


SCANNED
BY LASOP

CURB & GUTTER REPLACEMENT

PROSPECT AVE. NW BETWEEN SAN ISIDRO & SIOUX

INDEX

SHEET NO.	DESCRIPTION
1	TITLE
2	PLAN & PROFILE
3	PLAN & PROFILE
4	CROSS SECTION

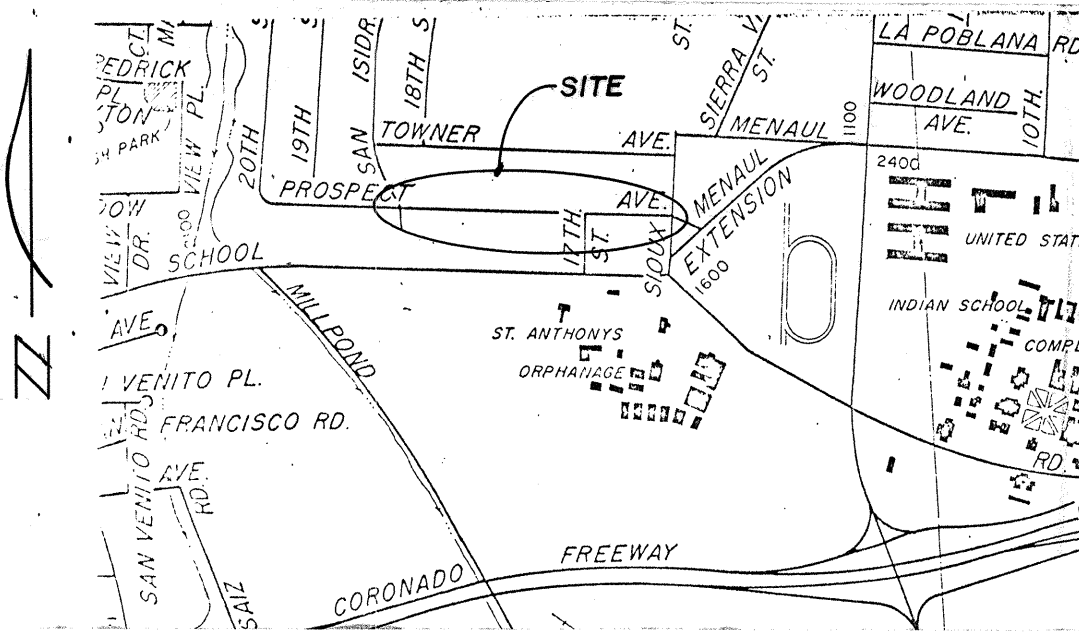

LOCATION MAP
1"=1000' ZONE ATLAS H-13

NOTICE TO CONTRACTORS

1. All work detailed on these plans to be performed under contract shall, except as otherwise stated or provided for hereon, be constructed in accordance with the New Mexico Standard Specifications for Public Works Construction - 1979 Edition (referred to herein as the Standard Specifications) and the Contract Documents for Public Works Contract 85-1

2. Two(2) working days prior to any excavation, the contractor must contact Line Locating Service, 765-1234 for location of existing utilities.

3. Prior to construction, the contractor shall excavate and verify the horizontal and vertical locations of all obstructions. Should a conflict exist, the contractor shall notify the engineer or surveyor so that the conflict can be resolved with minimum amount of delay.


THE FOLLOWING NOTES ALSO APPLY WHEN CHECKED

- ☐ All utilities and utility service lines shall be installed prior to paving.
- ☐ Backfill compaction shall be according to specified street use.
- ☐ Tack coat requirements shall be determined by the City Engineer.
- ☐ Sidewalks and wheelchair ramps within the curb returns shall be constructed wherever a new curb return is constructed.
- ☐ If curb is depressed for a drivepad or a handicap ramp, the drivepad or ramp shall be constructed prior to acceptance of the curb and gutter.
- ☐ All storm drainage facilities shall be completed prior to final acceptance.

APPROVAL OF AS BUILT DRAWINGS
ASST. CITY ENGINEER - FIELD
W. J. McManara
DATE 3-2-86

1 2 3 4 5 6 7 8 9 10 11 12
26 23860186

	CITY OF ALBUQUERQUE	APPROVED FOR CONSTRUCTION <i>C. M. Hayward</i> CITY ENGINEER DATE 3/2/86
	DRAWING NO. 2386	SHEET OF 1 4

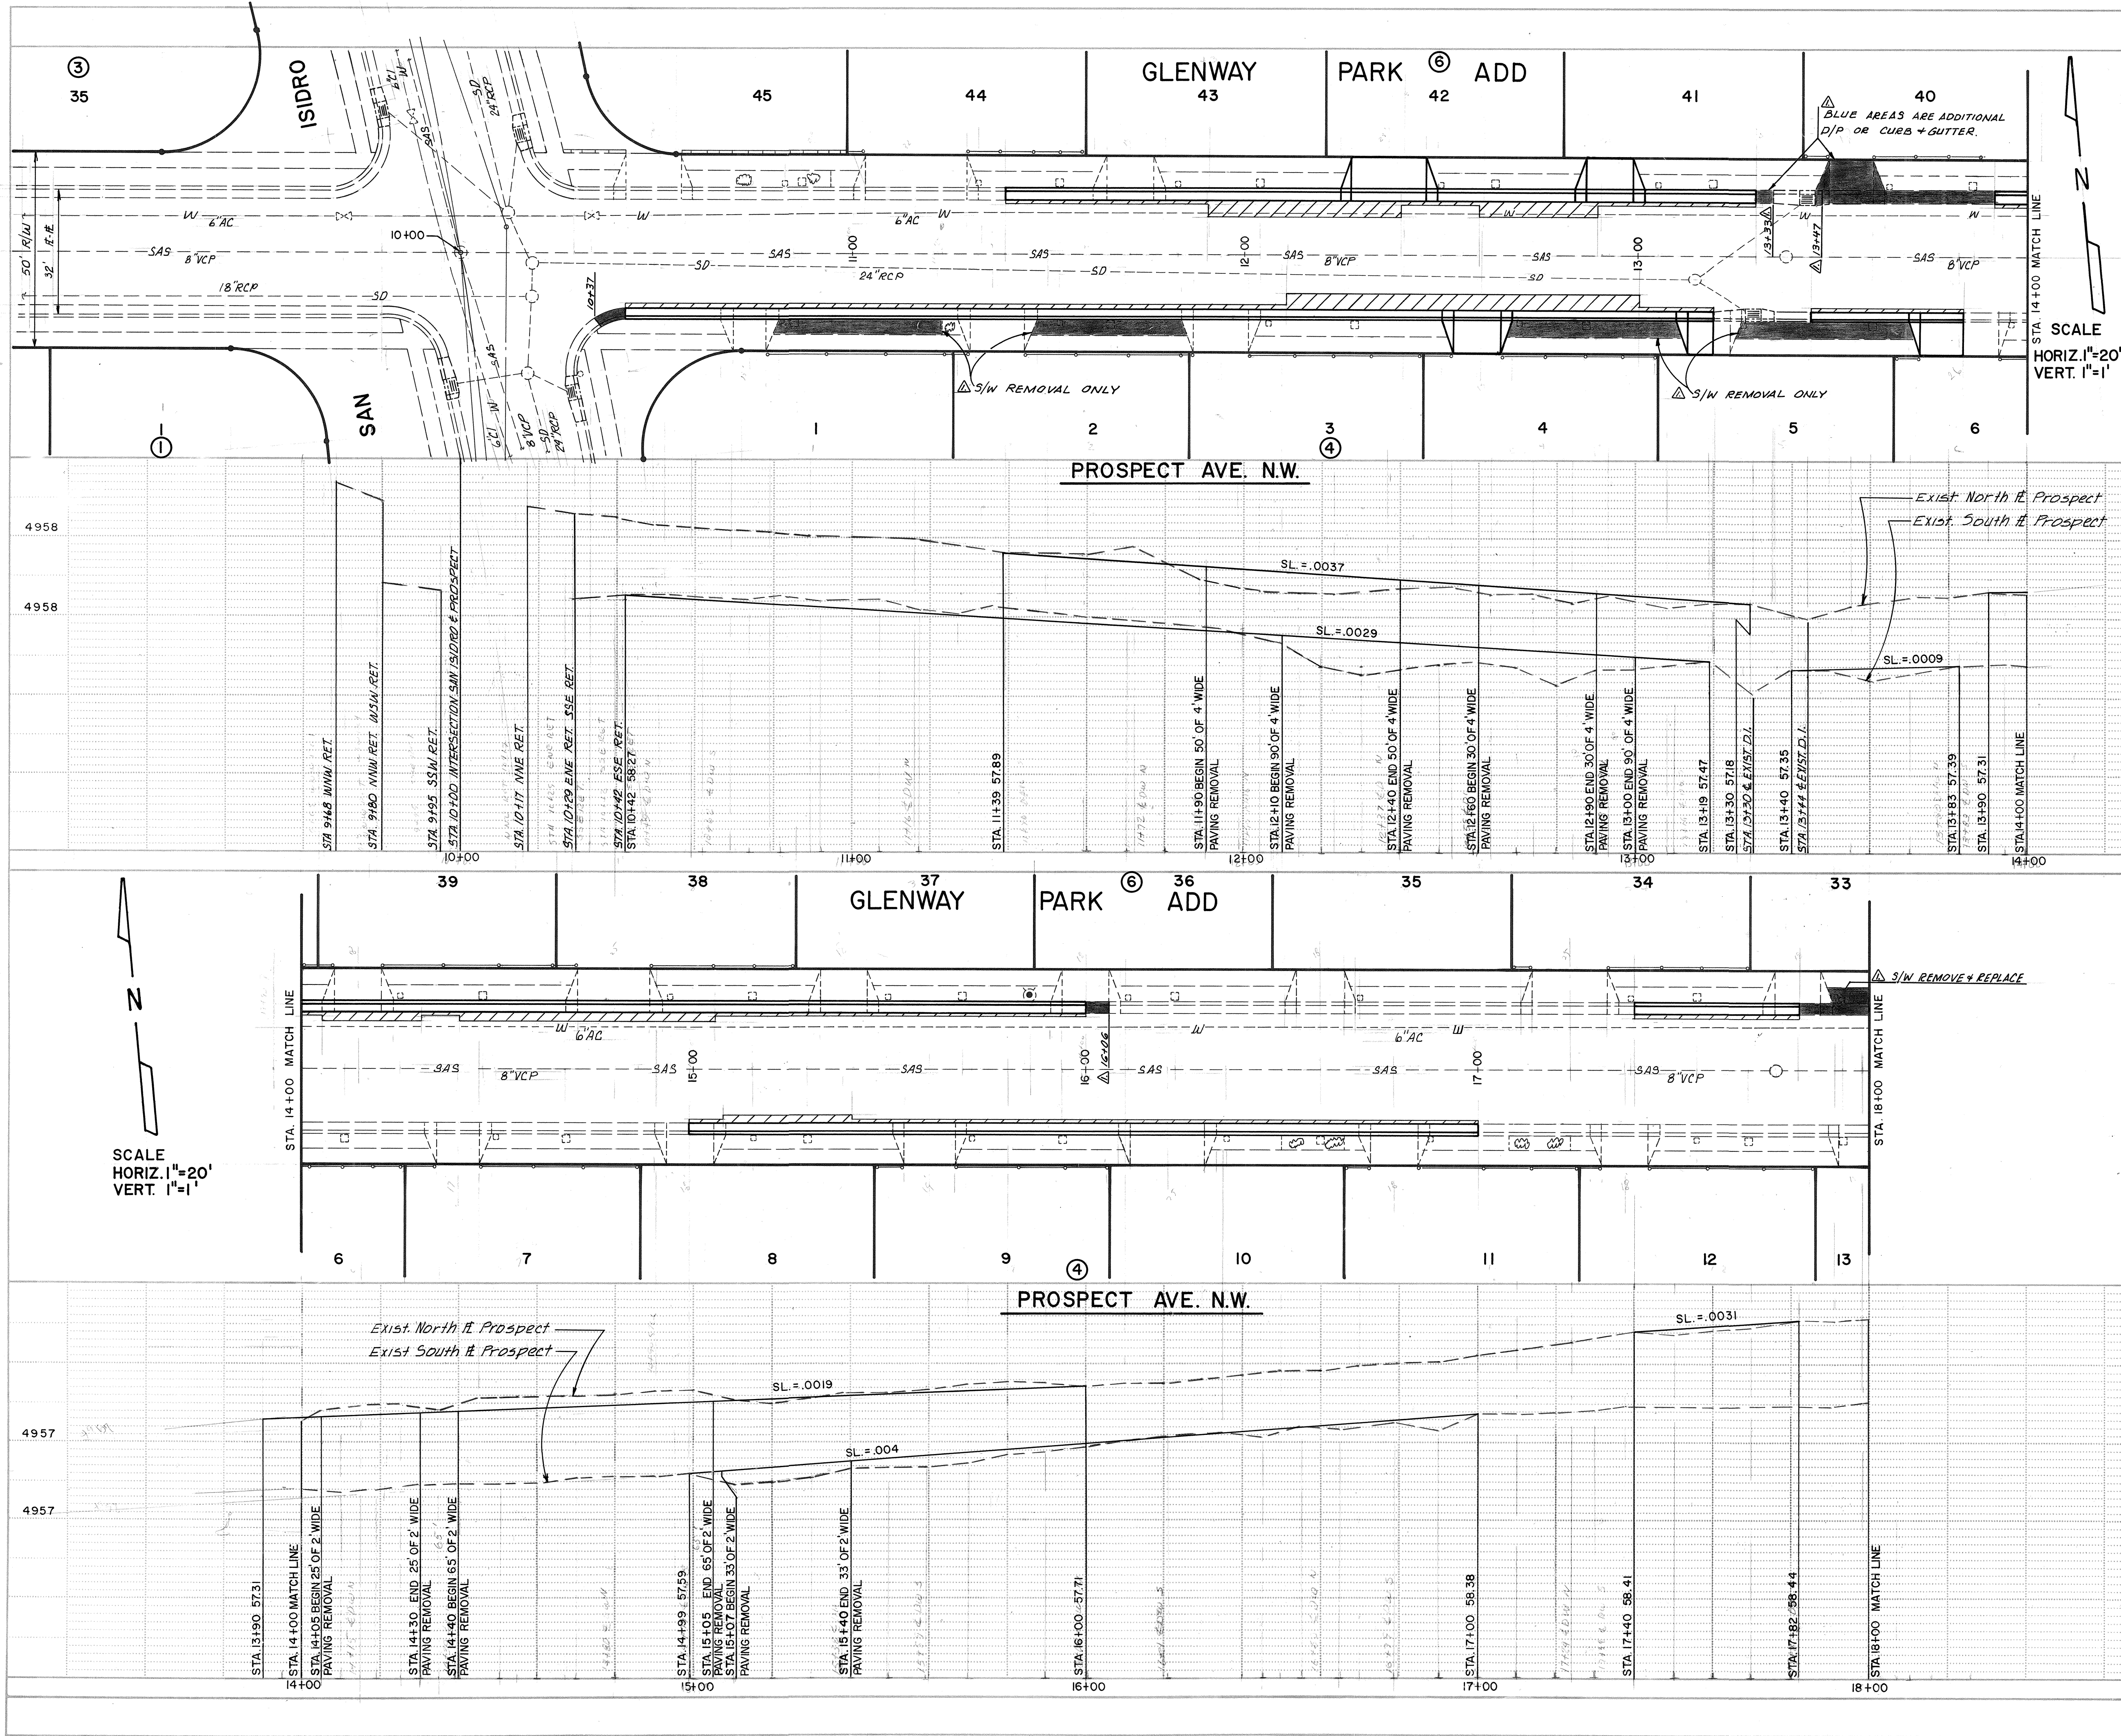

- LEGEND
- EXISTING CURB & GUTTER
 - EXISTING WATER METER
 - EXISTING MAIL BOX
 - EXISTING WATER VALVE
 - EXISTING MAN HOLE
 - EXISTING BUSH
 - 1' PAVING REML. & REPL.
 - 2' PAVING REML. & REPL.
 - 4' PAVING REML. & REPL.

SCALE
HORIZ. 1"=20'
VERT. 1"=1'

1	2	3	4	5	6	7	8	9	10	11	12
2	6	2	3	8	6	0	2	8	6		

CITY OF ALBUQUERQUE
MUNICIPAL DEVELOPMENT DEPARTMENT
ENGINEERING DIVISION


TITLE: CURB & GUTTER REPLACEMENT ON PROSPECT AVE NW
BETWEEN SAN ISIDRO AND SIOUX.

APPROVALS	ENGINEER	DATE	APPROVALS	ENGINEER	DATE
City Engineer	<i>[Signature]</i>	10/10/05	Liquid Waste	<i>[Signature]</i>	10/21/05
A.C.E. - Design	<i>[Signature]</i>	10/10/05	Traffic	<i>[Signature]</i>	10/18/05
A.C.E. - Hydrology	<i>[Signature]</i>	10/10/05	Water	<i>[Signature]</i>	10/21/05

DRAWING NO.	2386	MAP NO.	H-13	SHEET	2	OF	4
-------------	------	---------	------	-------	---	----	---

ENGINEER'S SEAL		SURVEY INFORMATION		BENCH MARKS		AS BUILT INFORMATION	
NO.	DATE	BY	FIELD NOTES	DATE	CONTRACTOR	WORK DONE BY	DATE
05-43	10/10/05	Aguilar		3/10/06	of Rio Grande Blvd. and Indian School Rd.	INSPECTOR'S	DATE
					M.W. 4 square chiseled on top of	ACCEPTANCE BY SUPERVISOR	DATE
					Concrete Curb at the NIE curb return.	FIELD VERIFICATION BY	DATE
					Reference B.M. S.A.S. M.H. #4-13-425	DRAWINGS	DATE
					Elev. 4960.17	COMPILED BY E. HAZ	DATE
						RECORDED BY	DATE
						NO.	DATE


SCALE
HORIZ. 1"=20'
VERT. 1"=1'

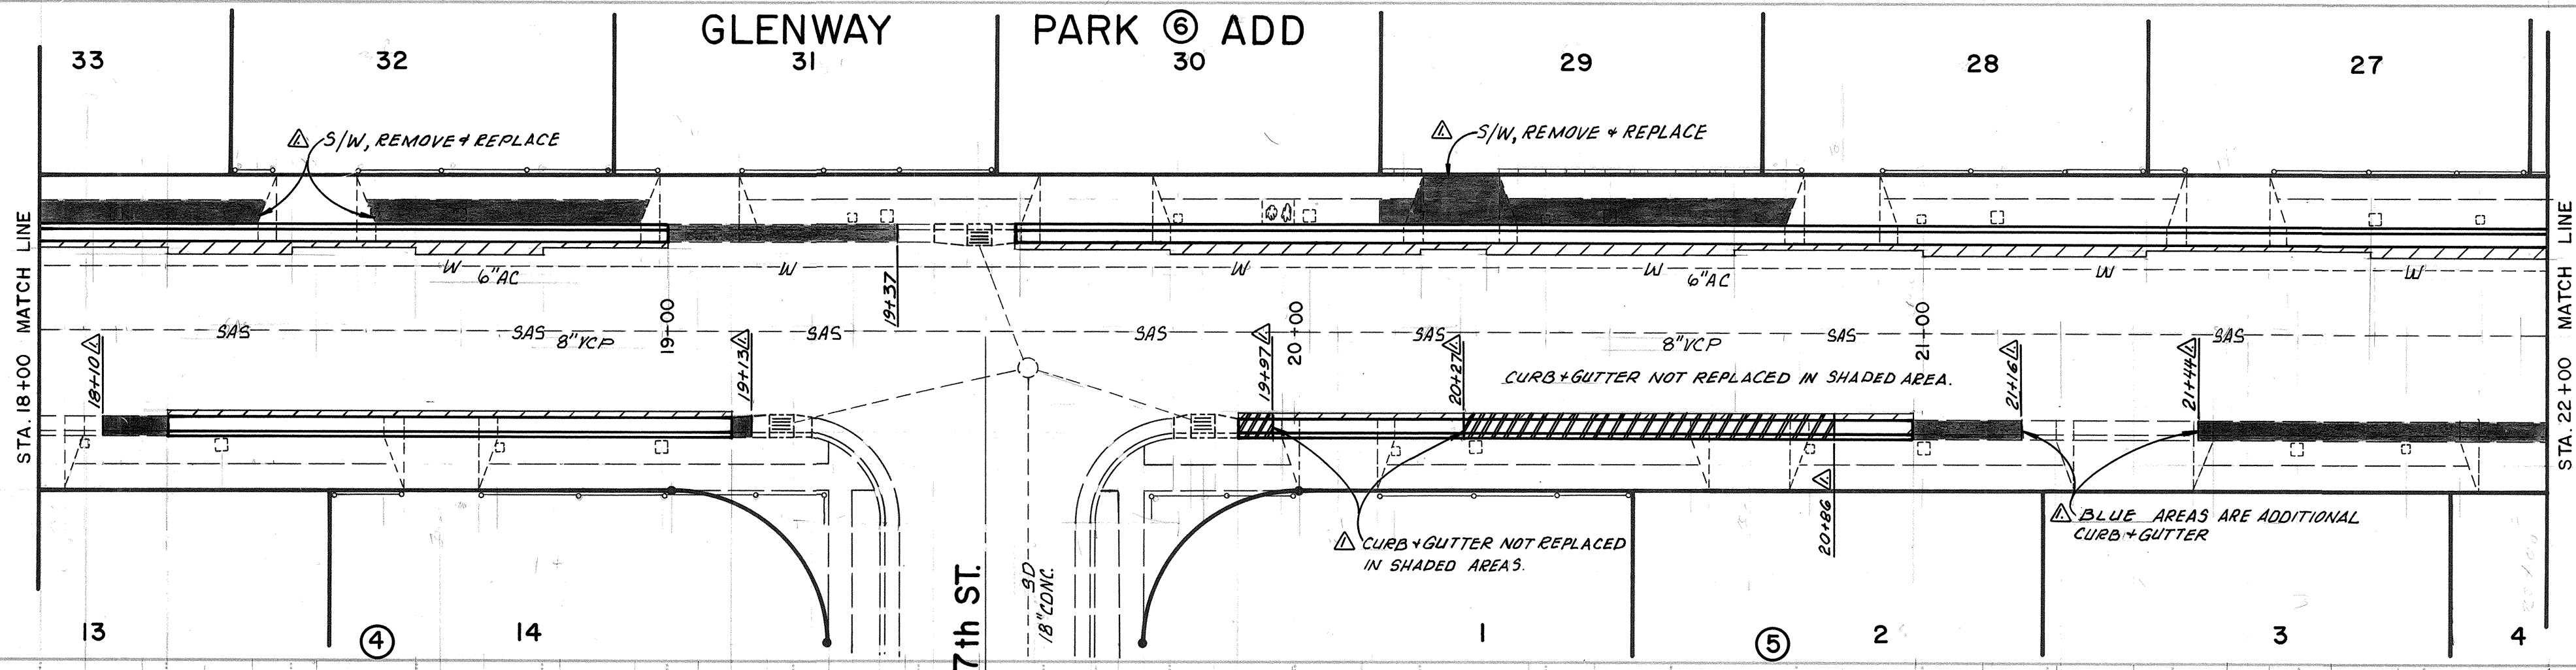

PROSPECT AVE. N.W.

Exist. North R. Prospect
Exist. South R. Prospect

SCALE
HORIZ. 1"=20'
VERT. 1"=1'

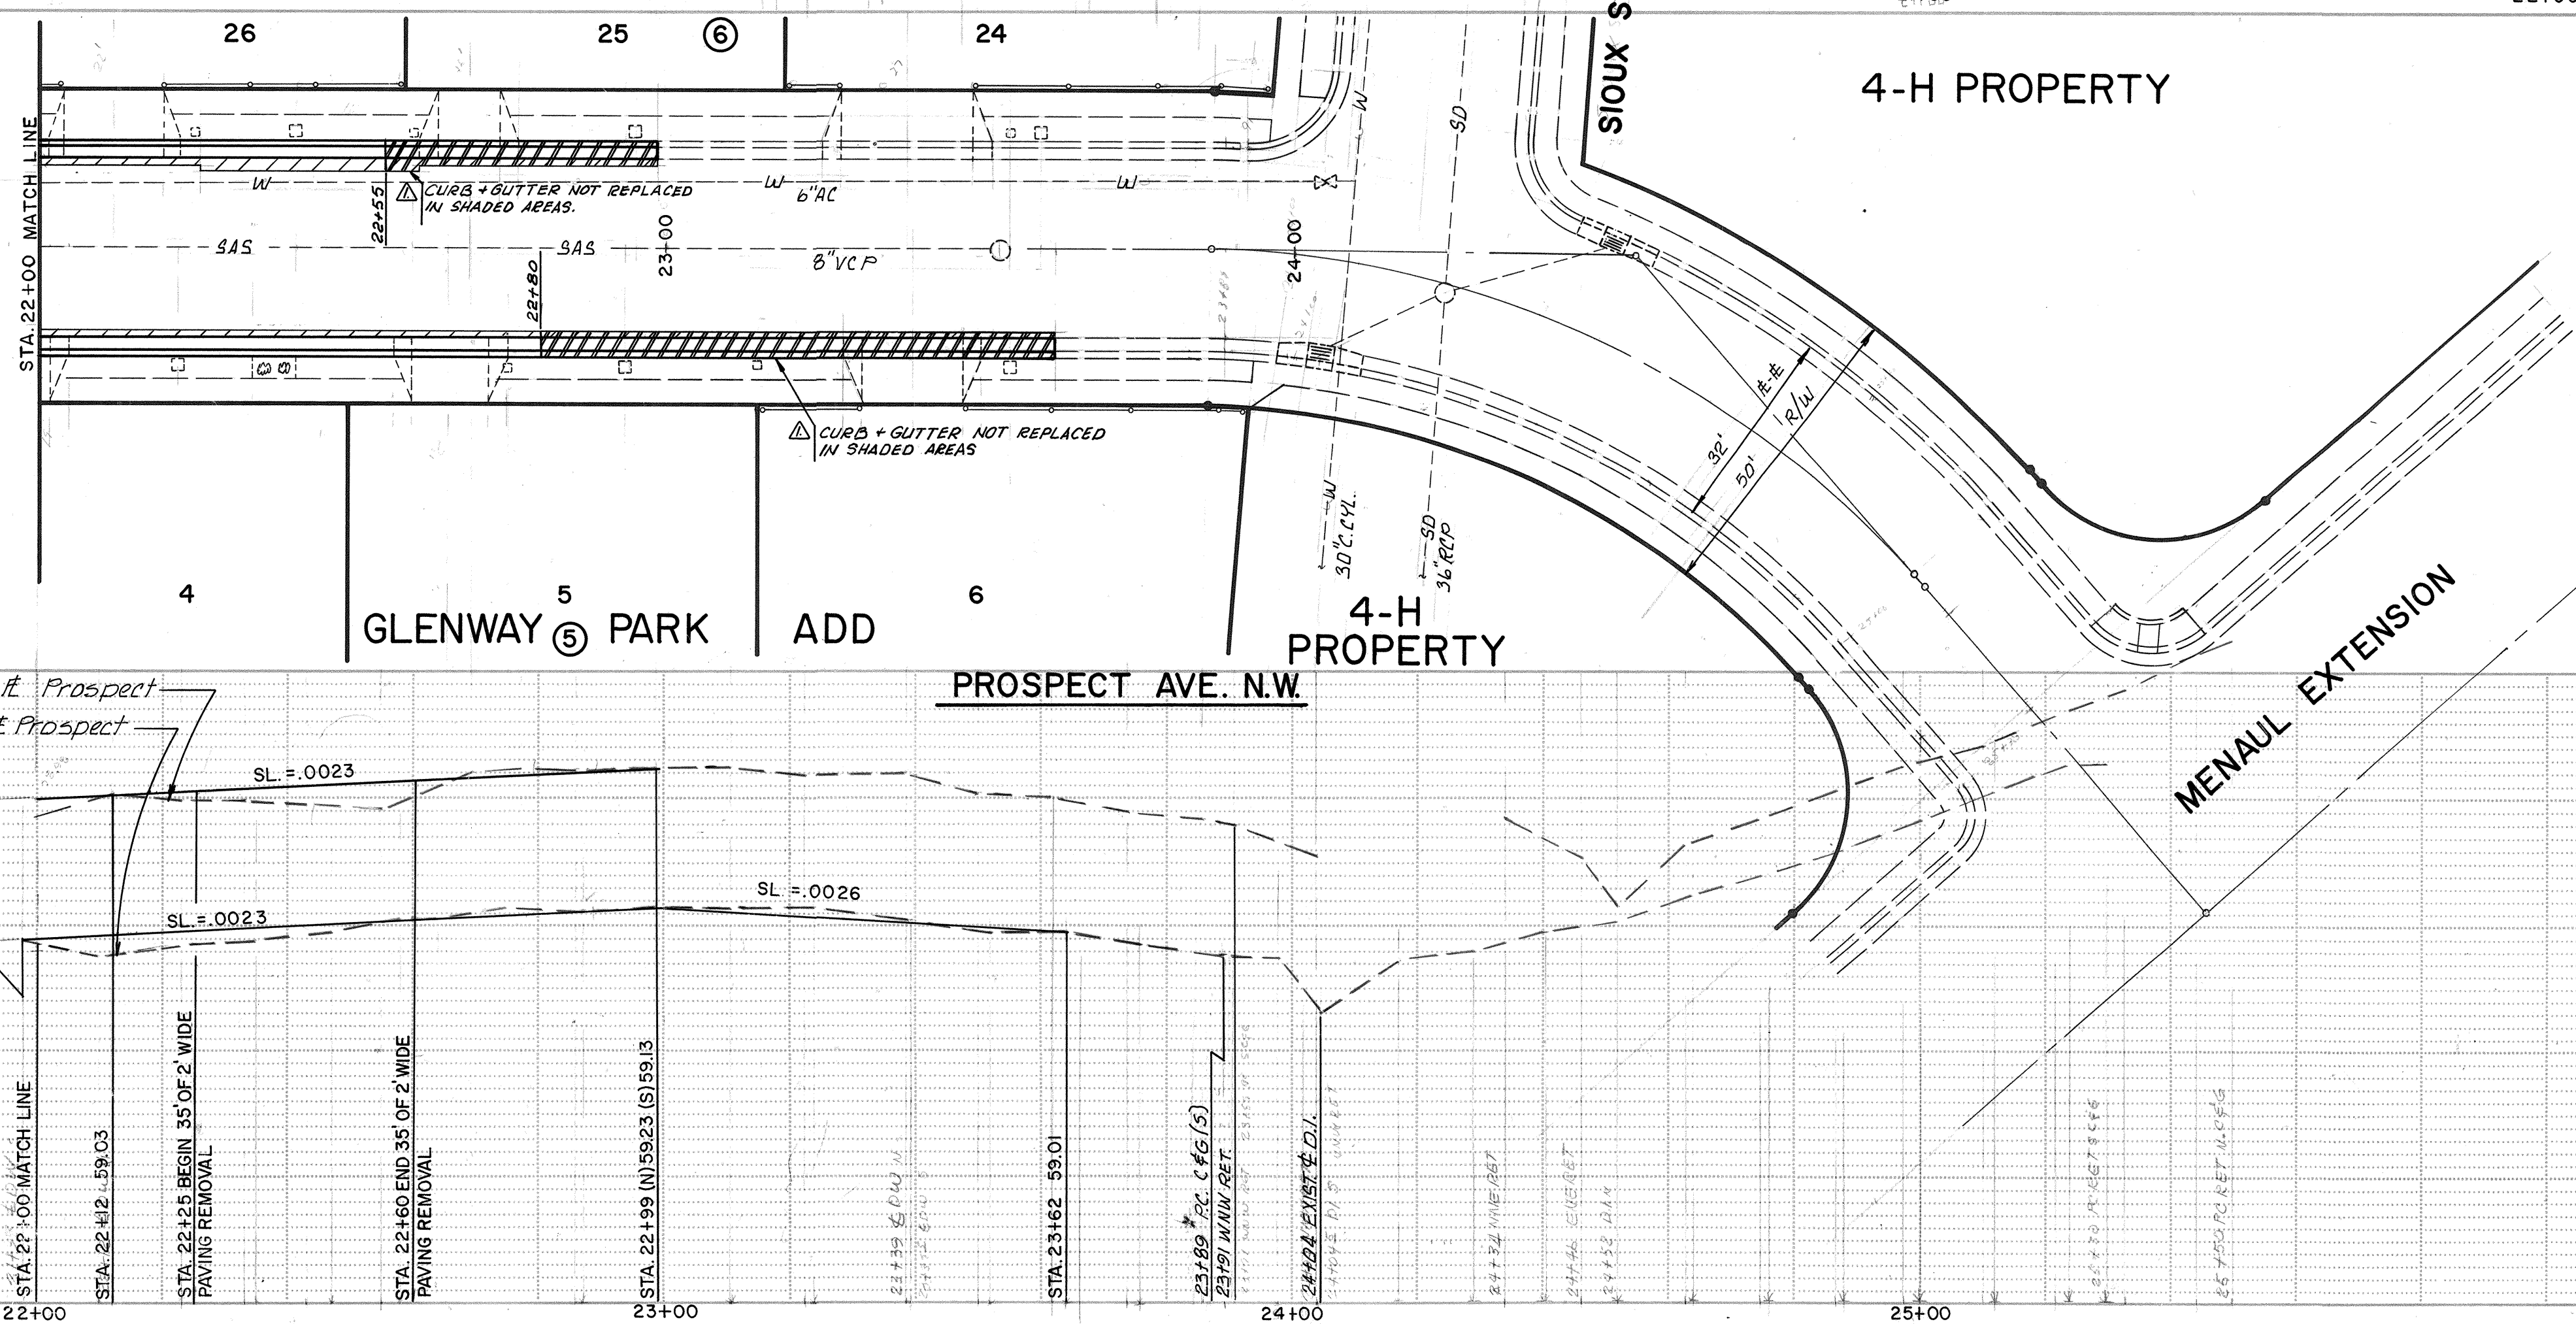

4-H PROPERTY

4-H PROPERTY

MENAU EXTENSION

LEGEND

- EXISTING CURB & GUTTER
- EXISTING WATER METER
- EXISTING MAIL BOX
- EXISTING WATER VALVE
- EXISTING MAN HOLE
- EXISTING BUSH
- 1' PAVING REML. & REPL.
- 2' PAVING REML. & REPL.
- 4' PAVING REML. & REPL.

3	2	3	4	5	6	7	8	9	10	11	12
2	6	2	3	8	6	0	3	8	6		


CITY OF ALBUQUERQUE
MUNICIPAL DEVELOPMENT DEPARTMENT
ENGINEERING DIVISION

TITLE CURB & GUTTER REPLACEMENT ON PROSPECT AVE NW
BETWEEN SAN ISIDRO AND SIOUX.

APPROVALS	ENGINEER	DATE	APPROVALS	ENGINEER	DATE
City Engineer	<i>[Signature]</i>	10/10/05	Liquid Waste	<i>[Signature]</i>	10/21/05
A.C.E. - Design	<i>[Signature]</i>	10/10/05	Traffic	<i>[Signature]</i>	10/11/05
A.C.E. - Hydrology	<i>[Signature]</i>	10/10/05	Water	<i>[Signature]</i>	10/21/05

DRAWING NO.	2386	MAP NO.	H-13	SHEET	3	OF	4
-------------	------	---------	------	-------	---	----	---

ENGINEER'S SEAL		SURVEY INFORMATION		BENCH MARKS		AS BUILT INFORMATION	
		NO.	BY	DATE	CONTRACTOR	WORK BY	DATE
		05-13	Aguilar	3/10/05	2113 Elva 4961.46 Located at the Intersection of Rio Grande Blvd and Indian School Rd. NW. A square chiseled on top of concrete curb at the NNE curb return.	INSPEC. ORS	DATE
						ACCEPTANCE BY C. SILVERMAN	DATE
						FIELD VERIFICATION BY	DATE
						DRAWINGS	DATE
						CORRECTED BY E. HAZ	DATE
						RECORDED BY	DATE
						MICRO-FILM INFORMATION	DATE
							NO.

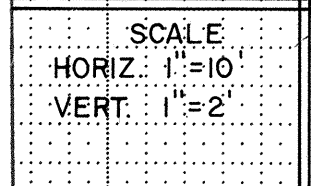

CITY OF ALBUQUERQUE MUNICIPAL DEVELOPMENT DEPARTMENT ENGINEERING DIVISION					
TITLE: CROSS SECTIONS ON PROSPECT BETWEEN SAN ISIDRO AND SIOUX.					
APPROVALS	ENGINEER	DATE	APPROVALS	ENGINEER	DATE
City Engineer	<i>M. Higgins</i>	11/6/85	Liquid Waste	<i>Rena</i>	10/21/85
A.C.E. - Design	<i>Al Chua</i>	11/6/85	Traffic	<i>N.R. Dwyer</i>	10/21/85
A.C.E. - Hydrology	<i>Anna Zink</i>	10/10/85	Water	<i>Rena</i>	10/21/85
DRAWING NO. 2386			SHEET 4 OF 4		