



PAVING — GRADING — DRAINAGE

1. Contractor shall notify all Utility Companies when working near their systems. Call 765-1234 regarding location of underground utility lines. All existing utilities shown here were taken as accurately as possible from Record Drawings and surface indications, but it shall be Contractors responsibility to protect, maintain in service and verify exact horizontal and vertical locations of all affected utilities during construction of this Project. Utility company shall be notified 2 working days in advance of work.
2. All work on this project shall be performed in accordance with applicable Federal, State and local laws, rules and regulations concerning construction safety and health.
3. Curb and gutter shown as existing and not to be removed under this contract which is damaged or displaced by the Contractor or his Subcontractors shall be replaced by the Contractor at his own expense.
4. The Contractor must submit a construction signing and barricading plan to Traffic Engineering to receive a barricading permit 48 hours prior to beginning construction.
5. Where removal of existing curb and gutter or sidewalk is required, remove to the nearest joint or saw cut.
6. The exact location of each wheelchair ramp shall be determined in the field by the Engineer. When construction of a new wheelchair ramp is called for at a location where curb and gutter exist, the Contractor shall remove and replace existing improvements as required to construct ramp.
7. Work included in these plans and not specifically included in the bid schedule are incidental to the related items specifically included in the bid schedule. No additional payment for these items will be allowed. For clarification some of these items may be labeled I.W. (incidental work) on these plans.
8. The Contractor shall be responsible for finding suitable material for engineered fills and will be responsible for the removal and disposal of waste materials and unsuitable soils. Borrow to be approved by the Engineer.
9. When work is required in streets, all Traffic Control and Barricading and Signing shall be done in accordance with the Manual on Uniform Traffic Control Devices, Latest edition. Traffic Division shall review and approve Traffic Control Plans, prior to any street or lane closures being allowed. Call 768-2780.
10. All work on these plans shall, unless otherwise provided herein, be constructed in accordance with the City of Albuquerque Interim Standard Specifications for Public Works Construction, 1985 Edition.
11. Prior to construction, the Contractor shall excavate and verify the horizontal and vertical location of all potential obstructions. Should a conflict exist, the Contractor shall notify the Engineer so that the conflict can be resolved with a minimum amount of delay.
12. The Contractor shall maintain access to adjacent properties during construction.
13. All utilities and utility service lines shall be installed prior to paving.
14. All storm drainage facilities shall be completed prior to final acceptance.
15. Backfill compaction shall be according to specified street use.
16. Tack coat requirements shall be determined by the City Engineer.


Odellia Park Parking Lot
2421

Sheet No.	Description
1	Index to drawings, General notes, Title
2	Grading plan
3	Pavement Plan and Profile
4	Detail Sheet

SET NO. _____


APPROVAL OF AS BUILT DRAWINGS
ASST. CITY ENGINEER - FIELD
W. J. McNamee
DATE 6/20/84

1	2	3	4	5	6	7	8	9	10	11	12
2	6		2	4	2	1	0	1	8	6	

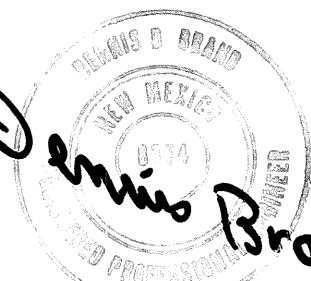
REV.	SHEETS	CITY	ENGR.	DATE	USER	DEPT.	DATE	USER	DEPT.
APPROVAL OF REVISIONS									
 <i>Dennis Brand</i> rev. 2/5/86					 SCANLON & ASSOCIATES CONSULTING ENGINEERS			APPROVED FOR CONSTRUCTION <i>James L. Engle</i> DESIGN	
DRAWING NO. 2421				MAP NO. J-15			SHEET <u>1</u> OF <u>4</u>		

LEGEND
Limits of Construction

Scale: 1"=50'

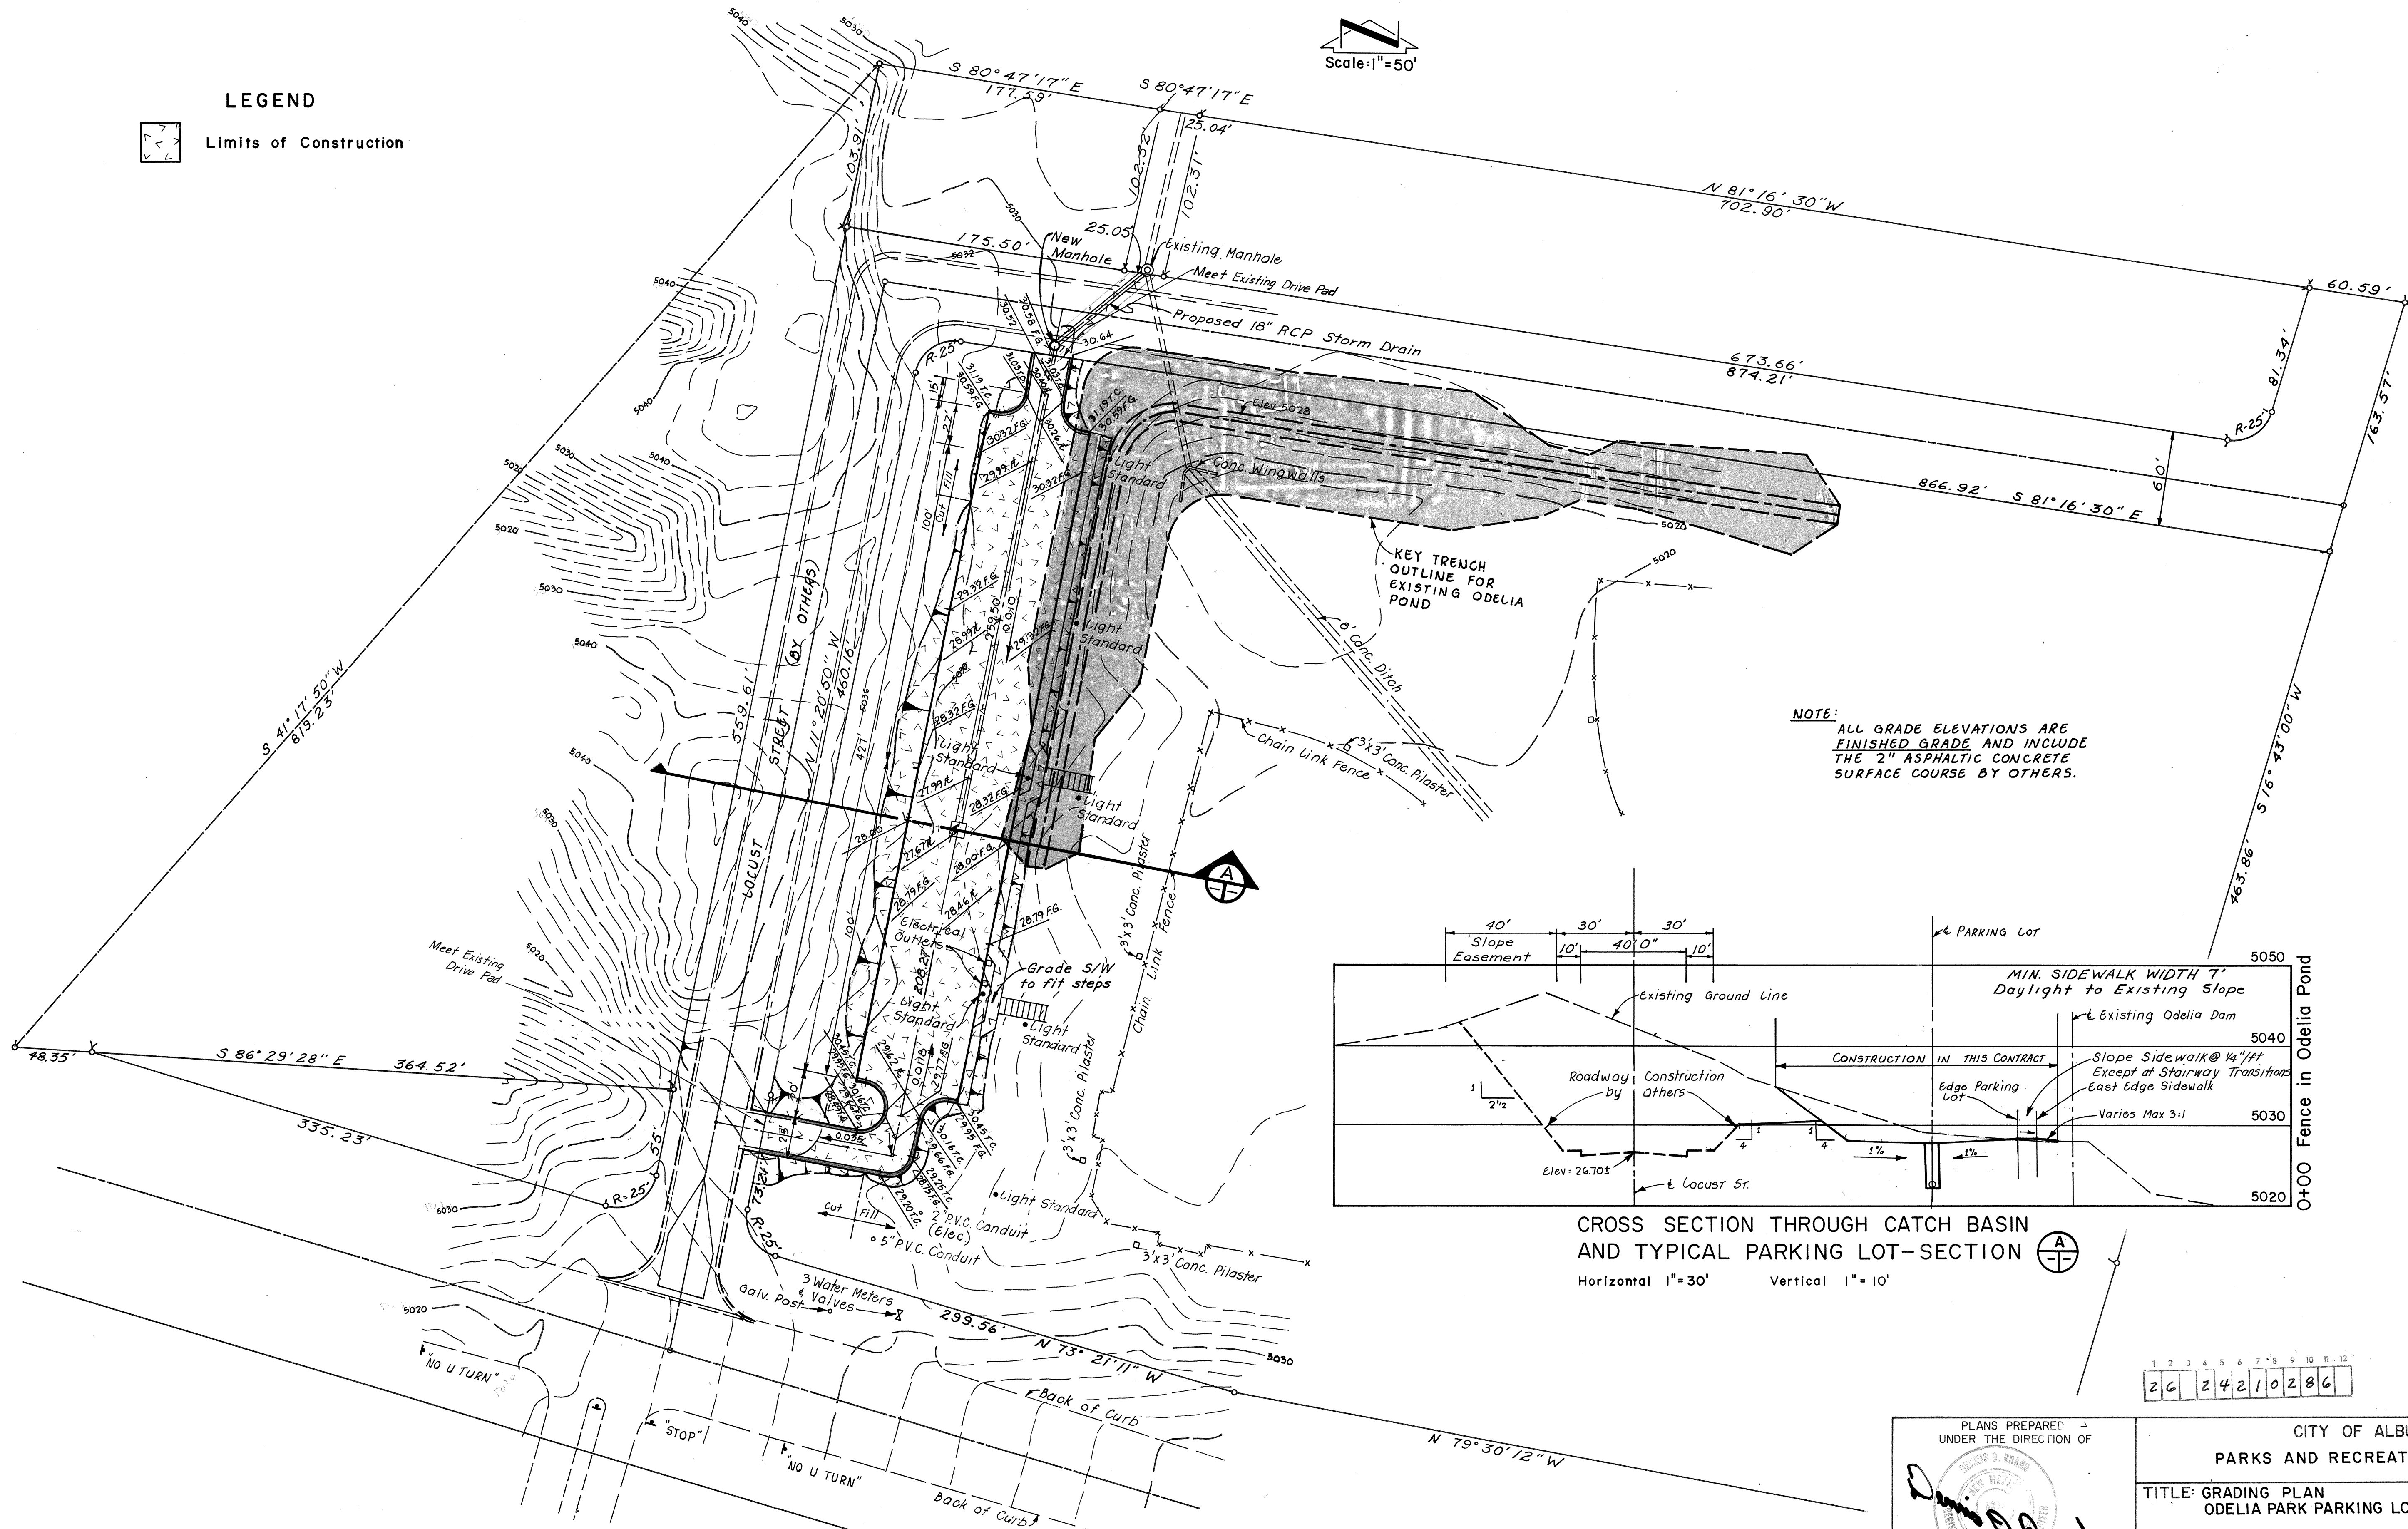

NOTE:
ALL GRADE ELEVATIONS ARE
FINISHED GRADE AND INCLUDE
THE 2" ASPHALTIC CONCRETE
SURFACE COURSE BY OTHERS.



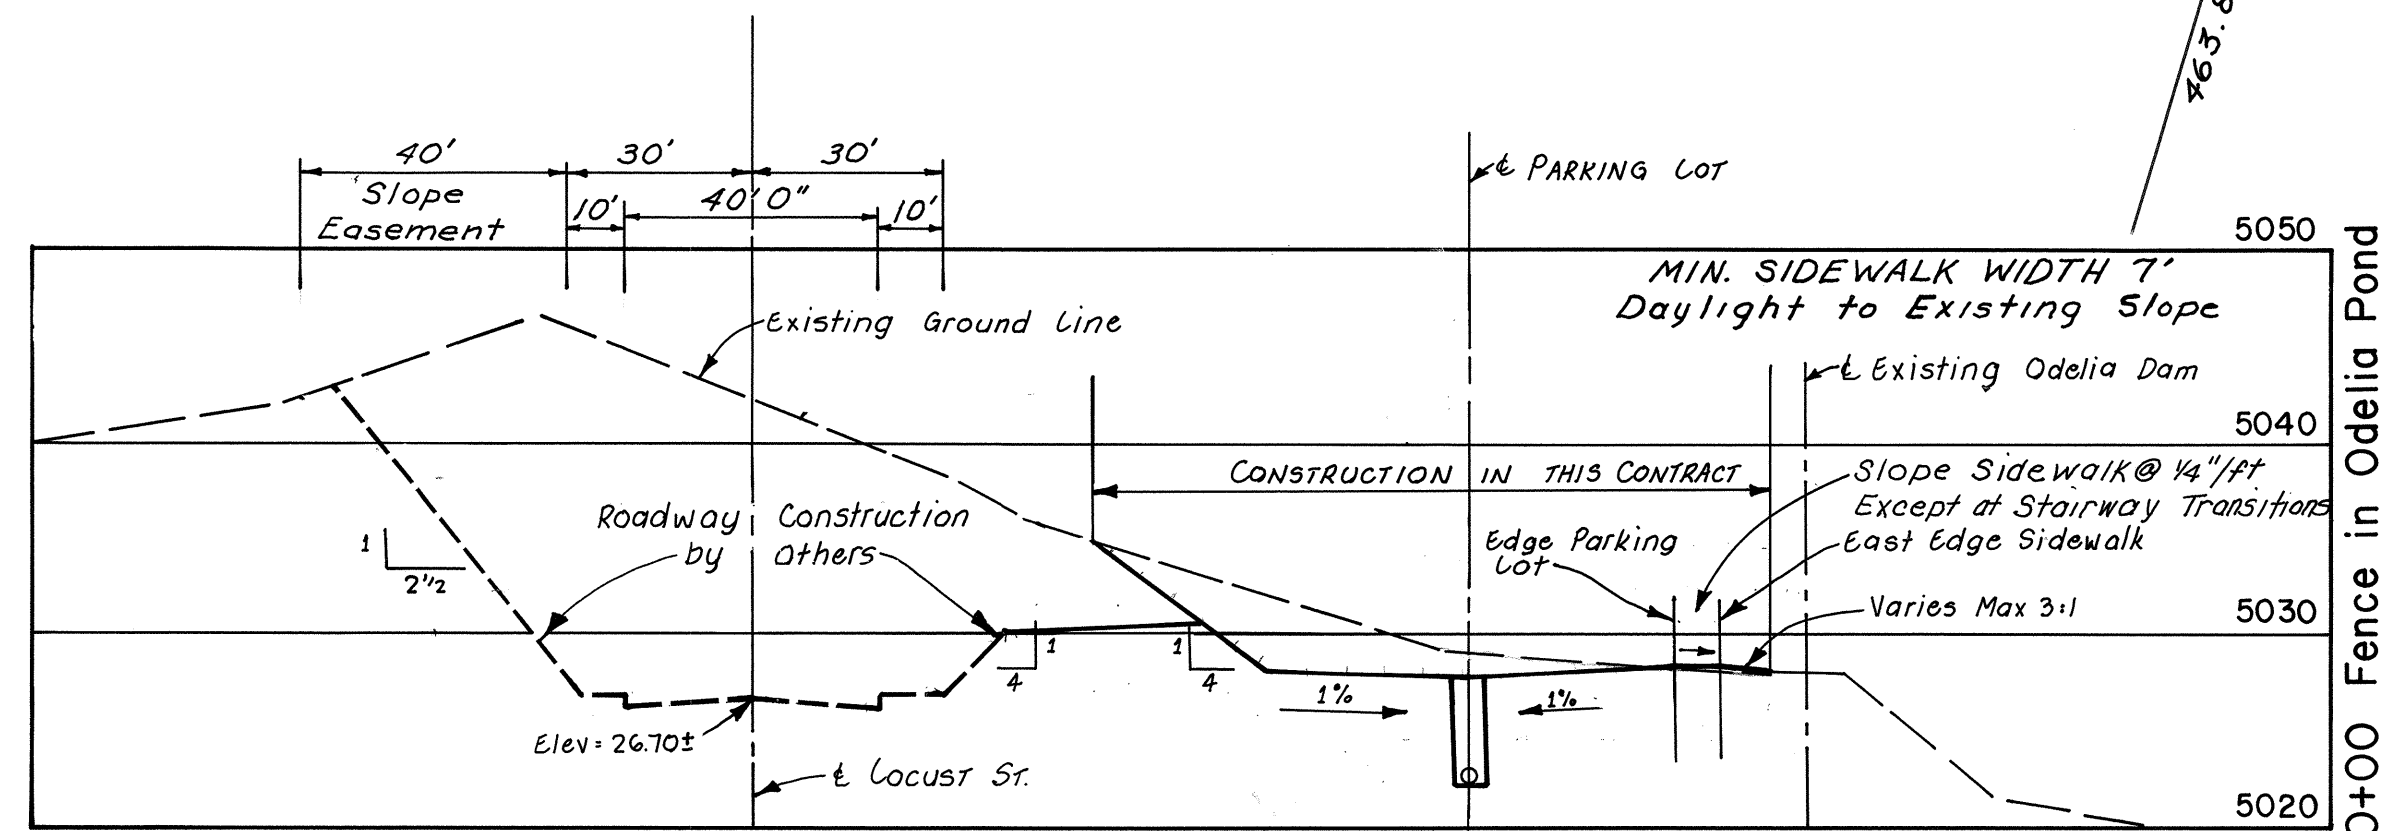


CROSS SECTION THROUGH CATCH BASIN
AND TYPICAL PARKING LOT-SECTION

Horizontal 1"=30' Vertical 1"=10'

26 24210286

PLANS PREPARED UNDER THE DIRECTION OF <i>Daniel O. Brand</i> 2/5/86 JOB NO. 85115			CITY OF ALBUQUERQUE PARKS AND RECREATION DEPARTMENT TITLE: GRADIAN PARK ODELIA PARK PARKING LOT		
APPROVALS	ENGINEER	DATE	APPROVALS	ENGINEER	DATE
City Engineer	<i>H. B. ...</i>	2/5/86	Liquid Waste	<i>N/A B. ...</i>	3/12/86
A.C.E.-Design	<i>And. H. ...</i>	3/20/86	Traffic	<i>D.G. Parks</i>	3/12/86
A.C.E.-Hydrology	<i>And. H. ...</i>	3/20/86	Water	<i>N/A B. ...</i>	3/12/86
DRAWING NO. 2421			MAP NO. J-15		
CITY ENGINEER DATE			SHEET 2 OF 4		

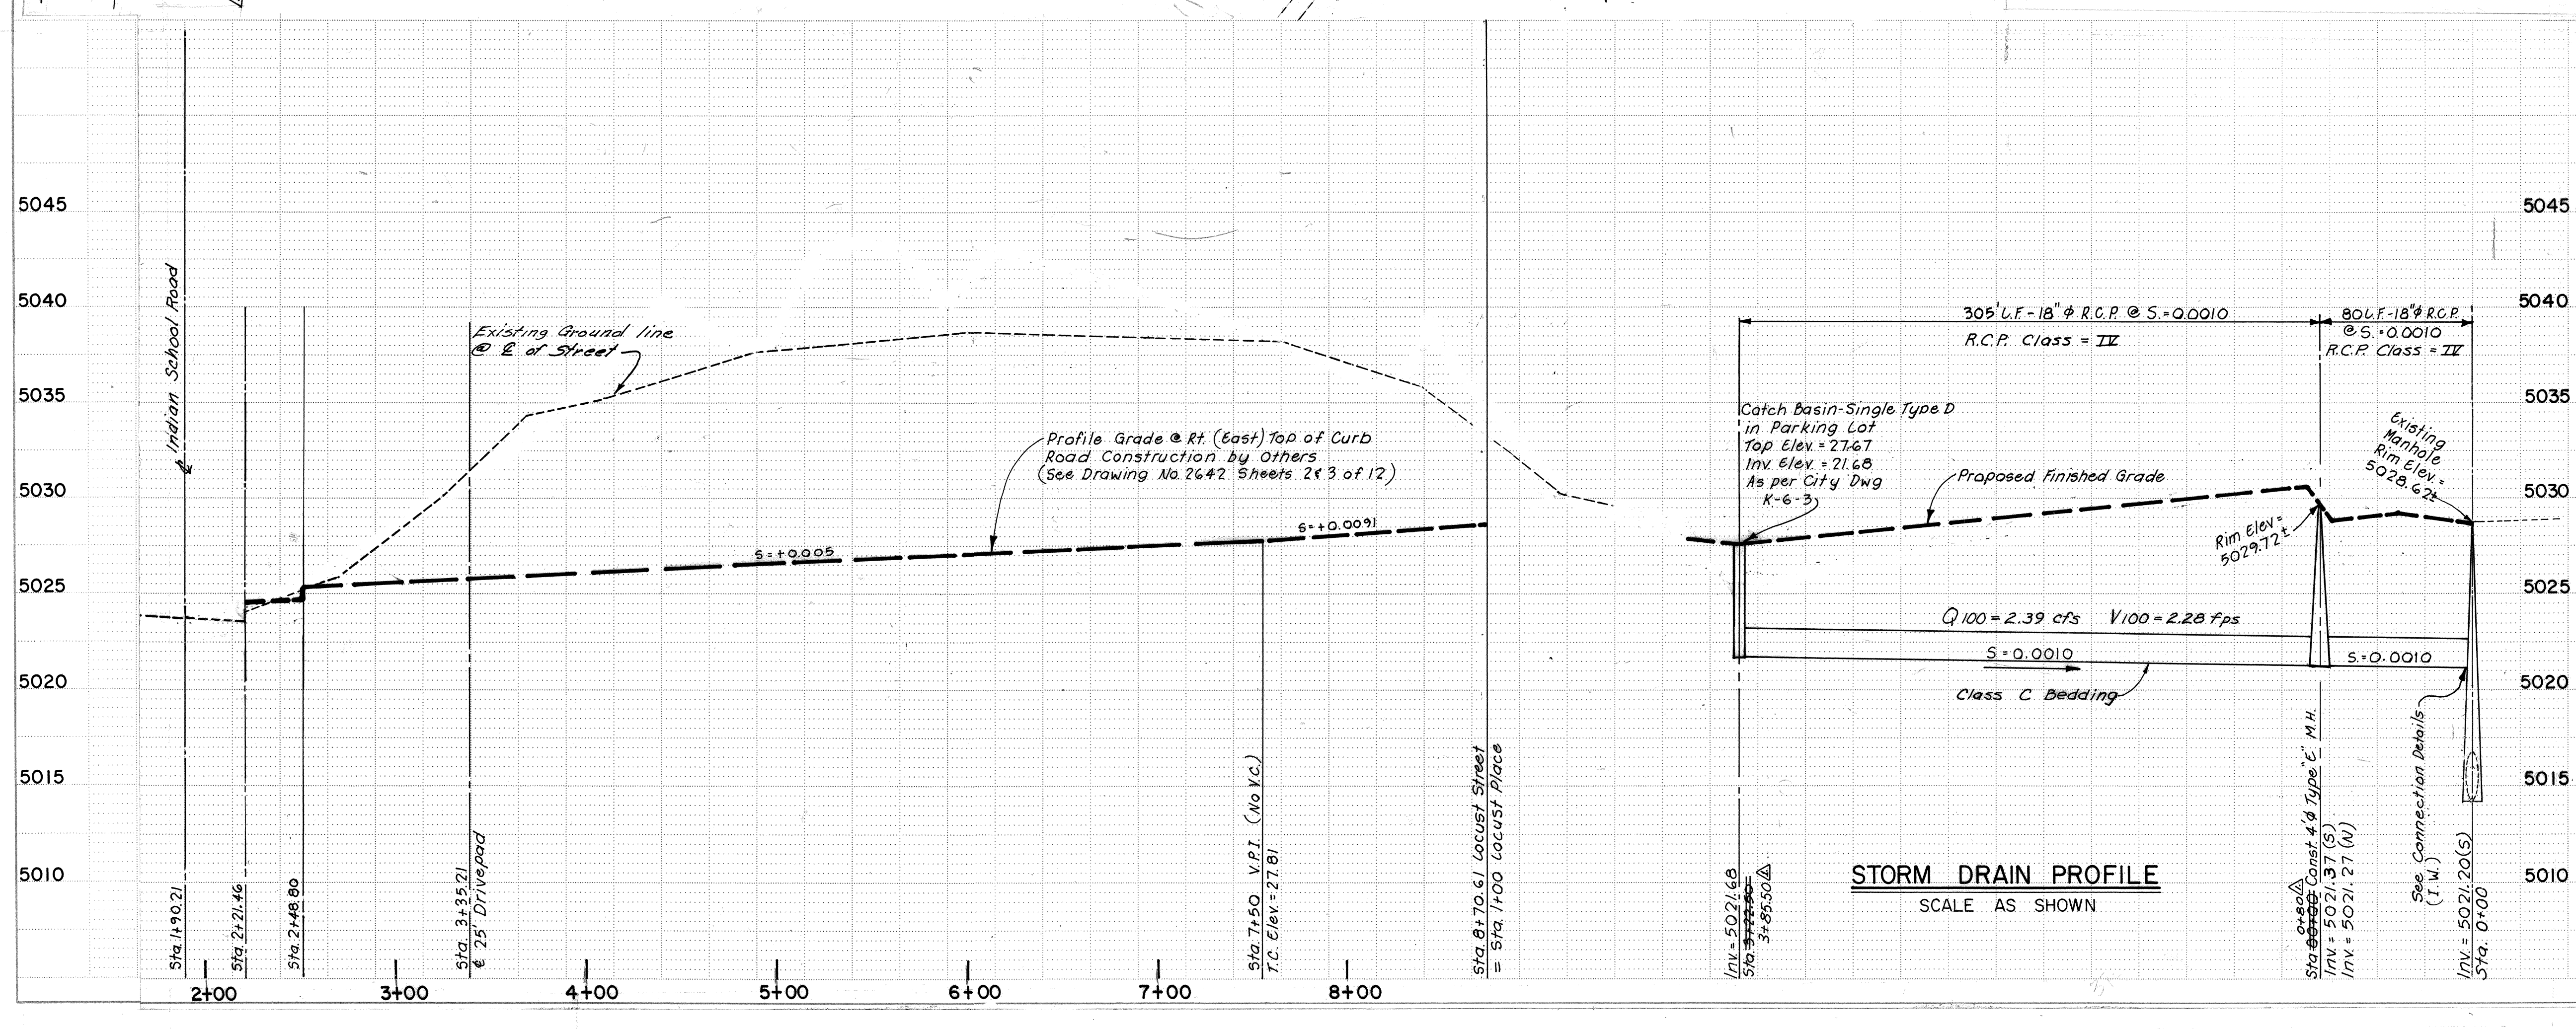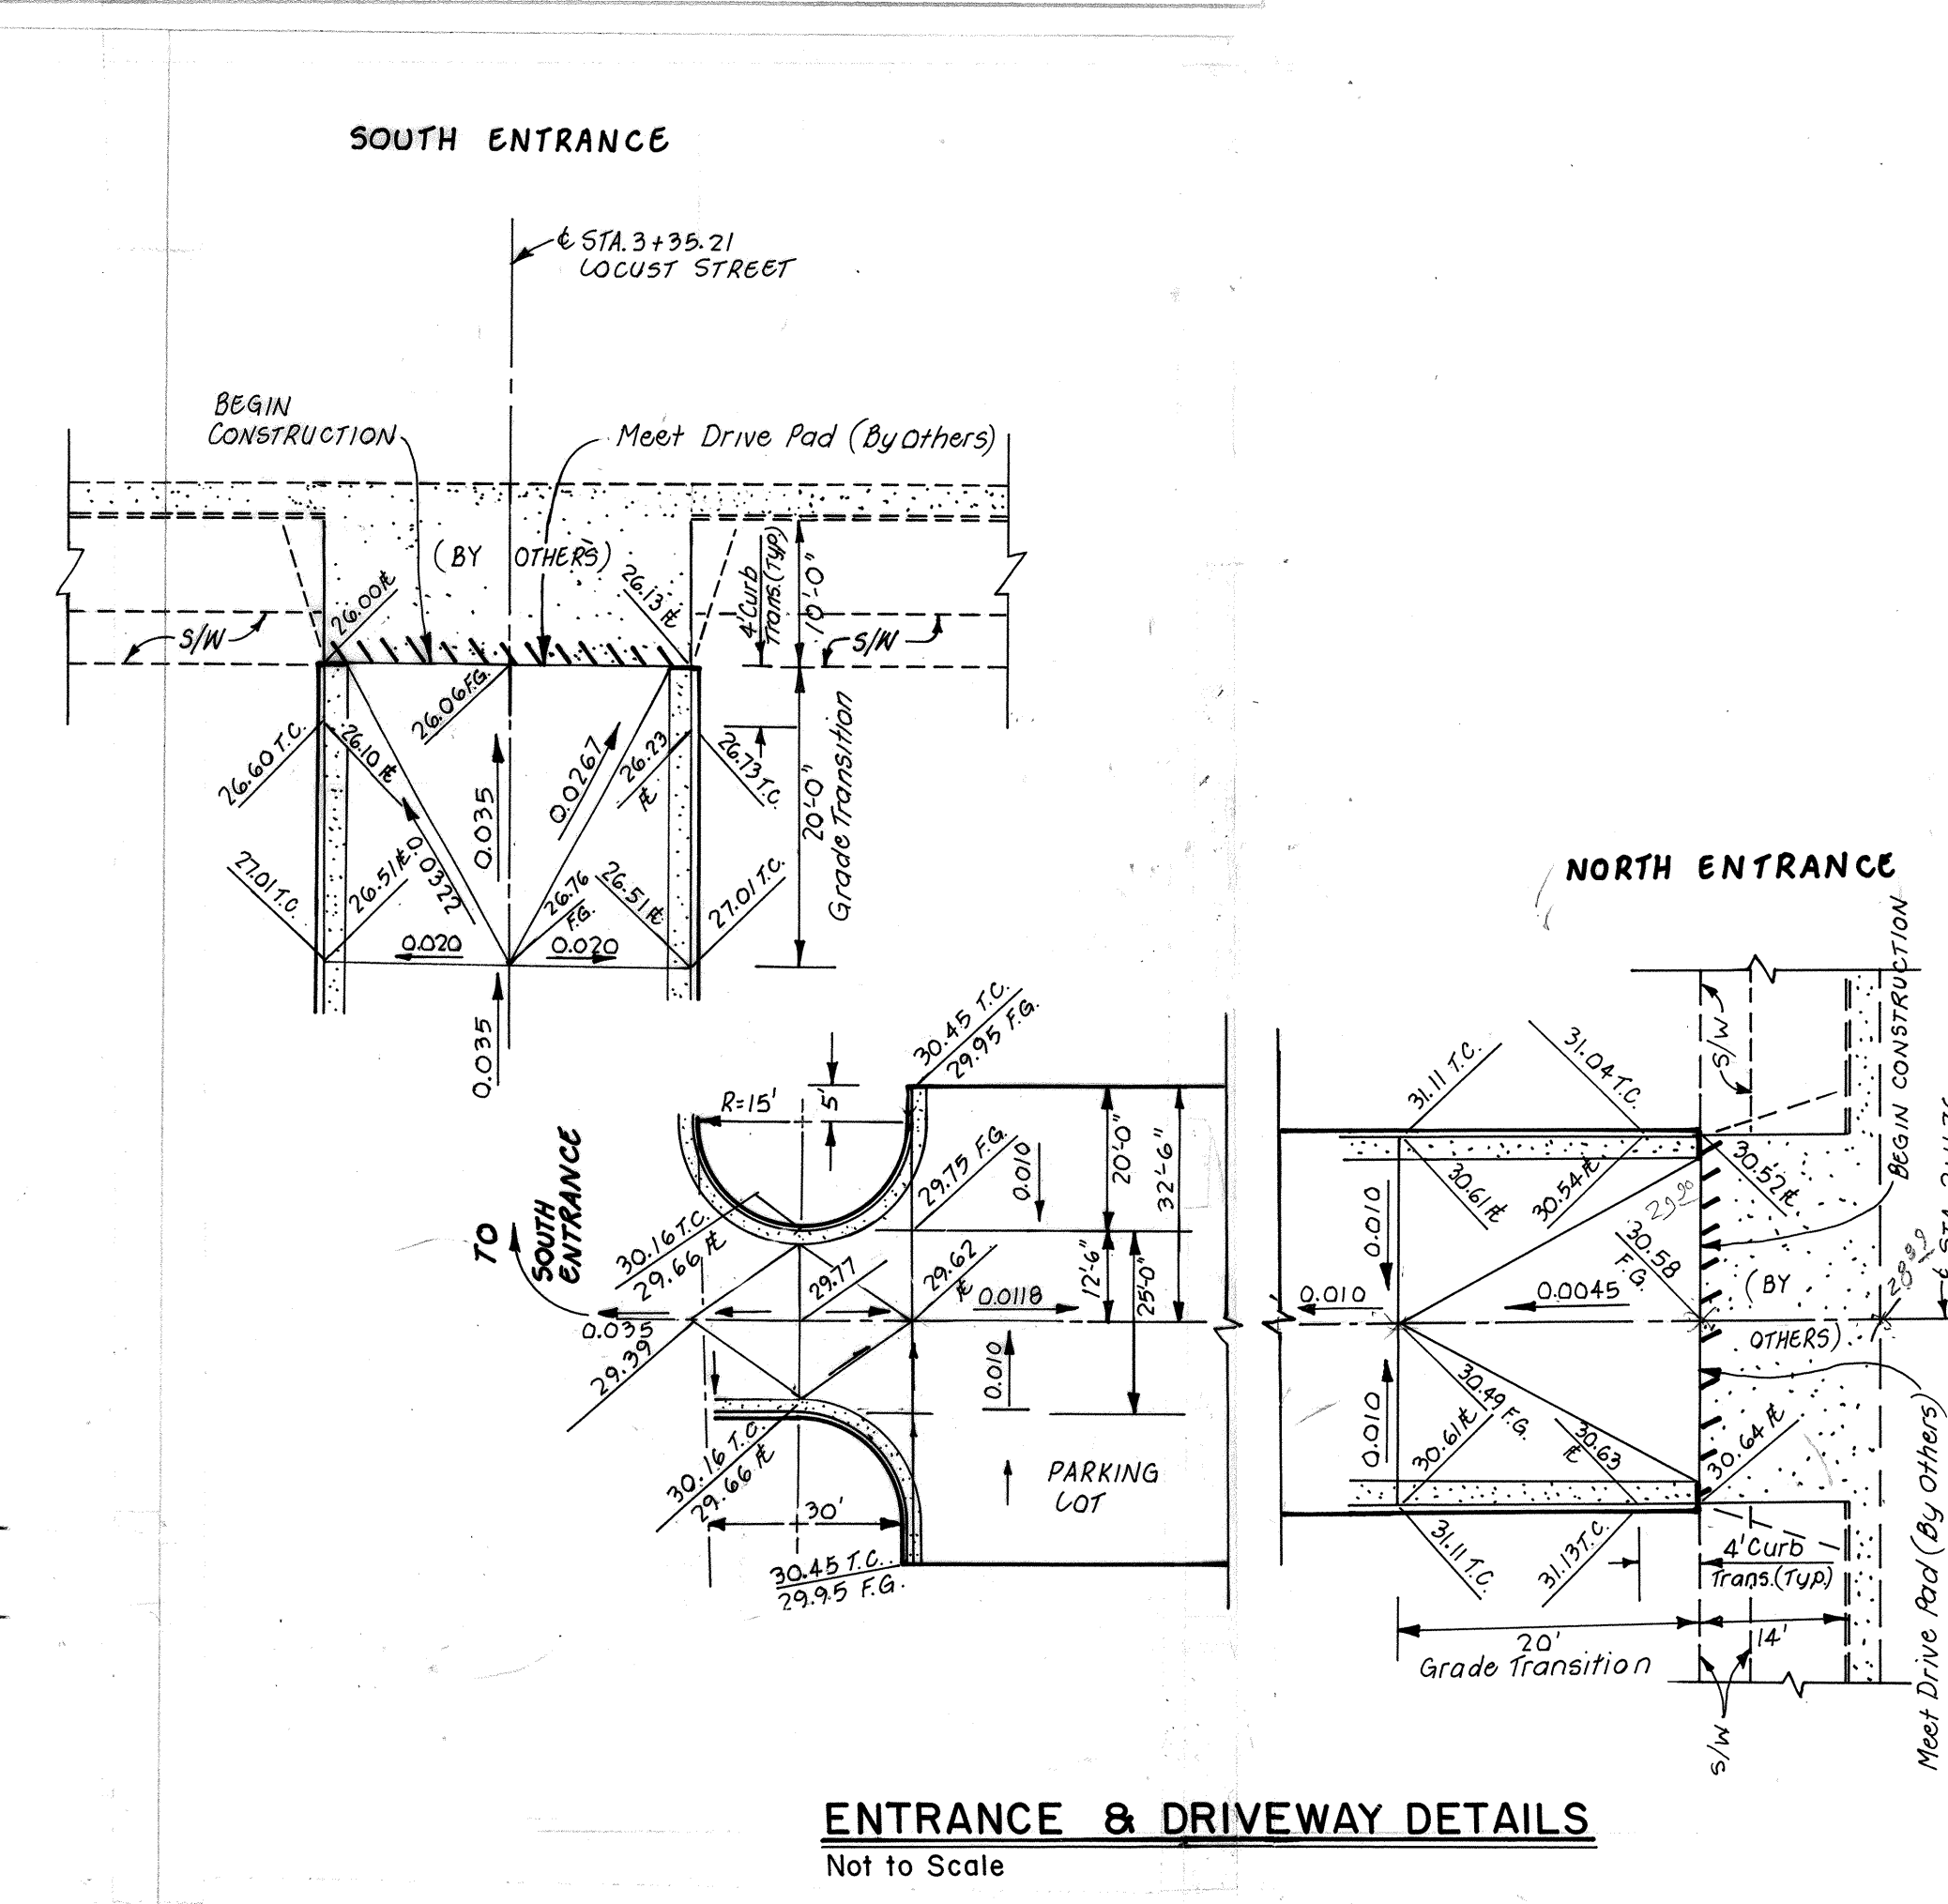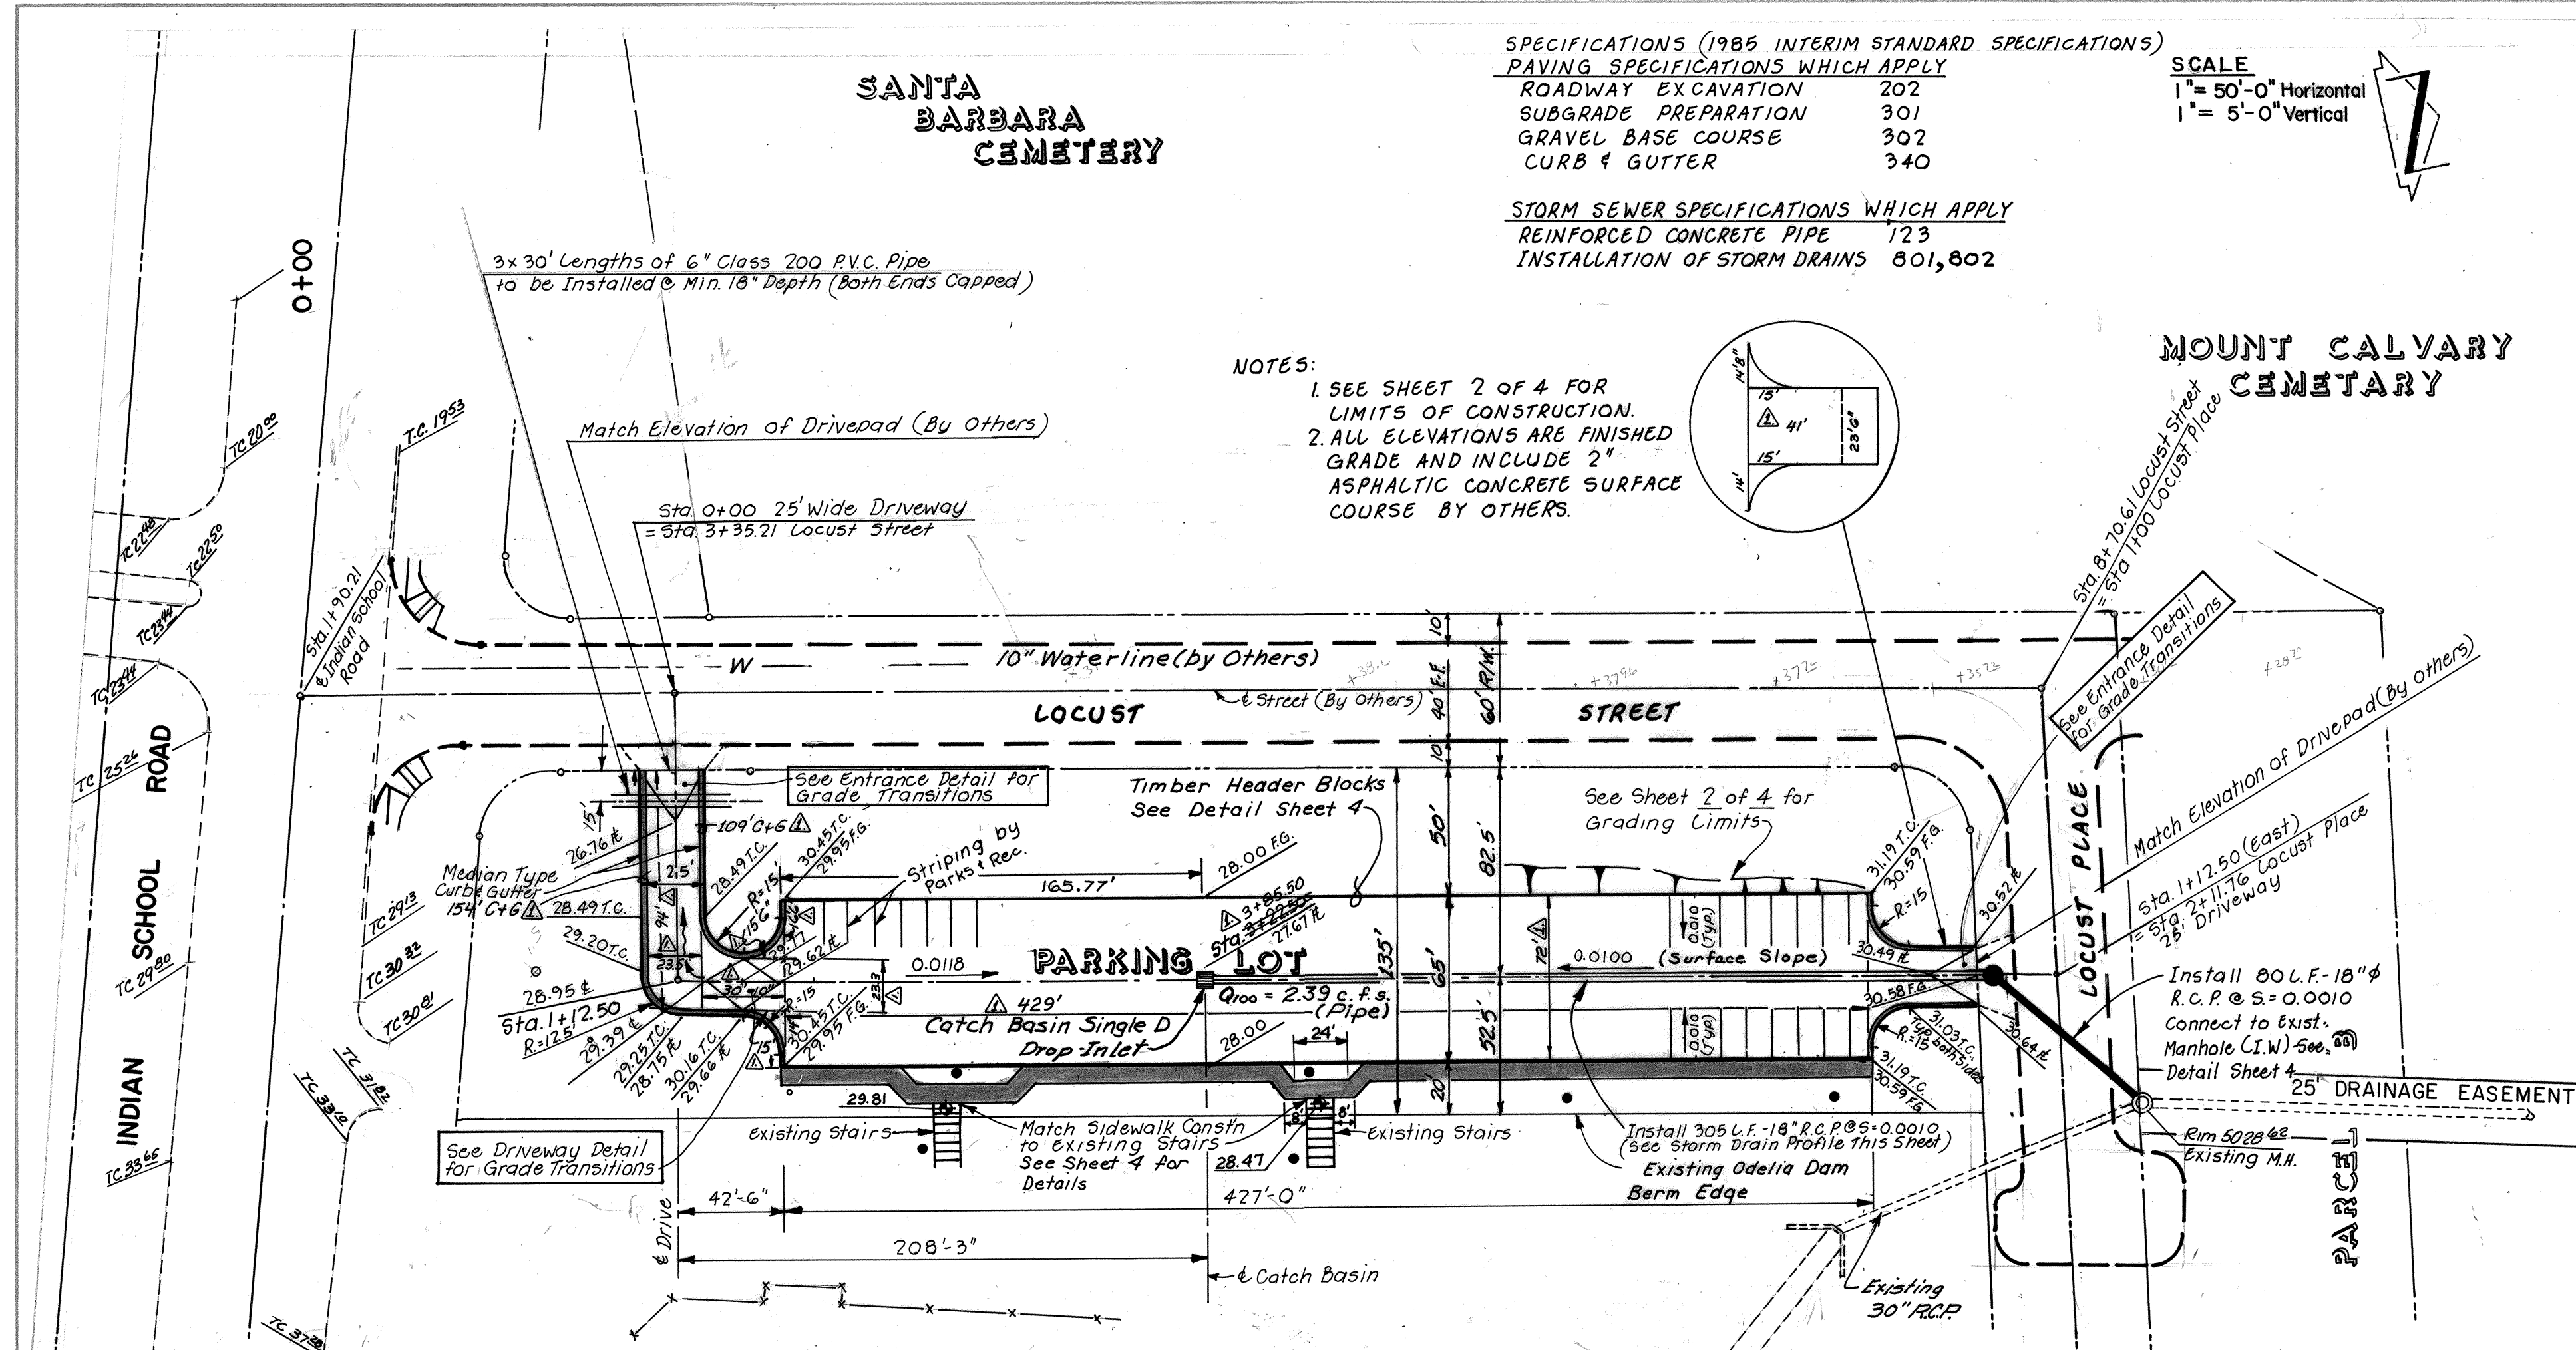

AS BUILT INFORMATION

CONTRACTOR: NMSHC I-25-24: Standard NMSHC Brass

DATE: 3/25/86

INSPECTOR: J. A. Pando

DATE: 3/25/86

FIELD: J. A. Pando

DATE: 3/25/86

REVISIONS: J. A. Pando

DATE: 3/25/86

DESIGNED BY: R.E.S.

DATE: 4-85

DRAWN BY: L.J.B.-P.J.R.-C.L.W.

DATE: 8-85

CHECKED BY:

DATE:

ENGINEER'S SEAL

REVISIONS

NO.	DATE	REMARKS
1	3/25/86	Revised from as-built drawings
2	3/25/86	Revised from as-built drawings
3	3/25/86	Revised from as-built drawings
4	3/25/86	Revised from as-built drawings
5	3/25/86	Revised from as-built drawings
6	3/25/86	Revised from as-built drawings
7	3/25/86	Revised from as-built drawings
8	3/25/86	Revised from as-built drawings
9	3/25/86	Revised from as-built drawings
10	3/25/86	Revised from as-built drawings
11	3/25/86	Revised from as-built drawings
12	3/25/86	Revised from as-built drawings

CITY OF ALBUQUERQUE

PARKS AND RECREATION DEPARTMENT

TITLE: PAVING PLAN & PROFILE

ODELIA PARK PARKING LOT


APPROVALS

ENGINEER	DATE	APPROVALS	ENGINEER	DATE
J. A. Pando	3/25/86	Liquid Waste	N/A B.R. al	3/12/86
J. A. Pando	3/25/86	Traffic	J. A. Pando	3/12/86
J. A. Pando	3/25/86	Water	N/A B.R. al	3/12/86


DRAWING NO. 2421

MAP NO. J-15


SHEET 3 OF 4

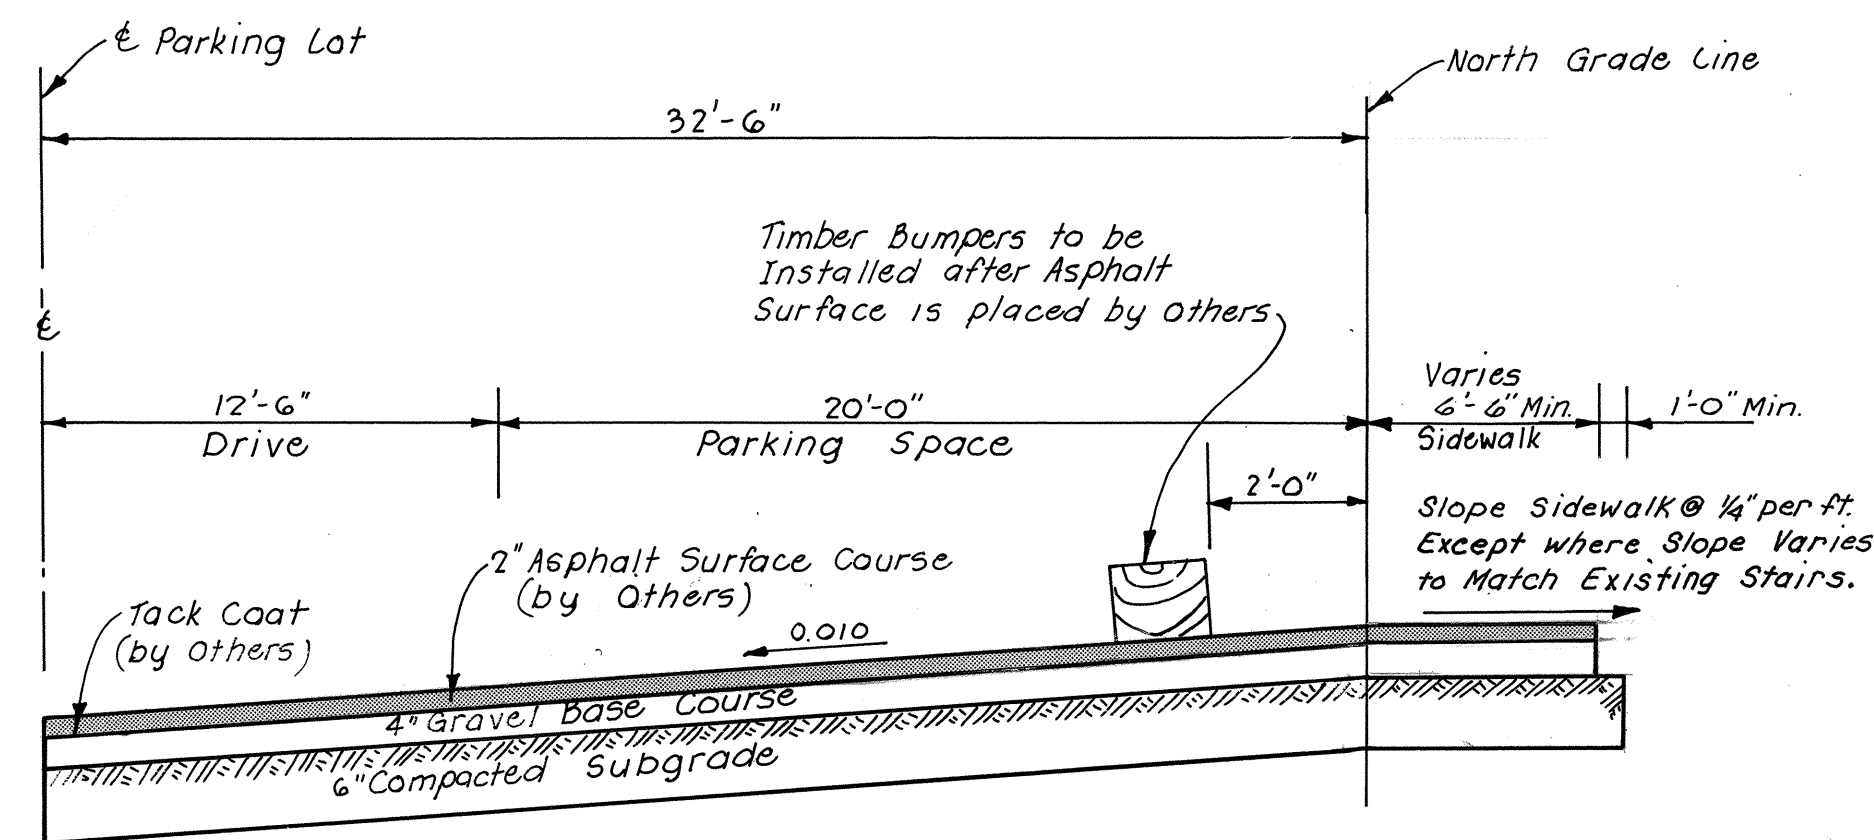

PARKING LOT SECTION
Scale 3/4" = 1'-0"

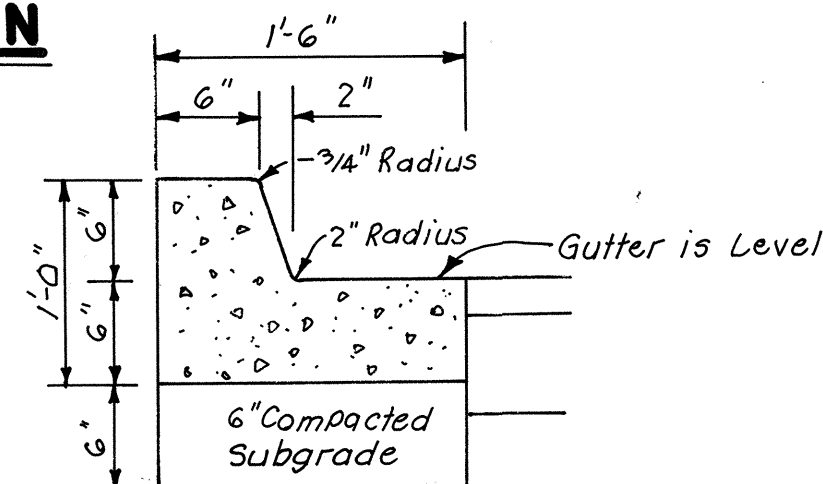


MEDIAN TYPE (DRIVEWAY) CURB & GUTTER

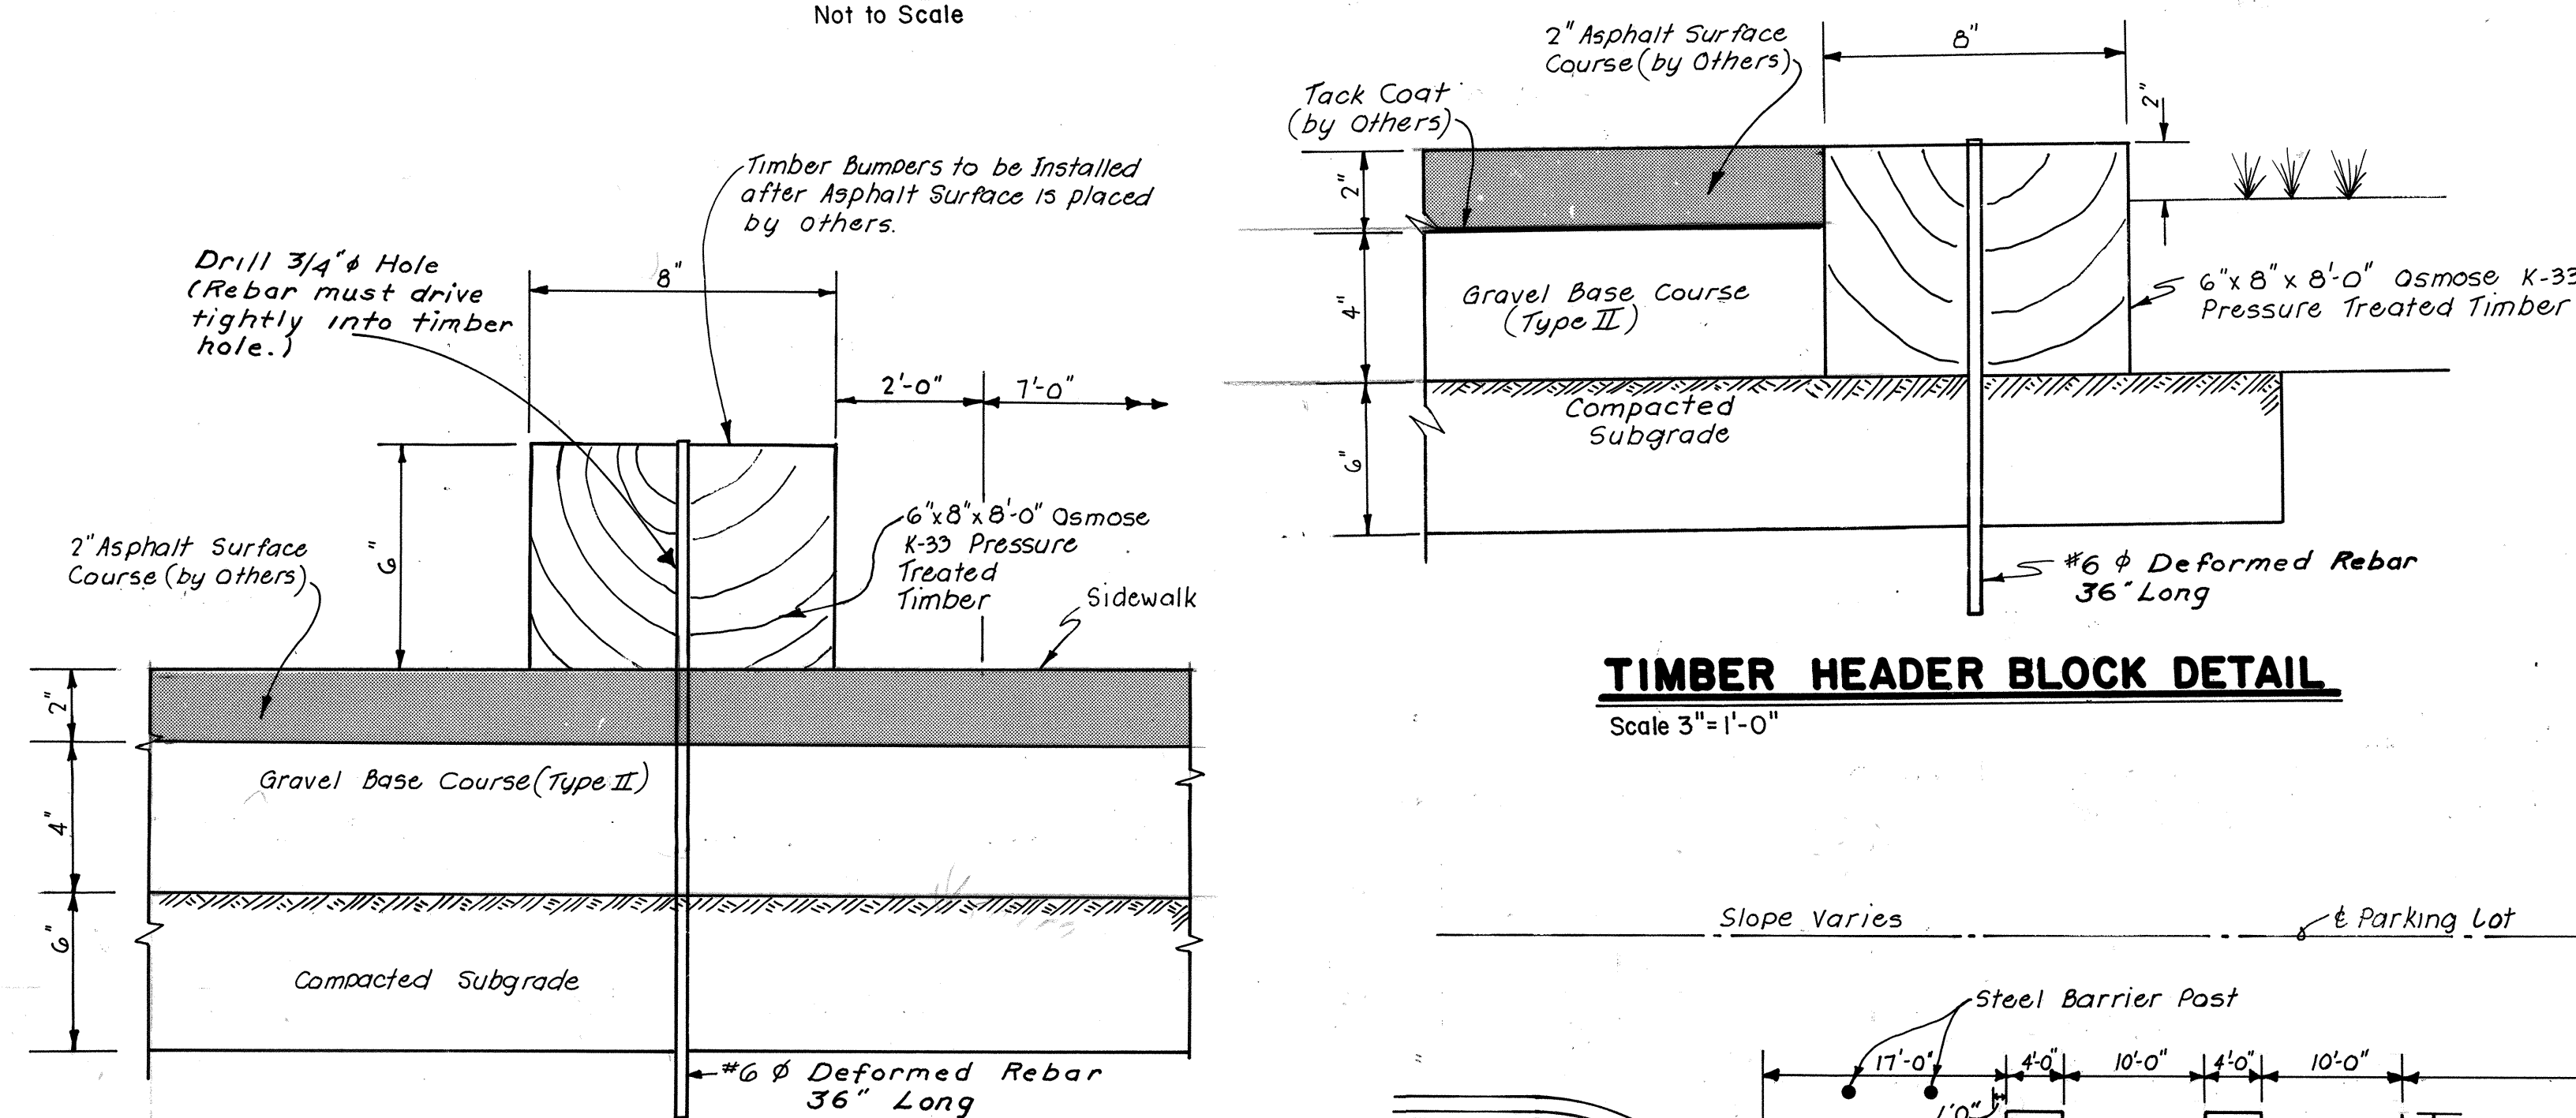


TIMBER HEADER BLOCK DETAIL


Scale 3" = 1'-0"

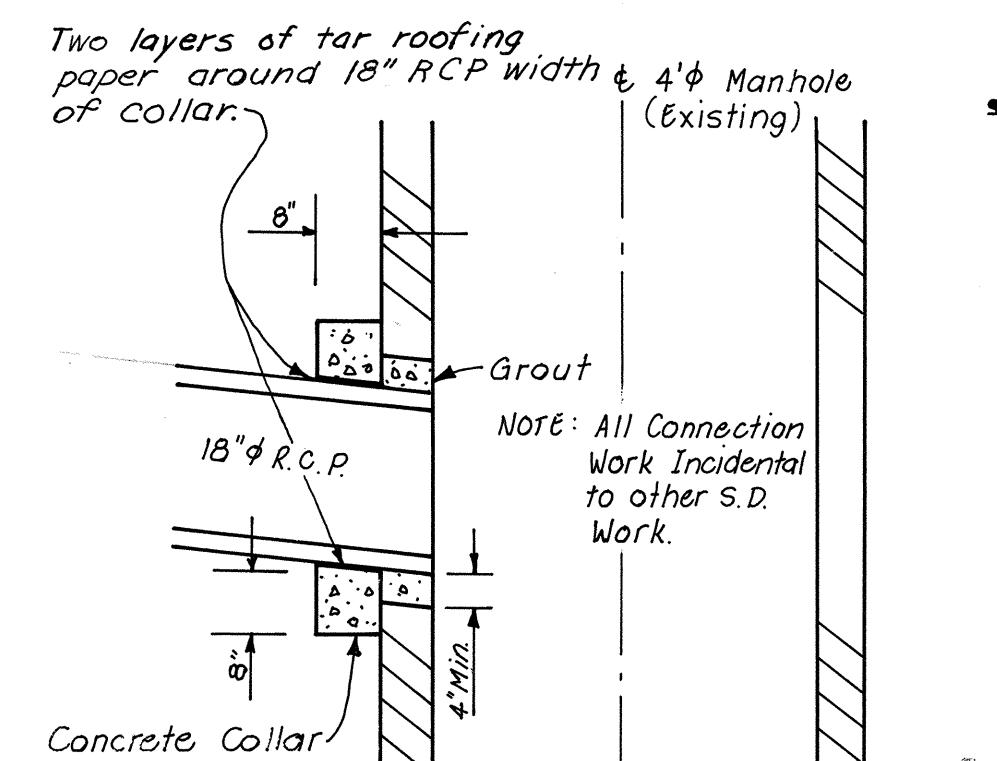

STA. 0+00 STORM DRAIN
MANHOLE JUNCTION
DETAIL
Not to Scale

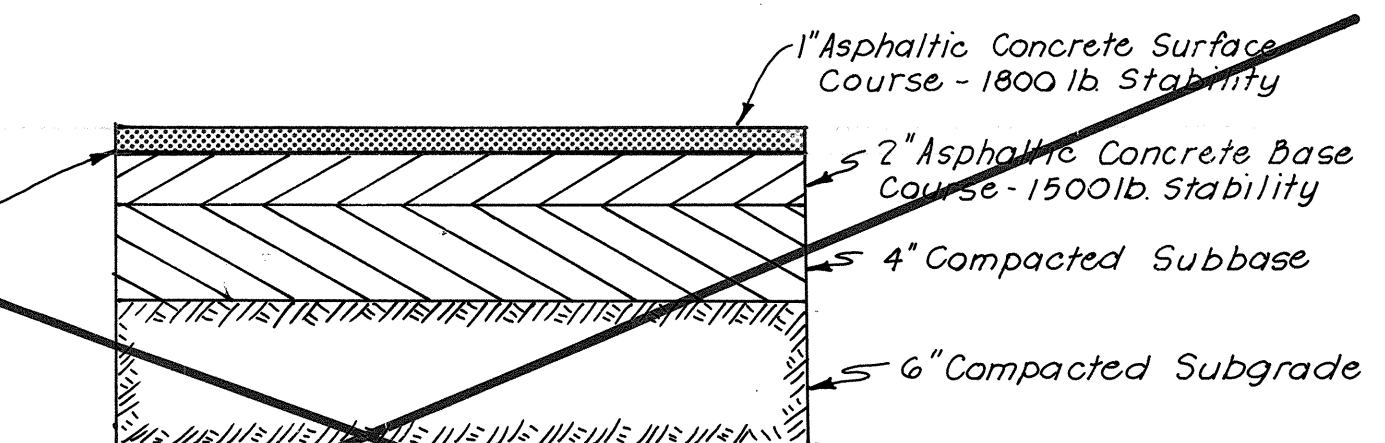

~~**TYPICAL MAJOR LOCAL TYPE PAVEMENT**~~
~~**LOCUST PLACE N.E.**~~
~~Scale 1 1/2" = 1'-0"~~

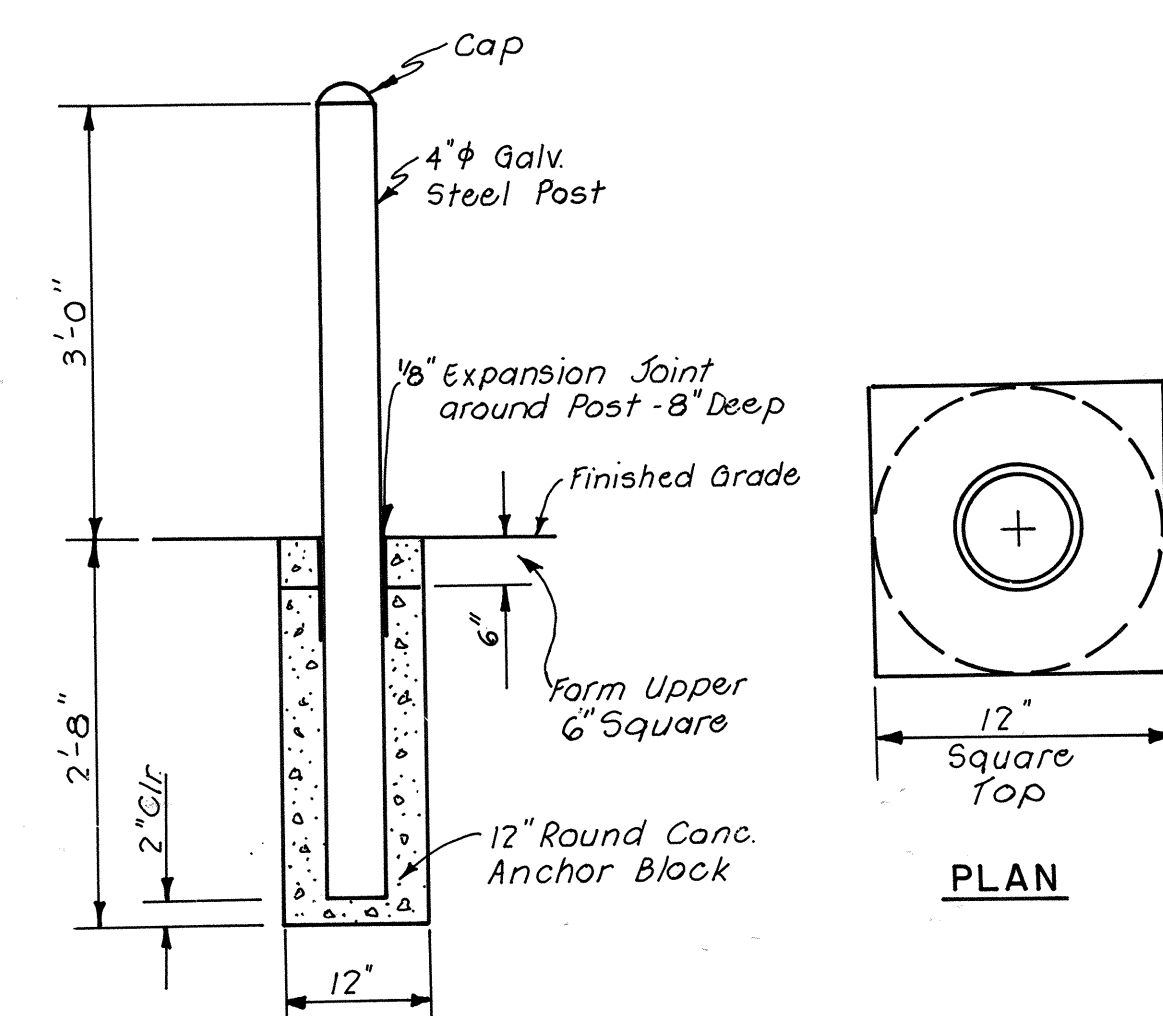ELEVATION

STEEL BARRIER POST DETAIL

NOT TO SCALE
Note: See Parking Details for Location

PLANS PREPARED
UNDER THE DIRECTION OF

ru 2/4



REGISTRATION NO. 8374

[Handwritten signature]

Seaton & Associates, Inc.
Engineers - Planners
JOB NO. 8

APPROVED FOR
CONSTRUCTION

TY ENGINEER DATE

1	2	3	4	5	6	7	8	9	10	11	12
2	6			2	4	2	1	0	4	8	6

ER POST DETAIL

File for Location

	CITY OF AL
--	------------

6 PARKS AND RECRE.

TITLE: DETAIL SHEET
ODELLA PARK PARKING

DELTA PARK PARKING		

APPROVALS	ENGINEER	DATE
City Engineer	<i>[Signature]</i>	2/25/86

5	A.C.E. - Design	<i>[Signature]</i>	3/24/01
---	-----------------	--------------------	---------

A.C.E. - Hydrology *Andra C. Melby* 5/20/84
Park + Rec. *Andra C. Melby*

DRAWING NO.	2421	MA
-------------	------	----

[illegible]