

VICINITY MAP
NOT TO SCALE

NOTICE TO CONTRACTORS

1. NEW MEXICO STANDARD SPECIFICATIONS FOR PUBLIC WORKS CONSTRUCTION-1979 EDITION WILL BE REFERRED TO HEREON AS THE "STANDARD SPECIFICATION."
2. ALL WORK DETAILED ON THESE PLANS TO BE PERFORMED UNDER CONTRACT SHALL, EXCEPT AS OTHERWISE STATED, BE PROVIDED FOR HEREON, BE CONSTRUCTED IN ACCORDANCE WITH "PUBLIC WORKS CONTRACT 85-1" AND THE NEW MEXICO STANDARD SPECIFICATIONS FOR PUBLIC WORKS CONSTRUCTION, 1979 EDITION.
3. TWO WORKING DAYS PRIOR TO ANY EXCAVATION, CONTRACTOR MUST CONTACT LINE LOCATING SERVICE, 765-1234, FOR LOCATION OF EXISTING UTILITIES.
4. PRIOR TO CONSTRUCTION, THE CONTRACTOR SHALL EXCAVATE AND VERIFY THE HORIZONTAL AND VERTICAL LOCATIONS OF ALL OLD EXISTING STRUCTURES. SHOULD A CONFLICT EXIST, THE CONTRACTOR SHALL NOTIFY THE ENGINEER OR SURVEYOR SO THAT THE CONFLICT CAN BE RESOLVED WITH A MINIMUM AMOUNT OF DELAY.

THE FOLLOWING NOTES ALSO APPLY WHEN CHECKED

- ☒ ALL UTILITIES AND UTILITY SERVICE LINES SHALL BE INSTALLED PRIOR TO PAVING.
- ☒ BACKFILL COMPACTION SHALL BE ACCORDING TO SPECIFIED STREET USE.
- ☒ TACK COAT REQUIREMENTS SHALL BE DETERMINED BY THE CITY ENGINEER.
- ☐ SIDEWALKS AND WHEELCHAIR RAMPS WITHIN THE CURB RETURNS SHALL BE CONSTRUCTED WHEREVER A NEW CURB RETURN IS CONSTRUCTED.
- ☐ IF CURB IS DEPRESSIONED FOR A DRIVEPAD, THE DRIVEPAD SHALL BE CONSTRUCTED PRIOR TO ACCEPTANCE OF CURB AND GUTTER.
- ☐ ALL STORM DRAINAGE FACILITIES SHALL BE COMPLETED PRIOR TO FINAL ACCEPTANCE.
- ☒ THE REQUESTOR OR DEVELOPER SHALL BE RESPONSIBLE FOR REPAIR OR REPLACEMENT OF ALL CURB AND GUTTER OR SIDEWALK DAMAGED AFTER APPROVAL BY THE CITY ENGINEER OF WORK COMPLETED BY THE CONTRACTOR.


APPROVAL OF AS BUILT DRAWINGS


ASST. CITY ENGINEER - FIELD
W. J. McNamee
DATE 2-4-86

1	2	3	4	5	6	7	8	9	10	11	12
2	6		2	4	3	5	0	1	8	6	

PAVING IMPROVE-
MENTS FOR THIS
PROJECT WILL NOT
BE ACCEPTED UN-
TILL THE PAVING
& DRAINAGE IM-
PROVEMENTS FOR
THE ALLEY ARE IN
PLACE & ACCEPTED

2	I-II								
1	4,8,9,0,I								
REV	SHEETS	CITY ENGINEER	DATE	USER	DEPT.	DATE	USER	DEPT.	DATE
APPROVAL OF REVISIONS									

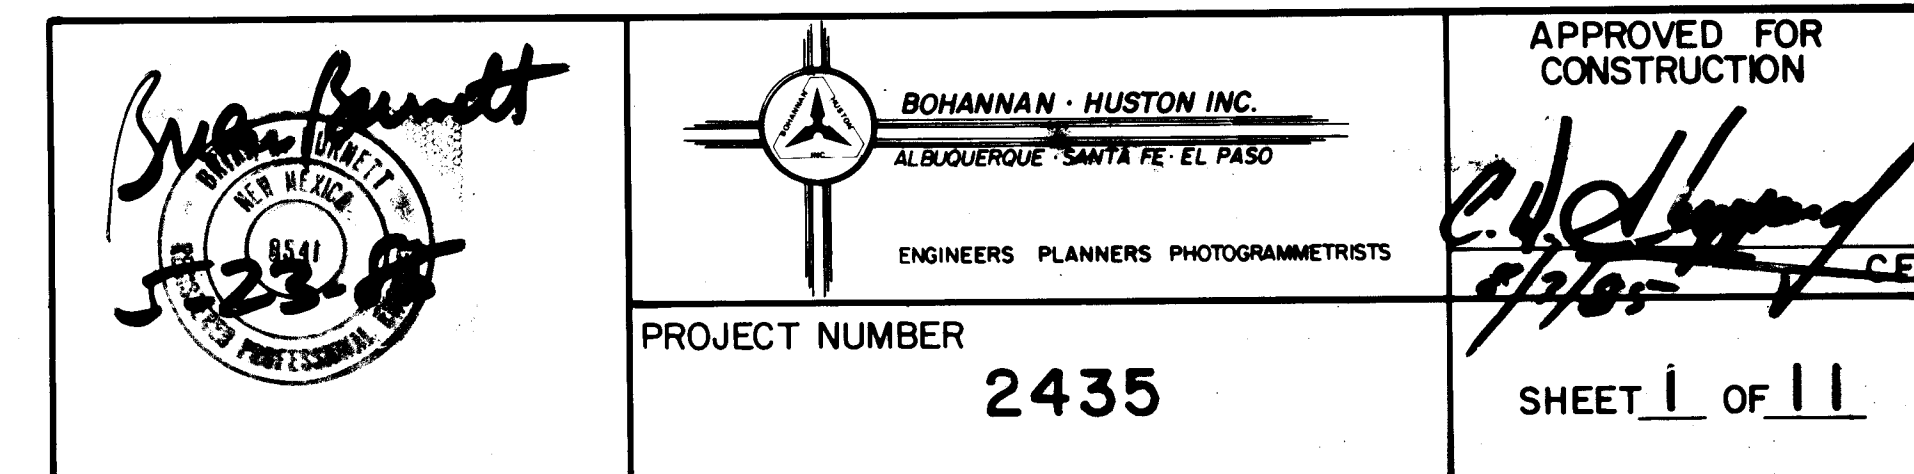

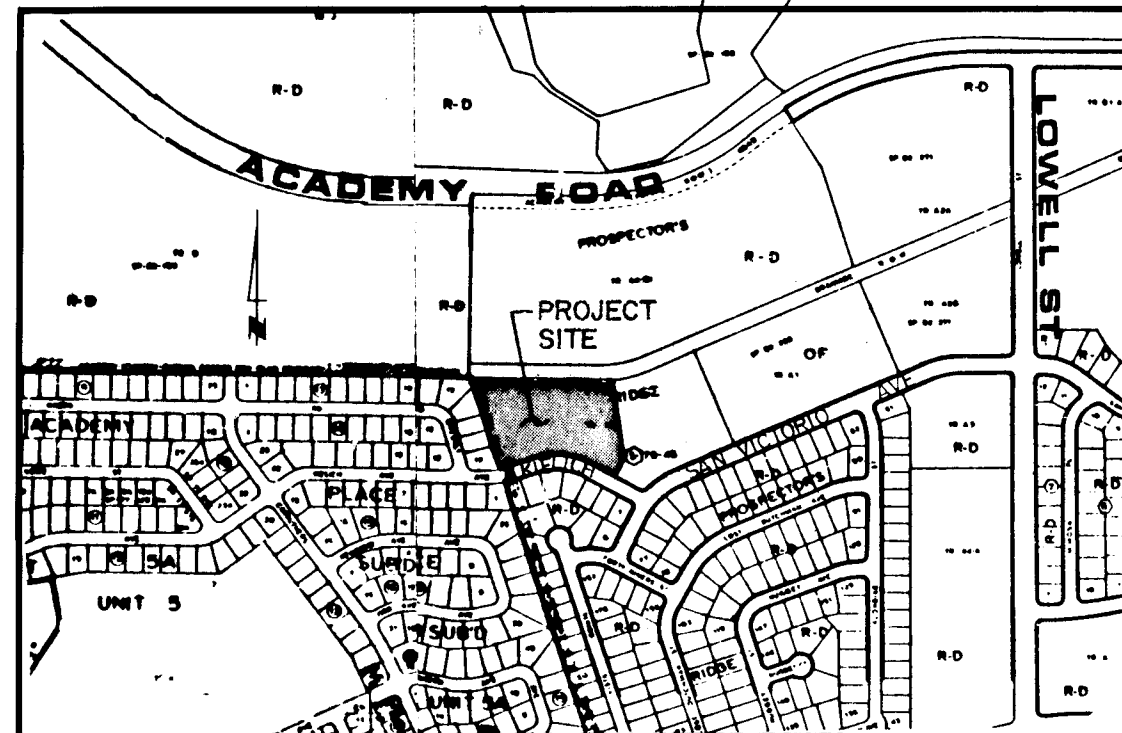

LOCATION MAP
Zone Atlas Map No. E-21-Z & E-22-Z

NOTES

1. Bearings are New Mexico State Plane Grid Bearings (Central Zone).
2. Distances are ground distances.
3. Record Bearings and distances are shown in parenthesis.
4. 5/8" rebar with 1-1/4" red plastic cap stamped "WEAVER LS 6544" were set on corners designated by ●.

SUBDIVISION DATA

1. DRB Number 85-16
2. Zone Atlas Index No. E-21 and E-22
3. Gross Subdivision Acreage: 3.9957
4. Total Number of Tracts Created: 26
5. Total Mileage of Full-Width Streets Created: 0.127

EASEMENTS

Easements shall include minimum working space requirements for single and three phase transformers for Public Service Company of New Mexico.

REPLAT OF
TRACT A4C1
PROSPECTOR'S RIDGE
(FILED: JULY 3, 1984)
NOW COMPRISING
PROSPECTOR'S POINT
ALBUQUERQUE, NEW MEXICO
APRIL 1985

DESCRIPTION

A certain tract of land situate within projected Section 27, T11N, R4E, N.M.P.M., comprising all of Tract A4C1 as the same is shown and designated on the plat of Replat of Tract A4C in Prospector's Ridge filed in the office of the County Clerk of Bernalillo County, New Mexico on July 3, 1984, and being more particularly described by New Mexico State Plane Grid bearings (Central Zone) and ground distances as follows:

Beginning at the southwest corner of the tract, whence the Albuquerque Control Station "Harry" (New Mexico State Plane Coordinates for Central Zone: X = 423,375.12, Y = 1,505,887.52) bears S32°13'26"E, 3858.60 feet; thence along the westerly boundary line of the tract, N17°51'50"W, 376.03 feet to the northwest corner of the tract; thence along the northerly boundary line of the tract, S88°53'35"E, 507.01 feet to a point of curvature; thence, 59.37 feet along the arc of a curve to the left having a radius of 480.00 feet and a chord bearing N87°34'10"E, 59.33 feet to the northeast corner of the tract; thence along the easterly boundary line of the tract, S05°59'48"E, 307.70 feet to a point; thence, S27°51'20"W, 82.69 feet to the southeast corner of the tract, a point on the northerly right-of-way line of Kiehl Avenue; thence along said northerly right-of-way line, N62°09'01"W, 105.66 feet to a point of curvature; thence 204.22 feet along the arc of a curve to the left having a radius of 262.03 feet and a chord bearing N55°01'25"W, 203.71 feet to a point of tangency; thence, S72°06'05"W, 52.91 feet to a point of curvature; thence, 100.60 feet along the arc of a curve to the right having a radius of 573.11 feet and a chord bearing S77°08'02"W, 100.55 feet to the point and place of beginning.

Tract contains 3.9957 acres, more or less.

DEDICATION

The subdivision of the land herein shown is with free consent and in accordance with the desires of the undersigned owner(s) and/or proprietor(s) thereof and said owner(s) and/or proprietor(s) do hereby dedicate all public rights-of-way and grant all easements as shown on this plat. Electrical Power and Communication easements are reserved for overhead distribution lines for pole type utilities and buried distribution lines, conduits, and pipes for underground utilities where shown or indicated, and including the right of ingress and egress for construction maintenance, and the right to trip, enter, cross and shunt. Also included are easements for the right to install power and communication service lines along side lot lines.

MC CLINTIC DEVELOPMENT CORPORATION

James R. McClintic
JAMES R. MCCLINTIC
President, McClintic Development Corporation

State of New Mexico)
County of Bernalillo)

The foregoing instrument was acknowledged before me this 3 day of May, 1985, by Jim McClintic, President of McClintic Development Corporation on behalf of said Company.

My Commission Expires March 16, 1986

David C. Spickard
Notary Public

March 16, 1986

APPROVALS

PLAT NUMBER S-85-5
Richard D. Moran
PLANNING DIRECTOR
DATE 8-2-85
Frank J. Aguirre
CITY ENGINEER
DATE 8-1-85
Frank J. Aguirre
CITY ENGINEER
DATE 8-1-85
Robert A. Hannon
TRAFFIC ENGINEER
DATE 6-3-85
Jim Clark
CITY SURVEYOR
DATE 0522-85
David C. Spickard
PROPERTY MANAGEMENT
DATE 6-4-85
Jan E. Entsgaard
OTHER RESOURCES
DATE 6-4-85
Walter Gaddy
PARKS AND RECREATION
DATE 5-22-85
H. B. B. B.
PUBLIC SERVICE COMPANY OF NEW MEXICO
DATE 5-22-85
Wayne Deming
MOUNTAIN BELL
DATE 6-22-85
Paula McElfee
GAS COMPANY OF NEW MEXICO

SURVEYOR'S CERTIFICATION

I, A. Dwain Weaver, a registered New Mexico Land Surveyor, certify that this plat was prepared by me or under my supervision, shows all easements of record, meets the minimum requirements for monumentation and surveys contained in the Albuquerque Subdivision Ordinance, and is true and accurate to the best of my knowledge and belief.

A. Dwain Weaver
A. Dwain Weaver
P.L.S. No. 6544
New Mexico

Bohannon-Huston Inc.
4125 Carlisle Blvd., N.E.
Albuquerque, NM 87107

State of New Mexico)
County of Bernalillo)

The foregoing instrument was acknowledged before me this 24th day of April, 1985, by A. Dwain Weaver.

Marcel Moller
Notary Public


2/23/86

2 6 2 4 3 5 0 2 8 6

SHEET 1 OF 2 SHEETS

REPLAT OF
TRACT A4C1
PROSPECTOR'S RIDGE
(FILED: JULY 3, 1984)
NOW COMPRISING
PROSPECTOR'S POINT
ALBUQUERQUE, NEW MEXICO
SCALE: 1"=60' APRIL 1985

NOTE: Features Such As Medians And Islands Shall Be Provided At The North End Of NASCI DRIVE AND PLACER DRIVE To Insure That Traffic Flow Travelling North On These Streets Shall Be Provided With Right Turns ONLY (Easterly Direction) Onto The Proposed Alley Right-Of-Way.

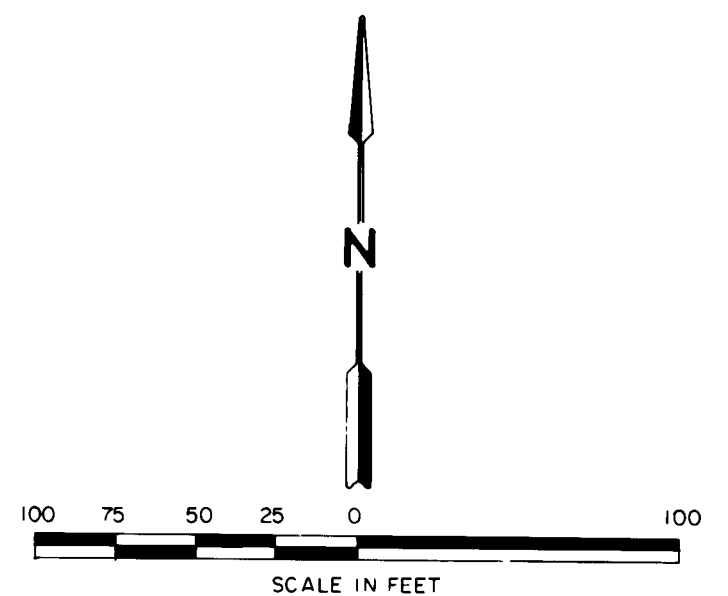

TRACT A4B1
PROSPECTOR'S RIDGE
(Filed: Sept. 20, 1982 C20-47)

TANGENT DATA		
NR.	DISTANCE	BEARING
T1	40.73'	N62°09'01"W
T2	46.26'	S88°53'35"E
T3	66.18'	S88°53'35"E
T4	21.09'	S72°06'05"W
T5	26.06'	S88°53'35"E
T6	59.47'	S88°53'35"E

CURVE DATA				
NR.	RADIUS	ARC	CHORD	DELTA
C1	573.11'	100.68'	100.55'	10°03'54"
C2	460.00'	59.37'	59.33'	07°05'12"
C3	262.03'	209.22'	203.71'	45°44'54"
C4	25.00'	34.42'	31.77'	78°53'25"
C5	135.10'	13.88'	13.87'	05°53'08"
C6	135.10'	47.39'	47.14'	20°05'48"
C7	34.00'	59.55'	52.22'	100°20'56"
C8	262.03'	6.42'	6.42'	01°24'15"
C9	262.03'	50.03'	49.96'	10°56'25"
C10	25.00'	44.25'	38.70'	101°24'52"
C11	85.10'	19.80'	19.76'	13°19'58"
C12	25.00'	34.75'	32.02'	79°39'04"
C13	110.10'	65.50'	64.54'	34°05'15"
C14	262.03'	62.60'	62.45'	13°41'19"
C15	262.03'	72.13'	71.90'	15°46'18"
C16	25.00'	38.59'	34.94'	88°40'20"
C17	25.00'	46.42'	40.03'	106°23'23"
C18	262.03'	18.04'	18.03'	03°56'37"
C19	573.11'	29.07'	29.07'	02°54'22"
C20	573.11'	71.61'	71.56'	07°09'31"
C21	25.00'	39.40'	35.44'	90°17'25"
C22	25.00'	32.12'	29.95'	73°36'37"

TRACT A4C2
PROSPECTOR'S RIDGE
(Filed: July 3, 1984 C24-96)

ACS Brass Tablet "S-E22"
N.M. State Plane Coordinates (Central Zone):
X = 421,699.2 Y = 1,509,74.02
Ground to Grid Factor = 0.9996281
AZ = -00°09'03"
Elevation = 5832.03'

SURVEYOR'S CERTIFICATION

I, A. Dwain Weaver, a registered New Mexico Land Surveyor, certify that this plat was prepared by me or under my supervision, shows all easements of record, meets the minimum requirements for monumentation and surveys contained in the Albuquerque Subdivision Ordinance, and is true and accurate to the best of my knowledge and belief.

A. Dwain Weaver
P.L.S. No. 6544
New Mexico

Bohannon-Huston Inc.
4125 Carlisle Blvd., N.E.
Albuquerque, NM 87107

State of New Mexico)
County of Bernalillo)

The foregoing instrument was acknowledged before me this 24th day of April, 1985, by A. Dwain Weaver.

Notary Public

2/23/86

SHEET 2 OF 2 SHEETS

PROJECT NO. 2435 SHEET 3 OF 11

JOB NO. 42492



**PROPOSED ACADEMY RIDGE EAST
PHASE II**

BEAR TRIBUTARY PUBLIC DRAINAGE & ACCESS R/W

ACADEMY PLACE SUBDIVISION UNIT 5

BLOCK A, **BLOCK B**, **BLOCK C**

NASOCI ROAD, **PLACER ROAD**, **KIELICH AVENUE**, **SAN VICTORIO AVENUE**

Notes:

- Construct w/x 24" PCC Cutoff wall @ Sta. 0+45.50
- Construct raised medians w/std. median curb & 4' colored & patterned concrete median pavement. See median details Sht. 11 of 11.
- Construct w/x 24" PCC Cutoff wall @ Sta. 55+32.69 Bear Tributary Public Drainage & Access R/W
- Future Alley pavement Section ⑥ to be constructed with Academy Ridge East, Phase II.
- Transition Curb Returns into existing Alley Curbing as per Detail B, Sheet 11 of 11.
- Transition Curb Returns into existing Alley Curbing as per Detail B, Sht. 11 of 11
- Provide Sawcut Pavement Removal
- Provide sawcut pavement removal and replacement as required for sewer reconstruction From Sta. 0+02.00 To Sta. 1+22.61, 12.5' Rt 9.5' Lt Kielich Ave To Sta. 1+22.61, 12.5' Rt 12.3' Lt Kielich Ave
- Sidewalks along Kielich Avenue are to be constructed along with street paving on Nasoci Road and Placer Road Remaining Sidewalks are not a part of project 2435

Dimensions:

- 50' R/W
- 32' F.F.
- 2%

LEGEND

●	PROPOSED MANHOLE
■	PROPOSED WATER VALVE
○	EXISTING MANHOLE
□	EXISTING WATER VALVE
⊙	EXISTING STORM DRAIN MANHOLE

1	2	3	4	5	6	7	8	9	10	11	12
2	6		2	4	2	5	0	4	8	6	

PAVING IMPROVE-
MENTS FOR THIS
PROJECT WILL NOT
BE ACCEPTED UN-
TILL THE PAVING
& DRAINAGE IM-
PROVEMENTS FOR
THE ALLEY ARE IN
PLACE & ACCEPTED.



CITY OF ALBUQUERQUE

MUNICIPAL DEVELOPMENT DEPARTMENT

ENGINEERING DIVISION

TITLE:	PROSPECTOR'S POINT SUBDIVISION
	STREET PAVING LAYOUT

APPROVALS	ENGINEER	DATE	APPROVALS	ENGINEER	DATE
City Engineer	C. D. [Signature]	5/6/85	Liquid Waste	William G. Pabst	5/29/85
A C E - Design	J. P. [Signature]	7/31/85	Traffic	Dave W. Hume	6/18/85
ACE - Hydrology	N. A. [Signature]	6/5/85	Water	William G. Pabst	5/29/85

DRAWING NO.	2435	MAP NO.	E - 22	SHEET	4	OF	11
-------------	------	---------	--------	-------	---	----	----

AS BUILT	CONTRACTOR	SUNDANCE	MECHANICAL
WORK			
STARTED BY BOHANNAN-HUSTON DATE 8/85			
INSPECTOR'S			
FIELD	ACCEPTANCE BY	DATE	
VERIFICATION BY	DATE		
DRAWINGS	CORRECTED BY	BHI	DATE 1/86
MICRO-FILM INFORMATION			
RECORDED BY	DATE		
40			

ACS BRASS CAP "6-E2" ELEV. 5934.53 LOCATION
IS 1.2 MILES EAST OF THE INTERSECTION OF
ACADEMY ROAD N.E. & EUBANK BLVD N.E. STATION
IS THEN 375' SOUTH ON THE SOUTH RIM OF
BEAR CANYON TRIBUTARY.


[illegible]

5-23-83
Buck-Smith

[illegible]

ACADEMY PLACE
SUBDIVISION
UNIT 5

PROPOSED ACADEMY RIDGE EAST
PHASE II

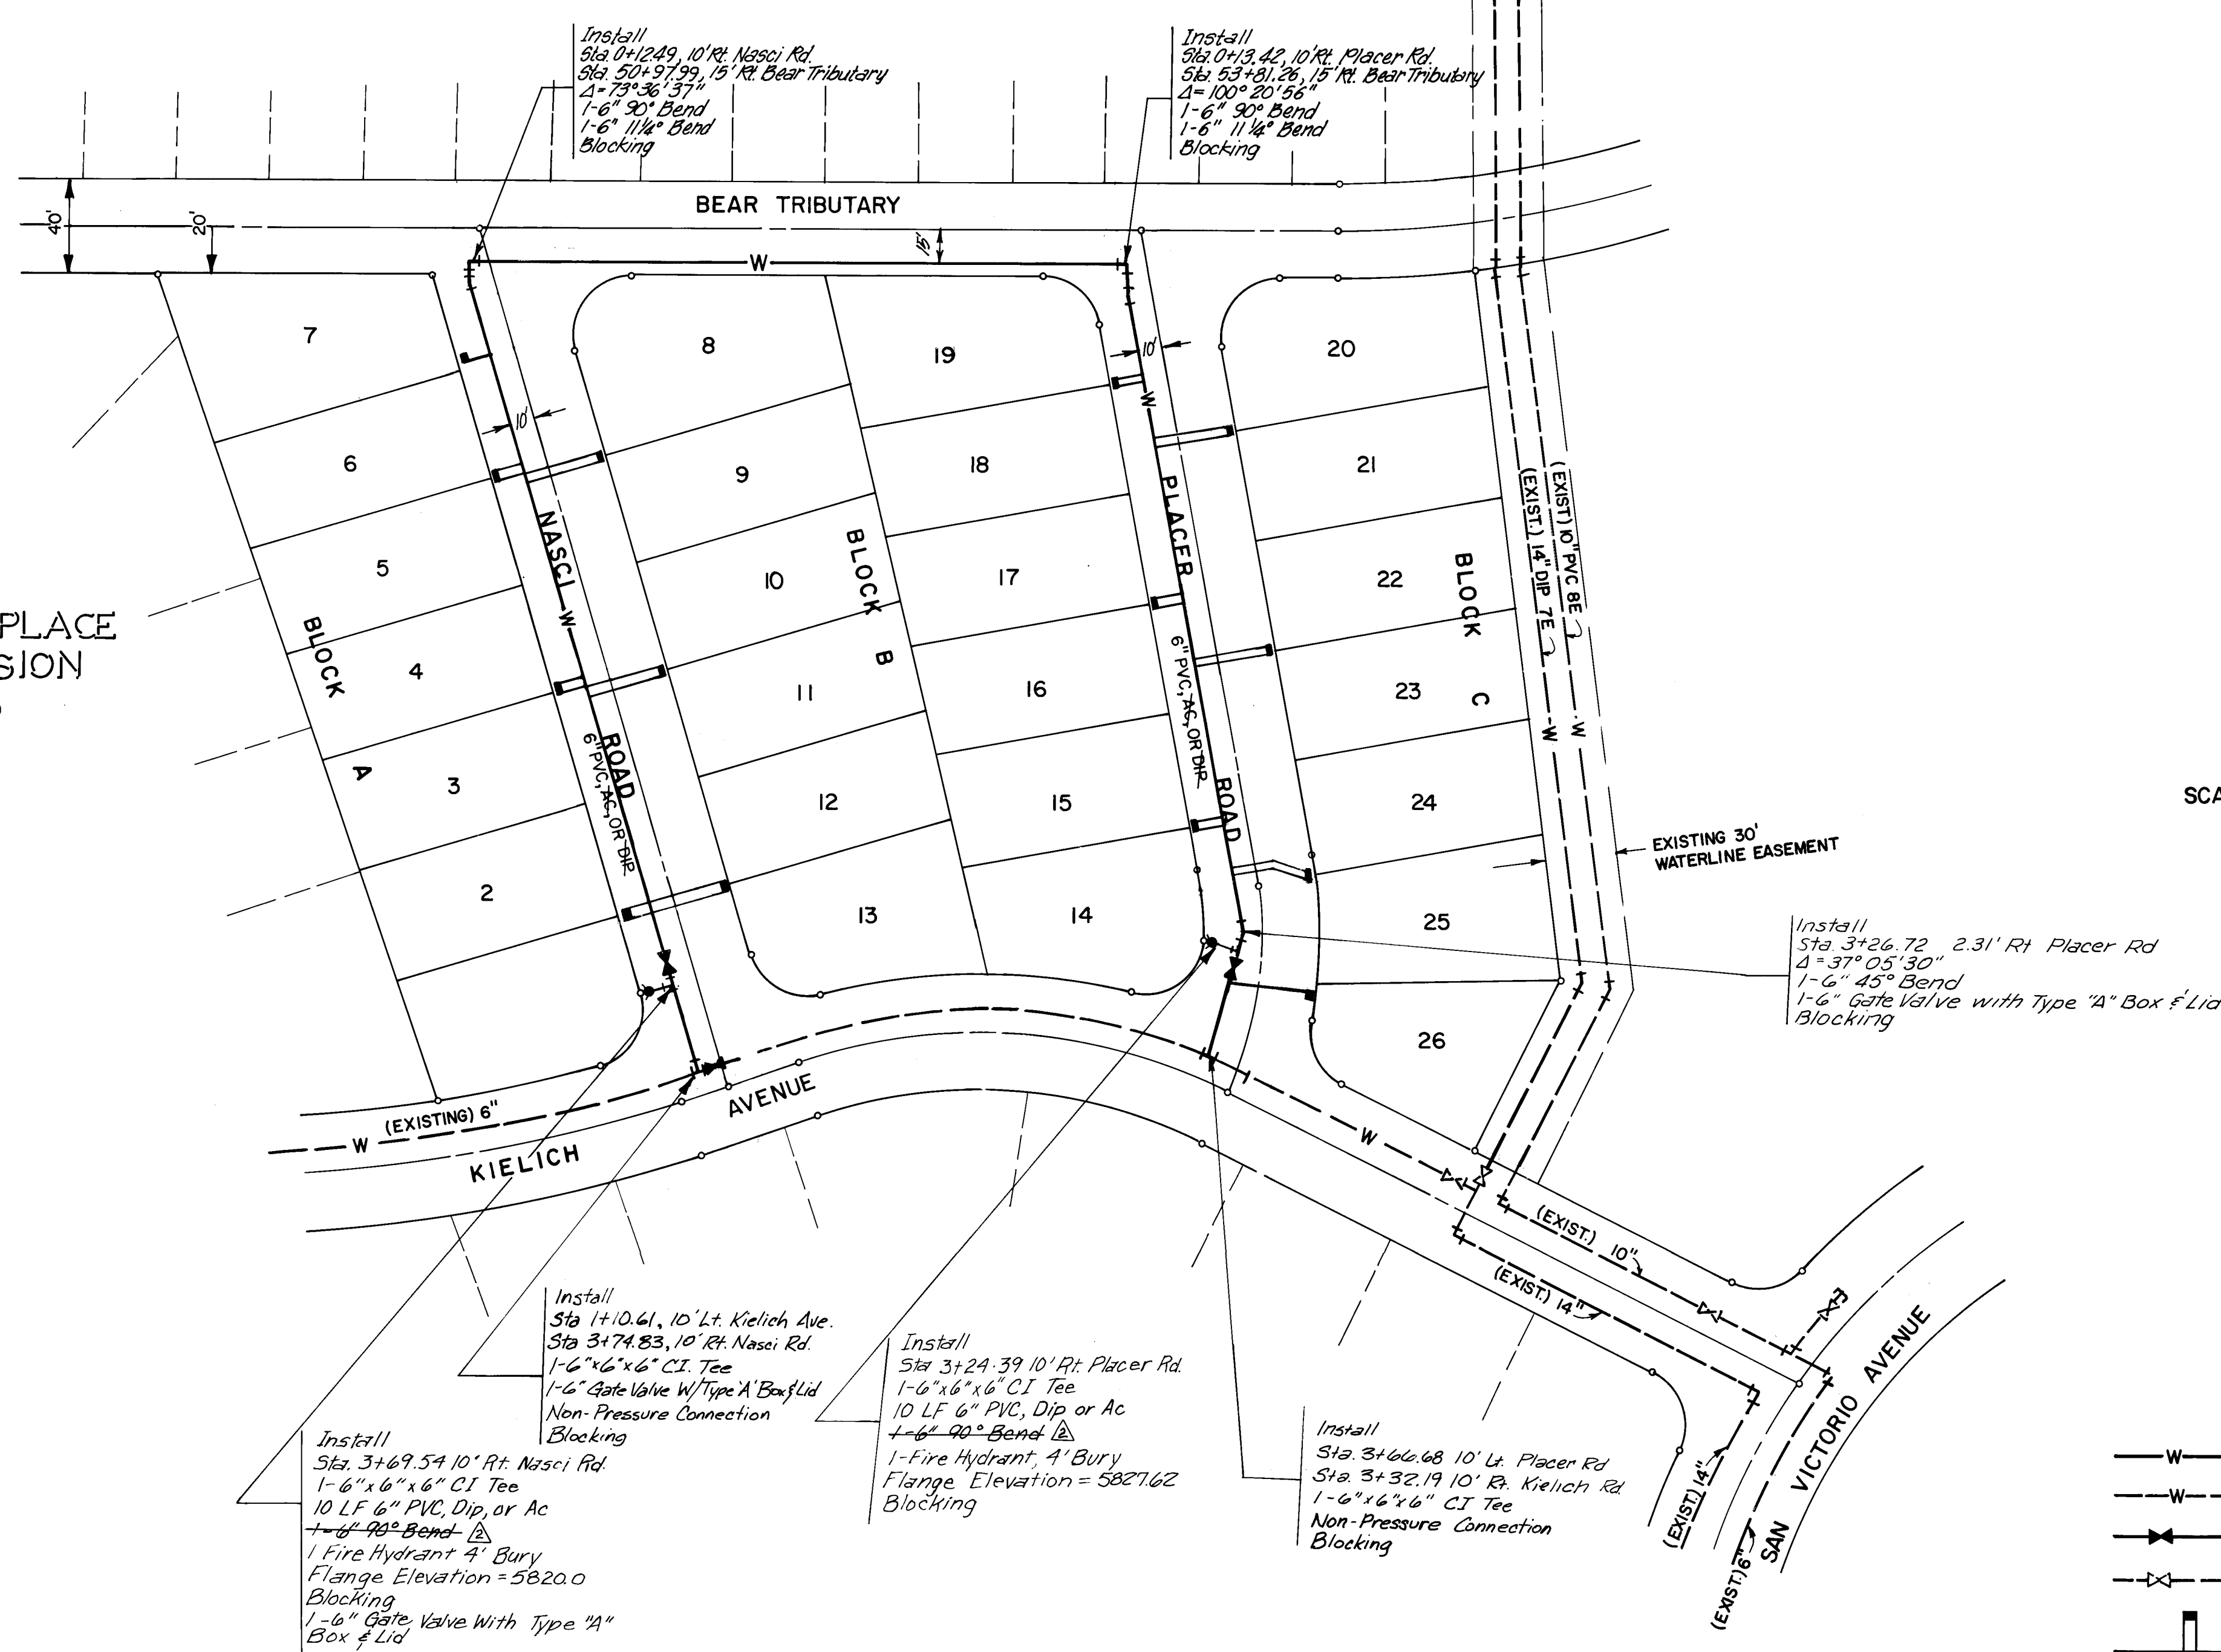

Note:
Shut-down of the existing water line
shall be coordinated with the City
Water Systems Division at 823-4052.

SCALE: 1" = 50'

LEGEND

- W — PROPOSED WATER LINE
- - - W - - - EXISTING WATER LINE
- X — PROPOSED WATER VALVE
- - - X - - - EXISTING WATER VALVE
- [Symbol] — WATER SERVICE LATERALS
- [Symbol] — PROPOSED FIRE HYDRANT

1 2 3 4 5 6 7 8 9 10 11 12
2 6 1 2 4 3 5 0 5 8 6

RECORD DRAWINGS
DATE 1/86



CITY OF ALBUQUERQUE
MUNICIPAL DEVELOPMENT DEPARTMENT
ENGINEERING DIVISION

TITLE: PROSPECTOR'S POINT SUBDIVISION
WATER DISTRIBUTION PLAN

APPROVALS	ENGINEER	DATE	APPROVALS	ENGINEER	DATE
City Engineer	<i>[Signature]</i>	5/85	Liquid Waste	<i>[Signature]</i>	5/85
A.C.E. Design	<i>[Signature]</i>	7/85	Traffic	<i>[Signature]</i>	6/85
Hydrology	<i>[Signature]</i>	6/85	Water	<i>[Signature]</i>	5/85

DRAWING NO. 2435 MAP NO. E-22 SHEET 5 OF 11

ENGINEER'S SEAL		SURVEY INFORMATION		BENCH MARKS		AS BUILT INFORMATION	
<i>[Signature]</i> 5-23-85		FIELD NOTES		DATE		CONTRACTOR SUNDANCE MECHANICAL	
		BY		NO.		WORK BY BOHANNAN - HUSTON, DATE 8/85	
		REVISIONS		REMARKS		FIELD ACCEPTANCE BY DATE	
		DESIGN		DATE		DRAWINGS CORRECTED BY BHI DATE 1/86	
		DESIGNED BY KLS		DATE 5/85		MICRO-FILM INFORMATION	
		DRAWN BY L.D.		DATE 5/85		RECORDED BY	
		CHECKED BY KLD		DATE 5/85		NO	

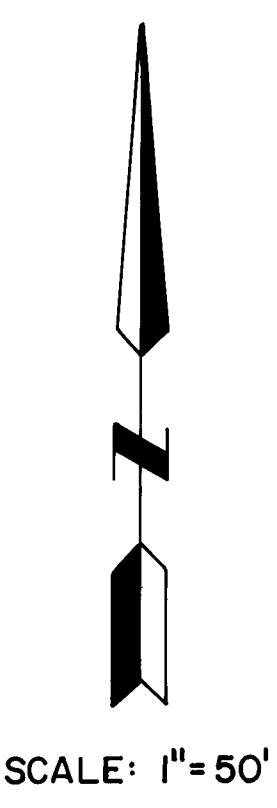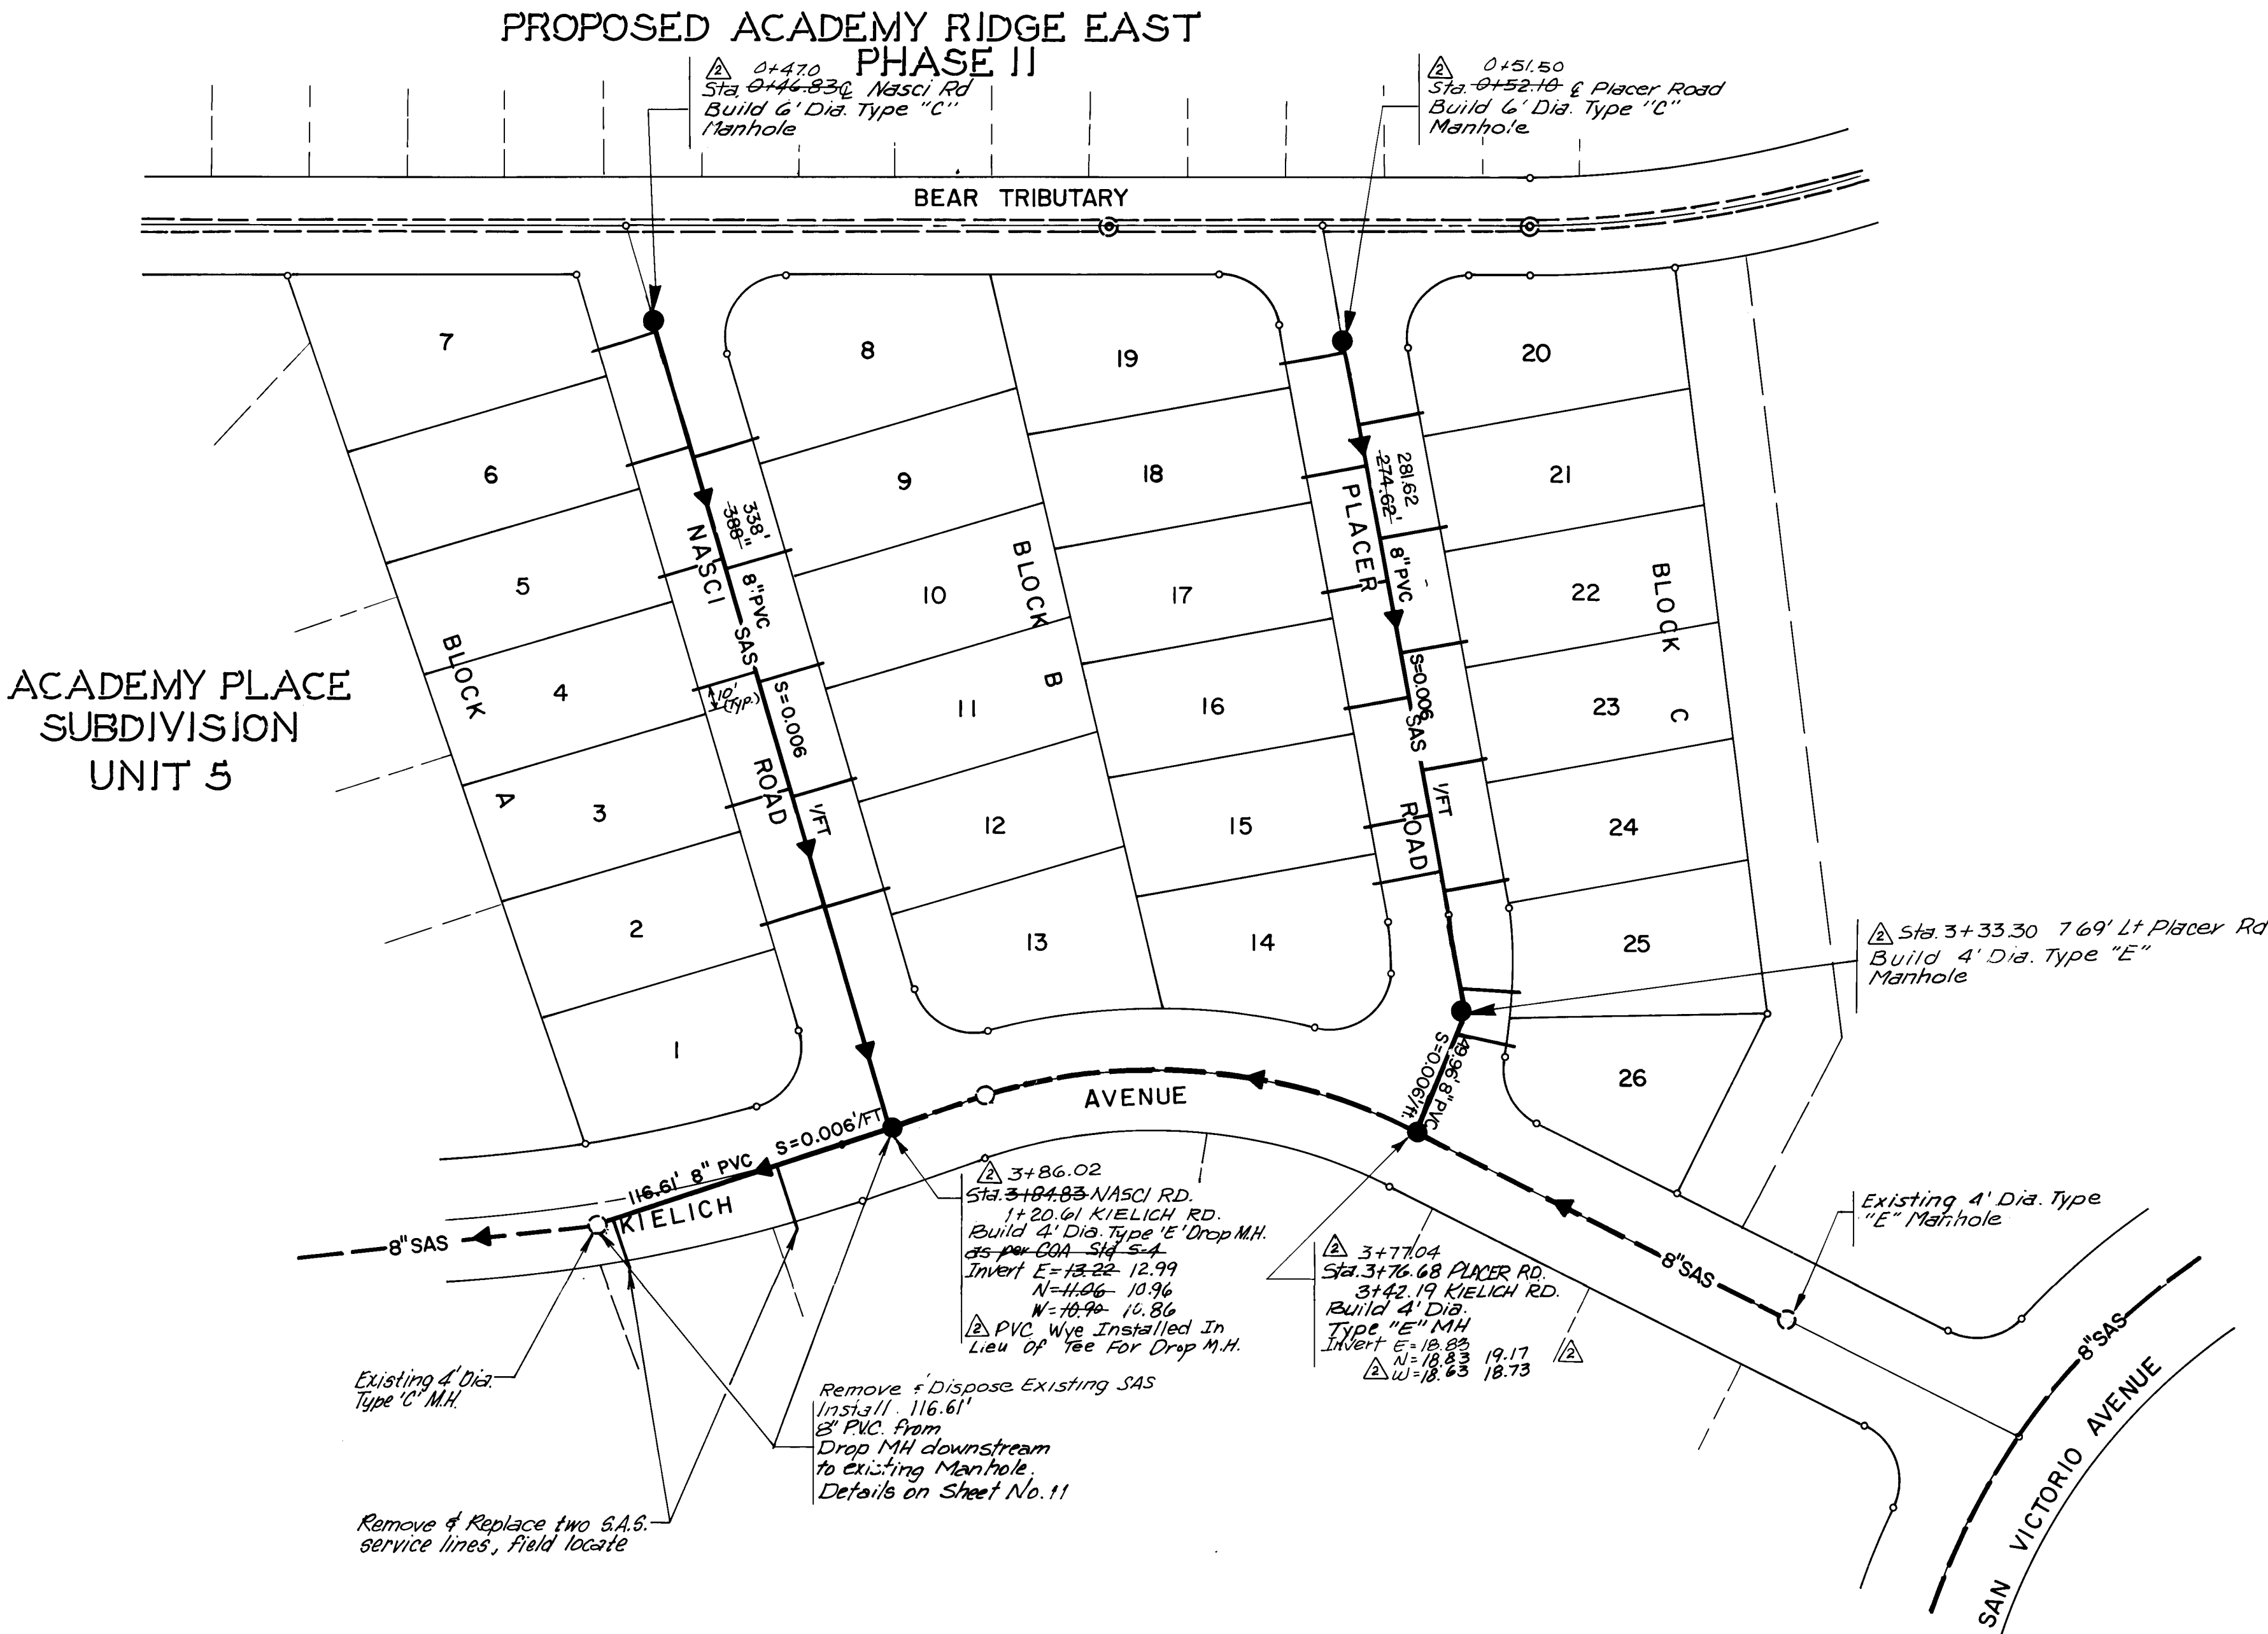

- LEGEND
- SAS— PROPOSED SEWER LINE
 - - -SAS- - EXISTING SEWER LINE
 - PROPOSED SEWER MANHOLE
 - EXISTING SEWER MANHOLE
 - DIRECTION OF FLOW

NOTE:
Sanitary Sewer Service Stubs are to be constructed of cast iron or ductile iron materials only. No soil cement materials may be used in construction of Sanitary Sewer Service Stubs.

AS BUILT INFORMATION			BENCH MARKS			SURVEY INFORMATION			ENGINEER'S SEAL		
CONTRACTOR	SUNDANCE MECHANICAL	DATE	DATE	DATE	DATE	NO.	BY	DATE	NO.	BY	DATE
ACCEPTED BY	BOHANNAN-HUSTON, INC.	DATE	DATE	DATE	DATE						
REVISIONS											
DESIGNED BY	BHI	DATE	DESIGNED BY	BHI	DATE	DESIGNED BY	BHI	DATE	DESIGNED BY	BHI	DATE
DRAWN BY	BHI	DATE	DRAWN BY	BHI	DATE	DRAWN BY	BHI	DATE	DRAWN BY	BHI	DATE
CHECKED BY	BHI	DATE	CHECKED BY	BHI	DATE	CHECKED BY	BHI	DATE	CHECKED BY	BHI	DATE
RECORDED BY		DATE	RECORDED BY		DATE	RECORDED BY		DATE	RECORDED BY		DATE

DESIGNED BY KLS DATE 5/85
DRAWN BY LD DATE 5/85
CHECKED BY KLD DATE 5/85

CITY OF ALBUQUERQUE
MUNICIPAL DEVELOPMENT DEPARTMENT
ENGINEERING DIVISION

TITLE: PROSPECTOR'S POINT SUBDIVISION
SANITARY SEWER PLAN

APPROVALS	ENGINEER	DATE	APPROVALS	ENGINEER	DATE
City Engineer	<i>[Signature]</i>	5/85	Liquid Waste	<i>[Signature]</i>	5/85
A.C.E.-Design	<i>[Signature]</i>	5/85	Traffic	<i>[Signature]</i>	5/85
Hydrology	<i>[Signature]</i>	5/85	Water	<i>[Signature]</i>	5/85

DRAWING NO. 2435 MAP NO. E-22 SHEET 6 OF 11



EARTH EXCAVATION

- A. General: Earth excavation shall consist of the excavation and removal of suitable soils for use as embankment as well as the satisfactory disposal of all vegetation, debris and deleterious material encountered within the area to be graded and/or in a borrow area.
- B. Surface Maintenance: Excavated areas shall be continuously maintained so that the surface shall be smooth and have sufficient slope to allow water to drain from the surface.

EMBANKMENT

- A. General: The embankment shall consist of a controlled fill constructed in the areas indicated on the grading plans.
- B. Embankment Materials: Embankment fill material shall consist of soils that conform to the following physical characteristics.

Sieve Size	Percent Passing
Square Openings	by Weight
6 inch	100
# 4	40 - 100
#200	10 - 50

The plasticity index of the material as determined in accordance with A.S.T.M. D-423 and D-424, shall not be more than 15.

The fill material shall be free from roots, grass, other vegetable matter, clay lumps, rocks larger than 6 inches, or other deleterious material.

Site soils from the cuts may be used for fill, provided they meet the requirements in paragraph B of EMBANKMENT. It is anticipated that some blending of soils will be required to meet specifications.

C. Construction:

- (1) Treatment of Natural Ground Surface in the Building Areas-- Prior to construction of building pad fills, the native soils beneath each building pad shall be scarified to a minimum depth of 12 inches and watered to bring the moisture content of the upper 5.0 feet as close as practicable to the optimum moisture content. Moisture increases achieved shall be verified by a representative of the soils engineer by augering small holes to 5.0 feet and obtaining representative samples in order to confirm proper pre-wetting. In the event infiltration does not take place to the prescribed depth, the soils engineer's representative shall make a decision based upon the nature of the soil in question. The ground surface shall then be subjected to 20 coverages of a heavy steel drum vibratory roller (10 ton minimum weight). The upper 6 inches of the native soils shall be compacted to the minimum density specified in paragraph C(3) of this section.

Cut areas of building pads shall be watered and rolled as specified above after cutting to substantial finished grade.

- (2) Treatment of Natural Ground Surfaces in Non-Building Areas-- The upper 6 inches of native soils outside building areas upon which fills are to be constructed shall be scarified, brought to a moisture content of 2 percent below optimum or higher, and compacted to requirements in C(3) of this section.

- (3) Compaction-- The fill shall be spread in layers not exceeding 8 inches, watered as necessary, and compacted. The moisture content at the time of compaction shall be 2 percent below optimum or higher. Compaction shall be with a vibratory roller as specified in C(1) of this section to obtain a density for building pads. Embankment outside the building pads shall be compacted to 90 percent of maximum density. Native soils beneath fills or in cuts shall be compacted to the density specified for fills in that area.
- Optimum moisture and maximum density for each soil type used shall be determined in accordance with A.S.T.M. D-1557.

- A. Field Inspection and Testing: The soils engineer shall provide continuous on-site inspection by experienced personnel during construction of controlled earthwork. The contractor shall notify the engineer at least 2 working days in advance of any field operations of the controlled earthwork, or of any resumption of operations after stoppages.

AS BUILT INFORMATION		BENCH MARKS		SURVEY INFORMATION		ENGINEER'S SEAL		RECORD DRAWINGS		APPROVALS		DESIGN		DRAWING	
CONTRACTOR	SUNDANCE MECHANICAL	INSPECTOR	BOHANNON-HUSTON	DATE	8/85	NO.	BY	REVISIONS	NO.	DATE	REVISIONS	NO.	DATE	DESIGNED BY	DATE
LOCATION		ACS BRASS CAP "6-22" ELEV. 5934.53		DATE		BY		NO.		DATE		DATE		DATE	
INTERSECTION OF		IS 1.2 MILES EAST OF THE INTERSECTION OF		DATE		BY		NO.		DATE		DATE		DATE	
ACADEMY ROAD NE. & EUBANK BLVD. NE. STATION		IS THEN 375' SOUTH ON THE SOUTH RIM OF		DATE		BY		NO.		DATE		DATE		DATE	
DRAWINGS		BY BHI		DATE		BY		NO.		DATE		DATE		DATE	
MICRO-FILM INFORMATION		RECORDED BY		DATE		BY		NO.		DATE		DATE		DATE	

ENGINEER'S SEAL

Signature

5-23-85

DESIGNED BY	KLS	DATE	5/85
DRAWN BY	LD	DATE	5/85
CHECKED BY	KLD	DATE	5/85

CITY OF ALBUQUERQUE

MUNICIPAL DEVELOPMENT DEPARTMENT

ENGINEERING DIVISION

TITLE: PROSPECTOR'S POINT SUBDIVISION



GRADING PLAN



APPROVALS	ENGINEER	DATE	APPROVALS	ENGINEER	DATE
City Engineer	<i>Signature</i>	5/85	Liquid Waste	NA	5/85
A.C.E. Design	<i>Signature</i>	5/85	Traffic	NA	5/85
Hydrology	<i>Signature</i>	5/85	Water	NA	5/85

DRAWING NO. 2435

MAP NO. E-22

SHEET 7 OF 11

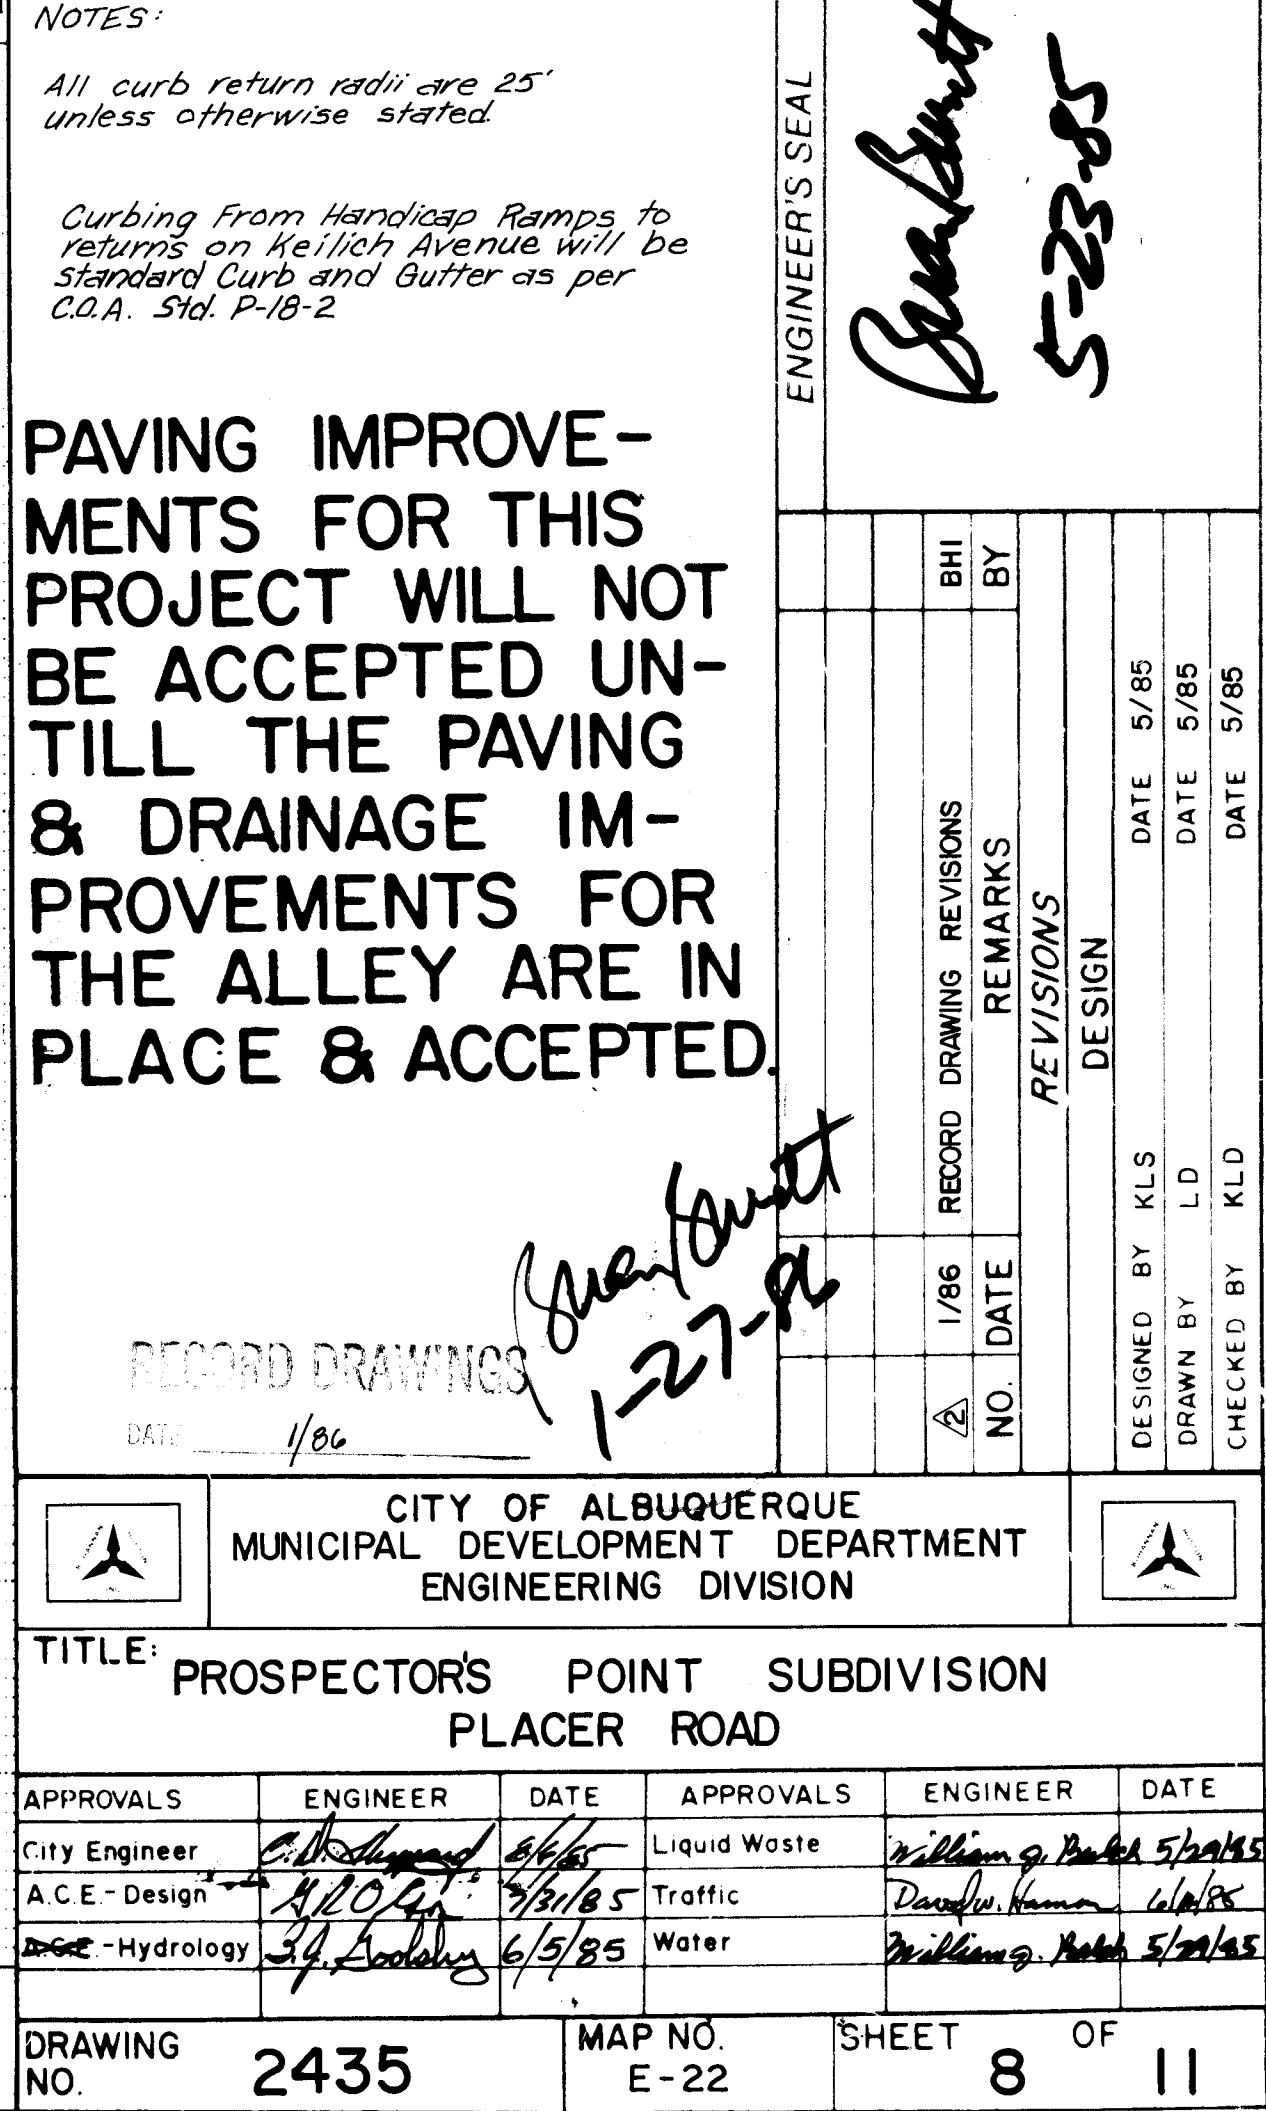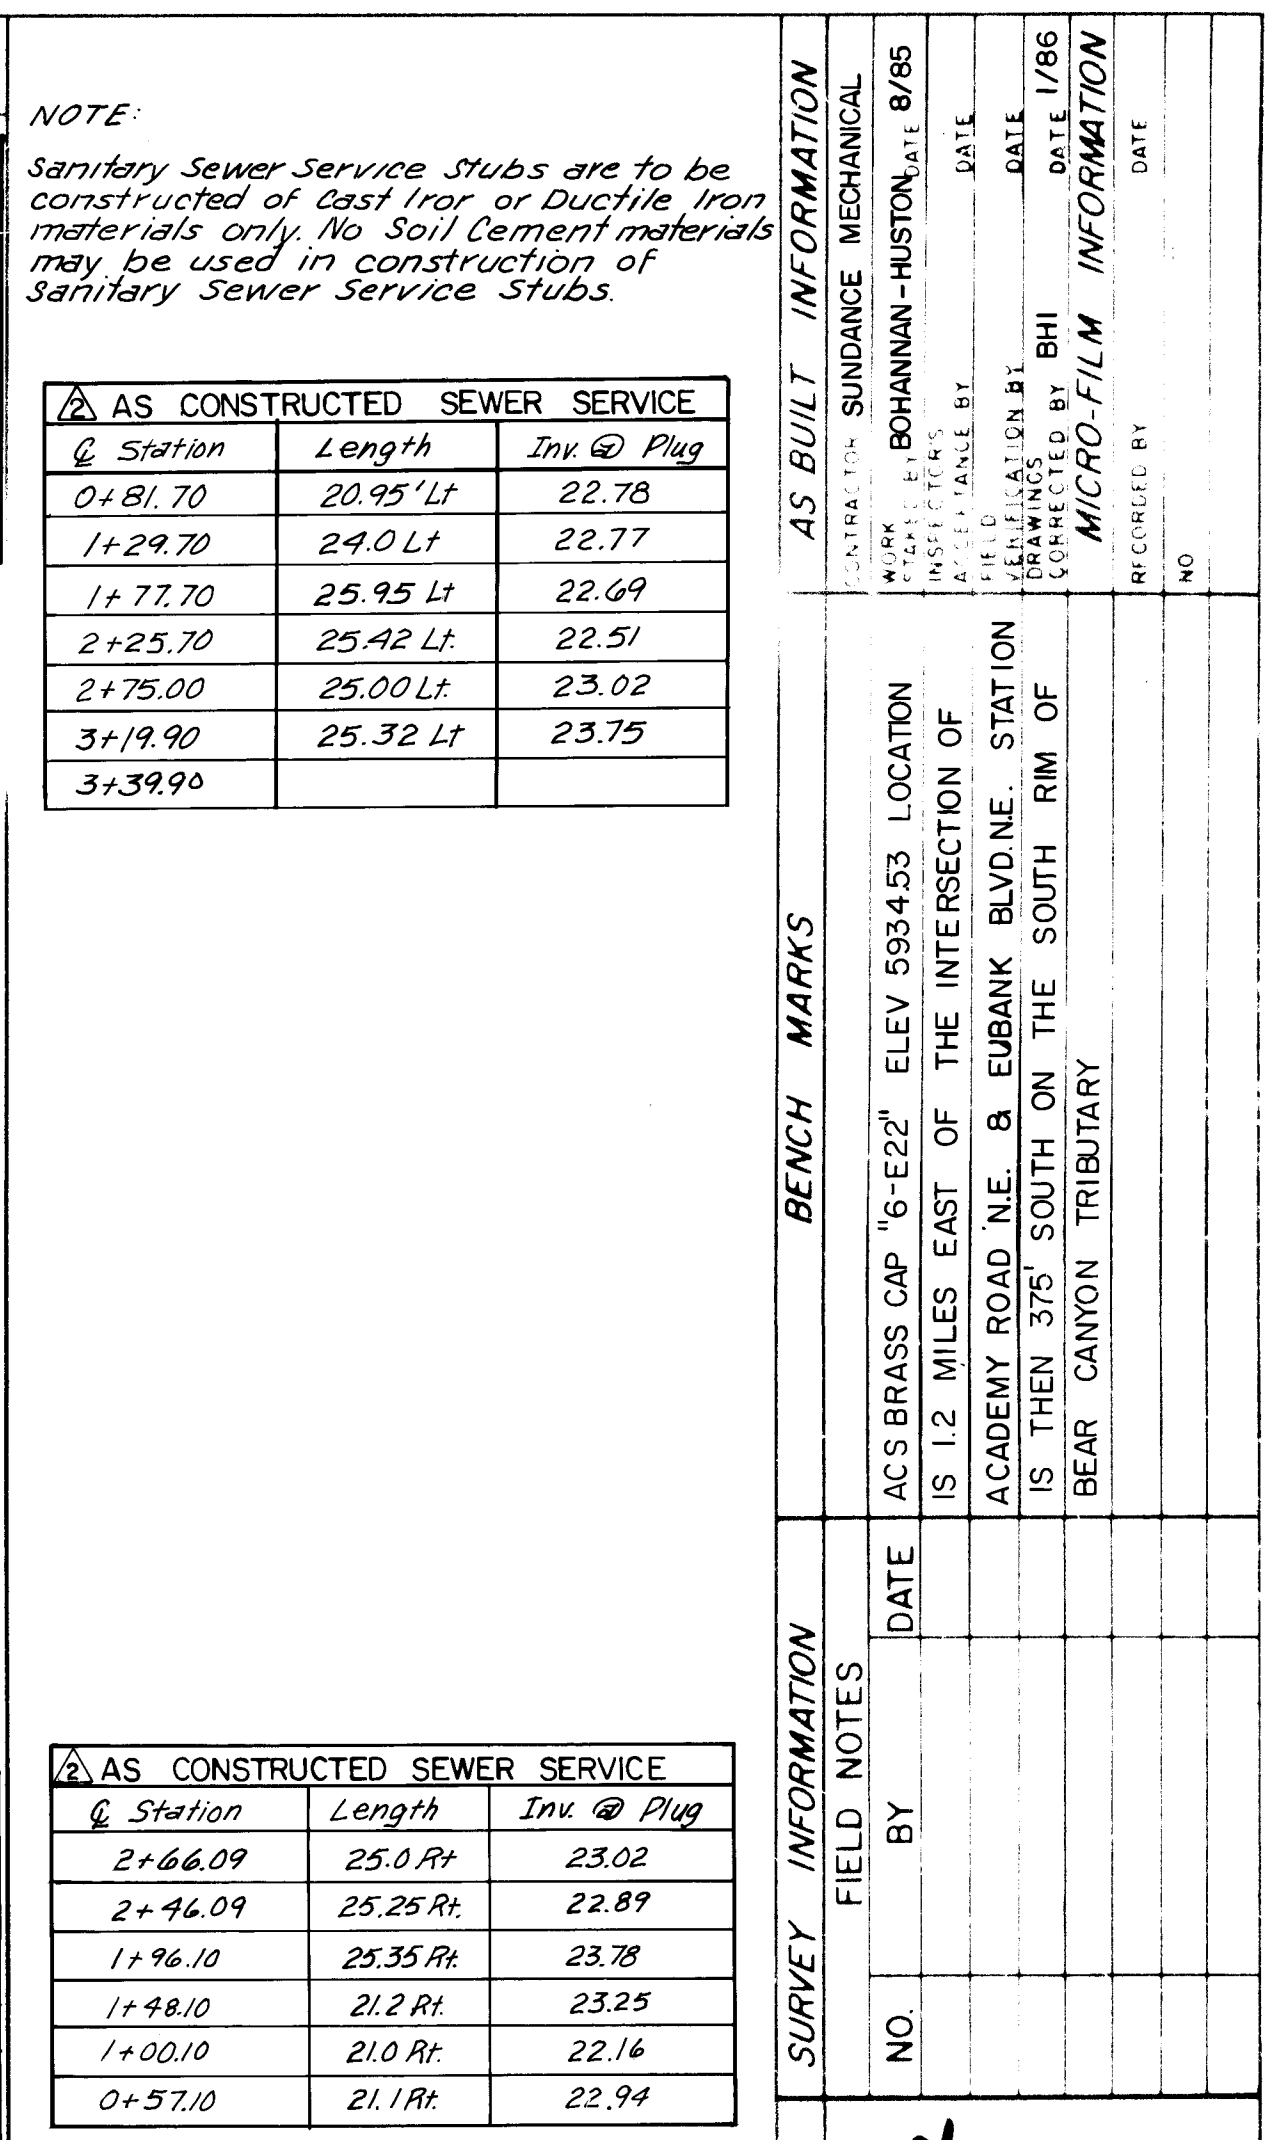

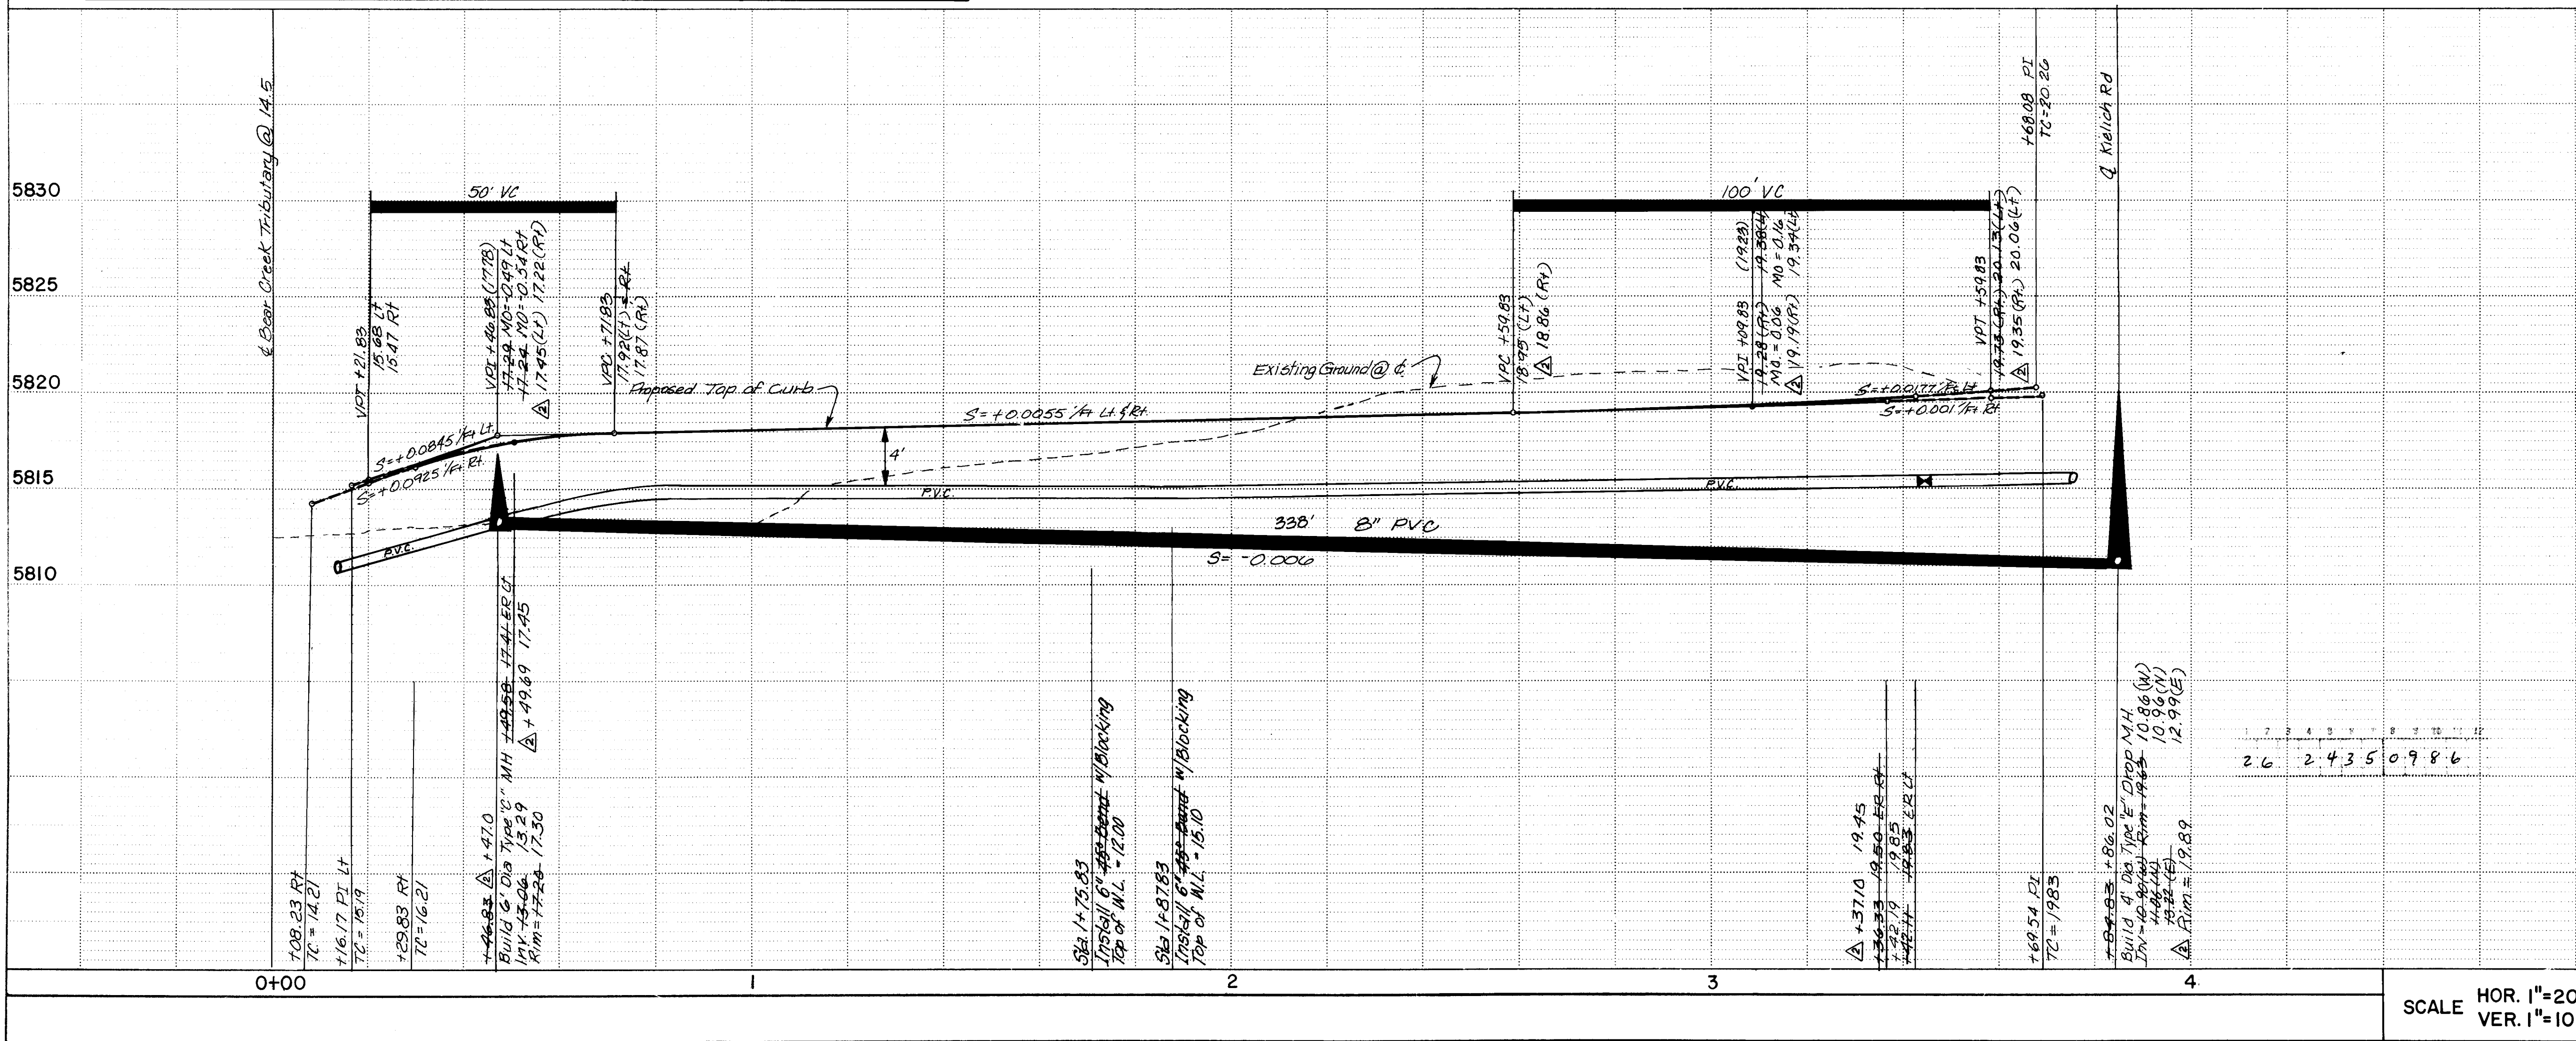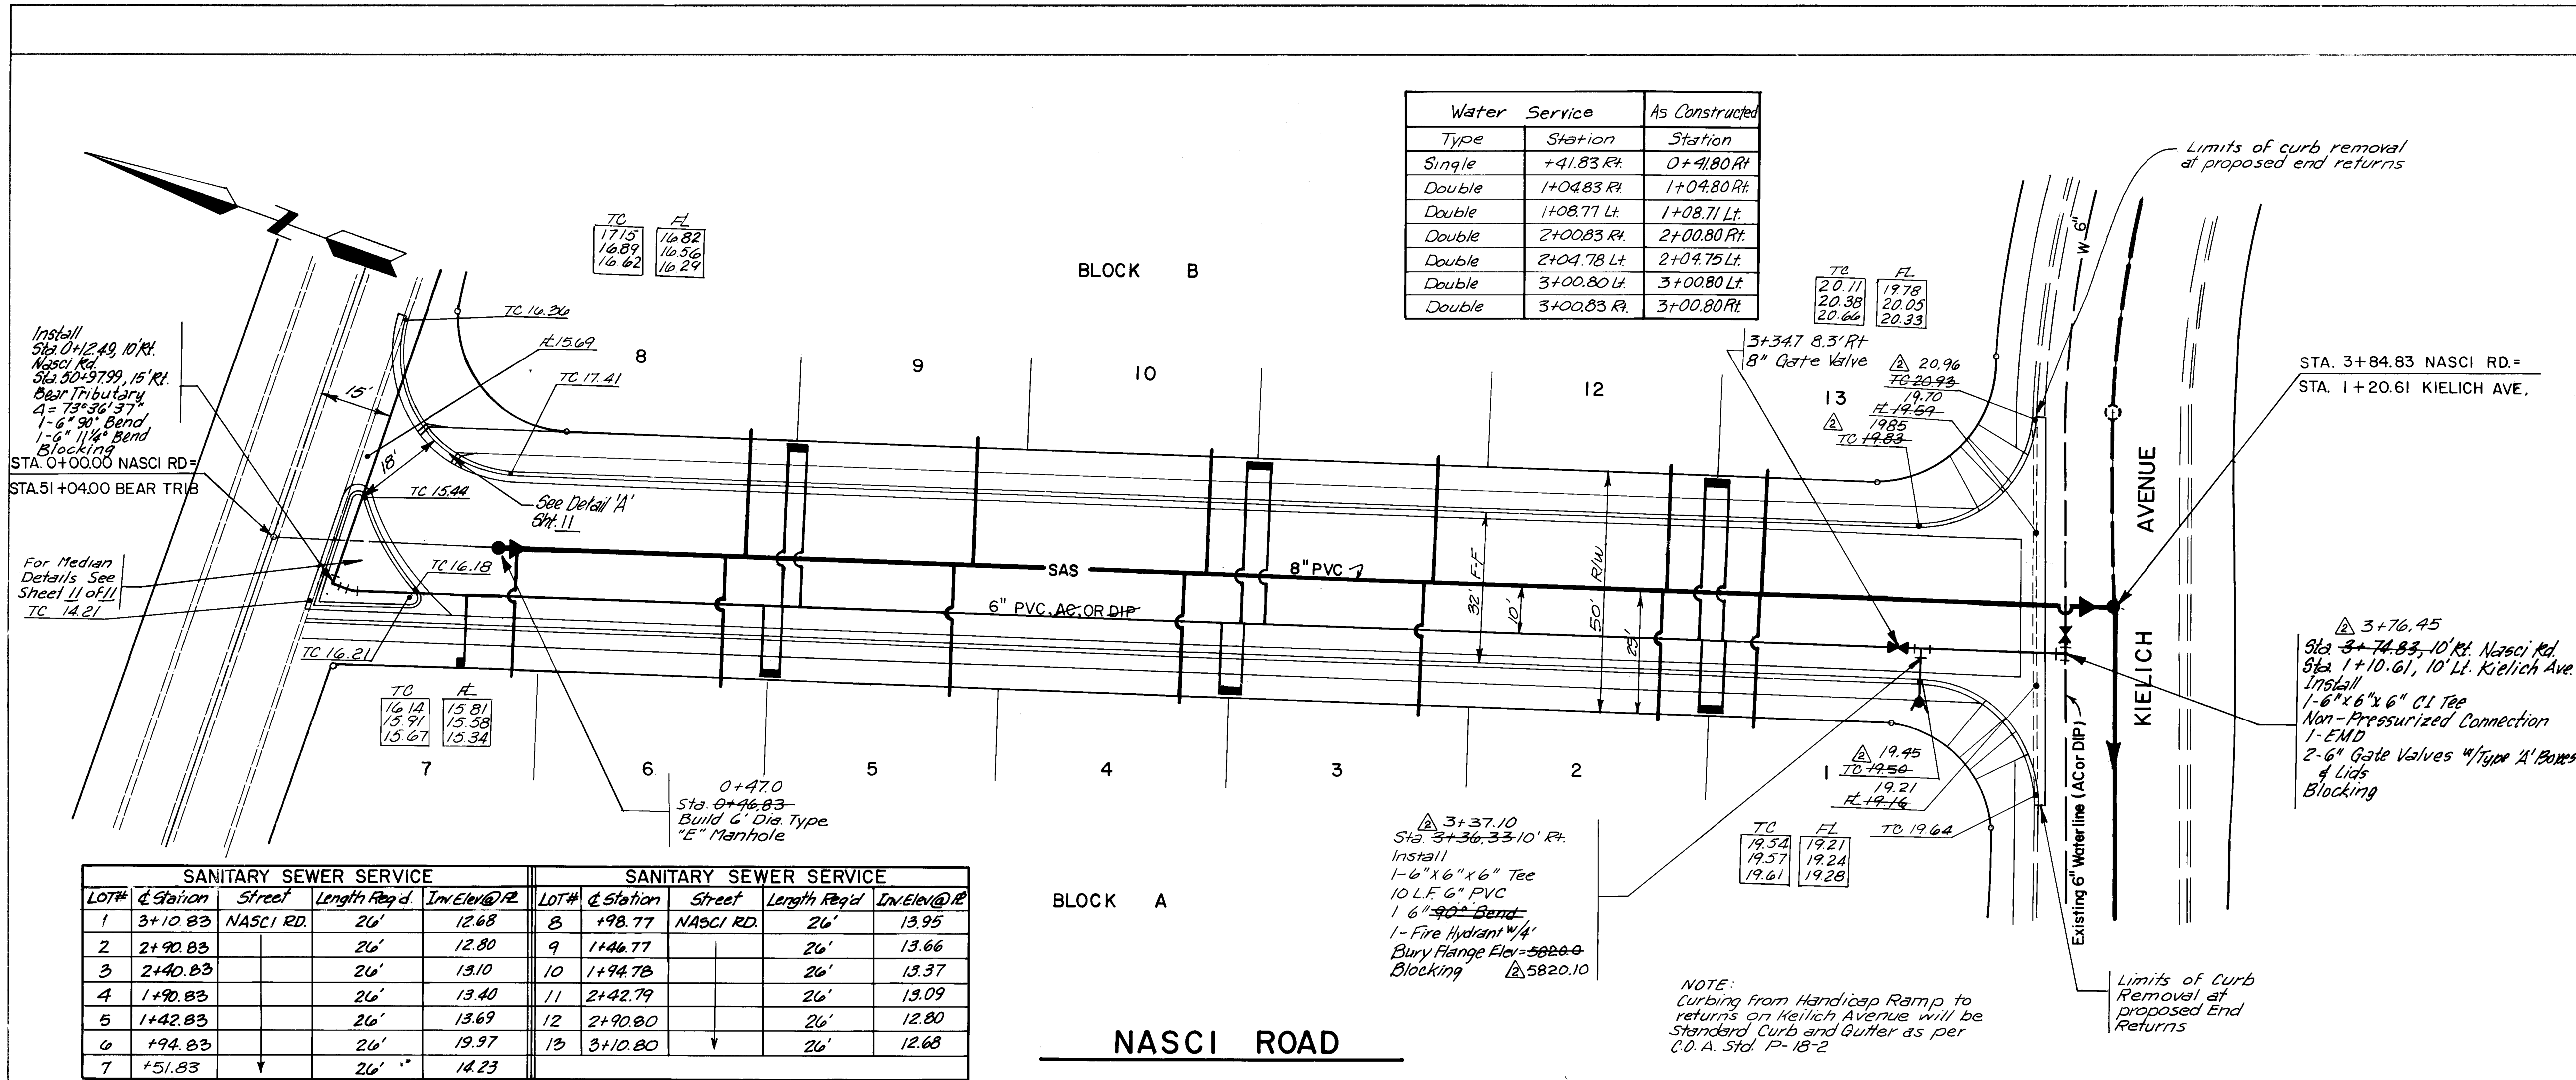

NOTES:
Remove and destroy 177.17' of existing 8" VCP. Replace with 8" VCP and tie to existing M.H. @ Sta. 0+00 Kielich Avenue.

Sanitary Sewer Service Stubs are to be constructed of Cast Iron or Ductile Iron materials only. No Soil Cement materials may be used in construction of Sanitary Sewer Service Stubs.

As Constructed Sewer Service		
Station	Length	Invert @ Plug
0+51.83	26' Rt.	14.78
0+94.83	26' Rt.	15.22
0+98.77	26' Lt.	14.95
1+42.83	26' Rt.	13.97
1+46.77	26' Lt.	14.56
1+90.83	26' Lt.	13.73
1+94.78	26' Lt.	14.94
2+40.83	26' Rt.	14.12
2+42.79	26' Lt.	14.62
2+90.80	26' Lt.	14.73
2+90.83	26' Rt.	14.76
3+10.83	26' Rt.	14.70
3+10.80	26' Lt.	14.95

NOTES:
All curb return radii are 25' unless otherwise stated.

Curbing From Handicap Ramps to returns on Kielich Avenue will be Standard Curb and Gutter as per C.O.A. Std. P-18-2

PAVING IMPROVEMENTS FOR THIS PROJECT WILL NOT BE ACCEPTED UNTILL THE PAVING & DRAINAGE IMPROVEMENTS FOR THE ALLEY ARE IN PLACE & ACCEPTED.

RECORD DRAWINGS
DATE 1/86
1-27-86

CITY OF ALBUQUERQUE
MUNICIPAL DEVELOPMENT DEPARTMENT
ENGINEERING DIVISION

TITLE: PROSPECTOR'S POINT SUBDIVISION
NASCI ROAD

APPROVALS	ENGINEER	DATE	APPROVALS	ENGINEER	DATE
City Engineer	William G. Bickel	5/24/85	Liquid Waste	William G. Bickel	5/24/85
A.C.E. Design	11042	7/1/85	Traffic	William G. Bickel	6/14/85
Hydrology	11042	6/5/85	Water	William G. Bickel	5/24/85

DRAWING NO. 2435
MAP NO. E-22
SHEET 9 OF 11

