


EAGLE RANCH ROAD, N.W.

WEST HALF ONLY ▲

AT EAGLE RANCH

CITY OF ALBUQUERQUE, NEW MEXICO

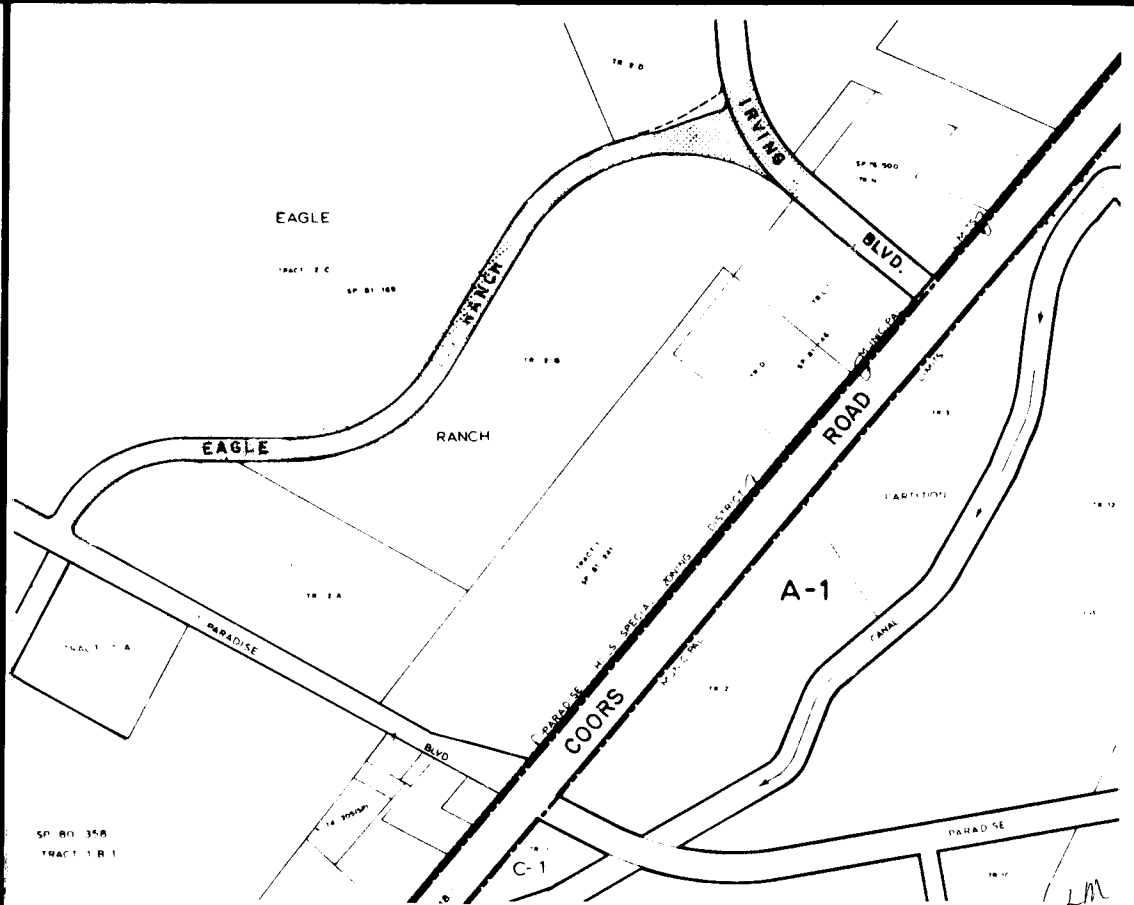

1" = 800' approx. VICINITY MAP ZONE ATLAS C-13

- GENERAL NOTES:
- 1) ALL WORK DETAILED ON THESE PLANS TO BE PERFORMED UNDER CONTRACT SHALL EXCEPT AS OTHERWISE STATED OR PROVIDED FOR HEREON, BE CONSTRUCTED IN ACCORDANCE WITH THE NEW MEXICO STANDARD SPECIFICATIONS FOR PUBLIC WORKS CONSTRUCTION - 1979 EDITION (REFERRED TO HEREIN AS THE STANDARD SPECIFICATIONS) AND THE CONTRACT DOCUMENTS FOR PUBLIC WORKS CONTRACT NUMBER 85-1.
 - 2) TWO (2) WORKING DAYS PRIOR TO ANY EXCAVATION, CONTRACTOR MUST CONTACT LINE LOCATING SERVICE, 765-1234, FOR LOCATION OF EXISTING UTILITIES.
 - 3) PRIOR TO CONSTRUCTION, THE CONTRACTOR SHALL EXCAVATE AND VERIFY THE HORIZONTAL AND VERTICAL LOCATIONS OF ALL OBSTRUCTIONS. SHOULD A CONFLICT EXIST, THE CONTRACTOR SHALL NOTIFY THE ENGINEER OR SURVEYOR SO THAT THE CONFLICT CAN BE RESOLVED WITH MINIMUM AMOUNT OF DELAY.
 - 4) ALL UTILITIES SHALL BE INSTALLED PRIOR TO PAVING.
 - 5) BACKFILL COMPACTION SHALL BE ACCORDING TO ARTERIAL STREET USE.
 - 6) TACK COAT REQUIREMENTS SHALL BE DETERMINED BY THE CITY ENGINEER.
 - 7) ALL STATIONING REFERS TO STREET CENTERLINE EXCEPT AT THE INTERSECTION OF EAGLE RANCH ROAD AND IRVING BOULEVARD.
 - 8) IF CURB IS DEPRESSED FOR A HANDICAP RAMP, THE RAMP SHALL BE CONSTRUCTED PRIOR TO ACCEPTANCE OF THE CURB AND GUTTER.

INDEX TO SHEETS

SHEET NO. DESCRIPTION

1	COVER SHEET & INDEX TO DRAWINGS
2-3	PLATS OF GEOMETRY
4	COMPOSITE PAVING PLAN
5-7	PAVING PLAN & PROFILES
8-11	MEDIAN DETAILS
12	COMPOSITE UTILITY PLAN
13-15	UTILITY PLAN & PROFILES
16	DETAILS

CHANGE ORDER NO. 7


SHEETS 1,4,5,6,7,8,9,10,11

The above-mentioned sheets are temporary additions to the final plans for Eagle Ranch Road. They outline the paving plan for completing approximately one half of the road as directed by the owner. Upon completion of the entire road section, these sheets shall be replaced by the originals.

Note that no alterations were made to any permanent horizontal or vertical alignments. The only changes on these sheets involve temporary elimination of road section, curb and gutter and temporary construction of asphalt pavement and curb, which were drawn by Easterling & Associates, Inc., February, 1986.


RECORD DRAWINGS


THESE DRAWINGS HAVE BEEN REVISED IN ACCORDANCE WITH INFORMATION PROVIDED BY COMMUNITY SCIENCES CORP., HUGG SURVEYING CO. AND EASTERLING & ASSOCIATES, INC. TO REFLECT THE CONSTRUCTION AS ACCOMPLISHED.

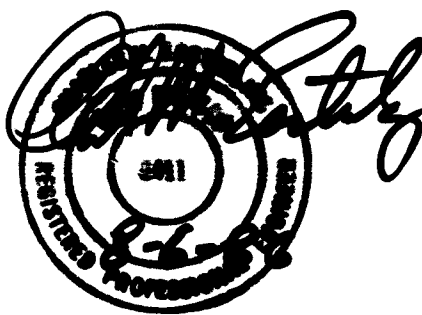

△	1,4,5,6,7,8,9,10,11	ALC ha, P.E.	3/25/86																																																																																																																																																																																																																																																																																																																																																																																																																																																																																																																																																																																																																																																																																																																																																																																																																																																																																																																																																																																																																																																																																																																																																																																																																																																																																																																																																																																																																																																																																																																														
---	---------------------	--------------	---------	--	--	

ENGINEER'S SEAL		DATE: MARCH, 1985	COMMUNITY SCIENCES CORPORATION	APPROVED FOR CONSTRUCTION ALC ha CITY ENGINEER 4-1-85 DATE
SCALE: N/A		DESIGNED: G.A.		
DRAWN: CS		JOB NO: 73-24-PRE		
PROJECT NO. 2440		SHEET 1 OF 16		

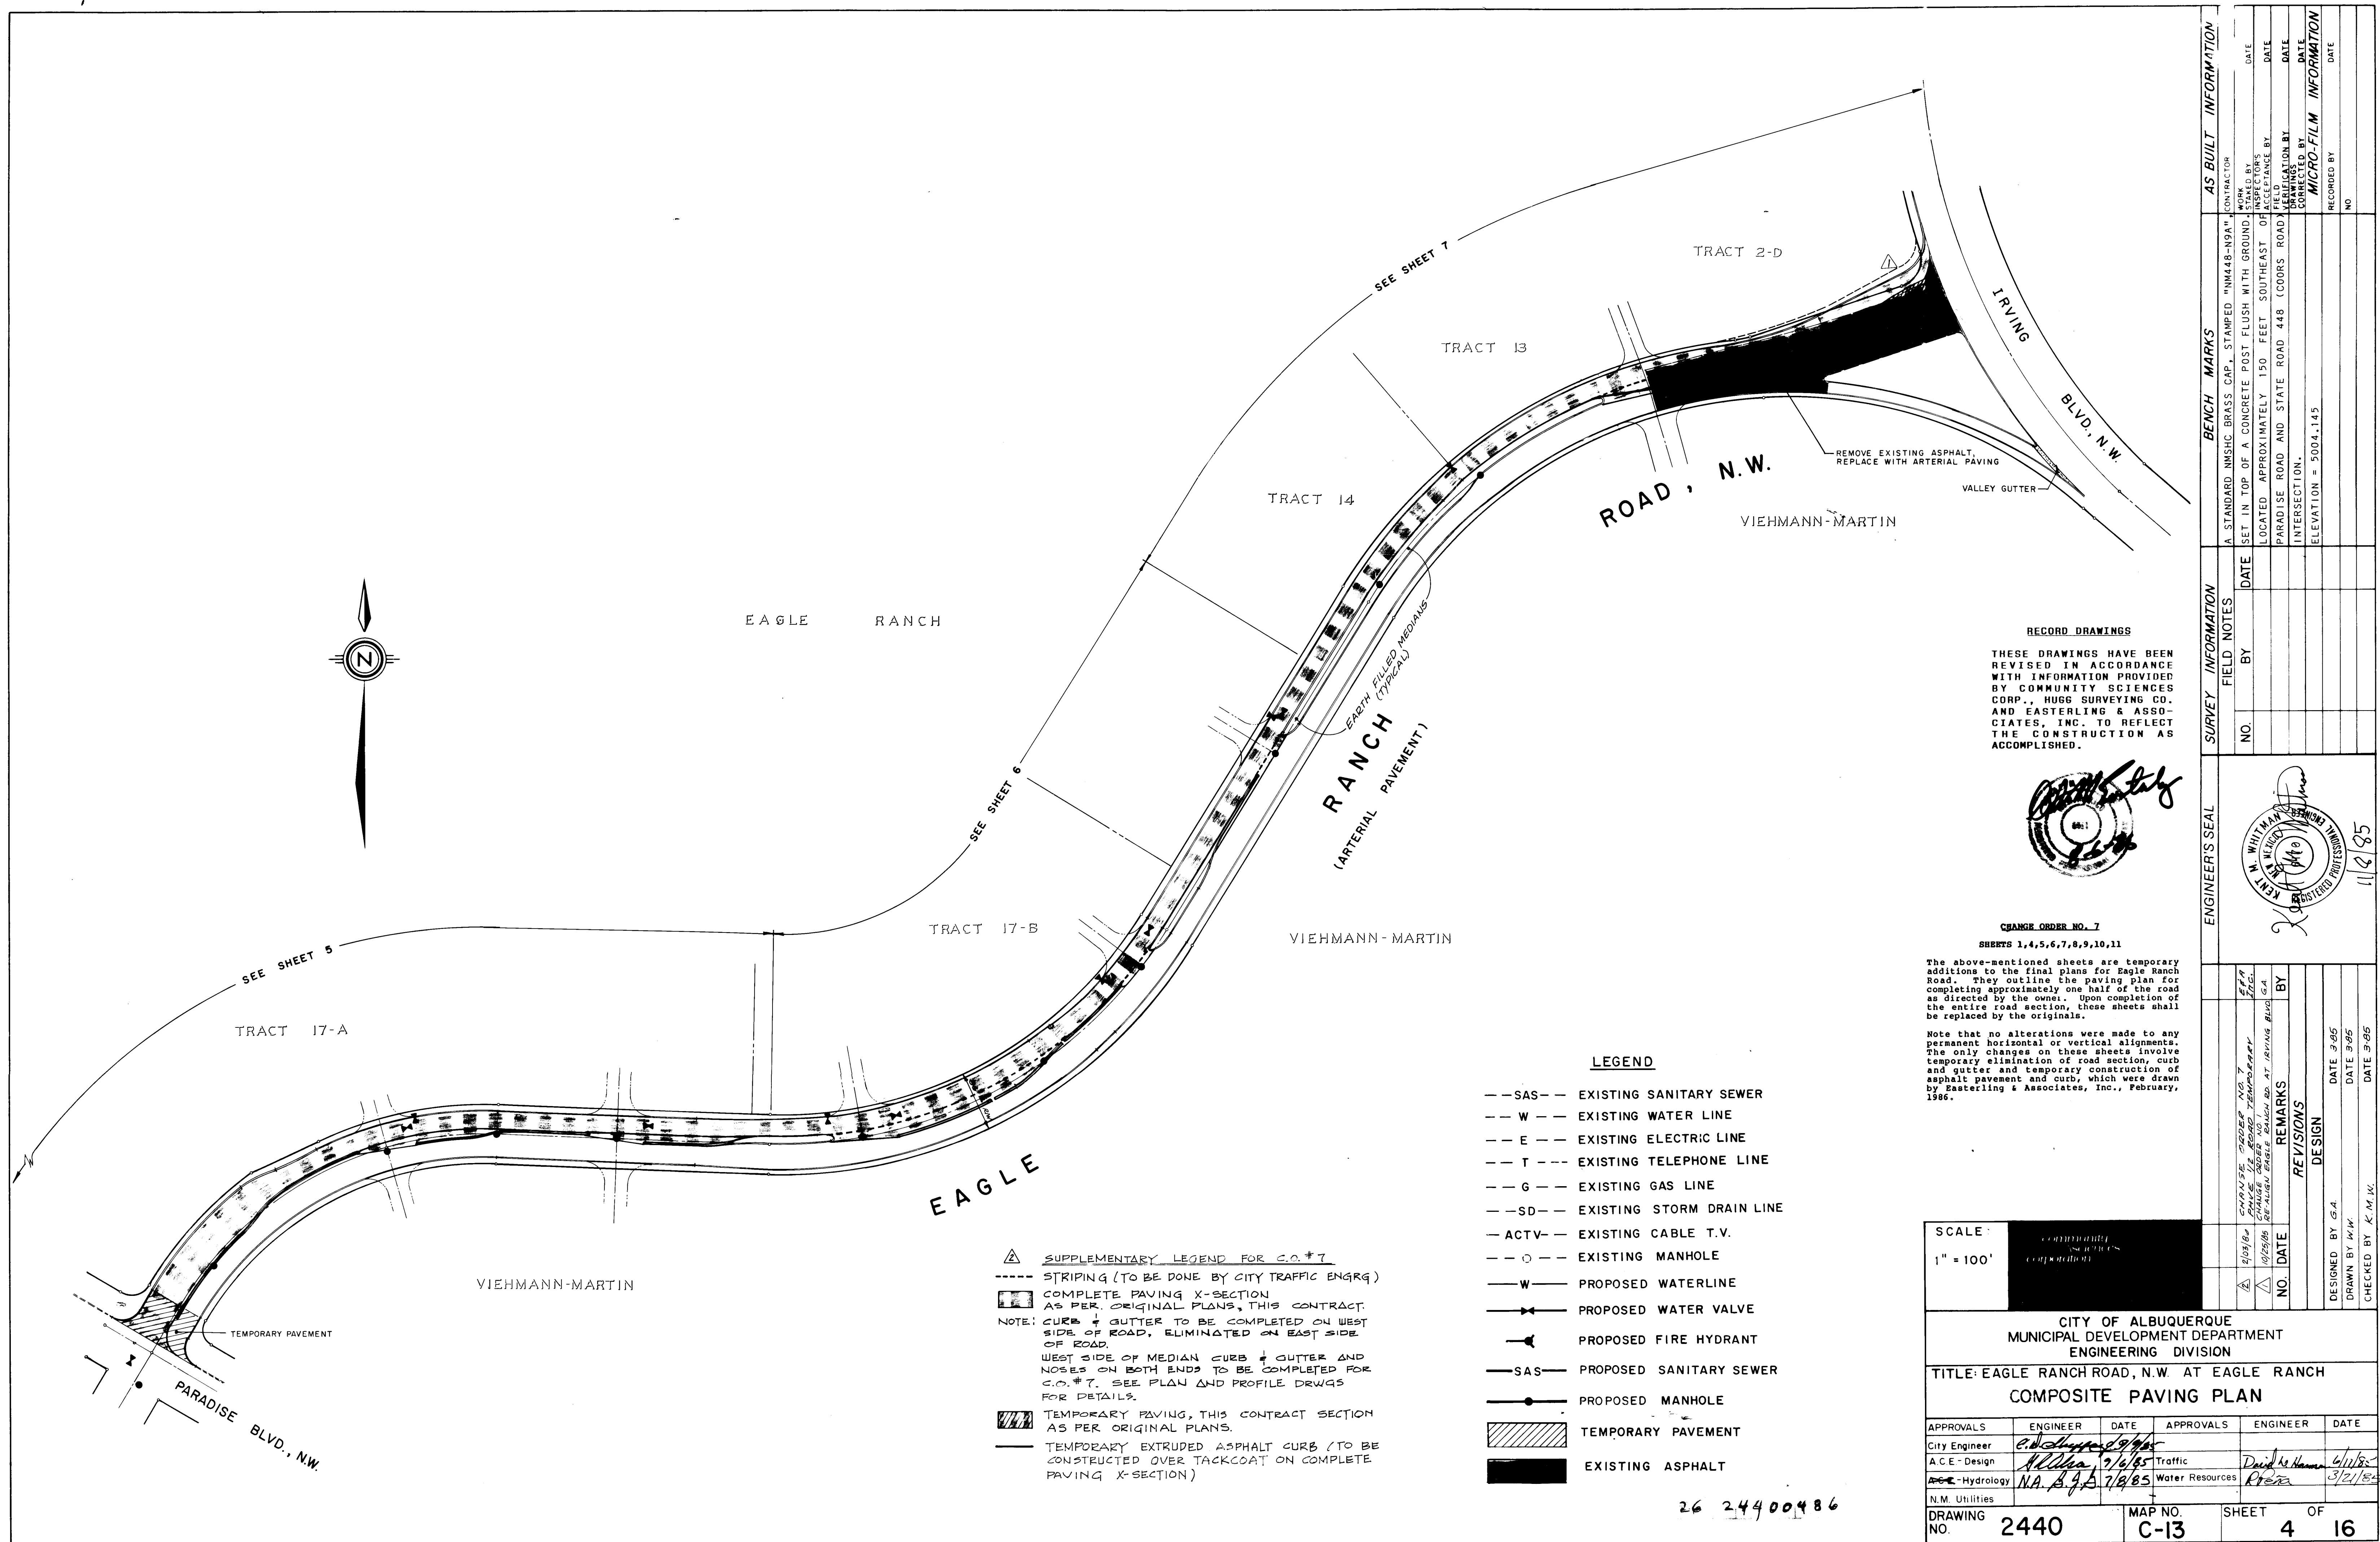

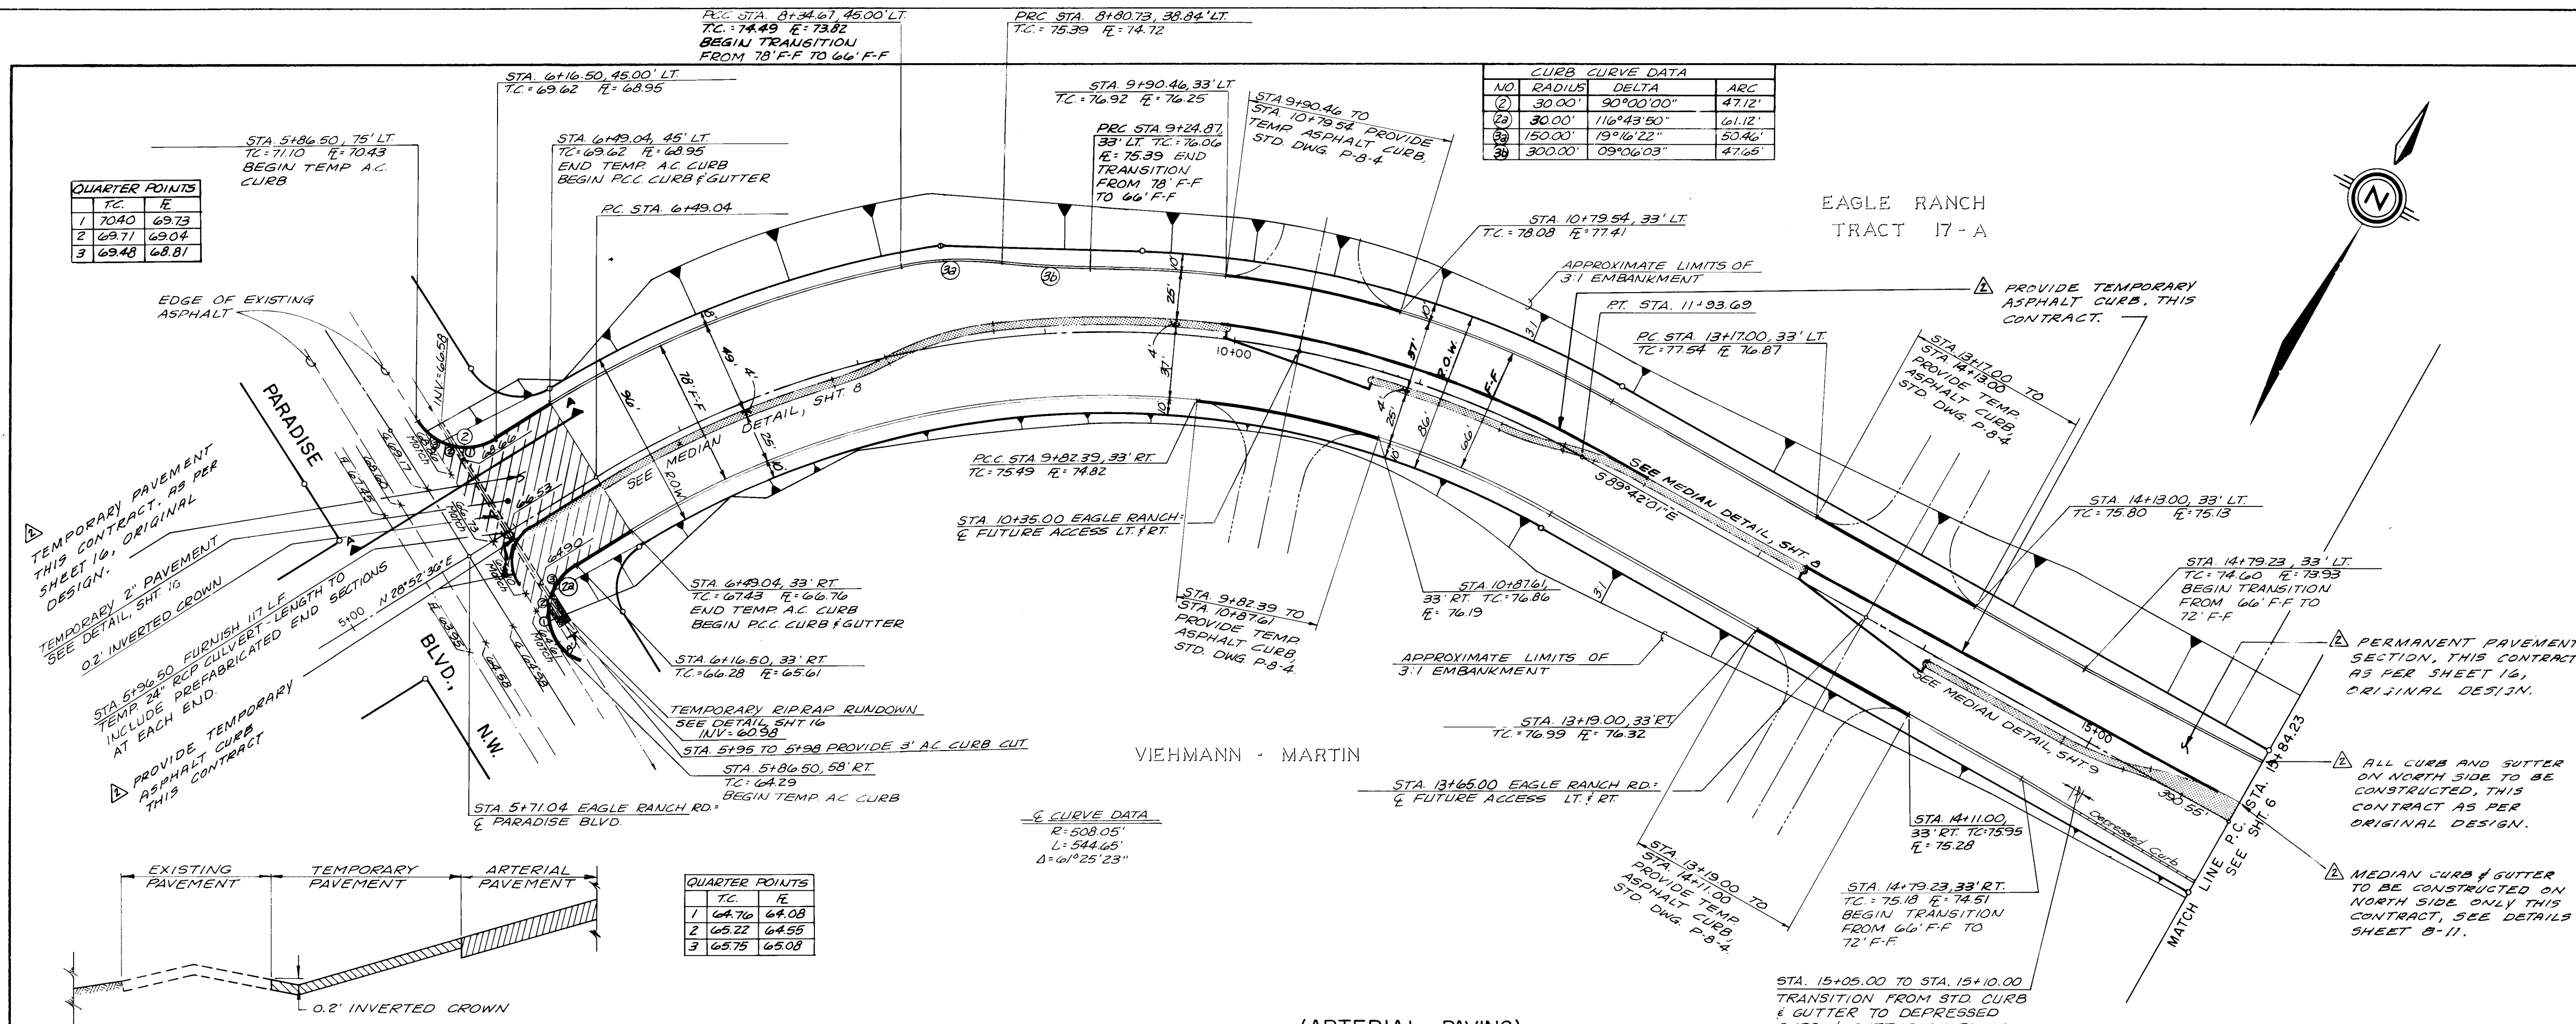

SECTION A-A

(ARTERIAL PAVING)
EAGLE RANCH ROAD, N.W.

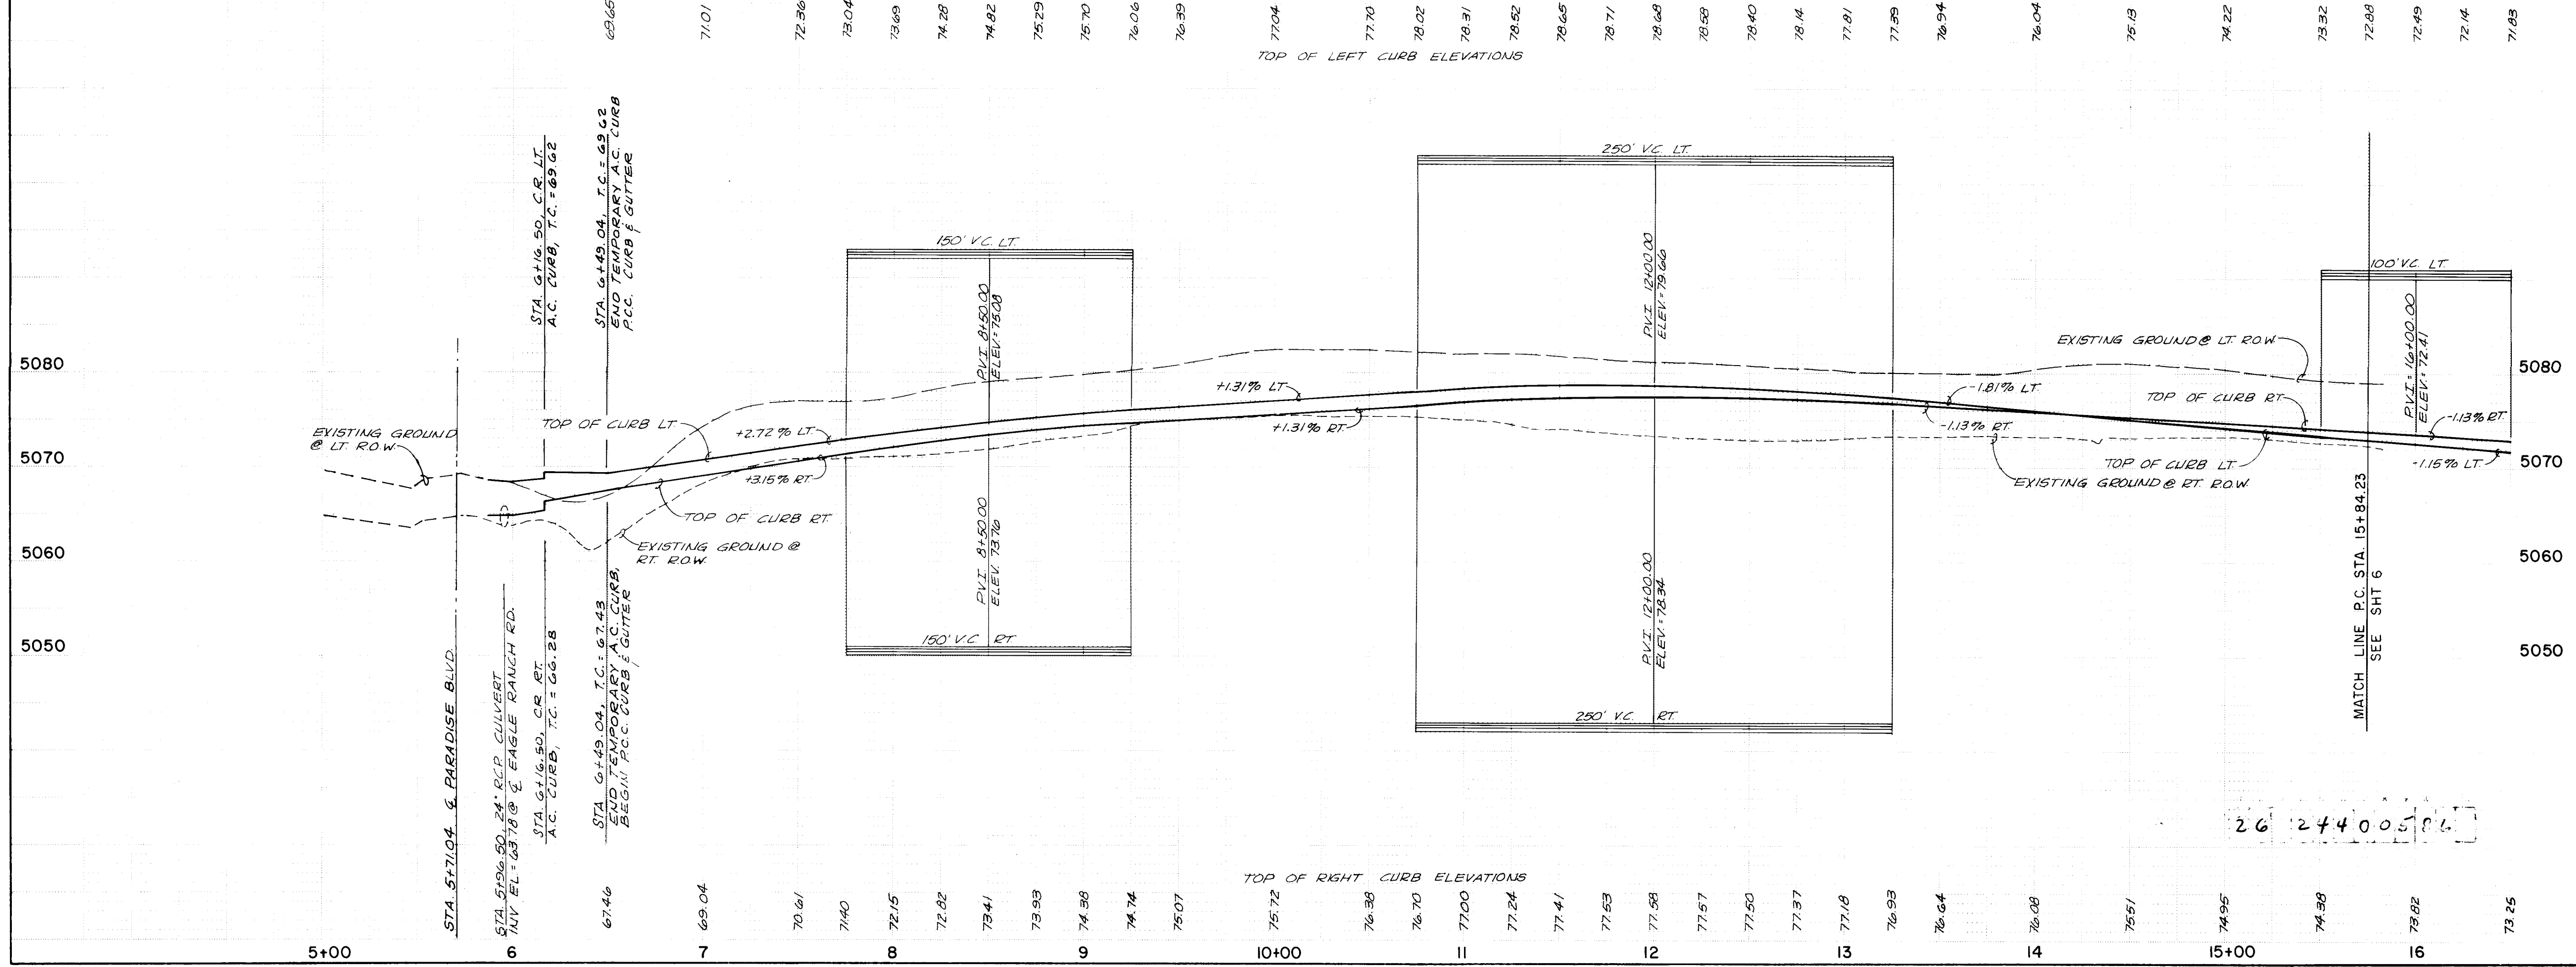

GENERAL NOTES FOR TRAFFIC CONTROL

- All traffic control devices shall comply with Chapter VI of the 1978 edition of the "Manual for Uniform Traffic Control Devices".
- Traffic control devices required after dark are to be equipped with warning lights. Type (A) flashing warning lights shall be used on all advance warning signs and on all devices which are intended to warn motorists or pedestrians of hazards or obstructions in or near the travel path. Type (C) steady burn lights shall be used on all devices which are intended to define the travel path.
- Permits to barricade or detour traffic must be obtained for each phase of construction through the traffic engineers office at least 24 hours in advance of construction activities.
- Contractor shall inspect and maintain all barricades at least once each day except for barricades on or adjacent to arterial and collector streets which shall be checked twice daily, including inspection during hours of darkness.
- Unless otherwise provided as part of the construction documents, the contractor shall prepare and submit to the project engineer a detailed traffic control plan, which is subject to the approval of the City Traffic Engineer. 3 working days in advance of any required closures.
- A minimum width of 11 feet shall be provided for traffic in one direction.

RECORD DRAWINGS

THESE DRAWINGS HAVE BEEN REVISIONED IN ACCORDANCE WITH INFORMATION PROVIDED BY COMMUNITY SCIENCES CORP., HUGG SURVEYING CO. AND EASTERLING & ASSOCIATES, INC. TO REFLECT THE CONSTRUCTION AS ACCOMPLISHED.

CHANGE ORDER NO. 7

SHEETS 1,4,5,6,7,8,9,10,11

The above-mentioned sheets are temporary additions to the final plans for Eagle Ranch Road. They outline the paving plan for completing approximately one half of the road as directed by the owner. Upon completion of the entire road section, these sheets shall be replaced by the originals.

Note that no alterations were made to any permanent horizontal or vertical alignments. The only changes on these sheets involve temporary elimination of construction, curb and gutter and temporary construction of asphalt pavement and curb, which were drawn by Easterling & Associates, Inc., February, 1986.

SCALE:


1" = 50' HOR.
1" = 10' VERT.

CITY OF ALBUQUERQUE
MUNICIPAL DEVELOPMENT DEPARTMENT
ENGINEERING DIVISION

TITLE: EAGLE RANCH RD. N.W. AT EAGLE RANCH PAVING PLAN & PROFILE
EAGLE RANCH ROAD, N.W.

APPROVALS	ENGINEER	DATE	APPROVALS	ENGINEER	DATE
City Engineer	<i>[Signature]</i>	2/1/85	Traffic	<i>[Signature]</i>	2/1/85
A.C.E. - Design	<i>[Signature]</i>	2/1/85	Water Resources	<i>[Signature]</i>	2/1/85
Hydrology	<i>[Signature]</i>	2/1/85			
N.M. Utilities					

DRAWING NO.	MAP NO.	SHEET	OF
2440	C-13	5	16

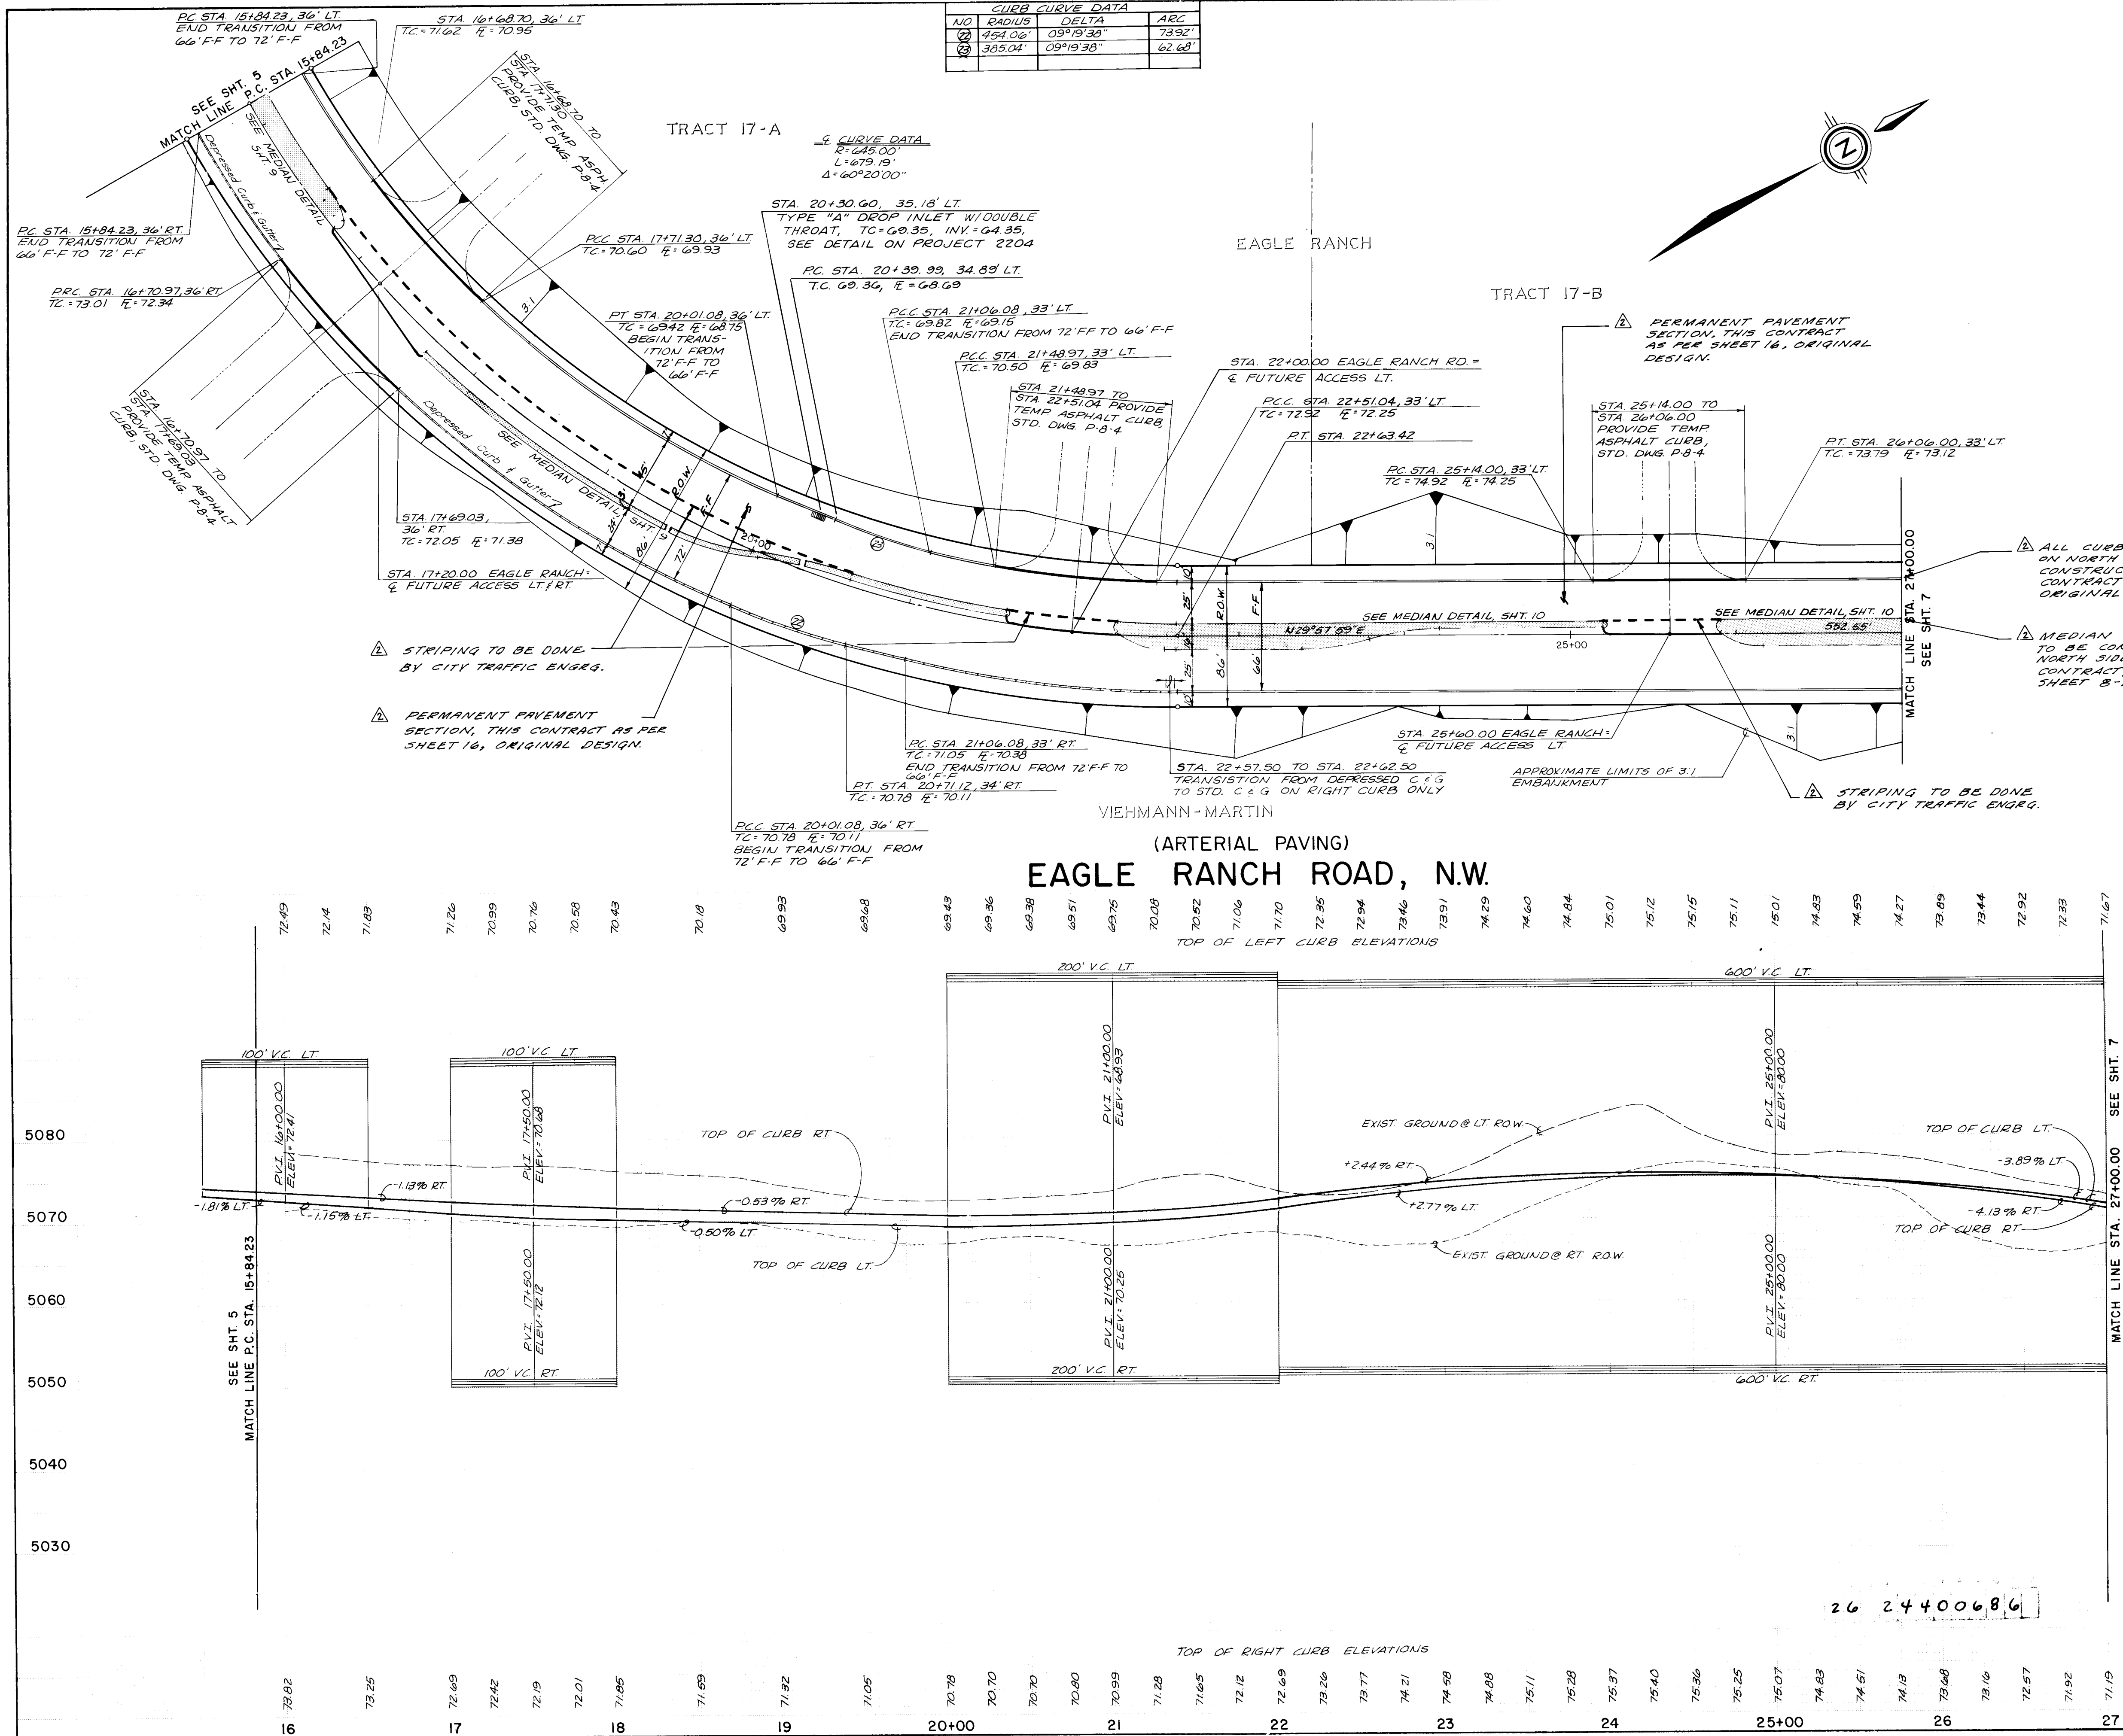

RECORD DRAWINGS

THESE DRAWINGS HAVE BEEN REVISED IN ACCORDANCE WITH INFORMATION PROVIDED BY COMMUNITY SCIENCES CORP., HUGG SURVEYING CO. AND EASTERLING & ASSOCIATES, INC. TO REFLECT THE CONSTRUCTION AS ACCOMPLISHED.

CHANGE ORDER NO. 7

SHEETS 1,4,5,6,7,8,9,10,11

The above-mentioned sheets are temporary additions to the final plans for Eagle Ranch Road. They outline the paving plan for completing approximately one half of the road as directed by the owner. Upon completion of the entire road section, these sheets shall be replaced by the originals.


Note that no alterations were made to any permanent horizontal or vertical alignments. The only changes on these sheets involve temporary elimination of road section, curb and gutter and temporary construction of asphalt pavement and curb, which were drawn by Easterling & Associates, Inc., February, 1986.

SCALE:

1" = 50' HOR.

1" = 10' VERT.

CITY OF ALBUQUERQUE MUNICIPAL DEVELOPMENT DEPARTMENT ENGINEERING DIVISION		
TITLE: EAGLE RANCH RD, N.W. AT EAGLE RANCH PAVING PLAN & PROFILE EAGLE RANCH ROAD, N.W.		
APPROVALS	ENGINEER	DATE
City Engineer	<i>[Signature]</i>	7/8/85
A.C.E. - Design	<i>[Signature]</i>	7/8/85
Hydrology	<i>[Signature]</i>	7/8/85
Water Resources	<i>[Signature]</i>	7/8/85
DRAWING NO. 2440		
MAP NO. C-13		
SHEET 6 OF 16		

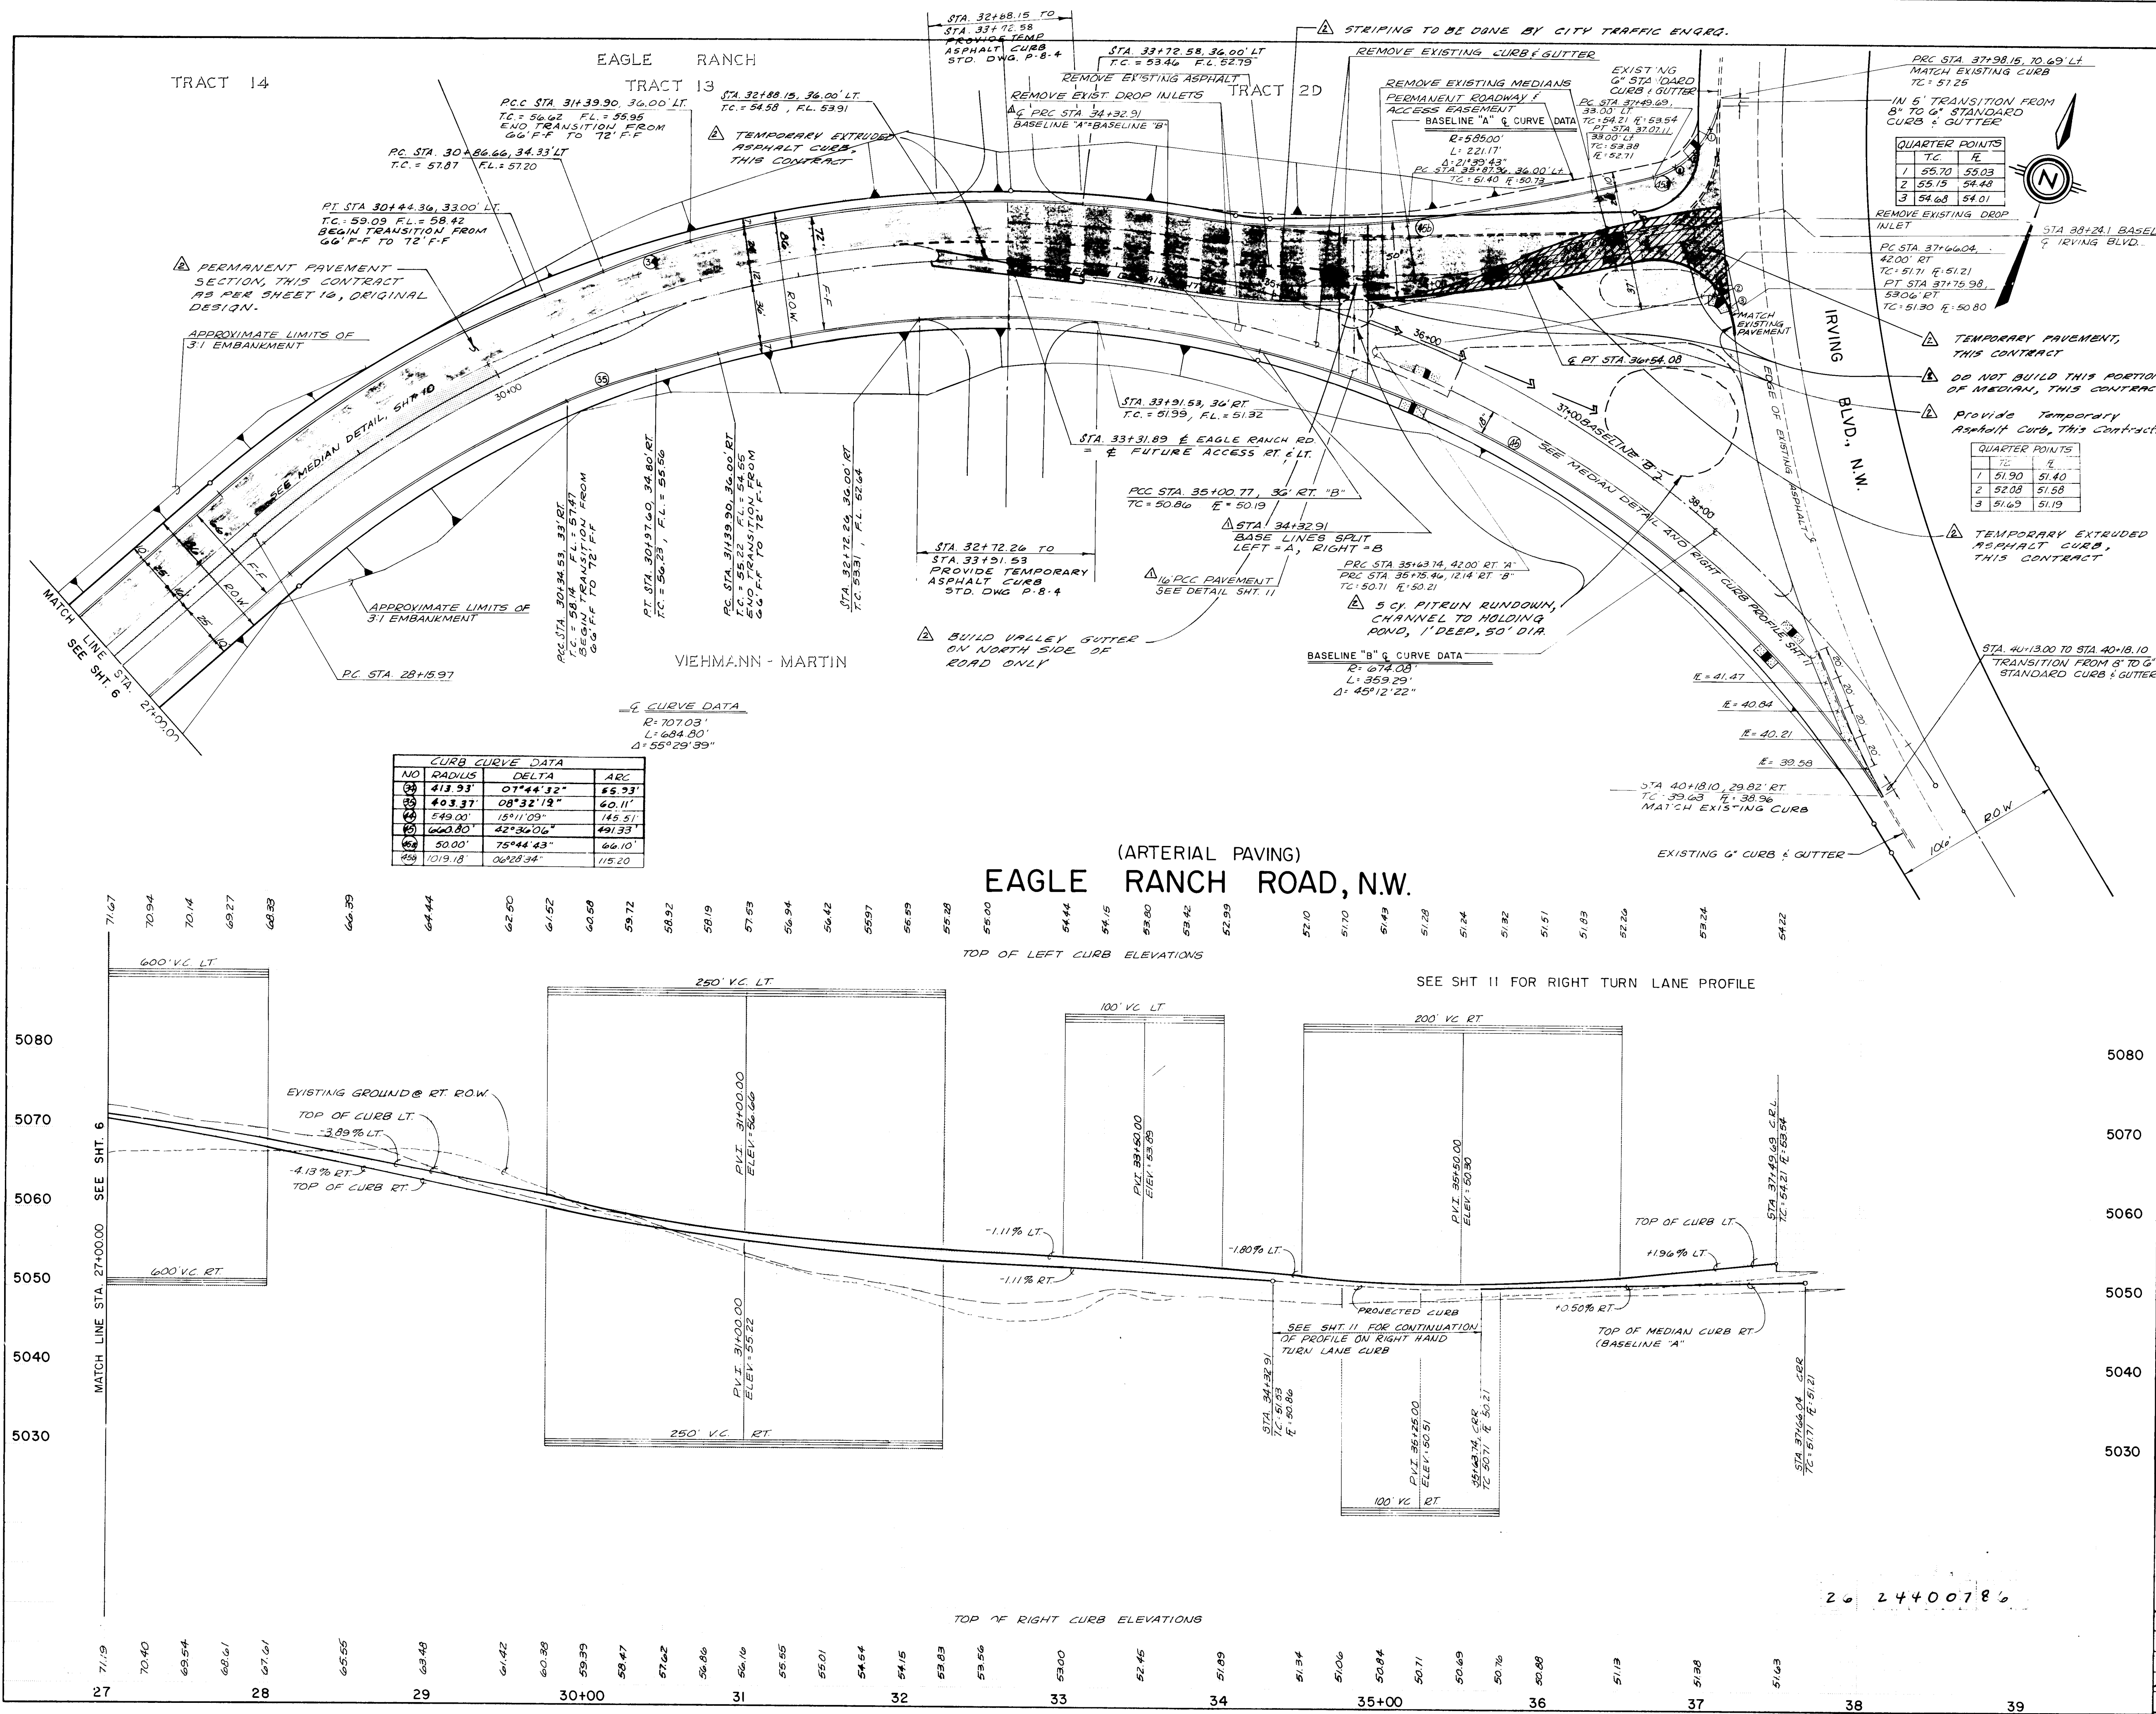


CURVE DATA		
NO.	RADIUS	DELTA
1	413.93'	07°44'32"
2	403.37'	08°32'12"
3	549.00'	15°11'09"
4	600.80'	42°36'06"
5	50.00'	75°44'43"
6	1019.18'	06°22'34"

G CURVE DATA		
R	1070.03'	
L	684.80'	
Δ	55°29'39"	


QUARTER POINTS	
TC	PC
1 55.70	53.03
2 55.15	54.43
3 54.60	54.01

QUARTER POINTS	
TC	PC
1 51.90	51.40
2 52.08	51.58
3 51.69	51.19

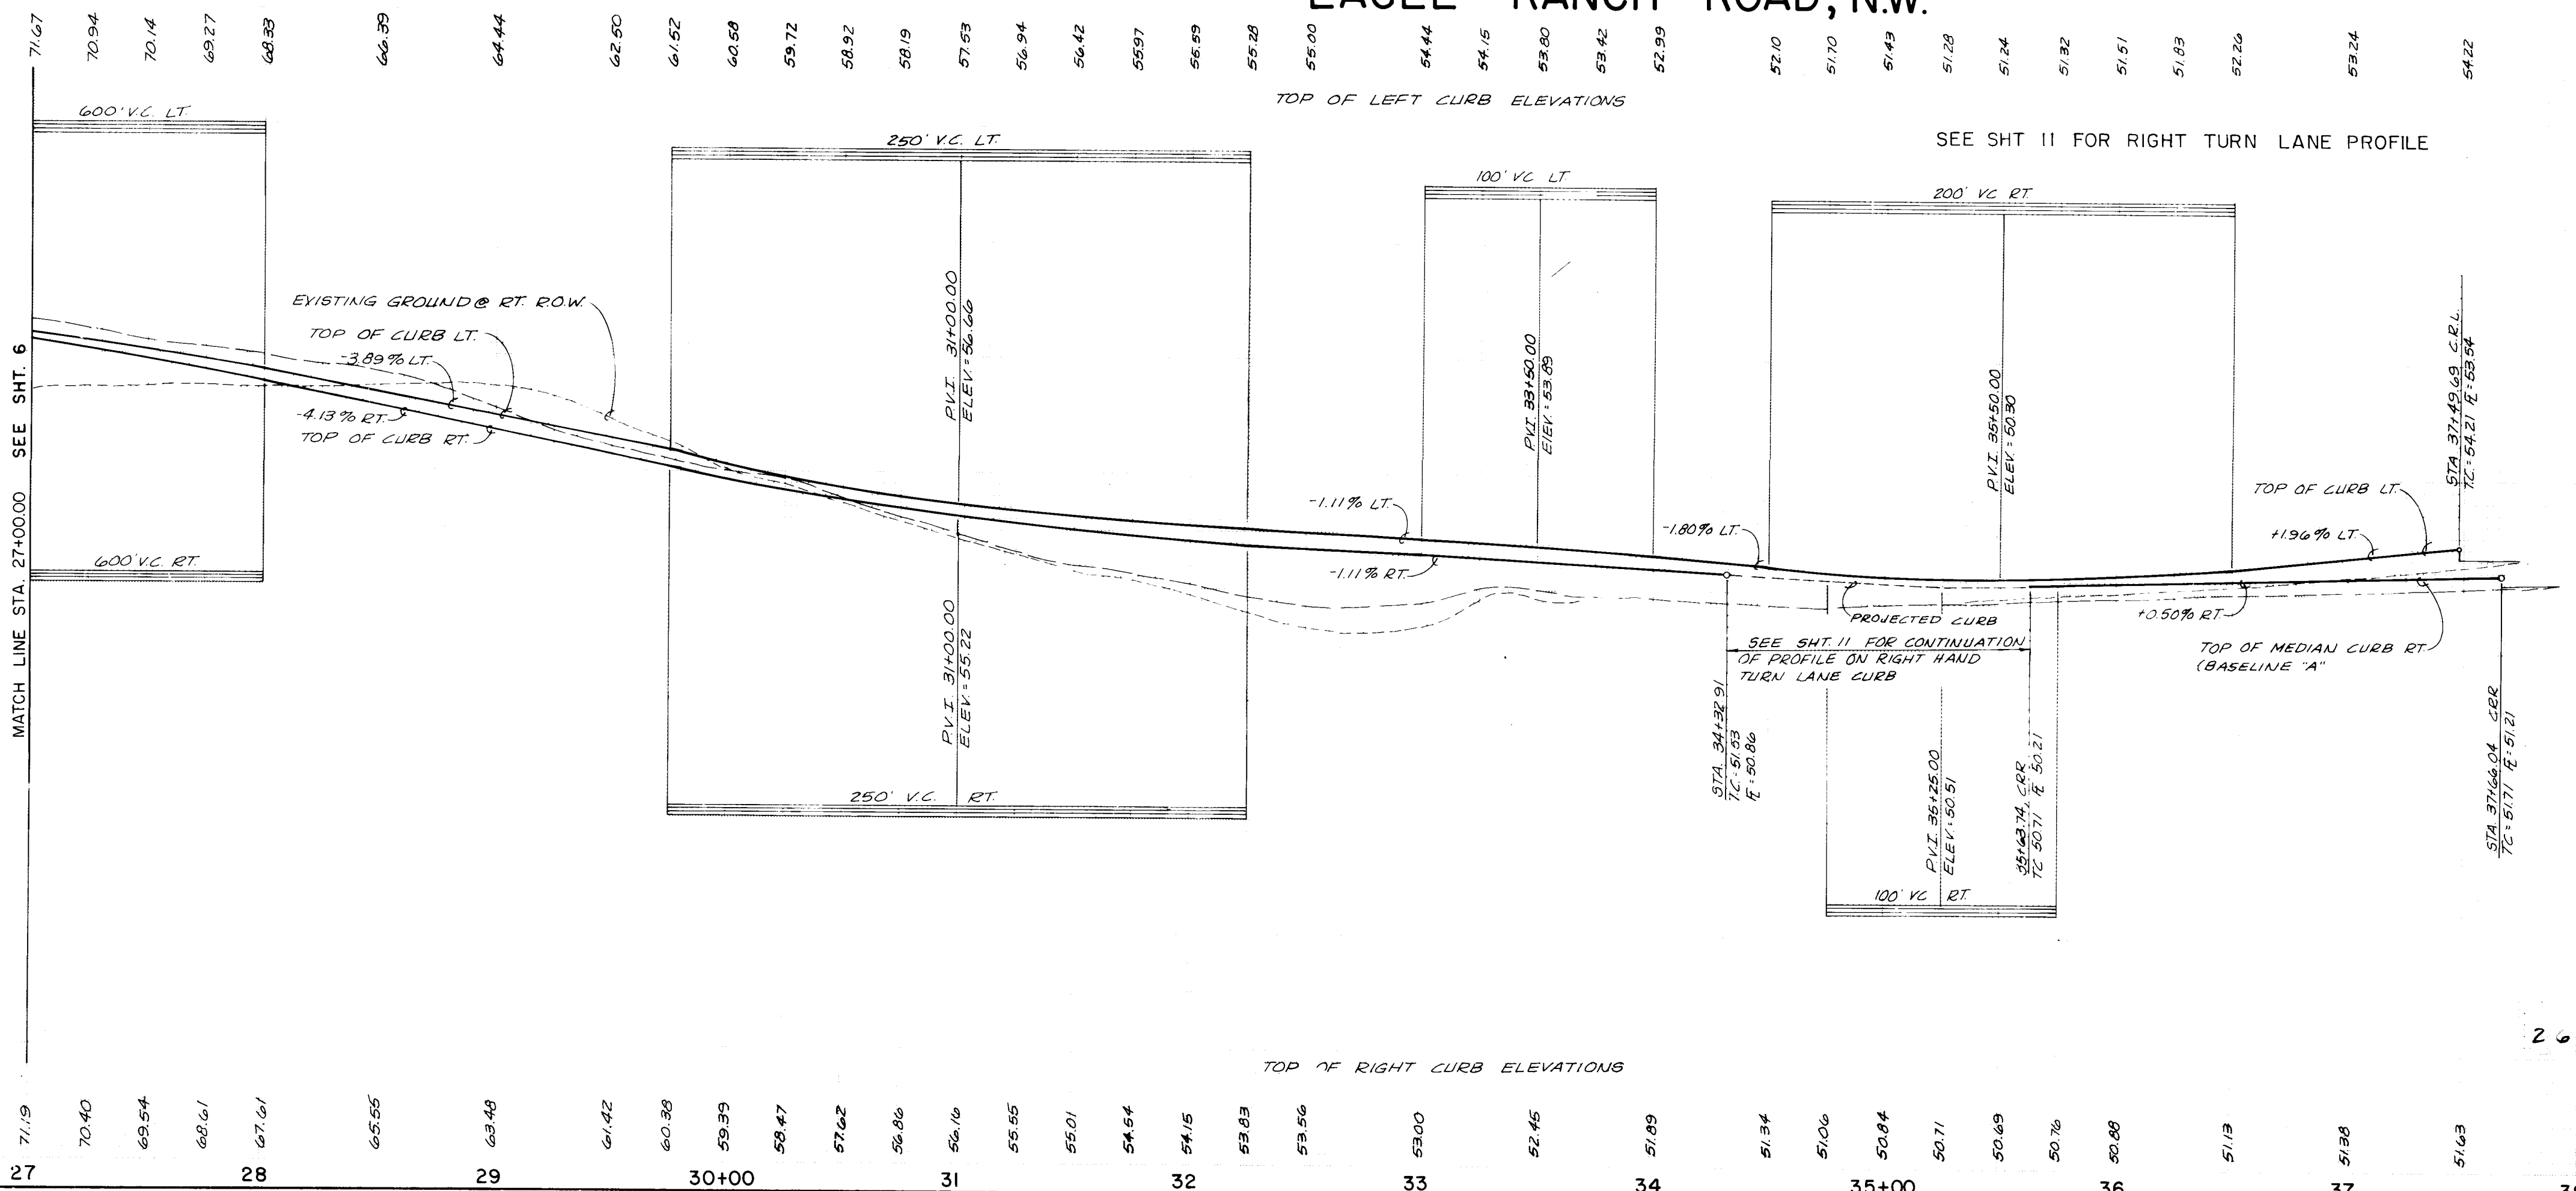

RECORD DRAWINGS

THESE DRAWINGS HAVE BEEN REVISED IN ACCORDANCE WITH INFORMATION PROVIDED BY COMMUNITY SCIENCES CORP., HUGG SURVEYING CO. AND EASTERLING & ASSOCIATES, INC. TO REFLECT THE CONSTRUCTION AS ACCOMPLISHED.

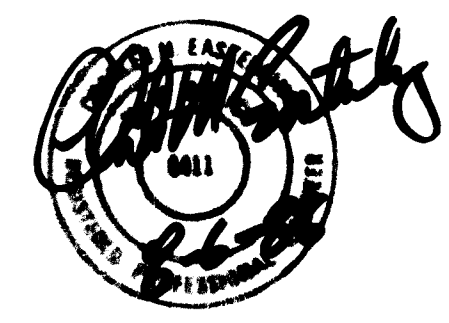

CHANGE ORDER NO. 7

SHEETS 1,4,5,6,7,8,9,10,11

The above-mentioned sheets are temporary additions to the final plans for Eagle Ranch Road. They outline the paving plan for completing approximately one half of the road as directed by the owner. Upon completion of the entire road section, these sheets shall be replaced by the originals.

Note that no alterations were made to any permanent horizontal or vertical alignments. The only changes on these sheets involve temporary elimination of road section, curb and gutter and temporary construction of asphalt pavement and curb, which were drawn by Easterling & Associates, Inc., February, 1986.


SCALE:

1" = 50' HOR.


1" = 10' VERT.

CITY OF ALBUQUERQUE MUNICIPAL DEVELOPMENT DEPARTMENT ENGINEERING DIVISION		
TITLE: EAGLE RANCH RD, N.W. AT EAGLE RANCH PAVING PLAN & PROFILE EAGLE RANCH ROAD, N.W.		
APPROVALS	ENGINEER	DATE
City Engineer	<i>[Signature]</i>	7/1/85
A.C.E. - Design	<i>[Signature]</i>	7/1/85
Hydrology	<i>[Signature]</i>	7/1/85
Water Resources	<i>[Signature]</i>	7/1/85
DRAWING NO.	2440	MAP NO. C-13
SHEET	7	OF 16

NO	RADIUS	DELTA	ABC
1	2.00'	180°00'00"	6.28'
2	154.00'	11°53'58"	31.98'
3	150.00'	21°52'10"	57.25'
4	154.00'	21°52'10"	58.78'
5	150.00'	11°53'58"	31.15'

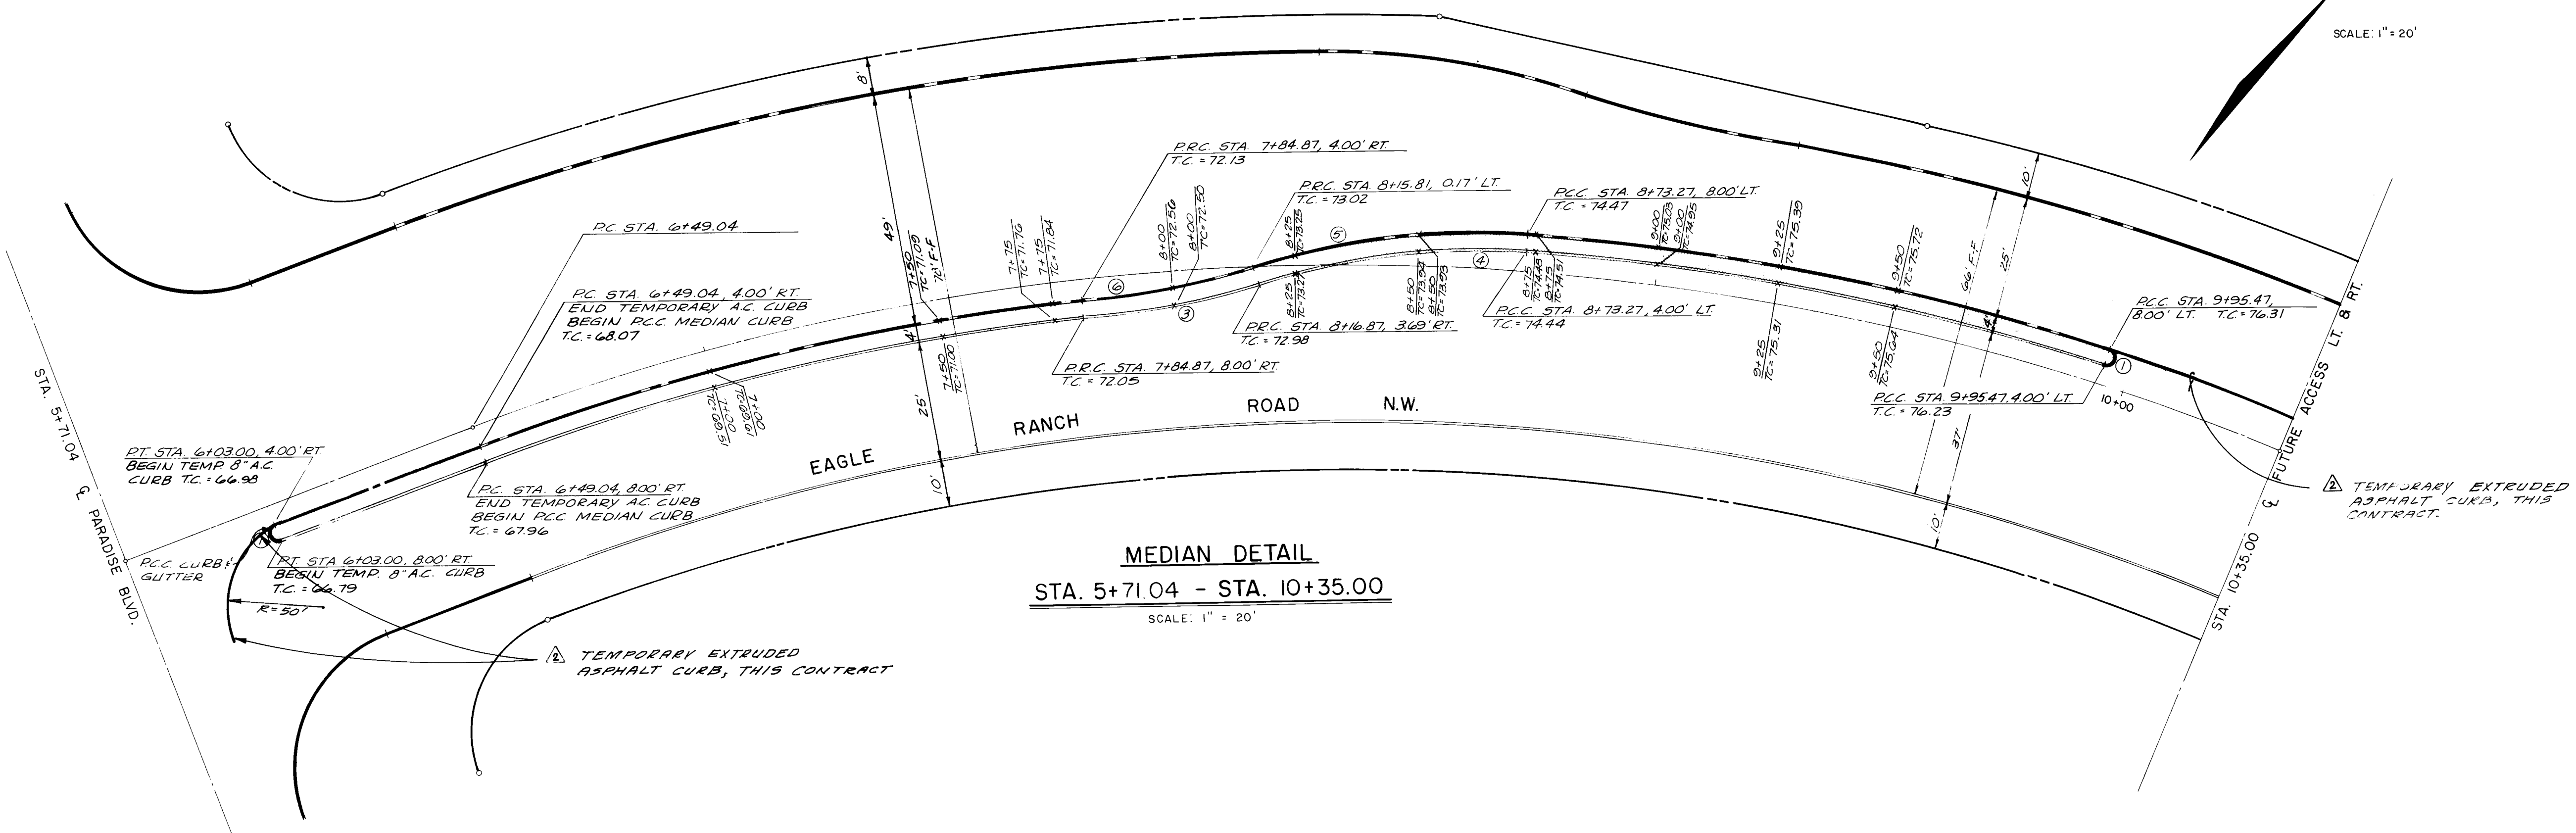

NO	RADIUS	DELTA	ABC
1	2.00'	180°00'00"	6.28'
2	154.00'	12°44'27"	34.25'
3	150.00'	17°47'32"	46.58'
4	154.00'	17°47'32"	47.82'
5	150.00'	12°44'27"	33.36'

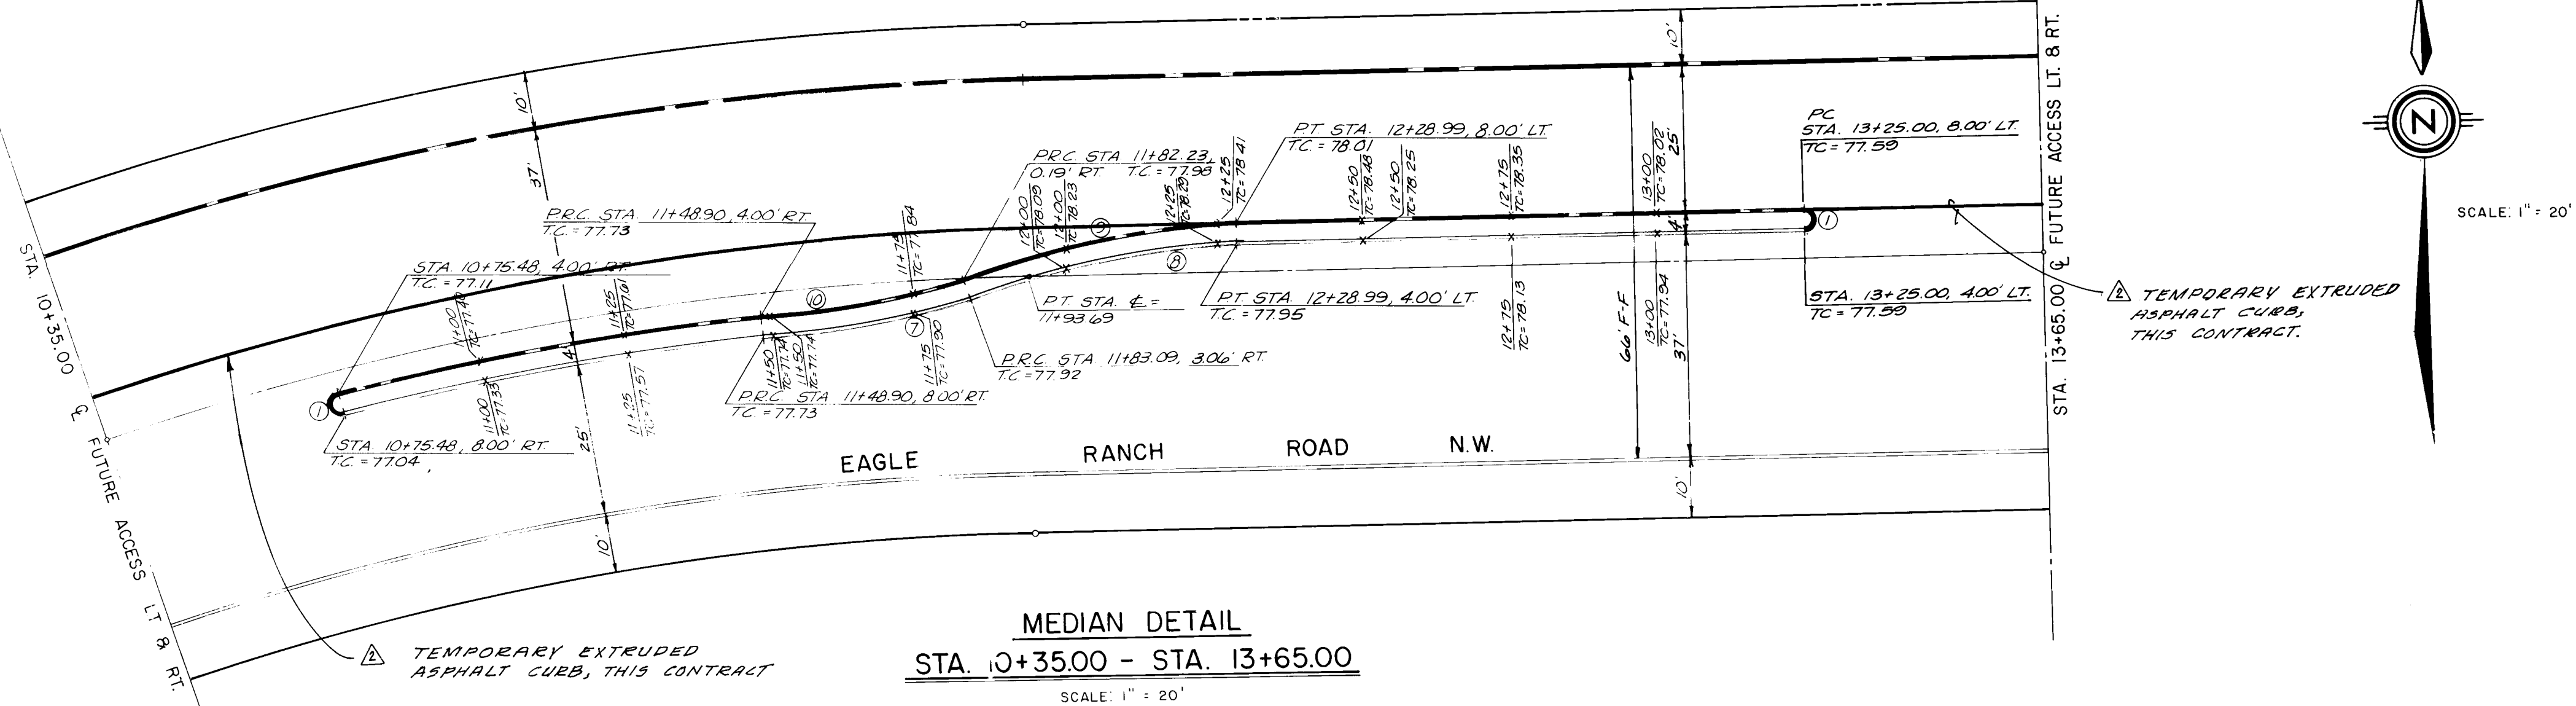

PERMANENT CURB AND GUTTER TO BE BUILT THIS CONTRACT.

TEMPORARY EXTRUDED ASPHALT CURB, THIS CONTRACT.

RECORD DRAWINGS

THESE DRAWINGS HAVE BEEN REVISED IN ACCORDANCE WITH INFORMATION PROVIDED BY COMMUNITY SCIENCES CORP., HUGG SURVEYING CO. AND EASTERLING & ASSOCIATES, INC. TO REFLECT THE CONSTRUCTION AS ACCOMPLISHED.



CHANGE ORDER NO. 7


SHEETS 1,4,5,6,7,8,9,10,11

The above-mentioned sheets are temporary additions to the final plans for Eagle Ranch Road. They outline the paving plan for completing approximately one half of the road as directed by the owner. Upon completion of the entire road section, these sheets shall be replaced by the originals.

Note that no alterations were made to any permanent horizontal or vertical alignments. The only changes on these sheets involve temporary elimination of road section, curb and gutter and temporary construction of asphalt pavement and curb, which were drawn by Easterling & Associates, Inc., February, 1986.


community sciences corporation

CITY OF ALBUQUERQUE MUNICIPAL DEVELOPMENT DEPARTMENT ENGINEERING DIVISION				
TITLE: EAGLE RANCH RD, N.W. AT EAGLE RANCH MEDIAN DETAILS				
STA. 5+71.04-10+35.00 & STA. 10+35.00-13+65.00				
APPROVALS	ENGINEER	DATE	APPROVALS	ENGINEER
City Engineer	<i>[Signature]</i>	7/1/85	Traffic	<i>[Signature]</i>
A.C.E. - Design	<i>[Signature]</i>	7/1/85	Water Resources	<i>[Signature]</i>
Hydrology	<i>[Signature]</i>	7/1/85		
N.M. Utilities				
DRAWING NO.	2440	MAP NO.	C-13	SHEET 8 OF 16

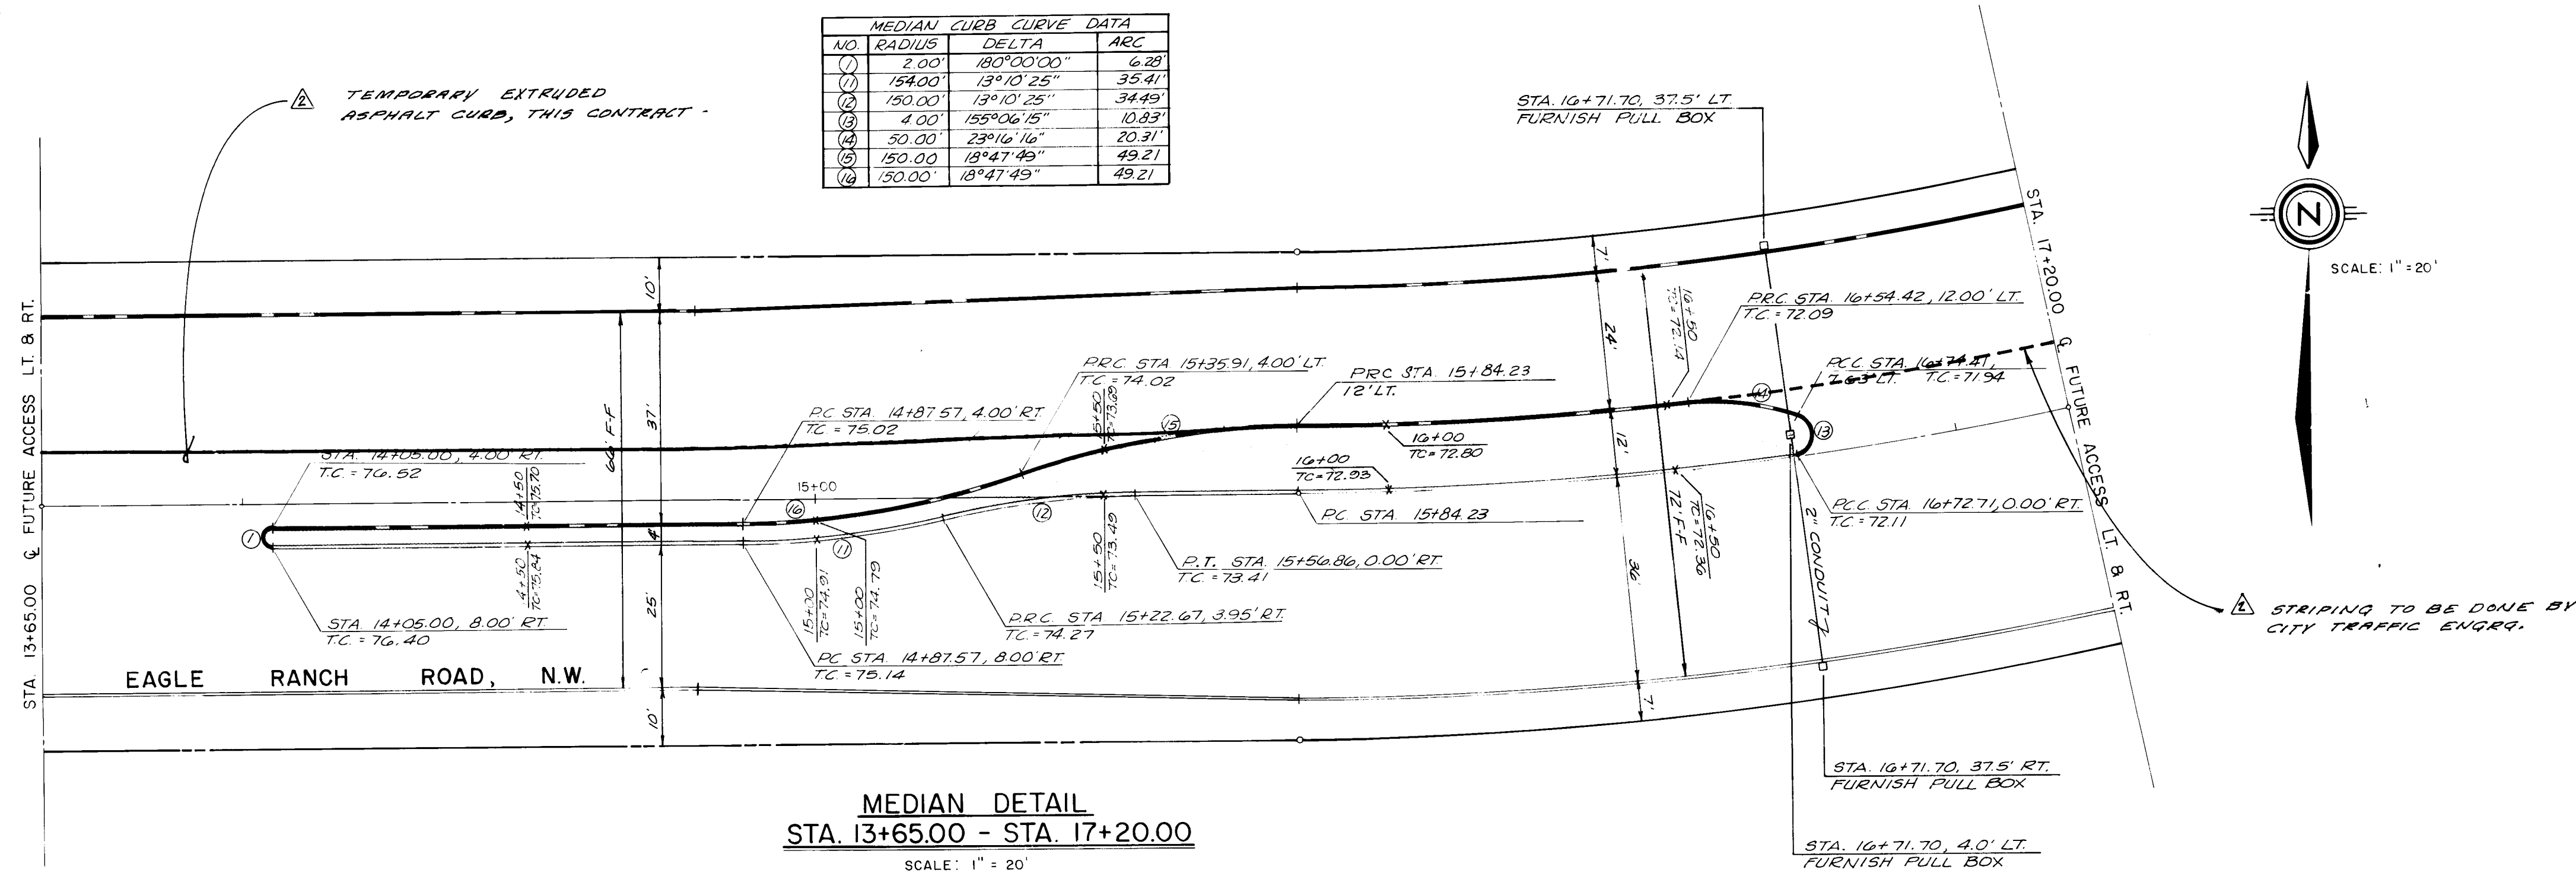


MEDIAN DETAIL
STA. 13+65.00 - STA. 17+20.00
SCALE: 1" = 20'

NO.	RADIUS	DELTA	ARC
1	2.00	180°00'00"	6.28
2	154.00	13°10'25"	35.41
3	150.00	13°10'25"	34.49
4	4.00	185°06'15"	10.33
5	50.00	23°16'16"	20.31
6	150.00	18°47'48"	49.21
7	150.00	18°47'48"	49.21

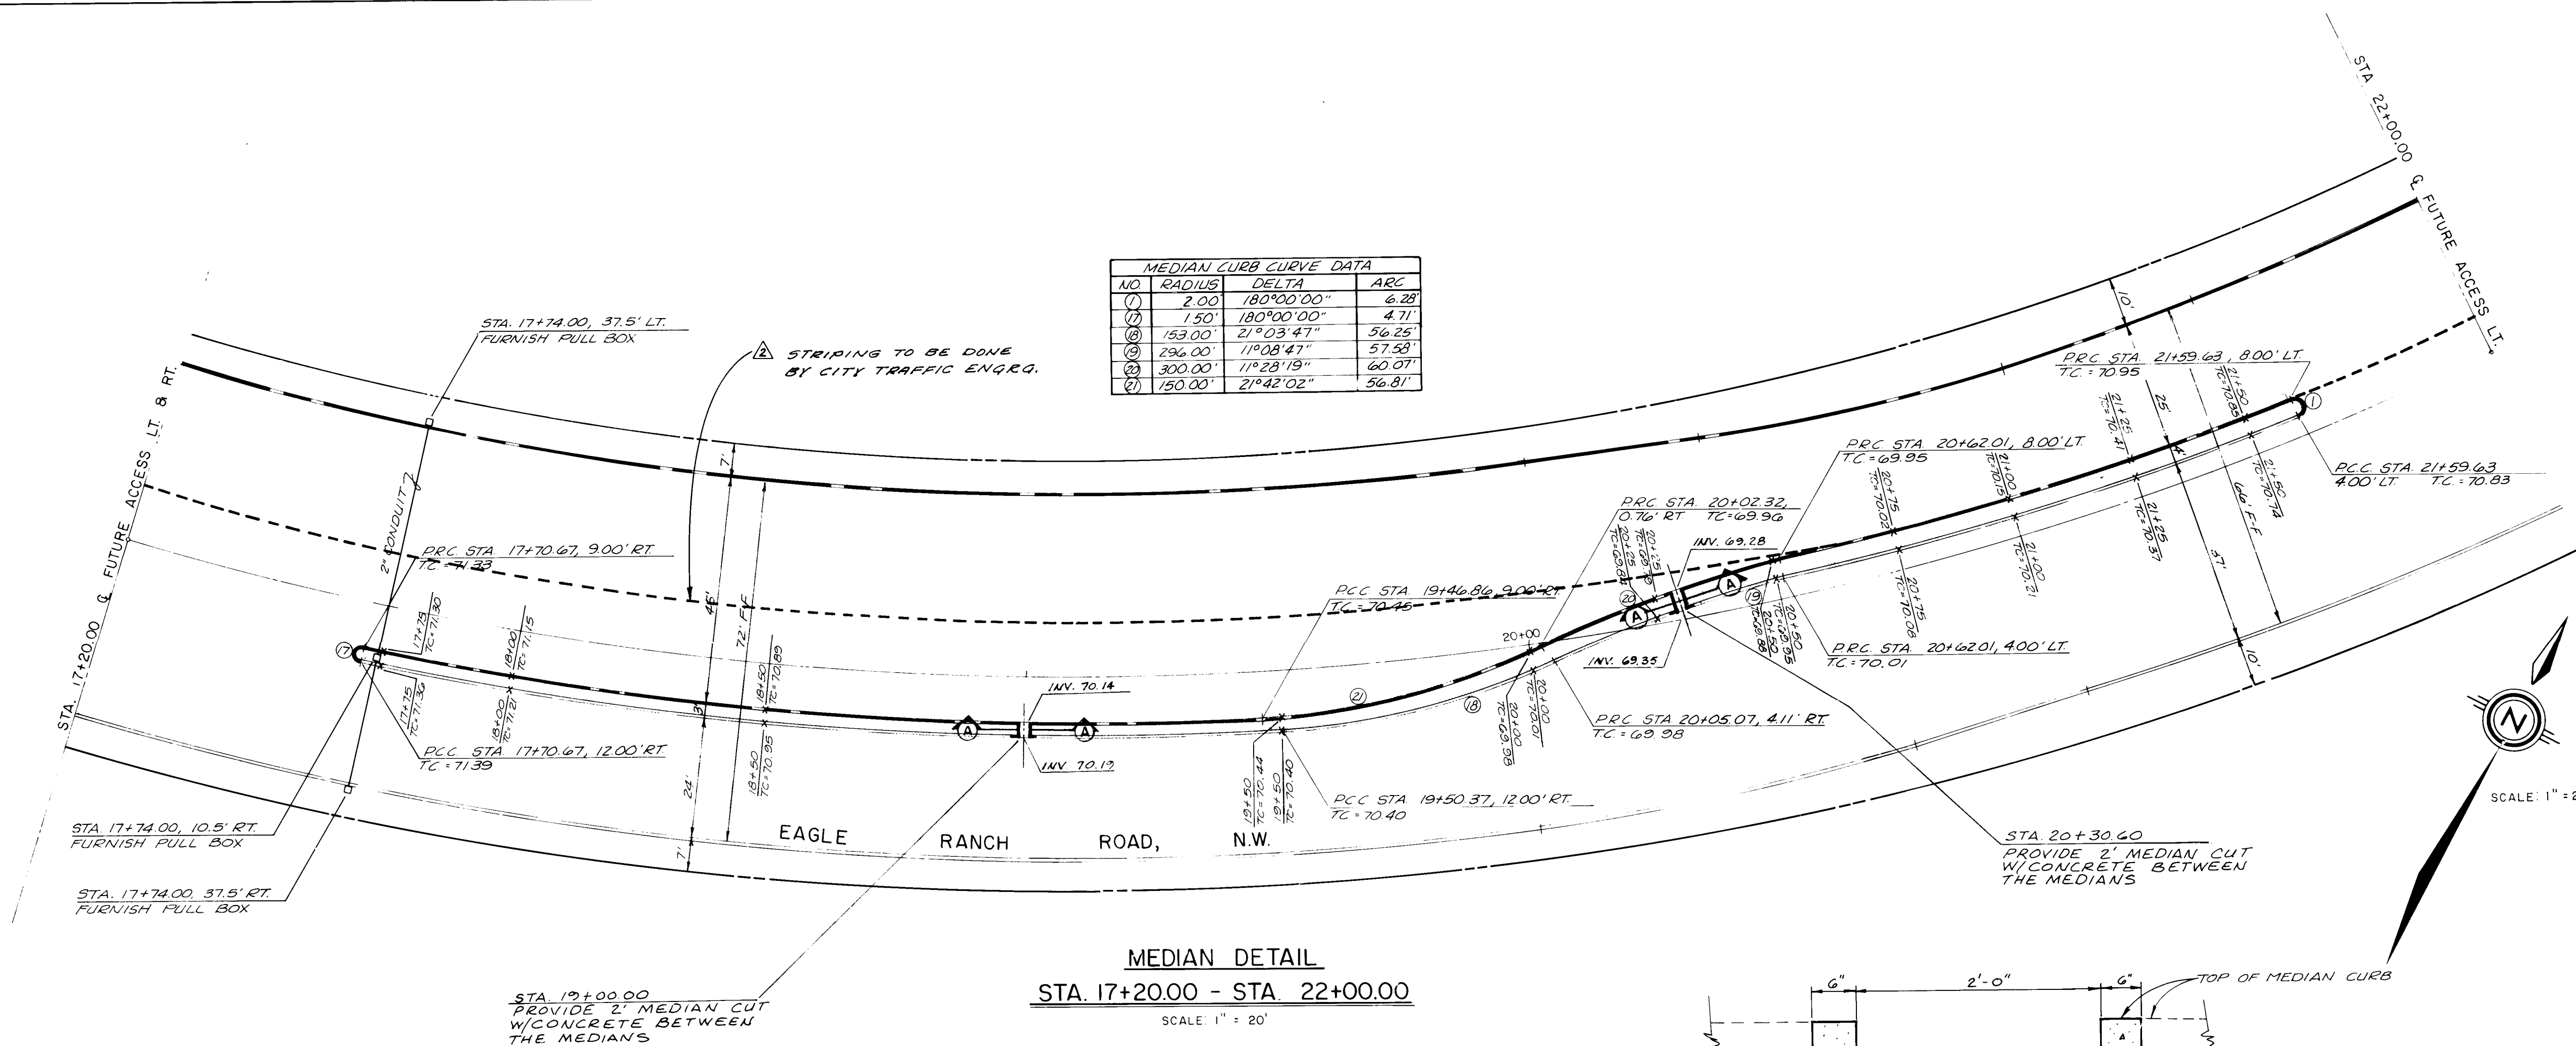

MEDIAN DETAIL
STA. 17+20.00 - STA. 22+00.00
SCALE: 1" = 20'

NO.	RADIUS	DELTA	ARC
1	2.00	180°00'00"	6.28
2	150	180°00'00"	4.71
3	153.00	21°23'41"	56.25
4	296.00	11°08'41"	57.99
5	300.00	11°28'19"	60.01
6	150.00	21°42'02"	56.81

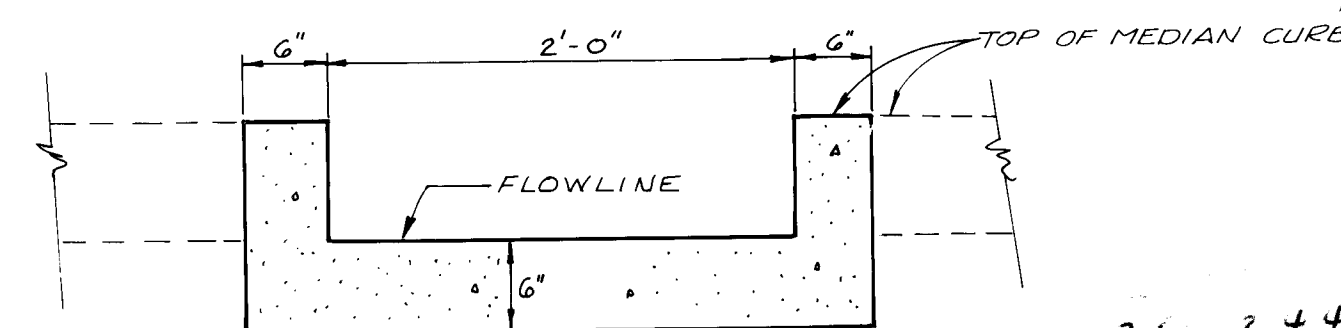


PERMANENT CURB AND GUTTER TO BE BUILT, THIS CONTRACT.

TEMPORARY EXTRUDED ASPHALT CURB, THIS CONTRACT.

RECORD DRAWINGS

THESE DRAWINGS HAVE BEEN REVISED IN ACCORDANCE WITH INFORMATION PROVIDED BY COMMUNITY SCIENCES CORP., HUGG SURVEYING CO. AND EASTERLING & ASSOCIATES, INC. TO REFLECT THE CONSTRUCTION AS ACCOMPLISHED.

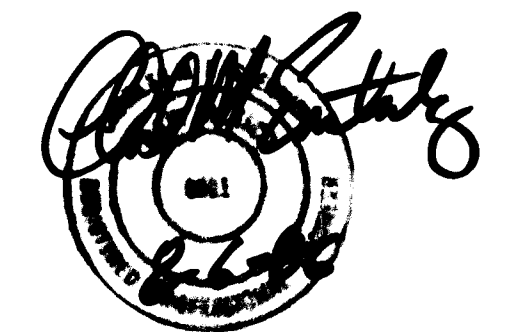

CHANGE ORDER NO. 7
SHEETS 1,4,5,6,7,8,9,10,11

The above-mentioned sheets are temporary additions to the final plans for Eagle Ranch Road. They outline the paving plan for completing approximately one half of the road as directed by the owner. Upon completion of the entire road section, these sheets shall be replaced by the originals.

Note that no alterations were made to any permanent horizontal or vertical alignments. The only changes on these sheets involve temporary elimination of road section, curb and gutter and temporary construction of asphalt pavement and curb, which were drawn by Easterling & Associates, Inc., February, 1986.



CITY OF ALBUQUERQUE
MUNICIPAL DEVELOPMENT DEPARTMENT
ENGINEERING DIVISION

TITLE: EAGLE RANCH RD, N.W. AT EAGLE RANCH
MEDIAN DETAILS
STA. 13+65.00 - 17+20.00 & STA. 17+20.00 - 22+00.00

APPROVALS	ENGINEER	DATE	APPROVALS	ENGINEER	DATE
City Engineer	<i>[Signature]</i>	2/1/86	Traffic	<i>[Signature]</i>	2/1/86
A.C.E. Design	<i>[Signature]</i>	2/1/86	Water Resources	<i>[Signature]</i>	2/1/86
Hydrology	<i>[Signature]</i>	2/1/86			
N.M. Utilities					

DRAWING NO. 2440 MAP NO. C-13 SHEET 9 OF 16

NO.	RADIUS	DELTA	ARC
1	150'	180°00'00"	4.71'
2	597.00'	15°11'09"	158.23'
3	153.00'	15°29'21"	42.70'
4	150.00'	09°30'47"	24.91'
5	4.00'	153°02'15"	10.68'
6	50.00'	26°57'45"	23.53'
7	300.00'	14°24'54"	75.46'
8	150.00'	20°53'28"	54.63'
9	594.00'	15°11'09"	157.44'
10	178.00'	28°12'54"	334.27'
11	3.00'	155°24'45"	31.4'
12	10.00'	36°03'31"	16.77'
13	179.57'	03°47'34"	60.78'
14	819.57'	03°45'43"	50.08'
15	150'	160°35'16"	4.20'
16	627.00'	08°50'55"	96.83'


RECORD DRAWINGS

THESE DRAWINGS HAVE BEEN REVISED IN ACCORDANCE WITH INFORMATION PROVIDED BY COMMUNITY SCIENCES CORP. HUGG SURVEYING CO. AND EASTERLING & ASSOCIATES, INC. TO REFLECT THE CONSTRUCTION AS ACCOMPLISHED.

Easterling
8-6-86

BASELINE "A" & CURVE DATA
R=585.00'
L=221.17'
Δ=21°39'43"

BASELINE "B" & CURVE DATA
R=674.08'
L=359.29'
Δ=45°12'22"

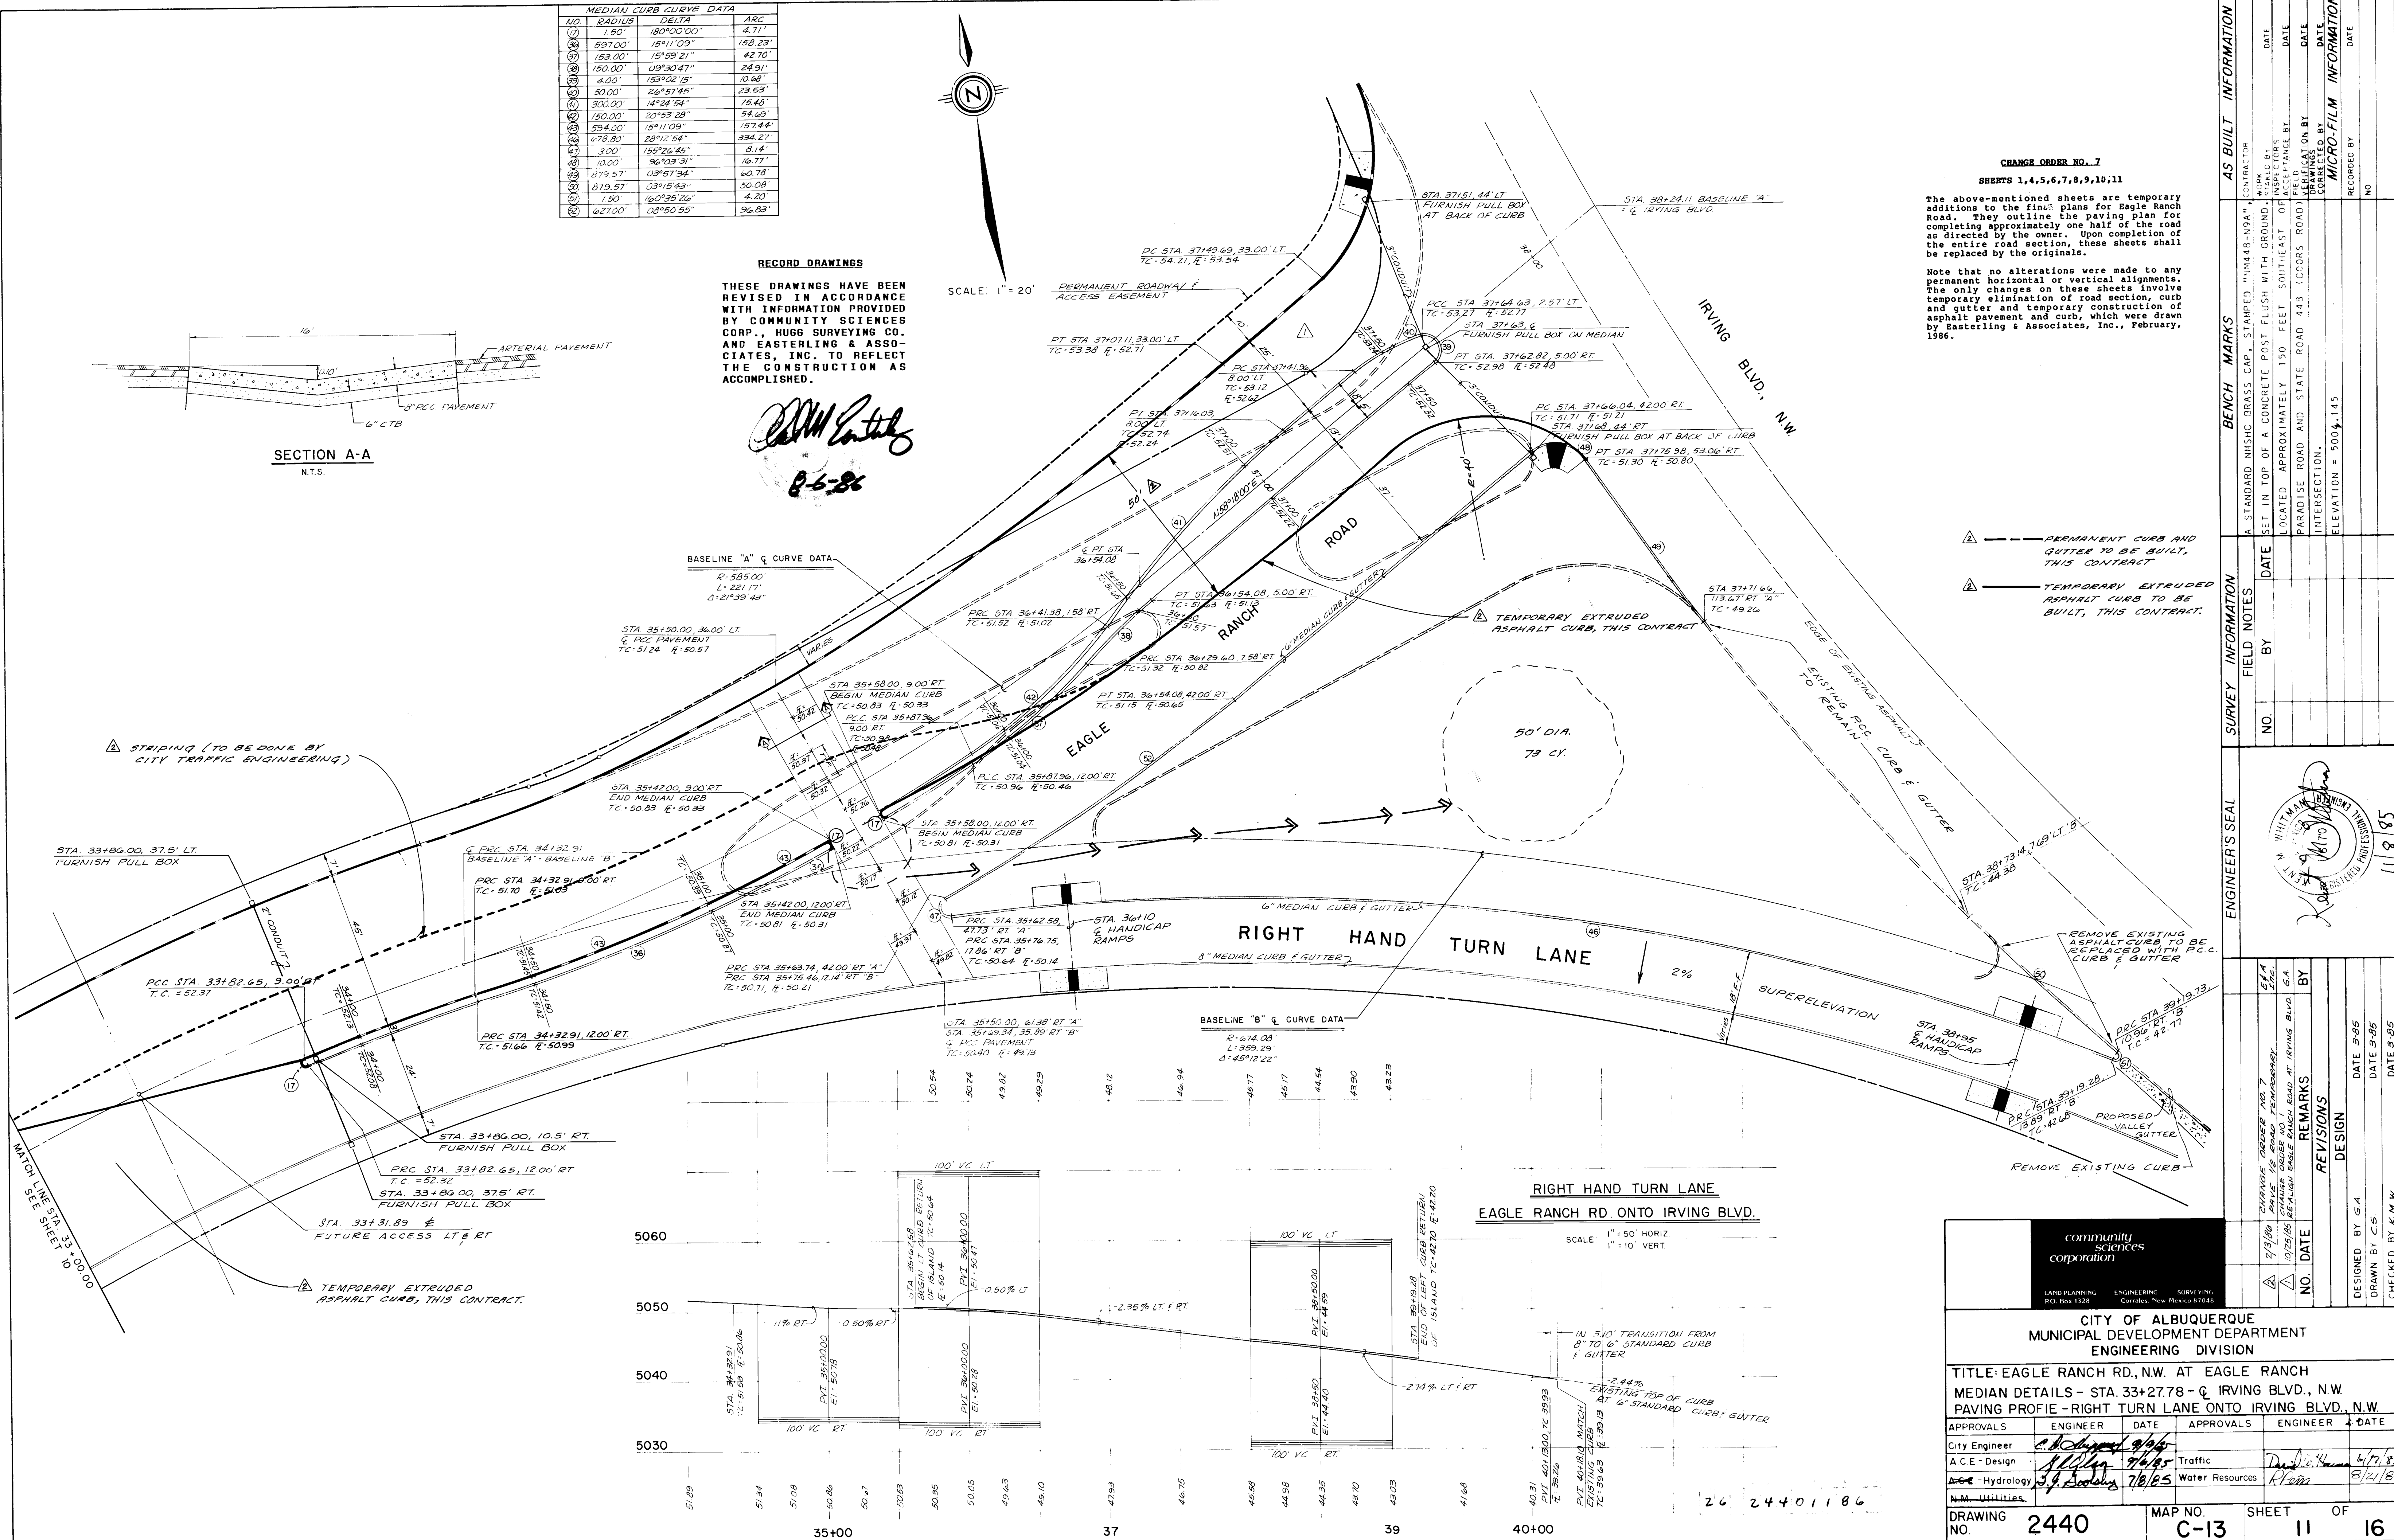

CHANGE ORDER NO. 7 SHEETS 1,4,5,6,7,8,9,10,11

The above-mentioned sheets are temporary additions to the final plans for Eagle Ranch Road. They outline the paving plan for completing approximately one half of the road as directed by the owner. Upon completion of the entire road section, these sheets shall be replaced by the originals.



Note that no alterations were made to any permanent horizontal or vertical alignments. The only changes on these sheets involve temporary elimination of road section, curb and gutter and temporary construction of asphalt pavement and curb, which were drawn by Easterling & Associates, Inc., February, 1986.

- PERMANENT CURB AND GUTTER TO BE BUILT, THIS CONTRACT
- TEMPORARY EXTRUDED ASPHALT CURB TO BE BUILT, THIS CONTRACT

AS BUILT INFORMATION		BENCH MARKS		SURVEY INFORMATION		ENGINEER'S SEAL		REVISIONS		DESIGN	
CONTRACTOR	DATE	CONTRACTOR	DATE	NO.	BY	NO.	BY	NO.	DATE	NO.	DATE
SET IN TOP OF A CONCRETE POST FLUSH WITH GROUND, LOCATED APPROXIMATELY 150 FEET SOUTHEAST OF PARADISE ROAD AND STATE ROAD 443 (COORS ROAD) INTERSECTION.	DATE	CONTRACTOR	DATE	NO.	BY	NO.	BY	NO.	DATE	NO.	DATE
ELEVATION = 5008.145	DATE	CONTRACTOR	DATE	NO.	BY	NO.	BY	NO.	DATE	NO.	DATE
DESIGNED BY G.A. DATE 3-85 DRAWN BY C.S. DATE 3-85 CHECKED BY K.M.W. DATE 3-85											
CITY OF ALBUQUERQUE MUNICIPAL DEVELOPMENT DEPARTMENT ENGINEERING DIVISION TITLE: EAGLE RANCH RD., N.W. AT EAGLE RANCH MEDIAN DETAILS - STA. 33+27.78 - & IRVING BLVD., N.W. PAVING PROFILE - RIGHT TURN LANE ONTO IRVING BLVD., N.W.											
APPROVALS	ENGINEER	DATE	APPROVALS	ENGINEER	DATE						
City Engineer	<i>[Signature]</i>	7/6/85	Traffic	<i>[Signature]</i>	4/7/85						
A.C.E. Design	<i>[Signature]</i>	7/6/85	Water Resources	<i>[Signature]</i>	8/21/85						
N.M. Utilities	<i>[Signature]</i>	7/6/85									
DRAWING NO.	2440	MAP NO.	C-13	SHEET	11	OF	16				

GENERAL NOTES-ALL UTILITY SHEETS

- 1) THE CONTRACTOR SHALL FURNISH ELDS ON ALL WATER AND SEWER SERVICE STUBS, CAPS AND PLUGS.
- 2) ALL STATIONING REFERS TO STREET CENTERLINE EXCEPT AT THE INTERSECTION OF EAGLE RANCH ROAD AND IRVING BOULEVARD.
- 3) CONTRACTOR SHALL FIELD VERIFY LOCATIONS AND ELEVATIONS OF ALL EXISTING 0000 AND UTILITIES PRIOR TO CONSTRUCTION.
- 4) ALL TEES, BENDS AND CAPS SHALL BE BLOCKED ACCORDING TO CITY OF ALBUQUERQUE STANDARDS.
- 5) ALL PIPE SHALL BE FURNISHED WITH CLASS "C" BEDDING UNLESS OTHERWISE NOTED.
- 6) WHERE GATE VALVES AND HYDRANTS ARE SHOWN AT INTERSECTIONS, THESE SHALL BE LOCATED OPPOSITE CURB RETURN INDICATED.
- 7) ALL ROADWAY AND TRENCH FILL SHALL BE COMPACTED TO A MINIMUM DENSITY OF 95% OF OPTIMUM (MODIFIED) A.S.T.M. - D1557
- 8) WATER PIPE SHALL BE P.V.C. CLASS 150 AWWA C900. SEWER SHALL BE P.V.C. CLASS SDR35.
- 9) ALL P.V.C. WATERMAIN FITTINGS SHALL BE "GRIP-TIGHT" PUSH-ON TYPE FITTINGS - AWWA APPROVED FOR P.V.C., C900 WATERMAIN.
- 10) ALL WATERLINES AND SANITARY SEWER LINES SHALL BECOME PROPERTY OF NEW MEXICO UTILITIES, INC.
- 11) CONTRACTOR SHALL SAWCUT AND REMOVE EXISTING ASPHALT PAVEMENT ON PARADISE BLVD. 6' TO EITHER SIDE OF PIPE. PAVEMENT SHALL BE REPLACED WITH TEMPORARY 2" A.C. HOT MIX, 1500#.
- 12) USE FLAGGERS AND WARNING SIGNS DURING PAVEMENT CUT ON IMPROVEMENTS ON PARADISE AND EAGLE RANCH ROAD AND ON IRVING BLVD. AND EAGLE RANCH ROAD INTERSECTIONS.
- 13) USE RESILIENT SEAT GATE VALVES.
- 14) TO OBTAIN THE DESIRED DEFLECTION PER JOINT FOR THE PVC WATER MAIN THE CONTRACTOR SHALL BEND THE PIPE THROUGHOUT THE 20 FOOT JOINT LENGTH NOT AT THE BELL AND SPIGOT. NO DEFLECTION SHALL BE ALLOWED AT THE GASKETED JOINT.

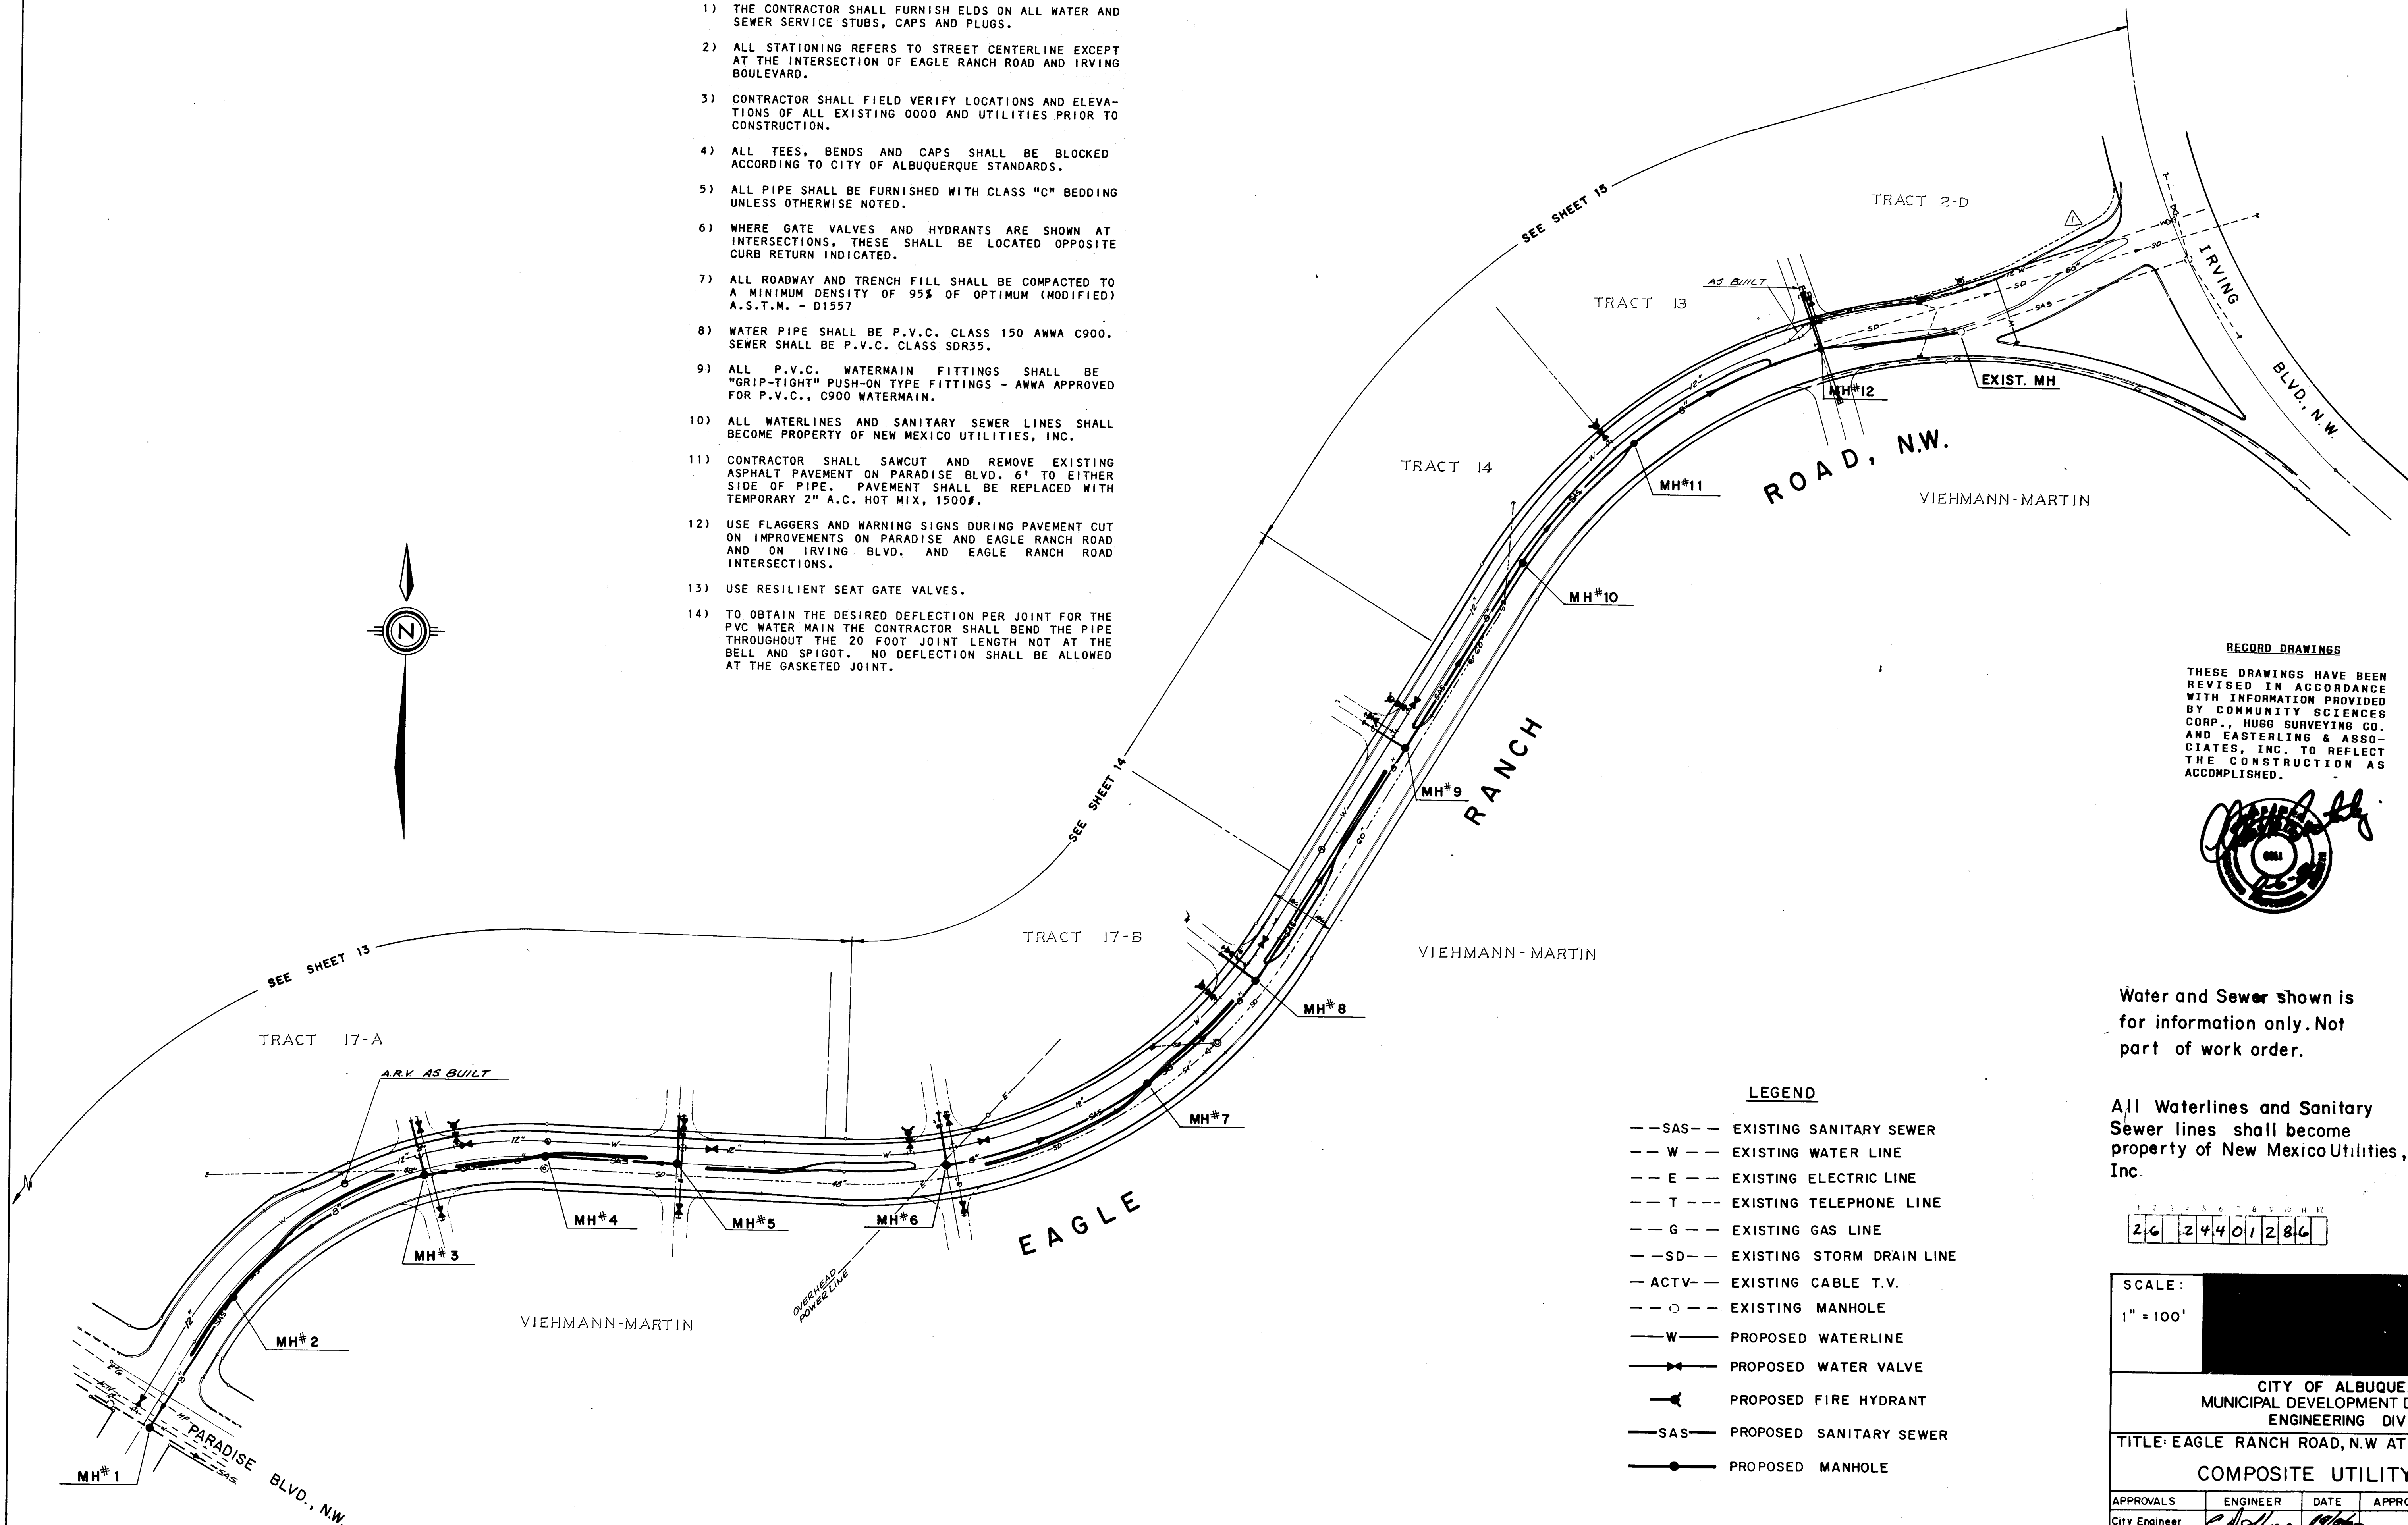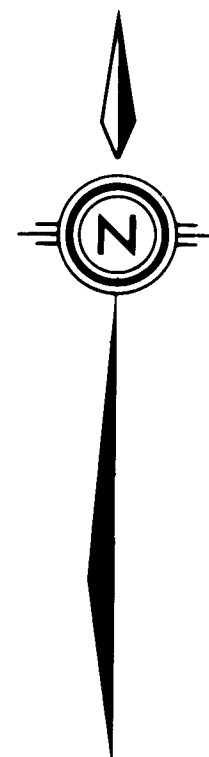


LEGEND

- SAS-- EXISTING SANITARY SEWER
- W-- EXISTING WATER LINE
- E-- EXISTING ELECTRIC LINE
- T-- EXISTING TELEPHONE LINE
- G-- EXISTING GAS LINE
- SD-- EXISTING STORM DRAIN LINE
- ACTV-- EXISTING CABLE T.V.
- O-- EXISTING MANHOLE
- W-- PROPOSED WATERLINE
- PROPOSED WATER VALVE
- PROPOSED FIRE HYDRANT
- SAS-- PROPOSED SANITARY SEWER
- PROPOSED MANHOLE

- SD--- PROPOSED STORM DRAIN (SEPARATE CONTRACT PROJECT 2204)
- O--- PROPOSED STORM DRAIN MANHOLE (SEPARATE CONTRACT - PROJECT 2204)

RECORD DRAWINGS

THESE DRAWINGS HAVE BEEN REVISED IN ACCORDANCE WITH INFORMATION PROVIDED BY COMMUNITY SCIENCES CORP., HUGG SURVEYING CO. AND EASTERLING & ASSOCIATES, INC. TO REFLECT THE CONSTRUCTION AS ACCOMPLISHED.

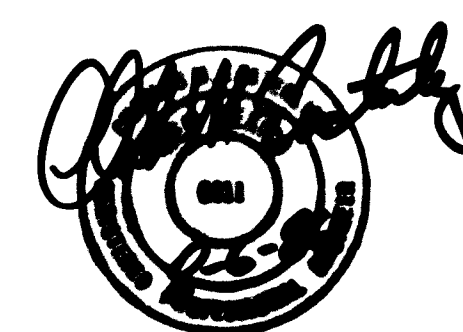


Water and Sewer shown is for information only. Not part of work order.

All Waterlines and Sanitary Sewer lines shall become property of New Mexico Utilities, Inc.


26 24401286

SCALE:
1" = 100'


CITY OF ALBUQUERQUE MUNICIPAL DEVELOPMENT DEPARTMENT ENGINEERING DIVISION					
TITLE: EAGLE RANCH ROAD, N.W. AT EAGLE RANCH					
COMPOSITE UTILITY PLAN					
APPROVALS	ENGINEER	DATE	APPROVALS	ENGINEER	DATE
City Engineer	<i>[Signature]</i>	11/18/85	Traffic	<i>[Signature]</i>	6/18/85
A.C.E. - Design	<i>[Signature]</i>	11/18/85	Water Resources	<i>[Signature]</i>	9/21/85
N.M. Utilities	<i>[Signature]</i>	11/18/85			
DRAWING NO.	2440	MAP NO.	C-13	SHEET	12 OF 16

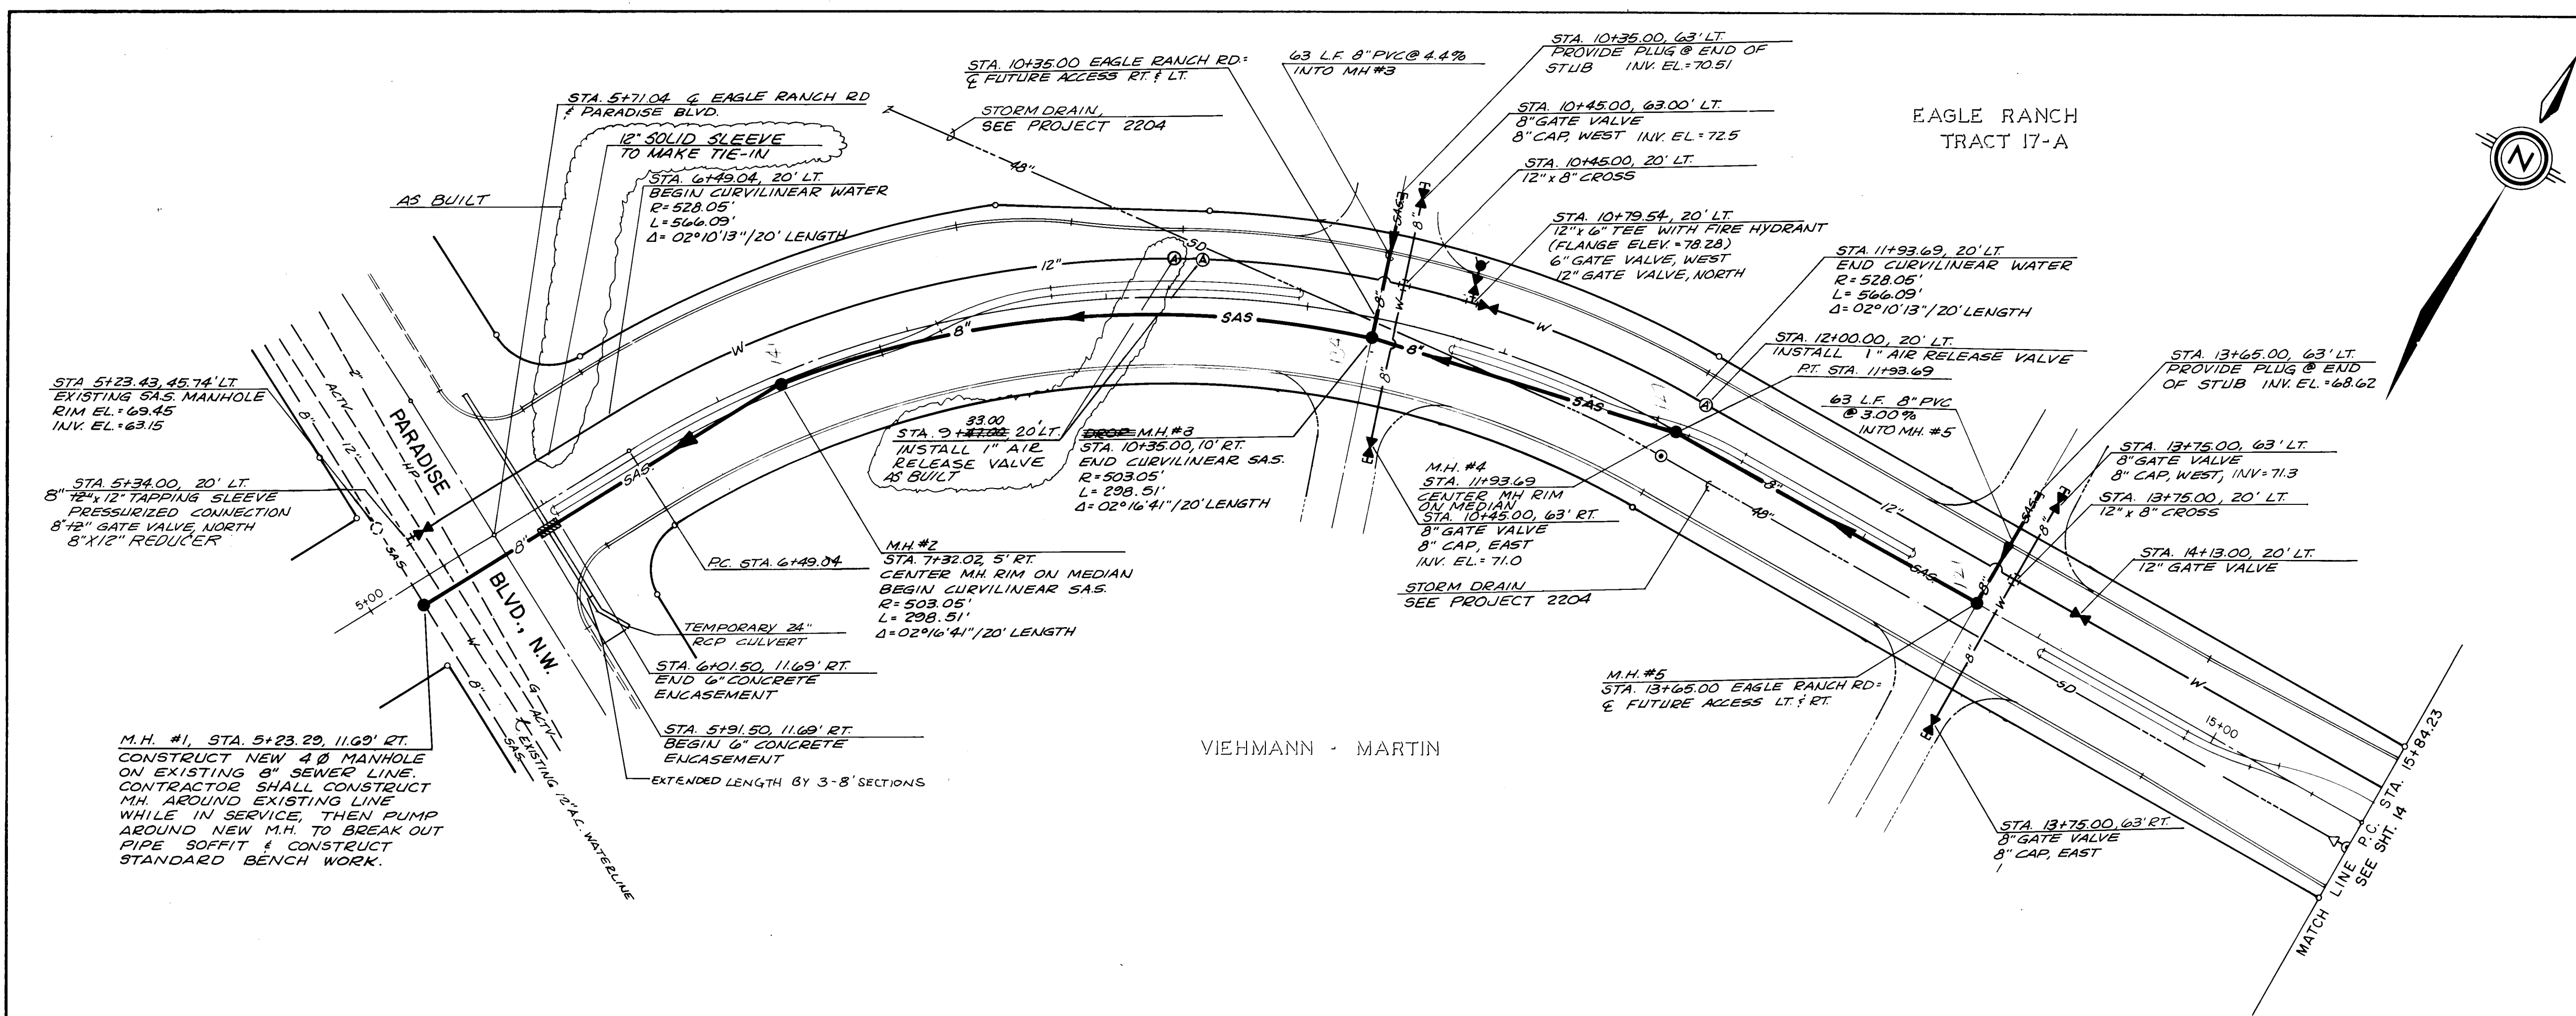

EAGLE RANCH ROAD, N.W.

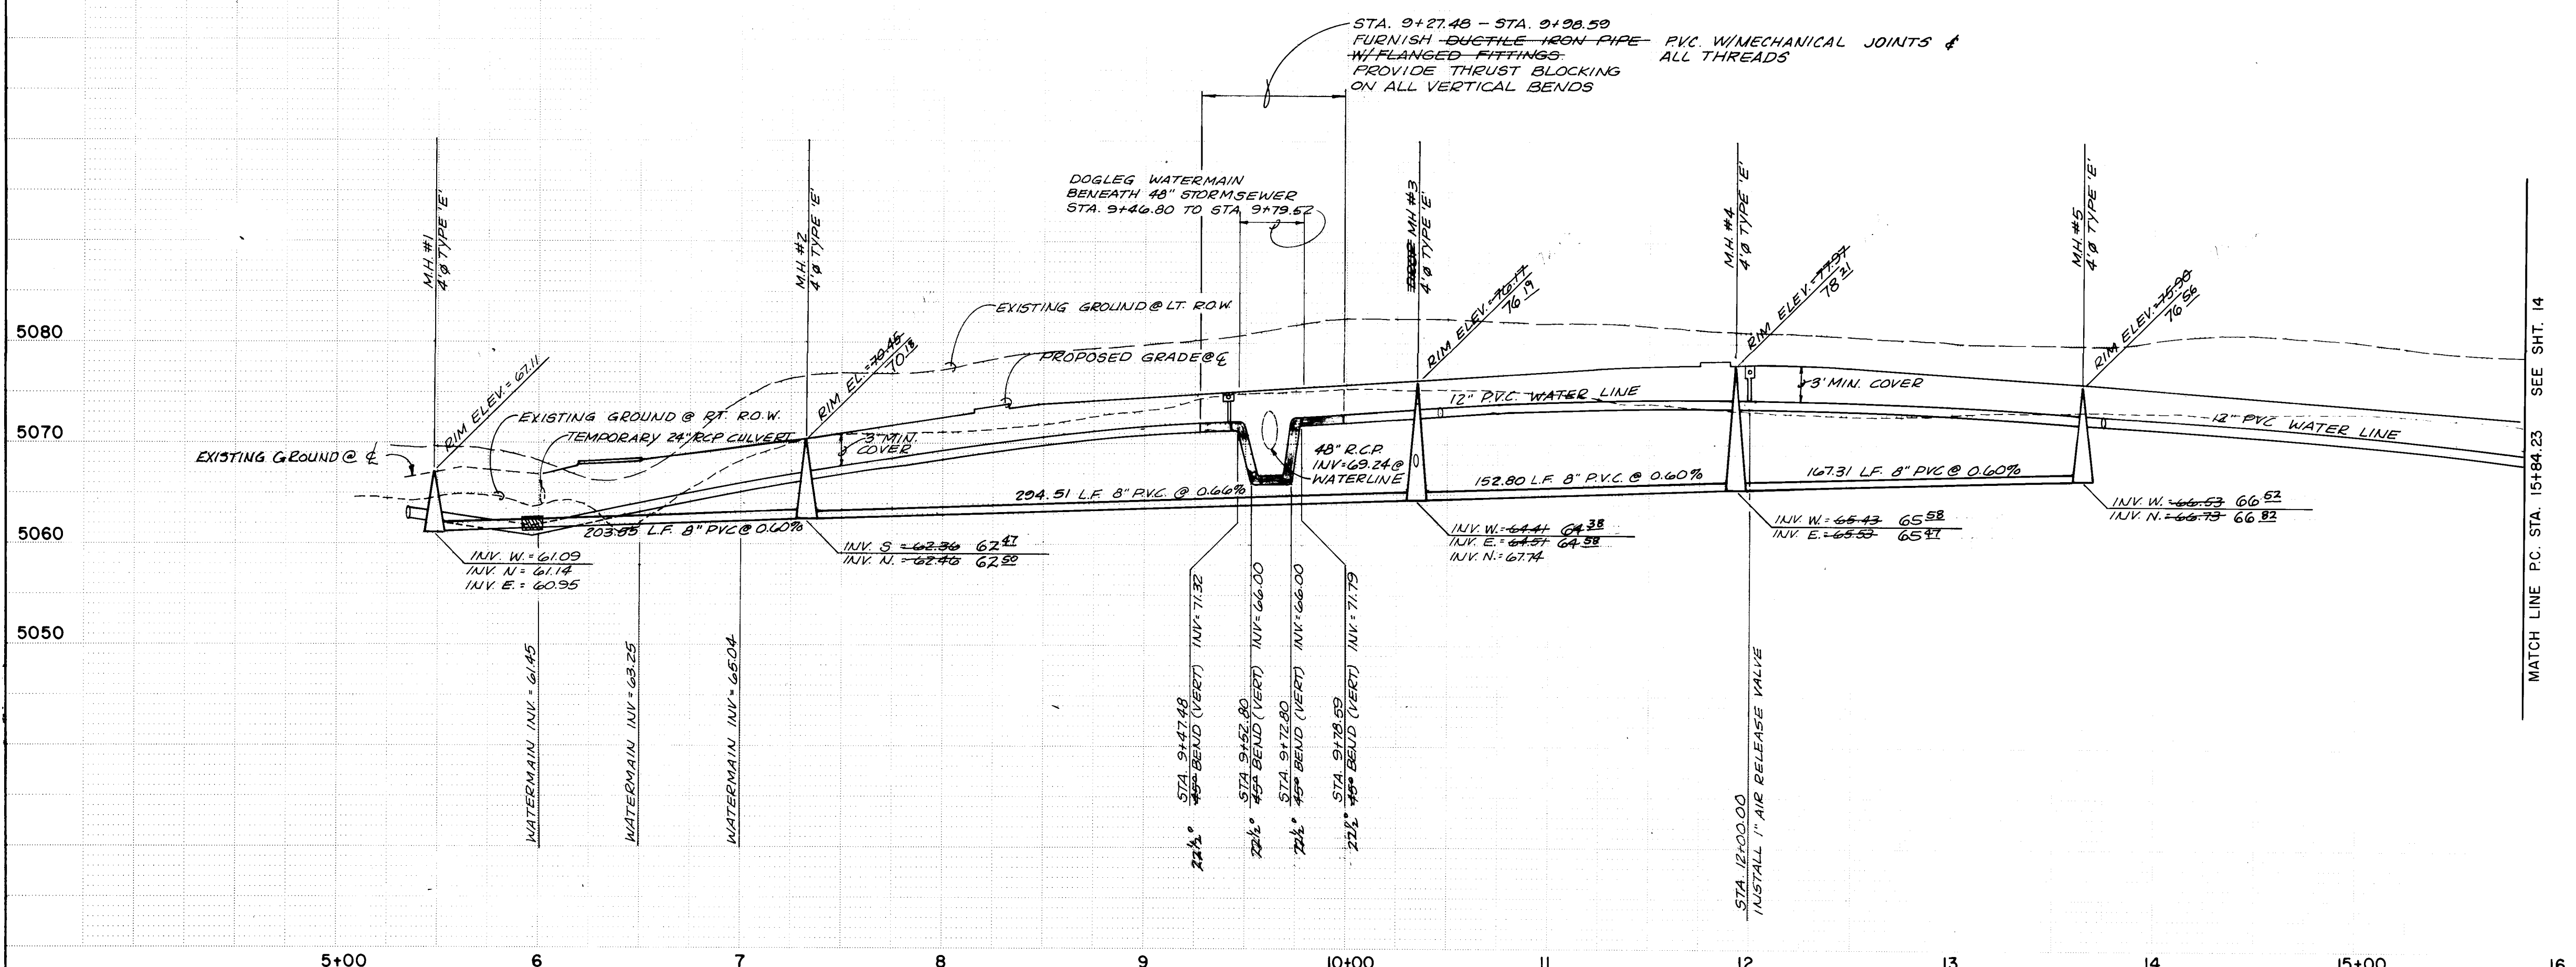

RECORD DRAWINGS
THESE DRAWINGS HAVE BEEN
REVISED IN ACCORDANCE
WITH INFORMATION PROVIDED
BY COMMUNITY SCIENCES
CORP., HUGG SURVEYING CO.
AND EASTERLING & ASSO-
CIATES, INC. TO REFLECT
THE CONSTRUCTION AS
ACCOMPLISHED.

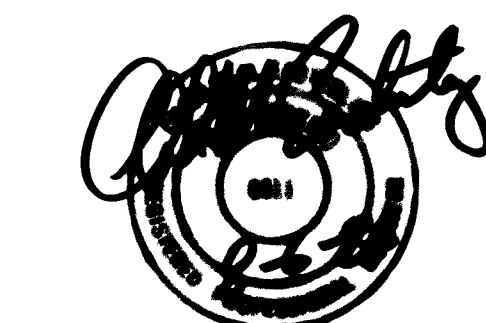



Water and Sewer shown is
for information only. Not
part of work order.

All Waterlines and Sanitary
Sewer lines shall become
property of New Mexico Utilities,
Inc.

26 2440 1386

SCALE:
1" = 50' HOR.
1" = 10' VERT.

CITY OF ALBUQUERQUE MUNICIPAL DEVELOPMENT DEPARTMENT ENGINEERING DIVISION					
TITLE: EAGLE RANCH RD., NW. AT EAGLE RANCH UTILITY PLAN & PROFILE EAGLE RANCH ROAD, N.W.					
APPROVALS	ENGINEER	DATE	APPROVALS	ENGINEER	DATE
City Engineer	<i>[Signature]</i>	9/16/85	Traffic	NA DW	6/17/85
ACE - Design	<i>[Signature]</i>	7/6/85	Water Resources	<i>[Signature]</i>	8/21/85
Hydrology	<i>[Signature]</i>	7/8/85			
N.M. Utilities	<i>[Signature]</i>	9/20/85			
DRAWING NO.	2440	MAP NO.	C-13	SHEET	13 OF 16

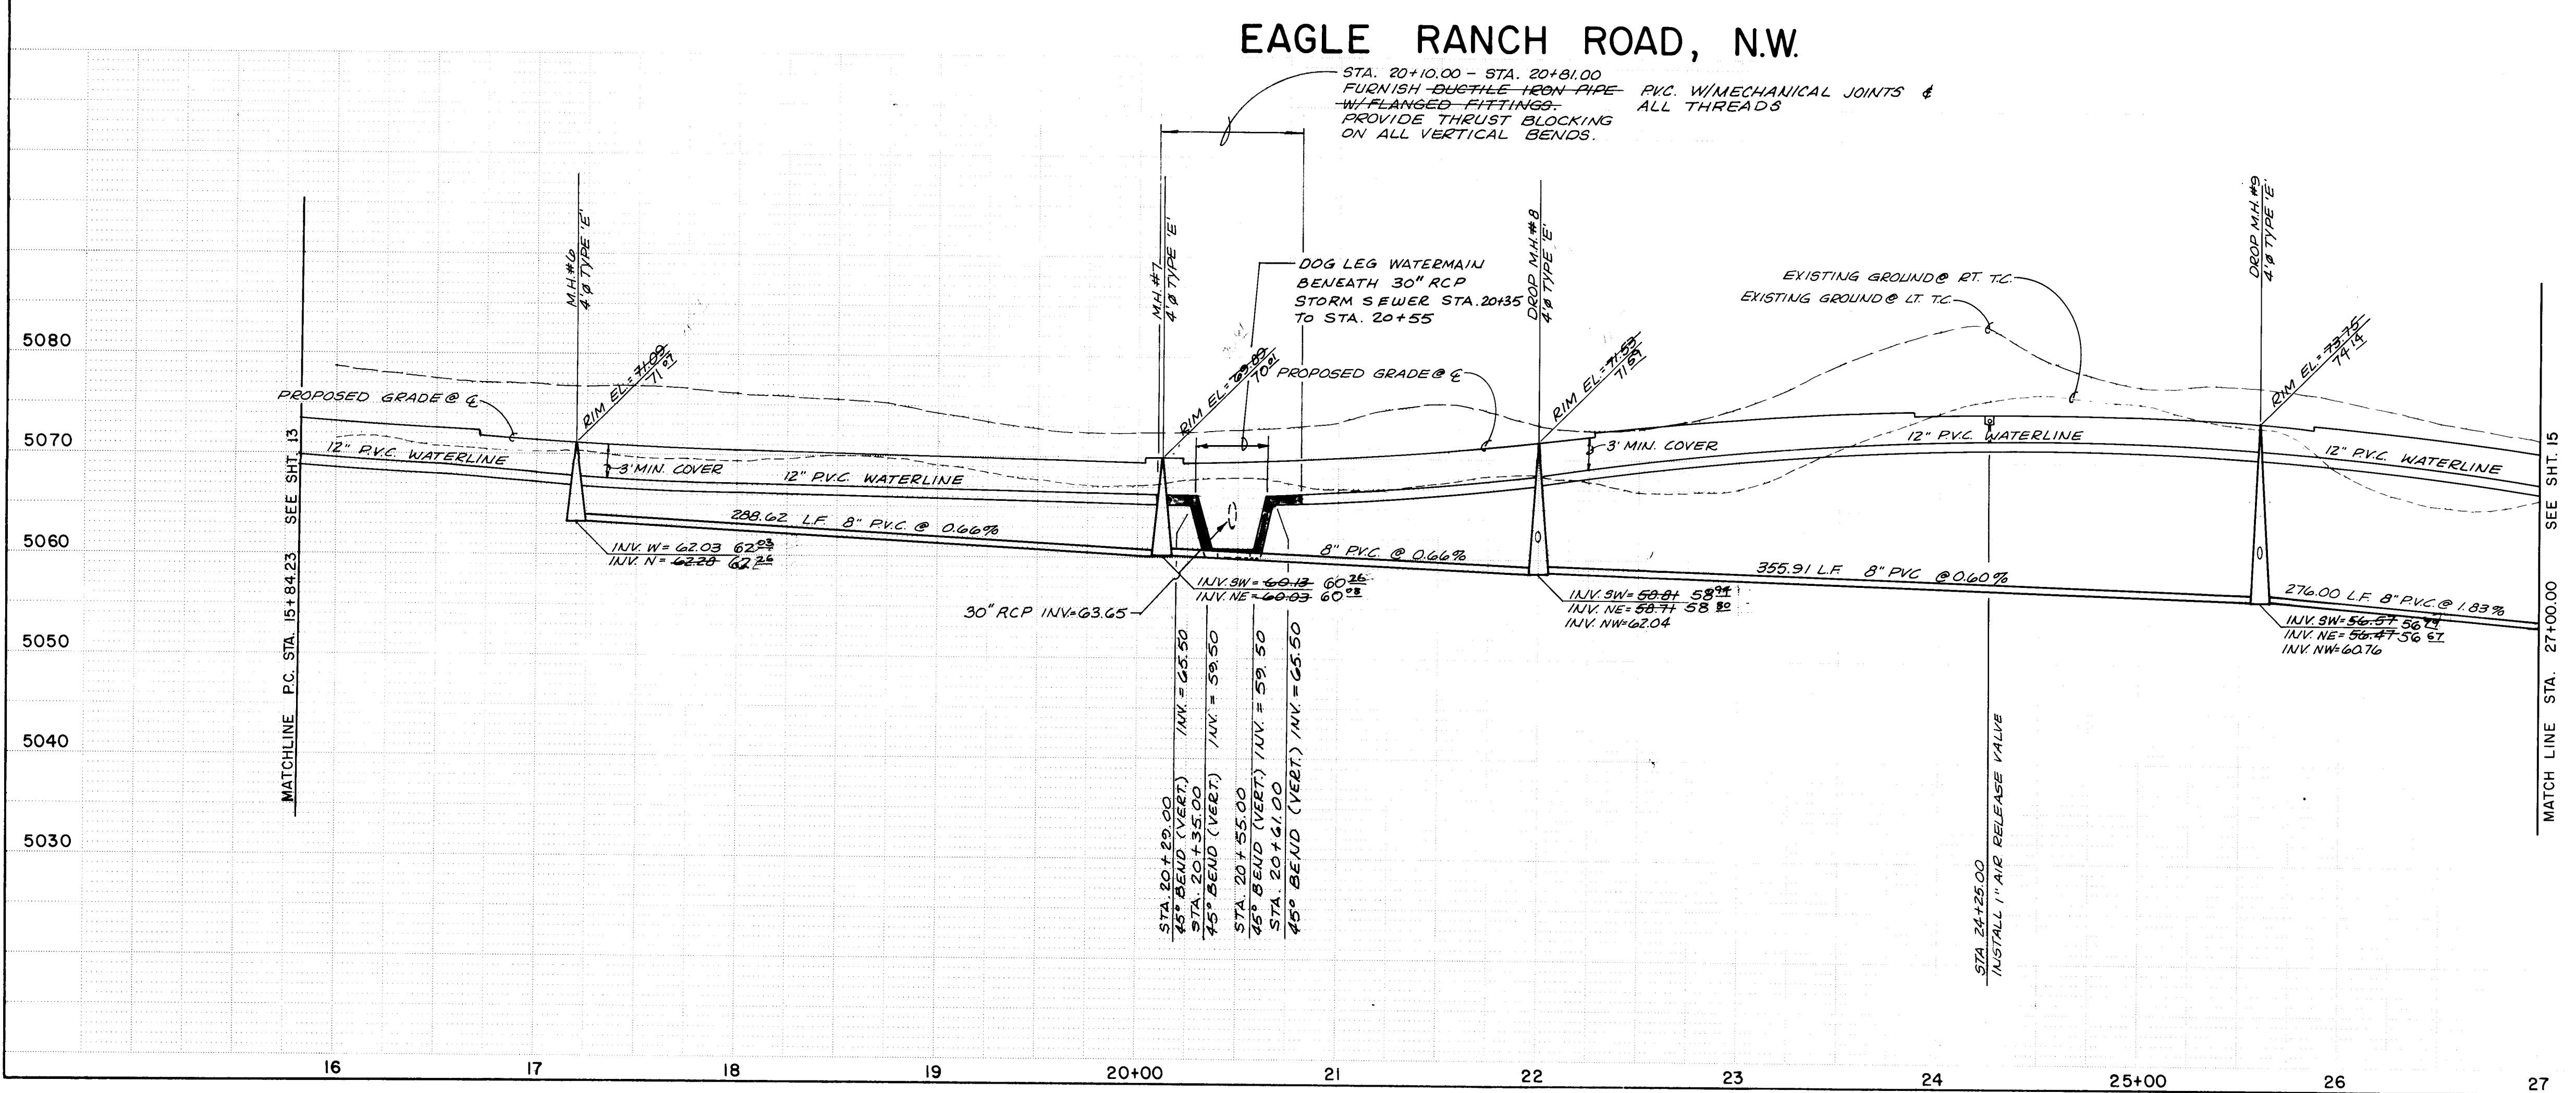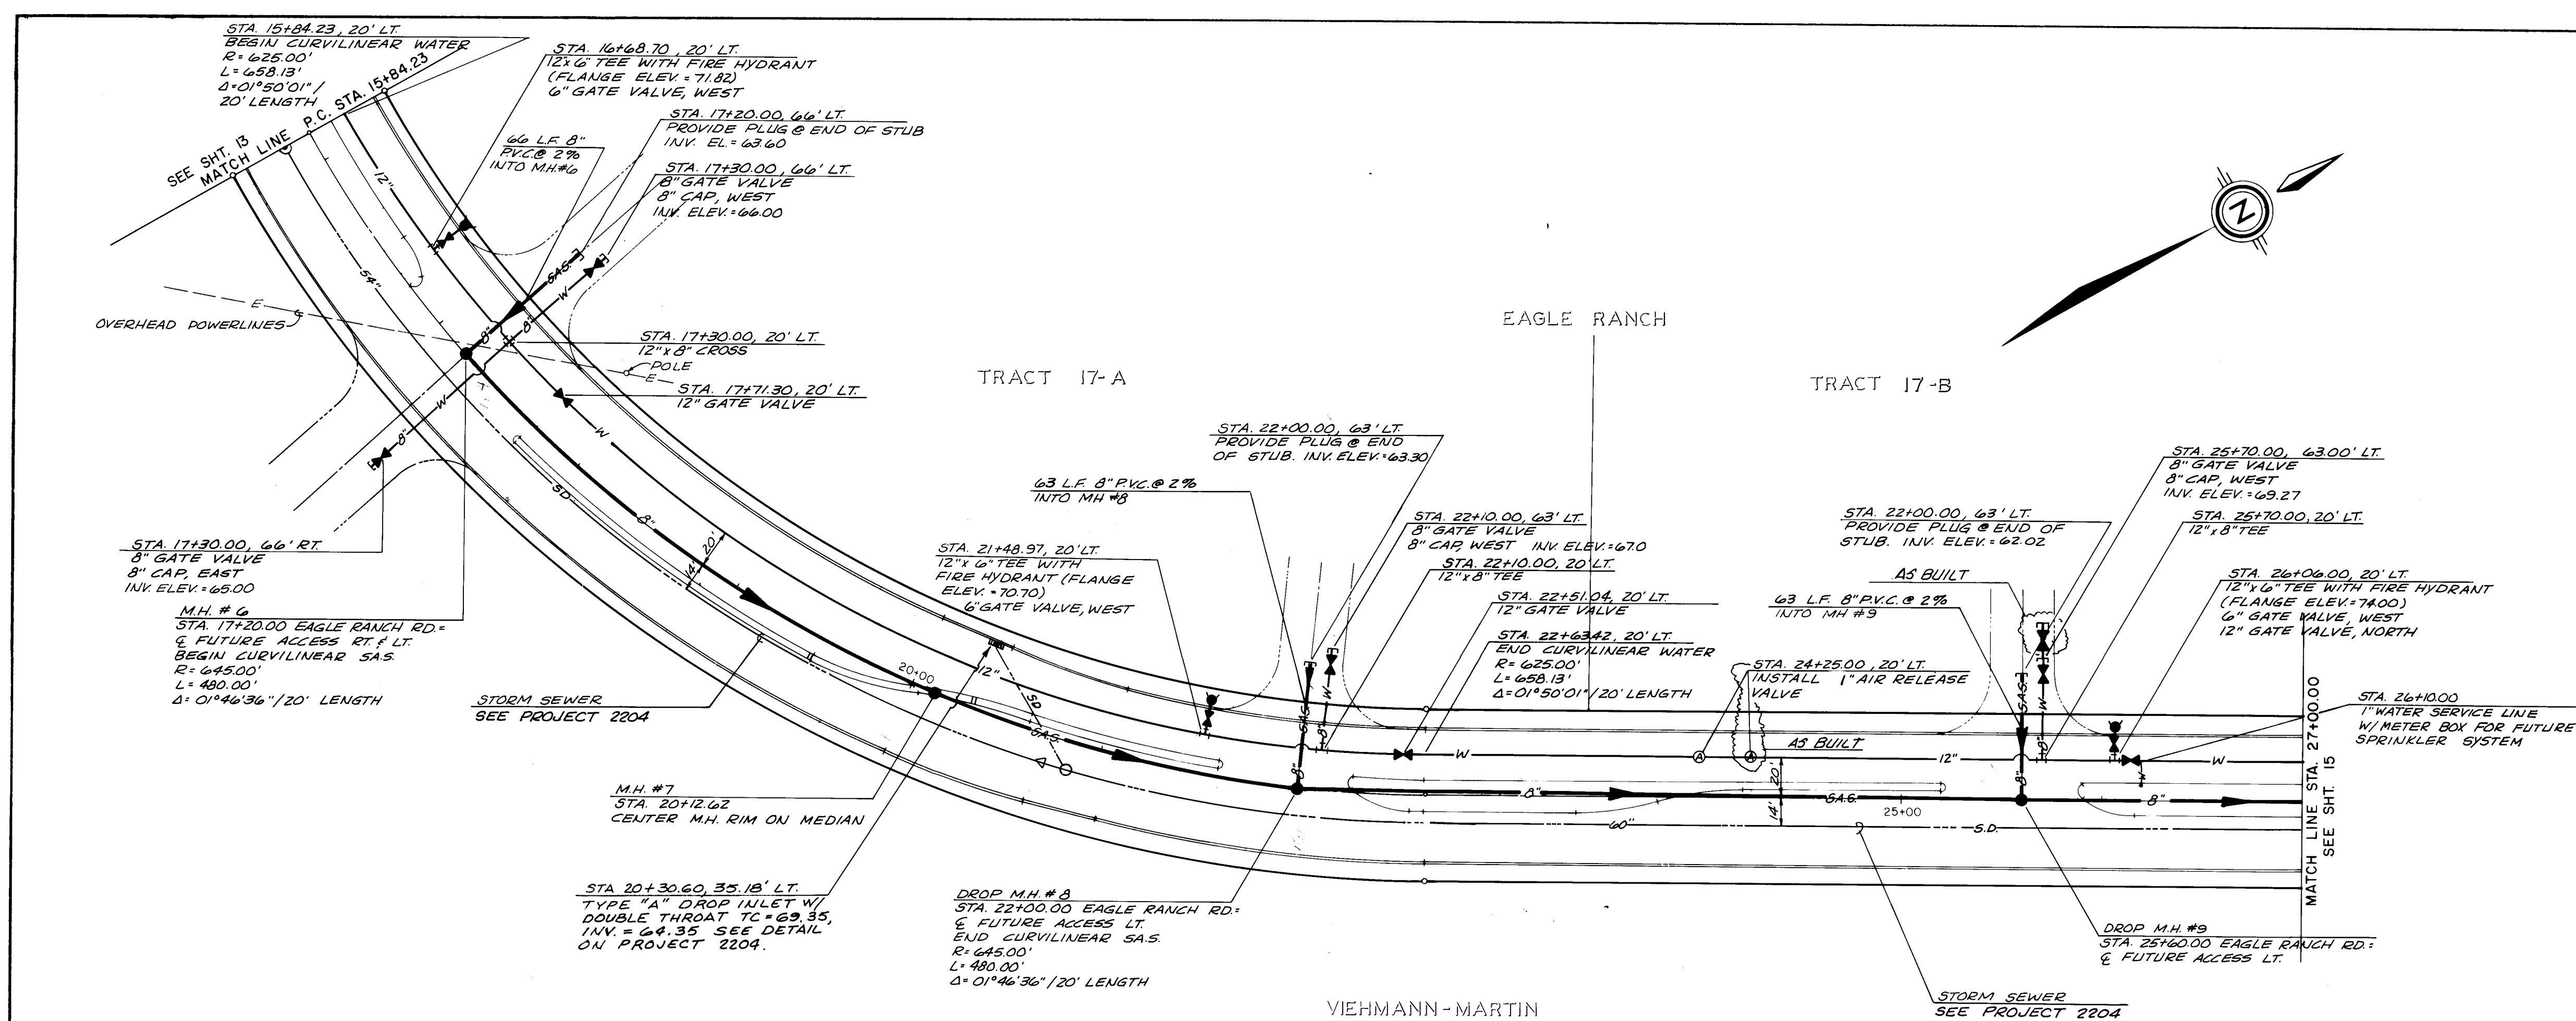

RECORD DRAWINGS
THESE DRAWINGS HAVE BEEN
REVISED IN ACCORDANCE
WITH INFORMATION PROVIDED
BY COMMUNITY SCIENCES
CORP., HUGG SURVEYING CO.
AND EASTERLING & ASSO-
CIATES, INC. TO REFLECT
THE CONSTRUCTION AS
ACCOMPLISHED.



Water and Sewer shown is
for information only. Not
part of work order.

All Waterline and Sanitary
Sewer shall become property of
New Mexico Utilities, Inc.

26 24 40 14 86

SCALE:
1" = 50' HOR.
1" = 10' VERT.


CITY OF ALBUQUERQUE MUNICIPAL DEVELOPMENT DEPARTMENT ENGINEERING DIVISION					
TITLE: EAGLE RANCH RD., NW AT EAGLE RANCH UTILITY PLAN & PROFILE EAGLE RANCH ROAD, N.W.					
APPROVALS	ENGINEER	DATE	APPROVALS	ENGINEER	DATE
City Engineer	<i>[Signature]</i>	9/1/85	Traffic	<i>[Signature]</i>	6/1/85
A.C.E. Design	<i>[Signature]</i>	7/1/85	Water Resources	<i>[Signature]</i>	8/21/85
Hydrology	<i>[Signature]</i>	7/1/85			
N.M. Utility	<i>[Signature]</i>	5/20/85			
DRAWING NO.	2440	MAP NO.	C-13	SHEET OF	14 16

ENGINEER'S SEAL		SURVEY INFORMATION		BENCH MARKS		AS BUILT INFORMATION	
		FIELD NOTES					
		BY		DATE		DATE	
		NO.				CONTRACTOR	
						WORK ORDER NO.	
						INSPECTOR'S NAME	
						DATE	
						DATE	
RECORD DRAWINGS

THESE DRAWINGS HAVE BEEN
REVISED IN ACCORDANCE
WITH INFORMATION PROVIDED
BY COMMUNITY SCIENCES
CORP., HUGG SURVEYING CO.
AND EASTERLING & ASSO-
CIATES, INC. TO REFLECT
THE CONSTRUCTION AS
ACCOMPLISHED.

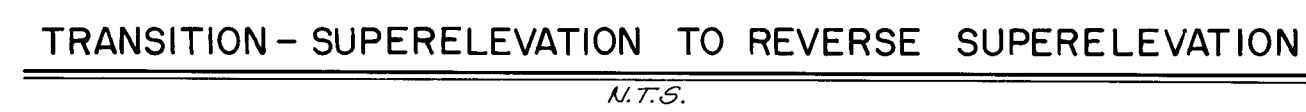

*K = MEAN PARTICLE SIZE
** AT LEAST 30% OF ALL STONES BY WEIGHT SHALL BE THIS DIMENSION.

GRADATION TYPE II	GRANULAR FILTER BLANKET
SIEVE SIZE	% PASSING BY WEIGHT
2"	90-100
3/4"	20-90
#4	0-20
#200	0-3

RIP RAP SPECIFICATIONS

ROCK PROPERTIES

ROCK PROPERTIES

ROCK USED FOR RIP SHALL BE HARD, DURABLE, ANGULAR IN SHAPE, AND BE FREE FROM CRACKS, OVERBURDEN, SHALE AND ORGANIC MATTER. NEITHER BREATH NOR THICKNESS OF A SINGLE STONE SHALL BE LESS THAN 1/8" AND SHALL SUSTAIN A LOSS OF NOT MORE THAN 40% AFTER 500 REVOLUTIONS ON AN ABRASION TEST (LOS ANGELES MACHINE - ASTM C-555-69) AND SHALL SUSTAIN A LOSS OF NOT MORE THAN 10% AFTER 12 CYCLES OF FREEZING AND THAWING (AASHTO TEST 103 FOR LEDGE ROCK PROCEDURE A). THE ROCK SHALL HAVE A MINIMUM SPECIFIC GRAVITY OF 2.65.

RIPRAP DESIGNATION	% SMALLER THAN GIVEN SIZE BY WEIGHT	MINIMUM DIMENSION INCHES	K _m INCHES
TYPE L	100 35-55 10	12** 9 2	9

RIP-RAP GRADUATION

26 24401686

community
sciences
corporation

LAND PLANNING ENGINEERING SURVEYING

CITY OF ALBUQUERQUE
MUNICIPAL DEVELOPMENT DEPARTMENT
ENGINEERING DIVISION

TITLE: EAGLE RANCH RD., N.W. AT EAGLE RANCH

DETAILS

APPROVALS	ENGINEER	DATE	APPROVALS	ENGINEER	DATE
City Engineer	<i>C. J. [Signature]</i>	<i>9/10/85</i>			
A.C.E. - Design	<i>A. C. [Signature]</i>	<i>9/6/85</i>	Traffic	<i>David [Signature]</i>	<i>4/17/85</i>
A.C.E. - Hydrology	<i>A. C. [Signature]</i>	<i>7/8/85</i>	Water Resources	<i>K. [Signature]</i>	<i>8/21/85</i>
N.M. Utilities	<i>John [Signature]</i>	<i>5/22/85</i>			
DRAWING NO.	2440	MAP NO.	C-13	SHEET	OF
				16	16

PRINT@ 9.0