


2444

STORM DRAINAGE IMPROVEMENTS

ACADEMY RD. WEST OF MARCHETA AVE.

INDEX

- SHEET 1 TITLE SHEET
- SHEET 2 PLAN AND PROFILE
- SHEET 3 DETAILS

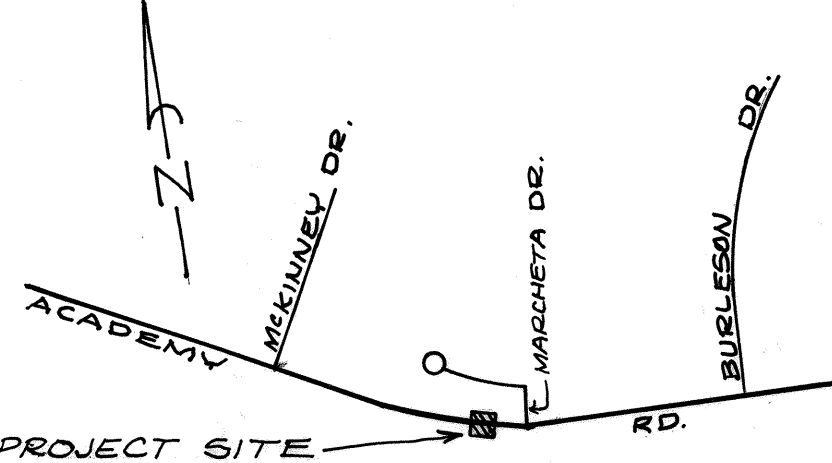

LOCATION MAP
ZONE MAP E-18 SCALE 1" = 800'

NOTICE TO CONTRACTORS

1. All work detailed on these plans to be performed under contract shall, except as otherwise stated or provided for hereon, be constructed in accordance with the City of Albuquerque Interim Standard Specifications For Public Works Construction 1985.
2. Two(2) working days prior to any excavation, the contractor must contact Line Locating Service, 765-1234 for location of existing utilities.
3. Prior to construction, the contractor shall excavate and verify the horizontal and vertical locations of all obstructions. Should a conflict exist, the contractor shall notify the engineer or surveyor so that the conflict can be resolved with minimum amount of delay.

THE FOLLOWING NOTES ALSO APPLY WHEN CHECKED

- ☐ All utilities and utility service lines shall be installed prior to paving.
- ☒ Backfill compaction shall be according to specified street use. (Arterial)
- ☒ Tack coat requirements shall be determined by the City Engineer.
- ☐ Sidewalks and wheelchair ramps within the curb returns shall be constructed wherever a new curb return is constructed.
- ☐ If curb is depressed for a driveway or a handicap ramp, the driveway or ramp shall be constructed prior to acceptance of the curb and gutter.
- ☒ All storm drainage facilities shall be completed prior to final acceptance.

SCANNED BY

APPROVAL OF AS BUILT DRAWINGS
CITY ENGINEER
[Signature]
DATE 12-12-16

2 6 2 4 4 4 0 1 8 6

	CITY OF ALBUQUERQUE	APPROVED FOR CONSTRUCTION <i>[Signature]</i> PRINCIPAL ENGR./DESIGN DATE
	DRAWING NO. 2444	SHEET 1 OF 3

770

2444

2115 TA AVE.

BLVD., NE

ARROYO DEL OSO
GOLF COURSE

SCALE HORIZ. $1'' = 10'$
VERT. $1'' = 5'$

PROFILE "C"

REMOVAL & REPLACEMENT OF PAVING AND SIDEWALK
SCALE 1" = 20'

49.60 NEW ELEVATION

49.38 EXISTING ELEVATION

NEW STORM DRAIN

EXISTING STORM DRAIN

NEW MANHOLE

EXISTING MANHOLE

NEW STD. CURB & GUTTER

EXIST. STD. CURB & GUTTER

NEW ASPH. CURB

EXIST. ASPH. CURB

REMOVE & REPLACE ART. PAVING
TO NEW GRADES

REMOVE EXIST. ART. PAVING
BACKFILL TO TOP OF MAJING

REMOVE & REPLACE EXIST.
ASPH. RUNDOWN

1 2 3 4 5 6 7 8 9 10 11 12

26 24440286

TITLE: STORM DRAINAGE IMPROVEMENTS
ON ACADEMY BLVD. BETWEEN MCKINNEY & MARCHETA

APPROVALS	ENGINEER	DATE	APPROVALS	ENGINEER	DATE
City Engineer	<i>[Signature]</i>	4/11/86	Liquid Waste	<i>[Signature]</i>	4/4/86
A.C.E.-Design	<i>[Signature]</i>	4/4/86	Traffic	<i>[Signature]</i>	4/4/86
A.C.E.-Hydrology	<i>[Signature]</i>	4/4/86	Water	<i>[Signature]</i>	4/4/86

DRAWING NO.	2444	MAP NO. E-18	SHEET 2 OF 3
----------------	------	-----------------	--------------


SCANNED BY

SURVEY INFORMATION		BENCH MARKS		AS BUILT INFORMATION	
NO.	FIELD NOTES	DATE	CONTRACTOR	INSPECTED BY	DATE
2548	R. CALLEGOS	1/7/86	1-F/BA	ACS CAP ON S. SIDE OF MEDIAN ON ACADEMY	275' W. OF MARCHETA.
				ELEV. 5251.25	
				VERIFICATION BY	DATE
				CORRECTED BY	DATE
				MICRO-FILM INFORMATION	
				RECORDED BY	DATE
				NO	




[illegible]

NAME	ENGINEER	DATE
IMPROVEMENTS		
79 KINNEY & MARCHETA		
VALS		
ite	<i>R. Pina</i>	<i>4/4/86</i>
	<i>D. G. Banks</i>	<i>4/4/86</i>
	<i>K. Pina</i>	<i>4/4/86</i>
SHEET	2	OF 3

5444

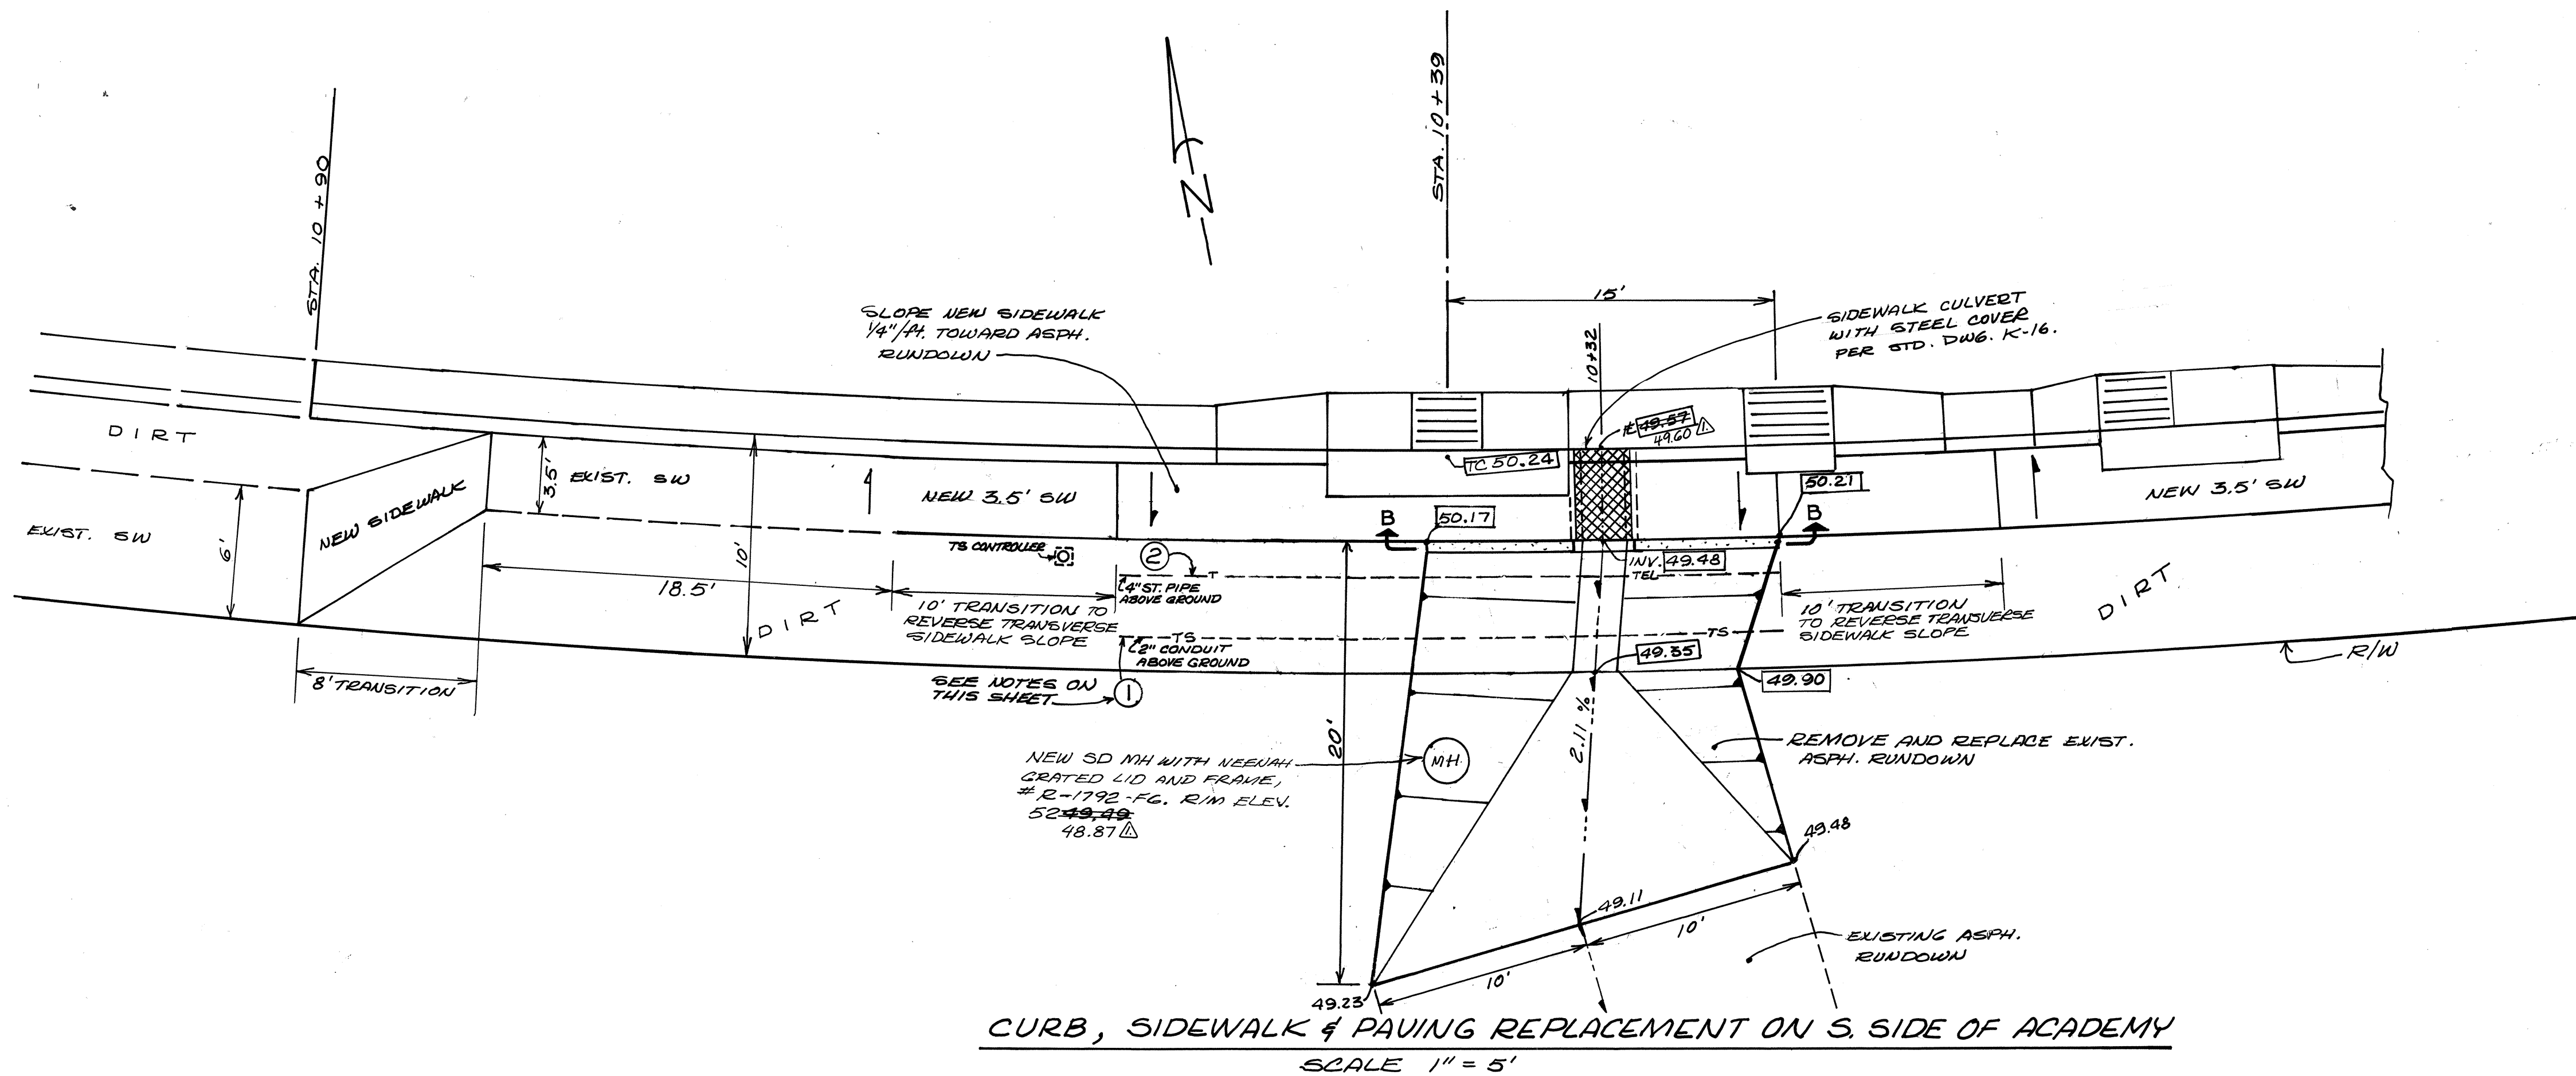

CURB, SIDEWALK & PAVING REPLACEMENT ON S. SIDE OF ACADEMY
SCALE 1" = 5'

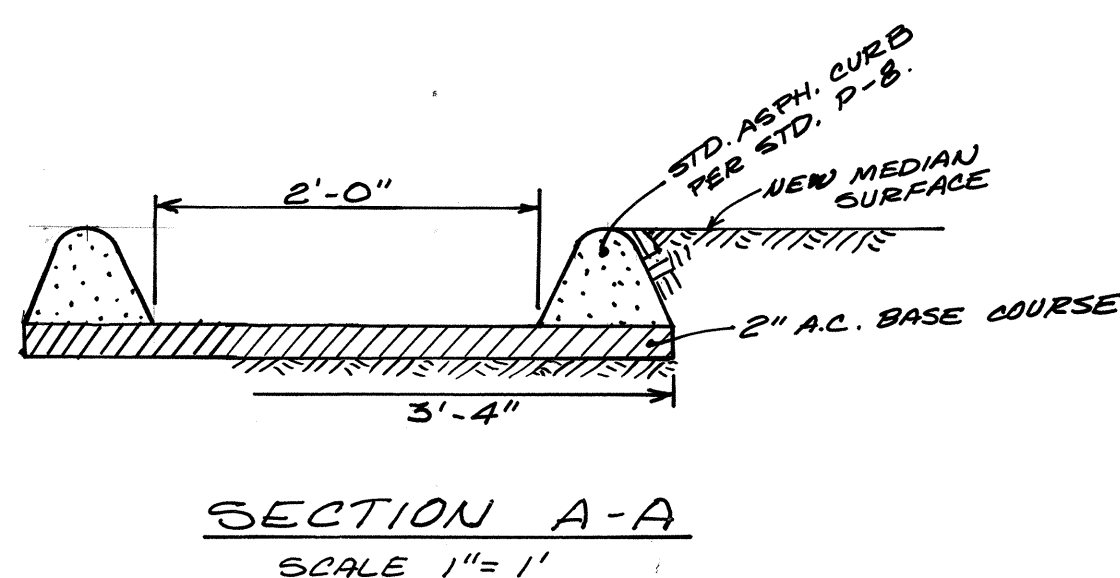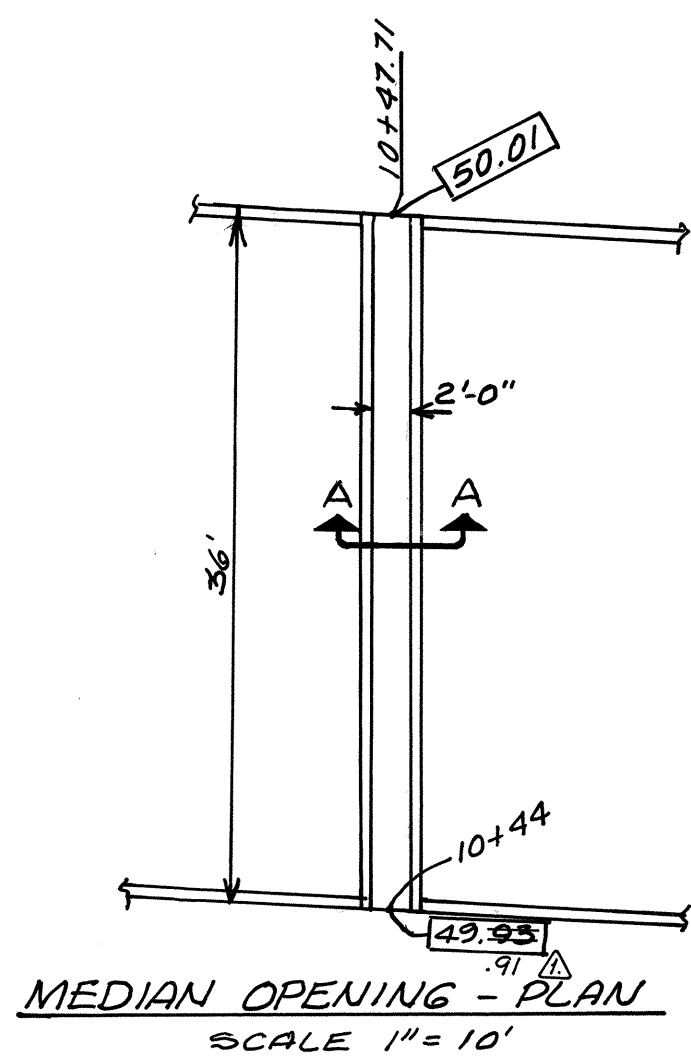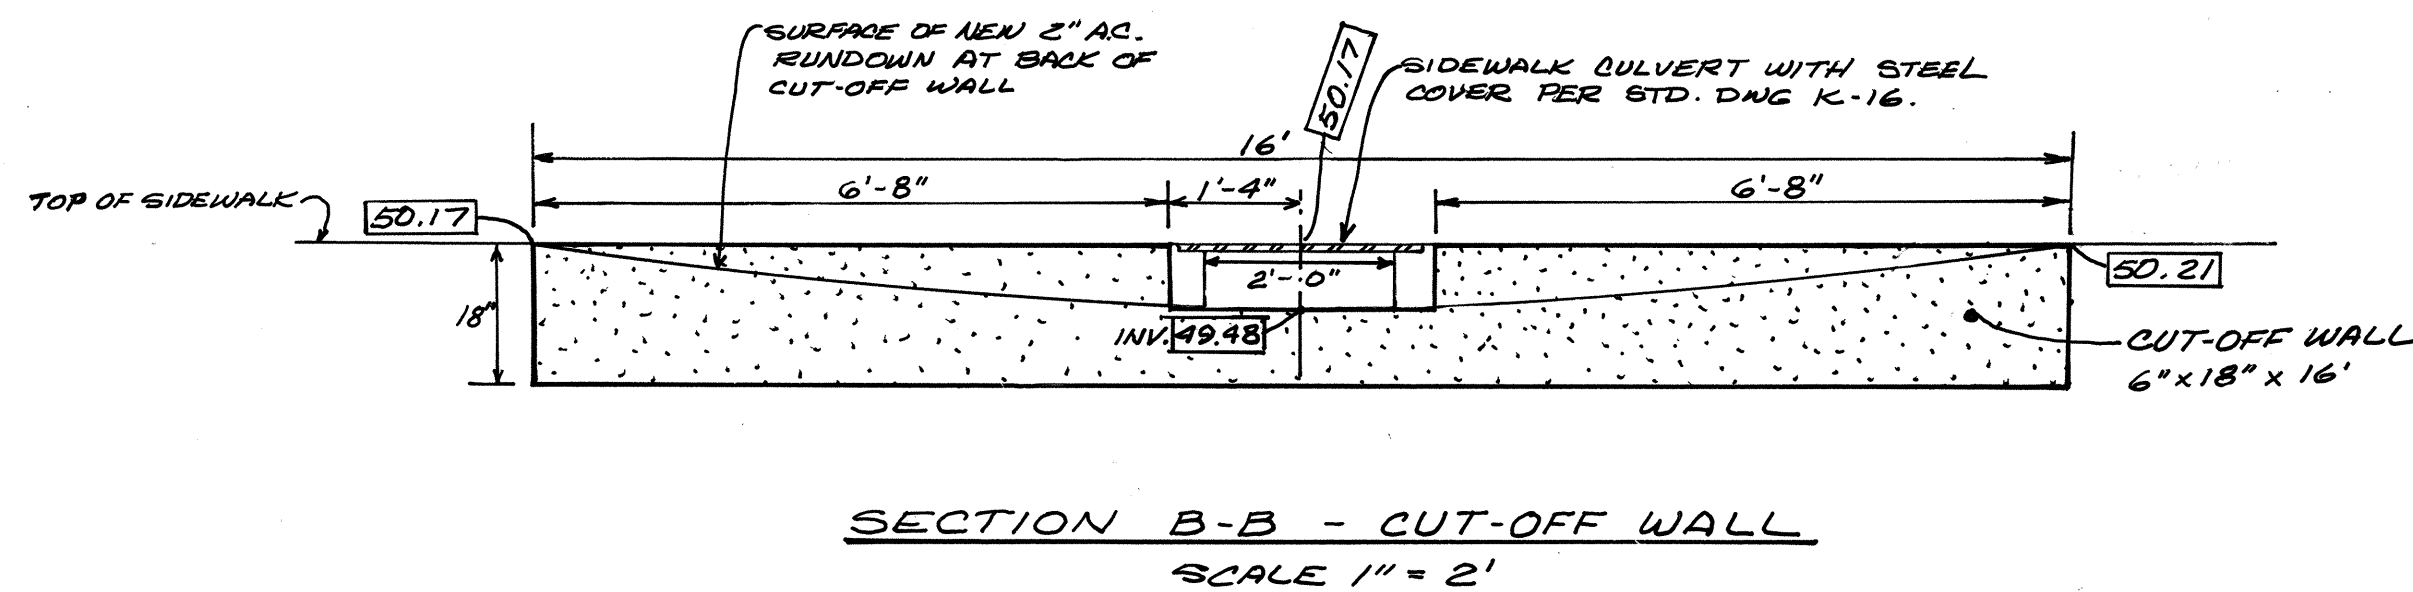

TRAFFIC HANDLING NOTES

1. CONTRACTOR MUST SUBMIT A CONSTRUCTION SIGNING AND BARRICADING PLAN TO TRAFFIC ENGINEERING DIVISION AND RECEIVE A BARRICADING PERMIT PRIOR TO CONSTRUCTION.
2. ALL CONSTRUCTION SIGNING AND BARRICADING MUST COMPLY WITH MANUAL ON UNIFORM TRAFFIC CONTROL DEVICES, 1978 EDITION AND SUBSEQUENT REVISIONS.
3. ACADEMY ROAD TRAFFIC MAY BE DIVERTED TO THE OPPOSITE SIDE OF THE MEDIAN FOR A MAXIMUM OF 10 DAYS FOR CONSTRUCTION ON EACH SIDE OF ACADEMY ROAD.

NOTES:

1. INSTALL 30 LF 2" RIGID CONDUIT 2' DEEP UNDER EXISTING ABOVE GROUND CONDUIT. CONTRACTOR TO INFORM TRAFFIC ENGINEERING OF CONDUIT INSTALL IN ADVANCE TO ALLOW SPLICING WITH EXISTING CONDUIT AND MINIMIZE SERVICE DISRUPTION.
2. CONTRACTOR TO COORDINATE LOWERING OF 4" STEEL PIPE BY MOUNTAIN BELL.

SCANNED BY

26 24440386

CITY OF ALBUQUERQUE
ENGINEERING DIVISION

TITLE: STORM DRAINAGE IMPROVEMENTS
ON ACADEMY BLVD. BETWEEN MCKINNEY & MARCHETA

APPROVALS	ENGINEER	DATE	APPROVALS	ENGINEER	DATE
City Engineer	Mike H	4/11/86	Liquid Waste	Mike H	4/1/86
A.C.E. Design	Mike H	4/1/86	Traffic	Mike H	4/1/86
A.C. E-Hydrology	Mike H	4/1/86	Water	Mike H	4/1/86

DRAWING NO. 2444 MAP NO. E-18 SHEET 3 OF 3

SURVEY INFORMATION		BENCH MARKS		AS BUILT INFORMATION	
NO.	DATE	NO.	DATE	NO.	DATE
DS-48	17/86	1-FIBA	17/86	CONTRACTOR	DATE
R. GALLEGOS		ON ACADEMY STS. N. OF MARCHETA		INSPECTOR'S	DATE
		ELEV. 5251.23		FIELD	DATE
				VERIFICATION BY	DATE
				CORRECTED BY	DATE
				MICRO-FILM INFORMATION	
				RECORDED BY	DATE
				NO.	