
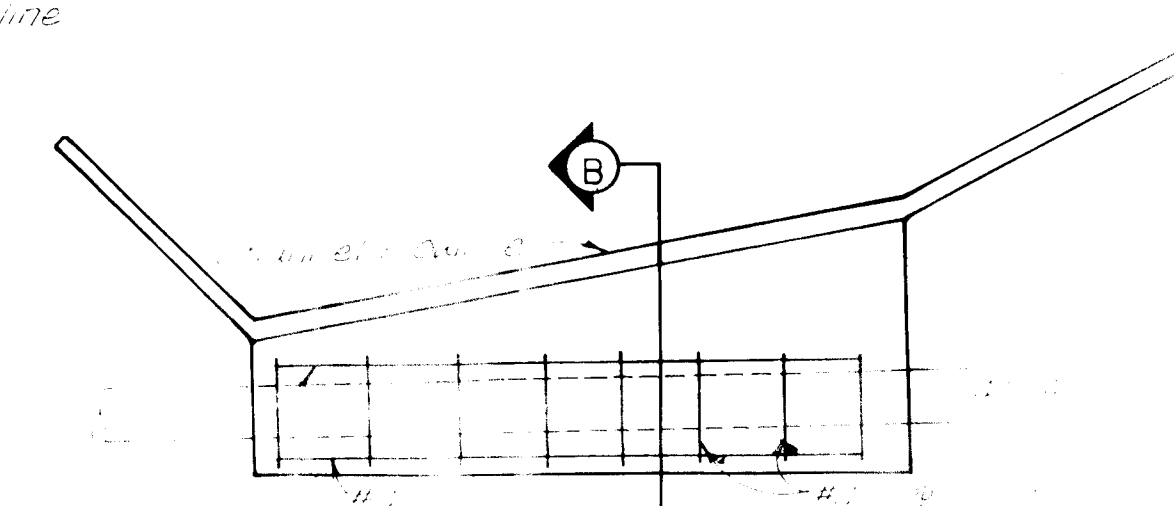
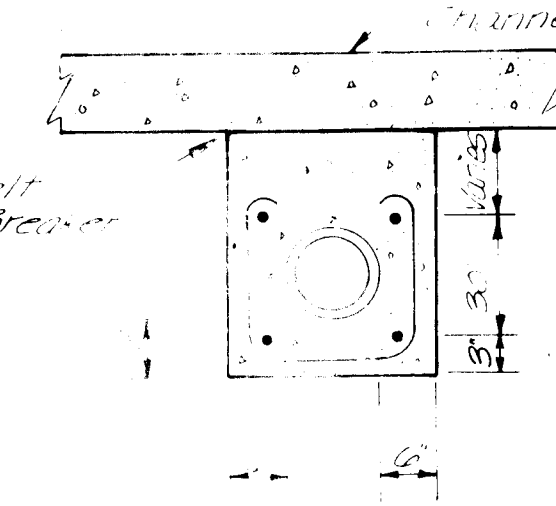
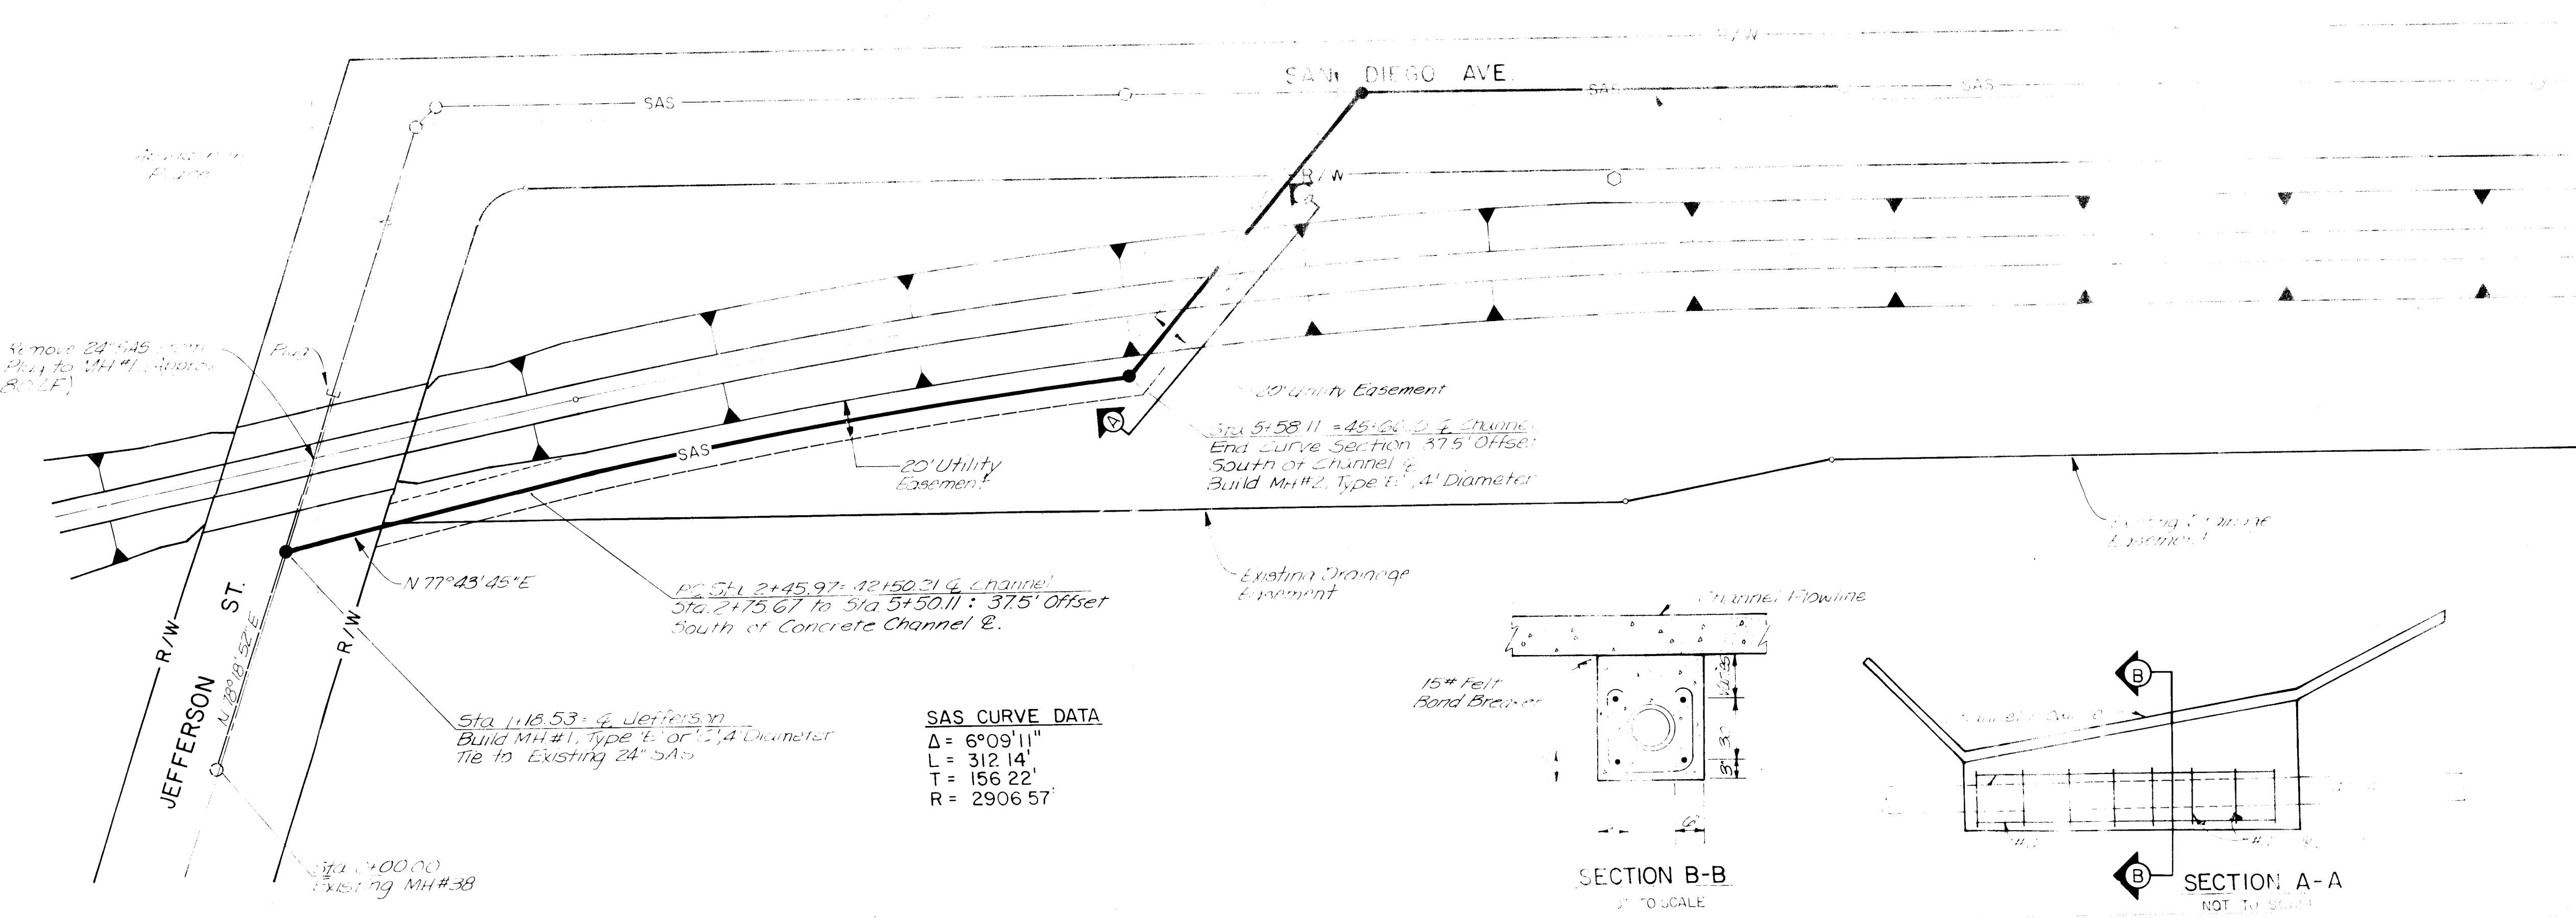


PLAN	SURVEYED	NOTED	DATE
NO.	NO.	NO.	NO.

PROFILE	SURVEYED	NOTED	DATE
NO.	NO.	NO.	NO.

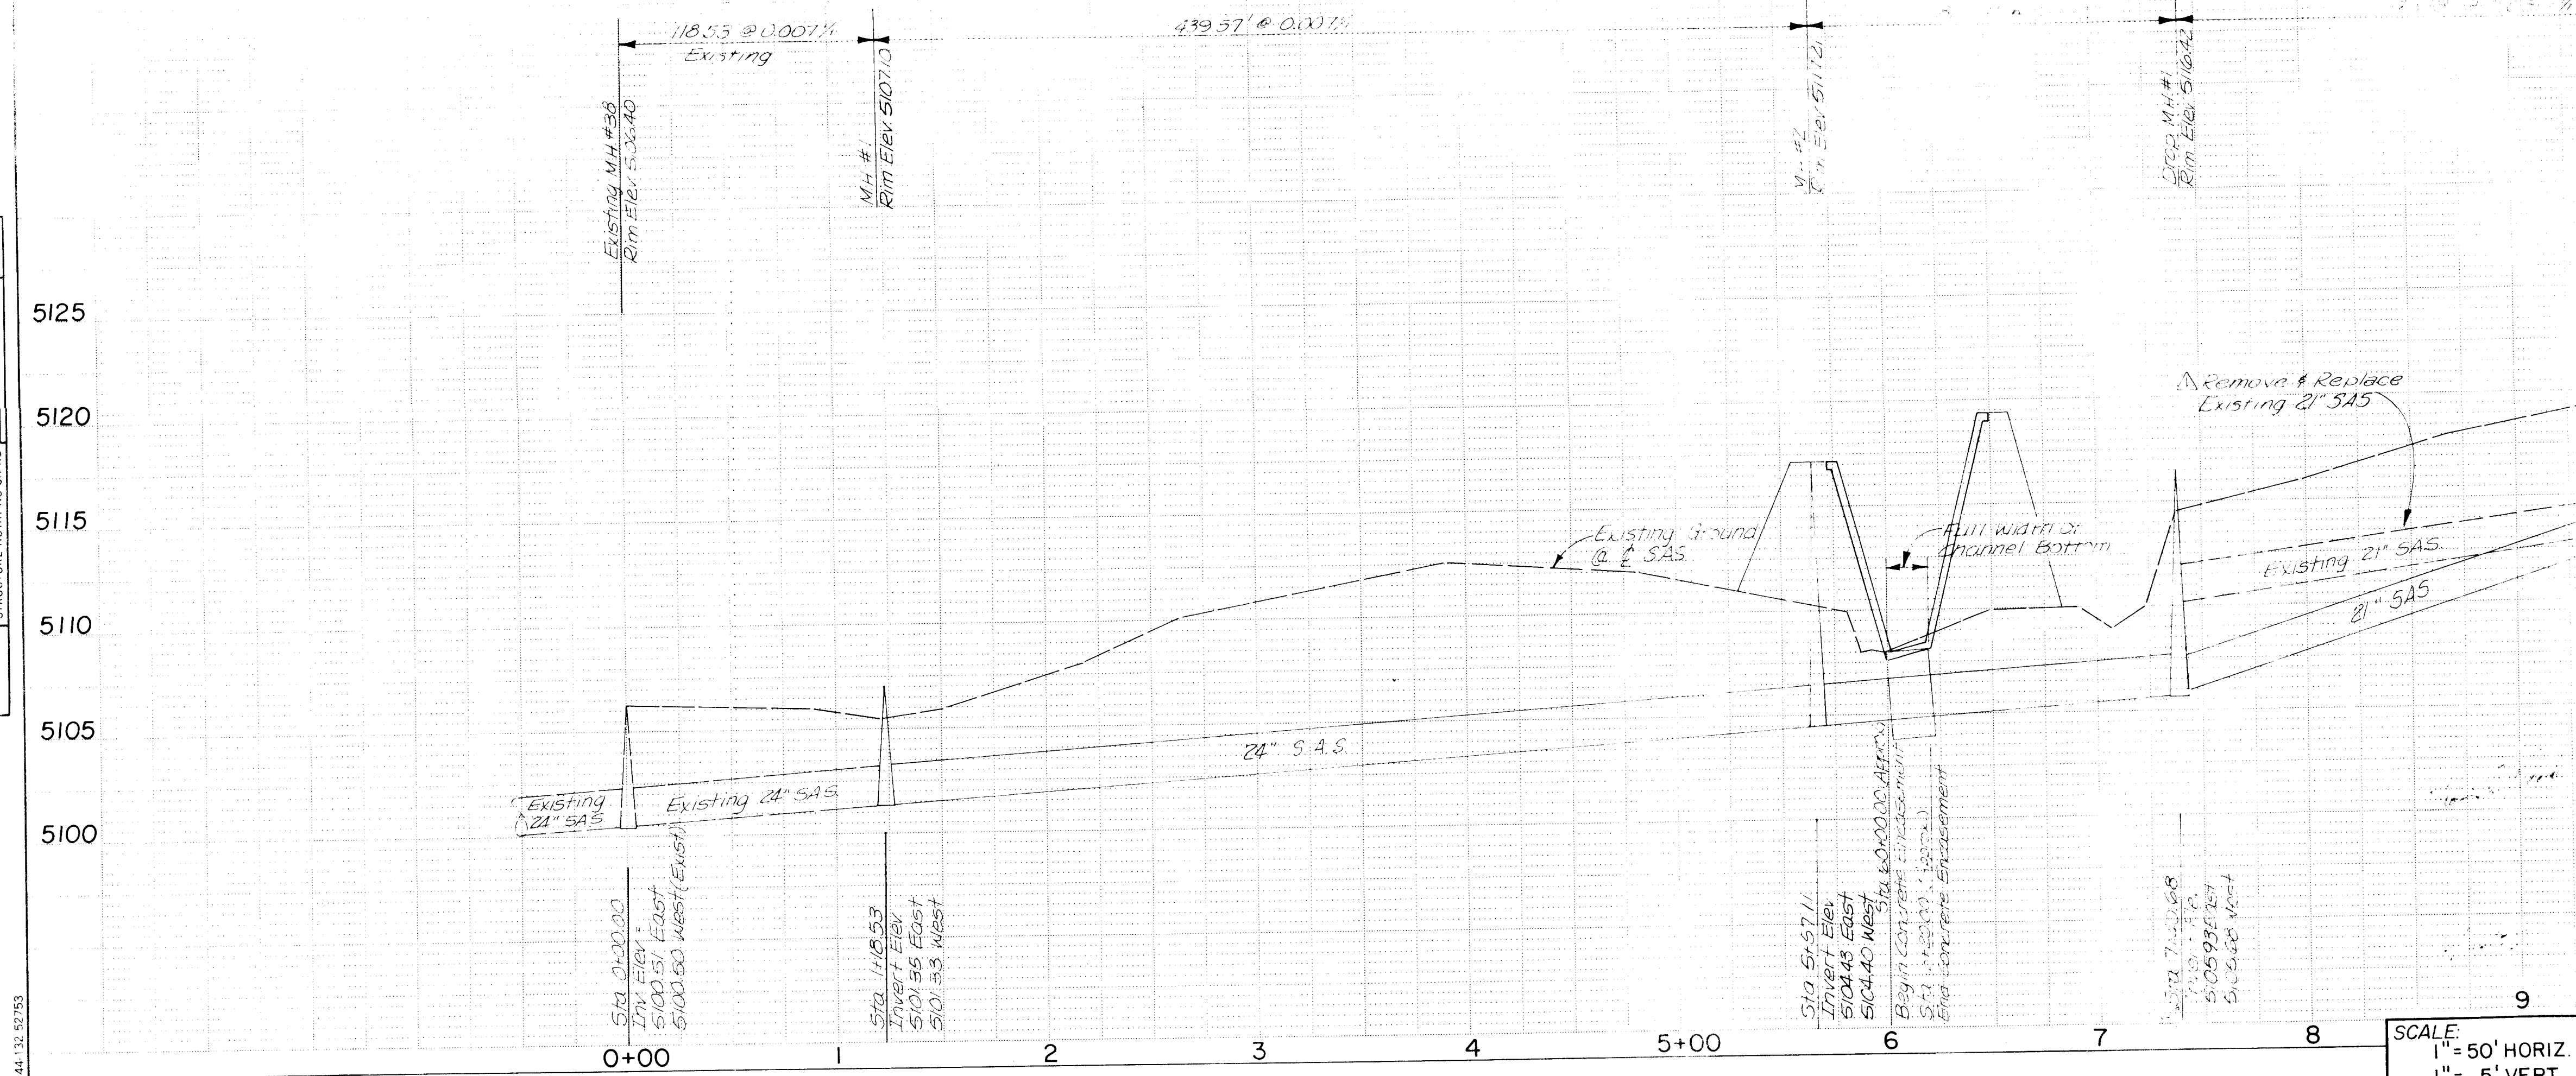

1 2 3 4 5 6 7 8 9 10 11 12 13 14 15
26-2455.90 01196

APPROVAL OF AS BUILT DRAWINGS
CHIEF CONSTRUCTION ENGINEER
Karen A. Green
DATE 3-27-96

PREPARED UNDER THE DIRECTION OF		ALBUQUERQUE METROPOLITAN ARROYO FLOOD CONTROL AUTHORITY	
TITLE: NORTH LA CUEVA CHANNEL SANITARY SEWER RELOCATION PLAN AND PROFILE			
APPROVALS	ENGINEER	DATE	APPROVALS
PROJECT NUMBER 31995		DRAWING NO. 2455.90	
SHEET 1 OF 1		SHEET 1 OF 1	

REFERENCES	SURVEY INFORMATION	BENCH MARKS
MAP NO. EST. NO.	DATE BY NO.	TBM # 3: North P.C. & South San Diego R/W at San Mateo - Bohannon-Huston Brass Cap w/ 4' Post. Elev. 5152.26
		TBM # 2: N.E. Corner Intersection of South San Diego R/W & West Frontage R/W - Bohannon-Huston Brass Cap w/ 4' Post. Elev. 5152.26