


CITY OF ALBUQUERQUE

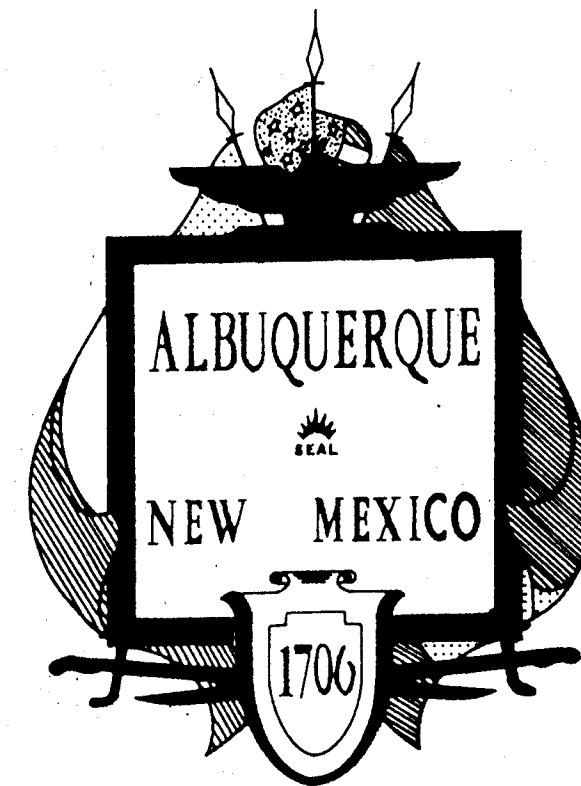

NEW MEXICO

CONSTRUCTION PLANS

FOR

NORTH VALLEY DRAINAGE SYSTEM IMPROVEMENTS

MONTANO ROAD - SYSTEM A
GRIEGOS ROAD - SYSTEMS B and C
PROJECT No. 2461


APPROVAL OF AS BUILT DRAWINGS
CHIEF CONSTRUCTION ENGINEER
Kenneth B. Linder
DATE 12-21-88

1 2 3 4 5 6 7 8 9 10 11 12
26 24610088

SET NO. _____
JOB NO. 85113

REV.	SHEETS	CITY	ENGR.	DATE	USER	DEPT.	DATE	USER	DEPT.	DATE
APPROVAL OF REVISIONS										
					2461					
								NOVEMBER 1987		

RECORD DRAWING

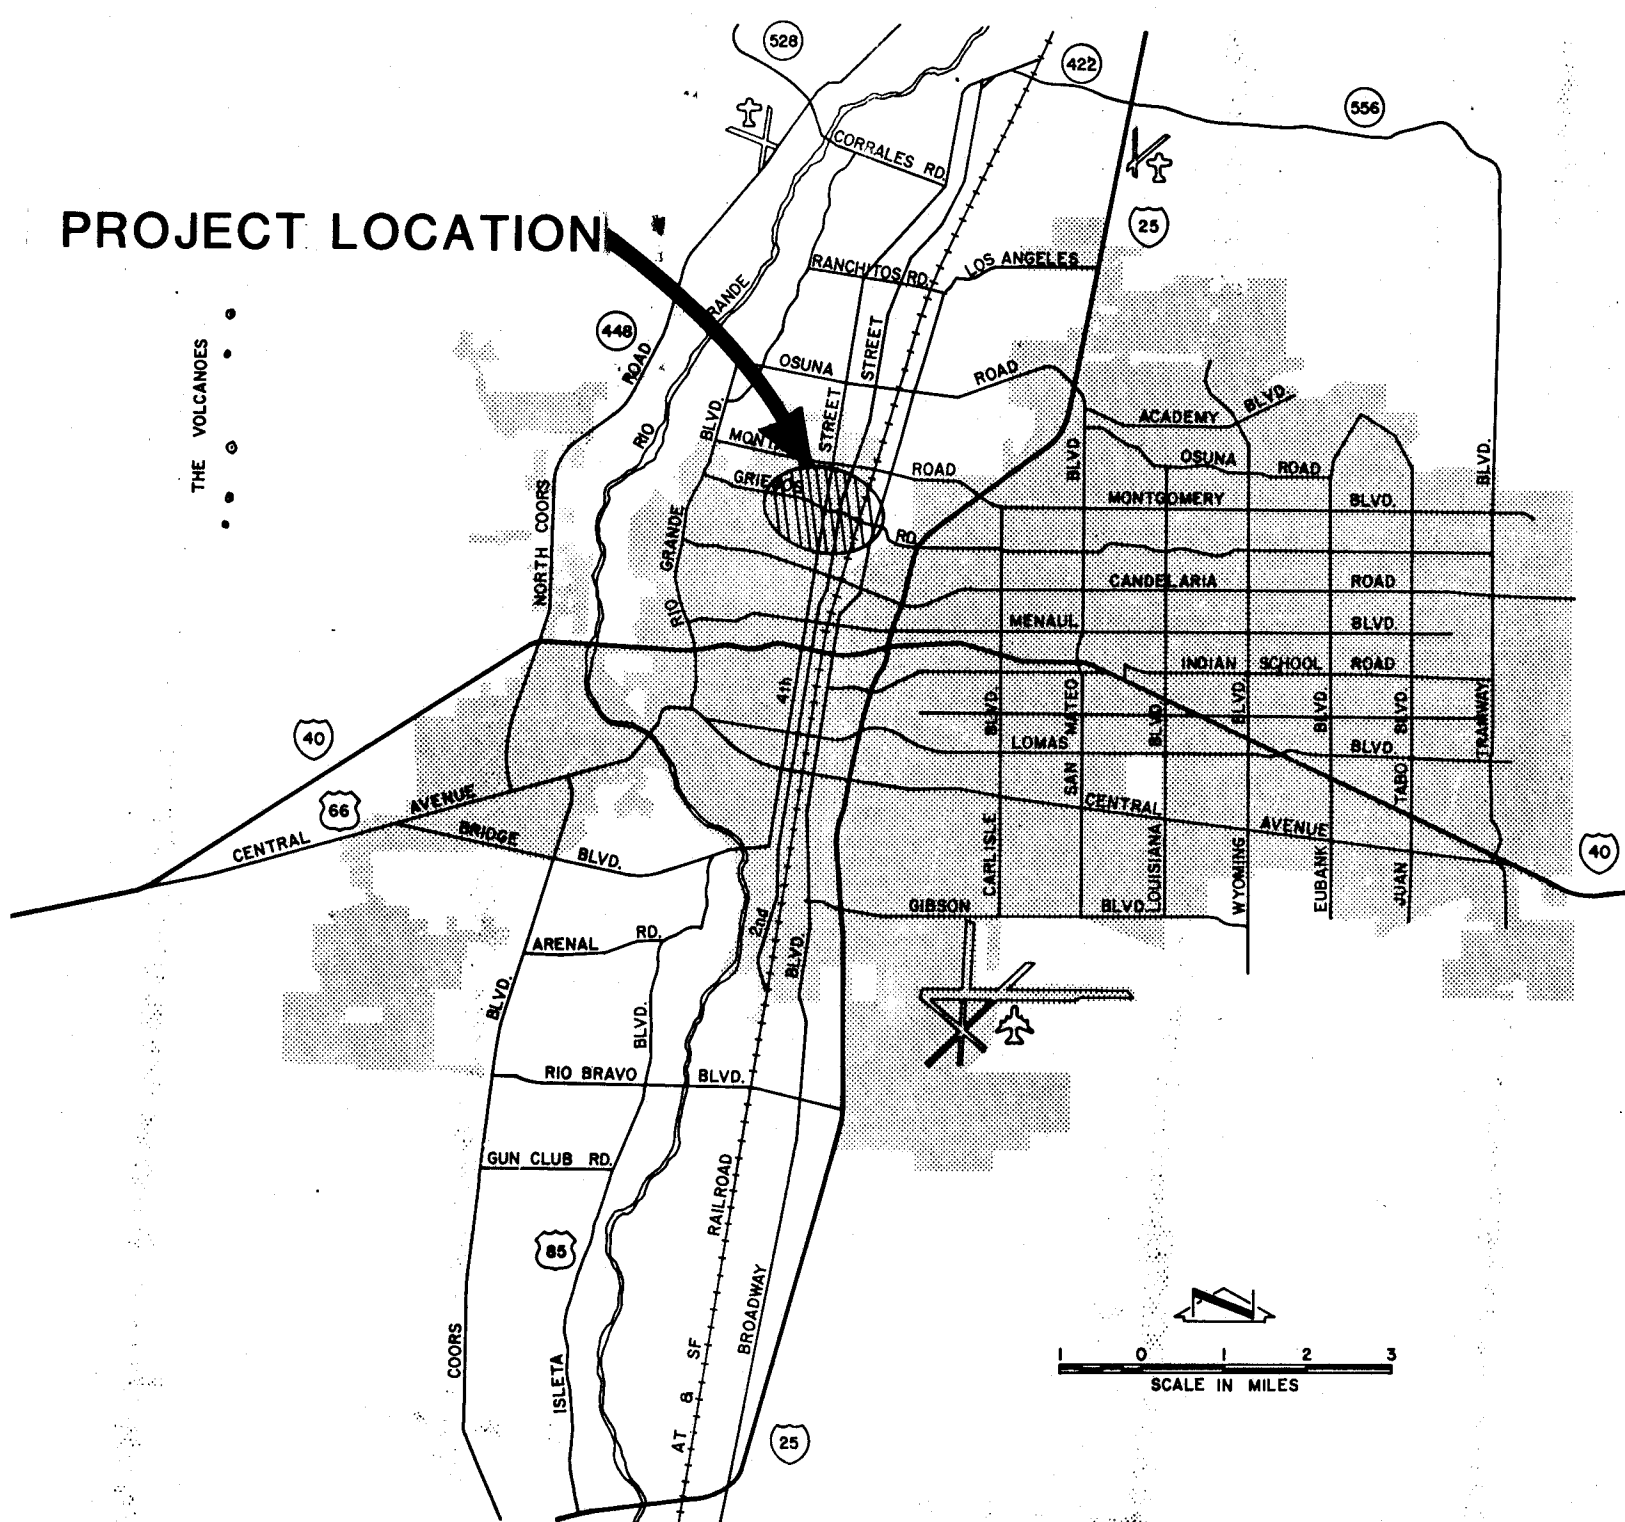

KEY MAP

CITY OF ALBUQUERQUE



NEW MEXICO

INDEX TO SHEETS

SHEET NO.	DESCRIPTION
1	Title Sheet
2	General Notes and Details
3	Site Plan Legend and Traffic Control Notes
4	Storm Drain Plan & Profile Sta. 2+88 to 4+50
5	Storm Drain Plan & Profile Sta. 4+50 to 9+00
6	Storm Drain Plan & Profile Sta. 9+00 to 13+50
7	Storm Drain Plan & Profile Sta. 13+50 to 18+00
8	Storm Drain Plan & Profile Sta. 18+00 to 22+50
9	Storm Drain Plan & Profile Sta. 22+50 to 27+00
10	Storm Drain Plan & Profile Sta. 27+00 to 31+50
11	Storm Drain Plan & Profile Sta. 31+50 to 36+00
12	Storm Drain Plan & Profile Sta. 36+00 to 38+63
13	Sanitary Sewer Plan & Profile Sta. 16+00 to 20+00
14	Sanitary Sewer Plan & Profile Sta. 20+00 to 24+00
15	Sanitary Sewer Plan & Profile Sta. 24+00 to 28+00
16	Sanitary Sewer Plan & Profile Sta. 27+80 to 31+50
17	Sanitary Sewer Plan & Profile Sta. 31+50 to 36+00
18	Sanitary Sewer Plan & Profile Sta. 36+00 to 37+00
19	Outlet Structure Plan & Details
20-21	Traffic Control Plan

CONSTRUCTION PLANS FOR
NORTH VALLEY
DRAINAGE SYSTEM IMPROVEMENTS

GRIEGOS ROAD SYSTEMS (B&C)


SET NO. _____
JOB NO. 85113

26 24610188
12-21-88

REV.	SHEETS	CITY	ENGR.	DATE	USER	DEPT.	DATE	USER	DEPT.	DATE
APPROVAL OF REVISIONS										
								APPROVED FOR CONSTRUCTION <i>Scott A. Verhines</i> 10/28/87 C.E.		
DRAWING NO. <u>2461</u>					MAP NO. _____			SHEET <u>1</u> OF <u>21</u>		


GENERAL NOTES

- The City of Albuquerque Interim Standard Specifications for Public Works Construction, 1985 Edition, and any revisions and or additions in the Specifications and Contract Documents, shall govern the construction of this project.
- The Contractor shall notify all utility companies when working near their systems. Two days prior to any excavation, Contractor must contact Line Locating Service, 765-1234, for location of existing utilities.
- All existing utilities shown here were taken as accurately as possible from record drawings and surface indications. It shall be the Contractor's responsibility to protect, maintain in service, and verify exact locations of all affected utilities during construction of this project, including service lines.
- All utilities which are to be abandoned under this contract shall be plugged with concrete at each end of the portion to be abandoned. Payment for this work will be made on the basis of the contract unit price bid.
- Curb return radii and street widths are to the face of the curb unless otherwise indicated in the plans.
- Where removal of existing curb and gutter or sidewalk is required, remove to the nearest joint or saw cut.
- When abutting new paving to existing, saw cut existing paving on a right angle, or as required by the Project Engineer to remove any broken, raveled, or cracked paving and match the new paving grade to the existing. No separate payment shall be made for saw cut but shall be considered incidental to the Contract Unit Price for pavement removal and replacement.
- Curb and gutter shown as existing and not to be removed under this contract which is damaged or displaced by the Contractor or his subcontractors, shall be replaced by the Contractor at his expense.
- Existing materials to be removed and paid for on a unit price basis shall be measured and the quantities approved by the Engineer before removal.
- Remove all valve boxes from abandoned water lines. Payment will be considered incidental to the contract unit price for pavement removal and replacement.
- All abandoned valve and meter box frames and covers shall be returned to the Water System Division city yard and all storm and sanitary manhole lids and inlet grates, castings, and frames not reused and in usable condition, shall be returned to the Liquid Waste Division warehouse. There shall be no direct payment for these items. Cost shall be considered incidental to other items of work.
- No separate payment shall be made for sewer by-pass pumping if required. It shall be considered incidental to sewer line construction.
- The Contractor shall expose existing water and sewer lines at locations where new storm sewer lines cross or parallel such lines in order to adequately establish the proximity of water and sewer lines. The cost of this work shall be incidental to other items of work.
- Prior to construction, exploratory excavation may be required as directed by the Project Engineer to more specifically locate utility lines. There will be no direct payment for this item of work. Cost will be considered incidental to other items of work.
- All water meters, water valve boxes, and sewer manholes in the construction area where street grades change are to be adjusted by the Contractor to finished grade under this contract. The Contractor shall be required to set reference points for locating manholes prior to any grading operation. Measurement and payment for this work shall be considered incidental to the unit price bid for pavement removal and replacement.
- The Contractor will be responsible to replace at his expense any and all property corners destroyed in the process of construction. All property corners must be set by a Registered Land Surveyor.
- The Contractor will be required to confine his work within the construction limits and/or right-of-way to preserve existing vegetation and private property. Contractor is not to store equipment or materials in R.O.W. overnight.
- Public mail boxes within new construction will be relocated to the right-of-way line by the U.S. Post Office. The Contractor shall coordinate relocation of private mail boxes with property owner or resident and the U.S. Post Office. The Contractor shall notify the U.S. Post Office, Delivery and Collection Department, at least 48 hours in advance of construction affecting mailboxes. Cost of this work will be considered incidental to other items.
- Utility relocation schedules shall be coordinated at the pre-construction conference.
- Utility relocations required by the construction of this project are to be coordinated by the Contractor during construction. No additional compensation will be allowed for delays or inconveniences caused by utility company work crews. The Contractor may be required to reschedule his activities to allow utility crews to perform their required work.
- Access to local business and residences shall be kept open at all times. In the event that access closures are unavoidable, closures must be scheduled at least twenty-four (24) hours in advance with property owners and approved by the Engineer. Access closures to business shall not exceed two (2) hours during business hours and for residences shall not exceed eight (8) hours. Alternate access provided if required.
- All valve box rings and covers shall be painted with blue enamel or epoxy paint. Color shall be equivalent to "Safety Blue".
- Sidewalks and wheel chair ramps within the curb returns shall be constructed wherever a new curb return is constructed. Wheel chair ramps shall be paid for at the unit price for sidewalks. If curb is depressed for a driveway or wheel chair ramp, the ramp or driveway shall be constructed prior to acceptance of the curb and gutter.
- A disposal site for all excess excavation material, asphaltic paving, concrete paving, etc. shall be obtained by the Contractor, and approved by the Project Engineer in compliance with applicable regulations. All costs incurred in obtaining a disposal site and haul thereto shall be considered incidental to the contract unit price for other items.
- Fifty ton roller operation shall not be used on this project where underground utilities are present. The required compaction of these locations shall be effected by other types of approved compaction methods.
- All work on this project shall be performed in accordance with applicable Federal, State, and local laws, rules, and regulations concerning construction safety and health.
- WARNING** - If any utility lines, pipelines or underground utility lines are shown on these drawings, they are shown in approximate manner only, and other such lines may exist where none are shown. If any such existing lines are shown, the location is based upon information provided by the utility or pipeline company, the Owner, or by others (except where specifically noted as field verified), and the information may be incomplete, or may be obsolete by the time construction commences. The Engineer has undertaken limited field verification of the location, depth, size or type of existing utility lines, pipelines, or underground utility lines, and makes no representation pertaining thereto, and assumes no responsibility or liability therefor, the Contractor shall inform himself of the location of any utility line, pipeline, or underground utility line in or near the area of the work in advance of and during the excavation work. The Contractor is fully responsible for any and all damage caused by failure to locate, identify, and preserve any and all existing utilities, pipelines, and underground utility lines. The Contractor shall comply with State statutes, Municipal and Local ordinances, rules and regulations, if any, pertaining to the location of these lines and facilities, in planning and conducting excavation, whether by calling or notifying the utilities, complying with "line locating" procedures, or otherwise. (See also Note 2)
- Steps are required in all drop inlets and manholes over 4 feet deep. All manhole and drop inlet steps shall be 1/2" grad 60 steel reinforcing rod encapsulated in a co-polymer polypropylene as manufactured by M.A. Industries, Inc. (Model #P-2-PFS) or equal. Steps are not to be precast in place but shall be installed as recommended by the manufacturer after the manhole or catch basin has been constructed. Top two steps to protrude 4 inches into manhole, all other 5 inches. Spacing between steps to be 16 inches O.C., first step to be 18 inches from manhole rim, last step to be 18 inches maximum from manhole invert. For step placement in drop inlets, see appropriate Standard Detail (K-1 or K-4).
- It shall be the responsibility of the Contractor to maintain sanitary sewer services at all times throughout the duration of the project, to include by-pass pumping of sewerage as required, at no additional cost to the Owner.
- The Contractor is responsible for coordination during construction for work over or into Middle Rio Grande Conservancy District (MRGCD) facilities. These facilities include but are not limited to the Alameda Drain. The Contractor shall obtain the necessary approvals from MRGCD regarding dewatering, scheduling, etc., during construction. The Contractor shall post a damage deposit with MRGCD for work which affects MRGCD facilities. There shall be no direct payment made for these items under this contract, but shall be considered incidental to other items of work.
- All Reinforced Concrete Pipe (RCP) storm drain shall conform to ASTM C 76 specifications as set forth in the Contract Documents. The following pipe strength classes will apply for this project, unless otherwise noted:
 - RCP less than thirty (30) inches in diameter (I.D.) - Class IV.
 - RCP greater than or equal to thirty (30) inches in diameter (I.D.) - Class III.
- Removal and replacement of existing curb and gutter required for the construction of new catch basins shall be considered incidental to the contract unit price for removal of existing catch basins and construction of new catch basins and no separate payment shall be made therefore.
- Catch basin grate elevations shown on the plans are at the flowline at face of curb and are computed at 10 3/4" below top of curb.
- All water service relocations or replacements required by the construction of new storm drain must be replaced from the water main to the existing meter. Splicing into existing service lines is not permitted.
- Use Type "C" manholes for SAS and storm drain depths of less than 6' measured from invert to rim. Use Type "B" manholes for all depths greater than or equal to 6' measured from invert to rim.
- For payment purposes, the maximum pavement cut width shall be as defined in Section 801.17.8.2. of the Interim Standard Specifications as defined in General Note 1 above.
- Trench dewatering if required due to groundwater conditions encountered during construction shall be paid for by contract change order during construction.
- Use of City approved alternate grates for storm inlets per City of Albuquerque Standard Drawing K-10 shall be limited to roadway slopes of one percent (1%) or greater.
- The water and sewer service relocations and/or replacements on the following plan sheets are shown in anticipation of conflicts with proposed storm drain lines. This work will only be done if necessary to correct the conflicts or inadequate grade conditions. Any relocations and/or replacements which are in question must be approved by the Project Manager prior to the work being performed.

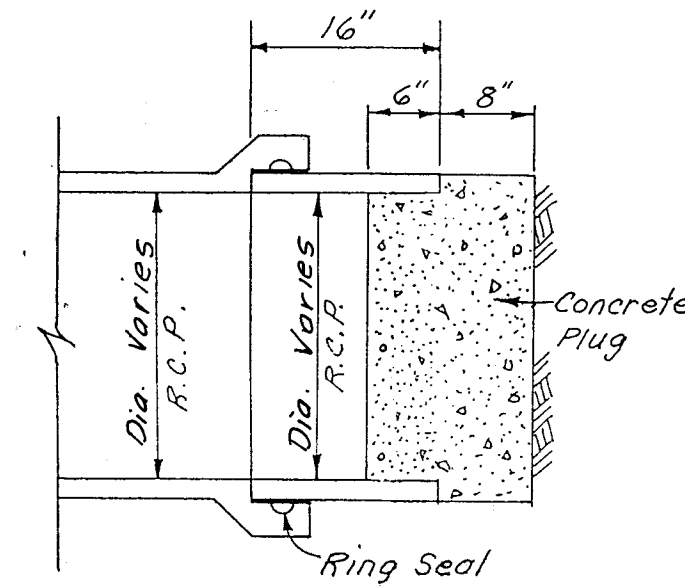

**REMOVABLE
WATERTIGHT PLUG**

Not to Scale

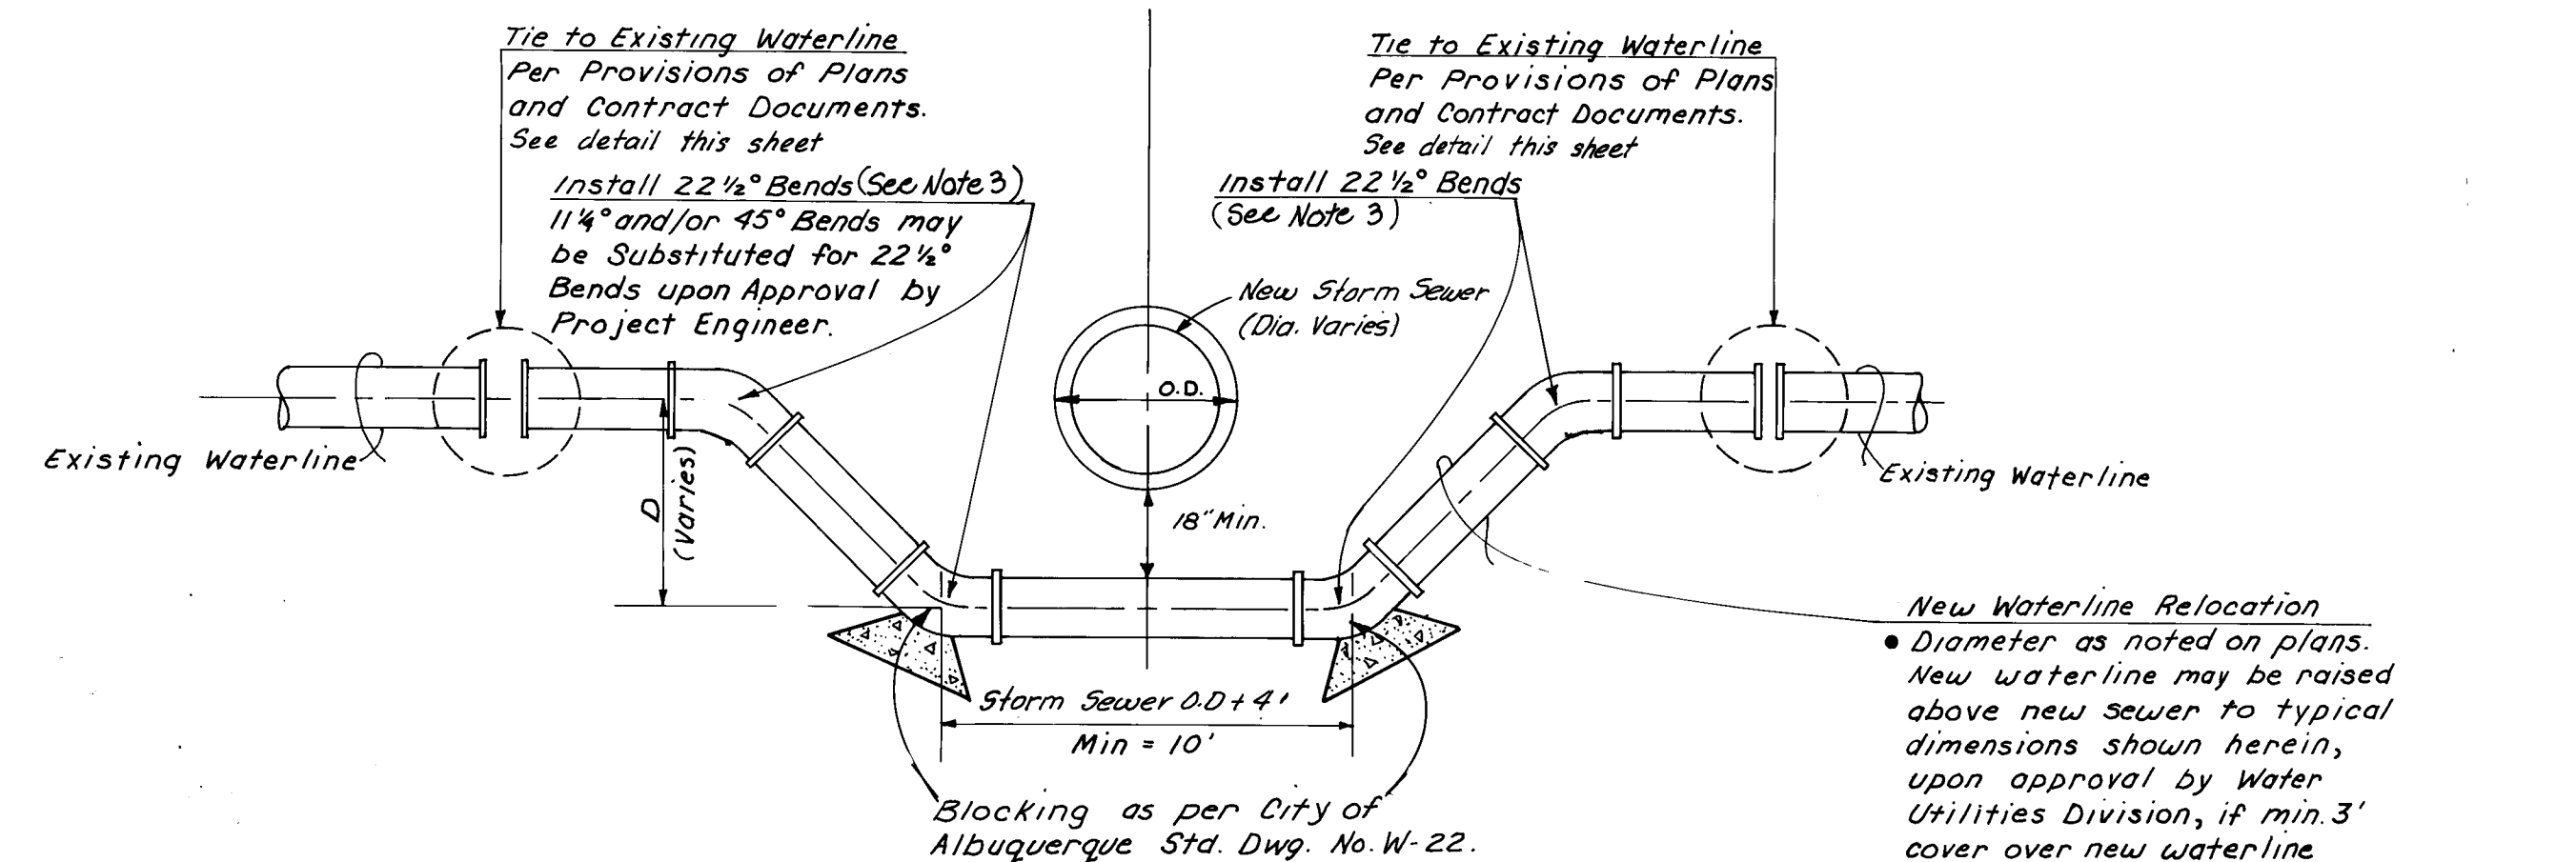


ELEVATION

TYPICAL WATERLINE RELOCATION DETAIL

Not to Scale

NOTES


- Lengths of Waterline Relocation may be extended at direction of Project Engineer until suitable existing material is found to make connection, in some cases maybe, to existing main or Valve.
- Joints subject to upward thrust shall be installed as rigid joints per the Requirements of Section 701.13.3 of the Interim Standard Specifications subject to Approval of the Engineer.

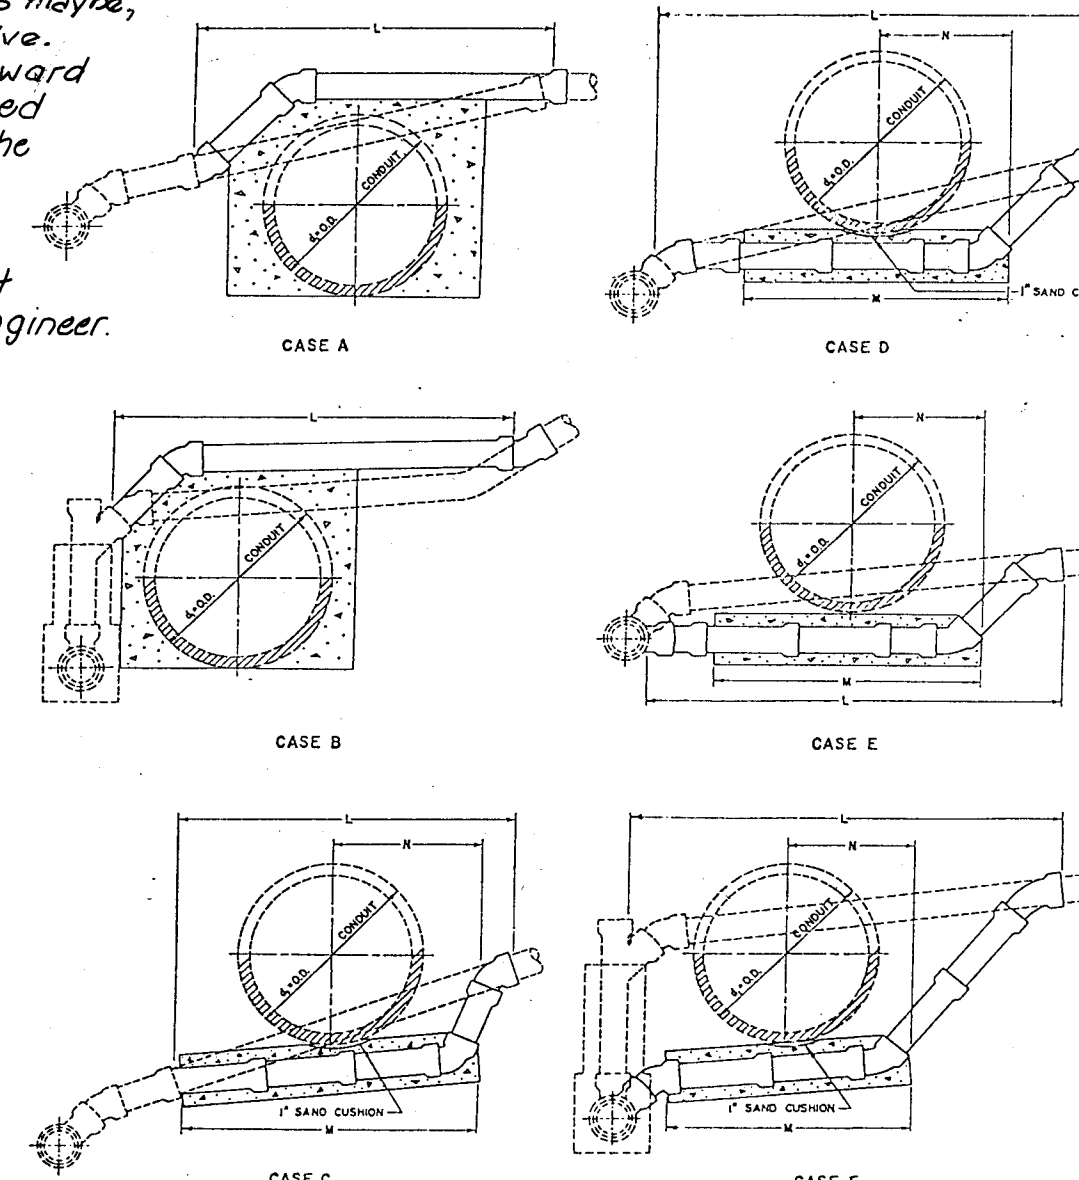

NOTES:

- LOCATION OF EXISTING UTILITY LINES AND SERVICE CONNECTIONS MUST BE VERIFIED PRIOR TO CONSTRUCTION OF NEW STORM DRAIN.
- WHERE CLEARANCE BETWEEN NEW STORM DRAIN AND EXISTING SERVICE LINE IS LESS THAN 1 FOOT, SERVICE LINE SHALL BE RELOCATED PER DETAIL.

TYPICAL SAS SERVICE LINE RELOCATION DETAIL

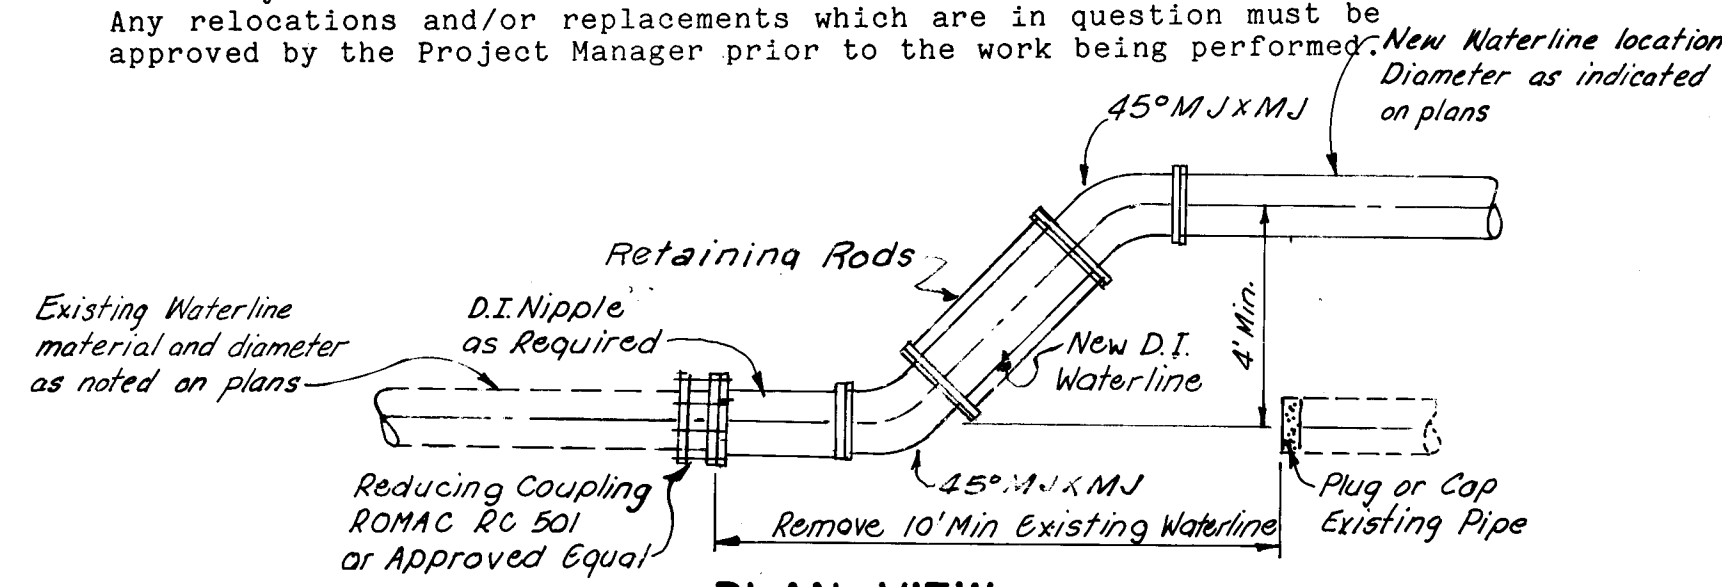

PLAN VIEW

TYPICAL WATERLINE CONNECTION DETAIL

26 24610288

TYPICAL SAS LINE THRU STORM DRAIN MANHOLE


NTS

CITY OF ALBUQUERQUE MUNICIPAL DEVELOPMENT DEPARTMENT ENGINEERING DIVISION					
TITLE: NORTH VALLEY DRAINAGE SYSTEM IMPROVEMENTS GENERAL NOTES AND DETAILS GRIEGOS ROAD SYSTEMS (B&C)					
APPROVALS	ENGINEER	DATE	APPROVALS	ENGINEER	DATE
City Engineer	<i>[Signature]</i>	10/27/87	Liquid Waste	<i>[Signature]</i>	10/27/87
A.C.E. Design	<i>[Signature]</i>	10/27/87	Traffic	<i>[Signature]</i>	10/27/87
A.C.E. Hydrology	<i>[Signature]</i>	10/27/87	Water	<i>[Signature]</i>	10/27/87
DRAWING NO.	2461		MAP NO.	SHEET 2 OF 21	



Scanlon Job No. 85113

RECORD DRAWING

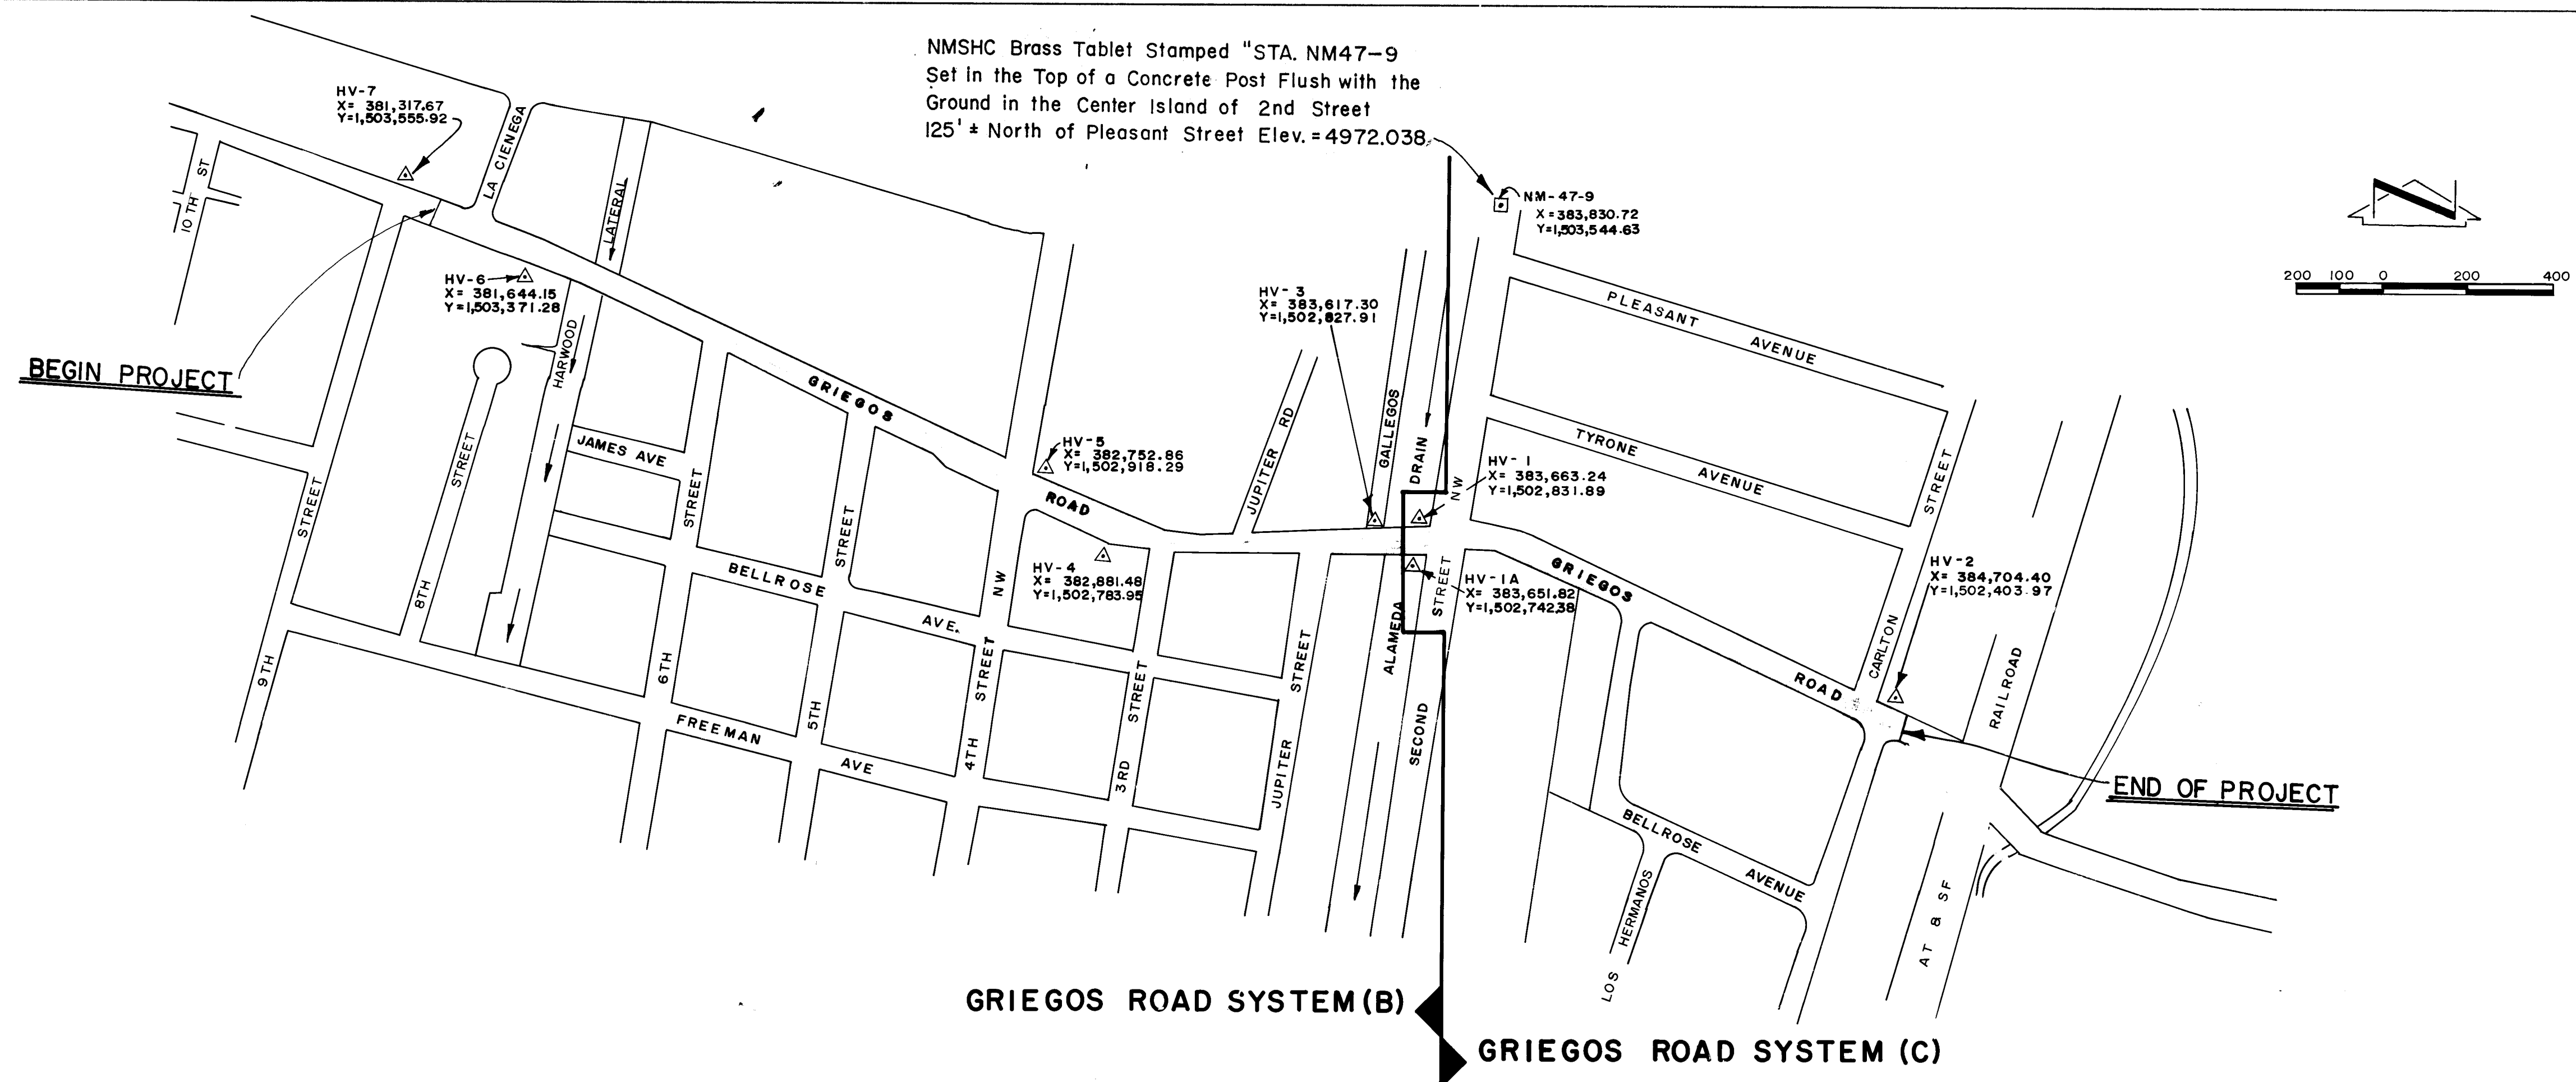

SITE PLAN

LEGEND

	EXISTING CURB AND GUTTER		EXISTING SANITARY SEWER
	NEW STANDARD AND MEDIAN CURB AND GUTTER		EXISTING STORM DRAIN
	NEW ASPHALT CURB		EXISTING WATER LINE
	EXISTING SIDEWALK		EXISTING GAS LINE
	NEW SIDEWALK PATCH		NEW SANITARY SEWER
	NEW MEDIAN PATCH		NEW SANITARY SEWER MANHOLE
	PAVEMENT REPLACEMENT PER C.O.A. STD. DWG P-25		NEW STORM DRAIN
	EXISTING SIGN		NEW STORM DRAIN MANHOLE
	EXISTING POLE		NEW CATCH BASIN
	EXISTING CHAIN LINK FENCE		EXISTING SPOT ELEVATION
	EXISTING BLOCK WALL		NEW SPOT ELEVATION
	EXISTING WIRE FENCE		EXISTING TELEPHONE LINE
	EXISTING WOOD FENCE		EXISTING CABLE TELEVISION LINE
	NEW CHAIN LINK FENCE		EXISTING WATER METER
	PI OR CONTROL POINT		EXISTING WATER VALVE
	CONSTRUCTION C AND SURVEY C		EXISTING FIRE HYDRANT
	R/W LINE		NEW FIRE HYDRANT
	ELEVATION OF HYDRAULIC GRADE LINE		
	FLOW RATE C.F.S. 100 YEAR-6 HOUR RUNOFF		
	VELOCITY (FT./SEC) 100 YEAR-6 HOUR RUNOFF		

TRAFFIC CONTROL NOTES


- All traffic control devices, and their placement, shall comply with Chapter VI of the 1978 Edition MANUAL FOR UNIFORM TRAFFIC CONTROL DEVICES.
- The Contractor shall prepare and submit to the Project Engineer a detailed detour plan, which must be approved by the City Traffic Engineer three (3) working days in advance of any required lane closures.
- All signs must be installed before construction begins as directed by the Project Engineer. Sign heights shall be 7 ft. from the bottom of the sign to the sidewalk level.
- All drums or barrels may have sand or water ballast limited to 100 lbs.
- All sign locations will be selected in the field and approved by the City Traffic Engineer or Project Engineer. Distances may be adjusted for local conditions.
- All signs will be ground mounted on single or double posts. Existing posts may be used at some locations, with the approval of the Project Engineer. Portable sign supports will be acceptable as an alternate.
- All signs will be moved forward as the construction progresses, as determined appropriate by the Project Engineer.
- Construction equipment and materials shall not be stored within the roadway or on the median during non-work hours.
- When barriers are required after dark, all advance warning signs and all barricades shall be equipped with flashing warning lights (Type A), except that all channelizing devices shall have steady burning warning lights (Type C).
- All existing regulatory signs and signals that need to be removed, relocated or reinstalled shall be done by the City of Albuquerque Traffic Engineering Division. The Contractor shall notify the Traffic Engineering Division three (3) working days in advance of any required work.
- Exact locations of relocated traffic signal foundations shall be determined by the Traffic Engineering Division.
- The Contractor shall provide and maintain a safe and adequate means of channelizing pedestrian traffic around all work areas throughout the period of construction. All such channelization shall be arranged to prevent pedestrians from having to enter an open traffic lane in order to pass around the work areas.
- All construction signing shall be black on a reflectorized orange field unless otherwise specified. All construction barricades and channelization devices shall be orange on white, reflectorized, unless otherwise specified.
- The Contractor shall prepare and submit to the Project Engineer a detailed project phasing plan at the pre-construction conference for approval prior to beginning construction.

26, 24610388

CITY OF ALBUQUERQUE MUNICIPAL DEVELOPMENT DEPARTMENT ENGINEERING DIVISION					
TITLE: GRIEGOS ROAD SYSTEM SITE PLAN LEGEND & TRAFFIC CONTROL NOTES					
APPROVALS	ENGINEER	DATE	APPROVALS	ENGINEER	DATE
City Engineer	<i>[Signature]</i>	10/27/97	Liquid Waste	<i>[Signature]</i>	10/27/97
A.C.E. - Design	<i>[Signature]</i>	10/27/97	Traffic	<i>[Signature]</i>	10/27/97
A.C.E. - Hydrology	<i>[Signature]</i>	10/27/97	Water	<i>[Signature]</i>	10/27/97
DRAWING NO.	2461		MAP NO.	F14, G14	
SHEET 3			OF 21		

Scanlon Job No. 85/13

RECORD DRAWING

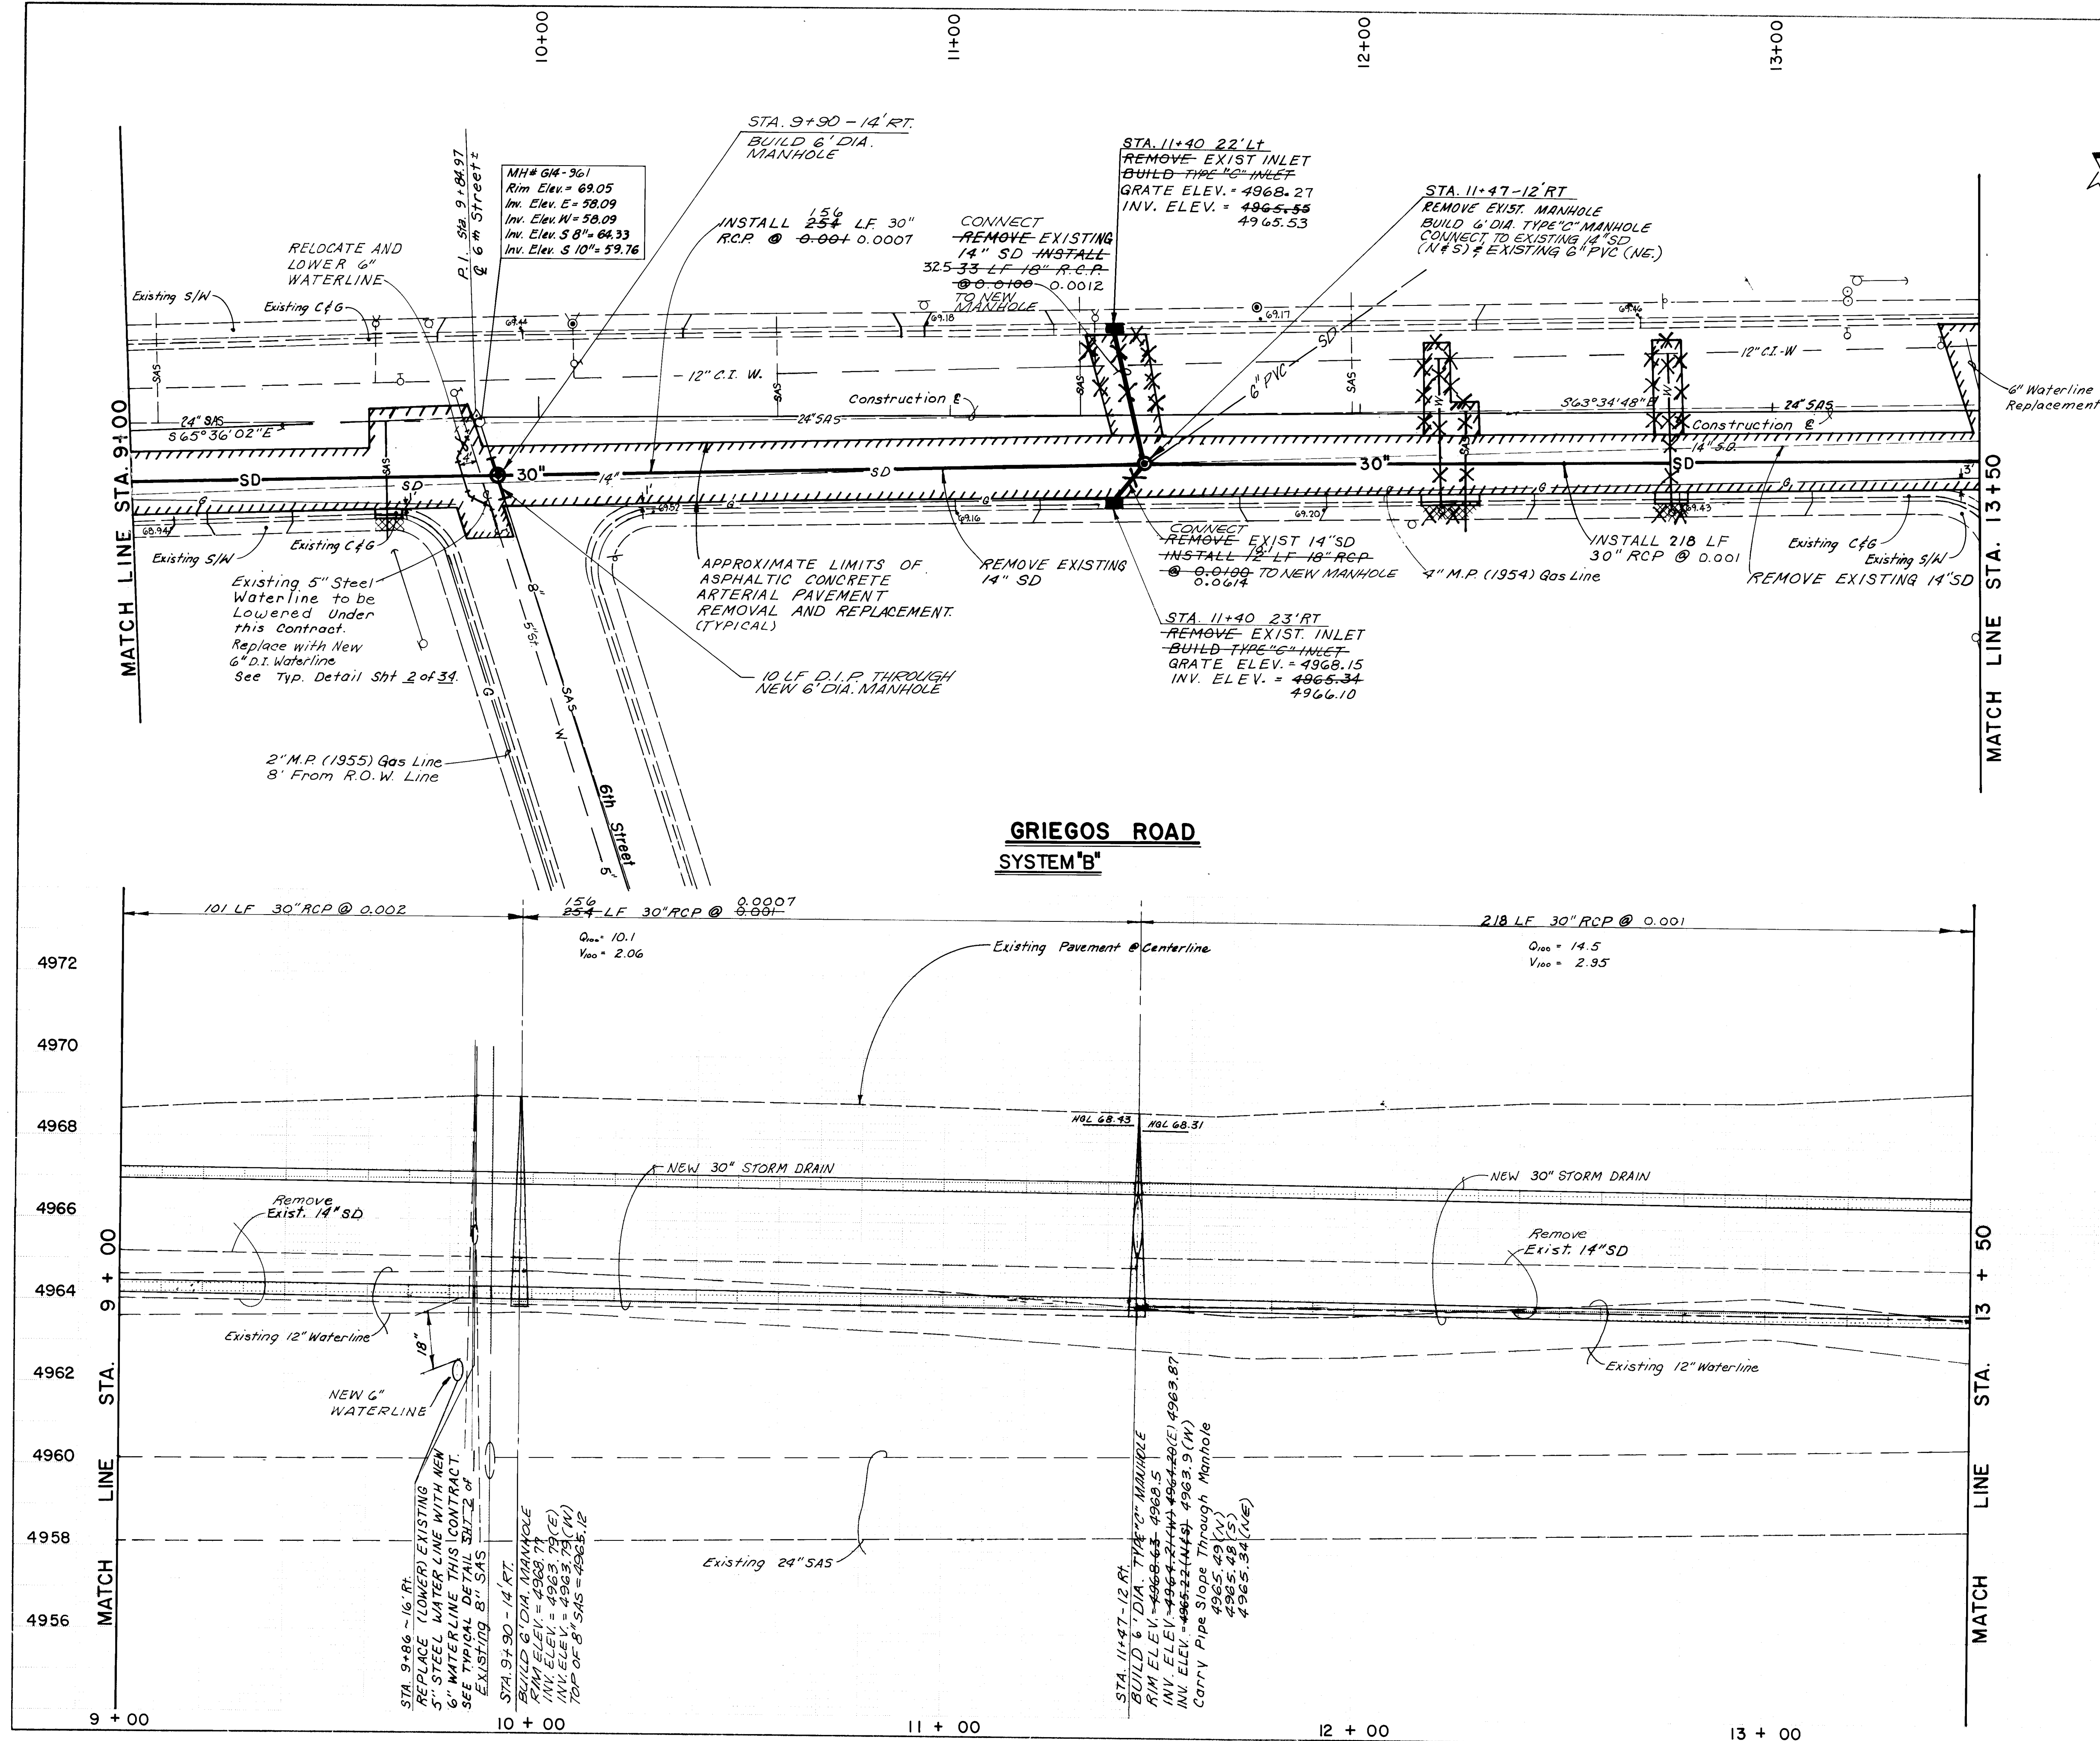

- NOTES
1. All spot elevations shown are at existing top of curb unless otherwise noted.
 2. It will be the responsibility of the contractor to support all gas main and service lines where they are within the area of excavation.
 3. All R.C.P. shall conform to ASTM C-76. See General Notes for pipe class.
 4. Remove and Replace Existing SAS Service Lines at Sta. 9+63± and 12+25± from R.O.W. Line to Existing 24" SAS.
 5. Remove and Replace Existing Water Service Lines at Sta. 12+19± and 12+75± from Main to Meter.

ENGINEER'S SEAL

26 24610688

SCALES
HORIZONTAL 1" = 20'
VERTICAL 1" = 2'

CITY OF ALBUQUERQUE
MUNICIPAL DEVELOPMENT DEPARTMENT
ENGINEERING DIVISION


TITLE NORTH VALLEY DRAINAGE SYSTEM IMPROVEMENTS
GRIEGOS ROAD SYSTEM (B)
STORM DRAIN - STATION 9+00 TO 13+50

APPROVALS	ENGINEER	DATE	APPROVALS	ENGINEER	DATE
City Engineer	[Signature]	10/27/87	Liquid Waste	[Signature]	10/27/87
A.C.E. Design	[Signature]	10/27/87	Traffic	[Signature]	10/27/87
A.C.E. Hydrology	[Signature]	10/27/87	Water	[Signature]	10/27/87


DRAWING NO. 2461 MAP NO. G-14 SHEET 6 OF 21



- | | | | | | | | |
|-----------------|--|--------------------|--|--|--|--------------------------------|--|
| ENGINEER'S SEAL | | SURVEY INFORMATION | | BENCH MARKS | | AS BUILT INFORMATION | |
| | | FIELD NOTES | | NMSHC Brass Tablet Stamped "STA. NM47-9" | | CONTRACTOR: New Concepts, Inc. | |
| | | BY | | DATE | | DATE 11-88 | |
| | | NO. | | DATE | | DATE 11-88 | |
| | | NO. | | DATE | | DATE 11-88 | |
| REMARKS | | BY | | Ground in the Center Island of 2nd Street | | CORRECTED BY: Associates | |
| REVISIONS | | BY | | 125' ± North of Pleasant Street Elev. = 4972.038 | | DATE | |
| DESIGN | | BY | | FIELD ACTION BY | | DATE | |
| S.A.V. | | DATE FEB 86 | | DRAWINGS | | DATE | |
| C.L.W. | | DATE FEB 86 | | MICRO-FILM INFORMATION | | DATE | |
| CHECKED BY | | DATE | | RECORDED BY | | DATE | |
| NO. | | DATE | | NO. | | DATE | |

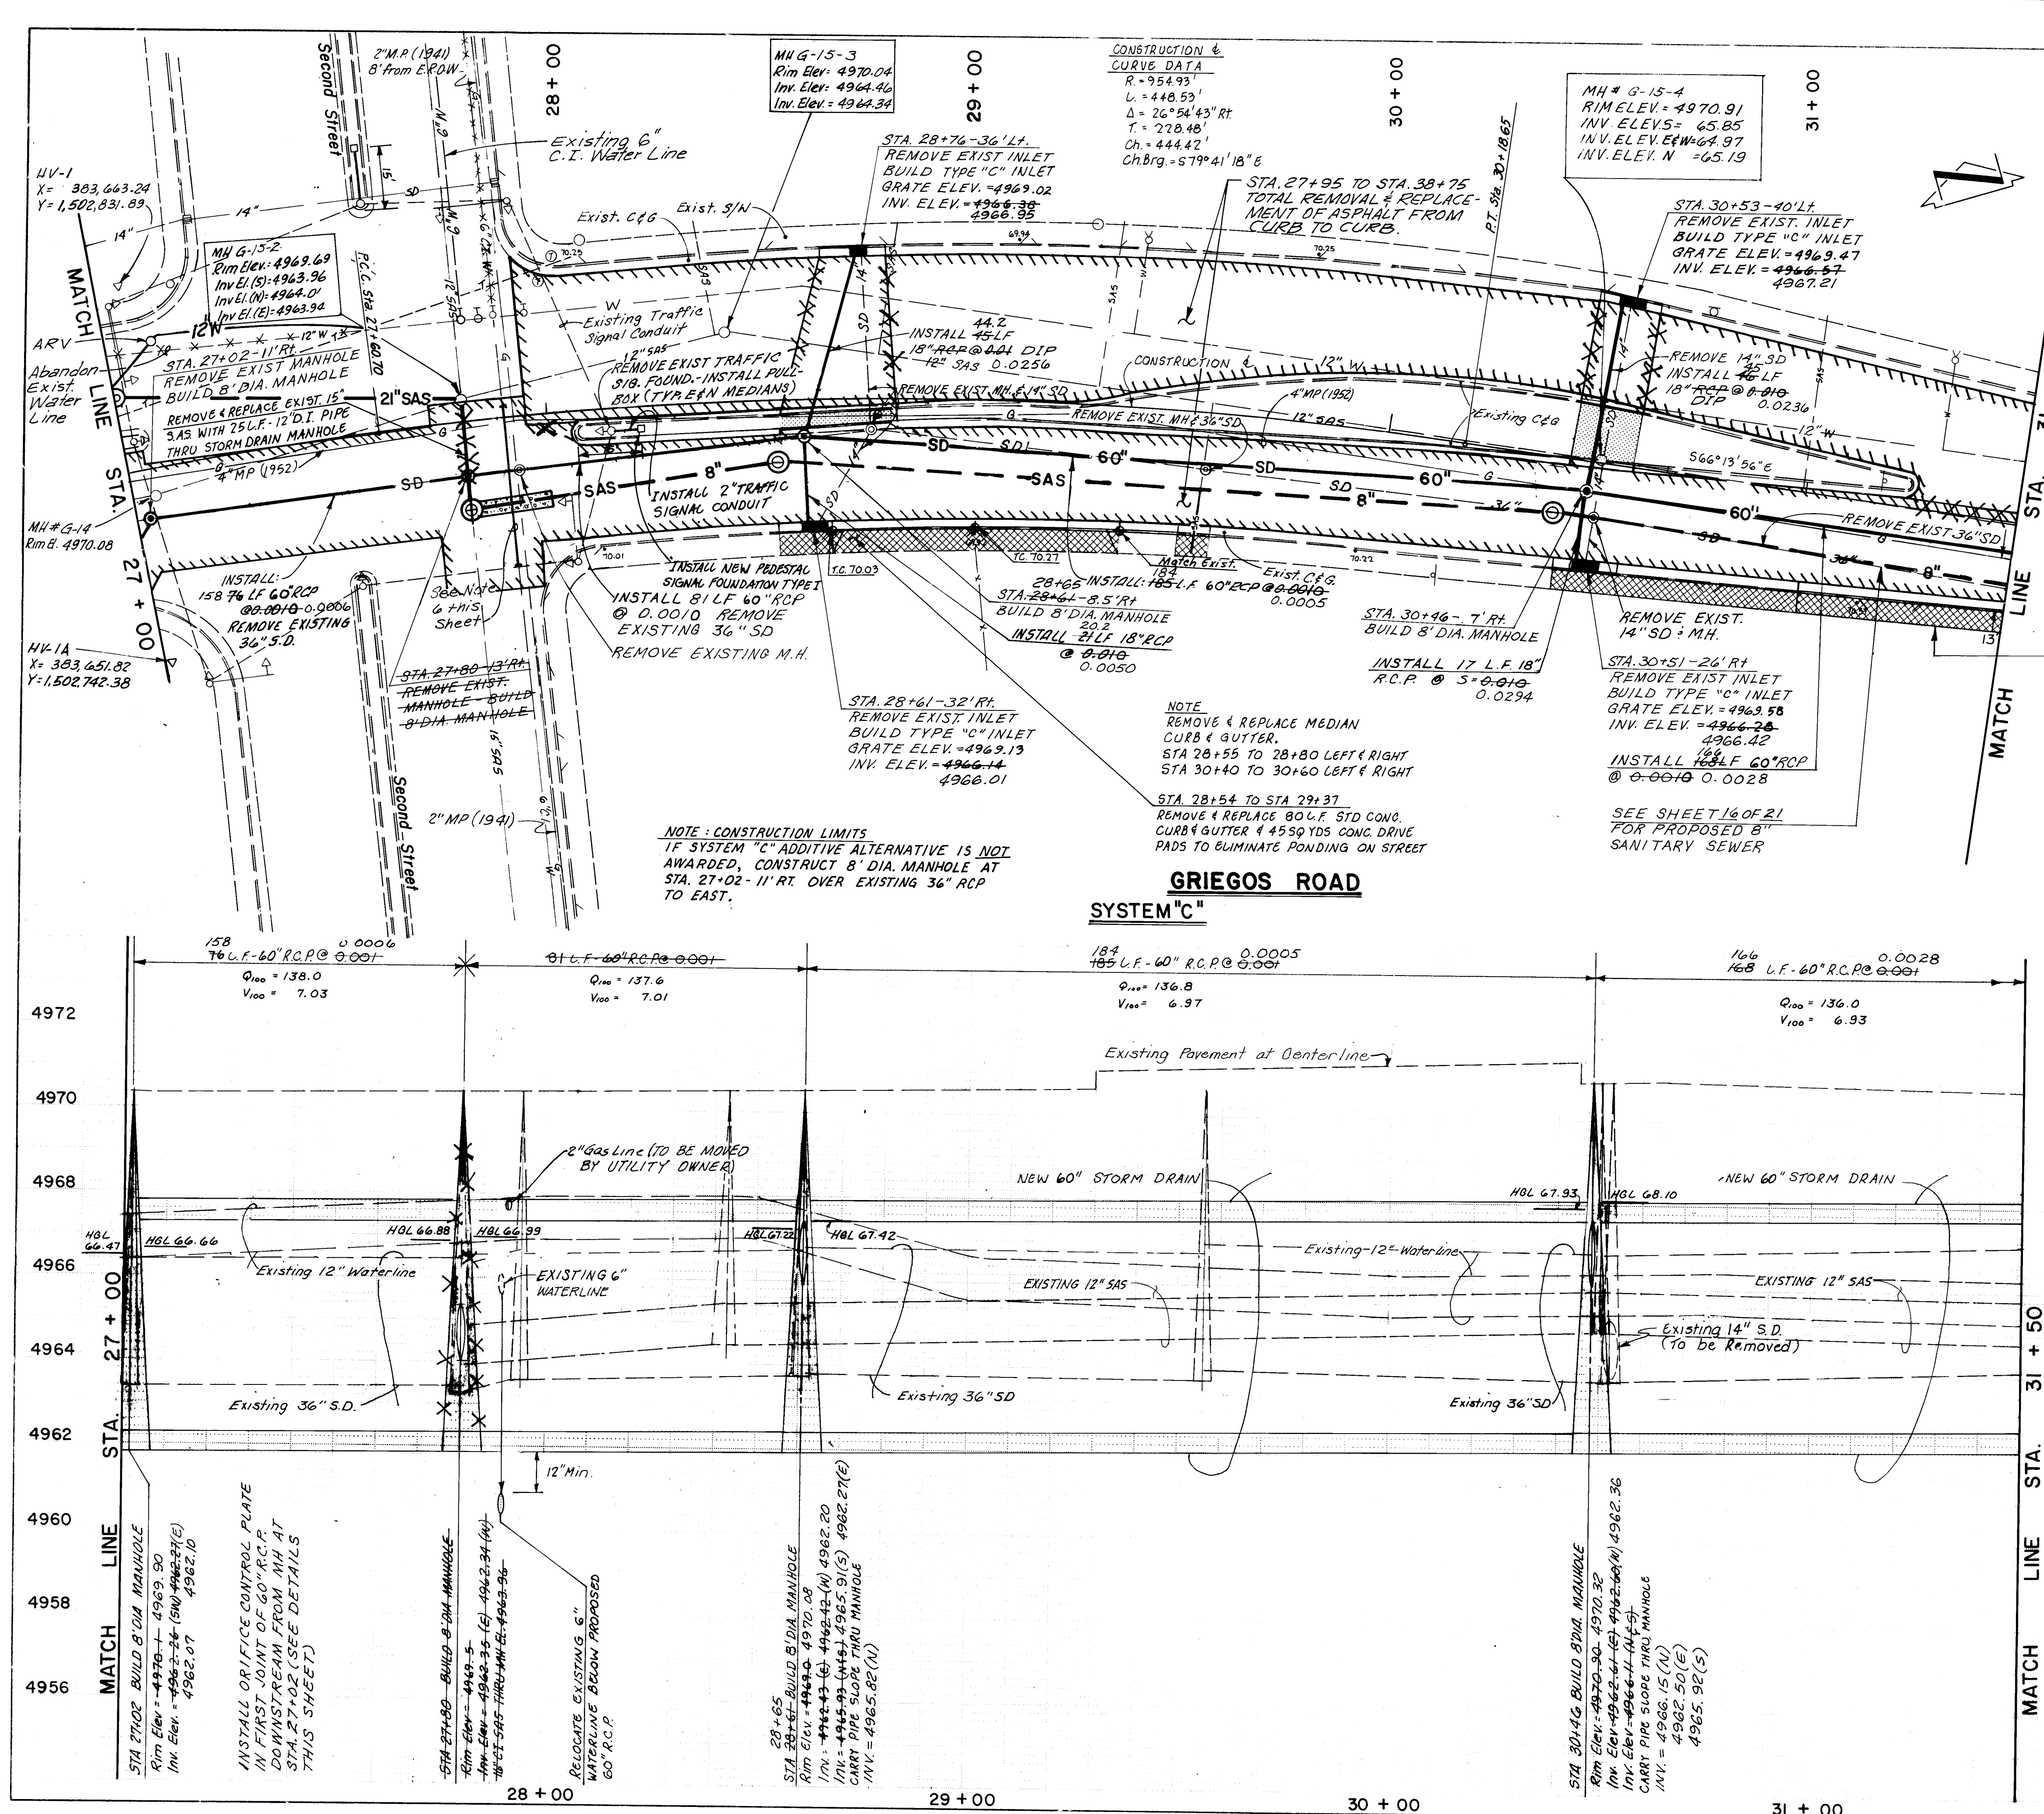


- NOTES**
1. All spot elevations shown are at existing top-of-curb unless otherwise noted.
 2. All R.C.P. shall conform to ASTM C-76. See General Notes for pipe class.
 3. It will be the responsibility of the Contractor to support all gas main and service lines where they are within the Area of excavation.
 4. When crossing Existing Signal Conduit - Replace from Median to Curb Line.
 5. When crossing Traffic Signal Conduit - Replace with 2" Conduit from Curb line to Median.
 6. Relocate Existing 6" Waterline below Proposed 60" S.D. and 8" SAS. Encase 8" SAS with concrete per Std. Details a minimum of 10 feet each side of 6" Waterline.
 7. The existing 4" gas line is to be Relocated by others from Second St. to Carlton Ave. Prior to Construction, along the North Curb Line.

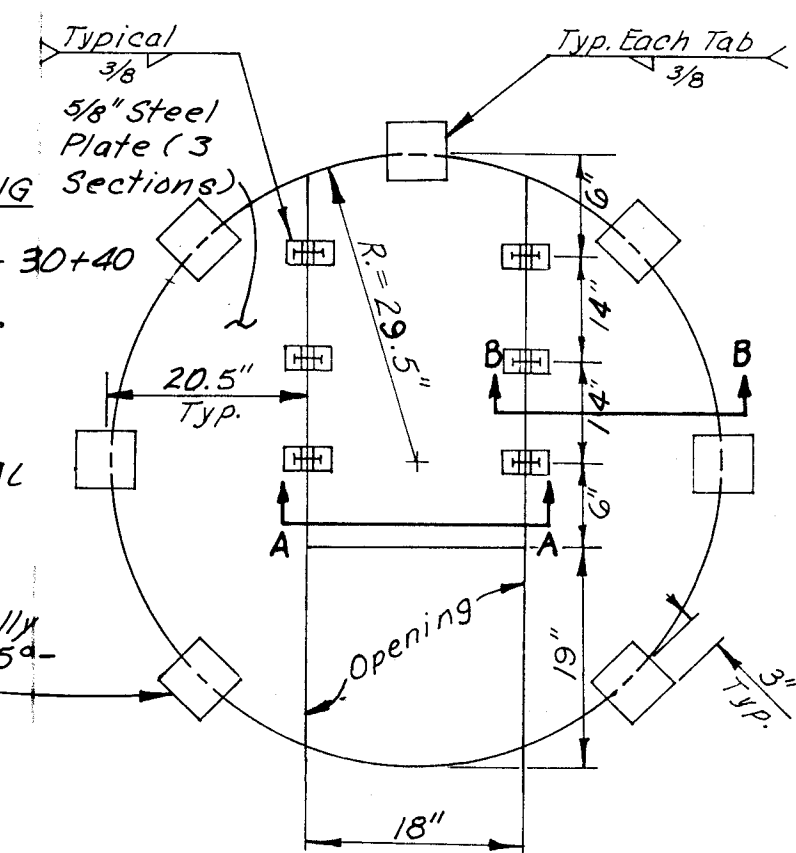


ORIFICE PLATE DETAIL
NOT TO SCALE

NOTE: All Steel shall be Grade 60. Orifice plate shall be Painted w/ two coats of Red Lead Primer & two coats of Aluminum paint per Sect. 157.3 of the Standard Specs's.

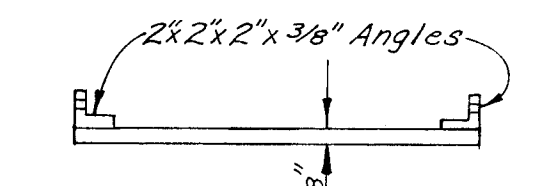

SECTION A

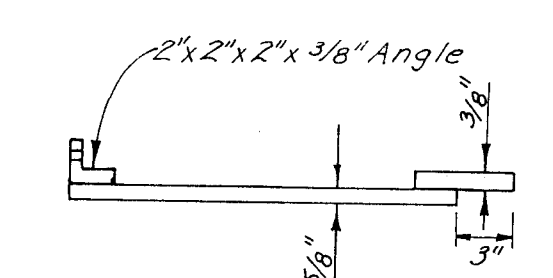


SECTION B

A 3/8" Spacer shall be provided at the Pipe Joint if the Orifice Plate is Not installed Simultaneously with the Pipe Laying Operation.

SCALES
26 24611088
HORIZONTAL 1" = 20'
VERTICAL 1" = 2'

CITY OF ALBUQUERQUE MUNICIPAL DEVELOPMENT DEPARTMENT ENGINEERING DIVISION			
TITLE NORTH VALLEY DRAINAGE SYSTEM IMPROVEMENTS GRIEGOS ROAD SYSTEM (C) STORM DRAIN STATION 27+00 TO 31+50			
APPROVALS	ENGINEER	DATE	APPROVALS
City Engineer	<i>[Signature]</i>	6/27/69	Liquid Waste
ACE - Design			Traffic
ACE - Hydrology	<i>[Signature]</i>	10/22/87	Water
DESIGNED BY	S.A.V.	DATE	FEB 86
DRAWN BY	C.L.W.	DATE	FEB 86
CHECKED BY		DATE	
DRAWING NO. 2461		MAP NO. G-14. SHEET 10 OF 21	

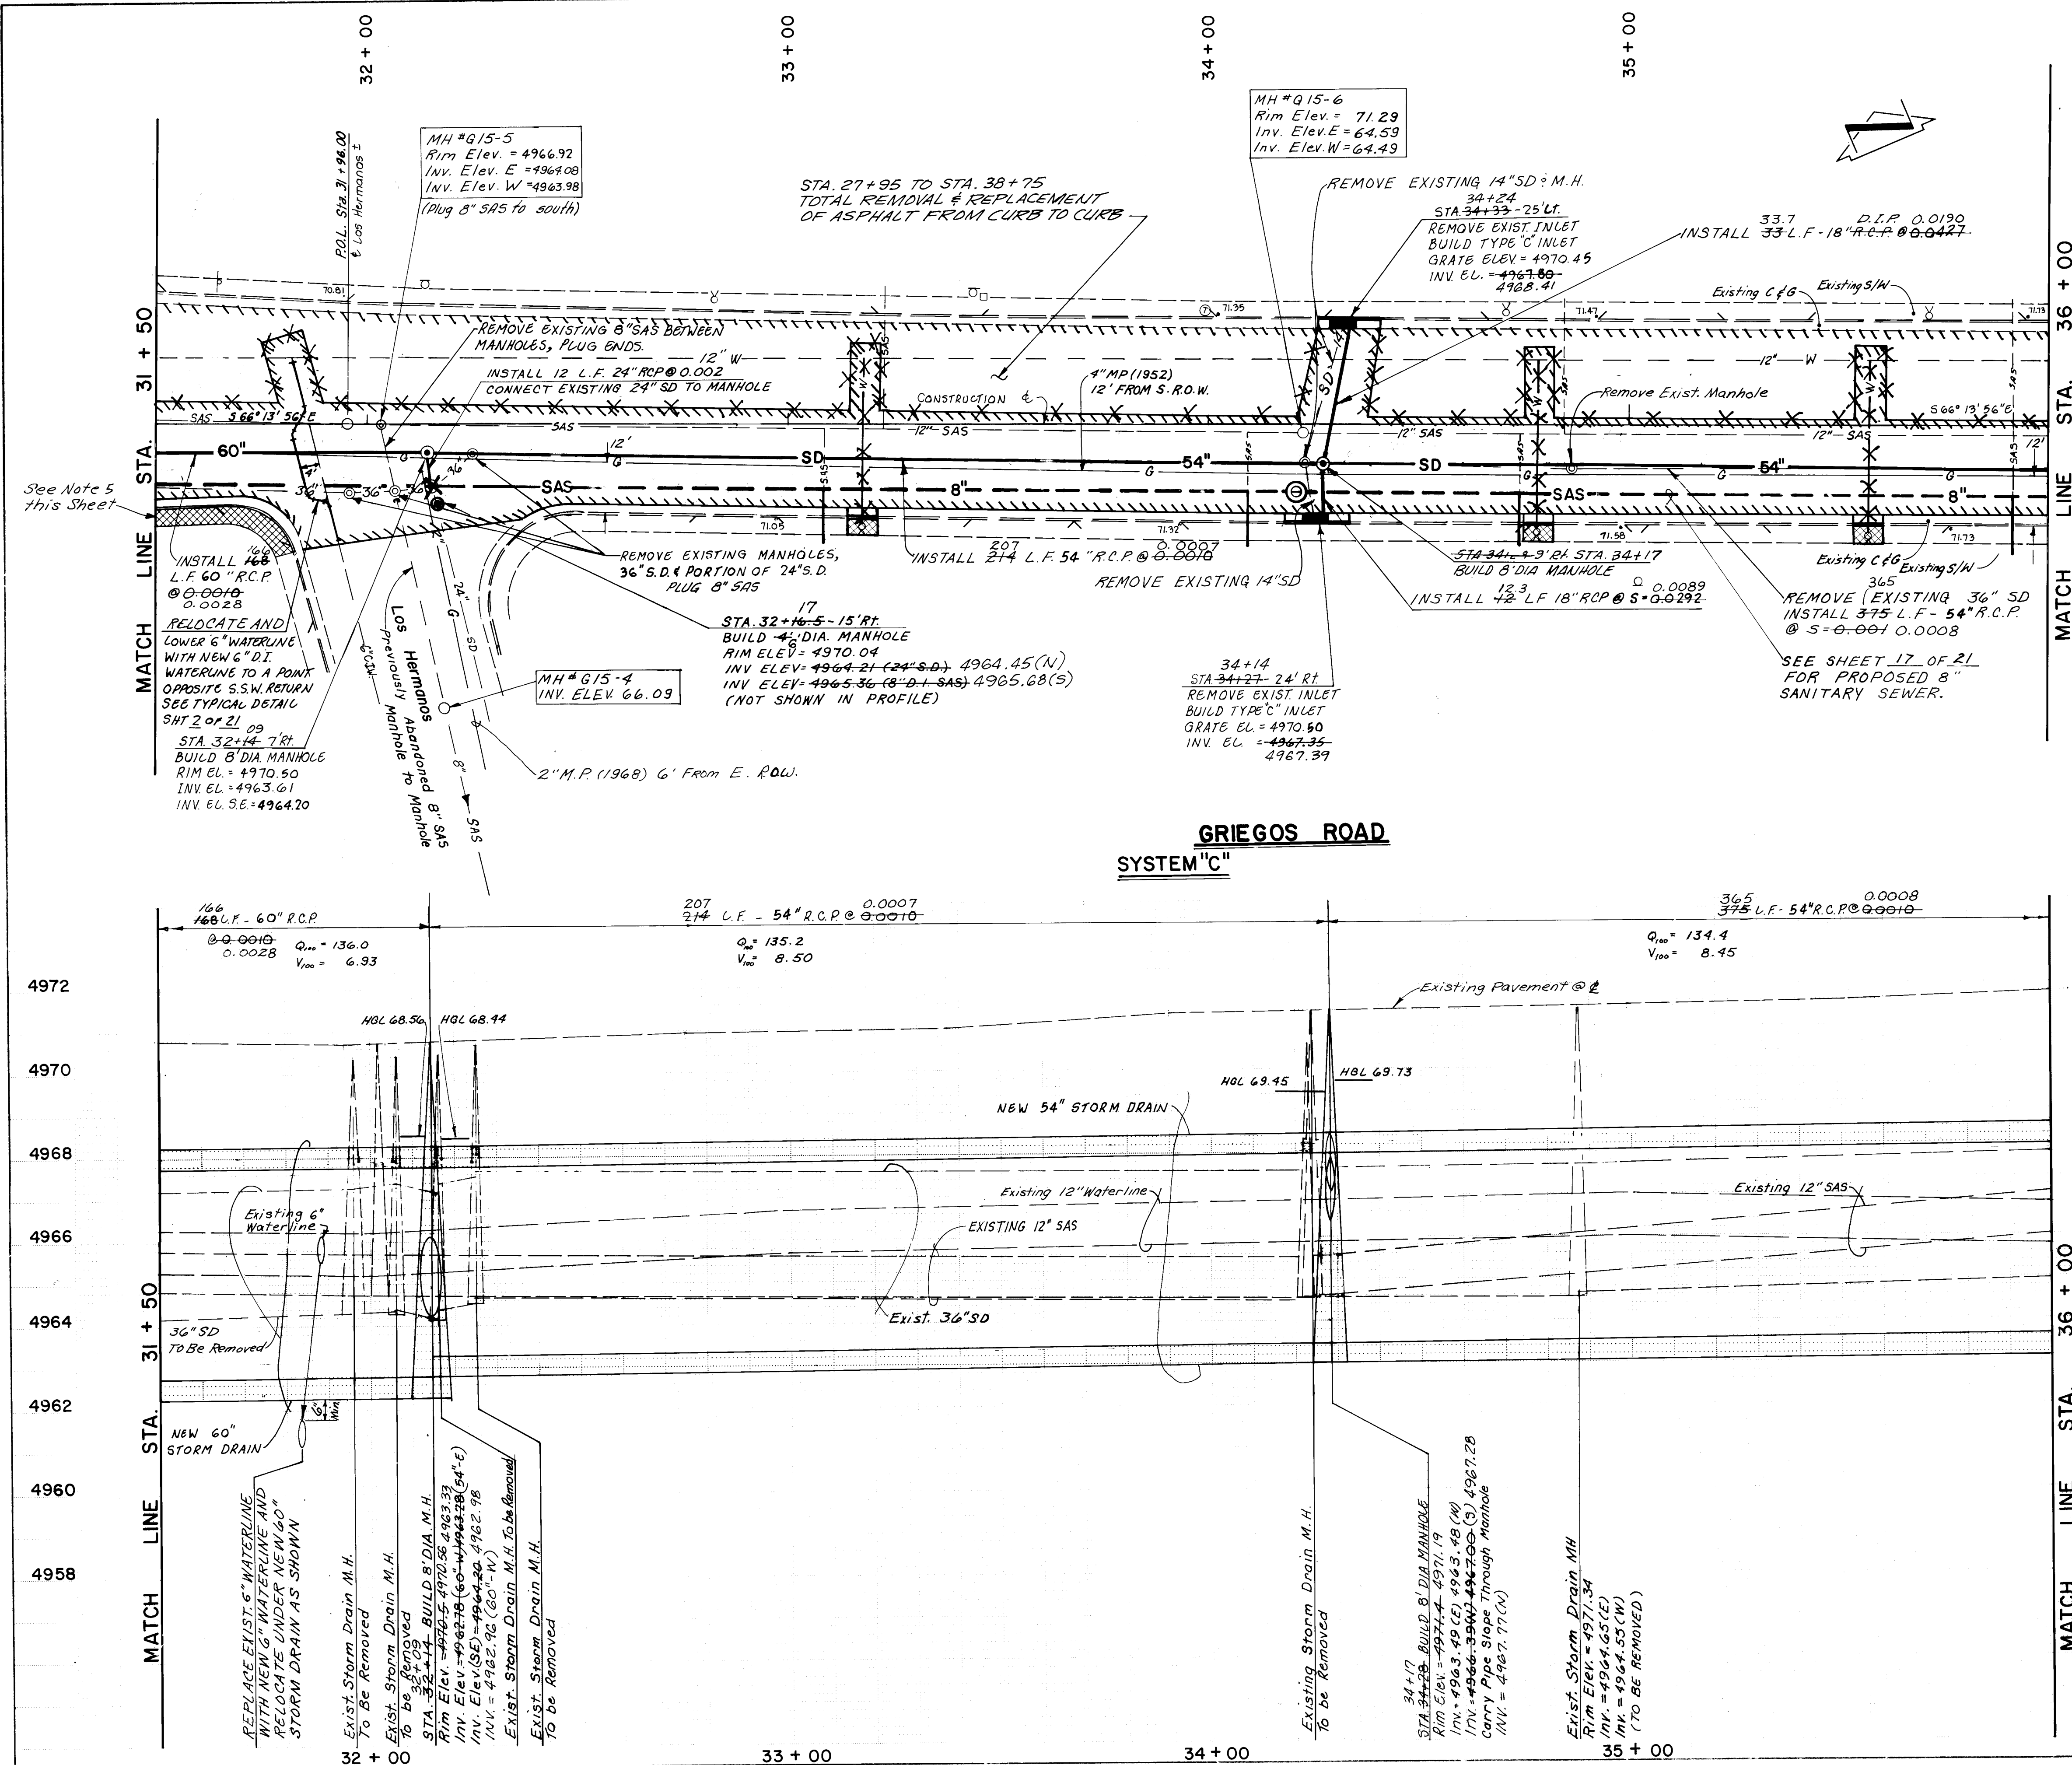


- NOTES
1. All spot elevations shown are at existing top-of-curb unless otherwise noted.
 2. All R.C.P. shall conform to ASTM C-76. See General Notes for Pipe class.
 3. It will be the responsibility of the Contractor to support all gas mains and service lines where they are within the area of excavation.
 4. Remove and Replace Existing Water Service Lines at Sta. 33+18±, 34+78± and 35+57± from Main to Meter.
 5. Remove & Replace Existing Curb and Gutter and Sidewalk from Sta. 31+00 Rt. to End of Curb Return at SW Corner Griegos and Los Hermanos. Contractor Shall Set Grade Reference Stakes Prior to Removal of Curb & Gutter.
 6. The Existing 4" Gas Line is to be relocated by Others from Second Street to Carlton Avenue, Prior to construction, along the North Curb Line.

4972
4970
4968
4966
4964
4962
4960
4958


SCALES
HORIZONTAL 1" = 20'
VERTICAL 1" = 2'

CITY OF ALBUQUERQUE MUNICIPAL DEVELOPMENT DEPARTMENT ENGINEERING DIVISION			
TITLE NORTH VALLEY DRAINAGE SYSTEM IMPROVEMENTS GRIEGOS ROAD SYSTEM (C) STORM DRAIN STATION 31+50 TO 36+00			
APPROVALS	ENGINEER	DATE	APPROVALS
City Engineer	<i>[Signature]</i>	4/2/91	Liquid Waste
A-C-E Design			Traffic
A-E Hydrology	Steve Boley	10/22/91	Water
DESIGNED BY	S.A.V.	DATE	DESIGNED BY
DRAWN BY	C.L.W.	DATE	DRAWN BY
CHECKED BY		DATE	CHECKED BY

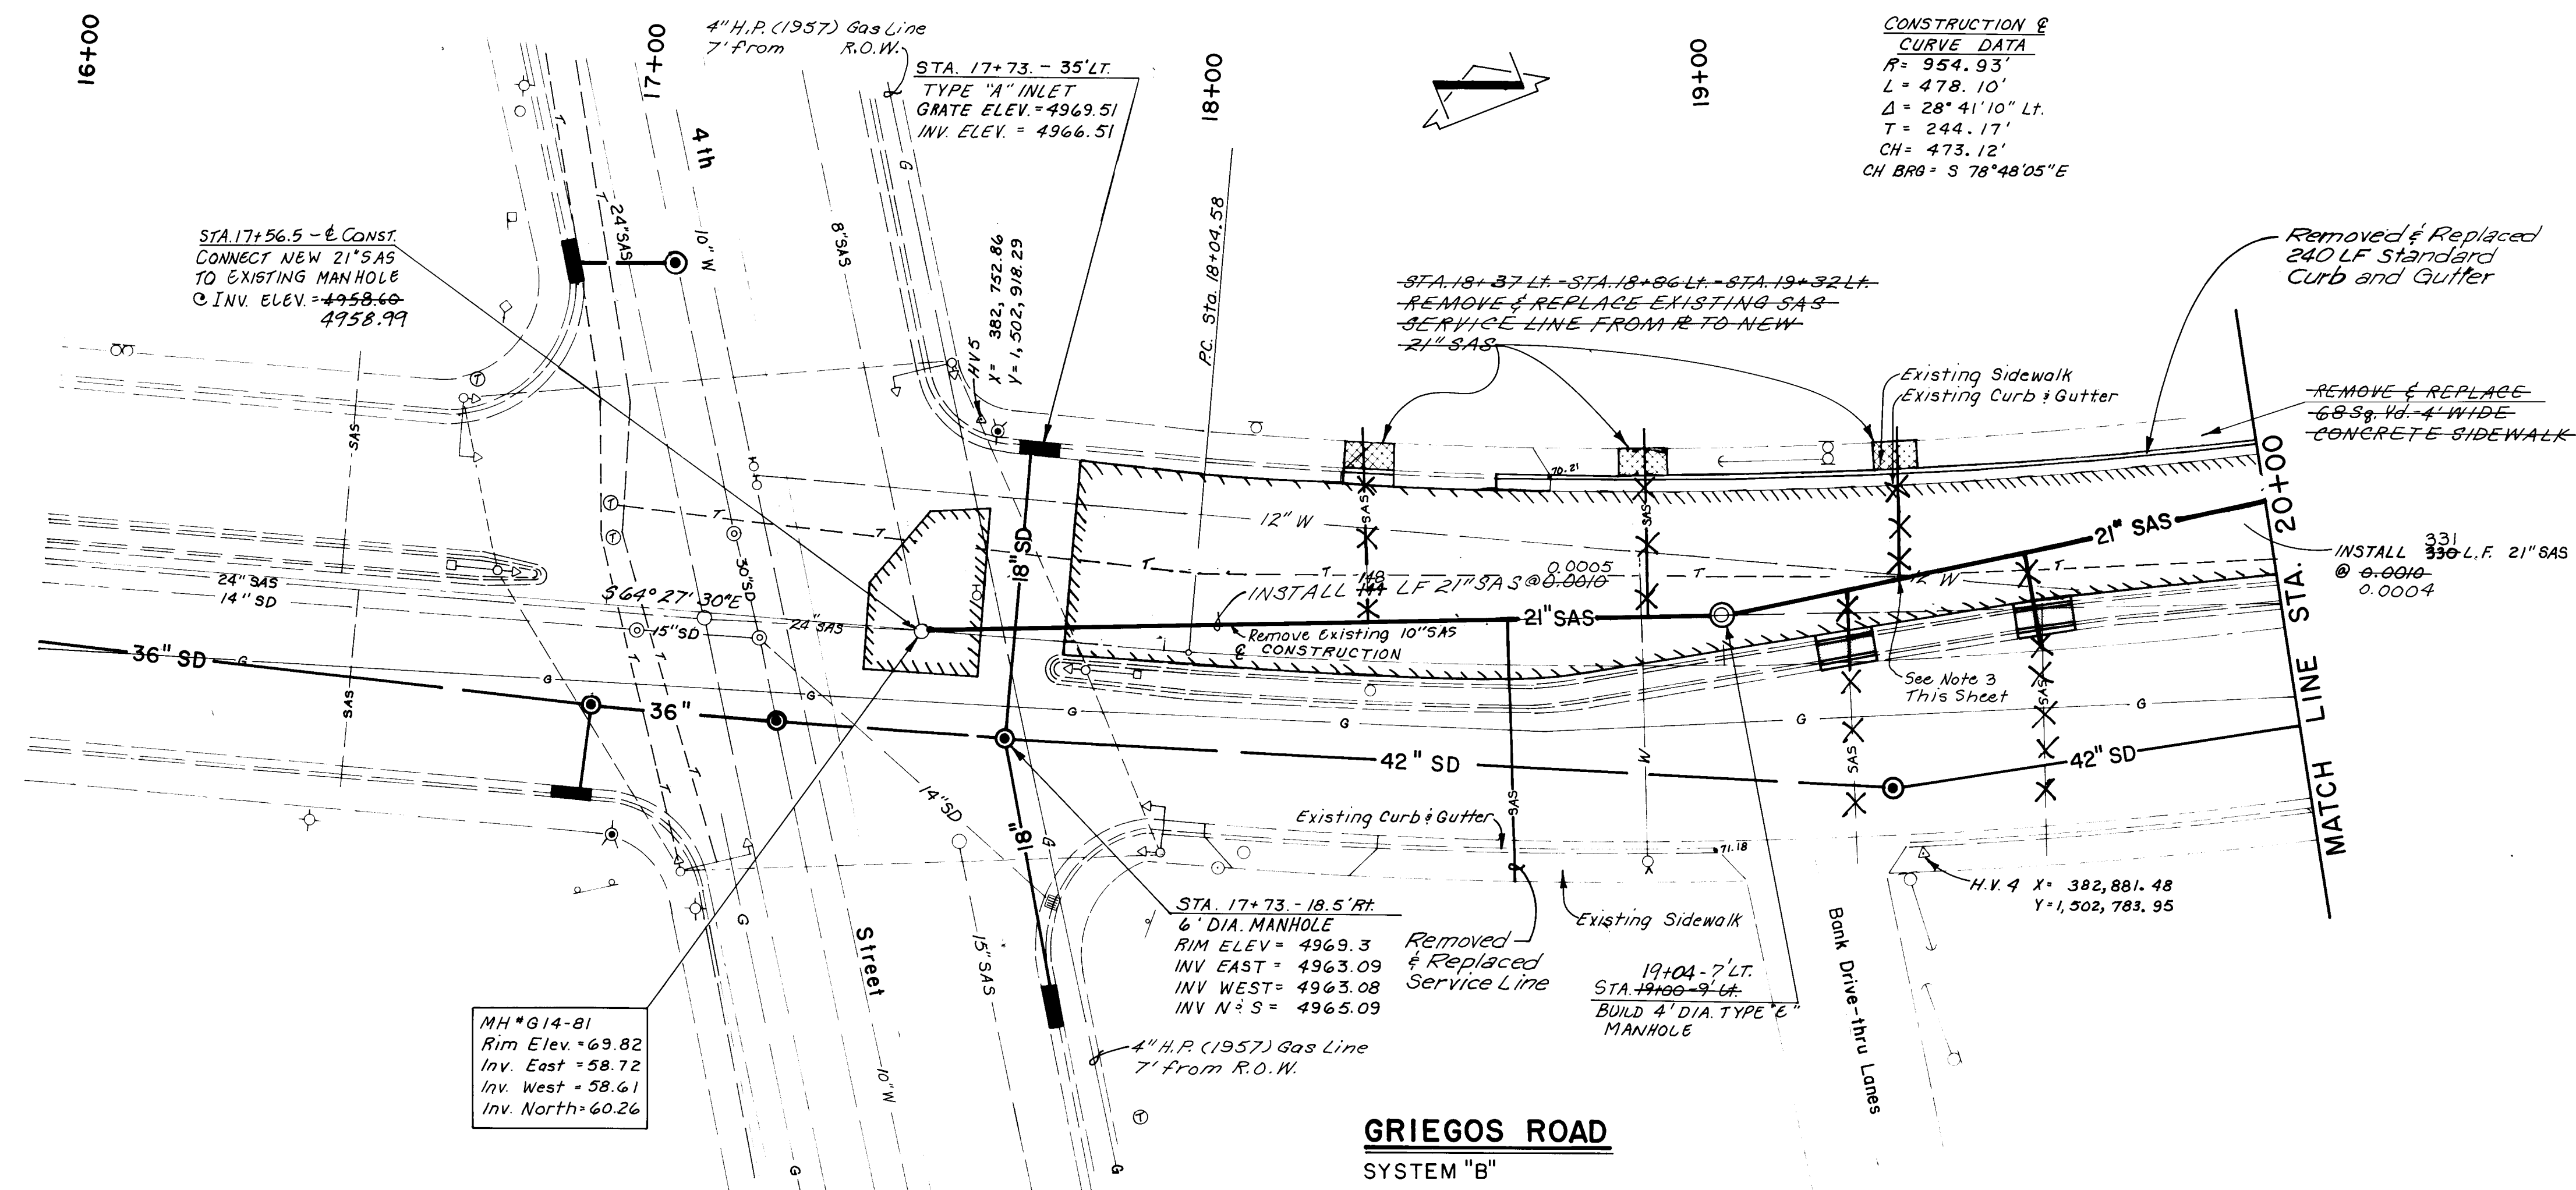


NOTES:

1. The existing 10" SAS is to be abandoned from Sta. 17+56.5 to Sta. 26+05. All existing Services shown on the Plans or encountered during Construction are to be disconnected from the 10" SAS and reconnected to the new 21" SAS. The Contractor shall be required to remove & replace existing services to a point where a minimum 1% slope can be maintained.
2. All SAS Service disconnections from the existing 10" SAS main shall be plugged with Concrete at the main.
3. The Contractor shall support existing 12" Waterline and existing Telephone Conduit during Construction of New 21" SAS

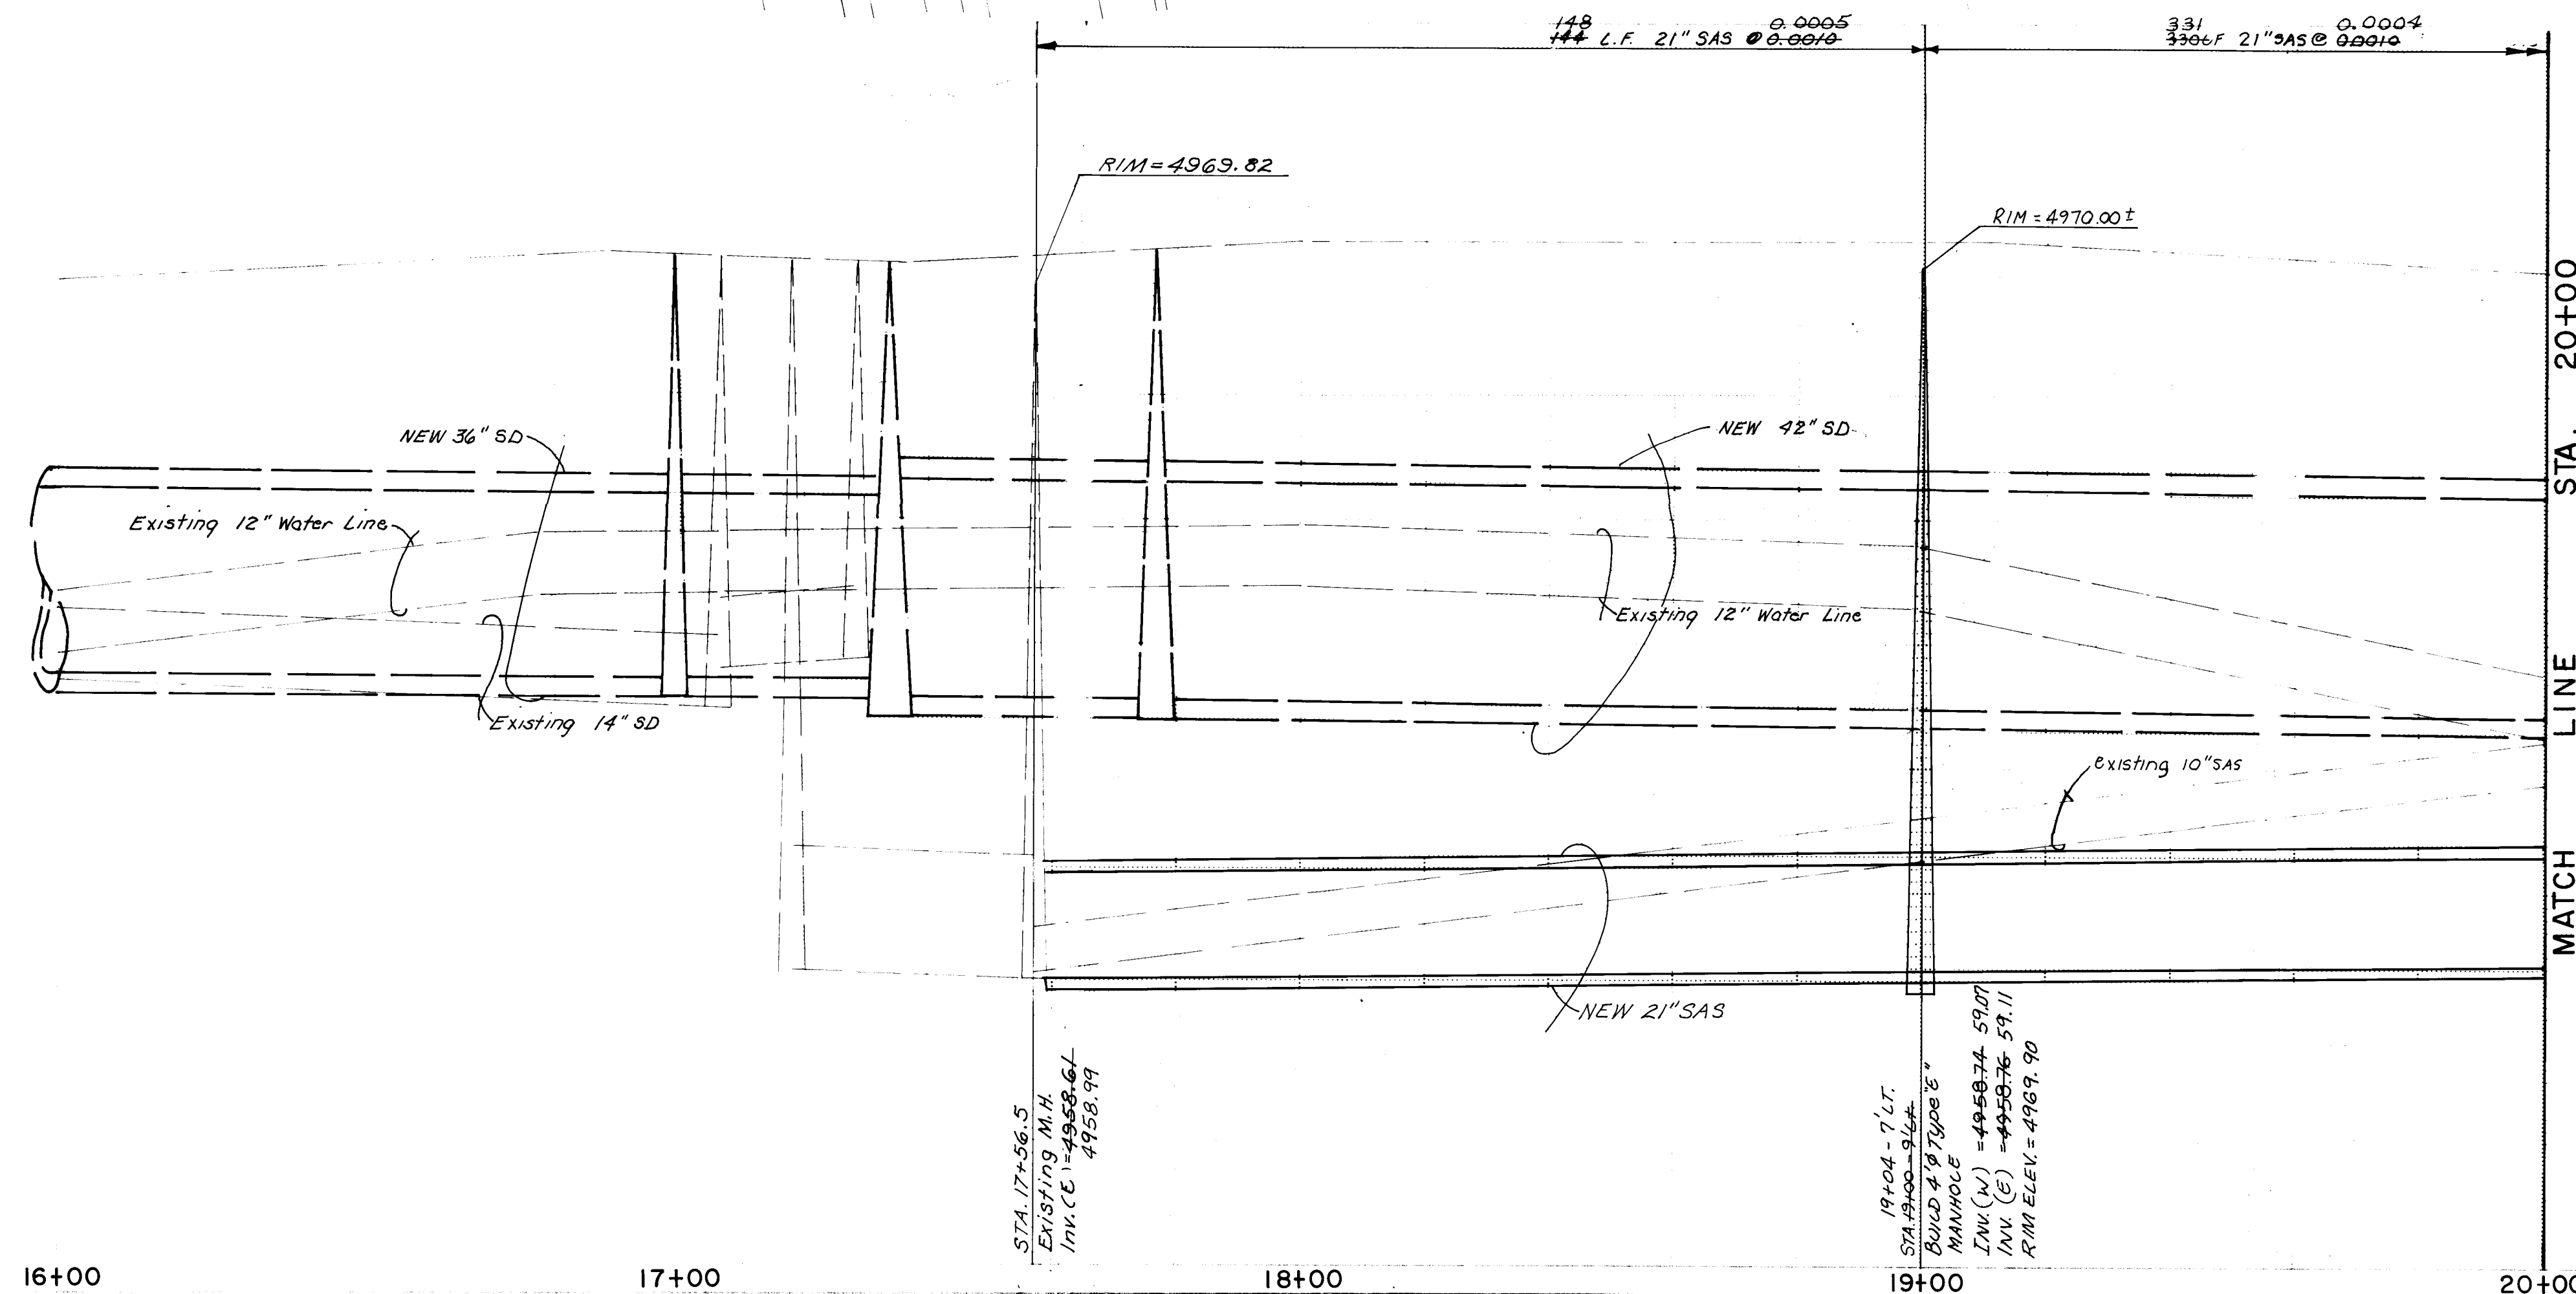

ENGINEER'S SEAL		SURVEY INFORMATION		BENCH MARKS		AS BUILT INFORMATION	
ENGINEER'S SEAL		FIELD NOTES		NMSHC Brass Tablet Stamped "STA. NM47-9"		AS BUILT INFORMATION	
ENGINEER'S SEAL		NO.	BY	DATE	Set in the Top of a Concrete Post Flush with the Ground in the Center Island of 2nd Street	AS BUILT INFORMATION	
ENGINEER'S SEAL		NO.	BY	DATE	125' ± North of Pleasant Street Elev = 4972.038	AS BUILT INFORMATION	
ENGINEER'S SEAL		REMARKS		NMSHC Brass Tablet Stamped "STA. NM47-9"		AS BUILT INFORMATION	
ENGINEER'S SEAL		BY		Set in the Top of a Concrete Post Flush with the Ground in the Center Island of 2nd Street		AS BUILT INFORMATION	
ENGINEER'S SEAL		NO. DATE		125' ± North of Pleasant Street Elev = 4972.038		AS BUILT INFORMATION	
ENGINEER'S SEAL		REVISIONS		NMSHC Brass Tablet Stamped "STA. NM47-9"		AS BUILT INFORMATION	
ENGINEER'S SEAL		DESIGN		Set in the Top of a Concrete Post Flush with the Ground in the Center Island of 2nd Street		AS BUILT INFORMATION	
ENGINEER'S SEAL		DESIGNED BY J.D.R.		125' ± North of Pleasant Street Elev = 4972.038		AS BUILT INFORMATION	
ENGINEER'S SEAL		DRAWN BY B.H.G.W.		NMSHC Brass Tablet Stamped "STA. NM47-9"		AS BUILT INFORMATION	
ENGINEER'S SEAL		CHECKED BY J.D.R.		Set in the Top of a Concrete Post Flush with the Ground in the Center Island of 2nd Street		AS BUILT INFORMATION	
ENGINEER'S SEAL		DATE 10-86		125' ± North of Pleasant Street Elev = 4972.038		AS BUILT INFORMATION	
ENGINEER'S SEAL		DATE 10-86		NMSHC Brass Tablet Stamped "STA. NM47-9"		AS BUILT INFORMATION	
ENGINEER'S SEAL		DATE 10-86		Set in the Top of a Concrete Post Flush with the Ground in the Center Island of 2nd Street		AS BUILT INFORMATION	
ENGINEER'S SEAL		DATE 10-86		125' ± North of Pleasant Street Elev = 4972.038		AS BUILT INFORMATION	

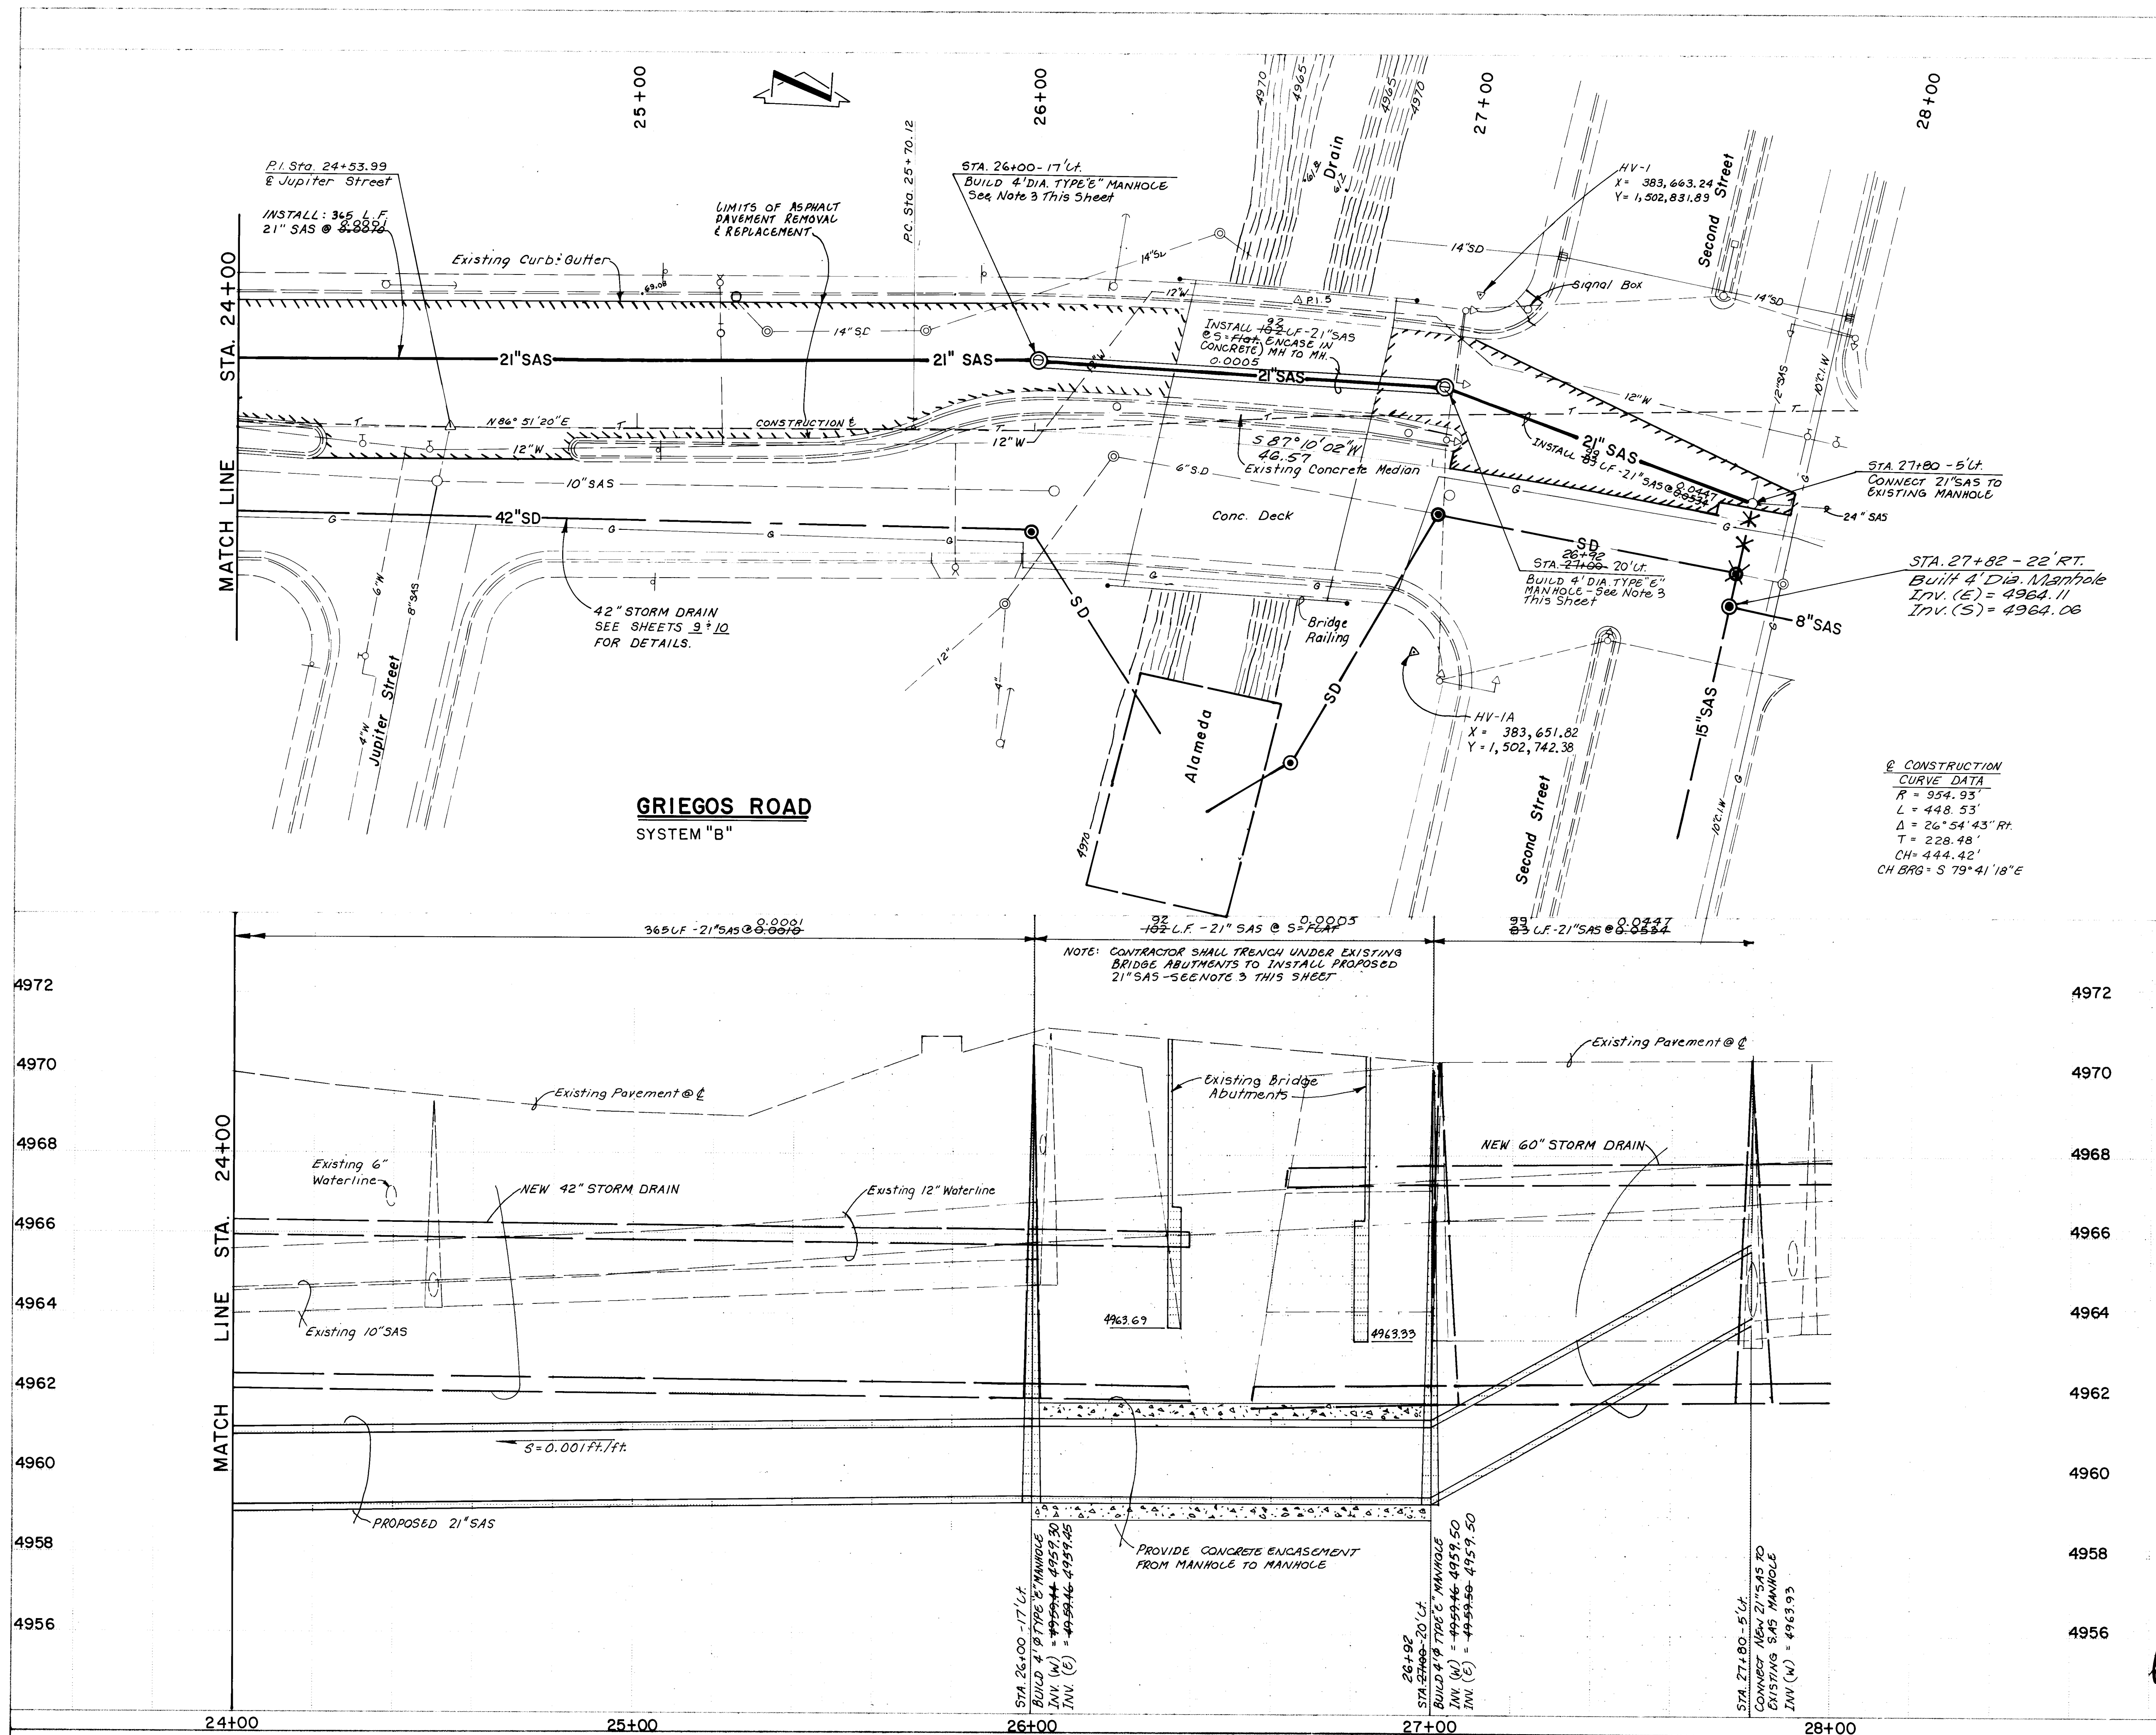

NOTES:

1. The existing 10" SAS is to be abandoned from Sta. 17+56.5 to Sta. 26+05. All existing services shown on the Plans or encountered during construction are to be disconnected from the 10" SAS and reconnected to the new 21" SAS. The Contractor shall be required to remove & replace existing services to a point where a minimum 2% slope can be maintained.

2. All SAS Service disconnections from the existing 10" SAS main shall be plugged with concrete at the main.

3. The existing Bridge Abutments are supported by 12" Treated Timber Piles spaced 3'-3" O.C. The Contractor shall excavate below the Abutments at their outside face prior to construction of the Manholes at STA 26+00 and STA 27+00 to determine actual pile locations. The Manholes may require adjustment in the field to Align the 21" SAS through the piles.

AS BUILT INFORMATION

AS BUILT INFORMATION

AS BUILT INFORMATION

ENGINEER'S SEAL

26 24611588

REVISIONS

NO.	DATE	REMARKS
1	10/27/86	DESIGN
2	10/27/86	DESIGN
3	10/27/86	DESIGN

APPROVALS

APPROVALS	ENGINEER	DATE
City Engineer	10/27/86	10/27/86
A.C.E. - Design	10/27/86	10/27/86
A.C.E. - Hydrology	10/27/86	10/27/86

CITY OF ALBUQUERQUE
MUNICIPAL DEVELOPMENT DEPARTMENT
ENGINEERING DIVISION


TITLE: NORTH VALLEY DRAINAGE SYSTEM IMPROVEMENTS
GRIEGOS ROAD SYSTEM (B)

SANITARY SEWER STATION 24+00 TO 28+00

DRAWING NO. 2461

MAP NO. G-15

SHEET 15 OF 21

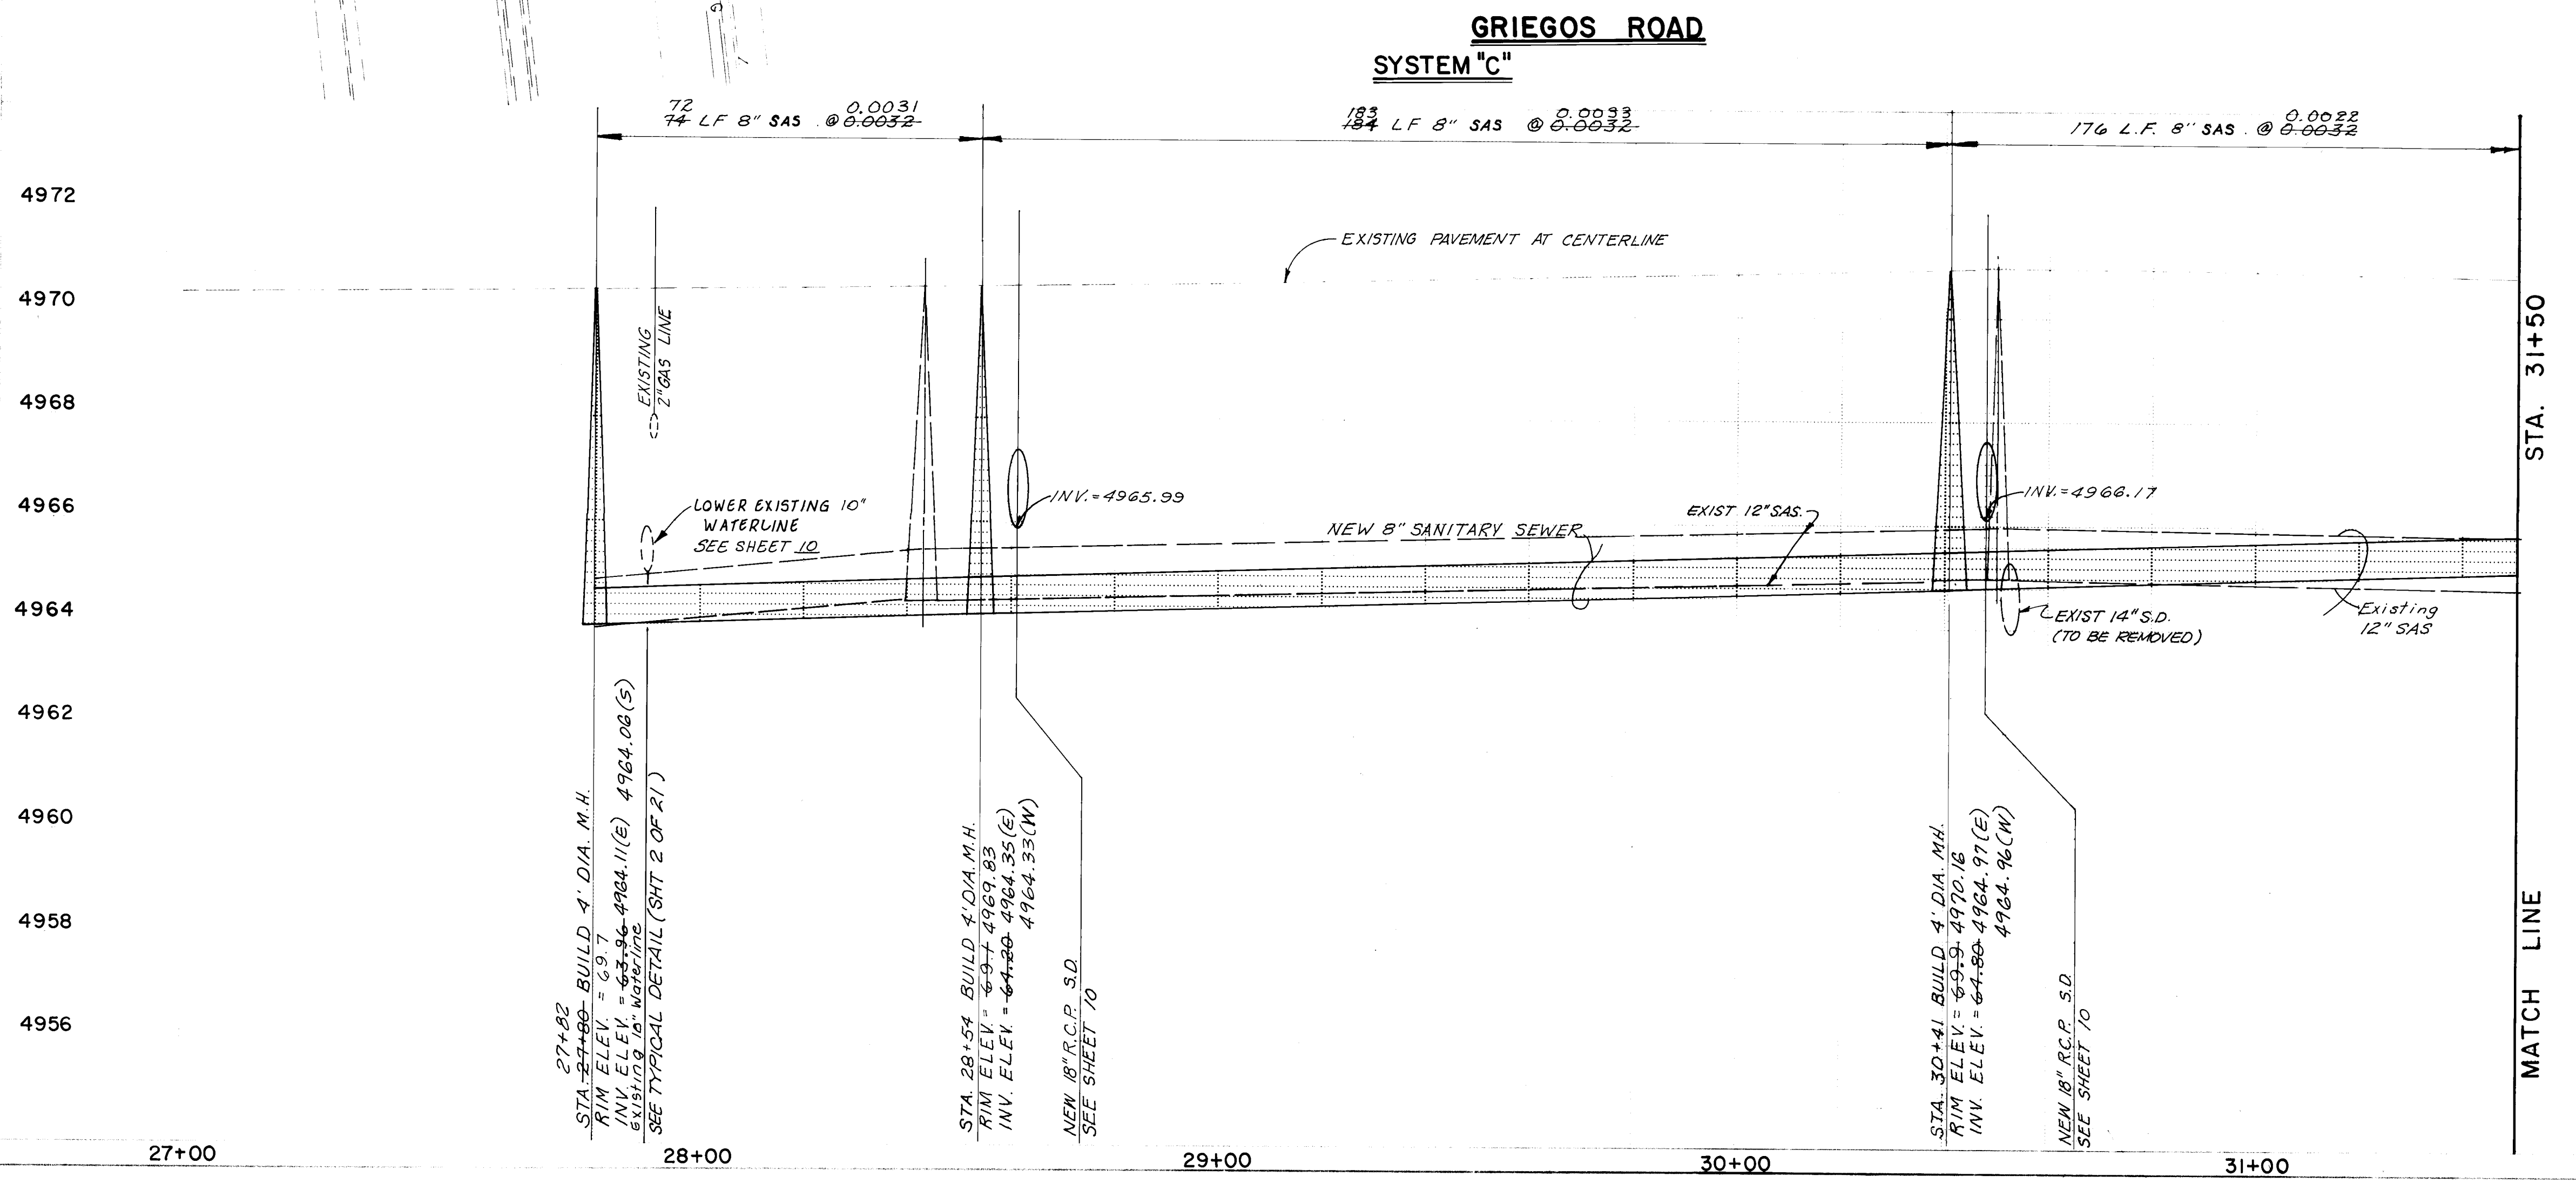


SURVEY INFORMATION	BENCH MARKS	AS BUILT INFORMATION
FIELD NOTES	NMSGHC Brass Tablet Stamped "STA. NM47-9"	New Concepts, Inc.
NO BY DATE	Set in the Top of a Concrete Post Flush with the Ground in the Center Island of 2nd Street 125' ± North of Pleasant Street Elev = 4972.038	WILLIAM E. STANLEY & ASSOCIATES P.O. BOX 67 NEWTON, MASSACHUSETTS 02459-0067 TEL: (617) 552-1188 FAX: (617) 552-1188
		CORRECTED BY ASSOCIATES DA11-88
		MICRO-FILM INFORMATION
		# RECORDED BY _____ DATE _____
		NO _____

ENGINEER'S SEAL			
NO.	DATE	REMARKS	BY
REVISIONS			
DESIGN			
DESIGNED BY	S.A.V.	DATE	FEB 86
DRAWN BY	C.L.W.	DATE	FEB 86
CHECKED BY		DATE	

CITY OF ALBUQUERQUE
MUNICIPAL DEVELOPMENT DEPARTMENT
ENGINEERING DIVISION

TITLE NORTH VALLEY DRAINAGE SYSTEM IMPROVEMENTS
GRIEGOS ROAD SYSTEM (C)
SANITARY SEWER - STATION 27+80 TO 31+50

APPROVAL S	ENGINEER	DATE	APPROVAL S	ENGINEER	DATE
City Engineer	<i>[Signature]</i>	10/27/87	Liquid Waste	<i>[Signature]</i>	10/27/87
A.C.E. Design	" "	"	Traffic	<i>[Signature]</i>	10/27/87
A.C.E. Hydrology	<i>[Signature]</i>	10/27/87	Water	<i>[Signature]</i>	10/27/87

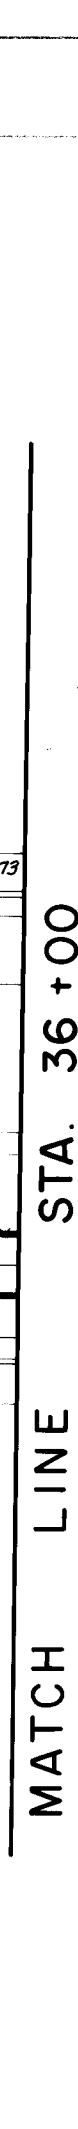

1. All spot elevations shown are of existing top-of-curb unless otherwise noted.
2. It will be the responsibility of the Contractor to support all gas mains and service lines where they are within the area of excavation.
3. See Sheet 11 for approximate limits of pavement removal.




SCALES

HORIZONTAL	1" = 20'
VERTICAL	1" = 2'

APPROVALS	ENGINEER	DATE	APPROVALS	ENGINEER	DATE
City Engineer	<i>[Signature]</i>	10/27/87	Liquid Waste	<i>[Signature]</i>	10/27/87
ACE-Design	" "	"	Traffic	<i>[Signature]</i>	10/27/87
ACE-Hydrology	<i>[Signature]</i>	10/27/87	Water	<i>[Signature]</i>	10/27/87

Scanlon Job No. 85113

RECORD DRAWING

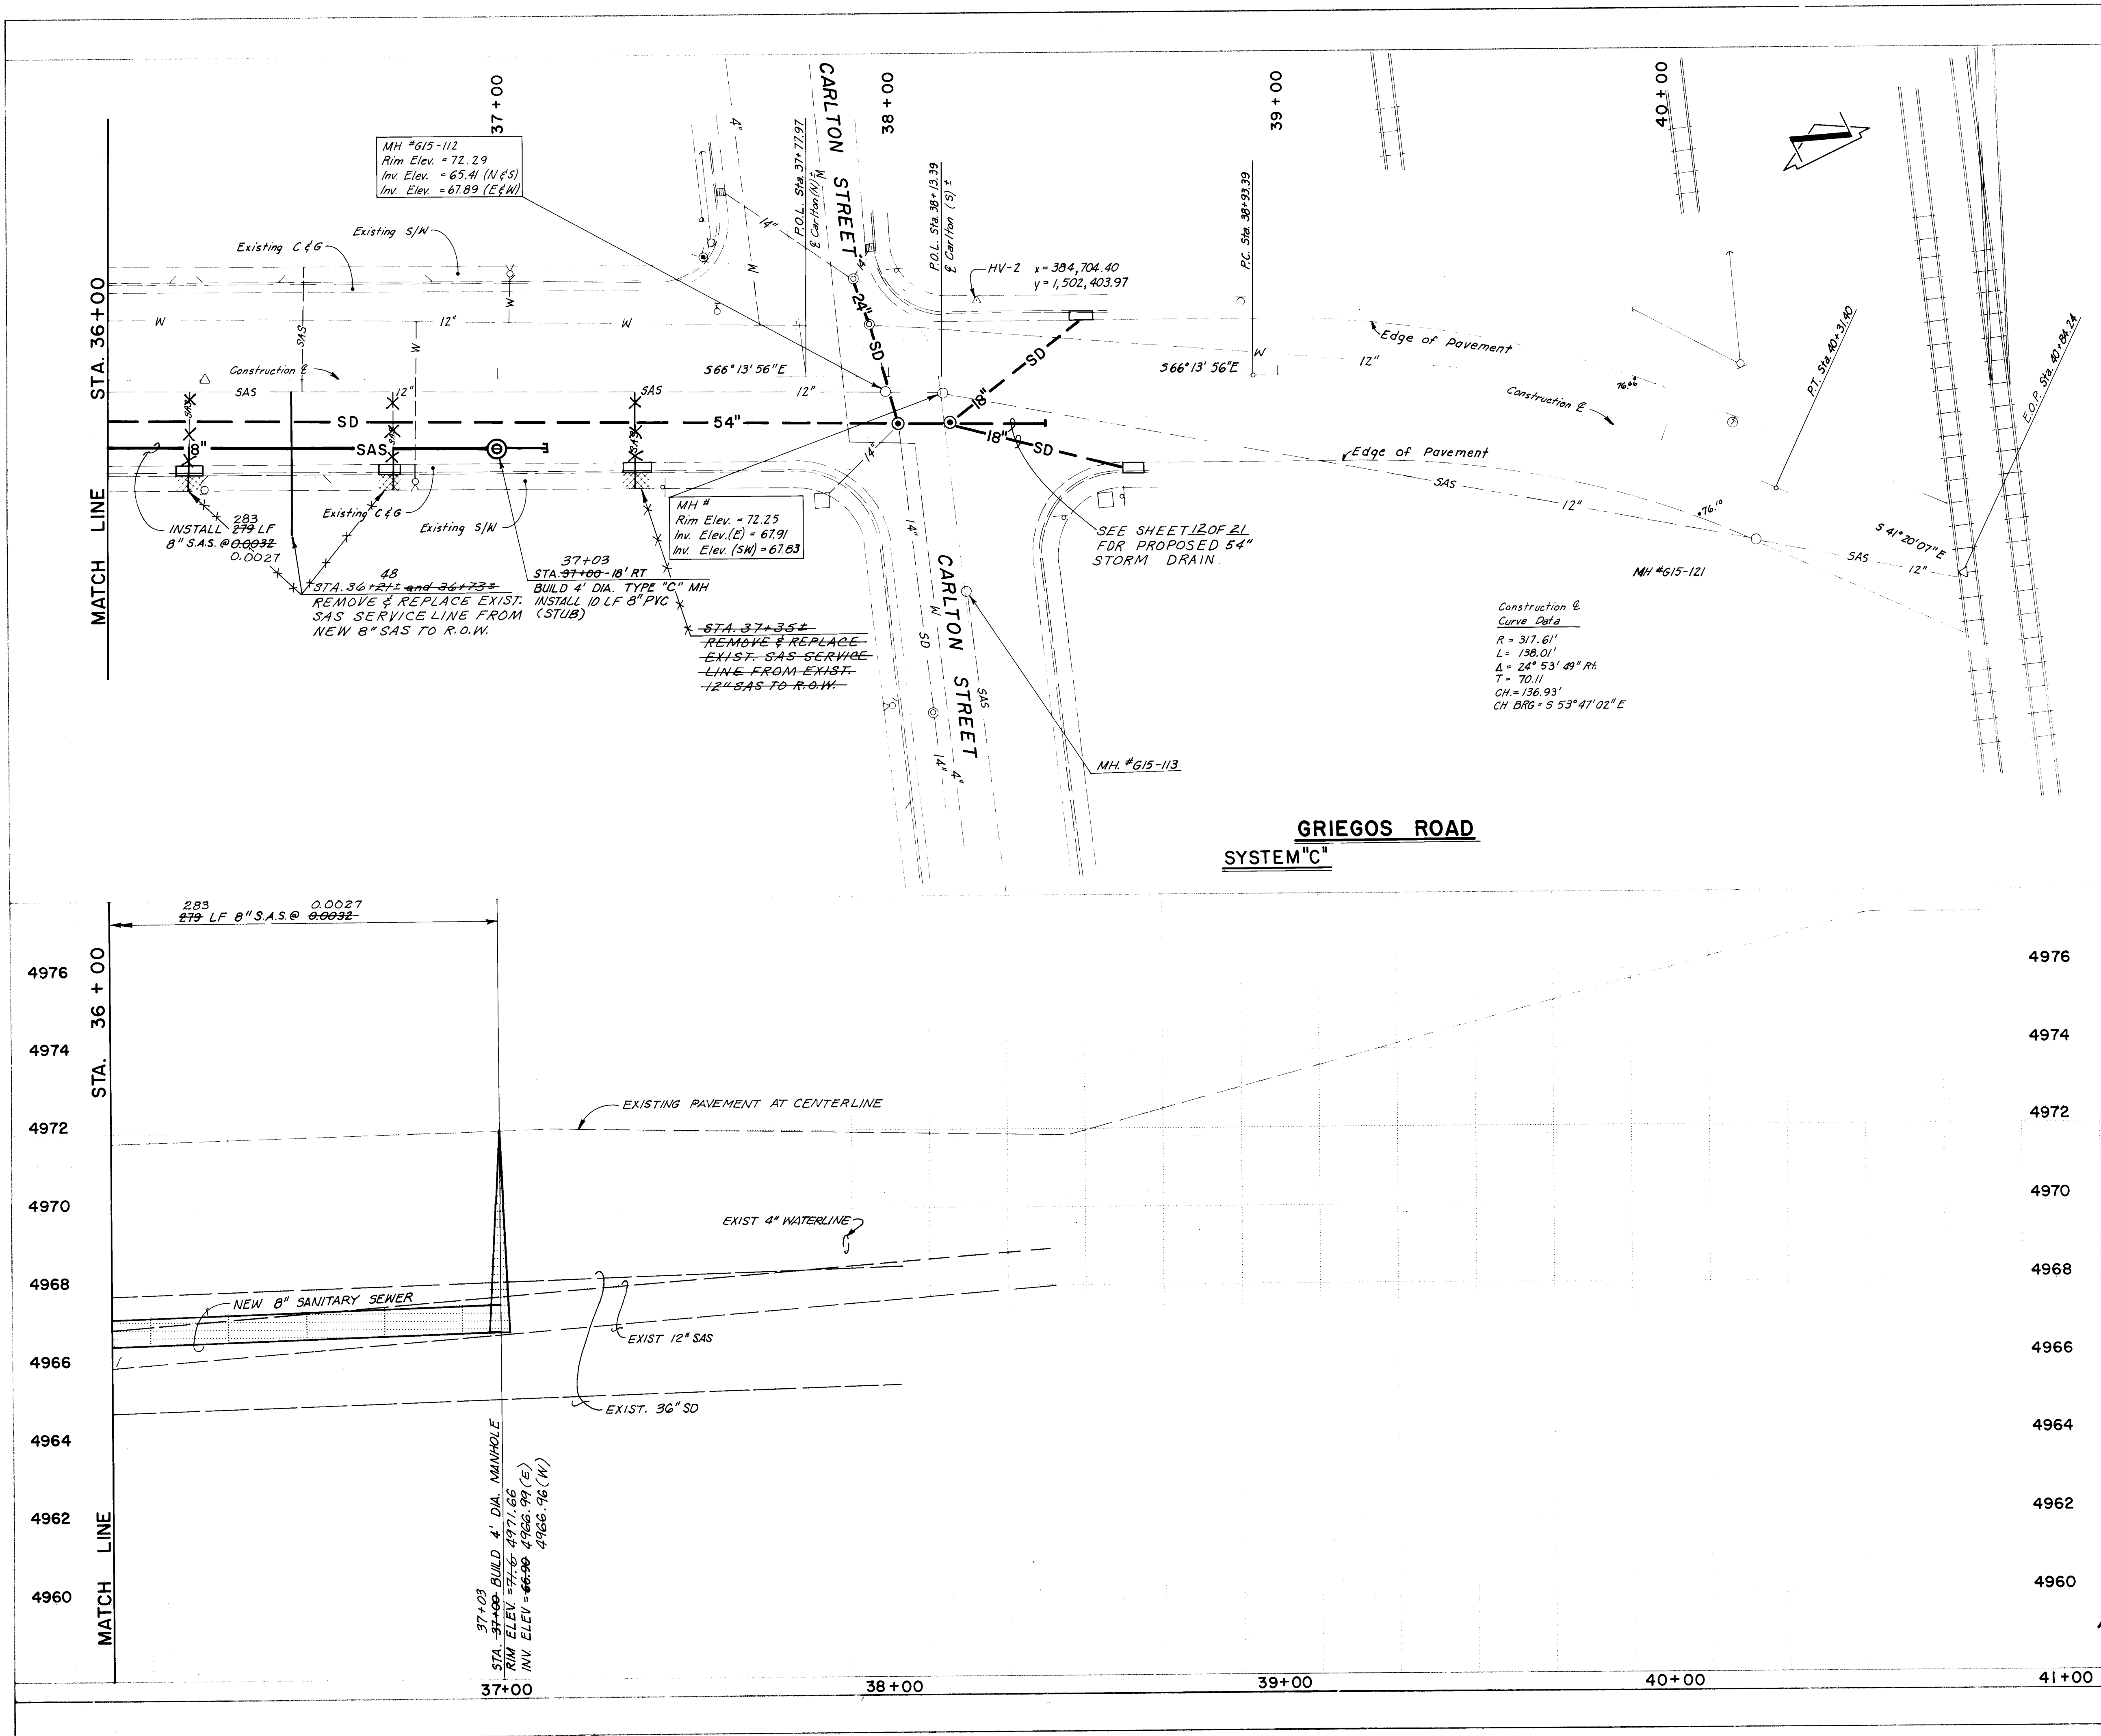

NOTES

- All spot elevations shown are at existing top of curb unless otherwise noted.
- It will be the responsibility of the Contractor to support all gas mains and service lines where they are within the area of excavation.
- See sheet 12 for approximate limits for pavement removal.

AS BUILT INFORMATION		BENCH MARKS		SURVEY INFORMATION		ENGINEER'S SEAL	
DATE	NO	DATE	NO	DATE	NO	DATE	NO
11-11-88		11-11-88		11-11-88		11-11-88	

REVISIONS

NO.	DATE	REVISIONS
1	10/21/87	DESIGN
2	10/21/87	DESIGN


APPROVALS

APPROVALS	DATE	APPROVALS	DATE
City Engineer	10/21/87	City Engineer	10/21/87
A.C.E. Design	10/21/87	A.C.E. Design	10/21/87
A.C.E. Hydrology	10/21/87	A.C.E. Hydrology	10/21/87



CITY OF ALBUQUERQUE
MUNICIPAL DEVELOPMENT DEPARTMENT
ENGINEERING DIVISION

TITLE NORTH VALLEY DRAINAGE SYSTEM IMPROVEMENTS
GRIEGOS ROAD SYSTEM (C)
SANITARY SEWER - STATION 36+00 TO 37+00

DRAWING NO. 2461 **MAP NO. G-15** **SHEET 18 OF 21**

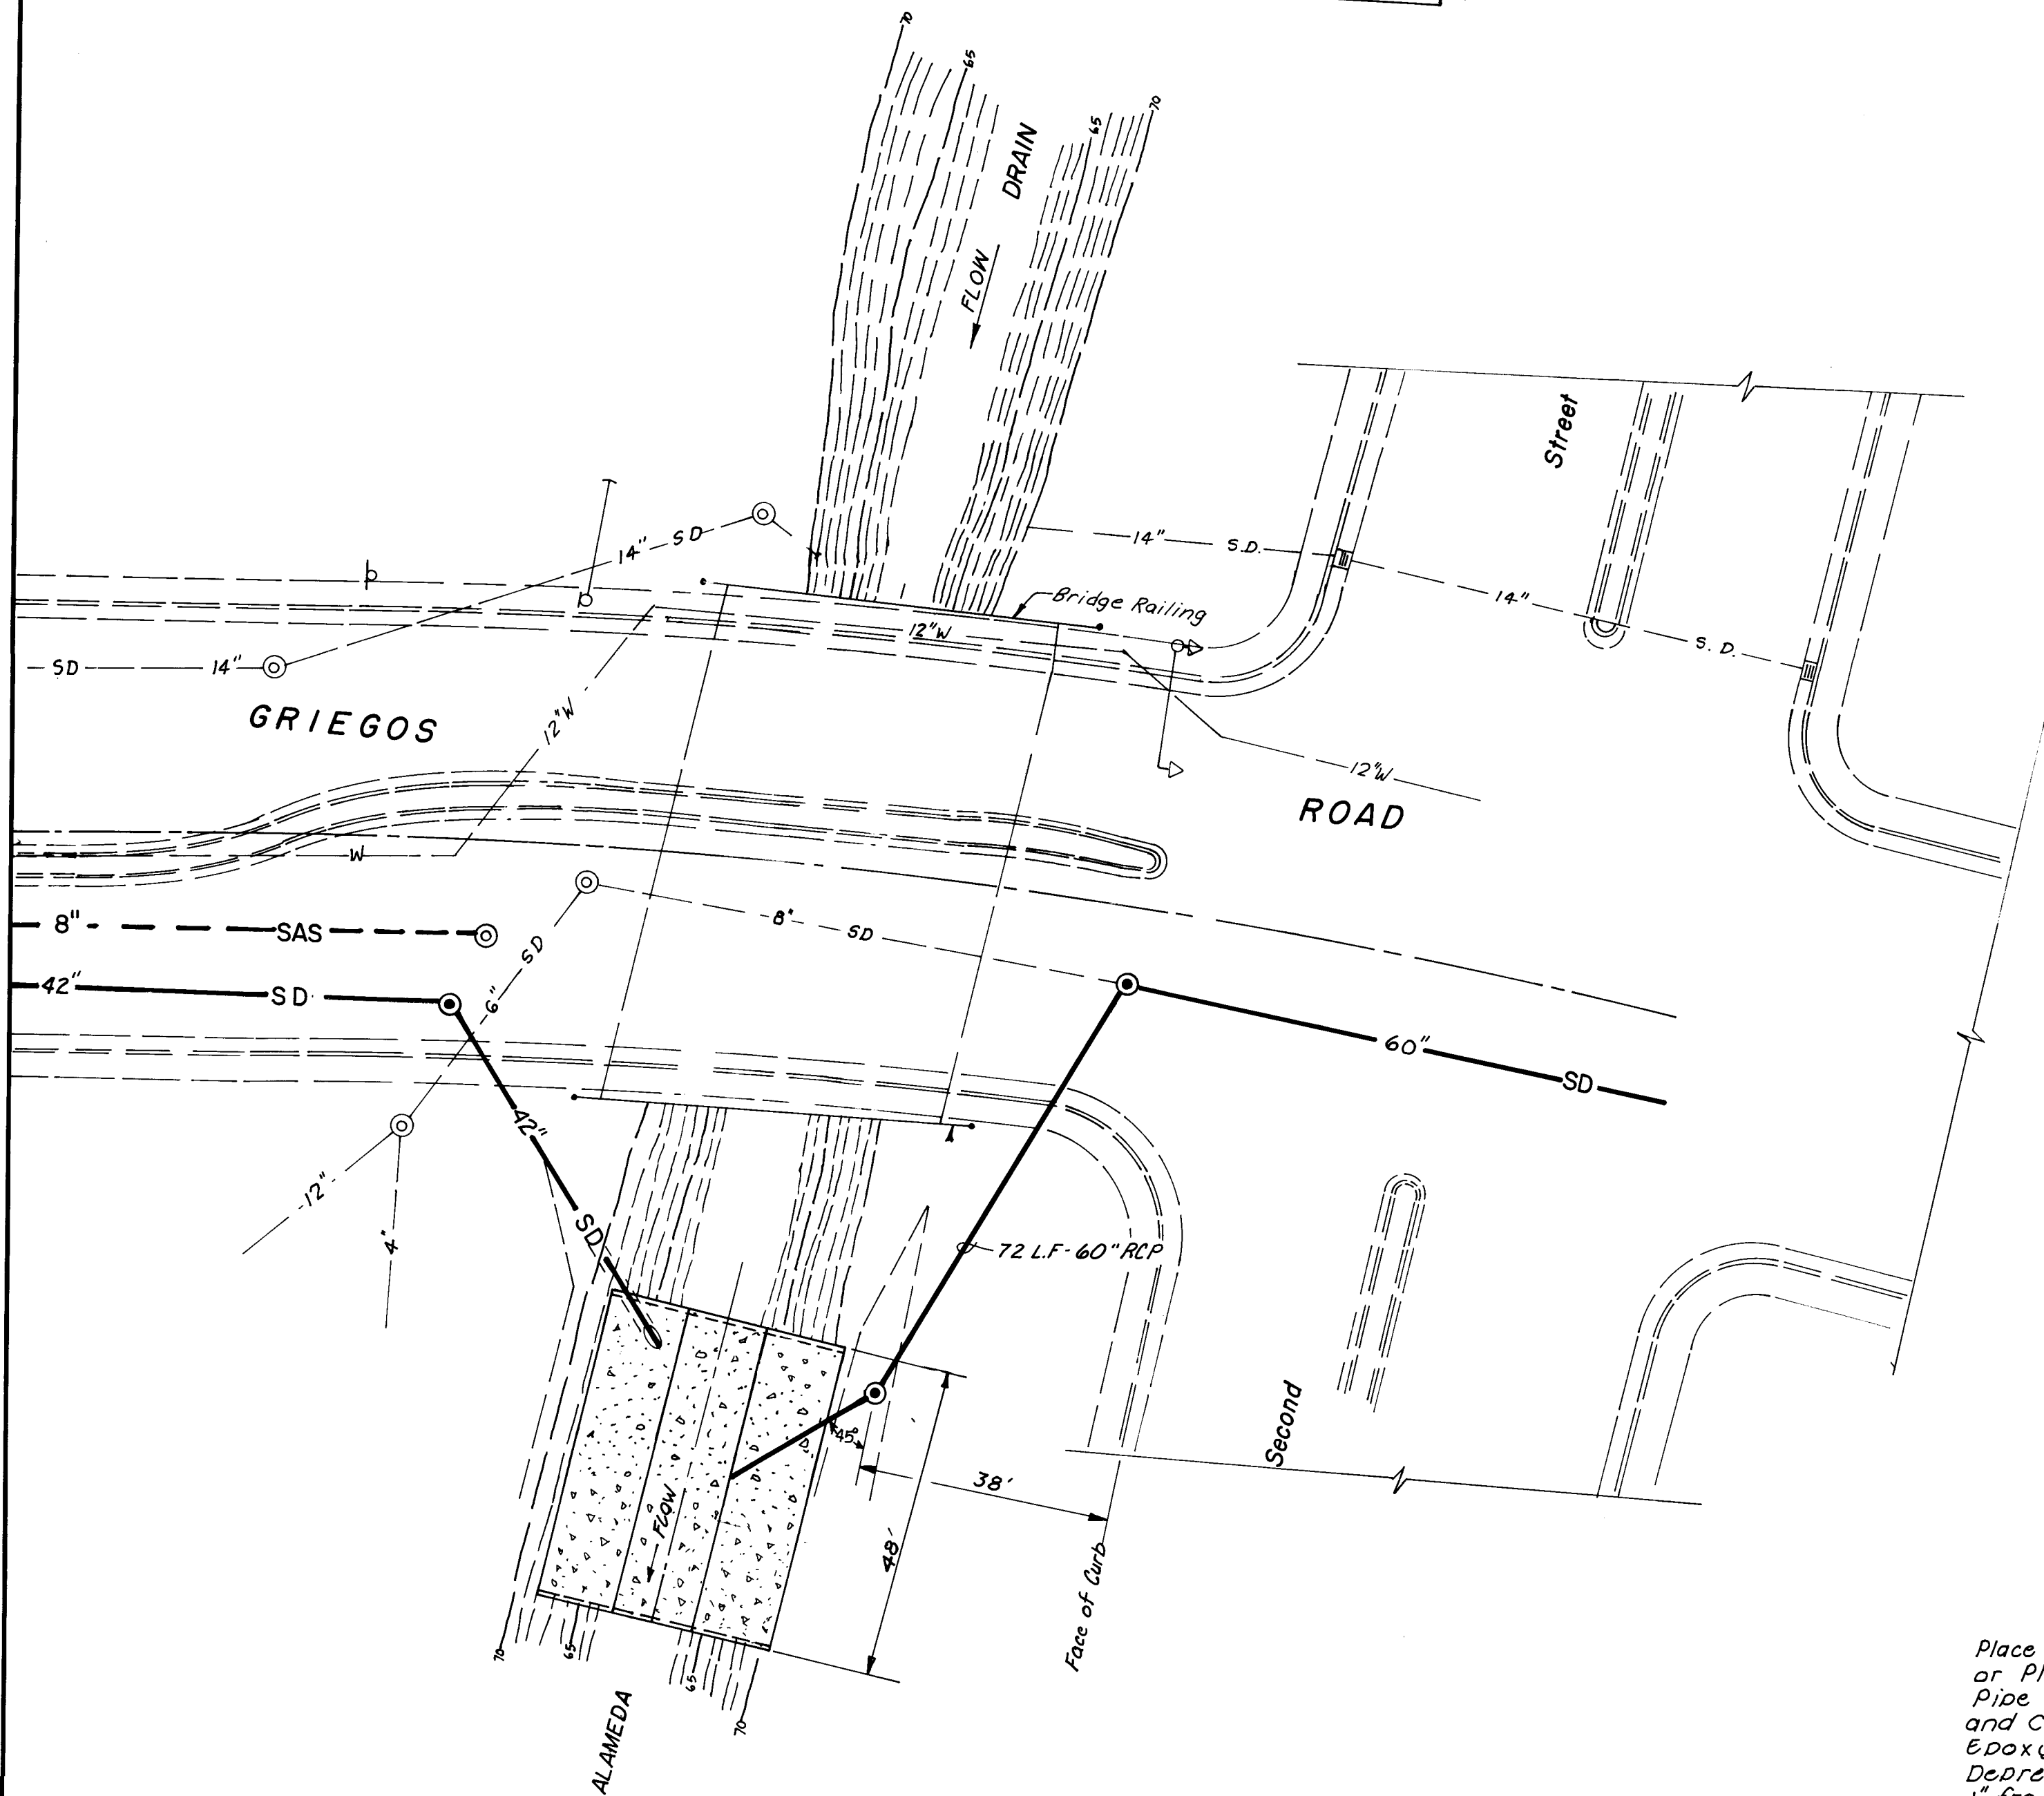

**GRIEGOS ROAD
OUTLET STRUCTURE PLAN**
Scale: 1" = 20'
SEE DETAILS THIS SHEET

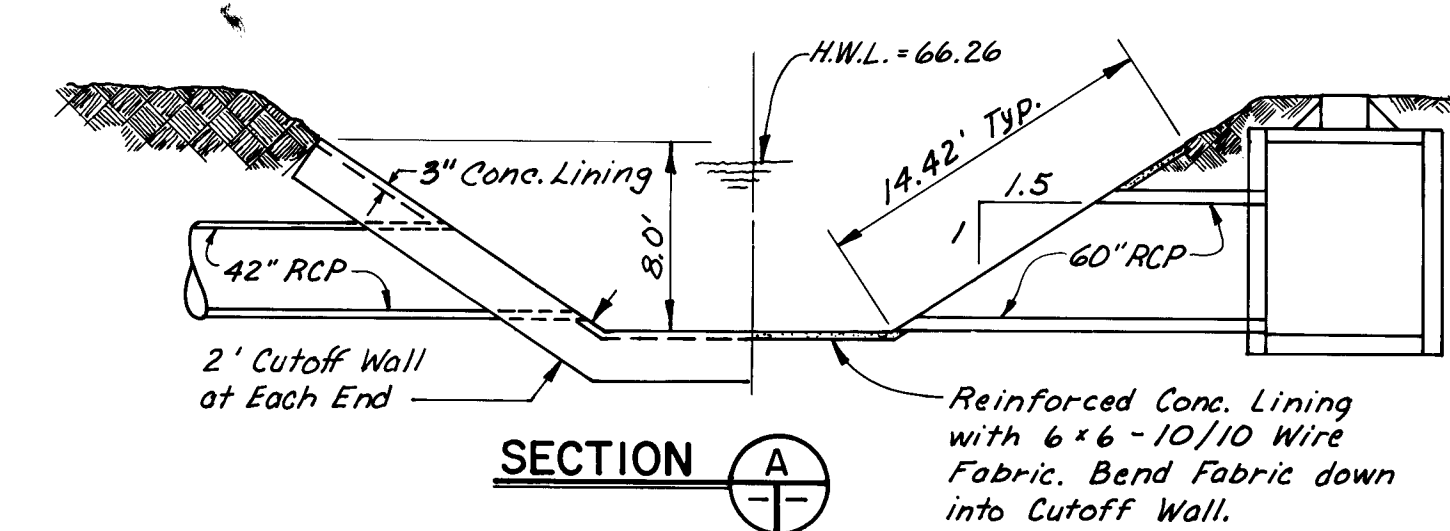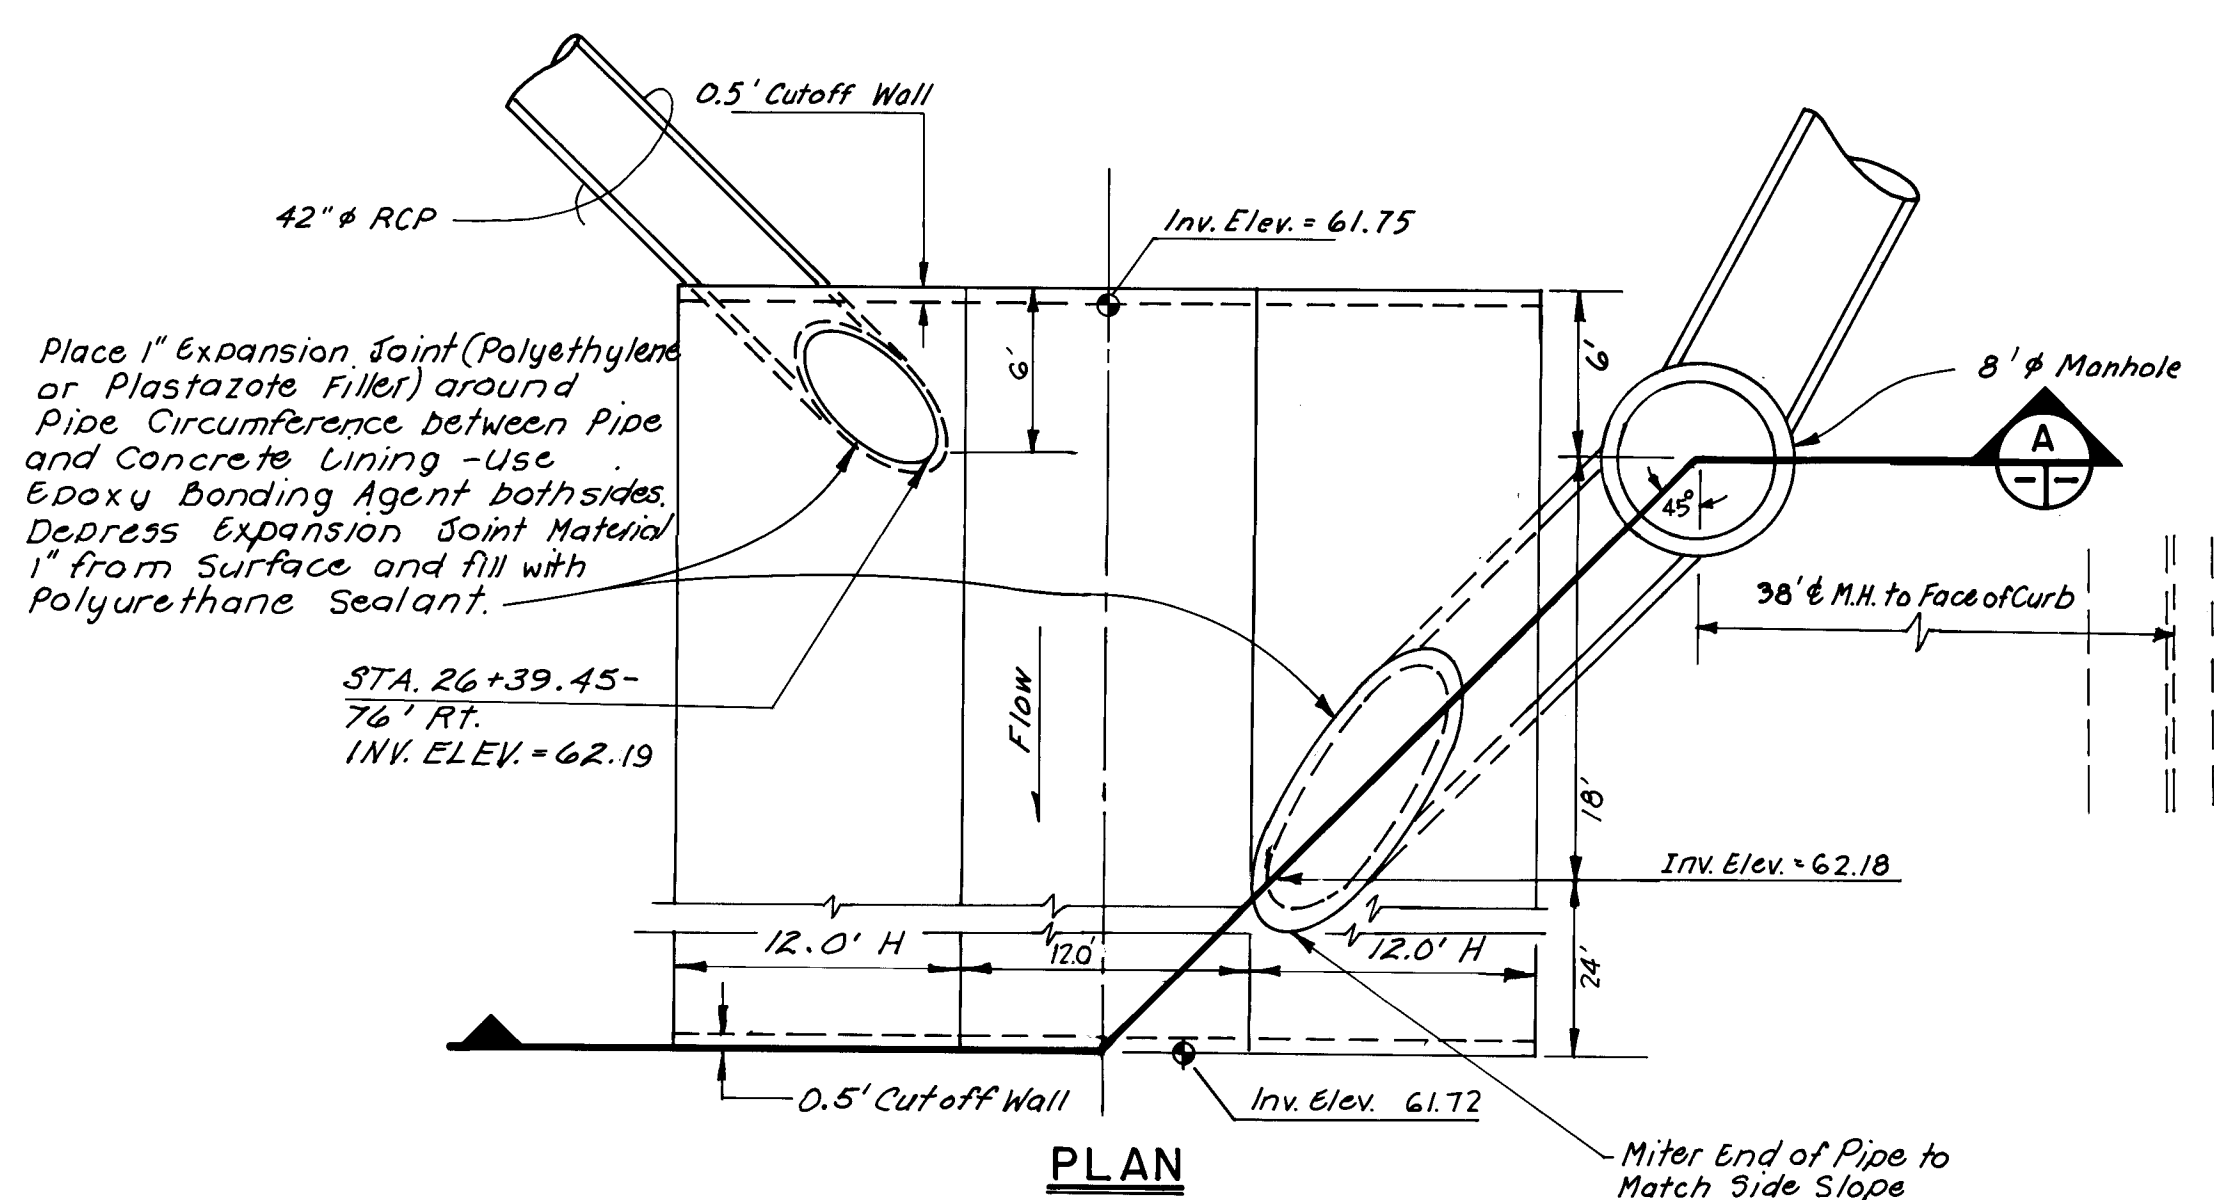


SOUTH OUTLET STRUCTURE
Scale: 1/8" = 1'-0"

- NOTES**
1. All spot elevations shown are at existing top of curb unless otherwise noted.
 2. All R.C.P. shall be ASTM C-76, Class II
 3. It will be the responsibility of the Contractor to support all gas mains and Service Lines where they are within the area of excavation.

AS BUILT INFORMATION			
CONTRACTOR	DATE	NO.	DATE
WORK	DATE	NO.	DATE
STAMPED BY	DATE	NO.	DATE
FIELD	DATE	NO.	DATE
ADJUSTED BY	DATE	NO.	DATE
DRAWINGS	DATE	NO.	DATE
CORRECTED BY	DATE	NO.	DATE
MICRO-FILM INFORMATION			
RECORDED BY	DATE	NO.	DATE
NO.	DATE	NO.	DATE

SURVEY INFORMATION	
FIELD NOTES	DATE
BY	DATE
NO.	DATE

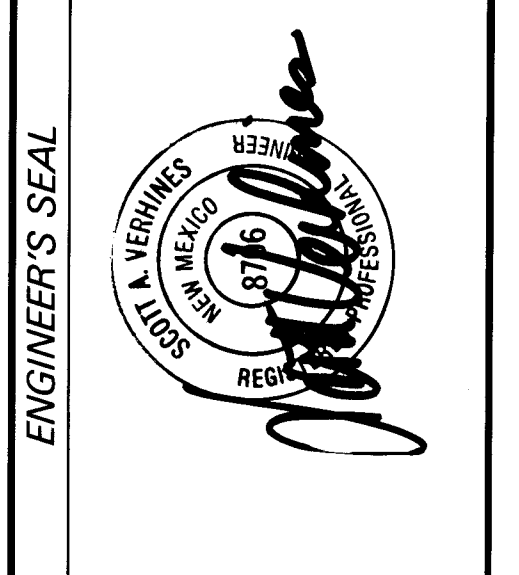


REVISIONS	
NO.	DATE
DATE	DATE
DESIGNED BY	DATE
DRAWN BY	DATE
CHECKED BY	DATE

26 246 1988

CITY OF ALBUQUERQUE
MUNICIPAL DEVELOPMENT DEPARTMENT
ENGINEERING DIVISION
TITLE: NORTH VALLEY DRAINAGE SYSTEM IMPROVEMENTS
OUTLET STRUCTURE PLAN AND DETAILS
GRIEGOS ROAD SYSTEM

APPROVALS	ENGINEER	DATE	APPROVALS	ENGINEER	DATE
City Engineer	10/27/87	10/27/87	Liquid Waste	10/27/87	10/27/87
A.C.E. Design	10/27/87	10/27/87	Traffic	10/27/87	10/27/87
A.C.E. Hydrology	10/27/87	10/27/87	Water	10/27/87	10/27/87

DRAWING NO.	2461	MAP NO.	6-15	SHEET	19	OF	21
-------------	------	---------	------	-------	----	----	----

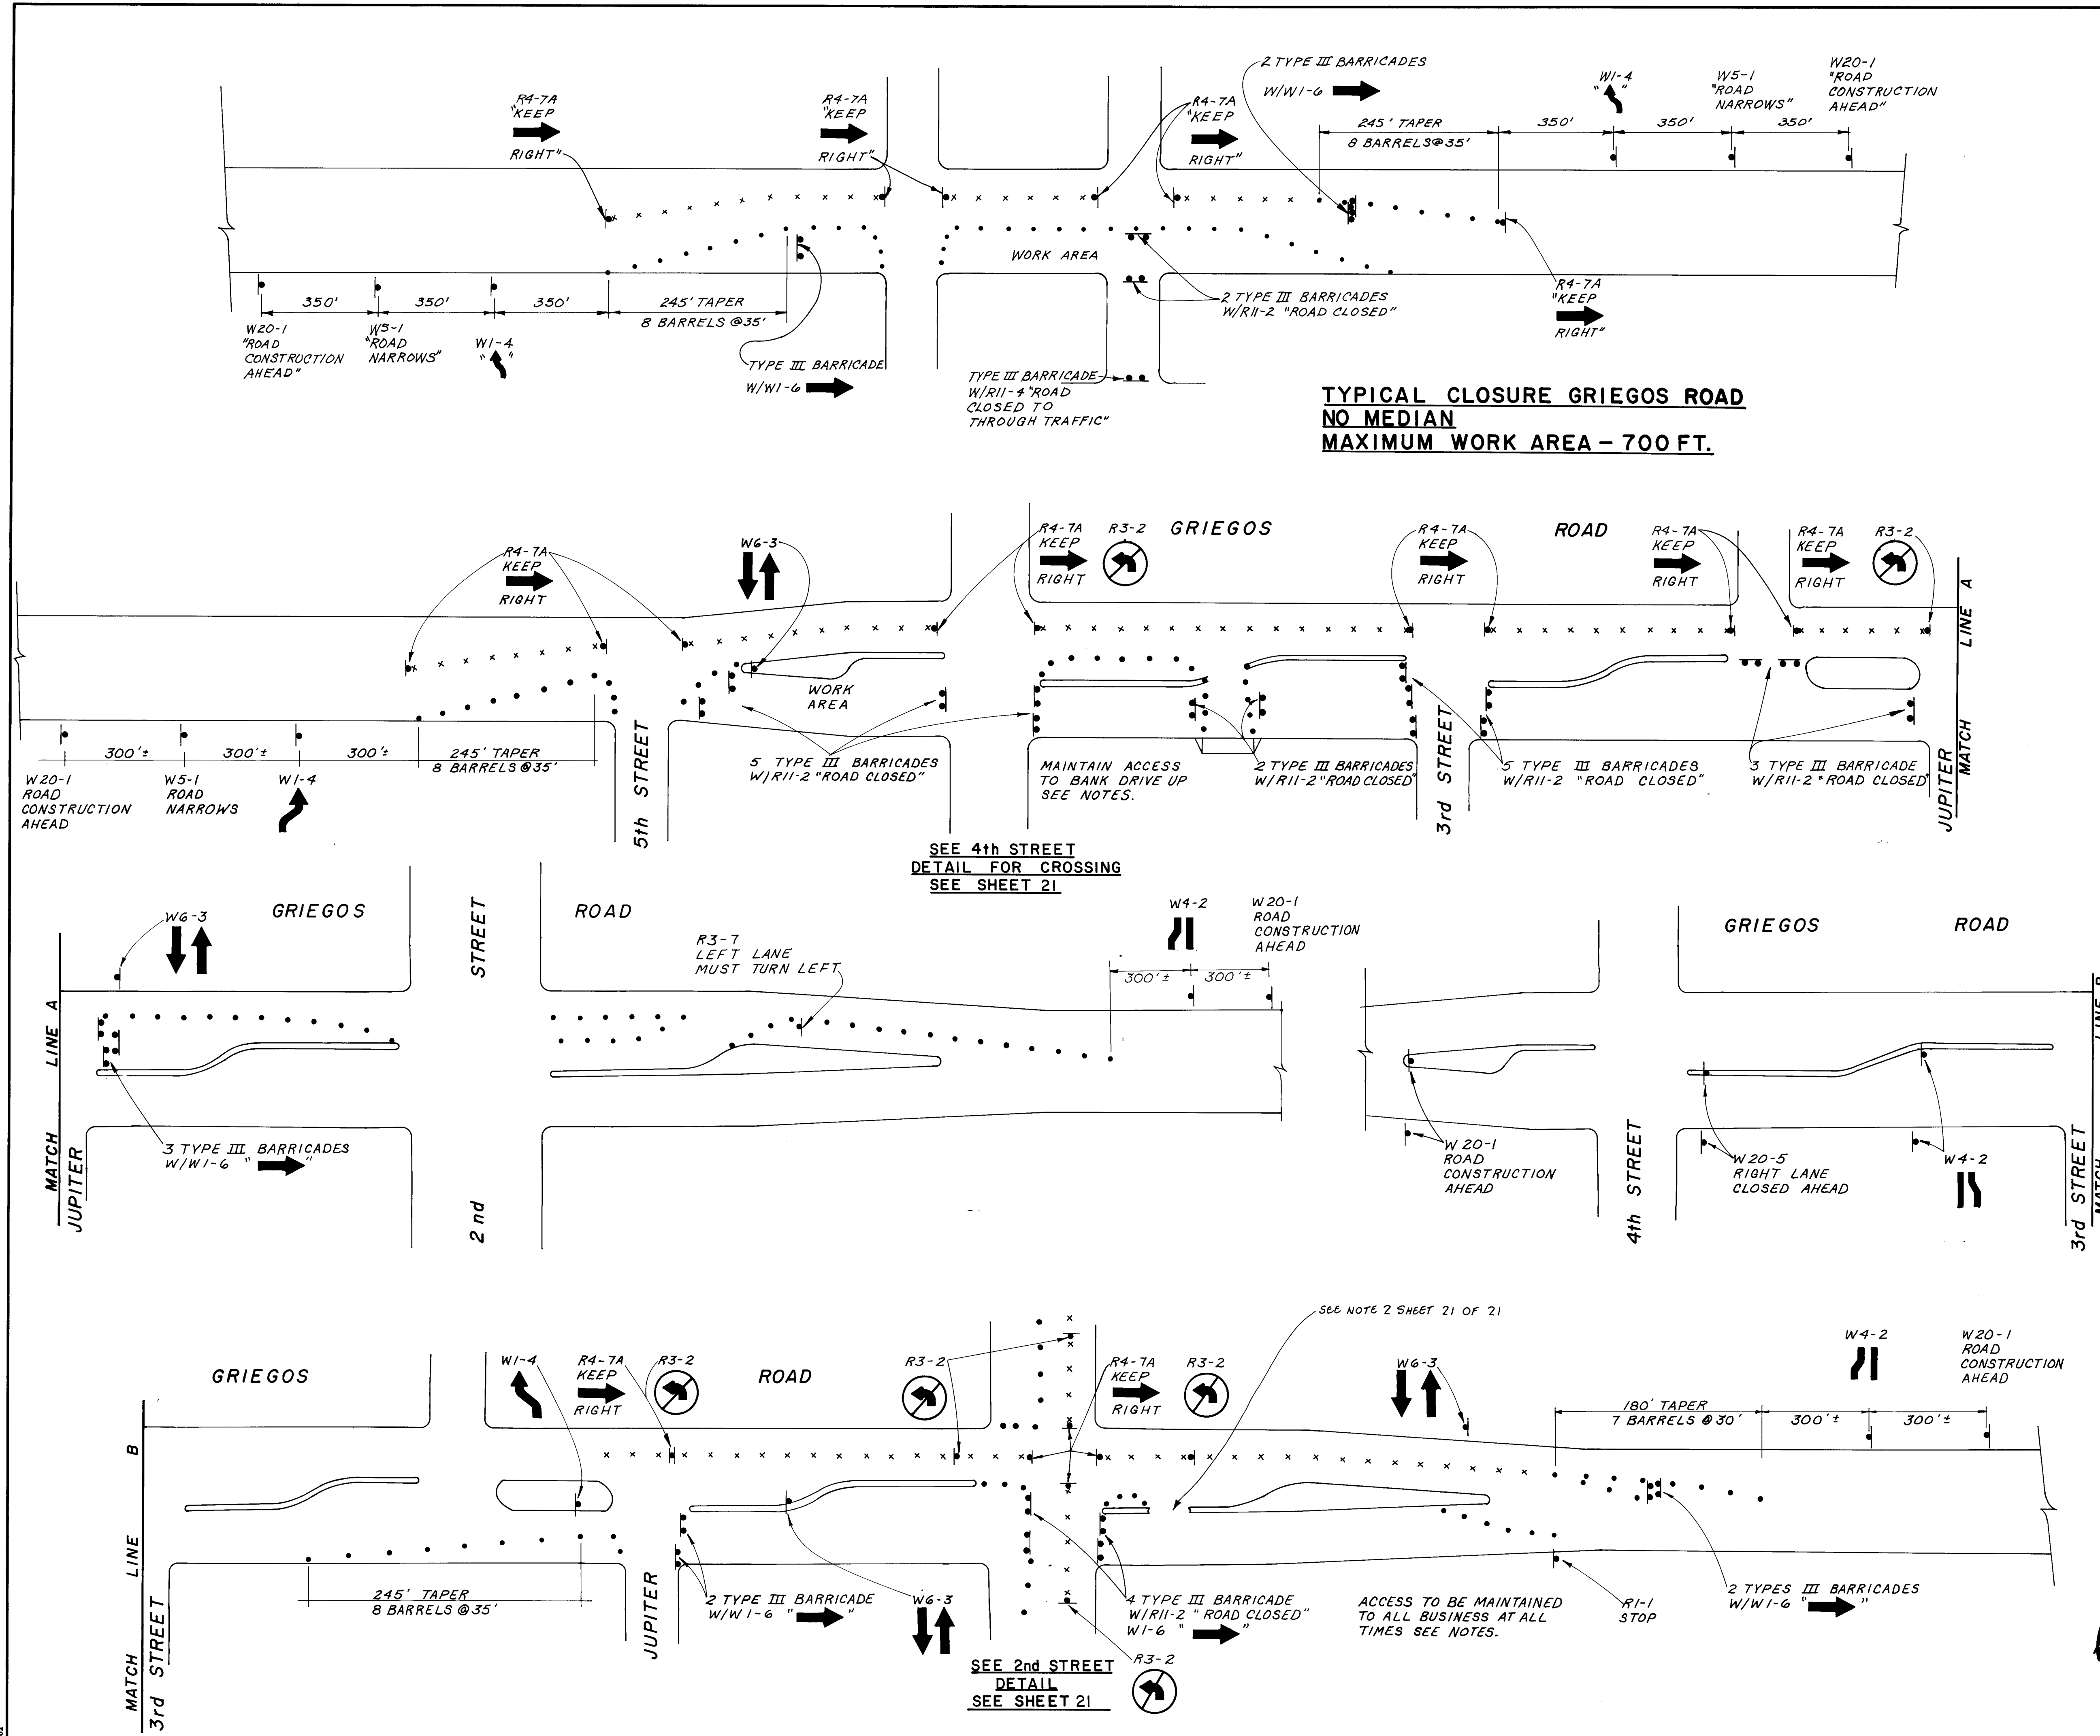


TYPICAL CLOSURE GRIEGOS ROAD
NO MEDIAN
MAXIMUM WORK AREA - 700 FT.

NOTES
1. See Traffic Control Notes Sheet 3 of 21.

AS BUILT INFORMATION			BENCH MARKS			SURVEY INFORMATION			ENGINEER'S SEAL		
CONTRACTOR	WORK	DATE	NMSHC Brass Tablet	Stamped	"STA. NM47-9	FIELD NOTES	NO.	BY			
INSPECTOR	DATE	DATE	Set in the Top of a Concrete Post Flush with the								
ACCEPTANCE BY	DATE	DATE	Ground in the Center Island of 2nd Street						REVISIONS		
VERIFICATION BY	DATE	DATE	25' ± North of Pleasant Street Elev. = 4972.036								
DRAWINGS BY	DATE	DATE							NO.	DATE	BY
MICRO-FILM INFORMATION											
RECORDED BY	DATE	DATE									

26 24612088

CITY OF ALBUQUERQUE MUNICIPAL DEVELOPMENT DEPARTMENT ENGINEERING DIVISION					
TITLE: NORTH VALLEY DRAINAGE SYSTEM IMPROVEMENTS TRAFFIC CONTROL PLAN GRIEGOS ROAD SYSTEMS (B & C)					
APPROVALS	ENGINEER	DATE	APPROVALS	ENGINEER	DATE
City Engineer		02/27/97	Liquid Waste	PECO	02/27/97
A.C.E. Design			Traffic	PECO	02/27/97
A.C.E. Hydrology		02/27/97	Water	PECO	02/27/97
DESIGNED BY: K.B. Albuquerque, Div. 12-31-86 DRAWN BY: CW RLH CHECKED BY: DATE					
DRAWING NO.	2461	MAP NO.	G-15	SHEET	20 OF 21

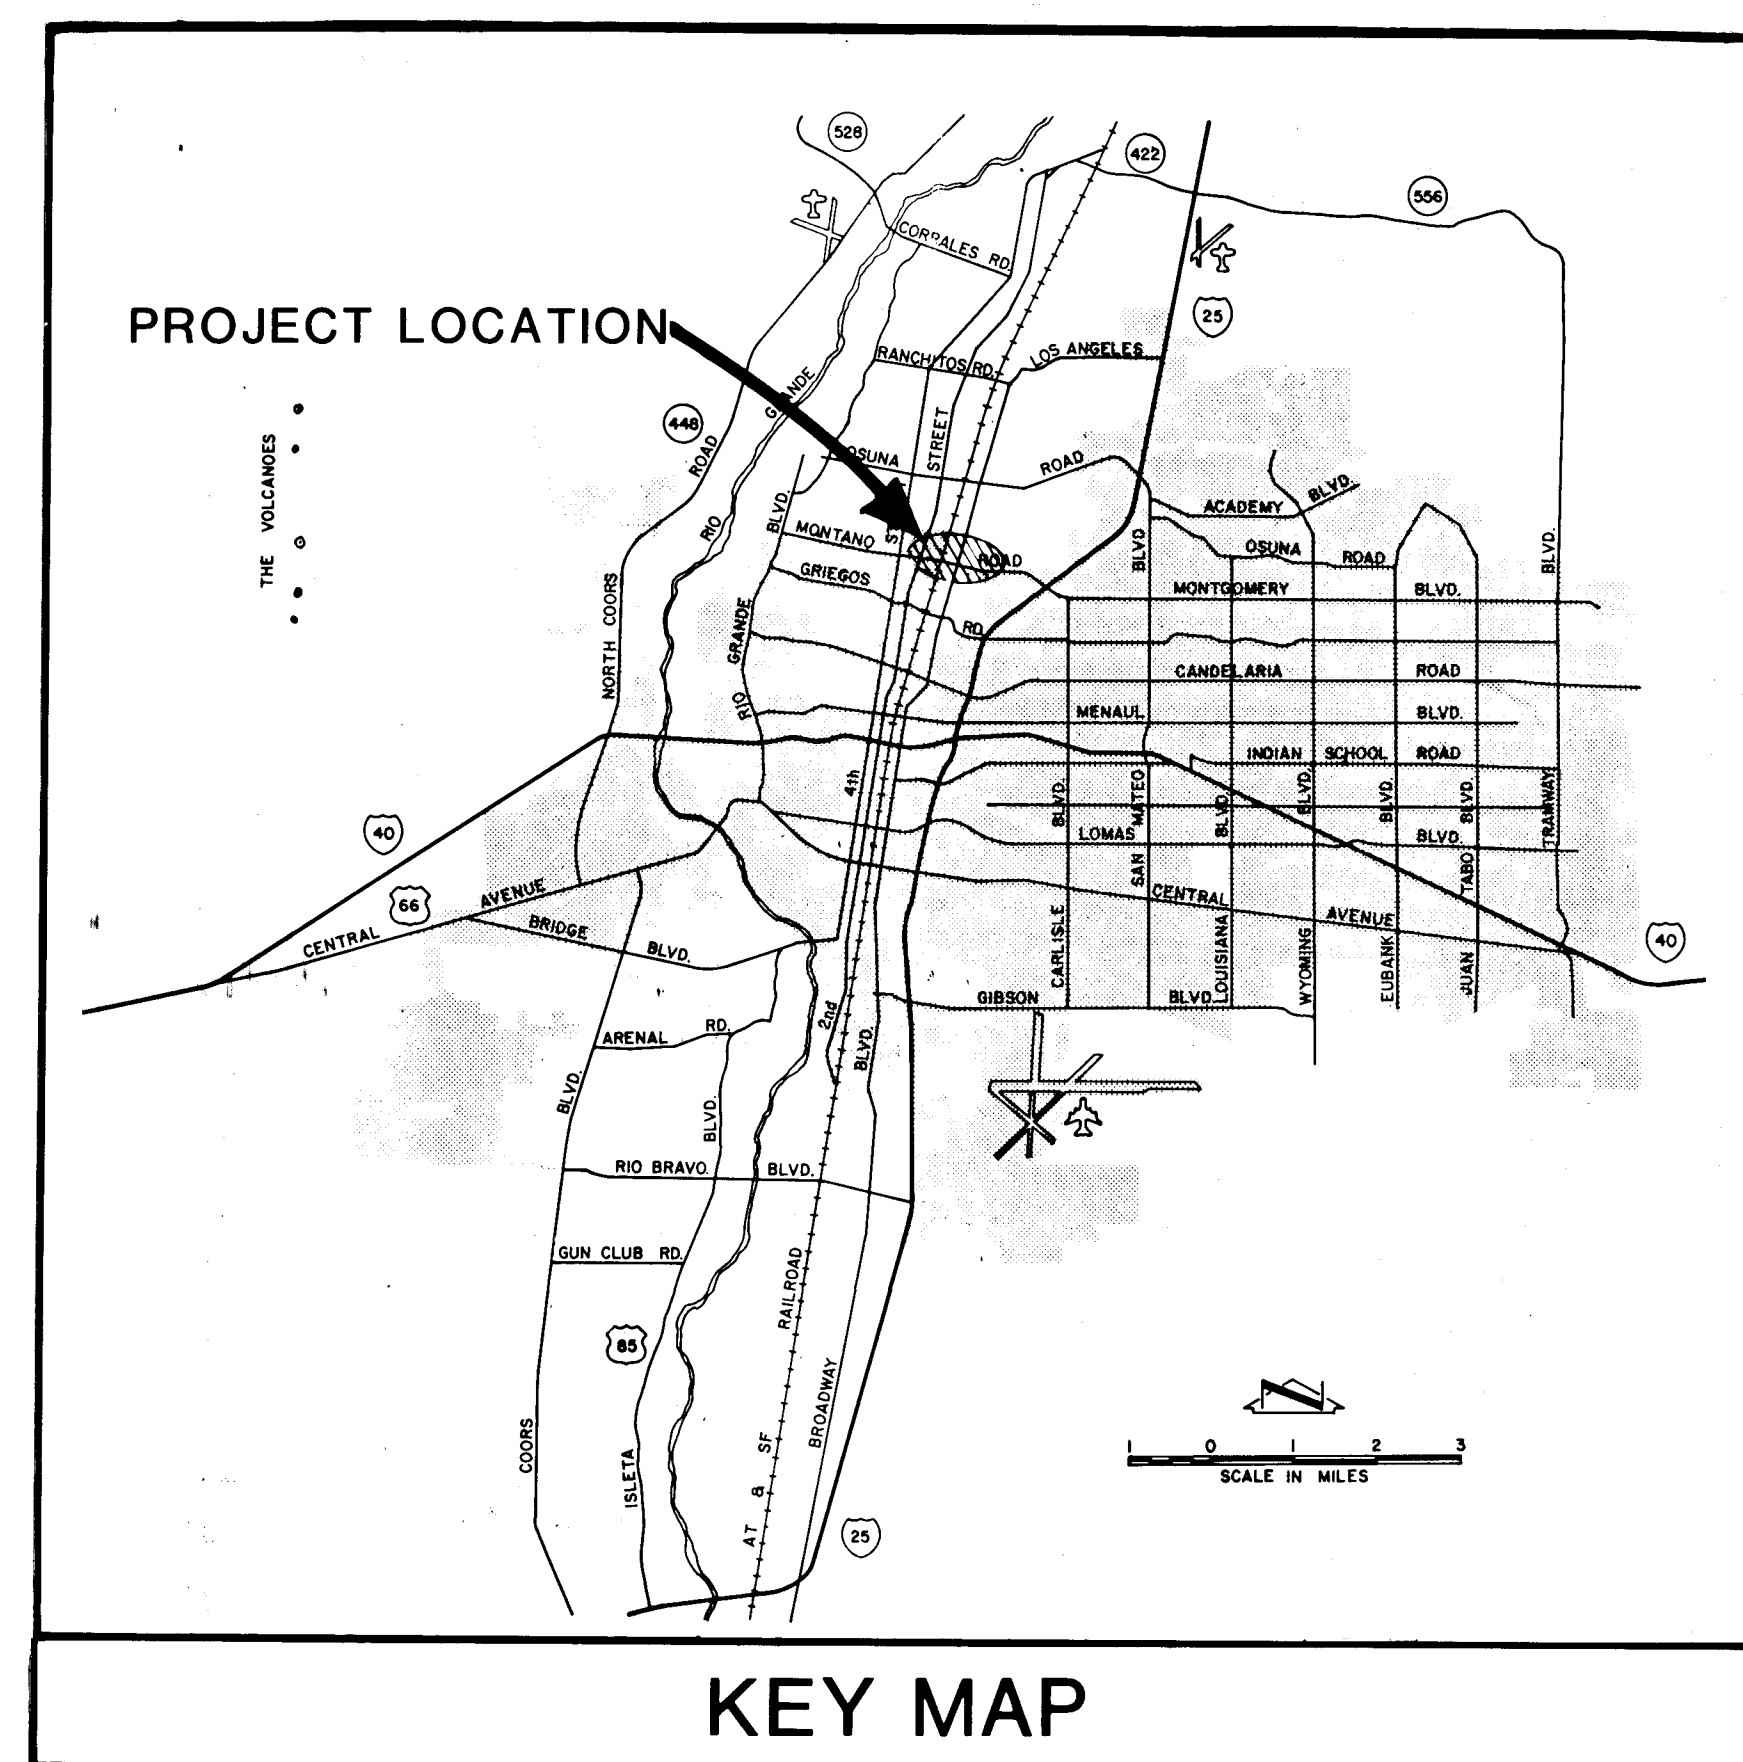

CITY OF ALBUQUERQUE



NEW MEXICO

INDEX TO SHEETS

SHT. NO.	DESCRIPTION
1.	TITLE SHEET
2.	GENERAL NOTES AND DETAILS
3-17.	MONTANO ROAD SYSTEM (A)
3.	SITE PLAN, LEGEND, AND TRAFFIC CONTROL NOTES
4.	STORM DRAIN PLAN-PROFILE
5.	STA. 1+66 to 4+50
6.	STA. 4+50 to 9+00
7.	STA. 9+00 to 13+75
8.	STA. 13+75 to 18+00
9.	STA. 18+00 to 22+50
10.	STA. 22+50 to 27+00
11.	STA. 27+00 to 31+50
12.	STA. 31+50 to 36+00
13.	STA. 36+00 to 40+50
14.	STA. 40+50 to 45+00
15.	STA. 45+00 to 46+92.55
16.	SANITARY SEWER PLAN-PROFILE
17.	STA. 7+00 to 12+00
18-19.	OUTLET STRUCTURE PLAN AND DETAILS
	TRAFFIC CONTROL PLAN

CONSTRUCTION PLANS FOR NORTH VALLEY DRAINAGE SYSTEM IMPROVEMENTS MONTANO ROAD SYSTEM (A)

SET NO. _____
JOB NO. 85113

26 24610188

REV.	SHEETS	CITY	ENGR.	DATE	USER	DEPT.	DATE	USER	DEPT.	DATE
APPROVAL OF REVISIONS										
					0			SCANLON ASSOCIATES		
DRAWING NO. 2461					MAP NO. _____			SHEET 1 OF 19		


CITY OF ALBUQUERQUE
APPROVED FOR
CONSTRUCTION
[Signature]
11/16/87

Scanlon Job No. 85113

RECORD DRAWING


GENERAL NOTES

- The City of Albuquerque Interim Standard Specifications for Public Works Construction, 1985 Edition, and any revisions and or additions in the Specifications and Contract Documents, shall govern the construction of this project.
- The Contractor shall notify all utility companies when working near their systems. Two days prior to any excavation, Contractor must contact Line Locating Service, 765-1234, for location of existing utilities.
- All existing utilities shown here were taken as accurately as possible from record drawings and surface indications. It shall be the Contractor's responsibility to protect, maintain in service, and verify exact locations of all affected utilities during construction of this project, including service lines.
- All utilities which are to be abandoned under this contract shall be plugged with concrete at each end of the portion to be abandoned. Payment for this work will be made on the basis of the contract unit price bid.
- Curb return radii and street widths are to the face of the curb unless otherwise indicated in the plans.
- Where removal of existing curb and gutter or sidewalk is required, remove to the nearest joint or saw cut.
- When abutting new paving to existing, saw cut existing paving on a right angle, or as required by the Project Engineer to remove any broken, raveled, or cracked paving and match the new paving grade to the existing. No separate payment shall be made for saw cut but shall be considered incidental to the Contract Unit Price for pavement removal and replacement.
- Curb and gutter shown as existing and not to be removed under this contract which is damaged or displaced by the Contractor or his subcontractors, shall be replaced by the Contractor at his expense.
- Existing materials to be removed and paid for on a unit price basis shall be measured and the quantities approved by the Engineer before removal.
- Remove all valve boxes from abandoned water lines. Payment will be considered incidental to the contract unit price for pavement removal and replacement.
- All abandoned valve and meter box frames and covers shall be returned to the Water System Division city yard and all storm and sanitary manhole lids and inlet grates, castings, and frames not reused and in usable condition, shall be returned to the Liquid Waste Division warehouse. There shall be no direct payment for these items. Cost shall be considered incidental to other items of work.
- The maximum allowable quantities for payment for removal and replacement of pavement where water, sanitary sewer, and storm sewer are to be installed under existing pavement will be computed in accordance with the Contract Documents.
- The Contractor shall expose existing water and sewer lines at locations where new storm sewer lines cross or parallel such lines in order to adequately establish the proximity of water and sewer lines. The cost of this work shall be incidental to other items of work.
- Prior to construction, exploratory excavation may be required as directed by the Project Engineer to more specifically locate utility lines. There will be no direct payment for this item of work. Cost will be considered incidental to other items of work.
- All water meters, water valve boxes, and sewer manholes in the construction area where street grades change are to be adjusted by the Contractor to finished grade under this contract. The Contractor shall be required to set reference points for locating manholes prior to any grading operation. Measurement and payment for this work shall be considered incidental to the unit price bid for pavement removal and replacement.
- The Contractor will be responsible to replace at his expense any and all property corners destroyed in the process of construction. All property corners must be set by a Registered Land Surveyor.
- The Contractor will be required to confine his work within the construction limits and/or right-of-way to preserve existing vegetation and private property. Contractor is not to store equipment or materials in R.O.W. overnight.
- Mail boxes within new construction will be relocated to the right-of-way line by the U.S. Post Office. The Contractor shall coordinate relocation of mailboxes with property owner or resident and the U.S. Post Office. The Contractor shall notify the U.S. Post Office, Delivery and Collection Department, at least 48 hours in advance of construction affecting mailboxes. Cost of this work will be considered incidental to other items.
- Utility relocation schedules shall be coordinated at the pre-construction conference.
- Utility relocations required by the construction of this project are to be coordinated by the Contractor during construction. No additional compensation will be allowed for delays or inconveniences caused by utility company work crews. The Contractor may be required to reschedule his activities to allow utility crews to perform their required work.
- Access to local business and residences shall be kept open at all times. In the event that access closures are unavoidable, closures must be scheduled at least twenty-four (24) hours in advance with property owners and approved by the Engineer. Access closures to business shall not exceed two (2) hours during business hours and for residences shall not exceed eight (8) hours. Alternate access provided if required.
- All valve box rings and covers shall be painted with blue enamel or epoxy paint. Color shall be equivalent to "Safety Blue".
- Sidewalks and wheel chair ramps within the curb returns shall be constructed wherever a new curb return is constructed. Wheel chair ramps shall be paid for at the unit price for sidewalks. If curb is depressed for a driveway or wheel-chair ramp, the ramp or driveway shall be constructed prior to acceptance of the curb and gutter.
- A disposal site for all excess excavation material, asphaltic paving, concrete paving, etc. shall be obtained by the Contractor, and approved by the Project Engineer in compliance with applicable regulations. All costs incurred in obtaining a disposal site and haul thereto shall be considered incidental to the contract unit price for other items.
- Fifty ton roller operation shall not be used on this project where underground utilities are present. The required compaction of these locations shall be effected by other types of approved compaction methods.
- All work on this project shall be performed in accordance with applicable Federal, State, and local laws, rules, and regulations concerning construction safety and health.
- WARNING** - If any utility lines, pipelines or underground utility lines are shown on these drawings, they are shown in approximate manner only, and other such lines may exist where none are shown. If any such existing lines are shown, the location is based upon information provided by the Utility or pipeline company, the Owner, or by others (except where specifically noted as field verified), and the information may be incomplete, or may be obsolete by the time construction commences. The Engineer has undertaken limited field verification of the location, depth, size or type of existing utility lines, pipelines, or underground utility lines, and makes no representation pertaining thereto, and assumes no responsibility or liability therefor, the Contractor shall inform himself of the location of any utility line, pipeline, or underground utility line in or near the area of the work in advance of and during the excavation work. The Contractor is fully responsible for any and all damage caused by failure to locate, identify, and preserve any and all existing utilities, pipelines, and underground utility lines. The Contractor shall comply with State statutes, Municipal and local ordinances, rules and regulations, if any, pertaining to the location of these lines and facilities, in planning and conducting excavation, whether by calling or notifying the utilities, complying with "line locating" procedures, or otherwise. (See also Note 2)
- Steps are required in all drop inlets and manholes over 4 feet deep. All manhole and drop inlet steps shall be 1/2" grad 60 steel reinforcing rod encapsulated in a co-polymer polypropylene as manufactured by M.A. Industries, Inc. (model #P-2-PFS) or equal. Steps are not to be precast in place but shall be installed as recommended by the manufacturer after the manhole or catch basin has been constructed. Top two steps to protrude 4 inches into manhole, all other 5 inches. Spacing between steps to be 16 inches O.C., first step to be 18 inches from manhole rim, last step to be 18 inches maximum from manhole invert. For step placement in drop inlets, see appropriate Standard Detail (K-1 or K-4).
- It shall be the responsibility of the Contractor to maintain sanitary sewer services at all times throughout the duration of the project, to include by-pass pumping of sewerage as required.
- The Contractor is responsible for coordination during construction for work over or into Middle Rio Grande Conservancy District (MRGCD) facilities. These facilities include but are not limited to the Alameda Drain, Alameda Lateral, and Harwood Lateral. The Contractor shall obtain the necessary approvals from MRGCD regarding dewatering, scheduling, etc., during construction. The Contractor shall post a damage deposit with MRGCD for work which affects MRGCD facilities. There shall be no direct payment made for these items under this contract, but shall be considered incidental to other items of work.
- All Reinforced Concrete Pipe (RCP) storm drain shall conform to ASTM C 76 specifications as set forth in the Contract Documents. The following pipe strength classes will apply for this project, unless otherwise noted:
 - RCP less than thirty (30) inches in diameter (I.D.) - Class IV.
 - RCP greater than or equal to thirty (30) inches in diameter (I.D.) - Class III.
- Removal and replacement of existing curb and gutter required for the construction of new catch basins shall be considered incidental to the contract unit price for removal of existing catch basins and construction of new catch basins and no separate payment shall be made therefore.
- Catch basin grate elevations shown on the plans are at the flowline at face of curb and are computed at 10 3/4" below top of curb.
- All water service relocations or replacements required by the construction of new storm drain must be replaced from the water main to the existing meter. Splicing into existing service lines is not permitted.
- Use Type "C" manholes for SAS and storm drain depths of less than 6' measured from invert to rim. Use Type "B" manholes for all depths greater than or equal to 6' measured from invert to rim.
- For payment purposes, the maximum pavement cut width shall be as defined in Section 801.17.8.2. of the Interim Standard Specifications as defined in General Note 1 above.
- Trench dewatering if required due to groundwater conditions encountered during construction shall be paid for by contract change order during construction.
- Use of City approved alternate grates for storm inlets per City of Albuquerque Standard Drawing K-10 shall be limited to roadway slopes of one percent (1%) or greater.
- Trench depth shall be measured from bottom of pavement to invert of pipe at centerline of pipe.

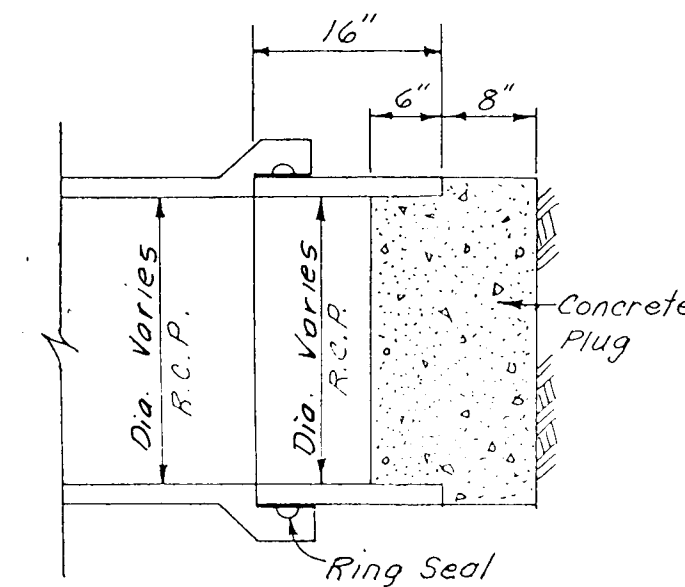

**REMOVABLE
WATERTIGHT PLUG**

Not to Scale

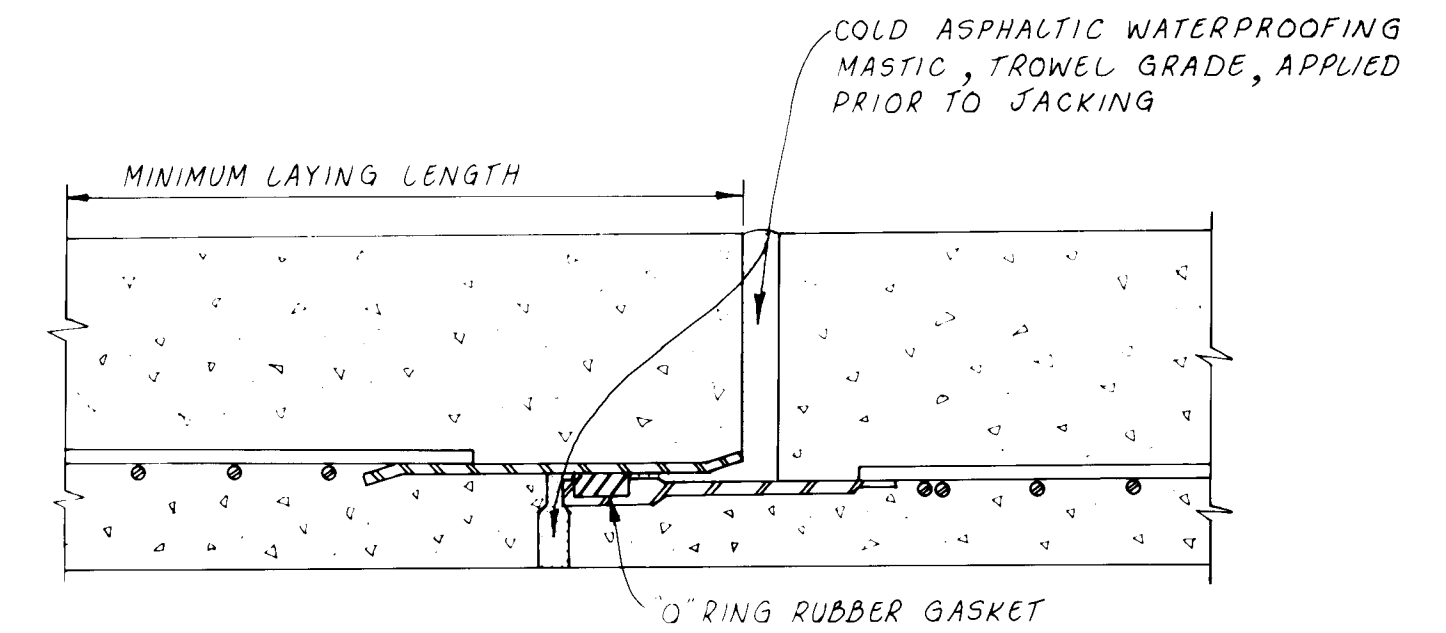


54" R.C.P. - STEEL END RING JOINT DETAIL

Not to Scale

Minimum Pipe Class = V
Pipe Inside Diameter = 54"
Wall Type = C
Bell Ring Min. Thickness = 1/4"
Min. Laying Length = 8.0'


MONTANO ROAD - SYSTEM "A"
Sta 16+14 to Sta. 16+79

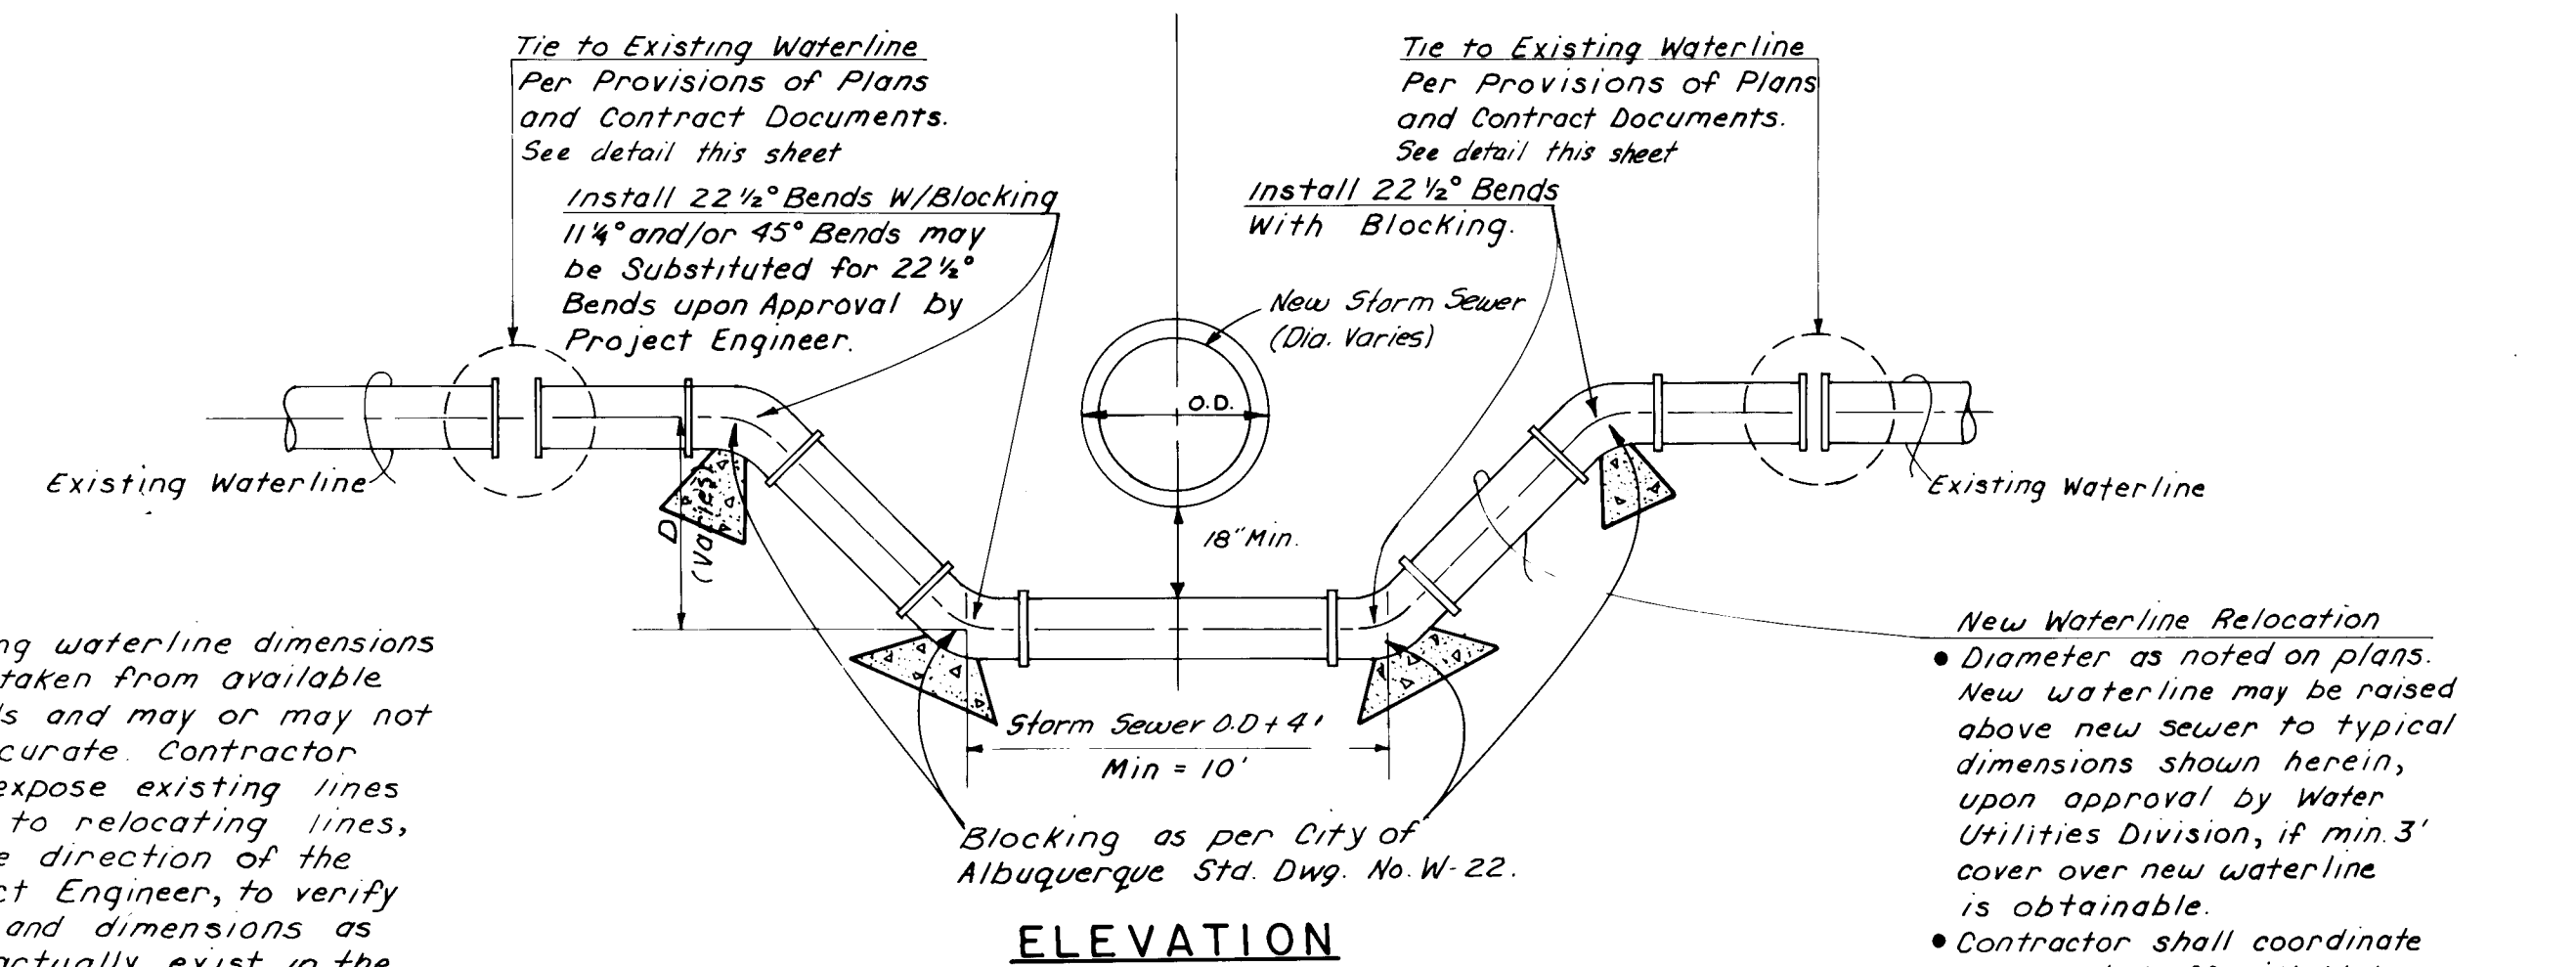

TYPICAL WATERLINE RELOCATION DETAIL


Not to Scale

NOTES: 1. Existing waterline dimensions were taken from available records and may or may not be accurate. Contractor shall expose existing lines prior to relocating lines, at the direction of the Project Engineer, to verify sizes and dimensions as they actually exist in the field.
2. Lengths of Waterline Relocation may be extended at direction of Project Engineer until suitable existing material is found to make connection in some cases maybe to existing main or Valve.

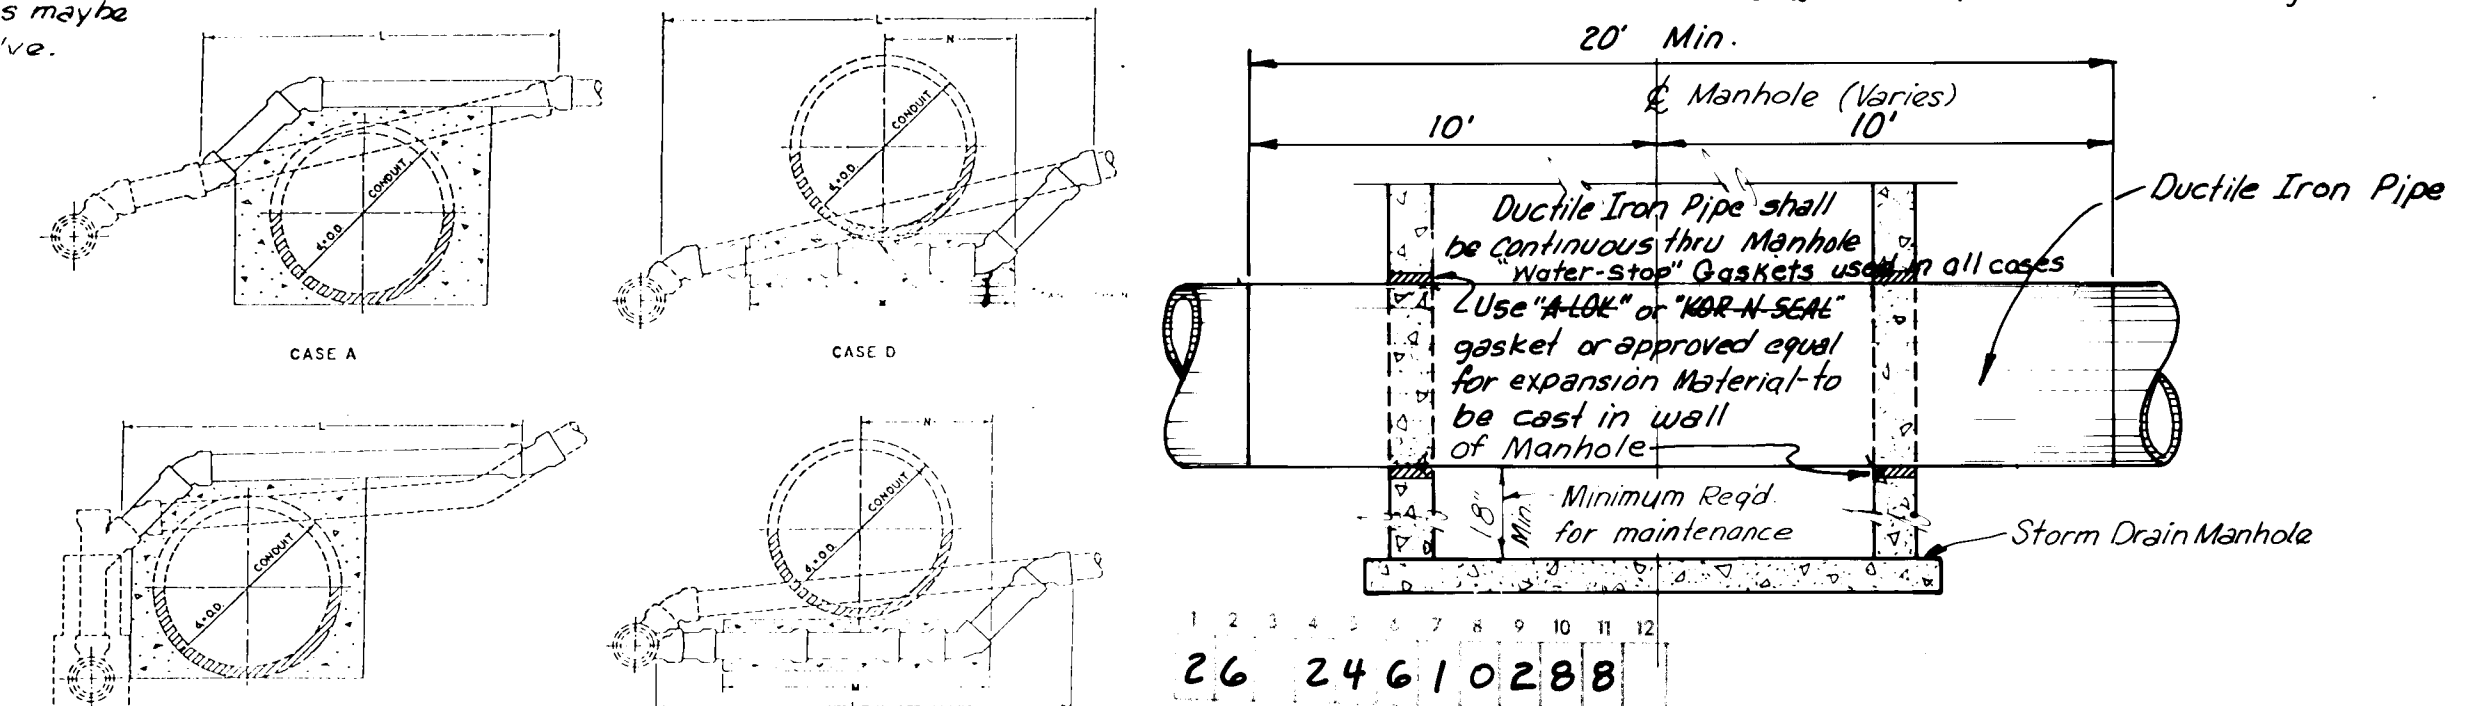

TYPICAL SAS LINE THRU STORM DRAIN MANHOLE

NTS

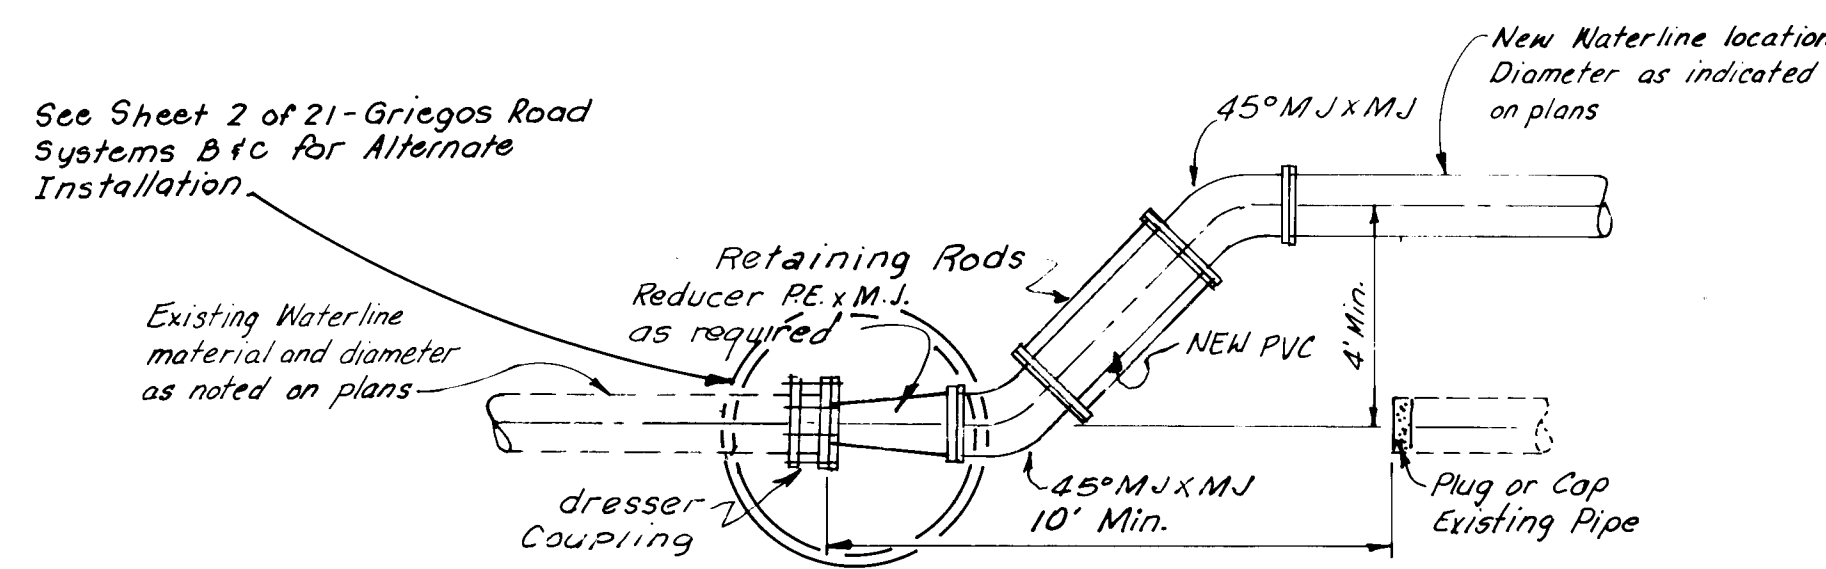

**PLAN VIEW
TYPICAL WATERLINE CONNECTION DETAIL**


TYPICAL SAS SERVICE LINE RELOCATION DETAIL

NTS

CITY OF ALBUQUERQUE MUNICIPAL DEVELOPMENT DEPARTMENT ENGINEERING DIVISION					
TITLE: NORTH VALLEY DRAINAGE SYSTEM IMPROVEMENTS GENERAL NOTES AND DETAILS MONTANO ROAD SYSTEM (A)					
APPROVALS	ENGINEER	DATE	APPROVALS	ENGINEER	DATE
City Engineer	Jul 11	12/9/86	Liquid Waste	W. Thompson	12-1-86
ACE - Design	Jul 11	12/9/86	Traffic	NADH	12-8/86
ACE - Hydrology	Jul 11	12/9/86	Water	W. Thompson	12-1-86
DRAWING NO.	2461	MAP NO.	SHEET 2 OF 19		

Scanlon Job No. 85113

RECORD DRAWING

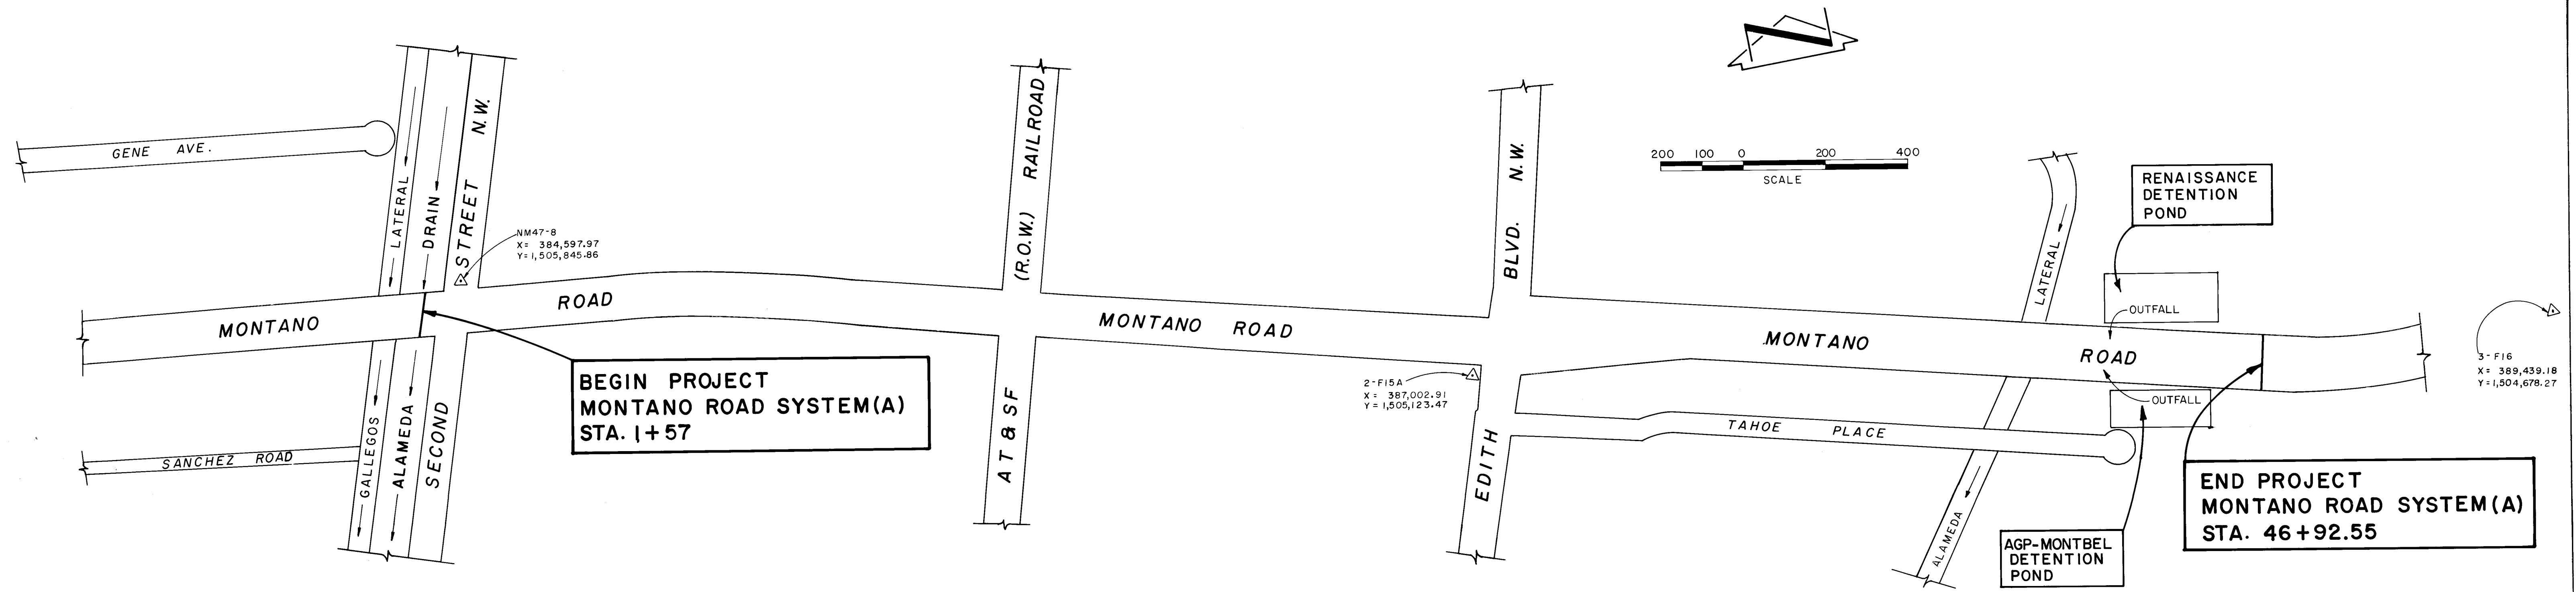

SITE PLAN
MONTANO ROAD SYSTEM (A)


LEGEND

	EXISTING CURB AND GUTTER		EXISTING SANITARY SEWER
	NEW STANDARD AND MEDIAN CURB AND GUTTER		EXISTING STORM DRAIN
	NEW ASPHALT CURB		EXISTING WATER LINE
	EXISTING SIDEWALK		EXISTING GAS LINE
	NEW SIDEWALK PATCH		NEW SANITARY SEWER
	NEW MEDIAN PATCH		NEW SANITARY SEWER MANHOLE
	PAVEMENT REPLACEMENT PER C.O.A. STD. DWG P-25		NEW STORM DRAIN
	EXISTING SIGN		NEW STORM DRAIN MANHOLE
	EXISTING POLE		NEW CATCH BASIN
	EXISTING CHAIN LINK FENCE		EXISTING SPOT ELEVATION
	EXISTING BLOCK WALL		NEW SPOT ELEVATION
	EXISTING WIRE FENCE		EXISTING TELEPHONE LINE
	EXISTING WOOD FENCE		EXISTING CABLE TELEVISION LINE
	NEW CHAIN LINK FENCE		EXISTING WATER METER
	PI OR CONTROL POINT		EXISTING WATER VALVE
	CONSTRUCTION CL AND SURVEY CL		EXISTING FIRE HYDRANT
	R/W LINE		NEW FIRE HYDRANT
	ELEVATION OF HYDRAULIC GRADE LINE		
	FLOW RATE C.F.S. 100 YEAR-6 HOUR RUNOFF		
	VELOCITY (FT./SEC) 100 YEAR-6 HOUR RUNOFF		

TRAFFIC CONTROL NOTES

- All traffic control devices, and their placement, shall comply with Chapter VI of the 1978 Edition MANUAL FOR UNIFORM TRAFFIC CONTROL DEVICES.
- The Contractor shall prepare and submit to the Project Engineer a detailed detour plan, which must be approved by the City Traffic Engineer three (3) working days in advance of any required lane closures.
- All signs must be installed before construction begins as directed by the Project Engineer. Sign heights shall be 7 ft. from the bottom of the sign to the sidewalk level.
- All drums or barrels may have sand or water ballast limited to 100 lbs.
- All sign locations will be selected in the field and approved by the City Traffic Engineer or Project Engineer. Distances may be adjusted for local conditions.
- All signs will be ground mounted on single or double posts. Existing posts may be used at some locations, with the approval of the Project Engineer. Portable sign supports will be acceptable as an alternate.
- All signs will be moved forward as the construction progresses, as determined appropriate by the Project Engineer.
- Construction equipment and materials shall not be stored within the roadway or on the median during non-work hours.
- When barriers are required after dark, all advance warning signs and all barricades shall be equipped with flashing warning lights (Type A), except that all channelizing devices shall have steady burning warning lights (Type C).
- All existing regulatory signs and signals that need to be removed, relocated or reinstalled shall be done by the City of Albuquerque Traffic Engineering Division. The Contractor shall notify the Traffic Engineering Division three (3) working days in advance of any required work.
- Exact locations of relocated traffic signal foundations shall be determined by the Traffic Engineering Division.
- The Contractor shall provide and maintain a safe and adequate means of channelizing pedestrian traffic around all work areas throughout the period of construction. All such channelization shall be arranged to prevent pedestrians from having to enter an open traffic lane in order to pass around the work areas.
- All construction signing shall be black on a reflectorized orange field unless otherwise specified. All construction barricades and channelization devices shall be orange on white, reflectorized, unless otherwise specified.
- The Contractor shall prepare and submit to the Project Engineer a detailed project phasing plan at the pre-construction conference for approval prior to beginning construction.


26 24610388

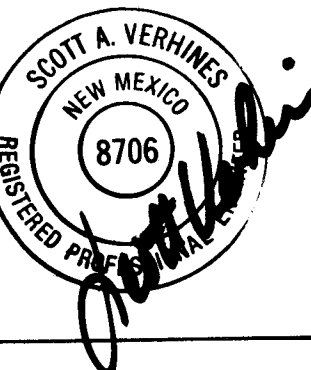

CITY OF ALBUQUERQUE MUNICIPAL DEVELOPMENT DEPARTMENT ENGINEERING DIVISION					
TITLE: MONTANO ROAD SYSTEM (A) SITE PLAN LEGEND & TRAFFIC CONTROL NOTES					
APPROVALS	ENGINEER	DATE	APPROVALS	ENGINEER	DATE
City Engineer			Liquid Waste	W/W	12-1-86
ACE - Design	<i>[Signature]</i>	12/9/86	Traffic	NADWH	12-8/86
ACE - Hydrology	<i>[Signature]</i>	12/9/86	Water	W/W	12-1-86
DRAWING NO.	2461		MAP NO.	F-15	
			SHEET	3	OF 19

Scanlon Job No. 85113

RECORD DRAWING

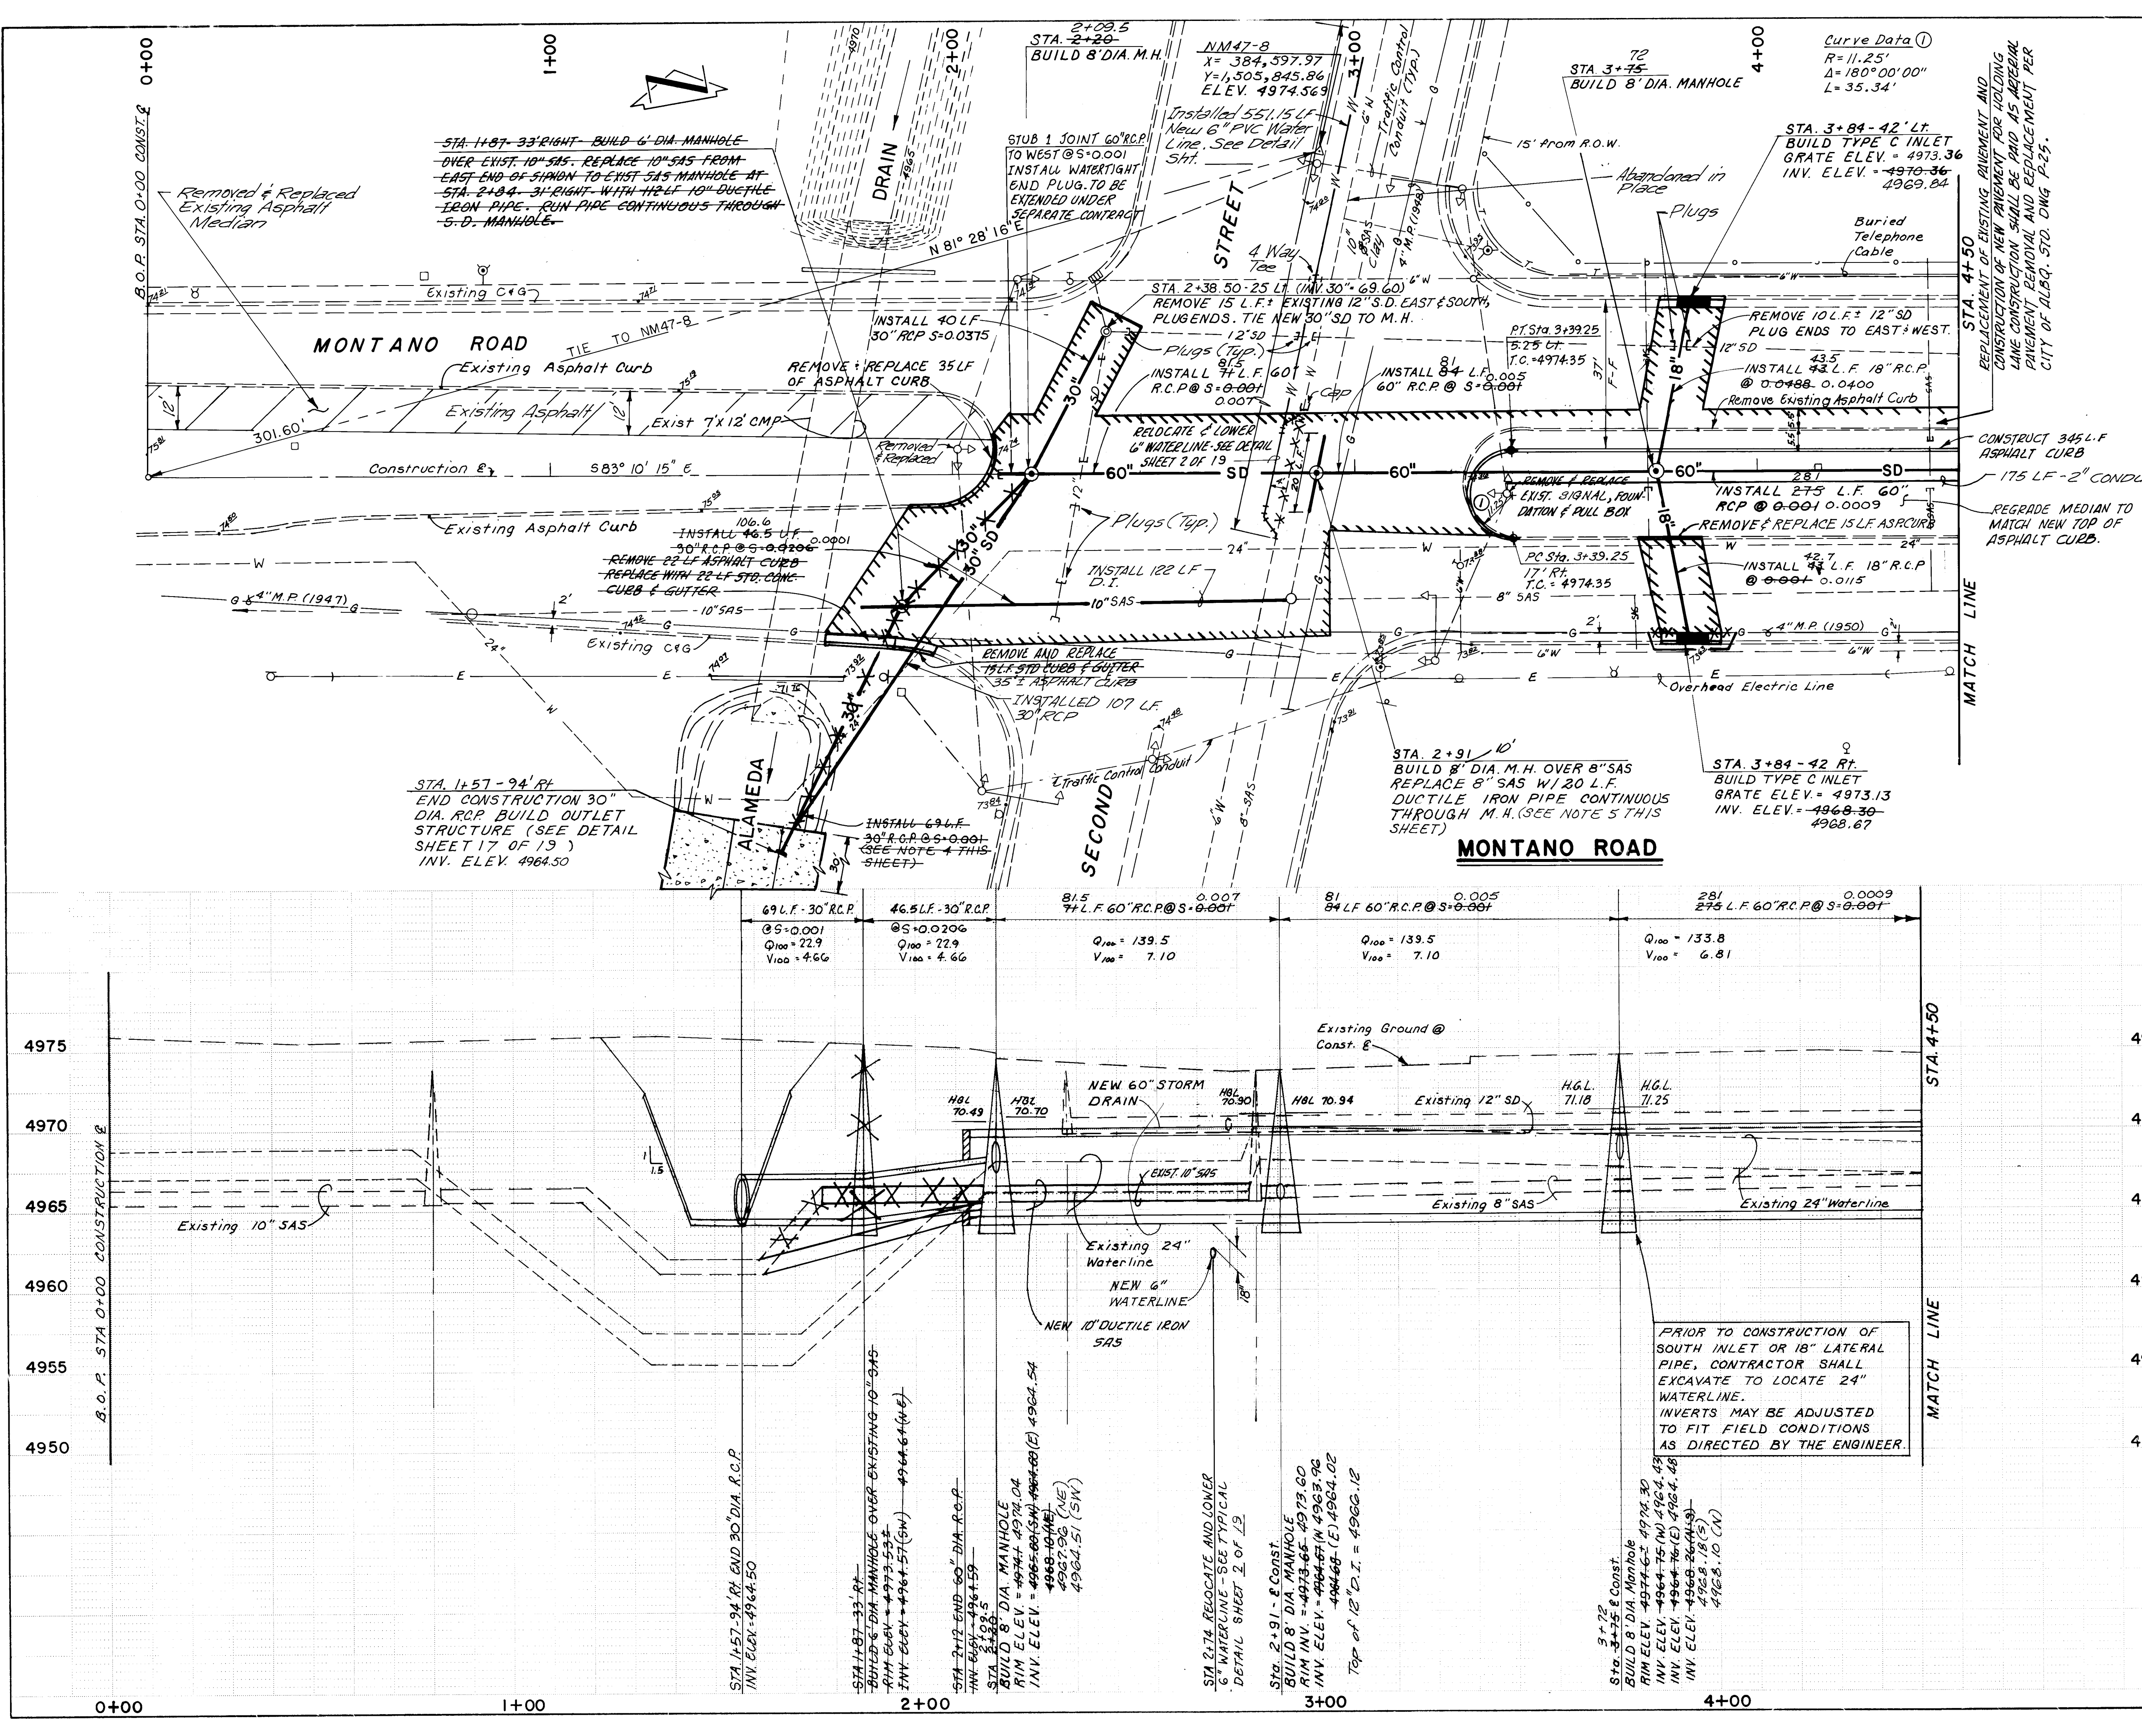

NOTE:

- ALL SPOT ELEVATIONS SHOWN ARE EXISTING TOP OF CURB UNLESS OTHERWISE NOTED
- WHEN CROSSING EXISTING SIGNAL CONDUIT REPLACE SIGNAL WIRE FROM TRAFFIC FIXTURE TO TRAFFIC FIXTURE
- SAS. SERVICE LINES NORTH SIDE OF MONTANO ROAD STA. 3+72 TO STA. 4+43 ARE NOT IN USE. ABANDON LINES AND PLUG PIPE ENDS.
- CONTRACTOR SHALL CONTACT UTILITY COMPANY AND COORDINATE SUPPORT OF EXISTING POLE AT SW RETURN PRIOR TO CONSTRUCTION OF 30" SD TO ALAMEDA DRAIN
- EXISTING 8" CONCRETE SAS HAS BEEN SLOPED WITH 7.125" D POLYETHYLENE. CONTRACTOR SHALL CONNECT EXISTING 7.125" SLOPED TO NEW 8" DUCTILE IRON REPLACEMENT PIPE WITH FLEXIBLE RUBBER COUPLING EACH END. ECCENTRIC TYPE. AS MANUFACTURED BY ATLAS FERNCO, OR APPROVED EQUAL. CONTRACTOR SHALL ENCASE PIPE 2' EITHER SIDE OF JOINTS PER COA STD. DWG. S-10. THE COST OF THE CONNECTIONS AND ENCASEMENT SHALL BE CONSIDERED INCIDENTAL TO PRICE BID FOR 8" DUCTILE IRON SEWER PIPE.
- EXISTING LINE 10" CLAY

26 24610488

SCALES
HORIZONTAL 1" = 20'
VERTICAL 1" = 5'

CITY OF ALBUQUERQUE
MUNICIPAL DEVELOPMENT DEPARTMENT
ENGINEERING DIVISION

TITLE: NORTH VALLEY DRAINAGE SYSTEM IMPROVEMENTS
MONTANO ROAD SYSTEM (A)
STORM DRAIN STA. 1 + 57 TO STA. 4 + 50

APPROVALS	ENGINEER	DATE	APPROVALS	ENGINEER	DATE
City Engineer	John H. [Signature]	12/1/86	Liquid Waste	WJW	12-1-86
Design	[Signature]	12/1/86	Traffic	NA DWA	12/1/86
Hydrology	[Signature]	12/1/86	Water	WJW	12-1-86

DRAWING NO. 2461 MAP NO. F-15 SHEET 4 OF 19

REVISIONS

NO.	DATE	REMARKS	BY
1	11/1/85	DESIGN	
2	11/1/85		

DESIGNED BY S.A.V.
DRAWN BY C.L.W.
CHECKED BY

ENGINEER'S SEAL

SCOTT A. VERMIREN
REGISTERED PROFESSIONAL ENGINEER
STATE OF NEW MEXICO
8106

SURVEY INFORMATION


FIELD NOTES	DATE	BY

BENCH MARKS

ACS 2 - FISA - ACS. BRASS. TABLET	ON CONCRETE POST SOUTHWEST CORNER MONTANO & EDITH	ELEV. 4984.24
NM5HC/ACS NM 47-8 BRASS TABLET IN ISLAND ON SECOND STREET NORTH OF MONTANO <td></td> <td>ELEV. 4974.569</td>		ELEV. 4974.569

AS BUILT 1" OR 1/2" DRAWING

CONTRACTOR: Scanlon & Associates, Inc.
DRAWN BY: Scanlon & Associates, Inc.
CHECKED BY: Scanlon & Associates, Inc.
DATE: 11-1-86

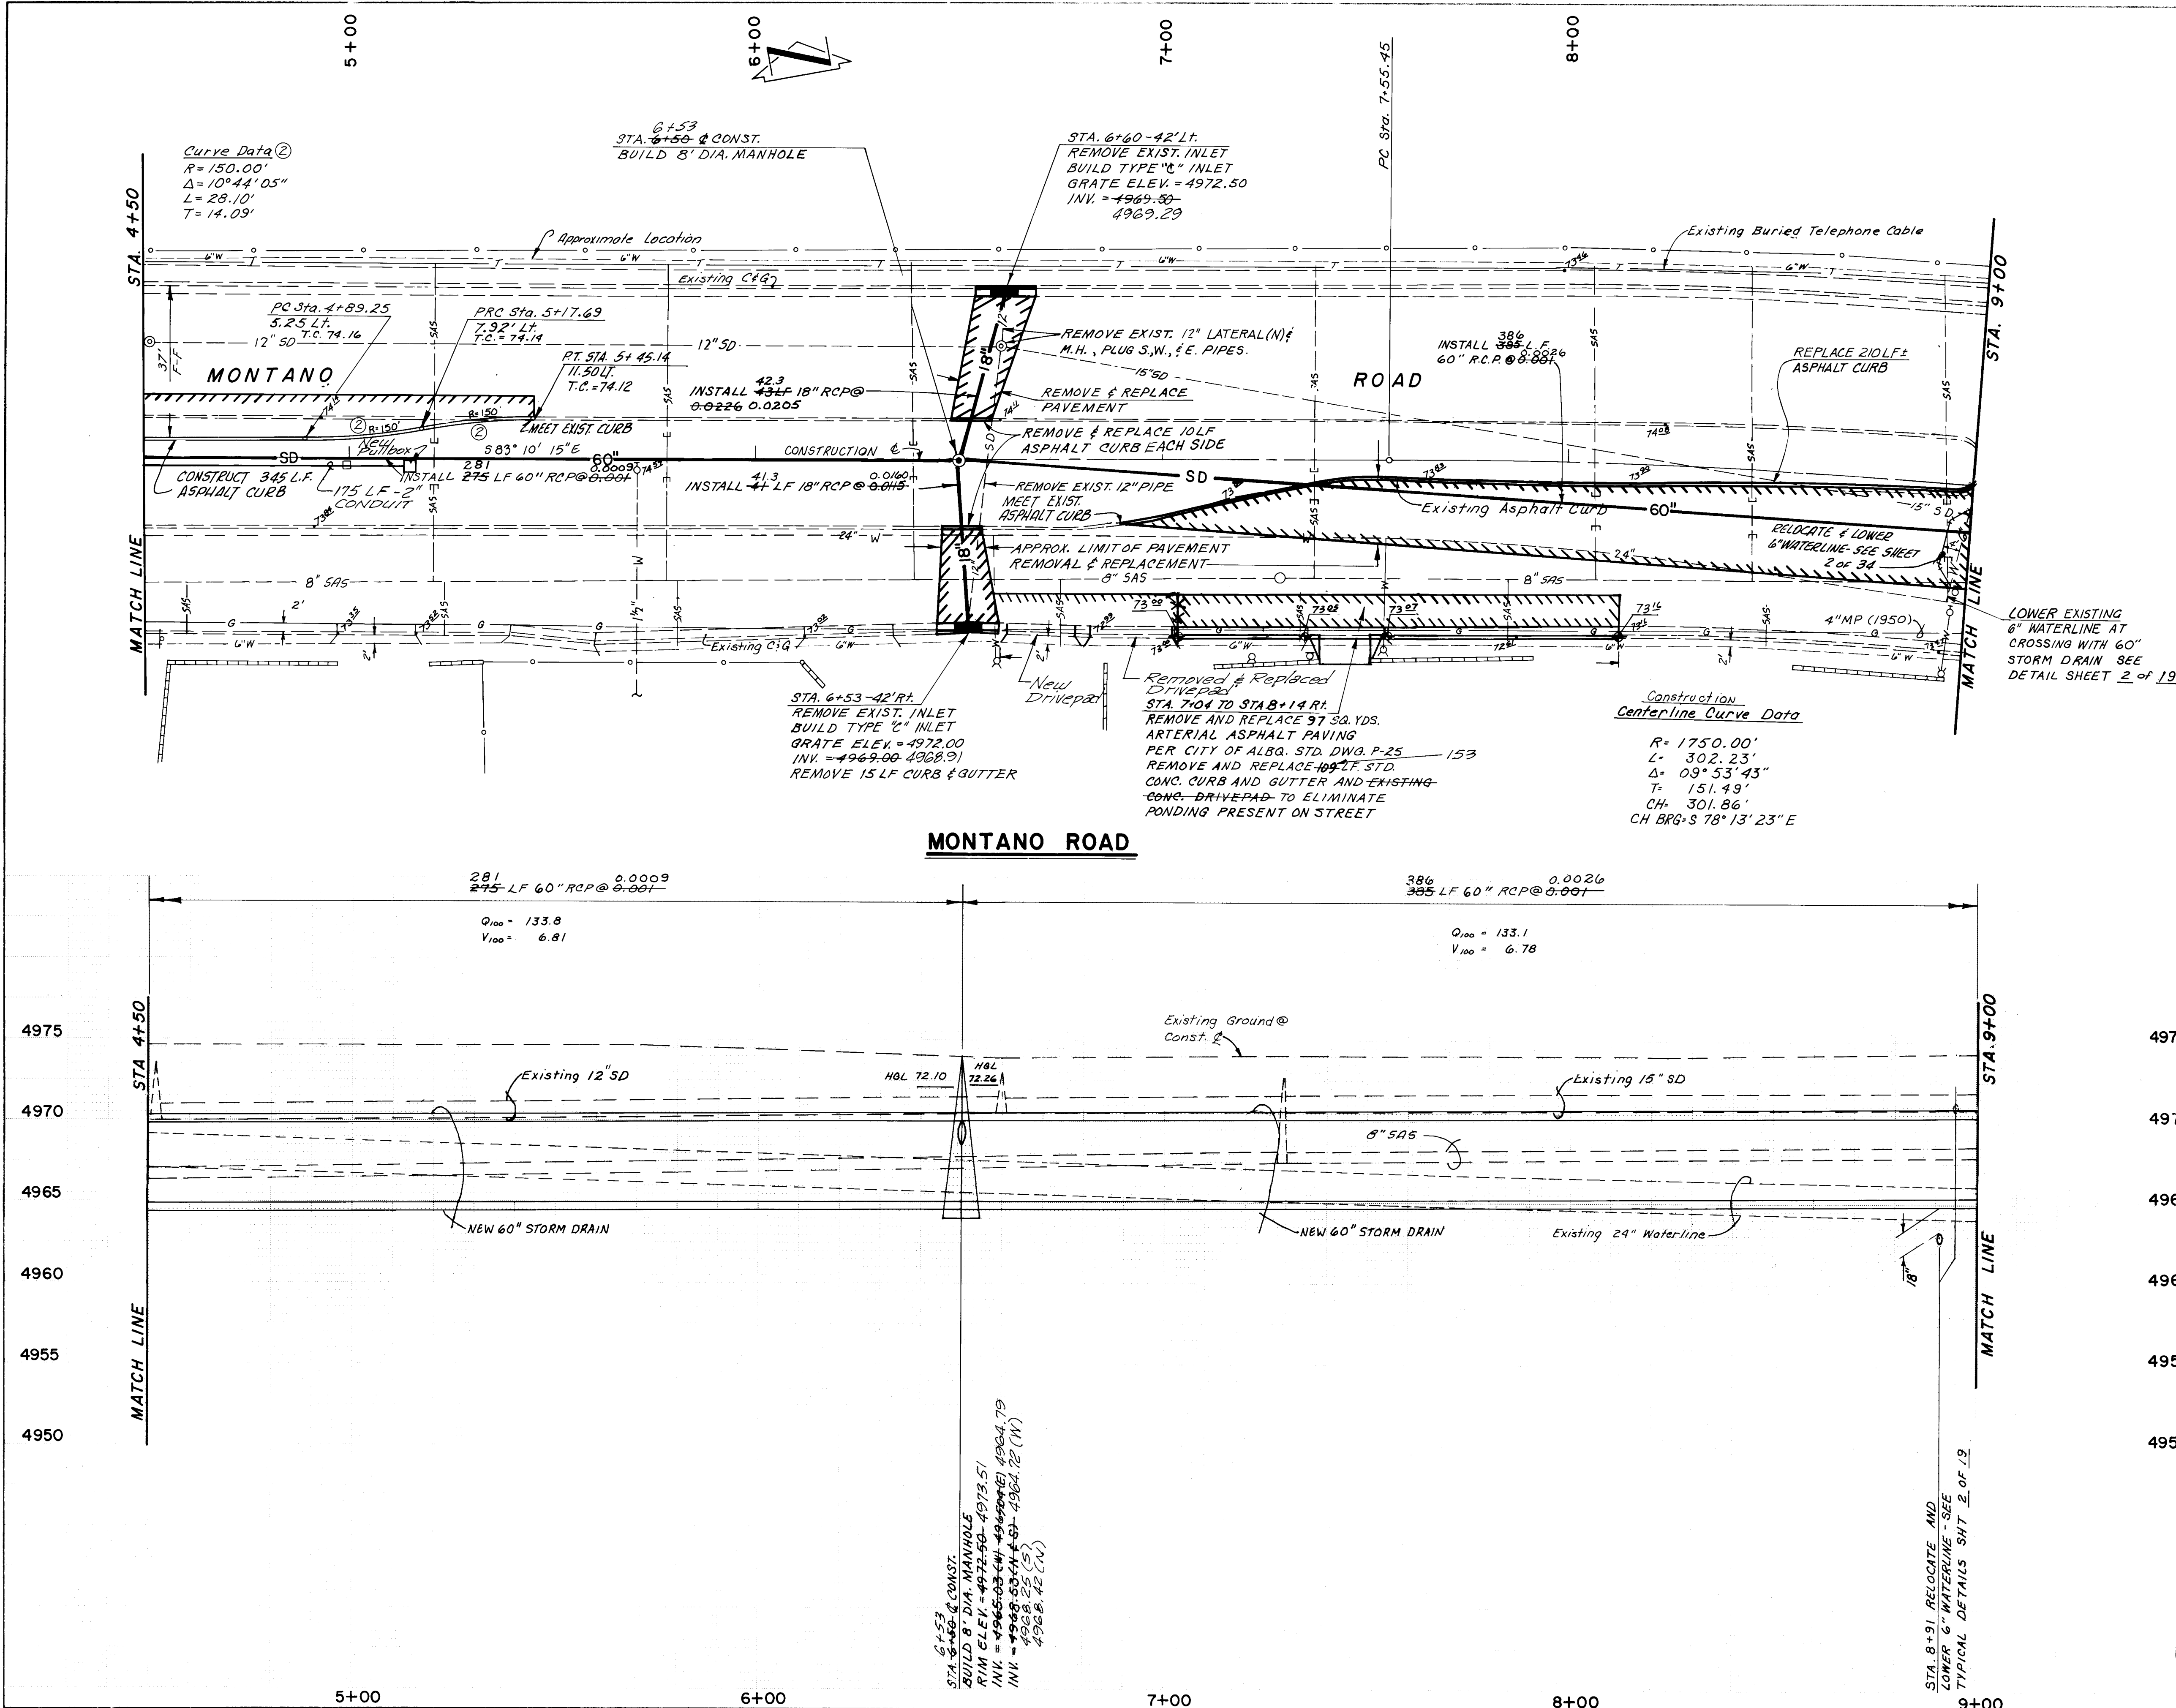

NOTE:
1. ALL SPOT ELEVATIONS SHOWN ARE EXISTING TOP OF CURB UNLESS OTHERWISE NOTED
2. SAS SERVICE LINES NORTH SIDE OF MONTANO ROAD FROM STA. 5+21 TO STA. 8+93 ARE NOT IN USE. ABANDON LINES AND PLUG PIPE ENDS.

AS BUILT INFORMATION		BENCH MARKS		SURVEY INFORMATION		ENGINEER'S SEAL	
CONTRACT NO.	NEW CONCEPTS, INC.	ACS 2-F15A-ACS BRASS	TABLET	FIELD NOTES	DATE		
DATE BY	DATE BY	ON CONCRETE POST	SOUTHWEST	NO	BY		
INSPECTED BY	DATE	CORNER	MONTANO & EDITH	NO	REVISIONS		
FIELD NO.	DATE	ELEV.	4984.24	NO	DATE		
MICRO-FILM INFORMATION		NMSHC/ACS NM 47-8 BRASS		DESIGNED BY S.A.K.		DATE 11/85	
DATE		TABLET IN ISLAND ON SECOND		DRAWN BY C.L.W.		DATE 11/85	
DATE		STREET NORTH OF MONTANO		CHECKED BY		DATE	
NO		ELEV. 4974.569					

26 2461058.8


SCALES
HORIZONTAL 1" = 20'
VERTICAL 1" = 5'

CITY OF ALBUQUERQUE
MUNICIPAL DEVELOPMENT DEPARTMENT
ENGINEERING DIVISION

TITLE NORTH VALLEY DRAINAGE SYSTEM IMPROVEMENTS
MONTANO ROAD SYSTEM (A)
STORM DRAIN STA. 4+50 TO STA. 9+00

APPROVALS	ENGINEER	DATE	APPROVALS	ENGINEER	DATE
City Engineer		12/3/84	Liquid Waste	W/W	12-1-86
Design		12/9/84	T. Affix	NADWH	12/9/86
Hydrology		12/8/84	Water	W/W	12-1-86

DRAWING NO. 2461 MAP NO. F-15 SHEET 5 OF 19

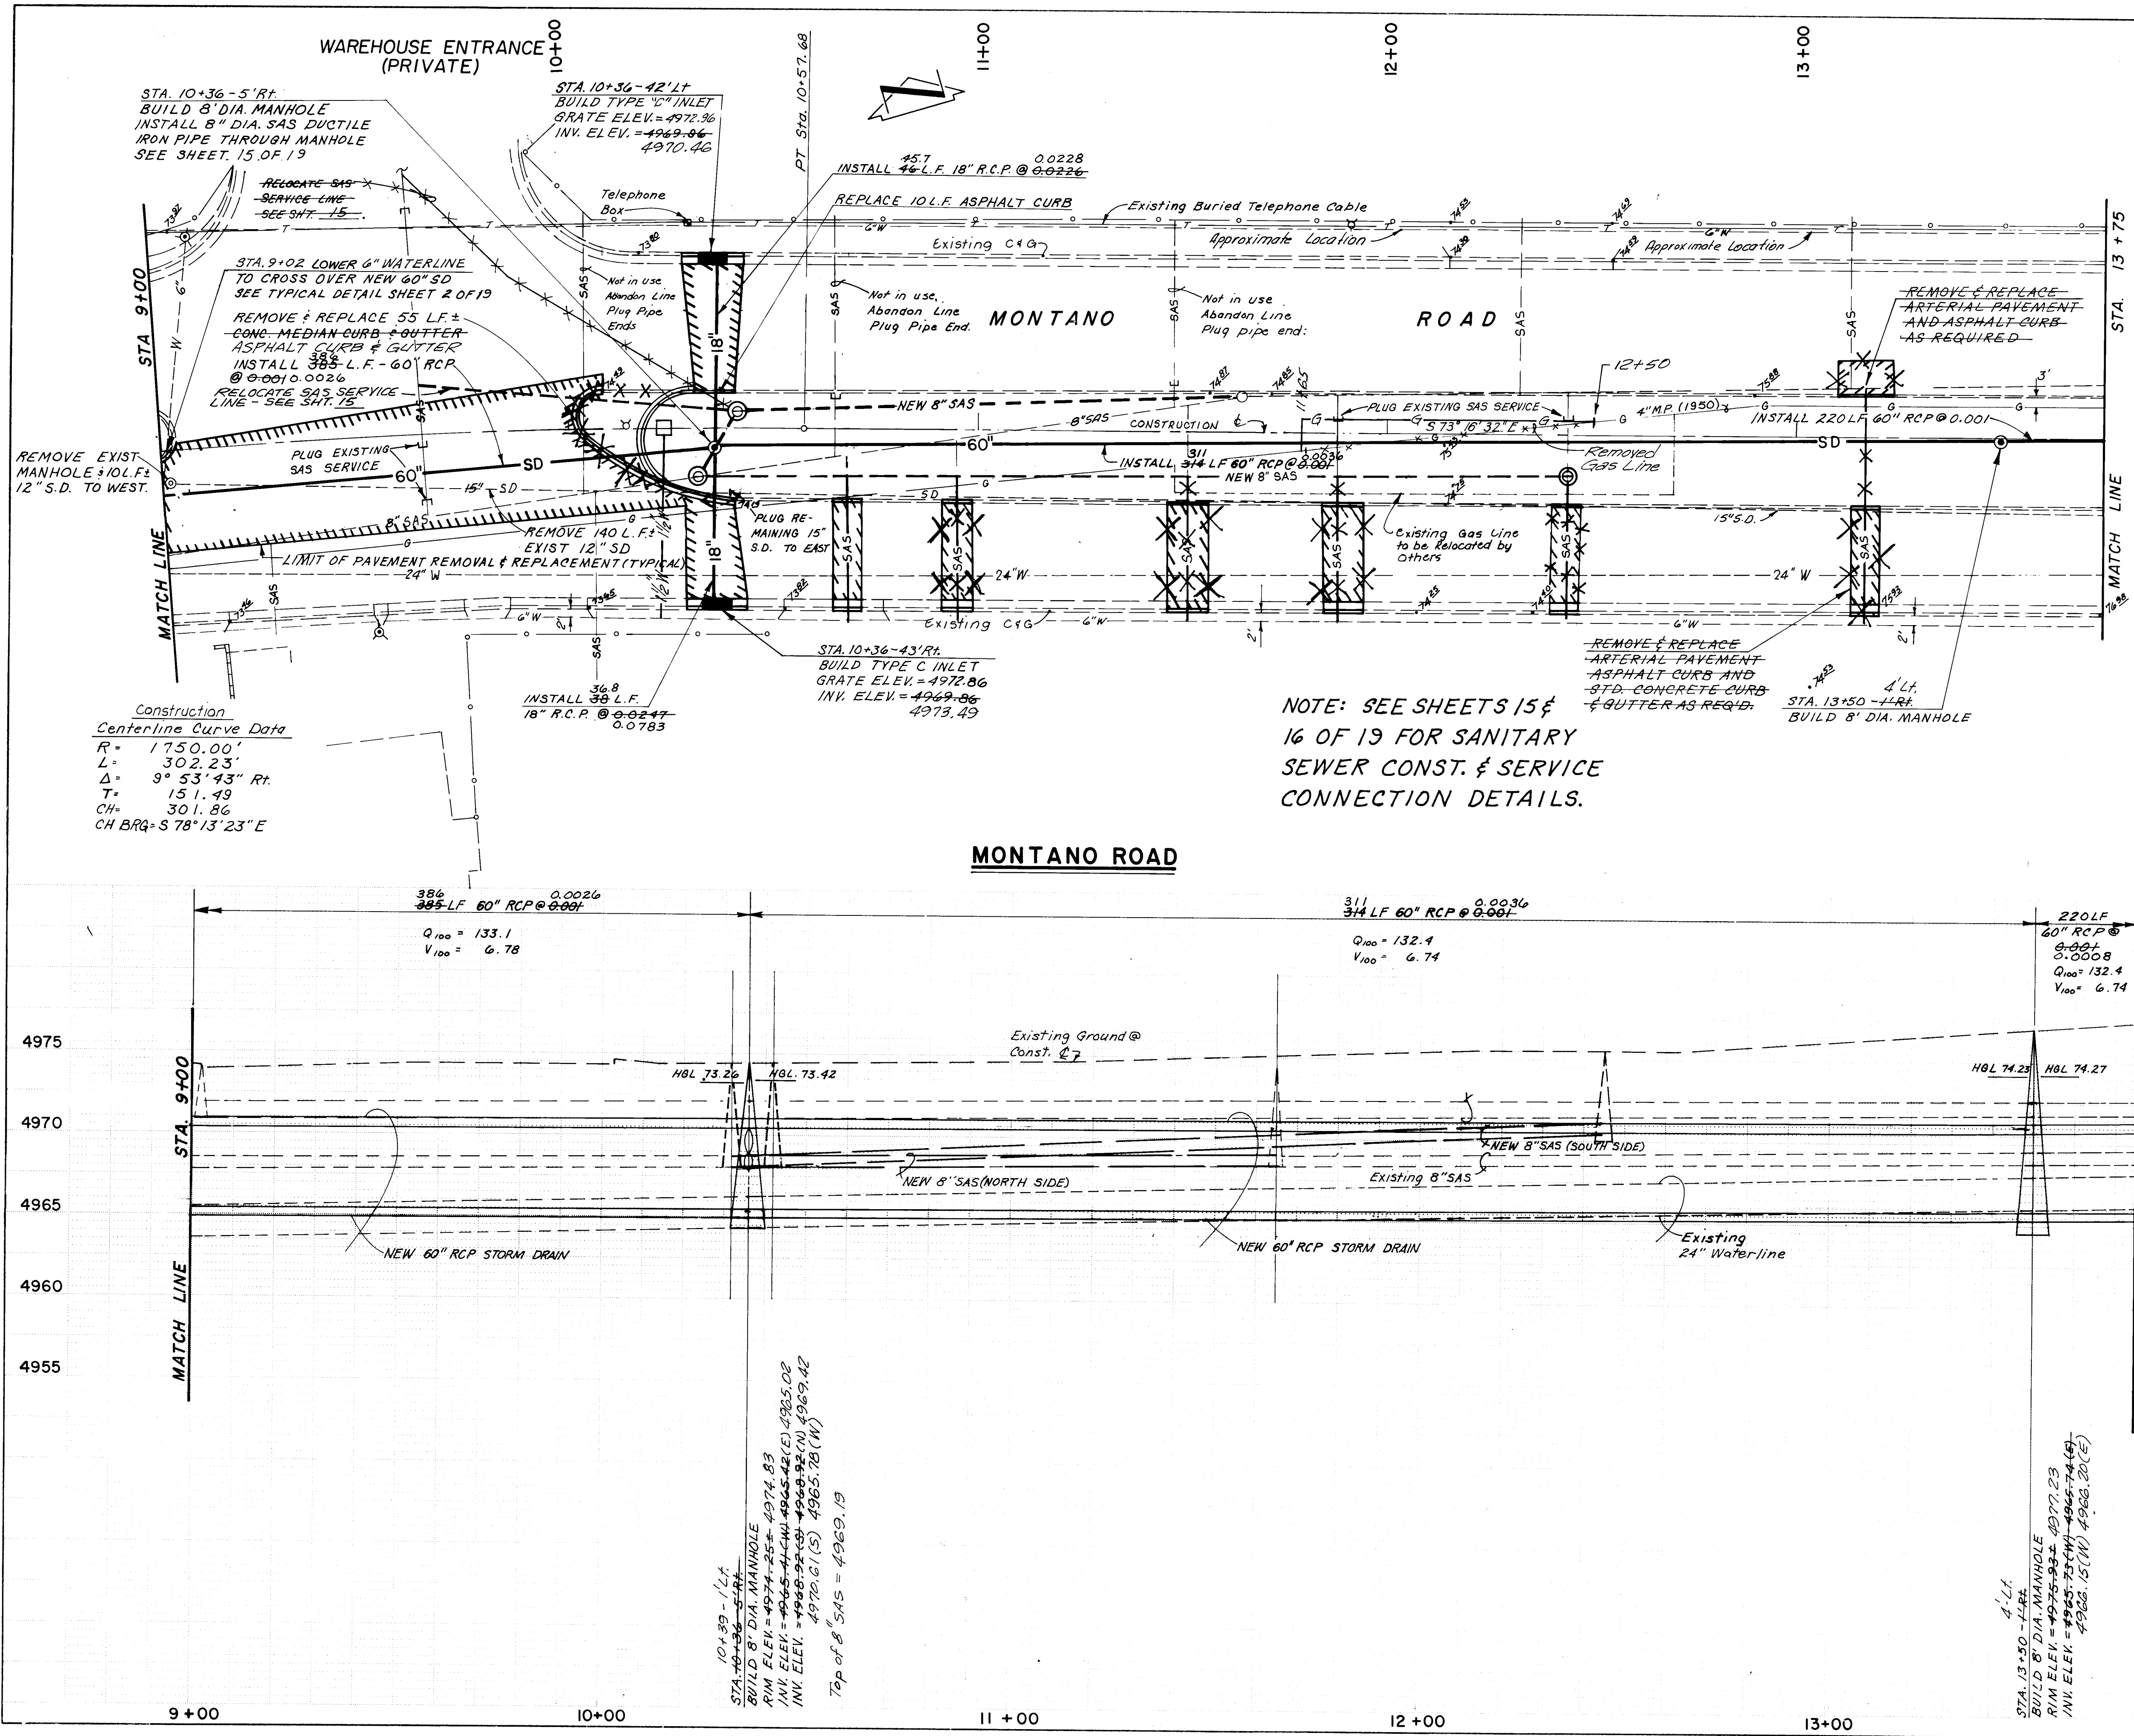


NOTE:
1. ALL SPOT ELEVATIONS SHOWN ARE EXISTING TOP OF CURB UNLESS OTHERWISE NOTED
2. STA. 13+17 SAS SERVICE LINES FROM SOUTH SIDE OF MONTANO ROAD SHALL BE ADJUSTED AND RECONNECTED TO EXISTING 8" SAS PER APPLICABLE DETAIL, SEE SHEET 2. CONTRACTOR SHALL LIMIT LENGTH OF REQUIRED ADJUSTMENTS TO THAT REQUIRED FOR PROPER INSTALLATION.

NOTE: SEE SHEETS 15 & 16 OF 19 FOR SANITARY SEWER CONST. & SERVICE CONNECTION DETAILS.

26 24610688
SCALES
HORIZONTAL 1" = 20'
VERTICAL 1" = 5'

CITY OF ALBUQUERQUE MUNICIPAL DEVELOPMENT DEPARTMENT ENGINEERING DIVISION					
TITLE: NORTH VALLEY DRAINAGE SYSTEM IMPROVEMENTS MONTANO ROAD SYSTEM(A) STORM DRAIN STA. 9+00 TO STA. 13+75					
APPROVALS	ENGINEER	DATE	APPROVALS	ENGINEER	DATE
City Engineer	<i>[Signature]</i>	12/3/86	Liquid Waste	JW	12-1-86
Design	<i>[Signature]</i>	12/9/86	Traffic	NA DWH	12/8/86
Hydrology	<i>[Signature]</i>	12/9/86	Water	JW	12-1-86
DRAWING NO. 2461		MAP NO. F-15		SHEET 6 OF 19	

AS BUILT INFORMATION		BENCH MARKS		SURVEY INFORMATION		ENGINEER'S SEAL	
CONTRACTOR	Scanlon & Associates, Inc.	ACS 2 - F15A - ACS BRASS TABLET ON CONCRETE POST SOUTHWEST CORNER MONTANO & EDITH	DATE	NO.	BY		REVISIONS
DATE	11-88	ELEV. 4984.24					
DATE							
DATE							
MICRO-FILM INFORMATION		NMSHC/ACS NM 47-8 BRASS TABLET IN ISLAND ON SECOND STREET NORTH OF MONTANO		DESIGNED BY S.A.V.		DATE 11/85	DATE
		ELEV. 4974.569		DRAWN BY C.L.W.		DATE 11/85	DATE
				CHECKED BY			

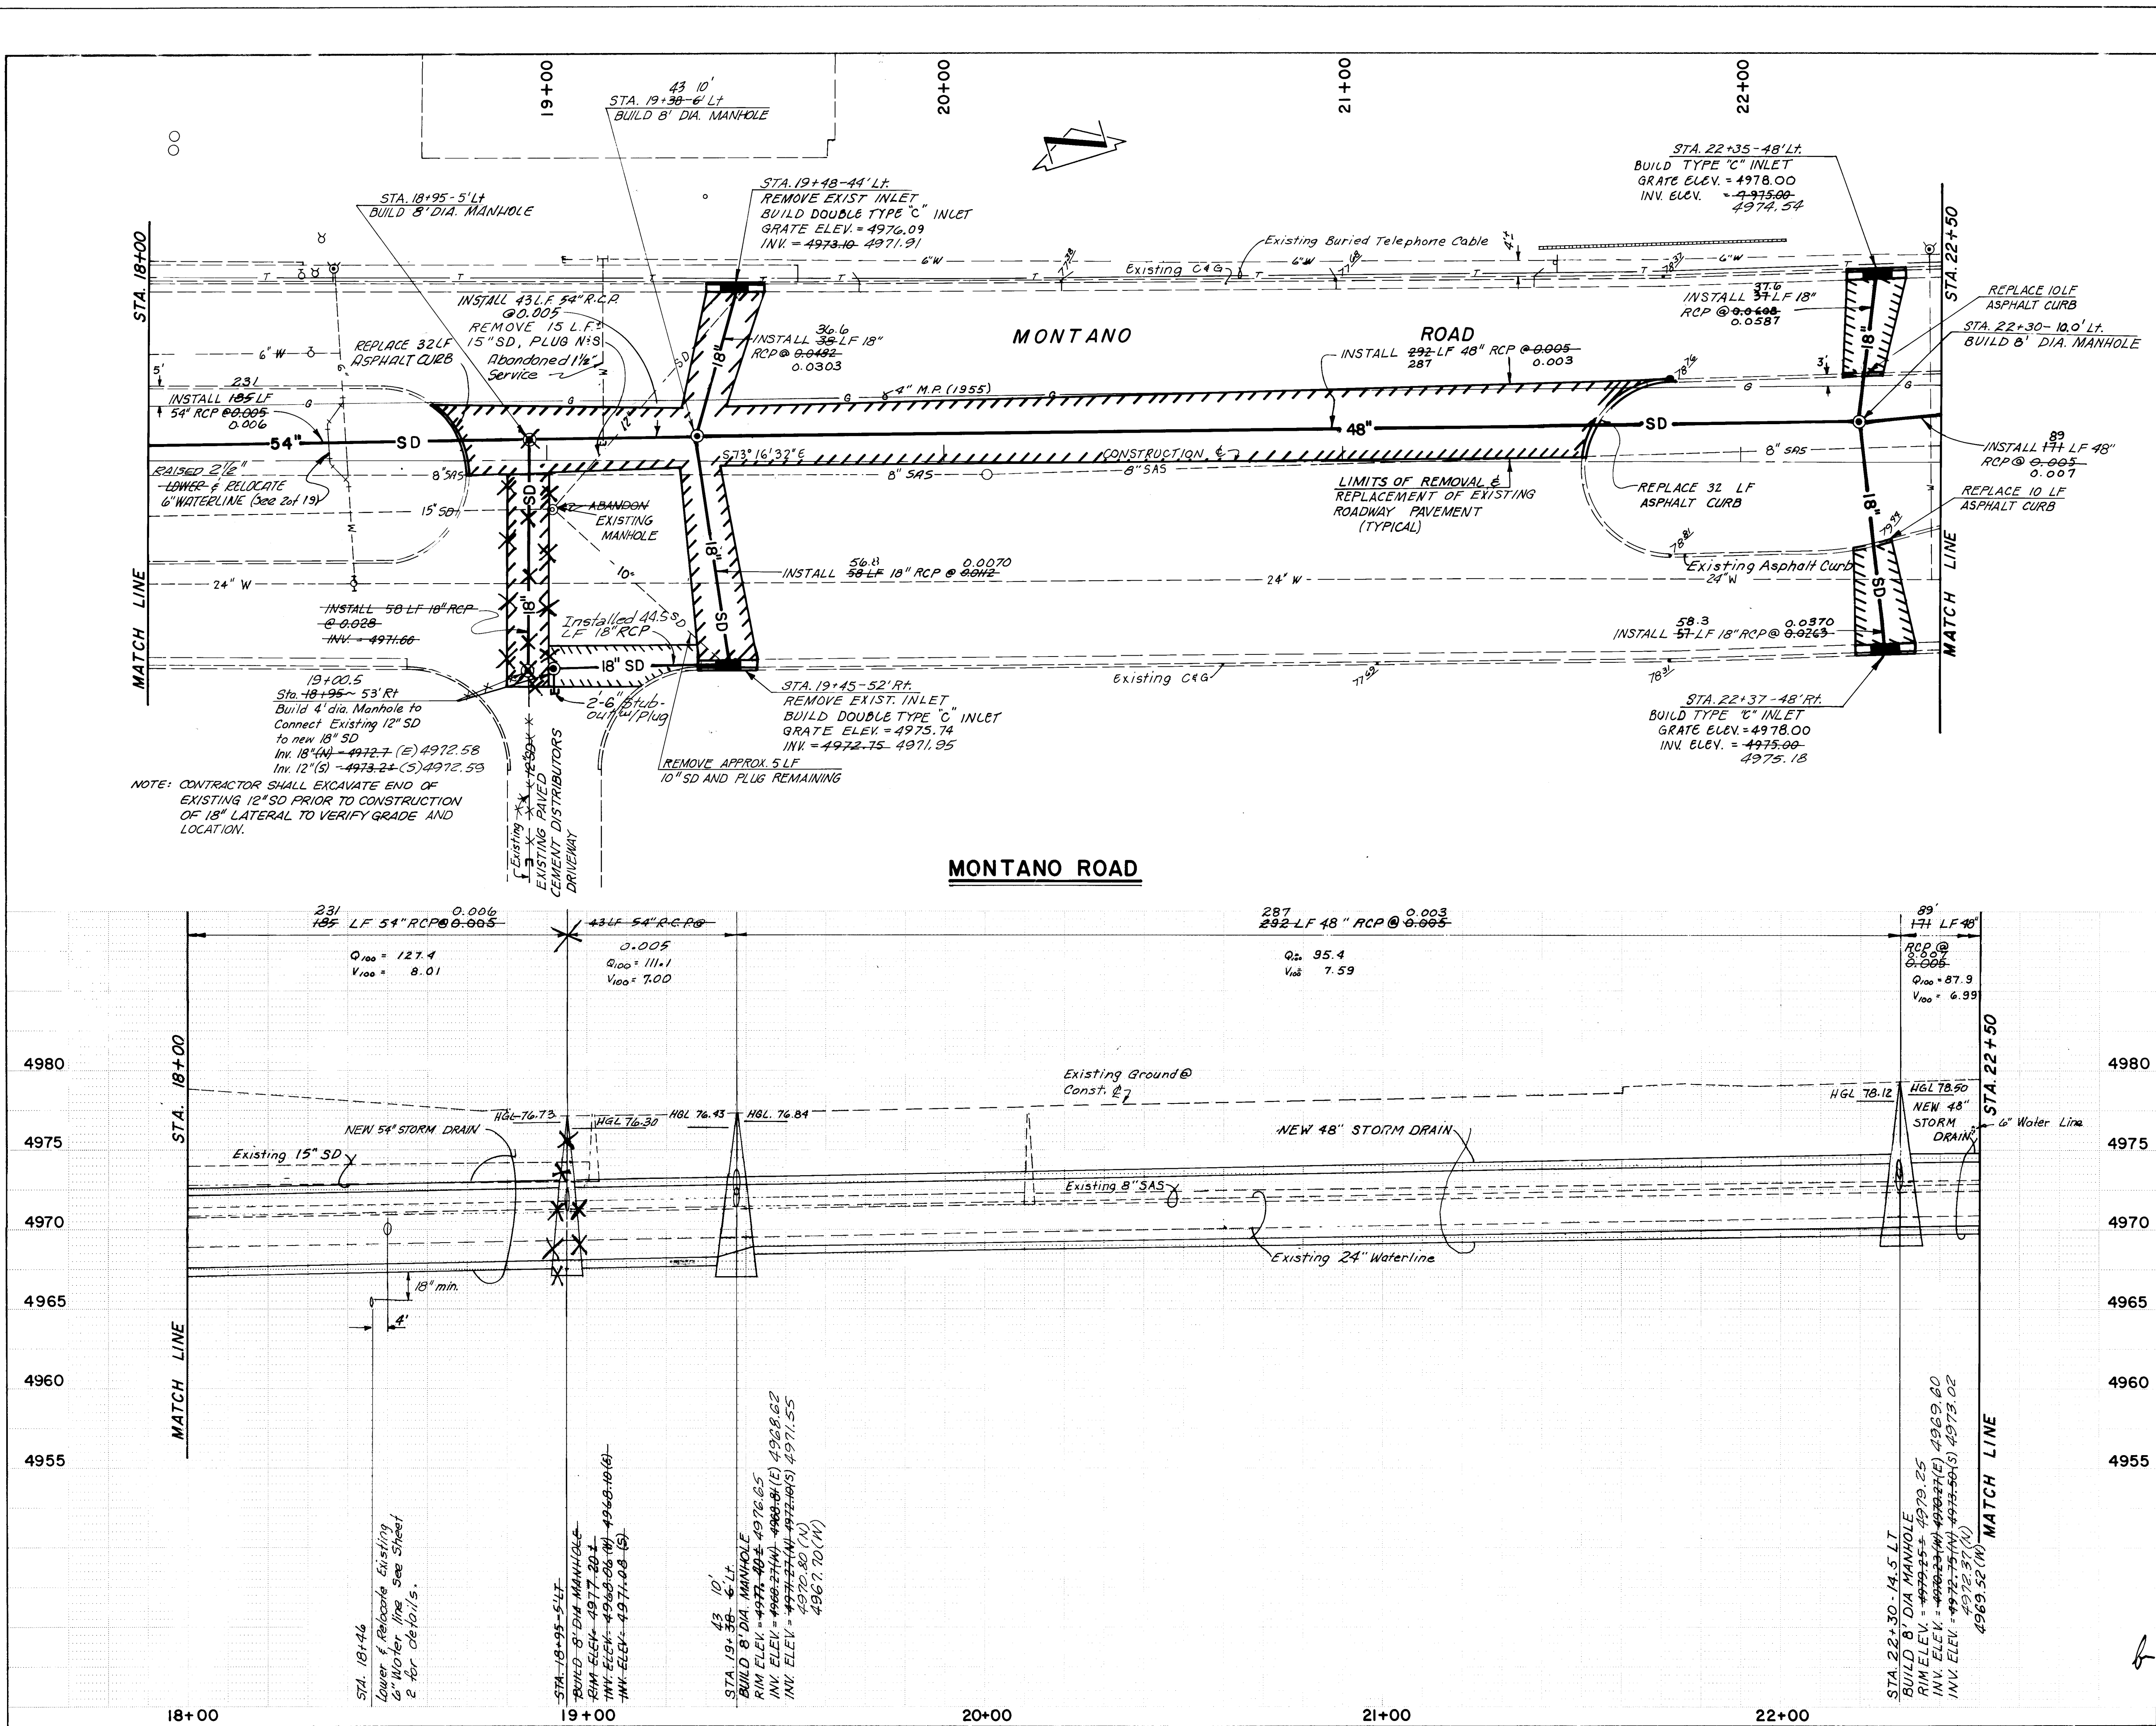

NOTE:
ALL SPOT ELEVATIONS
SHOWN ARE EXISTING
TOP OF CURB UNLESS
OTHERWISE NOTED

26 24610888


SCALES
HORIZONTAL 1" = 20'
VERTICAL 1" = 5'

CITY OF ALBUQUERQUE MUNICIPAL DEVELOPMENT DEPARTMENT ENGINEERING DIVISION					
TITLE: NORTH VALLEY DRAINAGE SYSTEM IMPROVEMENTS MONTANO ROAD SYSTEM (A) STORM DRAIN STA. 18+00 TO STA. 22+50					
APPROVALS	ENGINEER	DATE	APPROVALS	ENGINEER	DATE
City Engineer	<i>[Signature]</i>	12/5/06	Liquid Waste	WJW	12-1-06
ACE - Design	<i>[Signature]</i>	12/9/06	Traffic	NA DWH	12/8/06
ACE - Hydrology	<i>[Signature]</i>	12/9/06	Water	WJW	12-1-06
DRAWING NO. 2461		MAP NO. F - 15		SHEET 8 OF 19	

Scanlon Job No. 85113

RECORD DRAWING

AS BUILT INFORMATION		BENCH MARKS		SURVEY INFORMATION		ENGINEER'S SEAL	
CONTRACT FOR New Concepts, Inc.	TABLET	ACS 2 - F15A - ACS BRASS	DATE	NO.	BY		
STA. 18+00	DATE 11-88	ON CONCRETE POST SOUTHWEST	DATE				
INSTRUMENTED BY Associates	DATE	CORNER MONTANO & EDITH				REVISIONS	
FIELD MADE BY	DATE	ELEV. 4984.24					
REVISIONS	DATE	NMSHC/ACS NM 47-8 BRASS				DESIGNED BY S.A.K.	
CORRECTED BY Associates	DATE	TABLET IN ISLAND ON SECOND					
MICRO-FILM INFORMATION	DATE	STREET NORTH OF MONTANO				DRAWN BY C.L.W.	
	DATE	ELEV. 4974.569					

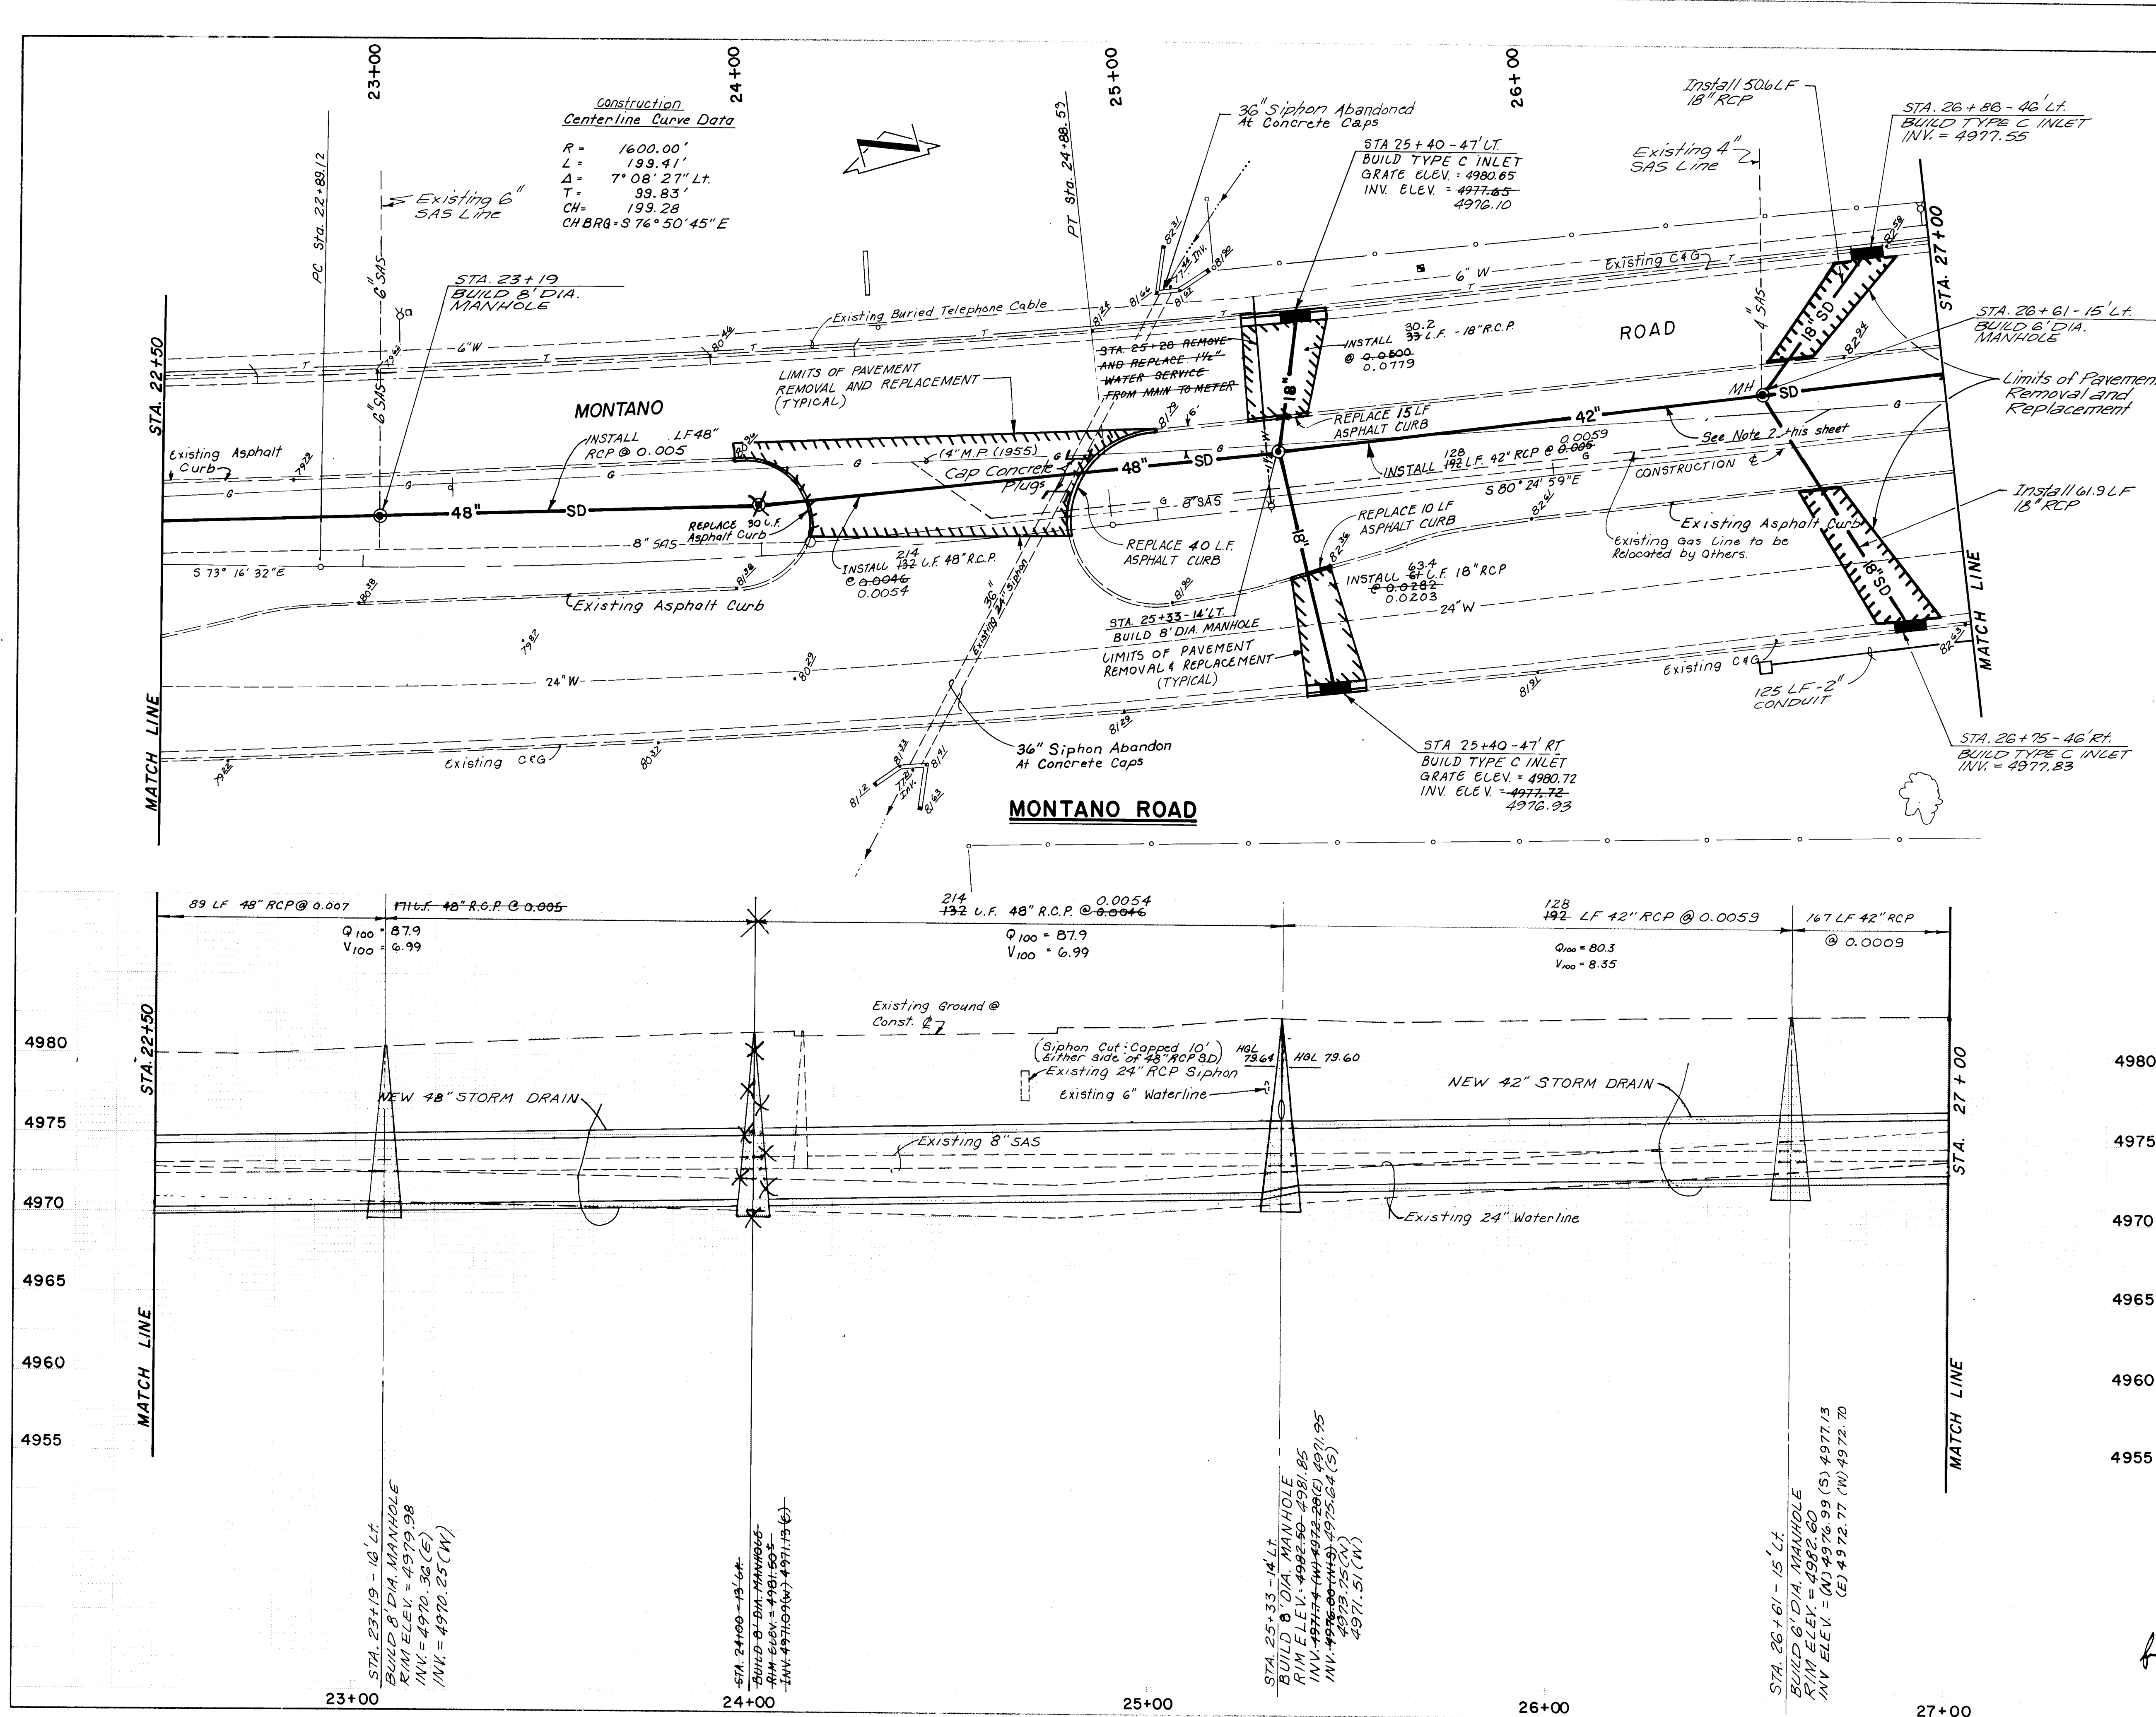

NOTE:
1. ALL SPOT ELEVATIONS SHOWN ARE EXISTING TOP OF CURB UNLESS OTHERWISE NOTED
2. CONTRACTOR SHALL EXCAVATE TO MORE SPECIFICALLY LOCATE EXISTING GAS LINE AND ANY POTENTIAL CONFLICT. ANY REQUIRED RELOCATIONS OF GAS LINES SHALL BE BY OTHERS. CONTRACTOR SHALL COORDINATE WITH GAS COMPANY.

AS BUILT INFORMATION		BENCH MARKS		SURVEY INFORMATION		ENGINEER'S SEAL	
CONTRACTOR: Scanlon & Associates, Inc.		ACS 2 - FISA - ACS BRASS TABLET ON CONCRETE POST SOUTHWEST CORNER MONTANO & EDITH ELEV. 4984.24		FIELD NOTES		NO. DATE BY	
WORK: Storm Drain Improvements		NMSHC/ACS NM 47-8 BRASS TABLET IN ISLAND ON SECOND STREET NORTH OF MONTANO ELEV. 4974.569		NO. DATE BY		REVISIONS	
INSPECTOR: DATE 11-88		DATE 11/85		NO. DATE BY		DESIGNED BY S.A.V. DATE 11/85	
DATE 11-88		DATE 11/85		NO. DATE BY		DRAWN BY C.L.W. DATE 11/85	
DATE 11-88		DATE 11/85		NO. DATE BY		CHECKED BY	

26 24610988


SCALES
HORIZONTAL 1" = 20'
VERTICAL 1" = 5'

CITY OF ALBUQUERQUE
MUNICIPAL DEVELOPMENT DEPARTMENT
ENGINEERING DIVISION

TITLE: NORTH VALLEY DRAINAGE SYSTEM IMPROVEMENTS
MONTANO ROAD SYSTEM(A)
STORM DRAIN STA. 22+50 TO STA. 27+00

APPROVALS	ENGINEER	DATE	APPROVALS	ENGINEER	DATE
City Engineer	[Signature]	12/9/86	Liquid Waste	[Signature]	12-1-86
ASCE Design	[Signature]	12/9/86	Traffic	[Signature]	12/8/86
ASCE Hydrology	[Signature]	12/9/86	Water	[Signature]	12-1-86

DRAWING NO. 2461 MAP NO. F - 15 SHEET 9 OF 19


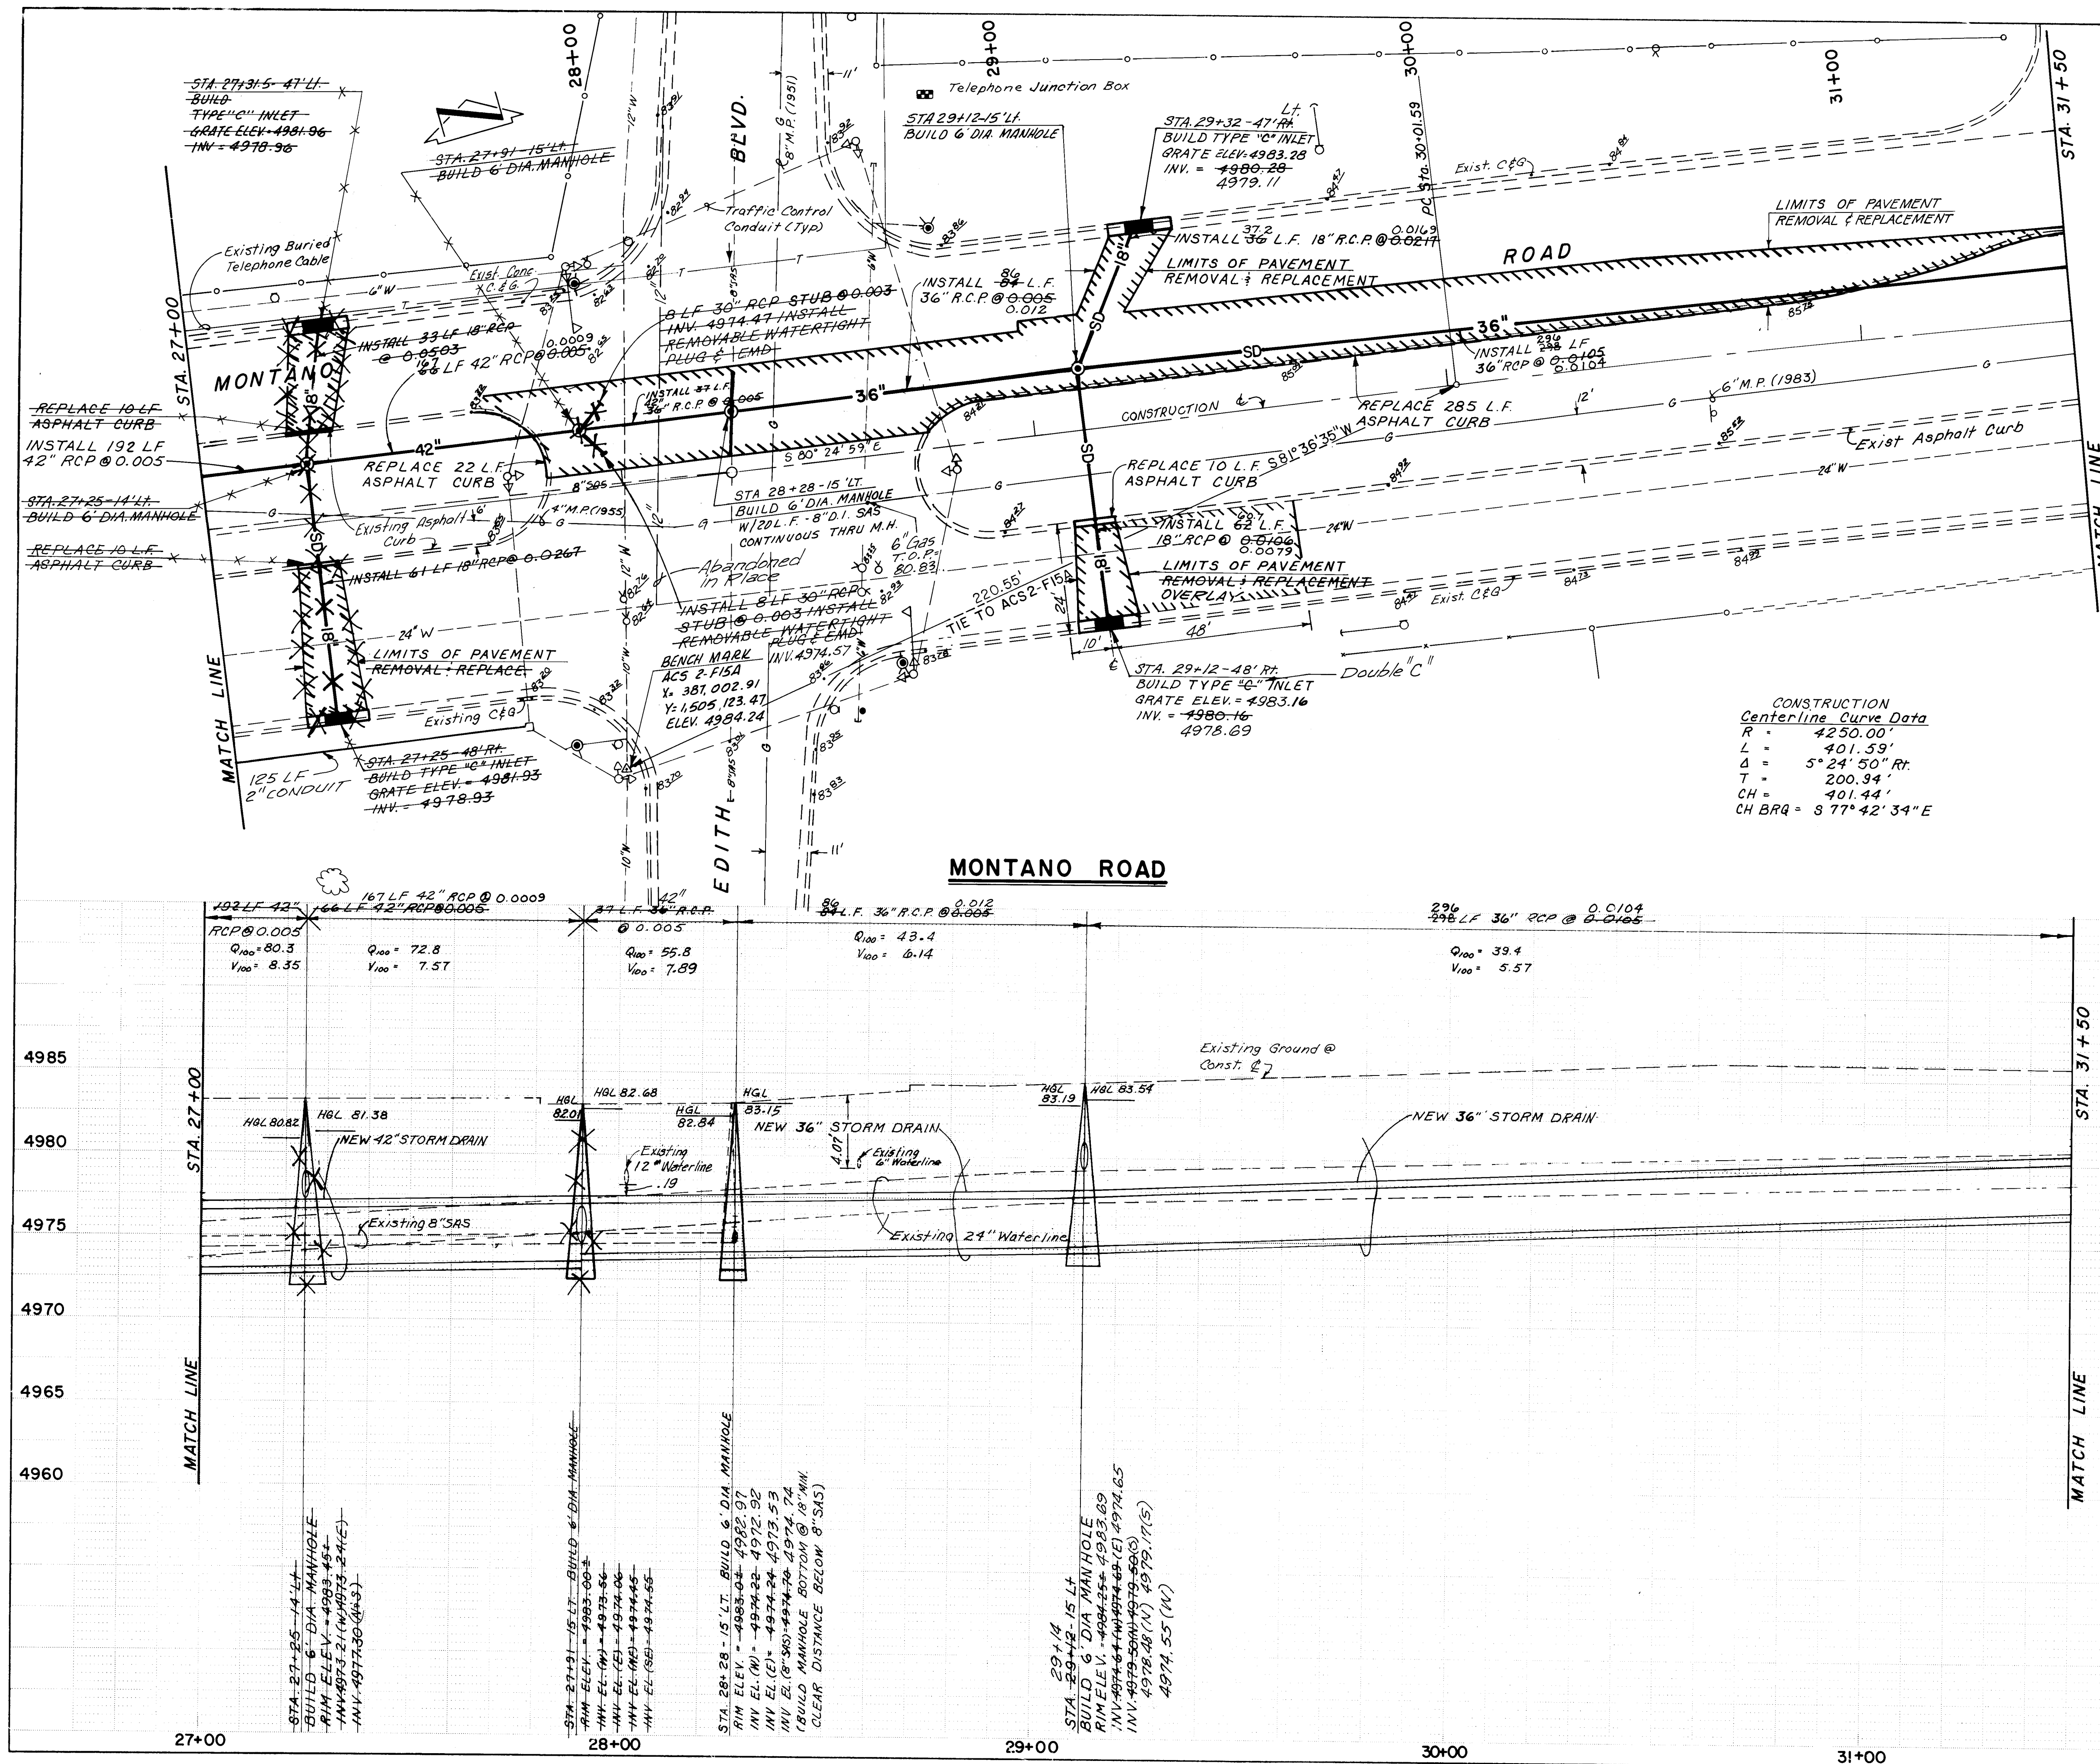


NOTE:
1. ALL SPOT ELEVATIONS SHOWN ARE EXISTING TOP OF CURB UNLESS OTHERWISE NOTED
2. WHEN CROSSING EXISTING SIGNAL CONDUIT REPLACE SIGNAL WIRE FROM TRAFFIC FIXTURE TO TRAFFIC FIXTURE
3. "EMD" = ELECTRONIC MARKER DISK INSTALLED PER C.O.A. STANDARD DRAWING S-12.

26 24611088
SCALES
HORIZONTAL 1"=20'
VERTICAL 1"=5'

CITY OF ALBUQUERQUE MUNICIPAL DEVELOPMENT DEPARTMENT ENGINEERING DIVISION					
TITLE: NORTH VALLEY DRAINAGE SYSTEM IMPROVEMENTS MONTANO ROAD SYSTEM(A) STORM DRAIN STA. 27+00 TO STA. 31+50					
APPROVALS	ENGINEER	DATE	APPROVALS	ENGINEER	DATE
City Engineer	<i>[Signature]</i>	12/9/86	Liquid Waste	<i>[Signature]</i>	12-1-86
Design	<i>[Signature]</i>	12/9/86	Traffic	NADWH	12/9/86
Hydrology	<i>[Signature]</i>	12/9/86	Water	<i>[Signature]</i>	12-1-86
DRAWING NO. 2461		MAP NO. F-15		SHEET 10 OF 19	

AS BUILT INFORMATION		BENCH MARKS		SURVEY INFORMATION		ENGINEER'S SEAL	
CONTRACTOR	Scanton & Associates	ACS 2-FISA-ACS BRASS	TABLET	FIELD NOTES	NO.		REVISIONS DESIGN DATE 11/85 DRAWN BY C.L.W. CHECKED BY
WORK	Scanton & Associates	ON CONCRETE POST SOUTHWEST		BY			
INSPECTOR	Scanton & Associates	CORNER MONTANO & EDITH		DATE			
DATE	11-88	ELEV. 4984.24					
MICRO-FILM INFORMATION		NMSHC/ACS NM 47-8 BRASS					
DATE		TABLET IN ISLAND ON SECOND					
DATE		STREET NORTH OF MONTANO					
DATE		ELEV. 4974.569					

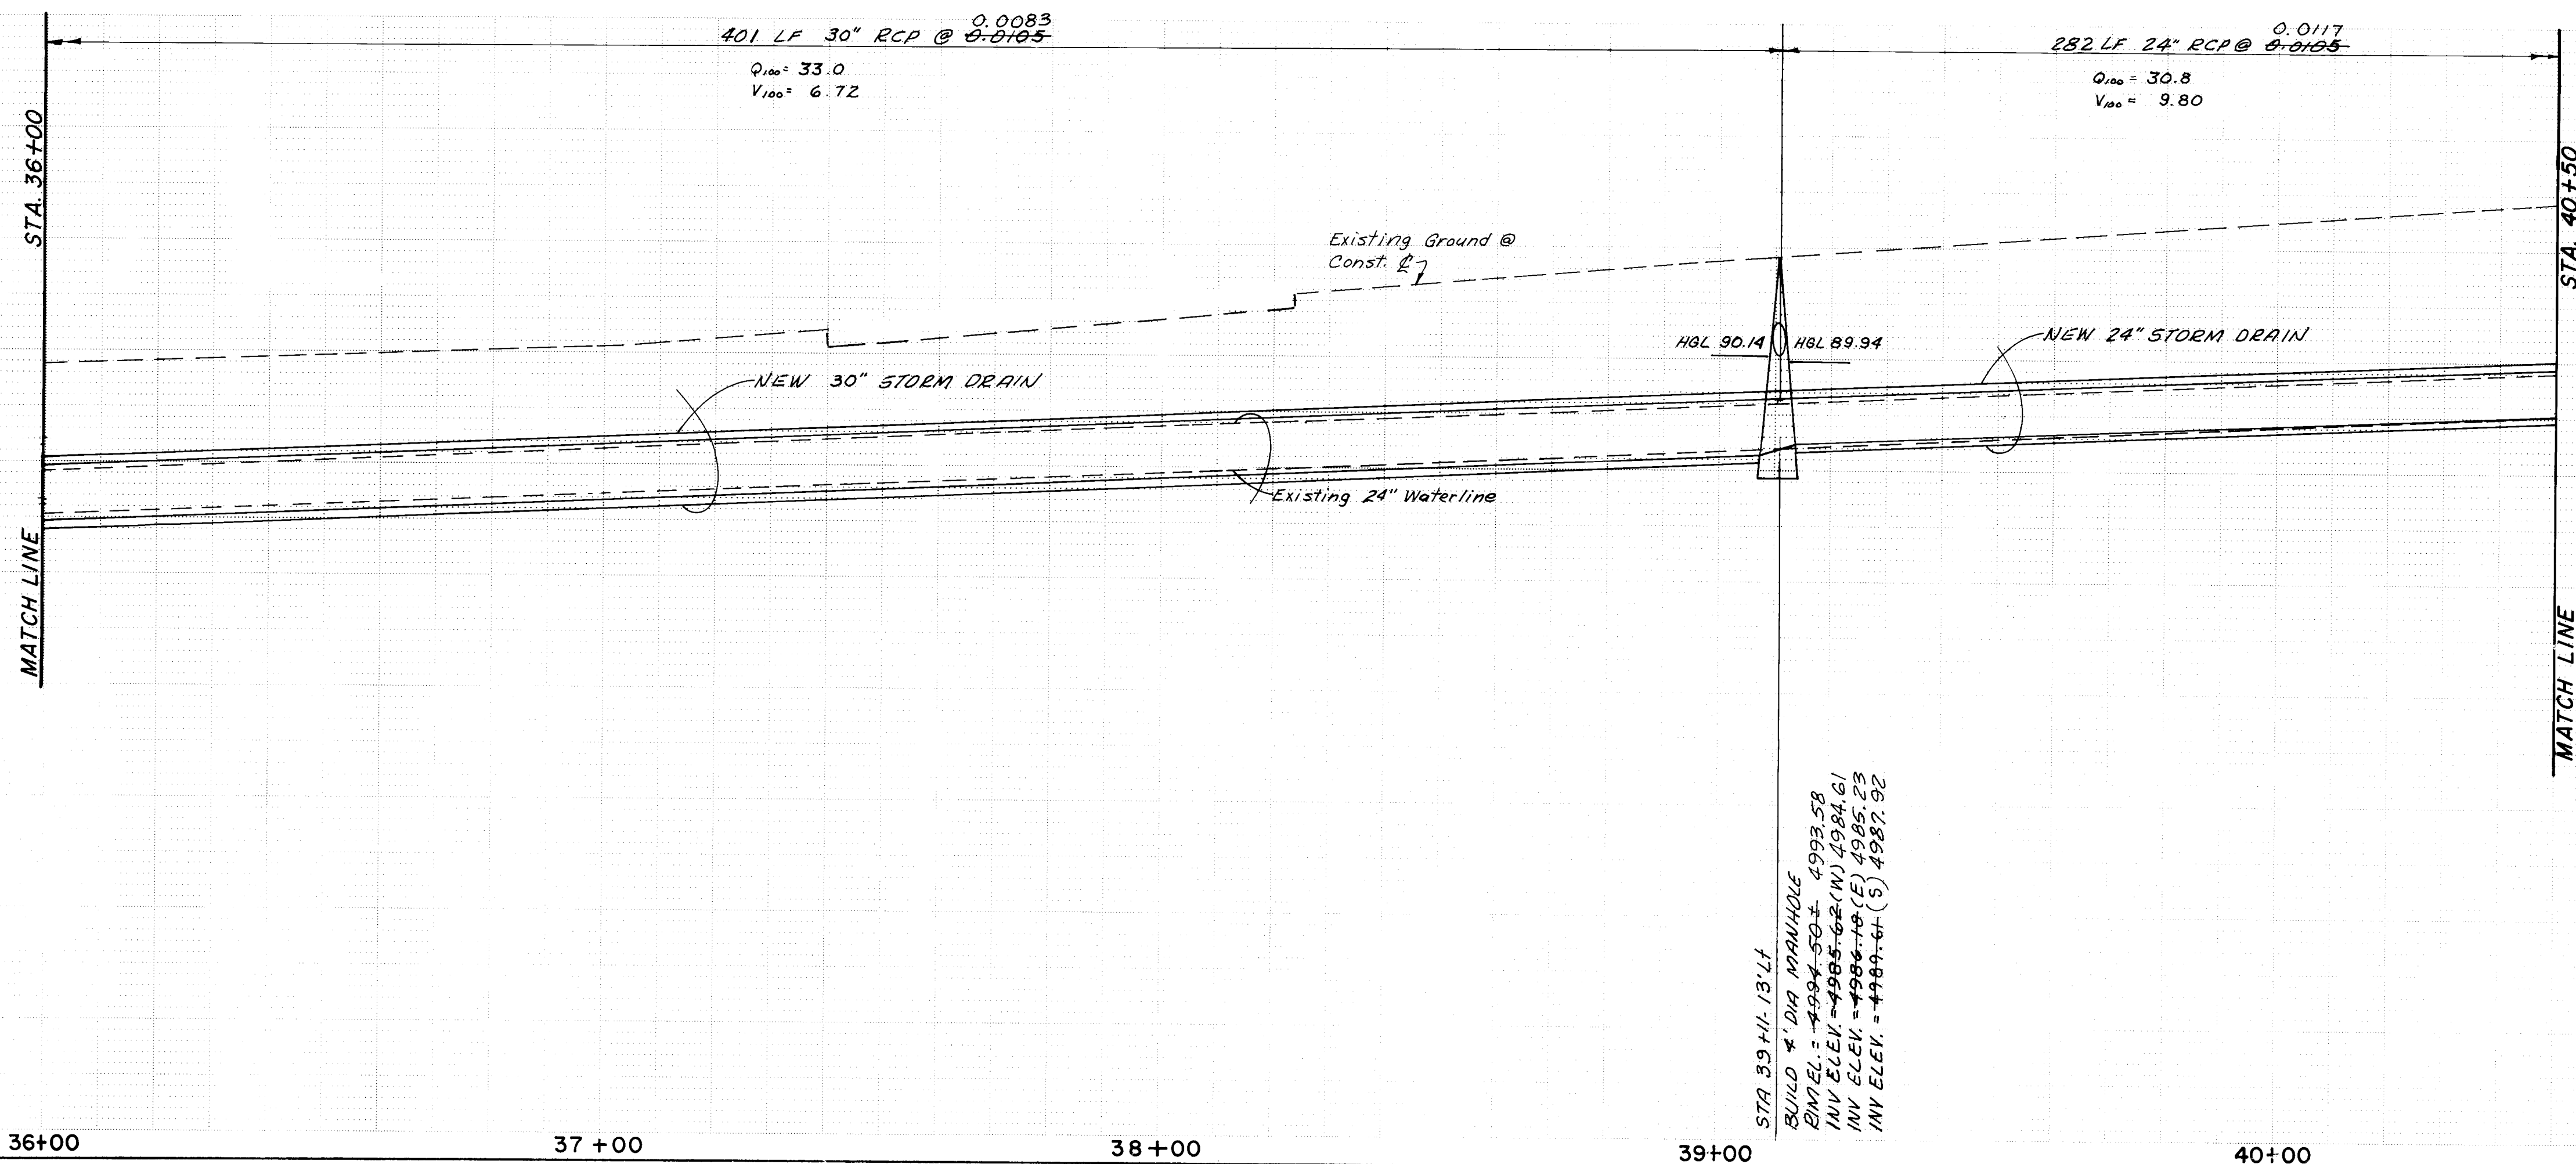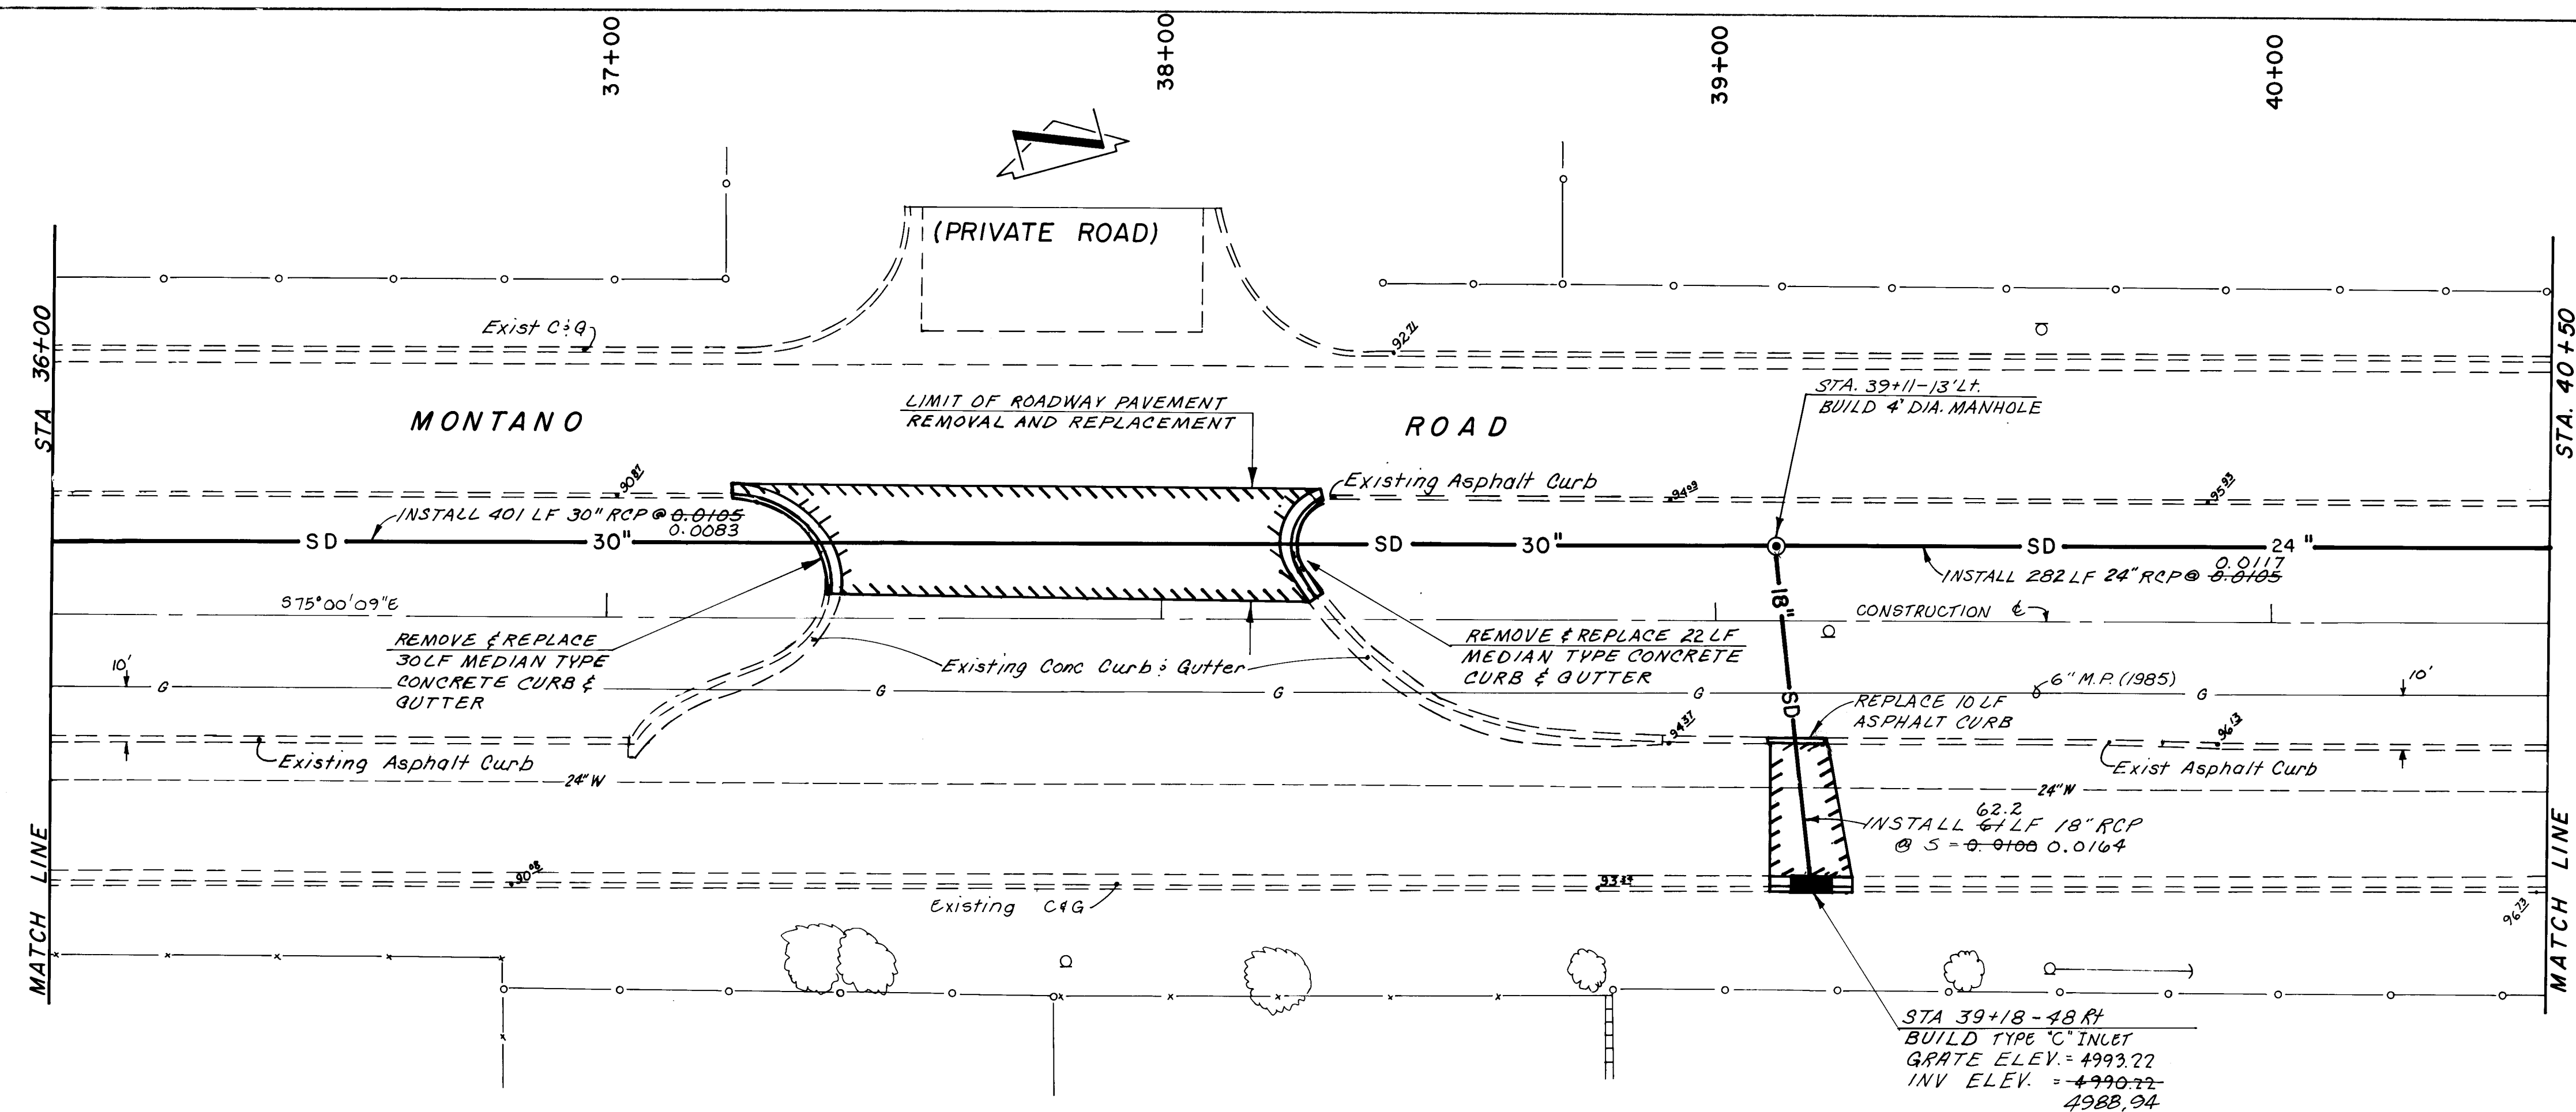


NOTE:
ALL SPOT ELEVATIONS
SHOWN ARE EXISTING
TOP OF CURB UNLESS
OTHERWISE NOTED

ENGINEER'S SEAL		SURVEY INFORMATION		BENCH MARKS		AS BUILT INFORMATION	
		NO.	BY	DATE	ACS 2 - FISA - ACS BRASS TABLET ON CONCRETE POST SOUTHWEST CORNER MONTANO & EDITH ELEV. 4984.24	CONTRACTOR	DATE
		REVISIONS		NO.	DATE	INSPECTOR	DATE
DESIGNED BY S.A.V.		DATE 11/85		RECORDED BY		DATE 11/85	
DRAWN BY C.L.W.		DATE 11/85		CHECKED BY		DATE 11/85	

26 24611288

SCALES
HORIZONTAL 1" = 20'
VERTICAL 1" = 5'


CITY OF ALBUQUERQUE MUNICIPAL DEVELOPMENT DEPARTMENT ENGINEERING DIVISION					
TITLE: NORTH VALLEY DRAINAGE SYSTEM IMPROVEMENTS MONTANO ROAD SYSTEM(A) STORM DRAIN- STA. 36+00 TO STA. 40+50					
APPROVALS	ENGINEER	DATE	APPROVALS	ENGINEER	DATE
City Engineer	<i>[Signature]</i>	12/3/86	Liquid Waste	W/W	12-1-86
ACE - Design	<i>[Signature]</i>	12/9/86	Traffic	N/A	12/8/86
ACE - Hydrology	<i>[Signature]</i>	12/8/86	Water	W/W	12-1-86
DRAWING NO.	2461		MAP NO.	F - 15	
SHEET	12		OF	19	

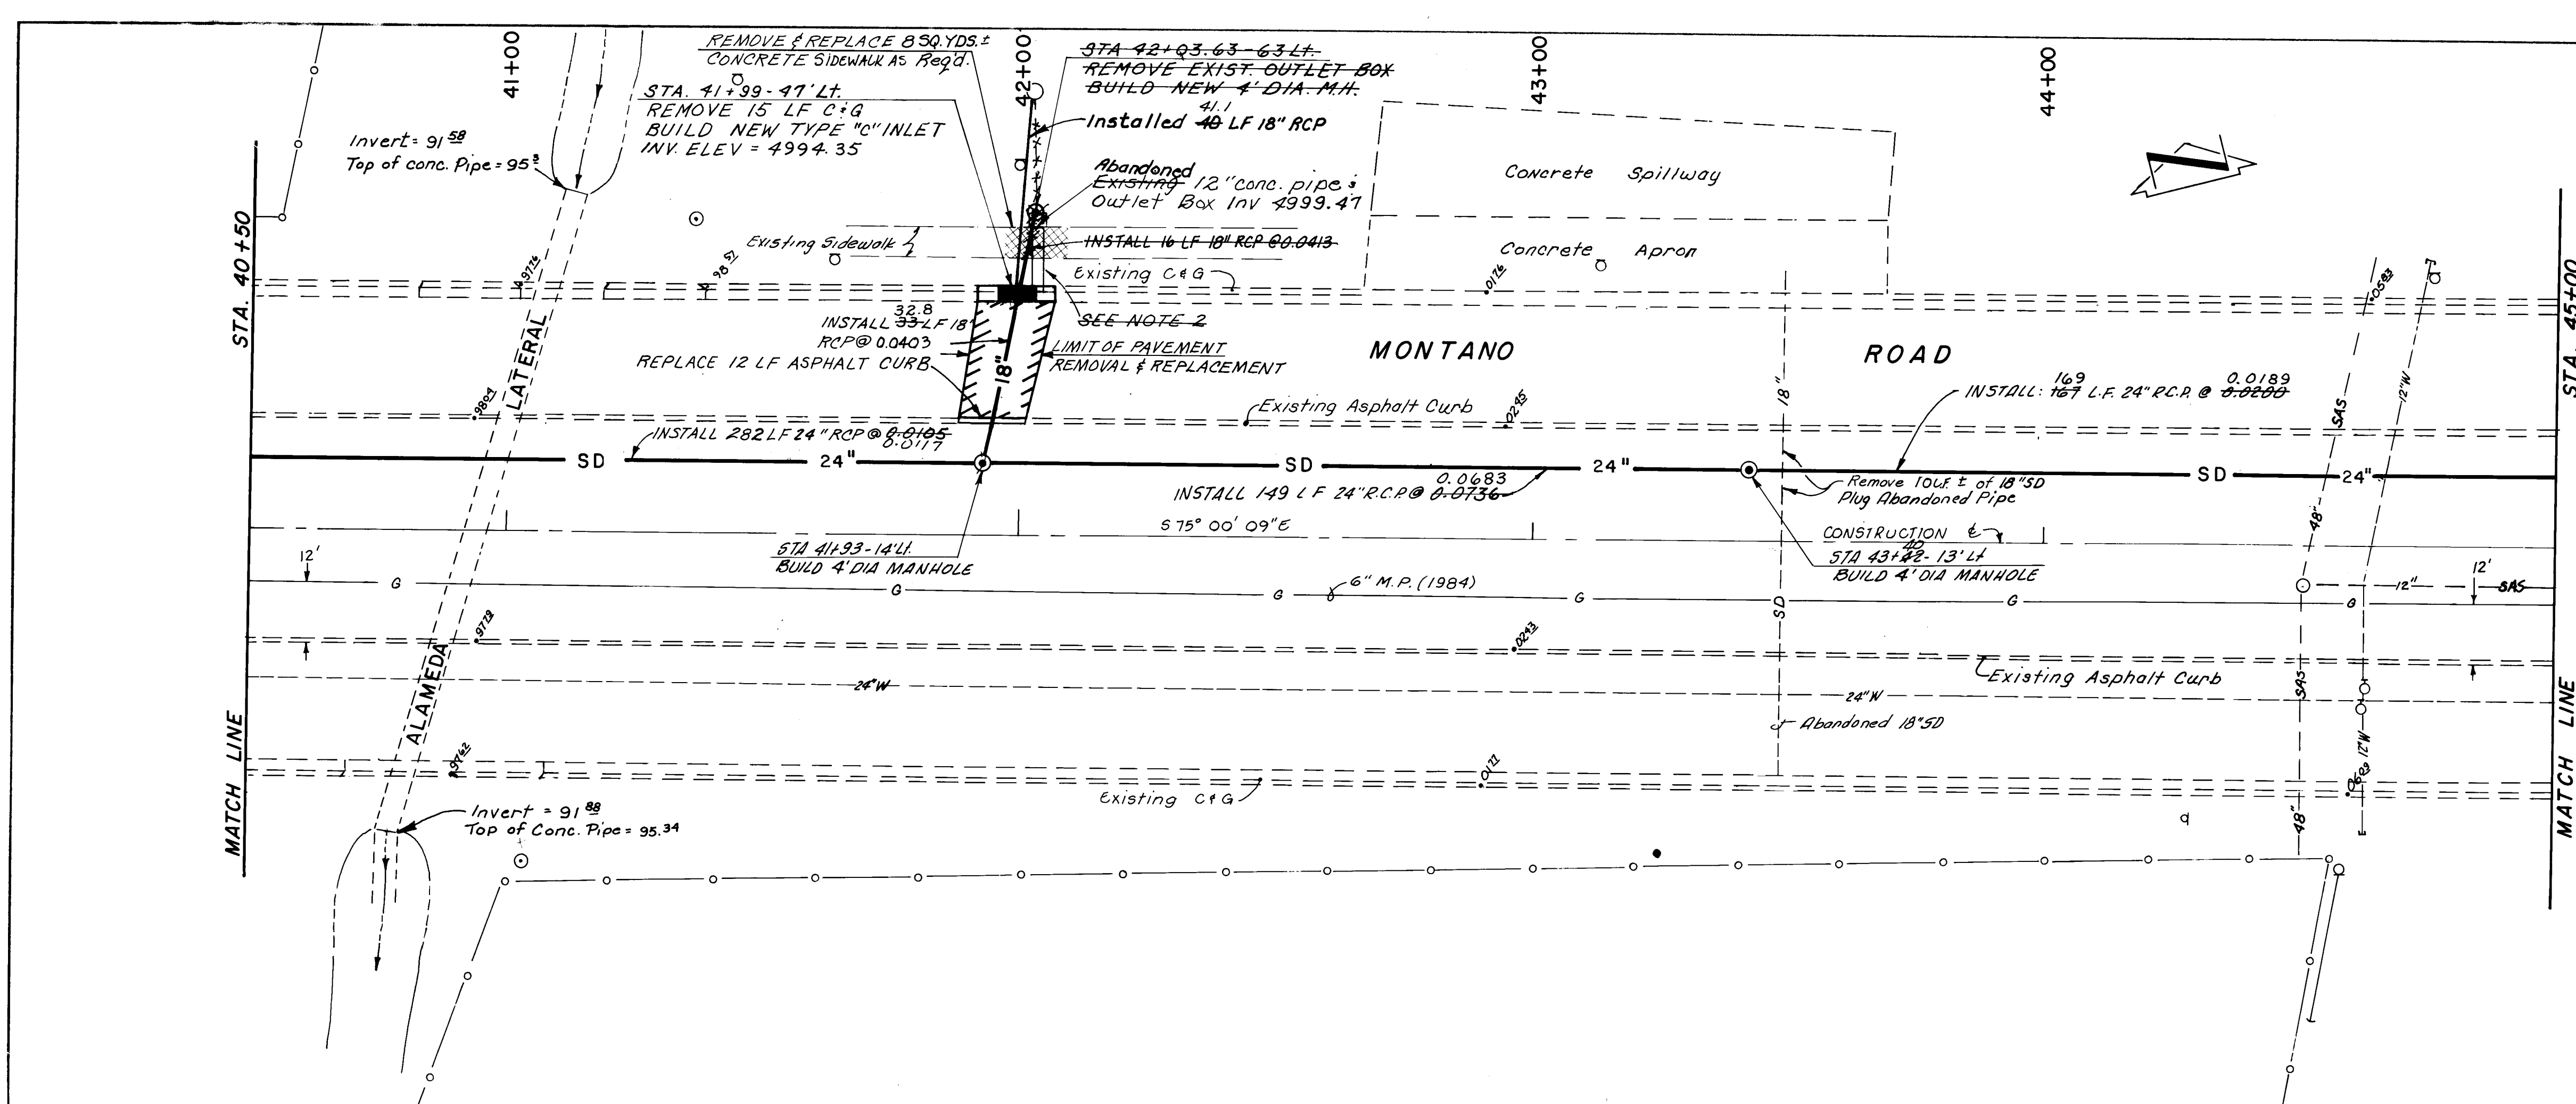

SCALES

HORIZONTAL	1" = 20'
VERTICAL	1" = 5'

CITY OF ALBUQUERQUE MUNICIPAL DEVELOPMENT DEPARTMENT ENGINEERING DIVISION					
TITLE: NORTH VALLEY DRAINAGE SYSTEM IMPROVEMENTS MONTANO ROAD SYSTEM (A) STORM DRAIN-STA. 40+50 TO STA. 45+00					
APPROVALS	ENGINEER	DATE	APPROVALS	ENGINEER	DATE
City Engineer	<i>[Signature]</i>	<i>12/3/86</i>	Liquid Waste	<i>W/W</i>	<i>12-1-86</i>
<i>ACE</i> - Design	<i>[Signature]</i>	<i>12/9/86</i>	Traffic	<i>N/A D W H</i>	<i>12/8/86</i>
<i>ACE</i> - Hydrology	<i>[Signature]</i>	<i>12/8/86</i>	Water	<i>W/W</i>	<i>12-1-86</i>
DRAWING NO.	2461		MAP NO.	SHEET OF	
		F - 15		13	19

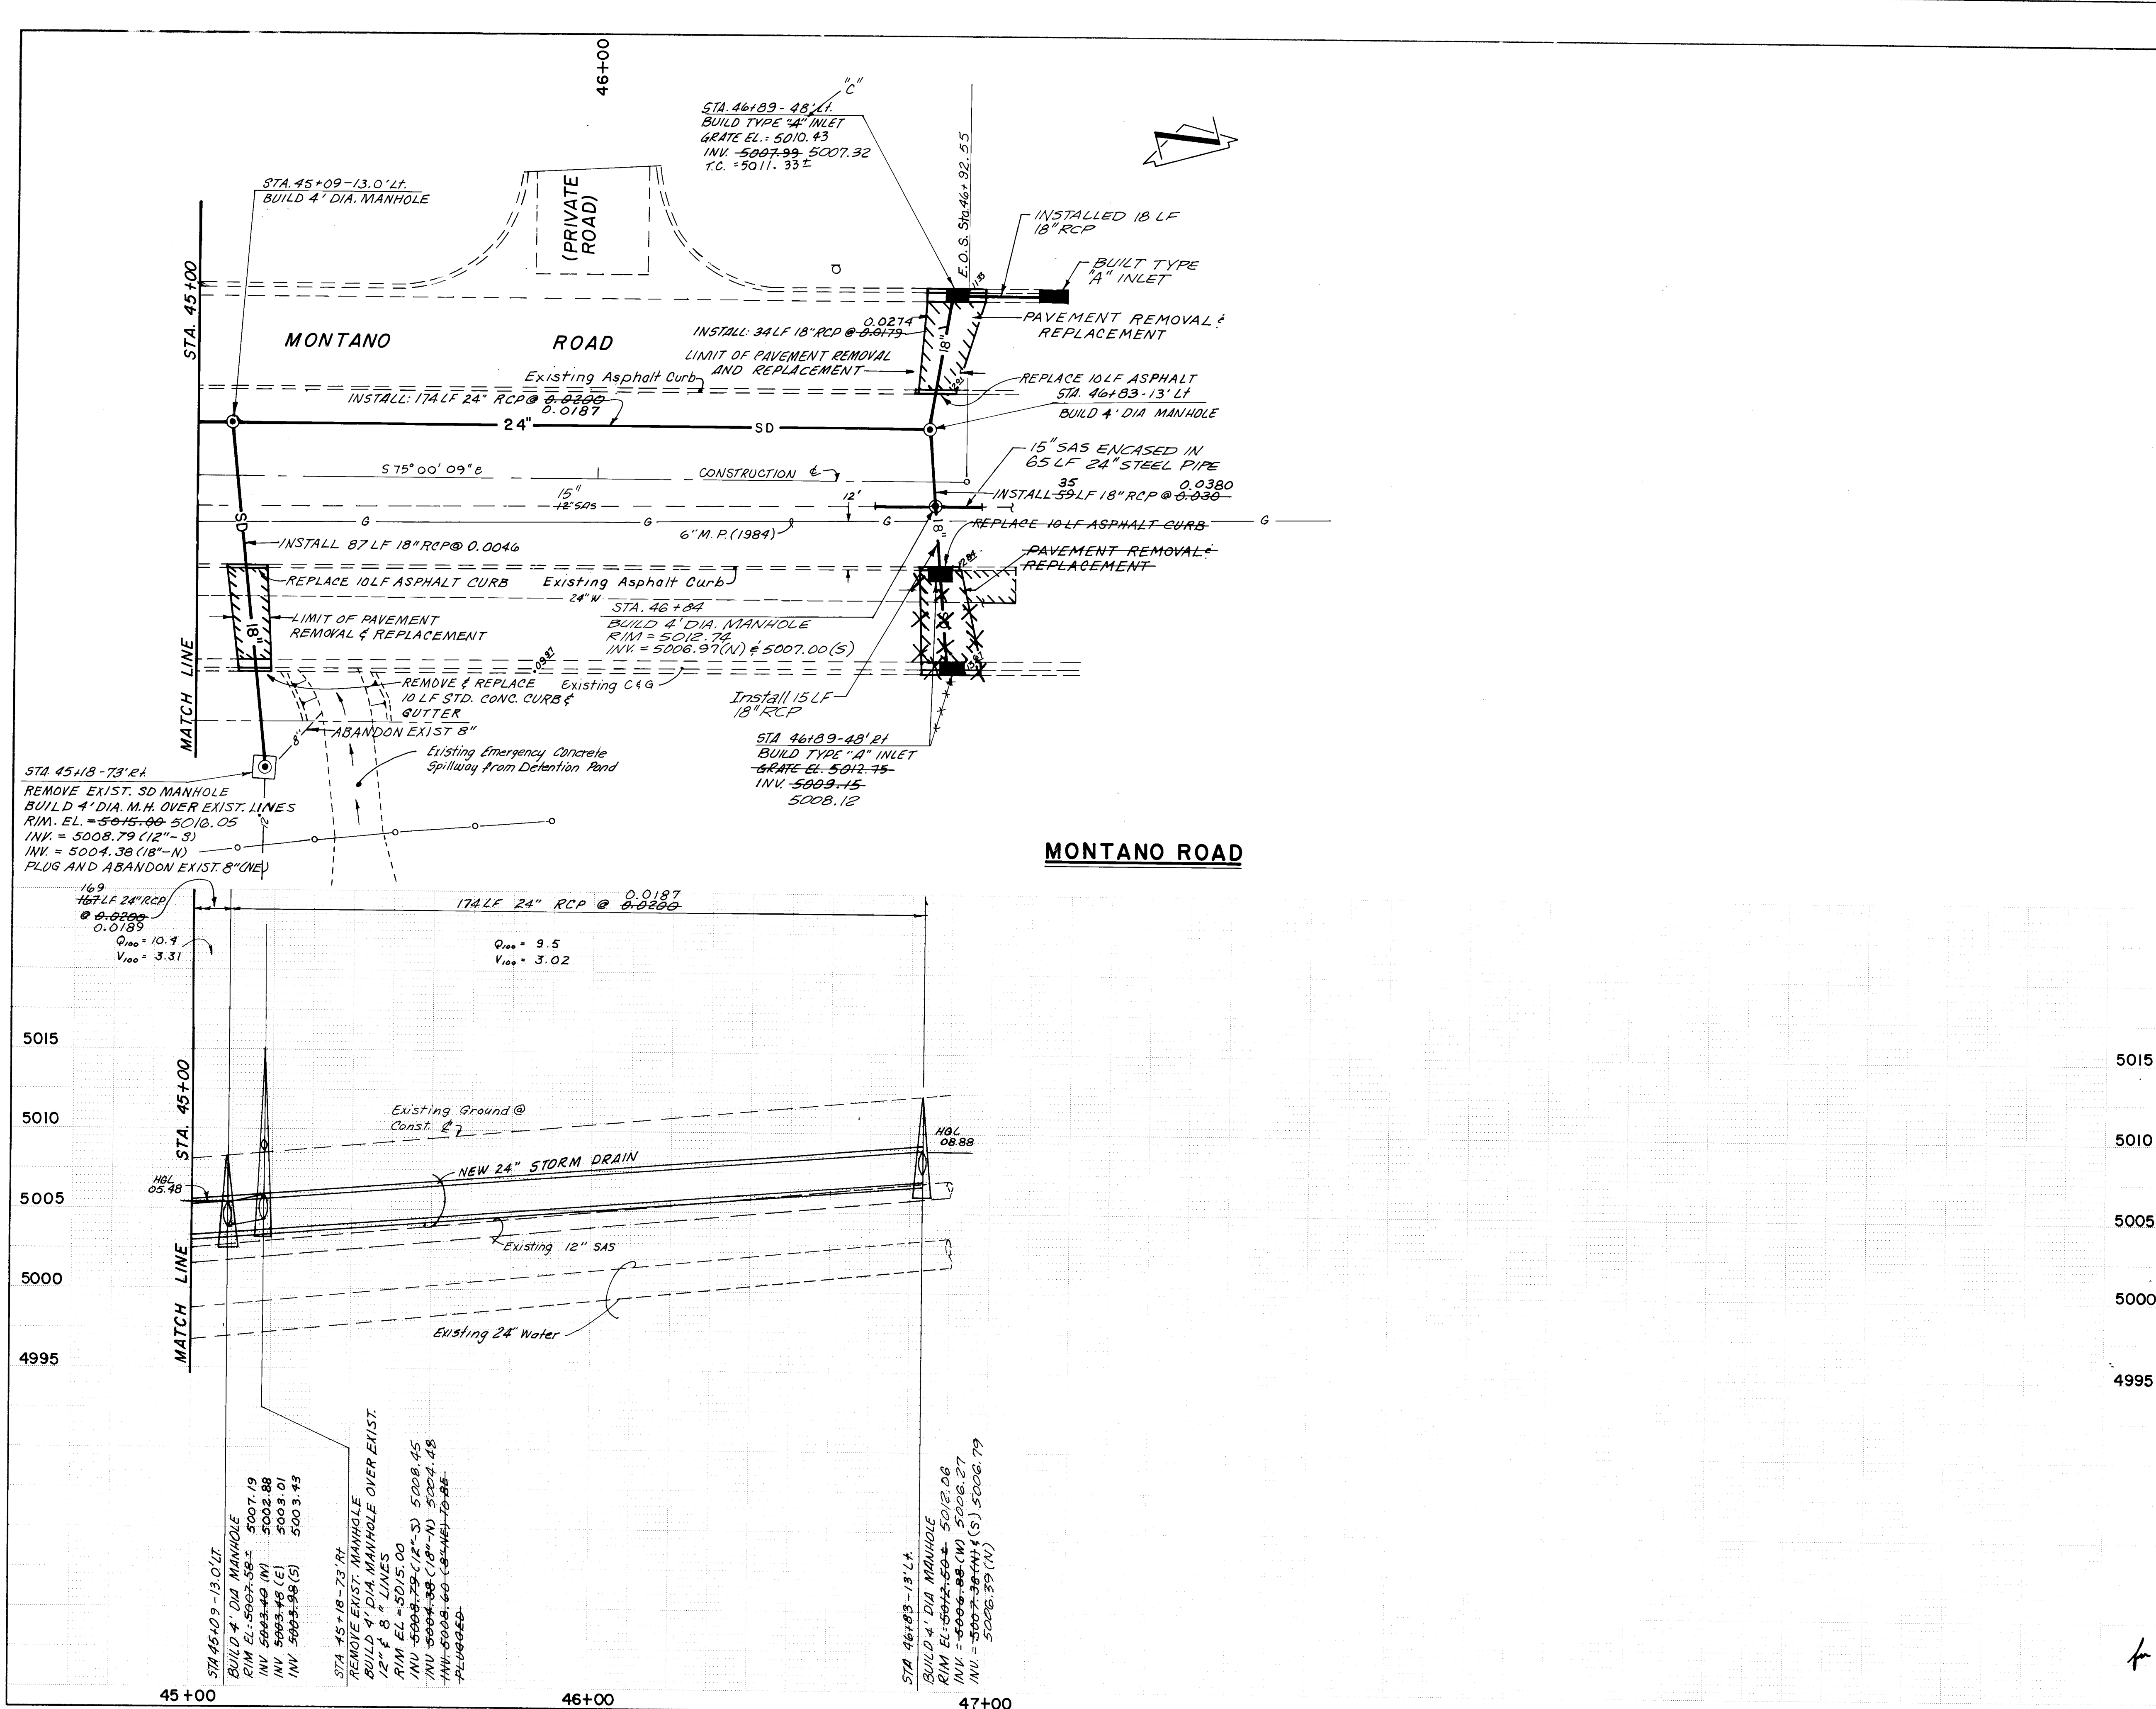


NOTE:
ALL SPOT ELEVATIONS
SHOWN ARE EXISTING
TOP OF CURB UNLESS
OTHERWISE NOTED

26 24611488

SCALES:
HORIZONTAL 1" = 20'
VERTICAL 1" = 5'

CITY OF ALBUQUERQUE MUNICIPAL DEVELOPMENT DEPARTMENT ENGINEERING DIVISION					
TITLE: NORTH VALLEY DRAINAGE SYSTEM IMPROVEMENTS MONTANO ROAD SYSTEM (A) STORM DRAIN-STA. 45+00 TO STA. 46+92.55					
APPROVALS	ENGINEER	DATE	APPROVALS	ENGINEER	DATE
City Engineer	<i>[Signature]</i>	12/1/86	Liquid Waste	<i>[Signature]</i>	12-1-86
ACE - Design	<i>[Signature]</i>	12/1/86	Traffic	<i>[Signature]</i>	12/8/86
ACE - Hydrology	<i>[Signature]</i>	12/4/86	Water	<i>[Signature]</i>	12-1-86
DRAWING NO.	2461		MAP NO.	F - 15	
SHEET 14			OF 19		

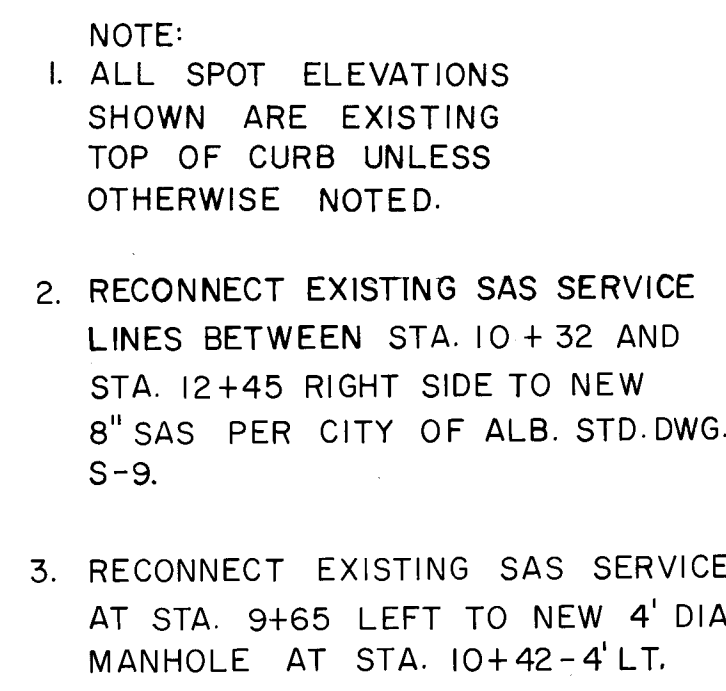


26 24611588

CITY OF ALBUQUERQUE MUNICIPAL DEVELOPMENT DEPARTMENT ENGINEERING DIVISION					
TITLE NORTH VALLEY DRAINAGE SYSTEM IMPROVEMENTS MONTANO ROAD SYSTEM (A) SANITARY SEWER STA. 7+00 TO STA. 12+00					
APPROVALS	ENGINEER	DATE	APPROVALS	ENGINEER	DATE
for City Engineer	<i>[Signature]</i>	12/3/86	Liquid Waste	<i>[Signature]</i>	12-1-86
ACE Design	<i>[Signature]</i>	12/9/86	Traffic	NAD and H	12/2/86
ACE Hydrology	<i>[Signature]</i>	12/4/86	Water	<i>[Signature]</i>	12-1-86

DRAWING NO.	2461	MAP NO. F - 15	SHEET 15	OF 19
----------------	------	-------------------	-------------	----------

Scanlon Job No. 85/13.1

RECORD DRAWING

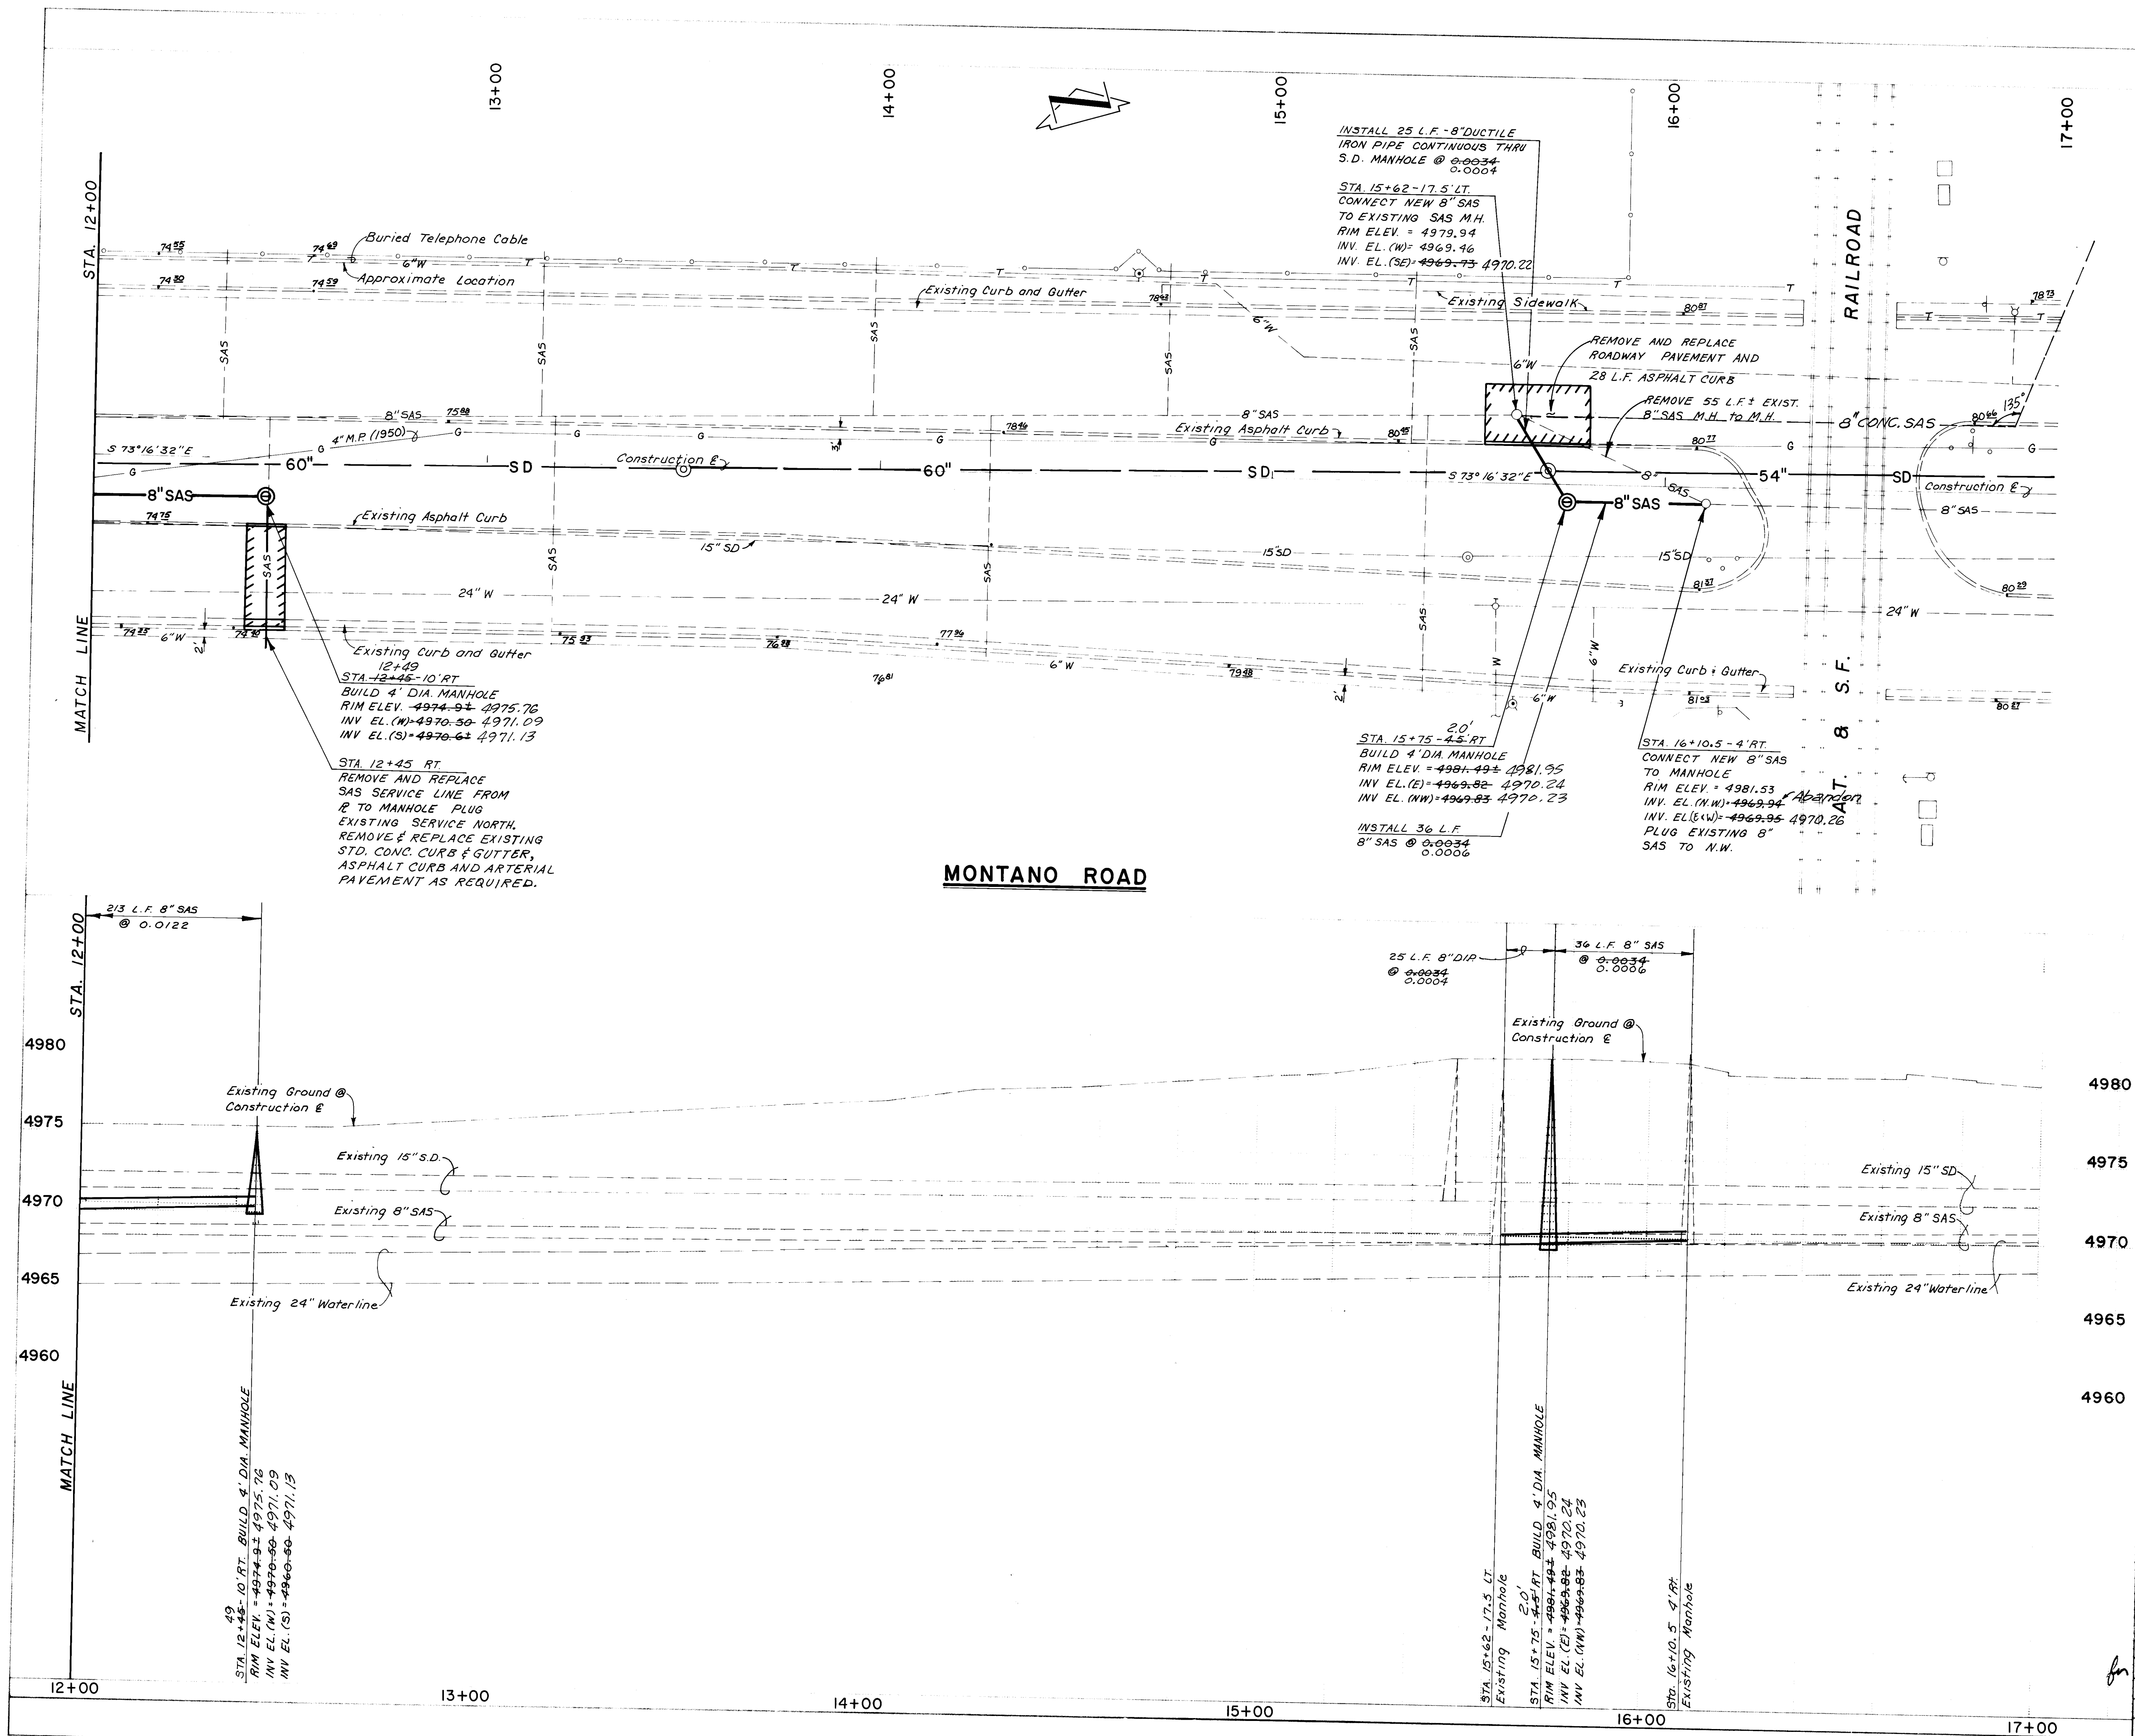


NOTE:
1. ALL SPOT ELEVATIONS
SHOWN ARE EXISTING
TOP OF CURB UNLESS
OTHERWISE NOTED.

SCALES
HORIZONTAL 1" = 20'
VERTICAL 1" = 5'

26 24611688

CITY OF ALBUQUERQUE MUNICIPAL DEVELOPMENT DEPARTMENT ENGINEERING DIVISION					
TITLE NORTH VALLEY DRAINAGE SYSTEM IMPROVEMENTS MONTANO ROAD SYSTEM (A) SANITARY SEWER STA. 12+00 TO STA. 17+00					
APPROVALS	ENGINEER	DATE	APPROVALS	ENGINEER	DATE
City Engineer	<i>[Signature]</i>	12/3/86	City Engineer	<i>[Signature]</i>	12-1-86
ACE Design	<i>[Signature]</i>	12/9/86	ACE Design	<i>[Signature]</i>	12/9/86
ACE Hydrology	<i>[Signature]</i>	12/4/86	ACE Hydrology	<i>[Signature]</i>	12-1-86
DRAWING NO. 2461		MAP NO. F-15		SHEET 16 OF 19	

AS BUILT INFORMATION		BENCH MARKS		SURVEY INFORMATION		ENGINEER'S SEAL	
N. VALLEY DRAINAGE SYSTEM, Inc.		ACS 2-F15A - ACS BRASS TABLET ON CONCRETE POST SOUTHWEST CORNER MONTANO & EDITH ELEV. 4984.24		FIELD NOTES		[Signature]	
Scanlon & Associates		NMSHC/ACS NM 47-8 BRASS TABLET IN ISLAND ON SECOND STREET NORTH OF MONTANO ELEV. 4974.569		NO. BY DATE		REVISIONS	
Scanlon & Associates		NMSHC/ACS NM 47-8 BRASS TABLET IN ISLAND ON SECOND STREET NORTH OF MONTANO ELEV. 4974.569		NO. BY DATE		DESIGN	
Scanlon & Associates		NMSHC/ACS NM 47-8 BRASS TABLET IN ISLAND ON SECOND STREET NORTH OF MONTANO ELEV. 4974.569		NO. BY DATE		CHECKED BY	
Scanlon & Associates		NMSHC/ACS NM 47-8 BRASS TABLET IN ISLAND ON SECOND STREET NORTH OF MONTANO ELEV. 4974.569		NO. BY DATE		DATE	

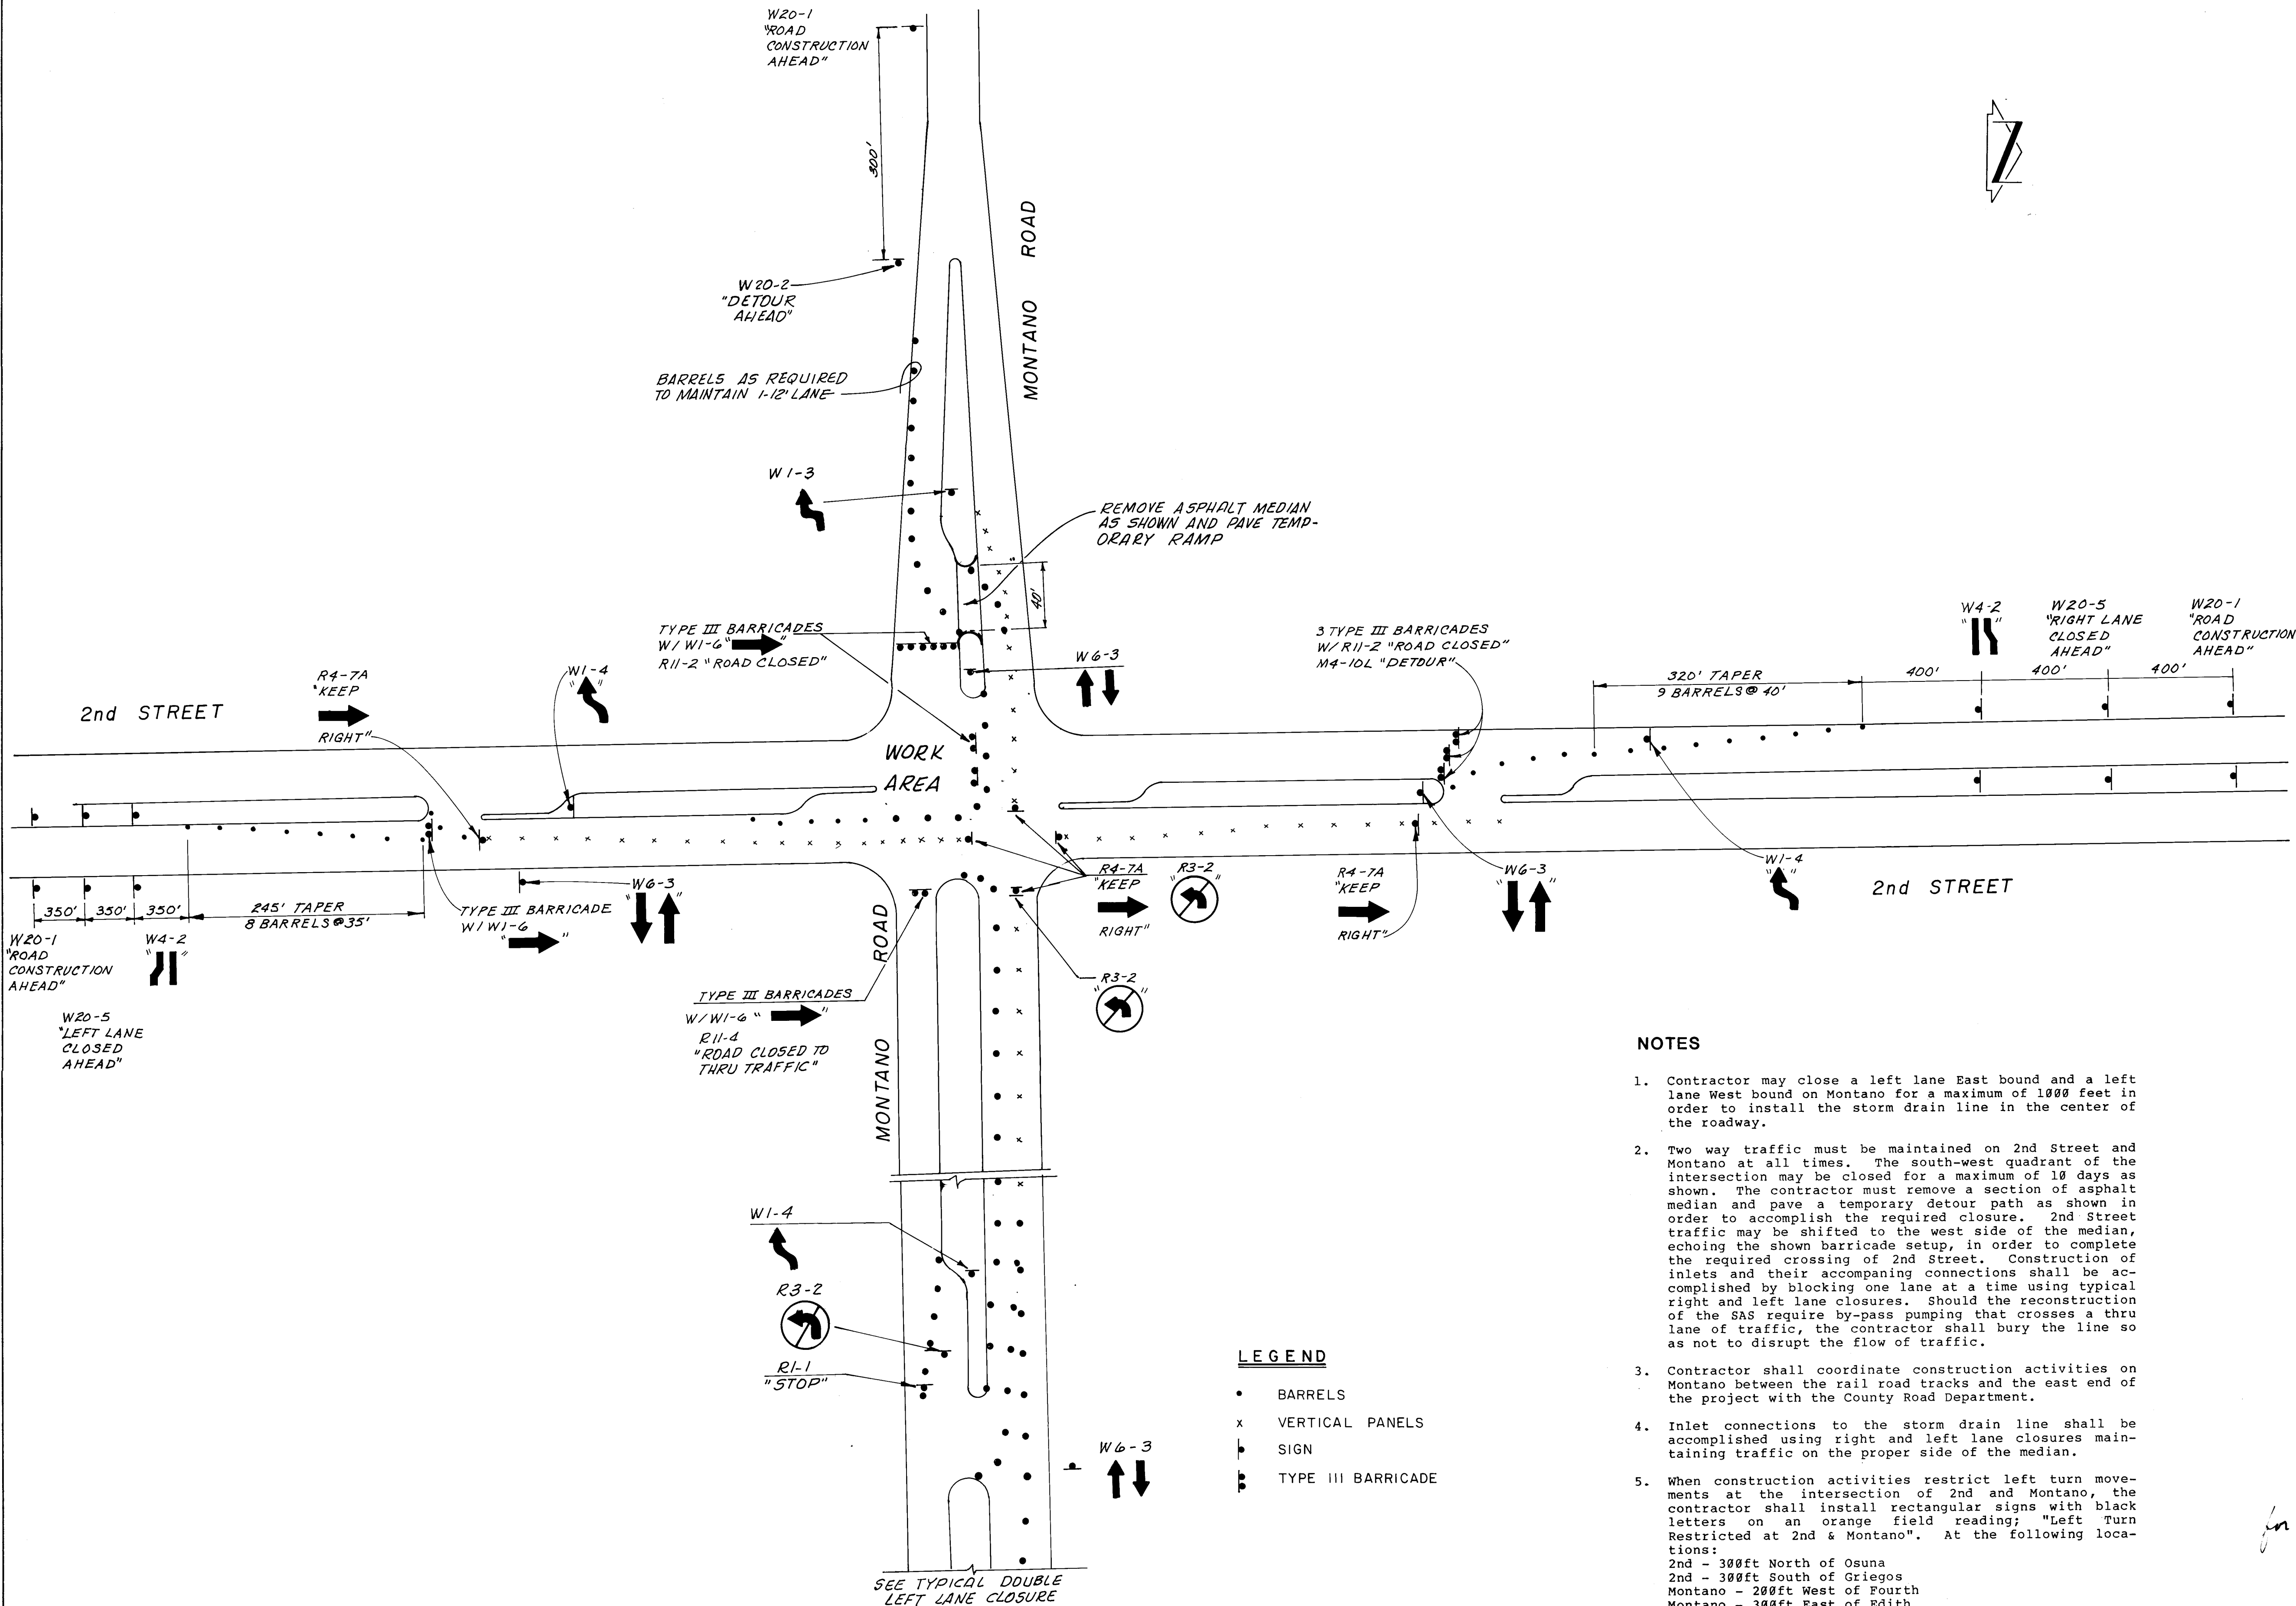

NOTES:
1. See Traffic Control Notes Sheet 3 of 19.

AS BUILT INFORMATION				BENCH MARKS				SURVEY INFORMATION				ENGINEER'S SEAL			
CONTRACTOR	NEW CONCEPTS, INC.	DATE	DATE	CONTRACTOR	DATE	DATE	DATE	NO.	BY	DATE	NO.	BY	DATE		
CONTRACTOR'S REPRESENTATIVE	DATE	DATE	DATE	CONTRACTOR'S REPRESENTATIVE	DATE	DATE	DATE								
INSPECTOR'S REPRESENTATIVE	DATE	DATE	DATE	INSPECTOR'S REPRESENTATIVE	DATE	DATE	DATE								
FIELD ENGINEER	DATE	DATE	DATE	FIELD ENGINEER	DATE	DATE	DATE								
VERIFICATION BY	DATE	DATE	DATE	VERIFICATION BY	DATE	DATE	DATE								
CORRECTED BY	DATE	DATE	DATE	CORRECTED BY	DATE	DATE	DATE								
MICRO-FILM INFORMATION				MICRO-FILM INFORMATION				MICRO-FILM INFORMATION				MICRO-FILM INFORMATION			
CONTRACTOR	DATE	DATE	DATE	CONTRACTOR	DATE	DATE	DATE								
INSPECTOR	DATE	DATE	DATE	INSPECTOR	DATE	DATE	DATE								
FIELD ENGINEER	DATE	DATE	DATE	FIELD ENGINEER	DATE	DATE	DATE								
VERIFICATION BY	DATE	DATE	DATE	VERIFICATION BY	DATE	DATE	DATE								
CORRECTED BY	DATE	DATE <td DATE	CORRECTED BY	DATE	DATE	DATE									
RECORDING INFORMATION				RECORDING INFORMATION				RECORDING INFORMATION				RECORDING INFORMATION			
CONTRACTOR	DATE	DATE	DATE	CONTRACTOR	DATE	DATE	DATE								
INSPECTOR	DATE	DATE	DATE	INSPECTOR	DATE	DATE	DATE								
FIELD ENGINEER	DATE	DATE	DATE	FIELD ENGINEER	DATE	DATE	DATE								
VERIFICATION BY	DATE	DATE	DATE	VERIFICATION BY	DATE	DATE	DATE								
CORRECTED BY	DATE	DATE	DATE	CORRECTED BY	DATE	DATE	DATE								

26 24611888

CITY OF ALBUQUERQUE
MUNICIPAL DEVELOPMENT DEPARTMENT
ENGINEERING DIVISION

TITLE: NORTH VALLEY DRAINAGE SYSTEM IMPROVEMENTS
MONTANO ROAD SYSTEM (A)
TRAFFIC CONTROL PLAN

APPROVALS	ENGINEER	DATE	APPROVALS	ENGINEER	DATE
City Engineer	<i>[Signature]</i>	12/1/86	Liquid Waste	<i>[Signature]</i>	12/1/86
A-E-E-Design	<i>[Signature]</i>	12/1/86	Traffic	<i>[Signature]</i>	12/1/86
A-E-E-Hydrology	<i>[Signature]</i>	12/1/86	Water	<i>[Signature]</i>	12-1-86
			Traffic Operations	<i>[Signature]</i>	12-9-86

DRAWING NO. 2461 MAP NO. F-15 SHEET 18 OF 19

