


PLAN	SURVEYED	BY	DATE
	DESIGNED		
	NOTED		
	NO.		

PROFILE	SURVEYED	BY	DATE
	DESIGNED		
	NOTED		
	NO.		

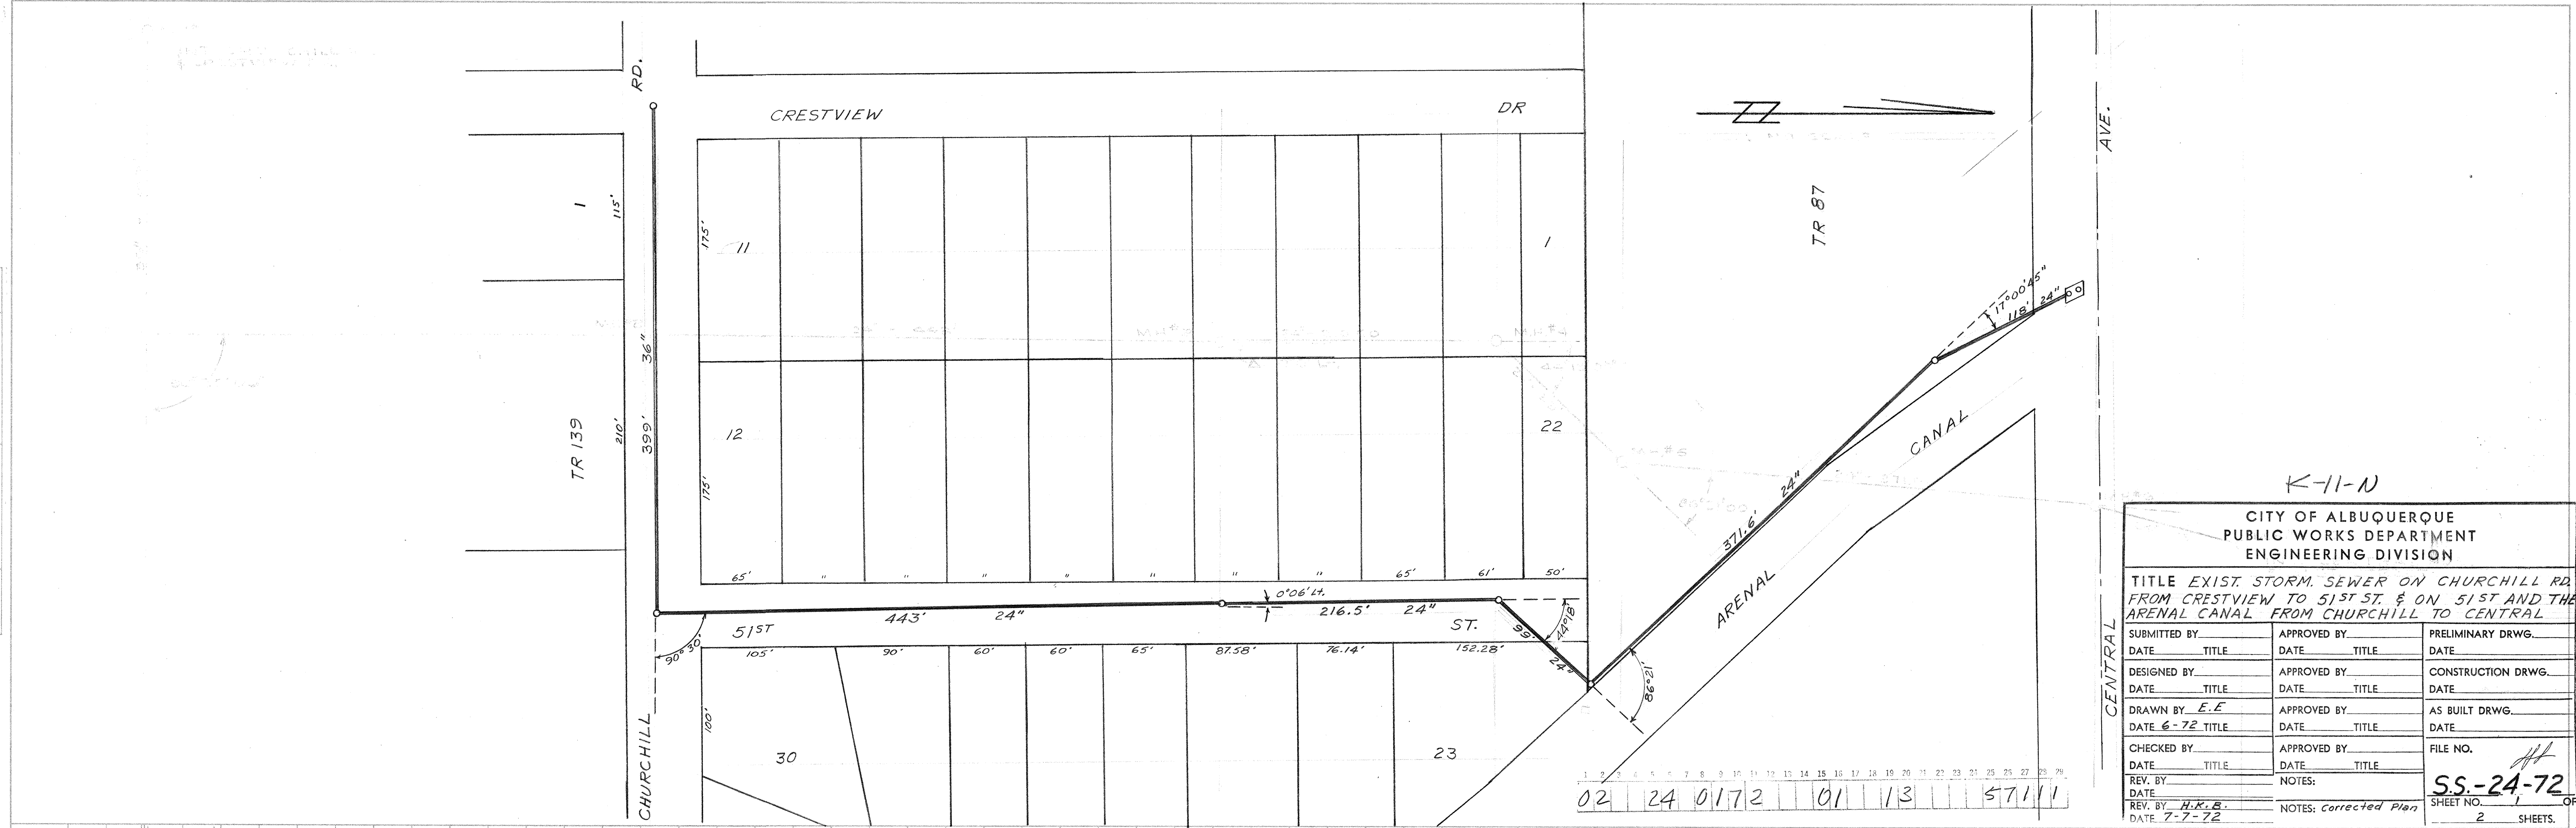

CITY OF ALBUQUERQUE PUBLIC WORKS DEPARTMENT ENGINEERING DIVISION		
TITLE EXIST STORM SEWER ON CHURCHILL RD FROM CRESTVIEW TO 51ST ST. & ON 51ST AND THE ARENAL CANAL FROM CHURCHILL TO CENTRAL		
SUBMITTED BY	APPROVED BY	PRELIMINARY DRWG.
DATE	DATE	DATE
DESIGNED BY	APPROVED BY	CONSTRUCTION DRWG.
DATE	DATE	DATE
DRAWN BY E.E.	APPROVED BY	AS BUILT DRWG.
DATE 6-72	DATE	DATE
CHECKED BY	APPROVED BY	FILE NO.
DATE	DATE	
REV. BY	NOTES	SS-24-72
DATE		
REV. BY H.K.B.	NOTES: Corrected Plan	SHEET NO. 1 OF 2
DATE 7-7-72		



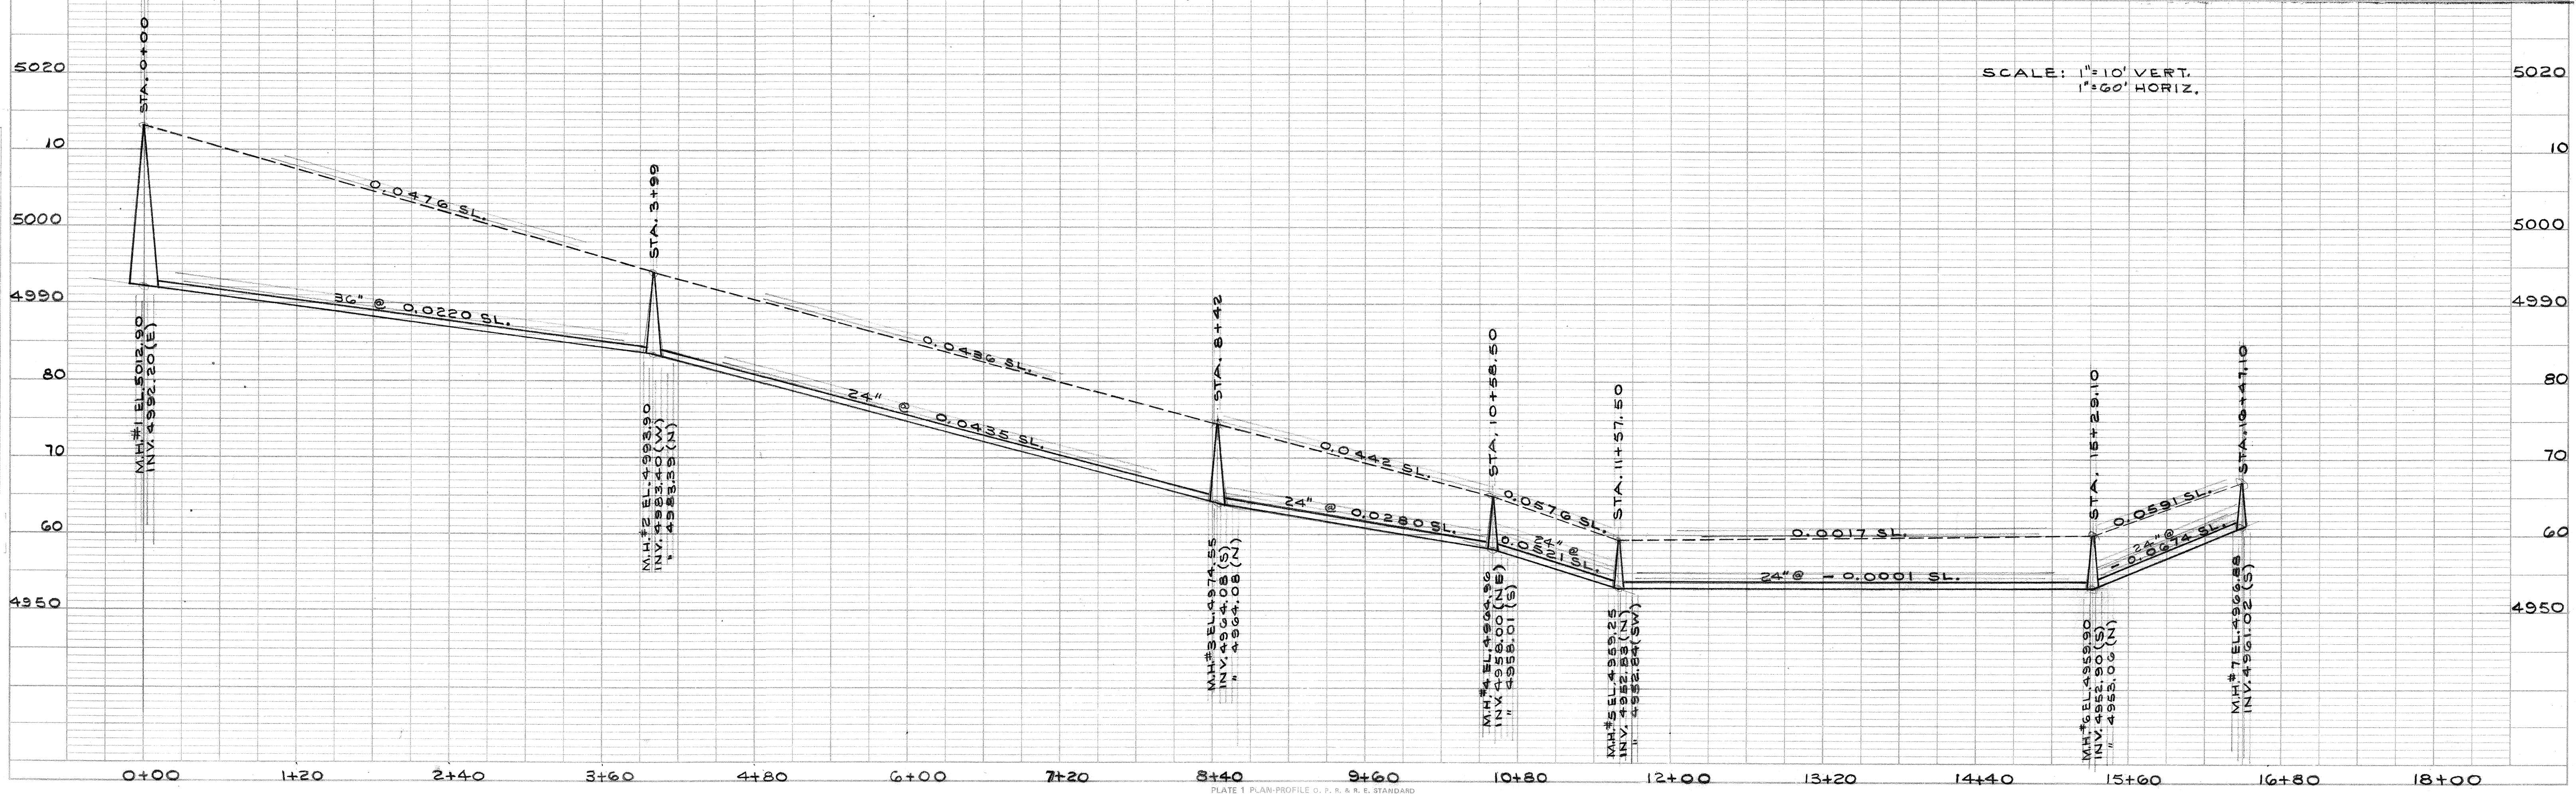



PLATE 1 PLAN-PROFILE D. P. R. & R. E. STANDARD
100% RAC AEROPROOF VELLUM—MADE AND PRINTED IN U. S. A.
EUGENE DIETZEN CO.

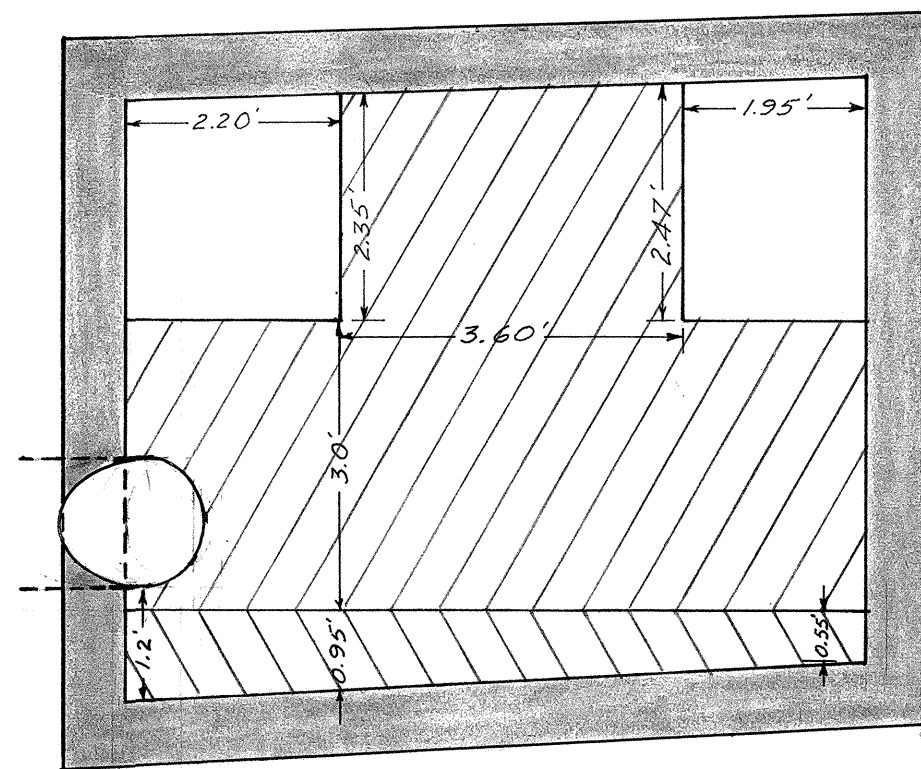


SECTION A-A

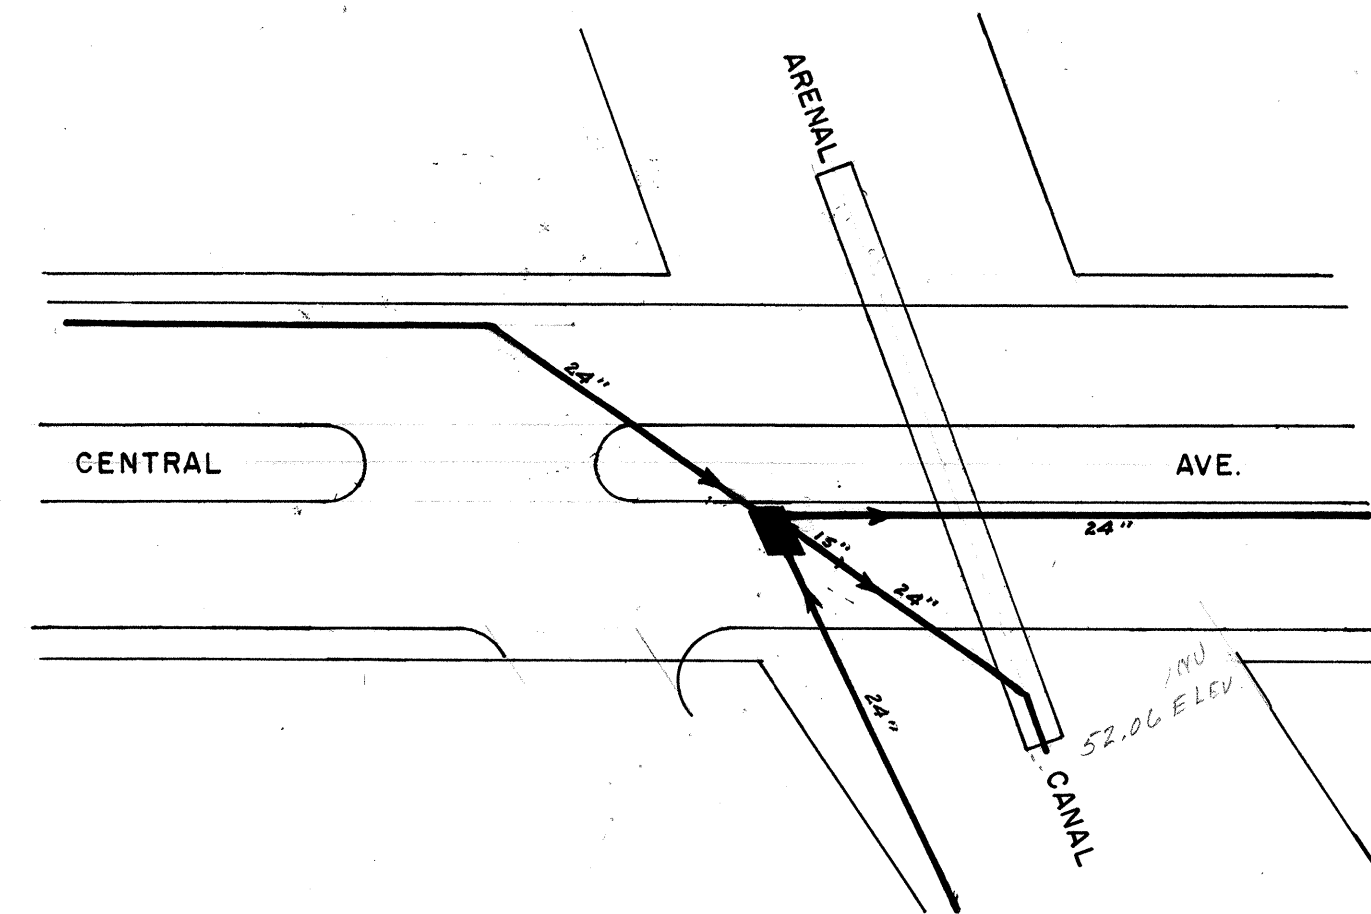

LOCATION MAP
SCALE 1"=50'

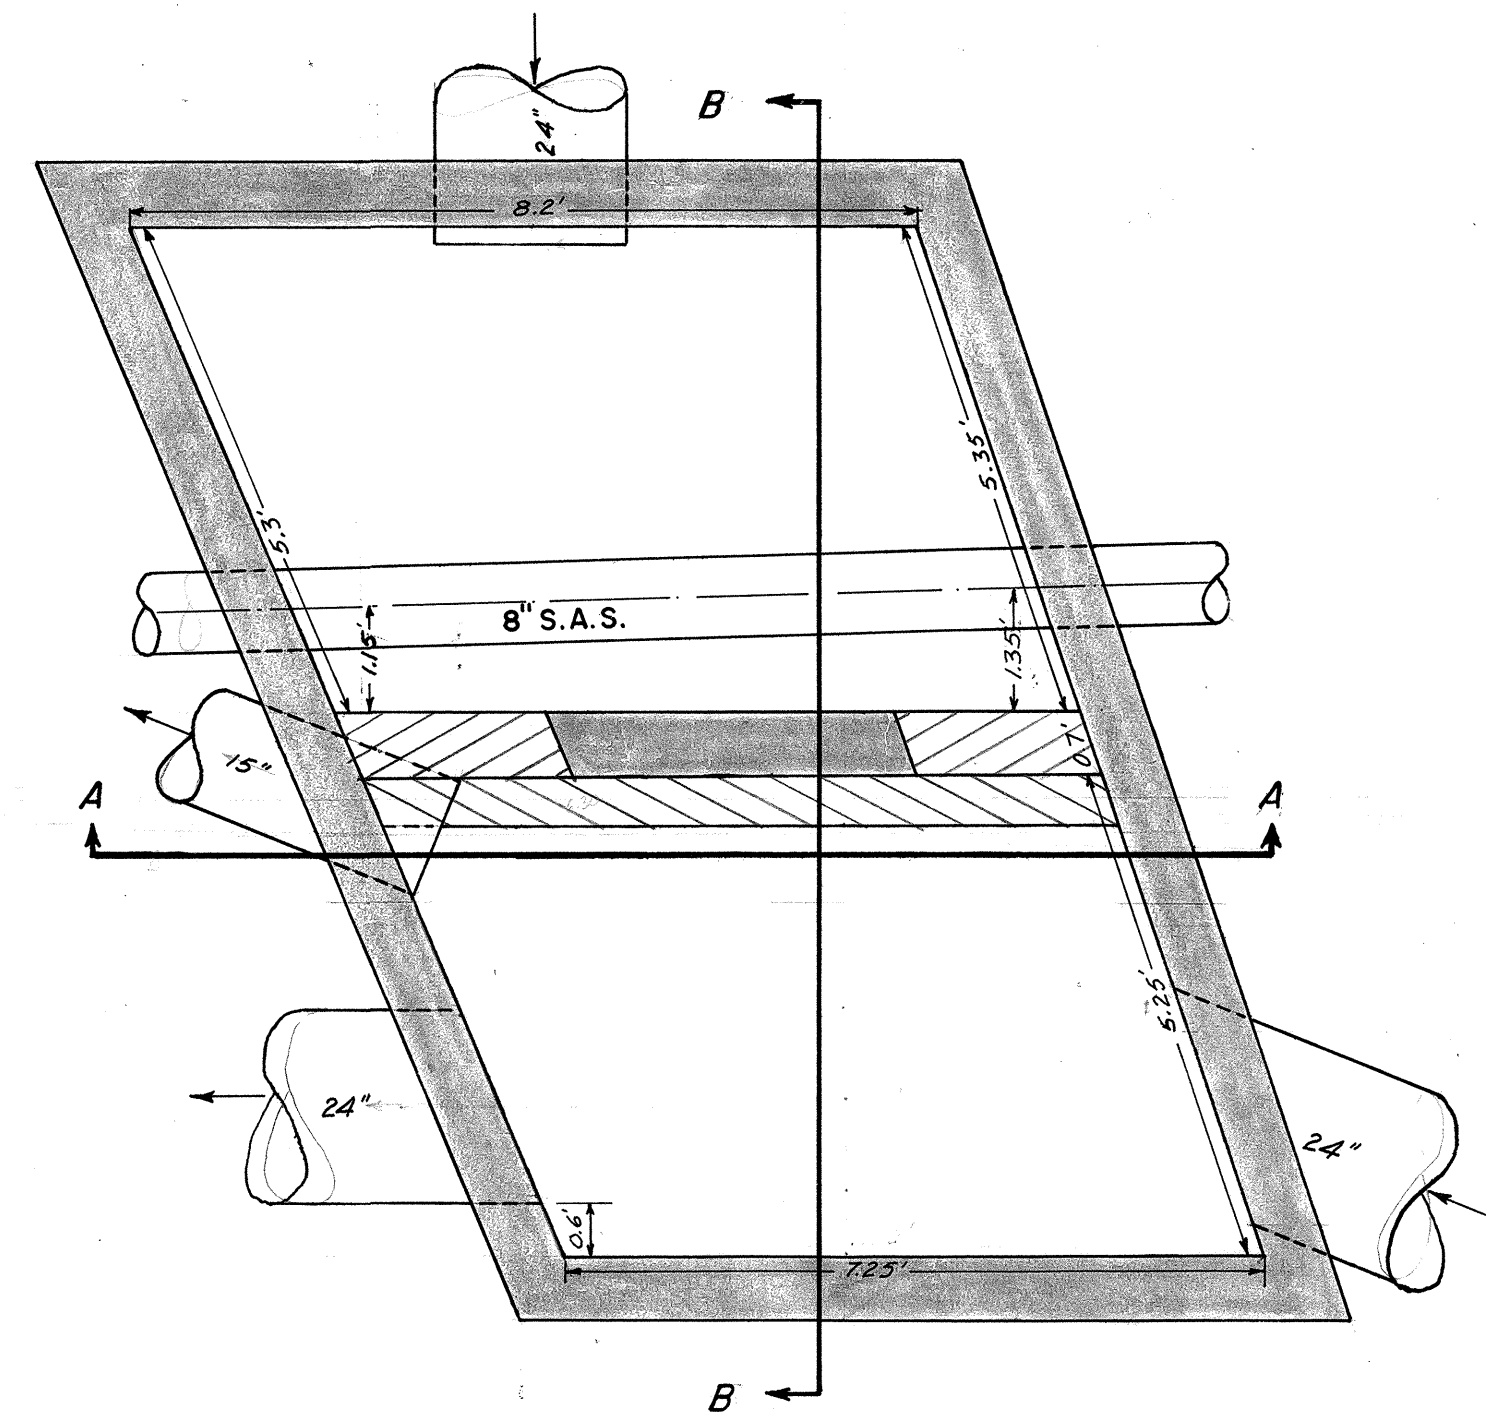

PLAN
SCALE 1"=2'

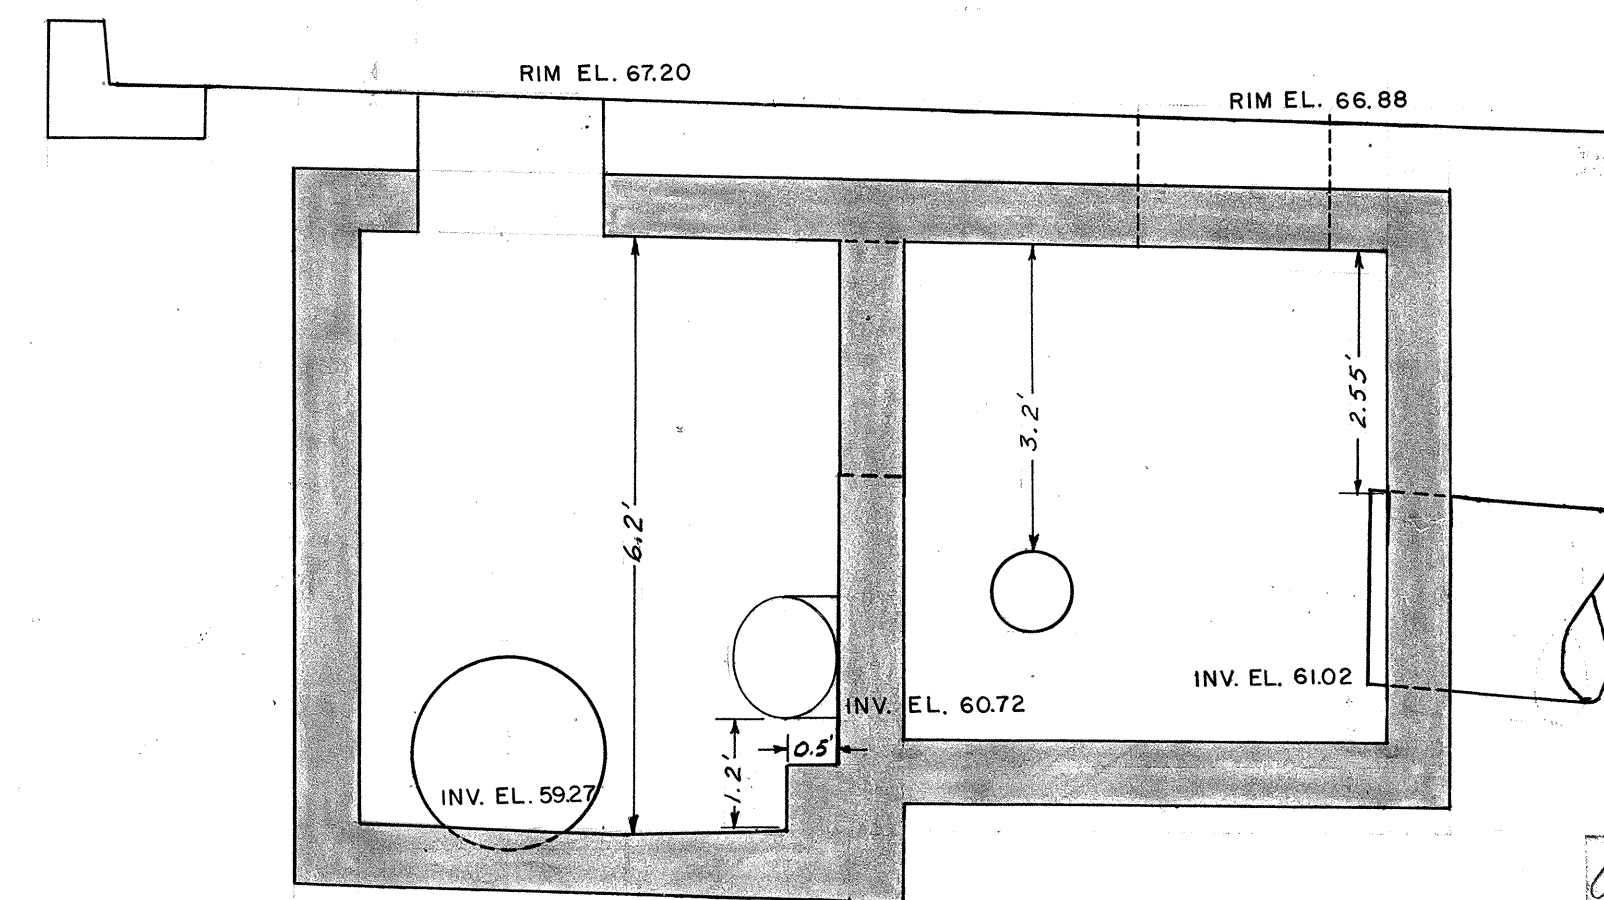

SECTION B-B

02 24 0272 14 57111

— JUNCTION BOX DETAILS —
CENTRAL & ARENAL CANAL

K-11-N

CITY OF ALBUQUERQUE PUBLIC WORKS DEPARTMENT ENGINEERING DIVISION		
TITLE STORM SEWER JUNCTION BOX DETAILS AT CENTRAL AVE. & ARENAL CANAL		
SUBMITTED BY	APPROVED BY	PRELIMINARY DRWG.
DATE	TITLE	DATE
DESIGNED BY	APPROVED BY	CONSTRUCTION DRWG.
DATE	TITLE	DATE
DRAWN BY H.K.B.	APPROVED BY	AS BUILT DRWG.
DATE 7-6-72 TITLE E.T.	DATE	DATE
CHECKED BY	APPROVED BY	FILE NO.
DATE	TITLE	DATE
REV. BY	NOTES	55.24-72
DATE	NOTES	SHEET NO. 2 OF 2
DATE	NOTES	2 SHEETS.