



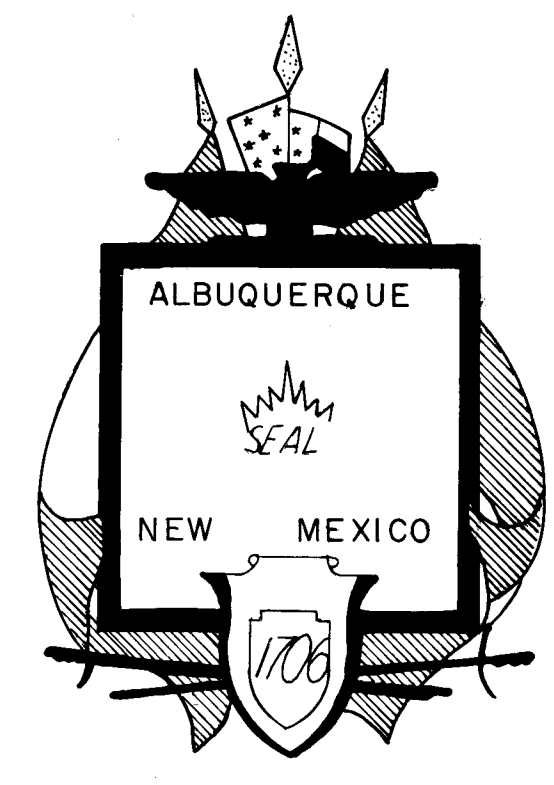

CITY OF ALBUQUERQUE, NEW MEXICO

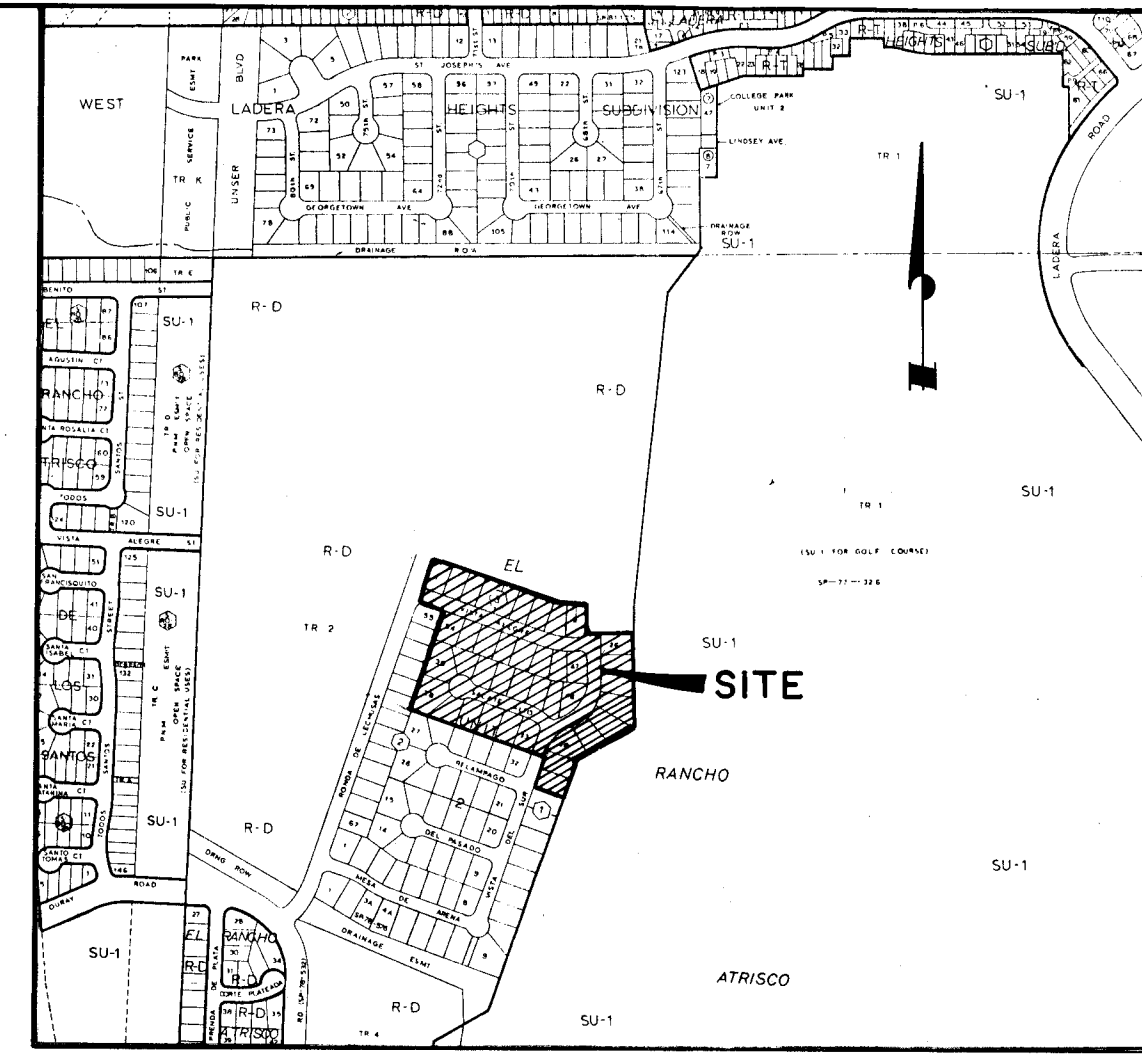

VICINITY MAP
SCALE: 1" = 400' 6-10-Z

EL RANCHO ATRISCO

UNIT 2B

INDEX

SHEET NO.	DESCRIPTION
1	TITLE SHEET
2	SUBDIVISION PLAT
3	GRADING & DRAINAGE PLAN
4	OVERALL STREET PLAN
5	OVERALL WATER & SEWER PLAN
6-8	UNIT 2-B PLAN & PROFILES
9	STREET SECTIONS & DETAILS

RECORD DRAWING
Date: 7-8-86


Russell B. Smith
DATE 3-25-87

26 24770187

GENERAL NOTES

- All work detailed on these plans to be performed under contract shall, except otherwise stated or provided for hereon, be constructed in accordance with the "City Of Albuquerque Interim Standard Specifications For Public Works Construction."
- Two working days prior to any excavation, Contractor must contact Line Locating Service, 765-1234, for the location of existing utilities.
- Prior to construction, the Contractor shall excavate and verify the horizontal and vertical locations of all existing utilities and potential obstructions. Should a conflict exist, the Contractor shall notify the Engineer so that the conflict can be resolved with a minimum amount of delay.
- The Contractor shall maintain access to adjacent properties at all times.
- All work on this project shall be performed in accordance with applicable Federal, State and Local laws, rules and regulations concerning construction safety and health.
- The Contractor must submit a construction signing and barricading plan to Traffic Engineering to receive a barricading permit prior to construction.
- All dimensions and radii of curb and curb returns are shown to face of curb unless otherwise noted.
- Where removal of existing curb and gutter, sidewalk or pavement is required the Contractor shall sawcut and/or remove to the nearest joint. Curb and gutter shown as existing and not to be removed under this contract which is damaged or displaced by the Contractor shall be removed and replaced by the Contractor at the Contractor's expense.
- Restriping of roadway shall be the responsibility of the City of Albuquerque and shall not be included in this contract.
- Backfill compaction shall be according to specified street use.
- Tack coat requirements shall be determined by the City Engineer.
- Sidewalks and wheelchair ramps within the curb returns shall be constructed wherever a new curb return is constructed.
- If curb is depressed for a driveway or a handicap ramp, the driveway or ramp shall be constructed prior to acceptance of the curb and gutter.
- All storm drainage facilities shall be completed prior to final acceptance.
- Sidewalks to be built upon completion of dwelling units on each lot.

REV.	SHEETS	CITY ENGR	DATE	USER DEPT	DATE	USER DEPT	DATE
APPROVAL OF REVISIONS							

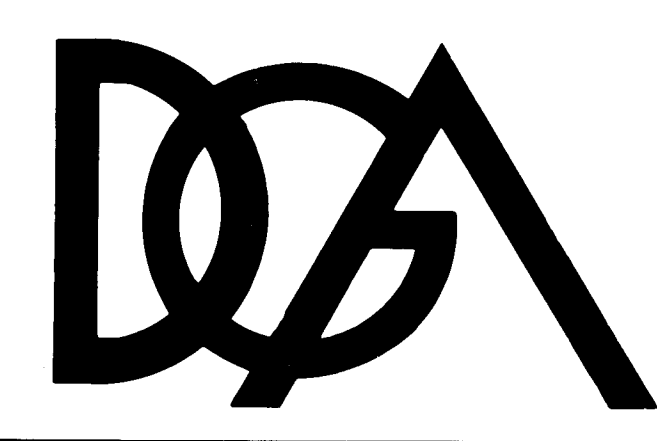


DENNEY-GROSS & ASSOCIATES, INC.
ENGINEERS - PLANNERS
ALBUQUERQUE, NEW MEXICO 87107

DRWG. No. 2477

DENNEY-GROSS & ASSOC., INC.
ENGINEERS SURVEYORS PLANNERS
2400 DENAHO DR. N.E., ALBUQUERQUE, NM 87107
(505) 894-0231

APPROVED FOR CONSTRUCTION
Andrew J. Smith 12/30/86
C.E.

SHEET 1 OF 9

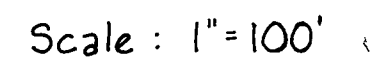

RECORD DRAWING
Date. 7-86

1. Horizontal Control Monuments
Bohannon, Westman, Huston & Assoc. Brass Cap "140-1"
X = 360,717.08 Y = 1,496,570.28
 $\Delta\alpha = -00^{\circ} 16' 04''$
ACS "NM 448 - N3" Brass Cap
X = 365,125.22 Y = 1,497,002.42
 $\Delta\alpha = -00^{\circ} 15' 34''$
Ground to Grid Factor = 0.99967849
2. Vertical Control Monuments
Bohannon, Westman, Huston & Assoc. Brass Cap "140-1"
Elevation 5,128.29 feet above M.S.I.
ACS "NM448 - N3" Brass Cap
Elevation 5,099.527 feet above M.S.I.
3. Plat Data
 - a. Bearings are New Mexico State Plane, Central Zone, grid bearings and the two above described Horizontal Control Monuments are used as a base line for bearings.
 - b. Distances and ground distances.
 - c. Number of lots = 102
 - d. Number of miles of full width streets = 0.934
4. Yard Ponds are to be maintained at the volume indicated on grading plans filed in the Office of the City Engineers.

FILED JULY 11, 1977 VOLUME D7,FOLIO 187.

N 70° 01' 41" W, 533.46 feet to a point; thence,
N 59° 47' 34" W, 244.92 feet to a point; thence,
N 56° 10' 56" W, 60.00 feet to a point, said point being
the Southwest Corner; thence,
Northeasterly, 72.83 feet along the arc of a curve, said
curve having a radius of 301.37 feet and a long
chord which bears N 26° 53' 42" E, 72.65 feet to a
point; thence,
N 19° 58' 19" E, 1,270.00 feet to a point, said point being
the Northwest Corner, thence,
S 70° 01' 41" E, 550.00 feet to a point; thence,
S 83° 50' 40" E, 129.55 feet to a point; thence,
Southwesterly, 90.00 feet along the arc of a curve, said
curve having a radius of 1,522.61 feet and a long
chord which bears S 1° 39' 50" W, 89.99 feet to a
point; thence,
N 89° 58' 14" E, 50.00 feet to a point; thence,
S 0° 01' 46" E, 11.70 feet to a point; thence,
N 89° 58' 14" E, 115.00 feet to a point, said point being
the Northeast Corner; thence,
S 0° 01' 46" E, 35.43 feet to a point; thence,
S 59° 58' 11" W, 249.96 feet to a point; thence,
S 19° 58' 19" W, 865.56 feet to a point, said point being
the point of beginning.

STREET CENTERLINES

CURVE NUMBER	RADIUS	ARC	CHORD	DELTA	TANGENT
S 1	483.00'	139.48'	139.00'	16° 32' 45"	70.23'
S 2	200.53'	109.17'	107.82'	31° 11' 29"	55.97'
S 3	140.00'	76.21'	75.28'	31° 11' 29"	39.08'
S 4	140.00'	21.52'	21.50'	8° 48' 23"	30.08'
S 5	150.37'	157.08'	150.00'	59° 58' 57"	86.60'
S 6	185.00'	64.58'	64.25'	20° 00' 05"	32.62'
S 7	131.37'	80.08'	79.88'	13° 50' 45"	40.23'

PROPERTY LINES						
P 1	25.00'	39.27'	35.36'	90° 00' 00"	25.00'	
P 2	25.00'	19.38'	18.90'	44° 24' 55"	10.21'	
P 3	45.00'	5.90'	5.90'	7° 31' 03"	2.96'	
P 4	45.00'	54.69'	51.39'	69° 37' 59"	31.30'	
P 5	45.00'	44.98'	43.13'	57° 15' 53"	24.57'	
P 6	361.37'	87.33'	87.11'	13° 50' 45"	43.88'	
P 7	458.00'	70.23'	70.16'	8° 47' 09"	35.18'	
P 8	458.00'	62.03'	61.98'	7° 45' 36"	31.06'	
P 9	508.00'	13.13'	13.13'	1° 28' 53"	6.57'	
P 10	508.00'	74.84'	74.84'	8° 28' 29"	37.49'	
P11	508.00'	58.72'	58.69'	3° 37' 23"	29.39'	
P12	508.00'	55.00'	54.97'	6° 12' 12"	27.53'	
P13	508.00'	73.71'	73.65'	8° 18' 50"	36.92'	
P14	508.00'	17.99'	17.99'	2° 01' 43"	8.99'	
P15	458.00'	46.73'	46.71'	5° 50' 46"	23.39'	
P16	458.00'	79.42'	79.32'	9° 56' 07"	39.81'	
P17	458.00'	6.11'	6.11'	0° 45' 52"	3.06'	
P18	25.00'	17.33'	16.98'	39° 42' 54"	9.03'	
P19	40.00'	9.49'	9.47'	13° 35' 26"	4.77'	
P20	40.00'	25.67'	25.23'	36° 46' 01"	13.25'	
P21	40.00'	37.51'	36.15'	53° 43' 32"	20.25'	
P22	40.00'	45.62'	43.19'	65° 20' 49"	25.65'	
P23	115.00'	80.28'	78.66'	39° 59' 52"	41.85'	
P24	165.00'	44.91'	44.77'	15° 35' 45"	22.60'	
P25	25.00'	35.46'	32.56'	81° 16' 27"	21.46'	
P26	175.53'	74.51'	73.95'	24° 19' 18"	37.83'	
P27	225.53'	49.08'	48.98'	12° 28' 09"	24.64'	
P28	225.53'	56.00'	55.85'	14° 13' 33"	28.14'	
P29	25.00'	33.47'	31.02'	76° 41' 50"	19.78'	
P30	175.00'	32.29'	32.24'	10° 54' 03"	16.70'	
P31	125.00'	158.33'	58.33'	19° 55' 55"	29.44'	
P32	125.00'	130.90'	125.00'	59° 59' 57"	72.17'	
P33	210.00'	12.17'	12.17'	3° 19' 12"	6.09'	
P34	210.00'	61.14'	60.92'	16° 40' 53"	30.79'	
P35	160.00'	55.85'	55.57'	20° 00' 05"	28.21'	

ENGINEER'S SEAL			SURVEY INFORMATION		BENCH MARKS		AS BUILT INFORMATION	
			FIELD NOTES					
			NO.	BY	DATE			
						The station is located 4.3 miles Northwest of downtown Albuquerque. Go 700 ft. East from intersection of Curry Rd, Ronda de Lachusos		
						Be a drainage channel.		
			NO.	DATE	REMARKS	BY		
			REVISIONS					
			DESIGN					
			DESIGNED BY	G.W.T.	DATE	JULY, 1985		
			DRAWN BY	E.L.D.	DATE	JULY, 1985		
			CHECKED BY	L.C.G.	DATE	JULY, 1985		

26 24770287


CITY OF ALBUQUERQUE
MUNICIPAL DEVELOPMENT DEPARTMENT
ENGINEERING DIVISION

TITLE: EL RANCHO ATRISCO UNIT 2-B

SUBDIVISION PLAT

APPROVALS	ENGINEER	DATE	APPROVALS	ENGINEER	DATE
City Engineer	<i>[Signature]</i>		Liquid Waste	NA <i>[Signature]</i>	7/17/85
A.C.E. - Design	<i>[Signature]</i>	7/17/85	Traffic	NA <i>[Signature]</i>	7/17/85
A.C.E. - Hydrology	<i>[Signature]</i>		Water	NA <i>[Signature]</i>	7/17/85

DRAWING NO.	2477	MAP NO.	G-10	SHEET	2	OF	9
-------------	------	---------	------	-------	---	----	---

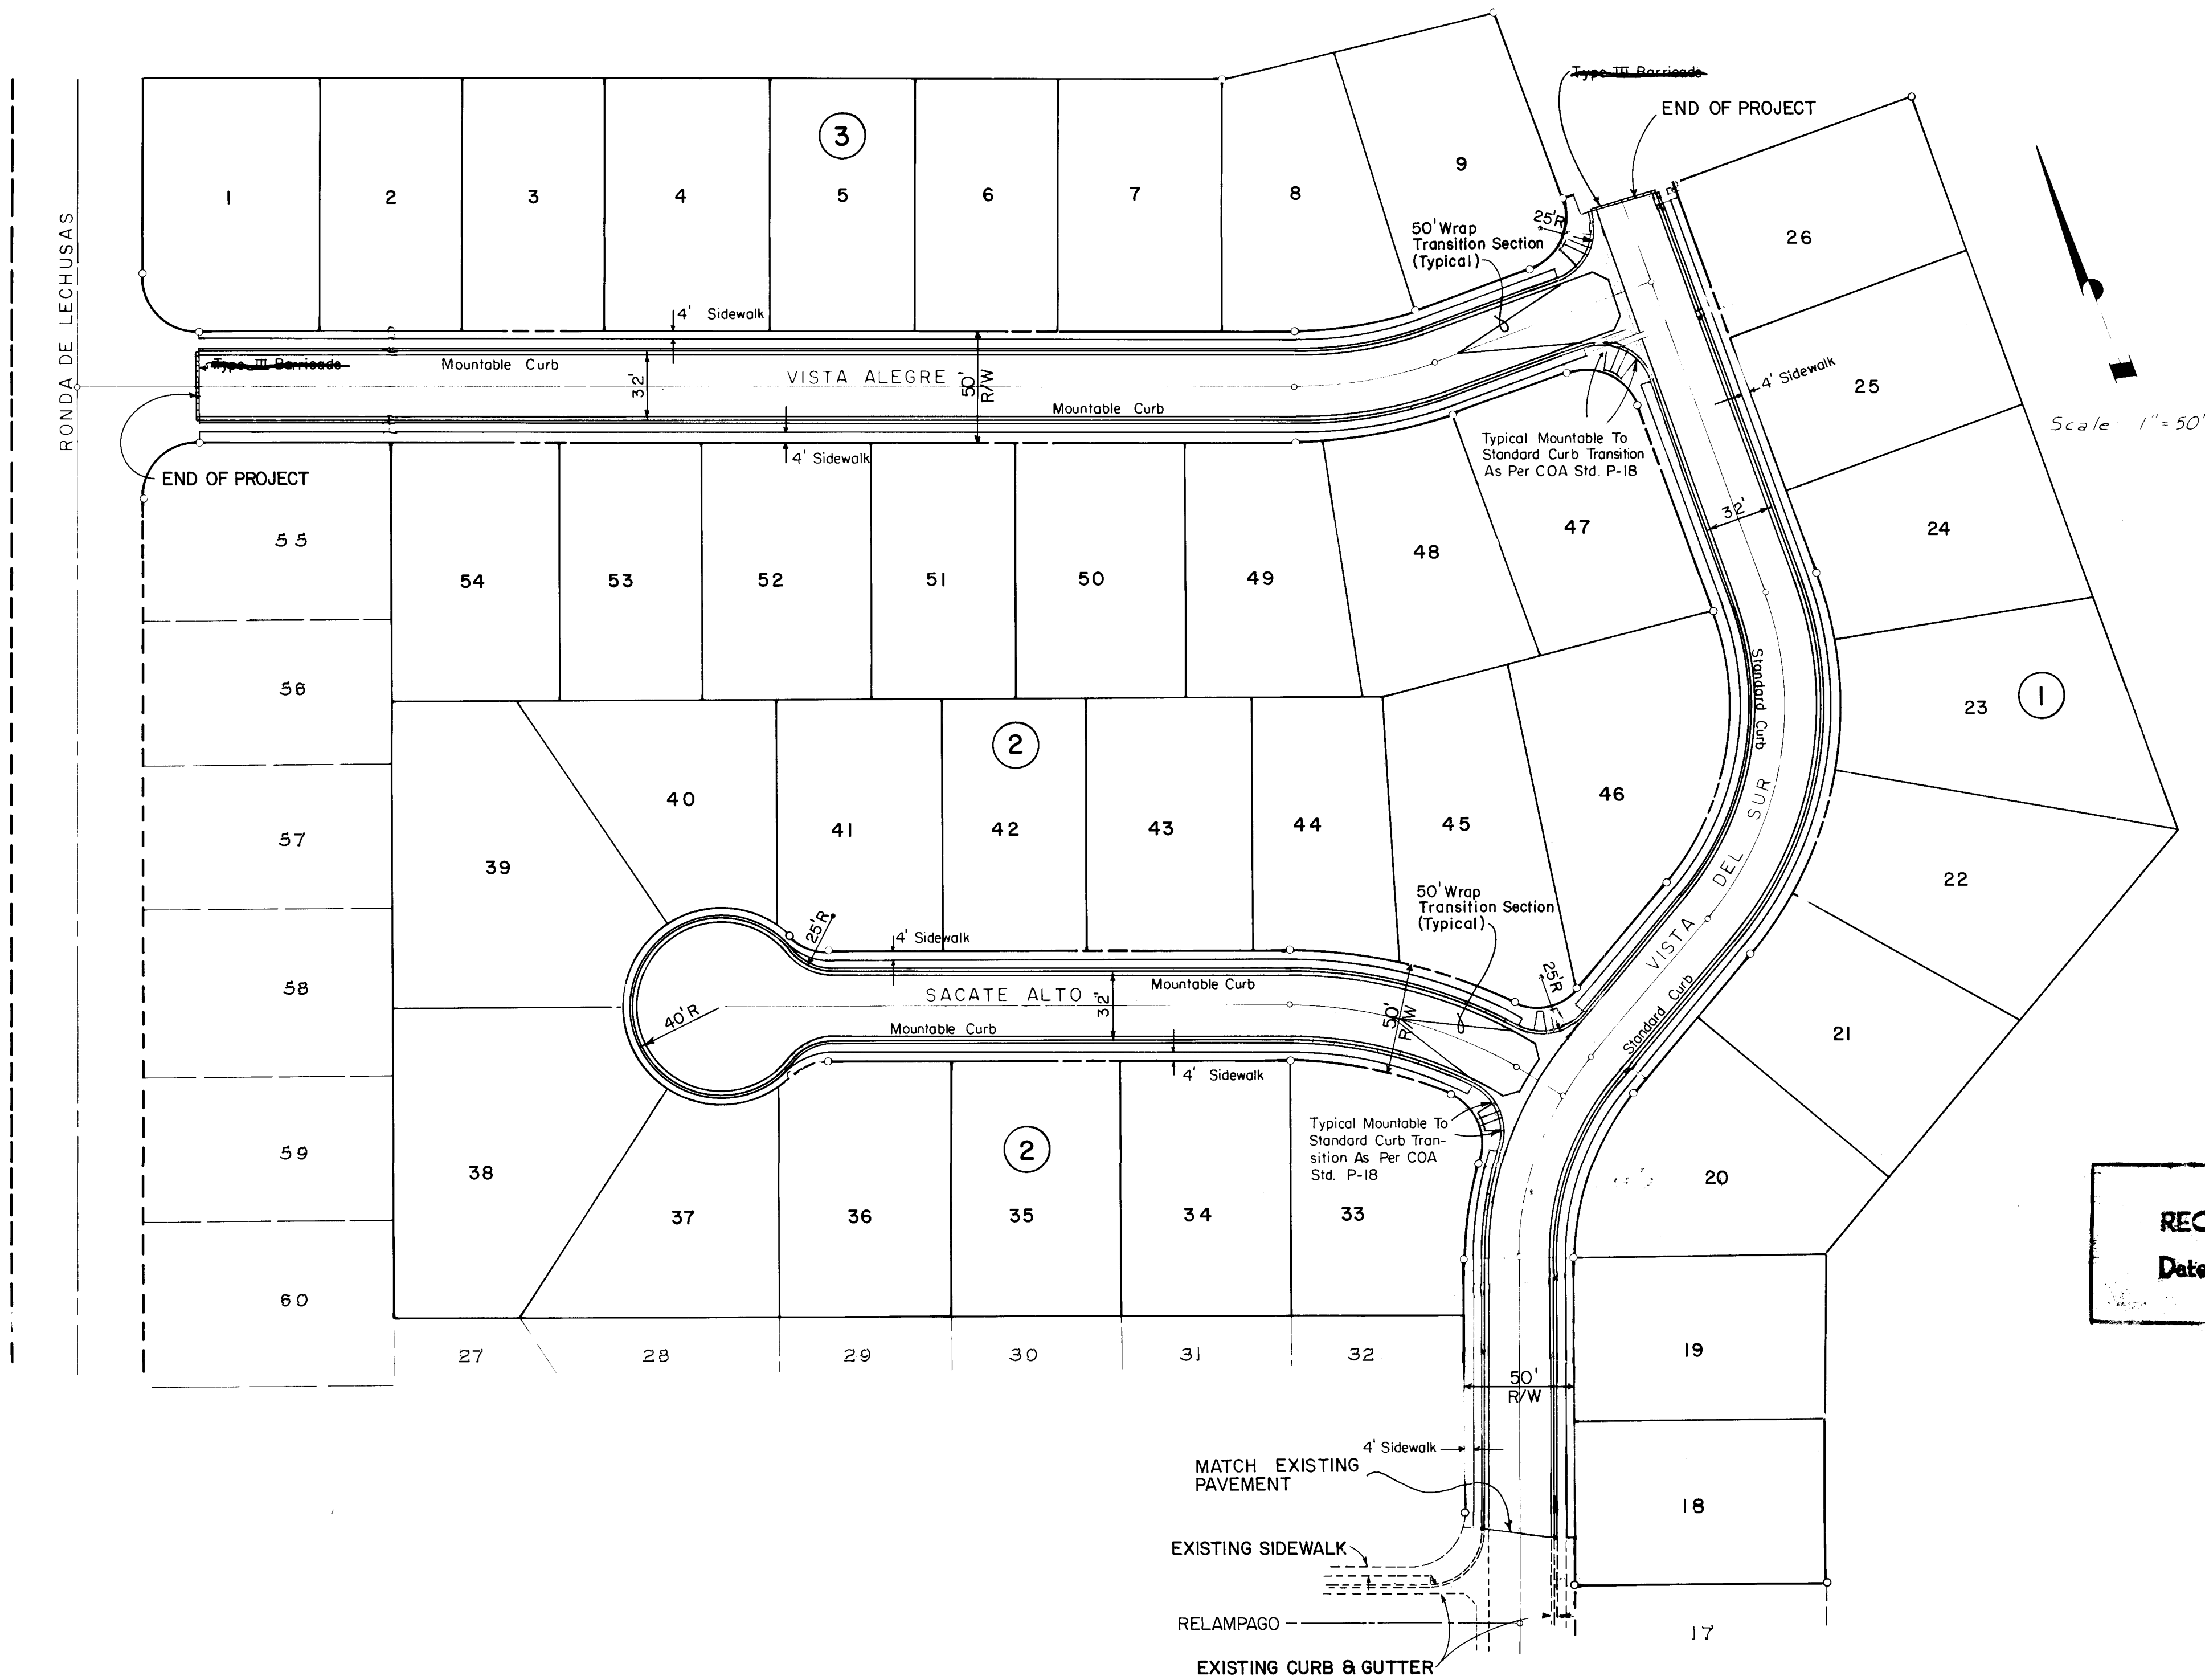


NOTE 1: GAS LINE PLACED BETWEEN CURB & GUTTER AND SIDEWALK AREA, PNM/ACTV AND MOUNTAIN BELL IN 7' PUE .
NOTE 2: SIDEWALK TO BE BUILT BY OTHERS.

ENGINEER'S SEAL			SURVEY INFORMATION		BENCH MARKS		AS BUILT INFORMATION			
			FIELD NOTES		The station is located 4.3 miles Northwest of downtown Albuquerque. So. 700 ft. East from the intersection of Ouray Rd., Rondo de Lechusa & a drainage channel. The station is a standard AC S brass tablet stamped 6-00-1981. The station is above the ground. set 0.10" above the ground.		A. Loc. <i>DM # 450C</i> DATE <i>6-82</i> B. Loc. <i>DM # 450C</i> DATE <i>6-82</i> C. Loc. <i>DM # 450C</i> DATE <i>6-82</i> REMARKS ON BY DATE CORRECTED BY DATE MICRO-FILM INFORMATION H. (INCHES) BY DATE NO.			
			NO.	DATE						
			REVISIONS							
			DESIGN							
			DESIGNED BY	L.W.G.	DATE	03/85				
			DRAWN BY	K.Z.	DATE	03/85				
CHECKED BY	L.C.G.	DATE	03/85							

26 24 17 10 4 8 7

CITY OF ALBUQUERQUE MUNICIPAL DEVELOPMENT DEPARTMENT ENGINEERING DIVISION					
TITLE: EL RANCHO ATRISCO UNIT 2-B OVERALL STREET PLAN					
APPROVALS	ENGINEER	DATE	APPROVALS	ENGINEER	DATE
City Engineer	<i>[Signature]</i>	11/4/85	Liquid Waste	NA	7/17/85
A.C.E. Design	<i>[Signature]</i>	7/17/85	Traffic	NA	7/17/85
Hydrology	<i>[Signature]</i>	7/17/85	Water	NA	7/17/85
DRAWING NO	2477	MAP NO.	G-10	SHEET	4 OF 9

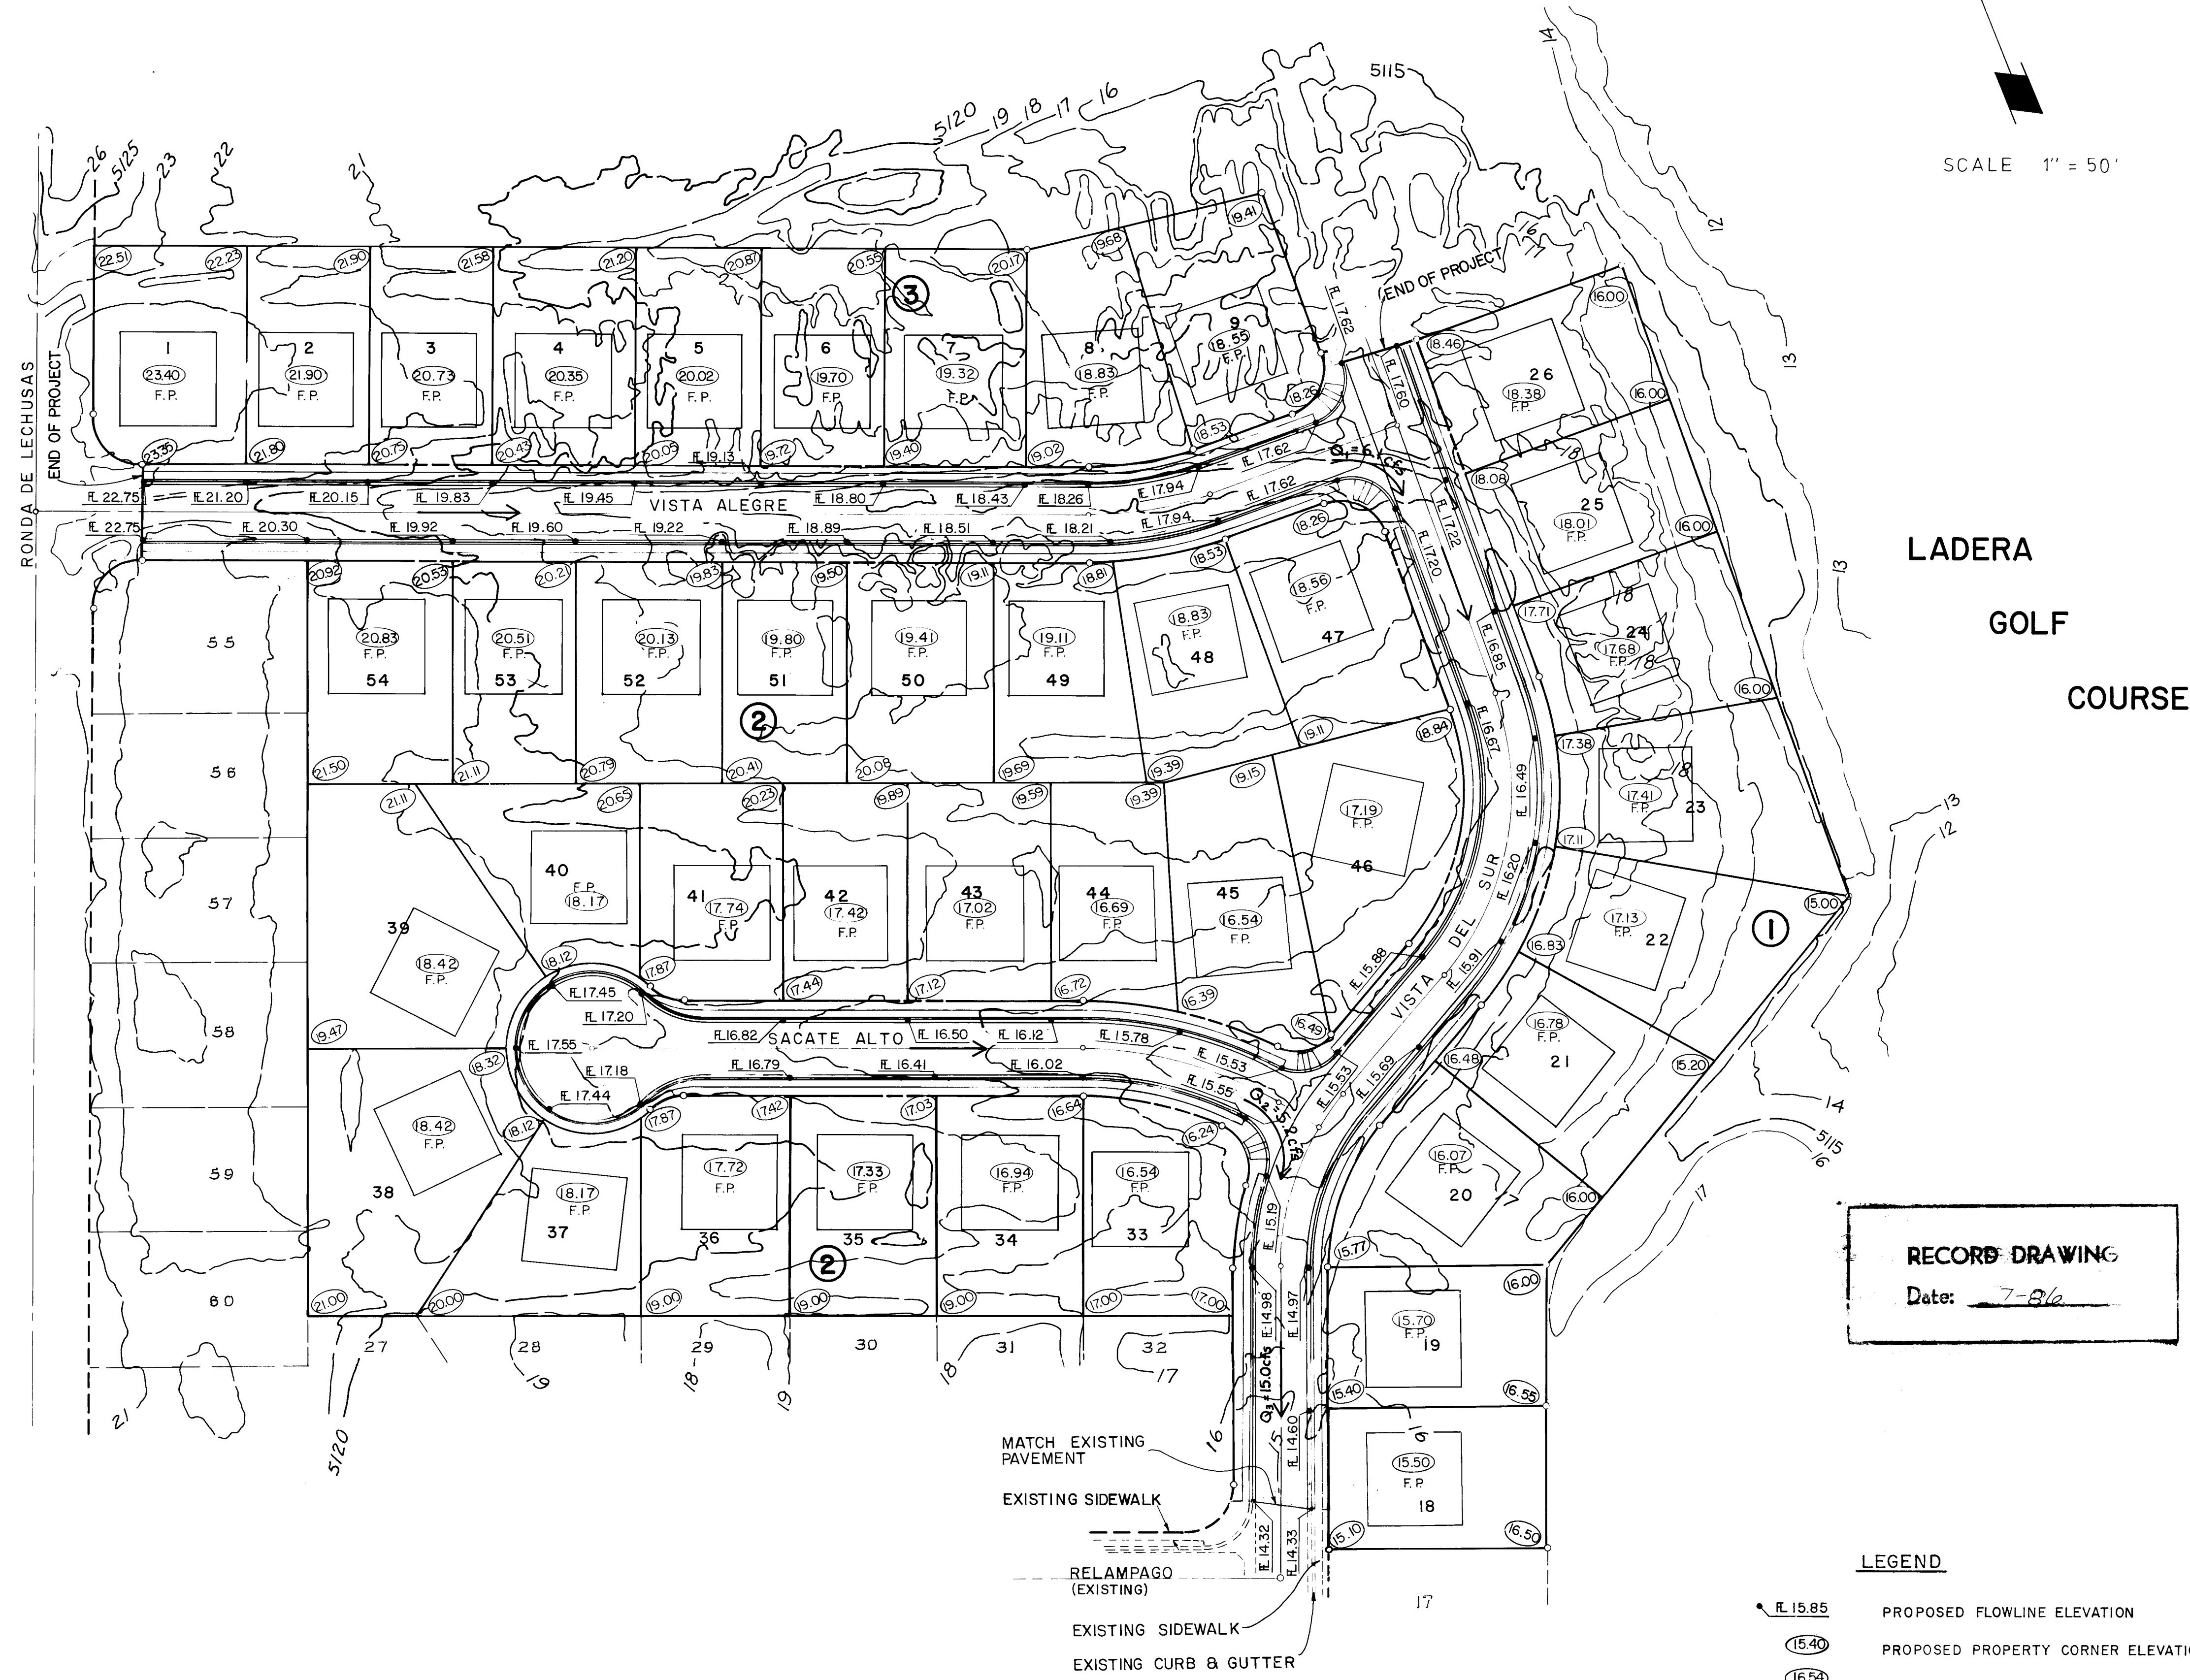

SCALE 1" = 50'

LADERA
GOLF
COURSE

RECORD DRAWING
Date: 7-8-85

- LEGEND
- PROPOSED FLOWLINE ELEVATION
 - PROPOSED PROPERTY CORNER ELEVATION
 - PROPOSED FINISHED PAD ELEVATION
 - FLOW ARROW

NOTES: VISTA ALEGRE AND SACATE
ALTO HAVE MOUNTABLE CURB,
ROLL TYPE. VISTA DEL SUR
HAS STANDARD CURB AND
GUTTER.


NOTE 1: GAS LINE PLACED BETWEEN CURB
& GUTTER AND SIDEWALK AREA, PNM/ACTV
AND MOUNTAIN BELL IN 7' PUE.

NOTE 2: SIDEWALK TO BE BUILT BY
OTHERS.

26 24770387
EXHIBIT IV

CITY OF ALBUQUERQUE
MUNICIPAL DEVELOPMENT DEPARTMENT
ENGINEERING DIVISION

TITLE:				EL RANCHO ATRISCO UNIT 2-B GRADING & DRAINAGE PLAN			
APPROVALS	ENGINEER	DATE	APPROVALS	ENGINEER	DATE		
City Engineer	NA	4/1/85	Liquid Waste	NA	7/17/85		
A.C.E. Design	NA	4/1/85	Traffic	NA	7/17/85		
Hydrology	NA	7/17/85	Water	NA	7/17/85		
DRAWING NO.	2477	MAP NO.	G-10	SHEET	3	OF	9

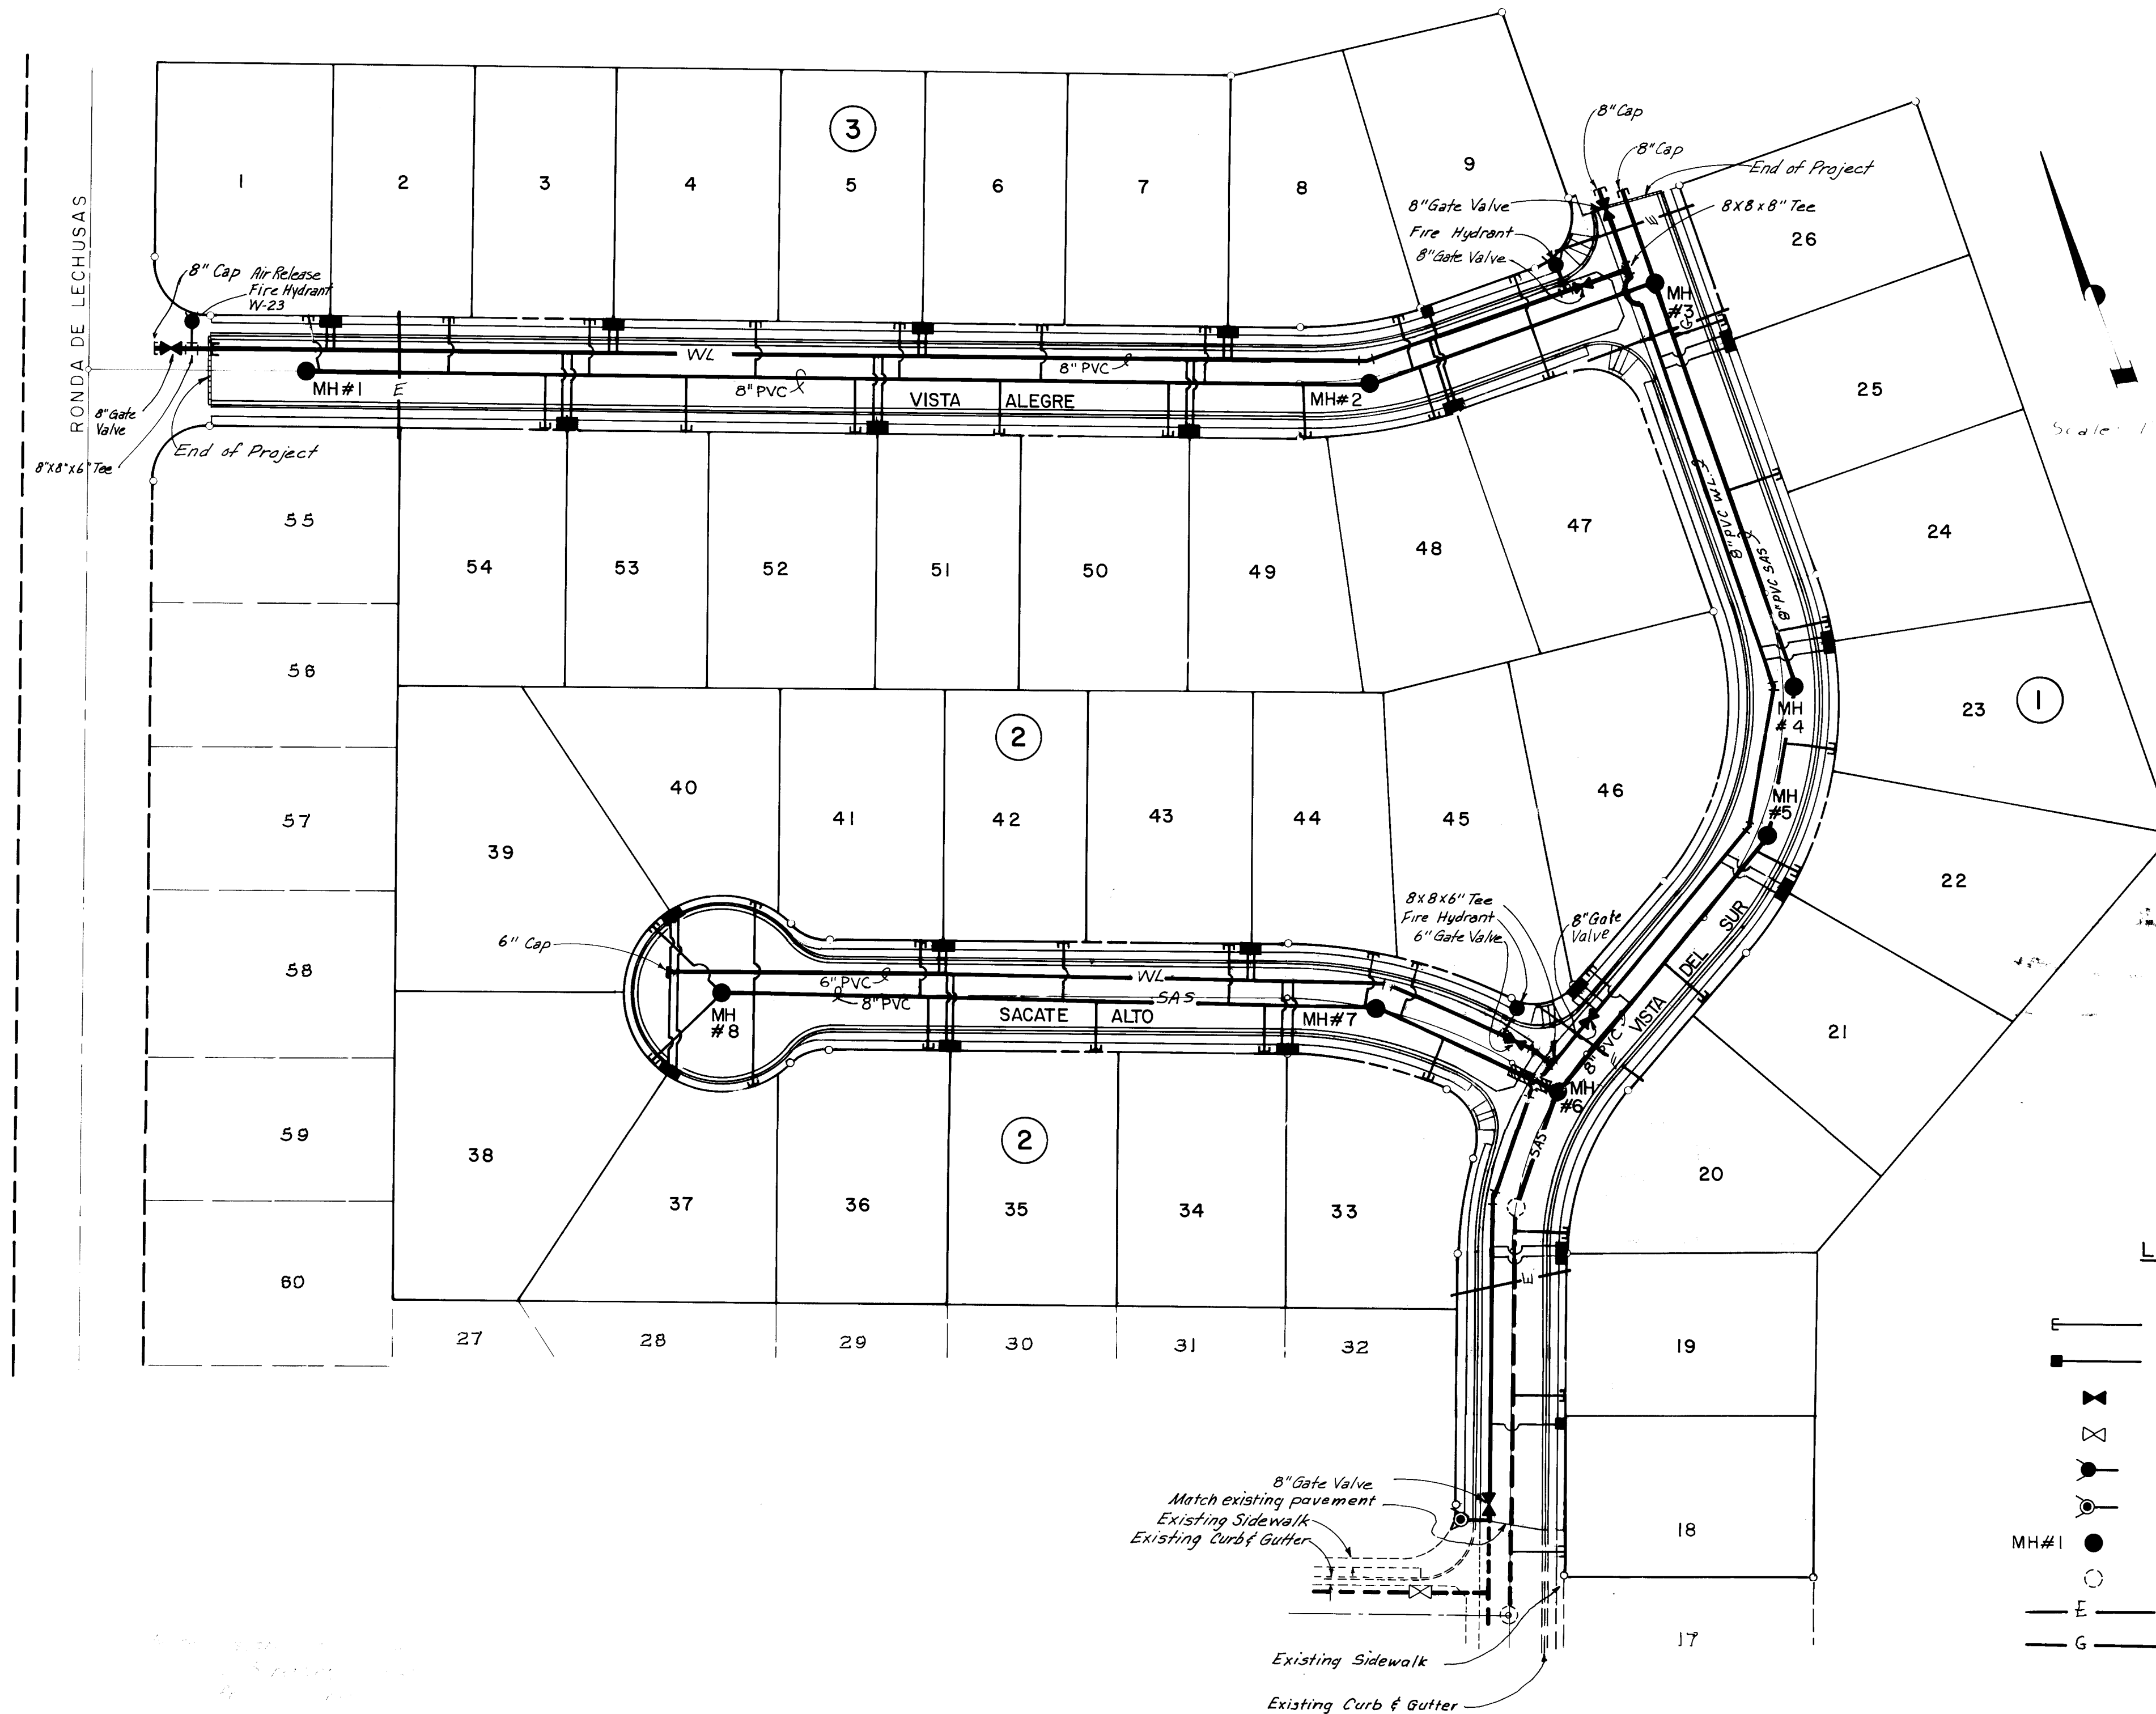

- LEGEND**
- 4" SEWER SERVICE
 - 2" WATER SERVICE, SINGLE METER
 - GATE VALVE, PROPOSED
 - GATE VALVE, EXISTING
 - FIRE HYDRANT, PROPOSED
 - FIRE HYDRANT, EXISTING
 - MANHOLE, PROPOSED
 - MANHOLE, EXISTING
 - Electric line crossing (See Note:1)
 - Gas line crossing (See Note:1)


RECORD DRAWING
Date: 7-86

NOTE 1: GAS LINE PLACED BETWEEN CURB & GUTTER AND SIDEWALK AREA, PNH/ACTV AND MOUNTAIN BELL IN 7' PUE .
NOTE 2: SIDEWALK TO BE BUILT BY OTHERS.

ENGINEER'S SEAL			SURVEY INFORMATION			BENCH MARKS			AS BUILT INFORMATION		
			FIELD NOTES			The station is located 4.3 miles Northwest of downtown Albuquerque. Go 700 ft East from the intersection of Ouray Rd. Ronda de Lechugas & a drainage channel. The station is a standard AC S. brass tablet stamped 6-GO, 1981 set 0.10' above the ground.			DATE: 7-86 BY: W. T. B. L. S.		
			NO.	BY	DATE	MICRO-FILM INFORMATION			DATE: 7-86 BY: W. T. B. L. S.		
REMARKS			DESIGNED BY			DRAWN BY			CHECKED BY		
REVISIONS			DATE 03/85			DATE 03/85			DATE 03/85		
DESIGN			DATE 03/85			DATE 03/85			DATE 03/85		

26 24 770587

CITY OF ALBUQUERQUE MUNICIPAL DEVELOPMENT DEPARTMENT ENGINEERING DIVISION					
TITLE: EL RANCHO ATRISCO UNIT 2-B OVERALL WATER & SEWER PLAN					
APPROVALS	ENGINEER	DATE	APPROVALS	ENGINEER	DATE
City Engineer	<i>N. A. B. A.</i>	7/1/85	Liquid Waste	<i>William G. Bales</i>	7/1/85
A.C.E. Design	<i>N. A. B. A.</i>	7/17/85	Traffic	<i>N. A. B. A.</i>	7/17/85
Hydrology	<i>N. A. B. A.</i>	7/17/85	Water	<i>William G. Bales</i>	7/17/85
DRAWING NO.	2477	MAP NO.	6-10	SHEET	5 OF 9

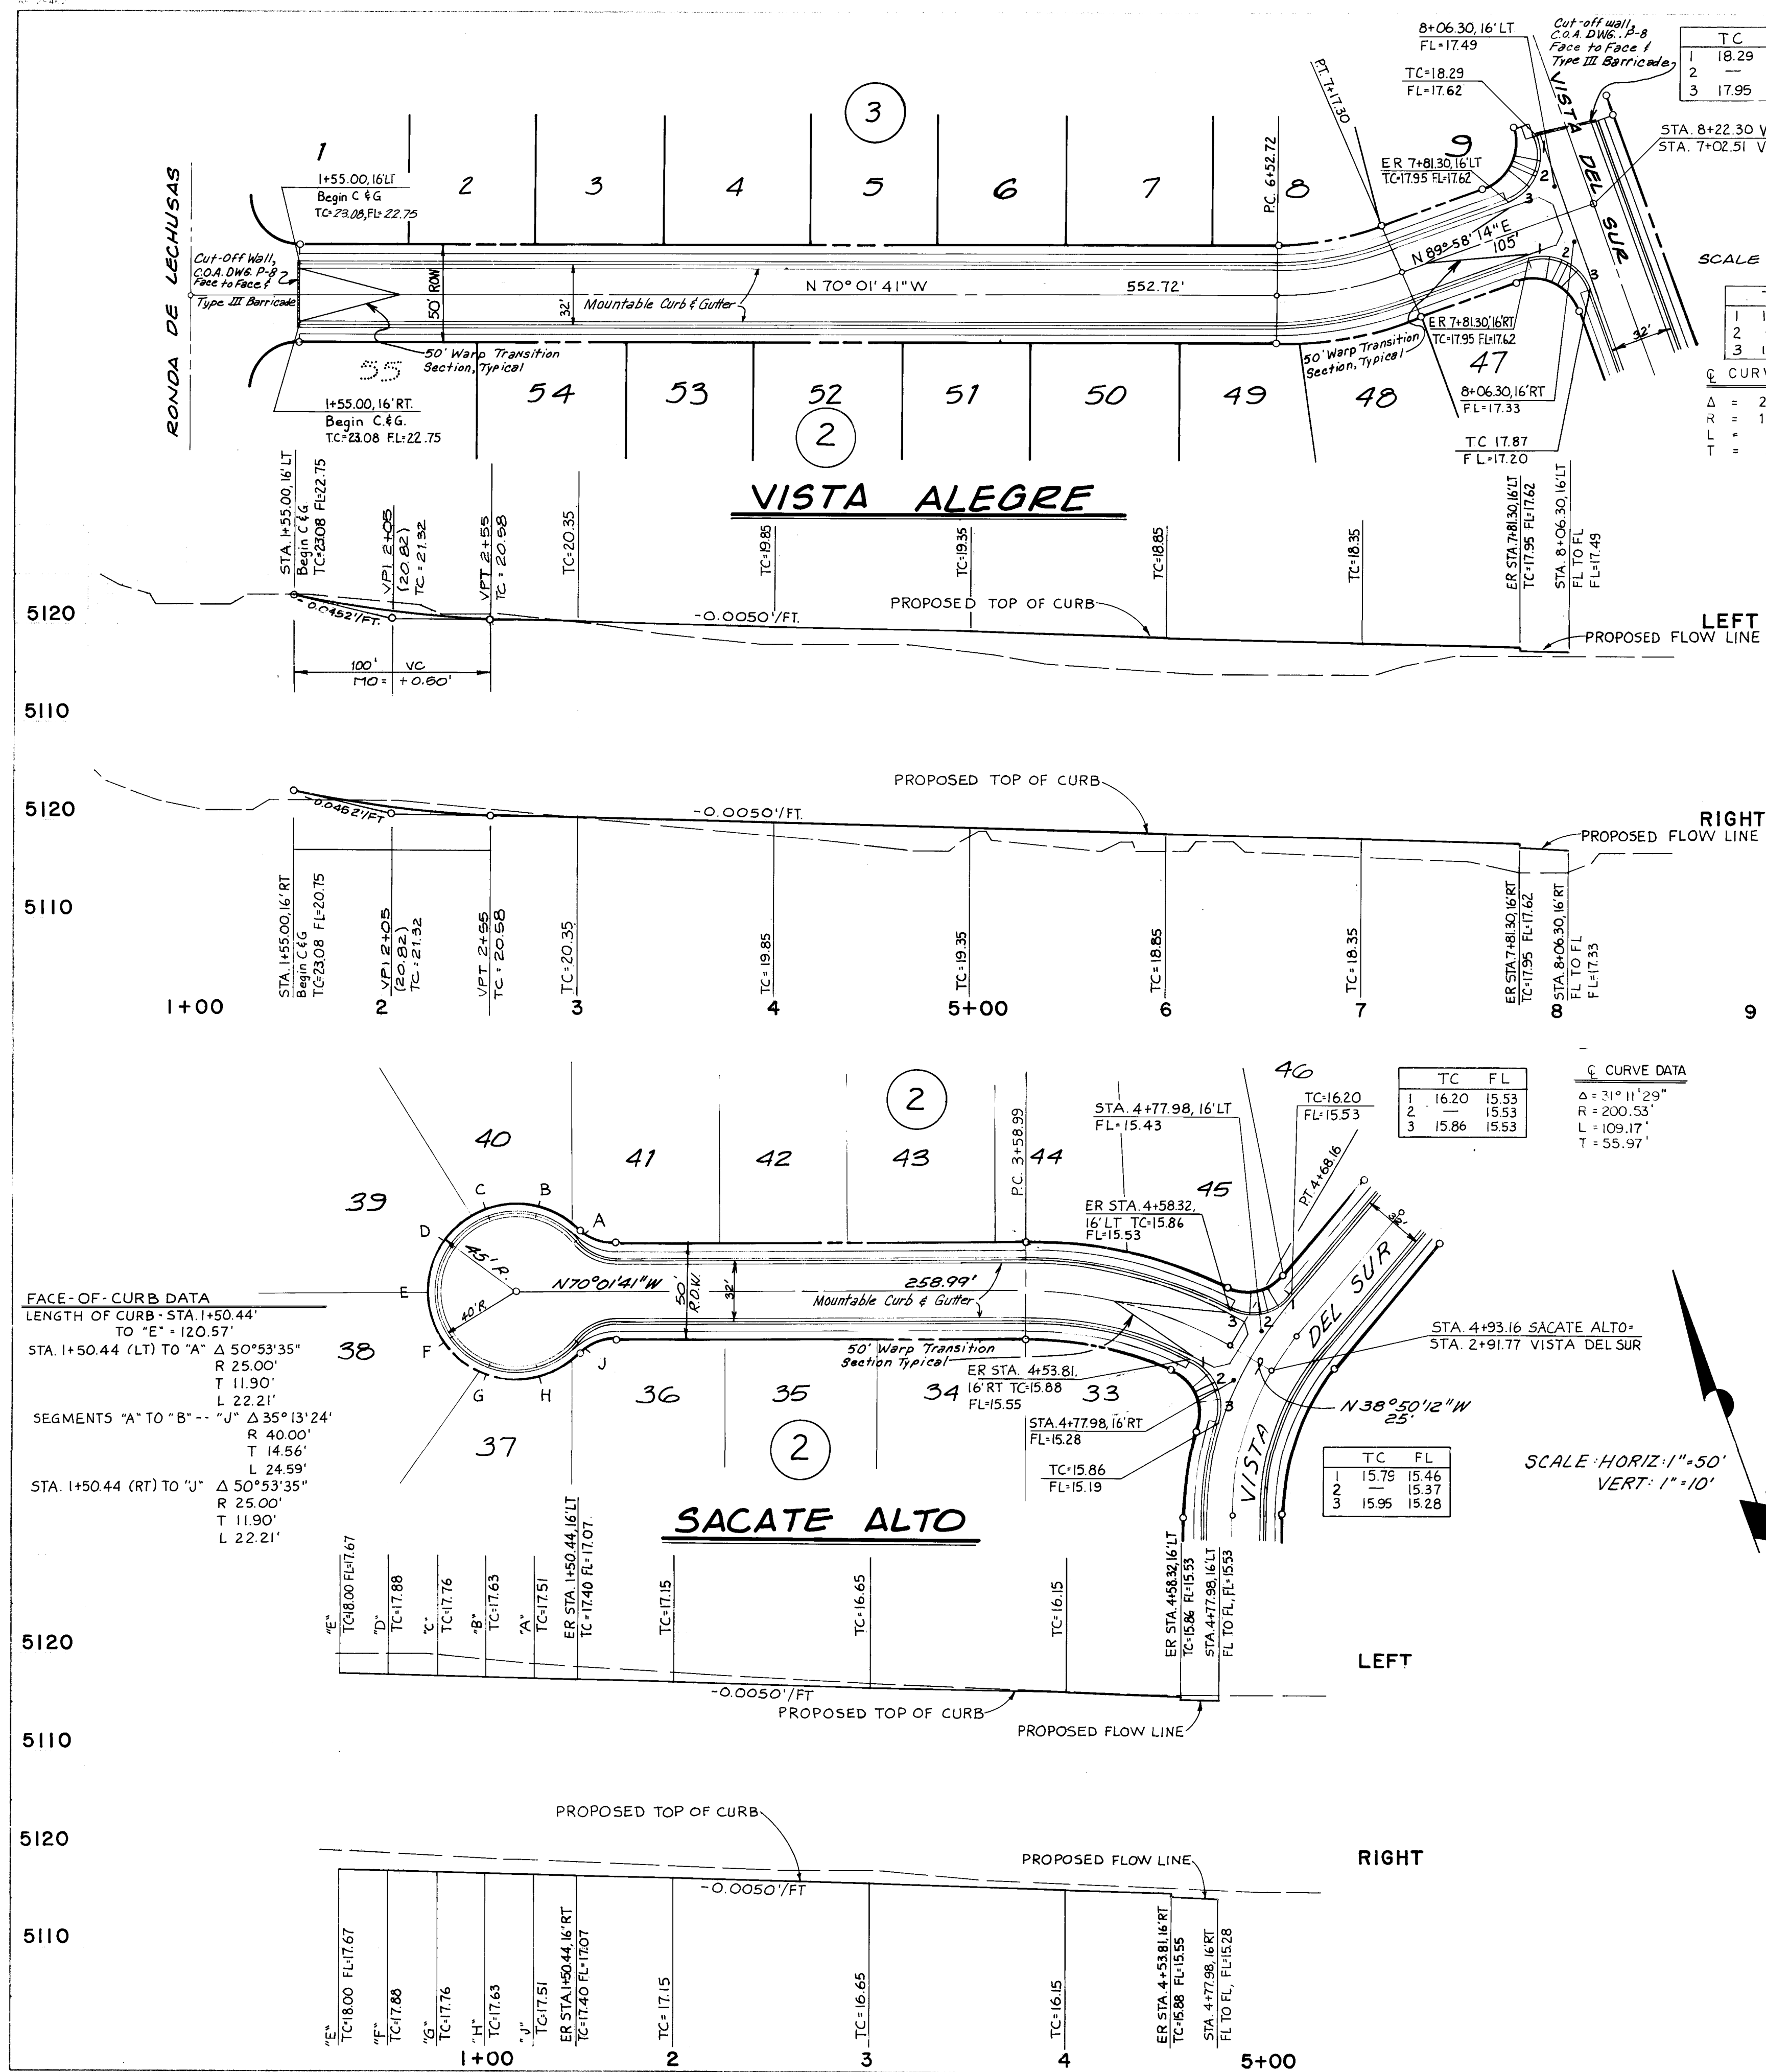

FACE-OF-CURB DATA
LENGTH OF CURB: STA 1+50.44 TO "E" = 120.57'
STA 1+50.44 (LT) TO "A" Δ 50°53'35"
R 25.00'
T 11.90'
L 22.21'
SEGMENTS "A" TO "B" -- "J" Δ 35°13'24"
R 40.00'
T 14.56'
L 24.59'
STA 1+50.44 (RT) TO "J" Δ 50°53'35"
R 25.00'
T 11.90'
L 22.21'

NOTE 1: GAS LINE PLACED BETWEEN CURB & GUTTER AND SIDEWALK AREA, PNH/ACTV AND MOUNTAIN BELL IN 7' PUE.
NOTE 2: SIDEWALK TO BE BUILT BY OTHERS.

RECORD DRAWING
Date: 7-86

AS BUILT INFORMATION		BENCH MARKS		SURVEY INFORMATION		ENGINEER'S SEAL	
The station is located 4.3 miles Northwest of downtown Albuquerque, Co. 700 ft East from the intersection of Quay Rd, Ronda de Lechusas & a drainage channel. The station is a standard AC S brass tablet stamped 6-60, 1981 set 0.10' above the ground.		The station is located 4.3 miles Northwest of downtown Albuquerque, Co. 700 ft East from the intersection of Quay Rd, Ronda de Lechusas & a drainage channel. The station is a standard AC S brass tablet stamped 6-60, 1981 set 0.10' above the ground.		NO. BY DATE		NO. DATE	
DATE: 3-86 DRAWN BY: D. J. Lopez CHECKED BY: D. J. Lopez DATE: 3-86 DRAWN BY: D. J. Lopez CHECKED BY: D. J. Lopez		DATE: 3-86 DRAWN BY: D. J. Lopez CHECKED BY: D. J. Lopez		DATE: 3-86 DRAWN BY: D. J. Lopez CHECKED BY: D. J. Lopez		DATE: 3-86 DRAWN BY: D. J. Lopez CHECKED BY: D. J. Lopez	


26 24770687

CITY OF ALBUQUERQUE
MUNICIPAL DEVELOPMENT DEPARTMENT
ENGINEERING DIVISION

TITLE: EL RANCHO ATRISCO UNIT 2-B
VISTA ALEGRE AND SACATE ALTO
STREET PLAN

APPROVALS	ENGINEER	DATE	APPROVALS	ENGINEER	DATE
for City Engineer	NA	7/1/85	Liquid Waste	NA	7/1/85
A.C.E. Design	NA	7/1/85	Traffic	NA	7/1/85
Hydrology	NA	7/1/85	Water	NA	7/1/85

DRAWING NO. 2477 MAP NO. 6-10 SHEET 6 OF 9

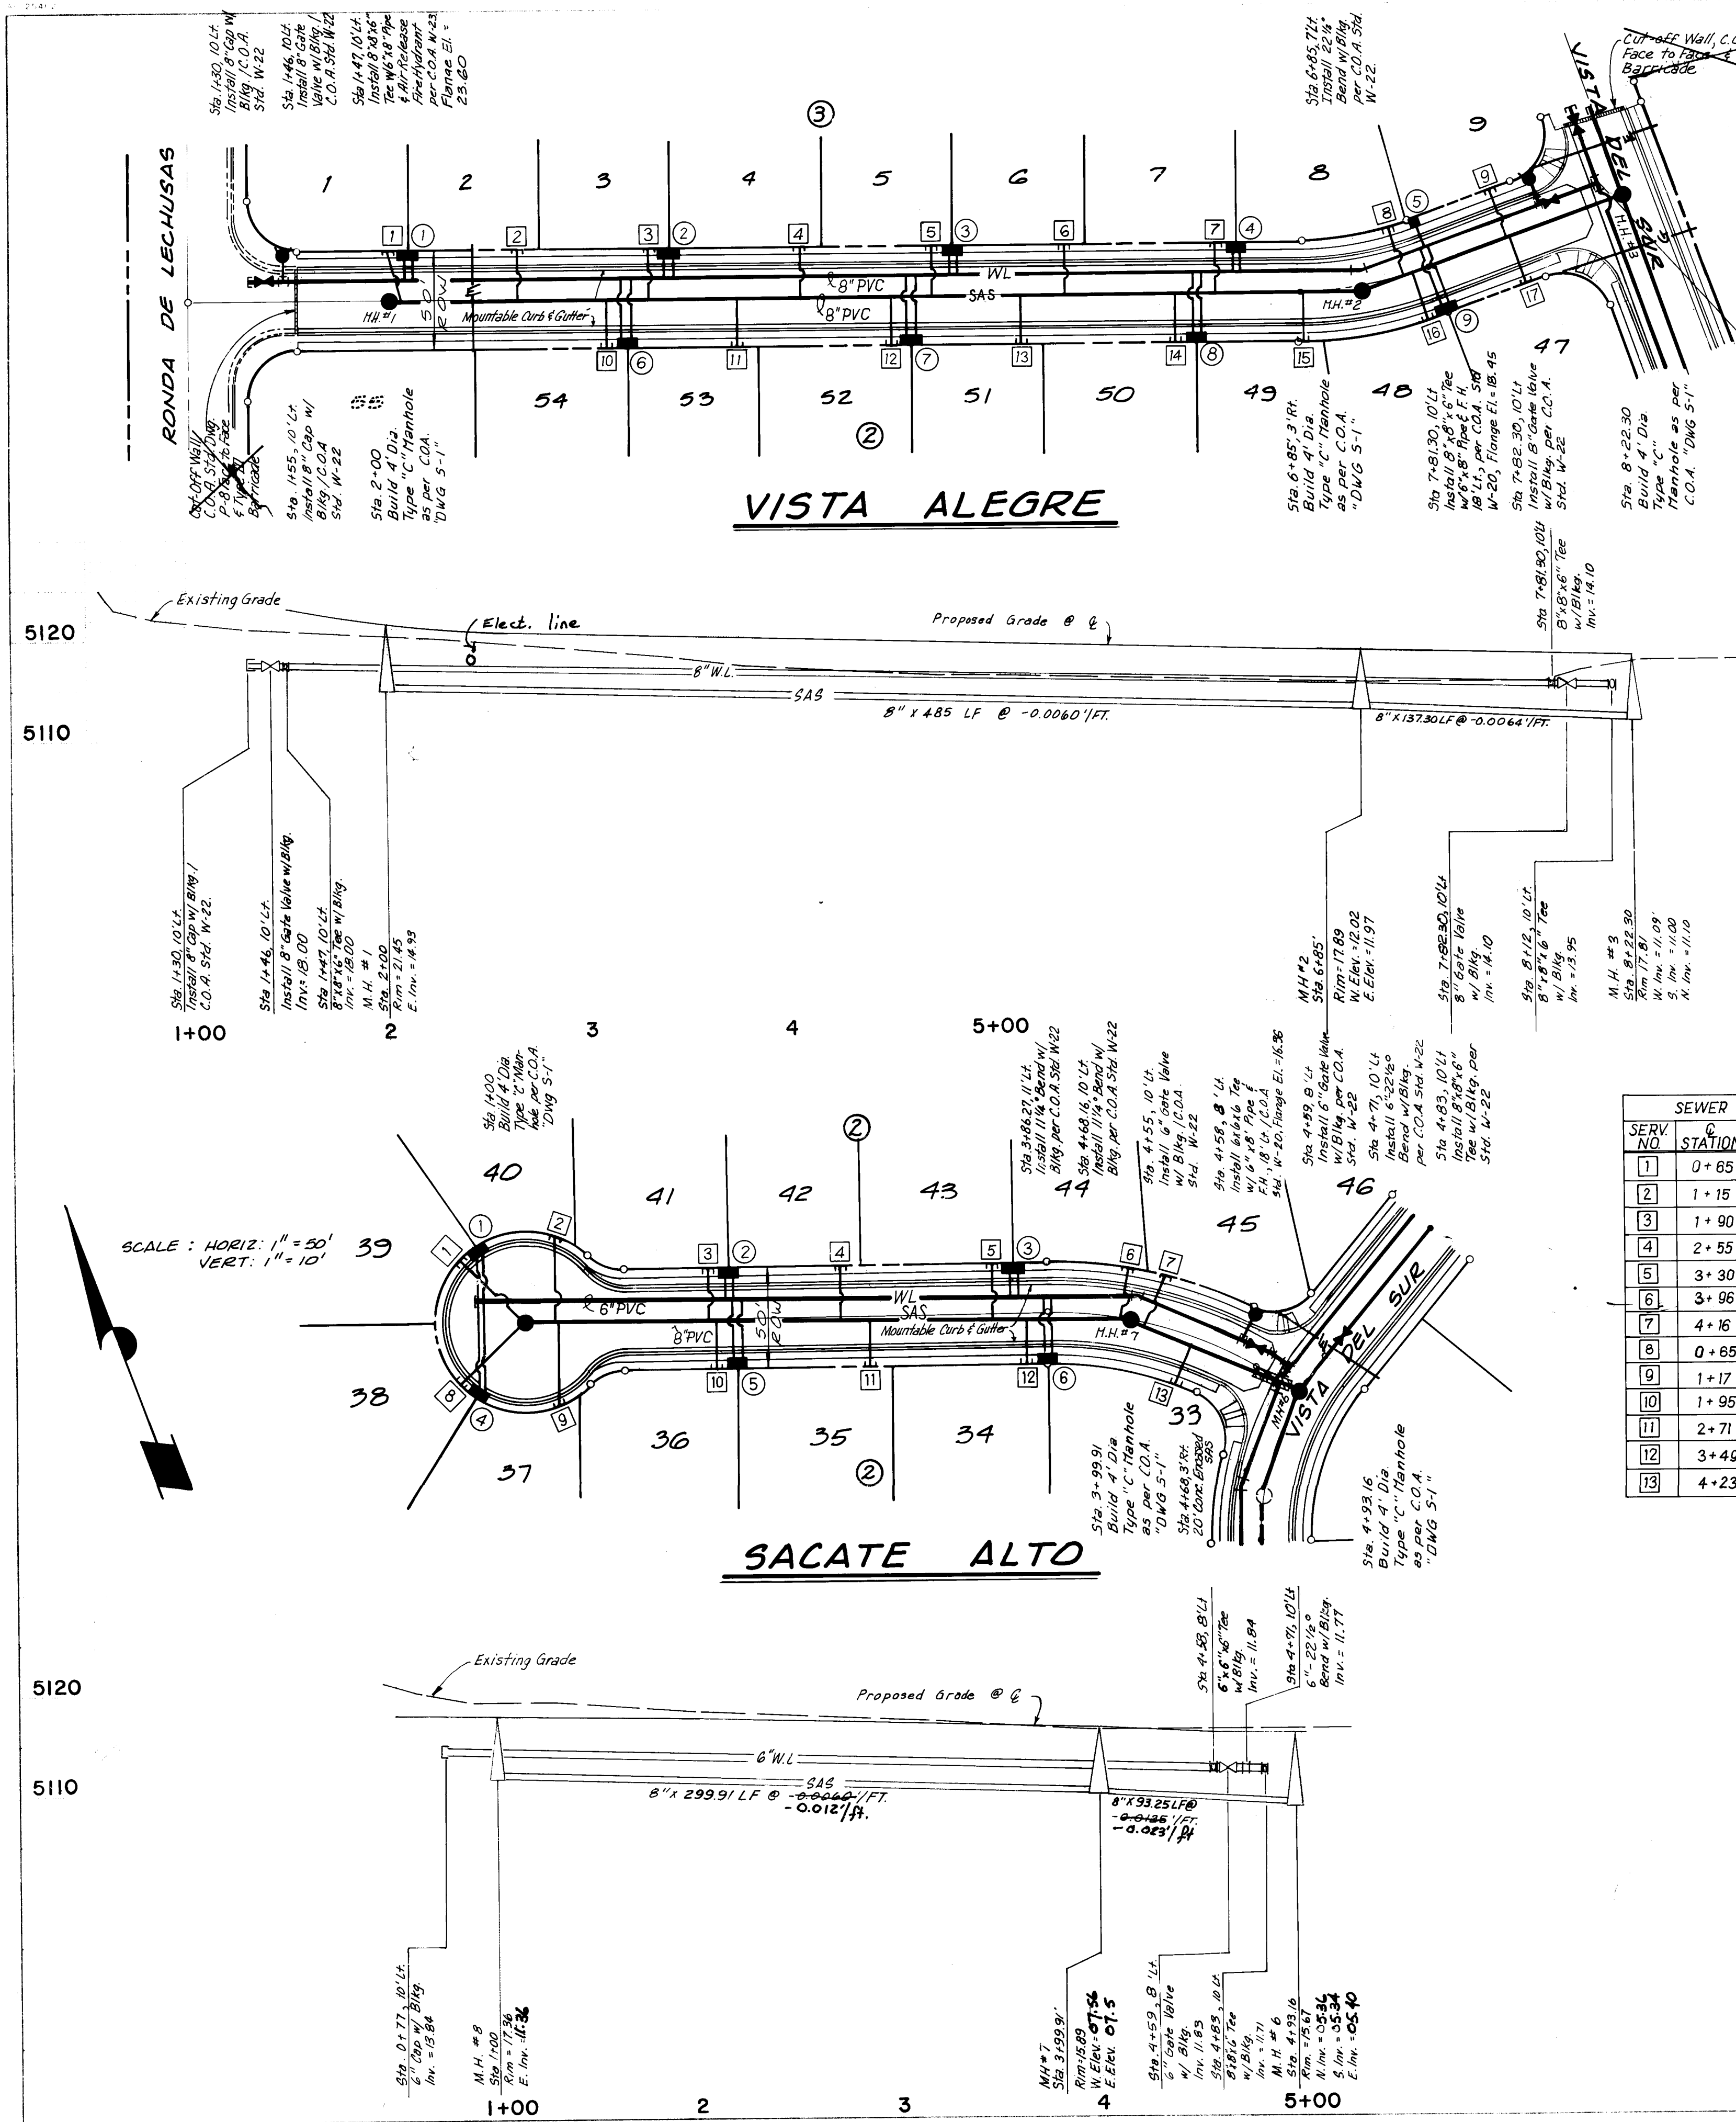

SCALE: HORIZ. 1" = 50'
VERT. 1" = 10'

SEWER SERVICE TABLE			
SERV. NO.	STATION	INV. EL. AT PL.	LENGTH
1	2+00	16.85	27.0
2	2+65	16.52	25.0
3	3+30	16.20	26.0
4	4+05	15.82	25.0
5	4+70	15.50	25.0
6	5+35	15.18	25.0
7	6+10	14.80	25.0
8	7+07	14.31	25.0
9	7+62	14.04	25.0
10	3+11	16.30	24.0
11	3+76	15.97	24.0
12	4+52	15.59	24.0
13	5+17	15.26	24.0
14	5+93	14.88	24.0
15	6+54	14.58	24.0
16	7+07	14.31	25.0
17	7+62	14.04	25.0

WATER SERVICE TABLE		
SERV. NO.	STATION	LENGTH
1	2+10	15.0
2	3+40	15.0
3	4+80	15.0
4	6+20	15.0
5	7+18	<15.0
6	3+21	35.0
7	4+62	35.0
8	6+03	35.0
9	7+18	>35.0

SEWER SERVICE TABLE			
SERV. NO.	STATION	INV. EL. AT PL.	LENGTH
1	0+65	13.32	43.0
2	1+15	13.07	42.0
3	1+90	12.80	26.0
4	2+55	12.50	27.0
5	3+30	12.00	28.0
6	3+96	12.10	26.0
7	4+16	12.10	28.0
8	0+65	13.40	45.0
9	1+17	13.07	42.0
10	1+95	12.70	24.0
11	2+71	12.40	23.0
12	3+49	12.00	22.0
13	4+23	11.80	21.0

WATER SERVICE TABLE		
SERV. NO.	STATION	LENGTH
1	0+75	28.0
2	2+00	15.0
3	3+40	17.0
4	0+75	48.0
5	2+05	35.0
6	3+59	33.0

NOTE 1: GAS LINE PLACED BETWEEN CURB & GUTTER AND SIDEWALK AREA, PNM/ACTV AND MOUNTAIN BELL IN 7' PUE.
NOTE 2: SIDEWALK TO BE BUILT BY OTHERS.

AS BUILT INFORMATION	INCHES	DATE	3-86
BY	DMG	DATE	3-86
REVISIONS	DATE	DATE	DATE
NO	DATE	DATE	DATE
BY	DATE	DATE	DATE
REMARKS	DATE	DATE	DATE
DESIGNED BY	DATE	DATE	DATE
CHECKED BY	DATE	DATE	DATE
APPROVED BY	DATE	DATE	DATE

CITY OF ALBUQUERQUE MUNICIPAL DEVELOPMENT DEPARTMENT ENGINEERING DIVISION			
TITLE: EL RANCHO ATRISCO UNIT 2-B VISTA ALEGRE AND SACATE ALTO WATER AND SEWER PLAN			
APPROVALS	ENGINEER	DATE	APPROVALS
City Engineer	W. J. P. P.	7/17/85	Liquid Waste
ACE Design	N. A. B. G. A.	7/17/85	Traffic
Hydrology	N. A. B. G. A.	7/17/85	Water
DRAWING NO.	2477	MAP NO.	G-10
SHEET	7	OF	9

①	②	③
$\Delta 31^{\circ}11'29''$	$\Delta 8^{\circ}48'23''$	$\Delta 59^{\circ}59'57''$
$R 140.00'$	$R 140.00'$	$R 150.00'$
$L 76.21'$	$L 21.52'$	$L 157.08'$
$T 39.08'$	$T 10.78'$	$T 86.60'$

NOTE 1: GAS LINE PLACED BETWEEN CURB
& GUTTER AND SIDEWALK AREA, PNM/ACTV
AND MOUNTAIN BELL IN 7' PUE .

NOTE 2: SIDEWALK TO BE BUILT BY
OTHERS.

[illegible][illegible]

SERV. NO.	CL. STA.	INV. EL. @ P.L.	LENGTH
1	1+51	0.44	25.0
2	2+68	0.86	25.0
3	3+26	0.89	29.0
4	4+12	0.92	28.0
5	4+70	12.32	29.0
6	5+28	13.21	30.0
7	6+01	13.57	29.0
8	6+76	13.99	26.0
9	3+70	12.42	16.0
10	0+75	11.02	25.0

SERV. NO.	Q. STA.	LENGTH
①	2 + 16	35
②	4 + 02	35
③	5 + 18	35
④	6 + 66	35
⑤	3 + 34	15
⑥	1 + 38	35



26 24770887

CITY OF ALBUQUERQUE
MUNICIPAL DEVELOPMENT DEPARTMENT
ENGINEERING DIVISION

TITLE: EL RANCHO ATRISCO UNIT 2-B
VISTA DEL SUR
STREET, WATER AND SEWER PLAN

APPROVALS	ENGINEER	DATE	APPROVALS	ENGINEER	DATE
City Engineer	<i>W. L. Lister</i>	11/1/85	Liquid Waste	<i>William D. Baker</i>	7/17/85
A.C.E. - Design	<i>W. L. Lister</i>	11/1/85	Traffic	<i>David W. Hanson</i>	7/12/85
ACE - Hydrology	<i>B. J. Lister</i>	7/17/85	Water	<i>William D. Baker</i>	7/17/85

DRAWING NO. 2477	MAP NO. G-10	SHEET 8	OF 9
---------------------	-----------------	------------	---------

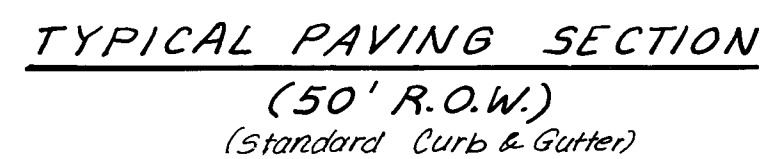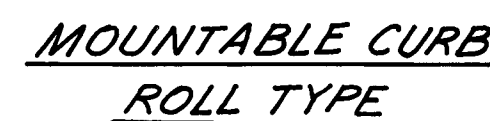

NOTE 1: GAS LINE PLACED BETWEEN CURB
& GUTTER AND SIDEWALK AREA, PNM/ACTV
AND MOUNTAIN BELL IN 7' PUE .

NOTE 2: SIDEWALK TO BE BUILT BY
OTHERS.

NOTE 2: SIDEWALK TO BE BUILT BY OTHERS.

REQUEST		
DEPARTMENT		
VISION		
UNIT 2-B		
DETAILS		
NO.	DESCRIPTION	DATE
1	1/12/85	1/12/85
2	2/12/85	2/12/85
3	3/12/85	3/12/85
4	4/12/85	4/12/85
5	5/12/85	5/12/85
6	6/12/85	6/12/85
7	7/12/85	7/12/85
8	8/12/85	8/12/85
9	9/12/85	9/12/85
10	10/12/85	10/12/85
11	11/12/85	11/12/85
12	12/12/85	12/12/85
13	1/1/86	1/1/86
14	2/1/86	2/1/86
15	3/1/86	3/1/86
16	4/1/86	4/1/86
17	5/1/86	5/1/86
18	6/1/86	6/1/86
19	7/1/86	7/1/86
20	8/1/86	8/1/86
21	9/1/86	9/1/86
22	10/1/86	10/1/86
23	11/1/86	11/1/86
24	12/1/86	12/1/86
25	1/2/86	1/2/86
26	2/2/86	2/2/86
27	3/2/86	3/2/86
28	4/2/86	4/2/86
29	5/2/86	5/2/86
30	6/2/86	6/2/86
31	7/2/86	7/2/86
32	8/2/86	8/2/86
33	9/2/86	9/2/86
34	10/2/86	10/2/86
35	11/2/86	11/2/86
36	12/2/86	12/2/86
37	1/3/86	1/3/86
38	2/3/86	2/3/86
39	3/3/86	3/3/86
40	4/3/86	4/3/86
41	5/3/86	5/3/86
42	6/3/86	6/3/86
43	7/3/86	7/3/86
44	8/3/86	8/3/86
45	9/3/86	9/3/86
46	10/3/86	10/3/86
47	11/3/86	11/3/86
48	12/3/86	12/3/86
49	1/4/86	1/4/86
50	2/4/86	2/4/86
51	3/4/86	3/4/86
52	4/4/86	4/4/86
53	5/4/86	5/4/86
54	6/4/86	6/4/86
55	7/4/86	7/4/86
56	8/4/86	8/4/86
57	9/4/86	9/4/86
58	10/4/86	10/4/86
59	11/4/86	11/4/86
60	12/4/86	12/4/86
61	1/5/86	1/5/86
62	2/5/86	2/5/86
63	3/5/86	3/5/86
64	4/5/86	4/5/86
65	5/5/86	5/5/86
66	6/5/86	6/5/86
67	7/5/86	7/5/86
68	8/5/86	8/5/86
69	9/5/86	9/5/86
70	10/5/86	10/5/86
71	11/5/86	11/5/86
72	12/5/86	12/5/86
73	1/6/86	1/6/86
74	2/6/86	2/6/86
75	3/6/86	3/6/86
76	4/6/86	4/6/86
77	5/6/86	5/6/86
78	6/6/86	6/6/86
79	7/6/86	7/6/86
80	8/6/86	8/6/86
81	9/6/86	9/6/86
82	10/6/86	10/6/86
83	11/6/86	11/6/86
84	12/6/86	12/6/86
85	1/7/86	1/7/86
86	2/7/86	2/7/86
87	3/7/86	3/7/86
88	4/7/86	4/7/86
89	5/7/86	5/7/86
90	6/7/86	6/7/86
91	7/7/86	7/7/86
92	8/7/86	8/7/86
93	9/7/86	9/7/86
94	10/7/86	10/7/86
95	11/7/86	11/7/86
96	12/7/86	12/7/86
97	1/8/86	1/8/86
98	2/8/86	2/8/86
99	3/8/86	3/8/86
100	4/8/86	4/8/86
101	5/8/86	5/8/86
102	6/8/86	6/8/86
103	7/8/86	7/8/86
104	8/8/86	8/8/86
105	9/8/86	9/8/86
106	10/8/86	10/8/86
107	11/8/86	11/8/86
108	12/8/86	12/8/86
109	1/9/86	1/9/86
110	2/9/86	2/9/86
111	3/9/86	3/9/86
112	4/9/86	4/9/86
113	5/9/86	5/9/86
114	6/9/86	6/9/86
115	7/9/86	7/9/86
116	8/9/86	8/9/86
117	9/9/86	9/9/86
118	10/9/86	10/9/86
119	11/9/86	11/9/86
120	12/9/86	12/9/86
121	1/10/86	1/10/86
122	2/10/86	2/10/86
123	3/10/86	3/10/86
124	4/10/86	4/10/86
125	5/10/86	5/10/86
126	6/10/86	6/10/86
127	7/10/86	7/10/86
128	8/10/86	8/10/86
129	9/10/86	9/10/86
130	10/10/86	10/10/86
131	11/10/86	11/10/86
132	12/10/86	12/10/86
133	1/11/86	1/11/86
134	2/11/86	2/11/86
135	3/11/86	3/11/86
136	4/11/86	4/11/86
137	5/11/86	5/11/86
138	6/11/86	6/11/86
139	7/11/86	7/11/86
140	8/11/86	8/11/86
141	9/11/86	9/11/86
142	10/11/86	10/11/86
143	11/11/86	11/11/86
144	12/11/86	12/11/86
145	1/12/86	1/12/86
146	2/12/86	2/12/86
147	3/12/86	3/12/86
148	4/12/86	4/12/86
149	5/12/86	5/12/86
150	6/12/86	6/12/86
151	7/12/86	7/12/86
152	8/12/86	8/12/86
153	9/12/86	9/12/86
154	10/12/86	10/12/86
155	11/12/86	11/12/86
156	12/12/86	12/12/86
157	1/13/86	1/13/86
158	2/13/86	2/13/86
159	3/13/86	3/13/86
160	4/13/86	4/13/86
161	5/13/86	5/13/86
162	6/13/86	6/13/86
163	7/13/86	7/13/86
164	8/13/86	8/13/86
165	9/13/86	9/13/86
166	10/13/86	10/13/86
167	11/13/86	11/13/86
168	12/13/86	12/13/86
169	1/14/86	1/14/86
170	2/14/86	2/14/86
171	3/14/86	3/14/86
172	4/14/86	4/14/86
173	5/14/86	5/14/86
174	6/14/86	6/14/86
175	7/14/86	7/14/86
176	8/14/86	8/14/86
177	9/14/86	9/14/86
178	10/14/86	10/14/86
179	11/14/86	11/14/86
180	12/14/86	12/14/86
181	1/15/86	1/15/86
182	2/15/86	2/15/86
183	3/15/86	3/15/86
184	4/15/86	4/15/86
185	5/15/86	5/15/86
186	6/15/86	6/15/86
187	7/15/86	7/15/86
188	8/15/86	8/15/86
189	9/15/86	9/15/86
190	10/15/86	10/15/86
191	11/15/86	11/15/86
192	12/15/86	12/15/86
193	1/16/86	1/16/86
194	2/16/86	2/16/86
195	3/16/86	3/16/86
196	4/16/86	4/16/86
197	5/16/86	5/16/86
198	6/16/86	6/16/86
199	7/16/86	7/16/86
200	8/16/86	8/16/86
201	9/16/86	9/16/86
202	10/16/86	10/16/86
203	11/16/86	11/16/86
204	12/16/86	12/16/86
205	1/17/86	1/17/86
206	2/17/86	2/17/86
207	3/17/86	3/17/86
208	4/17/86	4/17/86
209	5/17/86	5/17/86
210	6/17/86	6/17/86
211	7/17/86	7/17/86
212	8/17/86	8/17/86
213	9/17/86	9/17/86
214	10/17/86	10/17/86
215	11/17/86	11/17/86
216	12/17/86	12/17/86
217	1/18/86	1/18/86
218	2/18/86	2/18/86
219	3/18/86	3/18/86
220	4/18/86	4/18/86
221	5/18/86	5/18/86
222	6/18/86	6/18/86
223	7/18/86	7/18/86
224	8/18/86	8/18/86
225	9/18/86	9/18/86
226	10/18/86	10/18/86
227	11/18/86	11/18/86
228	12/18/86	12/18/86
229	1/19/86	1/19/86
230	2/19/86	2/19/86
231	3/19/86	3/19/86
232	4/19/86	4/19/86
233	5/19/86	5/19/86
234	6/19/86	6/19/86
235	7/19/86	7/19/86
236	8/19/86	8/19/86
237	9/19/86	9/19/86
238	10/19/86	10/19/86
239	11/19/86	11/19/86
240	12/19/86	12/19/86
241	1/20/86	1/20/86
242	2/20/86	2/20/86
243	3/20/86	3/20/86
244	4/20/86	4/20/86
245	5/20/86	5/20/86
246	6/20/86	6/20/86
247	7/20/86	7/20/86
248	8/20/86	8/20/86
249	9/20/86	9/20/86
250	10/20/86	10/20/86
251	11/20/86	11/20/86
252	12/20/86	12/20/86
253	1/21/86	1/21/86
254	2/21/86	2/21/86
255	3/21/86	3/21/86
256	4/21/86	4/21/86
257	5/21/86	5/21/86
258	6/21/86	6/21/86
259	7/21/86	7/21/86
260	8/21/86	8/21/86
261	9/21/86	9/21/86
262	10/21/86	10/21/86
263	11/21/86	11/21/86
264	12/21/86	12/21/86
265	1/22/86	1/22/86
266	2/22/86	2/22/86
267	3/22/86	3/22/86
268	4/22/86	4/22/86
269	5/22/86	5/22/86
270	6/22/86	6/22/86
271	7/22/86	7/22/86
272	8/22/86	8/22/86
273	9/22/86	9/22/86
274	10/22/86	10/22/86
275	11/22/86	11/22/86
276	12/22/86	12/22/86
277	1/23/86	1/23/86
278	2/23/86	2/23/86
279	3/23/86	3/23/86
280	4/23/86	4/23/86
281	5/23/86	5/23/86
282	6/23/86	6/23/86
283	7/23/86	7/23/86
284	8/23/86	8/23/86
285	9/23/86	9/23/86
286	10/23/86	10/23/86
287	11/23/86	11/23/86
288	12/23/86	12/23/86
289	1/24/86	1/24/86
290	2/24/86	2/24/86
291	3/24/86	3/24/86
292	4/24/86	4/24/86
293	5/24/86	5/24/86
294	6/24/86	6/24/86
295	7/24/86	7/24/86
296	8/24/86	8/24/86
297	9/24/86	9/24/86
298	10/24/86	10/24/86
299	11/24/86	11/24/86
300	12/24/86	12/24/86
301	1/25/86	1/25/86
302	2/25/86	2/25/86
303	3/25/86	3/25/86
304	4/25/86	4/25/86
305	5/25/86	5/25/86
306	6/25/86	6/25/86
307	7/25/86	7/25/86
308	8/25/86	8/25/86
309	9/25/86	9/25/86
310	10/25/86	10/25/86
311	11/25/86	11/25/86
312	12/25/86	12/25/86
313	1/26/86	1/26/86
314	2/26/86	2/26/86
315	3/26/86	3/26/86
316	4/26/86	4/26/86
317	5/26/86	5/26/86
318	6/26/86	6/26/86
319	7/26/86	7/26/86
320	8/26/86	8/26/86
321	9/26/86	9/26/86
322	10/26/86	10/26/86
323	11/26/86	11/26/86
324	12/26/86	12/26/86
325	1/27/86	1/27/86
326	2/27/86	2/27/86
327	3/27/86	3/27/86
328	4/27/86	4/27/86
329	5/27/86	5/27/86
330	6/27/86	6/27/86
331	7/27/86	7/27/86
332	8/27/86	8/27/86
333	9/27/86	9/27/86
334	10/27/86	10/27/86
335	11/27/86	11/27/86
336	12/27/86	12/27/86
337	1/28/86	1/28/86
338	2/28/86	2/28/86
339	3/28/86	3/28/86
340	4/28/86	4/28/86
341	5/28/86	5/28/86
342	6/28/86	6/28/86
343	7/28/86	7/28/86
344	8/28/86	8/28/86
345	9/28/86	9/28/86
346	10/28/86	

26 24770987

CITY OF ALBUQUERQUE
MUNICIPAL DEVELOPMENT DEPARTMENT
ENGINEERING DIVISION

TITLE: EL RANCHO ATRISCO UNIT 2-B					
STREET SECTIONS & DETAILS					
APPROVALS	ENGINEER	DATE	APPROVALS	ENGINEER	DATE
City Engineer	<i>Allen Lee</i>	11/1/85	Liquid Waste	NA <i>2/2/86</i>	2/2/86
A.C.E. - Design	<i>Allen Lee</i>	11/1/85	Traffic	<i>David W. Hume</i>	3/17/85
 - Hydrology	NA <i>2/2/86</i>	2/7/85	Water	NA <i>2/2/86</i>	2/2/86

DRAWING NO. 2477	MAP NO. G-10	SHEET 9 OF 9
---------------------	-----------------	--------------