


CONSTRUCTION PLANS FOR DESERT CLASSIC AT TANOAN SUBDIVISION - PHASE I ALBUQUERQUE, NEW MEXICO

SHEET NO.	DESCRIPTION
1	TITLE SHEET
2-7	SUBDIVISION PLAT
8	DRAINAGE / GRADING PLAN
9	RETAINING WALL DETAILS
10	PAVING & STORM DRAIN PLAN
11	WATER DISTRIBUTION PLAN
12	SANITARY SEWER PLAN
13-21	PAVING PLAN & PROFILE
	WOODMAR LANE
	DESERT CLASSIC LANE
	FAIRINGTON WAY
	PINE TOP LANE
	PENFIELD LANE / MARINER LANE
	WOODMAR / PINE TOP CUL-DE-SACS
	GLEN OAK
	SKY VALLEY
22-29	UTILITY PLAN & PROFILE
	WOODMAR LANE
	DESERT CLASSIC LANE
	FAIRINGTON WAY
	PINE TOP LANE
	PENFIELD LANE / MARINER LANE
	WOODMAR / PINE TOP CUL-DE-SACS
	GLEN OAK
	GLEN OAK / STORM DRAIN OUTLET

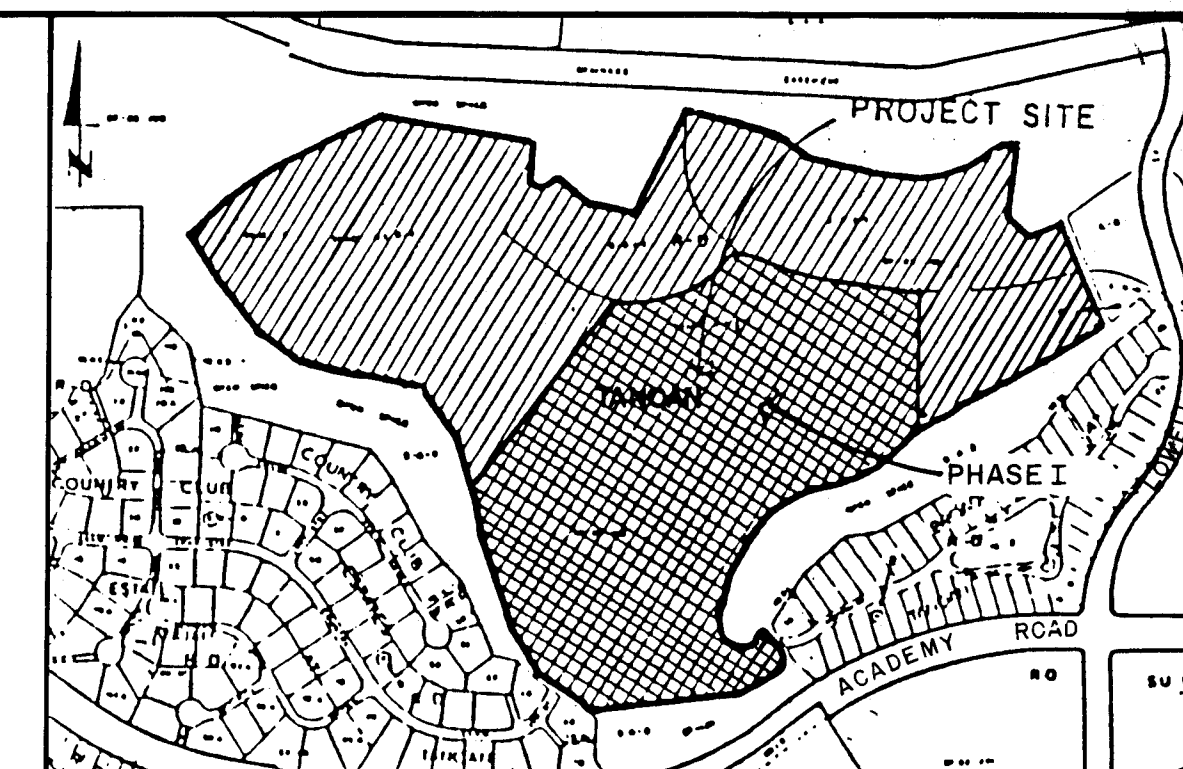


VICINITY MAP
NOT TO SCALE
ZONE ATLAS MAP E-22
GENERAL NOTES

NOTICE TO CONTRACTORS

- ALL WORK DETAILED ON THESE PLANS TO BE PERFORMED UNDER CONTRACT SHALL, EXCEPT AS OTHERWISE STATED OR PROVIDED FOR HEREON, BE CONSTRUCTED IN ACCORDANCE WITH CITY OF ALBUQUERQUE STANDARD SPECIFICATIONS FOR PUBLIC WORKS CONSTRUCTION, 1986 EDITION.
- TWO WORKING DAYS PRIOR TO ANY EXCAVATION, CONTRACTOR MUST CONTACT LINE LOCATING SERVICE, 765-1234, FOR LOCATION OF EXISTING UTILITIES.
- PRIOR TO CONSTRUCTION, THE CONTRACTOR SHALL EXCAVATE AND VERIFY THE HORIZONTAL AND VERTICAL LOCATIONS OF ALL OBSTRUCTIONS. SHOULD A CONFLICT EXIST, THE CONTRACTOR SHALL NOTIFY THE ENGINEER OR SURVEYOR SO THAT THE CONFLICT CAN BE RESOLVED WITH A MINIMUM AMOUNT OF DELAY.
- FORTY-EIGHT (48) HOURS PRIOR TO CONSTRUCTION, CONTRACTOR MUST CONTACT WATER SYSTEMS, 823-4200, FOR WATER SHUT OFF.

THE FOLLOWING NOTES ALSO APPLY WHEN CHECKED:


- ☒ ALL UTILITIES AND UTILITY SERVICE LINES SHALL BE INSTALLED PRIOR TO PAVING.
- ☒ BACKFILL COMPACTION SHALL BE ACCORDING TO SPECIFIED STREET USE.
- ☒ TACK COAT REQUIREMENTS SHALL BE DETERMINED BY THE CITY ENGINEER.
- ☒ SIDEWALKS AND WHEELCHAIR RAMPS WITHIN THE CURB RETURNS SHALL BE CONSTRUCTED WHEREVER A NEW CURB RETURN IS CONSTRUCTED.
- ☒ IF CURB IS DEPRESSED FOR A DRIVEPAD, THE DRIVEPAD SHALL BE CONSTRUCTED PRIOR TO ACCEPTANCE OF CURB AND GUTTER.
- ☒ ALL STORM DRAINAGE FACILITIES SHALL BE COMPLETED PRIOR TO FINAL ACCEPTANCE.
- ☒ THE REQUESTOR OR DEVELOPER SHALL BE RESPONSIBLE FOR REPAIR OR REPLACEMENT OF ALL CURB AND GUTTER OR SIDEWALK DAMAGED AFTER APPROVAL BY THE CITY ENGINEER OF WORK COMPLETED BY THE CONTRACTOR.

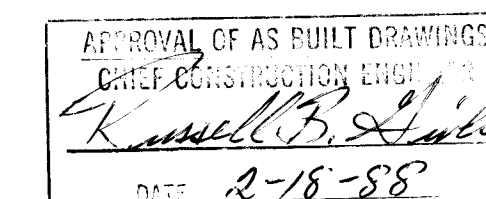

RECORD DRAWINGS
DATE 2/7/1988

1 2 3 4 5 6 7 8 9 10 11 12
26 24 7 9 0 1 8 8

REV	SHEETS	CITY ENGINEER	DATE	USER	DEPT	DATE	USER	DEPT	DATE
APPROVAL OF REVISIONS									

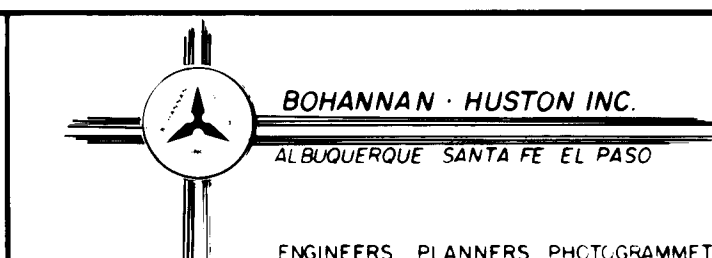

APPROVED FOR CONSTRUCTION
8-5-87 C.E.

PROJECT NUMBER

2479

SHEET 1 OF 29

ACS Brass Tablet "1-D22"

TRACT 0-1-A-1

OPEN SPACE 5-A-3-A

OPEN SPACE 5-A-3-B

TRACT K-3-A-1

TRACT K-3-B

LOCATION MAP
ZONE ATLAS MAP NO E-22

TANGENT DATA

NUMBER	BEARING	DISTANCE
T1	S02°10'41"W	133.14
T2	S31°28'13"W	178.22
T3	S54°40'09"E	238.93
T4	N77°46'17"E	153.90
T5	N77°46'17"E	20.48
T6	S24°41'23"E	155.70
T7	S24°41'26"E	27.27
T8	S59°45'52"W	100.00
T9	S58°22'35"W	70.34
T10	S57°47'22"W	66.32
T11	S62°53'17"W	45.00
T12	S62°53'17"W	30.07
T13	S63°09'36"W	86.89
T14	S62°55'41"W	106.53
T15	S64°52'20"W	86.91
T16	S59°15'44"W	128.65
T17	S45°12'24"W	65.80
T18	S45°12'24"W	99.13
T19	S57°36'33"W	68.47
T20	S67°37'12"W	65.84
T21	S77°05'36"W	115.72
T22	S71°24'01"W	20.18
T23	S59°25'26"W	115.55
T24	S34°08'32"W	125.03
T25	S26°33'34"W	119.95
T26	S49°30'54"W	933.62
T27	S19°42'35"W	74.77
T28	S11°35'12"E	116.47
T29	S83°08'49"W	34.66
T30	S83°08'49"W	33.25
T31	S83°08'49"W	98.90
T32	S43°29'51"W	33.25
T33	S31°24'01"W	114.44
T34	N58°35'59"W	52.18
T35	N38°17'10"W	109.66
T36	N21°12'57"W	101.57
T37	N19°45'60"W	250.41
T38	N10°09'59"W	126.90
T39	N14°30'18"W	90.41
T40	N17°37'16"W	160.22
T41	N38°56'51"W	188.32
T42	N79°22'55"W	114.90
T43	N80°47'42"W	280.43
T44	N56°34'56"W	122.77
T45	N42°48'23"W	82.30
T46	N39°06'52"W	135.62
T47	N30°33'07"W	70.64
T48	N33°17'58"W	136.79
T49	N45°16'37"E	148.74
T50	N53°20'45"E	156.73
T51	N59°17'30"E	205.59
T52	N66°53'42"E	194.52
T53	S80°50'49"E	511.74

CURVE DATA

NUMBER	ARC	RADIUS	DELTA	CHORD	TANGENT
C1	644.44	409.99	90°03'40"	580.12	410.43
C2	75.48	352.21	12°16'43"	75.33	37.88
C3	932.59	1801.16	29°39'58"	922.21	477.00
C4	29.64	133.38	12°43'55"	29.58	14.88
C5	46.60	166.62	16°01'21"	46.44	23.45
C6	39.27	25.00	90°00'00"	35.36	25.00
C7	39.27	25.00	90°00'00"	35.36	25.00
C8	205.09	233.38	50°21'02"	198.55	109.69
C9	33.99	25.00	77°54'10"	31.43	20.21

COUNTRY
CLUB
ESTATESTHE BROADMOOR
AT TANOAN

SURVEY NOTES

- Unless otherwise noted, all boundary corners shown (•) have been marked by a #5 rebar with plastic cap stamped "P.L.S. #6544".
- All street centerline points shown (Δ) will be marked by a 4" aluminum disk stamped "P.L.S. 6544".
- Boundary will be tied to the New Mexico State Plane Coordinate System as shown.
- Basis of bearings will be NMSP grid bearings.
- Distances will be ground distances.

APPROVED FOR MONUMENTATION AND STREET NAMES

L. Monte Arbores 4/13/87
CITY SURVEYOR DATE

NOTES

TOTAL ACREAGE 50.9772 ACRES

PROPOSED NUMBER OF LOTS: 129

72 LOTS - 55' x 100' (MINIMUM)

57 LOTS - 65' x 100' (MINIMUM)

ZONING IS R-D

SETBACKS CONFORM TO THOSE OF THE R-1 ZONE, SECTION 10.E.3.b

*ALL LOTS ON NORTH SOUTH STREETS MUST CONFORM TO REQUIREMENT OF SECTION 40.C.1.G FOR SOLAR ACCESS.


ALL STREETS & COMMON LANDSCAPED AREAS WILL BE PRIVATE, TO BE MAINTAINED BY THE HOMEOWNERS ASSOCIATION. ALL UNDERGROUND UTILITIES & DRAINAGE FACILITIES WILL BE PUBLIC, TO BE ACCEPTED FOR MAINTENANCE BY THE CITY OF ALBUQUERQUE.

ALL SURFACE DRAINAGEWAYS WILL BE MAINTAINED BY THE HOMEOWNERS ASSOCIATION EXCEPT FOR THE INTERIM EARTHEN CHANNEL WHICH WILL BE MAINTAINED BY THE DEVELOPER.

PRELIMINARY PLAT
FOR
DESERT CLASSIC
UNIT 11 2 3 4 5 6 7 8 9 10 11 12
26 24790288



ACS Brass Tablet "6-E22"

APRIL, 1987

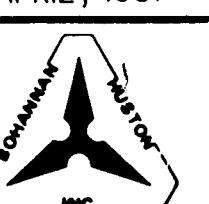

BHI JOB NO. 71260


SUBDIVISION MAP FOR
DESERT CLASSIC
AT TANOAN SUBDIVISION
ALBUQUERQUE, NEW MEXICO
APRIL, 1987

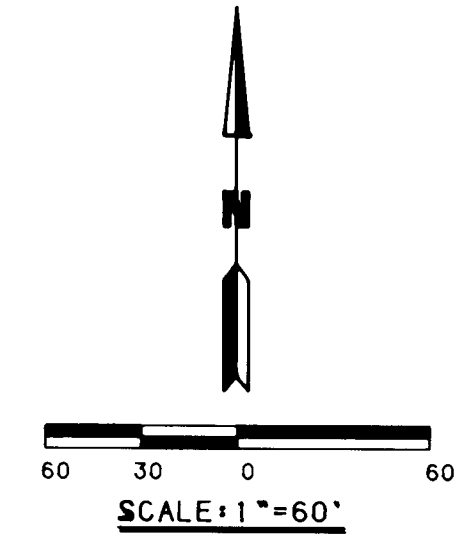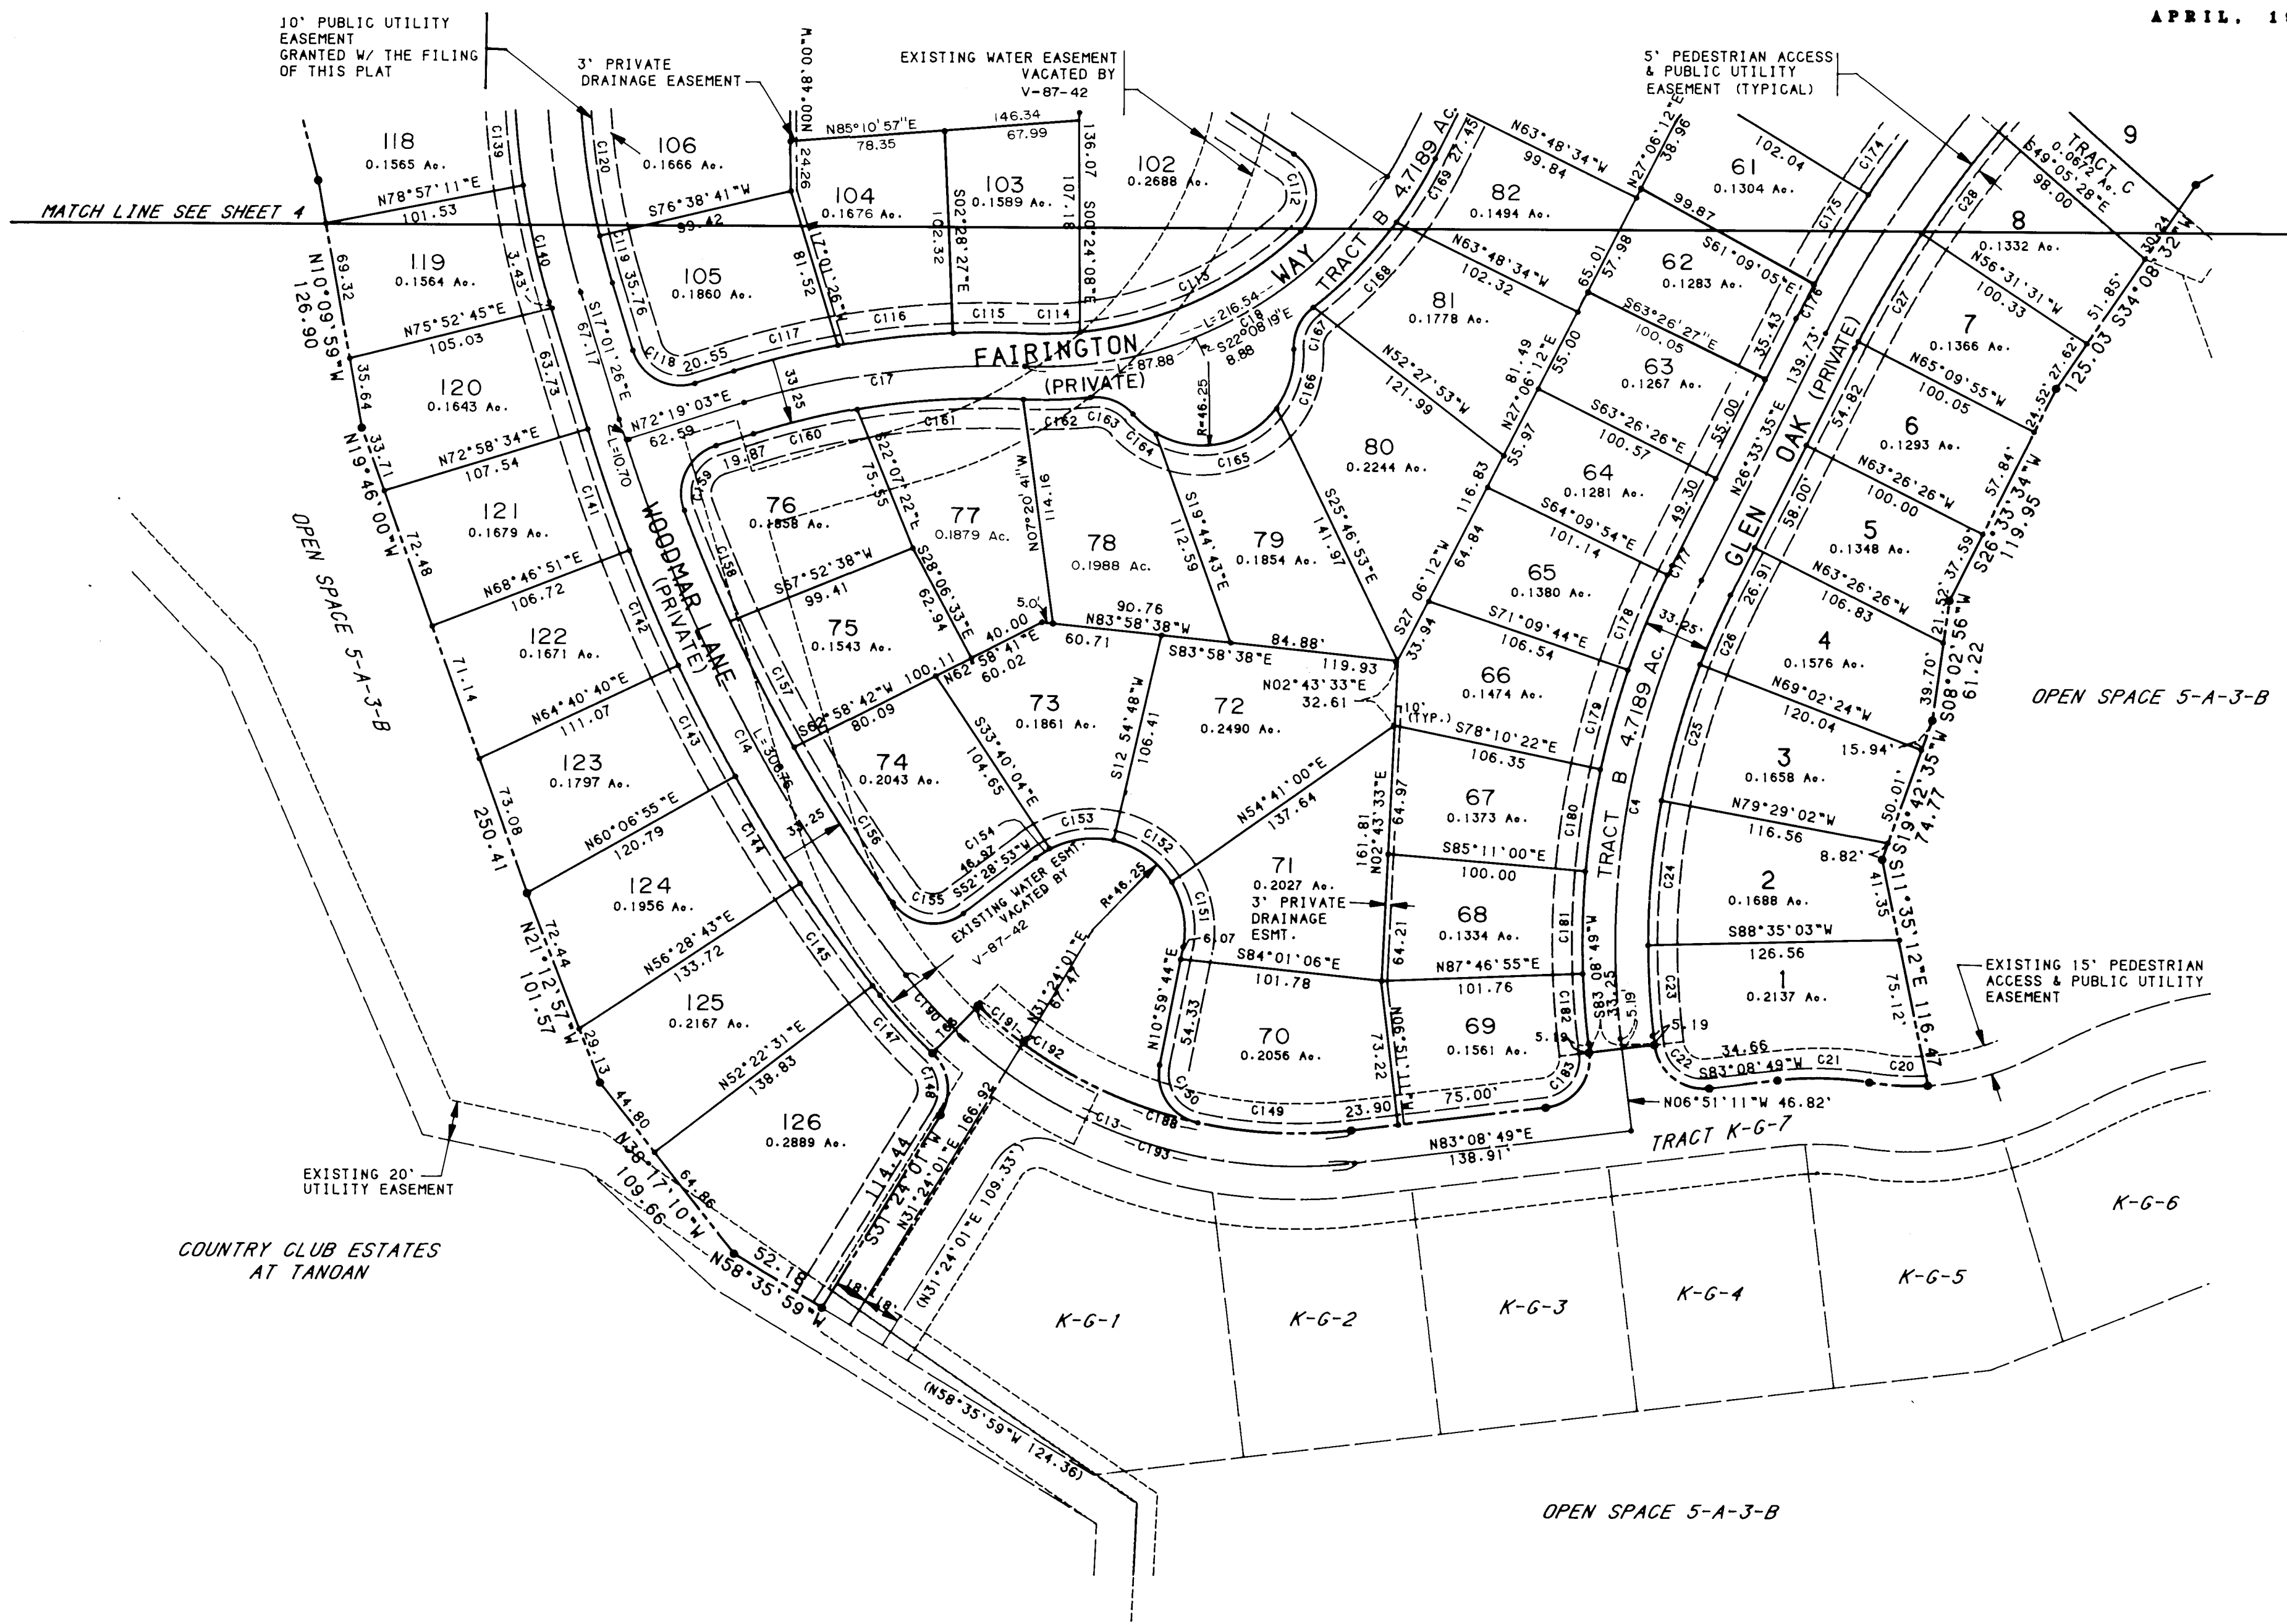



26 24 7 9 0 4 8 8

JOB NO. 71262

SHEET 3 OF 6 SHEET

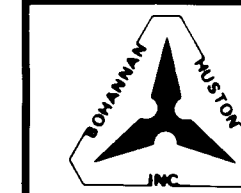


SUBDIVISION MAP FOR
DESERT CLASSIC
AT TANOAN SUBDIVISION
ALBUQUERQUE, NEW MEXICO
APRIL, 1987

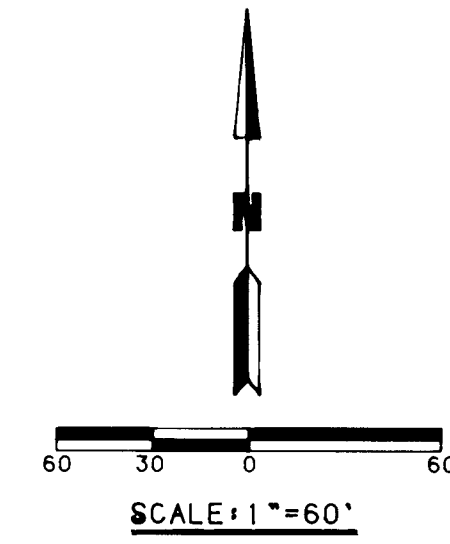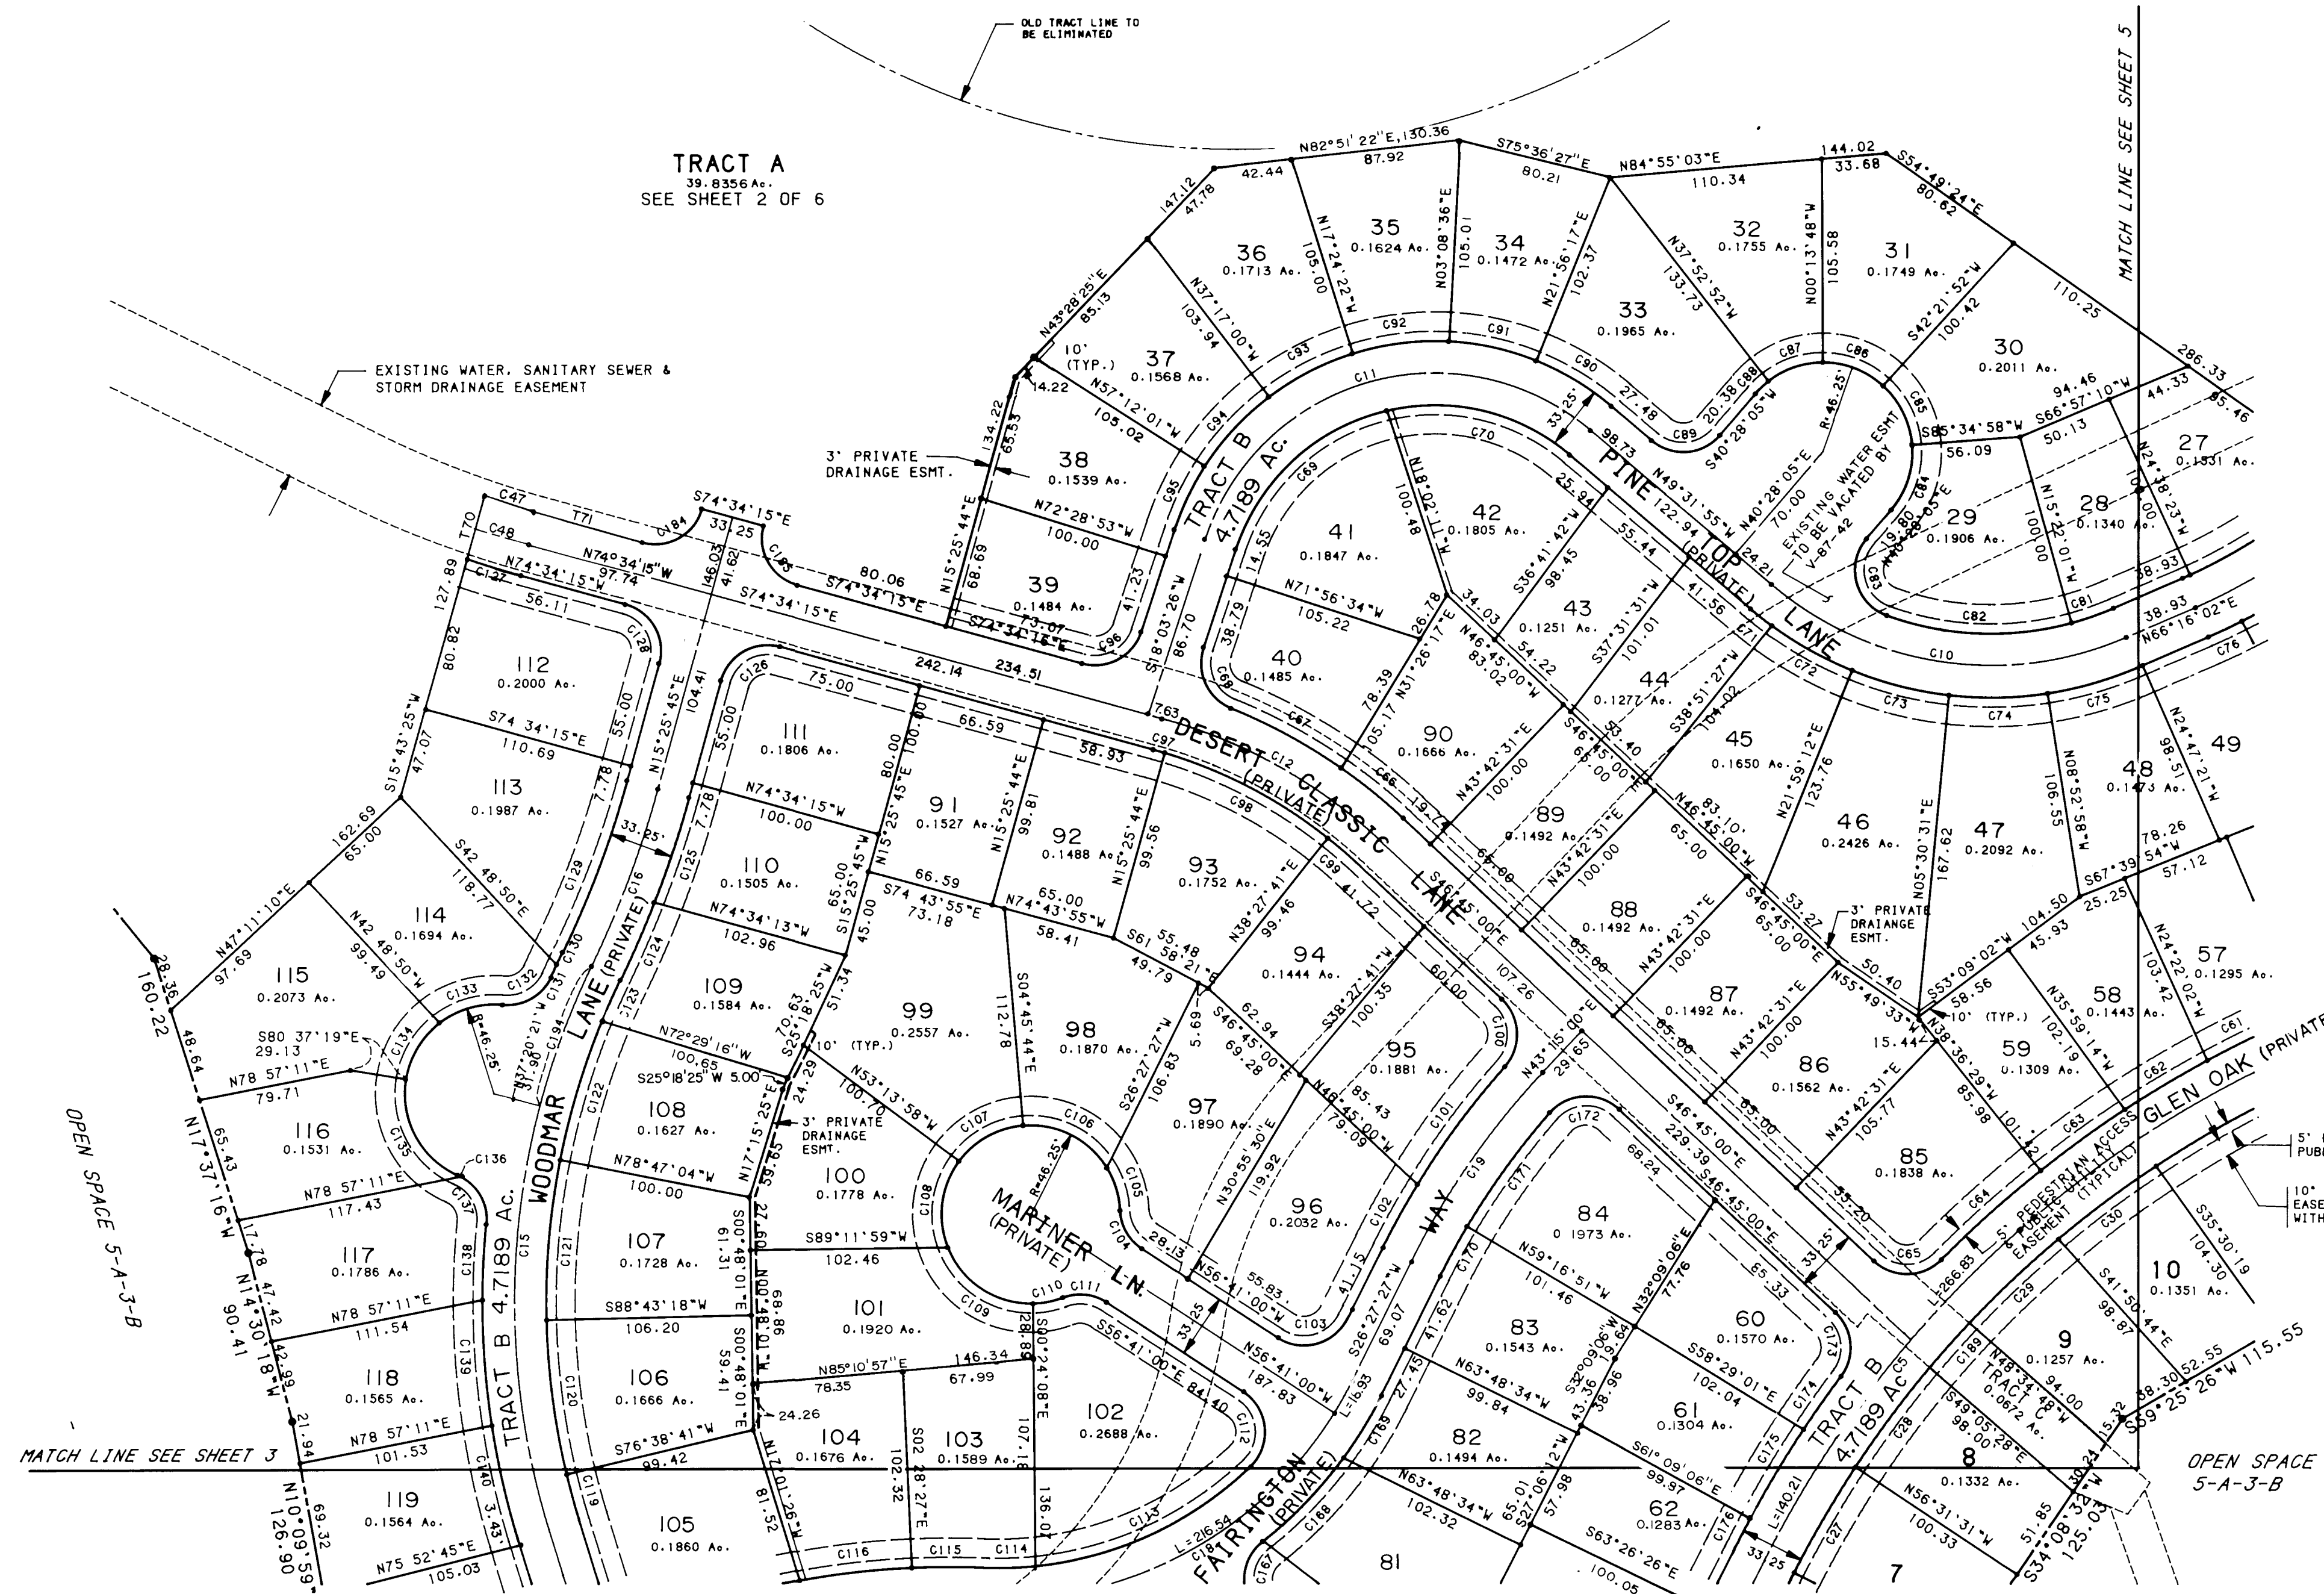


JOB NO. 71262


SHEET 4 OF 6 SHEETS

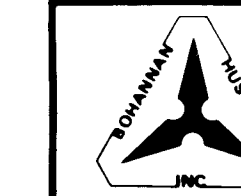

APRIL, 1987

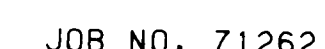

SHEET 5 OF 6 SHEETS

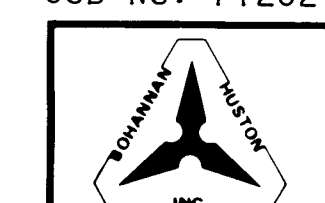


APRIL, 1987

NUMBER	BEARING	DISTANCE
11	N30°55'50"E	52.18
12	N30°55'50"E	52.18
13	N10°55'50"E	101.90
14	N10°55'50"E	101.90
15	N47°25'50"E	126.87
16	N47°25'50"E	126.87
17	N17°35'50"E	180.22
18	N17°35'50"E	180.22
19	N20°25'50"E	144.96
20	N20°25'50"E	144.96
21	N52°34'50"E	122.57
22	N52°34'50"E	122.57
23	N30°56'50"E	52.27
24	N30°56'50"E	52.27
NUMBER	TIME
C12	45.82
C13	45.82
C14	45.82
C192	45.82

CYBER	ARC	RADIUS	DELTA	CHORD	CHORD BEARING	TANGENT
C98	36.44	144.1444333	36.44	36.44	36.44	36.44
C99	38.12	25.00	77.2129149	34.54	581.4433536	43.88
C100	38.12	25.00	77.2129149	34.54	581.4433536	43.88
C98	95.78	253.36	26.7152240	95.21	582.220404E	28.47
C99	95.78	253.36	26.7152240	95.21	582.220404E	28.47
C100	95.78	253.36	26.7152240	95.21	582.220404E	28.47
C101	38.61	25.00	88.5805808	34.88	580.503343E	24.35
C102	38.61	25.00	88.5805808	34.88	580.503343E	24.35
C103	42.26	42.62	50.1571477	34.58	582.5882121E	18.74
C104	42.26	42.62	50.1571477	34.58	582.5882121E	18.74
C105	23.35	25.00	54.1354250	22.80	580.9333244E	12.81
C106	23.35	25.00	54.1354250	22.80	580.9333244E	12.81
C107	39.13	46.25	64.2516608	48.61	565.033262E	28.37
C108	39.13	46.25	64.2516608	48.61	565.033262E	28.37
C109	36.27	46.25	58.8425400	45.21	580.503422E	25.35
C110	36.27	46.25	58.8425400	45.21	580.503422E	25.35
C111	23.67	46.25	59.2929044	45.15	585.8784822E	7.16
C112	23.67	46.25	59.2929044	45.15	585.8784822E	7.16
C113	124.76	187.88	10.8249482	39.88	585.161009E	51.33
C114	124.76	187.88	10.8249482	39.88	585.161009E	51.33
C115	37.06	46.25	61.8167404	47.25	588.822110E	13.26
C116	37.06	46.25	61.8167404	47.25	588.822110E	13.26
C117	54.28	46.25	75.5406708	58.65	583.3433120E	29.40
C118	54.28	46.25	75.5406708	58.65	583.3433120E	29.40
C119	24.55	383.34	90.3033308	35.26	586.211210E	23.49
C120	24.55	383.34	90.3033308	35.26	586.211210E	23.49
C121	83.60	383.37	25.0438388	80.86	580.1910101E	40.86
C122	83.60	383.37	25.0438388	80.86	580.1910101E	40.86
C123	26.63	383.37	17.1446788	27.28	581.8212020E	37.92
C124	26.63	383.37	17.1446788	27.28	581.8212020E	37.92
C125	57.33	514.02	5.5051301	44.01	602.3812034E	22.62
C126	57.33	514.02	5.5051301	44.01	602.3812034E	22.62
C127	39.13	514.02	29.1163888	35.36	580.2504525E	25.69
C128	39.13	514.02	29.1163888	35.36	580.2504525E	25.69
C129	95.27	520.77	90.0000000	35.36	582.393141E	25.00
C130	95.27	520.77	90.0000000	35.36	582.393141E	25.00
C131	6.68	416.63	0.5108878	7.17	525.251251E	3.59
C132	6.68	416.63	0.5108878	7.17	525.251251E	3.59
C133	34.77	46.25	45.0454088	29.30	559.922247E	18.08
C134	34.77	46.25	45.0454088	29.30	559.922247E	18.08
C135	60.90	46.25	75.2630308	34.11	531.1011070E	18.35
C136	60.90	46.25	75.2630308	34.11	531.1011070E	18.35
C137	29.85	46.25	68.8855558	33.10	584.311201E	0.67
C138	29.85	46.25	68.8855558	33.10	584.311201E	0.67
C139	65.37	416.62	8.5824348	39.30	580.9012809E	9.87
C140	65.37	416.62	8.5824348	39.30	580.9012809E	9.87
C141	64.85	882.80	41.14333	60.80	512.5212527E	30.23
C142	64.85	882.80	41.14333	60.80	512.5212527E	30.23
C143	63.18	882.80	40.06000	63.31	523.6112141E	31.63
C144	63.18	882.80	40.06000	63.31	523.6112141E	31.63
C145	63.23	882.80	40.06102	63.35	531.281287E	31.60
C146	63.23	882.80	40.06102	63.35	531.281287E	31.60
C147	39.47	866.63	8.286533	39.43	532.4912871E	3.05
C148	39.47	866.63	8.286533	39.43	532.4912871E	3.05
C149	77.80	233.37	10.96044	77.44	503.733264E	20.21
C150	77.80	233.37	10.96044	77.44	503.733264E	20.21
C151	34.71	46.25	45.2221000	33.43	533.1011070E	34.44
C152	34.71	46.25	45.2221000	33.43	533.1011070E	34.44
C153	33.03	46.25	40.945338	32.34	534.1912171E	19.52
C154	33.03	46.25	40.945338	32.34	534.1912171E	19.52
C155	40.23	25.00	91.441233	35.89	581.121201E	25.77
C156	40.23	25.00	91.441233	35.89	581.121201E	25.77
C157	71.44	849.83	4.40033	71.42	502.973277E	46.55
C158	71.44	849.83	4.40033	71.42	502.973277E	46.55
C159	40.55	25.00	95.96411	36.25	535.191201E	30.35
C160	40.55	25.00	95.96411	36.25	535.191201E	30.35
C161	84.45	392.37	12.51954	84.29	586.820000E	26.92
C162	84.45	392.37	12.51954	84.29	586.820000E	26.92
C163	23.99	25.00	54.58466	23.88	584.450000E	10.98
C164	23.99	25.00	54.58466	23.88	584.450000E	10.98
C165	88.03	46.25	84.61558	62.05	577.561120E	41.85
C166	88.03	46.25	84.61558	62.05	577.561120E	41.85
C167	23.99	25.00	54.58465	23.88	584.248874E	16.23
C168	23.99	25.00	54.58465	23.88	584.248874E	16.23
C169	37.75	25.00	67.47335	37.70	581.311201E	30.49
C170	37.75	25.00	67.47335	37.70	581.311201E	30.49
C171	73.19	363.38	10.39388	73.08	582.880000E	14.66
C172	73.19	363.38	10.39388	73.08	582.880000E	14.66
C173	36.49	25.00	83.37044	36.33	554.563612E	25.83
C174	36.49	25.00	83.37044	36.33	554.563612E	25.83
C175	53.85	589.63	51.15057	53.81	530.94874E	18.84
C176	53.85	589.63	51.15057	53.81	530.94874E	18.84
C177	5.38	425.62	0.43287	5.38	526.61141E	26.02
C178	5.38	425.62	0.43287	5.38	526.61141E	26.02
C179	52.08	425.62	7.00038	52.05	531.191397E	9.28
C180	52.08	425.62	7.00038	52.05	531.191397E	9.28
C181	51.84	425.62	6.58433	51.81	501.191393E	26.07
C182	51.84	425.62	6.58433	51.81	501.191393E	26.07
C183	39.27	25.00	90.00101	35.38	538.08084E	25.00
C184	39.27	25.00	90.00101	35.38	538.08084E	25.00
C185	39.27	25.00	90.00101	35.38	539.94134E	25.00
C186	39.27	25.00	90.00101	35.38	539.94134E	25.00
C187	39.27	25.00	85.41111	34.90	531.158484E	25.00
C188	39.27	25.00	85.41111	34.90	531.158484E	25.00
C189	36.87	80.00	132.91154	36.81	518.845528E	169.66
C190	36.87	80.00	132.91154	36.81	518.845528E	169.66
C191	124.71	573.00	12.28511	124.66	535.95171E	85.91

JOB NO. 71262

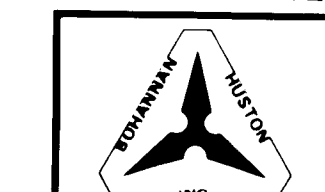


SHEET 6 OF 6 SHEETS

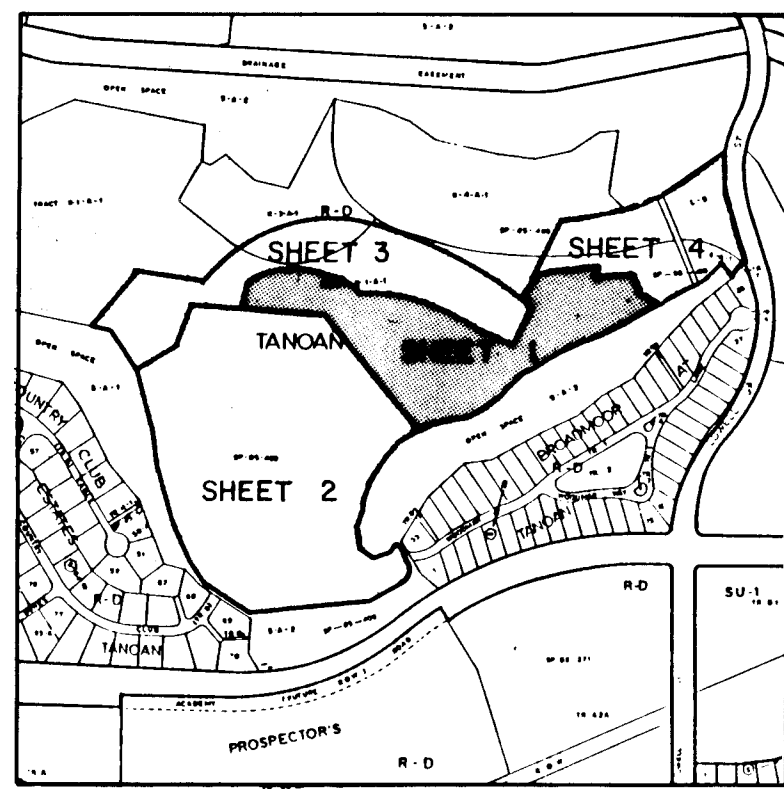

GRADING MAP KEY

DESERT CLASSIC AT TANOAN
FUTURE PHASE II

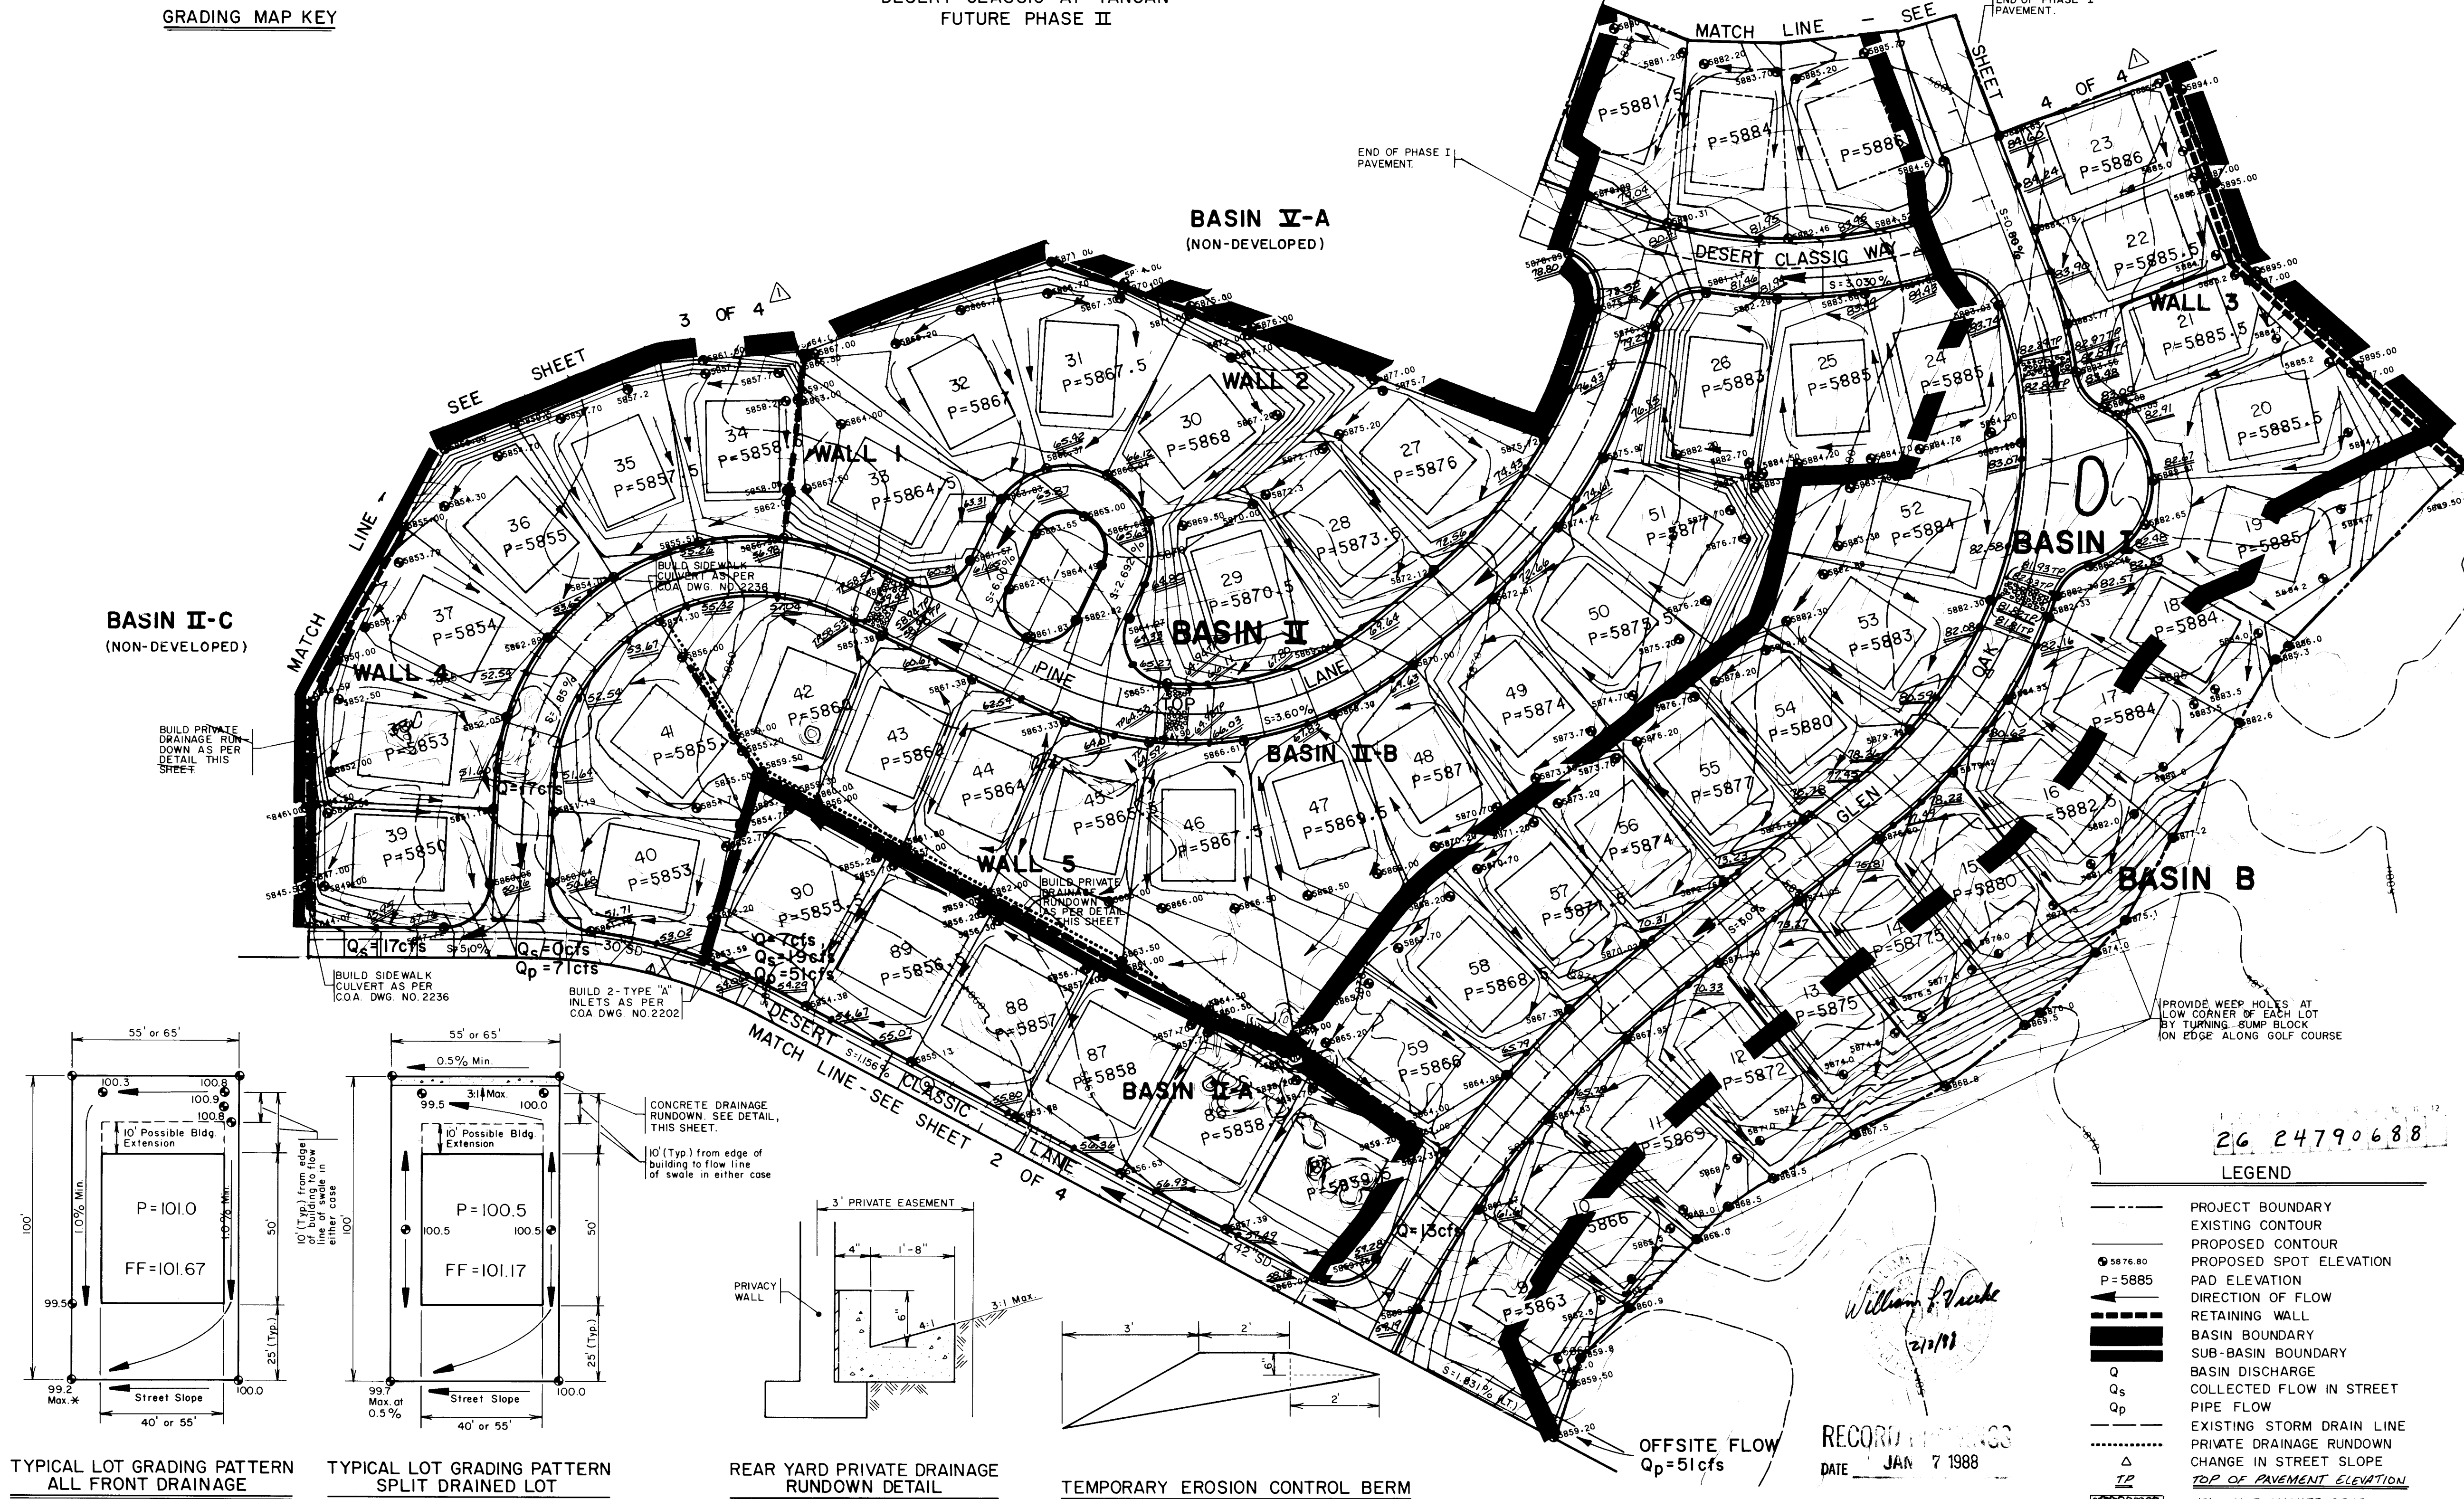

TYPICAL LOT GRADING PATTERN
ALL FRONT DRAINAGE

TYPICAL LOT GRADING PATTERN
SPLIT DRAINED LOT

REAR YARD PRIVATE DRAINAGE
RUNDOWN DETAIL

TEMPORARY EROSION CONTROL BERM
(TO BE PLACED ACROSS EACH LOT AT STREET
SIDES)

FOR INFORMATION ONLY

NOTE
I. CONTRACTOR MUST OBTAIN A TOPSOIL
DISTURBANCE PERMIT FROM CITY ENVIRO-
NMENTAL HEALTH DEPARTMENT.

EARTHWORK SPECIFICATIONS

GENERAL
The Soils Engineer shall be the Owner's
representative to control the earthwork
placement, moisture content, and compaction.
The Soils Engineer shall approve the materials,
the method of placing and compaction, and shall
give written approval of the completed fill.

CLEARING AREAS TO BE FILLED
All timber, logs, trees, brush, stumps,
trash, sod, matted roots and roots larger than
two (2) inches in diameter shall be removed,
piled, or otherwise disposed of. All rocks,
cobble and boulders larger than six (6) inches
in diameter shall be removed or otherwise
disposed of at the direction of the Soils
Engineer.

SCARPING AREA TO BE FILLED
The surface shall be plowed or scarified to
a depth of at least six (6) inches and smoothed
until the surface is free from ruts, hummocks,
and other uneven features, which would tend to
prevent uniform compaction from the equipment to
be used.

Where fill is to be placed on hillside or
slopes, the slope of the original ground upon
which the fill is to be placed shall be plowed
or scarified deeply where the slope ratio of
the ground is steeper than 3:1, the bank shall
be sloped or benched.

Stripplings may be placed along rear lot
lines and in rear areas where no foundation or
slope will be constructed. All stripplings shall
be free of logs, trees, timber, trash and rocks
greater than six (6) inches. Stripplings will be
placed subsequent to the placement of all
structurally controlled fill, and to a depth no
greater than six (6) inches, except in designated areas.

PREPARATION OF AREA TO BE FILLED
After the foundation for the fill has been
cleared, any frozen material removed, and it has
been plowed or scarified, it shall be placed or
bladed until it is uniform and free from large
clods, brought to optimum moisture content (w/ 26),
for a minimum of five (5) feet, or for as
deep as practicable as determined by the Soils
Engineer, and compacted with a minimum of twenty
(20) passes using a minimum 20 ton vibratory
compactor to a minimum of 95% of maximum density
as determined by ASTM D-1557.

TREATMENT OF CUT SECTIONS
Subsequent to the final grading in cut
sections, the ground surface shall be plowed or
scarified, and brought to optimum moisture content
(w/ 26), for a minimum of five (5)
feet, or for as deep as practicable as
determined by the Soils Engineer. The ground
surface shall then be compacted with a minimum
of twenty (20) passes using a minimum 20 ton
vibratory compactor to a minimum of 95% of
maximum density as determined by ASTM D-1557.

FILL MATERIALS
Materials for the fill shall consist of
material selected or approved by the Soils
Engineer. The materials used shall be free
vegetable matter, frozen material and other
deteriorative substance and shall not contain
rocks or lumps which have a diameter of more
than six (6) inches and shall have a liquid
limit not greater than thirty (30) and a
plasticity index not greater than twelve (12).
It is anticipated that a borrow from the site
will be satisfactory.

DEPTH AND MIXING OF FILL LAYERS
The selected fill material shall be placed
in layers which, when compacted shall not exceed
six (6) inches. Each layer shall be spread
evenly and shall be thoroughly mixed during
the spreading to insure uniformity of material in
each layer.

ROCK
When the fill material includes rock, no
large rock shall be allowed to seat and all
voids must be carefully filled with small stones
or earth, properly compacted. No larger clods
(maximum size six (6) inches) will be permitted
closer than twelve (12) inches below the
finished grade.

MOISTURE CONTENT
The fill material shall be compacted at the
optimum moisture content (w/ 26) specified for
soils. Sufficient laboratory moisture density
relationship tests will be made to determine the
optimum moisture content for the various soils
encountered in the borrow area. The Contractor
may be required to add the necessary moisture to
the fill material in the borrow area if, in the
opinion of the Soils Engineer, it is not
possible to obtain uniform moisture content by
adding water to the fill surface.

CONTINUED ON SHEET 2 OF 4

APPROVED FOR ROUGH GRADING !!

Calvin M. Mott
HYDROLOGY ENGINEER
DATE 5-27-17

CITY OF ALBUQUERQUE
PUBLIC WORKS
ENGINEERING

TITLE DESERT CLASSIC AT TANOAN - PHASE I
DRAINAGE/GRADING PLAN


NORTH HALF			
APPROVALS	ENGINEER	DATE	ENGINEER
City Engineer			
A.C.E. Design	DATE 1-24-17	Liquid Waste	DATE 1-24-17
A.C.E. Hydrology	DATE 1-24-17	Traffic	DATE 1-24-17
		Water	DATE 1-24-17

DRAWING NO. 2479 MAP NO. E-22 SHEET 1 OF 4

8A 29


BASIN II

DESERT CLASSIC AT TANOAN
FUTURE PHASE II

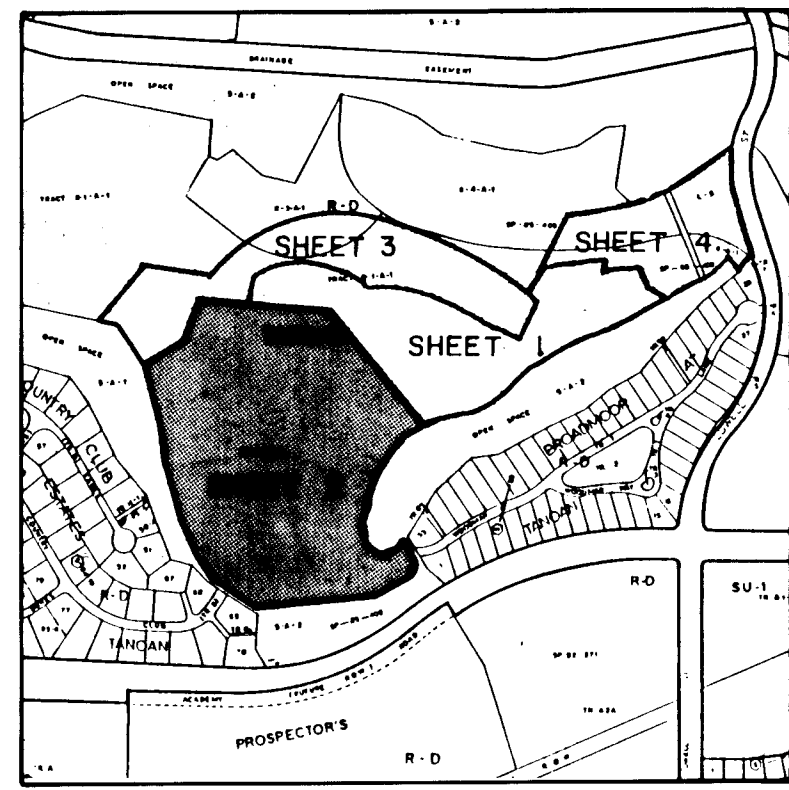


GRADING MAP KEY


BASIN I-C
(NON-DEVELOPED)

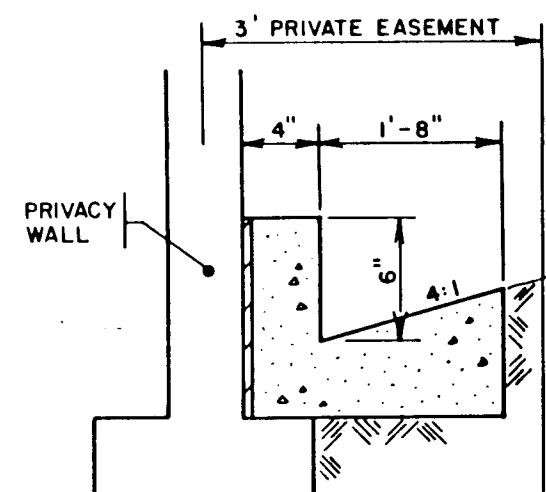

REAR YARD PRIVATE DRAINAGE
RUNDOWN DETAIL

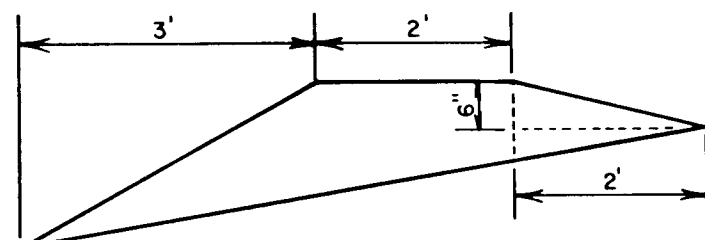


TEMPORARY EROSION CONTROL BERM
(TO BE PLACED ACROSS EACH LOT AT STREET
SIDES)

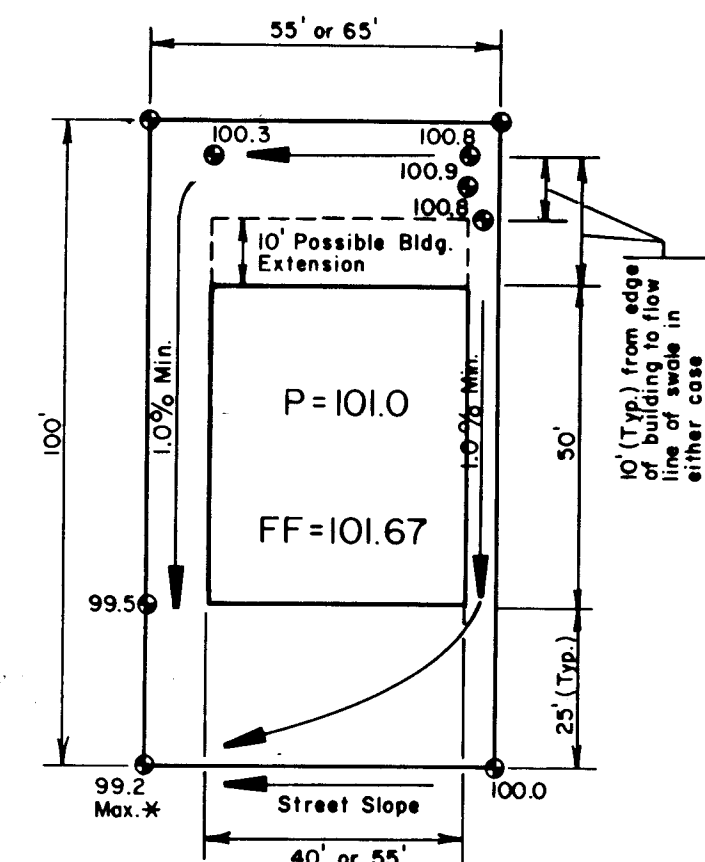


TYPICAL LOT GRADING PATTERN
ALL FRONT DRAINAGE

* FOR STREET SLOPES $\leq 1.5\%$ (55' Lot)
or $\leq 1.2\%$ (65' Lot) INCREASE LOT
ELEVATIONS 0.5'

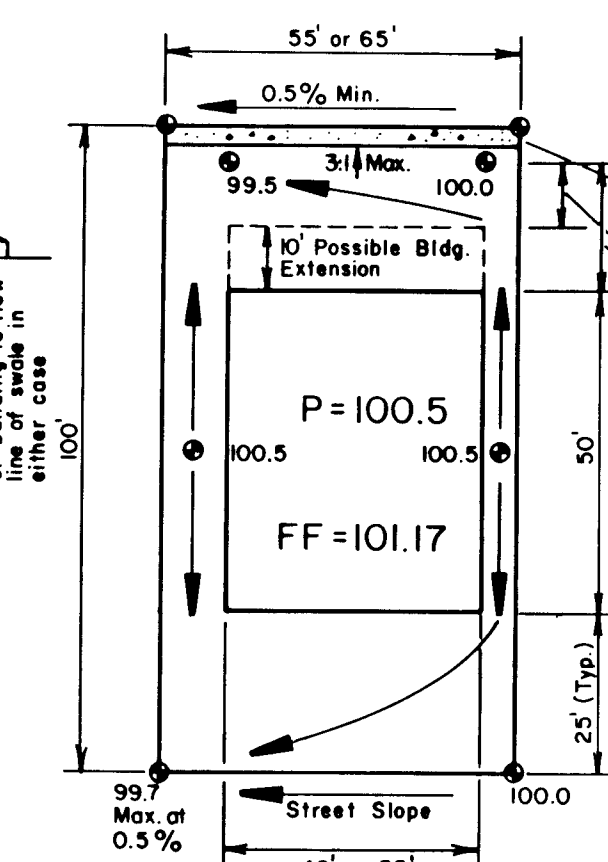


TYPICAL LOT GRADING PATTERN
SPLIT DRAINED LOT


CONCRETE DRAINAGE
RUNDOWN SEE DETAIL,
THIS SHEET.

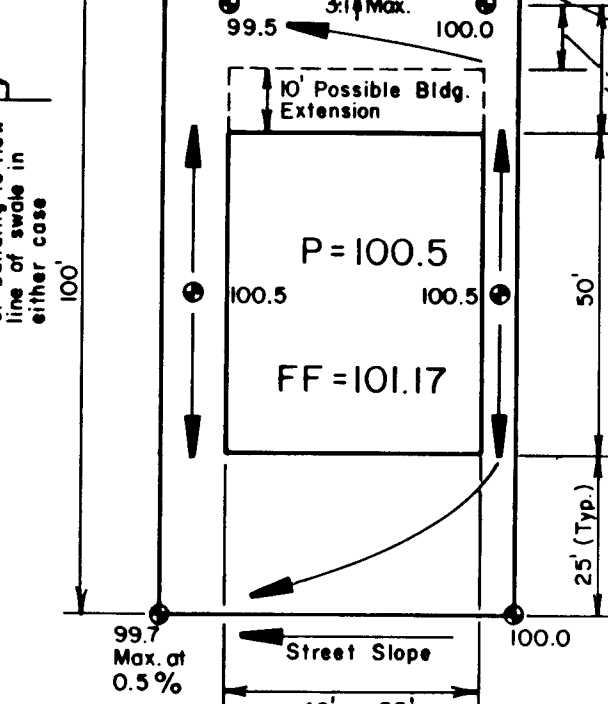


TYPICAL LOT GRADING PATTERN
SPLIT DRAINED LOT

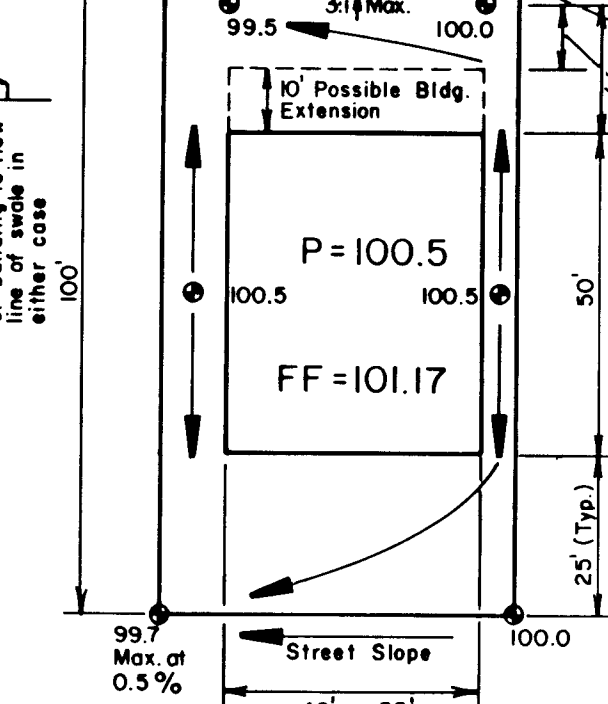


TYPICAL LOT GRADING PATTERN
SPLIT DRAINED LOT

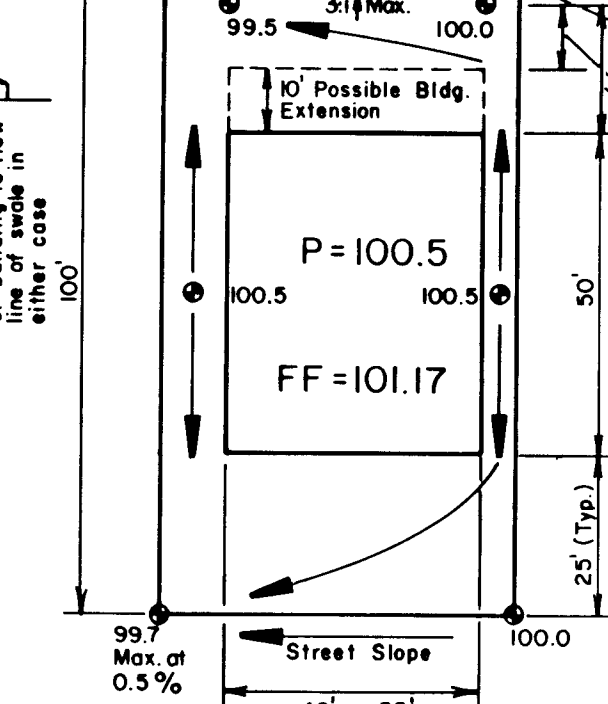


TYPICAL LOT GRADING PATTERN
SPLIT DRAINED LOT

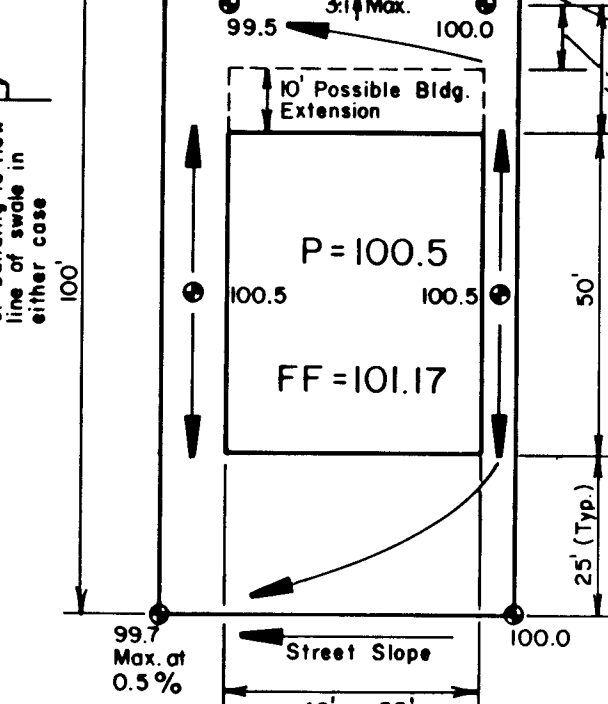


TYPICAL LOT GRADING PATTERN
SPLIT DRAINED LOT

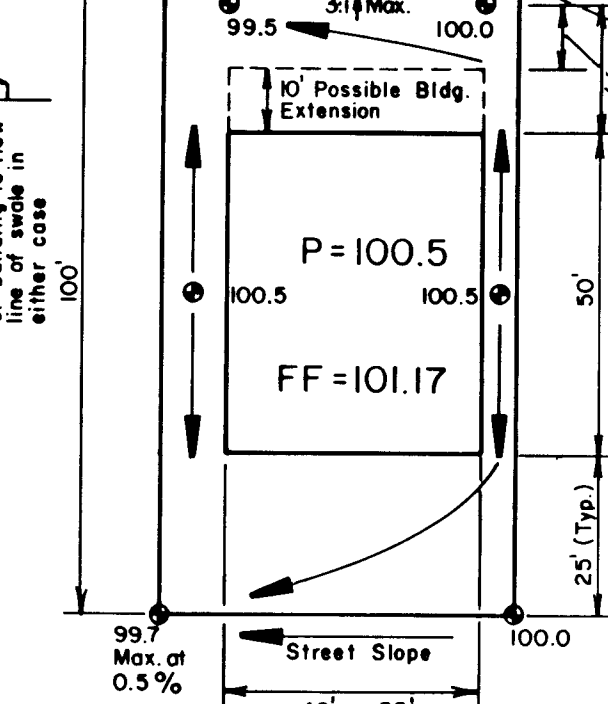


TYPICAL LOT GRADING PATTERN
SPLIT DRAINED LOT

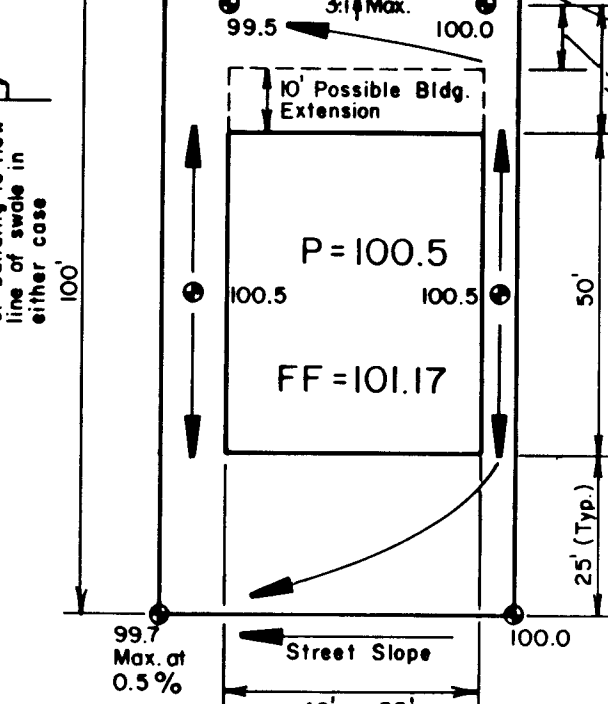


TYPICAL LOT GRADING PATTERN
SPLIT DRAINED LOT

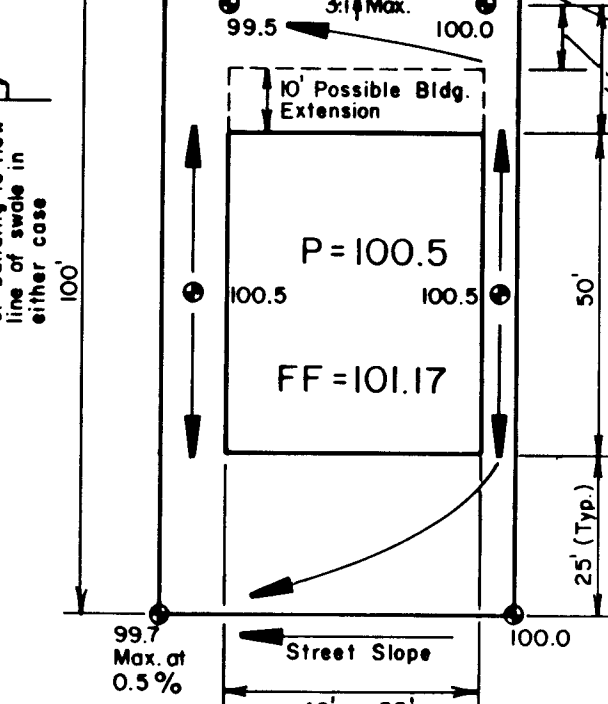


TYPICAL LOT GRADING PATTERN
SPLIT DRAINED LOT

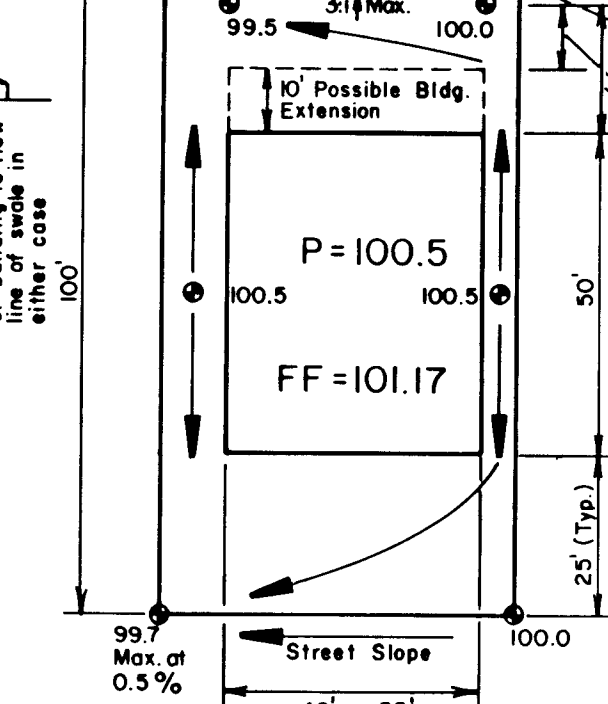


TYPICAL LOT GRADING PATTERN
SPLIT DRAINED LOT

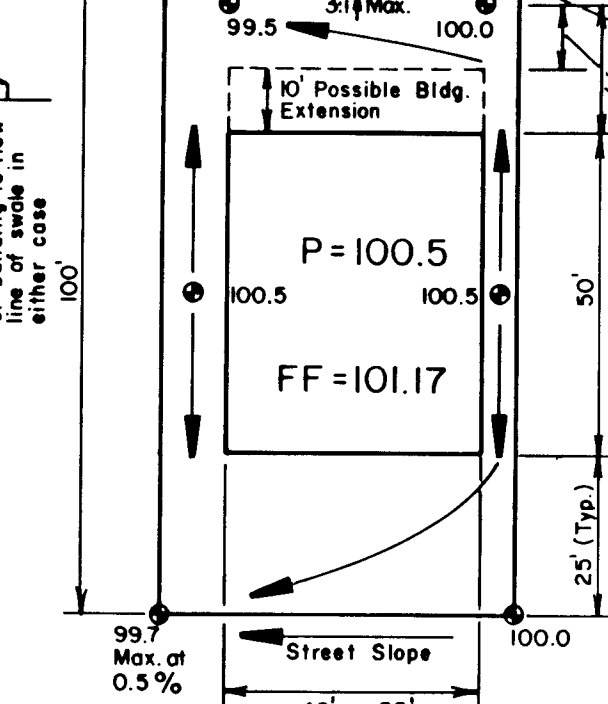


TYPICAL LOT GRADING PATTERN
SPLIT DRAINED LOT

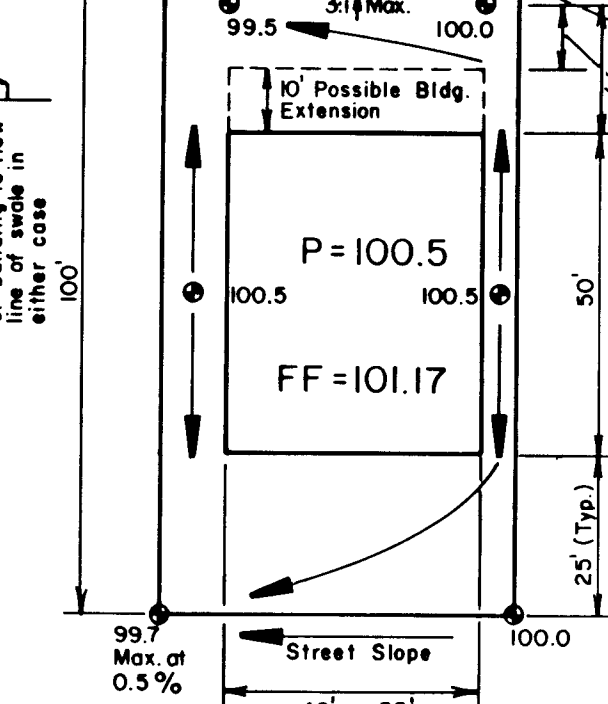


TYPICAL LOT GRADING PATTERN
SPLIT DRAINED LOT

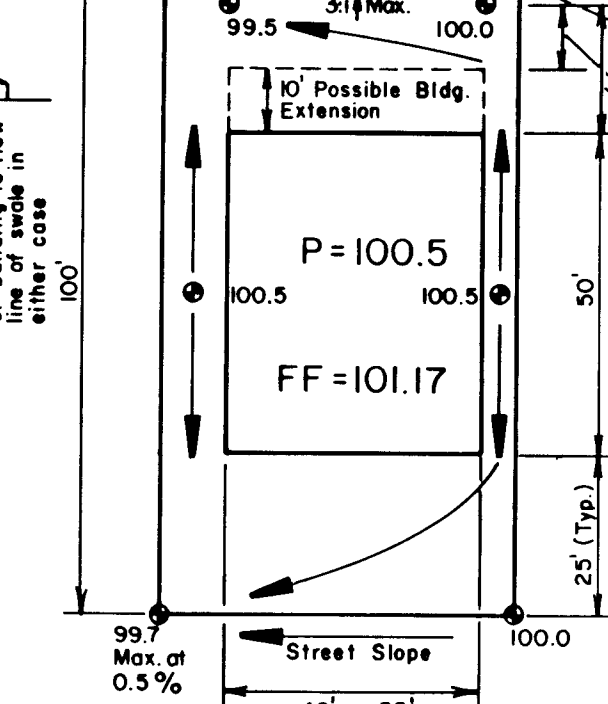


TYPICAL LOT GRADING PATTERN
SPLIT DRAINED LOT

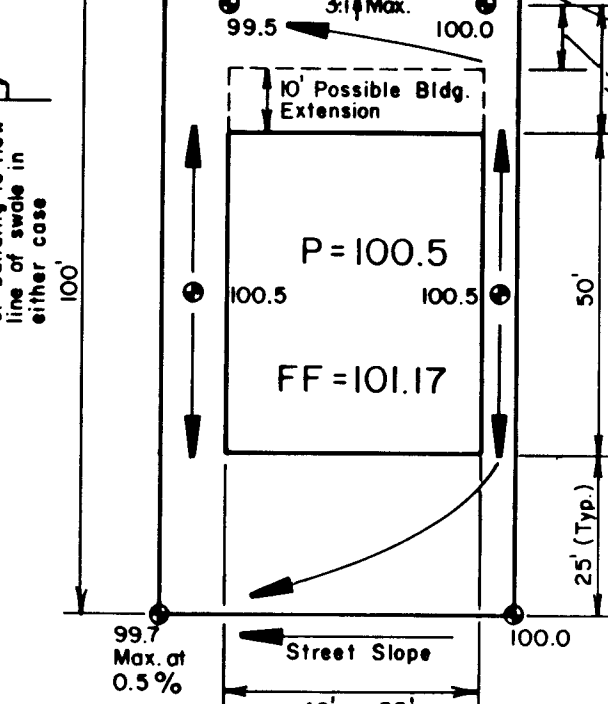


TYPICAL LOT GRADING PATTERN
SPLIT DRAINED LOT

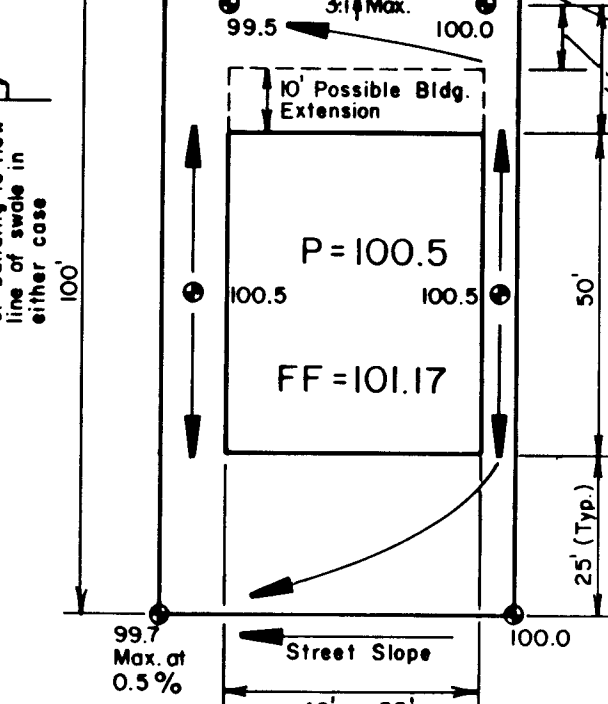


TYPICAL LOT GRADING PATTERN
SPLIT DRAINED LOT

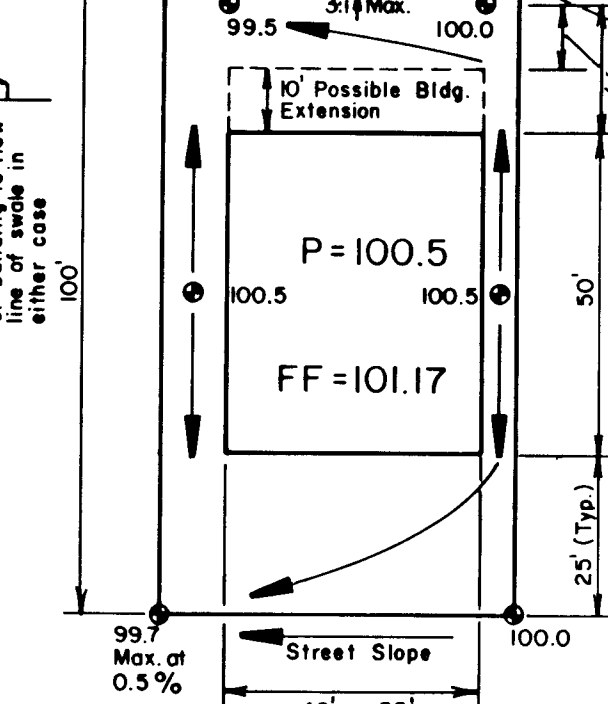


TYPICAL LOT GRADING PATTERN
SPLIT DRAINED LOT

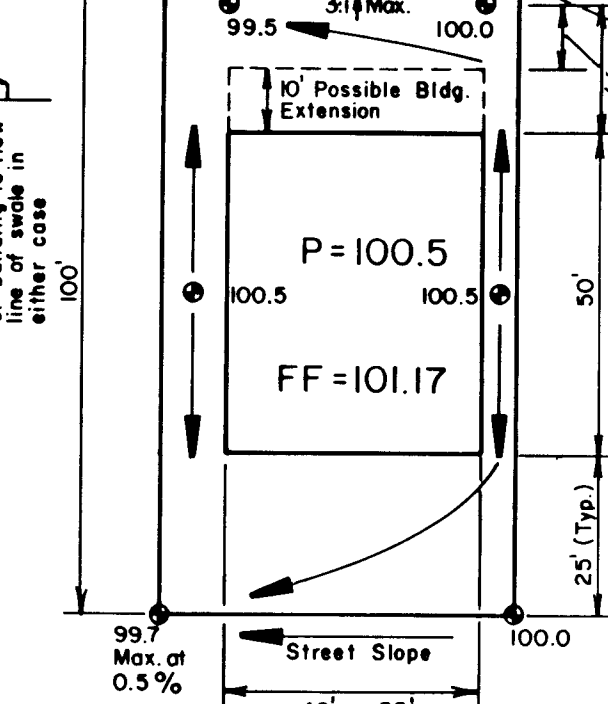


TYPICAL LOT GRADING PATTERN
SPLIT DRAINED LOT

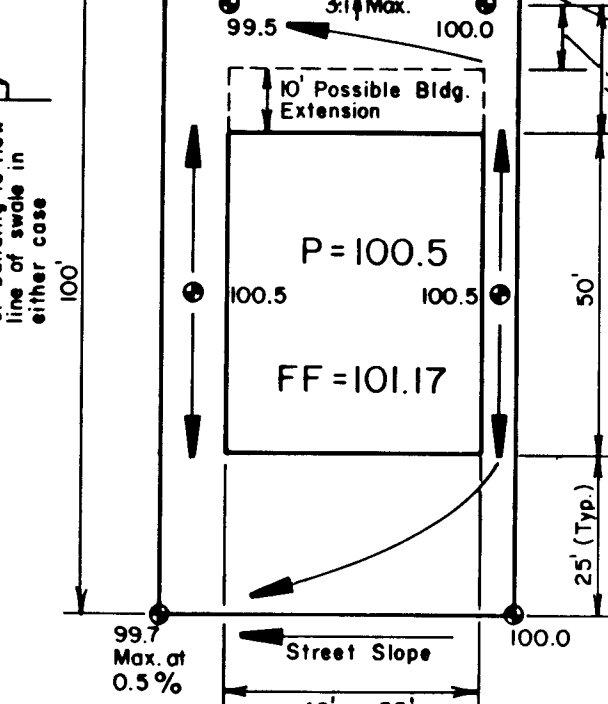


TYPICAL LOT GRADING PATTERN
SPLIT DRAINED LOT

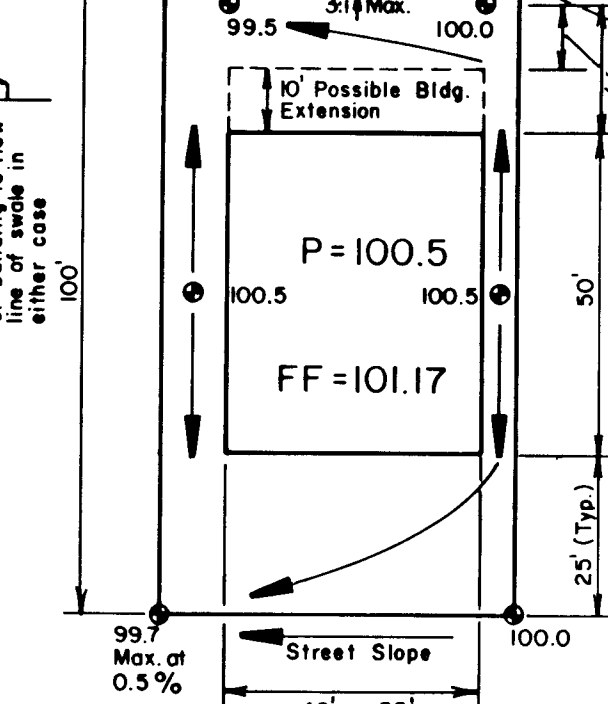


TYPICAL LOT GRADING PATTERN
SPLIT DRAINED LOT

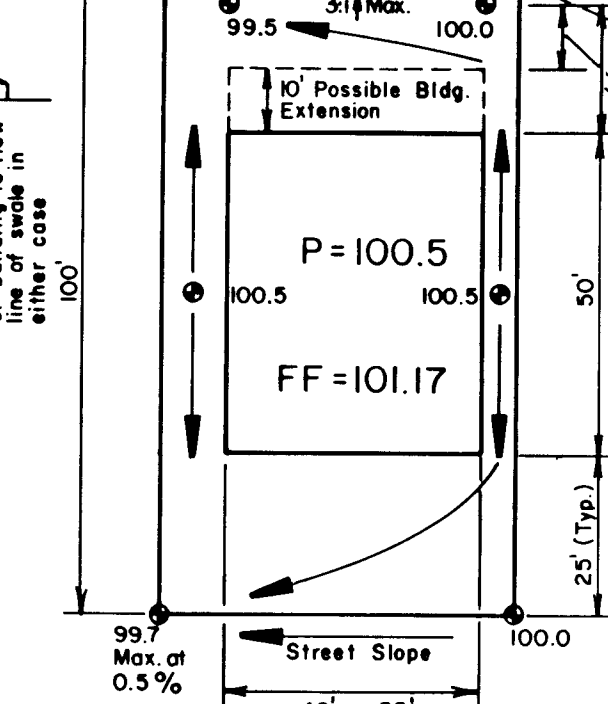


TYPICAL LOT GRADING PATTERN
SPLIT DRAINED LOT

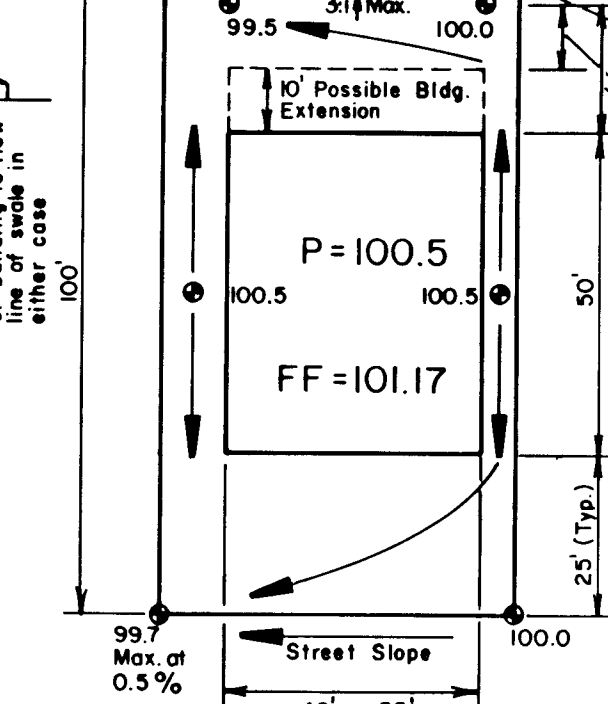


TYPICAL LOT GRADING PATTERN
SPLIT DRAINED LOT

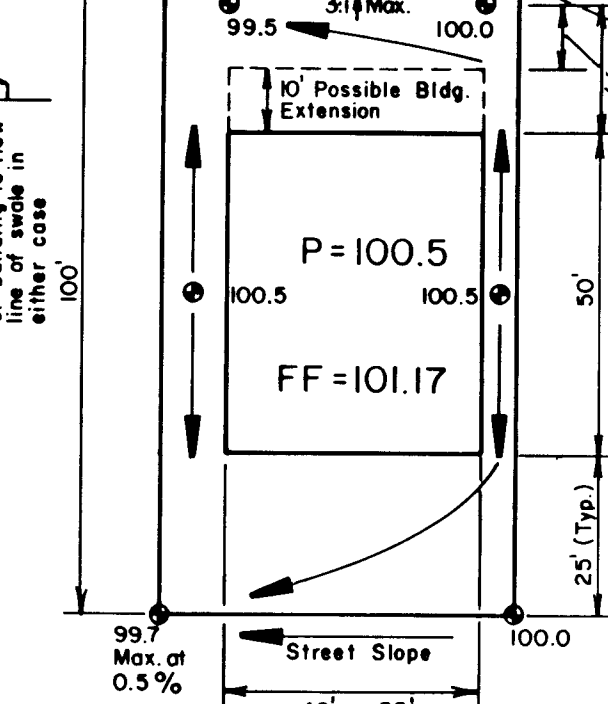


TYPICAL LOT GRADING PATTERN
SPLIT DRAINED LOT

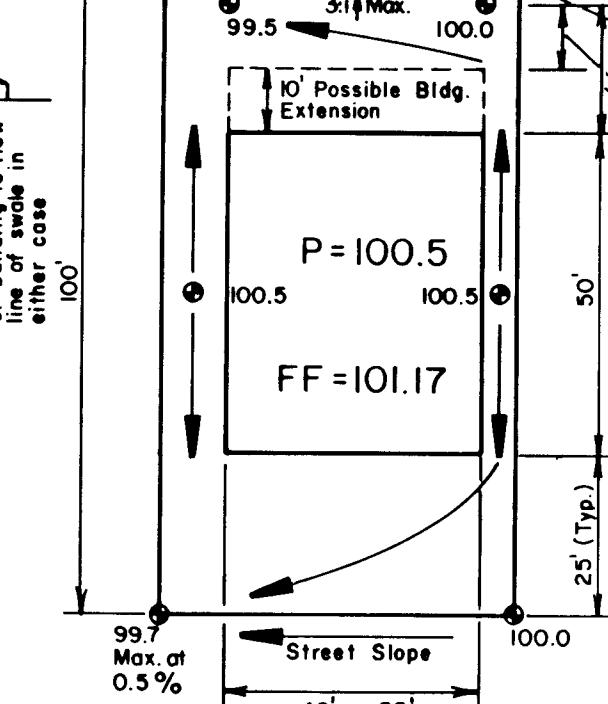


TYPICAL LOT GRADING PATTERN
SPLIT DRAINED LOT

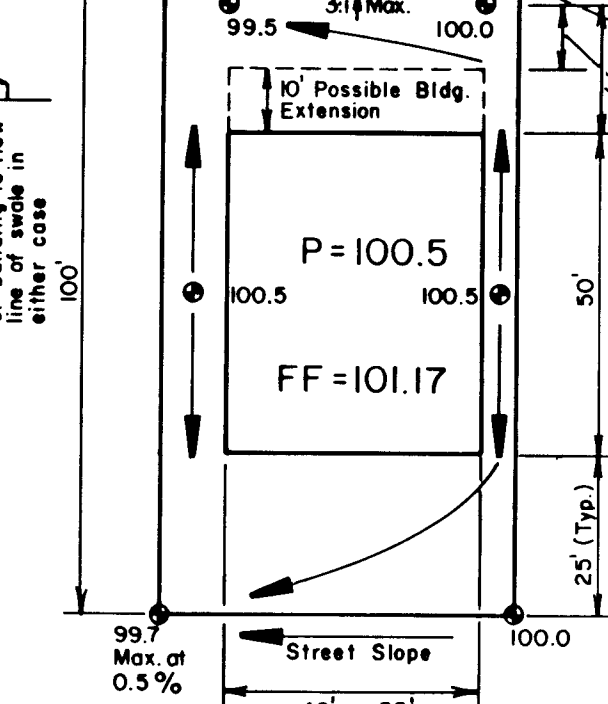


TYPICAL LOT GRADING PATTERN
SPLIT DRAINED LOT

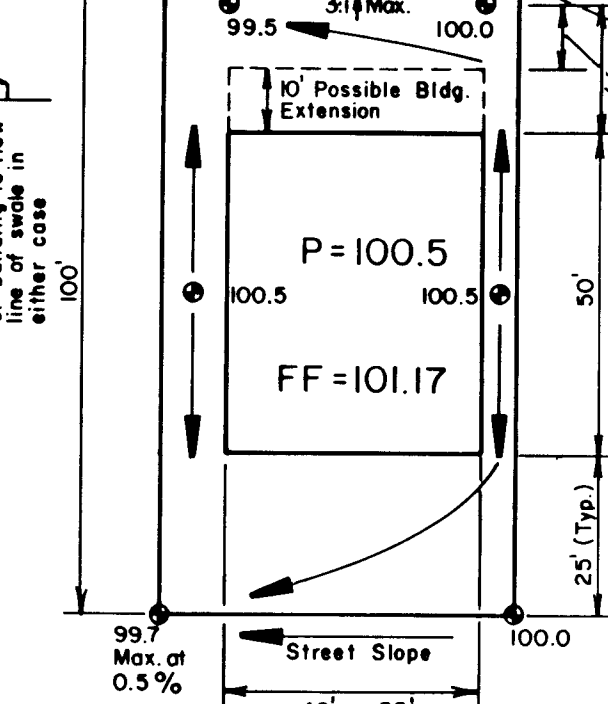


TYPICAL LOT GRADING PATTERN
SPLIT DRAINED LOT

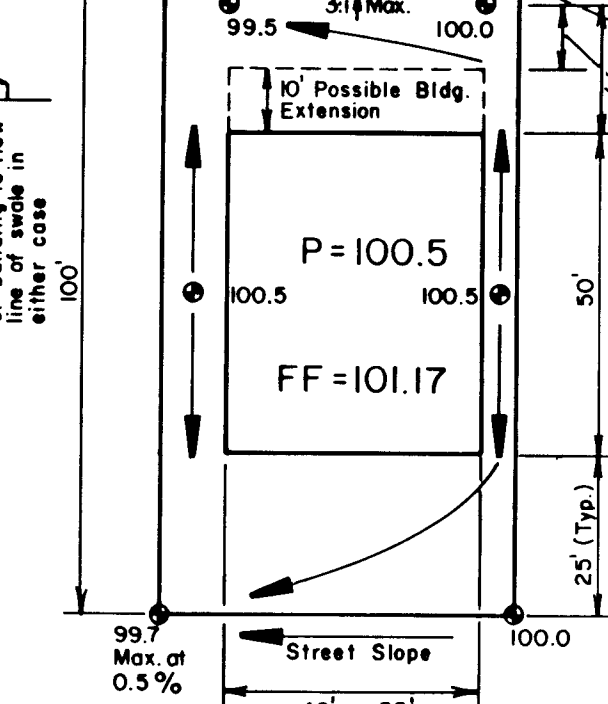


TYPICAL LOT GRADING PATTERN
SPLIT DRAINED LOT

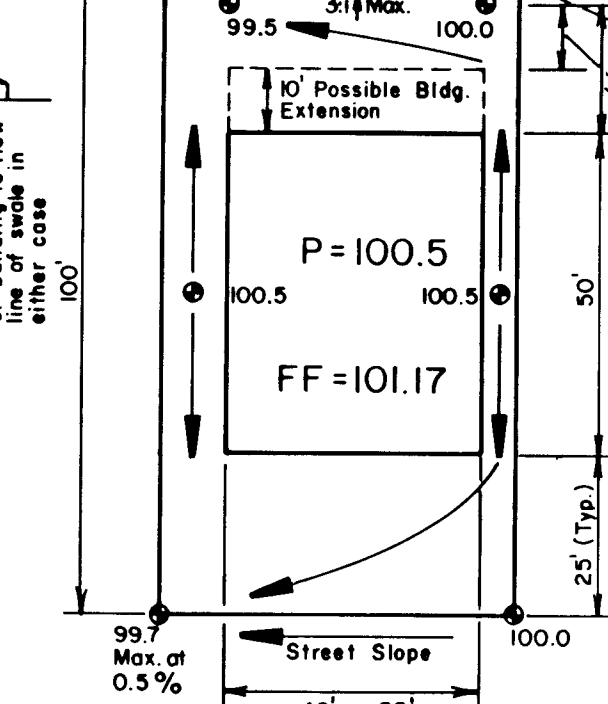


TYPICAL LOT GRADING PATTERN
SPLIT DRAINED LOT

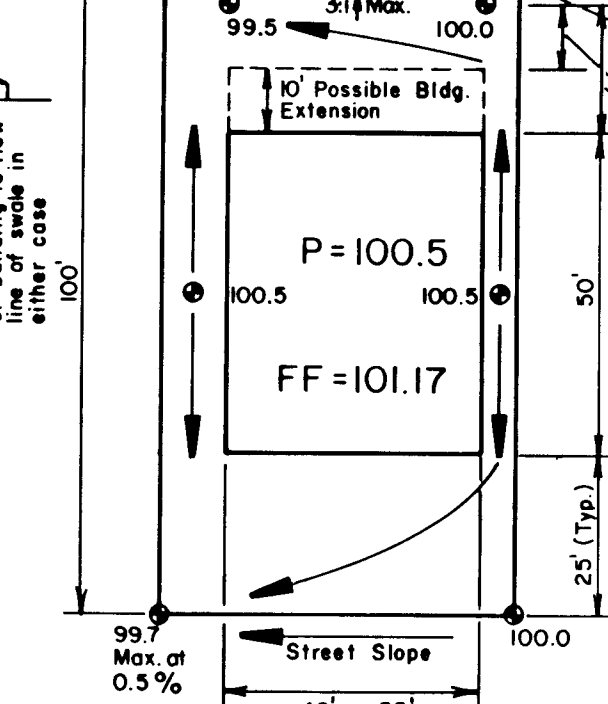


TYPICAL LOT GRADING PATTERN
SPLIT DRAINED LOT

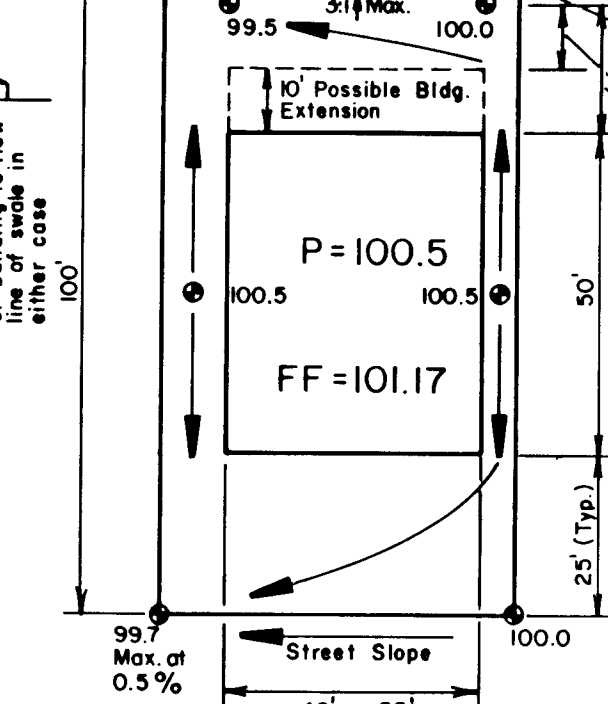


TYPICAL LOT GRADING PATTERN
SPLIT DRAINED LOT

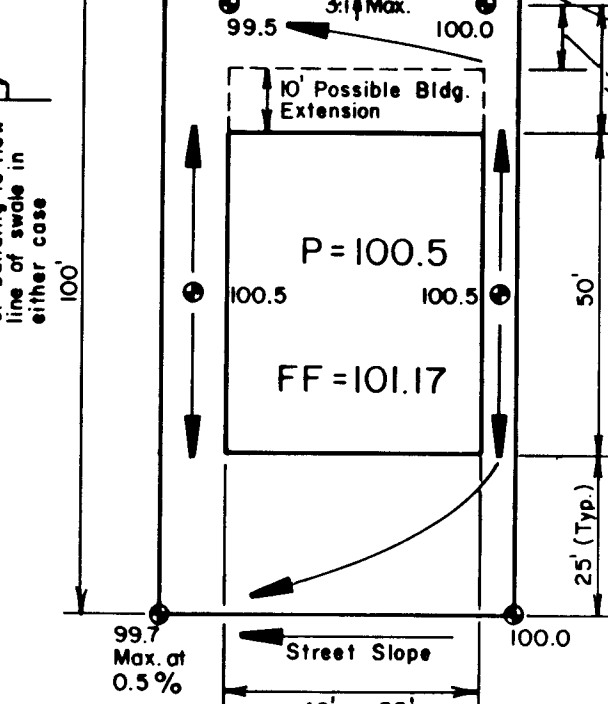


TYPICAL LOT GRADING PATTERN
SPLIT DRAINED LOT

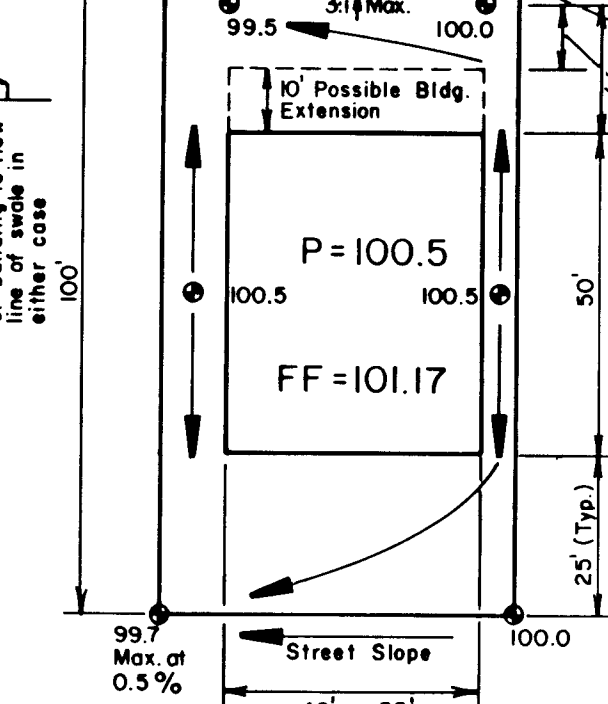


TYPICAL LOT GRADING PATTERN
SPLIT DRAINED LOT

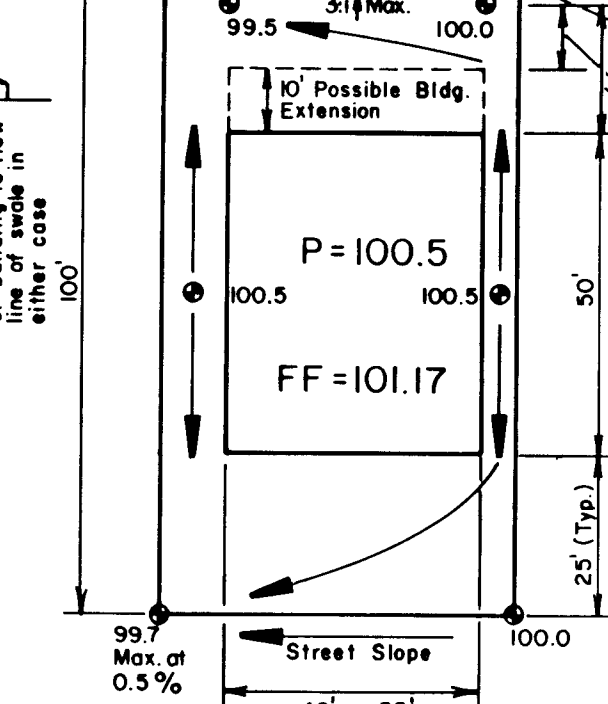


TYPICAL LOT GRADING PATTERN
SPLIT DRAINED LOT

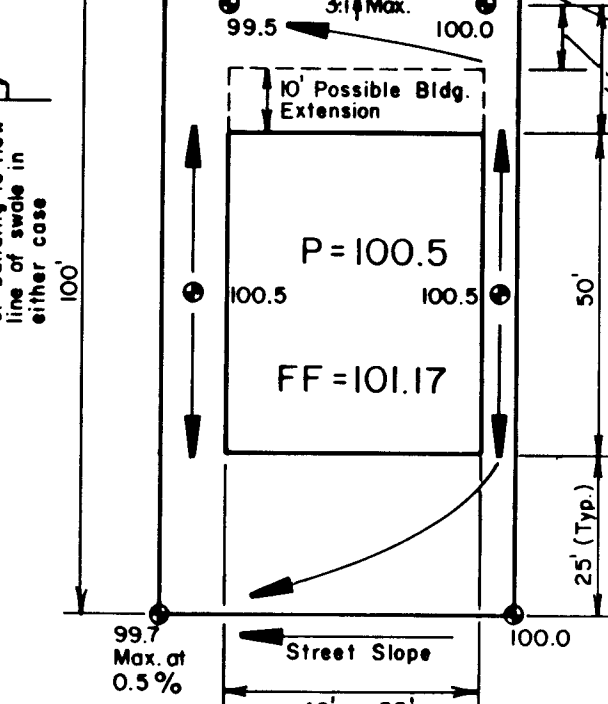


TYPICAL LOT GRADING PATTERN
SPLIT DRAINED LOT

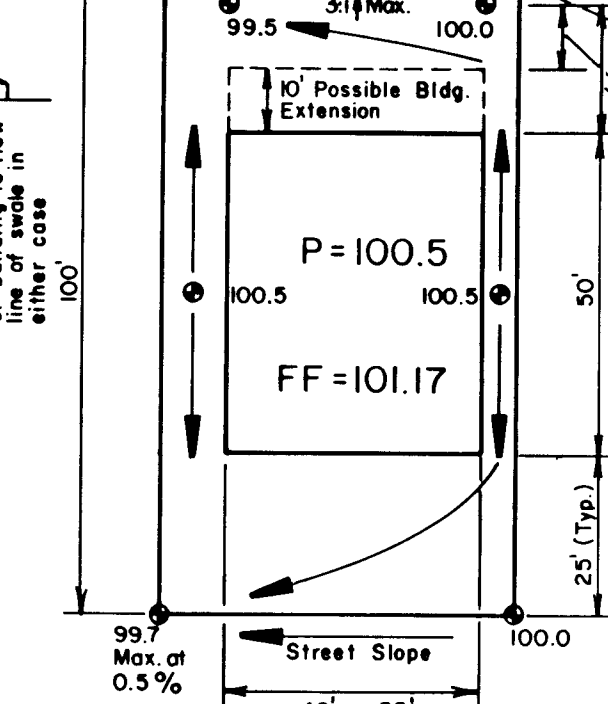


TYPICAL LOT GRADING PATTERN
SPLIT DRAINED LOT

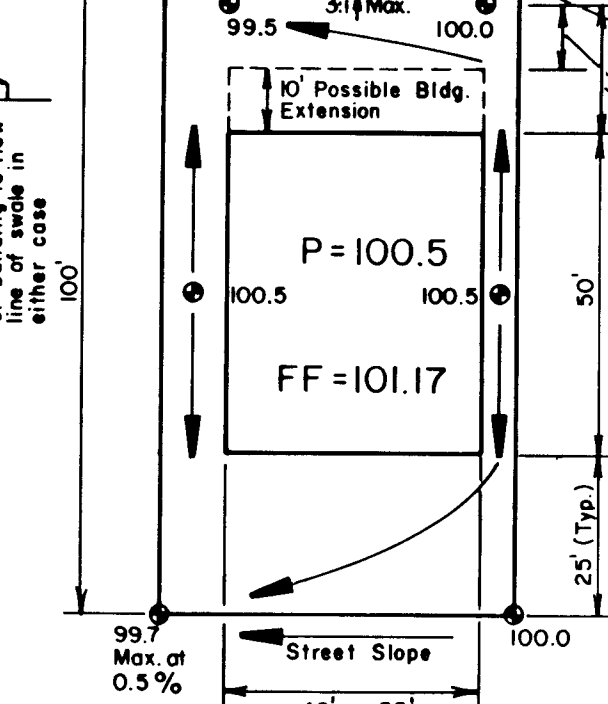


TYPICAL LOT GRADING PATTERN
SPLIT DRAINED LOT

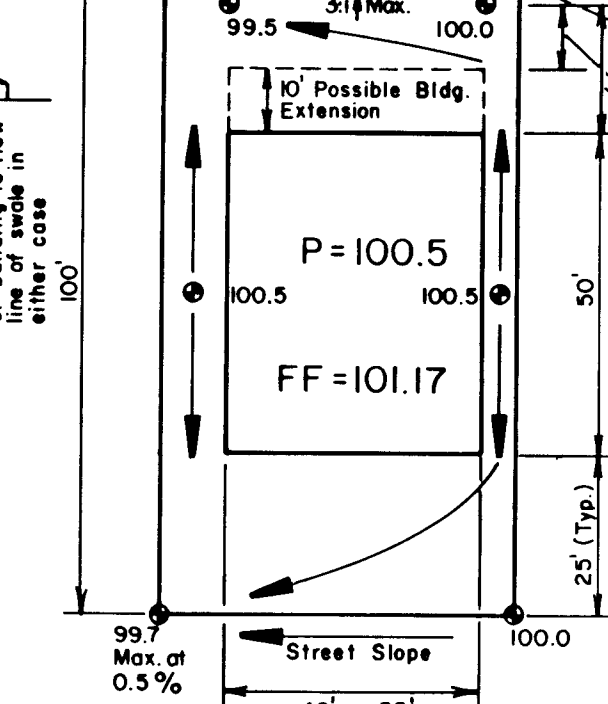


TYPICAL LOT GRADING PATTERN
SPLIT DRAINED LOT

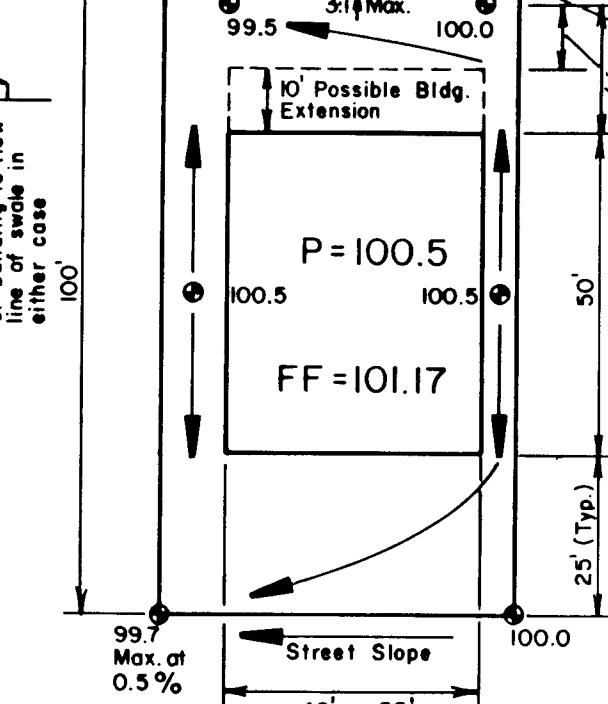


TYPICAL LOT GRADING PATTERN
SPLIT DRAINED LOT

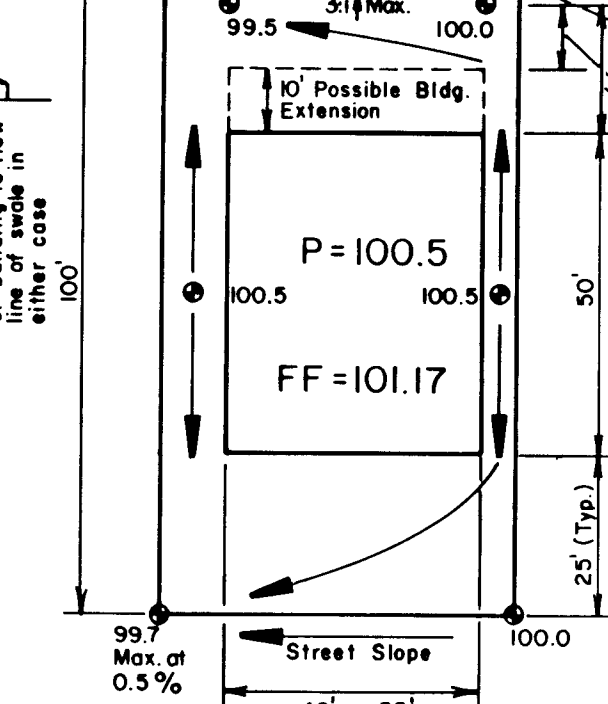


TYPICAL LOT GRADING PATTERN
SPLIT DRAINED LOT

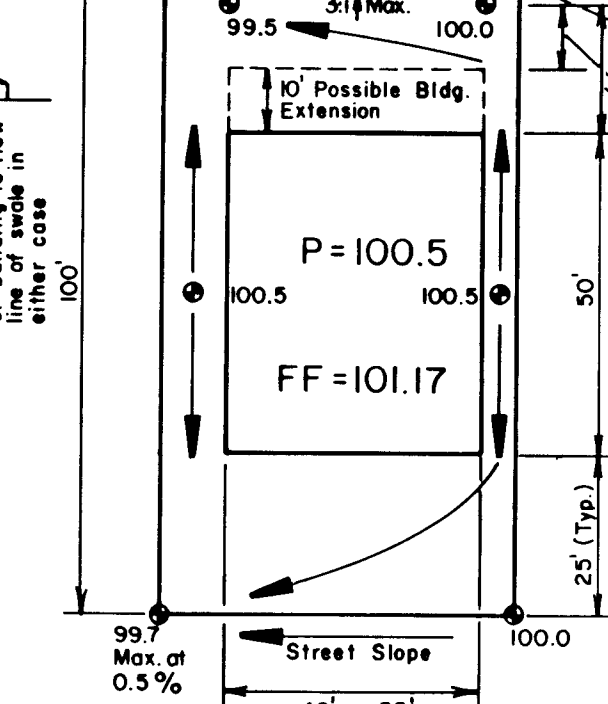


TYPICAL LOT GRADING PATTERN
SPLIT DRAINED LOT

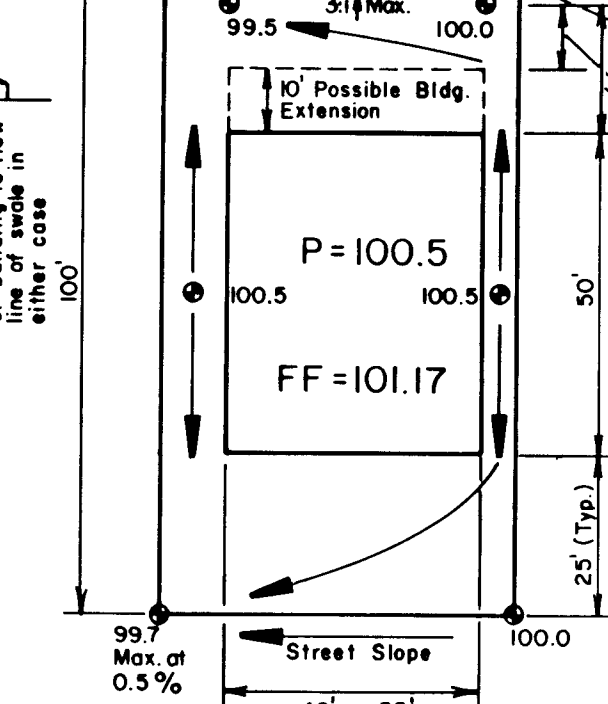


TYPICAL LOT GRADING PATTERN
SPLIT DRAINED LOT

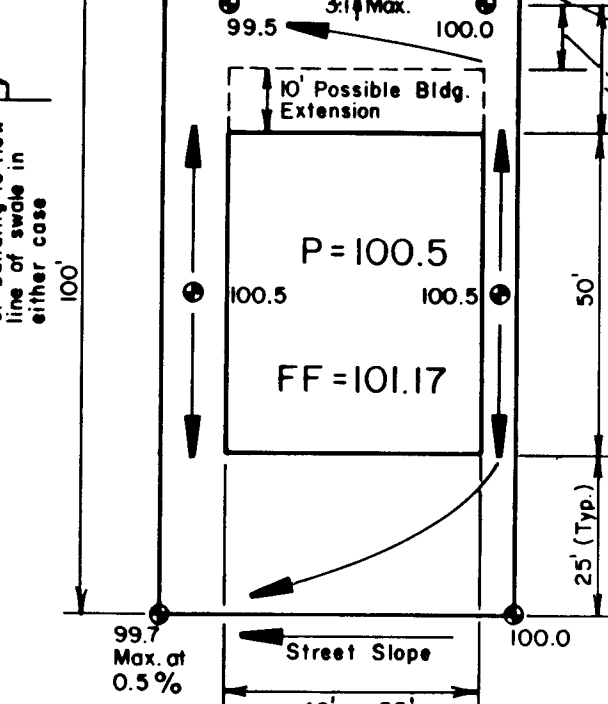


TYPICAL LOT GRADING PATTERN
SPLIT DRAINED LOT

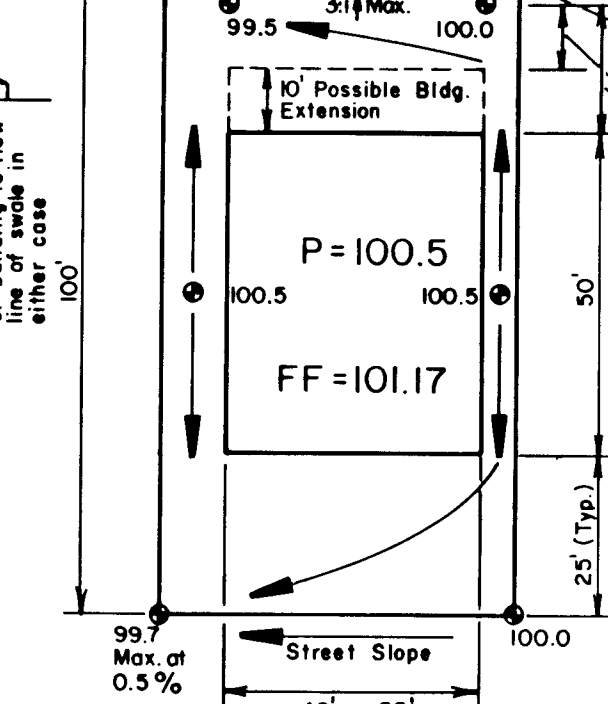


TYPICAL LOT GRADING PATTERN
SPLIT DRAINED LOT

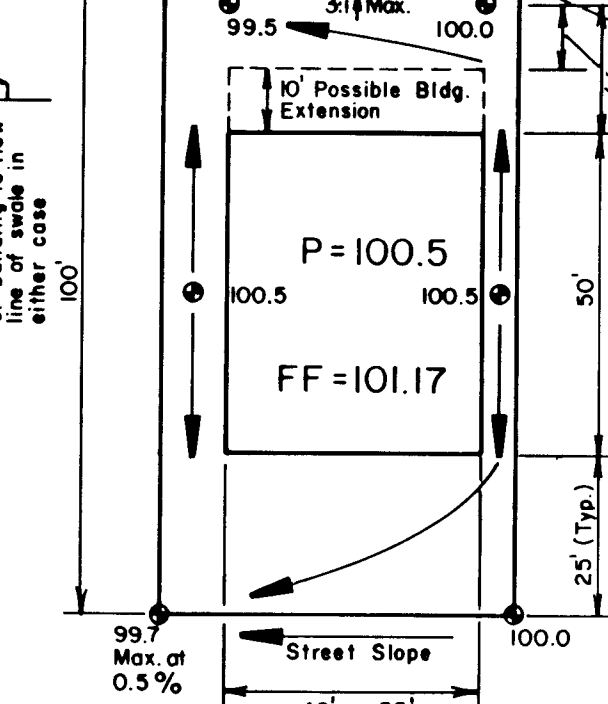


TYPICAL LOT GRADING PATTERN
SPLIT DRAINED LOT

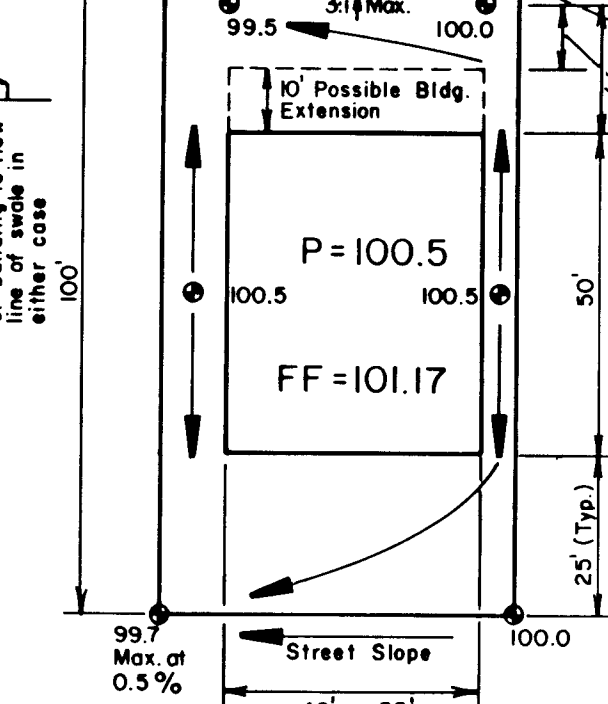


TYPICAL LOT GRADING PATTERN
SPLIT DRAINED LOT

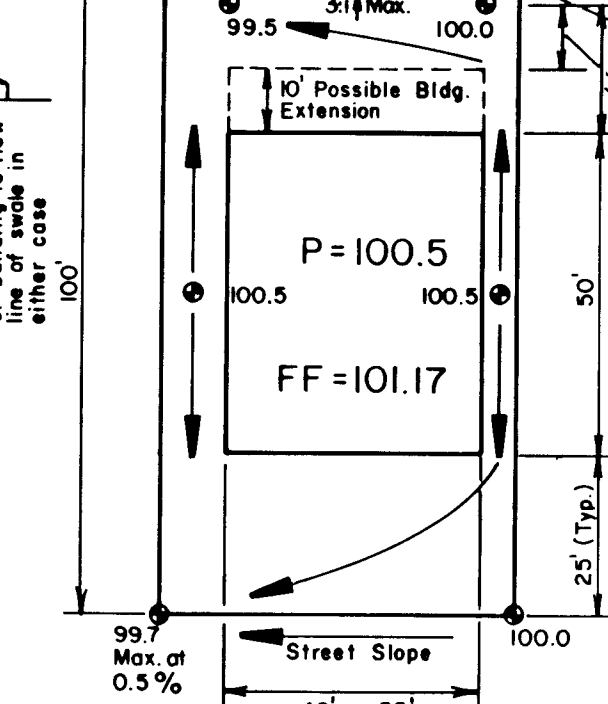


TYPICAL LOT GRADING PATTERN
SPLIT DRAINED LOT

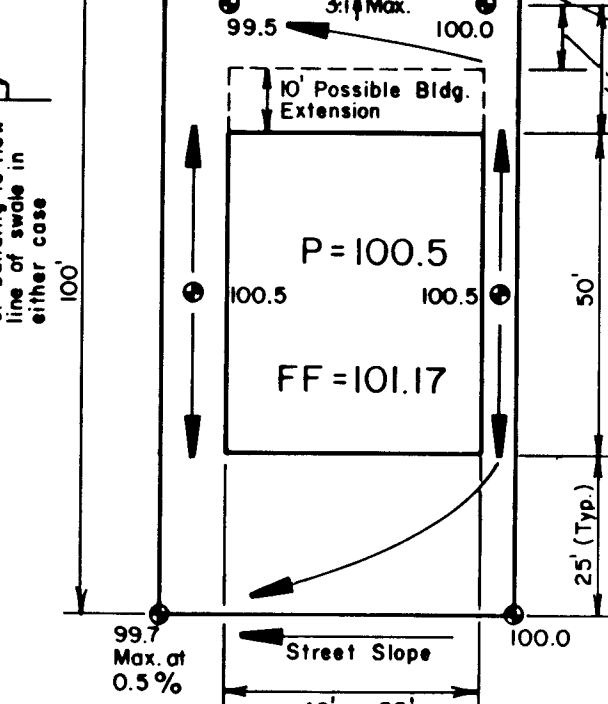


TYPICAL LOT GRADING PATTERN
SPLIT DRAINED LOT

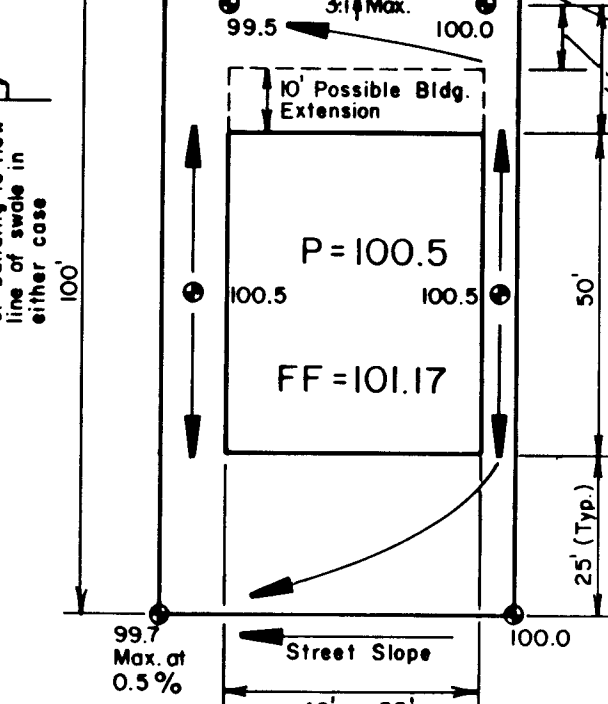


TYPICAL LOT GRADING PATTERN
SPLIT DRAINED LOT

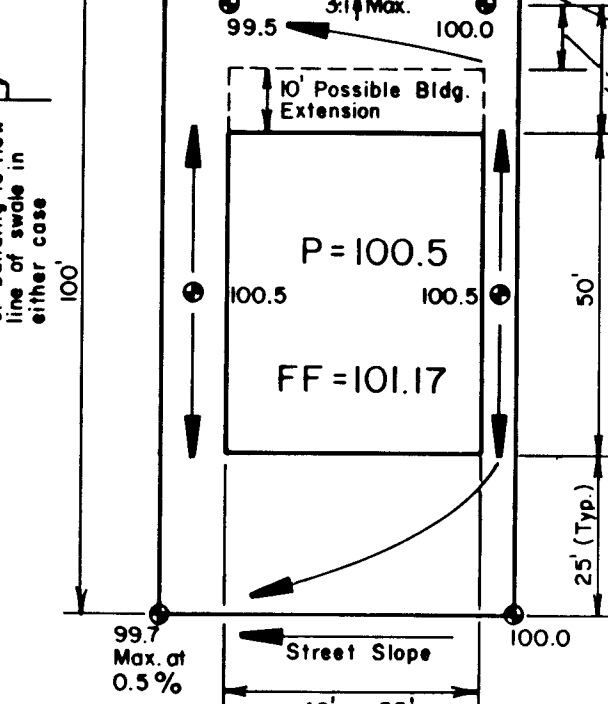


TYPICAL LOT GRADING PATTERN
SPLIT DRAINED LOT

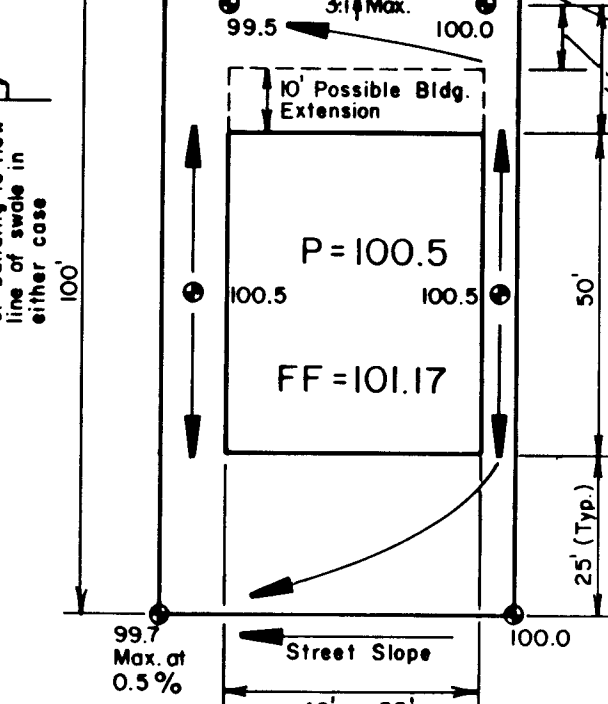


TYPICAL LOT GRADING PATTERN
SPLIT DRAINED LOT

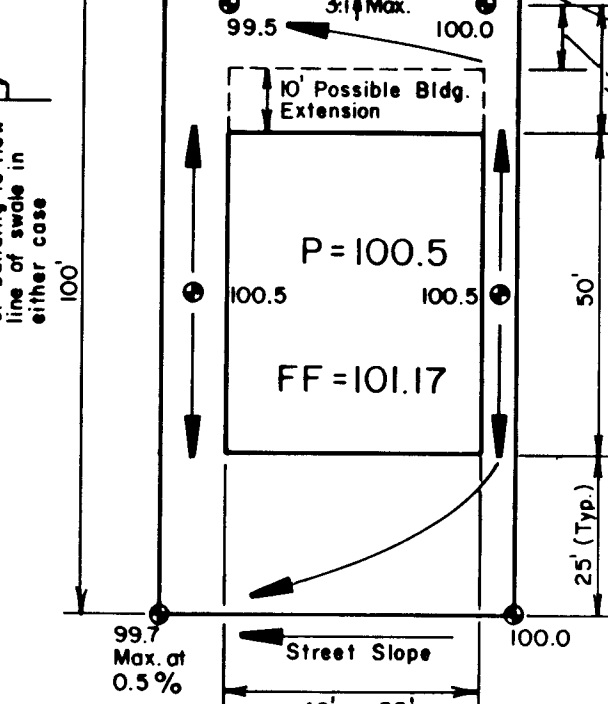


TYPICAL LOT GRADING PATTERN
SPLIT DRAINED LOT

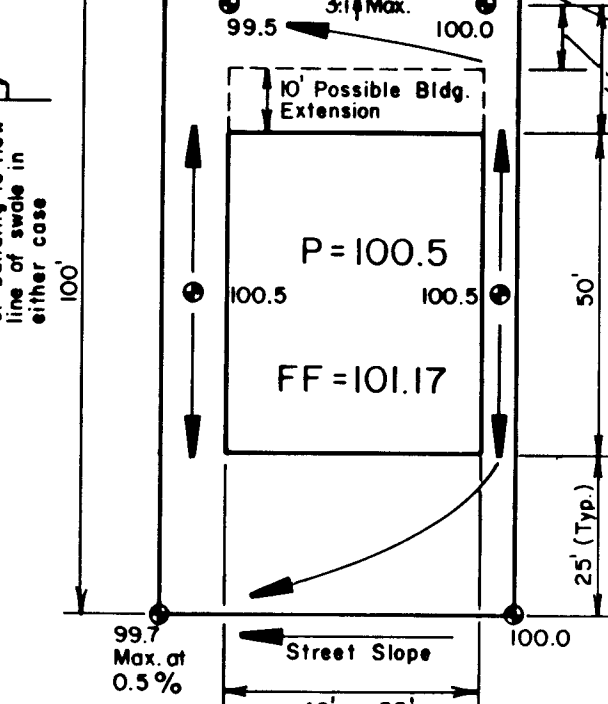


TYPICAL LOT GRADING PATTERN
SPLIT DRAINED LOT

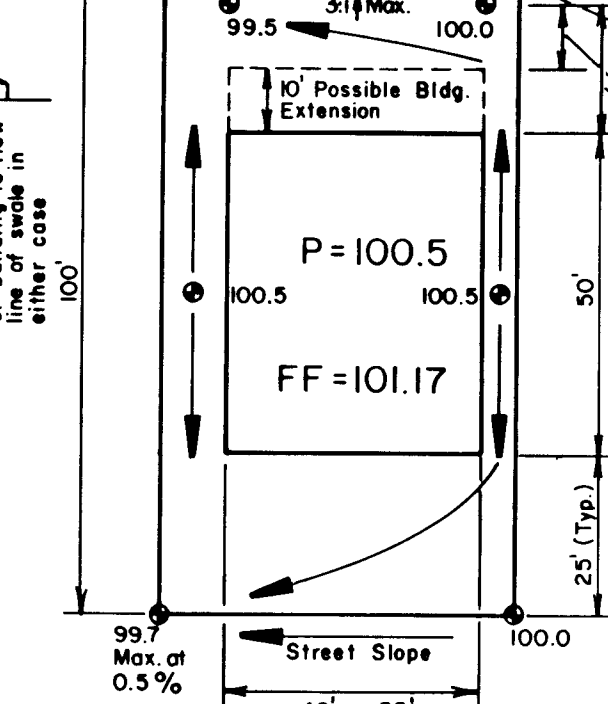


TYPICAL LOT GRADING PATTERN
SPLIT DRAINED LOT

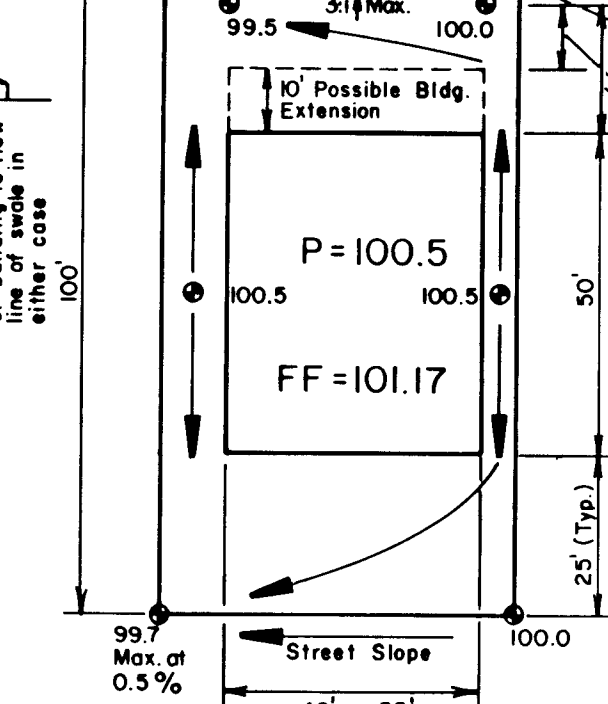


TYPICAL LOT GRADING PATTERN
SPLIT DRAINED LOT

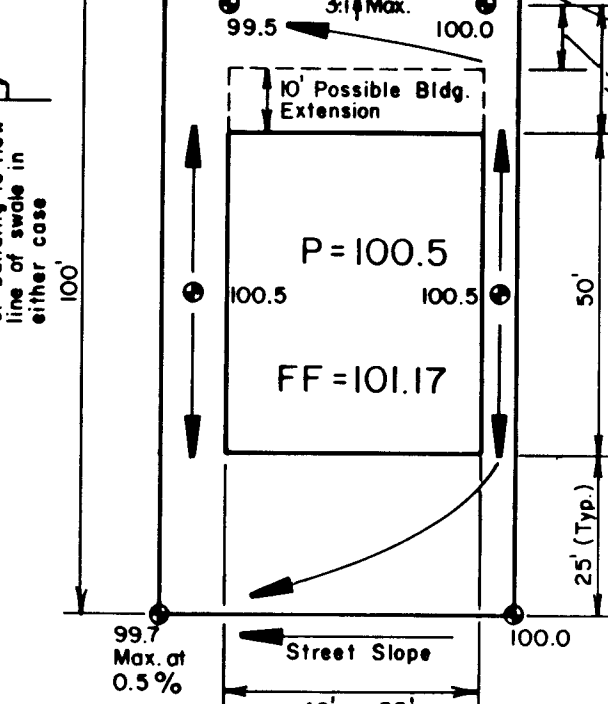


TYPICAL LOT GRADING PATTERN
SPLIT DRAINED LOT

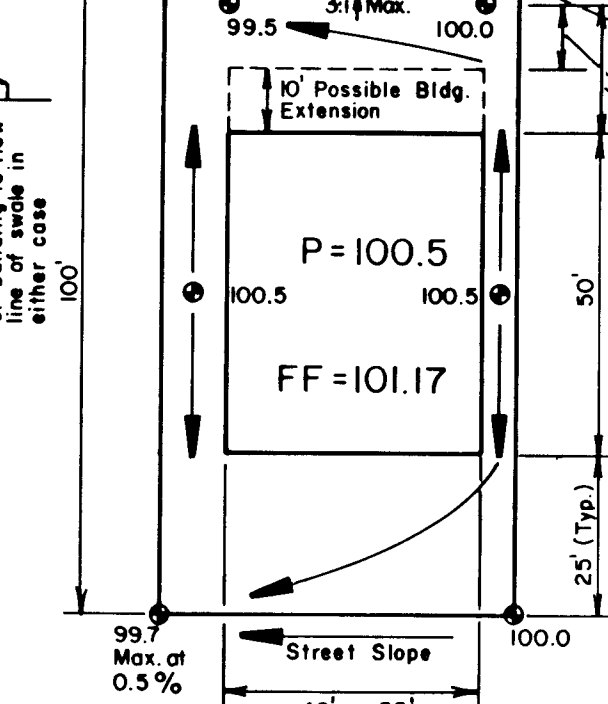


TYPICAL LOT GRADING PATTERN
SPLIT DRAINED LOT

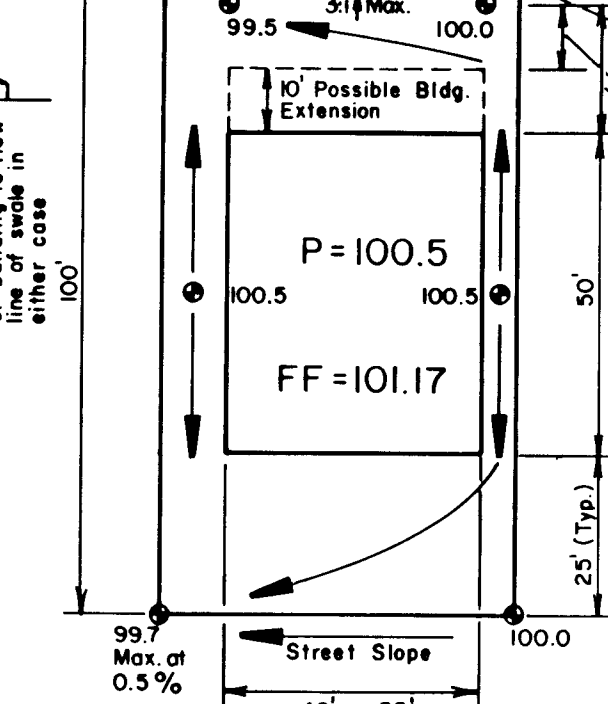


TYPICAL LOT GRADING PATTERN
SPLIT DRAINED LOT

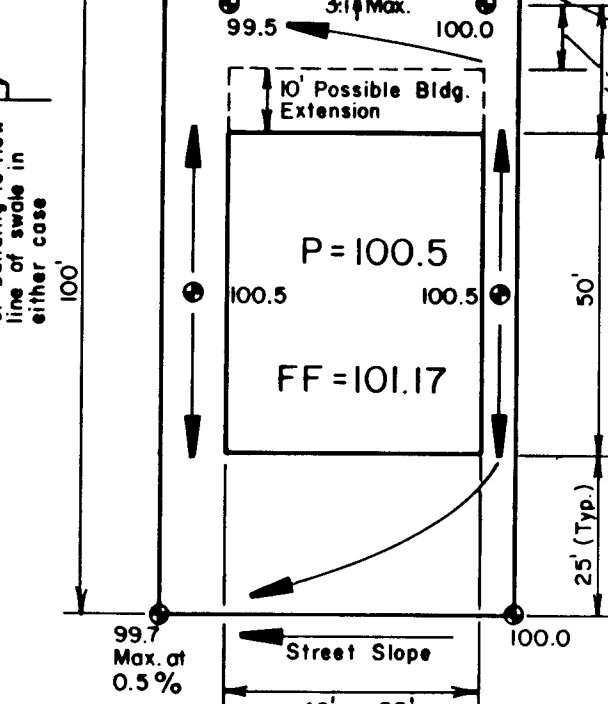


TYPICAL LOT GRADING PATTERN
SPLIT DRAINED LOT

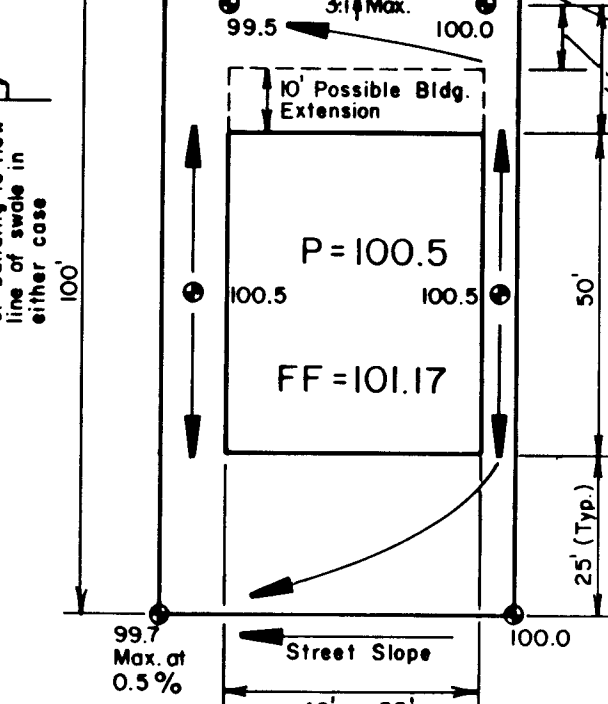


TYPICAL LOT GRADING PATTERN
SPLIT DRAINED LOT

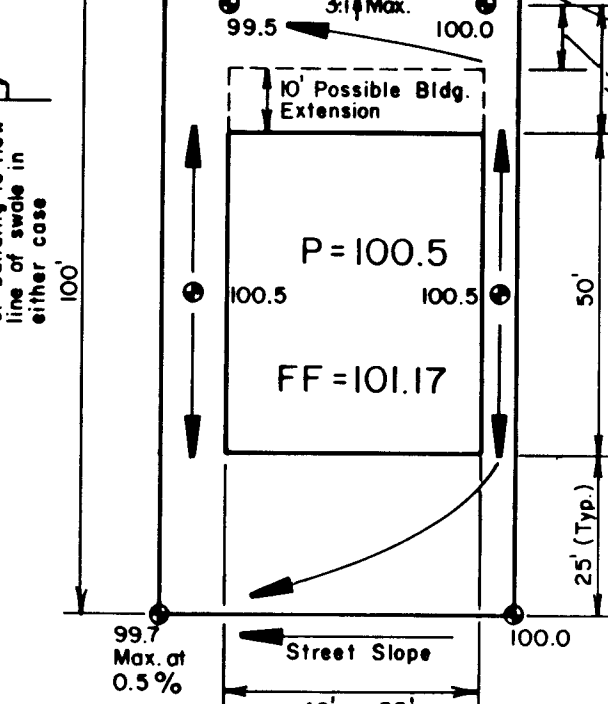


TYPICAL LOT GRADING PATTERN
SPLIT DRAINED LOT

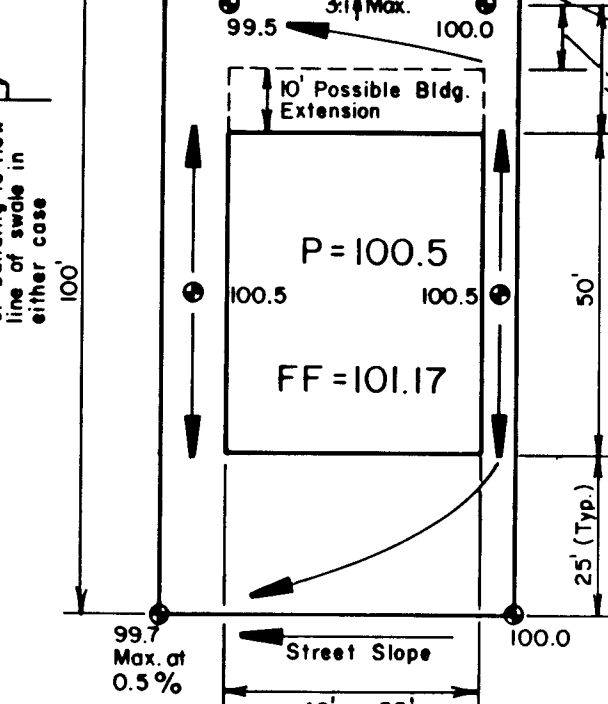


TYPICAL LOT GRADING PATTERN
SPLIT DRAINED LOT

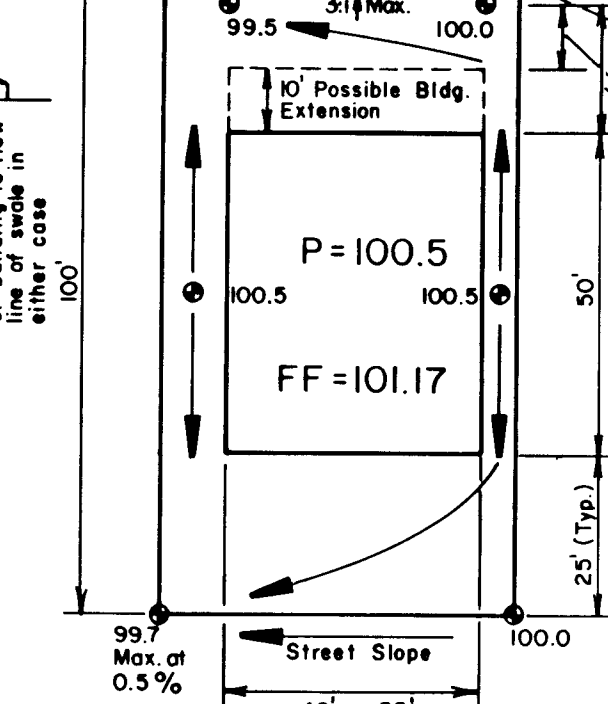


TYPICAL LOT GRADING PATTERN
SPLIT DRAINED LOT

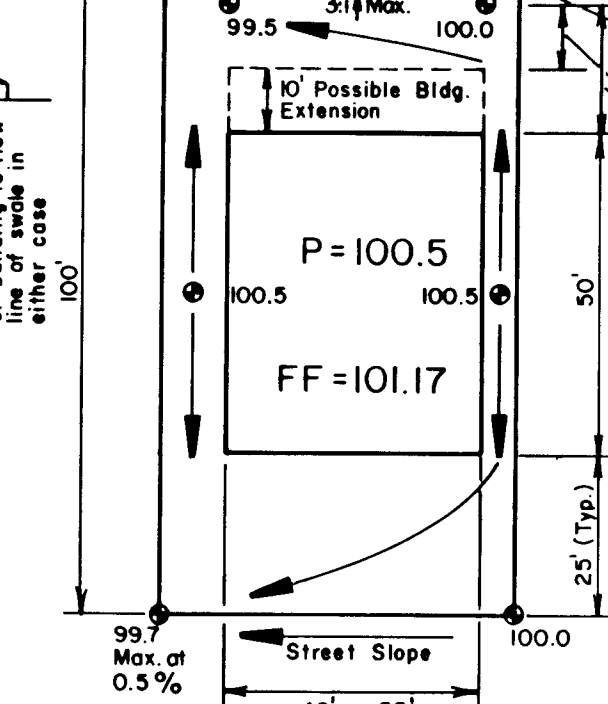


TYPICAL LOT GRADING PATTERN
SPLIT DRAINED LOT

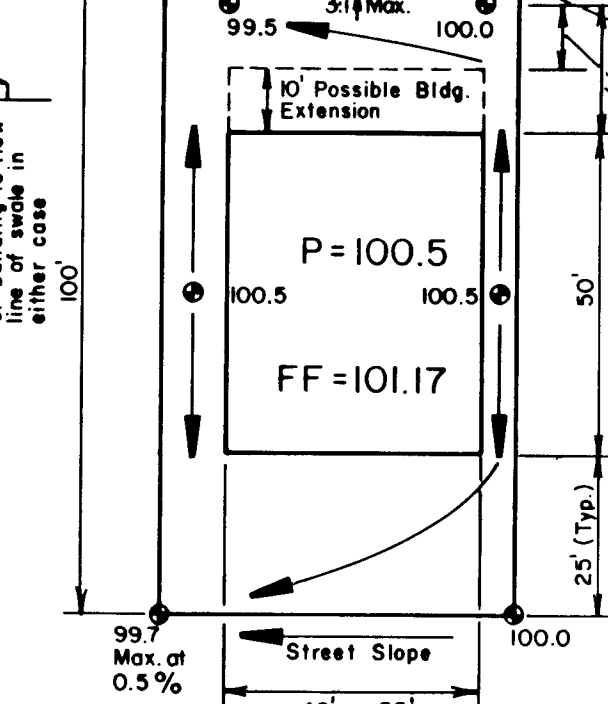


TYPICAL LOT GRADING PATTERN
SPLIT DRAINED LOT

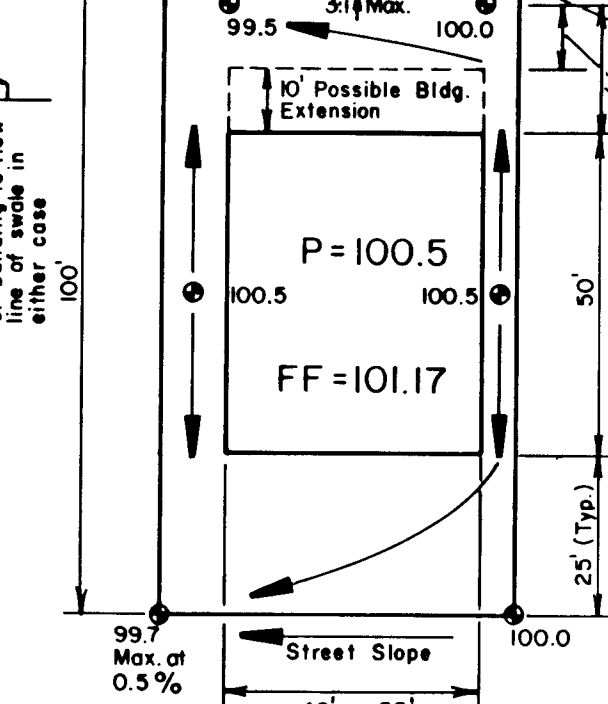


TYPICAL LOT GRADING PATTERN
SPLIT DRAINED LOT

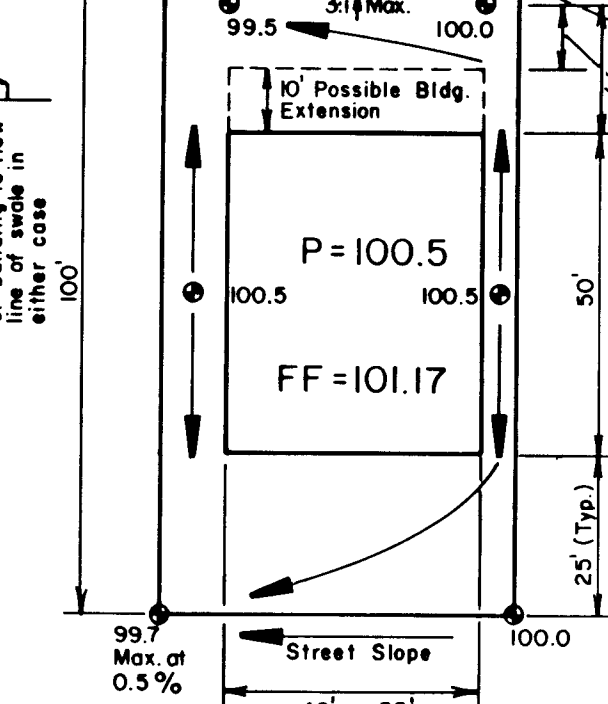


TYPICAL LOT GRADING PATTERN
SPLIT DRAINED LOT

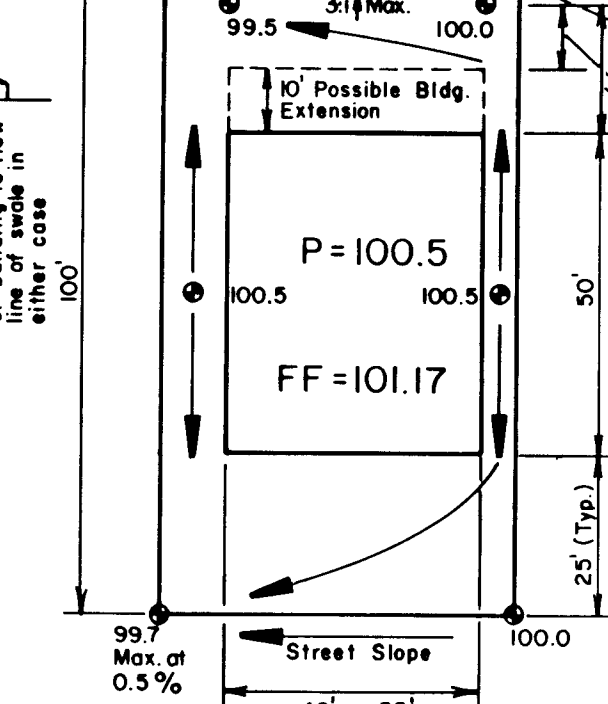


TYPICAL LOT GRADING PATTERN
SPLIT DRAINED LOT

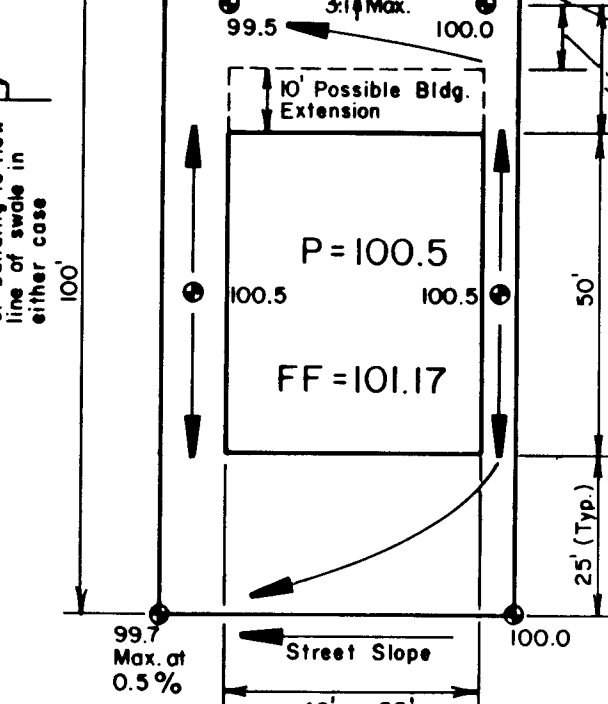


TYPICAL LOT GRADING PATTERN
SPLIT DRAINED LOT


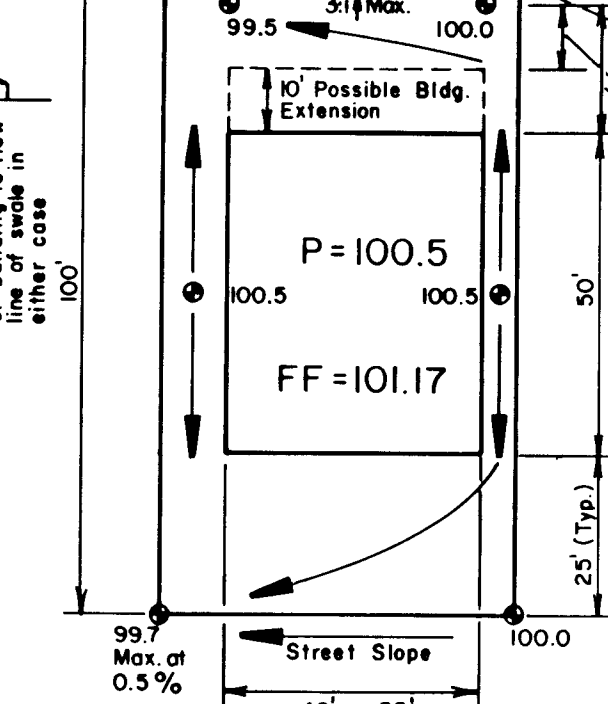


TYPICAL LOT GRADING PATTERN
SPLIT DRAINED LOT

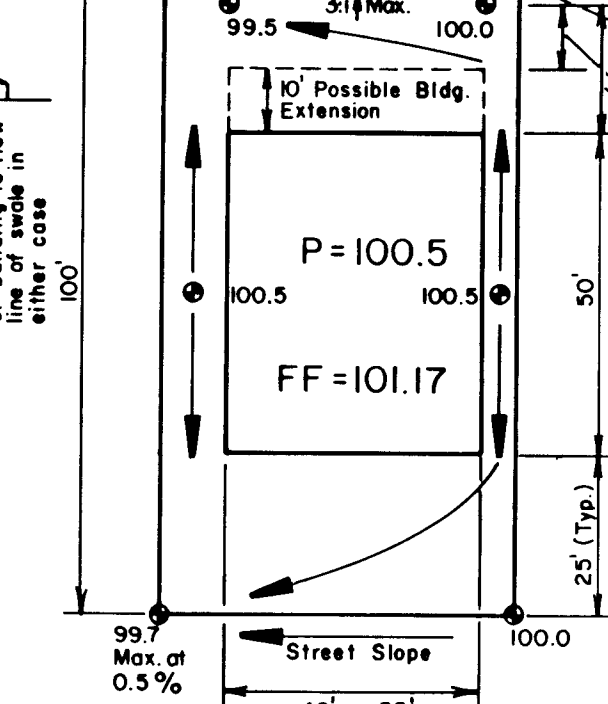

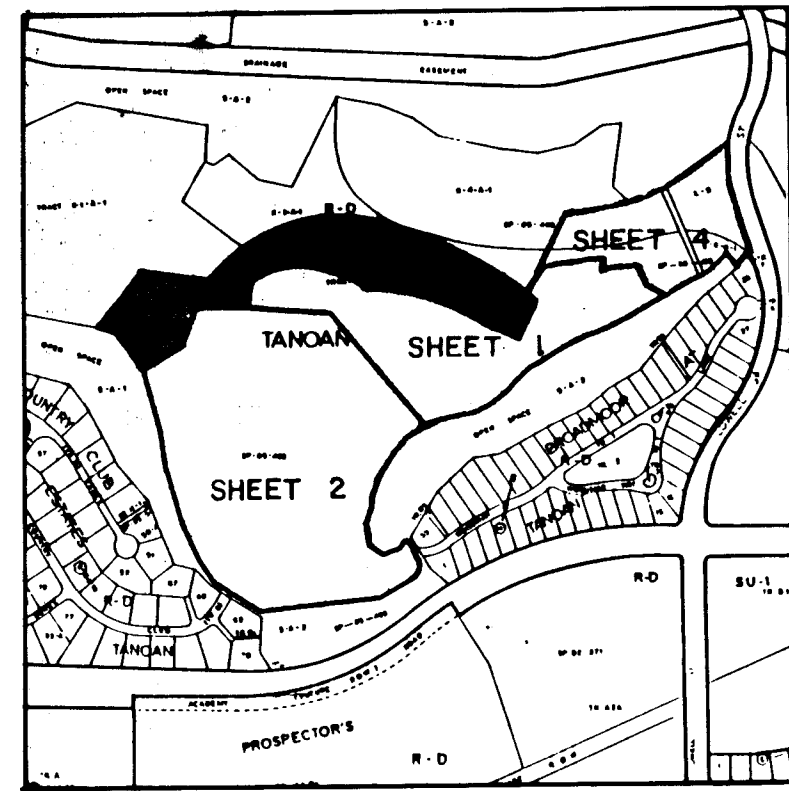


GRADING KEY MAP

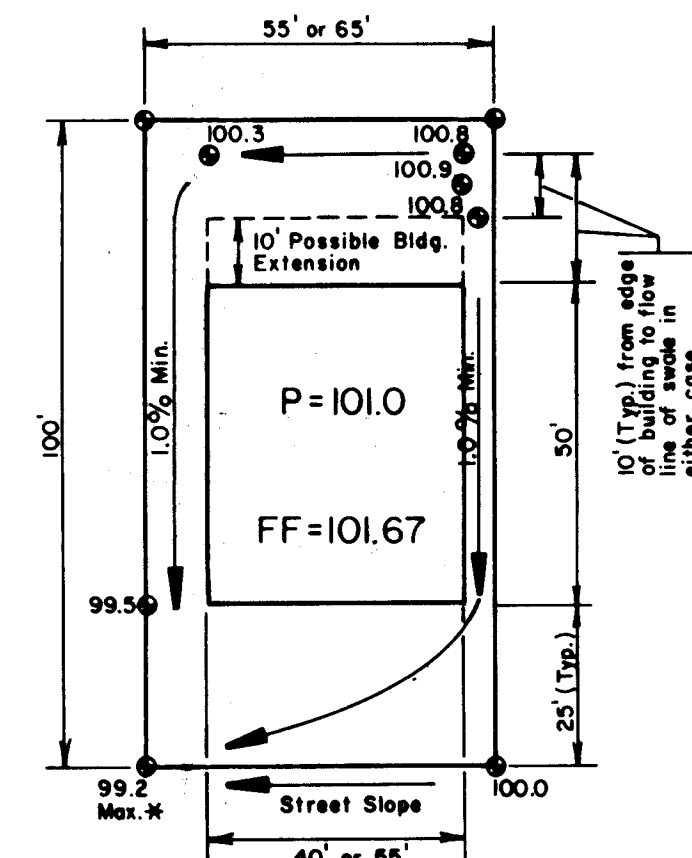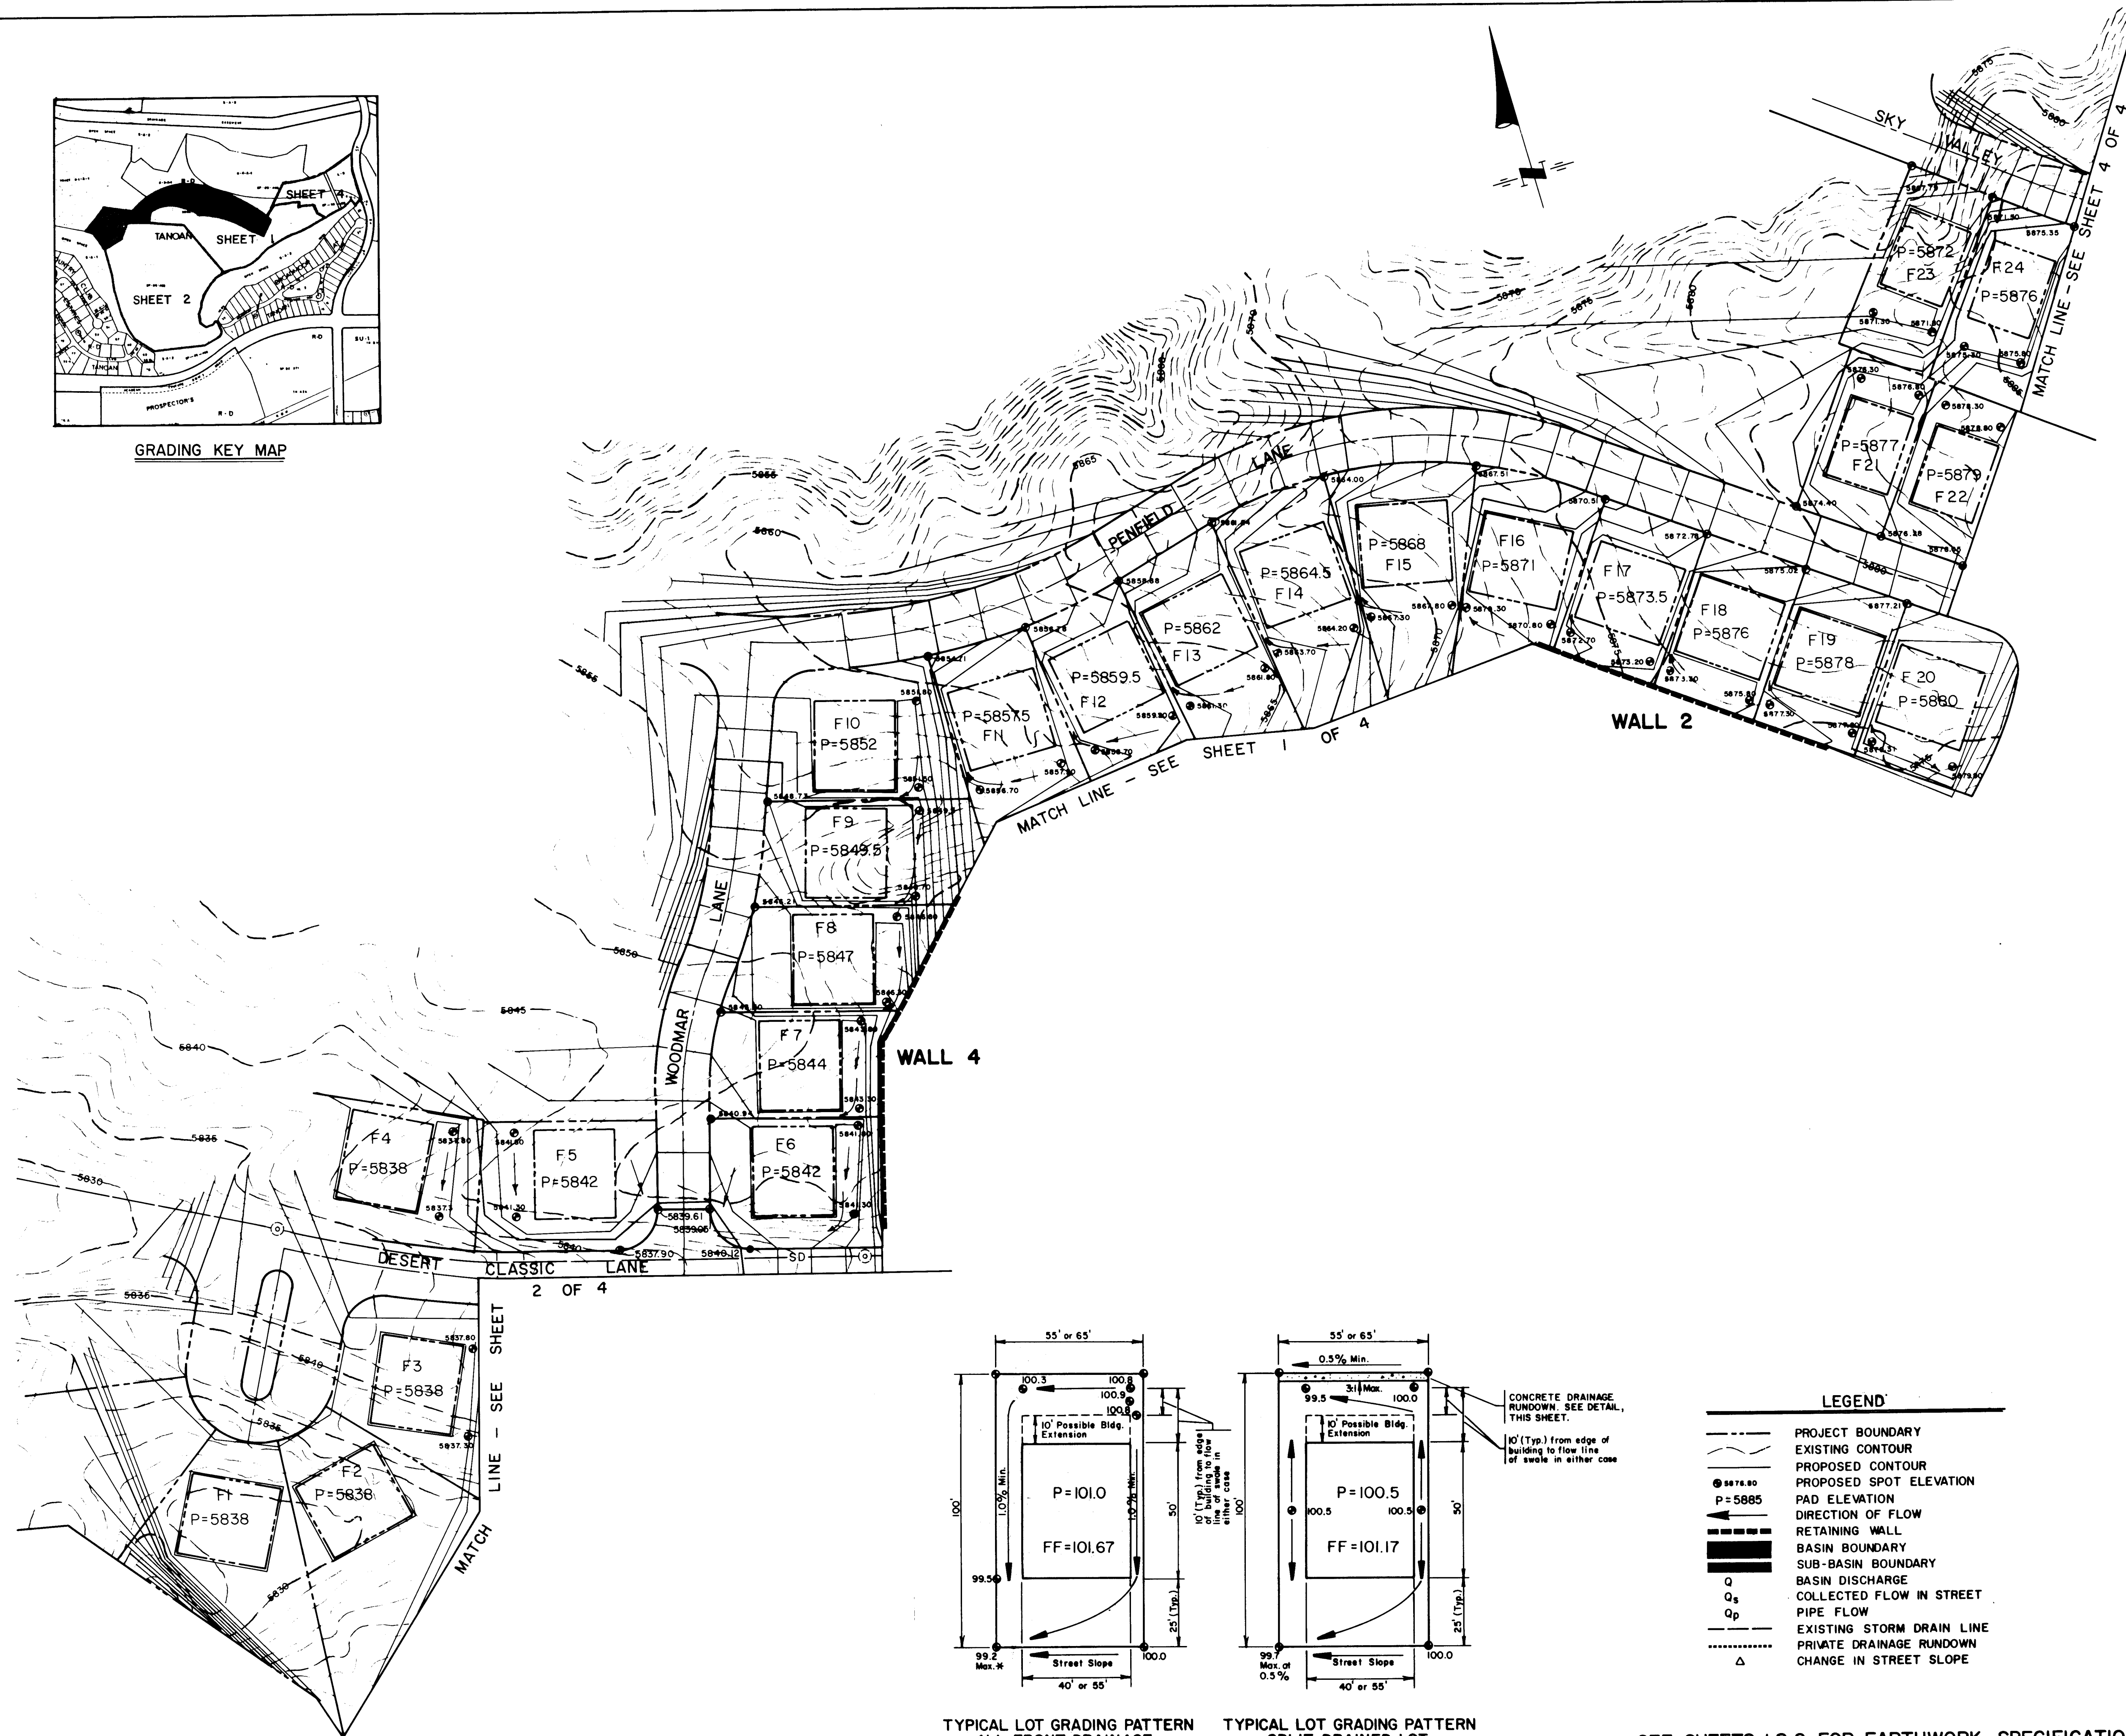

TYPICAL LOT GRADING PATTERN
ALL FRONT DRAINAGE

* FOR STREET SLOPES $\leq 1.5\%$ (55' Lot)
or $\leq 1.2\%$ (65' Lot) INCREASE LOT
ELEVATIONS 0.5'

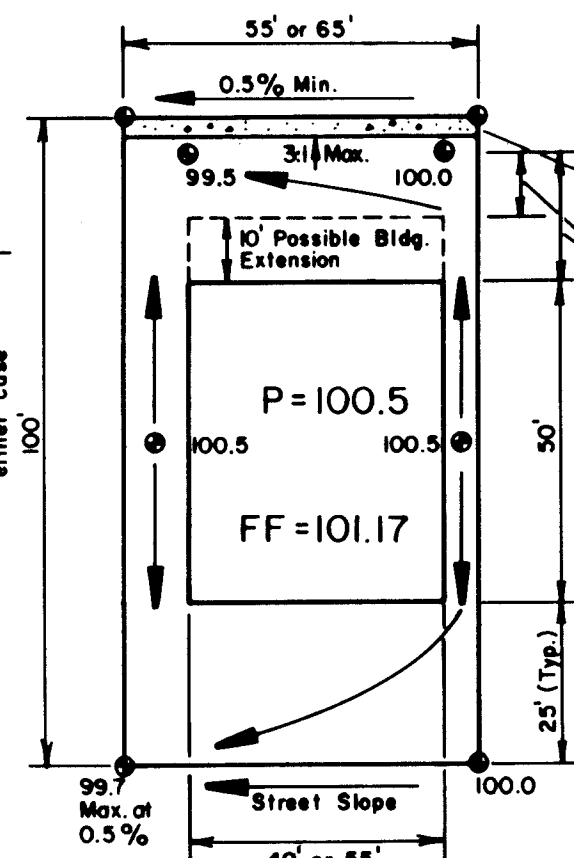

TYPICAL LOT GRADING PATTERN
SPLIT DRAINED LOT

- LEGEND**
- PROJECT BOUNDARY
 - EXISTING CONTOUR
 - PROPOSED CONTOUR
 - PROPOSED SPOT ELEVATION
 - PAD ELEVATION
 - DIRECTION OF FLOW
 - RETAINING WALL
 - BASIN BOUNDARY
 - SUB-BASIN BOUNDARY
 - BASIN DISCHARGE
 - COLLECTED FLOW IN STREET
 - PIPE FLOW
 - EXISTING STORM DRAIN LINE
 - PRIVATE DRAINAGE RUNDOWN
 - CHANGE IN STREET SLOPE

SEE SHEETS 1 & 2 FOR EARTHWORK SPECIFICATIONS

FOR INFORMATION ONLY

BHI JOB # 72420
SCALE: 1" = 50'

ENGINEER'S SEAL			SURVEY INFORMATION		BENCH MARKS		AS-BUILT INFORMATION	
			NO.	BY	DATE	CONTRACTOR	NO.	DATE
						THE BENCH MARK IS LOCATED 1.2 MILES EAST OF THE INTERSECTION OF ACADEMY ROAD, NE & EURANK BLVD., NE THEN 370' S SOUTH, THE BENCH MARK IS ON THE SOUTH RIM OF THE BEAR CANYON TRIBUTARY & IS A STANDARD ACS BRASS TABLET STAMPED "6-E22 134972" ELEVATION 9934.83'		
			NO.	DATE	REVISIONS	NO.	DATE	REVISIONS

26 24790888

APPROVED FOR ROUGH GRADING 11'


Calvin A. Monte 6-24-87
HYDROLOGY ENGINEER DATE

CITY OF ALBUQUERQUE
PUBLIC WORKS
ENGINEERING

TITLE: DESERT CLASSIC AT TANOAN - PHASE I
DRAINAGE/GRADING PLAN
PERIMETER

APPROVALS	ENGINEER	DATE	APPROVALS	ENGINEER	DATE
City Engineer	<i>Handwritten Signature</i>	7/6/87	Liquid Waste	N/A R.H.	6/24/87
A.C.E. - Design	<i>Handwritten Signature</i>	6/24/87	Traffic	N/A R.H.	6/24/87
A.C.E. - Hydrology	<i>Handwritten Signature</i>	6-24-87	Water	N/A R.H.	6-24-87

DRAWING NO.	2479	MAP NO.	E-22	SHEET	3	OF	4
-------------	------	---------	------	-------	---	----	---

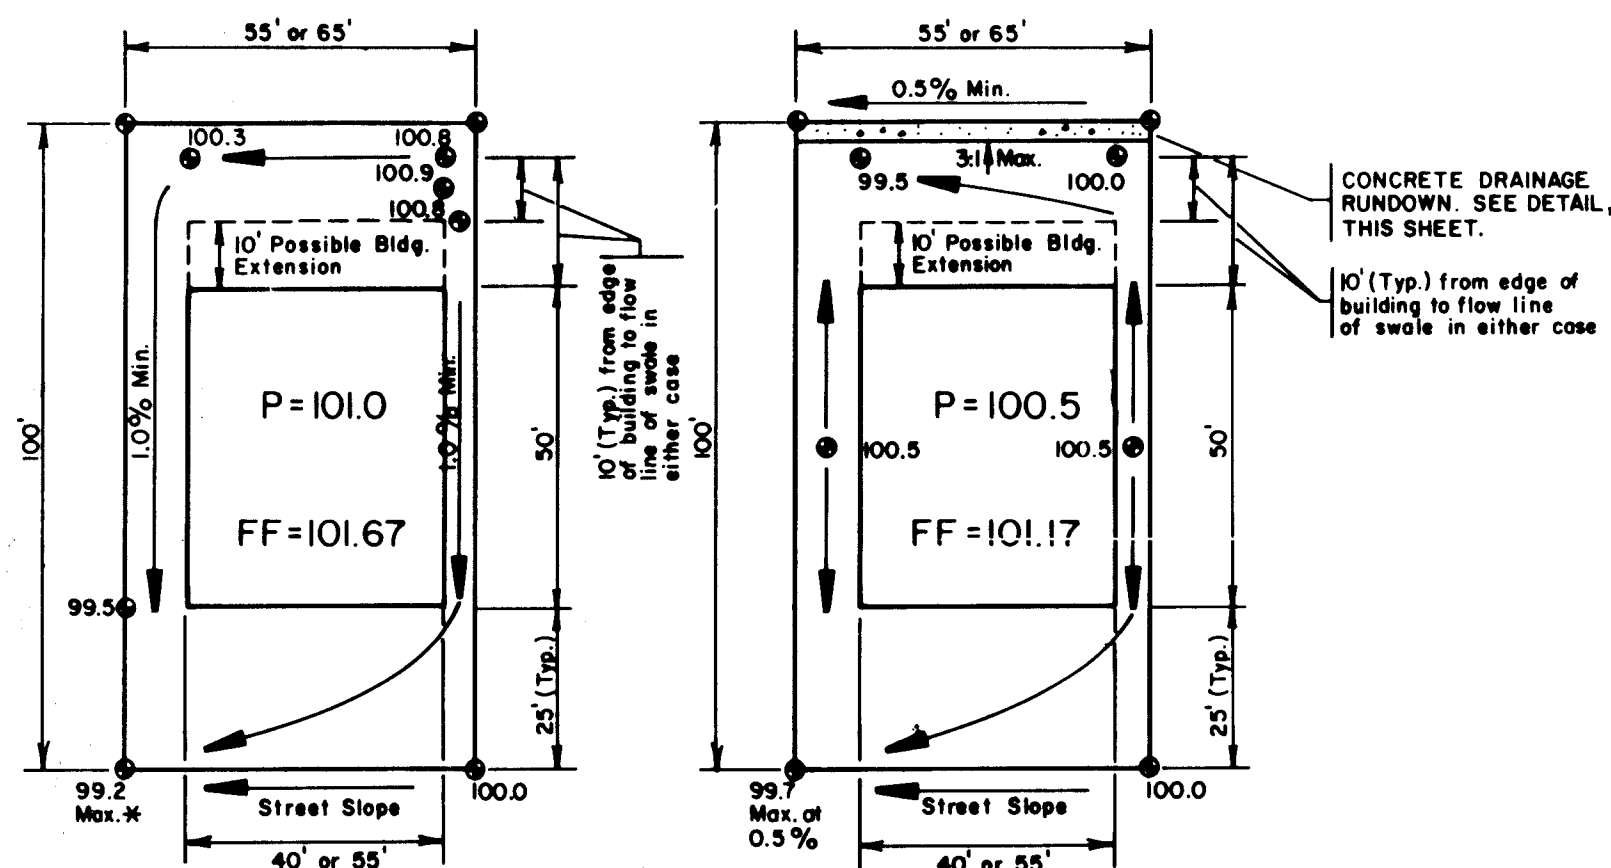



TYPICAL LOT GRADING PATTERN ALL FRONT DRAINAGE

* FOR STREET SLOPES $\leq 1.5\%$ (55' Lot) or $\leq 1.2\%$ (65' Lot) INCREASE LOT ELEVATIONS 0.5'


TYPICAL LOT GRADING PATTERN SPLIT DRAINED LOT

NOTES:


1. SEQUENCE OF FILL SHALL BE AS FOLLOWS:
 1. FILL TRACT L-4-B
 2. FILL LOWELL STREET
 3. FILL TWO LOT PADS IN TRACT L-5-A
 4. FILL REAR YARD AREAS IN TRACT L-5-A
2. ANY EARTH SHORTAGES SHALL BE ABSORBED BY ALTERING FINAL CONTOURS IN THE REAR YARD AREAS OF TWO LOTS WEST OF LOWELL ST. AND THE STRIPPINGS AREA.
3. STRIPPINGS SHALL FIRST BE SPREAD WITHIN REAR YARD AREAS NOT FARTHER THAN 15 FT. FROM REAR PROPERTY LINES. THEN EXCESS STRIPPINGS MAY BE PLACED IN DESIGNATED AREA.
4. CART PATH ACCESS SHALL NOT BE DISRUPTED ACROSS SKY VALLEY. EXTREME CARE SHALL BE TAKEN BY MACHINERY OPERATORS TO ENSURE SAFETY OF GOLFERS.

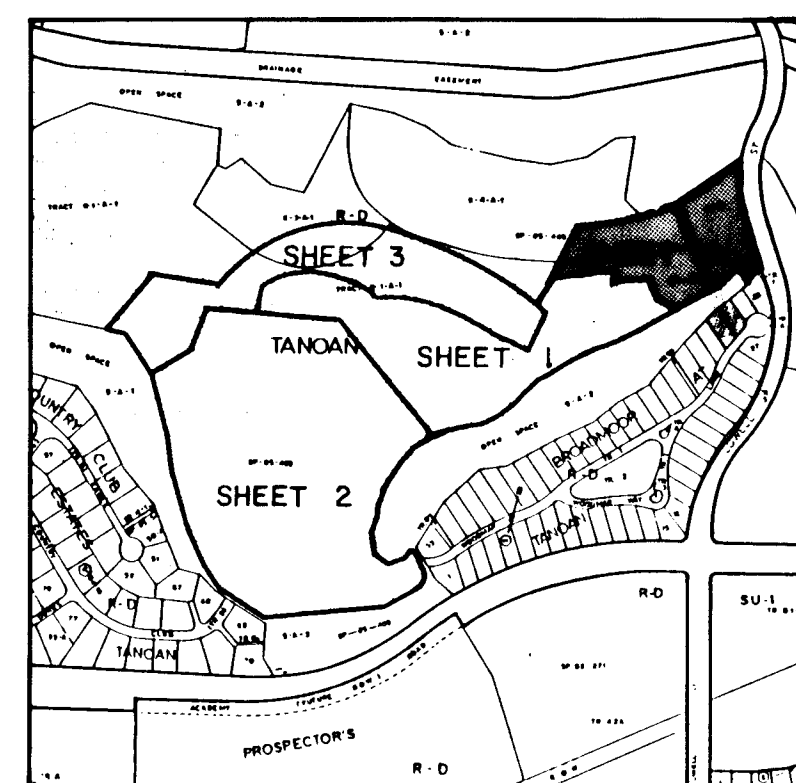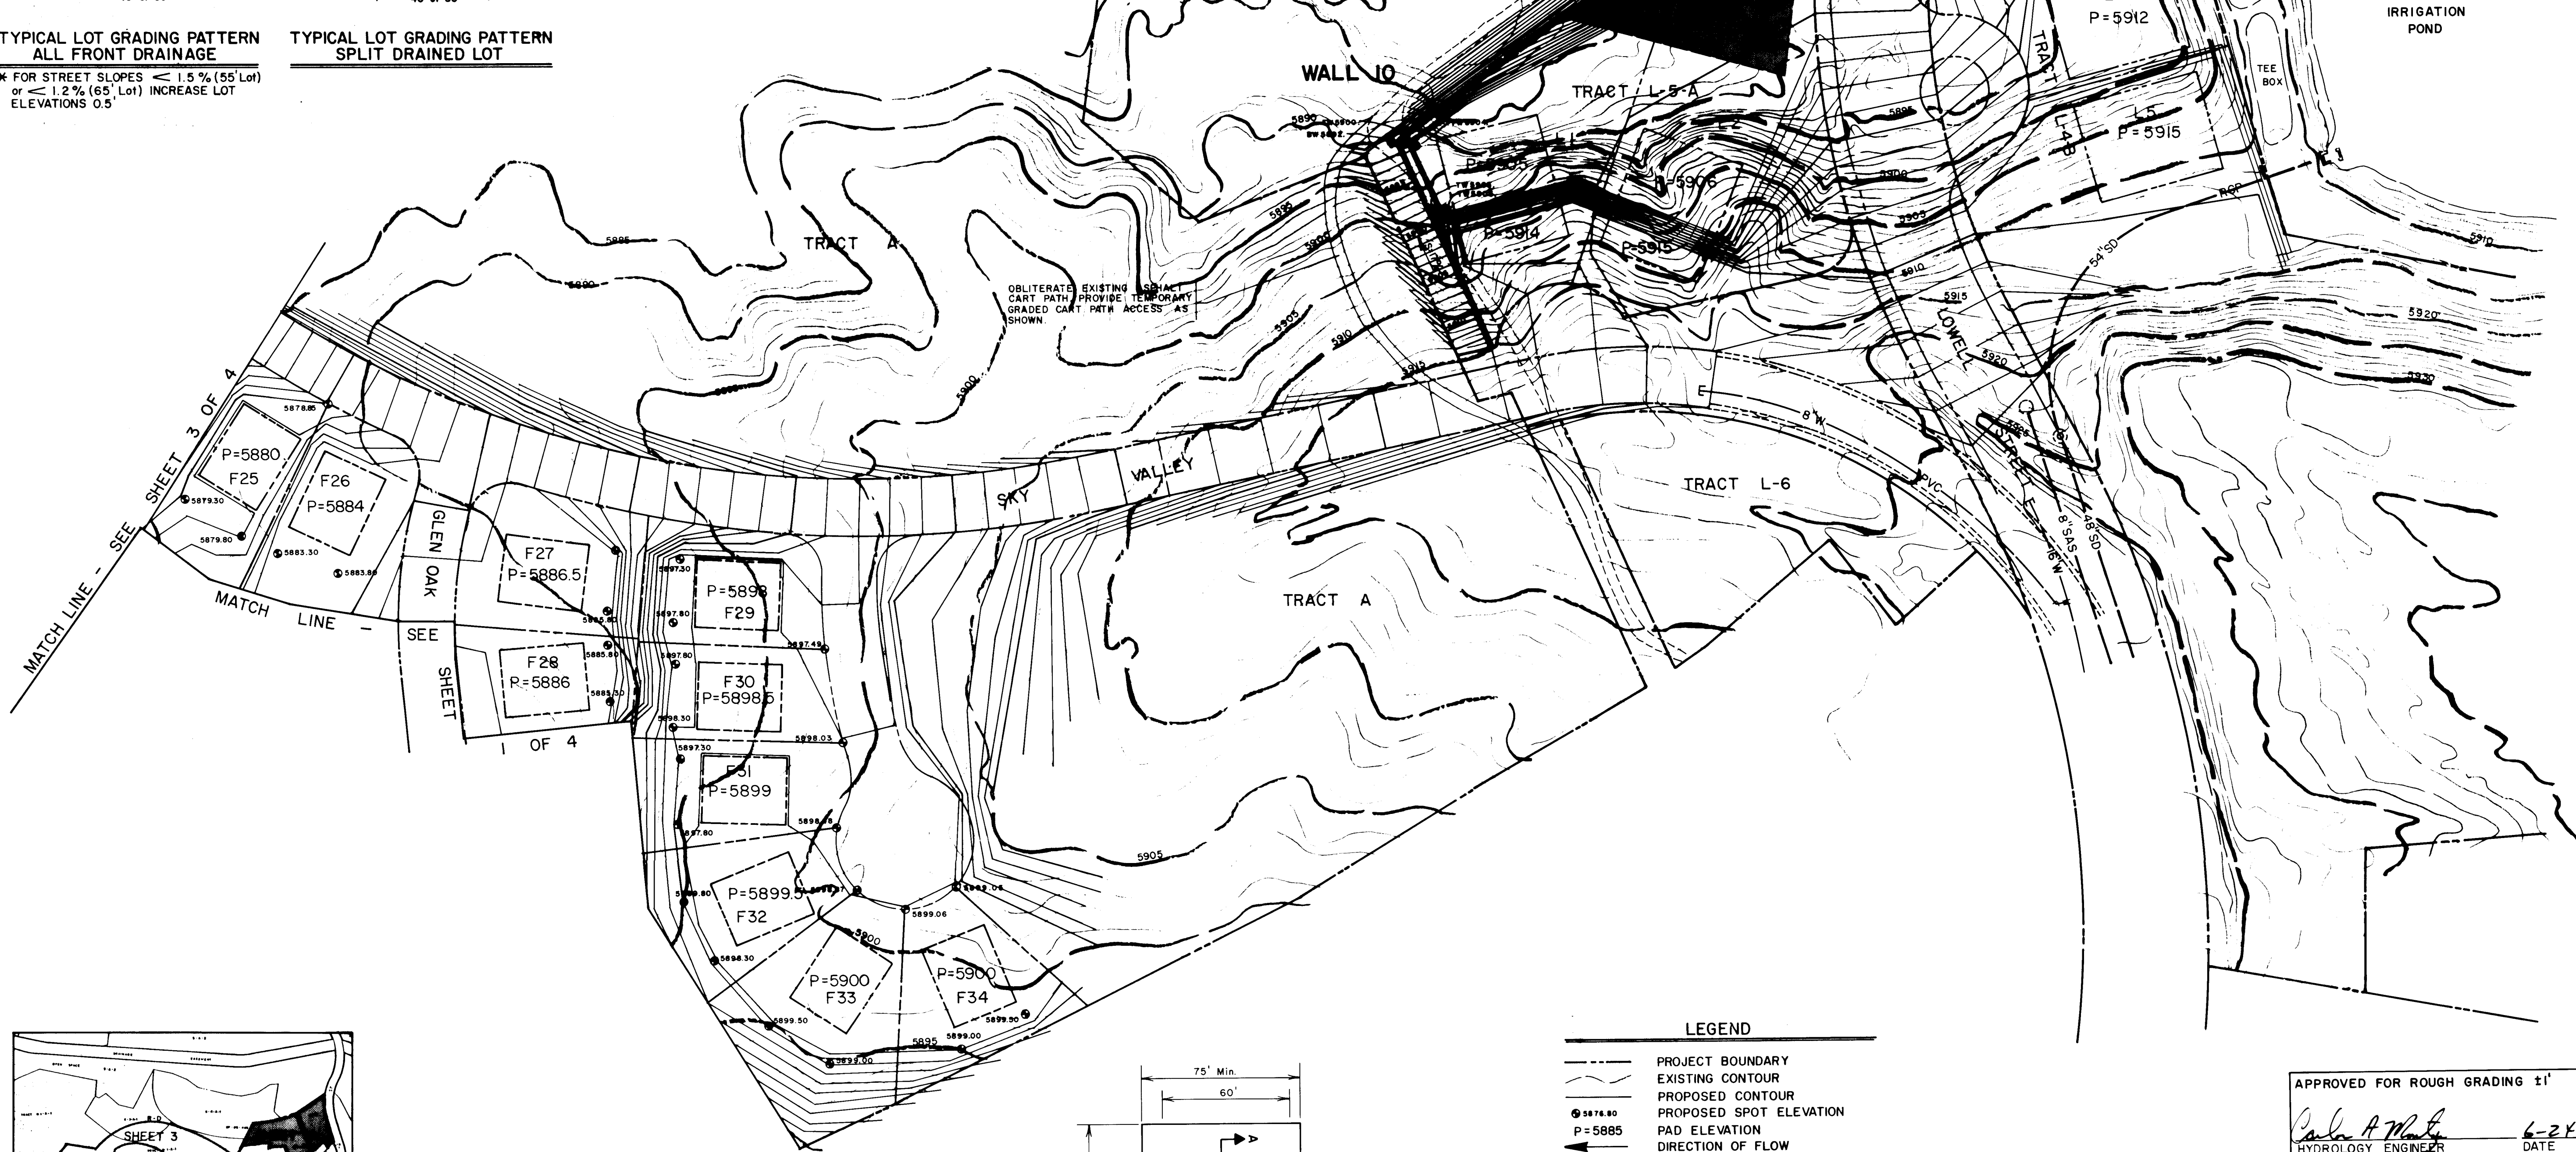

GRADING KEY MAP

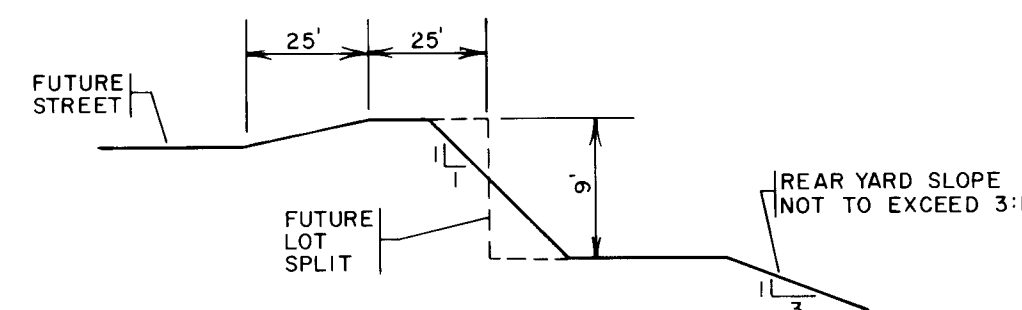

SECTION A-A

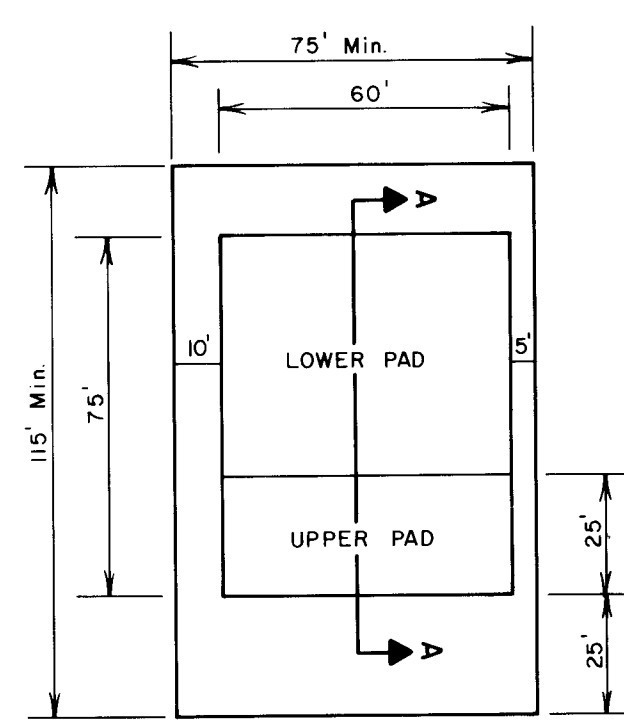

TYPICAL LOT GRADING PATTERN TRACTS L-4 & L-5

LEGEND

---	PROJECT BOUNDARY
---	EXISTING CONTOUR
---	PROPOSED CONTOUR
●	PROPOSED SPOT ELEVATION
○	PAD ELEVATION
→	DIRECTION OF FLOW
---	RETAINING WALL
---	BASIN BOUNDARY
---	SUB-BASIN BOUNDARY
Q	BASIN DISCHARGE
Q _s	COLLECTED FLOW IN STREET
Q _p	PIPE FLOW
---	EXISTING STORM DRAIN LINE
---	PRIVATE DRAINAGE RUNDOWN
Δ	CHANGE IN STREET SLOPE

SEE SHEETS 1 & 2 FOR EARTHWORK SPECIFICATIONS

FOR INFORMATION ONLY

BHI JOB N° 724 20
 SCALE: 1" = 50'

APPROVED FOR ROUGH GRADING $\pm 1'$
 Hydrology Engineer
 6-24-87
 DATE


CITY OF ALBUQUERQUE
 PUBLIC WORKS
 ENGINEERING

TITLE: DESERT CLASSIC AT TANOAN - PHASE I
 DRAINAGE/GRADING PLAN
 PERIMETER & EXCESS DEPOSITION


APPROVALS	ENGINEER	DATE	APPROVALS	ENGINEER	DATE
City Engineer	6/24/87		Liquid Waste	N/A DM1	6-24-87
A C E - Design	6/24/87		Traffic	N/A DM1	6-24-87
A C E - Hydrology	6-24-87		Water	N/A DM1	6-24-87

DRAWING NO. 2479
 MAP NO. E-22
 SHEET 4 OF 4


SURVEY INFORMATION		BENCH MARKS		AS-BUILT INFORMATION	
NO.	BY	DATE	CONTRACTOR	NO.	DATE
			THE BENCH MARK IS LOCATED 1.2 MILES EAST OF THE INTERSECTION OF ACADEMY ROAD, NE & EUBANK BLVD. NE THEN 375' S. SOUTH, THE BENCH MARK IS ON THE SOUTH RIM OF THE BEAR CANYON TRIBUTARY & IS A STANDARD ACS BRASS TABLET STAMPED "G-E22 LS4972" ELEVATION 5934.53'		

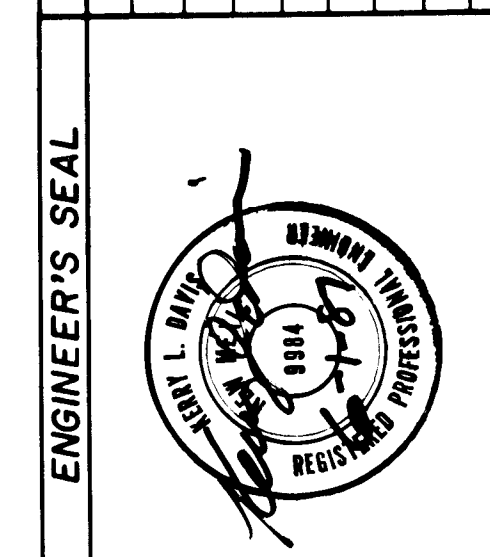


NO.	DATE	REVISIONS
		DESIGN
		REVISIONS
		DESIGNED BY
		DRAWN BY
		CHECKED BY

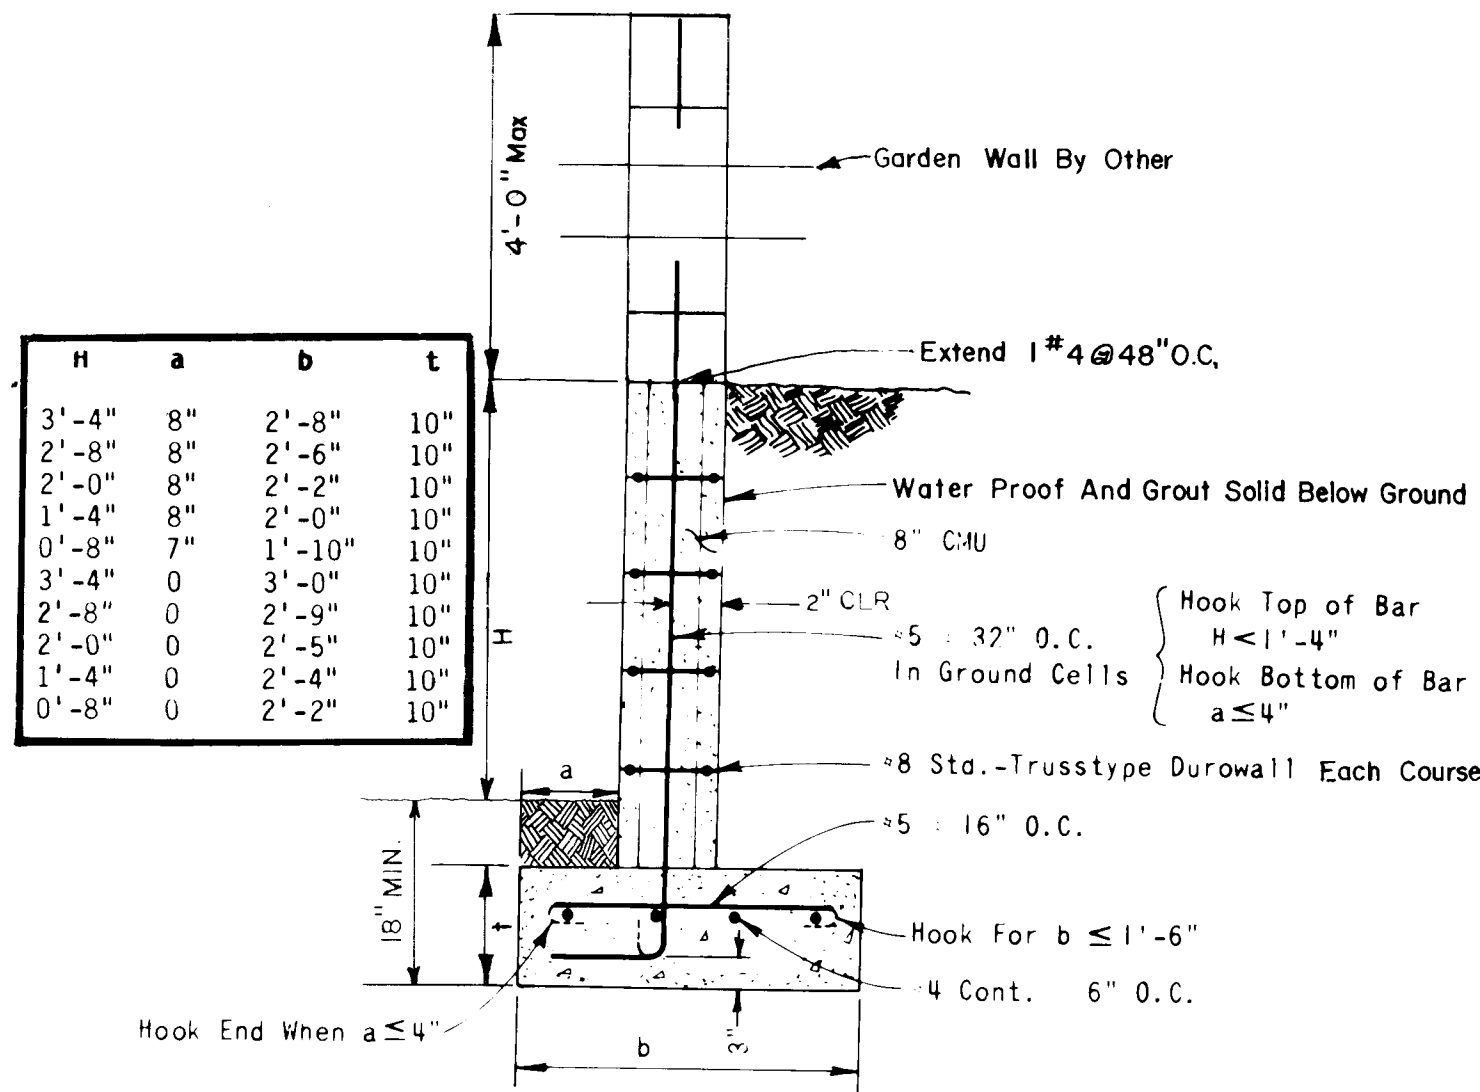


WALL I
REINFORCED CONCRETE MASONRY WALL
0 to 3'-4"

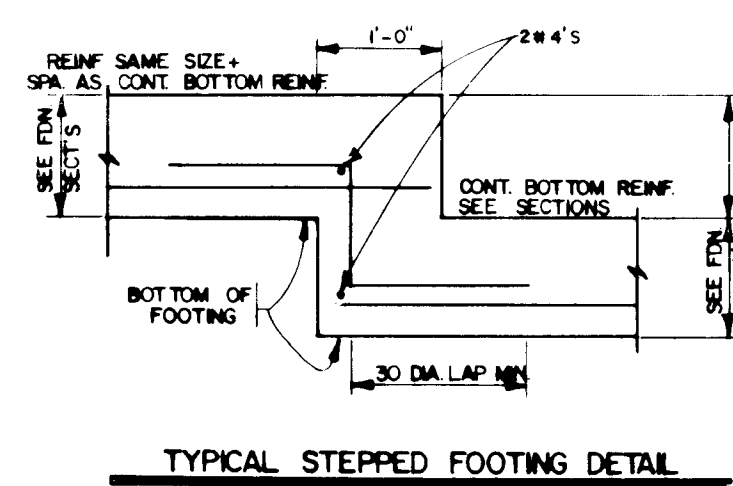

COPYRIGHT © 1986, BOHANNAN-HUSTON, INC. These documents are instruments of service and remain the property of the Engineer. No use or reuse of the documents shall be permitted unless authorized in writing by Bohannan-Huston, Inc. with proper compensation.

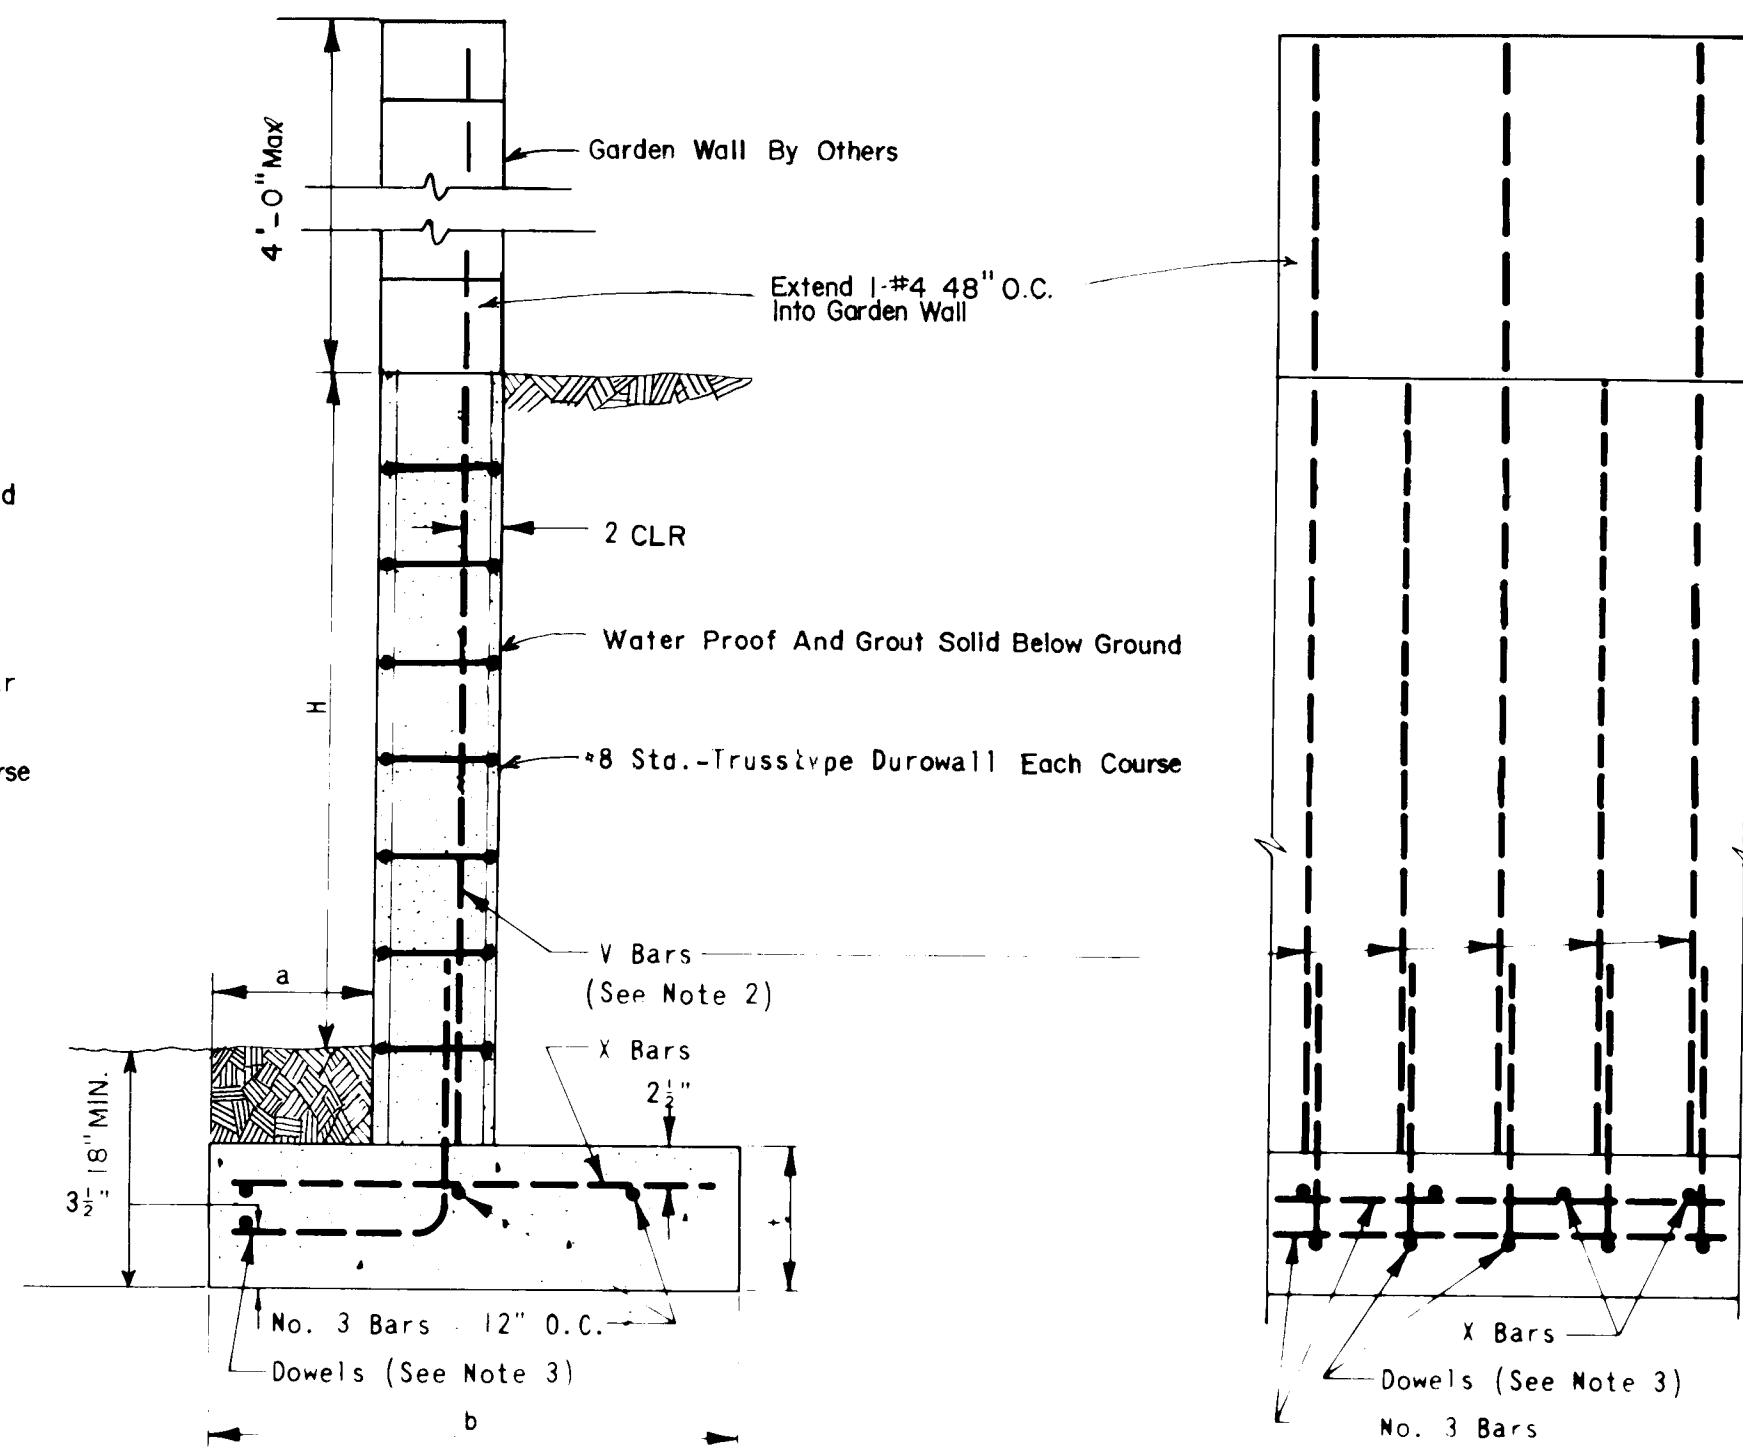

WALL II
REINFORCED CONCRETE MASONRY WALLS
3'-4" to 6'-0"



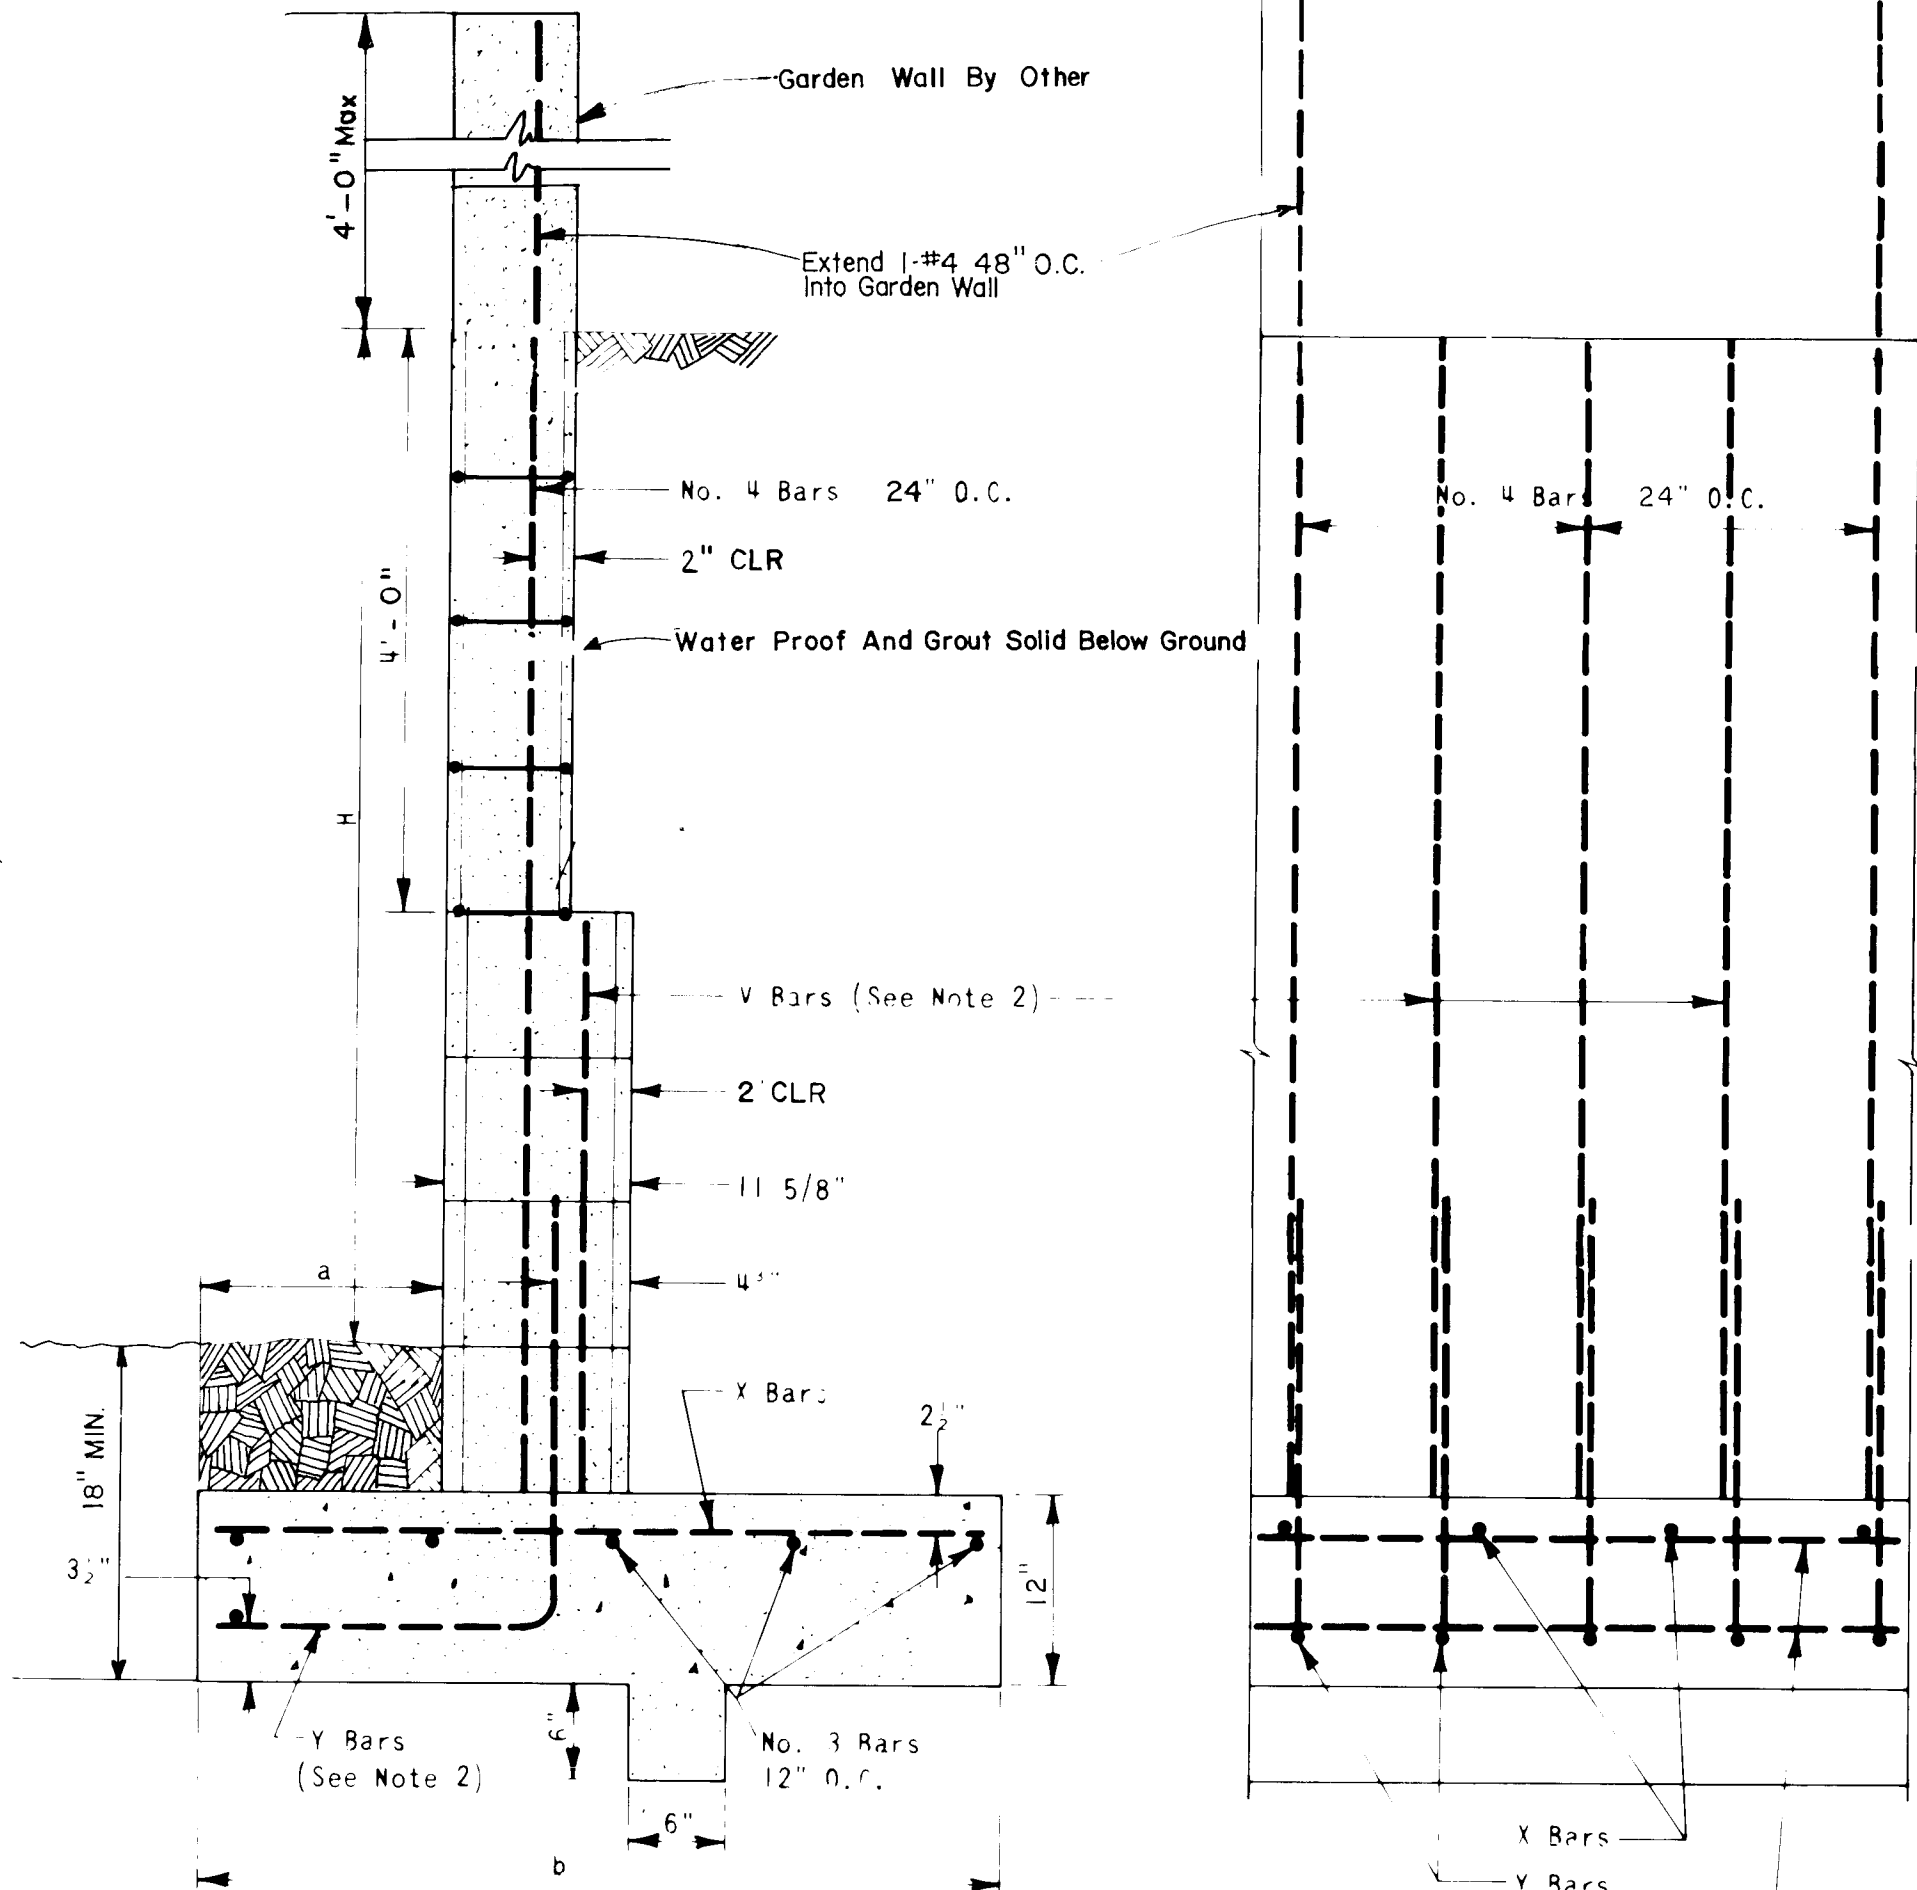


WALL III
REINFORCED CONCRETE MASONRY - 8" & 12" WALLS

GENERAL NOTES


- Retaining wall footings shall be placed on a minimum of 2'-0" of engineered fill extending a minimum of 2'-0" from the edge of the footing and compacted to a minimum of 95% optimum density (ASTM D-1557). Backfill shall be free draining material and shall be placed in 8" loose lifts and compacted to 90% optimum density (ASTM D-1557) with light vibratory compacting equipment.
- Retaining wall shall not be back-filled until at least 7 days after placing of final grout level. Where heavy equipment is used in back-filling walls designed to resist earth pressure only, such equipment should not approach closer to the top of the wall than a distance equal to the height of the wall. Care should be taken to avoid exerting large impact forces on the wall as could be caused by a large mass of moving earth. All walls are designed for level backfill only. Slopes up away from walls should not exceed 10:1.
- Vertical control joints with PVC inserts shall be placed at intervals not to exceed 30'-0" on center. Pilasters may be substituted for control joints when placed at 12'-0" intervals. Discontinue durowall each side of pilasters.
- Minimum lap splice on reinforcing bars shall be 30 bar diameters or 1'-6" minimum. Reinforcement of a size and spacing other than that given in the tables may be used providing such other reinforcement furnishes an area of steel area at least equal to that given in the table.
- Construction of retaining walls shall conform to requirements of the Uniform Building Code Section 24, low lift grouting method.
- Omission of a vertical mortar joint on first course at 48" O.C. may be substituted for PVC weep holes. White slump block with a minimum compressive strength of 1500 psi may be substituted for standard CMU Grade N.
- DESIGN DATA
Block Weight 12" = 130 pcf.
Block Weight 8" = 85 pcf.
Soil Weight = 130 pcf.
Equiv. Fluid Pressure = 43 pcf.
Soil Bearing Pressure = 1500 pcf.
(1/3 Increase for Wind/Settle)
Coefficient of Friction = 0.4
Passive Soil Pressure = 390 pcf.
Concrete f'c (28 days) = 3000 psi
Grout Strength = 2000 psi
CMU Grade N = 1500 psi (Grouted)
Reinforcement = 60 psi ASTM A-615.

THIS SHEET FOR INFORMATION
ONLY. A SEPARATE BUILDING
PERMIT IS REQUIRED FOR
RETAINING WALL CONSTRUCTION.

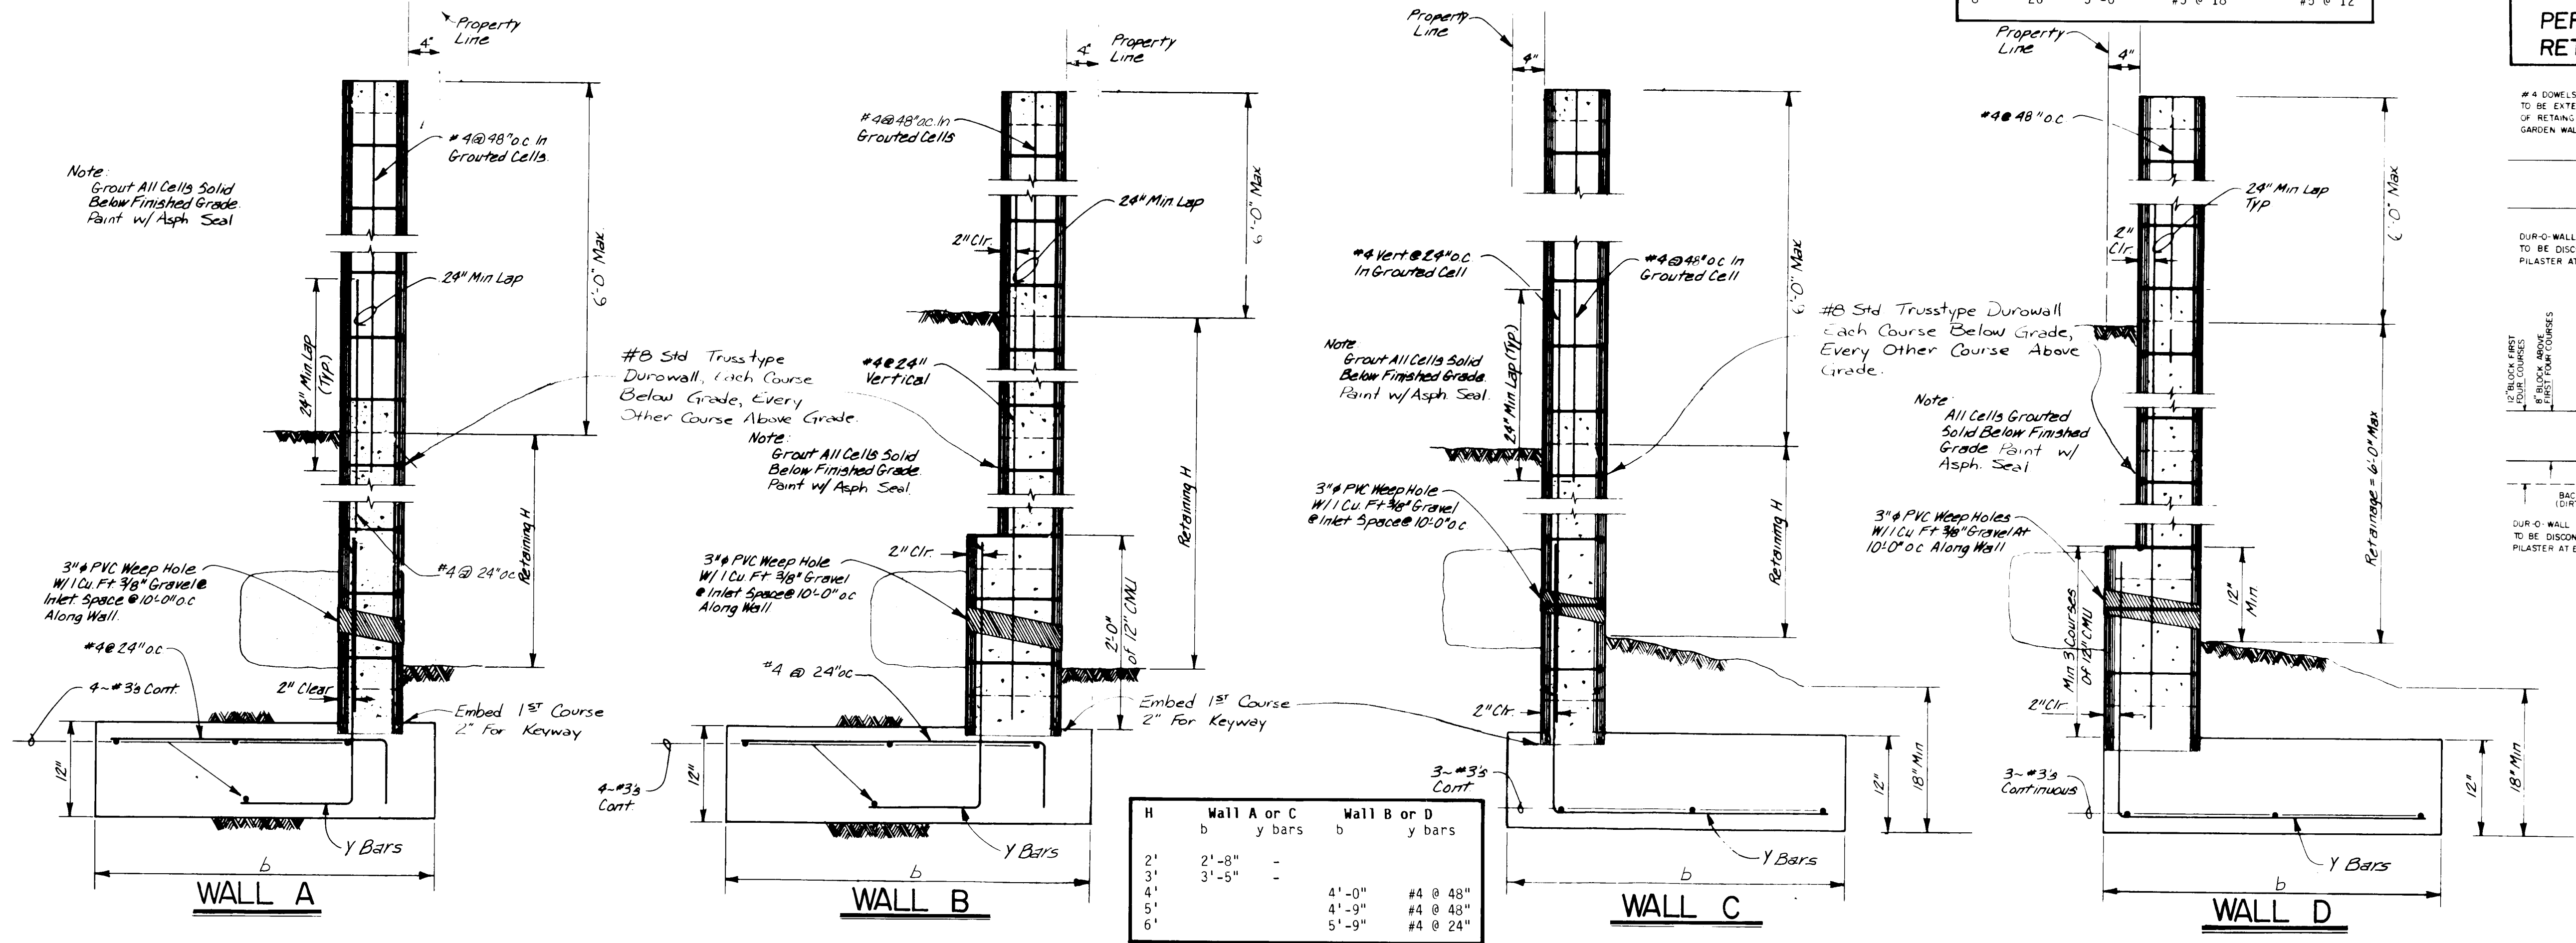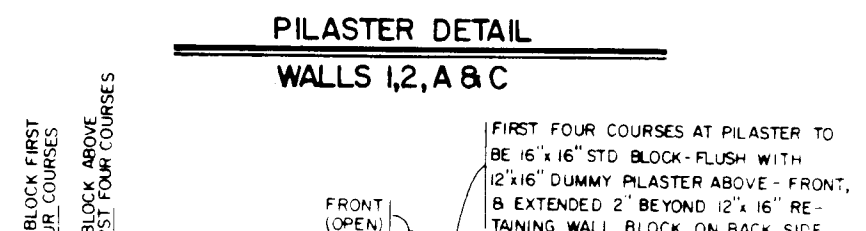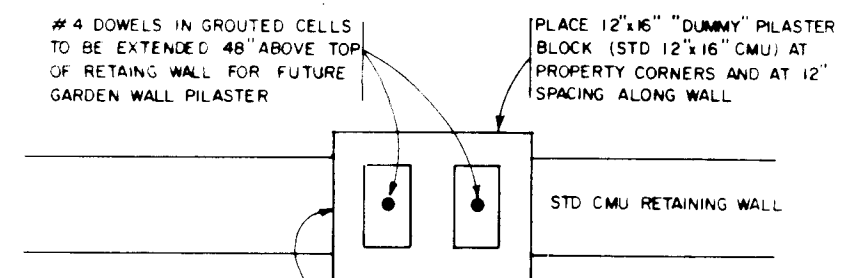


CITY OF ALBUQUERQUE MUNICIPAL DEVELOPMENT DEPARTMENT ENGINEERING DIVISION					
TITLE DESERT CLASSIC AT TANOAN - PHASE I RETAINING WALL DETAILS					
APPROVALS	ENGINEER	DATE	APPROVALS	ENGINEER	DATE
D.R.C. Chairperson			Parks & Rec. Dept.		
Trans. Dev.	NA		User Dept.	NA-DWH	6/24/87
Utility Dev.	NA	6-24-87	User Dept.	NA-CAN	6-24-87
DRAWING NO.	2479	MAP NO. E-22	SHEET 9A	OF 29	


ORIGINAL								
SURVEY	SURVEYED _____	BY _____						DATE _____
NOTE BOOK	PLOTTED _____							
	TEMPLATE _____							
	AREAS _____							
NO.	AREAS CHECKED _____							

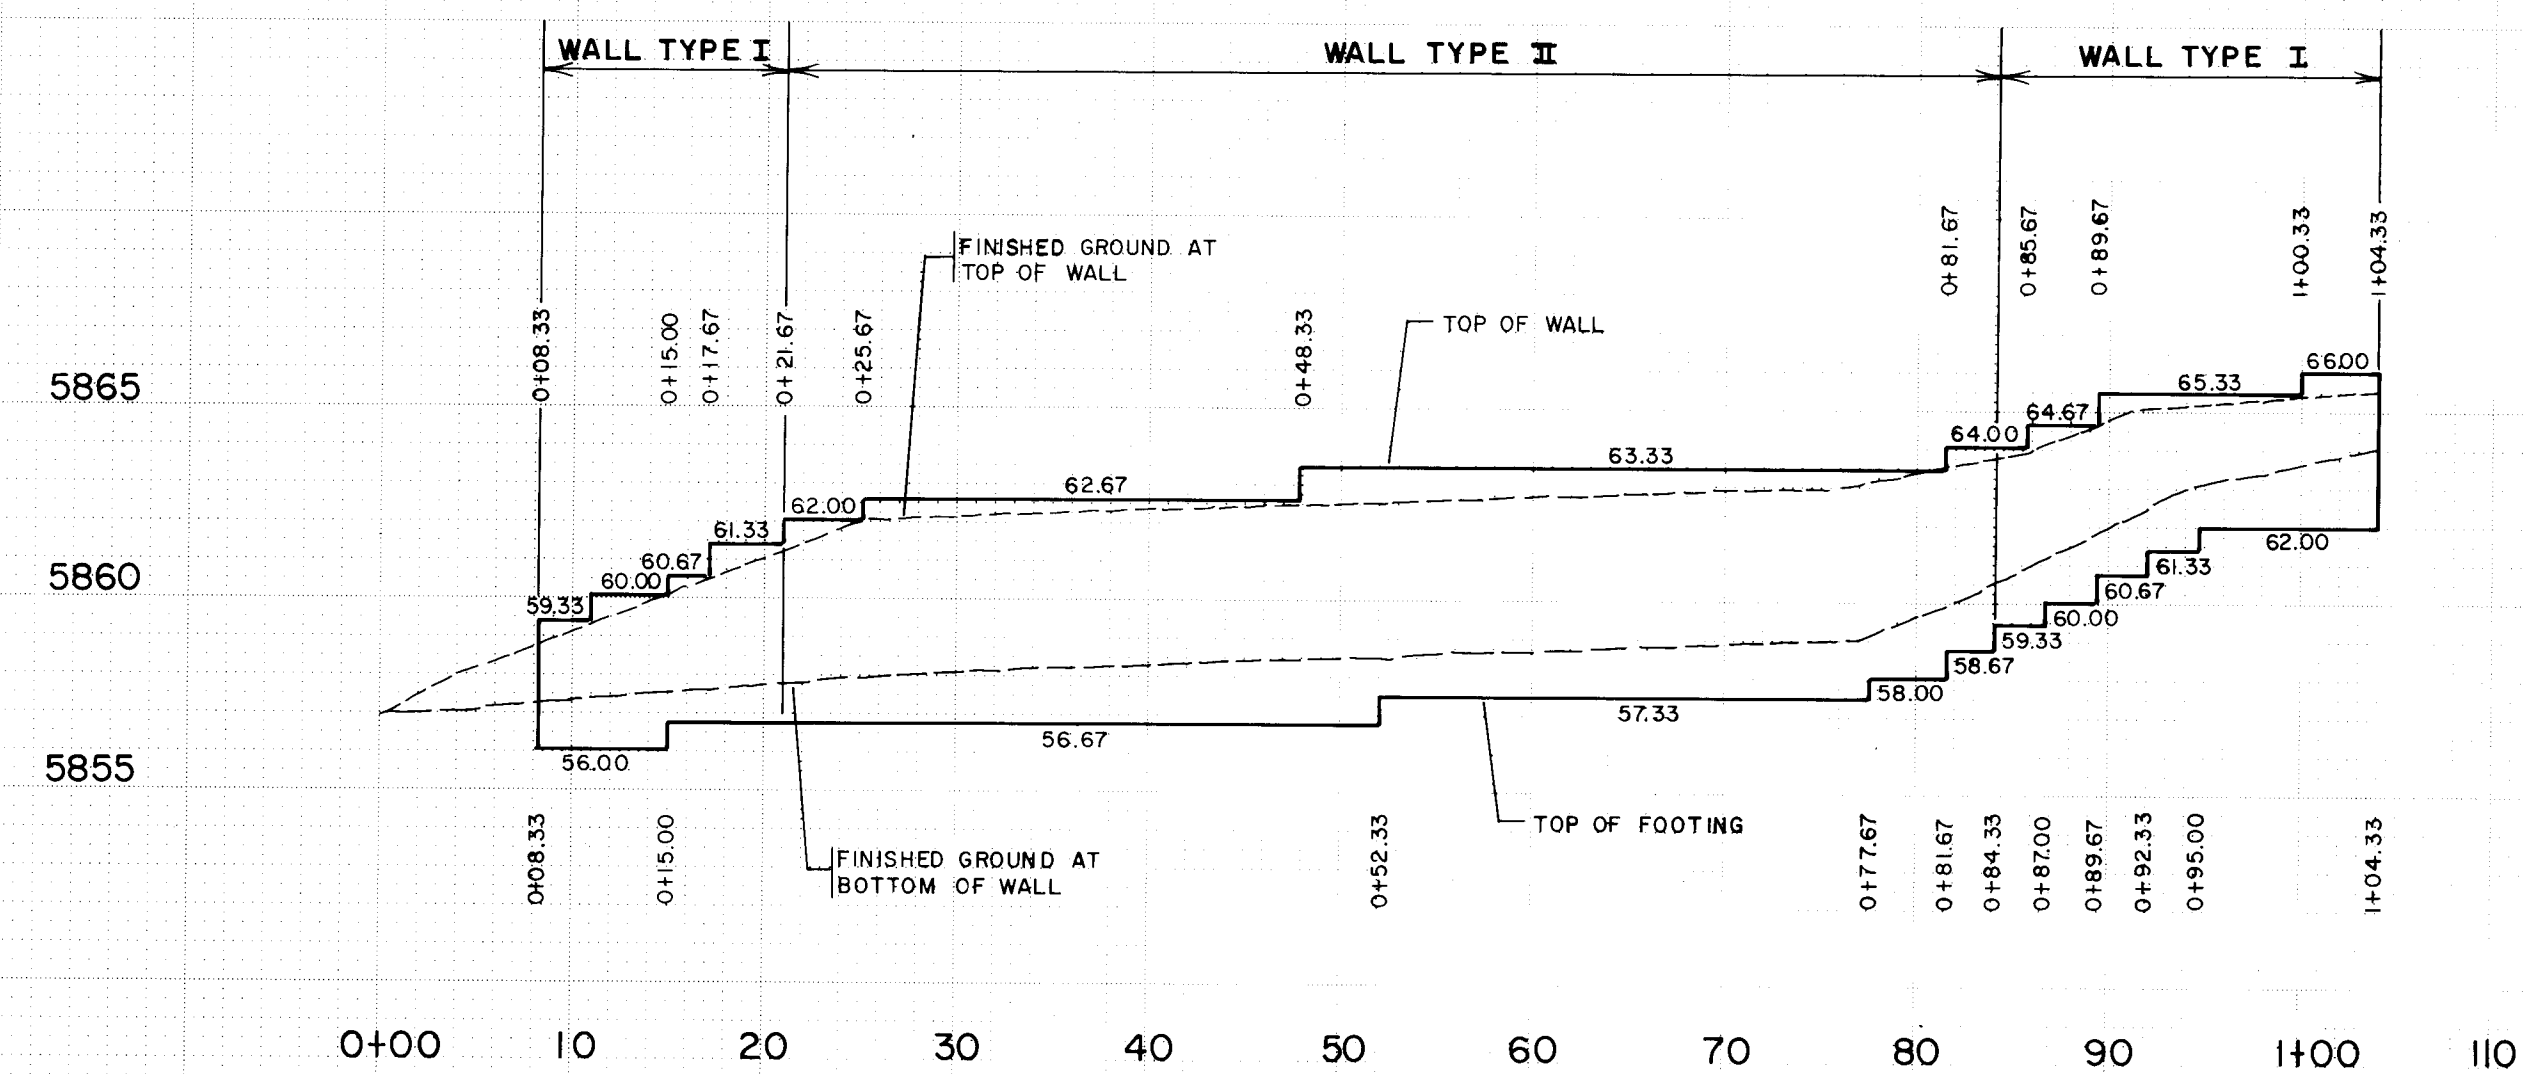

WALL 1

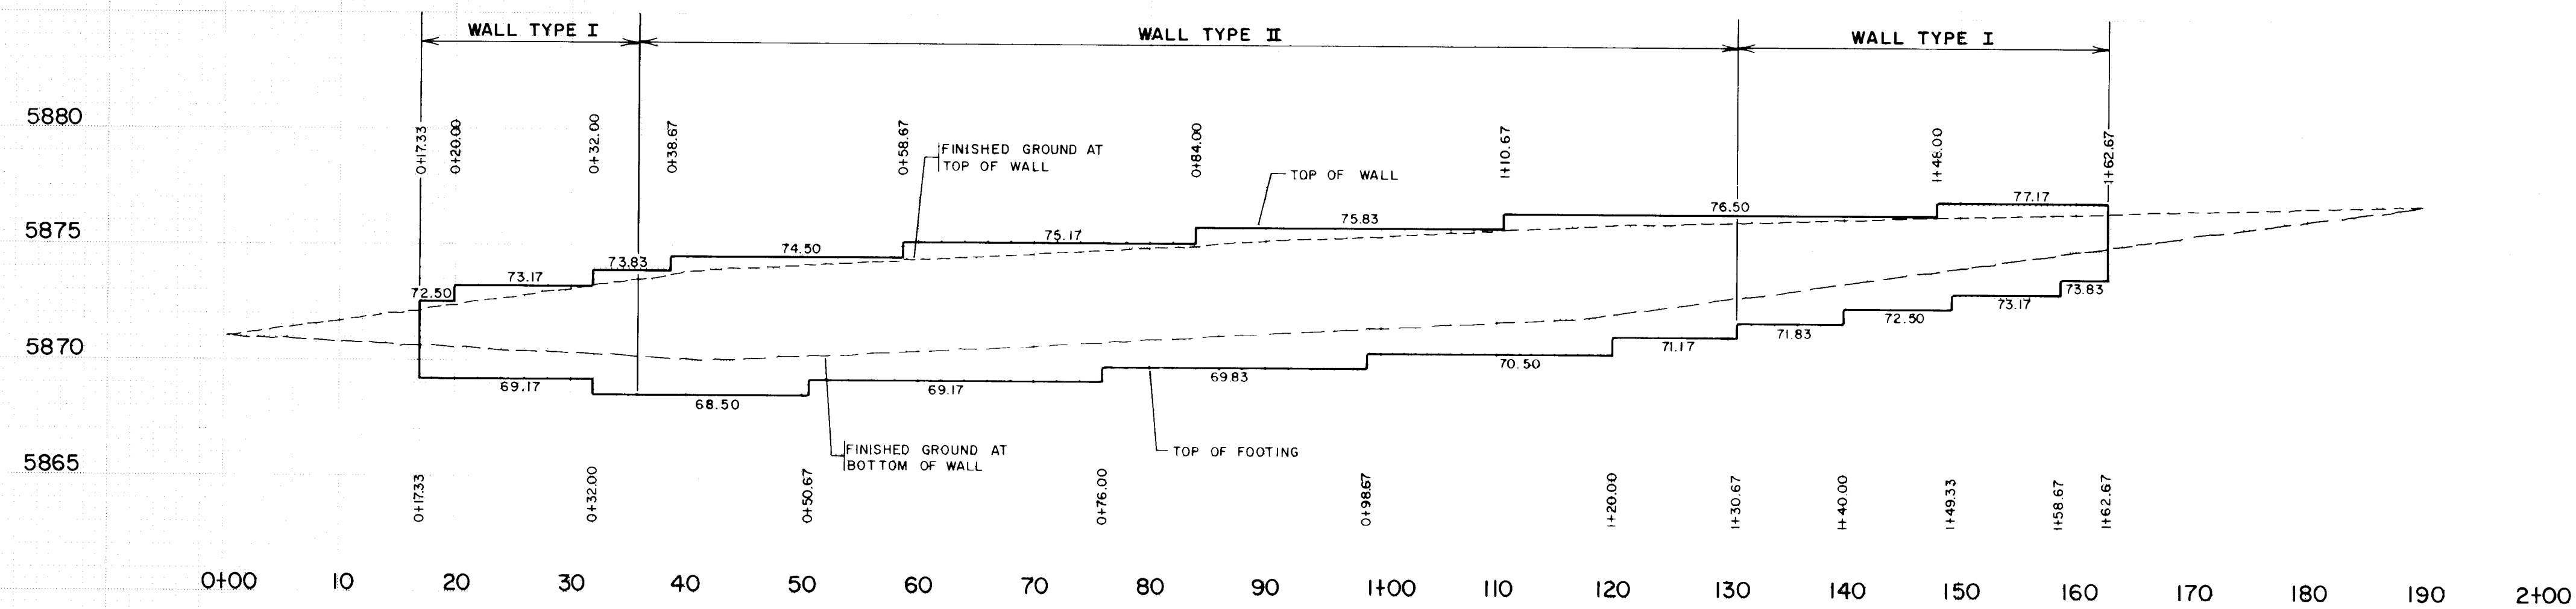

WALL 2

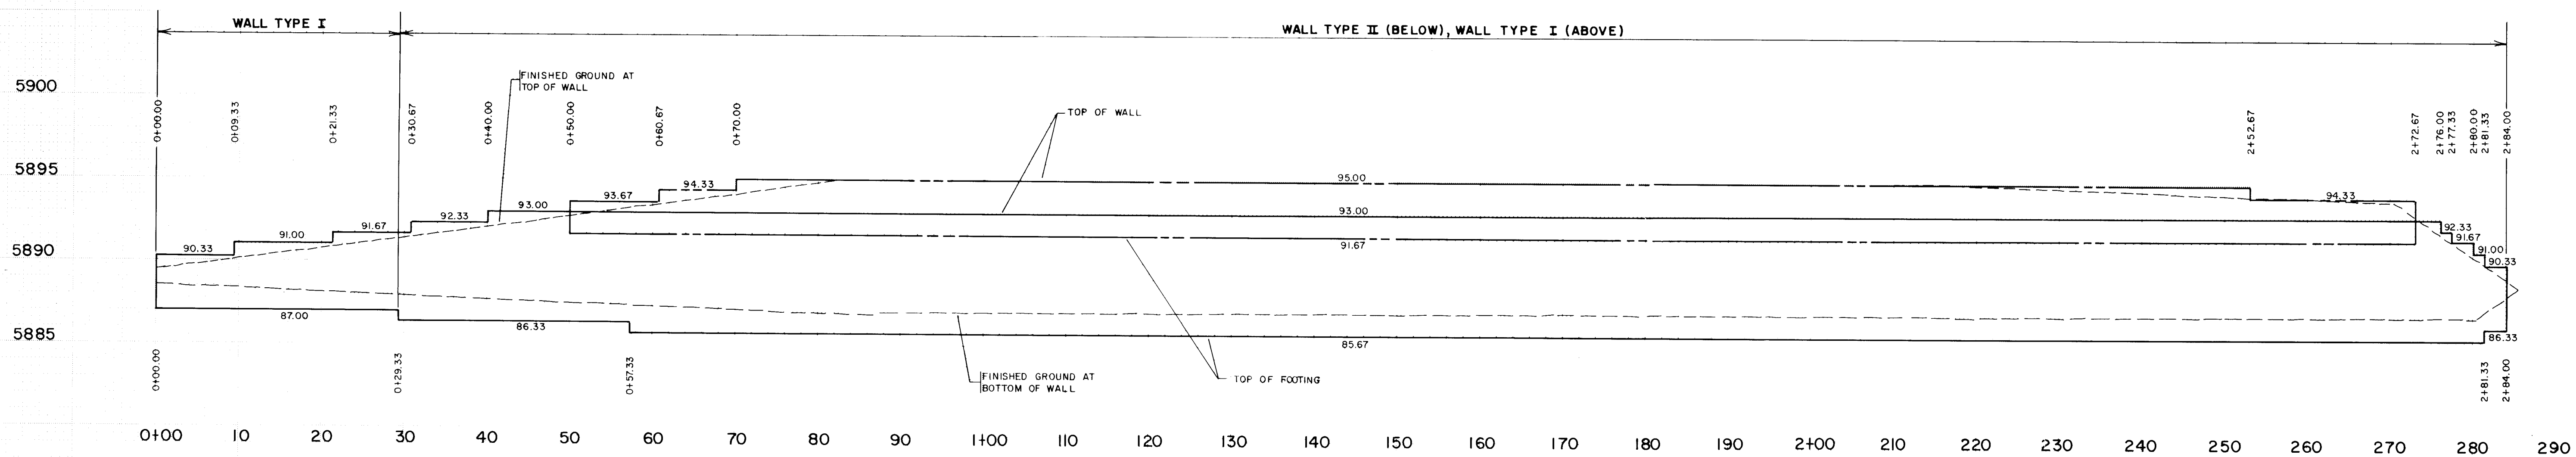

WALL 3

1	2	3	4	5	6	7	8	9	10	11	12
26			24	7	9	1	1	8	8		




BHI JOB Nº 71263

PROJECT NO. 2479

SHEET **9B** OF 29

PLATE 3 CROSS SECTION - DOTTED
CHARLES BRUNING COMPANY
MADE IN U.S.A.

ORIGINAL SURVEY			BY	DATE
	SURVEYED			
	PLOTTED			
	TEMPLATE			
	AREAS			
	AREAS CHECKED			

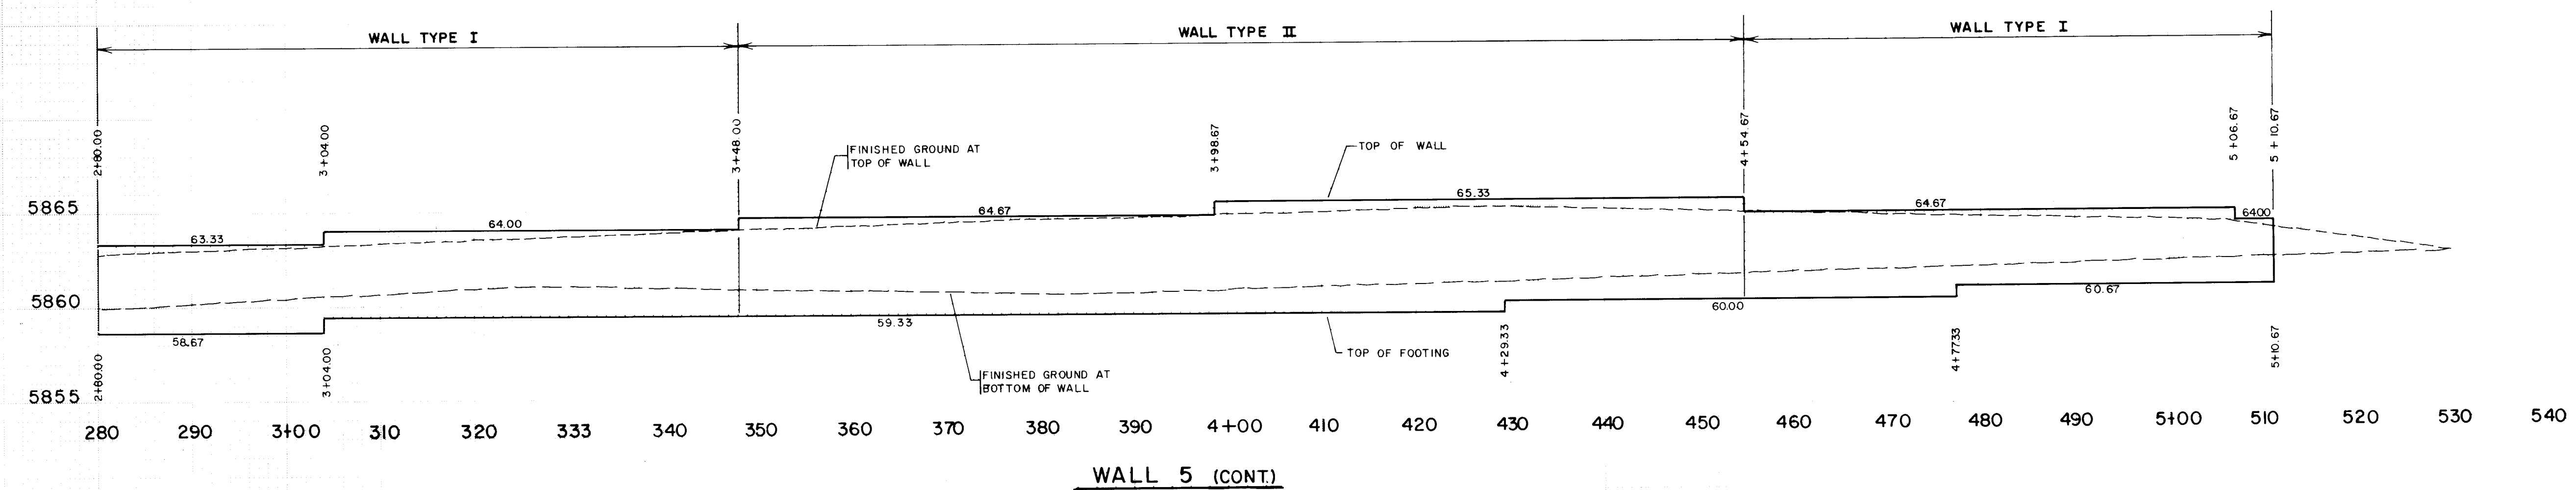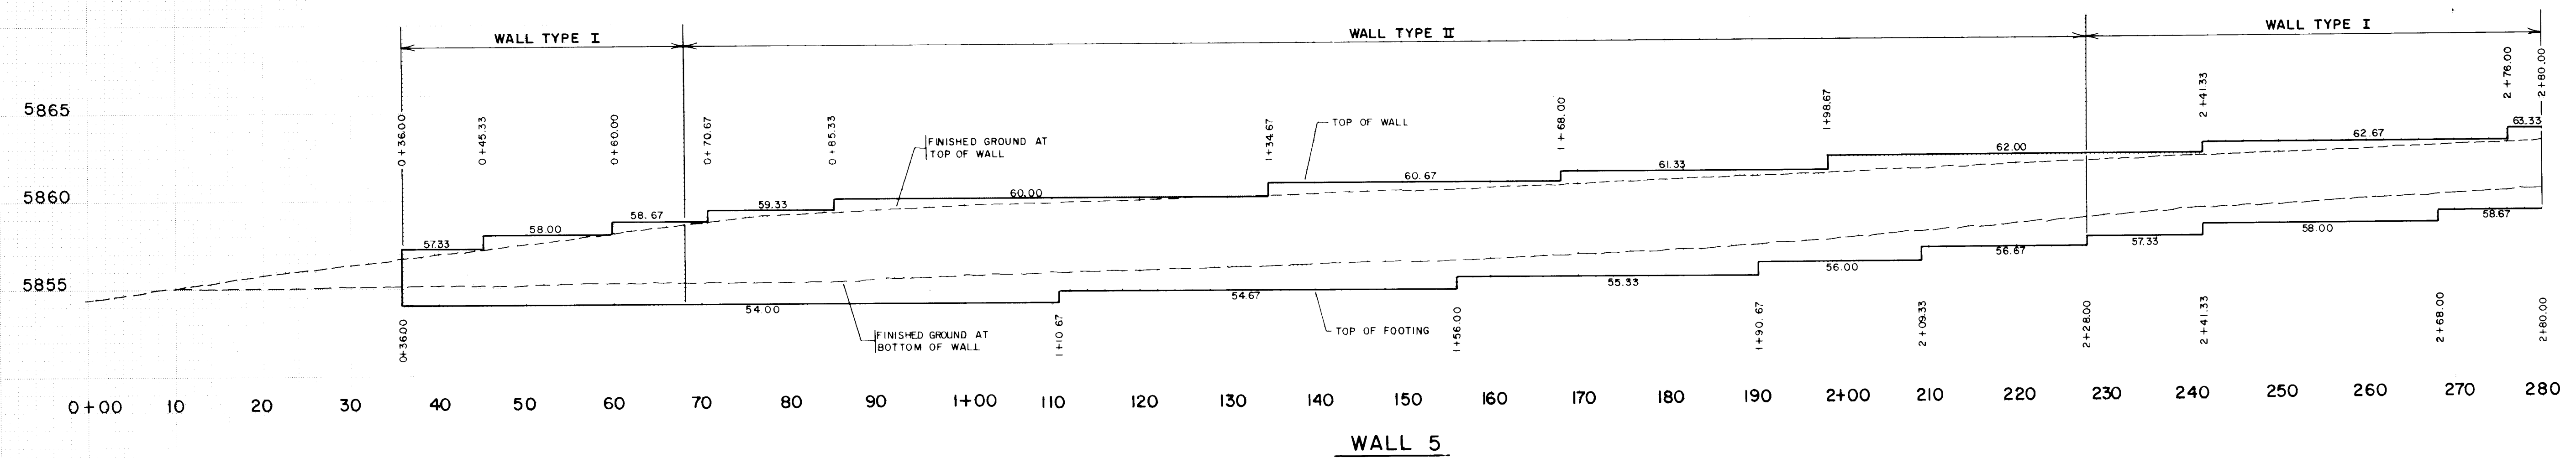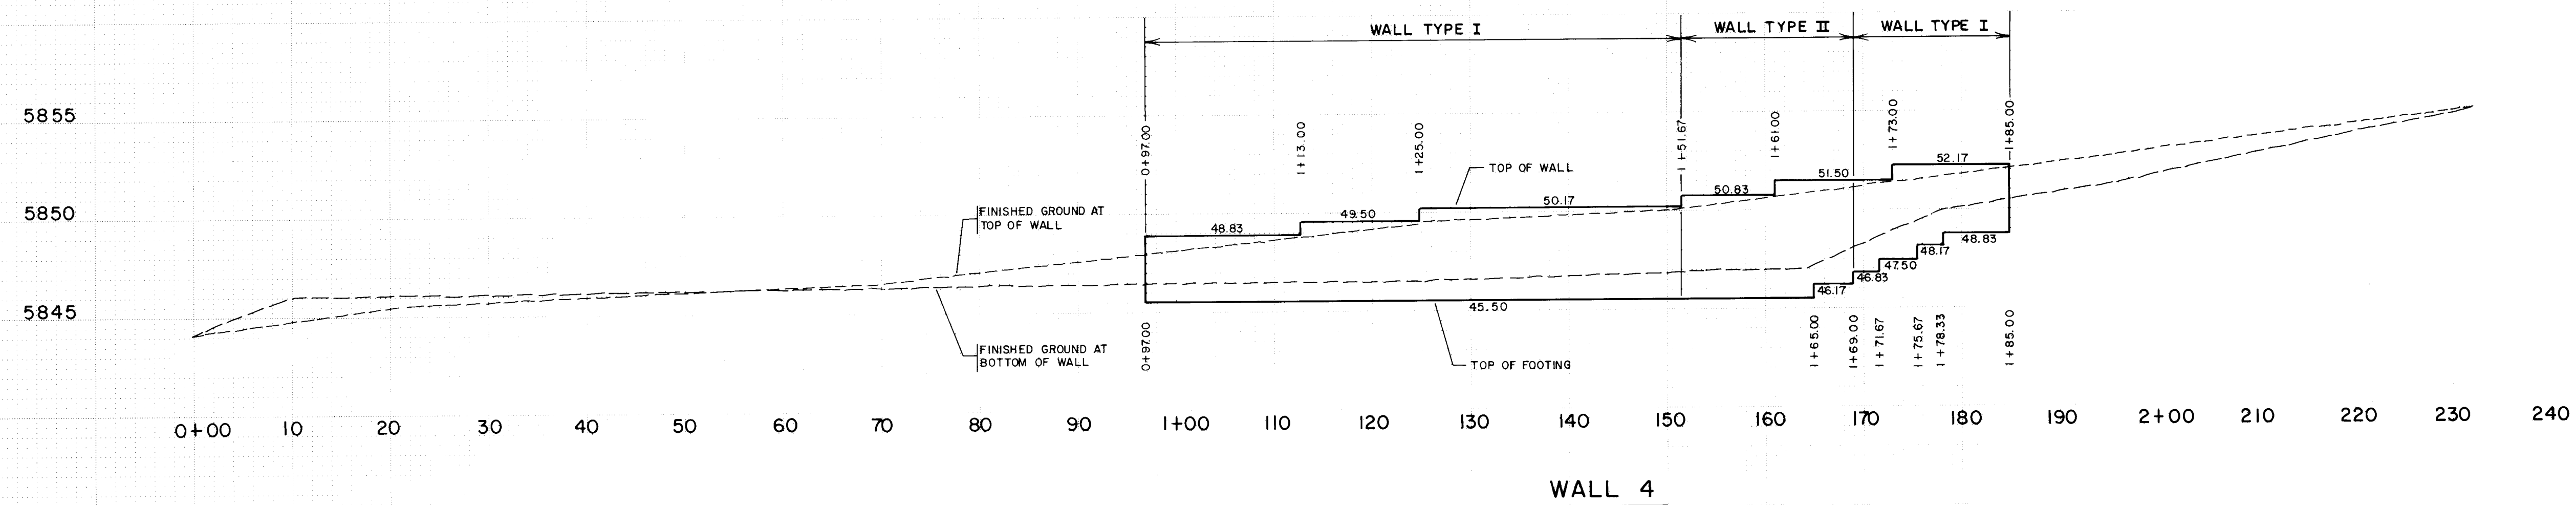

1	2	3	4	5	6	7	8	9	10	11	12
2	6		2	4	7	9	1	2	8	8	


BHI JOB N°71263

PROJECT NO. **2479** SHEET **9C** OF **29**


PLATE 3 CROSS SECTION - DOTTED
CHARLES BRUNING COMPANY
MADE IN U.S.A.

DATE	BY
FINAL SURVEY	
NOTE BOOK	
NO.	


DATE	BY
ORIGINAL SURVEY	
NOTE BOOK	
NO.	

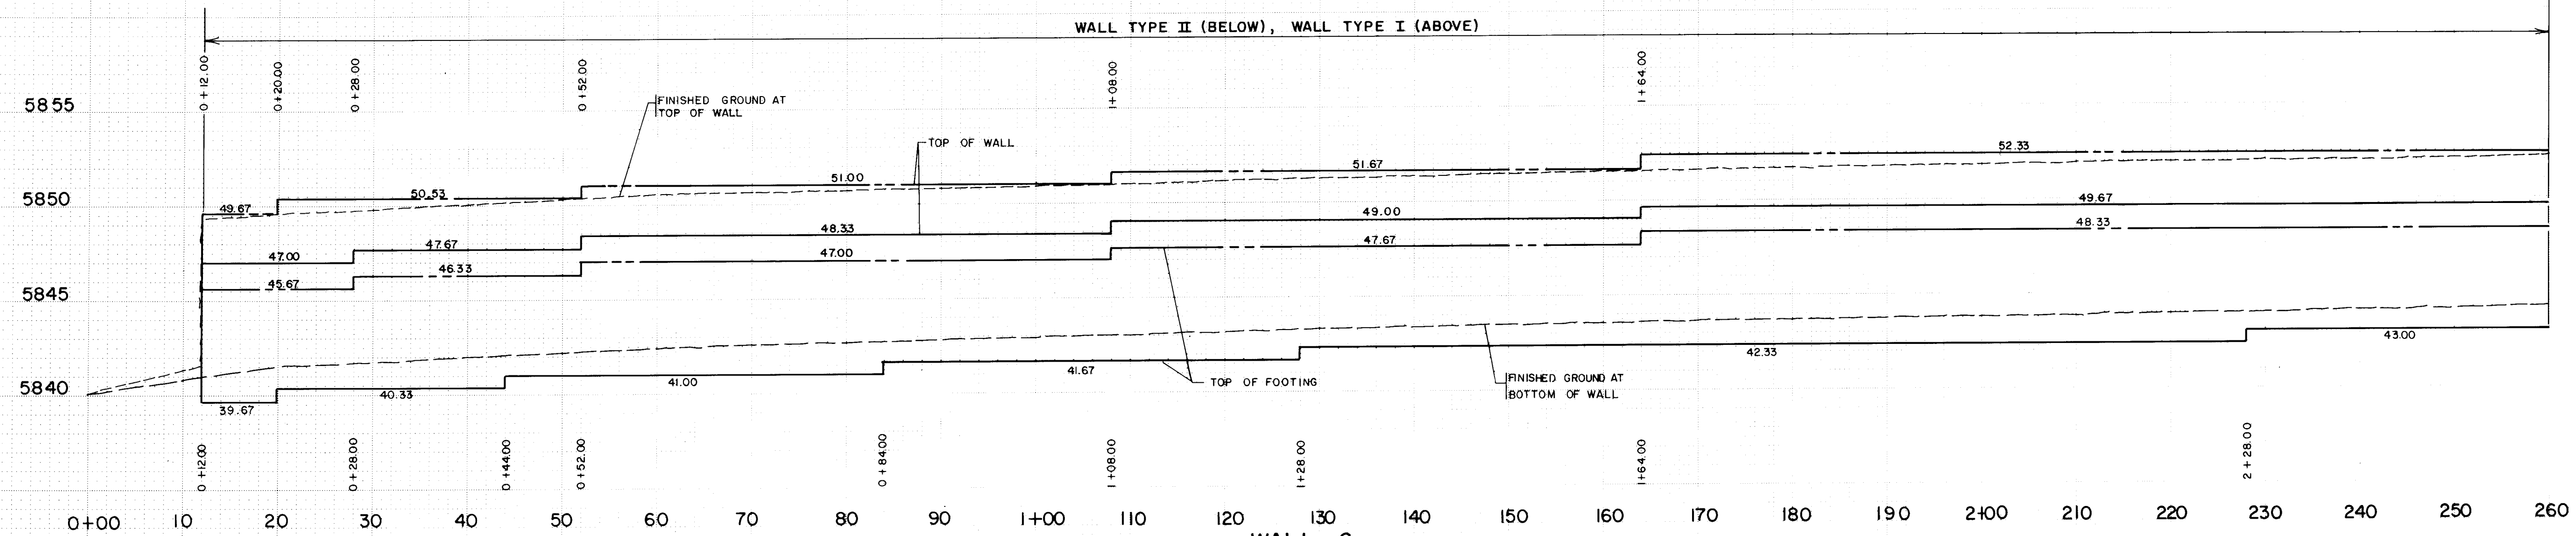

WALL 6

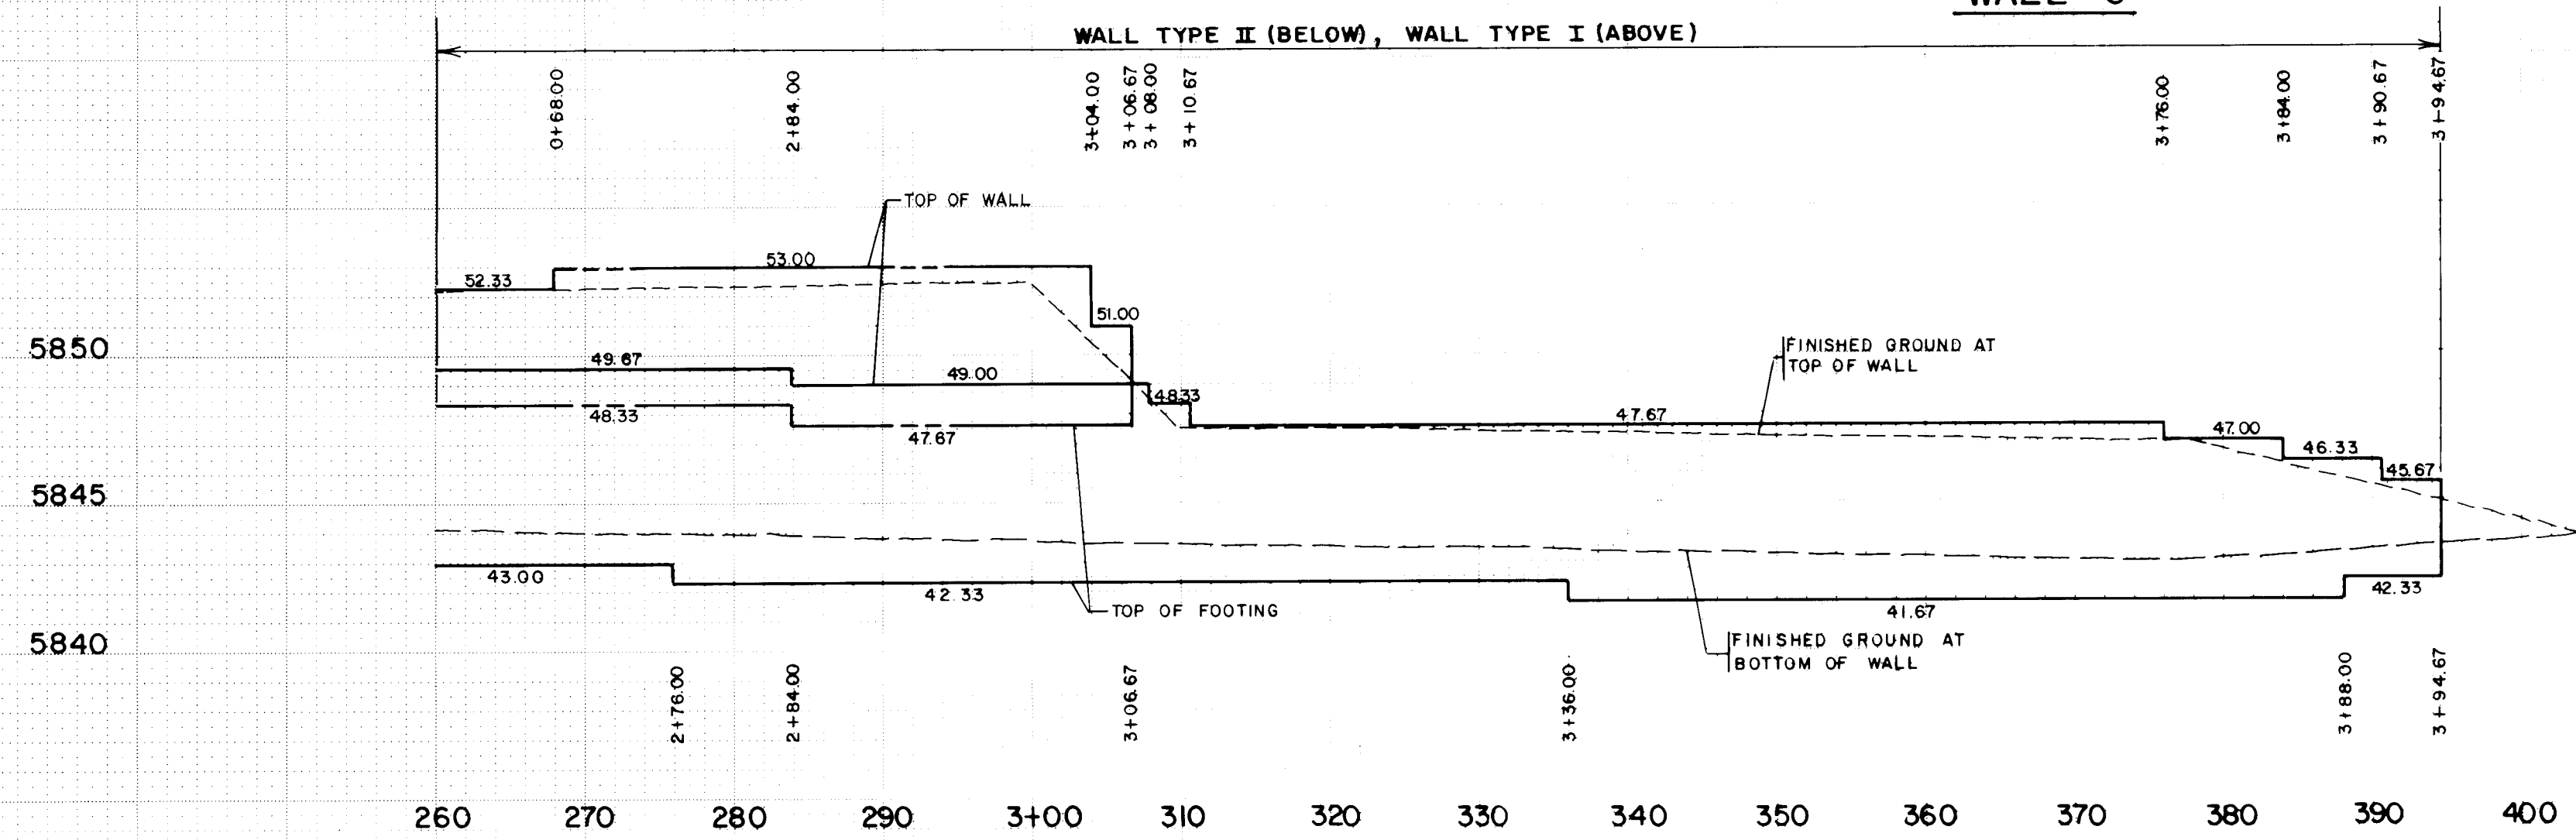




WALL 6 (CONT.)

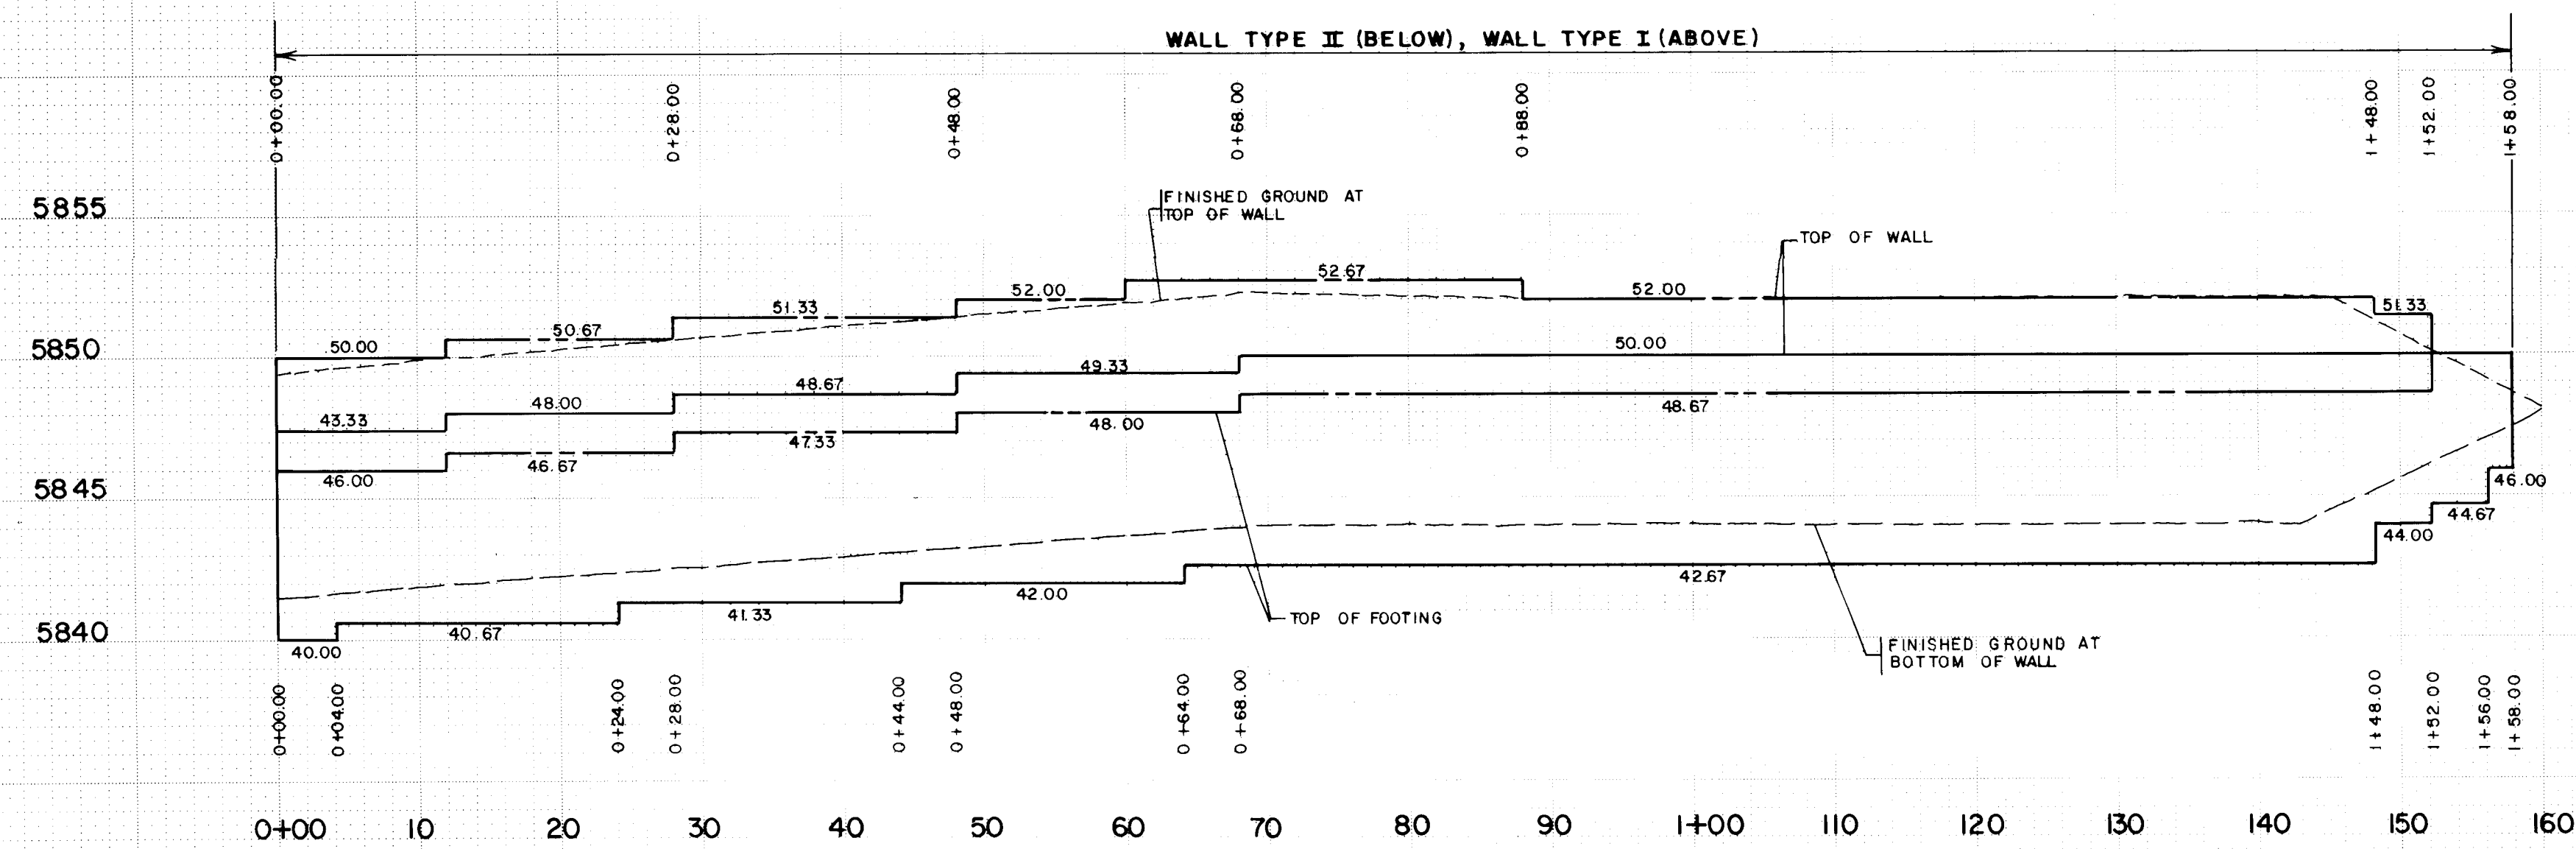

WALL 7



26 24791388

ORIGINAL	SURVEYED _____	BY _____	DATE _____
SURVEY	PLOTTED _____		
NOTE BOOK	TEMPLATE _____		
NO.	AREAS _____		
	AREAS CHECKED _____		

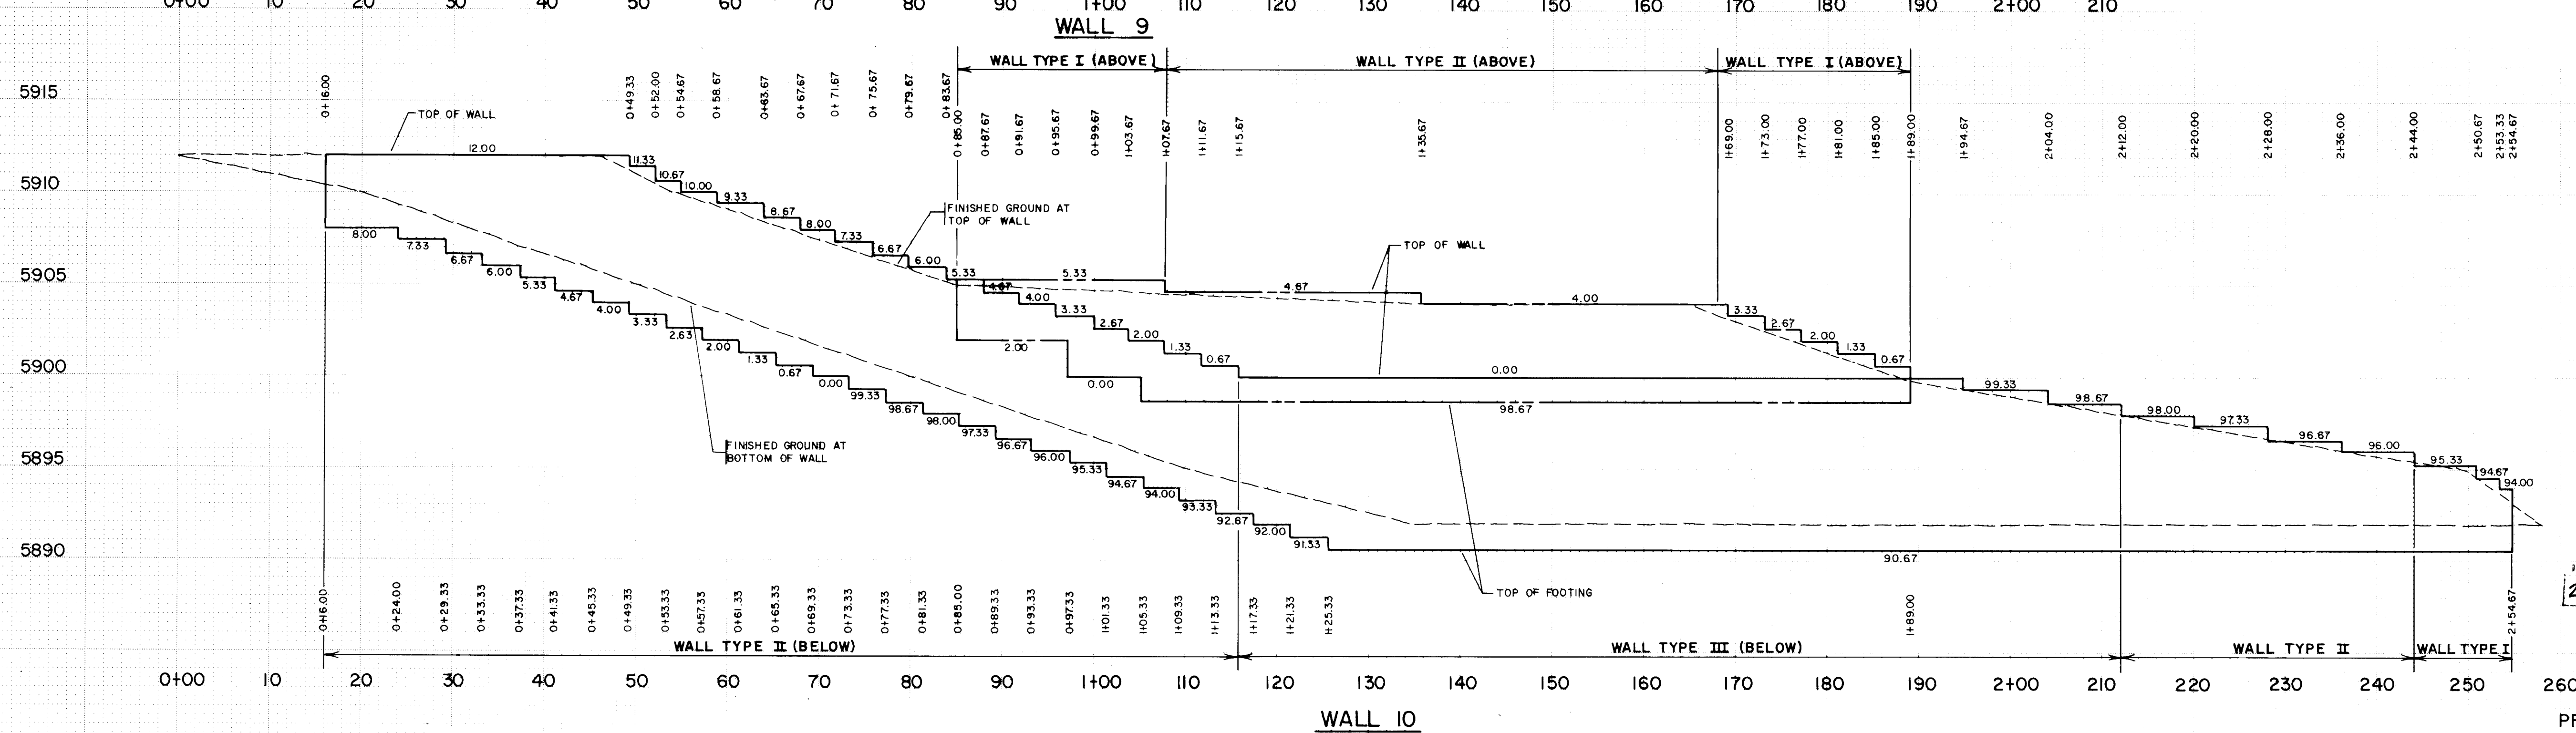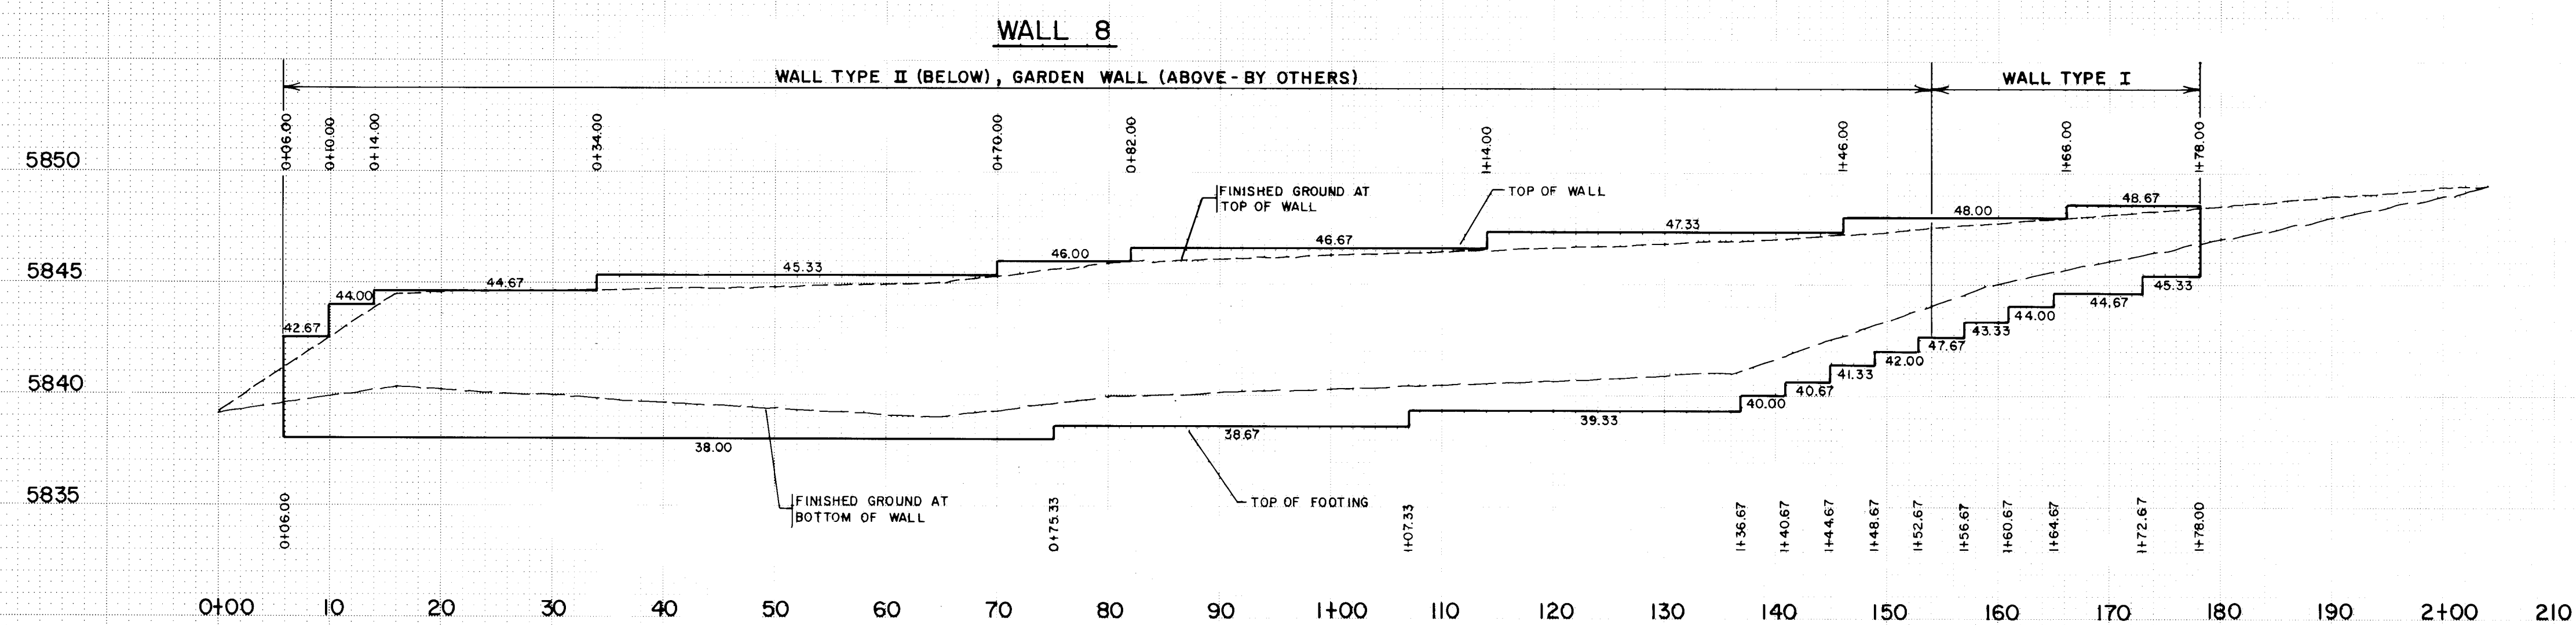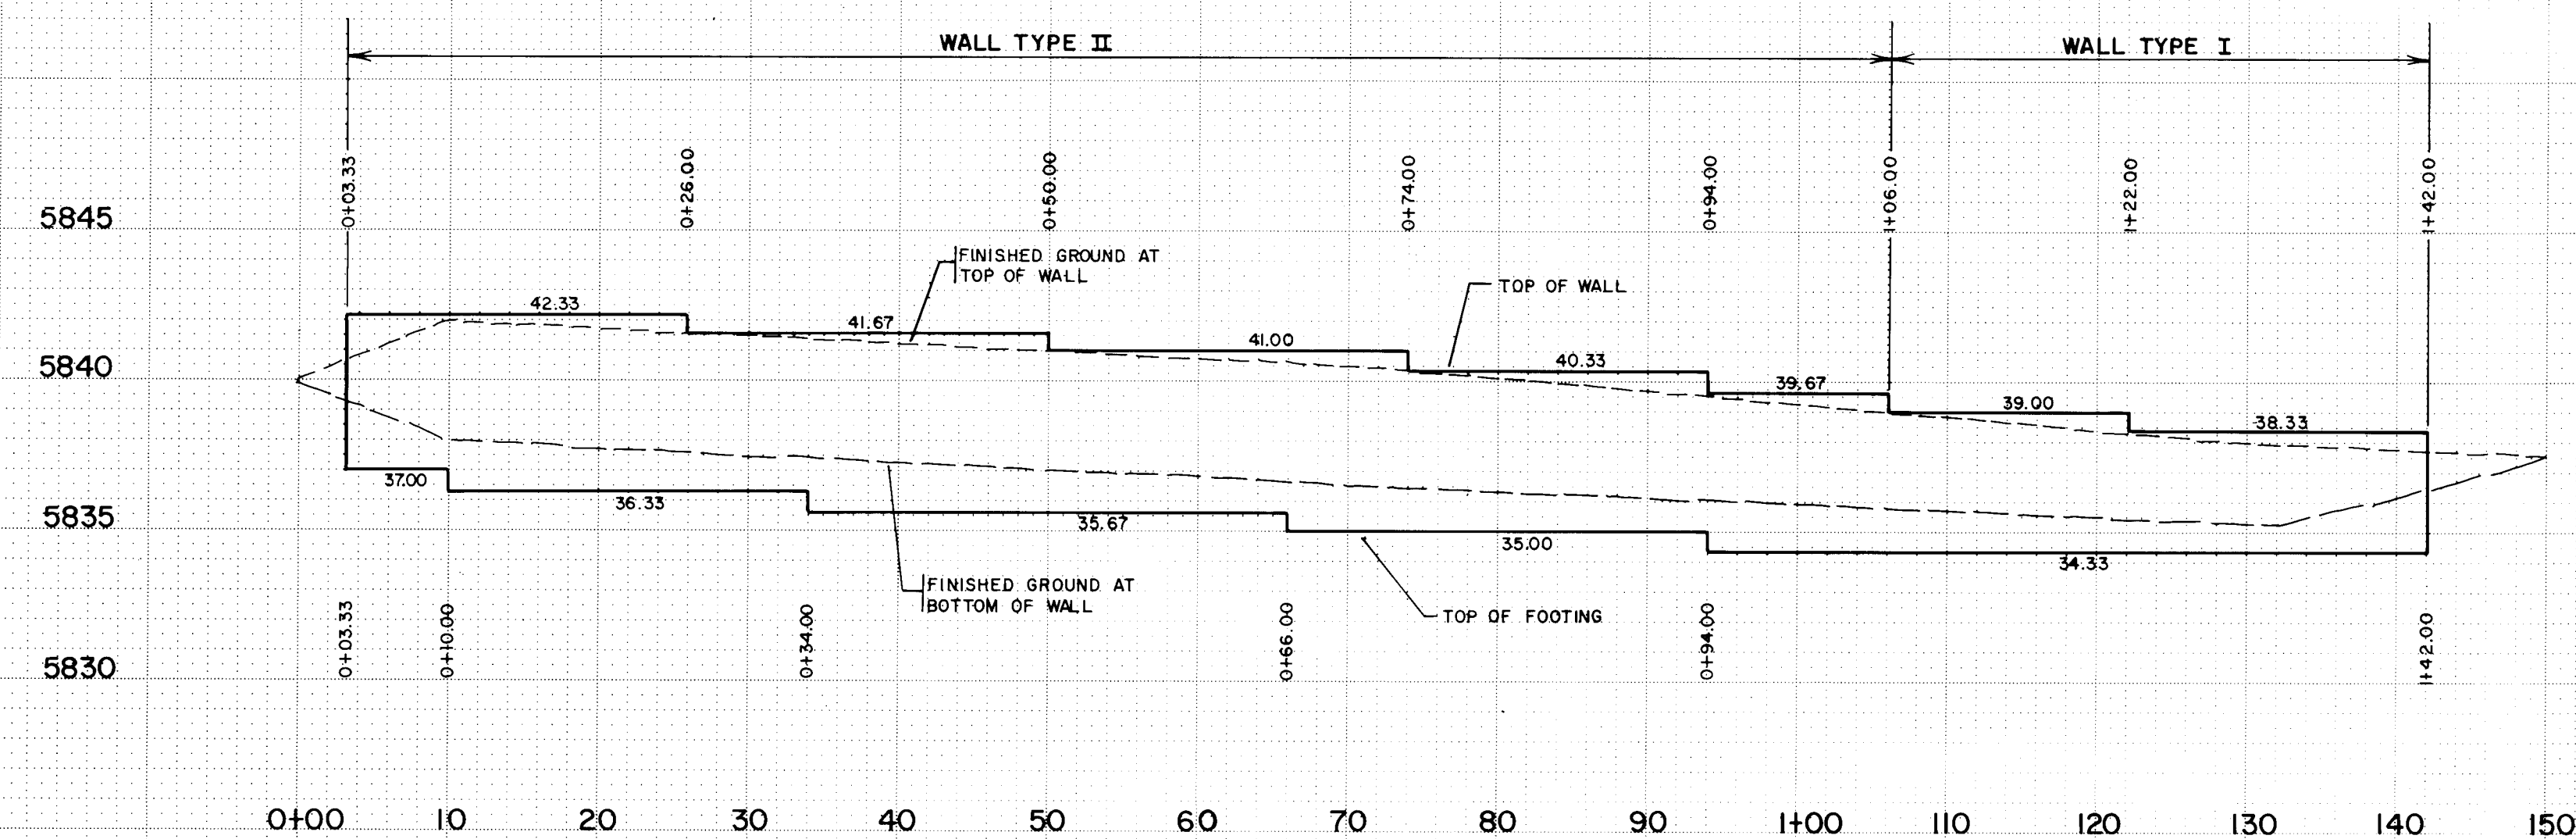

1	2	3	4	5	6	7	8	9	10	11
2	6		2	4	7	9	1	4	8	8

BRUINING 44-232

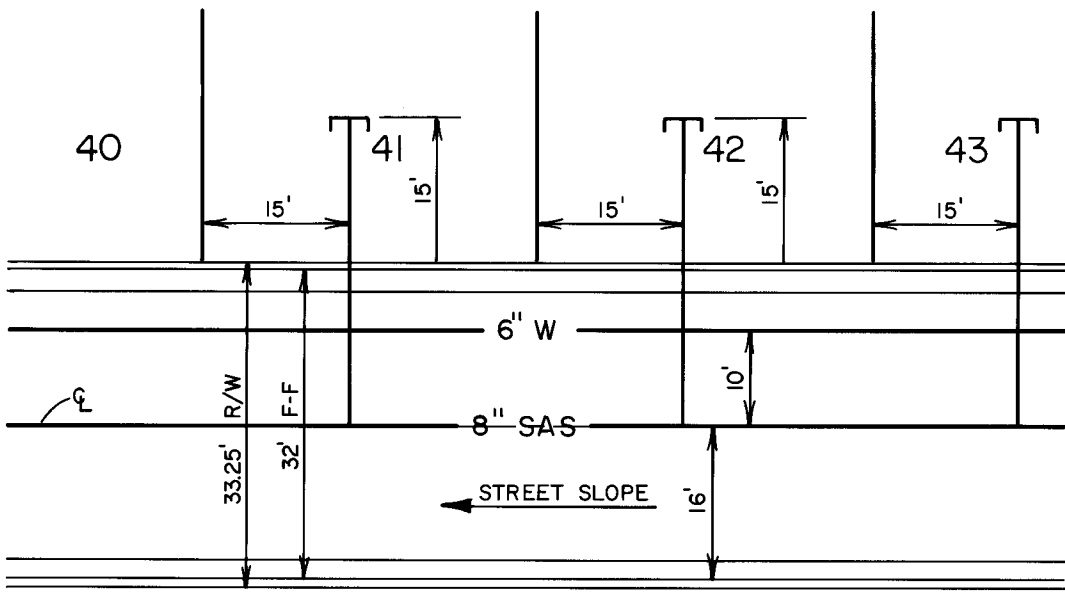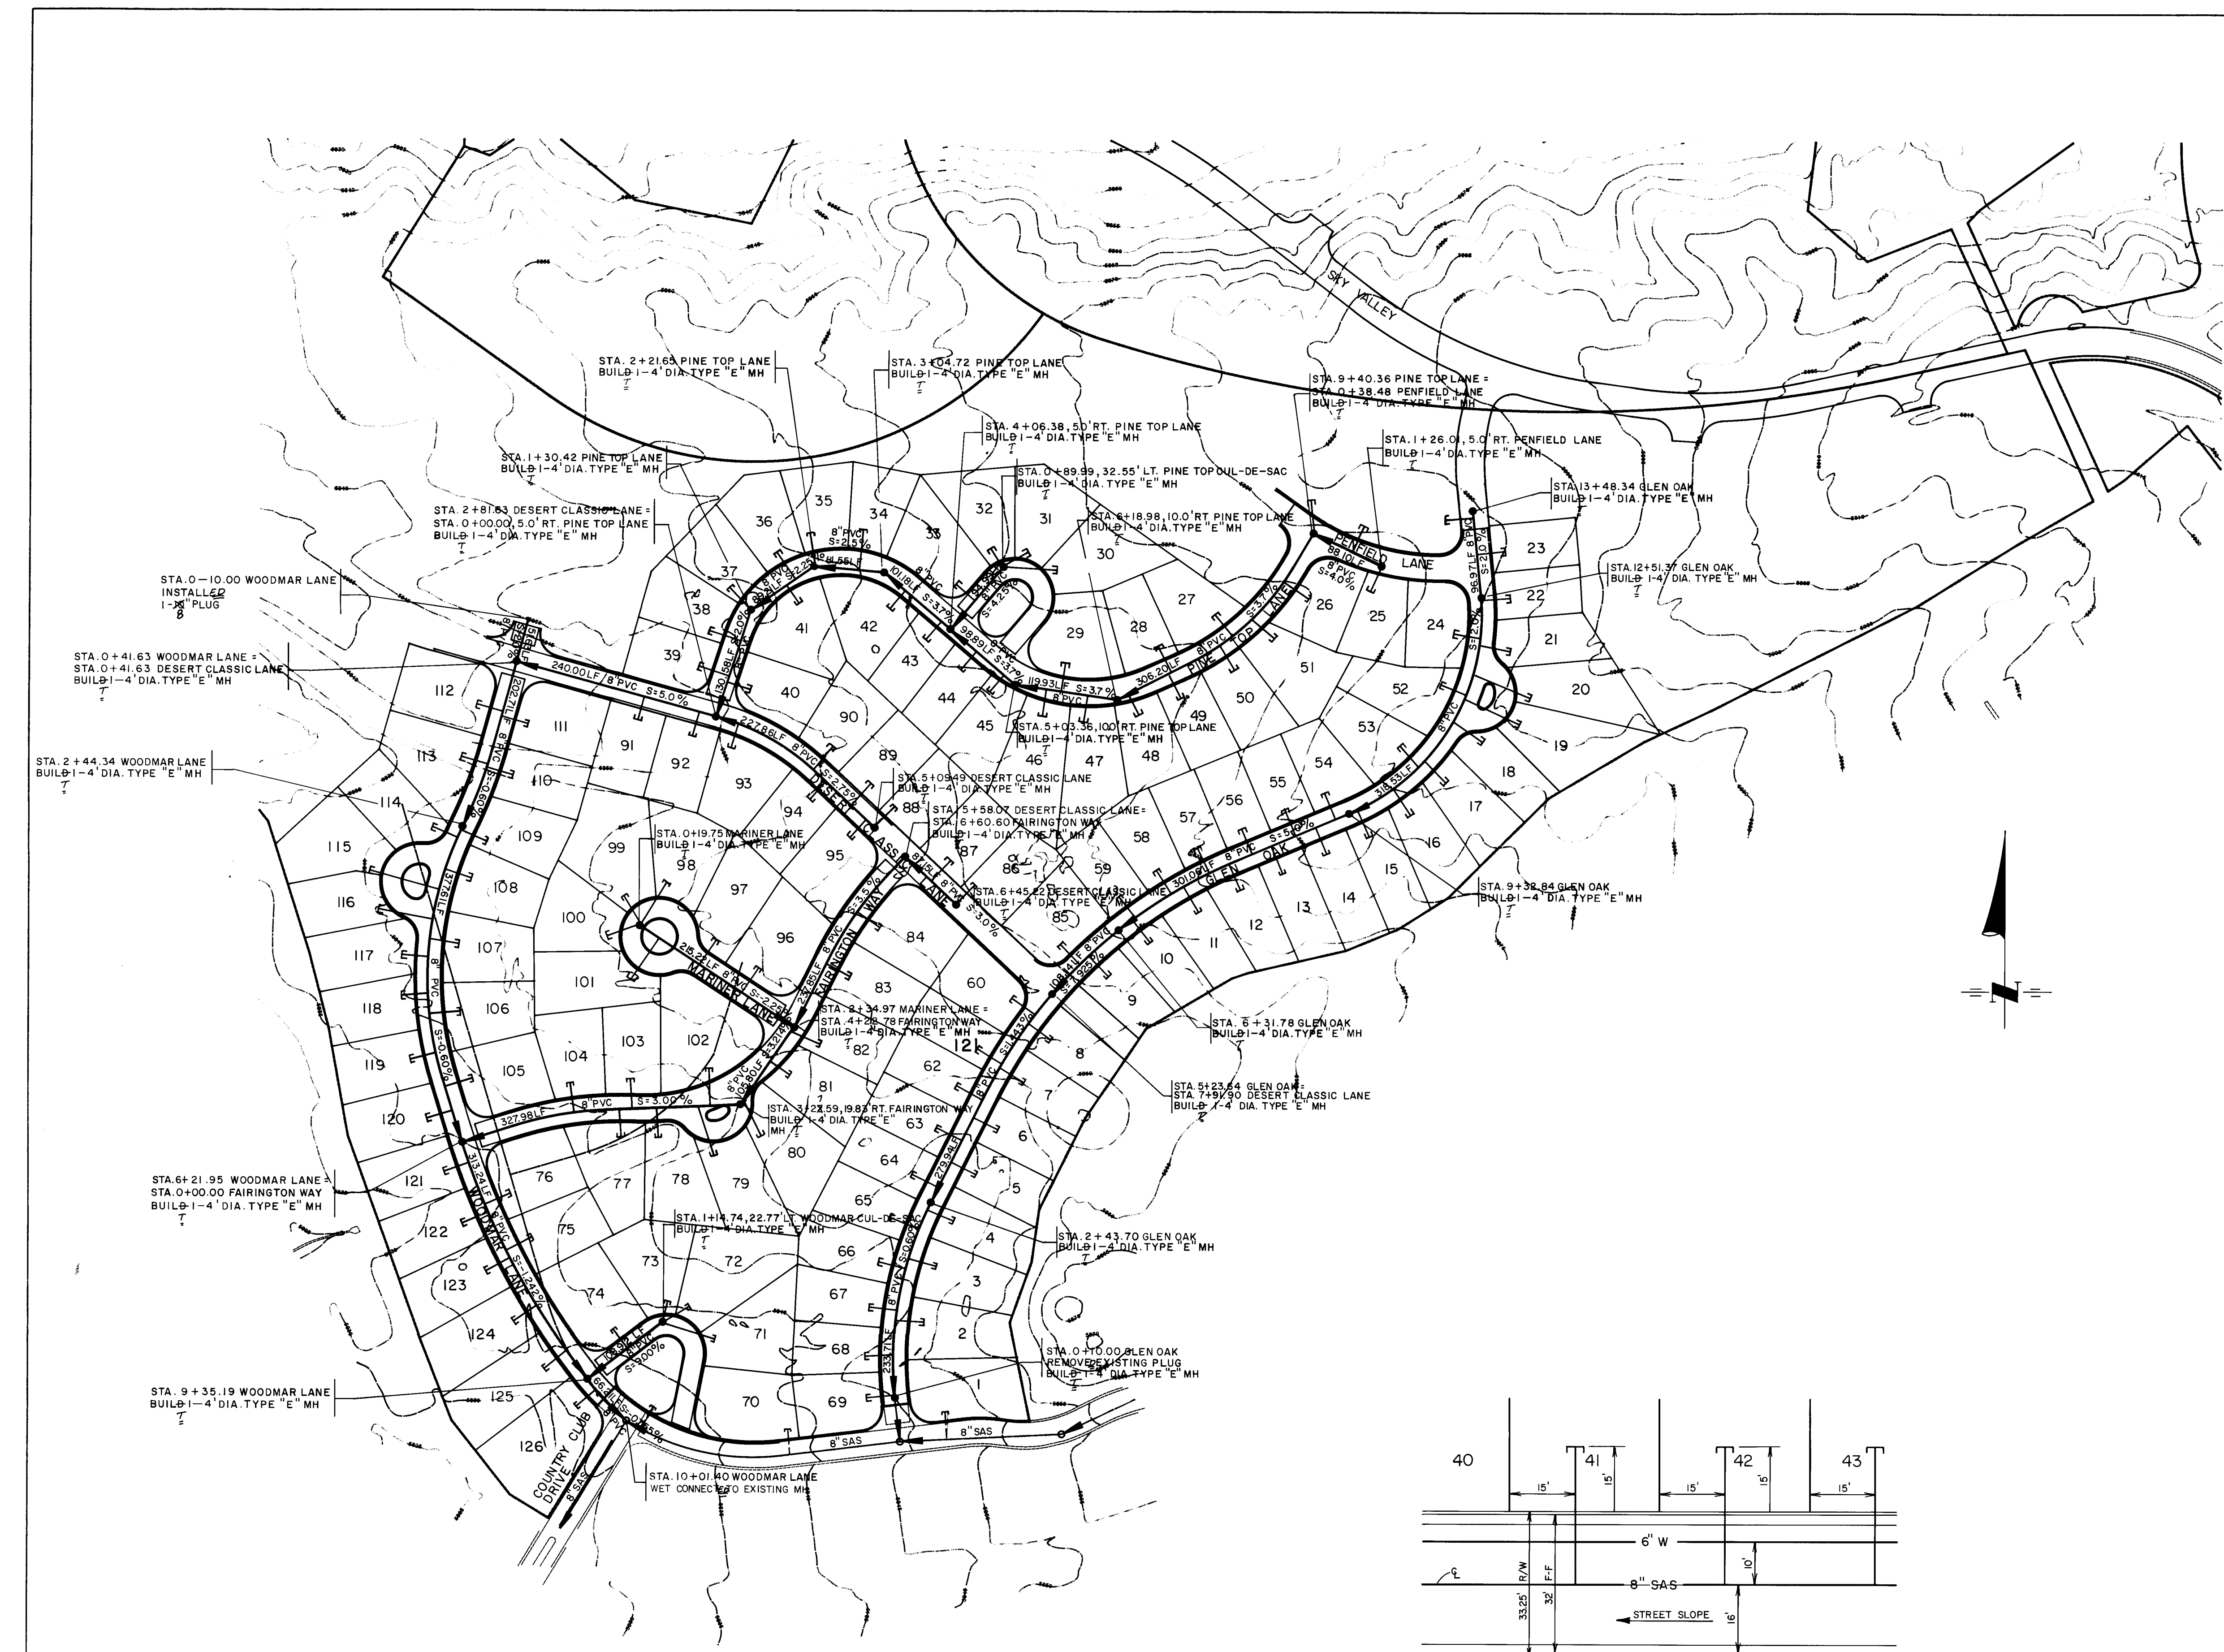

TYPICAL SERVICE LOCATION
NO SCALE

NOTE

I. THE CONTRACTOR SHALL FIELD VERIFY ALL EXISTING UTILITY LOCATIONS AND NOTIFY THE ENGINEER IMMEDIATELY OF ANY DISCREPANCIES.



DATE 7/19/88

LEGEND

- PROJECT BOUNDARY
- EXISTING CURB & GUTTER
- PROPOSED CURB & GUTTER
- EXISTING SANITARY SEWER LINE
- PROPOSED SANITARY SEWER LINE
- EXISTING SANITARY SEWER MANHOLE
- PROPOSED SANITARY SEWER MANHOLE
- PROPOSED SANITARY SEWER SERVICE CONNECTION
- SANITARY SEWER DIRECTION OF FLOW

1 2 3 4 5 6 7 8 9 10 11 12
2/6 2/4 7/9 1/7 8/8




CITY OF ALBUQUERQUE
PUBLIC WORKS
ENGINEERING

TITLE: DESERT CLASSIC AT TANOAN - PHASE I
SANITARY SEWER PLAN

APPROVALS	ENGINEER	DATE	APPROVALS	ENGINEER	DATE
City Engineer	<i>[Signature]</i>	7/2/88	Liquid Waste	<i>[Signature]</i>	6/24/87
A.C.E. - Design	<i>[Signature]</i>	6/23/87	Traffic	<i>[Signature]</i>	6/24/87
A.C.E. - Hydrology	<i>[Signature]</i>	6/24/87	Water	<i>[Signature]</i>	6/24/87

DRAWING NO.	2479	MAP NO.	E-22	SHEET	12	OF	29
-------------	------	---------	------	-------	----	----	----

BHI JOB N° 71263
SCALE: 1" = 100'

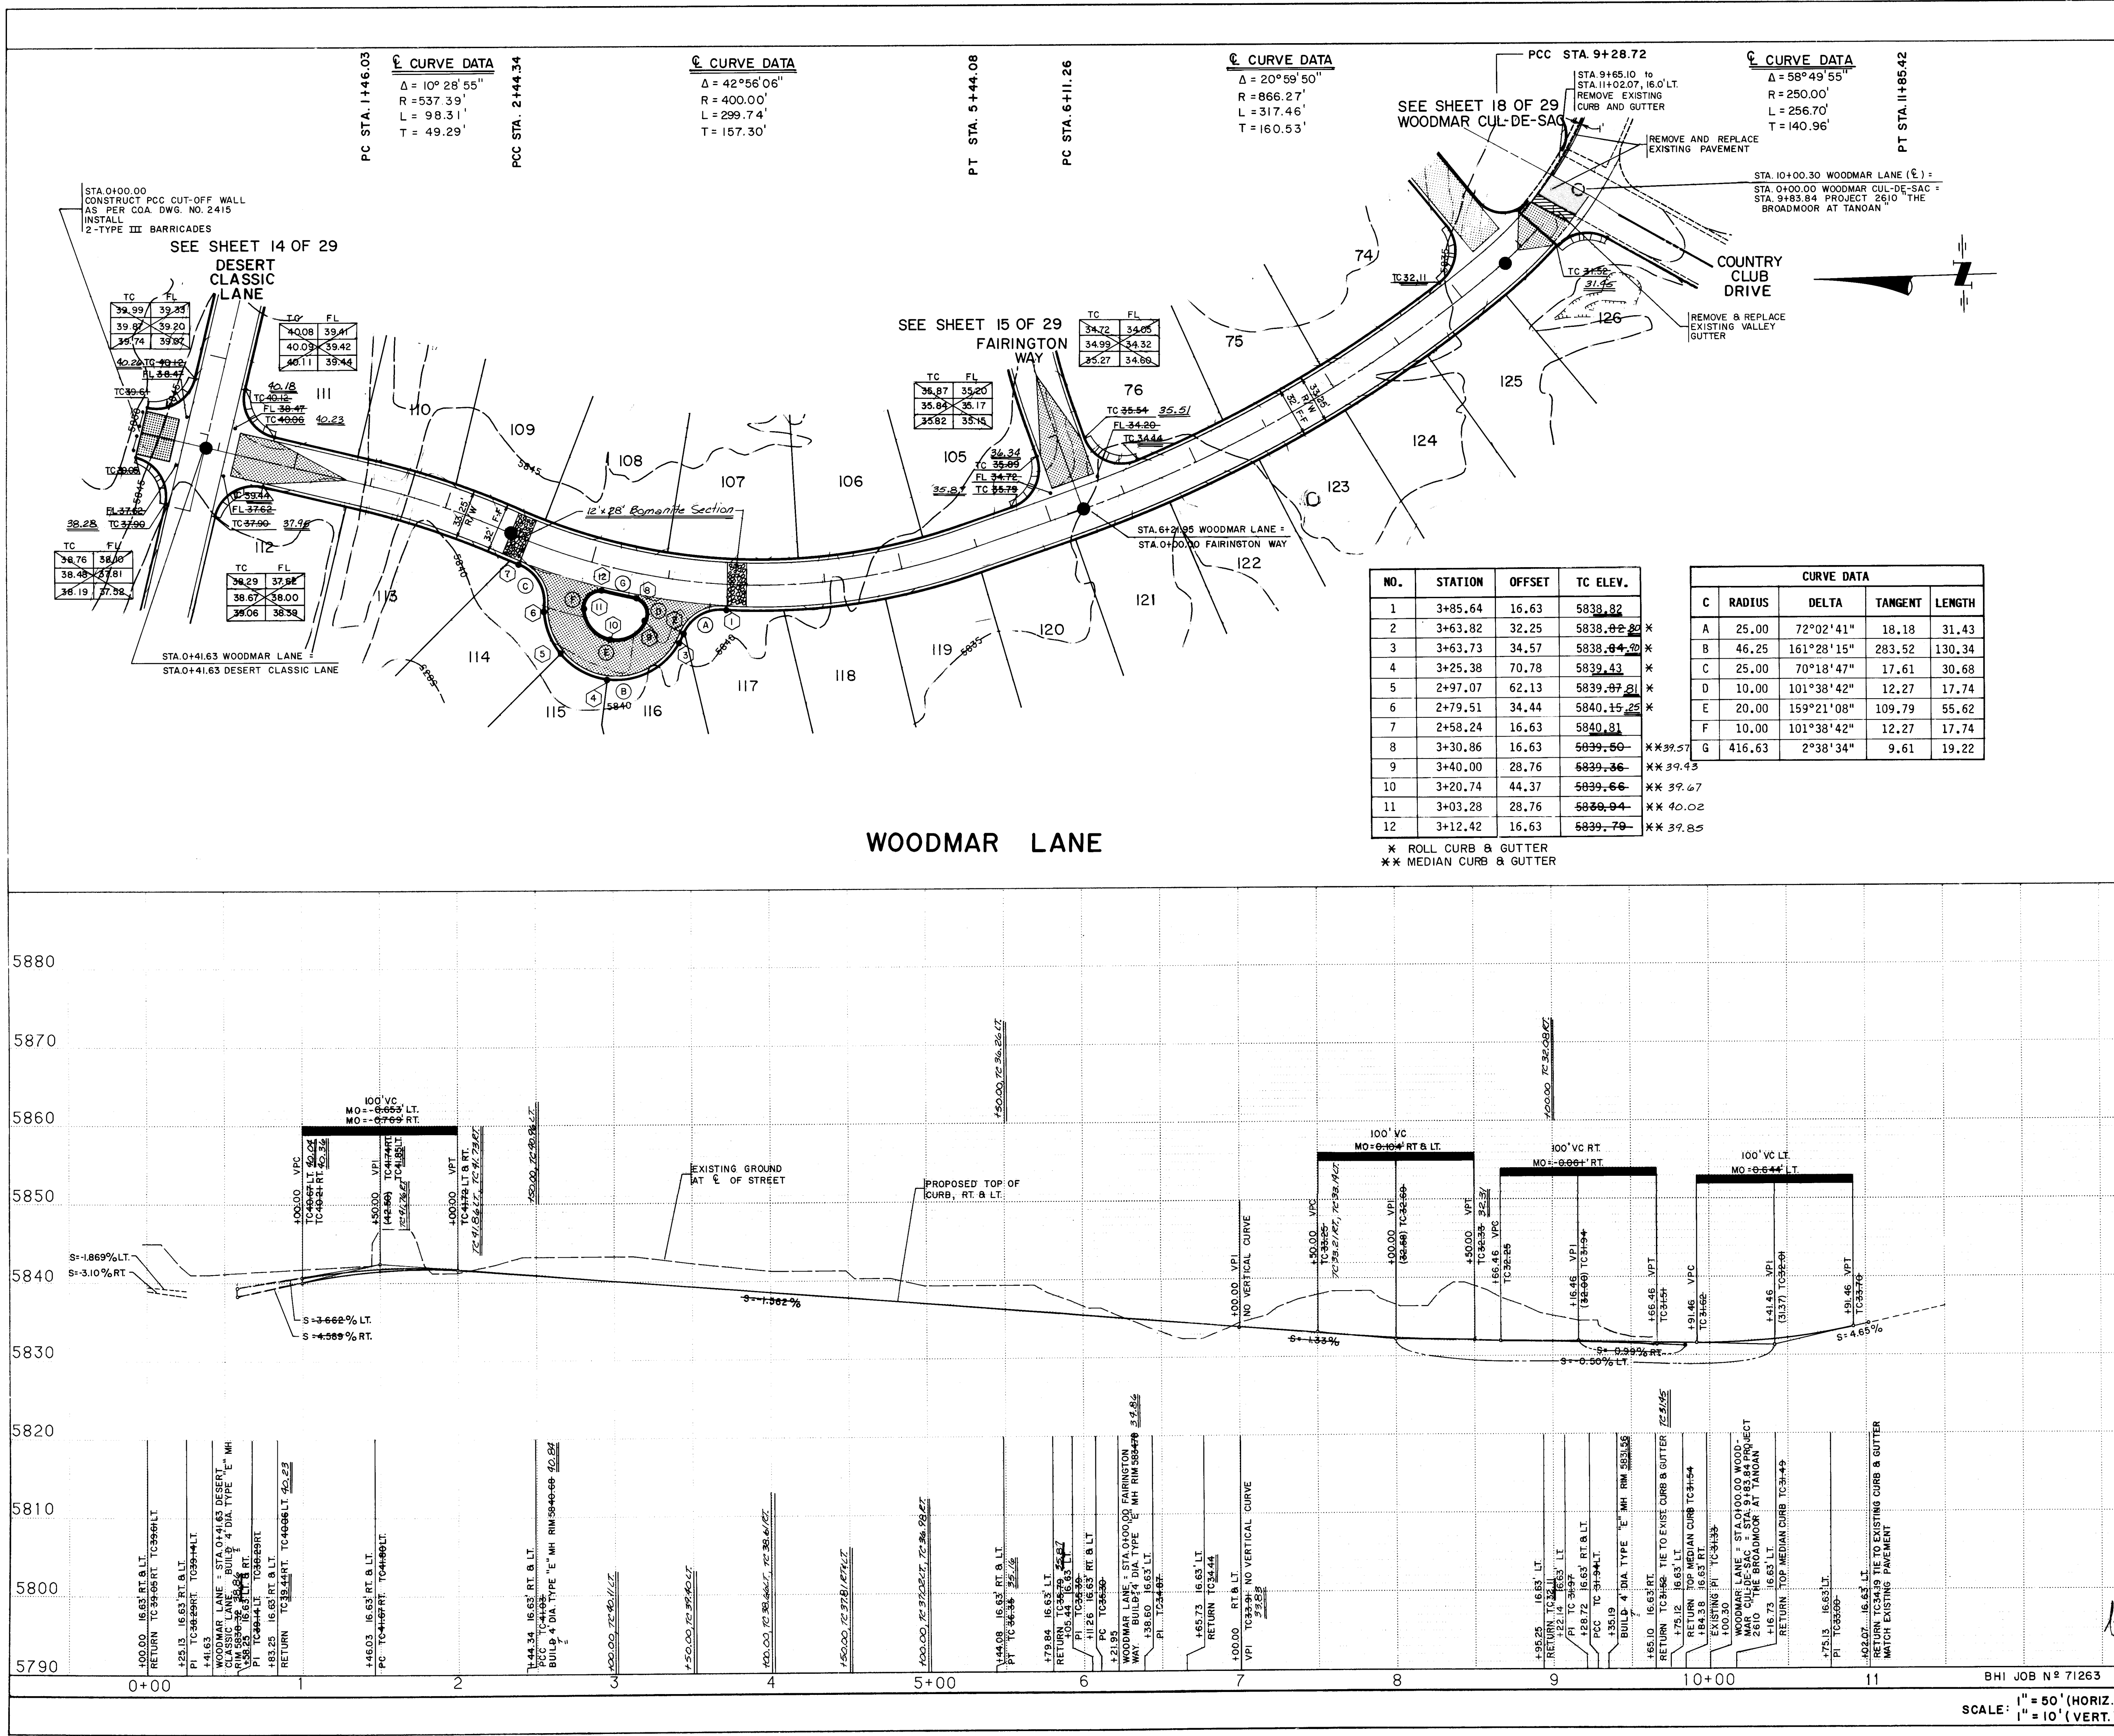

NOTES

- THE CONTRACTOR SHALL FIELD VERIFY ALL EXISTING UTILITY LOCATIONS AND NOTIFY THE ENGINEER IMMEDIATELY OF ANY DISCREPANCIES.
- ALL CURB RETURN RADII SHALL BE 25' TO BACK OF CURB UNLESS OTHERWISE SPECIFIED.
- ALL CURVE DATA AND DIMENSIONS REFER TO BACK OF CURB UNLESS OTHERWISE SPECIFIED.
- GRADE ELEVATIONS, WHERE NOTED, ARE FOR TOP OF STANDARD CURB UNLESS OTHERWISE SPECIFIED.
- ALL ISLAND CONSTRUCTION SHALL CONSIST OF STANDARD MEDIAN CURB AND GUTTER.

CURVE DATA

C	RADIUS	DELTA	TANGENT	LENGTH
A	25.00	72°02'41"	18.18	31.43
B	46.25	161°28'15"	283.52	130.34
C	25.00	70°18'47"	17.61	30.68
D	10.00	101°38'42"	12.27	17.74
E	20.00	159°21'08"	109.79	55.62
F	10.00	101°38'42"	12.27	17.74
G	416.63	2°38'34"	9.61	19.22

STATION DATA

NO.	STATION	OFFSET	TC ELEV.
1	3+85.64	16.63	5838.82
2	3+63.82	32.25	5838.82
3	3+63.73	34.57	5838.84
4	3+25.38	70.78	5839.43
5	2+97.07	62.13	5839.87
6	2+79.51	34.44	5840.15
7	2+58.24	16.63	5840.81
8	3+30.86	16.63	5839.50
9	3+40.00	28.76	5839.36
10	3+20.74	44.37	5839.66
11	3+03.28	28.76	5839.94
12	3+12.42	16.63	5839.79

* ROLL CURB & GUTTER
** MEDIAN CURB & GUTTER

REVISIONS

NO.	DATE	REMARKS
1	6-24-87	DESIGN
2	6-24-87	DESIGN
3	6-24-87	DESIGN
4	6-24-87	DESIGN
5	6-24-87	DESIGN
6	6-24-87	DESIGN
7	6-24-87	DESIGN
8	6-24-87	DESIGN
9	6-24-87	DESIGN
10	6-24-87	DESIGN
11	6-24-87	DESIGN
12	6-24-87	DESIGN

CITY OF ALBUQUERQUE PUBLIC WORKS ENGINEERING

TITLE: DESERT CLASSIC AT TANOAN - PHASE I
PAVING PLAN & PROFILE
WOODMAR LANE

APPROVALS	ENGINEER	DATE	APPROVALS	ENGINEER	DATE
City Engineer	W. J. ...	7/2/87	Liquid Waste	W. J. ...	6-24-87
A.C.E.-Design	W. J. ...	6-24-87	Traffic	W. J. ...	6-24-87
A.C.E.-Hydrology	W. J. ...	6-24-87	Water	W. J. ...	6-24-87



DRAWING NO. **2479** MAP NO. **E-22** SHEET **13** OF **29**

PC STA 11+04.29
PT STA 11+32.55

C CURVE DATA
 $\Delta = 3^\circ 14' 26''$
 $R = 499.68'$
 $L = 28.26'$
 $T = 14.13'$

C CURVE DATA
 $\Delta = 27^\circ 49' 16''$
 $R = 270.00'$
 $L = 131.10'$
 $T = 66.87'$

PT STA 4+14.88

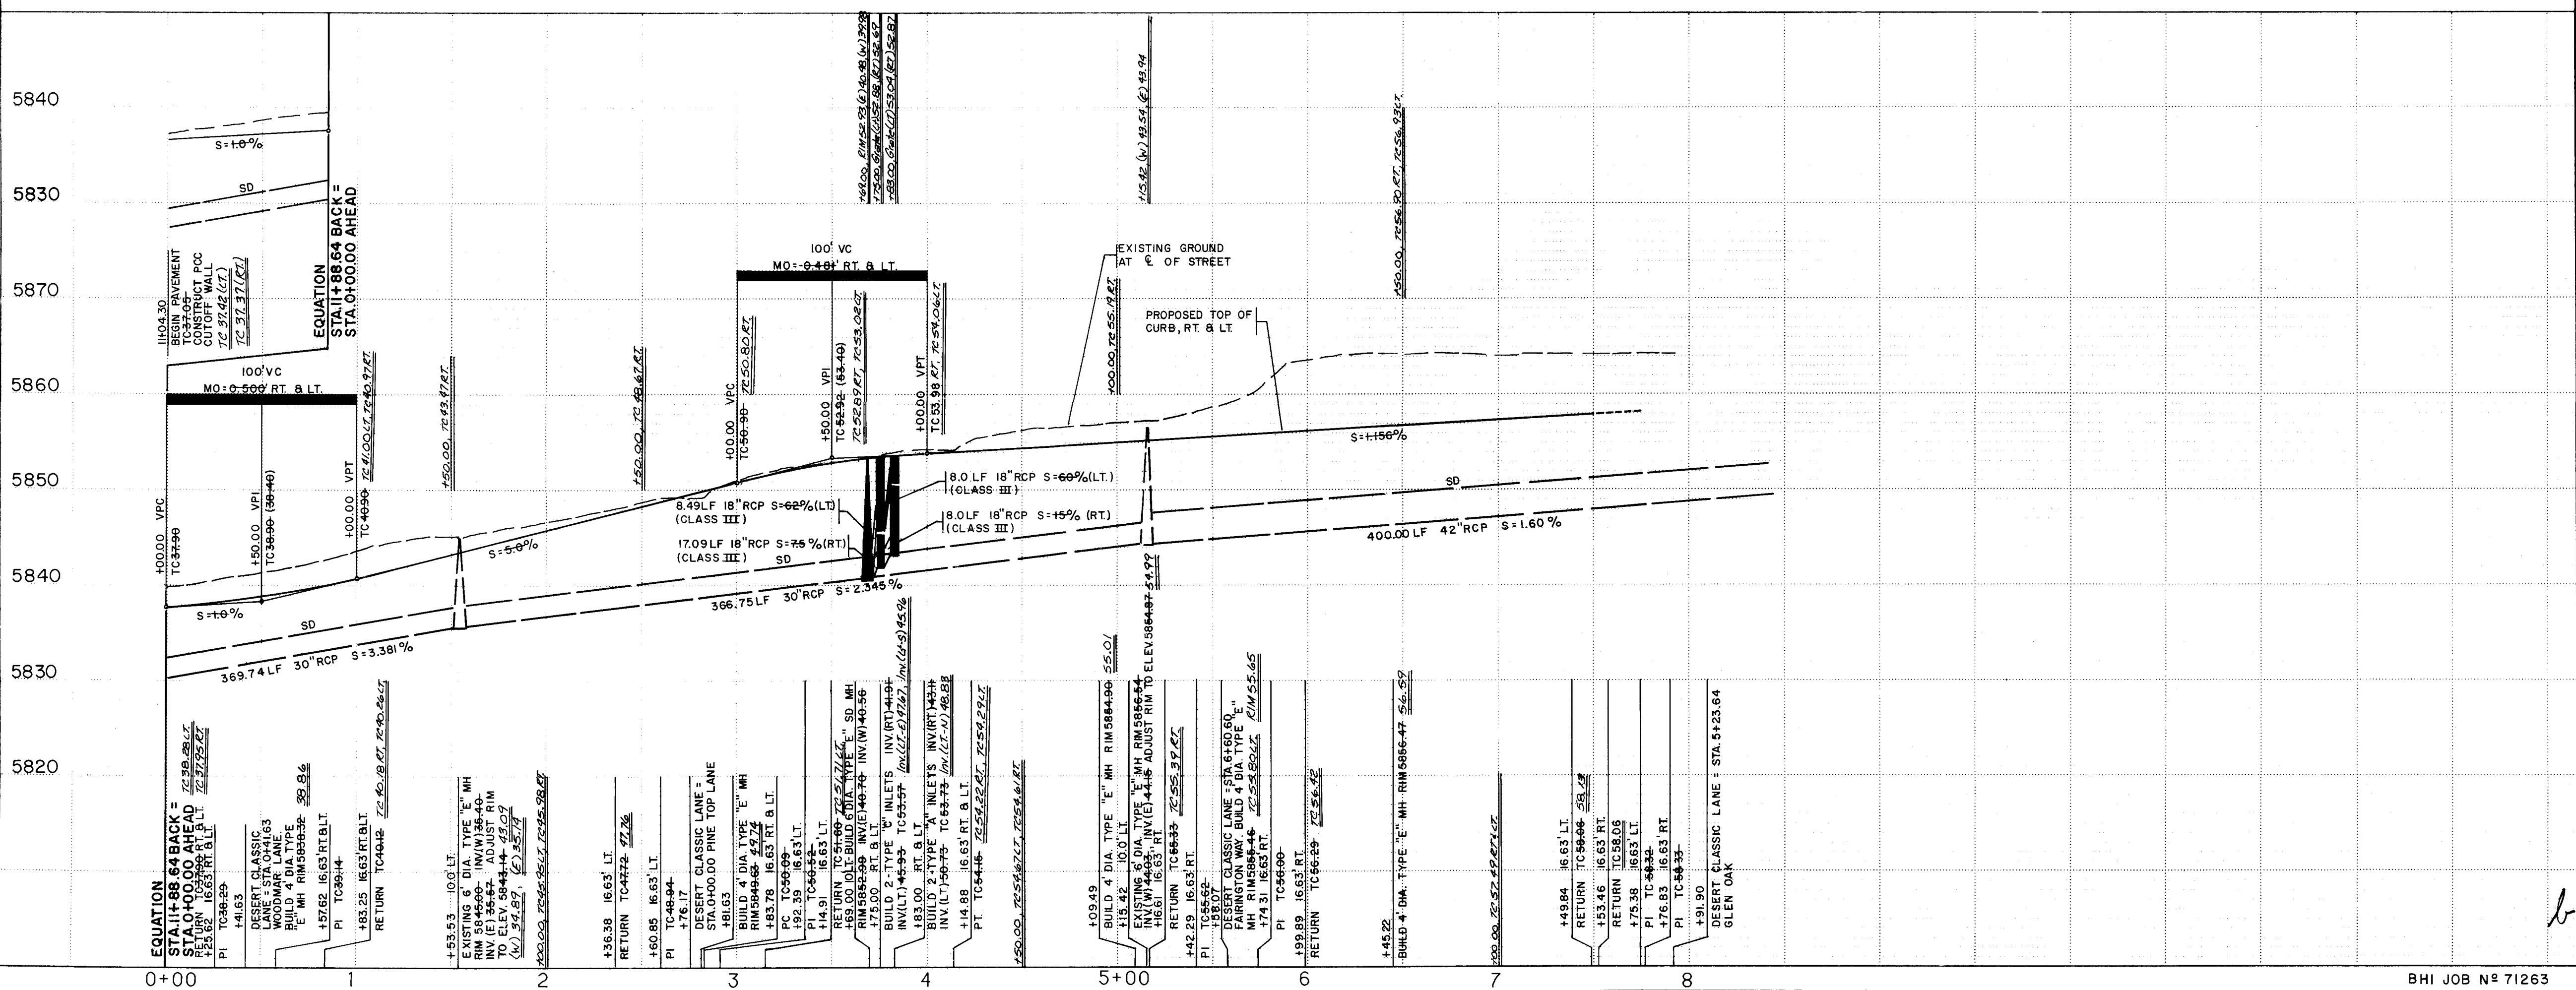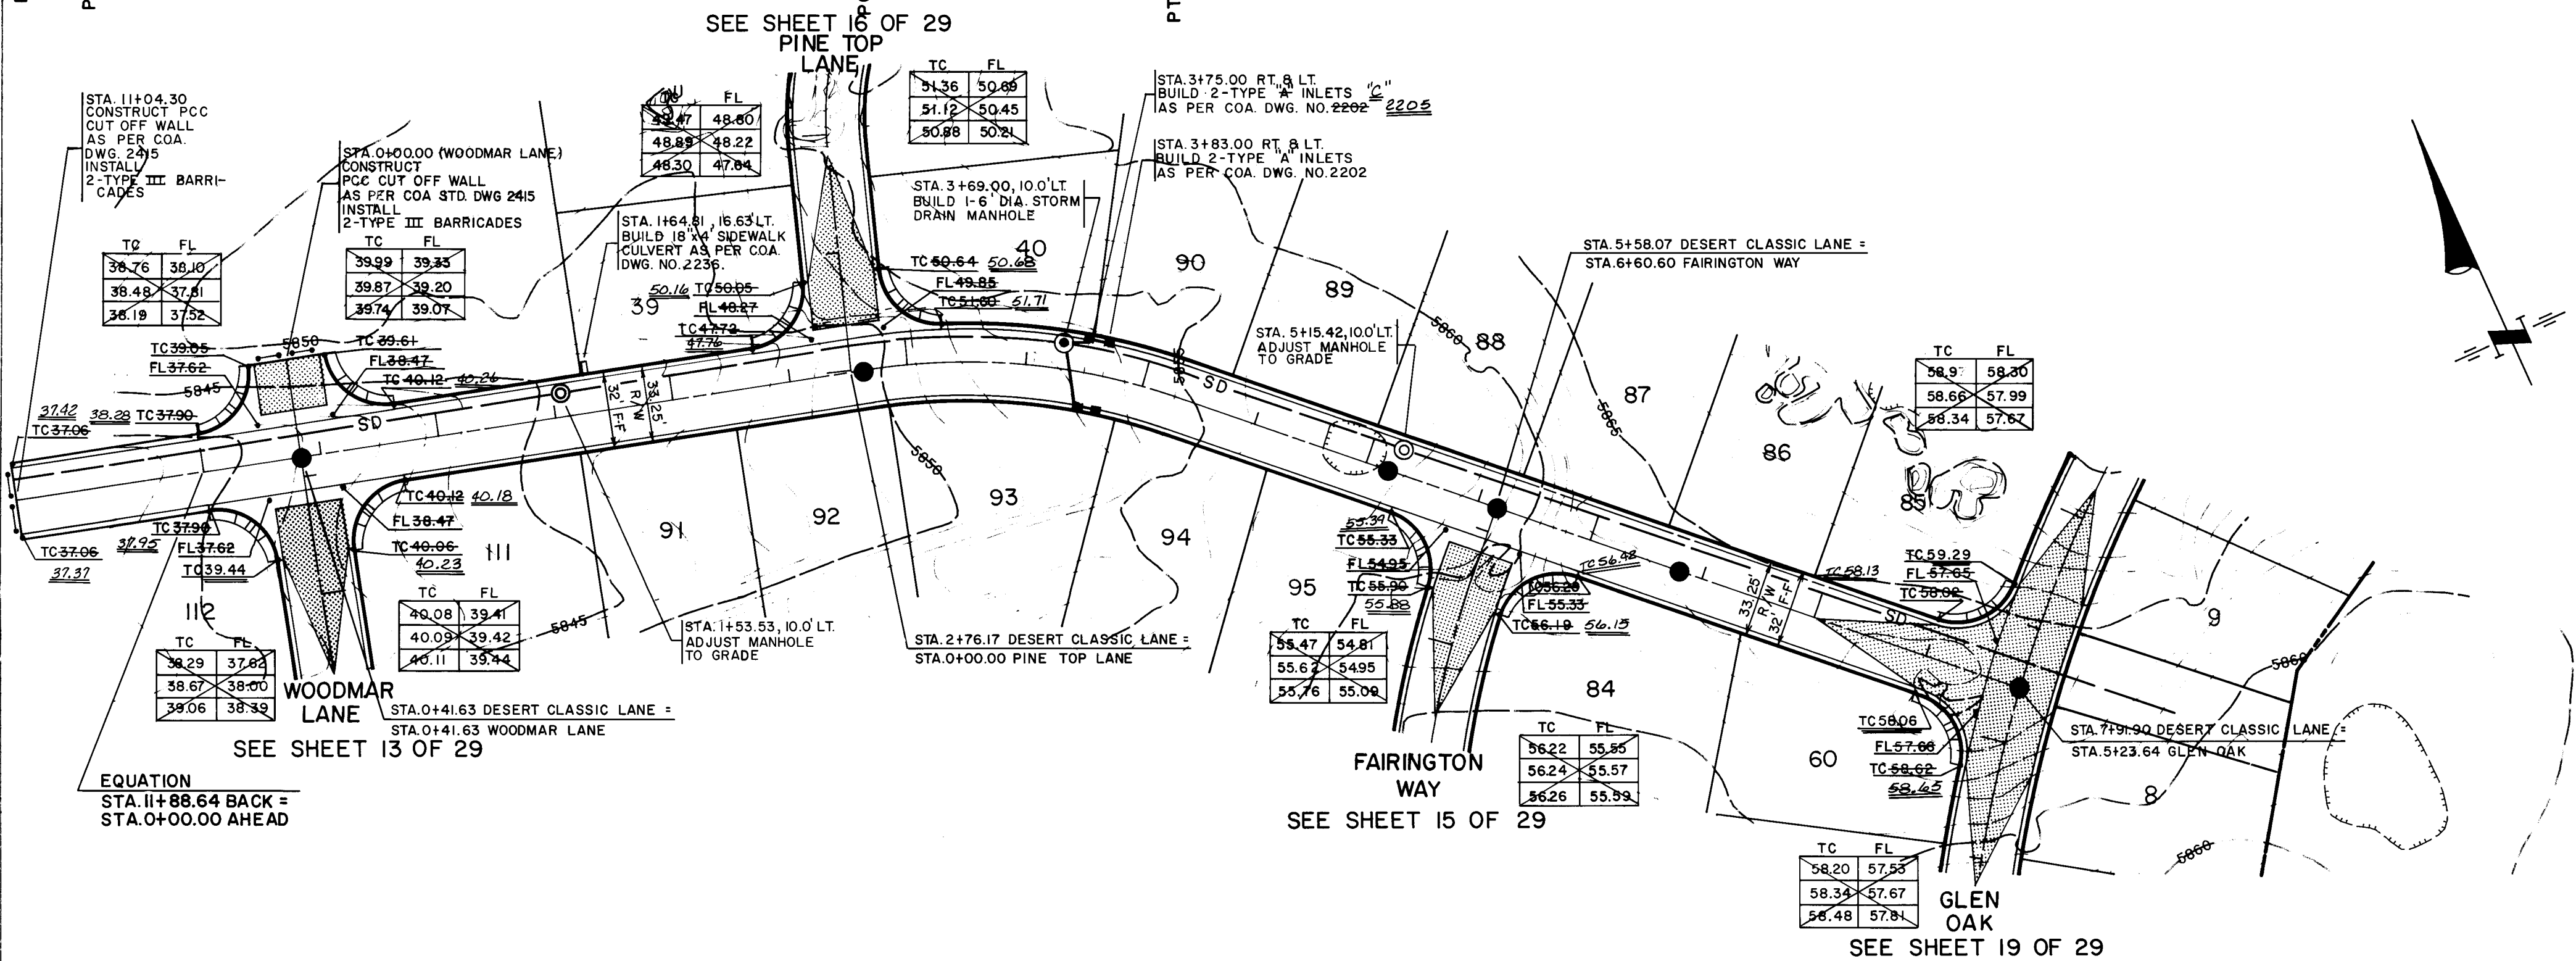

NOTES

1. THE CONTRACTOR SHALL FIELD VERIFY ALL EXISTING UTILITY LOCATIONS AND NOTIFY THE ENGINEER IMMEDIATELY OF ANY DISCREPANCIES.
2. ALL CURB RETURN RADII SHALL BE 25' TO BACK OF CURB UNLESS OTHERWISE SPECIFIED.
3. ALL CURVE DATA AND DIMENSIONS REFER TO BACK OF CURB UNLESS OTHERWISE SPECIFIED.
4. GRADE ELEVATIONS, WHERE NOTED, ARE FOR TOP OF STANDARD CURB UNLESS OTHERWISE SPECIFIED.
5. ALL ISLAND CONSTRUCTION SHALL CONSIST OF STANDARD MEDIAN CURB AND GUTTER.

SURVEY INFORMATION		BENCH MARKS		AS BUILT INFORMATION	
NO.	BY	DATE	THE BENCH MARK IS LOCATED 1.2 MILES EAST OF THE INTERSECTION OF ACADEMY ROAD, NE & EUBANK BLVD, NE THEN 375' SOUTH. THE BENCH MARK IS ON THE SOUTH RIM OF THE BEAR CANYON TRIBUTARY & IS A STANDARD ACS BRASS TABLET STAMPED "6-E22 L84972" ELEVATION 5934.53'	DATE	BY
				DATE	BY

ENGINEER'S SEAL		REVISIONS	
	BY	NO.	DATE
		REMARKS	DATE

RECORD DRAWINGS
DATE JAN 7 1988


26 2479 1988

CITY OF ALBUQUERQUE PUBLIC WORKS ENGINEERING					
TITLE: DESERT CLASSIC AT TANOAN - PHASE I PAVING PLAN & PROFILE DESERT CLASSIC LANE					
APPROVALS	ENGINEER	DATE	APPROVALS	ENGINEER	DATE
City Engineer	Am...	7/2/87	Liquid Waste	N/A R...	6-24-87
A C E - Design	J2H...	6-24-87	Traffic	N/A R...	6-24-87
A C E - Hydrology	Cam	6-24-87	Water	N/A R...	6-24-87

BHI JOB N° 71263

SCALE: 1" = 50' (HORIZ.)
1" = 10' (VERT.)

DRAWING NO. 2479 MAP NO. E-22 SHEET 14 OF 29

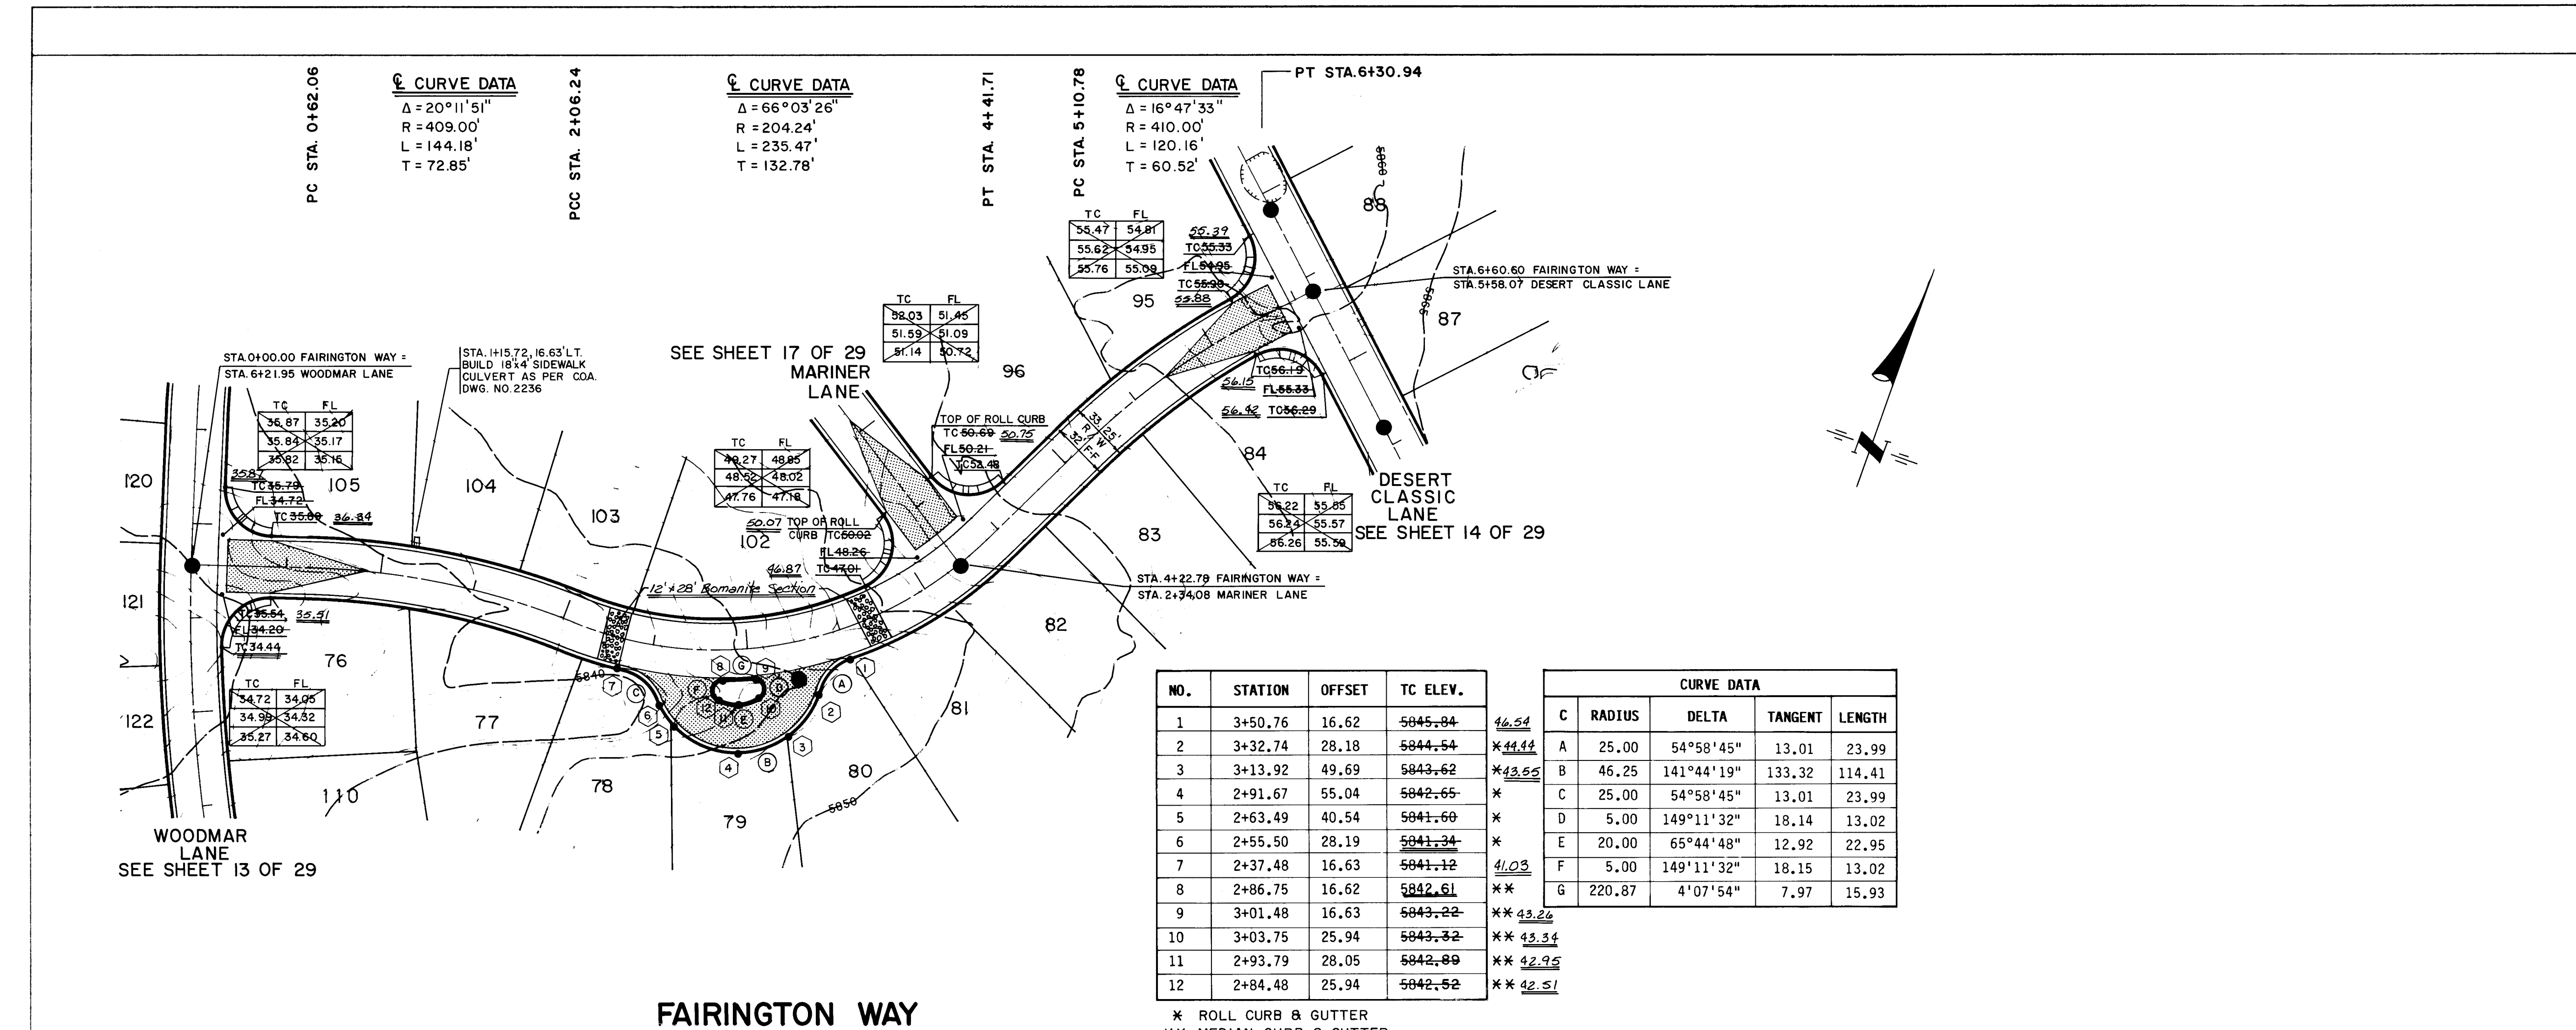

NOTES

- THE CONTRACTOR SHALL FIELD VERIFY ALL EXISTING UTILITY LOCATIONS AND NOTIFY THE ENGINEER IMMEDIATELY OF ANY DISCREPANCIES.
- ALL CURB RETURN RADII SHALL BE 25' TO BACK OF CURB UNLESS OTHERWISE SPECIFIED.
- ALL CURVE DATA AND DIMENSIONS REFER TO BACK OF CURB UNLESS OTHERWISE SPECIFIED.
- GRADE ELEVATIONS, WHERE NOTED, ARE FOR TOP OF STANDARD CURB UNLESS OTHERWISE SPECIFIED.
- ALL ISLAND CONSTRUCTION SHALL CONSIST OF STANDARD MEDIAN CURB AND GUTTER.

AS BUILT INFORMATION
J.R. HALE
DATE 9/87

BENCH MARKS
THE BENCH MARK IS LOCATED 1.2 MILES EAST OF THE INTERSECTION OF ACADEMY ROAD, NE & EUBANK BLVD., NE THEN 375' SOUTH. THE BENCH MARK IS ON THE SOUTH RIM OF THE BEAR CANYON TRIBUTARY & IS A STANDARD ACS BRASS TABLET STAMPED "6-E22 LS4972", ELEVATION 5834.53'

SURVEY INFORMATION
FIELD NOTES
NO. BY DATE

ENGINEER'S SEAL
WILLIAM L. FRANK
REGISTERED PROFESSIONAL ENGINEER
8131
2/3/01

RECORD DRAWINGS
DATE JAN 7 1988

REVISIONS
NO. DATE BY

DESIGNED BY MLJ/AMT
DRAWN BY TG/TL
CHECKED BY KLD

CITY OF ALBUQUERQUE
PUBLIC WORKS
ENGINEERING

TITLE: DESERT CLASSIC AT TANOAN - PHASE I
PAVING PLAN & PROFILE
FAIRINGTON WAY

APPROVALS	ENGINEER	DATE	APPROVALS	ENGINEER	DATE
City Engineer	W. J. S.	7/2/87	Liquid Waste	N/A	6-24-87
A.C.E. - Design	W. J. S.	6-24-87	Traffic	N/A	6-24-87
A.C.E. - Hydrology	N/A	6-24-87	Water	N/A	6-24-87

BRUNING 627'6"


BHI JOB N° 71263

SCALE: 1" = 50' (HORIZ.)
1" = 10' (VERT.)

DRAWING NO. 2479

MAP NO. E-22

SHEET 15 OF 29

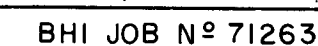

DRAWING NO.	2479
-------------	------

SHEET 16 OF 29

29

1. THE CONTRACTOR SHALL FIELD VERIFY ALL EXISTING UTILITY LOCATIONS AND NOTIFY THE ENGINEER IMMEDIATELY OF ANY DISCREPANCIES.
2. ALL CURB RETURN RADII SHALL BE 25' TO BACK OF CURB UNLESS OTHERWISE SPECIFIED.
3. ALL CURVE DATA AND DIMENSIONS REFER TO BACK OF CURB UNLESS OTHERWISE SPECIFIED.
4. GRADE ELEVATIONS, WHERE NOTED, ARE FOR TOP OF STANDARD CURB UNLESS OTHERWISE SPECIFIED.
5. ALL ISLAND CONSTRUCTION SHALL CONSIST OF STANDARD MEDIAN CURB AND GUTTER.

Professional Engineer Seal for the State of Texas, No. 19864, signed by Robert J. Smith.

RECORD DRAWINGS
DATE JAN 7 1988

Professional Engineer Seal for the State of Texas, No. 19864, signed by Robert J. Smith.

[illegible]

MARKS	DATE
WS	
1	

[illegible]

RQUE
 S




COAN - PHASE I
PROFILE

NOVALS	ENGINEER	DA
aste	N/A RM 1	6.2

	NADWH	6/2
	N/A RY 1	6.7

SHEET 16 OF 2

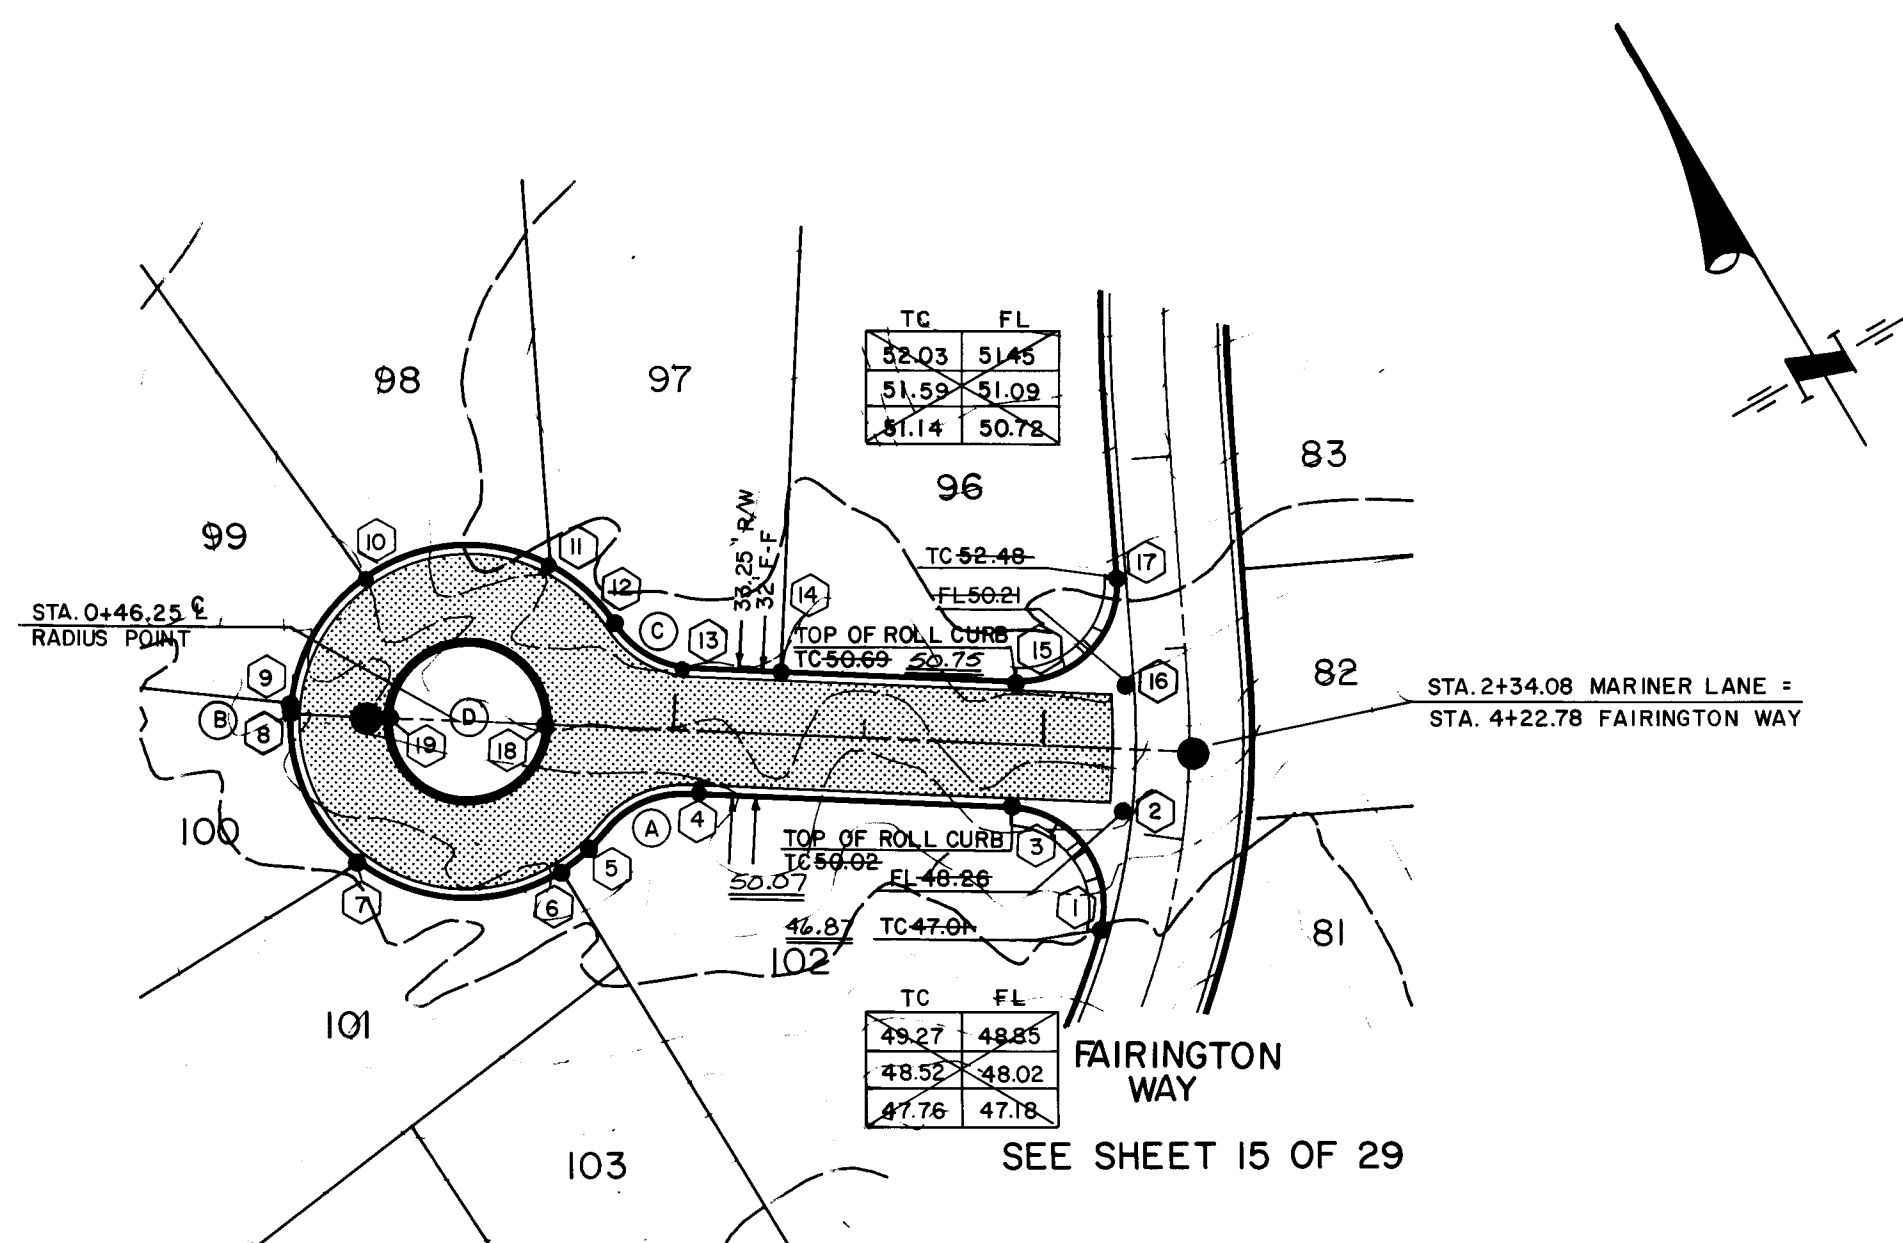

NO.	STATION	OFFSET	TC ELEV.	
1	2+13.46	47.31 RT	5047.01	<u>46.87</u>
2	2+17.86	16.00 RT	5048.26	FL
3	1+88.48	16.68 RT	5050.02	*
4	1+04.03	16.63 RT	5051.11	* <u>51.16</u>
5	0+83.28	26.65 RT	5051.22	*
6	0+72.62	37.99 RT	5051.27	* <u>51.86</u>
7	0+19.76	37.91 RT	5051.54	* <u>51.61</u>
8	0+00.00	---	5051.63	*
9	0+00.09	2.78 LT	5051.63	* <u>51.76</u>
10	0+17.73	36.41 LT	5051.55	*
11	0+66.04	41.80 LT	5051.30	*
12	0+83.28	26.65 LT	5051.22	*
13	1+04.80	16.63 LT	5051.11	* <u>51.04</u>
14	1+27.20	16.63 LT	5051.00	* <u>50.92</u>
15	1+88.04	16.03 LT	5050.69	*
16	2+16.93	16.00 LT	5050.21	FL
17	2+13.48	44.66 LT	5052.40	*
18	0+66.25	---	5051.47	* <u>51.50</u>
19	0+26.26	---	5051.67	* <u>51.70</u>

* ROLL CURB & GUTTER
** MEDIAN CURB & GUTTER

CURVE DATA				
C	RADIUS	DELTA	TANGENT	LENGT
A	25.00	54°15'10"	12.81	23.6
B	46.25	288°30'18"	---	232.9
C	25.00	54°15'10"	12.81	23.6
D	20.00	360°00'00"	---	125.6

NOTES

1. THE CONTRACTOR SHALL FIELD VERIFY ALL EXISTING UTILITY LOCATIONS AND NOTIFY THE ENGINEER IMMEDIATELY OF ANY DISCREPANCIES.
2. ALL CURB RETURN RADII SHALL BE 25' TO BACK OF CURB UNLESS OTHERWISE SPECIFIED.
3. ALL CURVE DATA AND DIMENSIONS REFER TO BACK OF CURB UNLESS OTHERWISE SPECIFIED.
4. GRADE ELEVATIONS, WHERE NOTED, ARE FOR TOP OF STANDARD CURB UNLESS OTHERWISE SPECIFIED.
5. ALL ISLAND CONSTRUCTION SHALL CONSIST OF STANDARD MEDIAN CURB AND GUTTER.

BENCH MARKS		AS BUILT INFORMATION	
THE BENCH MARK IS LOCATED 12 MILES EAST OF THE INTERSECTION OF ACADEMY ROAD, NE & EUBANK BLVD., NE. THEN 375' S. SOUTH. THE BENCH MARK IS ON THE SOUTH RIM OF THE BEAR CANYON TRIBUTARY & IS A STANDARD A.C.S. BRASS TABLET STAMPED "6-E22 LS4972" ELEVATION 5934.53'	INSTRUMENT WALSH	J.R. HALE	
	INSPECTED BY BHI	DATE	9/87
	FIELD LANCE BY BHI	DATE	1/88
	RECALCULATION BY BHI	DATE	1/88
	CORRECTED BY MICRO-FILM	DATE	
	RECORDED BY		
	NO		

[illegible][illegible]

RECORD DRAWINGS
DATE JAN 7 1988

1	2	3	4	5	6	7	8	9	10	11	12
26			24	7	9	2	2	8	8		

	CITY OF ALBUQUERQUE PUBLIC WORKS ENGINEERING	
---	--	---

TITLE: DESERT CLASSIC AT TANOAN - PHASE I
PAVING PLAN & PROFILE
PENFIELD LANE / MARINER LANE

APPROVALS	ENGINEER	DATE	APPROVALS	ENGINEER	DATE
City Engineer	<i>[Signature]</i>	7/2/87	Liquid Waste	N/A RJH	6/24/87
ACE - Design	TJH	6/29/87	Traffic	N/A DWH	6/24/87
ACE - Hydrology	N/A SGM	6-24-87	Water	N/A RJH	6-24-87

BHI JOB N° 71263

SCALE: 1" = 50' (HORI)
1" = 10' (VER)

DRAWING
NO.

2479

MAP NO.
E-22


SHEET 17 OF 29



CURVE DATA				
C	RADIUS	DELTA	TANGENT	LENGTH
A	25.00	91°44'13"	25.77	40.03
B	46.25	138°52'07"	123.27	112.10
C	25.00	88°14'13"	24.24	38.50
D	20.00	101°08'18"	24.32	35.30
E	20.00	138°52'07"	53.31	48.48
F	20.00	110°51'09"	29.02	38.70



CURVE DATA				
C	RADIUS	DELTA	TANGENT	LENGTH
A	25.00	90°00'00"	25.00	39.27
B	46.25	179°59'59"	---	145.31
C	25.00	110°39'12"	36.14	48.28
D	20.00	179°59'59"	---	62.83
E	20.00	179°59'59"	---	62.83

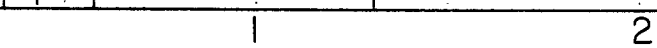

62.90
62.04
62.52
63.64
65.02
64.36

ENGINEER'S SEAL

Kang Z. Qian

6-17-87

EXP.


RECORD DRAWINGS
DATE JAN 7 1988

1	2	3	4	5	6	7	8	9	10	11	12
2	6		2	4	7	9	2	3	8	8	


TITLE: DESERT CLASSIC AT TANOAN - PHASE I
PAVING PLAN & PROFILE
WOODMAR / PINE TOP CUL-DE-SACS

APPROVALS	ENGINEER	DATE	APPROVALS	ENGINEER	DATE
City Engineer	<i>[Signature]</i>	7/2/87	Liquid Waste	NA DW4	6-24-88
ACE - Design	<i>[Signature]</i>	6-29-87	Traffic	NA DW4	6/24/87
ACE - Hydrology	NA CAM	6-24-87	Water	NA DW4	6-24-87

SCALE: 1" = 50' (HORIZ.) 1" = 10' (VERT.)	DRAWING NO. 2479	MAP NO. E-22	SHEET 18 OF 29
--	------------------	--------------	----------------

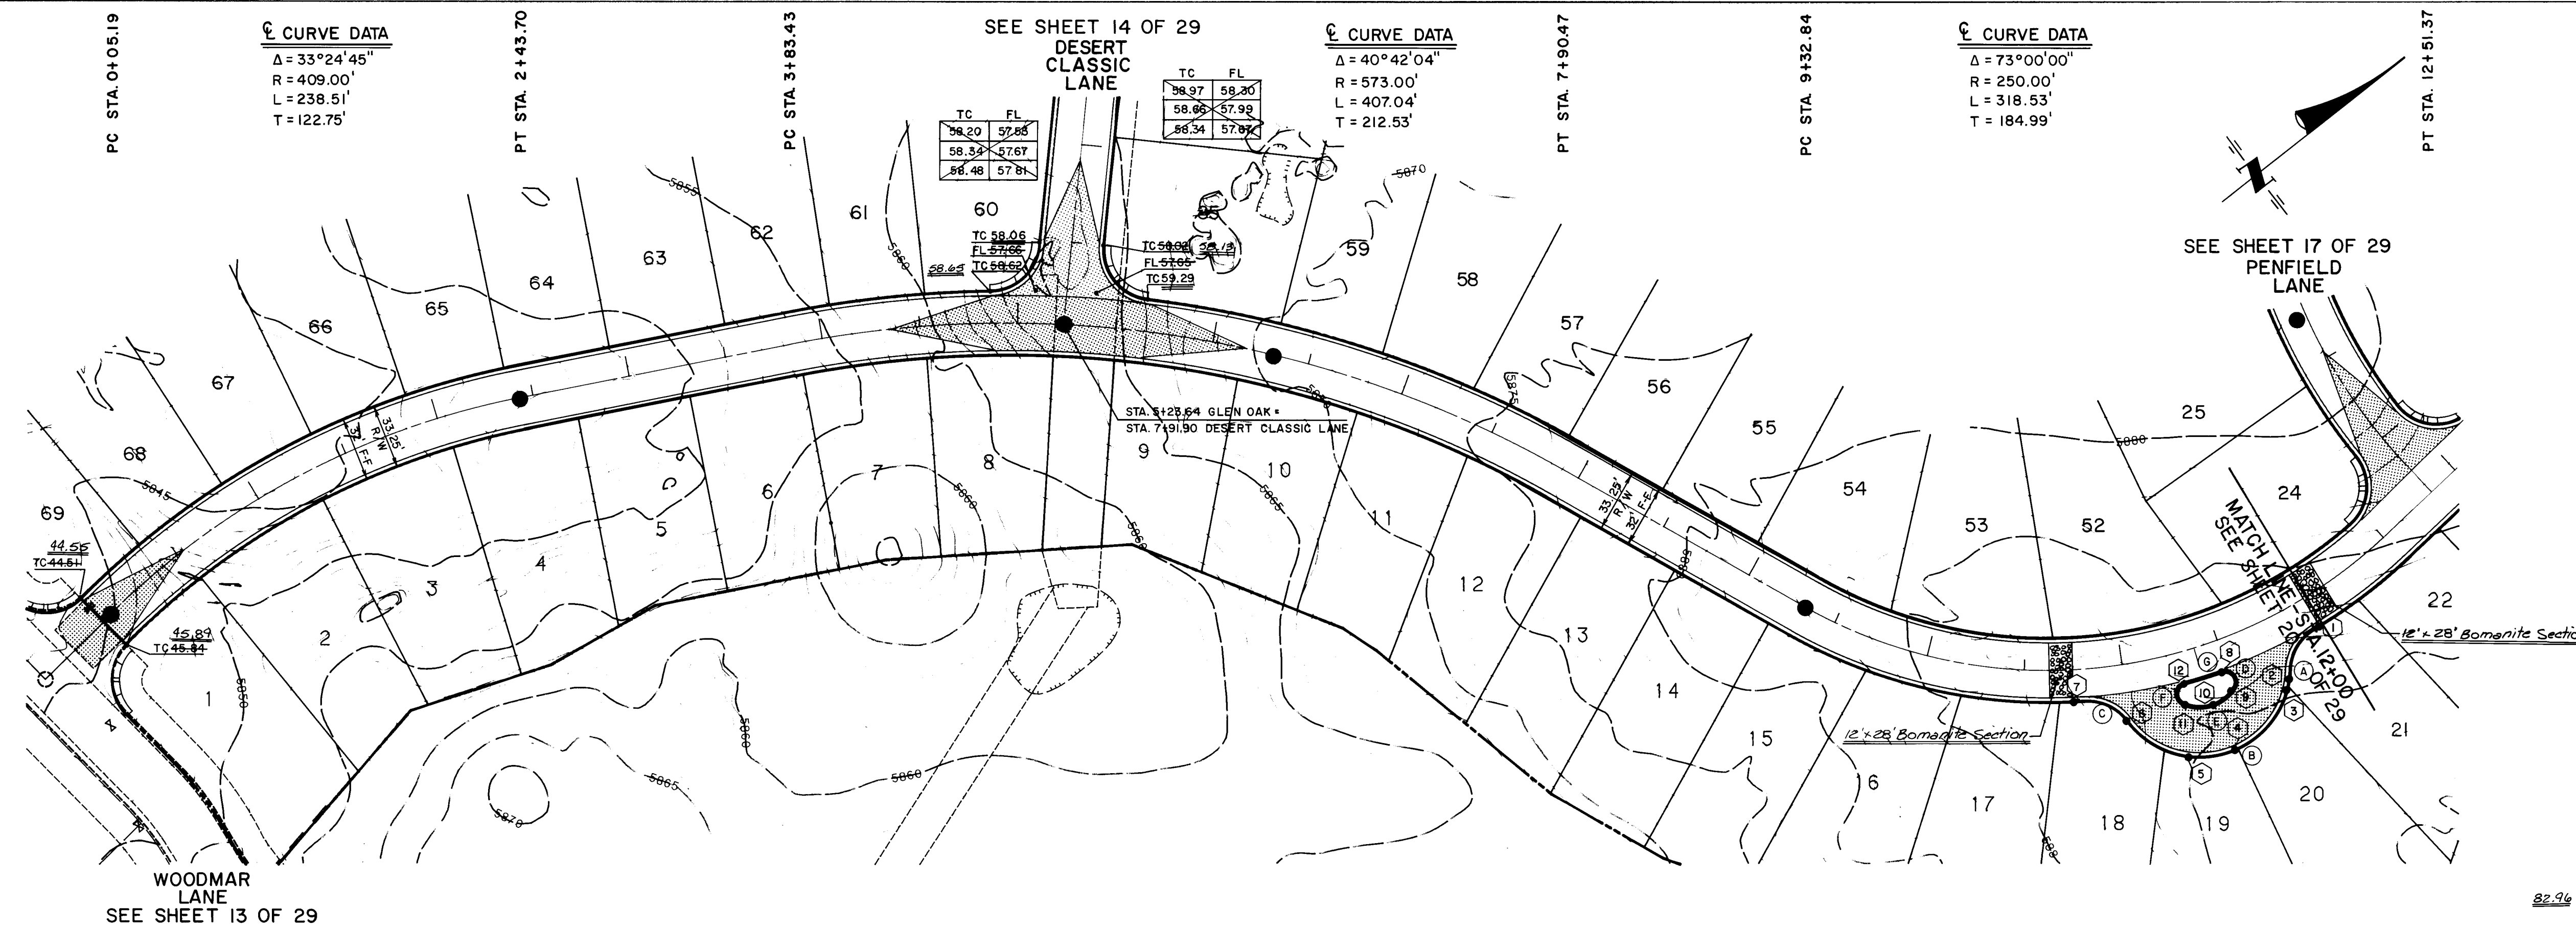


GLEN OAK

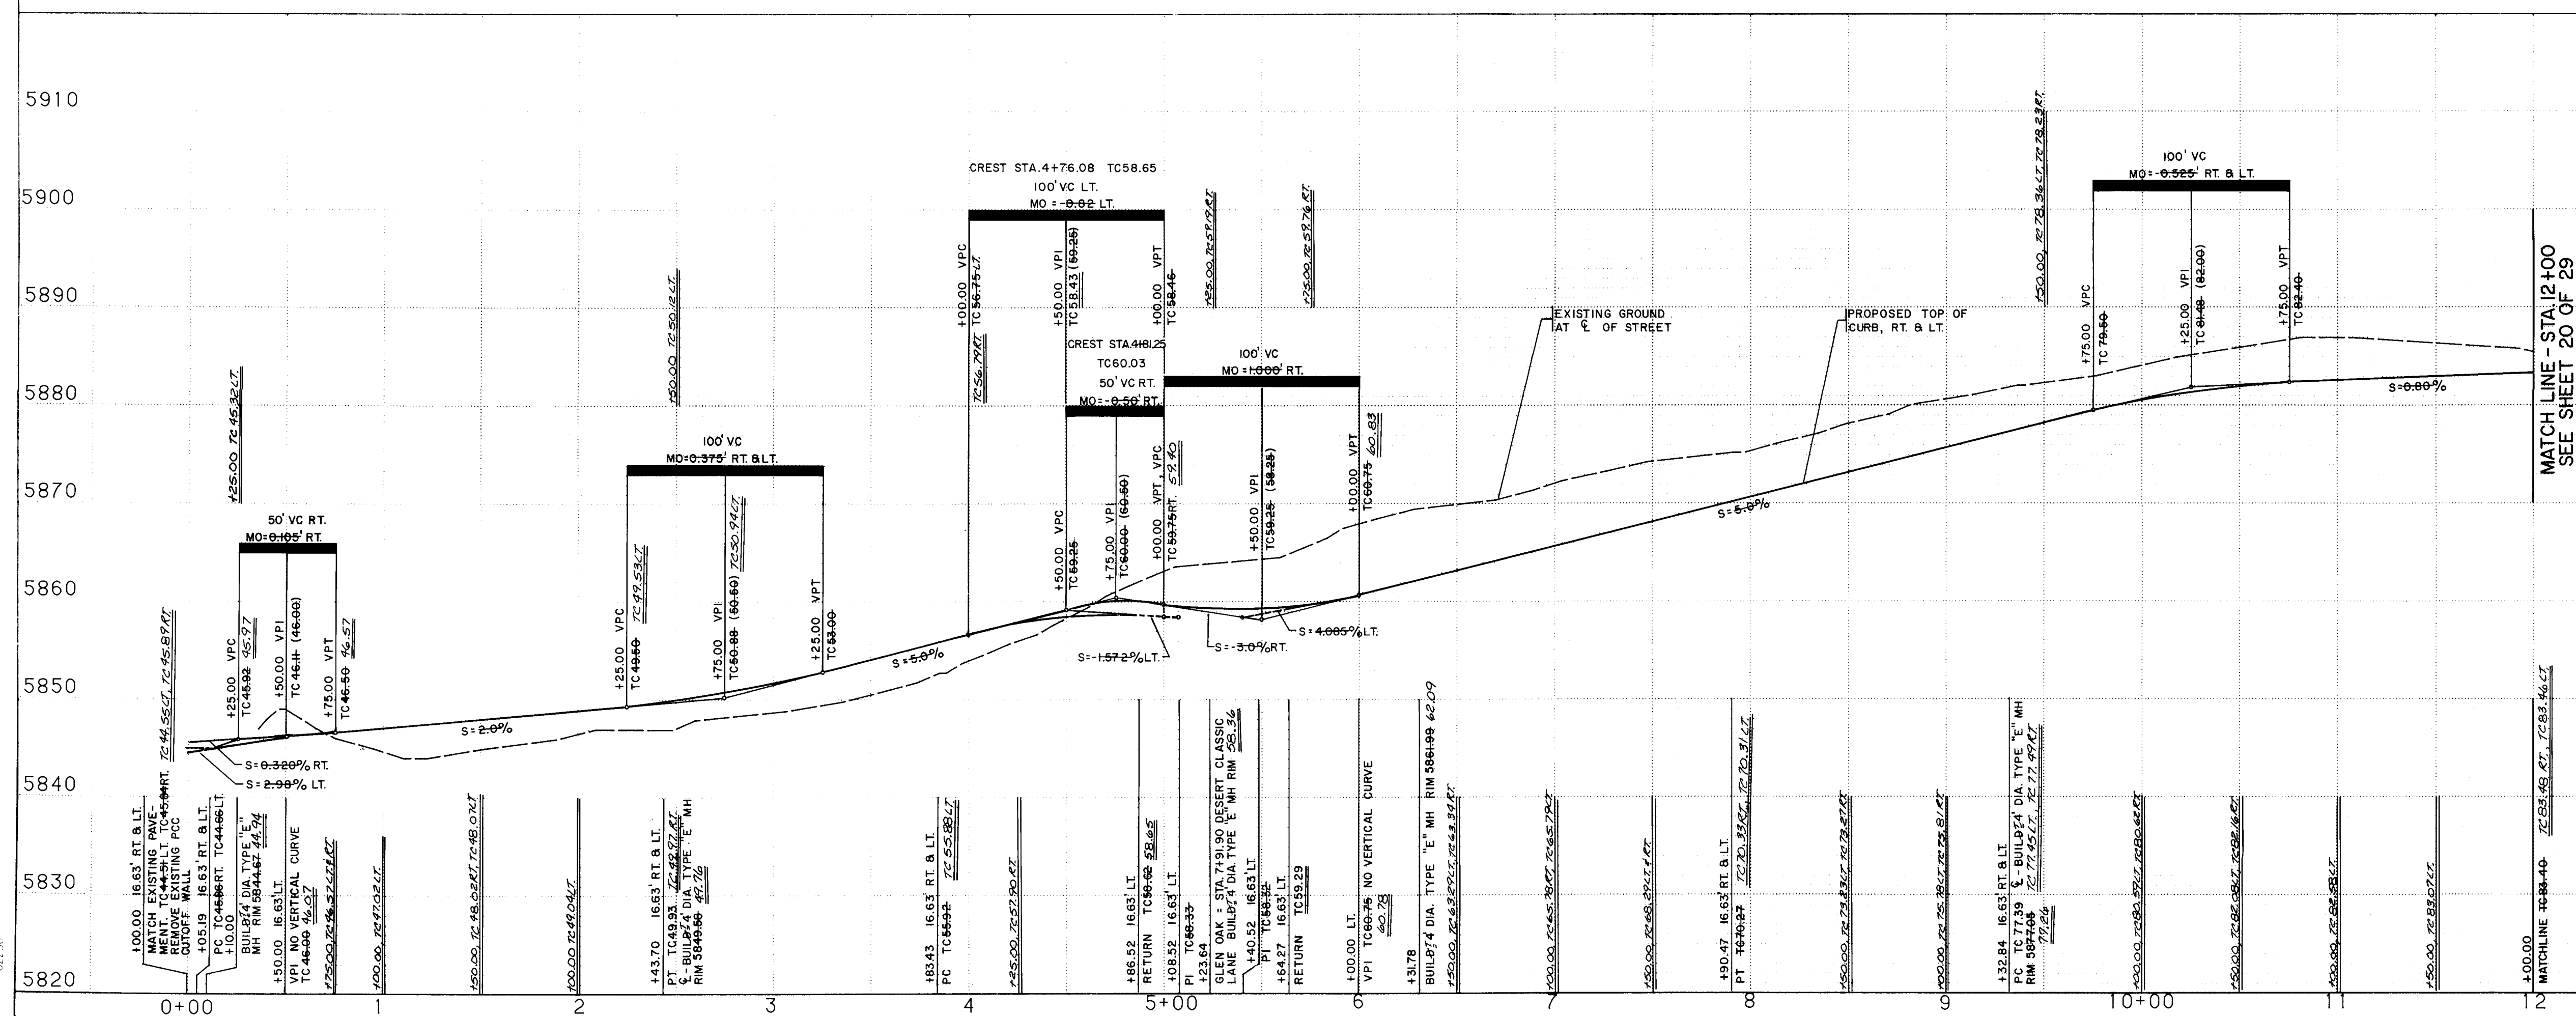

SCALE: 1" = 50' (HORIZ.)
1" = 10' (VERT.)

NOTES			
1.	THE CONTRACTOR SHALL FIELD VERIFY ALL EXISTING UTILITY LOCATIONS AND NOTIFY THE ENGINEER IMMEDIATELY OF ANY DISCREPANCIES.	AS BUILT	INFORMATION
2.	ALL CURB RETURN RADII SHALL BE 25' TO BACK OF CURB UNLESS OTHERWISE SPECIFIED.	J.R. HALE	DATE 9/1/78
3.	ALL CURVE DATA AND DIMENSIONS REFER TO BACK OF CURB UNLESS OTHERWISE SPECIFIED.	BHI	DATE 1/8/78
4.	GRADE ELEVATIONS, WHERE NOTED, ARE FOR TOP OF STANDARD CURB UNLESS OTHERWISE SPECIFIED.	BHI	DATE 1/8/78
5.	ALL ISLAND CONSTRUCTION SHALL CONSIST OF STANDARD MEDIAN CURB AND GUTTER.	BHI	DATE 1/8/78
		MICRO-FILM INFORMATION	DATE
		RECORDED BY	NO

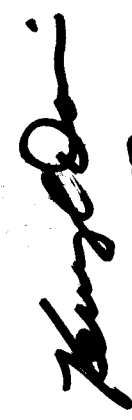NO.	STATION	OFFSET	TC ELEV.		BENCH MARKS	SURVEY INFORMATION	ENGINEER'S SEAL
1	11+95.61	16.62	5003.36		THE BENCH MARK IS LOCATED 1.2 MILES EAST OF THE INTERSECTION OF ACADEMY ROAD, NE & EUBANK BLVD., NE THEN 375' SOUTH. THE BENCH MARK IS ON THE SOUTH RIM OF THE BEAR CANYON TRIBUTARY & IS A STANDARD ACS BRASS TABLET STAMPED "6-E22 L54972". ELEVATION 5934.53.	FIELD NOTES DATE BY NO.	
2	11+76.74	28.91	5002.08	*			
3	11+72.61	36.03	5002.95	*			
4	11+42.57	56.01	5002.61	*			
5	11+11.72	46.47	5002.45	*			
6	10+98.20	28.91	5002.26	*			
7	10+79.33	16.62	5002.43	*			
8	11+46.53	16.62	5002.97	**			
9	11+49.38	25.53	5003.00	**			
10	11+37.47	30.12	5002.90	**			
11	11+25.57	25.53	5002.80	**			
12	11+28.42	16.62	5002.83	**			

* ROLL CURB & GUTTER
** MEDIAN CURB & GUTTER

CURVE DATA				
C	RADIUS	DELTA	TANGENT	LENGTH
A	25.00	57°17'19"	13.66	25.00
B	46.25	141°13'35"	131.44	114.01
C	25.00	57°17'19"	13.66	25.00
D	5.00	141°05'25"	14.16	12.32
E	20.00	81°58'12"	17.38	28.61
F	5.00	141°05'25"	14.16	12.32
G	266.63	4°09'05"	9.66	19.32



RECORD DRAWINGS


DATE JAN 7 1966

NO.	DATE	REMARKS	DESIGNED BY	DATE	DRAWN BY	DATE
				4/87		
				4/87		
				4/87		




NO.	DATE	REVISIONS	DESIGNED BY	DATE	DRAWN BY	DATE
				4/87		
				4/87		
				4/87		

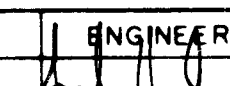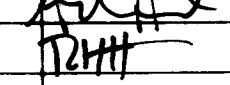CITY OF ALBUQUERQUE PUBLIC WORKS ENGINEERING					
TITLE: DESERT CLASSIC AT TANOAN - PHASE I PAVING PLAN & PROFILE GLENN OAK - STA. 0+00 TO STA. 12+00					
APPROVALS	ENGINEER	DATE	APPROVALS	ENGINEER	DATE
City Engineer		7/2/87	Liquid Waste	N/A P.H.	6-24-87
ACE - Design		6-24-87	Traffic	N/A P.H.	6-24-87
ACE - Hydrology	N/A CAM	6-24-87	Water	N/A P.H.	6-24-87
DRAWING NO.		MAP NO.		SHEET OF	
2479		E-22		19 29	

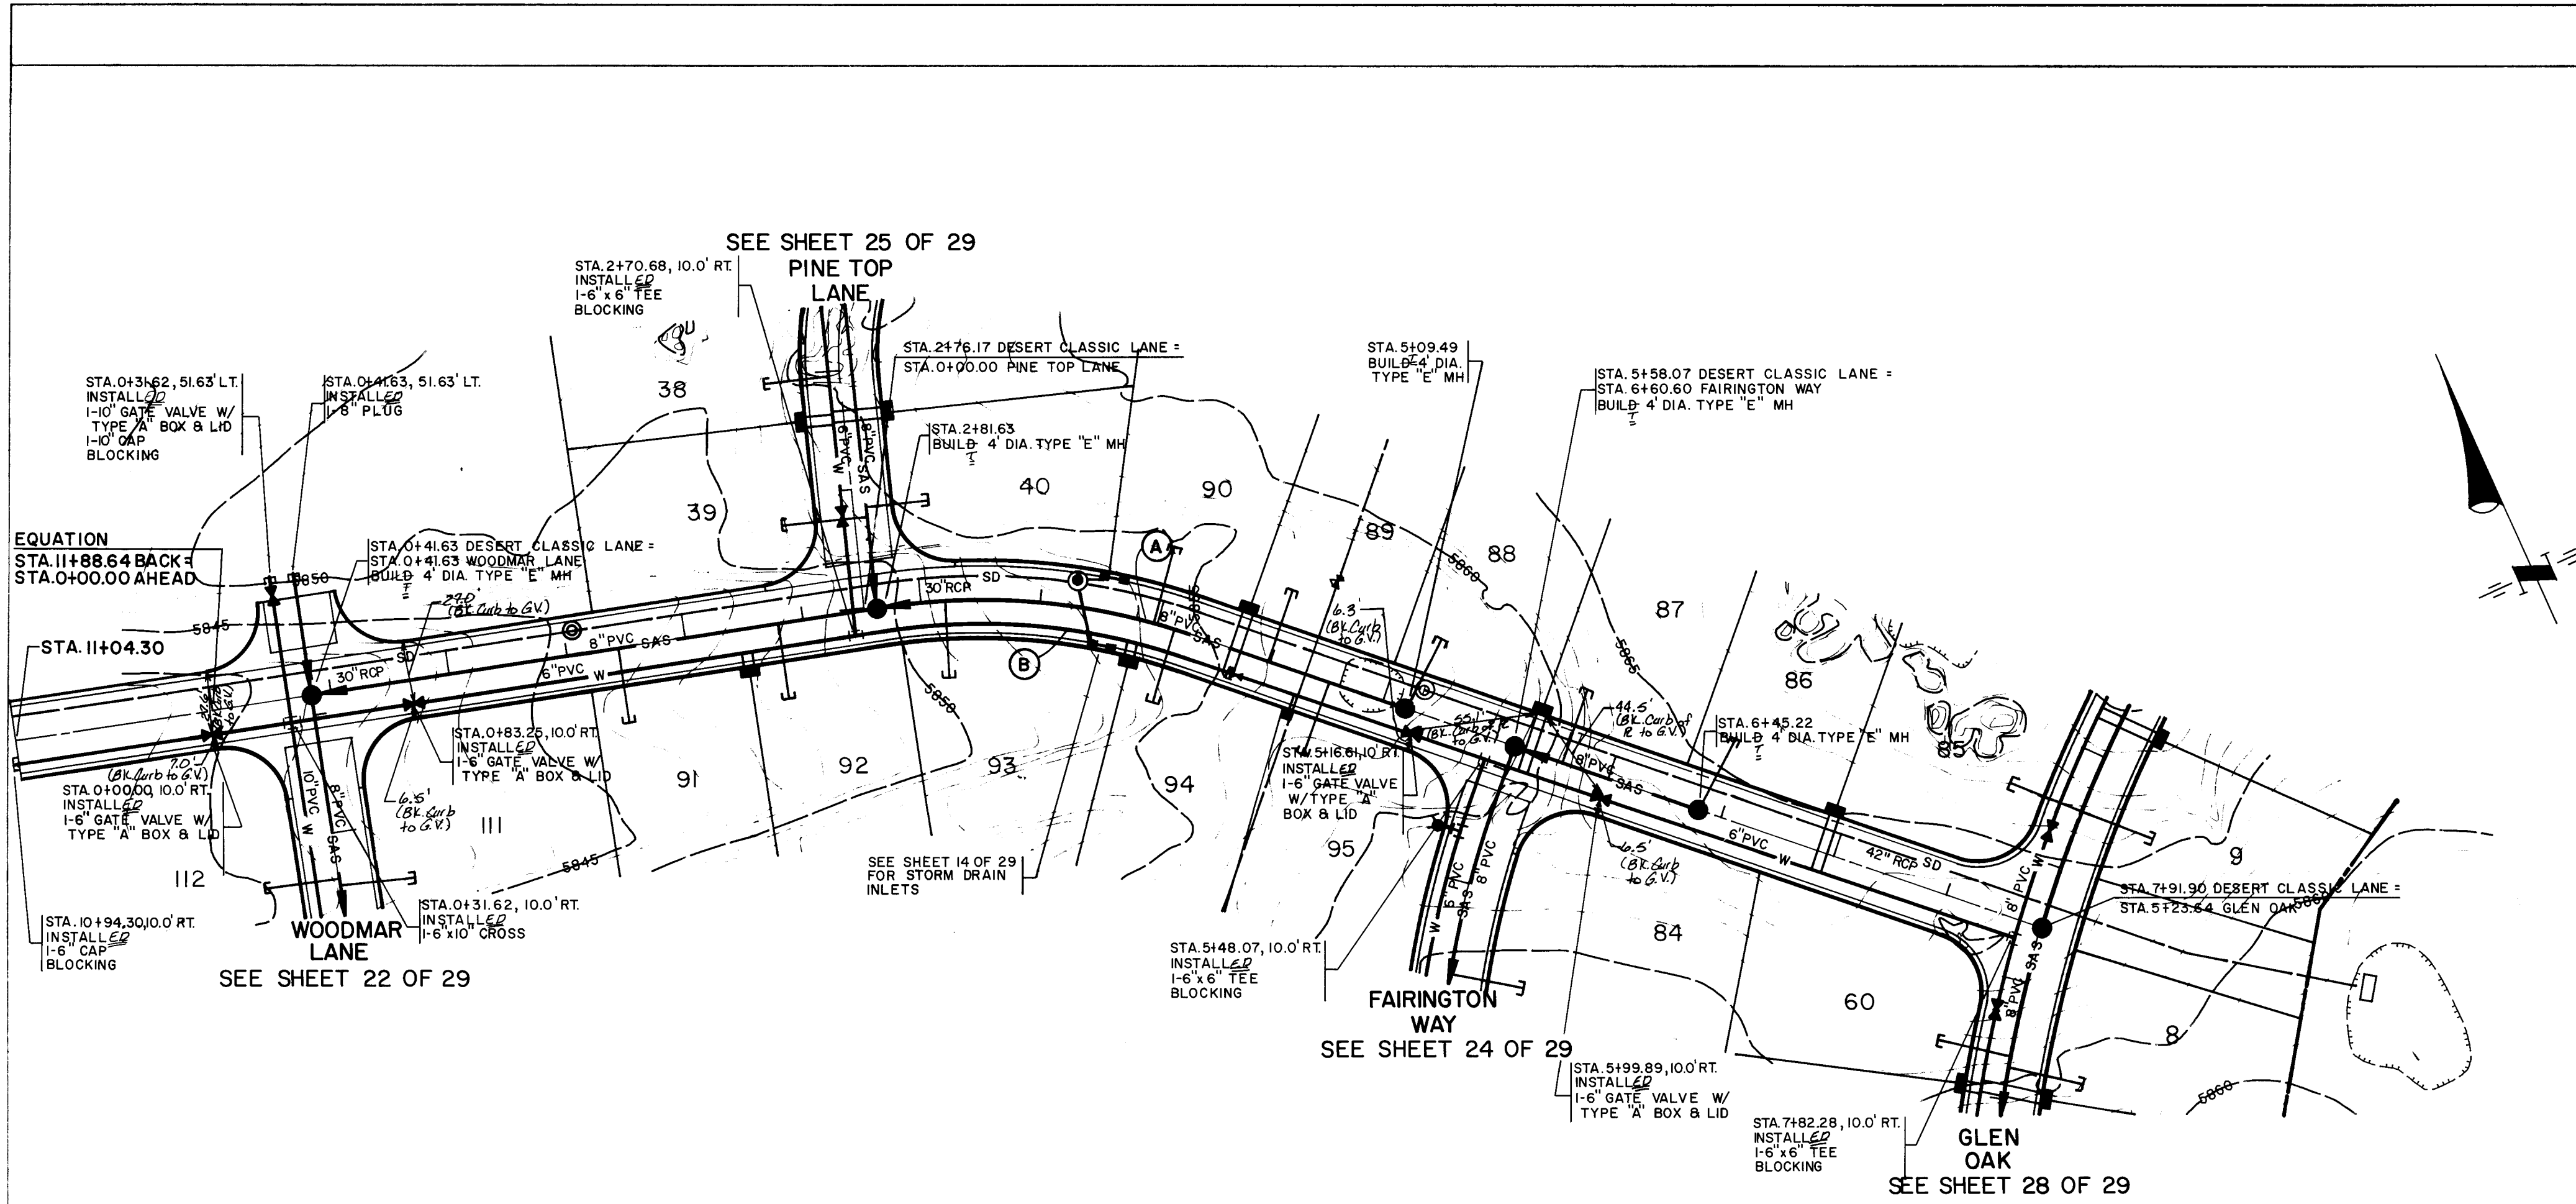

WATER & SEWER SERVICES						TOP OF PIPE
LOT	WL STATION	WL TYPE	SAS STATION	SAS LENGTH	INVERT	AT PLUG
85						
86	6+94.63 LT.	DOUBLE	6+45.22 LT.	32'	51.06	
87			5+79.83 LT.	32'	51.06	
88	5+64.63 LT.	DOUBLE	5+09.49 LT.	32'	50.30	
89			4+49.63 LT.	32'	49.86	
90	4+34.63 LT.	DOUBLE	3+91.17 LT.	32'	48.86	
91			1+73.25 RT.	32'	39.86	
92	2+24.83 RT.	DOUBLE	2+39.83 RT.	32'	41.89	
93			3+10.25 RT.	32'	46.39	
94	3+92.31 RT.	DOUBLE	4+07.31 RT.	32'	49.03	
95	4+61.46 RT.	SINGLE	4+76.46 RT.	32'	49.87	

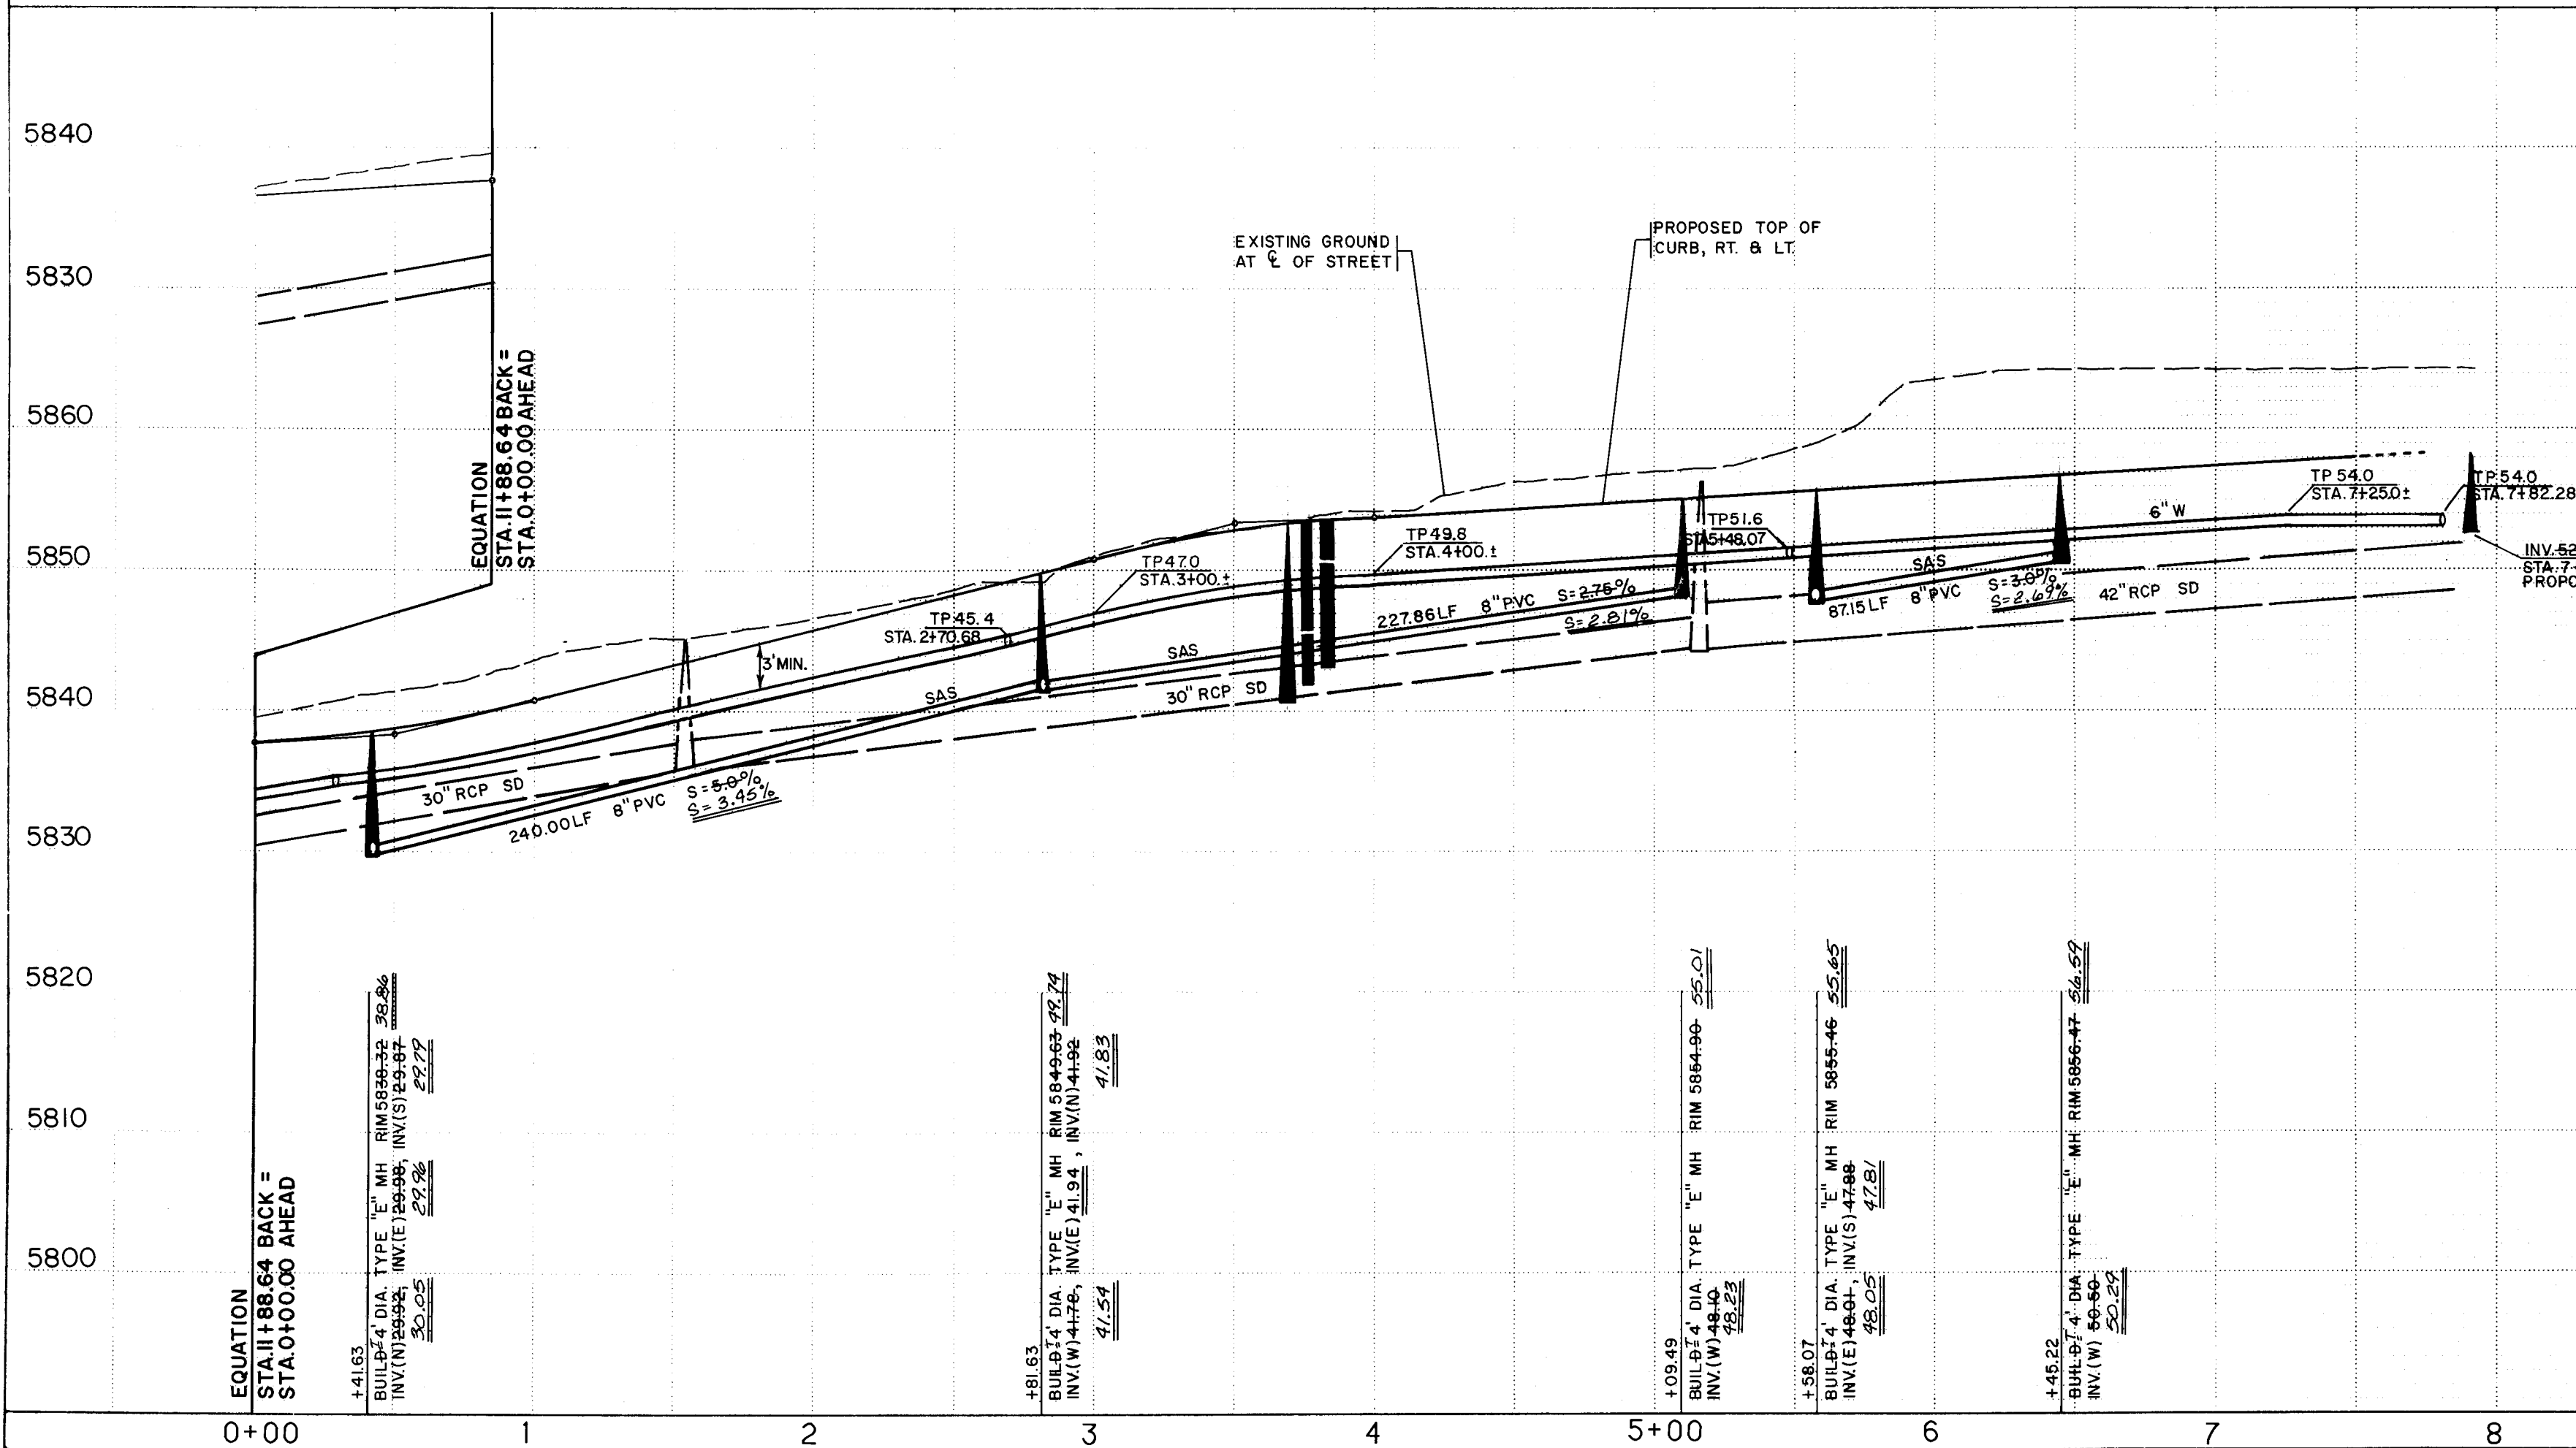

NOTE

I. THE CONTRACTOR SHALL FIELD VERIFY ALL EXISTING UTILITY LOCATIONS AND NOTIFY THE ENGINEER IMMEDIATELY OF ANY DISCREPANCIES.

SANITARY SEWER CURVE DATA

(A) PC STA.2+83.78
PT STA.4+14.88
Δ = 27° 49' 13"
R = 270.00'
L = 131.10'
T = 66.87'

WATERLINE CURVE DATA

(B) PC STA.2+83.78
PT STA.4+14.88
Δ = 27° 49' 13"
R = 260.00'
L = 126.25'
T = 64.39'

LOT	WL STATION	WL TYPE	SAS STATION	SAS LENGTH	INVERT	AT PLUG
85						
86	6+94.63 LT.	DOUBLE	6+45.22 LT.	32'	51.06	
87			5+79.83 LT.	32'	51.06	
88	5+64.63 LT.	DOUBLE	5+09.49 LT.	32'	50.30	
89			4+49.63 LT.	32'	49.86	
90	4+34.63 LT.	DOUBLE	3+91.17 LT.	32'	48.86	
91			1+73.25 RT.	32'	39.86	
92	2+24.83 RT.	DOUBLE	2+39.83 RT.	32'	41.89	
93			3+10.25 RT.	32'	46.39	
94	3+92.31 RT.	DOUBLE	4+07.31 RT.	32'	49.03	
95	4+61.46 RT.	SINGLE	4+76.46 RT.	32'	49.87	

RECORD DRAWINGS

DATE JAN 7 1988

CITY OF ALBUQUERQUE
PUBLIC WORKS
ENGINEERING

TITLE: DESERT CLASSIC AT TANOAN - PHASE I
UTILITY PLAN & PROFILE
DESERT CLASSIC LANE

APPROVALS	ENGINEER	DATE	APPROVALS	ENGINEER	DATE
City Engineer	John R. Smith	7/2/87	Liquid Waste	John R. Smith	6/24/87
A.C.E.-Design	John R. Smith	6/24/87	Traffic	NADWH	6/24/87
A.C.E.-Hydrology	John R. Smith	6-24-87	Water	John R. Smith	6-24-87

DESIGNED BY MLJ/AMT DATE 4/87
DRAWN BY TG/TL DATE 4/87
CHECKED BY KLD DATE 4/87

AS BUILT INFORMATION

THE BENCH MARK IS LOCATED 1.2 MILES EAST OF THE INTERSECTION OF ACADEMY ROAD, NE & EUBANK BLVD., NE THEN 375' SOUTH. THE BENCH MARK IS ON THE SOUTH RIM OF THE BEAR CANYON TRIBUTARY & IS A STANDARD ACS BRASS TABLET STAMPED "6-E22 L54972" ELEVATION 5934.53'

DATE 9/87
DATE 2/88
DATE 1/88
DATE 1/88
DATE

DESERT CLASSIC LANE

FAIRINGTON WAY

GLEN OAK


SCALE: 1" = 50' (HORIZ.)
1" = 10' (VERT.)

BHI JOB N° 71263

DRAWING NO. 2479

MAP NO. E-22

SHEET 23 OF 29

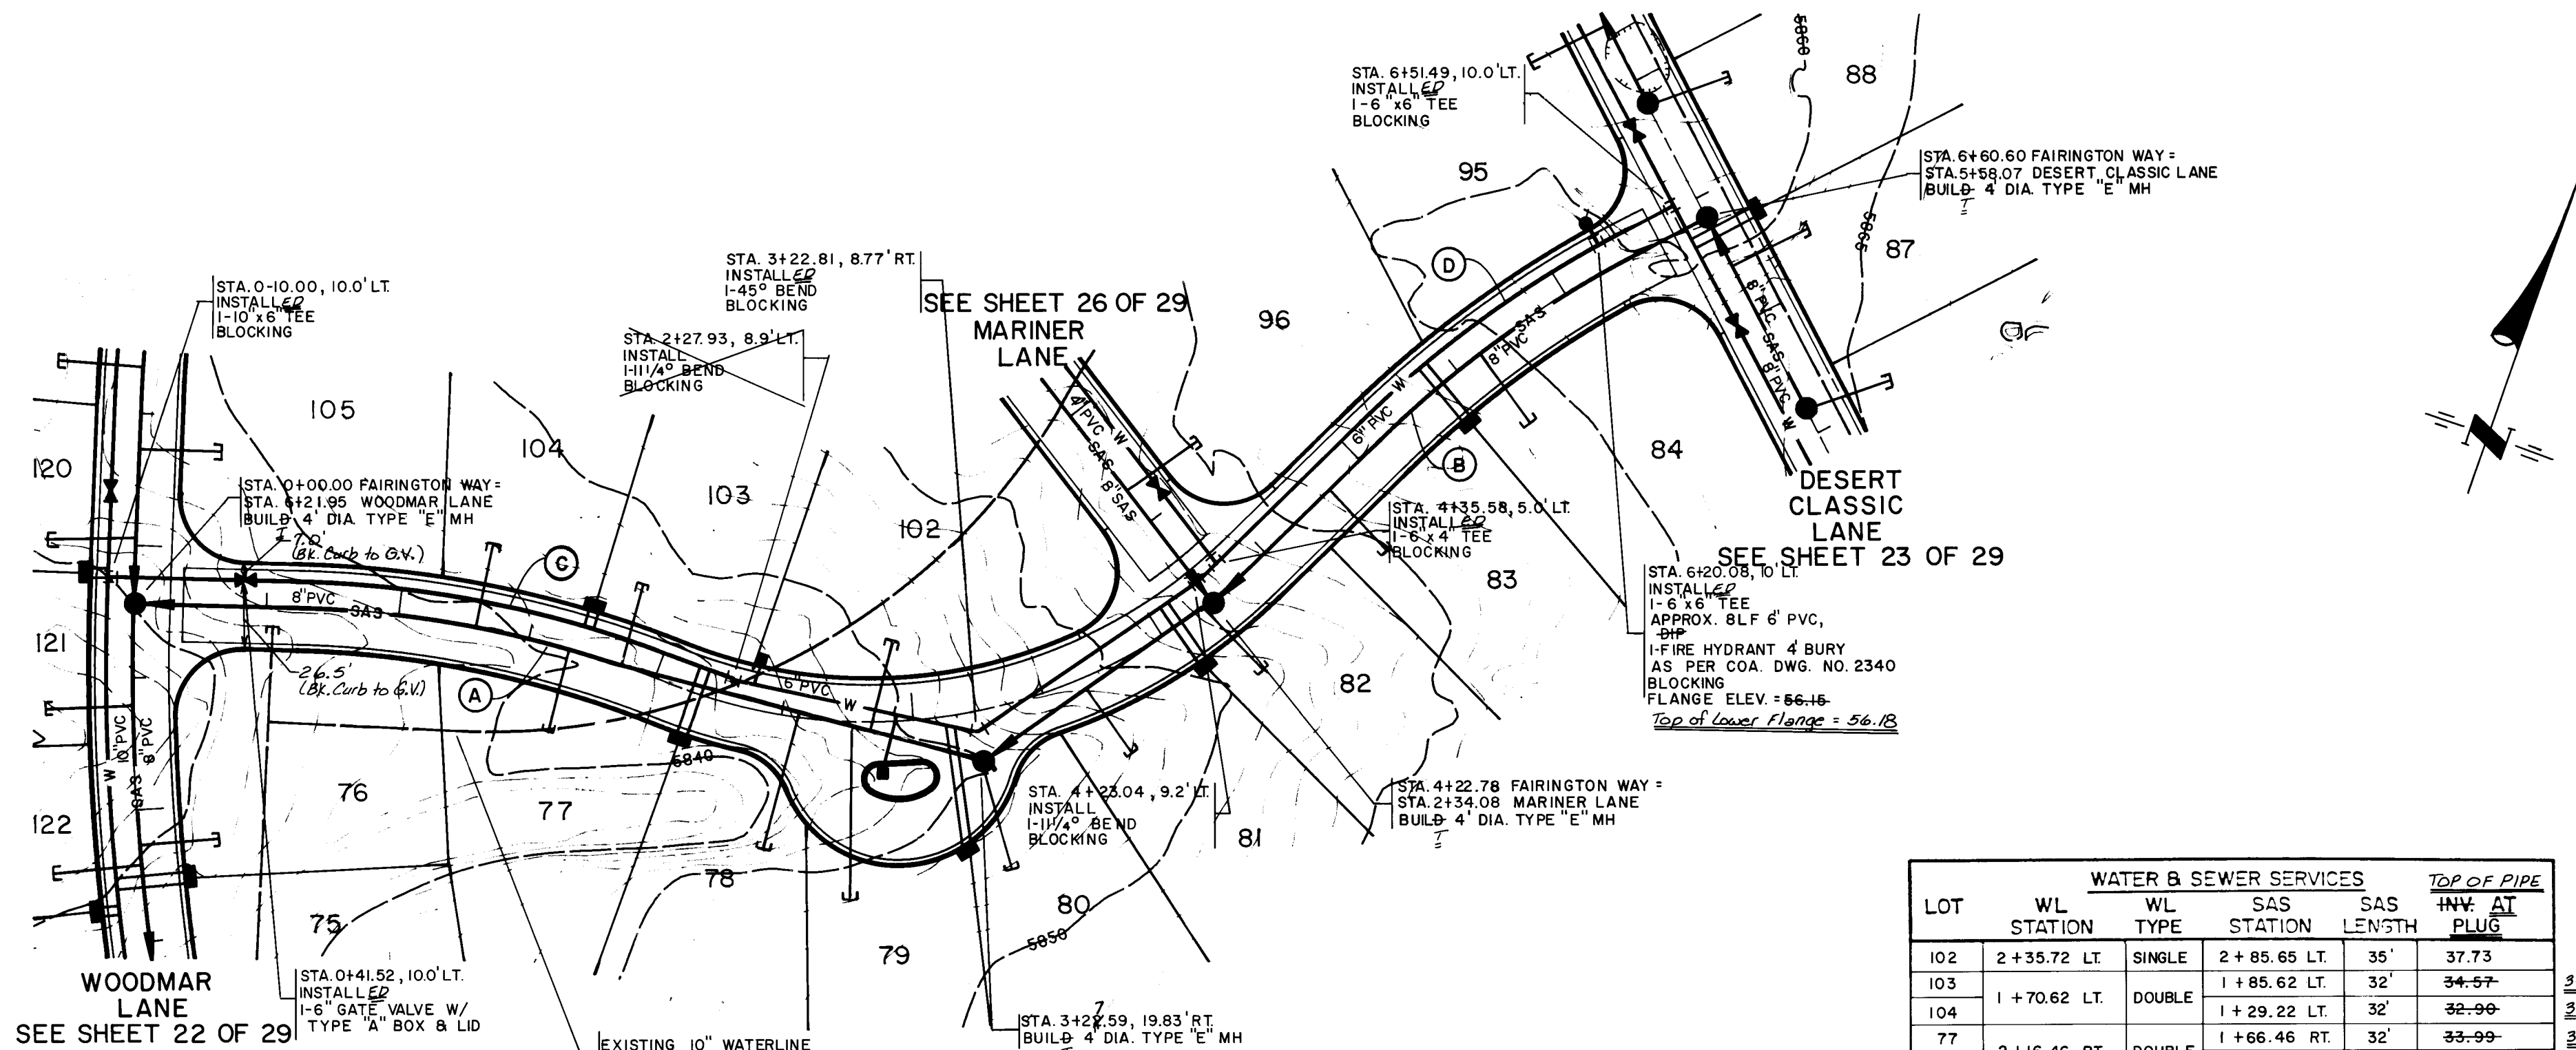

WATER & SEWER SERVICES					
LOT	WL STATION	WL TYPE	SAS STATION	SAS LENGTH	TOP OF PIPE INV. AT PLUG
102	2+35.72 LT.	SINGLE	2+85.65 LT.	35'	37.73
103	1+70.62 LT.	DOUBLE	1+85.62 LT.	32'	34.57
104			1+29.22 LT.	32'	32.99
77	2+16.46 RT.	DOUBLE	1+66.46 RT.	32'	33.99
78			2+56.18 RT.	54'	36.36
79	3+13.92 RT.	DOUBLE	2+76.97 RT.	63'	37.10
80			3+22.59 RT.	43'	39.04
81	4+06.80 RT.	DOUBLE	3+66.30 RT.	28'	41.71
82			4+21.80 RT.	32'	44.82
83	5+14.33 RT.	DOUBLE	4+84.16 RT.	32'	47.21
84			5+61.33 RT.	32'	49.74

* INSTALL SEWER RISER AS PER COA DWG. NO. 2136


NOTE
I. THE CONTRACTOR SHALL FIELD VERIFY ALL EXISTING UTILITY LOCATIONS AND NOTIFY THE ENGINEER IMMEDIATELY OF ANY DISCREPANCIES.

SANITARY SEWER CURVE DATA

- (A) PC STA. 0+62.06
PT STA. 1+61.92
 $\Delta = 13^\circ 59' 20''$
R = 409.00'
L = 99.86'
T = 50.18'
- (B) PC STA. 5+10.78
PT STA. 6+30.94
 $\Delta = 16^\circ 47' 33''$
R = 410.00'
L = 120.16'
T = 60.52'

WATERLINE CURVE DATA

- (C) PC STA. 0+62.06
PT STA. 2+06.24
 $\Delta = 20^\circ 11' 51''$
R = 419.00'
L = 147.70'
T = 74.63'
- (D) PC STA. 5+10.78
PT STA. 6+30.94
 $\Delta = 16^\circ 47' 33''$
R = 420.00'
L = 123.09'
T = 61.99'

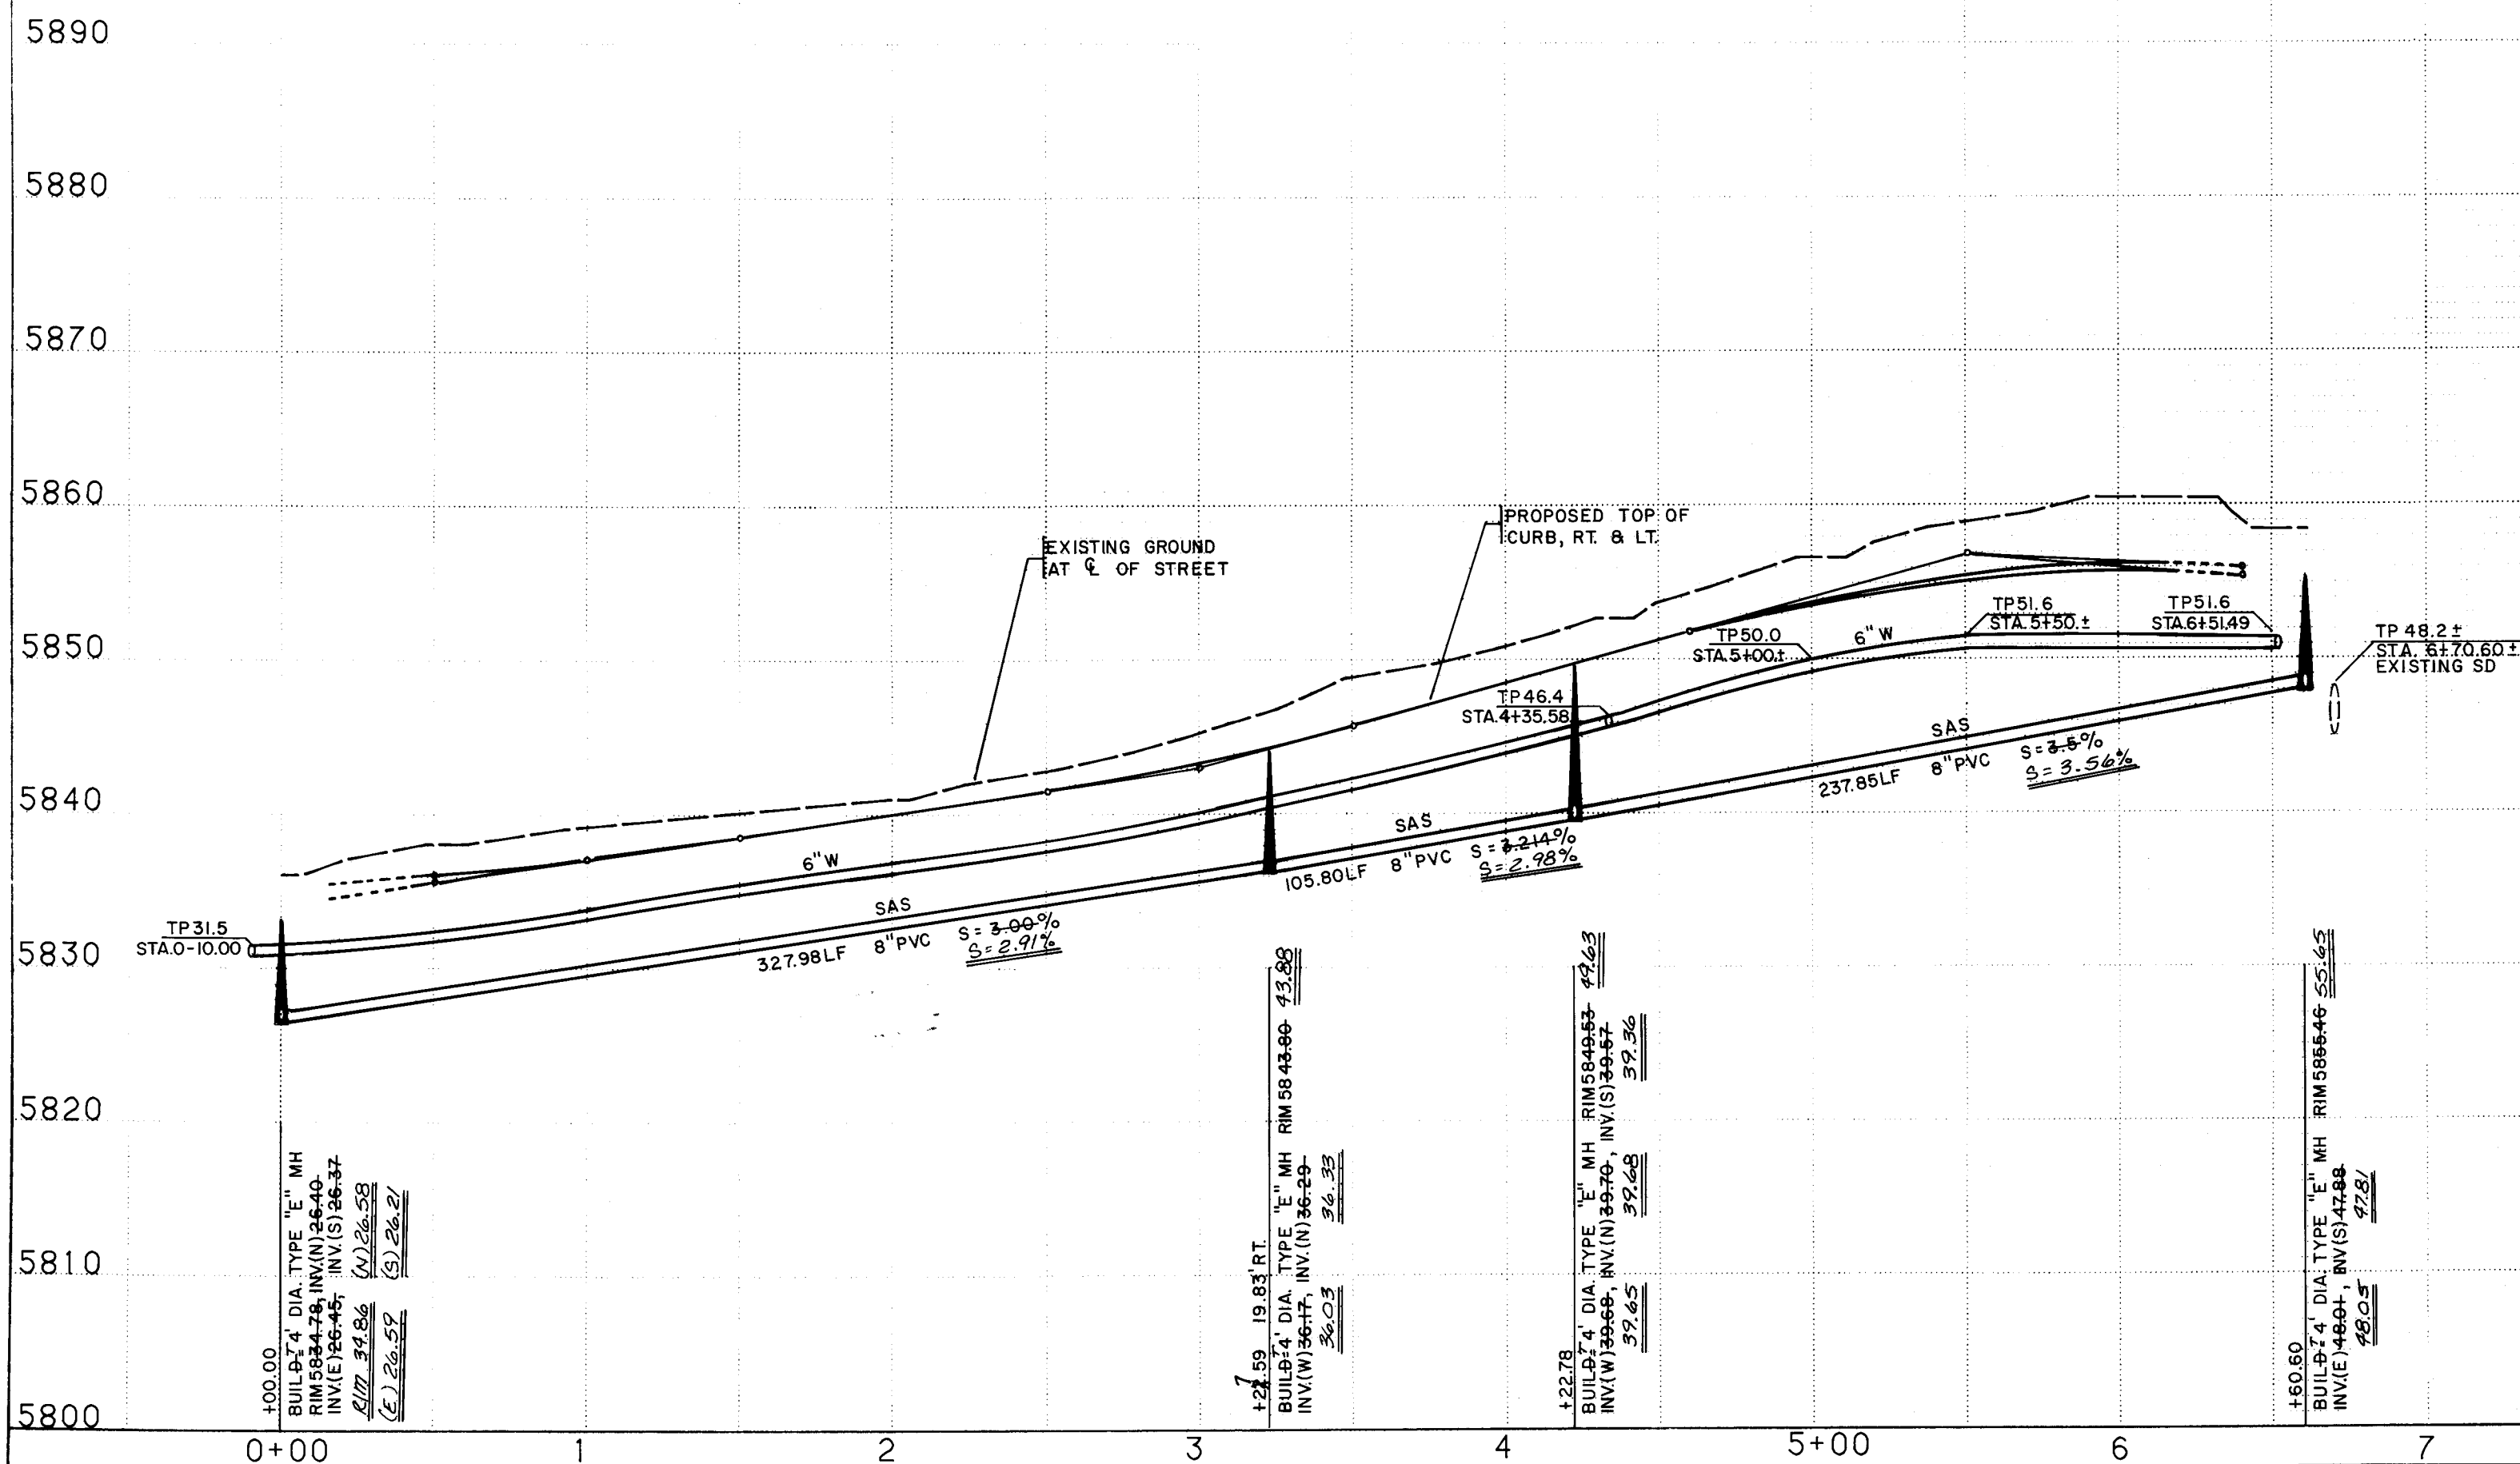

RECORD DRAWINGS
DATE JAN 7 1988


1 2 3 4 5 6 7 8 9 10 11 12
26 247929818

CITY OF ALBUQUERQUE PUBLIC WORKS ENGINEERING			
TITLE: DESERT CLASSIC AT TANOAN - PHASE I UTILITY PLAN & PROFILE FAIRINGTON WAY			
APPROVALS	ENGINEER	DATE	APPROVALS
City Engineer	<i>[Signature]</i>	7/2/87	Liquid Waste
A C E - Design	<i>[Signature]</i>	6-24-87	Traffic
A C E - Hydrology	<i>[Signature]</i>	6-24-87	Water
DESIGNED BY	MLJ/AMT	DATE	4/87
DRAWN BY	TG/TL	DATE	4/87
CHECKED BY	KLD	DATE	4/87


BHI JOB N° 71263

SCALE: 1" = 50' (HORIZ.)
1" = 10' (VERT.)

DRAWING NO. 2479 MAP NO. E-22 SHEET 24 OF 29

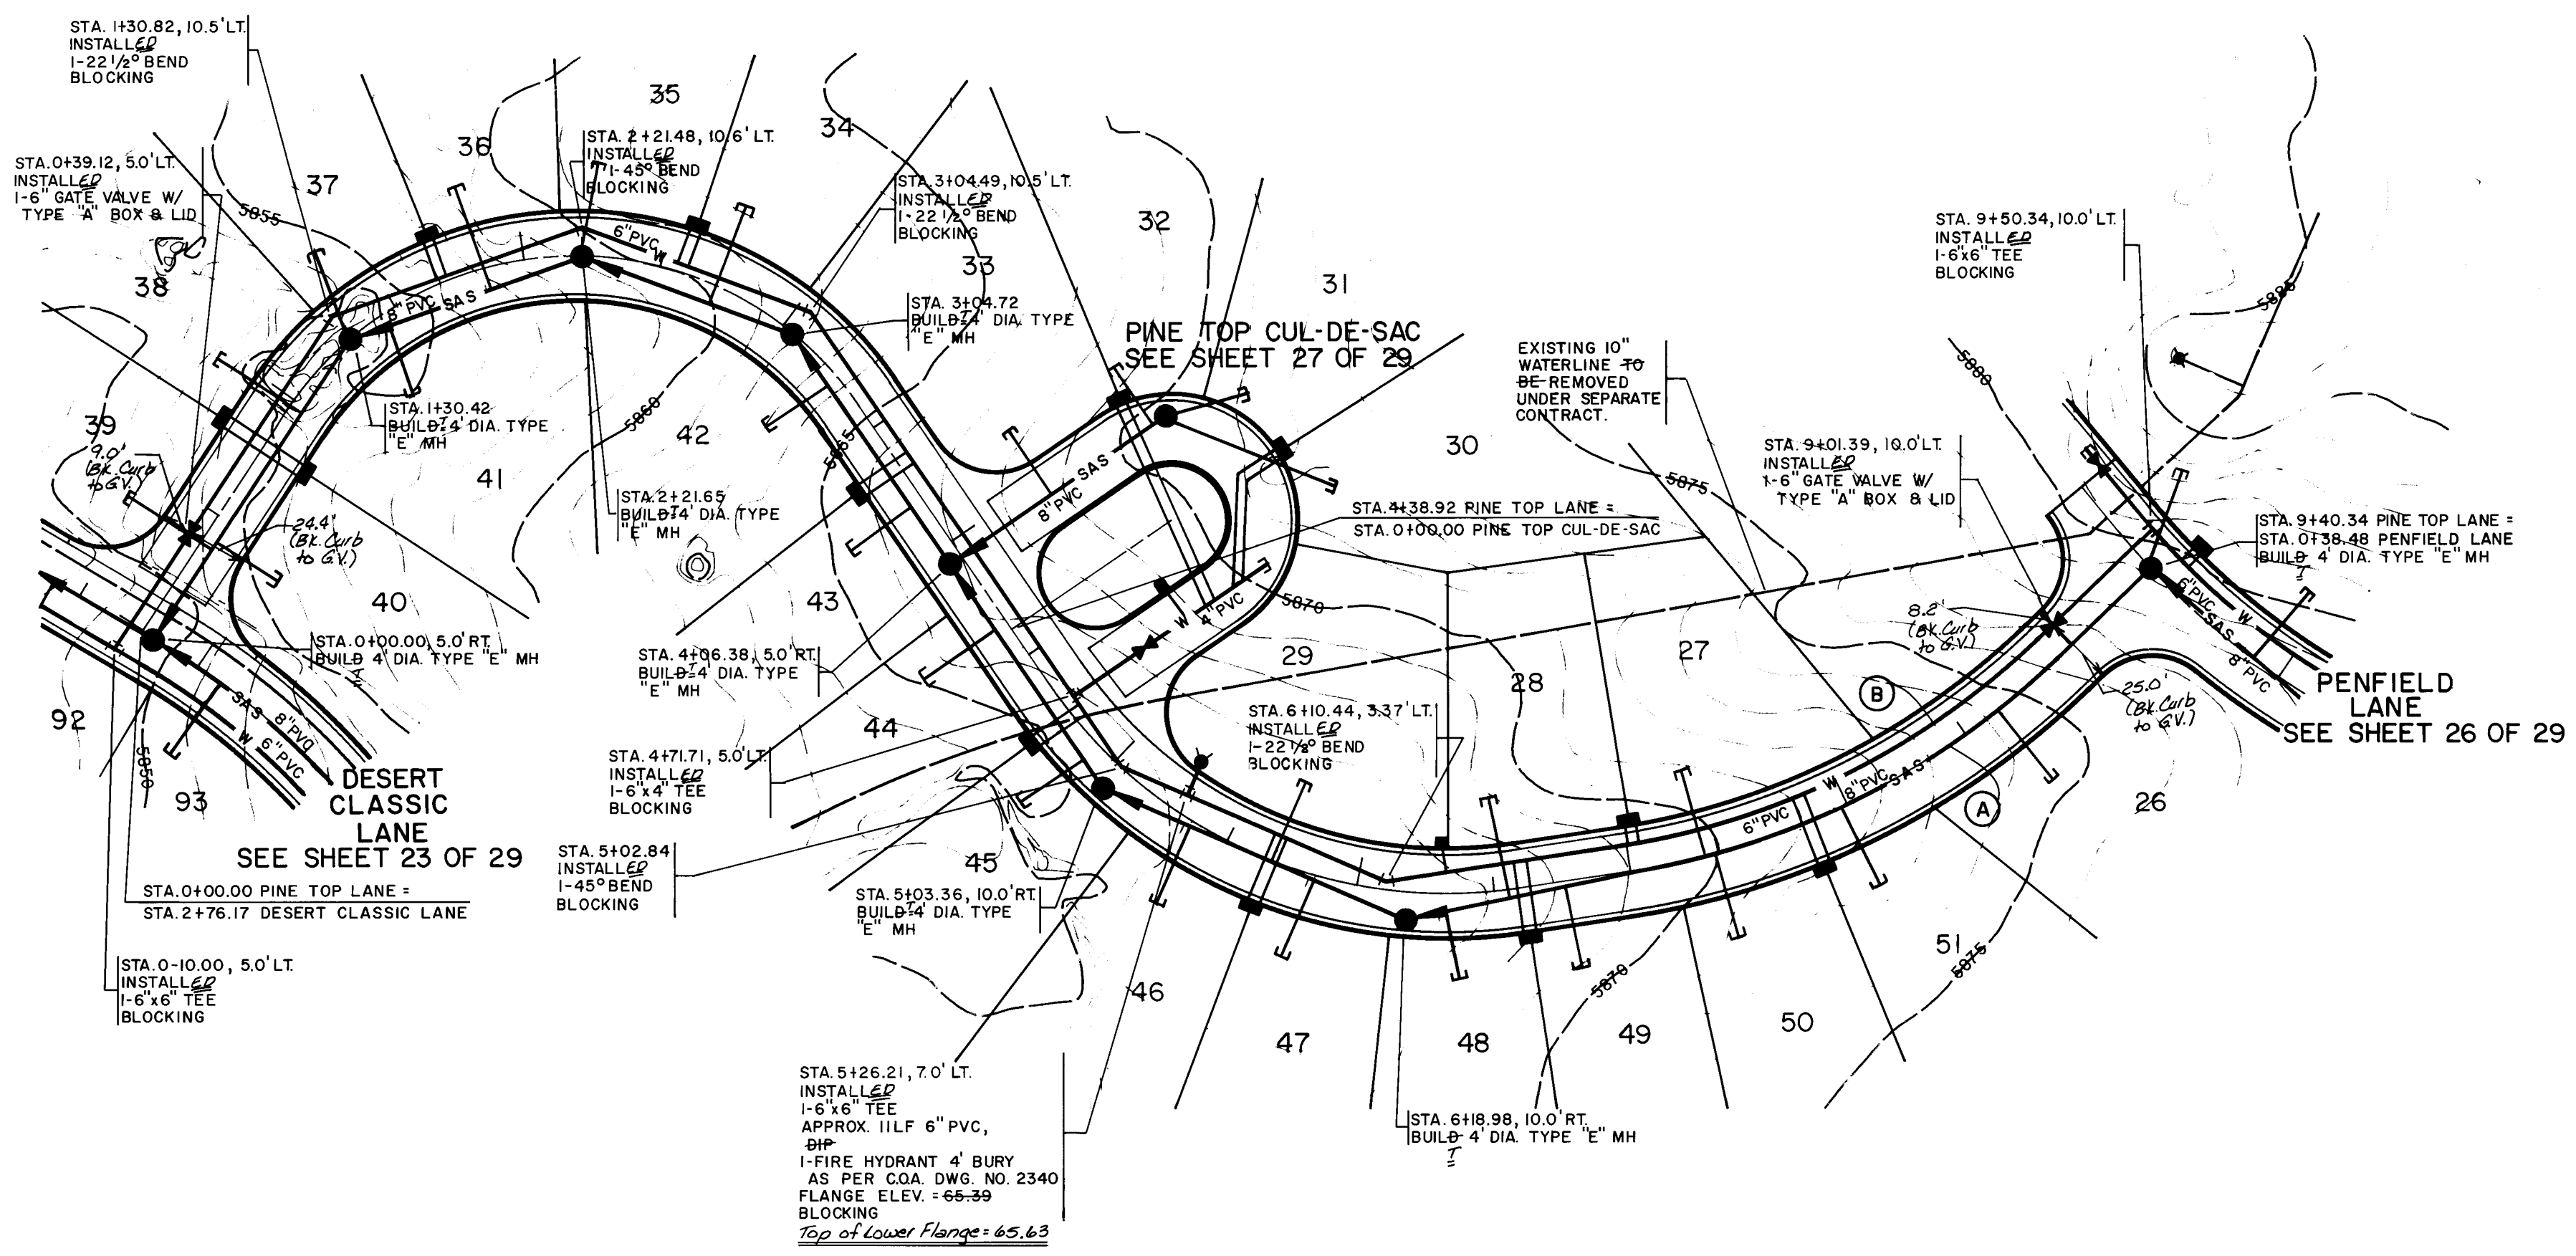

WATER & SEWER SERVICES						TOP OF PIPE
LOT	WL STATION	WL TYPE	SAS STATION	SAS LENGTH	INV. AT PLUG	
26			8+65.85 RT	32'	72.04	73.24
40	0+80.40 RT	DOUBLE	0+42.12 RT	27'	45.65	46.19
41			1+44.85 RT	27'	47.38	47.82
42	3+26.13 RT	DOUBLE	3+81.13 RT	27'	42.94	43.12
43			4+36.58 RT	27'	44.92	45.14
44	4+75.97 RT	DOUBLE	4+91.49 RT	25'	58.89	59.37
45			5+34.58 RT	30'	60.44	60.64
46	5+67.07 RT	DOUBLE	5+82.07 RT	31'	62.15	62.72
47			6+28.86 RT	25'	65.84	66.10
48	6+61.03 RT	DOUBLE	6+76.03 RT	30'	65.84	65.91
49			7+48.59 RT	32'	67.53	67.85
50	7+83.97 RT	DOUBLE	7+98.97 RT	32'	69.34	69.46
51			7+45.59 LT	32'	67.42	67.77
27	7+19.89 LT	DOUBLE	6+55.32 LT	35'	64.79	65.21
28			5+67.88 LT	32'	61.64	62.00
29	6+33.67 LT	SINGLE	2+70.62 LT	38'	60.94	61.34
34	2+58.71 LT	DOUBLE	2+21.65 LT	32'	49.40	49.86
35			1+85.16 LT	40'	48.24	48.75
37	1+70.57 LT	DOUBLE	1+30.42 LT	33'	47.12	47.54
38			0+95.36 LT	37'	46.43	46.87
39	0+80.36 LT	DOUBLE	0+39.12 LT	37'	45.06	45.43

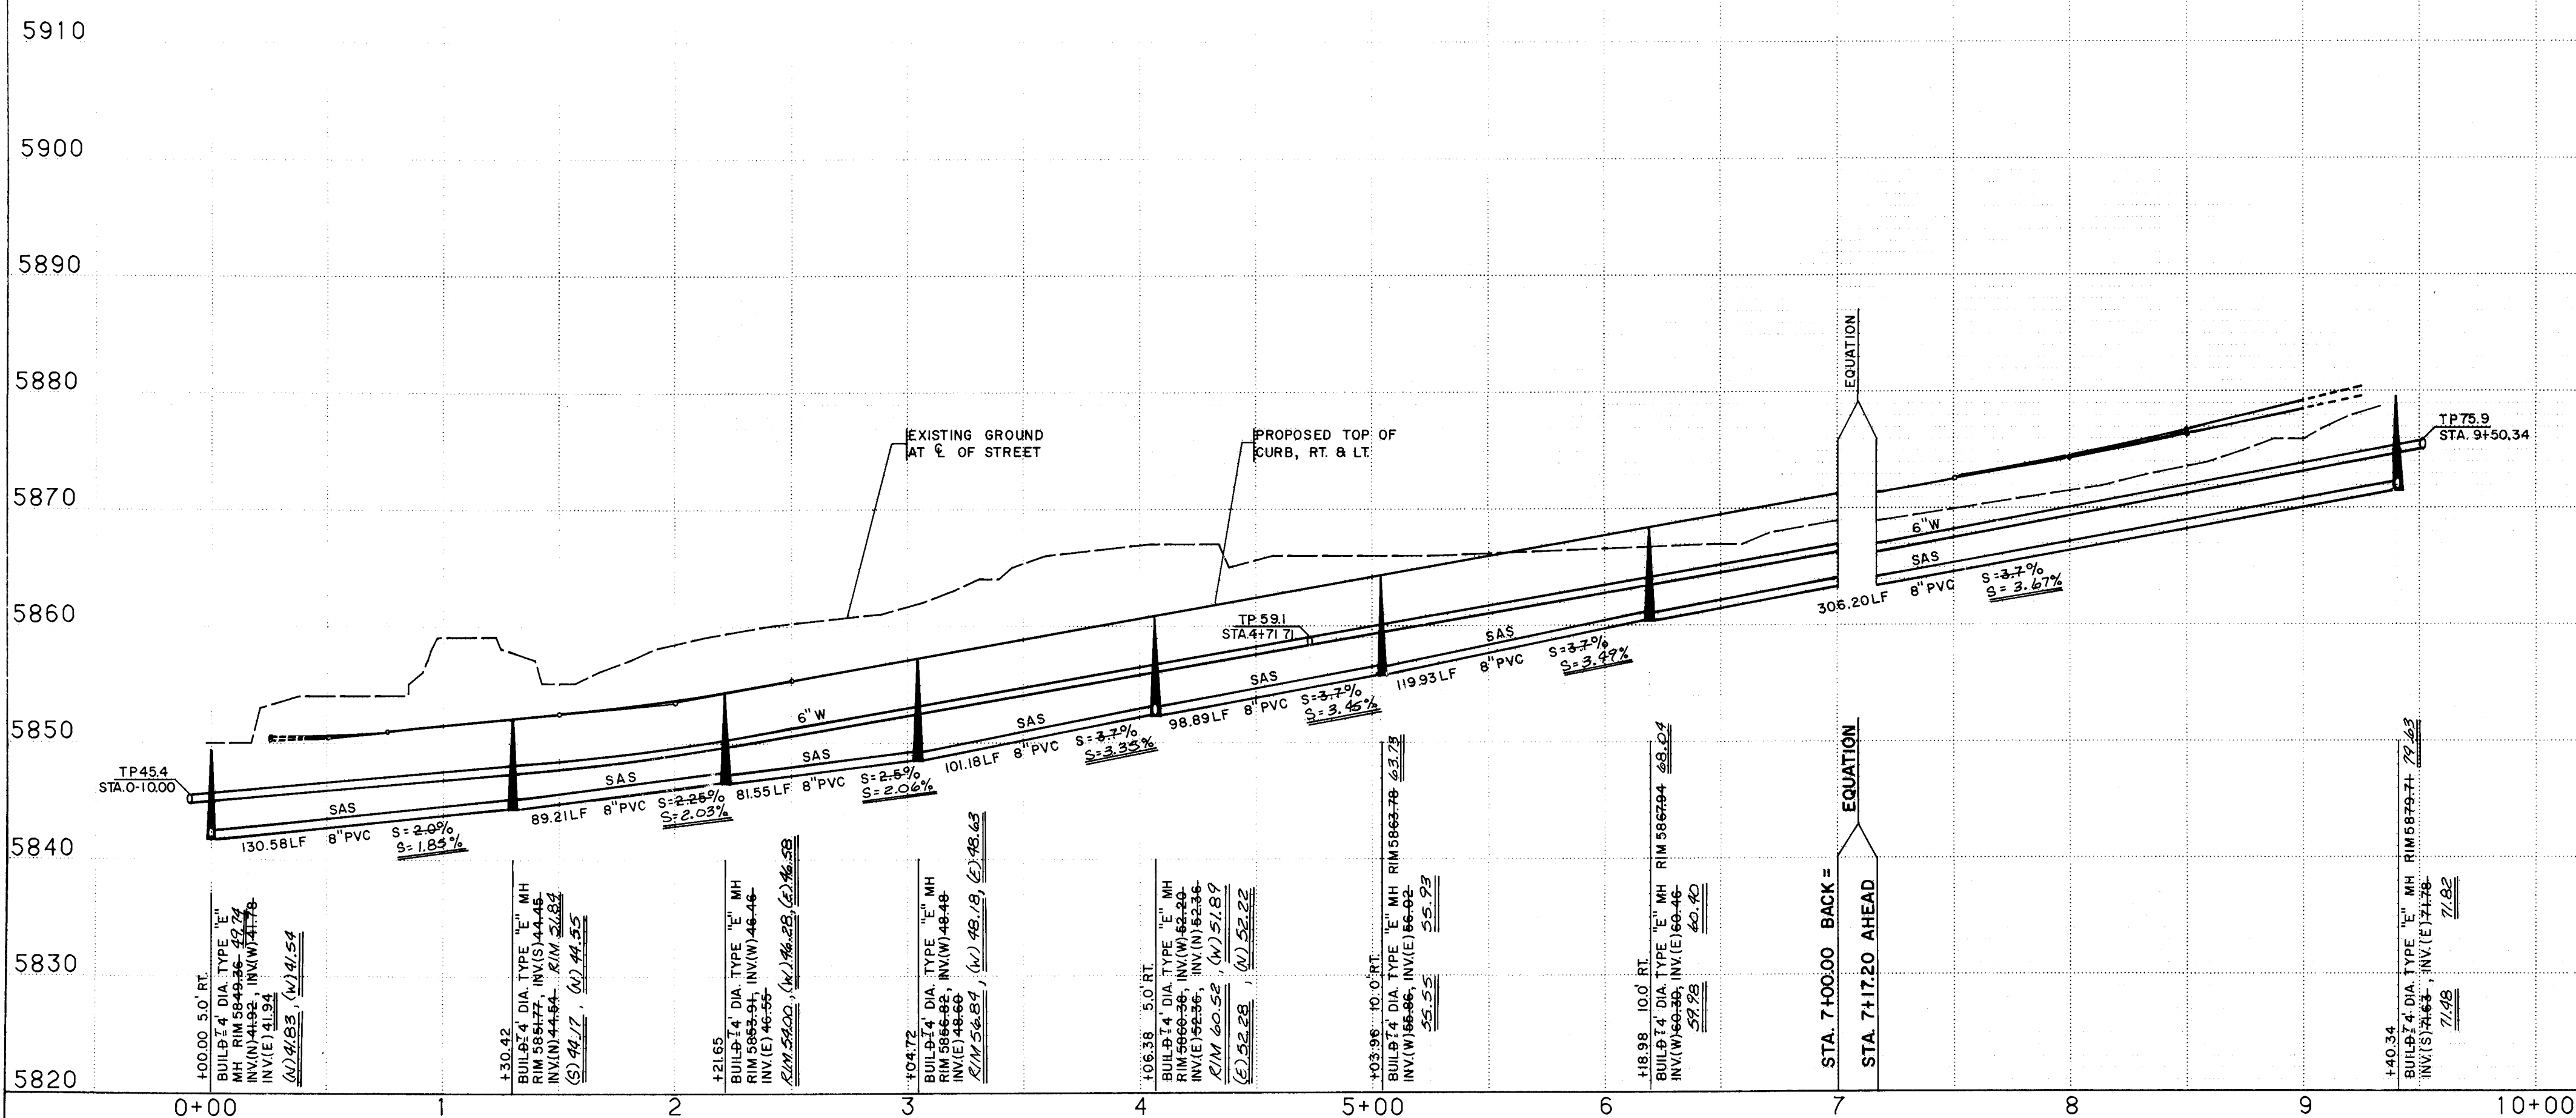

NOTE
I. THE CONTRACTOR SHALL FIELD VERIFY ALL EXISTING UTILITY LOCATIONS AND NOTIFY THE ENGINEER IMMEDIATELY OF ANY DISCREPANCIES.

SANITARY SEWER CURVE DATA

(A) PC STA.6+98.14
PT STA.8+93.44
Δ = 32° 20' 38"
R = 287.00'
L = 162.01'
T = 83.23'

WATERLINE CURVE DATA

(B) PC STA.6+98.14
PT STA.8+93.44
Δ = 35° 33' 20"
R = 277.00'
L = 171.89'
T = 88.82'



RECORD DRAWINGS
DATE JUN 7 1988

26 247930818


CITY OF ALBUQUERQUE PUBLIC WORKS ENGINEERING				
TITLE: DESERT CLASSIC AT TANOAN - PHASE I UTILITY PLAN & PROFILE PINE TOP LANE				
APPROVALS	ENGINEER	DATE	APPROVALS	ENGINEER
City Engineer	<i>Antonia</i>	7/6/87	Liquid Waste	<i>25 Samy</i>
A C E - Design	<i>Antonia</i>	6/23/87	Traffic	<i>NADUH</i>
A C E - Hydrology	<i>AR CAM</i>	6/24/87	Water	<i>25 Samy</i>
DRAWING NO. 2479		MAP NO. E-22		SHEET 25 OF 29



WATER & SEWER SERVICES						
LOT	WL STATION	WL TYPE	SAS STATION	SAS LENGTH	INV. AT PLUG	
1	I + 17.75 LT.	SINGLE	—	—	—	
2			+ 0+1.82 LT.	32'	75.76	
3	O + 46.82 LT.	DOUBLE	+ 0+38.48 LT.	35'	74.85	
26						
25	I + 12.11 RT.	DOUBLE	+ 1+26.01 RT.	30'	77.74	
24	I + 57.54 SA.	SINGLE				



WATER & SEWER SERVICES						TOP OF PIPE
LOT	WL STATION	WL TYPE	SAS STATION	SAS LENGTH	INVT. AT PLUG	
96	1+27.20 LT.	DOUBLE	1+82.20 LT.	32'	44.72	* 45.07
97			1+17.21 LT.	32'	45.04	* 45.36
98	0+17.73 LT.	DOUBLE	0+19.75 LT.	54'	45.66	* 45.98
99			0+19.75 LT.	36'	45.18	* 45.58
100	0+19.76 RT.	DOUBLE	0+19.75 RT.	40'	46.60	* 46.99
101			0+44.64 RT.	62'	46.41	* 46.70

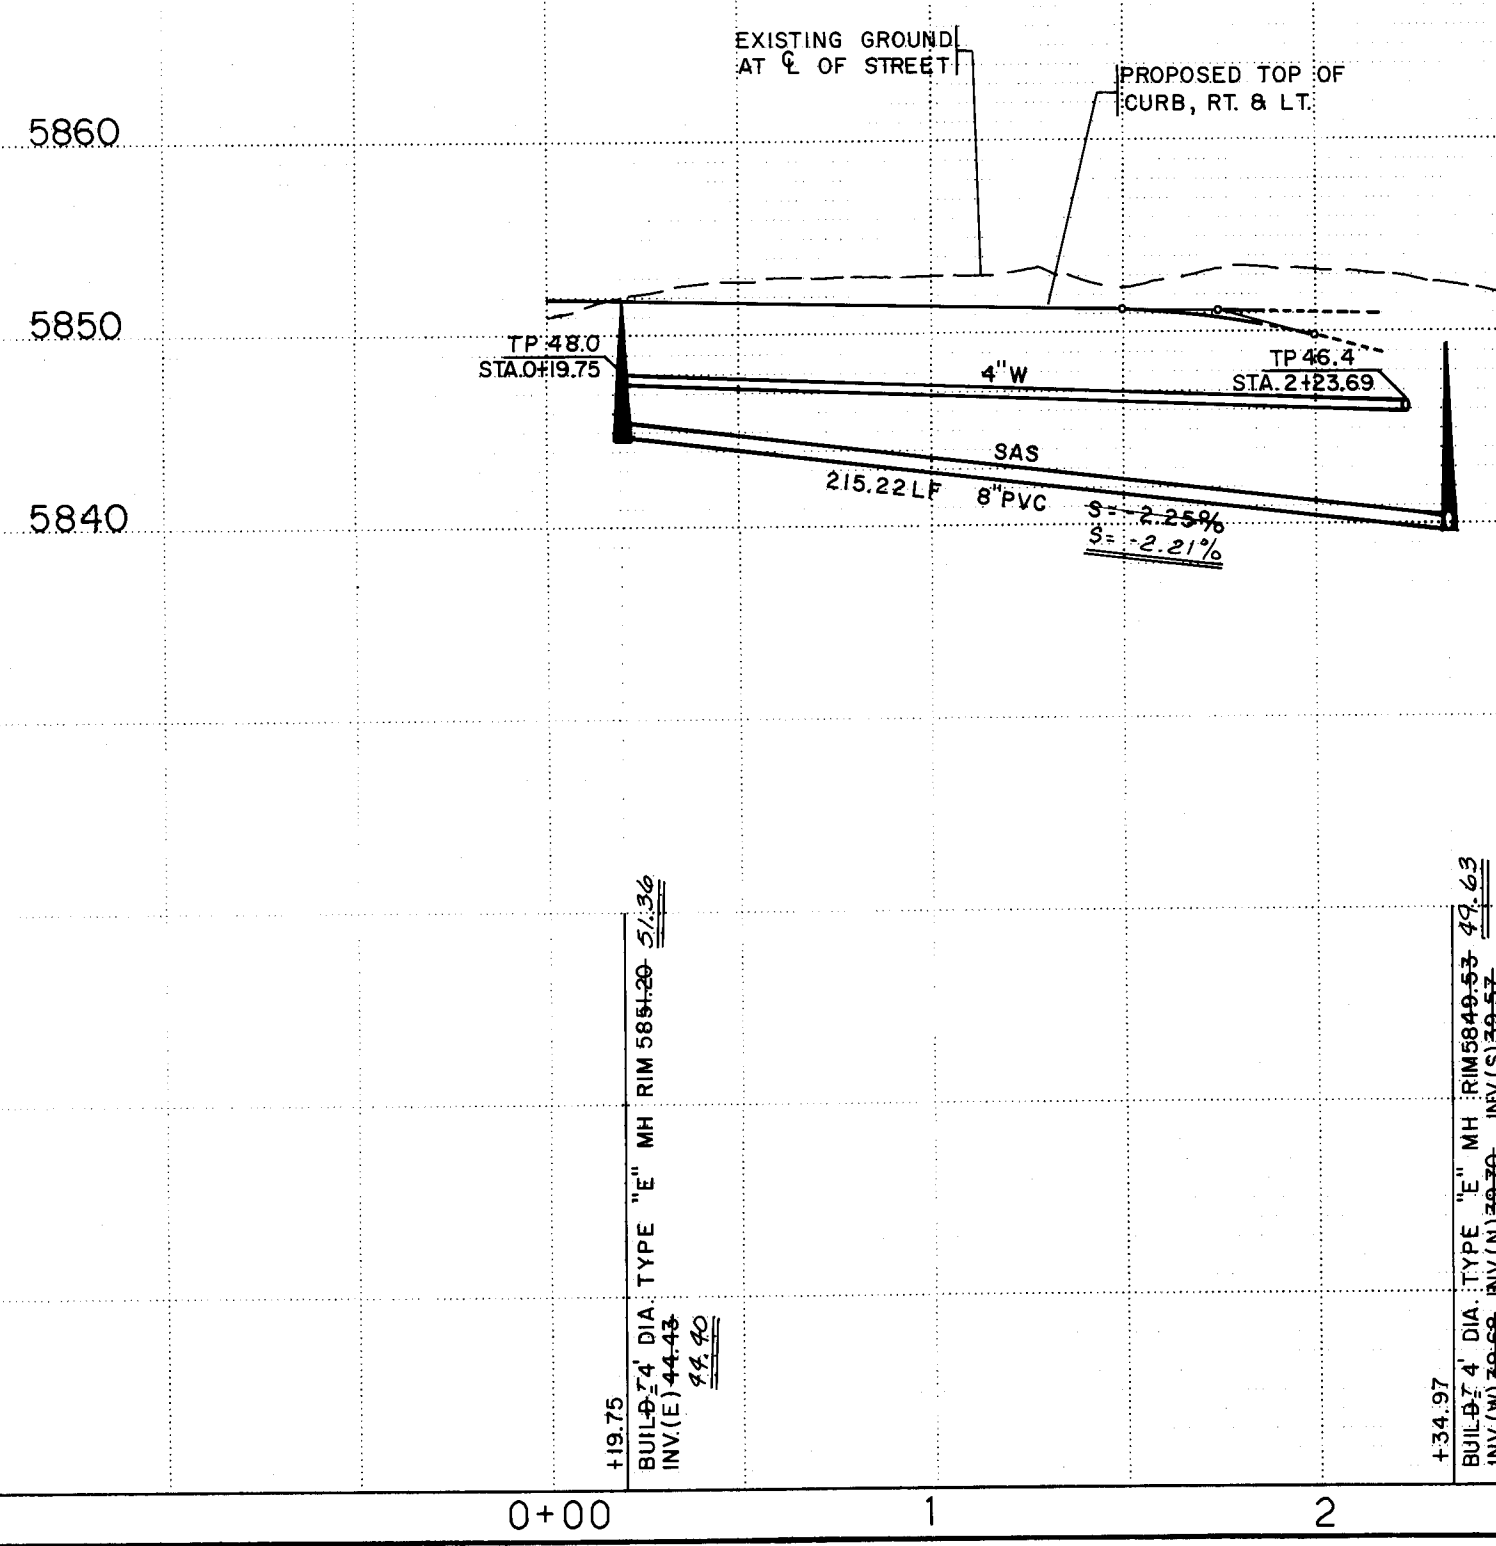

WATERLINE CURVE DATA


(A) PC STA.0+27.91
PT STA.2+18.44
 $\Delta = 40^\circ 55' 00''$
R = 265.00'
L = 189.24'
T = 98.86'

[illegible]



68.5' 33.86
37' 33.34
22.5' 33.13
Buried

54'	61.46
26'	60.69
25'	59.40
20'	

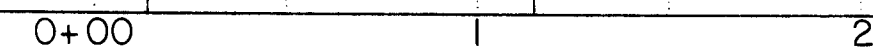

<i>SURVEY INFORMATION</i>		<i>BENCH MARKS</i>	<i>AS BUILT INFORMATION</i>	
NO.	FIELD NOTES		DATE	J.R. HALE
	BY	THE INTERSECTION OF ACADEMY ROAD, NE & EUBANK BLVD., NE THEN 375'± SOUTH. THE BENCH MARK IS ON THE SOUTH RIM OF THE BEAR CANYON TRIBUTARY & IS A STANDARD AGS BRASS TABLET STAMPED "6-E22 LS4972" ELEVATION 5934.53'	DATE 9/87	BHI
			DATE 2/88	282
			DATE 1/88	BHI
			DATE 1/88	BHI
			<i>MICRO-FILM INFORMATION</i>	
			RECORDED BY DATE	
			NO	

ENGINEER'S SEAL

6-17-87

JOSEPH L. BROWN

1000

1000

A circular professional engineer seal for William L. Krueger, No. 8131, State of New Mexico. The seal includes the text "WILLIAM L. KRUEGER", "NEW MEXICO", "8131", "REGISTERED PROFESSIONAL ENGINEER", and the date "2/3/88". A signature is written across the seal.

RECORD DRAWINGS
DATE JAN 7 1988



1	2	3	4	5	6	7	8	9	10	11	12
2	6		2	4	7	9	3	2	8	8	

	CITY OF ALBUQUERQUE PUBLIC WORKS ENGINEERING	
---	--	---

TITLE: DESERT CLASSIC AT TANOAN - PHASE I
UTILITY PLAN & PROFILE
WOODMAR/PINE TOP CUL-DE-SACS

APPROVALS	ENGINEER	DATE	APPROVALS	ENGINEER	DATE
City Engineer	<i>[Signature]</i>	7/6/87	Liquid Waste	<i>[Signature]</i>	6-24-87
ACE-Design	<i>[Signature]</i>	6-29-87	Traffic	NADWH	6/24/87
ACE-Hydrology	NA CAM	6-24-87	Water	<i>[Signature]</i>	6-24-87

BHI JOB N° 71263		DRAWING NO. 2479		MAP NO. E-22		SHEET 27 OF 29	
SCALE: 1" = 50' (HORIZ.) 1" = 10' (VERT.)							

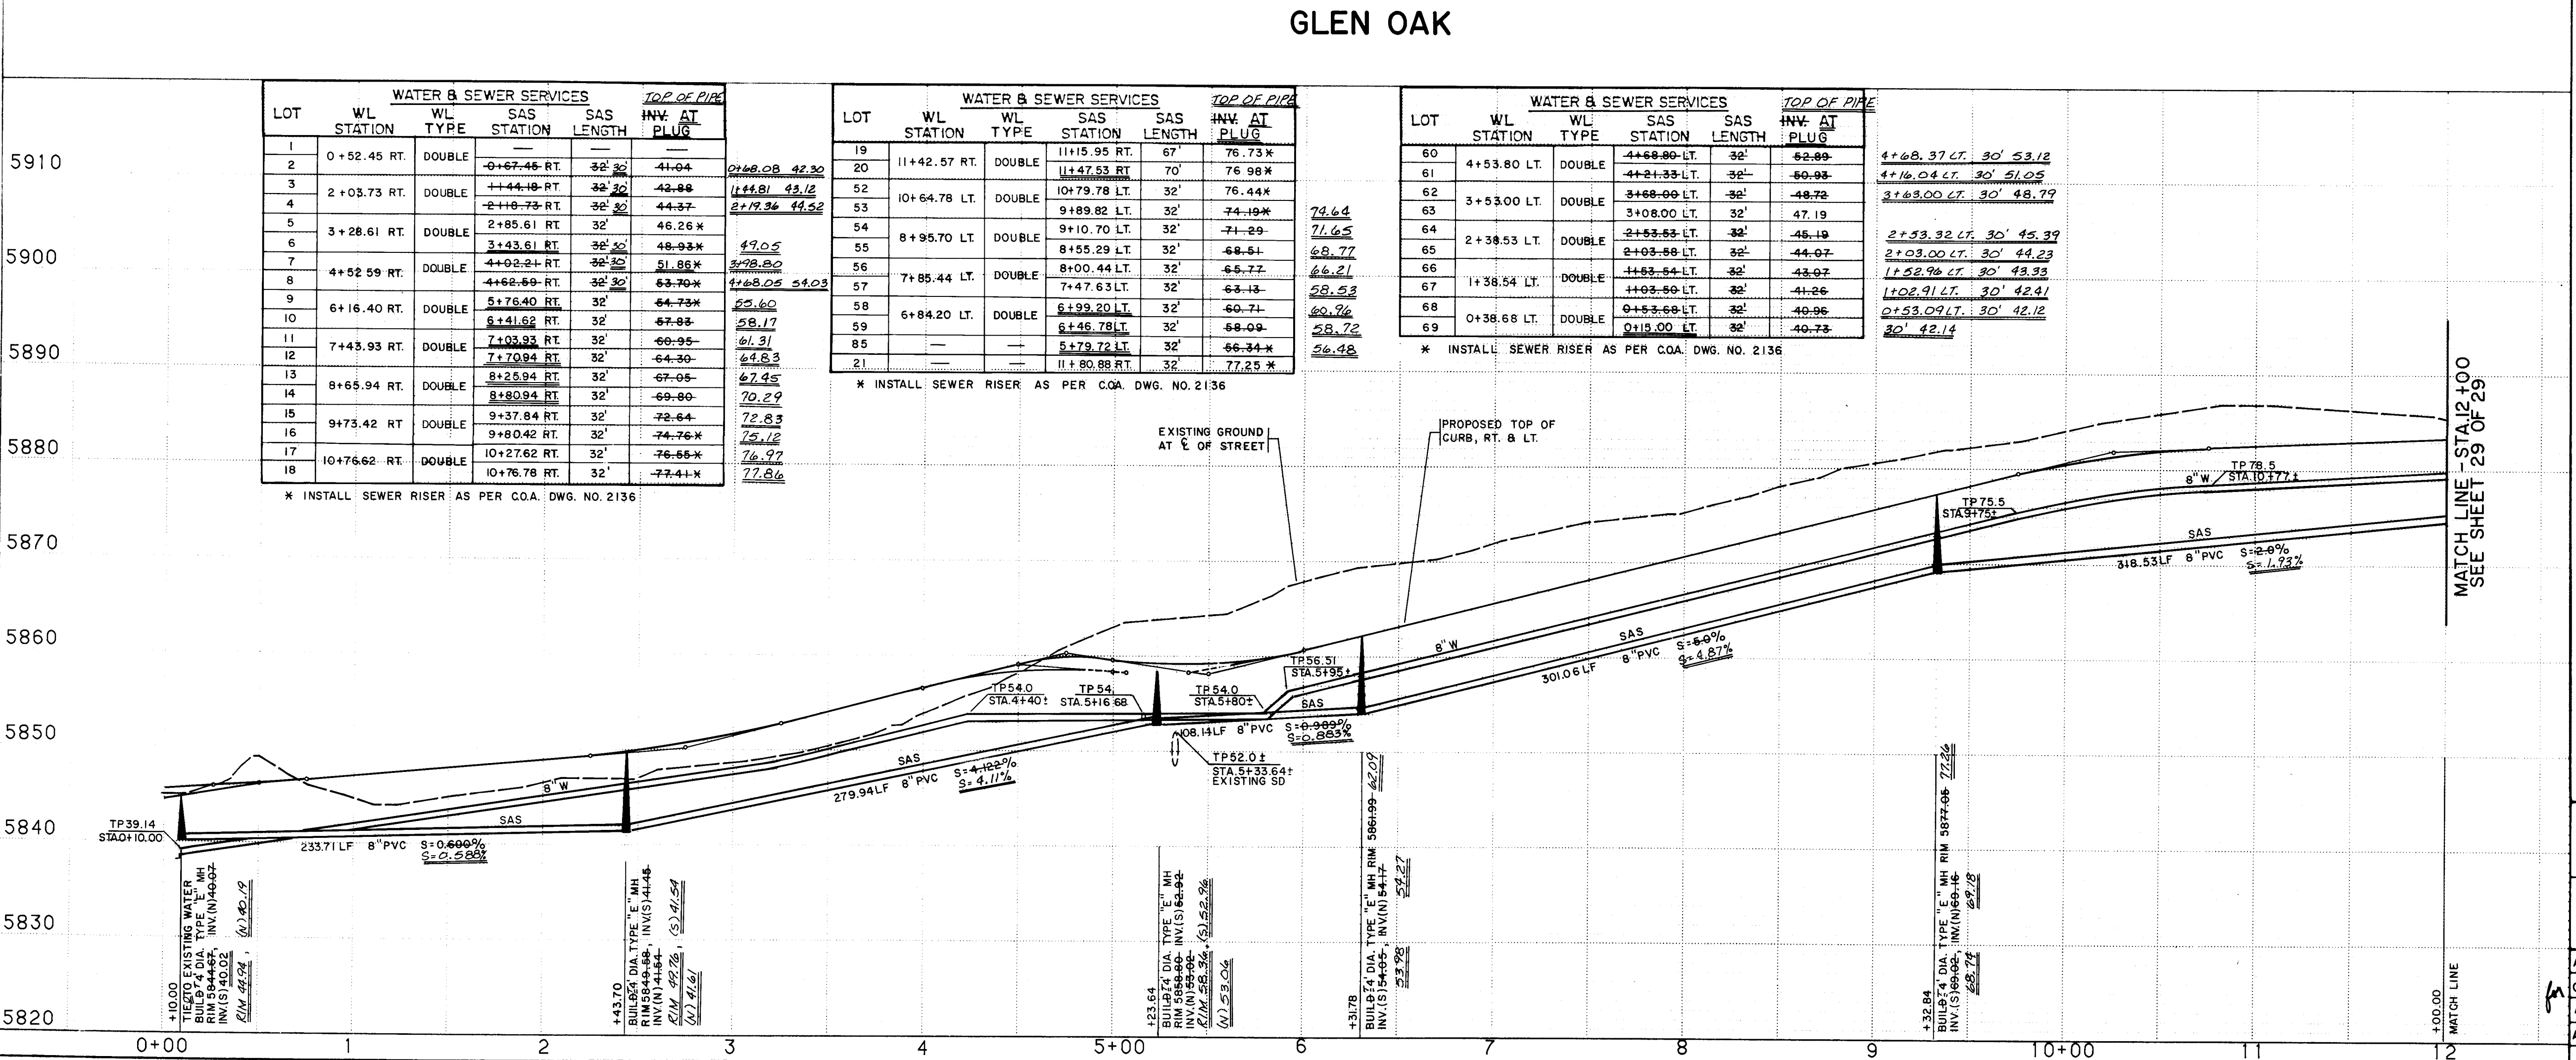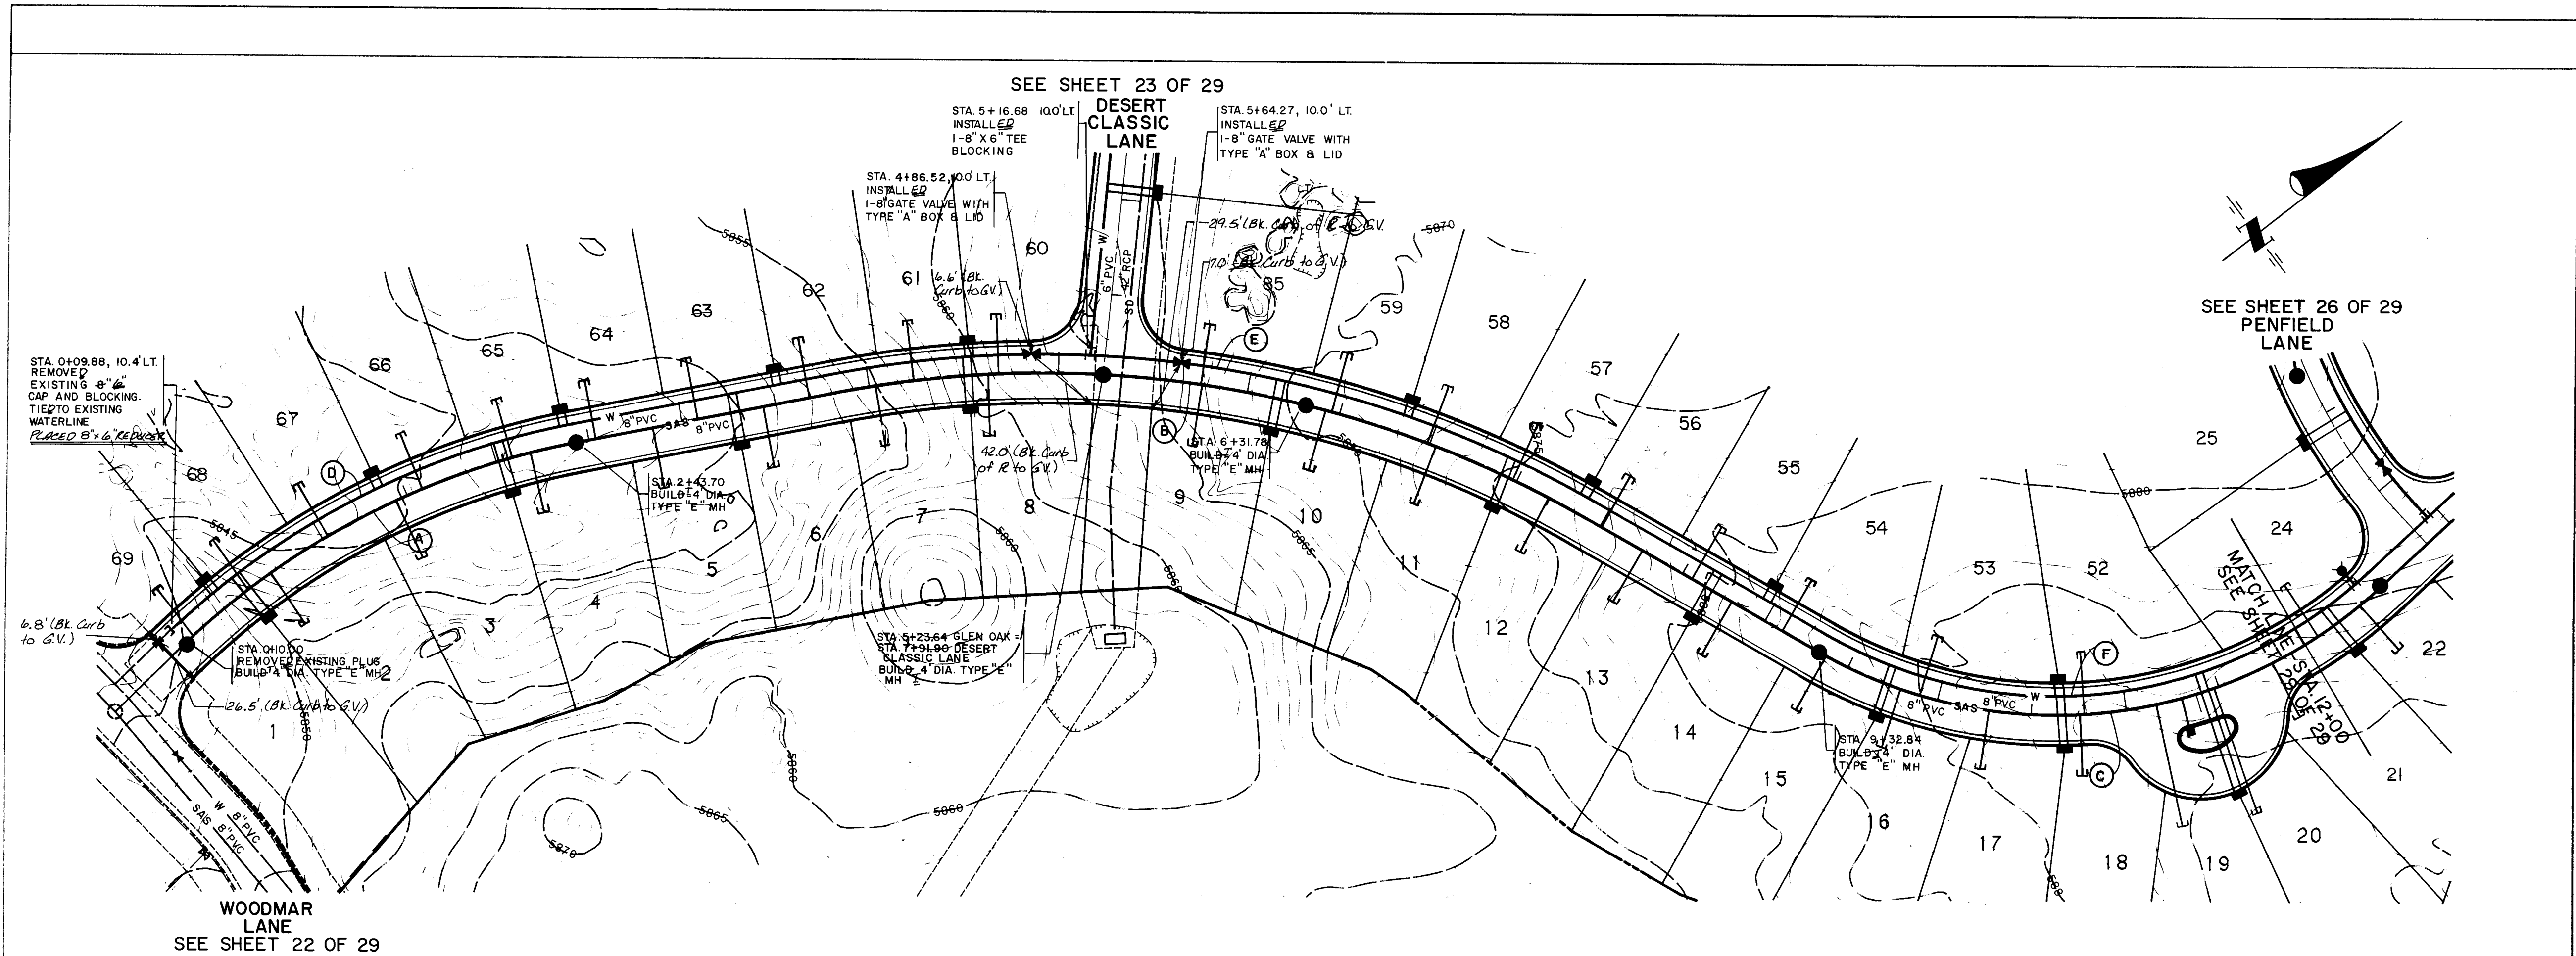

WATER & SEWER SERVICES					
LOT	WL STATION	WL TYPE	SAS STATION	SAS LENGTH	INV. AT PLUG
1	0+52.45 RT.	DOUBLE	0+57.45 RT.	32'	41.04
2	2+03.73 RT.	DOUBLE	1+44.18 RT.	32'	42.88
3	2+03.73 RT.	DOUBLE	2+10.73 RT.	32'	44.37
4	3+28.61 RT.	DOUBLE	2+85.61 RT.	32'	46.26
5	3+28.61 RT.	DOUBLE	3+43.61 RT.	32'	48.93
6	4+52.59 RT.	DOUBLE	4+02.21 RT.	32'	51.88
7	4+52.59 RT.	DOUBLE	4+68.59 RT.	32'	53.70
8	6+16.40 RT.	DOUBLE	5+76.40 RT.	32'	54.73
9	6+16.40 RT.	DOUBLE	6+41.62 RT.	32'	56.17
10	7+43.93 RT.	DOUBLE	7+03.93 RT.	32'	58.95
11	7+43.93 RT.	DOUBLE	7+70.94 RT.	32'	61.31
12	8+65.94 RT.	DOUBLE	8+25.94 RT.	32'	64.30
13	8+65.94 RT.	DOUBLE	8+80.94 RT.	32'	67.05
14	9+73.42 RT.	DOUBLE	9+37.84 RT.	32'	69.80
15	9+73.42 RT.	DOUBLE	9+80.42 RT.	32'	72.64
16	10+75.62 RT.	DOUBLE	10+27.62 RT.	32'	74.76
17	10+75.62 RT.	DOUBLE	10+76.78 RT.	32'	76.55
18			10+76.78 RT.	32'	77.41

WATER & SEWER SERVICES					
LOT	WL STATION	WL TYPE	SAS STATION	SAS LENGTH	INV. AT PLUG
19	11+42.57 RT.	DOUBLE	11+15.95 RT.	67'	76.73
20	11+42.57 RT.	DOUBLE	11+47.53 RT.	70'	76.98
52	10+64.78 LT.	DOUBLE	10+79.78 LT.	32'	76.44
53			9+89.82 LT.	32'	74.10
54			9+10.70 LT.	32'	71.89
55	8+95.70 LT.	DOUBLE	8+55.29 LT.	32'	68.61
56	7+85.44 LT.	DOUBLE	8+00.44 LT.	32'	65.77
57			7+47.63 LT.	32'	63.13
58	6+84.20 LT.	DOUBLE	6+99.20 LT.	32'	60.71
59			6+46.78 LT.	32'	58.09
60			5+79.72 LT.	32'	56.24
61			11+80.88 RT.	32'	77.25

WATER & SEWER SERVICES					
LOT	WL STATION	WL TYPE	SAS STATION	SAS LENGTH	INV. AT PLUG
60	4+53.80 LT.	DOUBLE	4+68.80 LT.	32'	52.89
61			4+21.33 LT.	32'	50.93
62			3+68.80 LT.	32'	48.72
63	3+53.00 LT.	DOUBLE	3+08.00 LT.	32'	47.19
64			2+53.83 LT.	32'	45.19
65	2+38.53 LT.	DOUBLE	2+03.88 LT.	32'	44.07
66			1+52.96 LT.	32'	43.93
67	1+38.54 LT.	DOUBLE	1+03.50 LT.	32'	41.86
68			0+53.68 LT.	32'	40.96
69	0+38.68 LT.	DOUBLE	0+18.00 LT.	32'	40.73

* INSTALL SEWER RISER AS PER COA. DWG. NO. 2136

NOTE
I. THE CONTRACTOR SHALL FIELD VERIFY ALL EXISTING UTILITY LOCATIONS AND NOTIFY THE ENGINEER IMMEDIATELY OF ANY DISCREPANCIES.


SANITARY SEWER CURVE DATA

- A PC STA. 0+10.00
PT STA. 2+43.70
Δ= 32° 44' 18"
R= 409.00'
L= 233.70'
T= 120.14'
- B PC STA. 3+83.43
PT STA. 7+90.47
Δ= 40° 42' 04"
R= 573.00'
L= 407.04'
T= 212.53'
- C PC STA. 9+32.84
PT STA. 12+51.37
Δ= 73° 00' 00"
R= 250.00'
L= 318.53'
T= 184.99'


WATERLINE CURVE DATA

- D PC STA. 0+09.88
PT STA. 2+43.71
Δ= 32° 45' 20"
R= 419.00'
L= 239.54'
T= 123.14'
- E PC STA. 3+83.43
PT STA. 7+90.47
Δ= 40° 42' 04"
R= 583.00'
L= 414.15'
T= 216.24'
- F PC STA. 9+32.84
PT STA. 12+51.37
Δ= 73° 00' 00"
R= 240.00'
L= 305.78'
T= 177.59'

RECORD DRAWINGS
DATE 11/13/98

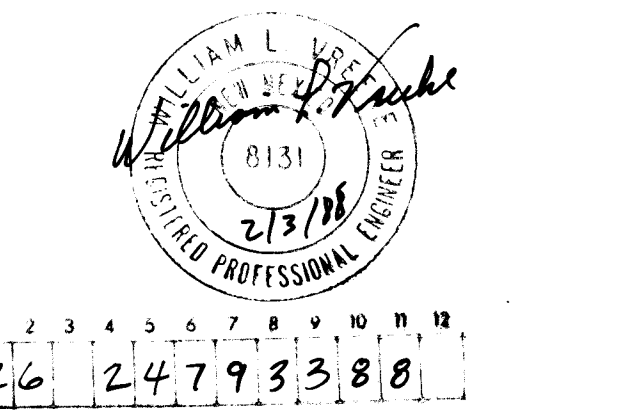

CITY OF ALBUQUERQUE PUBLIC WORKS ENGINEERING			
TITLE: DESERT CLASSIC AT TANOAN - PHASE I UTILITY PLAN & PROFILE GLEN OAK - STA. 0+00 TO STA. 12+00			
APPROVALS	ENGINEER	DATE	APPROVALS
City Engineer	<i>[Signature]</i>	7/2/97	Liquid Waste
ACE - Design	<i>[Signature]</i>	6-24-97	Traffic
ACE - Hydrology	<i>[Signature]</i>	6-24-97	Water
DESIGNED BY		MLJ/AMT	DATE
DRAWN BY		TG/TL	DATE
CHECKED BY		KLD	DATE
REVISIONS			
NO.	DATE		
26	2/4/93		
27	7/2/97		
28	6-24-97		
29	6-24-97		
DRAWING NO.		2479	MAP NO.
		E-22	SHEET
		28	OF
		29	

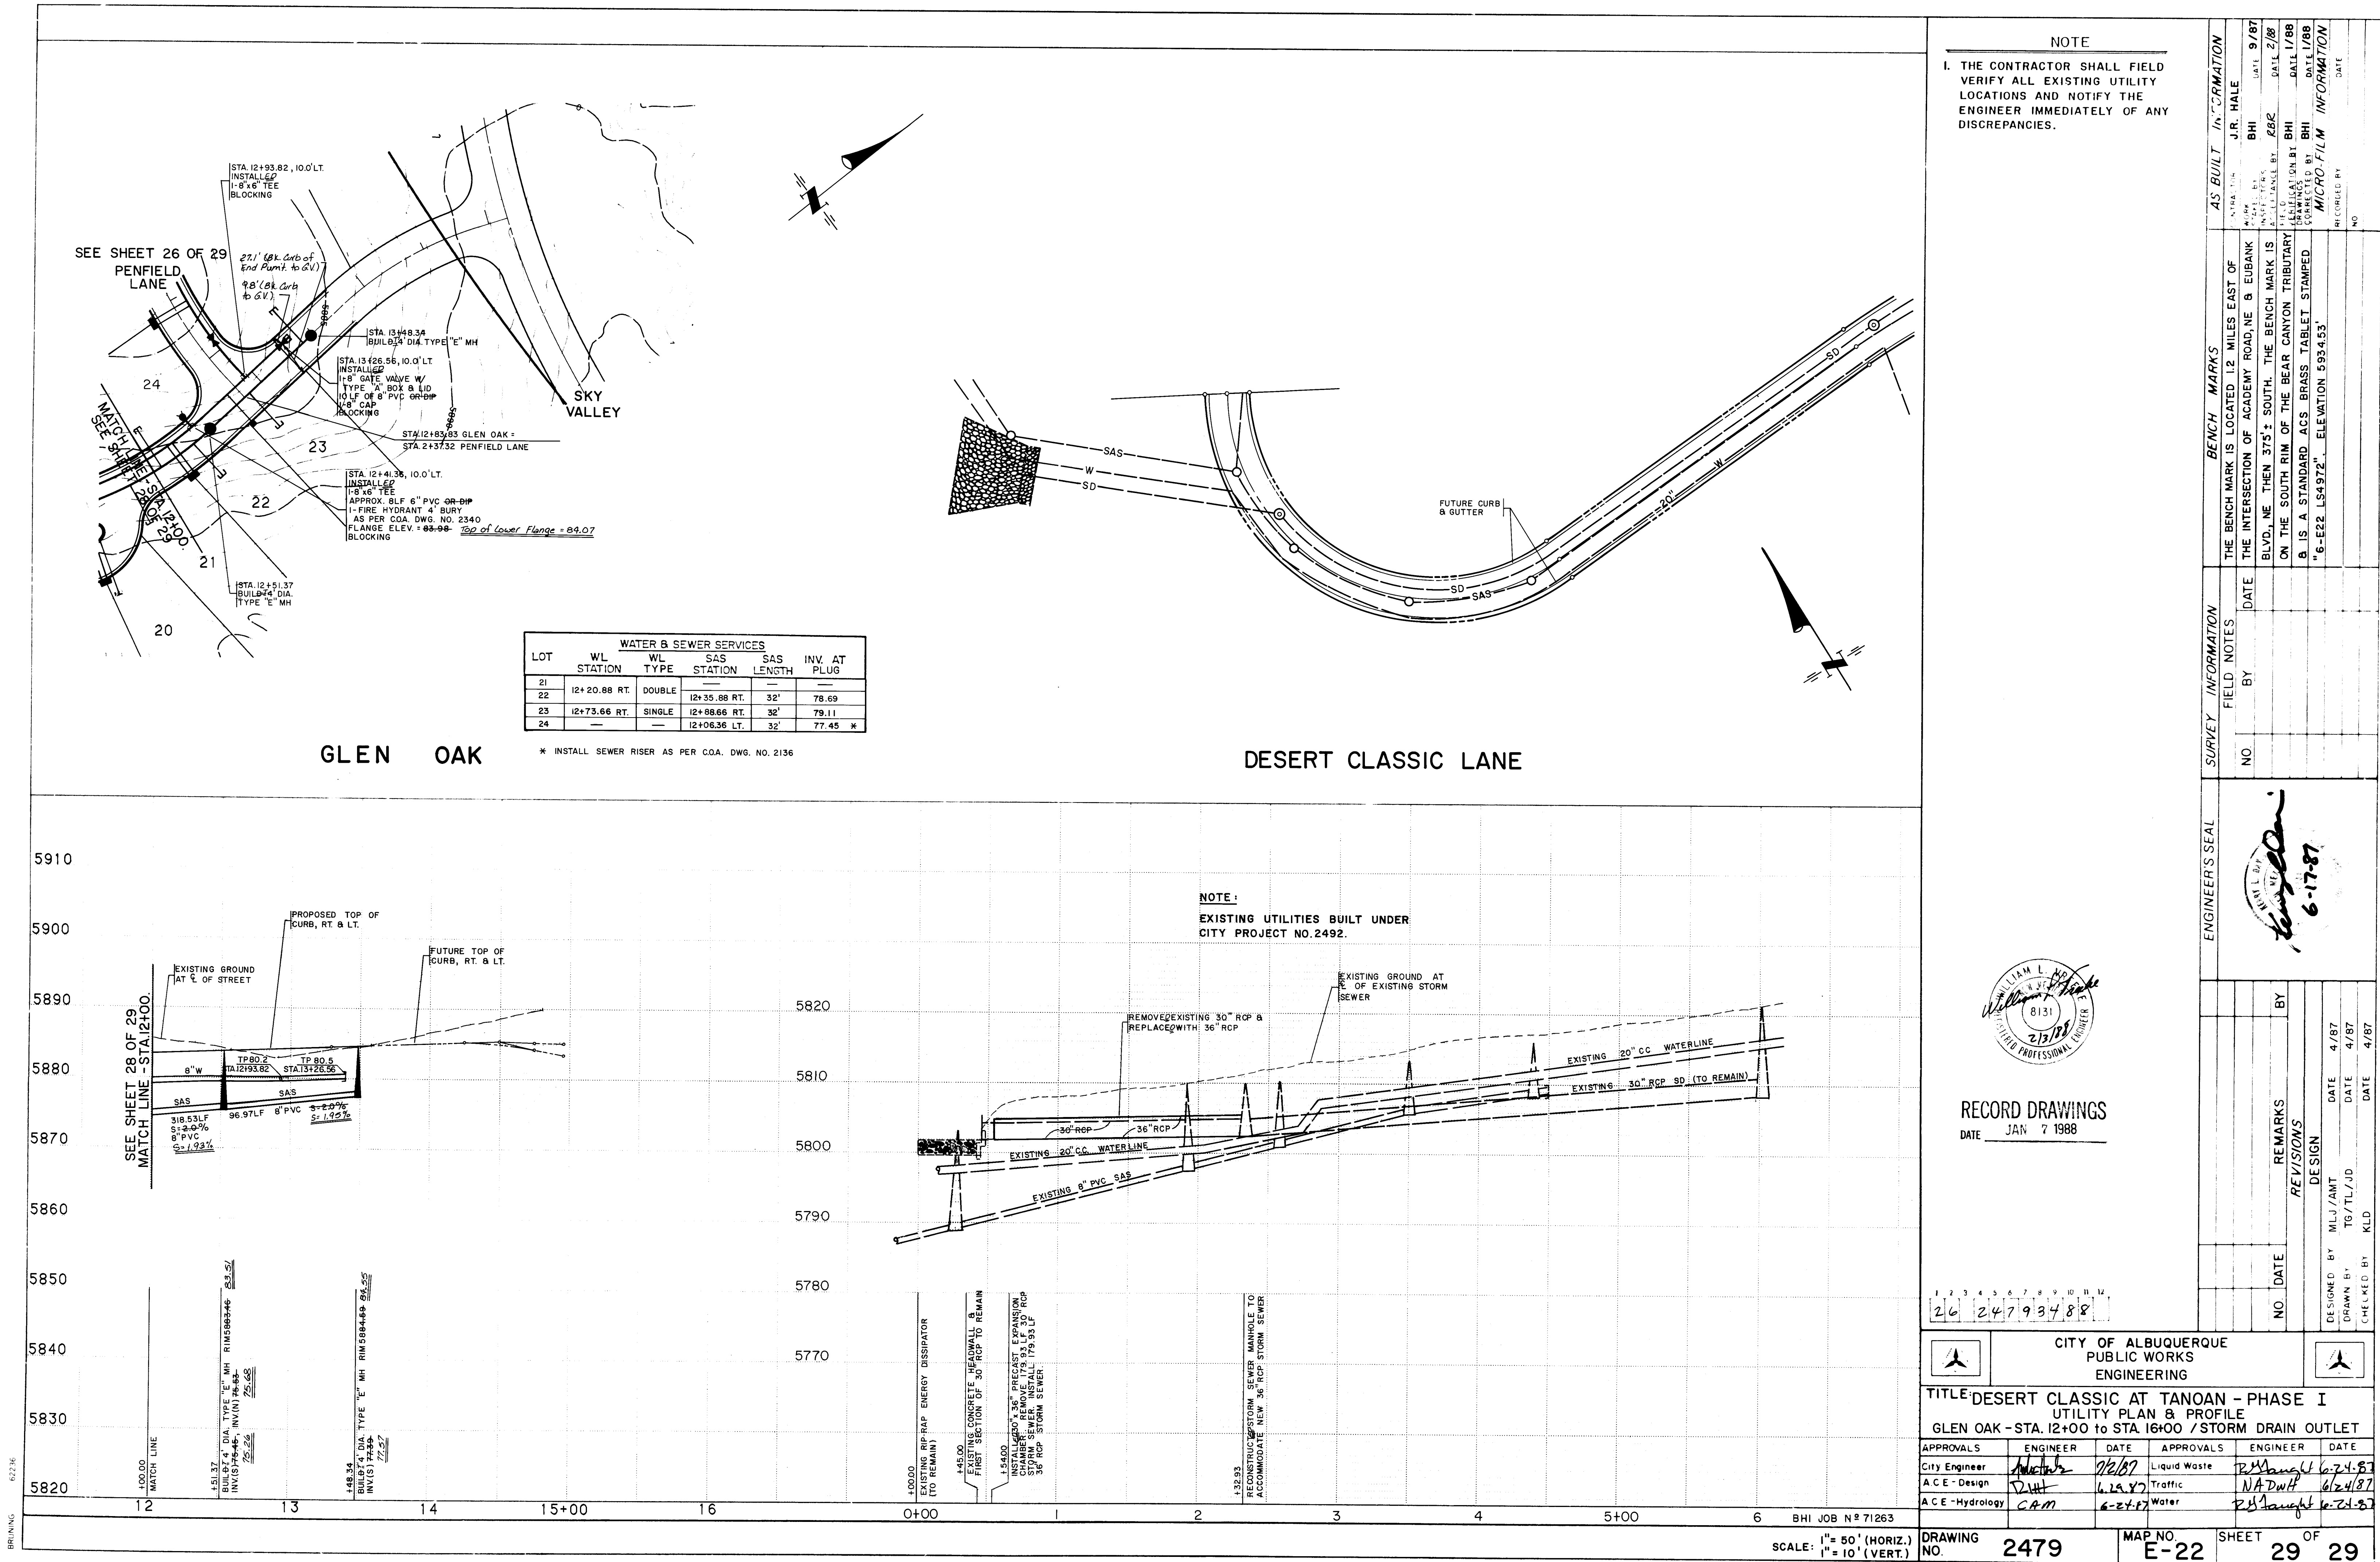

NOTE
I. THE CONTRACTOR SHALL FIELD VERIFY ALL EXISTING UTILITY LOCATIONS AND NOTIFY THE ENGINEER IMMEDIATELY OF ANY DISCREPANCIES.

WATER & SEWER SERVICES					
LOT	WL STATION	WL TYPE	SAS STATION	SAS LENGTH	INV. AT PLUG
21	12+20.88 RT.	DOUBLE	12+35.88 RT.	32'	78.69
22	12+73.66 RT.	SINGLE	12+86.66 RT.	32'	79.11
23	—	—	12+06.36 LT.	32'	77.45 *

* INSTALL SEWER RISER AS PER C.O.A. DWG. NO. 2136

AS BUILT INFORMATION		BENCH MARKS		SURVEY INFORMATION		ENGINEER'S SEAL	
DATE	BY	THE BENCH MARK IS LOCATED 1.2 MILES EAST OF THE INTERSECTION OF ACADEMY ROAD, NE & EUBANK BLVD., NE THEN 375' S. SOUTH. THE BENCH MARK IS ON THE SOUTH RIM OF THE BEAR CANYON TRIBUTARY & IS A STANDARD ACS BRASS TABLET STAMPED "6-E22 LS4972" ELEVATION 5934.53'	DATE	BY	NO.	REMARKS	BY
DATE	BY		DATE	BY		DESIGNED BY	DATE
DATE	BY		DATE	BY		DRAWN BY	DATE
DATE	BY		DATE	BY		CHECKED BY	DATE

CITY OF ALBUQUERQUE PUBLIC WORKS ENGINEERING					
TITLE: DESERT CLASSIC AT TANOAN - PHASE I UTILITY PLAN & PROFILE GLEN OAK - STA. 12+00 TO STA. 16+00 / STORM DRAIN OUTLET					
APPROVALS	ENGINEER	DATE	APPROVALS	ENGINEER	DATE
City Engineer	<i>[Signature]</i>	7/2/87	Liquid Waste	<i>[Signature]</i>	6-24-87
A.C.E. - Design	<i>[Signature]</i>	6-24-87	Traffic	<i>[Signature]</i>	6-24-87
A.C.E. - Hydrology	<i>[Signature]</i>	6-24-87	Water	<i>[Signature]</i>	6-24-87
DRAWING NO.	2479	MAP NO.	E-22	SHEET	29 OF 29