

CITY OF ALBUQUERQUE
CONSTRUCTION PLANS
FOR
AMOLE DEL NORTE
STORM DIVERSION FACILITY



PHASE I :

AMOLE DETENTION BASIN TO N. SIDE BLAKE ROAD

STA. - 1+04.00 TO STA. 38+52.00

INDEX


SHEET No.	
1	TITLE SHEET & GENERAL NOTES
2	LOCATION MAP & LEGEND
3	CHANNEL P&P STA. -1+04.00 TO STA. 15+00.00
4	CHANNEL P&P STA. 15+00.00 TO STA. 38+00.00
5	SPOIL AREA GRADING, CHANNEL STA. 38+00.00 TO STA. 50+00.00
6	TYPICAL CHANNEL SECTIONS
7	TYPICAL CHANNEL DETAILS
8	TYPICAL CHANNEL DETAILS
9	TYPICAL PAVING SECTION
10	ENERGY DISSIPATOR DETAILS

INDEX

SHEET No.	TITLE
11	BLAKE ROAD PLAN & PROFILE
12	BLAKE ROAD CROSSING STRUCTURE
13	BLAKE ROAD TRAFFIC CONTROL PLAN
14	UTILITY PROFILES AND SECTIONS
15	SEWER RELOCATION PLAN & PROFILE
16	CHANNEL CROSS SECTIONS STA. 0+12.00 TO STA. 5+00.00
17	CHANNEL CROSS SECTIONS STA. 6+00.00 TO STA. 13+00.00
18	CHANNEL CROSS SECTIONS STA. 14+00.00 TO STA. 27+00.00
19	CHANNEL CROSS SECTIONS STA. 28+00.00 TO STA. 38+25.00
20	BLAKE ROAD CROSS SECTIONS
21	STRUCTURAL EXCAVATION CROSS SECTIONS

Russell Rodriguez
4-27-87

RECORD DRAWING
These record drawings apply only to those facilities constructed under the contract identified in the title block and shall not be used for any other project. In part, on the basis of information compiled and furnished by others, Boyle Engineering Corporation will not be responsible for any errors or omissions which have been incorporated into this drawing as a result of the work by others.

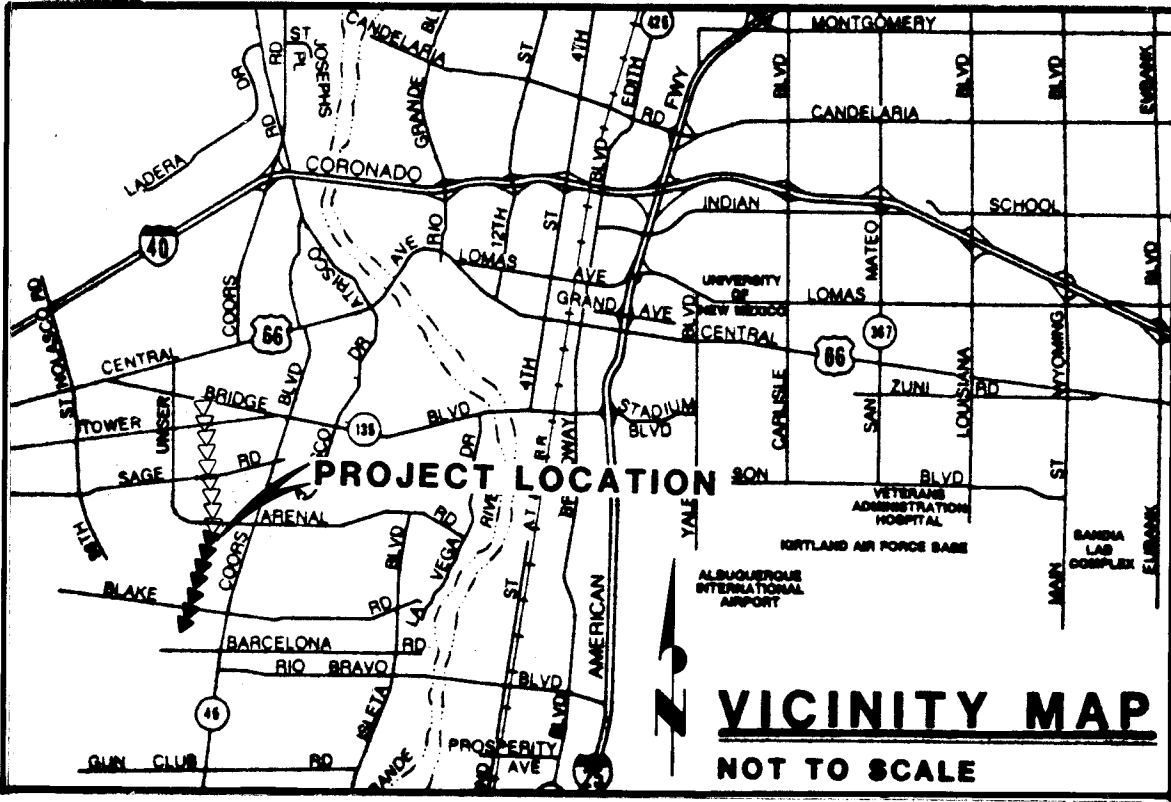



- GENERAL NOTES:
1. TOPOGRAPHIC ORTHOPHOTO MAPS USED IN THE CONSTRUCTION PLANS WERE DEVELOPED FROM AERIAL PHOTOGRAPHS TAKEN ON MAY 5, 1979.
 2. TWO WORKING DAYS PRIOR TO ANY EXCAVATION, CONTRACTOR MUST CONTACT LINE LOCATION SERVICE, 765-1234, FOR LOCATION OF EXISTING UTILITIES.
 3. PRIOR TO CONSTRUCTION, THE CONTRACTOR SHALL EXCAVATE AND VERIFY THE HORIZONTAL AND VERTICAL LOCATIONS OF ALL OBSTRUCTIONS. SHOULD A CONFLICT EXIST, THE CONTRACTOR SHALL NOTIFY THE ENGINEER OR SURVEYOR SO THAT THE CONFLICT CAN BE RESOLVED WITH A MINIMUM AMOUNT OF DELAY.
 4. NO CONSTRUCTION WILL BE ALLOWED WITHIN THE AMAFCA RIGHT OF WAY AT THE AMOLE DETENTION BASIN FROM MAY 15 TO OCTOBER 15. NO PORTION OF THE CONSTRUCTION WITHIN THIS AREA MAY BE LEFT UNCOMPLETED DURING THIS PERIOD. NOTIFY AMAFCA FIELD ENGINEER (884-2215) ONE WEEK BEFORE STARTING WORK IN AMAFCA RIGHT-OF-WAY.
 5. RIGHT OF WAY MAPS ARE AVAILABLE FROM THE ENGINEER FOR THE CONTRACTOR'S USE DURING CONSTRUCTION. CONTRACTOR SHALL NOT ENTER PRIVATE PROPERTY WITHOUT WRITTEN VERIFIABLE PERMISSION FROM THE OWNER.
 6. ALL WORK DETAILED ON THESE PLANS TO BE PERFORMED UNDER CONTRACT SHALL, EXCEPT AS OTHERWISE STATED OR PROVIDED FOR HEREON, BE CONSTRUCTED IN ACCORDANCE WITH THE CITY OF ALBUQUERQUE INTERIM STANDARD SPECIFICATIONS FOR PUBLIC WORKS CONSTRUCTION, 1985 (REFERENCE TO HEREIN AS THE "STANDARD SPECIFICATIONS").
 7. CONTRACTOR SHALL NOTIFY THE CITY TRAFFIC ENGINEER (768-2780) THREE (3) WORKING DAYS PRIOR TO THE OPENING OF ANY DETOUR.

- THE FOLLOWING NOTES ALSO APPLY WHEN CHECKED
- ☒ ALL UTILITIES AND UTILITY SERVICE LINES SHALL BE INSTALLED PRIOR TO PAVING.
 - ☒ BACKFILL COMPACTION SHALL BE ACCORDING TO SPECIFIED STREET USE.
 - ☒ TACK COAT REQUIREMENTS SHALL BE DETERMINED BY THE CITY ENGINEER.
 - ☐ SIDEWALKS AND WHEELCHAIR RAMPS WITHIN THE CURB RETURNS SHALL BE CONSTRUCTED WHEREVER A NEW CURB RETURN IS CONSTRUCTED.
 - ☐ IF CURB IS DEPRESSED FOR A DRIVEPAD, THE DRIVEPAD SHALL BE CONSTRUCTED PRIOR TO ACCEPTANCE OF CURB AND GUTTER.
 - ☒ ALL STORM DRAINAGE FACILITIES SHALL BE COMPLETED PRIOR TO FINAL ACCEPTANCE.
 - ☐ THE REQUESTOR OR DEVELOPER SHALL BE RESPONSIBLE FOR REPAIR OR REPLACEMENT OF ALL CURB AND GUTTER OR SIDEWALK DAMAGED AFTER APPROVAL BY THE CITY ENGINEER OF WORK COMPLETED BY THE CONTRACTOR.



26 24800187

REV	SHEETS	CITY ENGINEER	DATE	USER DEPT	DATE	USER DEPT	DATE
APPROVAL OF REVISIONS							

		APPROVED FOR CONSTRUCTION CITY ENGINEER <i>[Signature]</i> DATE <i>[Date]</i>
PROJECT NUMBER: 2480		PLAN SET No. SHEET 1 OF 2

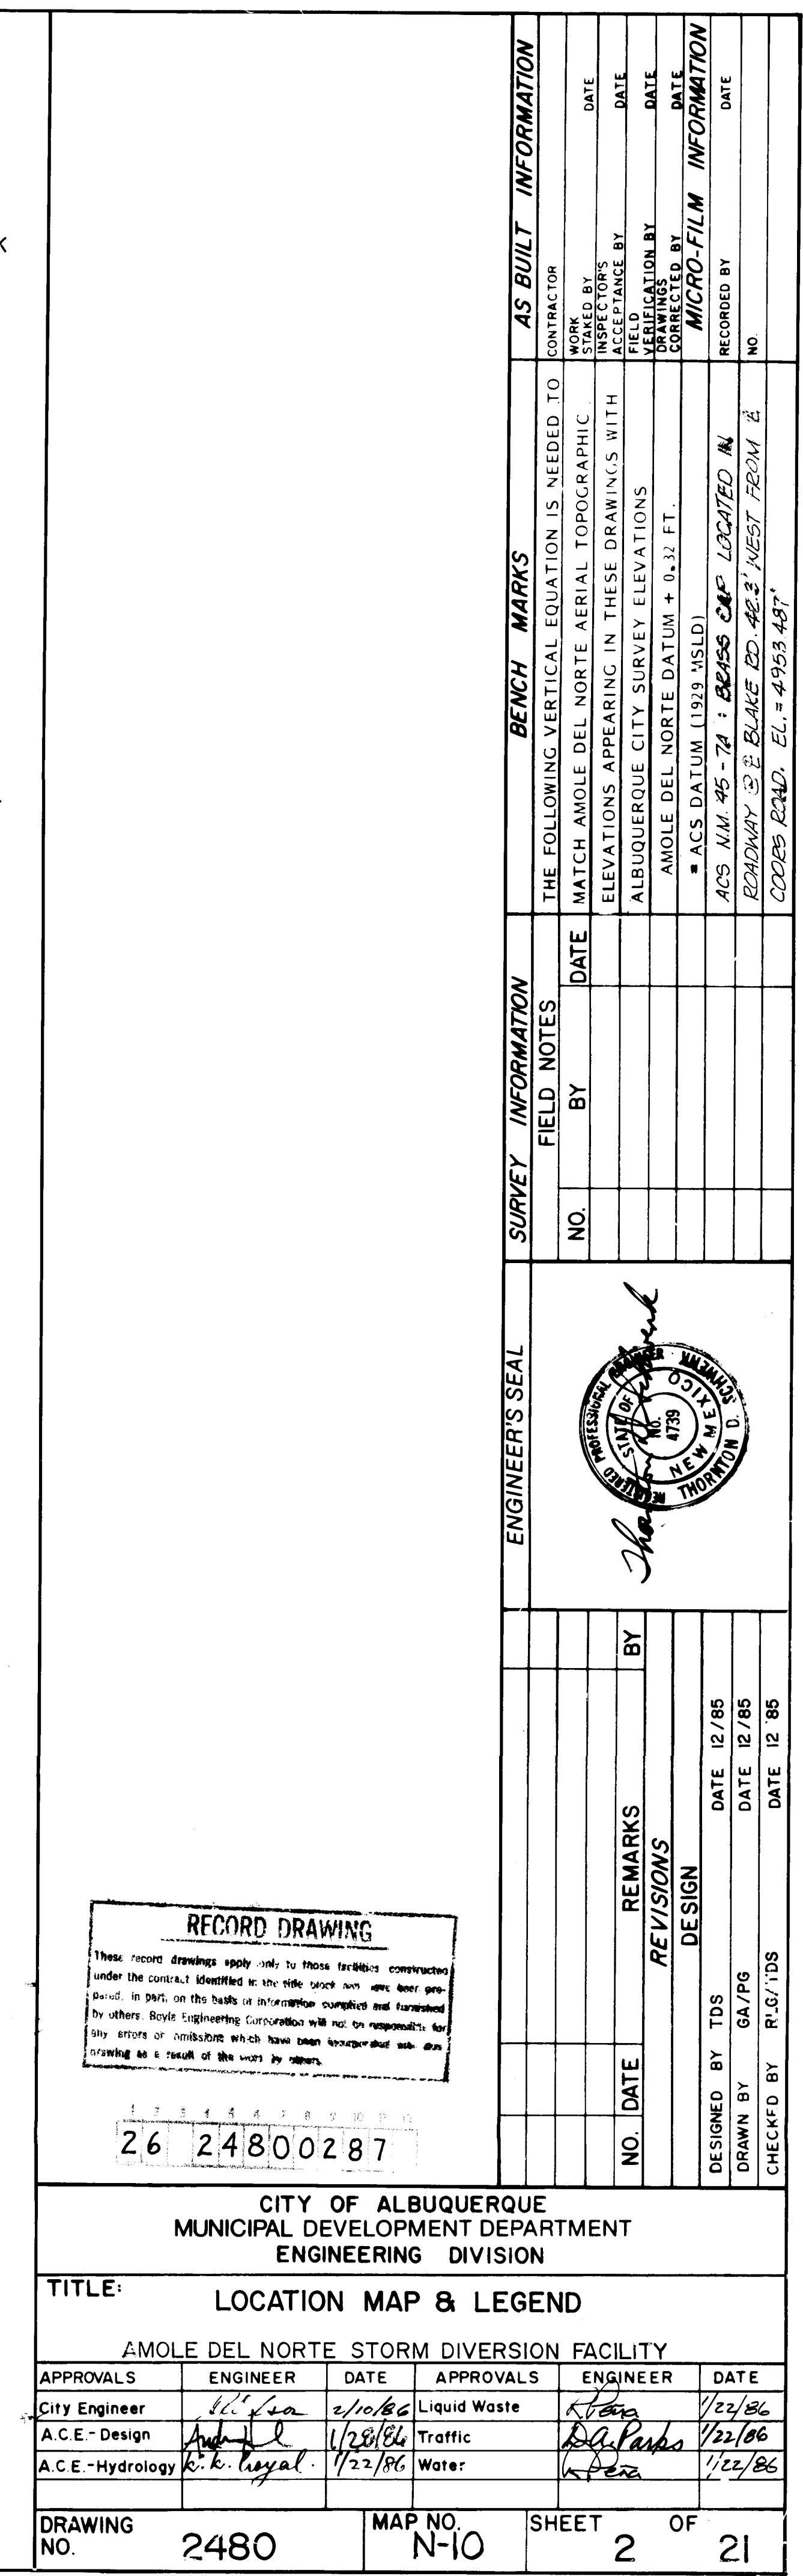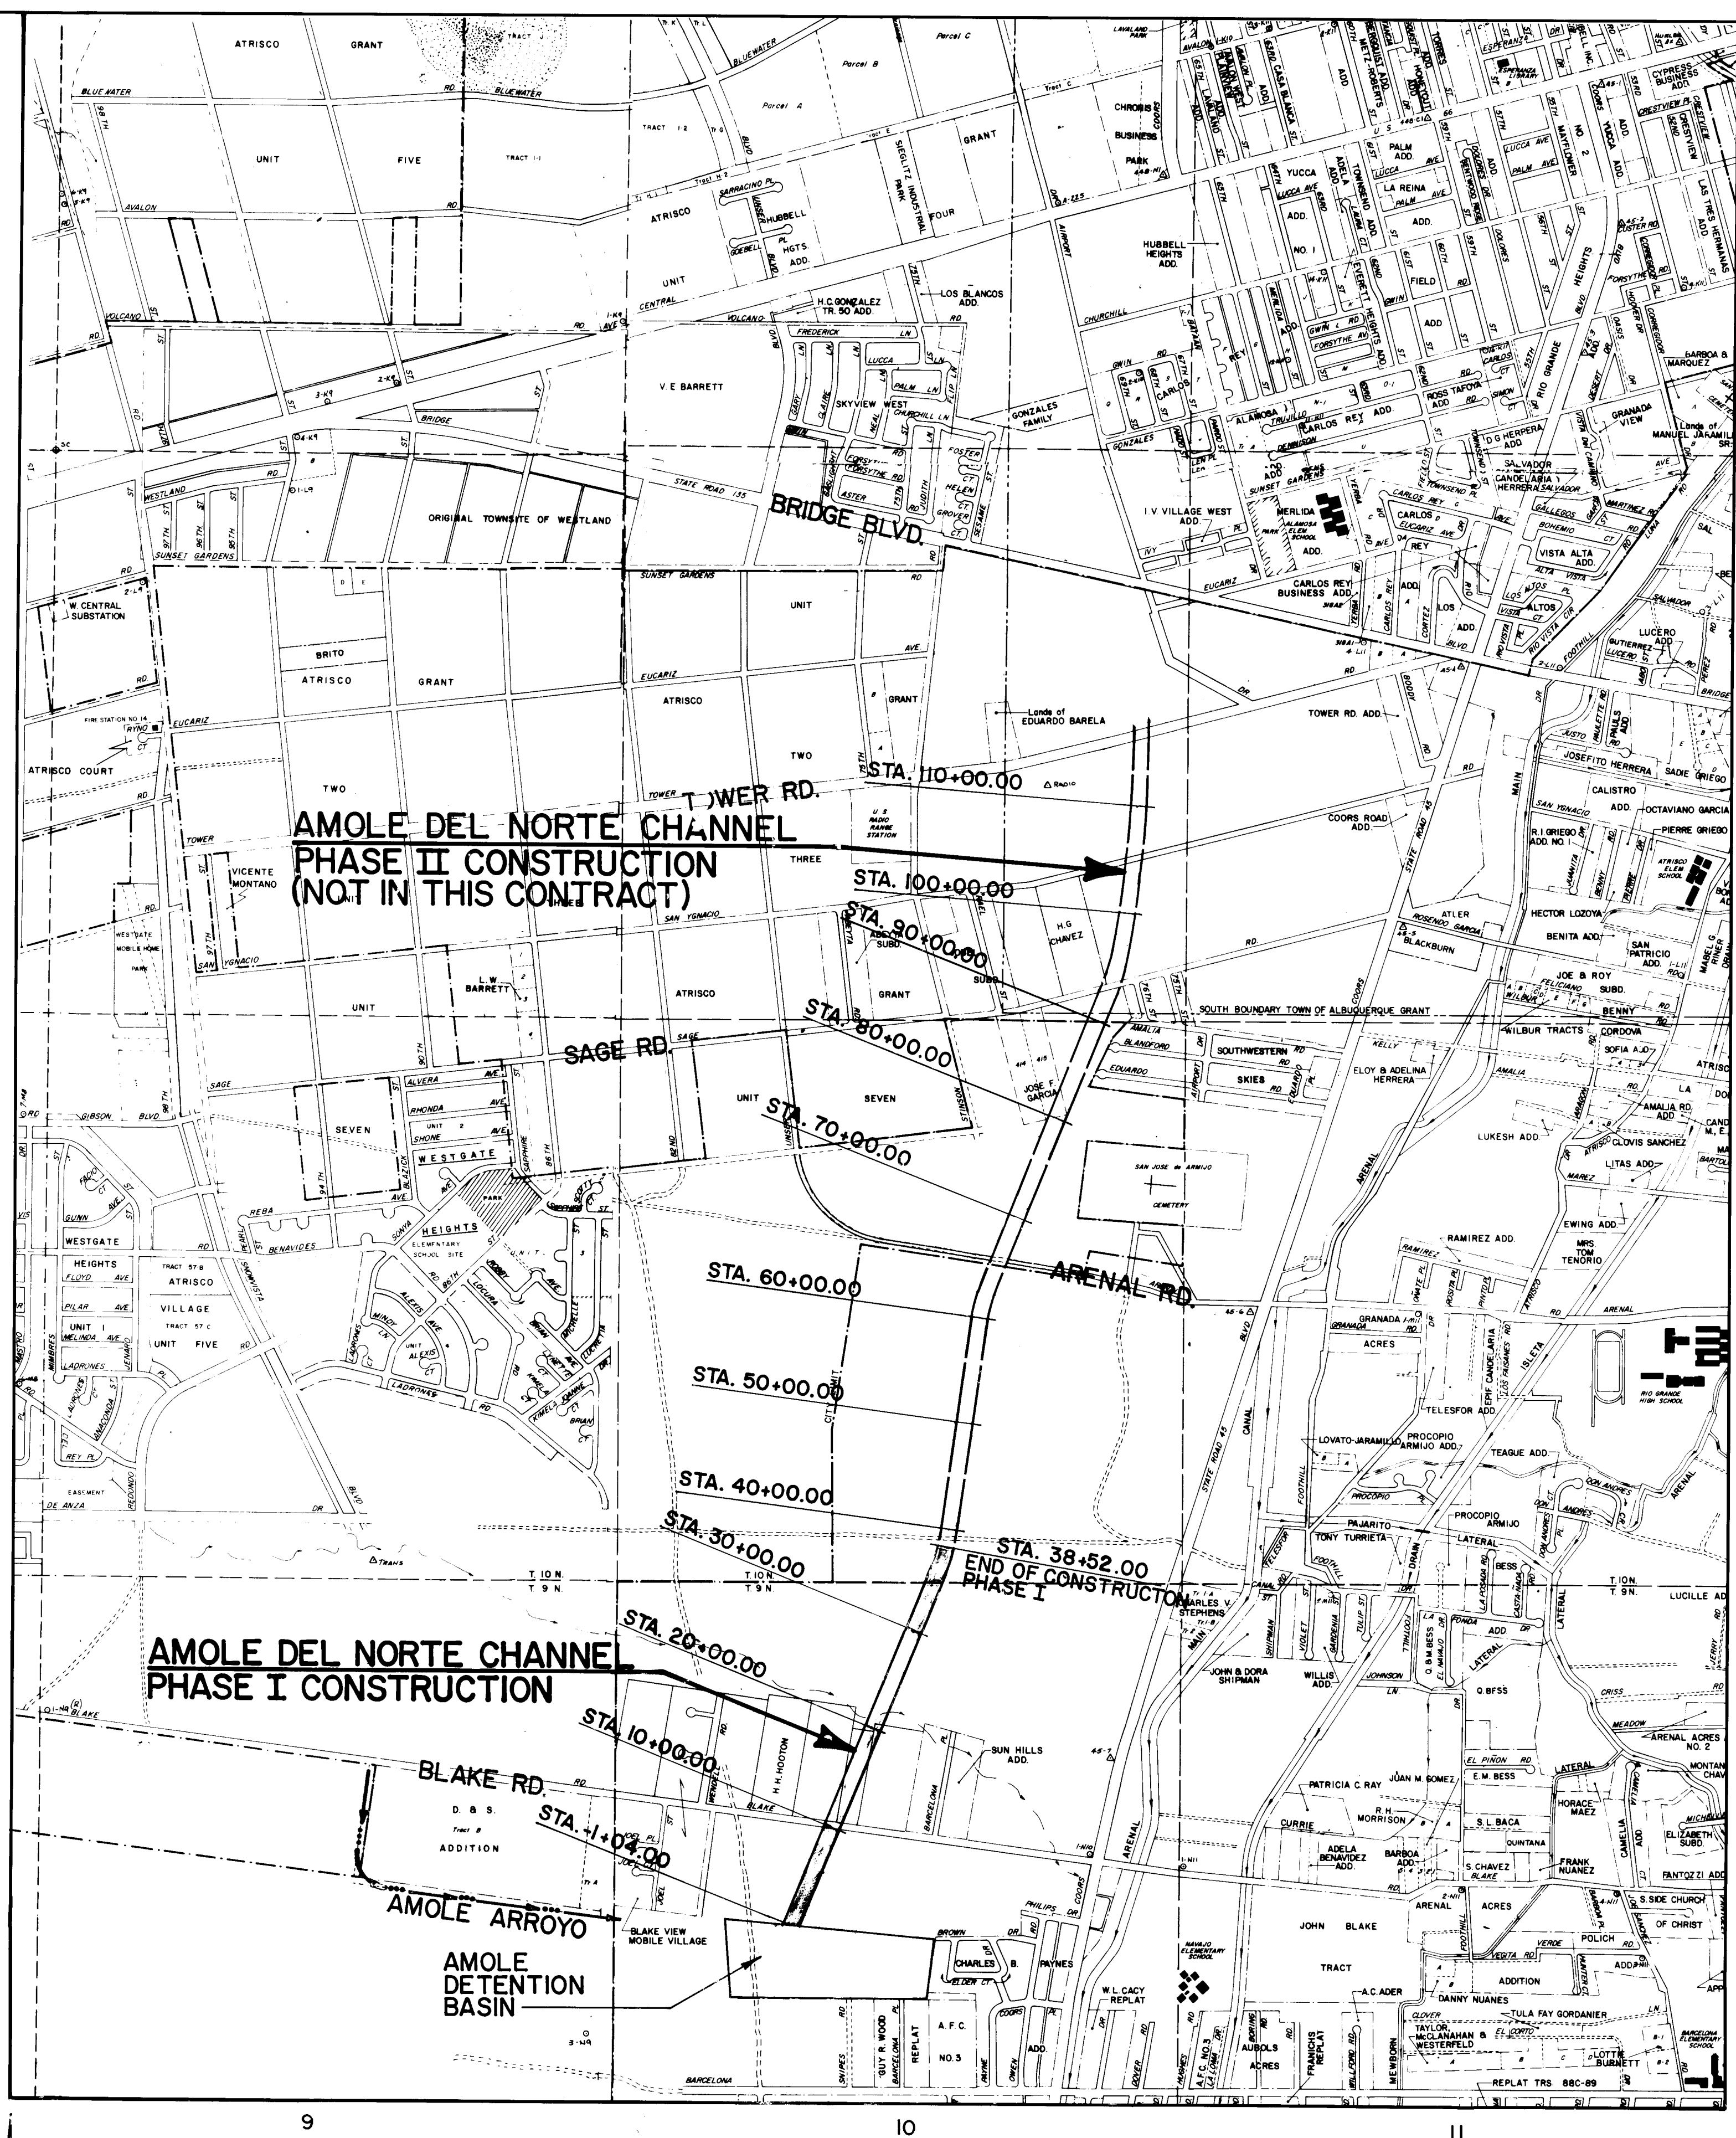

COA BEASS CAP "TRANS 1969"
NMSPGS (CENTRAL ZONE)
X=354,879.4500
Y=1,471,822.6700
Δα = -13° 10' 42"
GROUND TO GRID FACTOR = 0.99967921

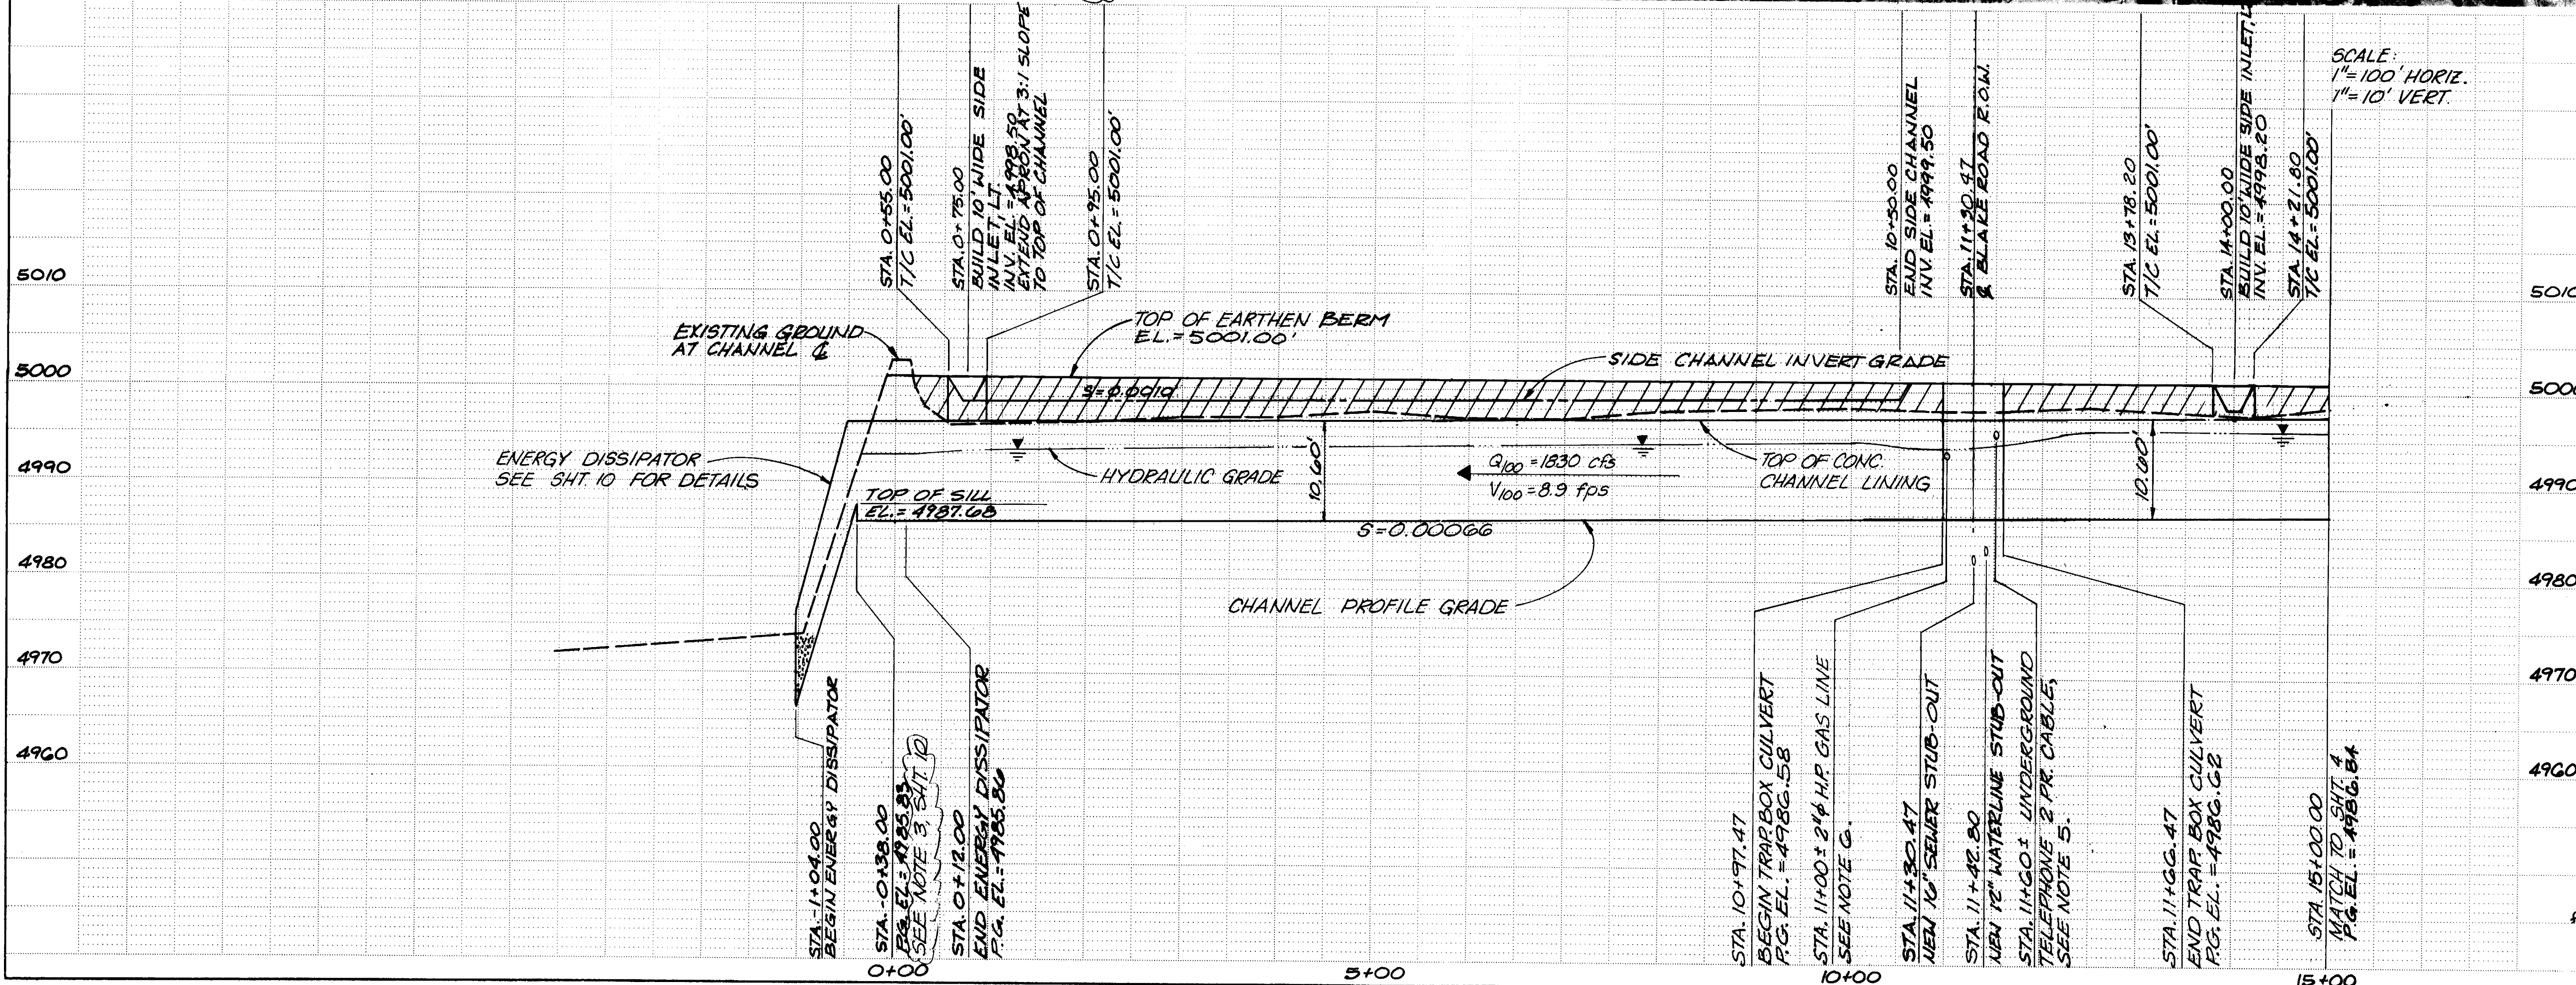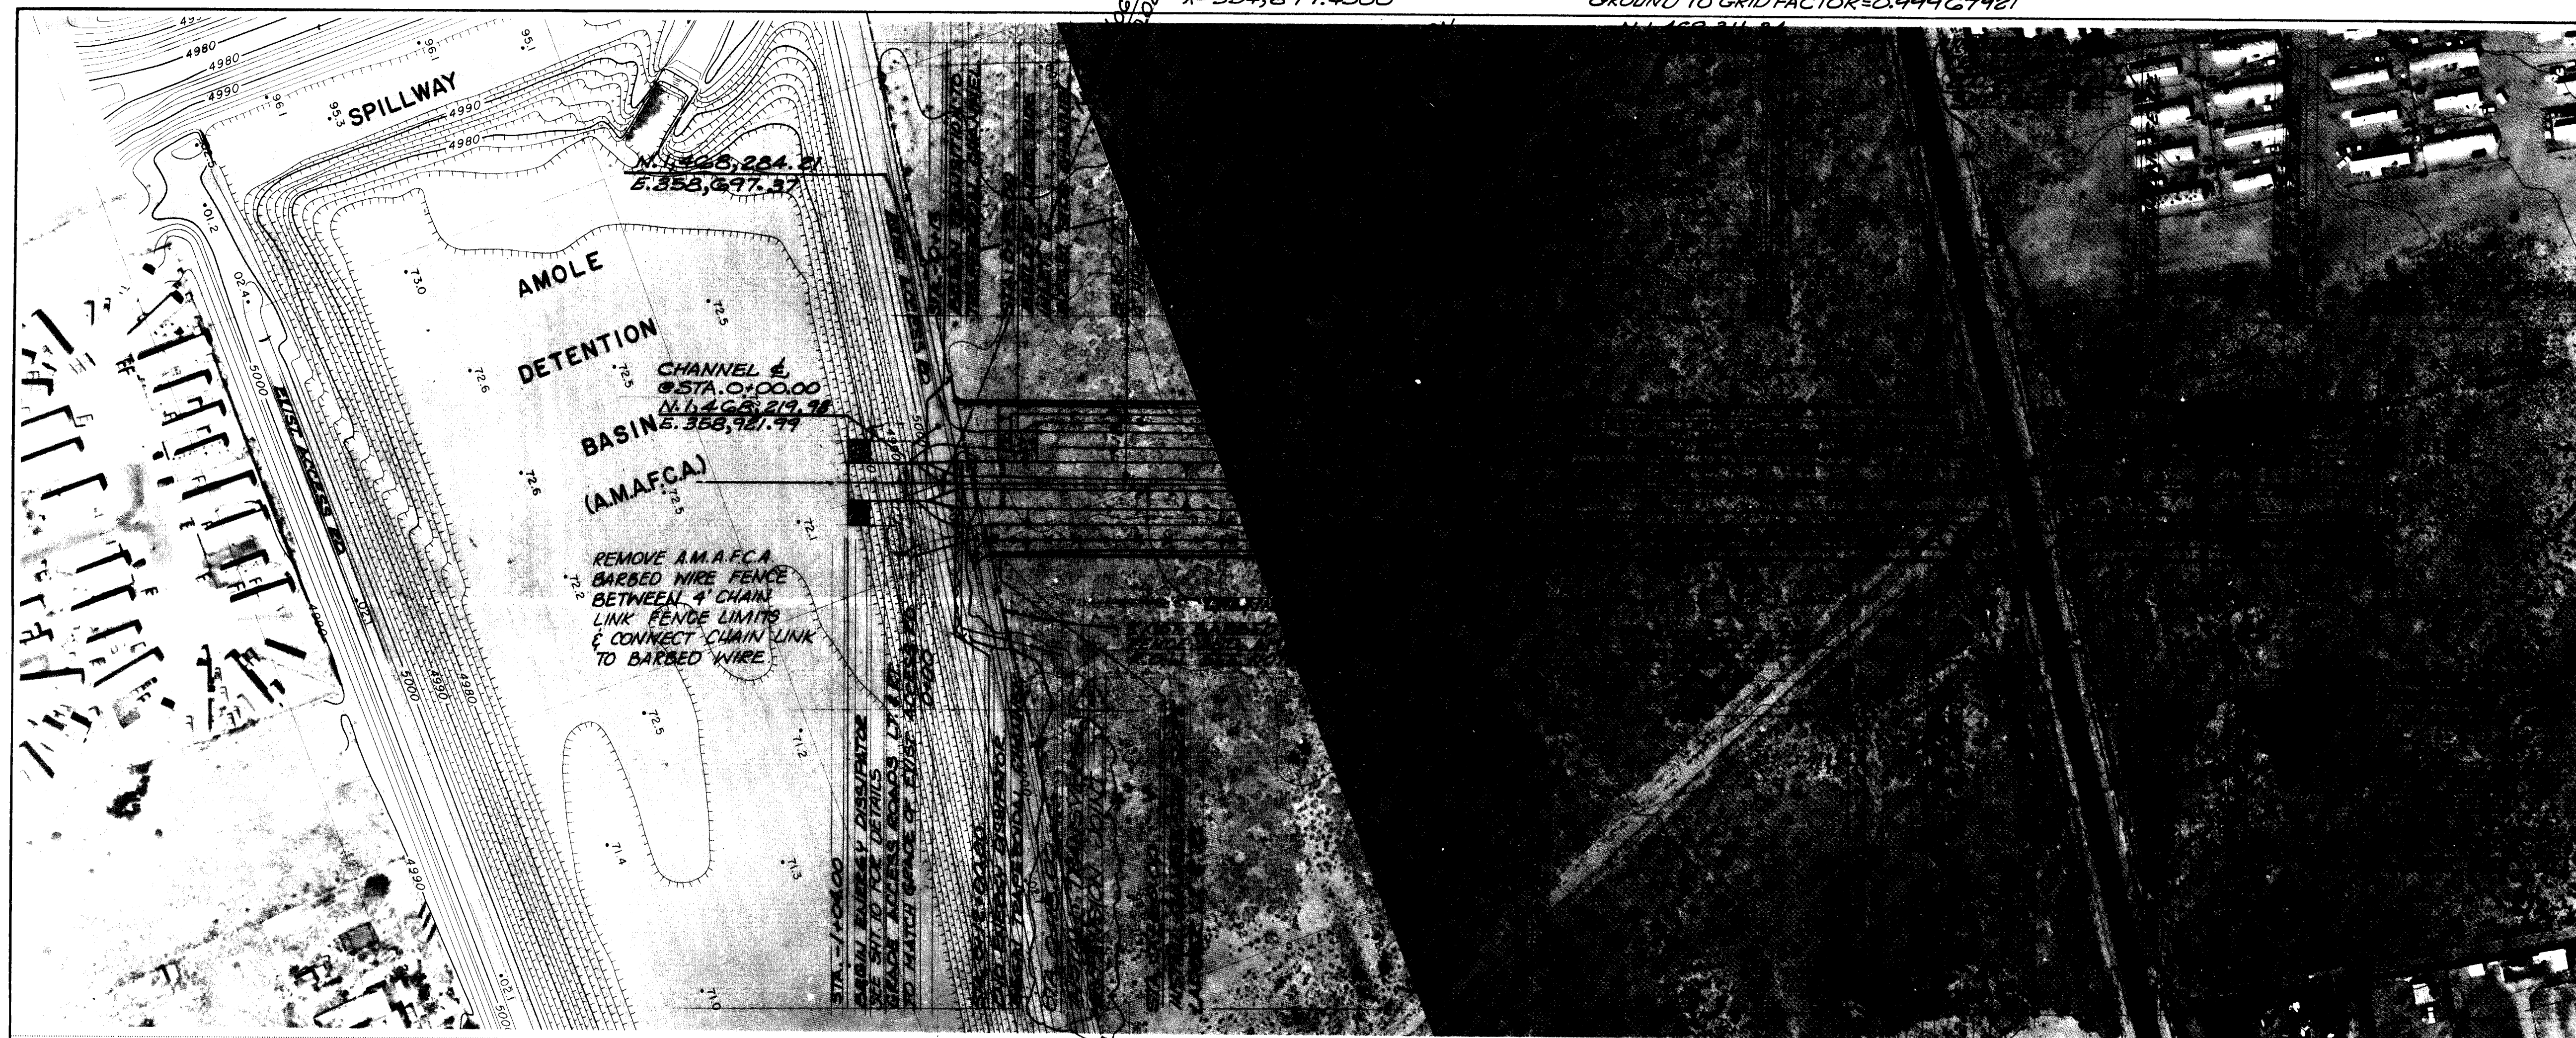

- NOTES:
- NO CONSTRUCTION WILL BE ALLOWED WITHIN THE AMAFCA R.O.W. FROM MAY 15 TO OCTOBER 15. NO PORTION OF THE CONSTRUCTION WITHIN THIS AREA MAY BE LEFT UNCOMPLETED DURING THIS PERIOD.
 - AMAFCA = ALBUQUERQUE METROPOLITAN ARROYO FLOOD CONTROL AUTHORITY.
 - COORDINATES, DISTANCES, AND BEARINGS ARE REFERENCED TO THE NEW MEXICO STATE PLANE SYSTEM (CENTRAL ZONE). GROUND DISTANCES CAN BE OBTAINED BY DIVIDING THE REPORTED GRID DISTANCES SHOWN ON THE DRAWINGS BY THE CONVERSION FACTOR 0.999677785.
 - LIMIT OF PAYMENT FOR STRUCTURAL EXCAVATION FOR THE BLAKE ROAD TRAPEZOIDAL BOX CULVERT IS STA. 10+94.47 TO STA. 11+66.47.
 - EXISTING UNDERGROUND TELEPHONE 200 PR CABLE TO BE LOWERED BY UTILITY OWNER.
 - EXISTING 2" φ HP. GAS LINE TO BE LOWERED BY UTILITY OWNER.

ENGINEER'S SEAL		SURVEY INFORMATION		BENCH MARKS		AS BUILT INFORMATION	
NO.		FIELD NOTES		THE FOLLOWING VERTICAL EQUATION IS NEEDED TO MATCH AMOLE DEL NORTE AERIAL TOPOGRAPHIC ELEVATIONS APPEARING IN THESE DRAWINGS WITH ALBUQUERQUE CITY SURVEY ELEVATIONS:		CONTRACTOR	
DATE		BY		AMOLE DEL NORTE DATUM + 0.32 FT.		WORK PERFORMED	
REVISIONS		NO.		= ACS DATUM (1929 MSLD)		DATE	
DESIGNED BY		NO.		VERTICAL CONTROL POINT "AMOLE B"		DATE	
DRAWN BY		NO.		EL. = 4997.11' AMOLE DATUM		DATE	
CHECKED BY		NO.		EL. = 4997.43' ACS DATUM		DATE	
A-30-84 CORRECTED TEL. CABLE SIZE TDS		TDS		TDS		TDS	
A-30-84 MOVED EXP. LT. 6' NORTH		BY		BY		BY	
NO. DATE		NO. DATE		NO. DATE		NO. DATE	
REVISIONS		REVISIONS		REVISIONS		REVISIONS	
DESIGN		DESIGN		DESIGN		DESIGN	
DATE 12/85		DATE 12/85		DATE 12/85		DATE 12/85	
DRAWN BY		DRAWN BY		DRAWN BY		DRAWN BY	
CHECKED BY		CHECKED BY		CHECKED BY		CHECKED BY	


CITY OF ALBUQUERQUE
MUNICIPAL DEVELOPMENT DEPARTMENT
ENGINEERING DIVISION

TITLE: CHANNEL PLAN & PROFILE
STA. -1+04.00 TO STA. 15+00.00

AMOLE DEL NORTE STORM DIVERSION FACILITY

APPROVALS	ENGINEER	DATE	APPROVALS	ENGINEER	DATE
City Engineer	<i>[Signature]</i>	2/1/86	Liquid Waste	<i>[Signature]</i>	1/22/86
A.C.E. - Design	<i>[Signature]</i>	1/22/86	Traffic	<i>[Signature]</i>	1/22/86
A.C.E. - Hydrology	<i>[Signature]</i>	1/22/86	Water	<i>[Signature]</i>	1/22/86

DRAWING NO. 2480 MAP NO. N-10 SHEET 3 OF 21

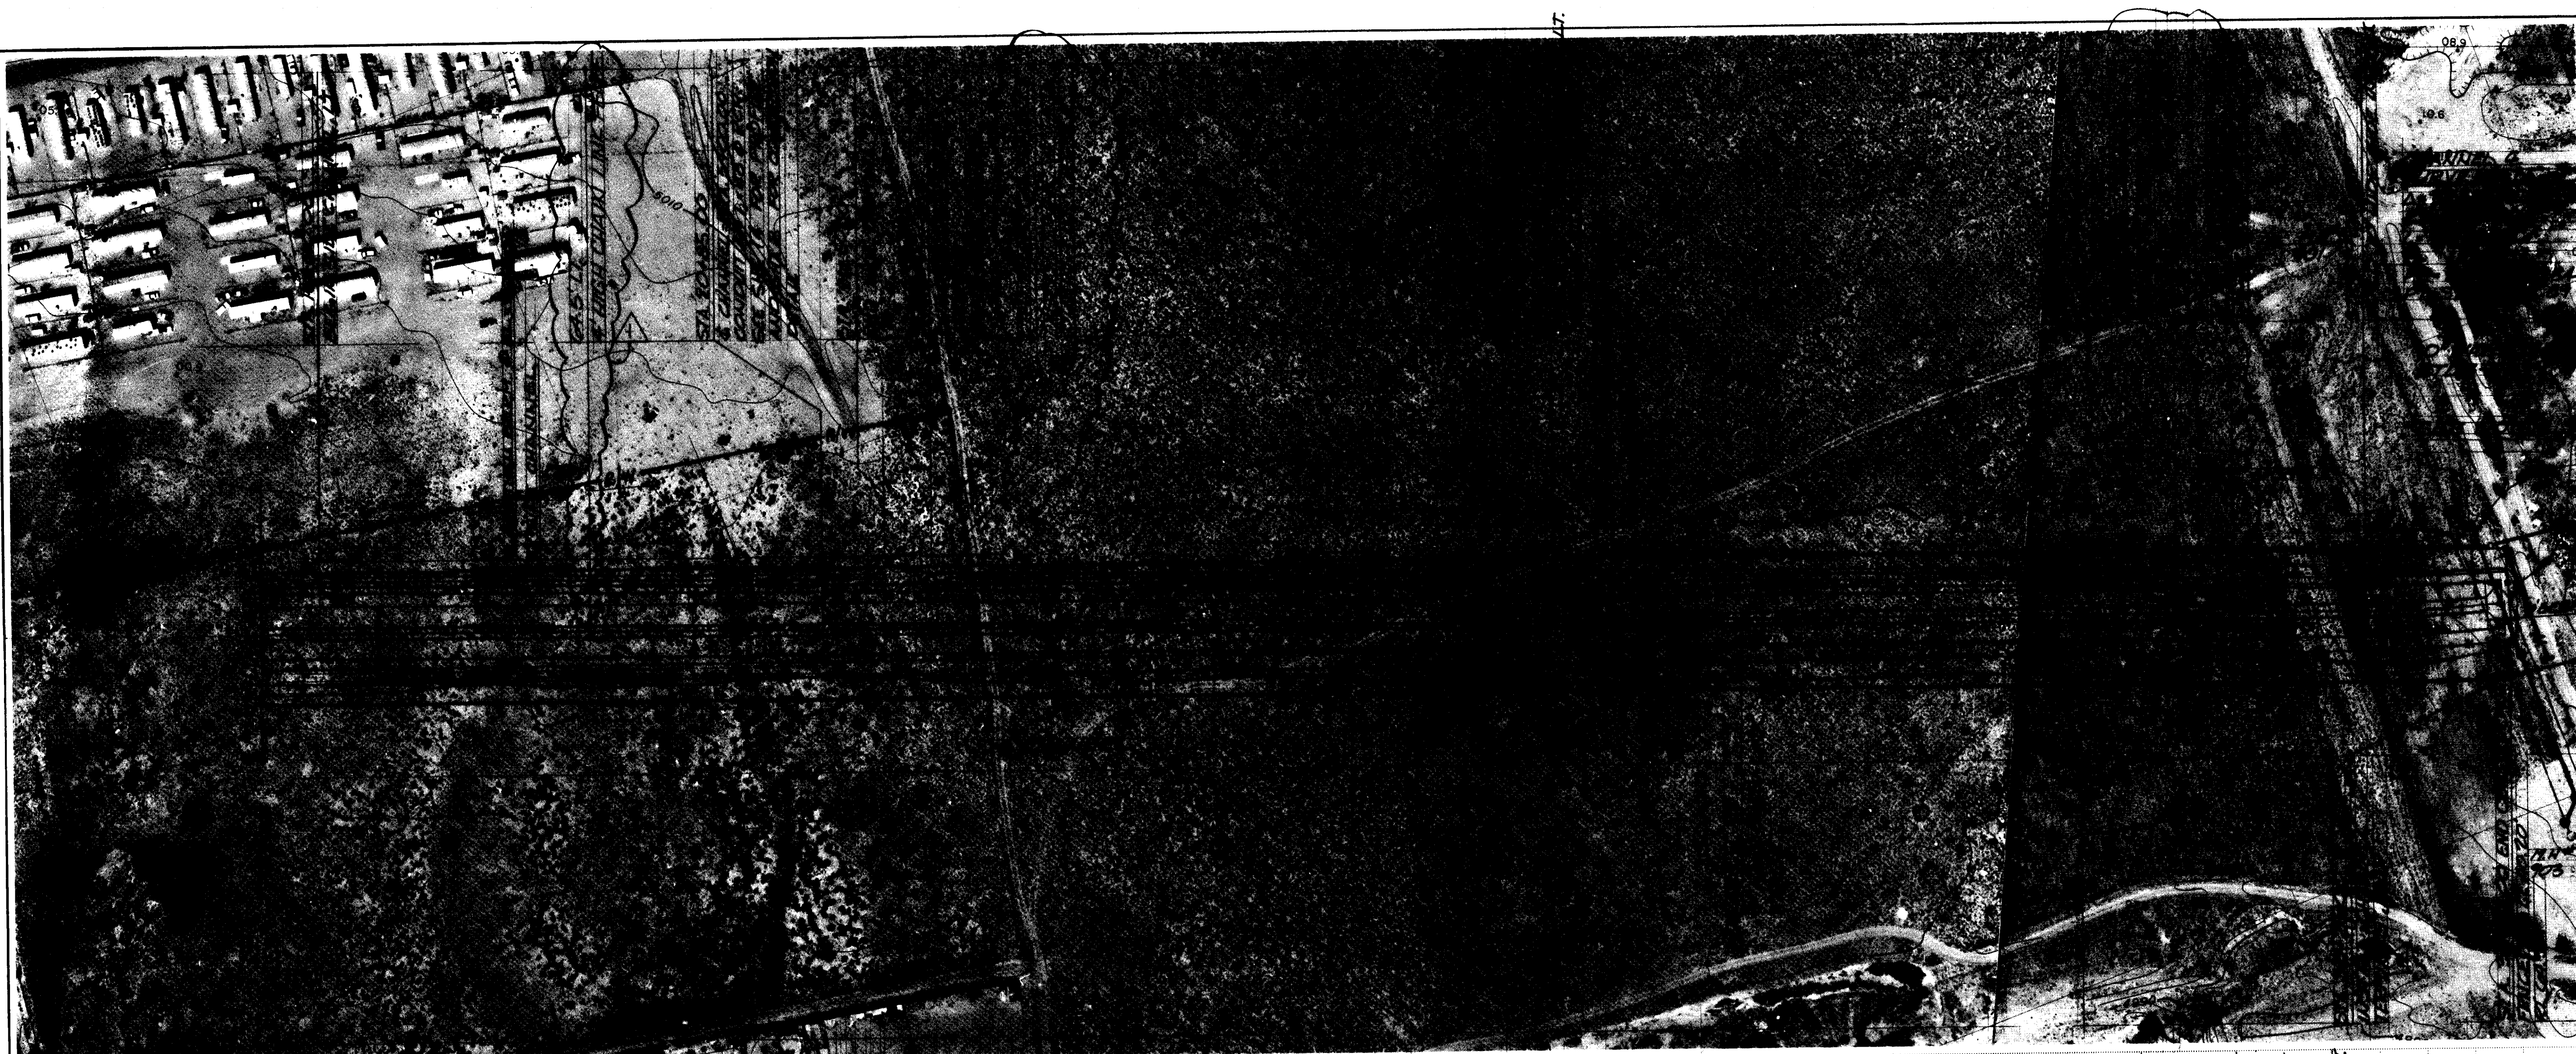


1. **FILL EXISTING DEPRESSION AND GRADE AREA TO DIRECT DRAINAGE TOWARD SIDE CHANNEL INLET.**
2. **SEE SHEET 15 FOR SEWER RELOCATION PLAN AND PROFILE.**
3. **COORDINATES, DISTANCES, AND BEARINGS ARE REFERENCED TO THE NEW MEXICO STATE PLANE SYSTEM (CENTRAL ZONE). GROUND DISTANCES CAN BE OBTAINED BY DIVIDING THE REPORTED GRID DISTANCES SHOWN ON THE DRAWINGS BY THE CONVERSION FACTOR 0.9999277785.**

[illegible][illegible]

CITY OF ALBUQUERQUE					
MUNICIPAL DEVELOPMENT DEPARTMENT					
ENGINEERING DIVISION					
TITLE: CHANNEL PLAN & PROFILE					
STA. 15+00.00 TO STA. 38+00.00					
AMOLE DEL NORTE STORM DIVERSION FACILITY					
APPROVALS	ENGINEER	DATE	APPROVALS	ENGINEER	DATE
City Engineer	<i>[Signature]</i>	2/10/86	Liquid Waste	<i>[Signature]</i>	1/22/86
A.C.E.-Design	<i>[Signature]</i>	1/22/86	Traffic	N/A	1/22/86
A.C.E.-Hydrology	K.K. Legal	1/22/86	Water	<i>[Signature]</i>	1/22/86
DRAWING NO. 2480		MAP NO. N-10		SHEET 4 OF 21	



- NOTES:**
- COORDINATES, DISTANCES, & BEARINGS ARE REFERENCED TO THE NEW MEXICO STATE PLANE SYSTEM (CENTRAL ZONE). GROUND DISTANCES CAN BE OBTAINED BY DIVIDING THE REPORTED GRID DISTANCES SHOWN ON THE DRAWINGS BY THE CONVERSION FACTOR 0.999677785.
 - EARTHWORK VOLUMES WERE COMPUTED USING A 30% SHRINKAGE FACTOR. IF ACTUAL FIELD SHRINKAGE DIFFERS, AN EARTHWORK BALANCE FOR THIS PROJECT MAY BE ACHIEVED BY ADJUSTING THE FILL ELEVATION OF LAGOON NO. 2.
 - CLEARED AND GRUBBED VEGETABLE MATTER SUCH AS TREES, TREE STUMPS, LOGS, ROOTS, DOWNED TREES, BRUSH, GRASS AND WEEDS SHALL BE STORED FOR USE AS MULCH FOR SLOPE STABILIZATION SEEDING OPERATIONS. THE CONTRACTOR MAY STORE THE MATERIAL AT ANY LOCATION WITHIN THE PROJECT RIGHT-OF-WAY OR CONSTRUCTION EASEMENT, INCLUDING LAGOONS NO. 1 THRU 6. DELETERIOUS MATERIAL FOUND WITHIN THE LIMITS OF CLEARING AND GRUBBING, SUCH AS TRASH, TIRES, CONCRETE AND OTHER NON-VEGETABLE MATERIALS SHALL BE REMOVED FROM THE SITE AND DISPOSED OF AT AN APPROVED LAND FILL.

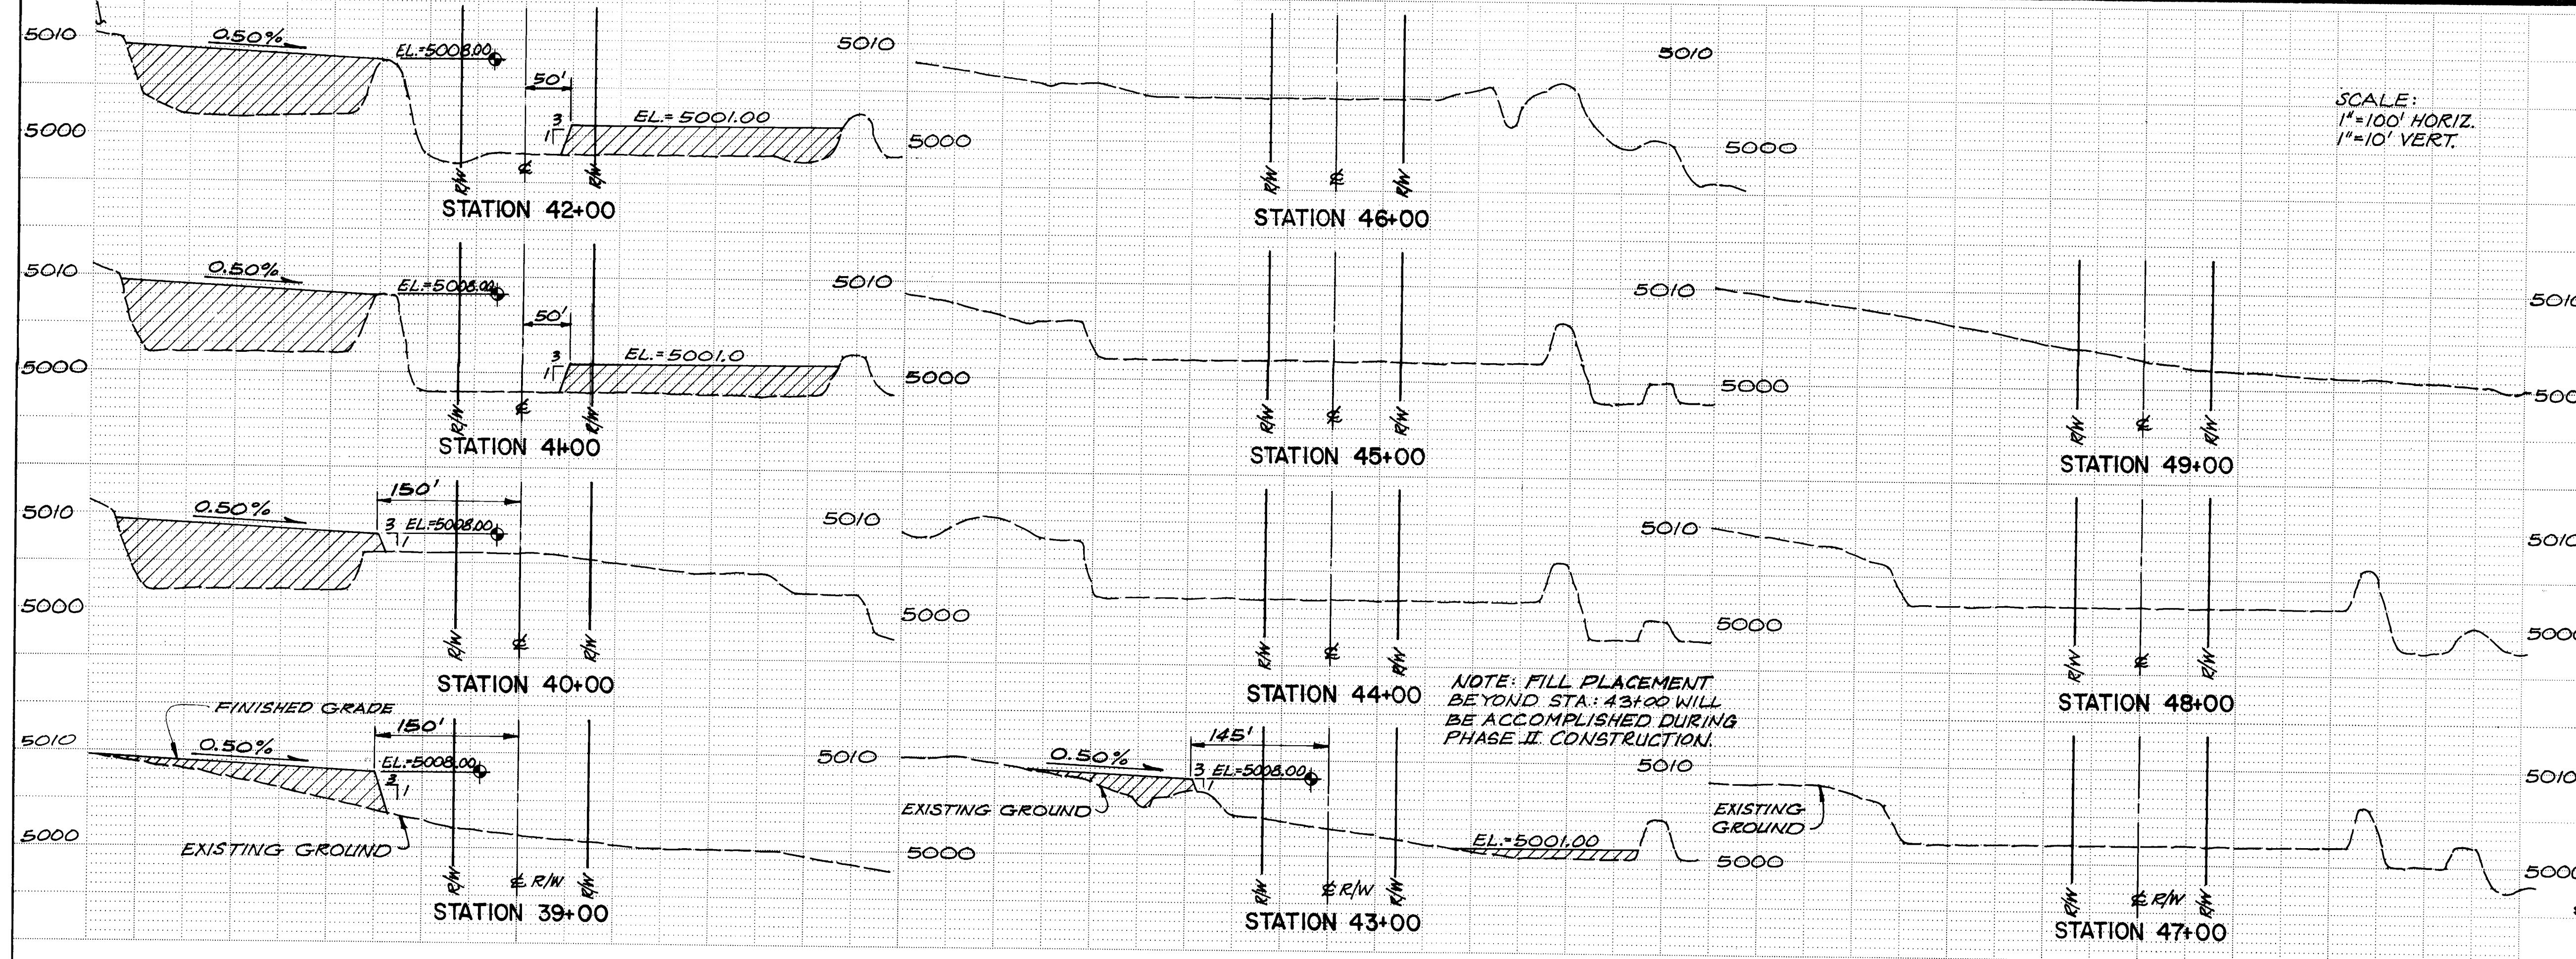

RECORD DRAWING

These record drawings shall only be those facilities constructed in accordance with the contract identified in the title block and have been prepared in part on the basis of information compiled and furnished by the City of Albuquerque. Boyle Engineering Corporation will not be responsible for any errors or omissions in this record drawing.

26 24800587

CITY OF ALBUQUERQUE MUNICIPAL DEVELOPMENT DEPARTMENT ENGINEERING DIVISION					
TITLE: SPOIL AREA GRADING CHANNEL STA. 38+00.00 TO STA. 50+00.00 AMOLE DEL NORTE STORM DIVERSION FACILITY					
APPROVALS	ENGINEER	DATE	APPROVALS	ENGINEER	DATE
City Engineer	J. L. Lee	2/11/86	Liquid Waste	H. Pena	1/22/86
A.C.E. - Design	J. L. Lee	1/22/86	Trigrid	N/A	1/22/86
A.C.E. - Hydrology	K. K. Vogel	1/22/86	Water	H. Pena	1/22/86
DRAWING NO.		MAP NO.	SHEET		
2480		M-10	5 OF 21		

				ENGINEER'S SEAL		SURVEY INFORMATION		BENCH MARKS		AS BUILT INFORMATION	
						FIELD NOTES		THE FOLLOWING VERTICAL EQUATION IS NEEDED TO		CONTRACTOR	
						NO. BY DATE		MATCH AMOLE DEL NORTE AERIAL TOPOGRAPHIC		WORK ORDER NO.	
								ELEVATIONS APPEARING IN THESE DRAWINGS WITH		INSPECTED BY	
								ALBUQUERQUE CITY SURVEY ELEVATIONS:		ACCEPTANCE BY	
								AMOLE DEL NORTE DATUM + 0.32 FT.		FIELD LOCATION BY	
										DRAWING NO.	
										CORRECTED BY	
										DATE	
										MICRO-FILM INFORMATION	
										RECORDED BY	
										DATE	

DESIGNED BY

TWP

DATE 12/85

DRAWN BY

PG/MM

DATE 12/85

REVISIONS

DESIGN

NO. DATE

REMARKS

BY

PROFESSIONAL SEAL

REGISTERED PROFESSIONAL ENGINEER


STATE OF NEW MEXICO

THORNTON D.


4739




- | | | | | | | | |
|---|--------------------|----------------|--------------|--------------------|----------------|-------|---------|
| 26 | 24800687 | | | NO | DESIGN | DRAWN | CHECKED |
| <p align="center">CITY OF ALBUQUERQUE
MUNICIPAL DEVELOPMENT DEPARTMENT
ENGINEERING DIVISION</p> | | | | | | | |
| <p align="center">TITLE: TYPICAL CHANNEL SECTIONS</p> | | | | | | | |
| <p align="center">AMOLE DEL NORTE STORM DIVERSION FACILITY</p> | | | | | | | |
| APPROVALS | ENGINEER | DATE | APPROVALS | ENGINEER | DATE | | |
| CITY Engineer | <i>[Signature]</i> | <i>2/22/96</i> | Liquid Waste | <i>[Signature]</i> | <i>1/22/96</i> | | |
| A C E - Design | <i>[Signature]</i> | <i>1/22/96</i> | Traffic | <i>[Signature]</i> | <i>1/22/96</i> | | |
| A C E - Hydrology | <i>[Signature]</i> | <i>1/22/96</i> | Water | <i>[Signature]</i> | <i>1/22/96</i> | | |
| DRAWING NO. | 2480 | MAP NO. | SHEET | 6 | OF | 21 | |

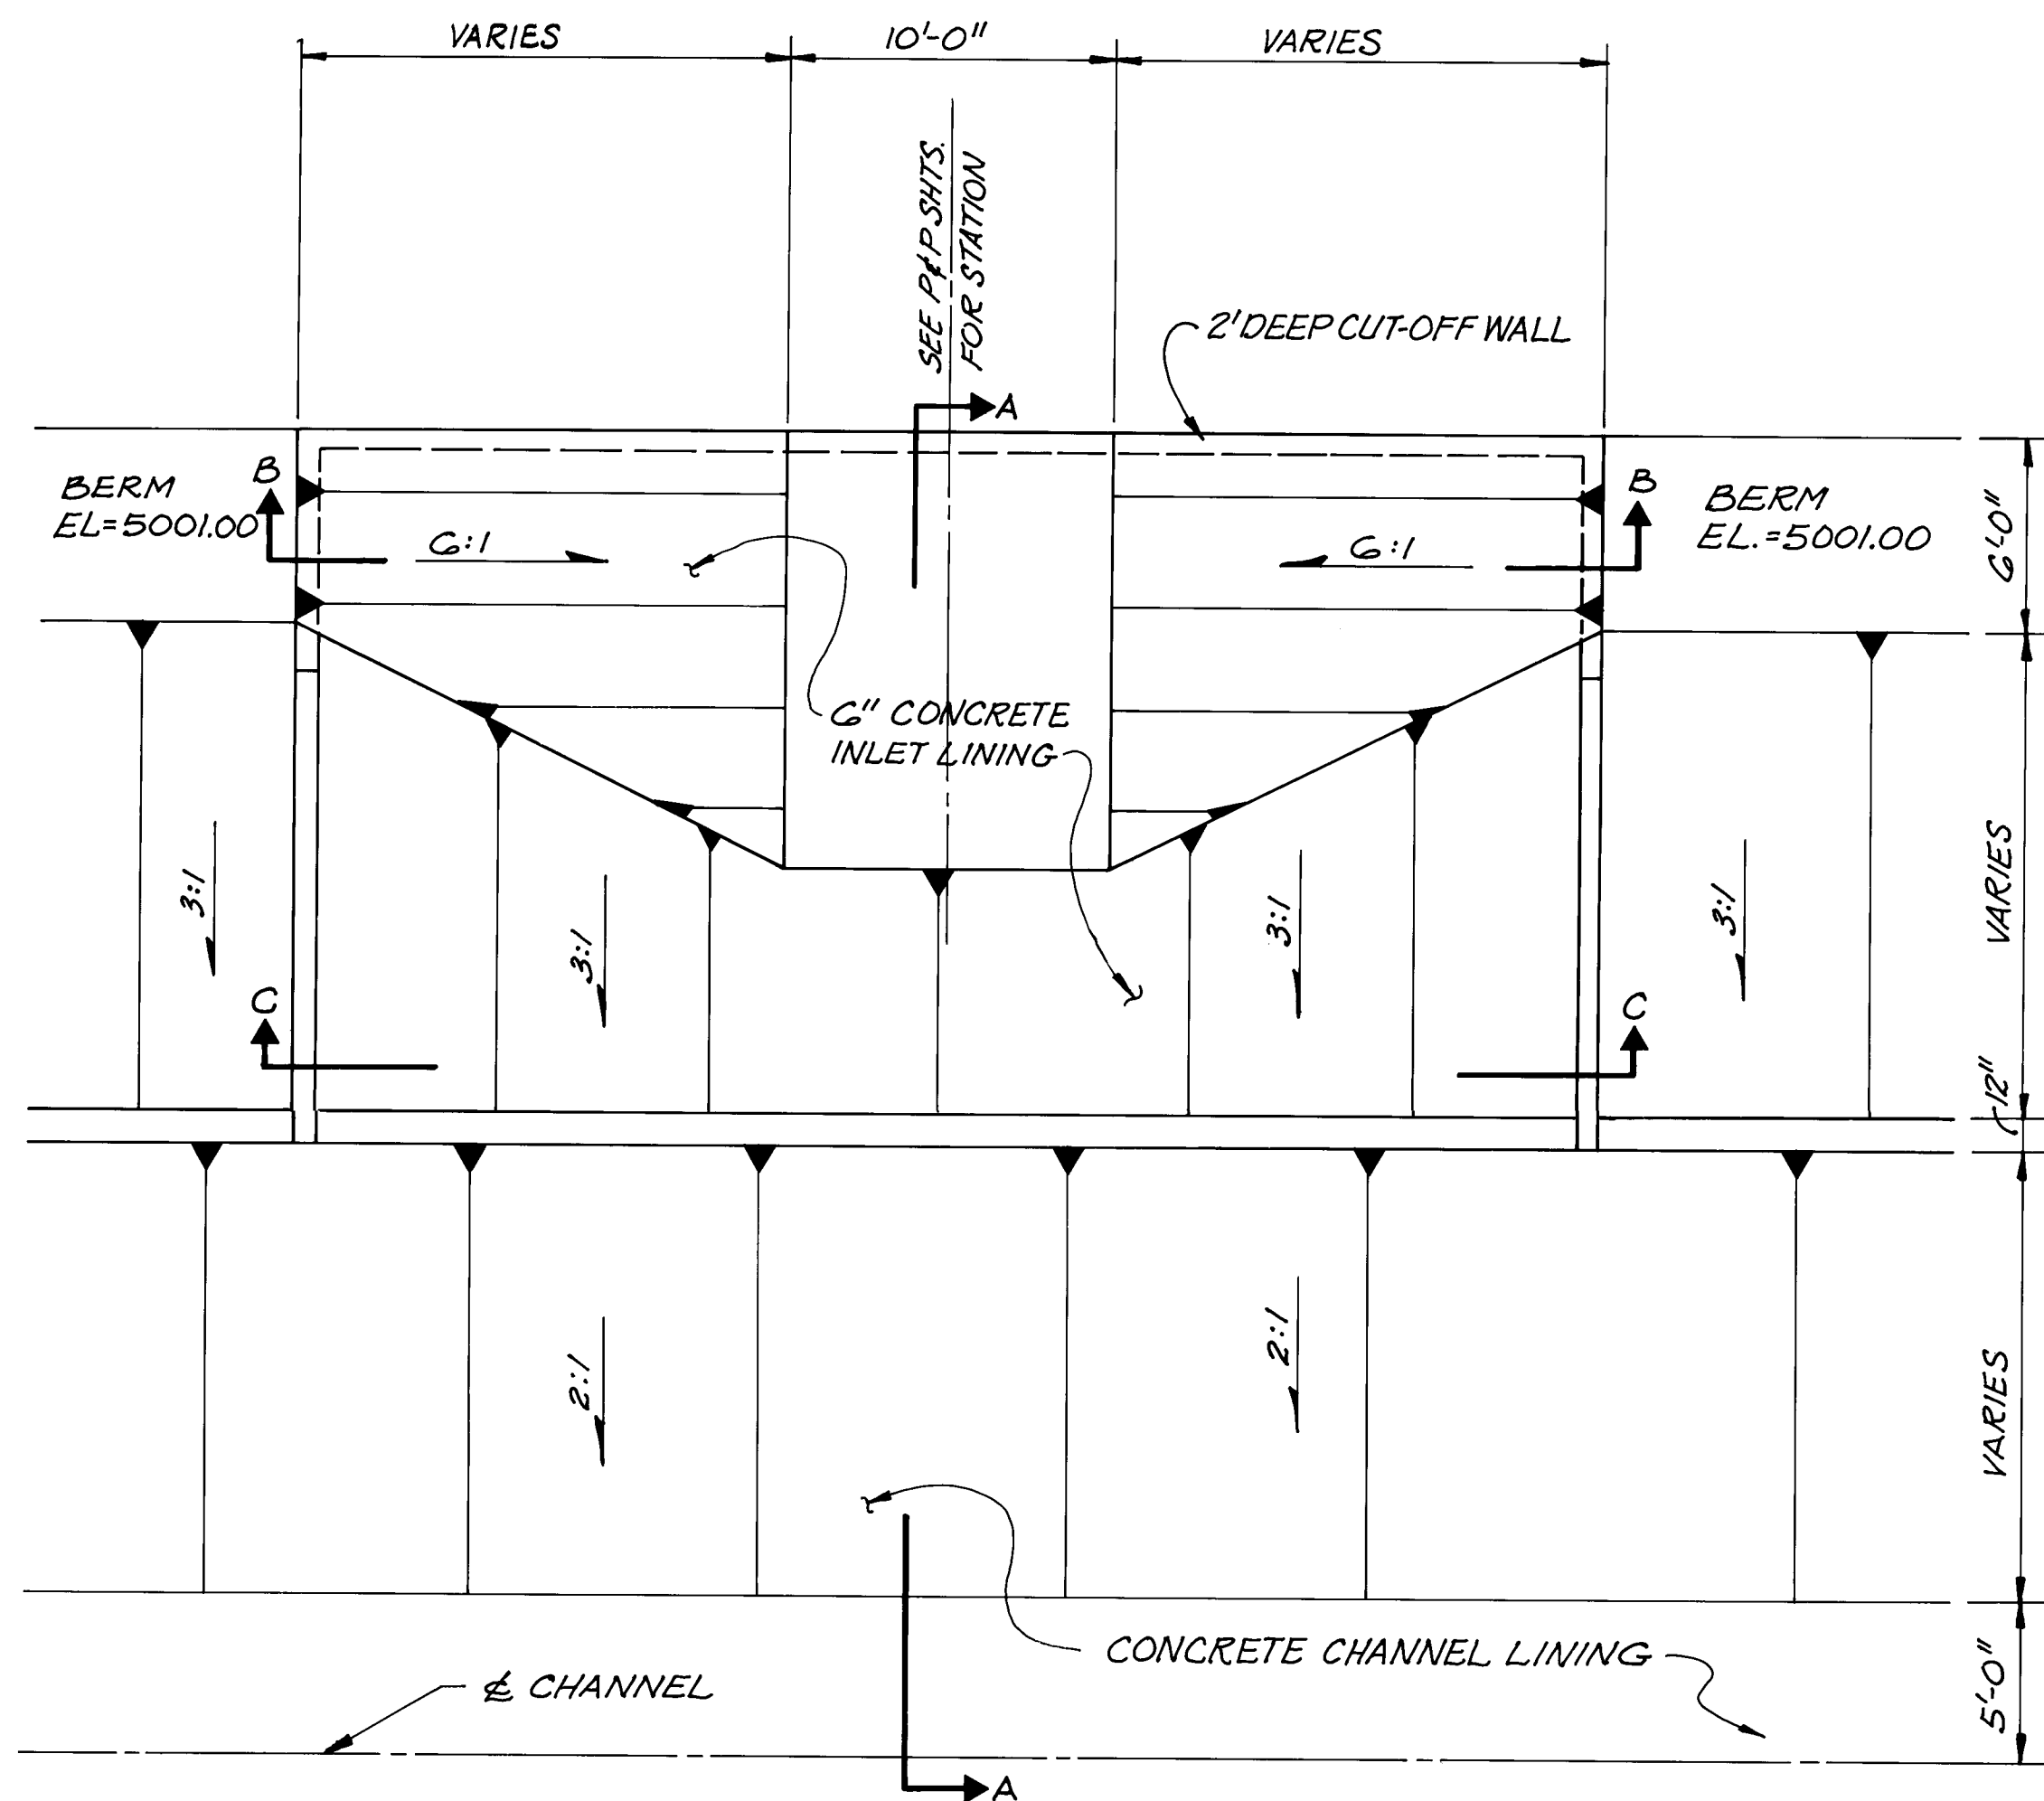


TYPICAL SIDE INLET DETAIL
3/16"=1'-0"

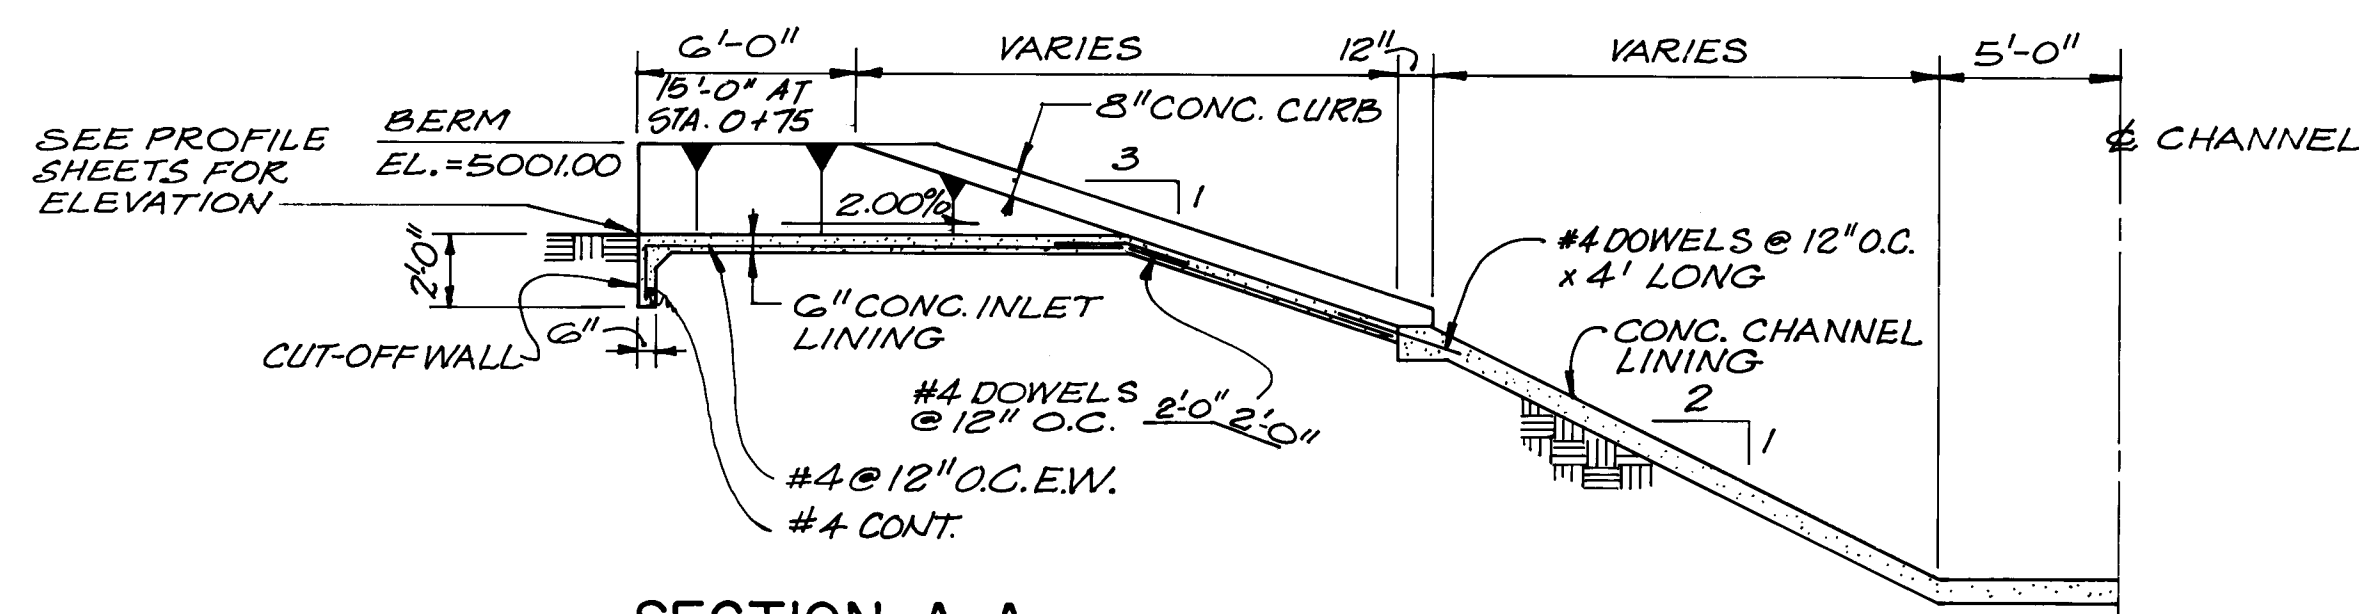


SECTION A-A
SIDE INLET WITH INVERT ABOVE TOP OF CHANNEL
3/16"=1'-0"

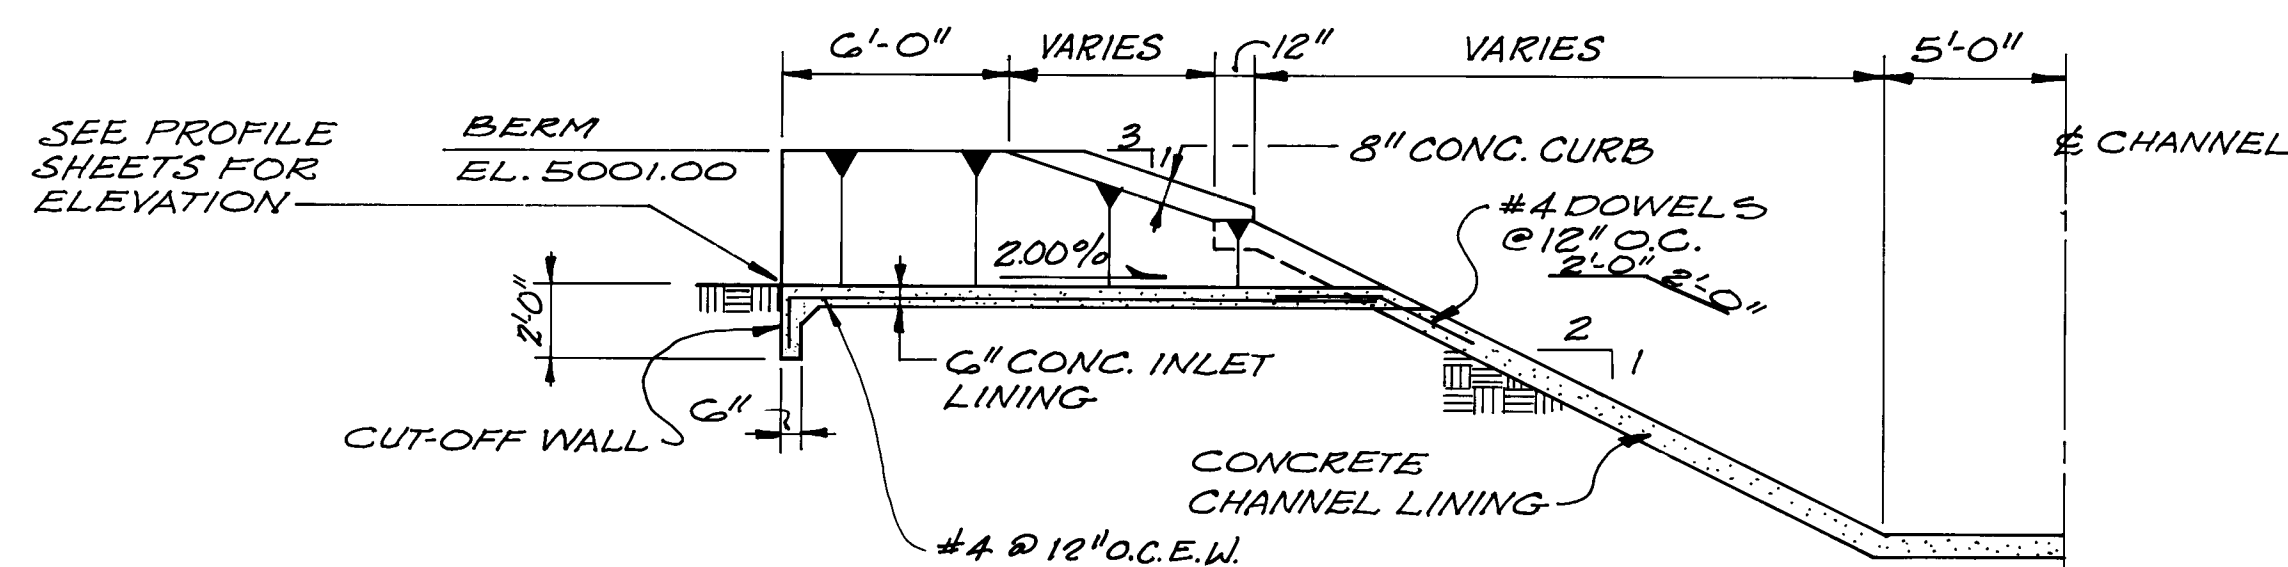


SECTION A-A
SIDE INLET WITH INVERT BELOW TOP OF CHANNEL
3/16"=1'-0"

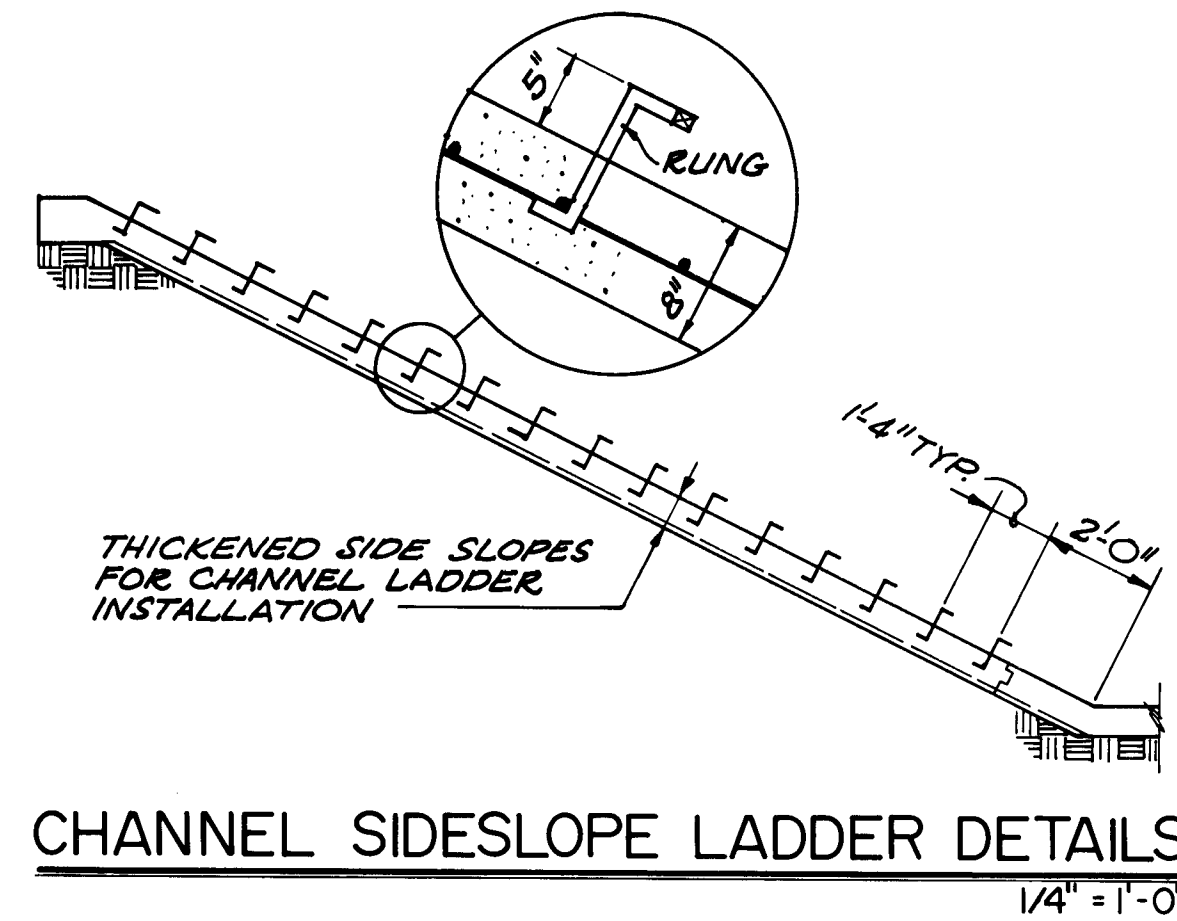


CHANNEL SIDESLOPE LADDER DETAILS
1/4"=1'-0"

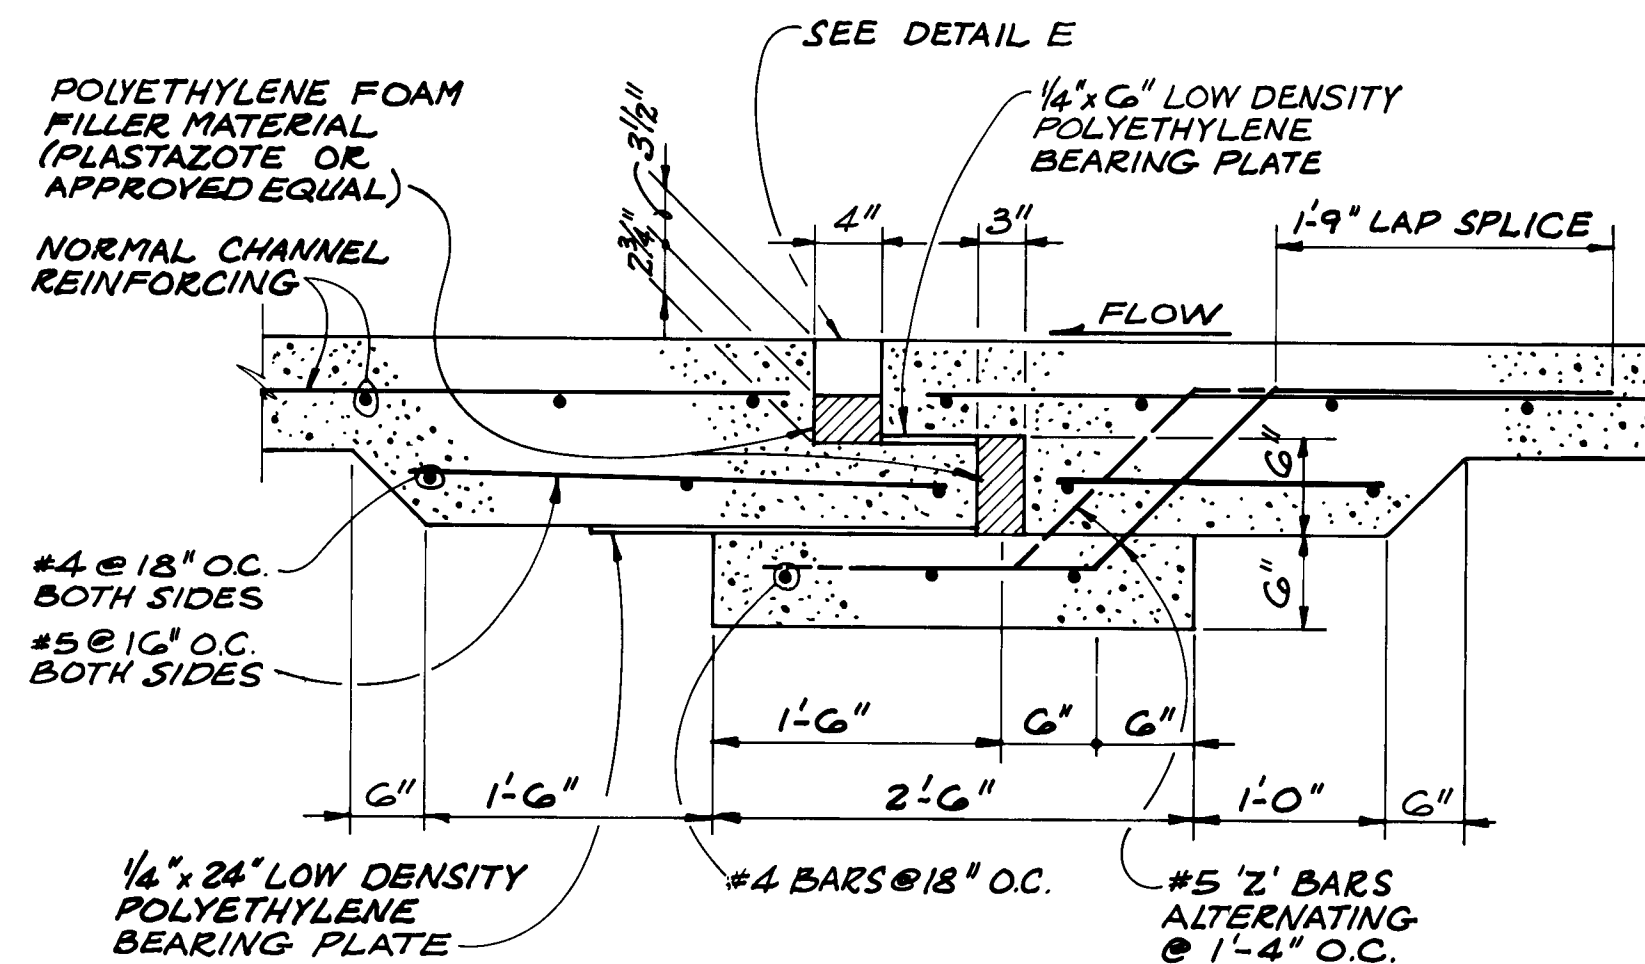


TYPICAL TRANSVERSE EXPANSION JOINT
1"=1'-0"

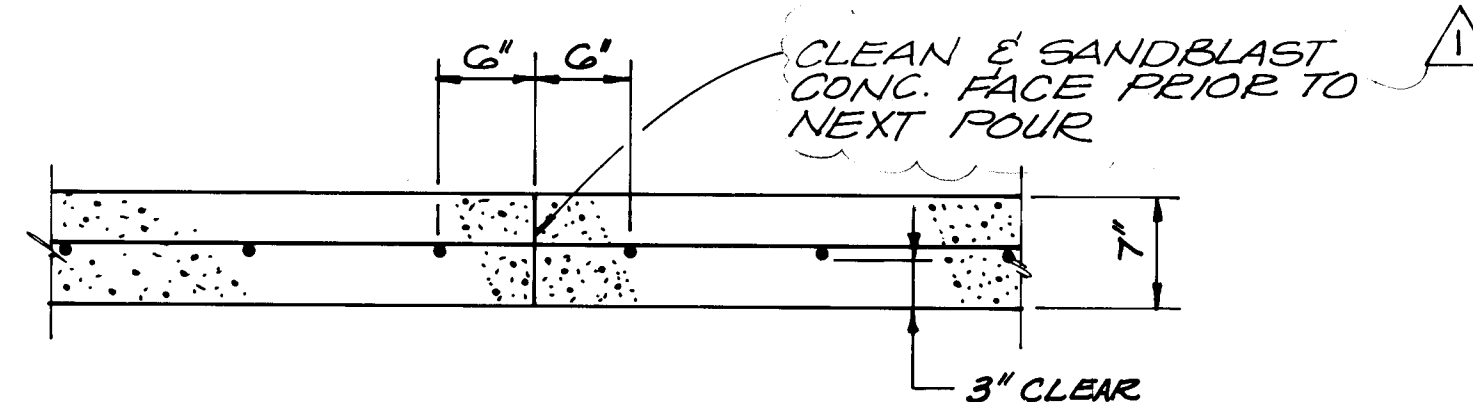

CONSTRUCTION JOINT DETAIL
AS REQUIRED BY CHANNEL CONSTRUCTION
1"=1'-0"

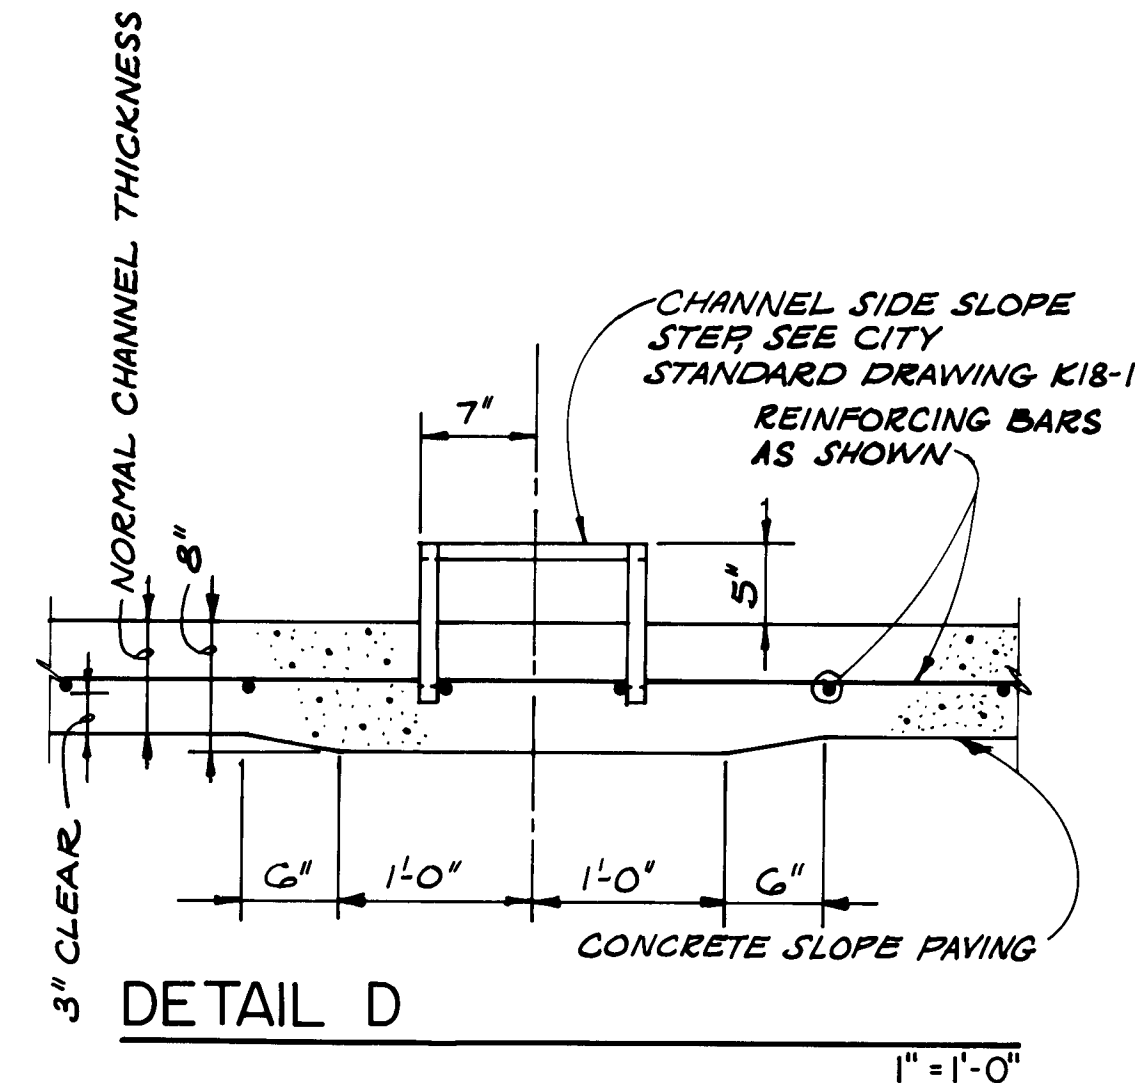

DETAIL D
1"=1'-0"

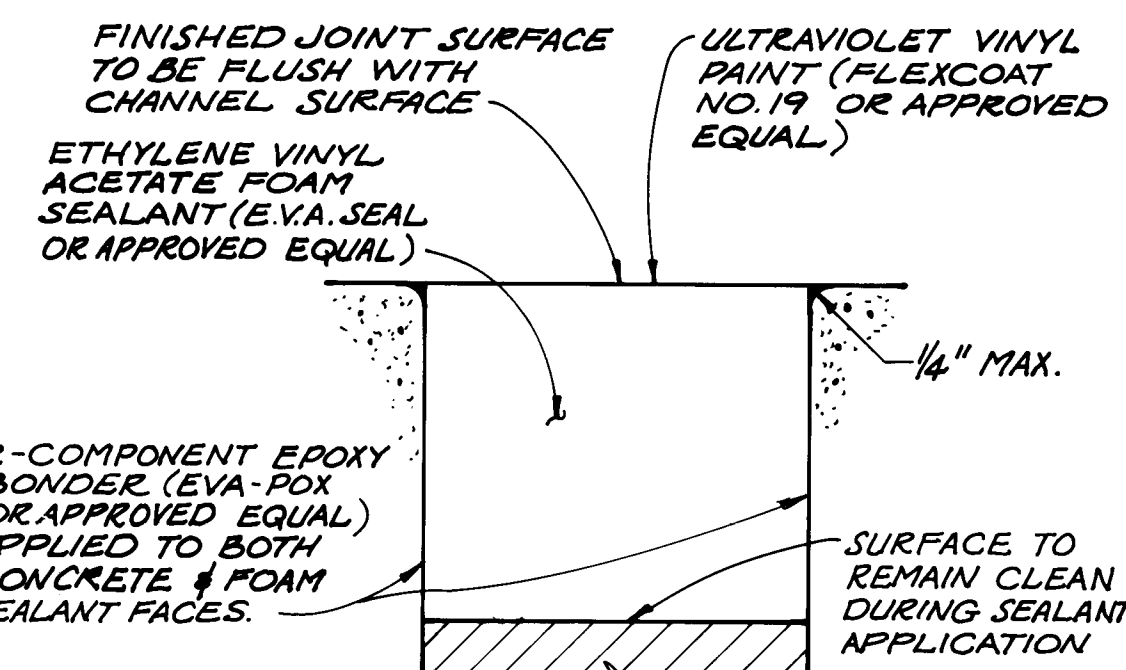

DETAIL E
N.T.S.

TYPICAL CORNER REINFORCING
N.T.S.


TYP. SPLICE LENGTHS FOR LONGITUDINAL CHANNEL REINFORCING		
BAR SIZE	2" CHANNEL LINING & BOX CULVERT 30 BAR DIA.	ENERGY DISSIPATOR 40 BAR DIA.
#5	1'-7"	2'-1"
#6	1'-11"	2'-6"
#7	2'-2"	2'-11"

EXPANSION JOINT CONSTRUCTION NOTES








1. Compact sleeper subgrade to 90% per ASTM D 1557.
2. Pour sleeper with Z-bar reinforcement extending above slab. Steel trowel bearing plate surface only.
3. Compact subgrade and form downstream portion of joint. Construction joints may be installed a min. of 5 feet upstream and downstream of joint centerline. Place lower bearing plate and downstream reinforcing and make downstream pour. Steel trowel upper bearing plate surface.
4. Compact subgrade and form upstream portion of joint. Place reinforcing steel, upper bearing plate, and upper and lower foam filler material. Upper bearing plate must be parallel to lower bearing plate. Do not anchor foam filler material with nails or bonding agent, but keep flush with poured downstream section. Block out foam sealant notch, clean exposed sleeper surface and make upstream pour.
5. When upstream and downstream concrete has reached a min. of 80% design strength or after a minimum of seven days has elapsed since concrete was poured, remove sealant notch form, sand blast vertical surfaces and blow all debris from notch. Apply Epoxy bond to both vertical concrete faces and to both sides of foam sealant material. Immediately compress foam sealant into notch. Remove bond from top surface of sealant material, but do not clean bond bead along edges.
6. If sealant material extends from 0" to 1/8" above channel flowline, apply ultra violet paint as specified. If sealant material extends from 1/8" to 1/2" above channel flowline, power sand material flush with channel flowline under the direction of the Engineer prior to application of ultra violet paint.
7. Order width for form filler shall be 25% greater than width shown. If laminations are required they shall be in the long dimension.

AS BUILT INFORMATION		BENCH MARKS		SURVEY INFORMATION		ENGINEER'S SEAL	
CONTRACTOR	DATE	CONTRACTOR	DATE	NO.	BY	NO.	BY
INSPECTOR	DATE	INSPECTOR	DATE	NO.	BY	NO.	BY
ACCEPTANCE BY	DATE	ACCEPTANCE BY	DATE	NO.	BY	NO.	BY
VERIFICATION BY	DATE	VERIFICATION BY	DATE	NO.	BY	NO.	BY
CORRECTED BY	DATE	CORRECTED BY	DATE	NO.	BY	NO.	BY
RECORDED BY	DATE	RECORDED BY	DATE	NO.	BY	NO.	BY

CITY OF ALBUQUERQUE MUNICIPAL DEVELOPMENT DEPARTMENT ENGINEERING DIVISION			
TITLE: TYPICAL CHANNEL DETAILS			
AMOLE DEL NORTE STORM DIVERSION FACILITY			
APPROVALS	ENGINEER	DATE	APPROVALS
City Engineer	1/12/86	1/12/86	1/12/86
A.C.E. Design	1/12/86	1/12/86	1/12/86
A.C.E. Hydrology	1/12/86	1/12/86	1/12/86
DRAWING NO.	2480	MAP NO.	SHEET 7 OF 21

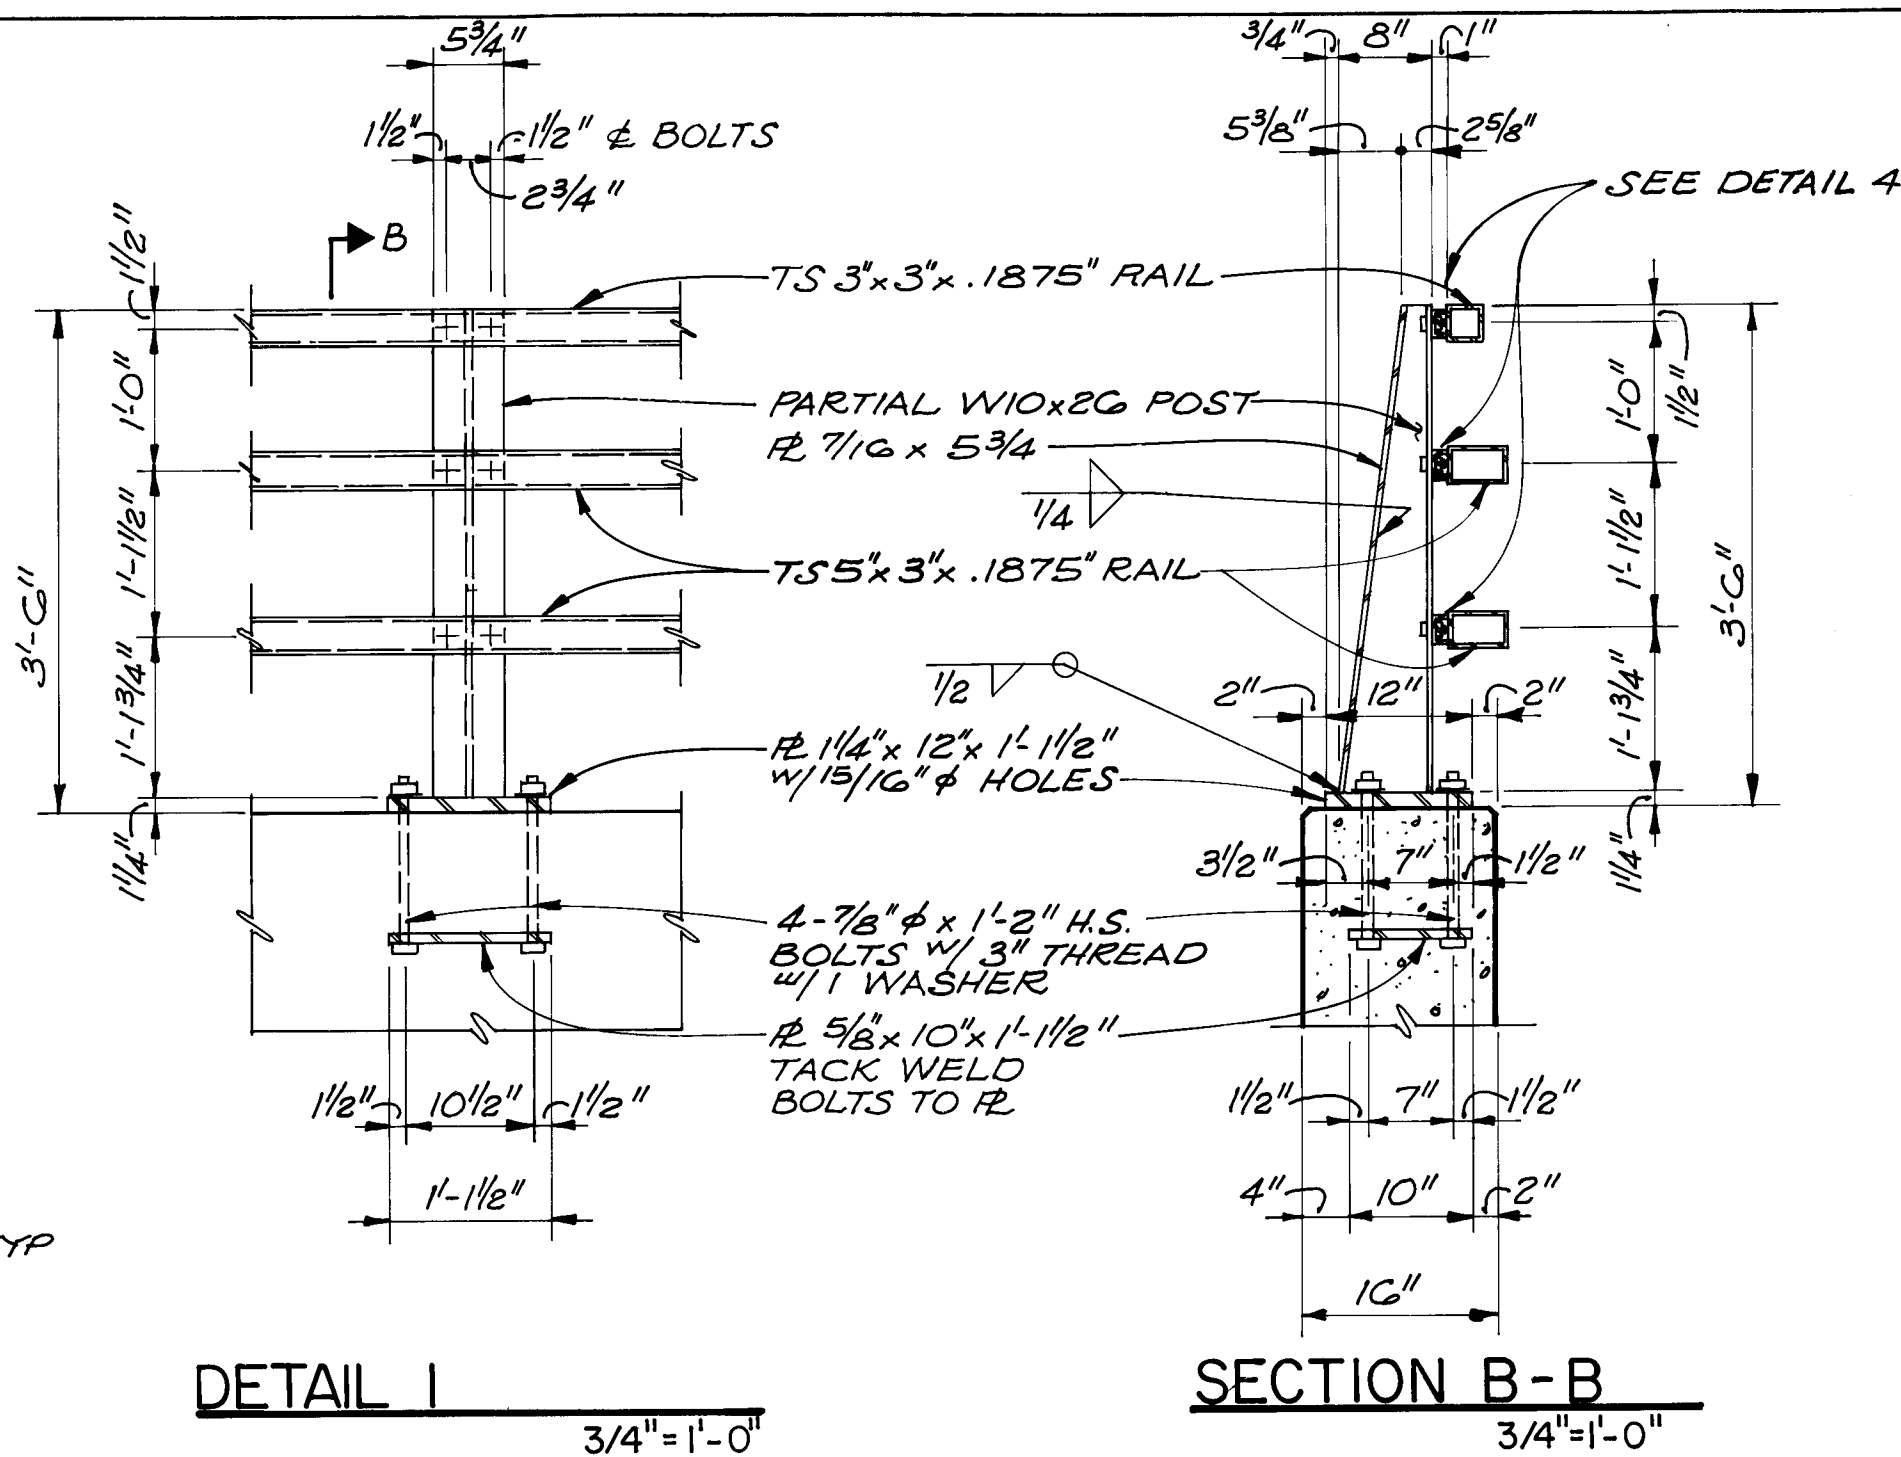

- NOTES:**
1. STEEL FOR METAL RAILING SHALL CONFORM TO THE FOLLOWING ASTM STANDARDS UNLESS OTHERWISE DESIGNATED:
STRUCTURAL
STEEL -----ASTM A36
TUBE STEEL-----ASTM A500
GRADE B, OR
ASTM A501
BOLTS-----ASTM A307
HIGH STRENGTH (H.S.)
BOLTS-----ASTM A325
OR A490
 2. TS RAILING # 5/16" R (BENT) SHALL BE INSTALLED AT ALL HEADWALL ENDS WHETHER OR NOT GUARDRAIL IS INSTALLED.
 3. ALL STEEL METAL RAILING MEMBERS SHALL BE GALVANIZED IN ACCORDANCE WITH SECTION 143 OF THE STANDARD SPECIFICATIONS.
 4. RICHMOND DOWEL ANCHORS SHALL BE DEFORMED BILLET STEEL, ASTM A615, GRADE 60, AS MANUFACTURED BY RICHMOND SCREEN ANCHOR CO., INC.

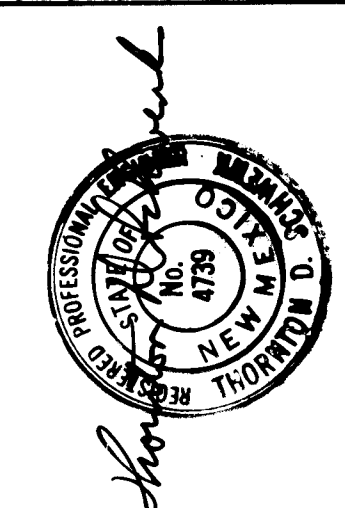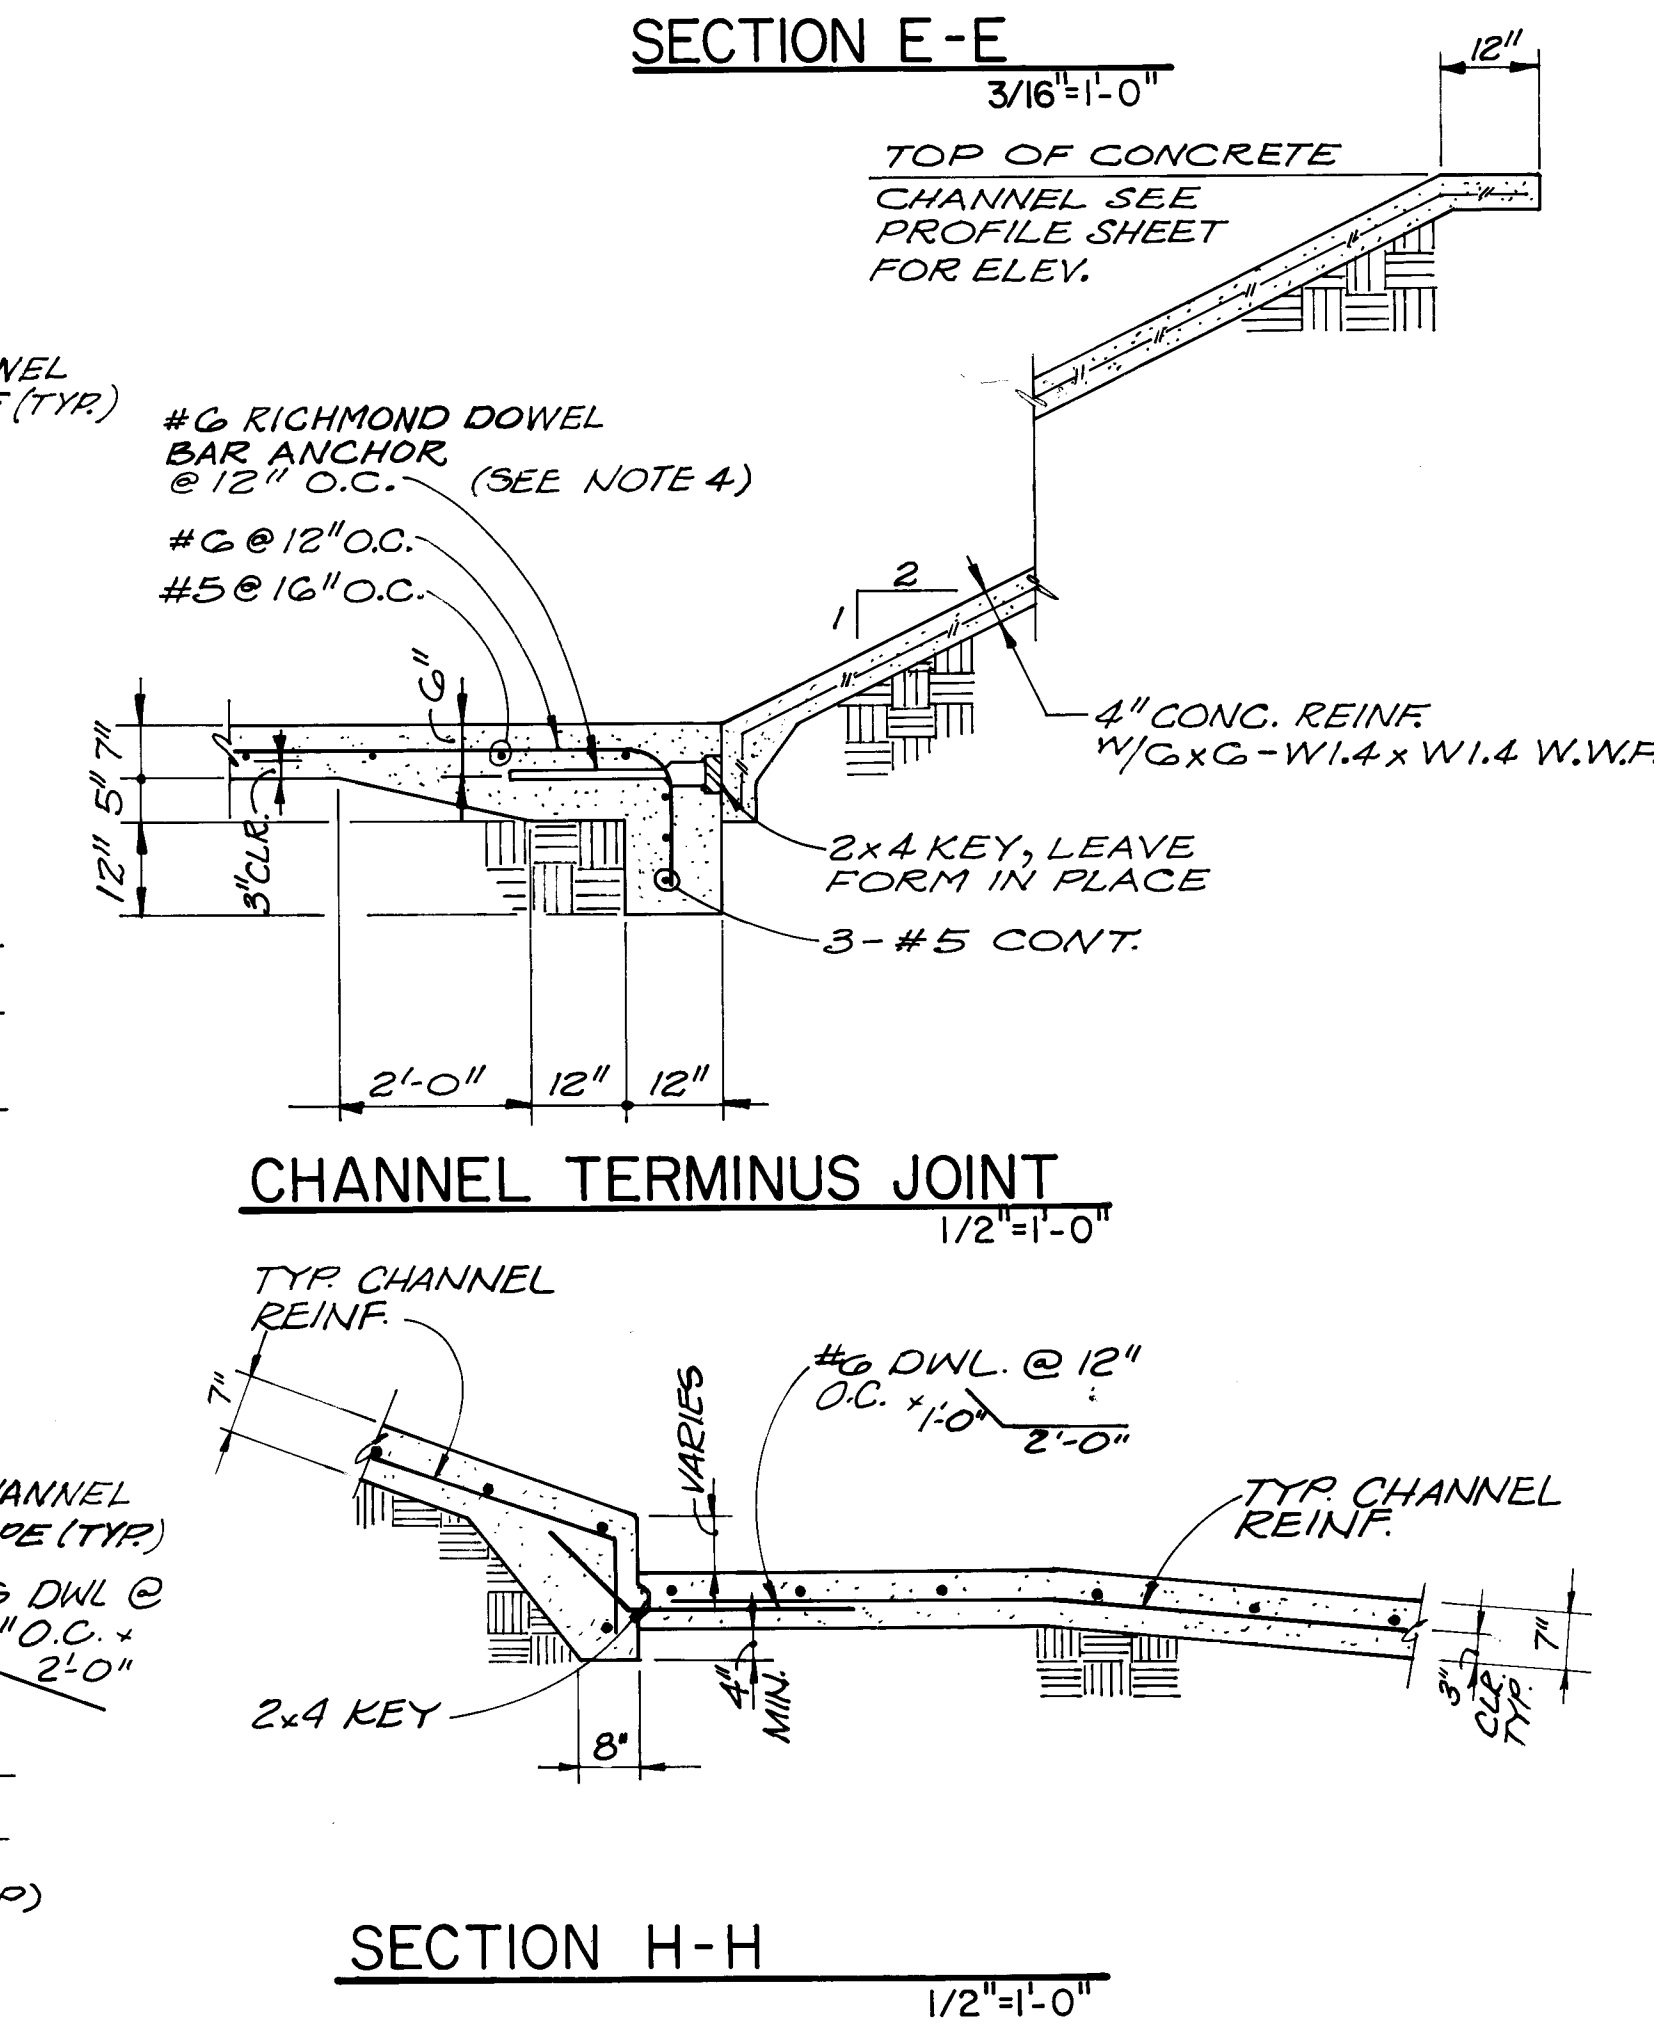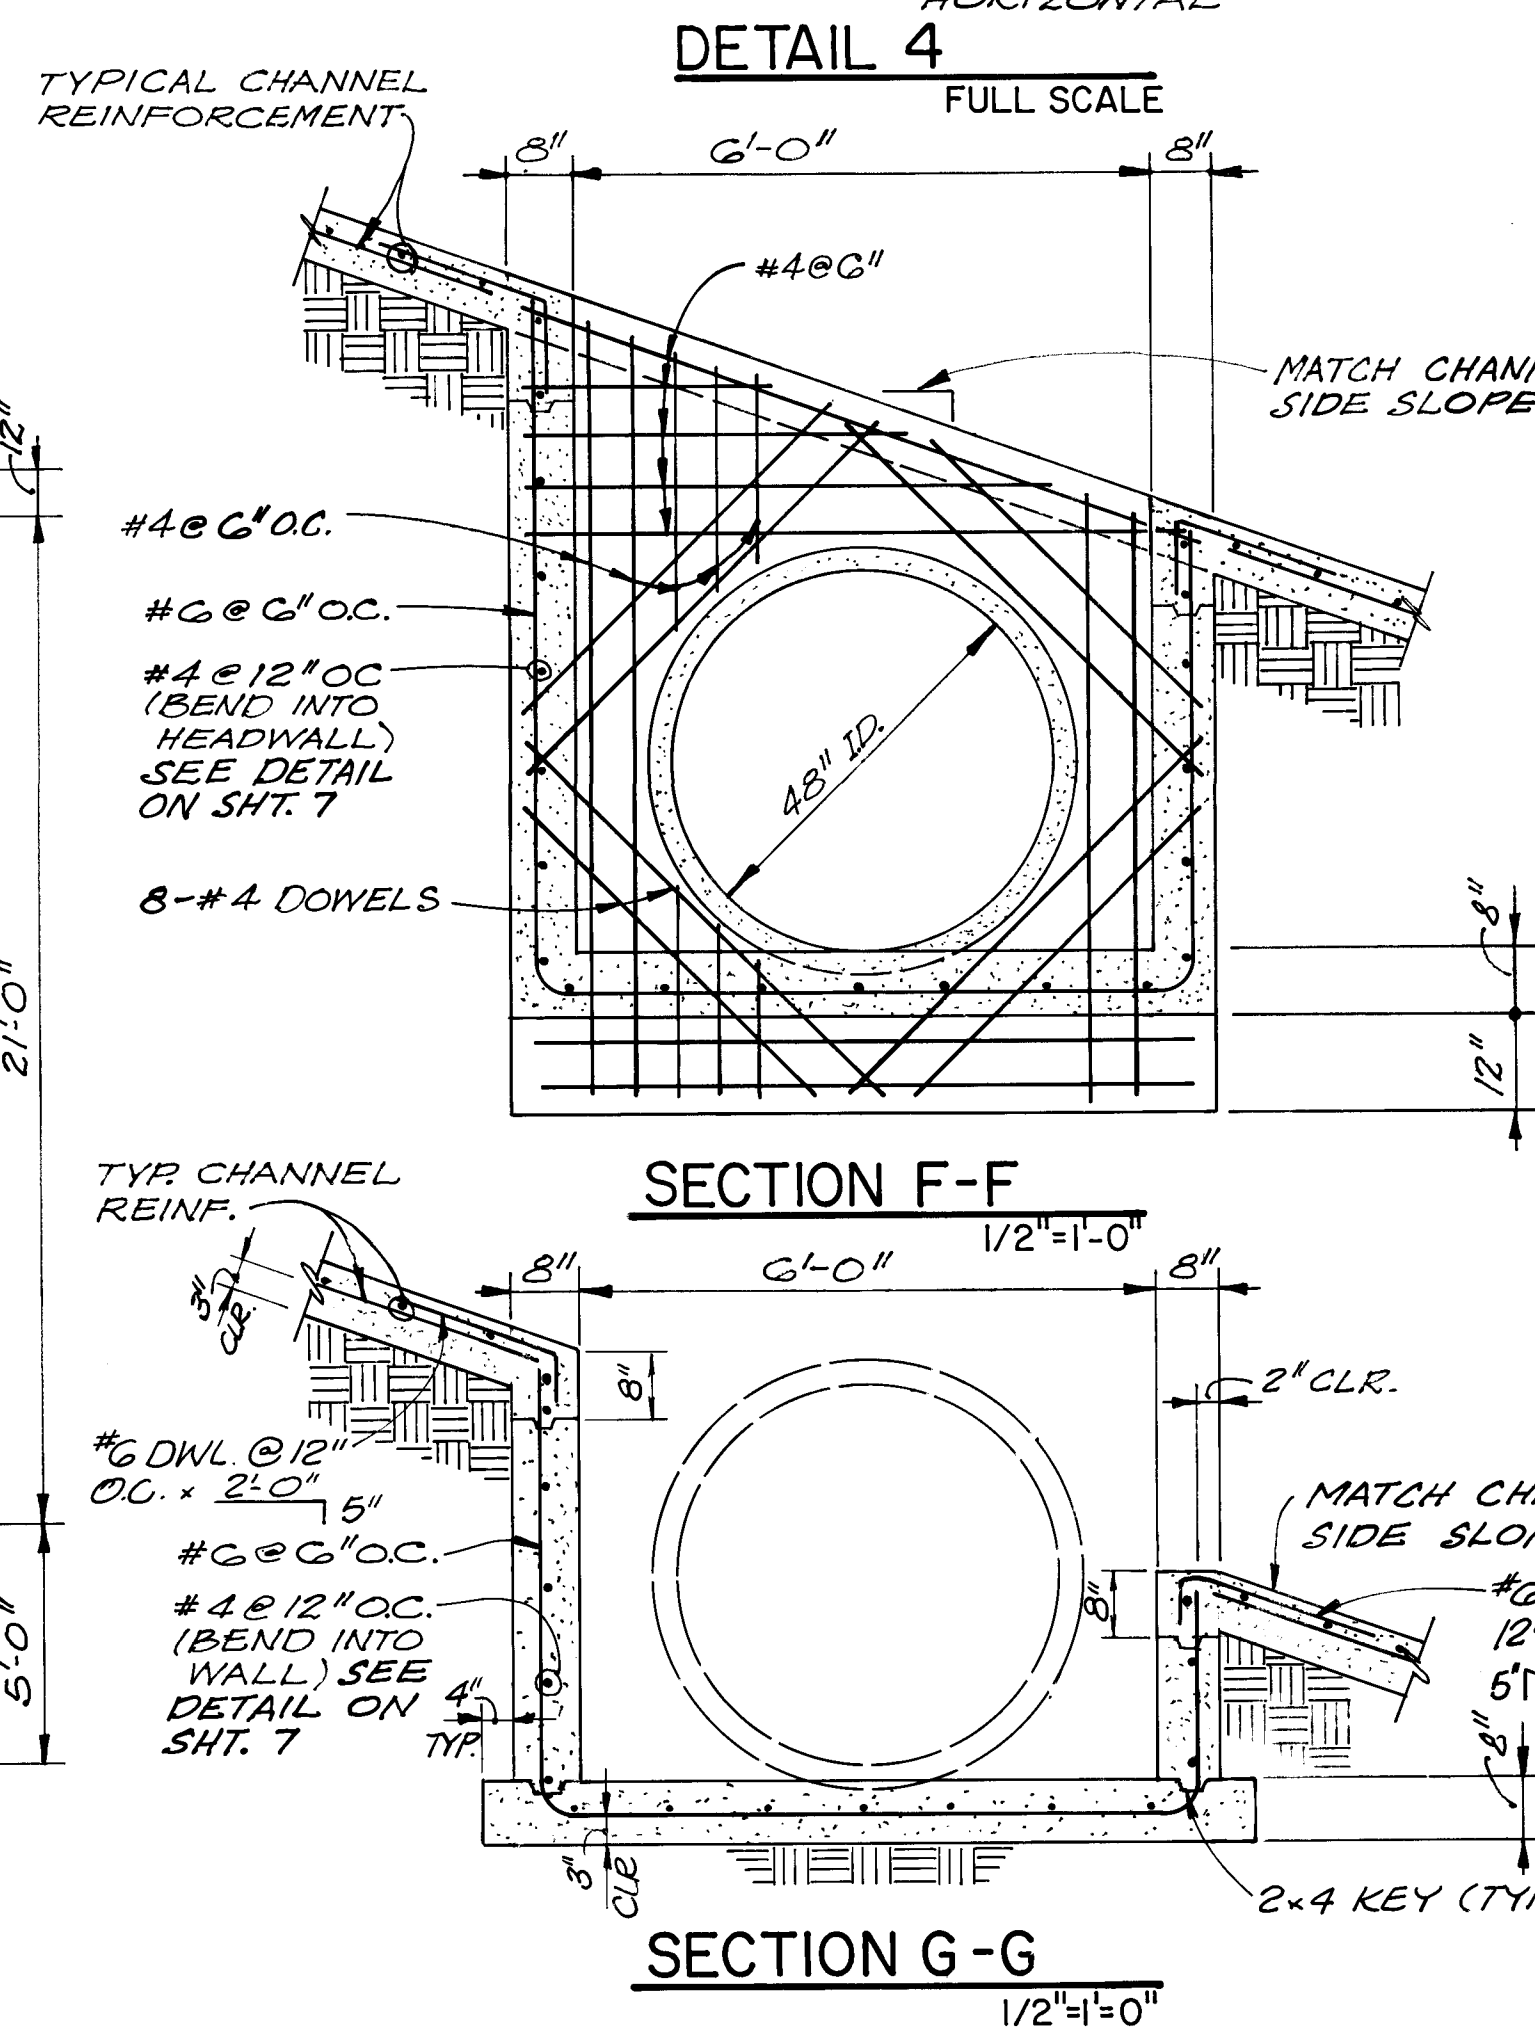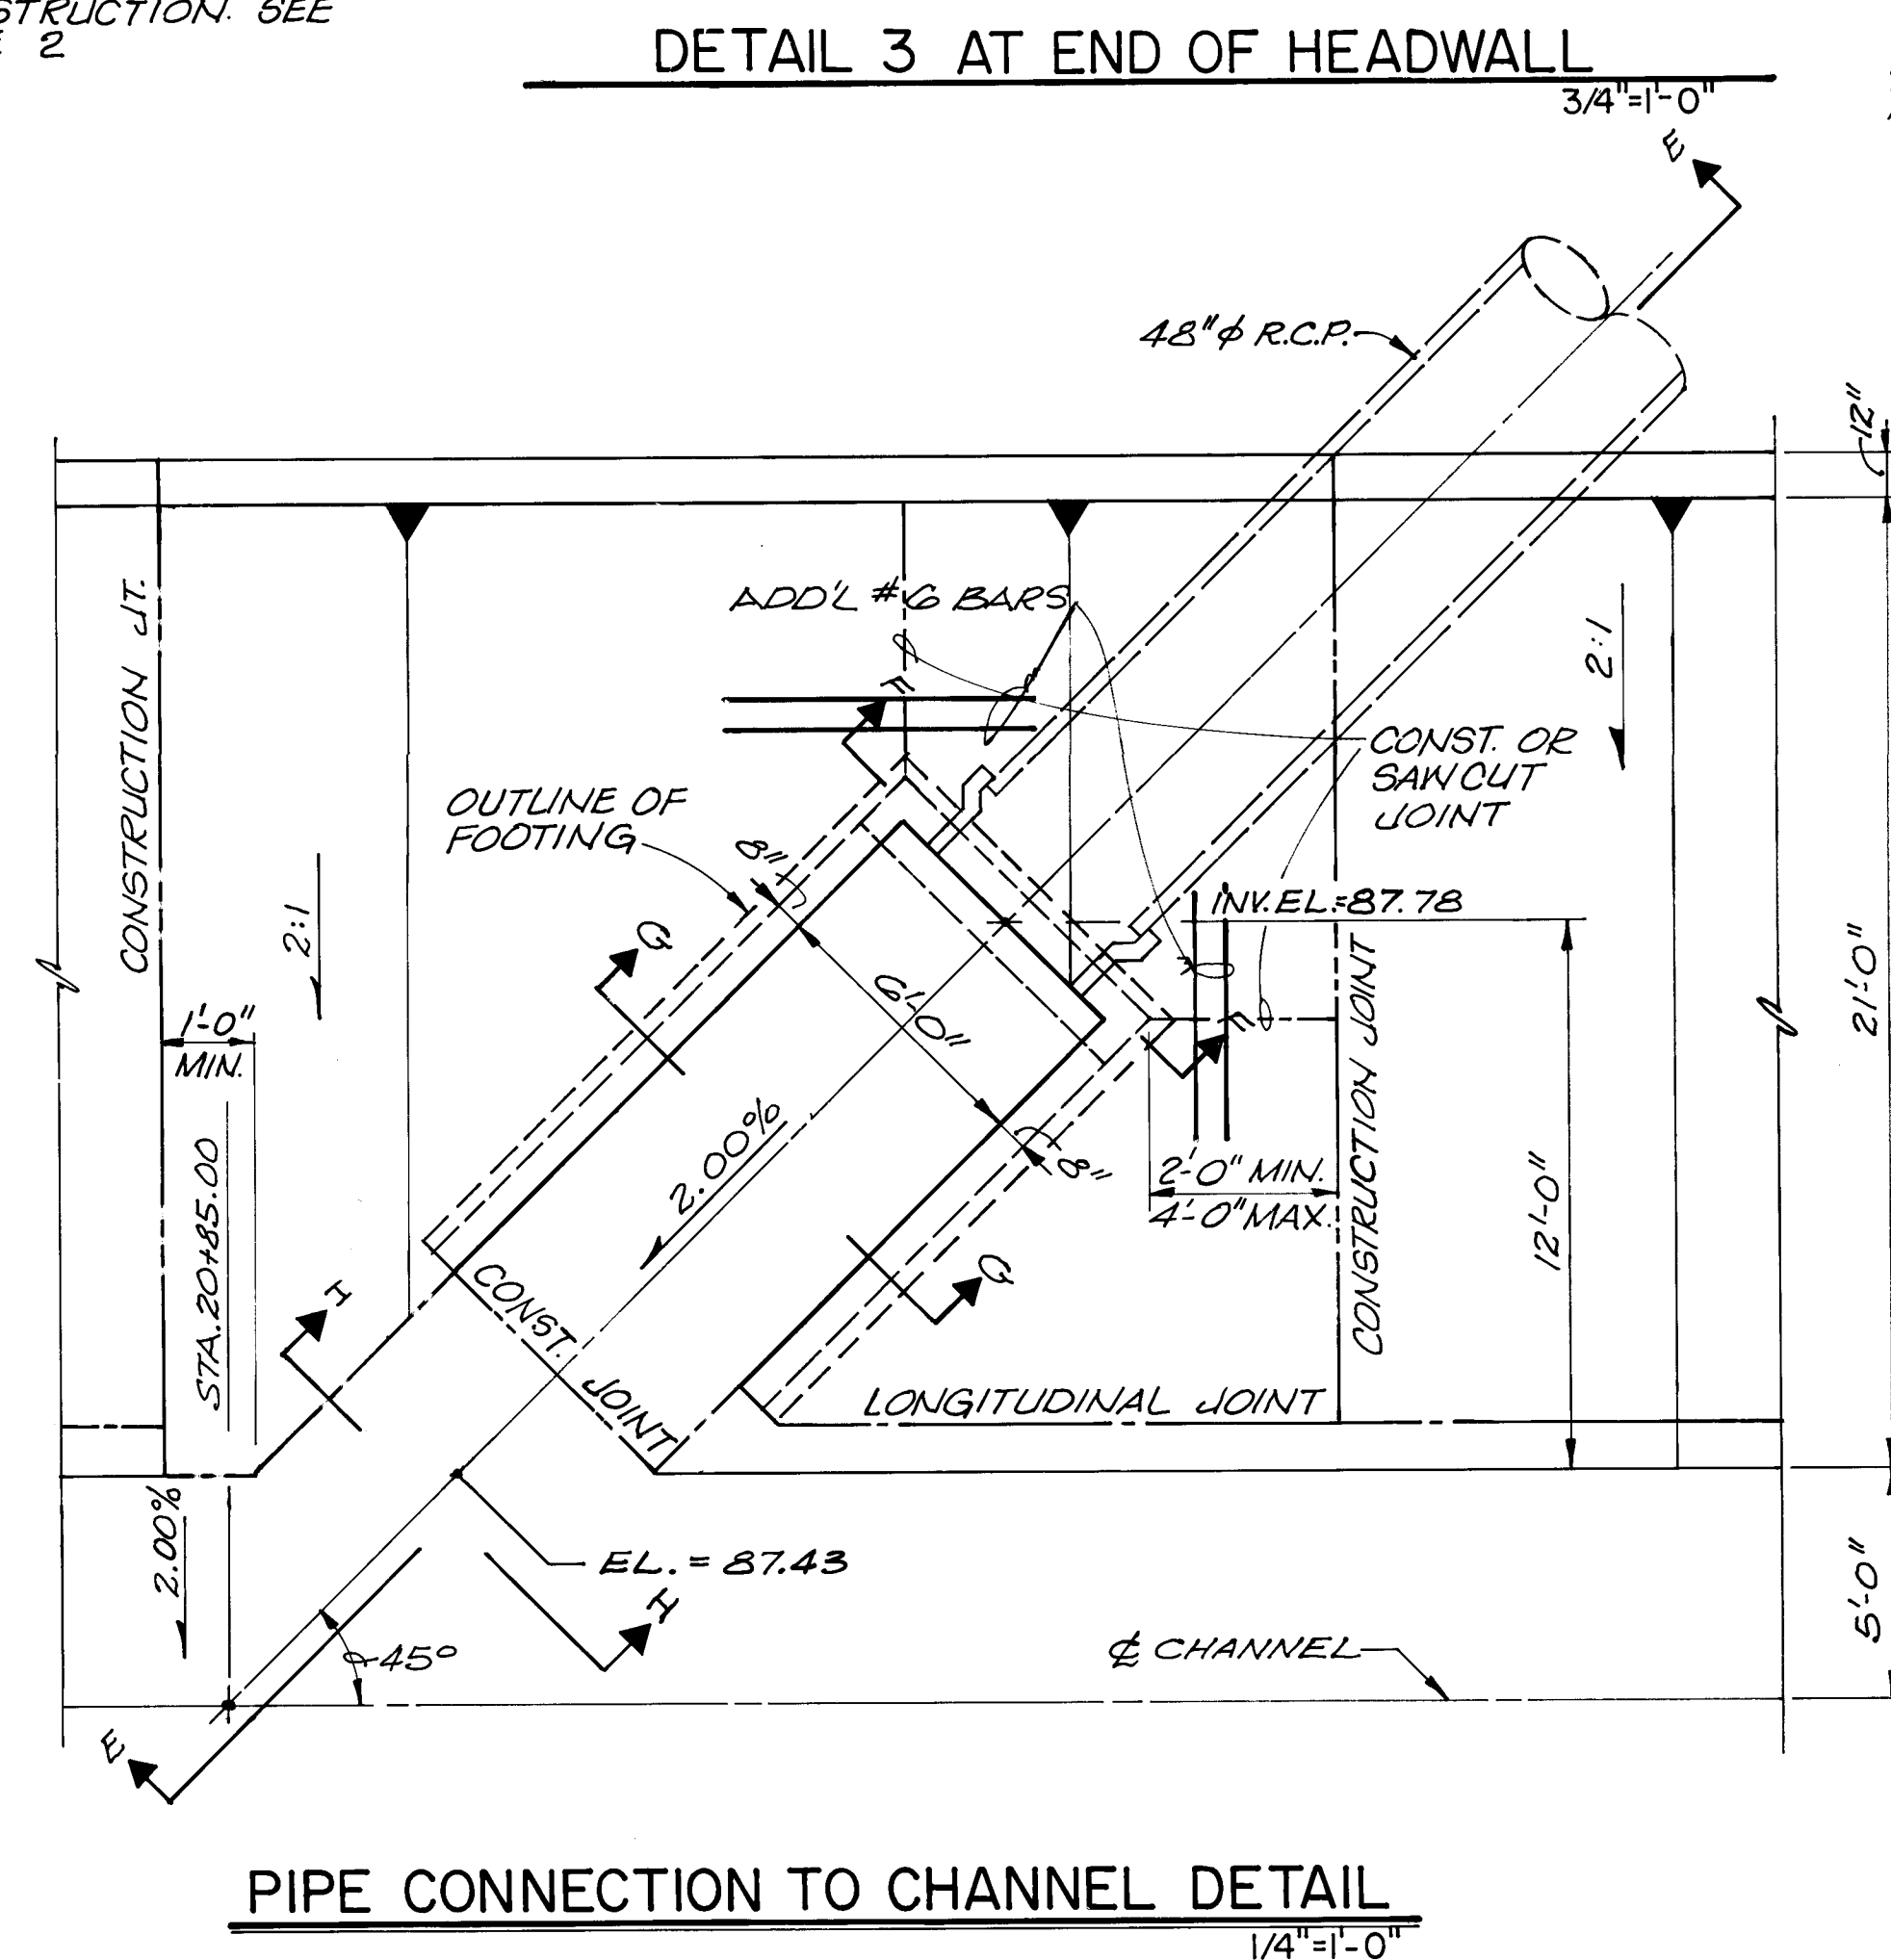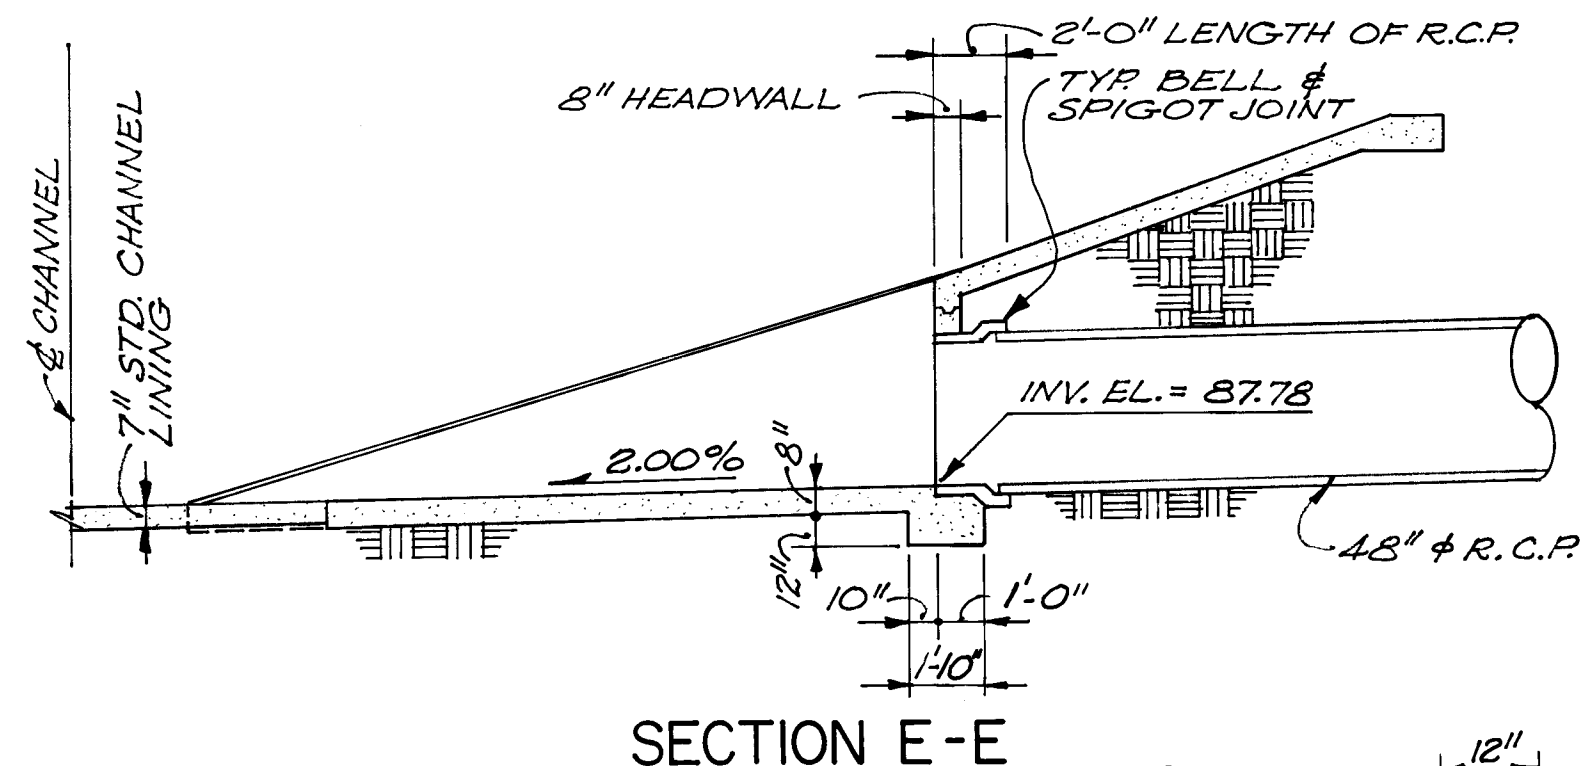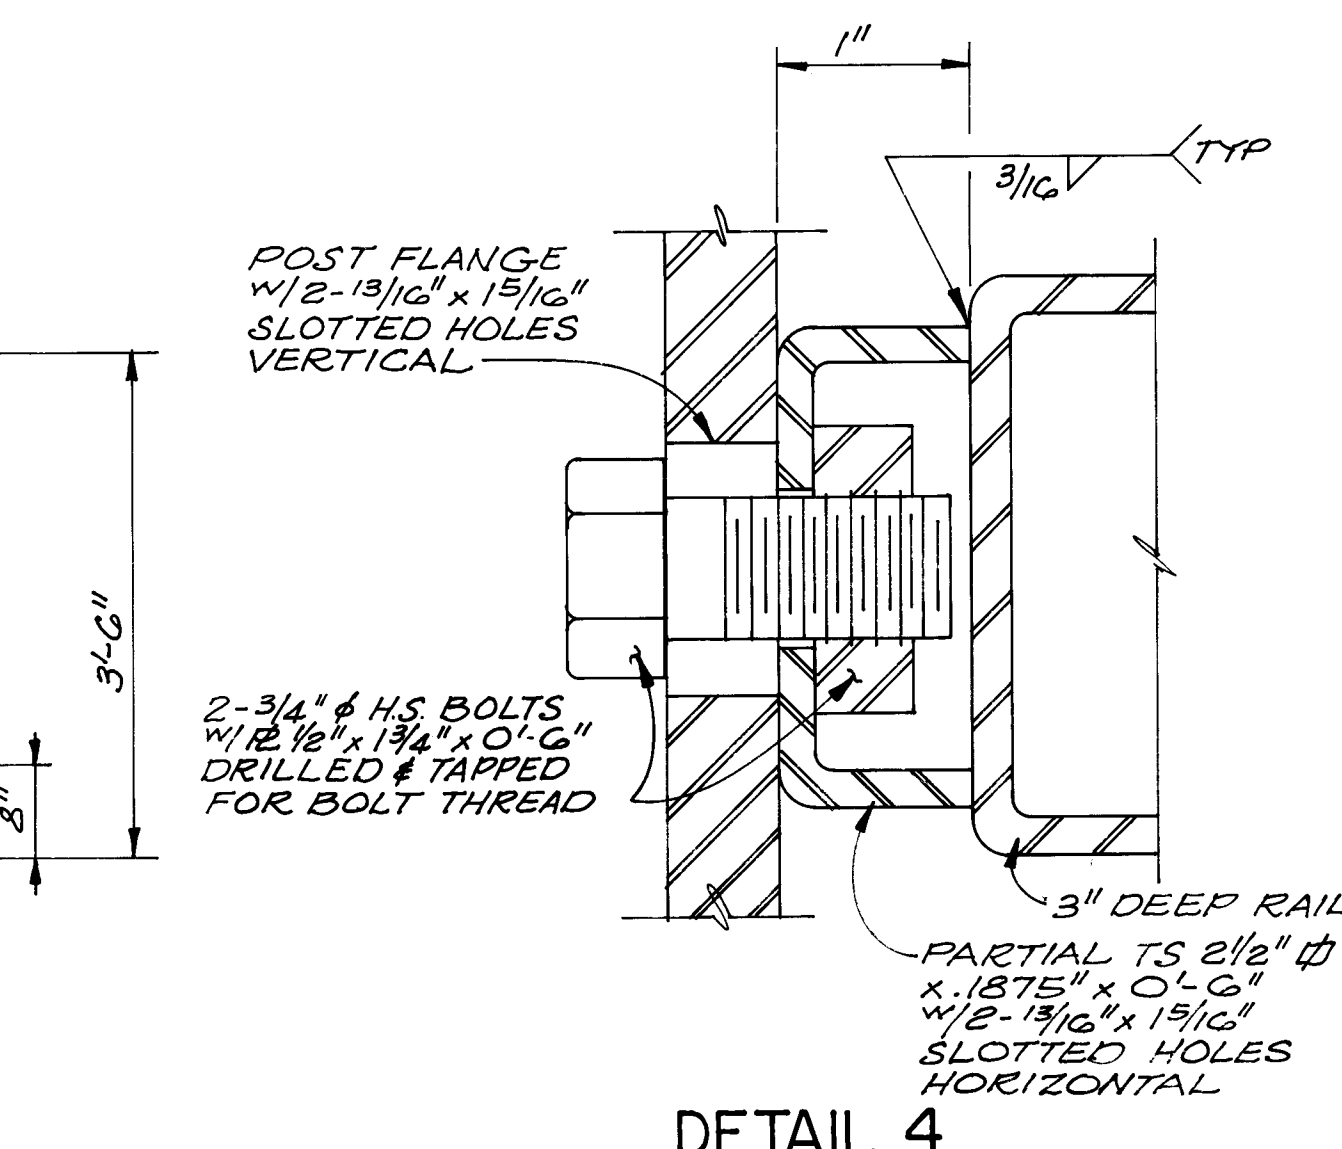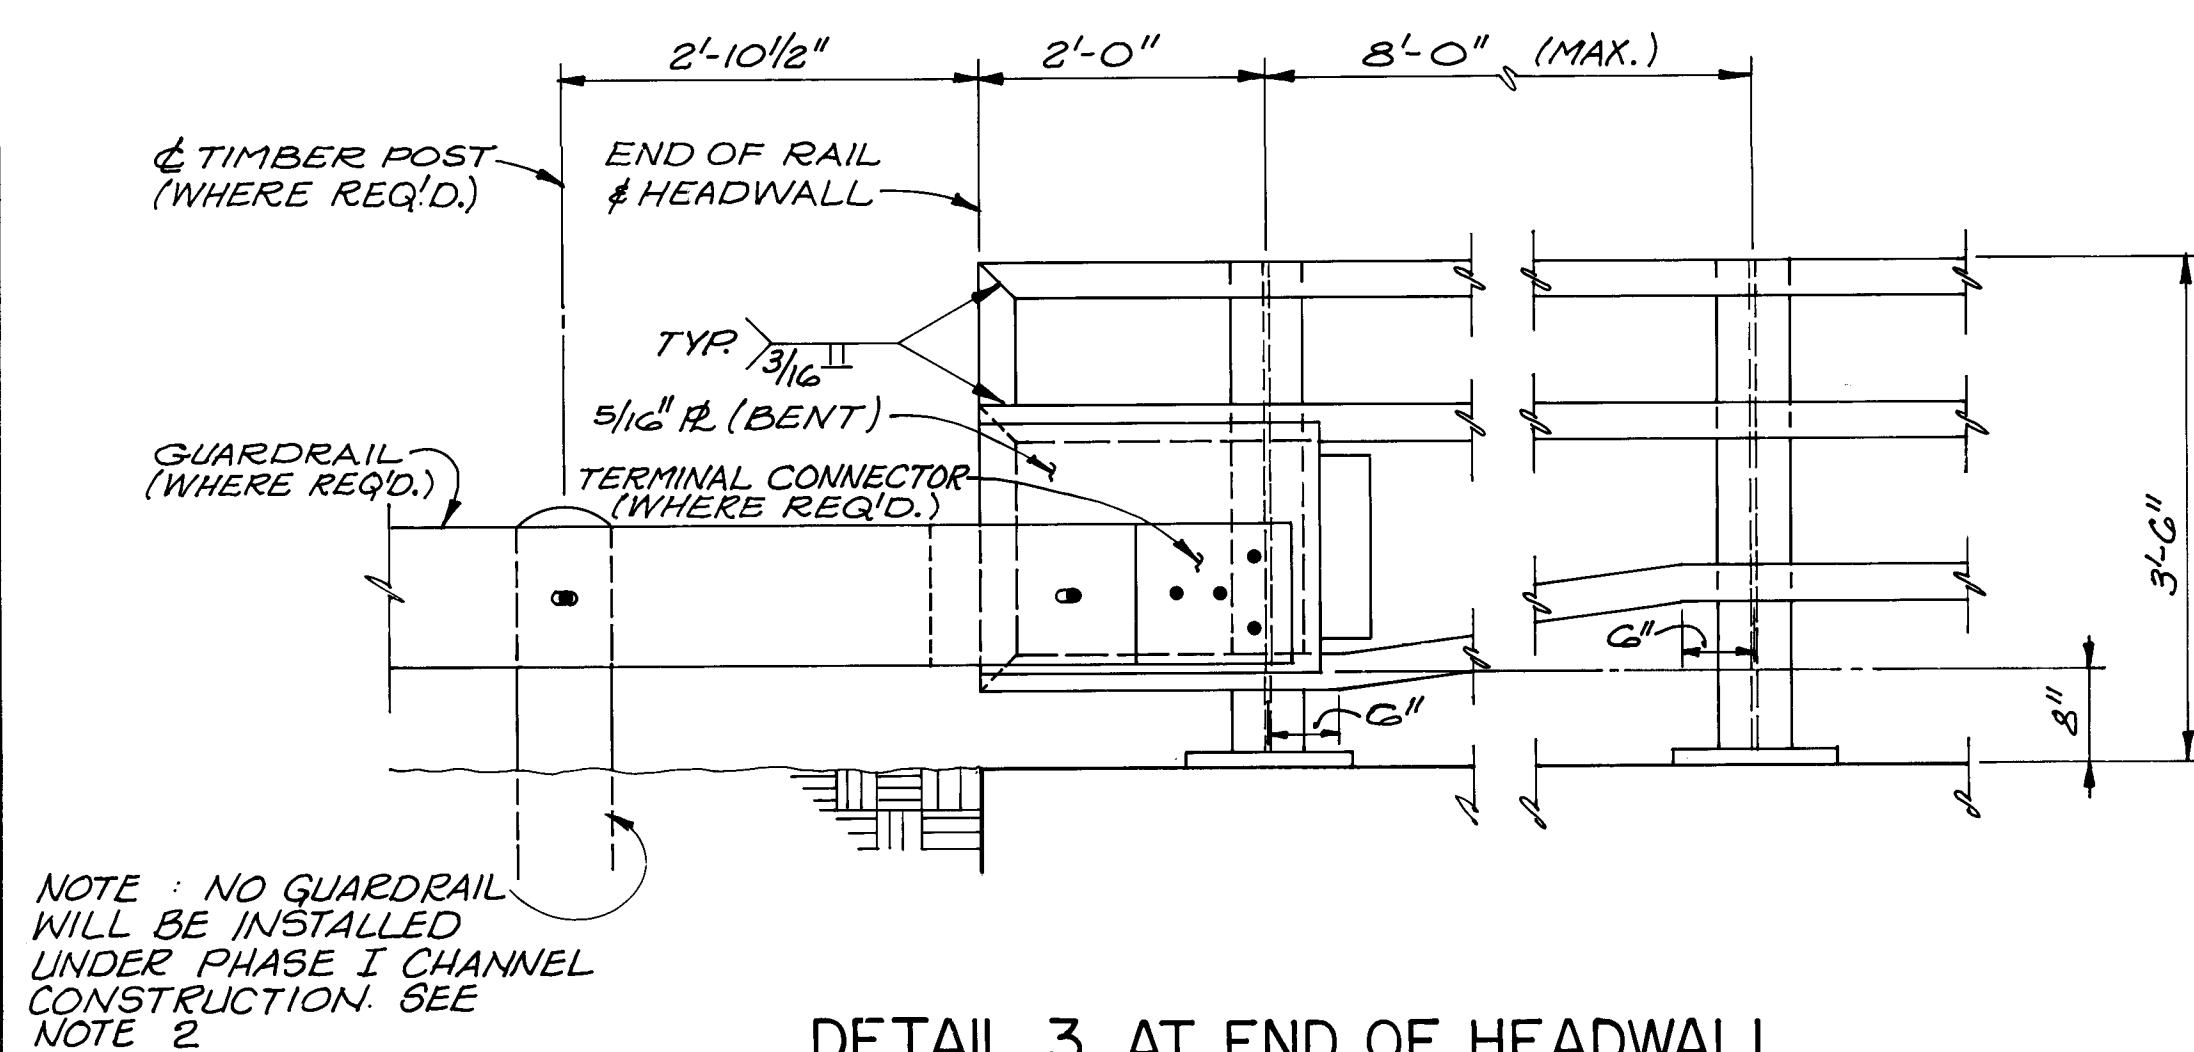

RECORD DRAWING

These record drawings apply only to those facilities constructed under the contract identified in the title block and have been prepared in part on the basis of information compiled and furnished by others. Boyle Engineering Corporation will not be responsible for errors or omissions which have been incorporated into this document as a result of the work by others.






26 24800887

CITY OF ALBUQUERQUE
MUNICIPAL DEVELOPMENT DEPARTMENT
ENGINEERING DIVISION

TITLE: TYPICAL CHANNEL DETAIL

AMOLE DEL NORTE STORM DIVERSION FACILITY					
APPROVALS		ENGINEER	DATE	APPROVALS	
		ENGINEER	DATE		
City Engineer		<i>[Signature]</i>	2/10/86	Liquid Waste	
A.C.E. - Design		<i>[Signature]</i>	1/29/86	Traffic	
A.C.E. -Hydrology		<i>[Signature]</i>	1/22/86	Water	

DRAWING NO.	2480	MAP NO.	SHEET 8 OF 21
-------------	------	---------	---------------

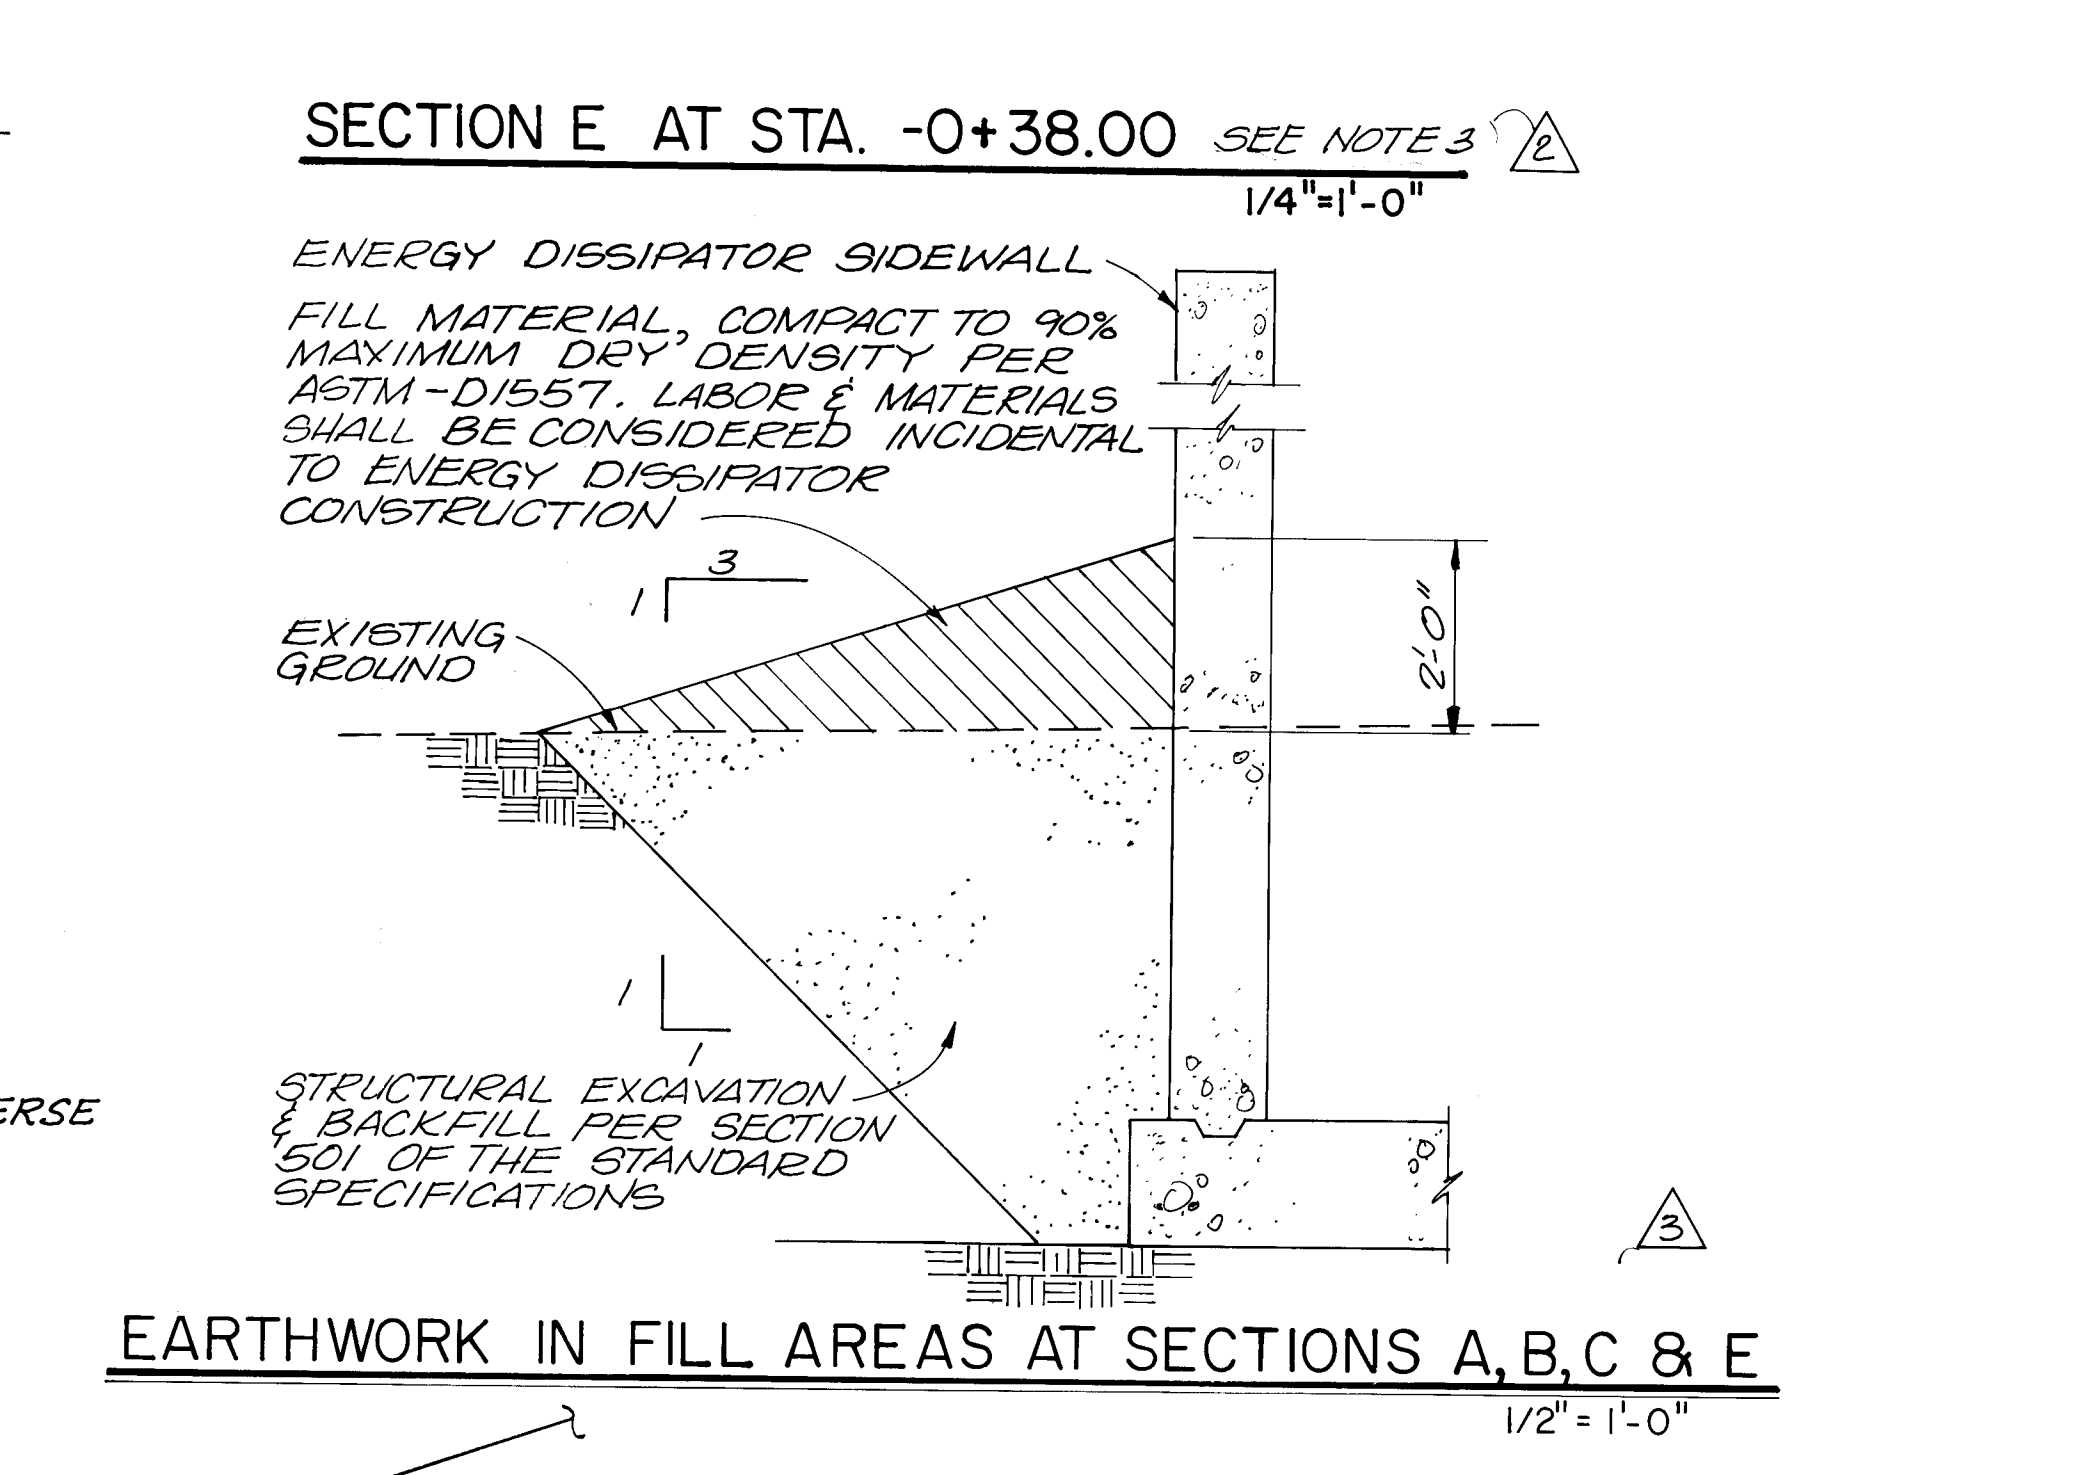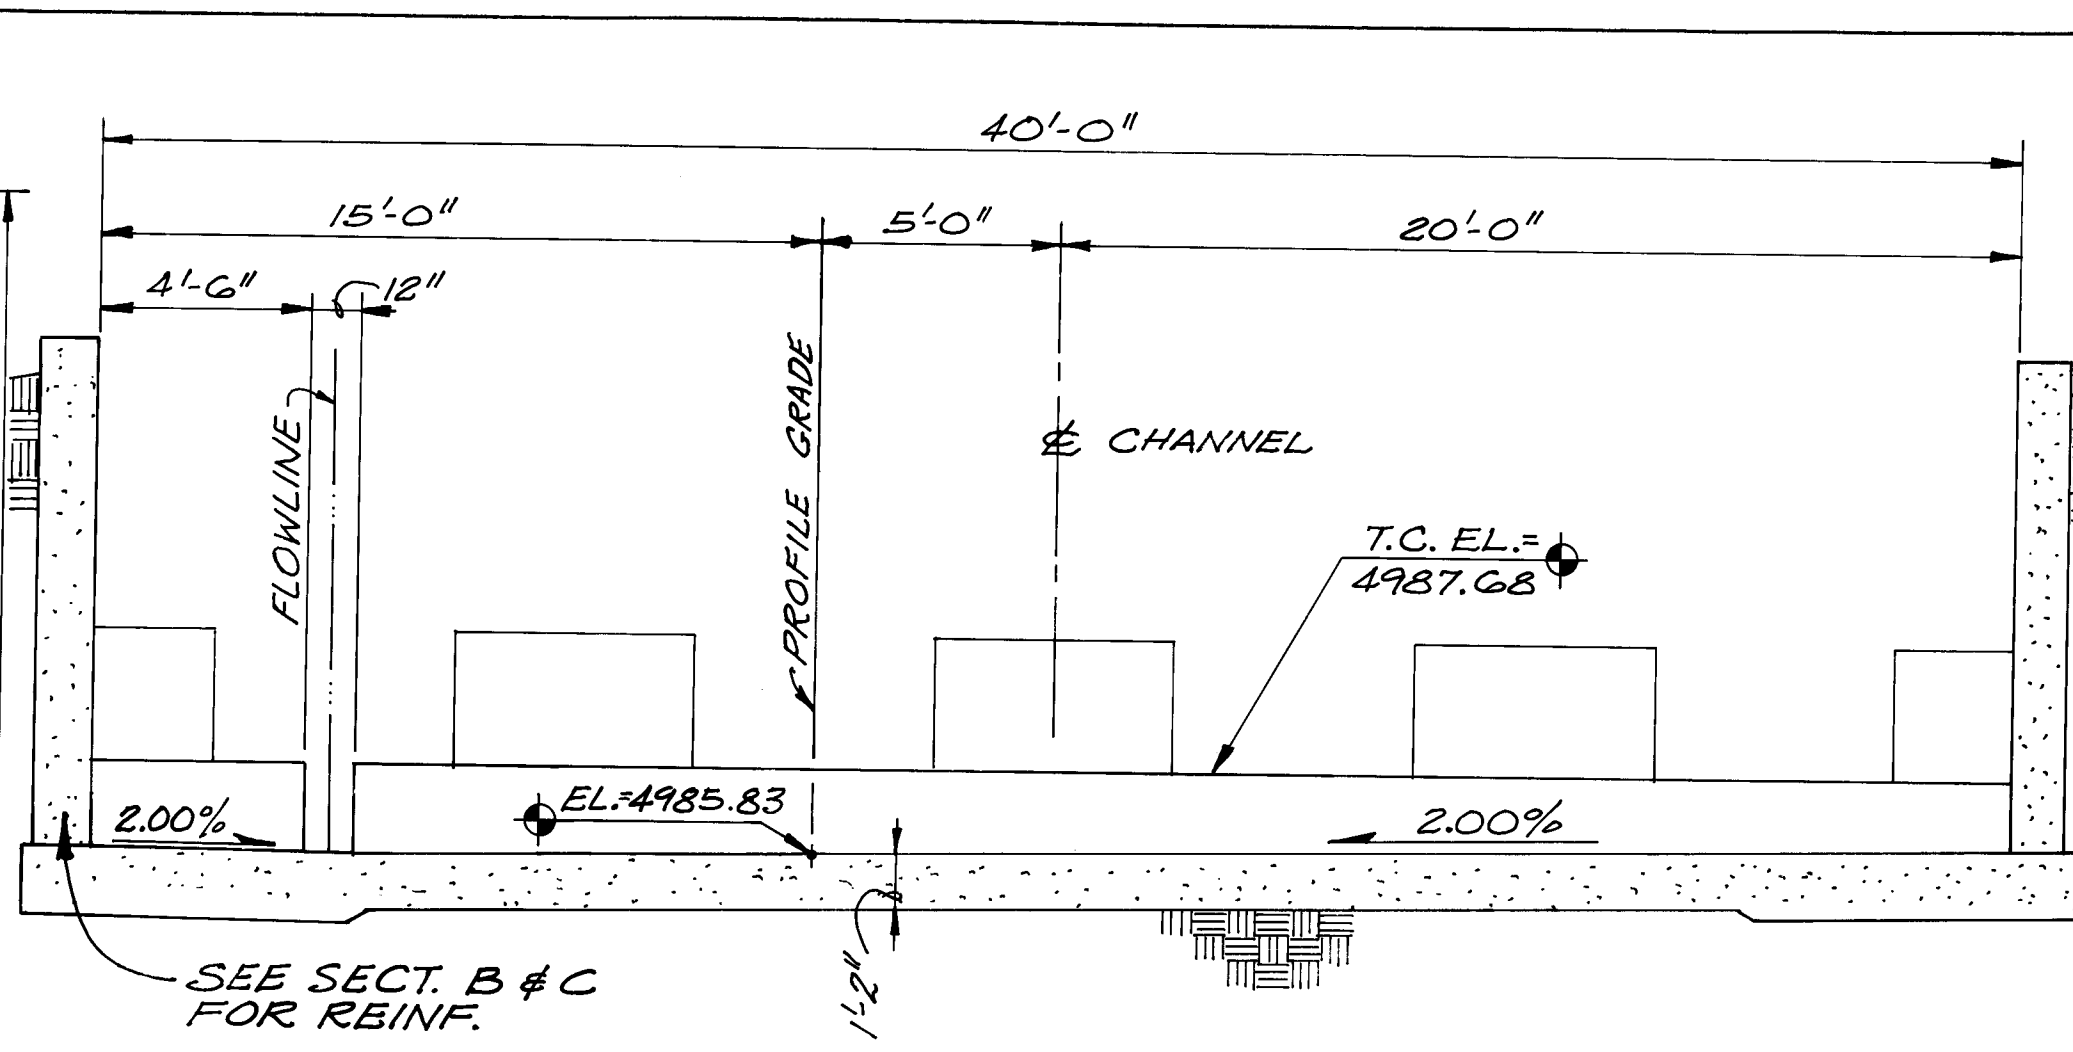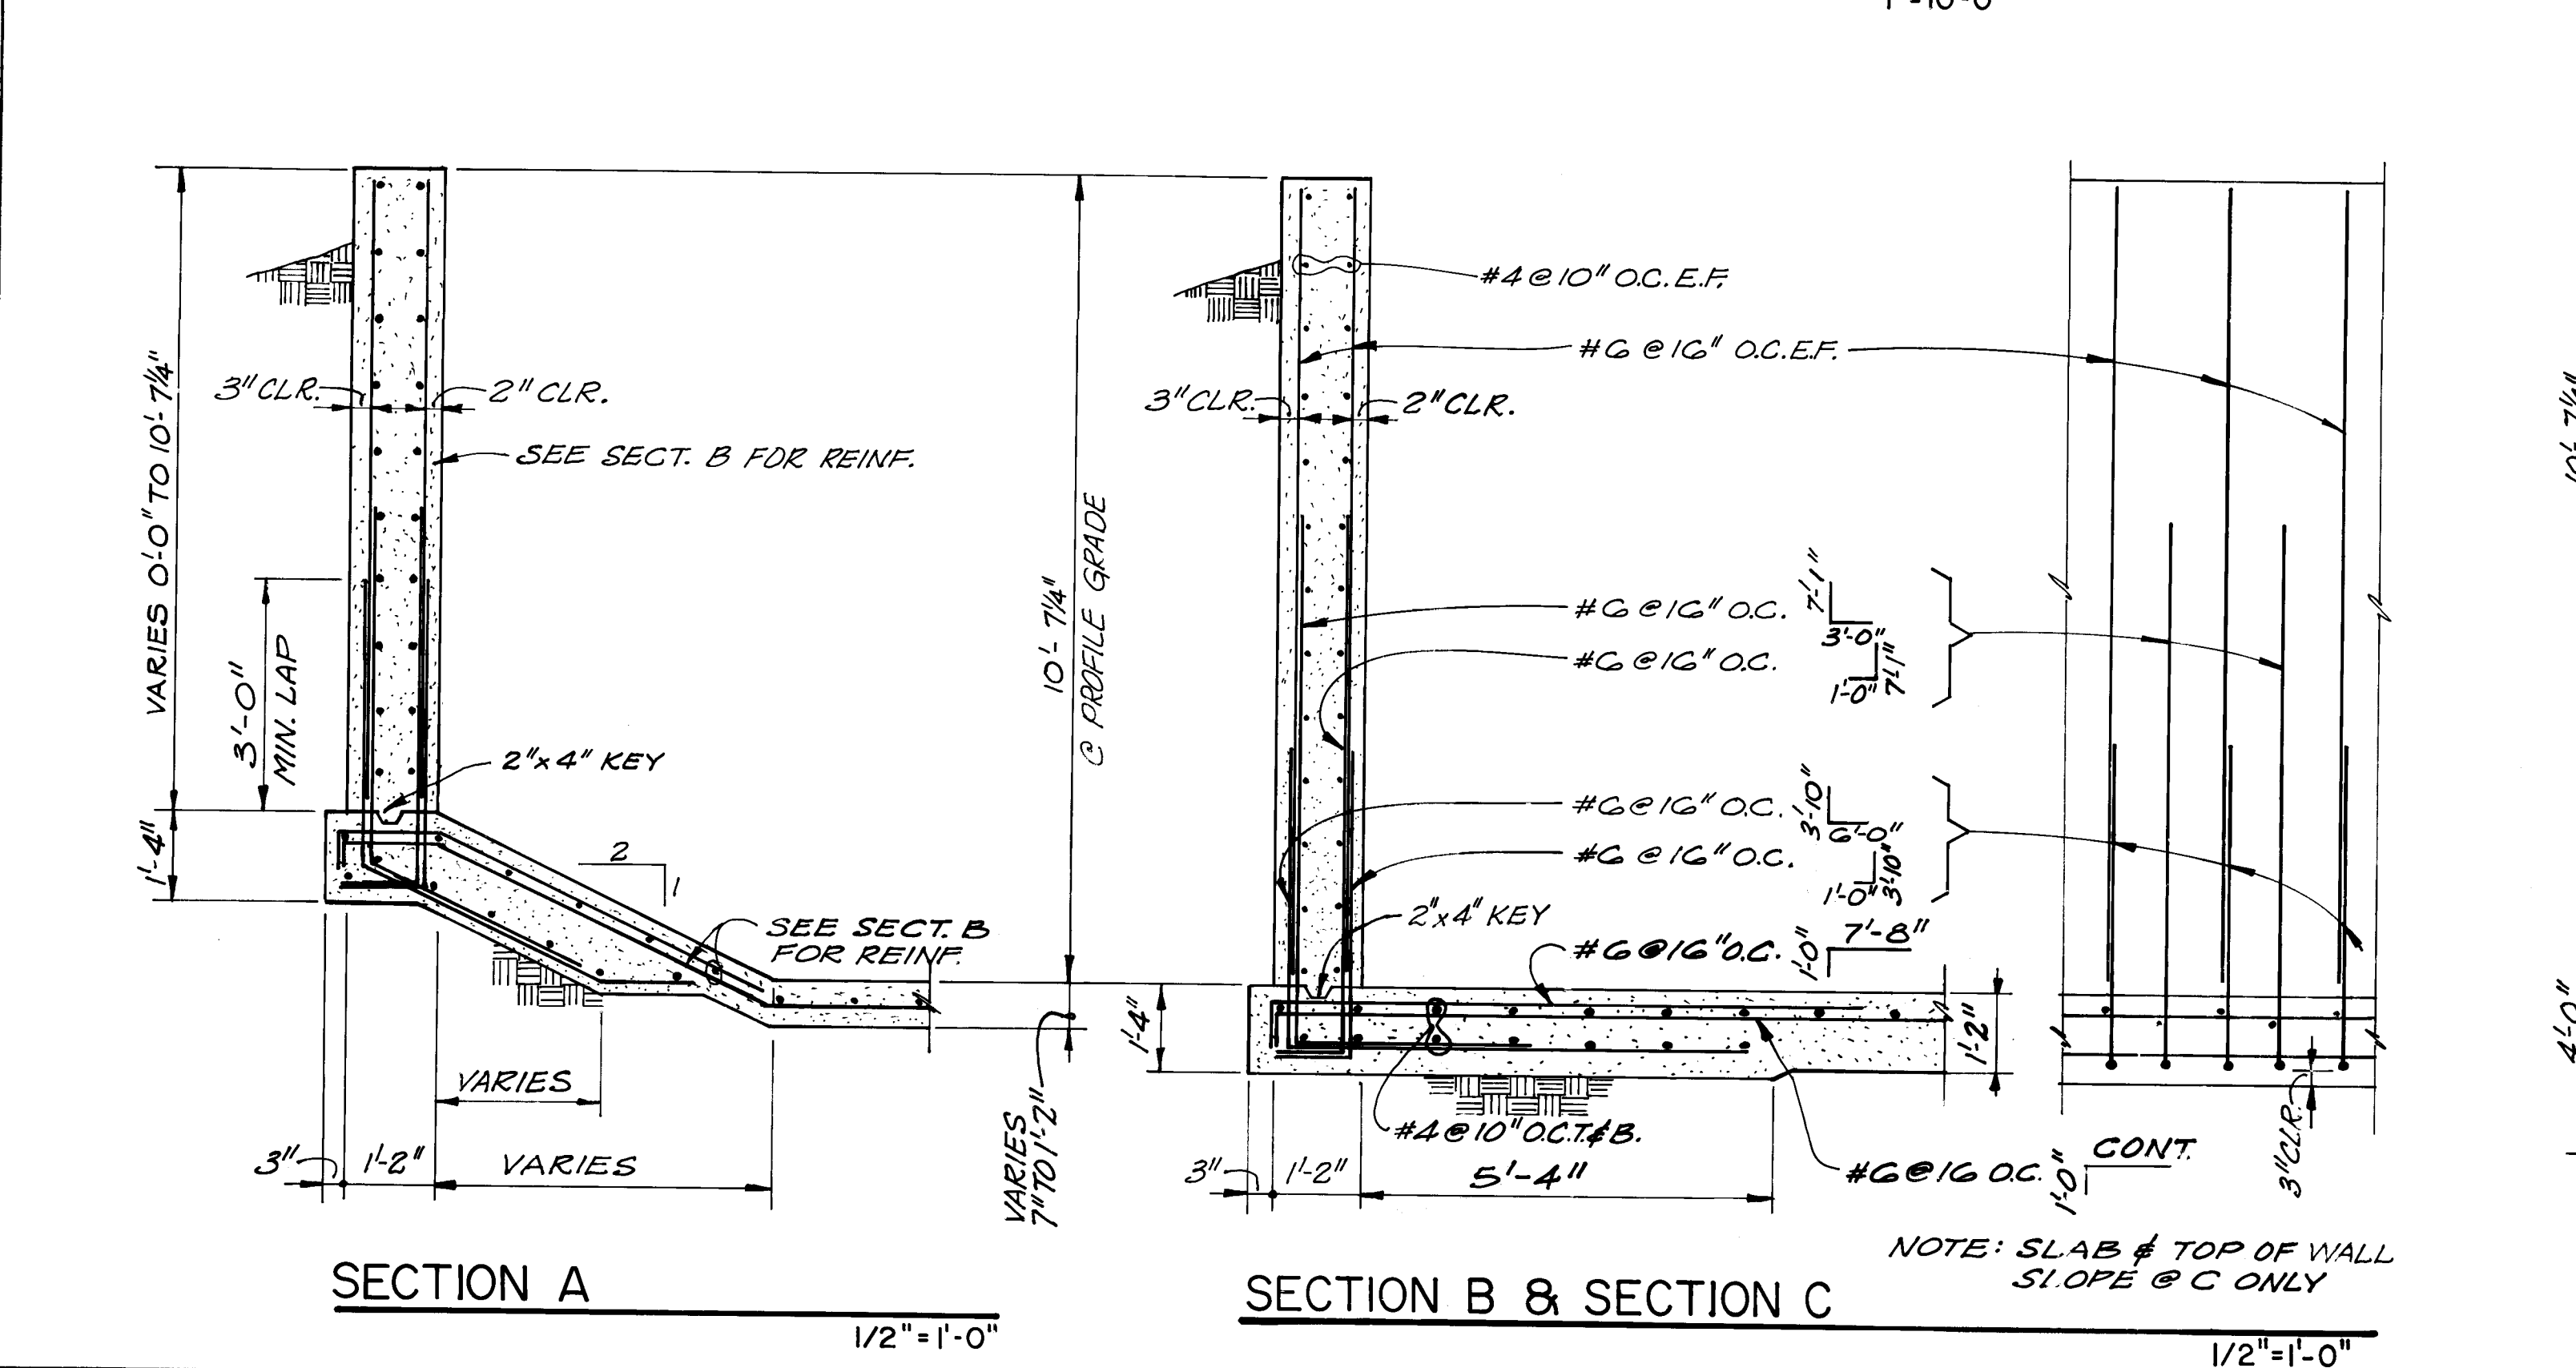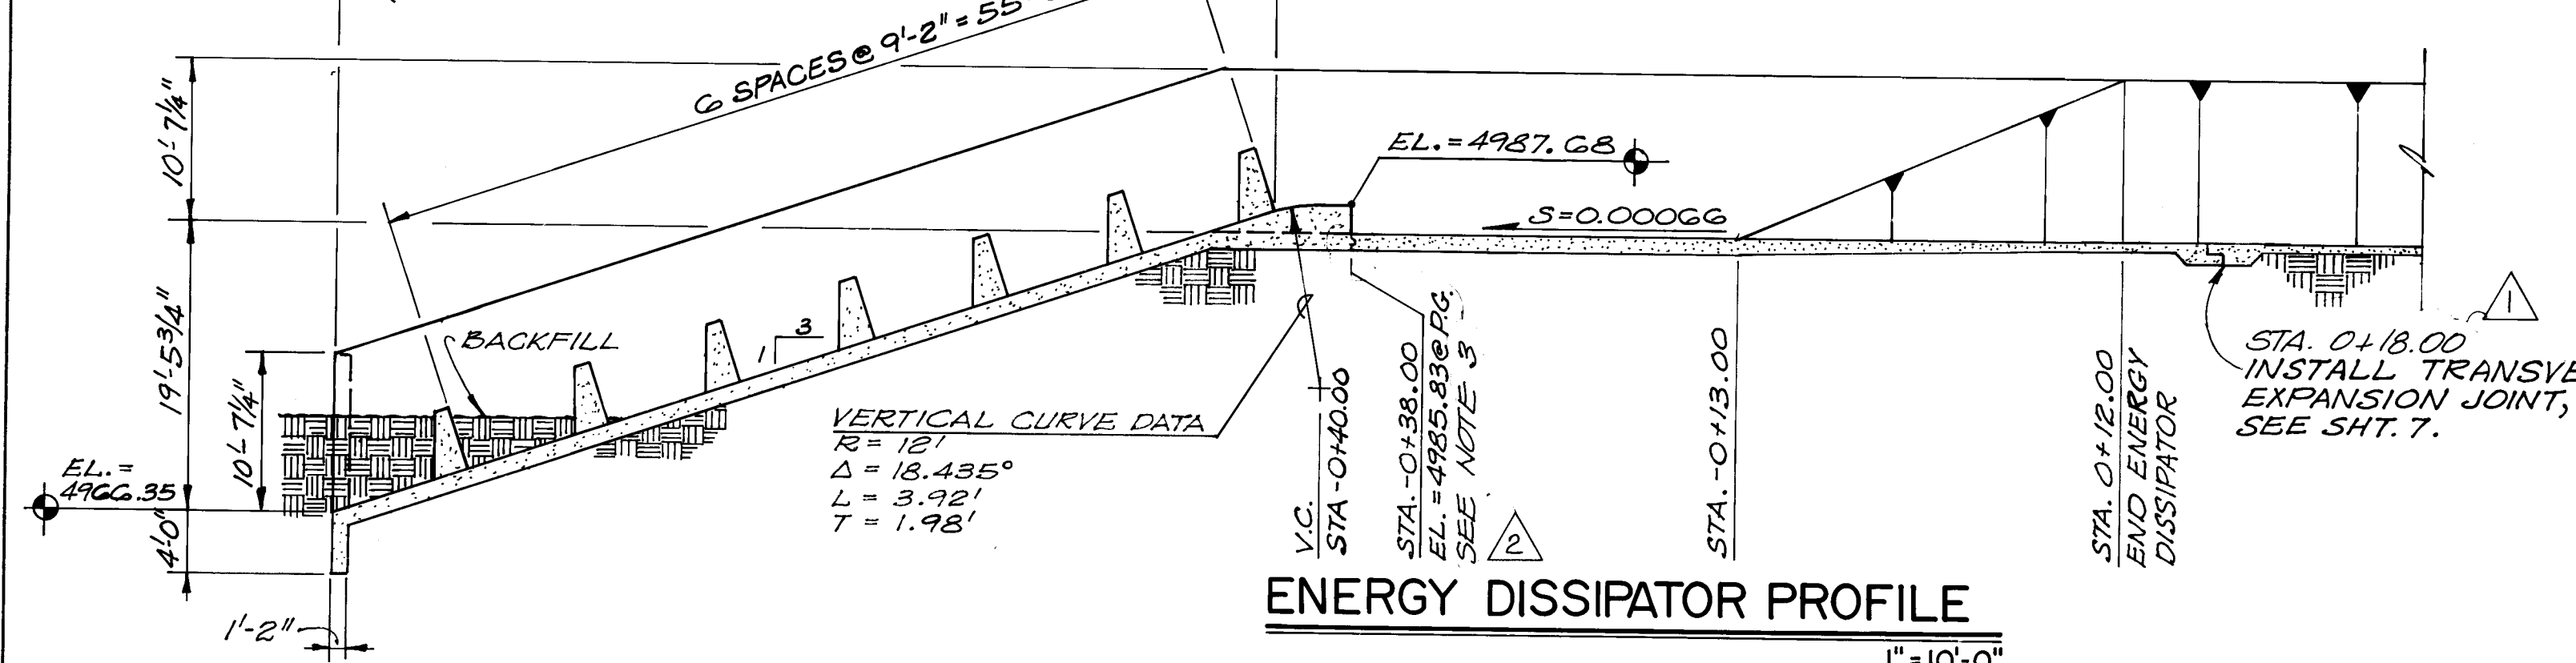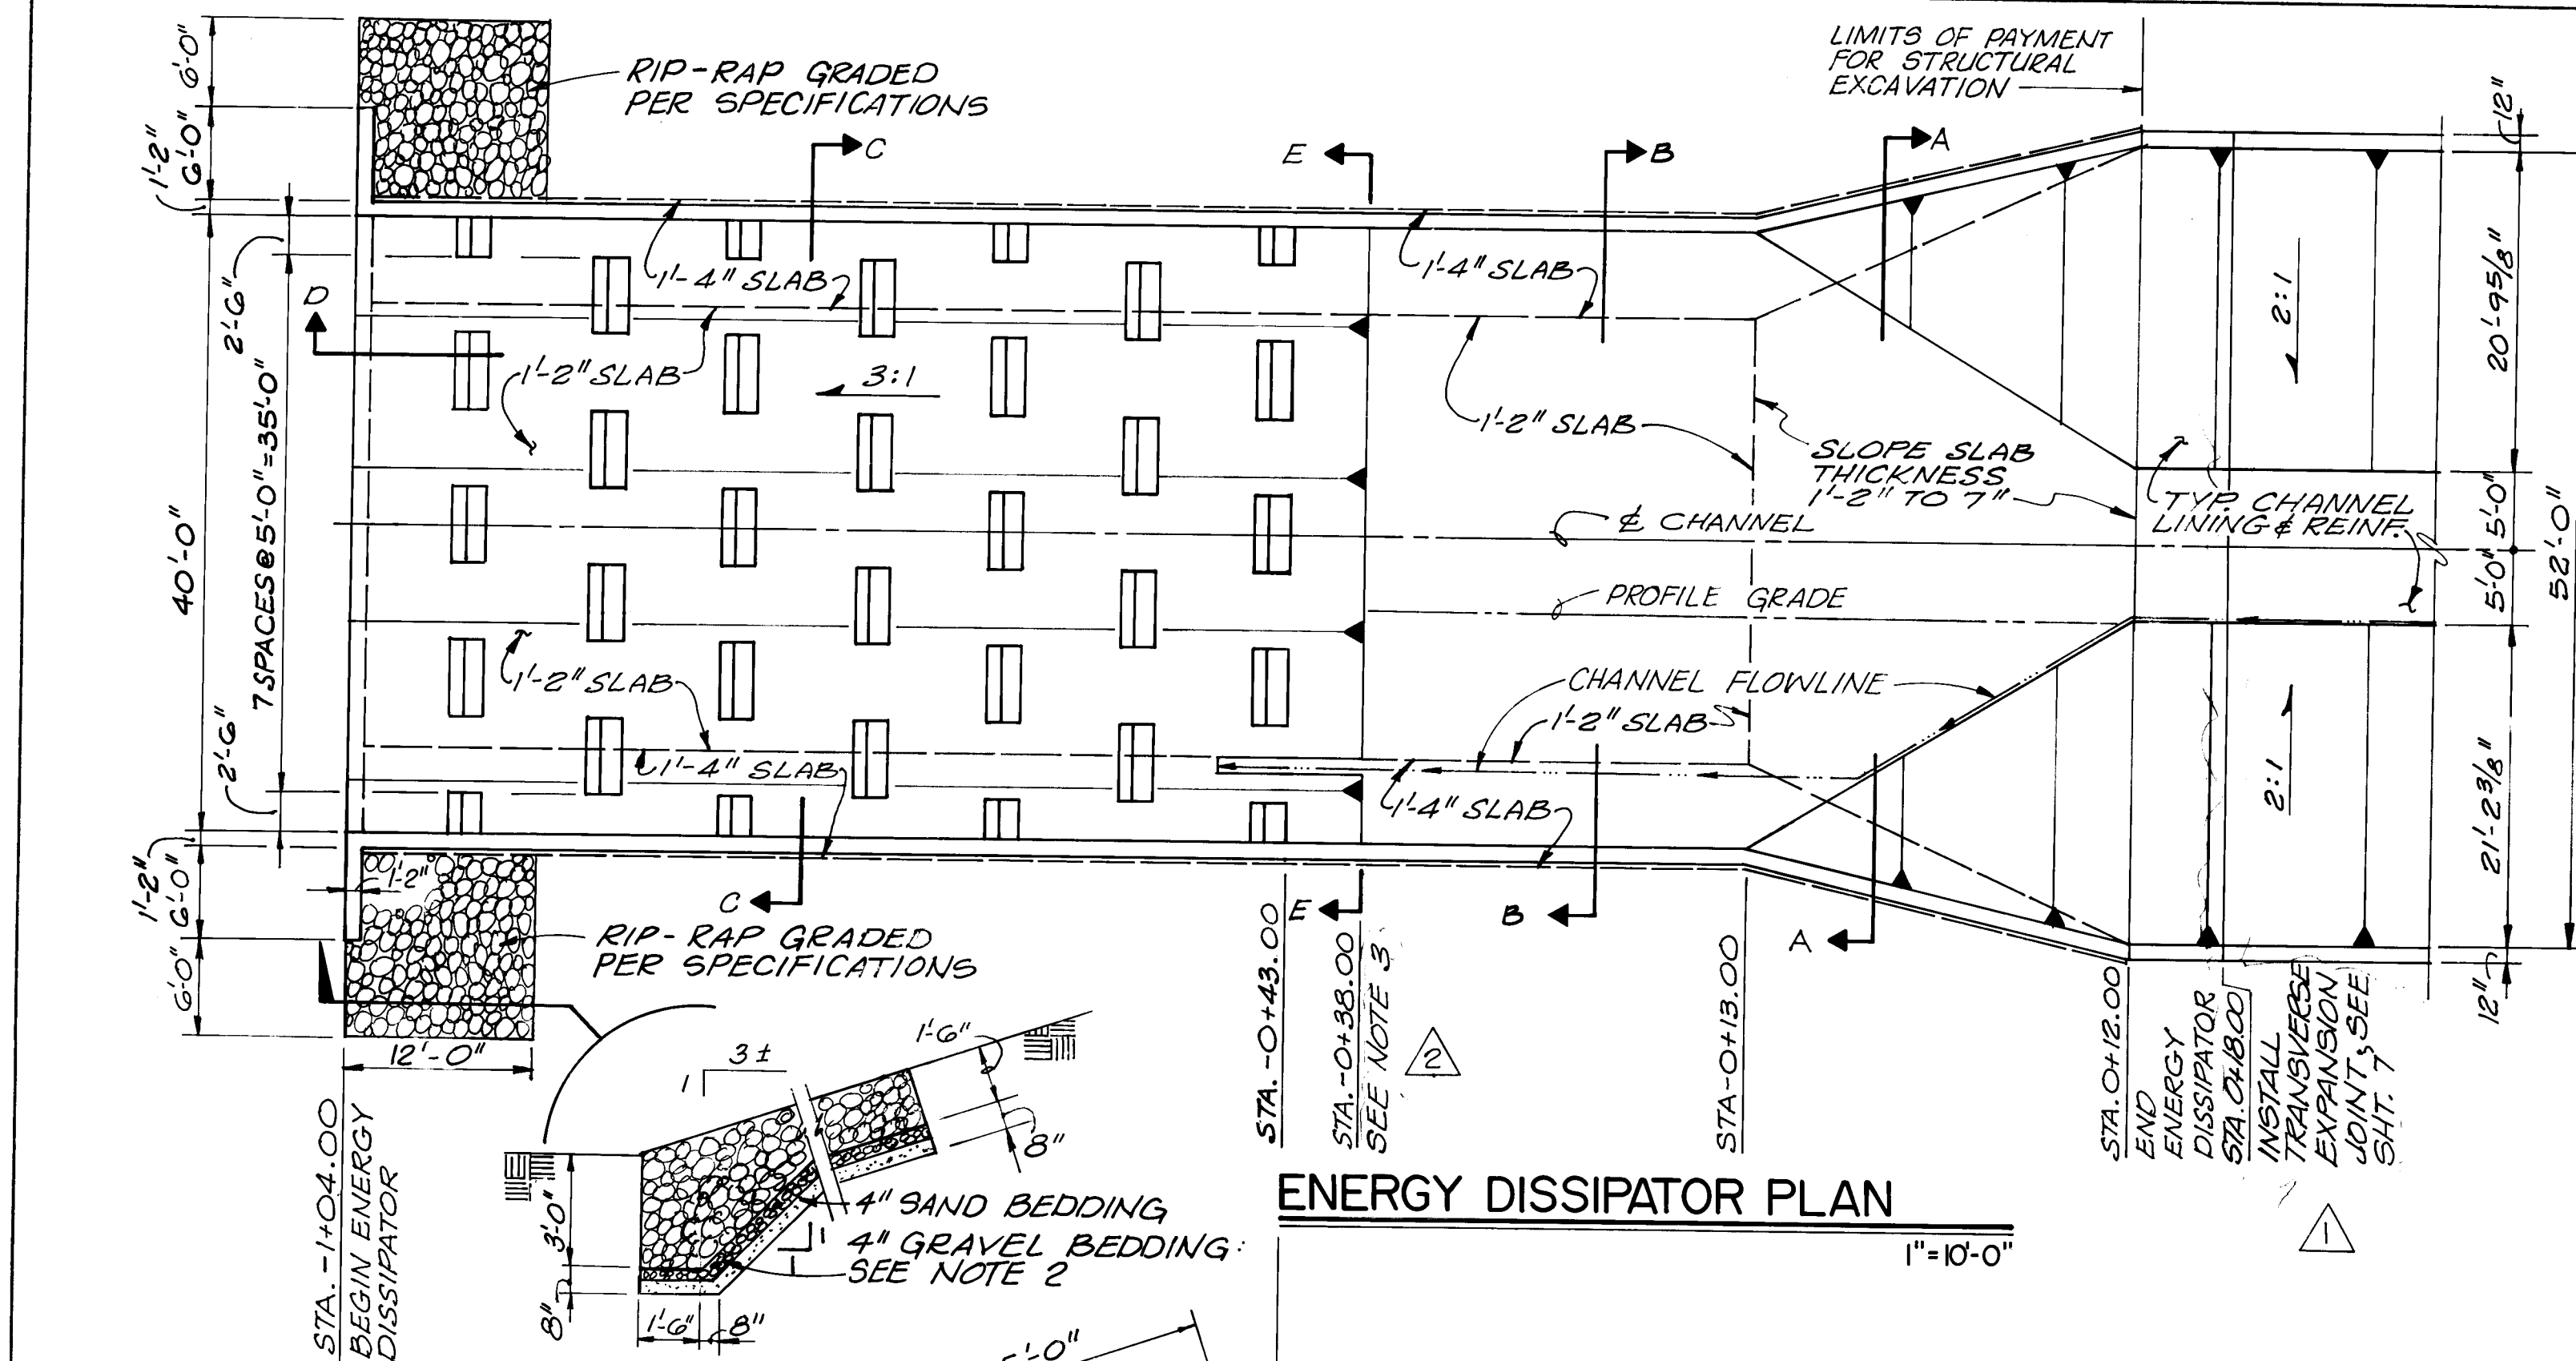

NOTES:

- ALL REINFORCING STEEL SHALL BE GRADE 60 & CONCRETE SHALL BE 4000 PSI @ 28 DAYS IN ACCORDANCE WITH THE STANDARD SPECIFICATIONS.
- RIP-RAP BEDDING SHALL CONSIST OF A GRAVEL TYPE FILTER MATERIAL. FILTER CLOTH BEDDING WILL NOT BE ALLOWED.

FILTER MATERIAL SHALL MEET THE FOLLOWING GRADATION REQUIREMENTS:

SAND BEDDING:

SIEVE SIZE	% PASSING
#4	100
#10	65-80
#200	0-5

GRAVEL BEDDING:

SIEVE SIZE	% PASSING
2"	100
1"	60-80
#4	20-30
#10	0-10

3. A CONSTRUCTION JOINT WAS USED BY THE CONTRACTOR AT THIS LOCATION. A "KEY" WAS CAST IN THE SOUTH FACE OF THE JOINT BUT THE 3/8" x 6" BUEKE KEYLOCK PVO WATERSTOP RECOMMENDED BY THE ENGINEER WAS NOT USED. CONCRETE IN THE NEXT POUR WAS CAST DIRECTLY AGAINST THIS JOINT.

RECORD DRAWING

26 2480 1087


CITY OF ALBUQUERQUE
MUNICIPAL DEVELOPMENT DEPARTMENT
ENGINEERING DIVISION

TITLE: ENERGY DISSIPATOR DETAILS

AMOLE DEL NORTE STORM DIVERSION FACILITY

APPROVALS	ENGINEER	DATE	APPROVALS	ENGINEER	DATE
City Engineer	ALC	2/10/06	Liquid Waste	R.P.	1/22/06
A.C.E. - Design	ALC	1/22/06	Traffic	N/A	1/22/06
A.C.E. - Hydrology	K. K. Loyola	1/22/06	Water	R. P.	1/22/06

DRAWING NO. 2480 **MAP NO. N-10** **SHEET 10 OF 21**

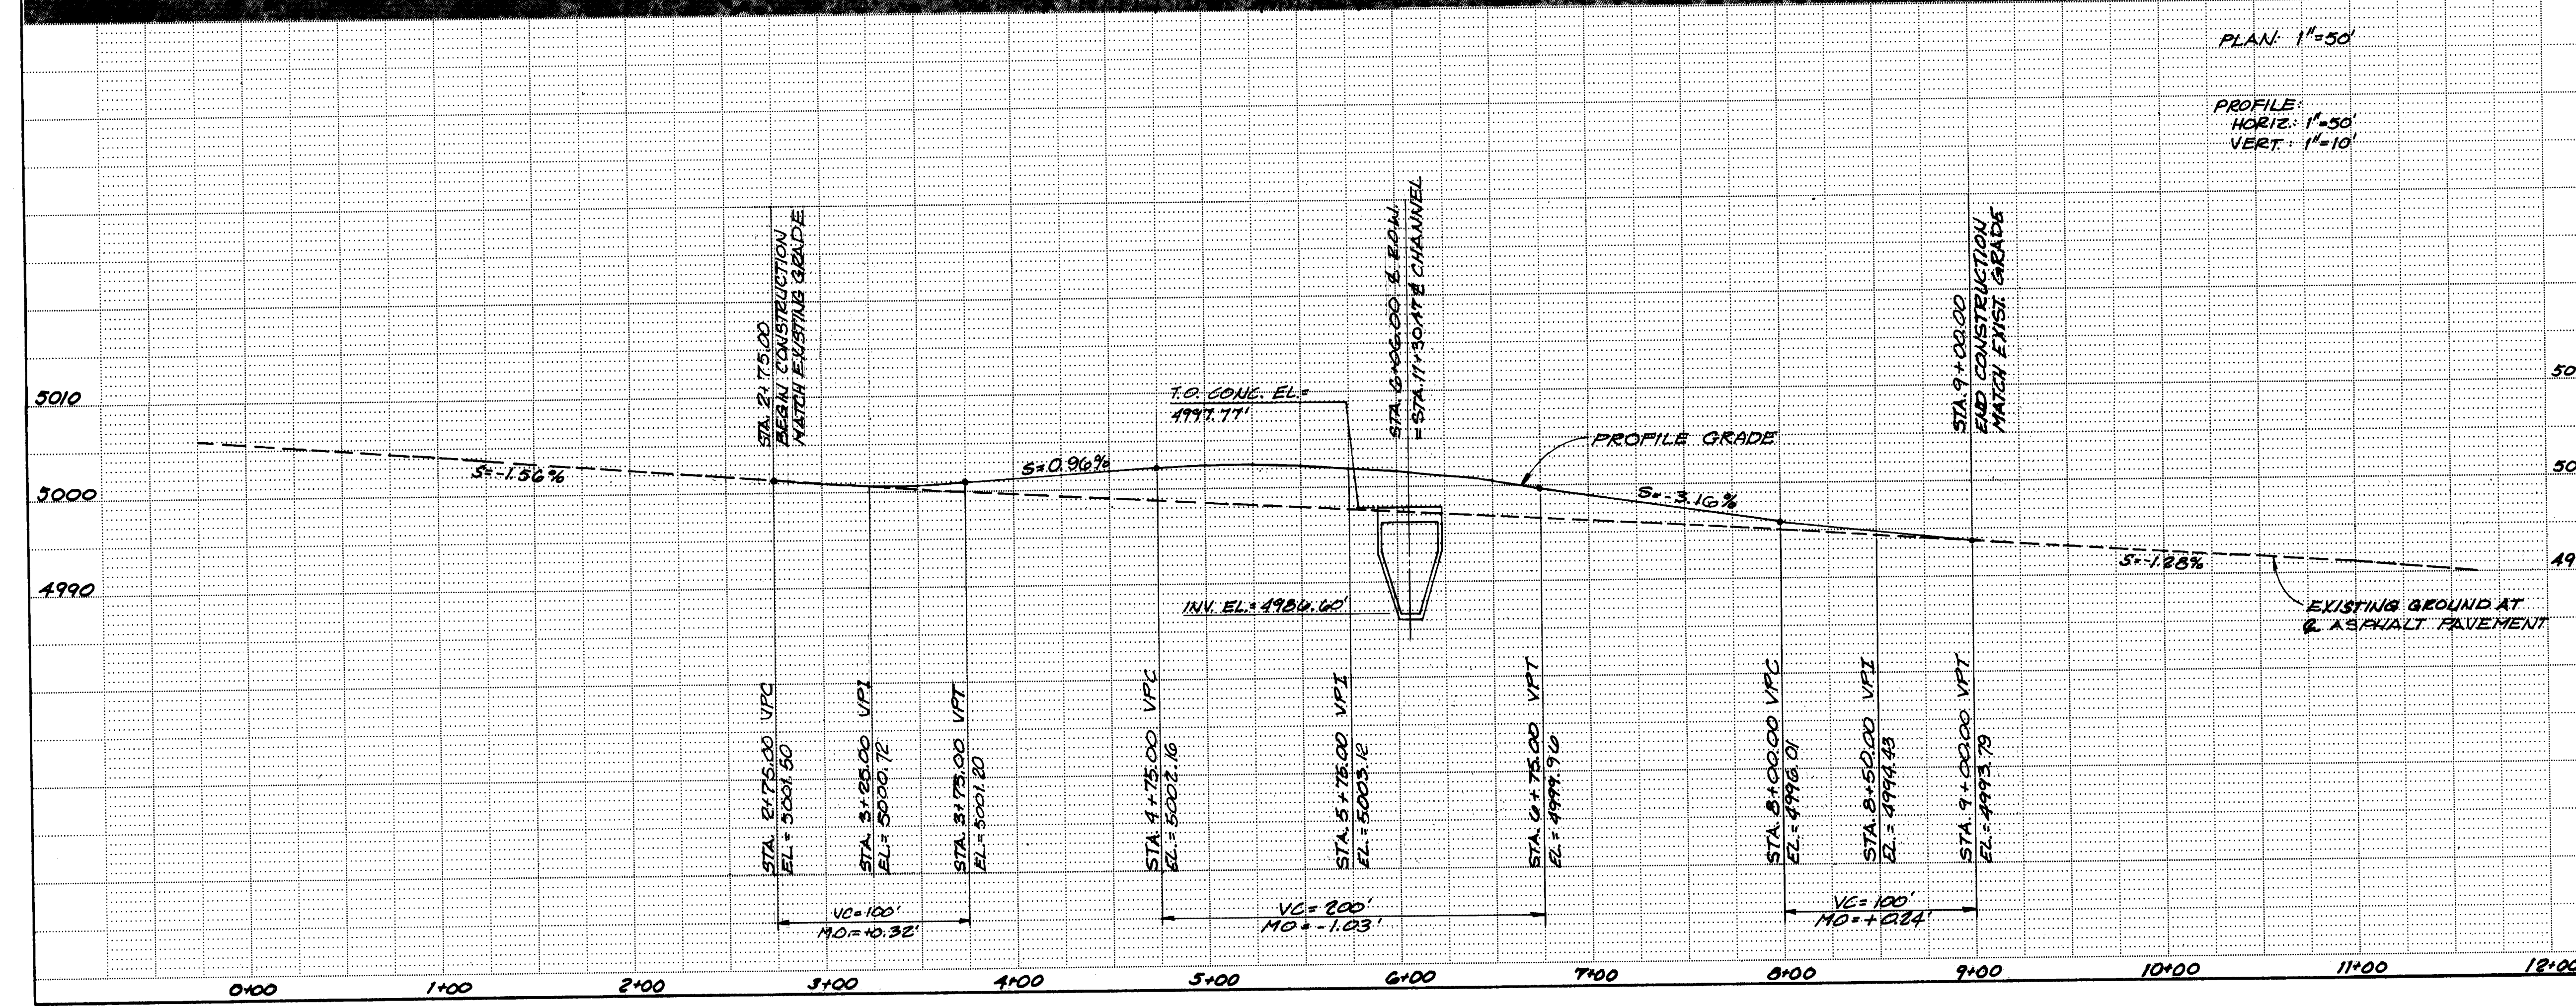

NOTES:

- BLAKE ROAD CENTERLINE STATIONS APPLY TO & FUTURE R.O.W. & OF PAVEMENT IS OFFSET. DISTANCES SHOWN ON CROSS-SECTION. SEE TYPICAL PAVING SECTION SHEET 9.
- SEWER AND WATERLINE STUD-OUTS ARE STATIONED WEST AND EAST. SEE UTILITY PROFILES, SHEET 1A FOR STATION EQUATION.
- CONTRACTOR SHALL MAINTAIN ACCESS TO EXISTING MOBILE HOME PARK (STA. 3+90±) AT ALL TIMES.
- COORDINATES, DISTANCES, AND BEARINGS ARE REFERENCED TO THE NEW MEXICO STATE PLANE SYSTEM (CENTRAL ZONE). GROUND DISTANCES CAN BE OBTAINED BY DIVIDING THE REPORTED GRID DISTANCES SHOWN ON THE DRAWINGS BY THE CONVERSION FACTOR 0.999677785.
- EXISTING BLAKE ROAD PAVEMENT SHALL BE REMOVED WITHIN THE LIMITS OF CONSTRUCTION, STA. 2+75 TO STA. 9+00. PAYMENT FOR REMOVAL AND DISPOSAL SHALL BE INCLUDED IN PAYMENT FOR NEW ASPHALT CONCRETE PAVEMENT.
- VERTICAL CONTROL POINT (REBAR SET IN CONCRETE) "AMOLE B" X=359,437± Y=1,469,362±

RECORD DRAWING

These record drawings apply only to those facilities constructed under the contract identified in the title block and shall not be used, in part or in whole, for any other project without the written approval of the City of Albuquerque. Any use of these drawings for any other project without the written approval of the City of Albuquerque shall be at the user's sole risk.


**CITY OF ALBUQUERQUE
MUNICIPAL DEVELOPMENT DEPARTMENT
ENGINEERING DIVISION**

TITLE: BLAKE ROAD PLAN & PROFILE

AMOLE DEL NORTE STORM DIVERSION FACILITY


APPROVALS	ENGINEER	DATE	APPROVALS	ENGINEER	DATE
City Engineer	<i>[Signature]</i>	1/22/06	Liquid Waste	<i>[Signature]</i>	1/22/06
A.C.E. Design	<i>[Signature]</i>	1/22/06	Traffic	<i>[Signature]</i>	1/22/06
A.C.E. Hydrology	<i>[Signature]</i>	1/22/06	Water	<i>[Signature]</i>	1/22/06

DRAWING NO. 2480 **MAP NO. N-10** **SHEET 11 OF 21**

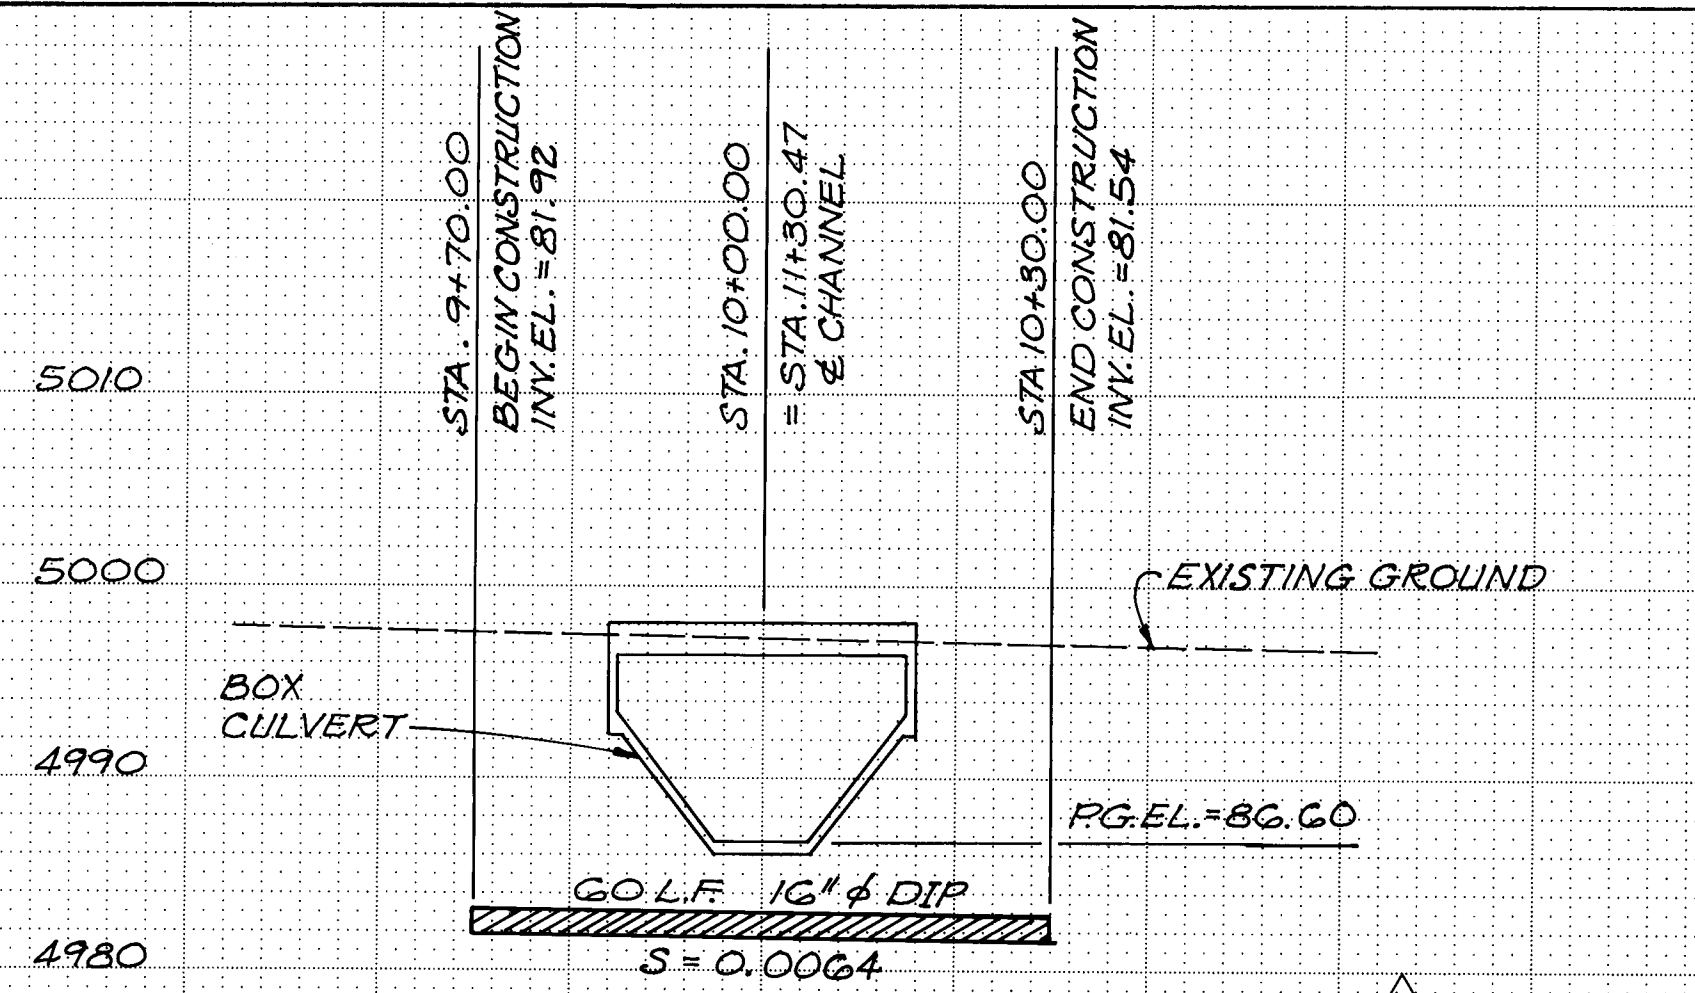


BLAKE ROAD SEWER STUB-OUT

SEE NOTE 1

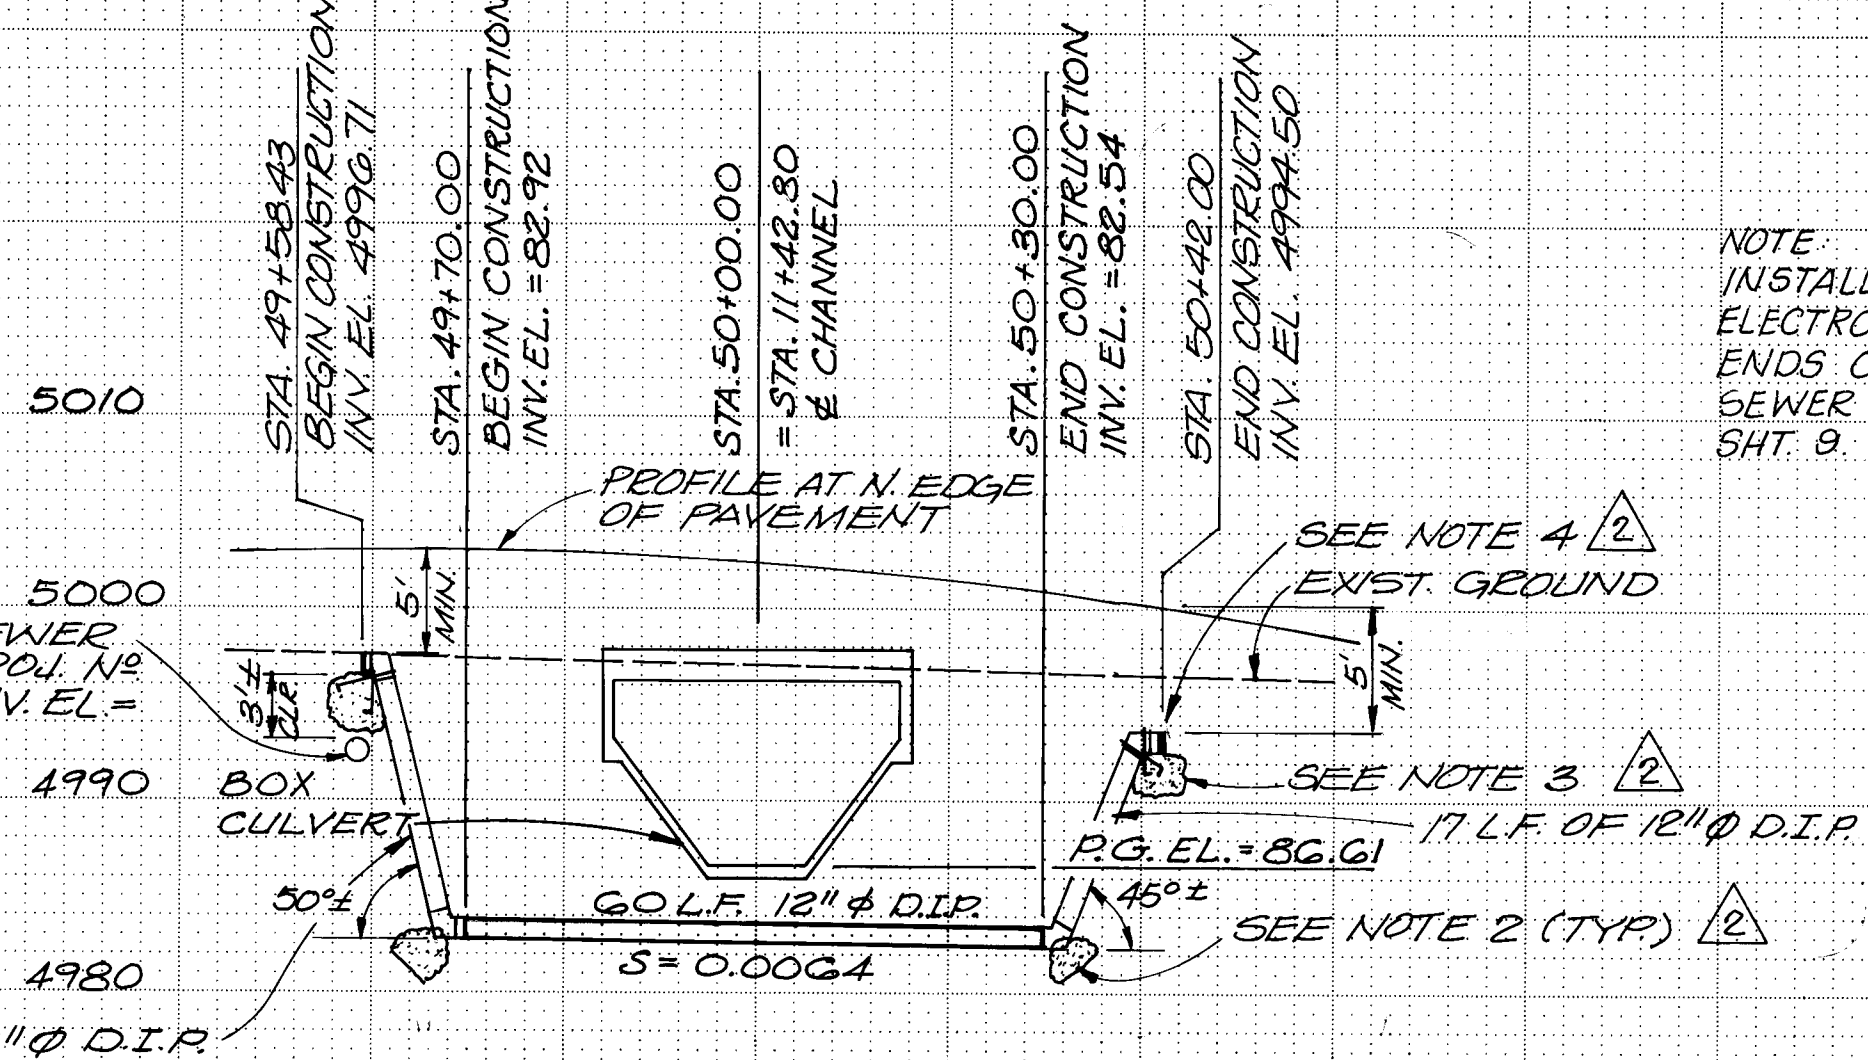


BLAKE ROAD WATERLINE STUB-OUT

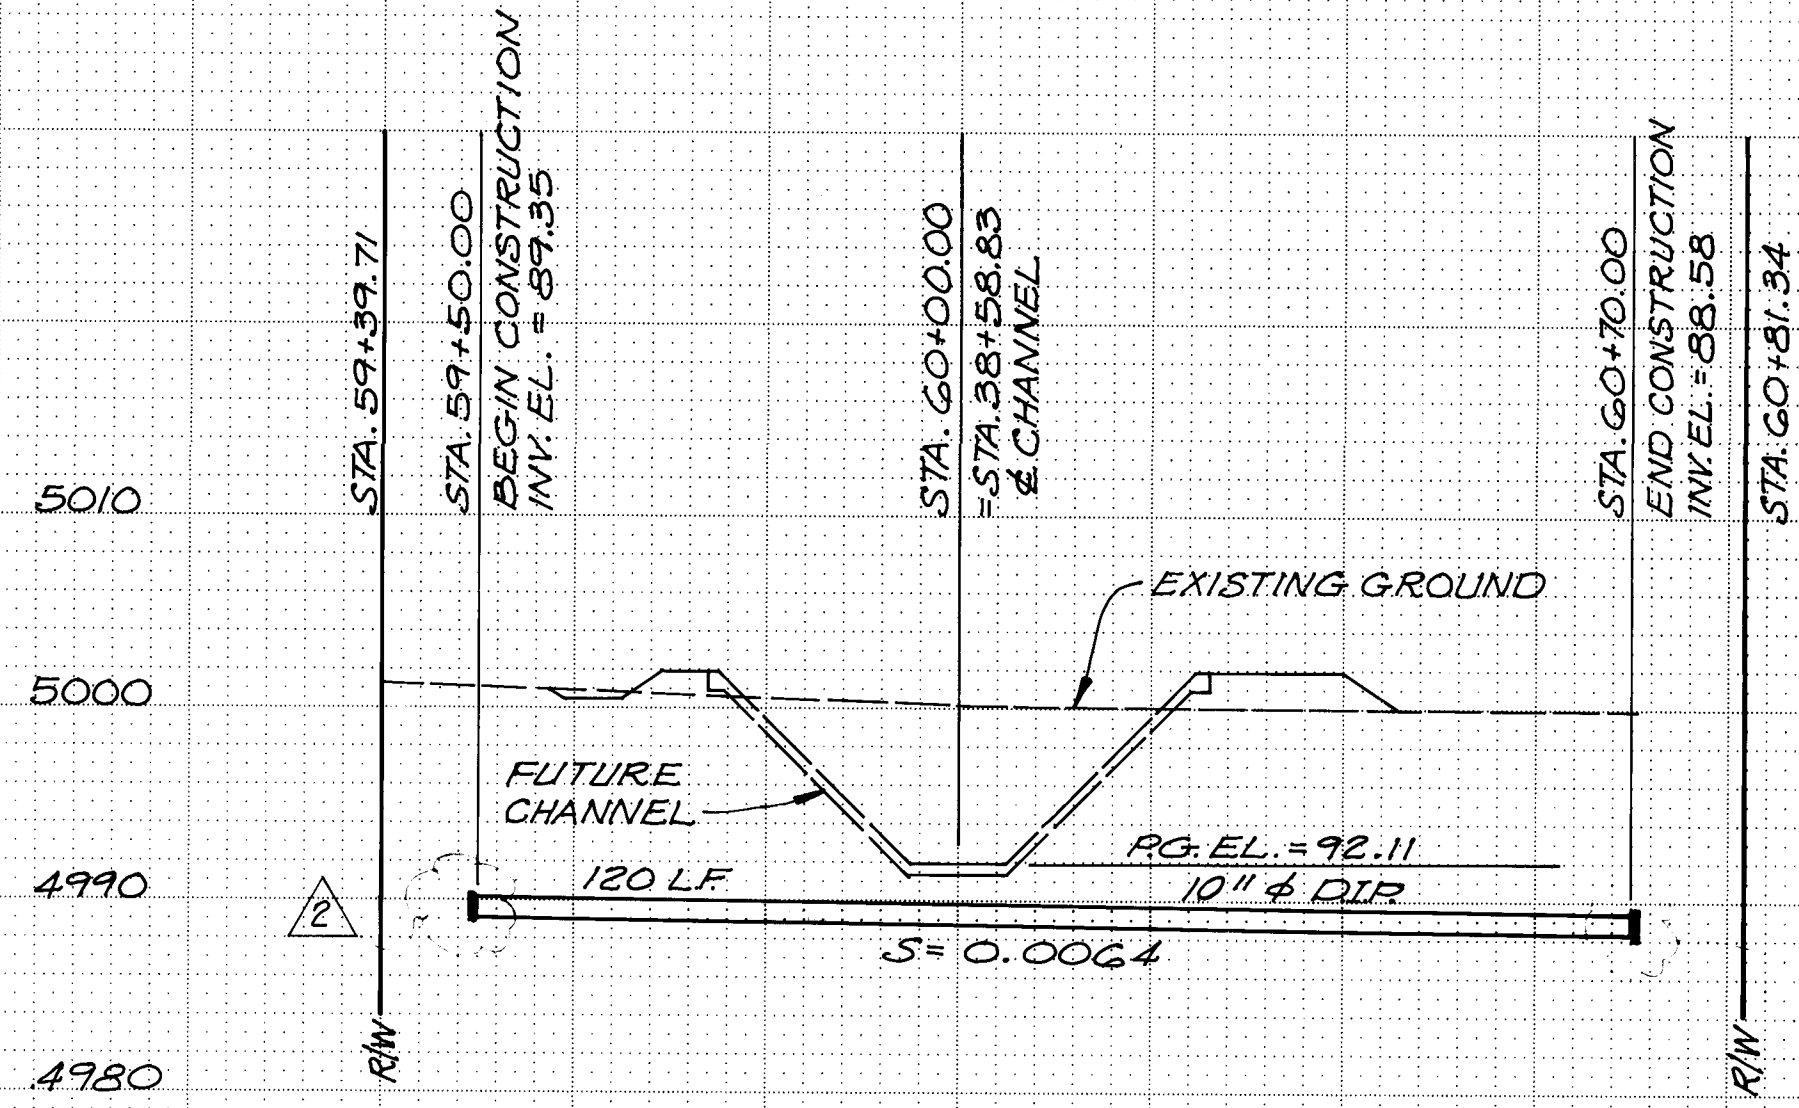

WATERLINE STUB-OUT AT STA. 38+58.83

SEE NOTE 5

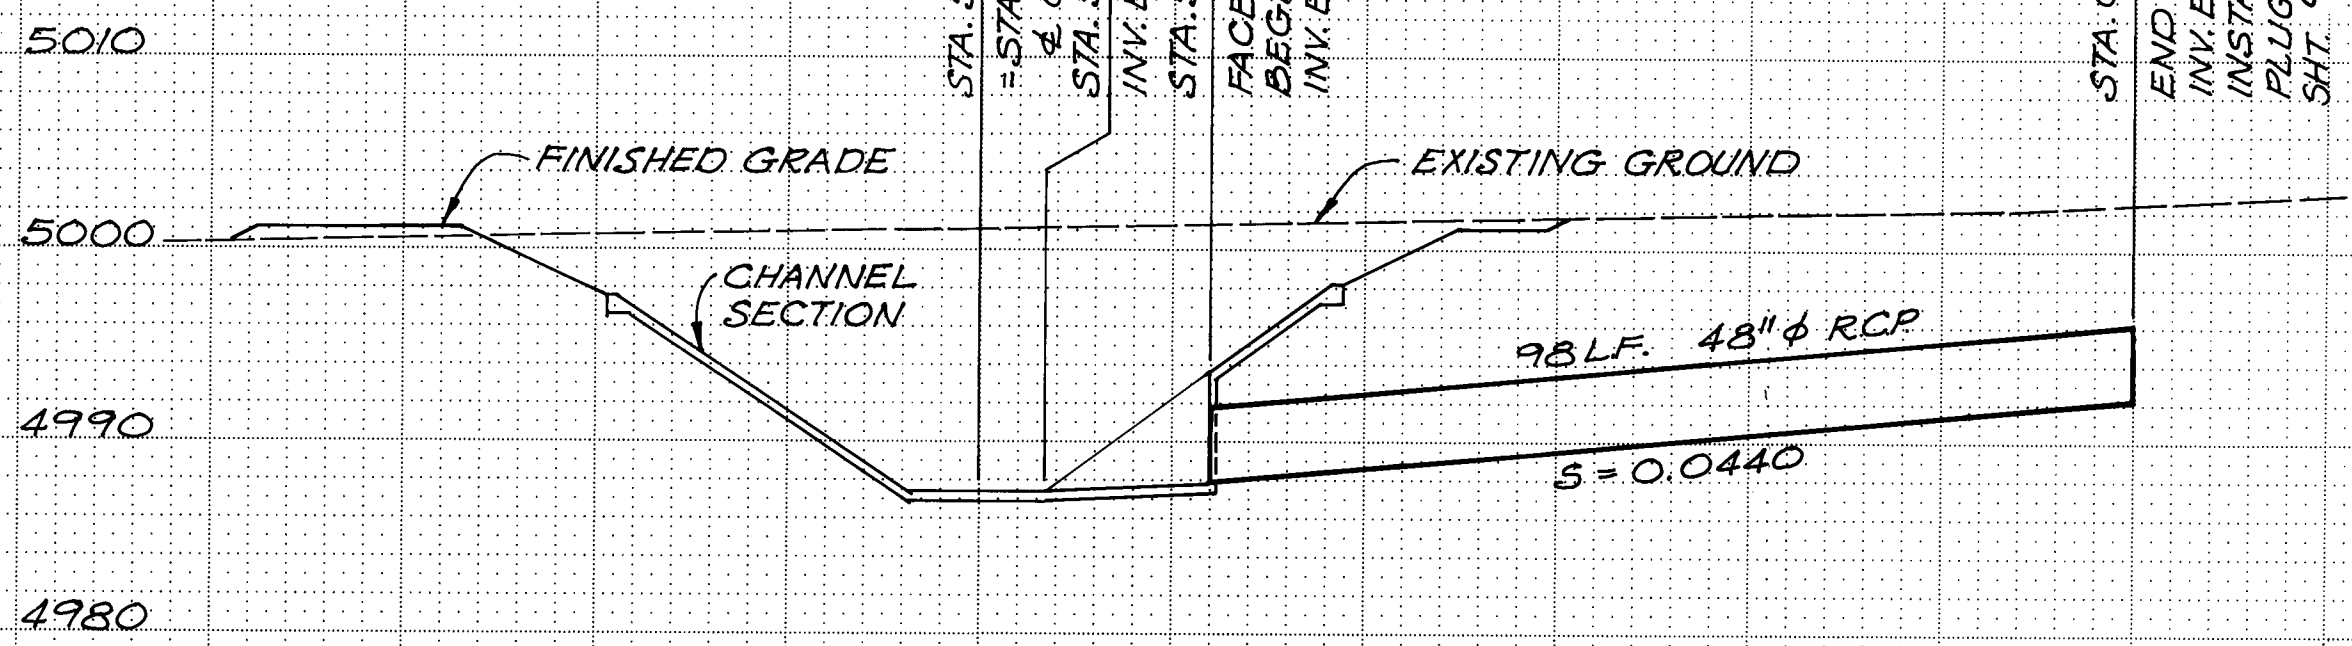

CONDUIT NO. 1 - 48" R.C.P.

NOTE:
INSTALL TEMPORARY PLUGS &
ELECTRONIC MARKER DISKS AT
ENDS OF ALL WATERLINE &
SEWER STUB-OUTS PER DETAIL,
SHT. 9.

RECORD DRAWING
These record drawings shall only be used for those facilities constructed under the contract identified in the title block and have been prepared in accordance with the design and construction specifications. No other use, reproduction, or alteration of these drawings without the written consent of the engineer is permitted. The engineer shall be responsible for the accuracy of the information contained in these drawings and for the results of any work based on these drawings.



SCALES:
1" = 20'
HORIZ.
1" = 5'
VERT.

1. FOR CONTINUATION OF SANITARY SEWER, SEE CITY OF ALBUQUERQUE PROJECT NO 2831, SHEET 2 OF 4, "BLAKE ROAD SANITARY SEWER EXTENSION".
2. FURNISH & INSTALL 45° x 12 IN. DIAGONAL D.I. BENDS (4 LOCATIONS). HYDROSTATIC PRESSURE TESTING SHALL BE CARRIED OUT IN ACCORDANCE WITH SEC. 701.16 OF THE STANDARD SPECIFICATIONS.
3. CONCRETE THRUST BLOCKS SHALL BE CONSTRUCTED IN ACCORDANCE WITH SEC. 701.13 OF THE STANDARD SPECIFICATIONS. DESIGN FOR THRUST BLOCK FOR VERTICAL OVERBEND ELBOW SHALL INCLUDE THRUST TIE RODS.
4. FURNISH & INSTALL 12 IN. M.J. END CAPS (2 LOCATIONS).
5. FURNISH & INSTALL 10 IN. M.J. END CAPS (2 LOCATIONS).

ENGINEER'S SEAL			SURVEY INFORMATION		BENCH MARKS		AS BUILT INFORMATION	
Professional Engineer State of New Mexico No. 12345 Name: John D. Smith			FIELD NOTES		THE FOLLOWING VERTICAL EQUATION IS NEEDED TO MATCH ANGLE DEL NORTE AERIAL TOPOGRAPHIC ELEVATIONS APPEARING IN THESE DRAWINGS WITH ALBUQUERQUE CITY SURVEY ELEVATIONS		CONTRACT NO.	
			NO.	DATE	ANOLE DEL NORTE DATUM + 0.31 FT		WORK ORDER NO.	
					ACS DATUM (1929 MSLD)		DATE	
							DATE	
REVISIONS			DESIGN		MICRO-FILM INFORMATION			
NO.			DATE		RECORDED BY			
DATE			DATE		NO.			

26 24801481

CITY OF ALBUQUERQUE MUNICIPAL DEVELOPMENT DEPARTMENT ENGINEERING DIVISION					
TITLE: UTILITY PROFILES & SECTIONS					
AMOLE DEL NORTE STORM DIVERSION FACILITY					
APPROVALS	ENGINEER	DATE	APPROVALS	ENGINEER	DATE
City Engineer	ALL	2/14/86	Liquid Waste		
ACE - Design	John D. Smith	1/28/86	Traffic	NA	1/27/86
ACE - Hydrology	K. K. Lopez	1/27/86	Water		
DRAWING NO.	2480	MAP NO.	SHEET	OF	
			14	21	

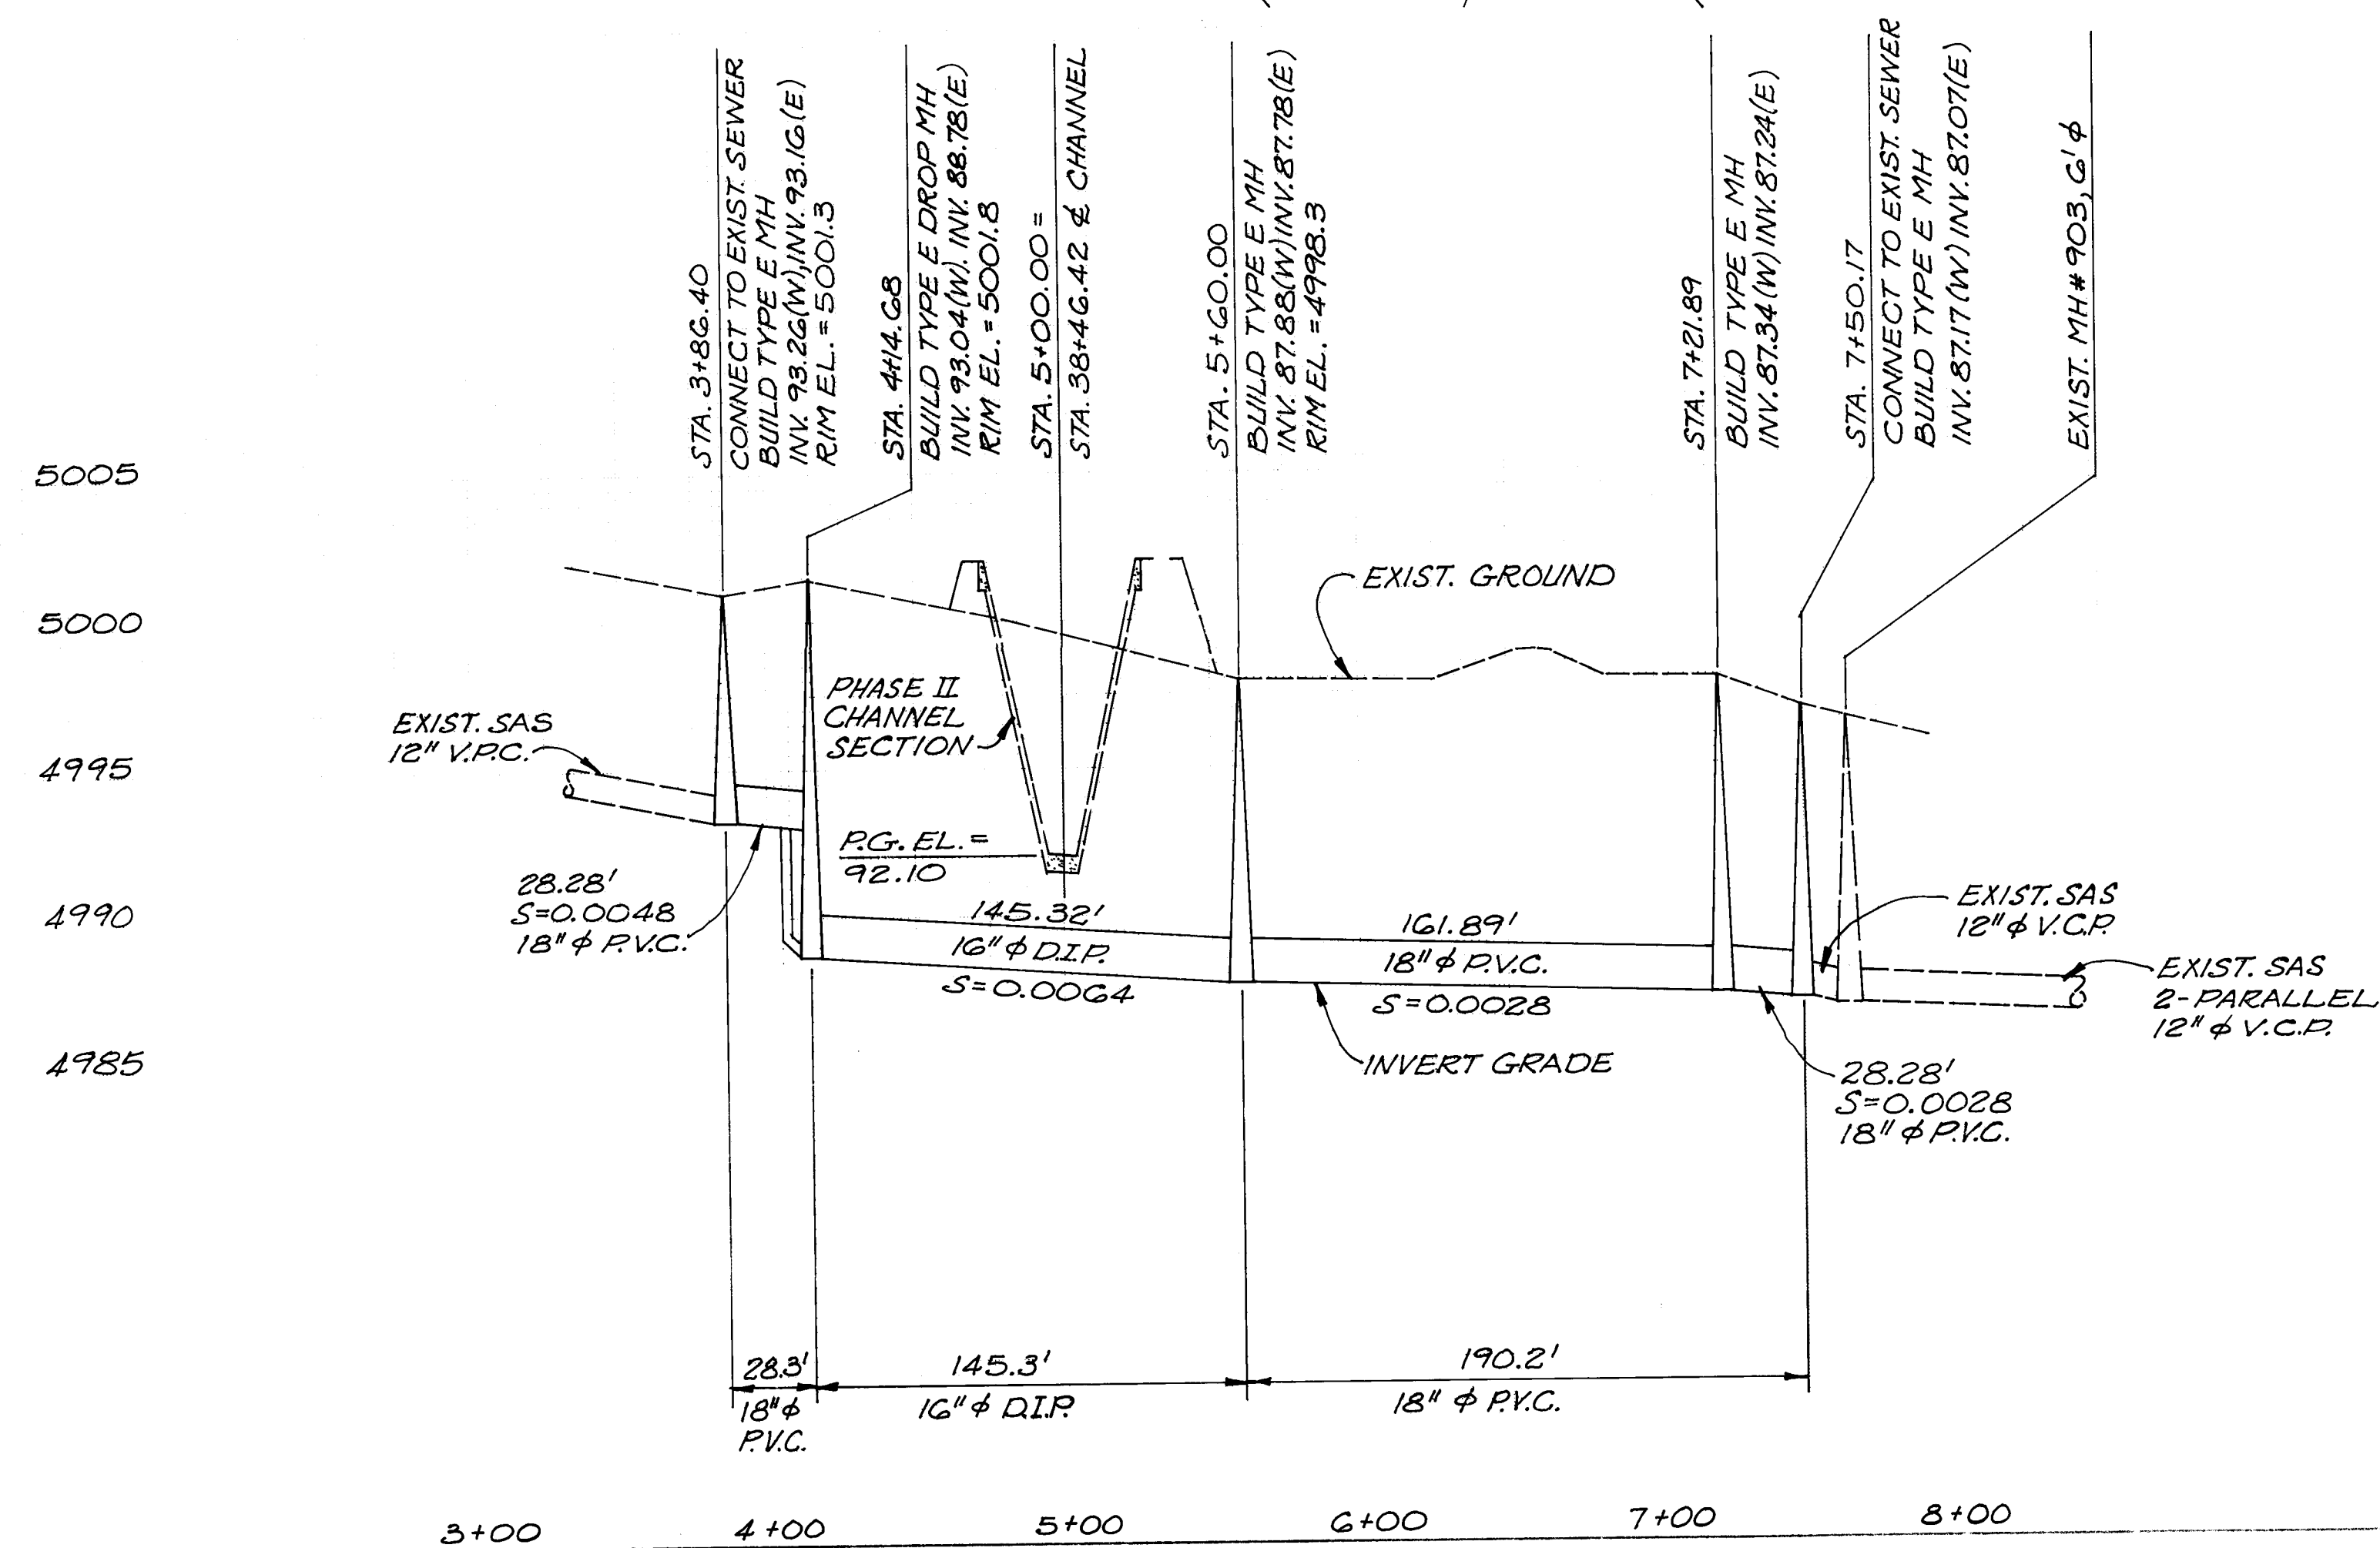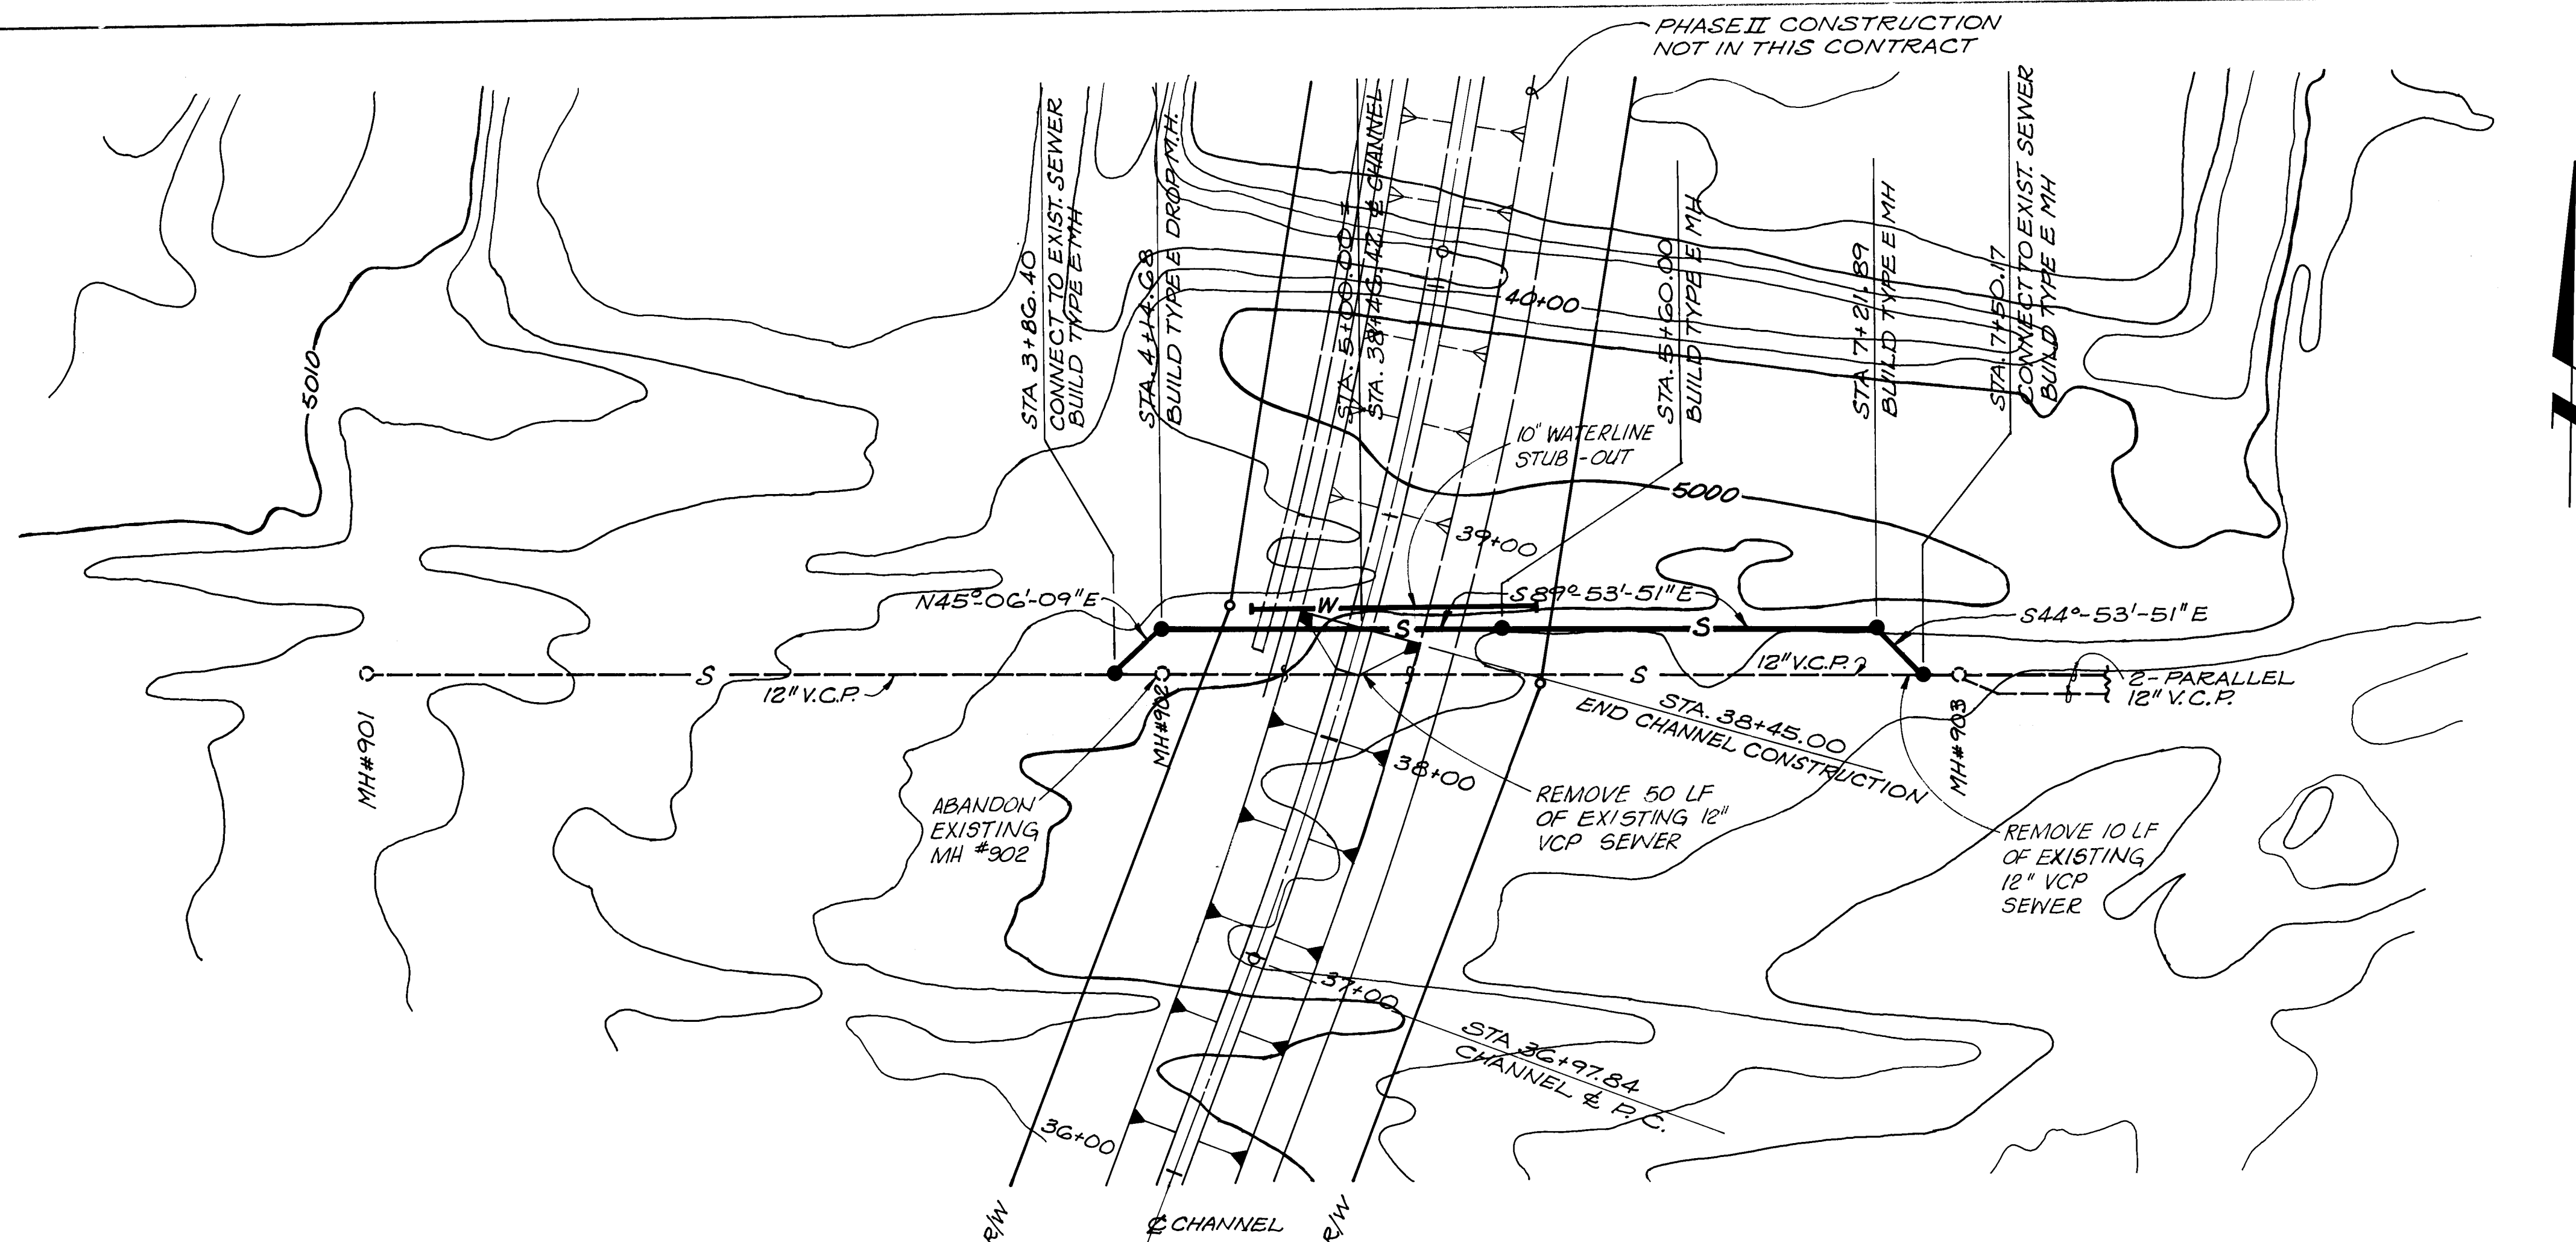

SCALES:
1" = 50' HORIZ.
1" = 5' VERT.

NOTES:

1. EXISTING MANHOLE(S) SHALL BE ABANDONED IN ACCORDANCE WITH SECTION 802.12 OF THE STANDARD SPECIFICATIONS. PLUG OPEN ENDS OF ABANDONED SEWER REMAINING AT ALL LOCATIONS WITH 12" THICK CONCRETE OR CONCRETE MORTAR PLUG.

ENGINEER'S SEAL		SURVEY INFORMATION		BENCH MARKS		AS BUILT INFORMATION	
		FIELD NOTES		THE FOLLOWING VERTICAL EQUATION IS NEEDED TO			
		NO.	BY	MATCH ANGLE DEL NORTE AERIAL TOPOGRAPHIC		WORK BY	DATE
				ELEVATIONS APPEARING IN THESE DRAWINGS WITH		INSPECTED BY	DATE
				ALBUQUERQUE CITY SURVEY ELEVATIONS		ACCEPTANCE BY	DATE
		NO.	DATE	DRAWINGS		VEGETATION BY	DATE
				AMOLE DEL NORTE DATUM + 0.32 FT.		CORRECTED BY	DATE
				= ACS DATUM (1929 MSD)		MICRO-FILM INFORMATION	
						RECORDED BY	DATE
						NO.	

DESIGNED BY: TWP		DATE: 12/85
DRAWN BY: P6/MM		DATE: 12/85

REVISIONS

NO.	DATE	REMARKS	BY

DESIGN

ALBUQUERQUE
CITY DEPARTMENT
DIVISION

PLAN & PROFILE

DIVERSION FACILITY

APPROVALS

and Waste: *N/A*

IC: *N/A*

r: *N/A*

ENGINEER

Pardo

R. P. Pardo

R. Pardo

DATE

1/24/86

1/24/86

1/22/86









10

SHEET 15 OF

21

FINAL SURVEY NOTE BOOK NO.	BY	DATE
SURVEYED PLOTED DATE AREAS CHECKED	BY	DATE

ORIGINAL SURVEY NOTE BOOK NO.	BY	DATE
SURVEYED PLOTED DATE AREAS CHECKED	BY	DATE

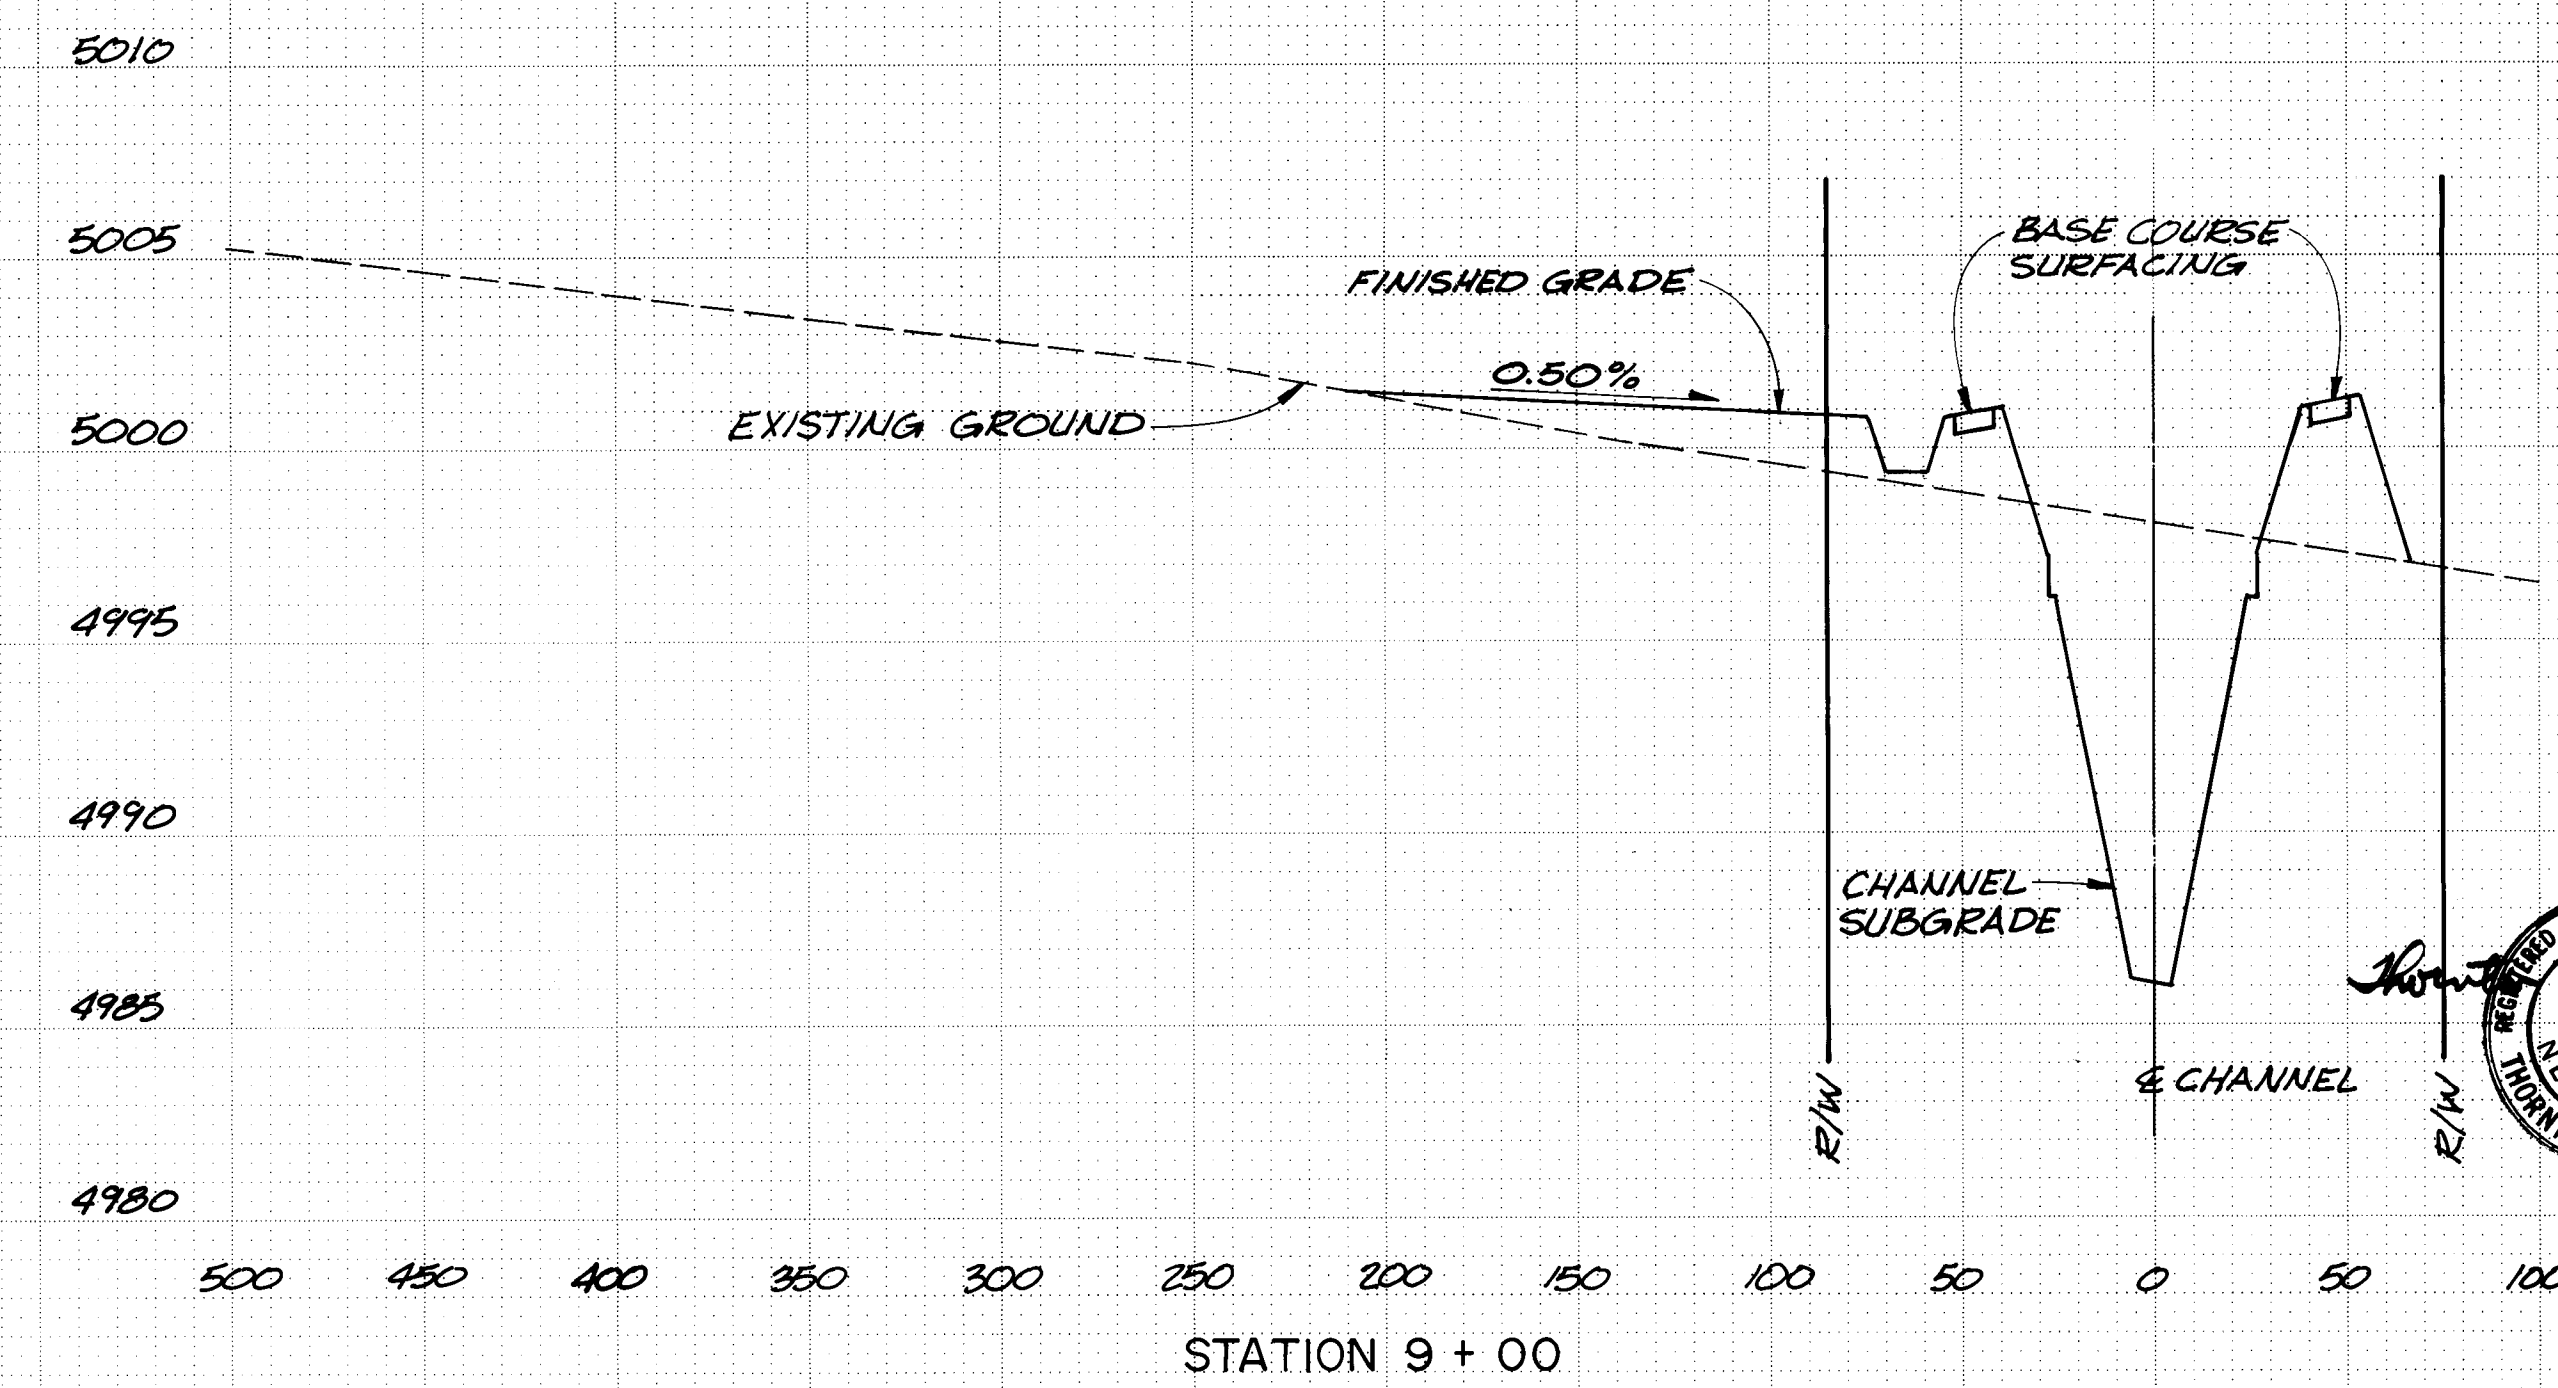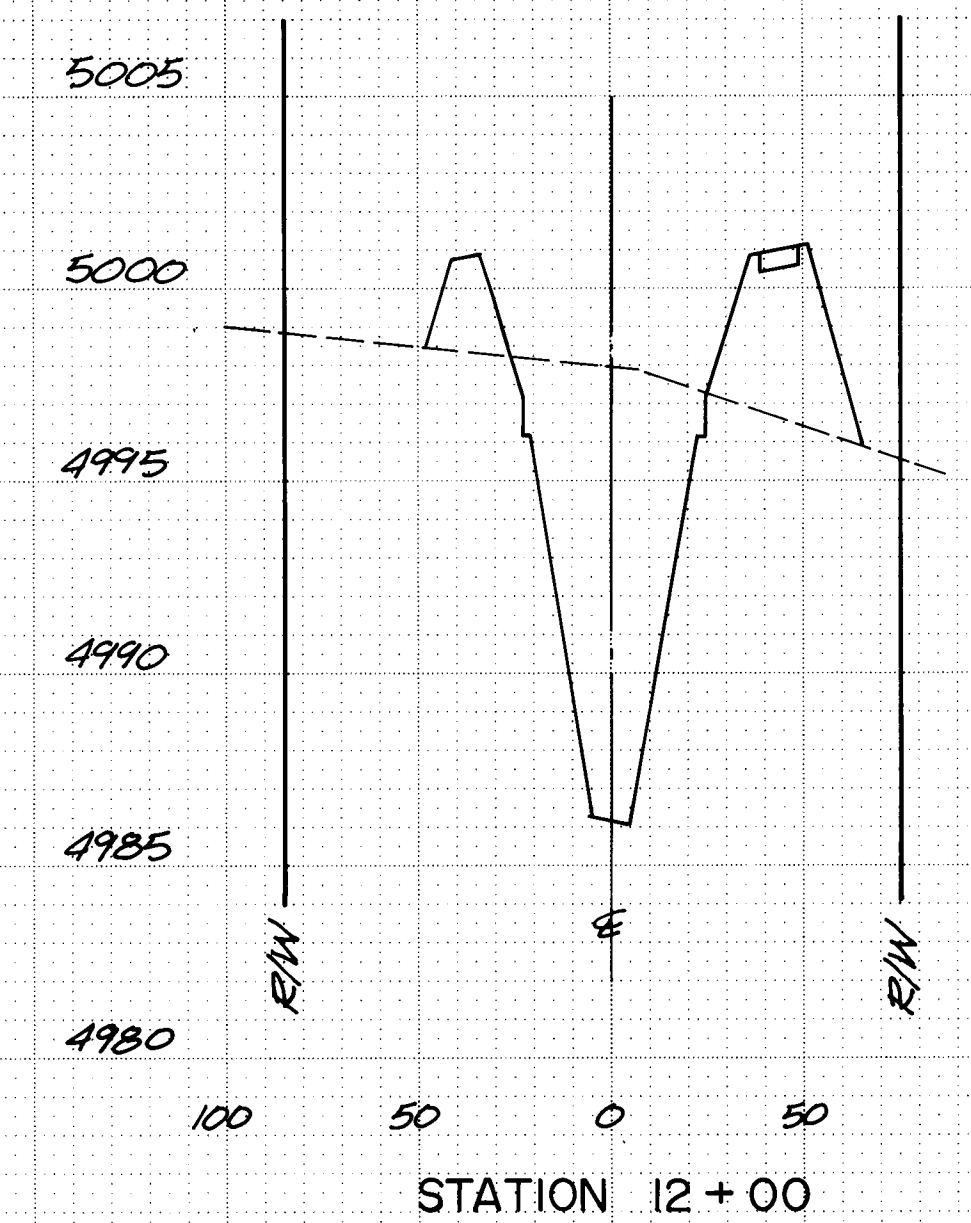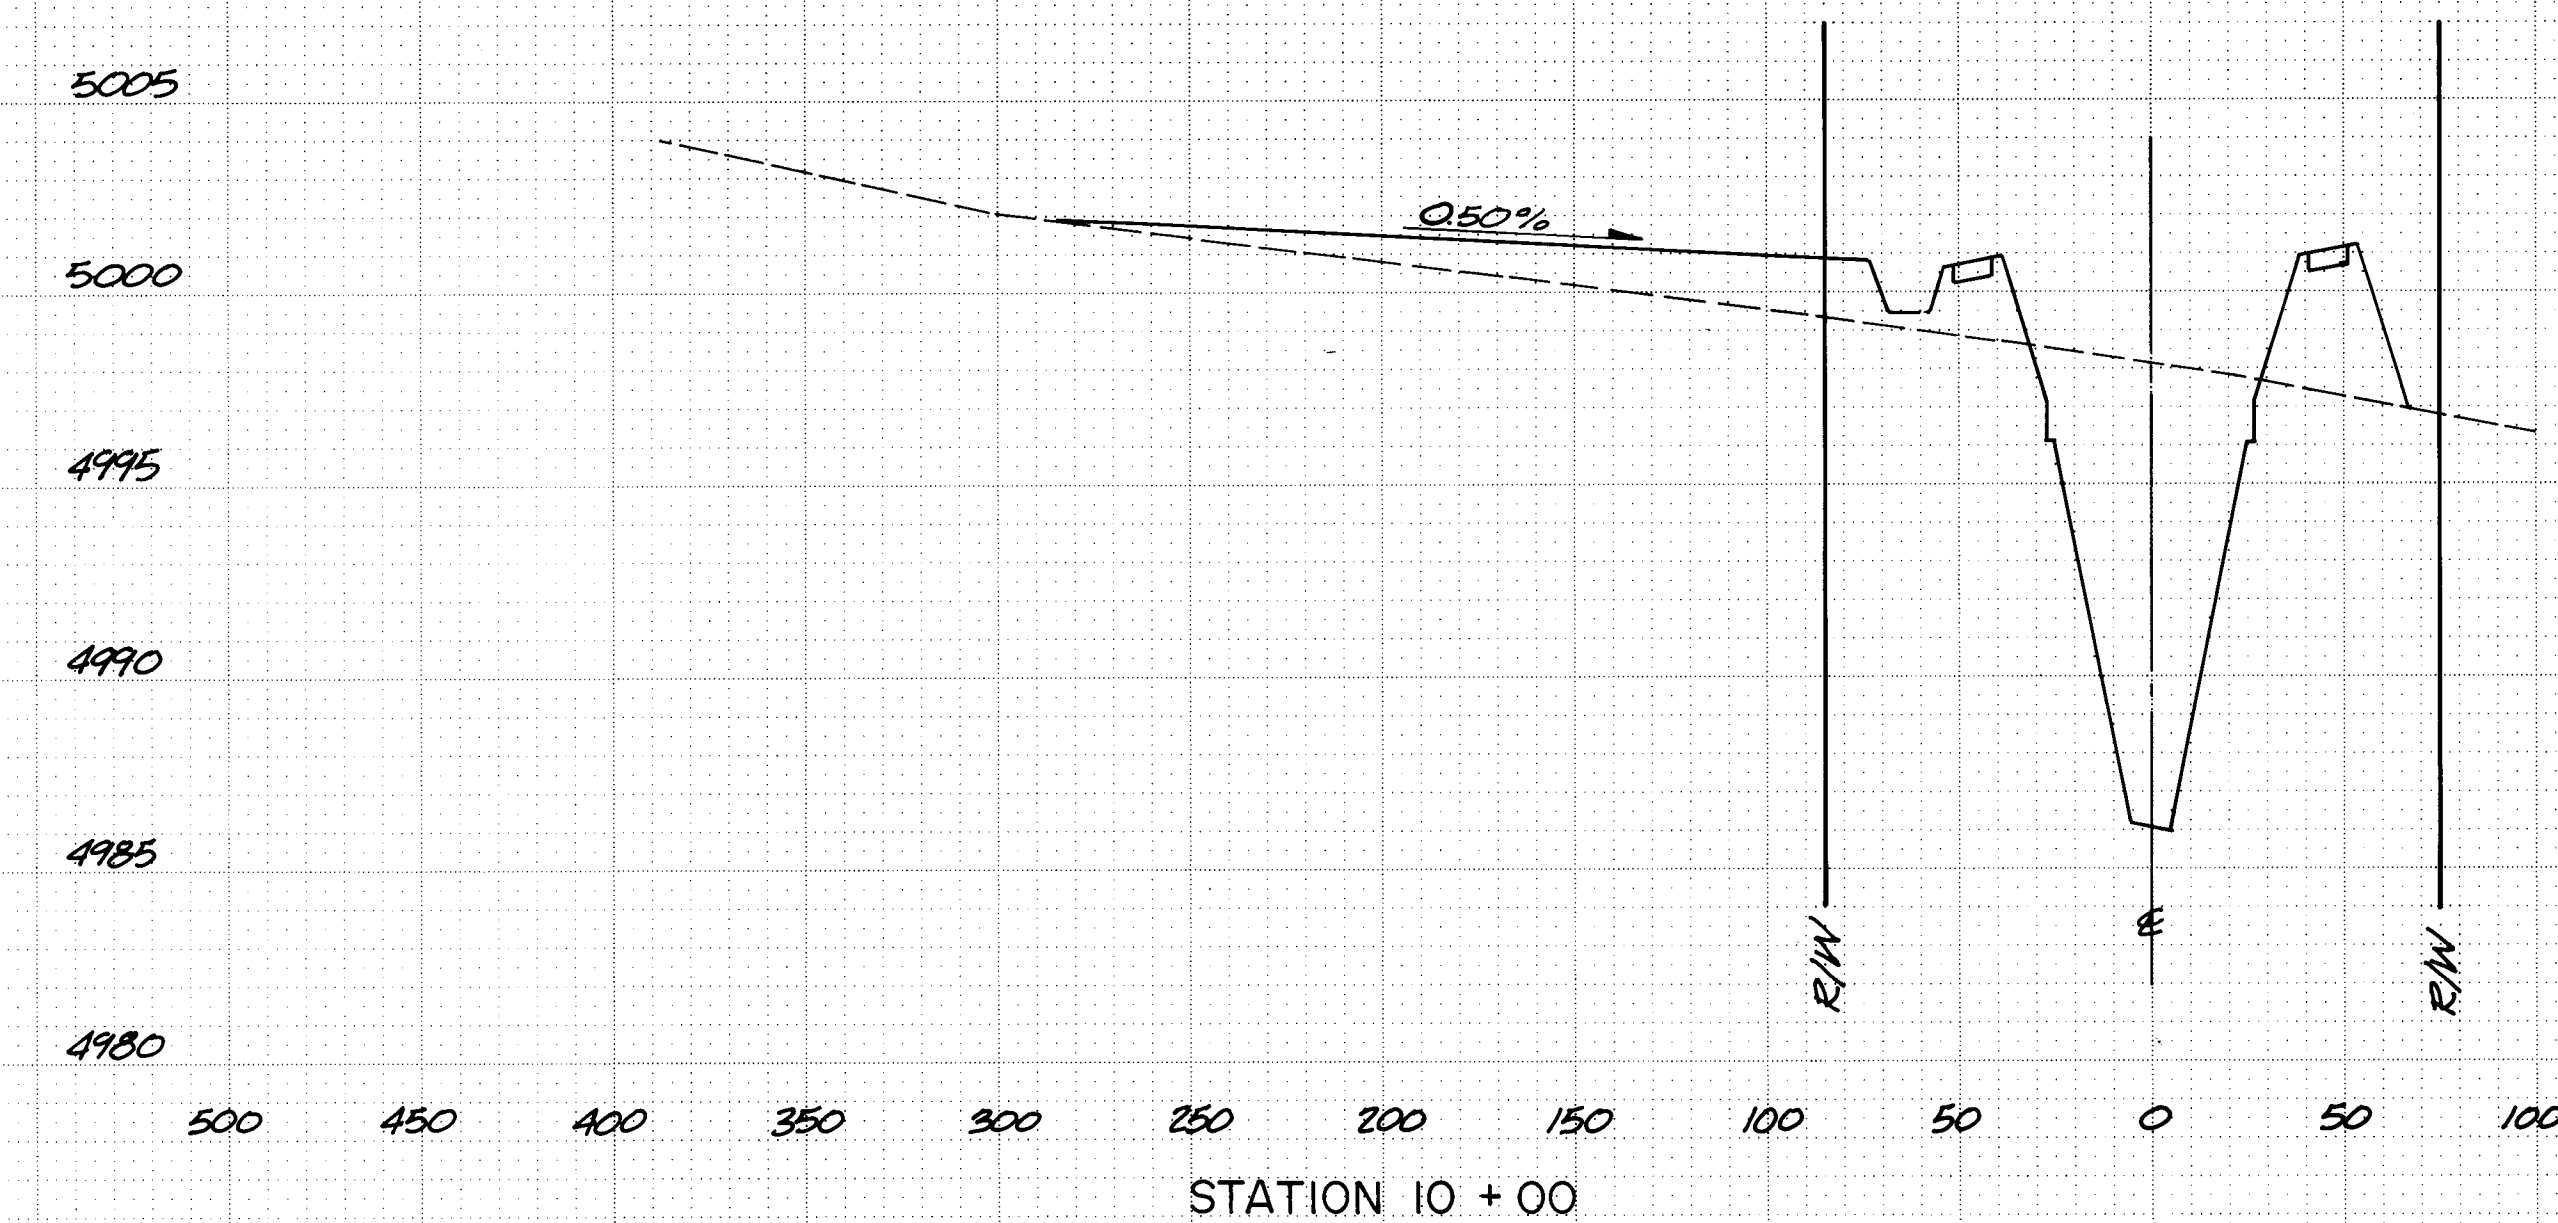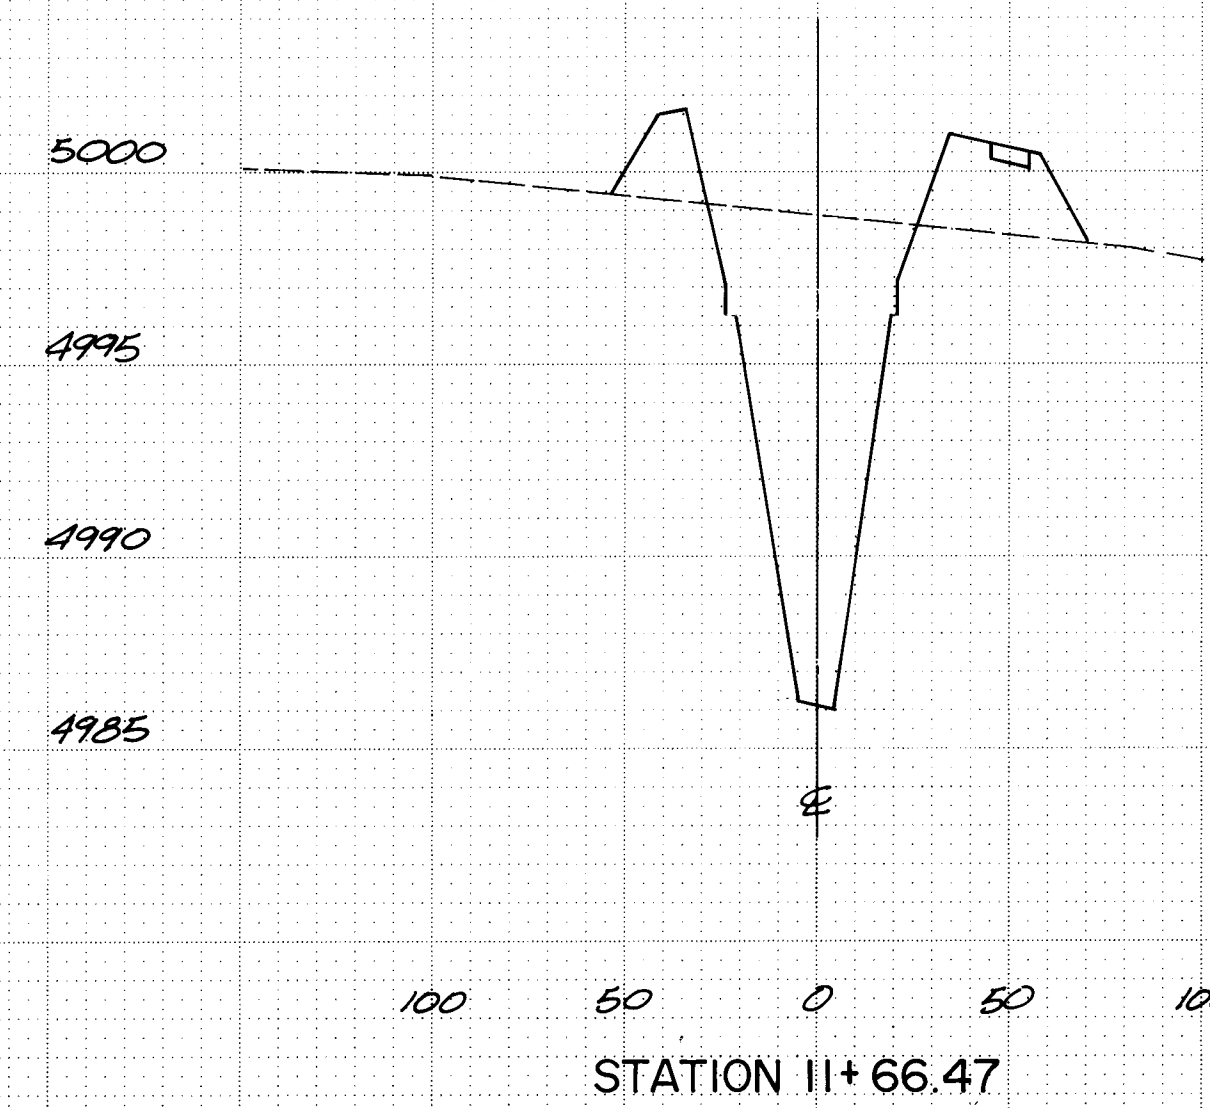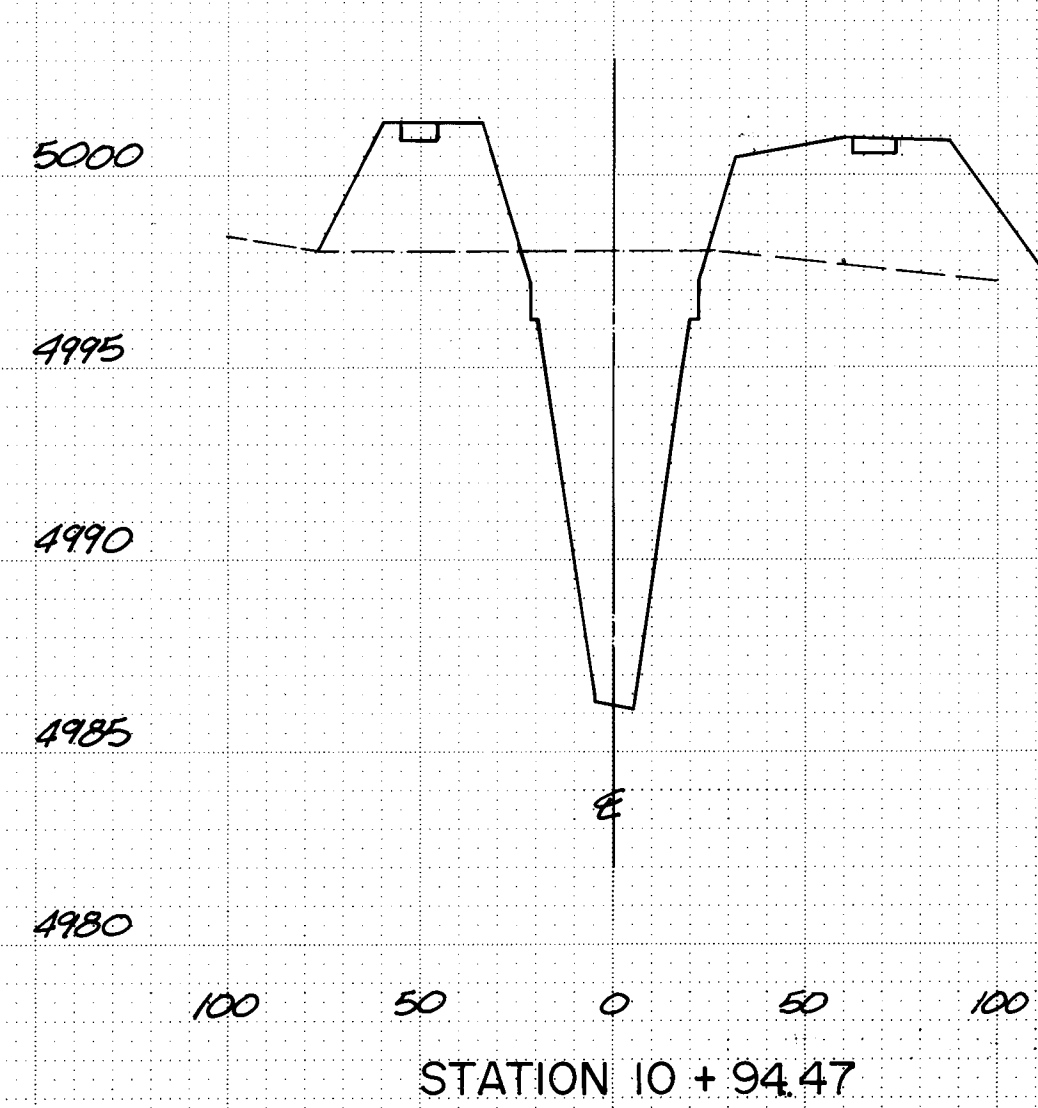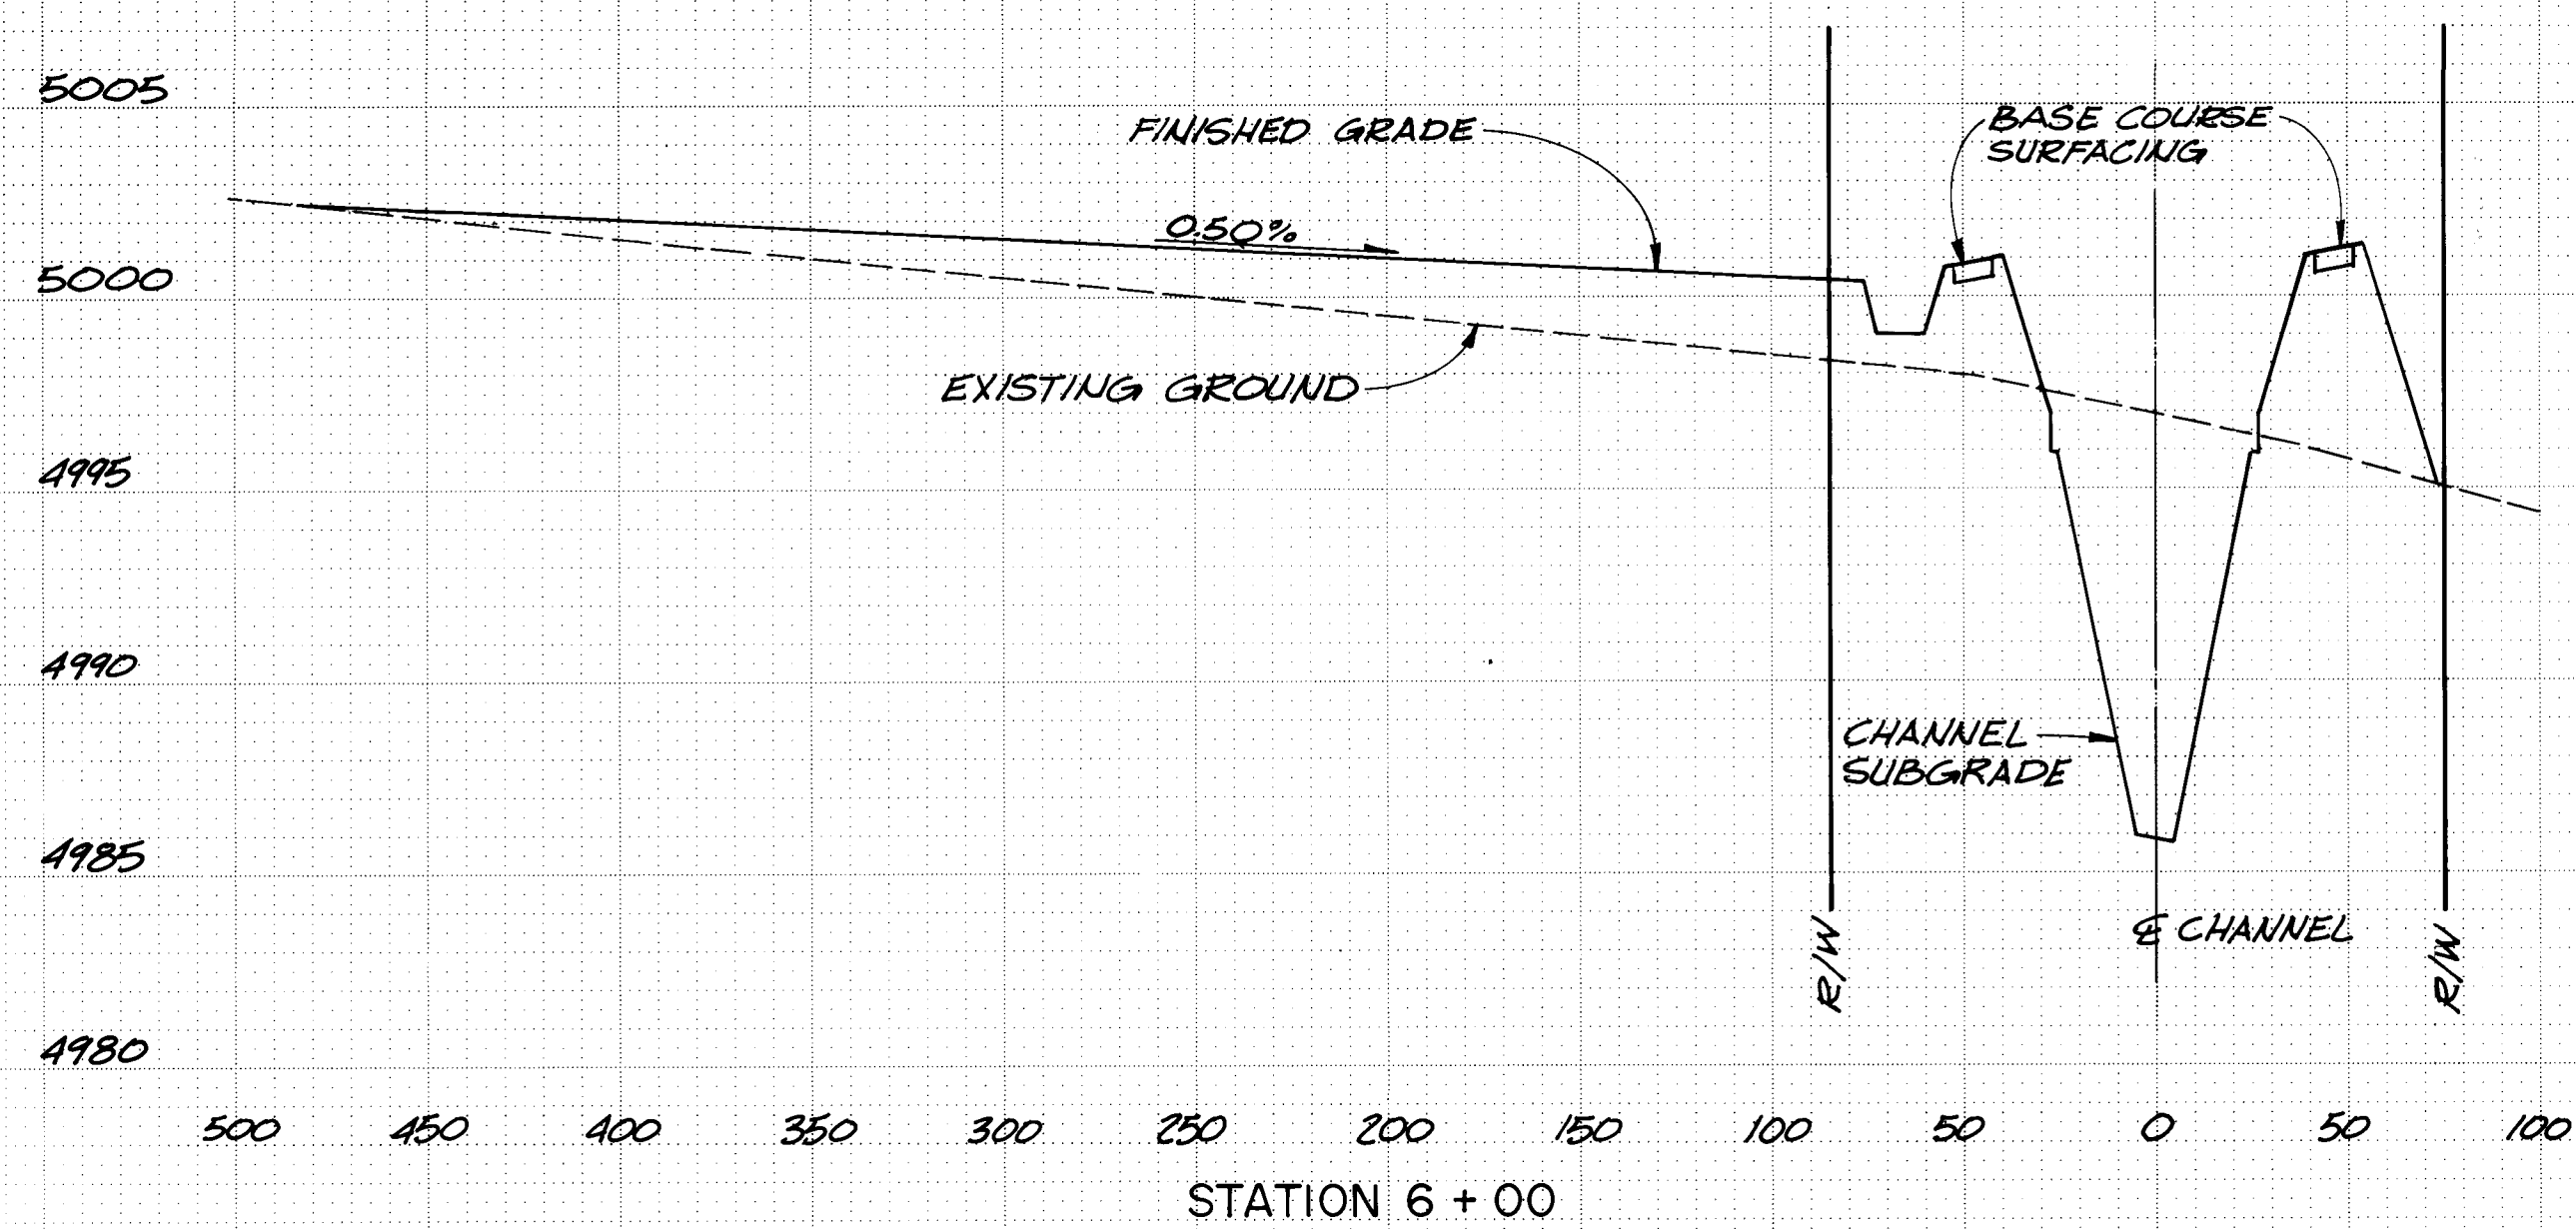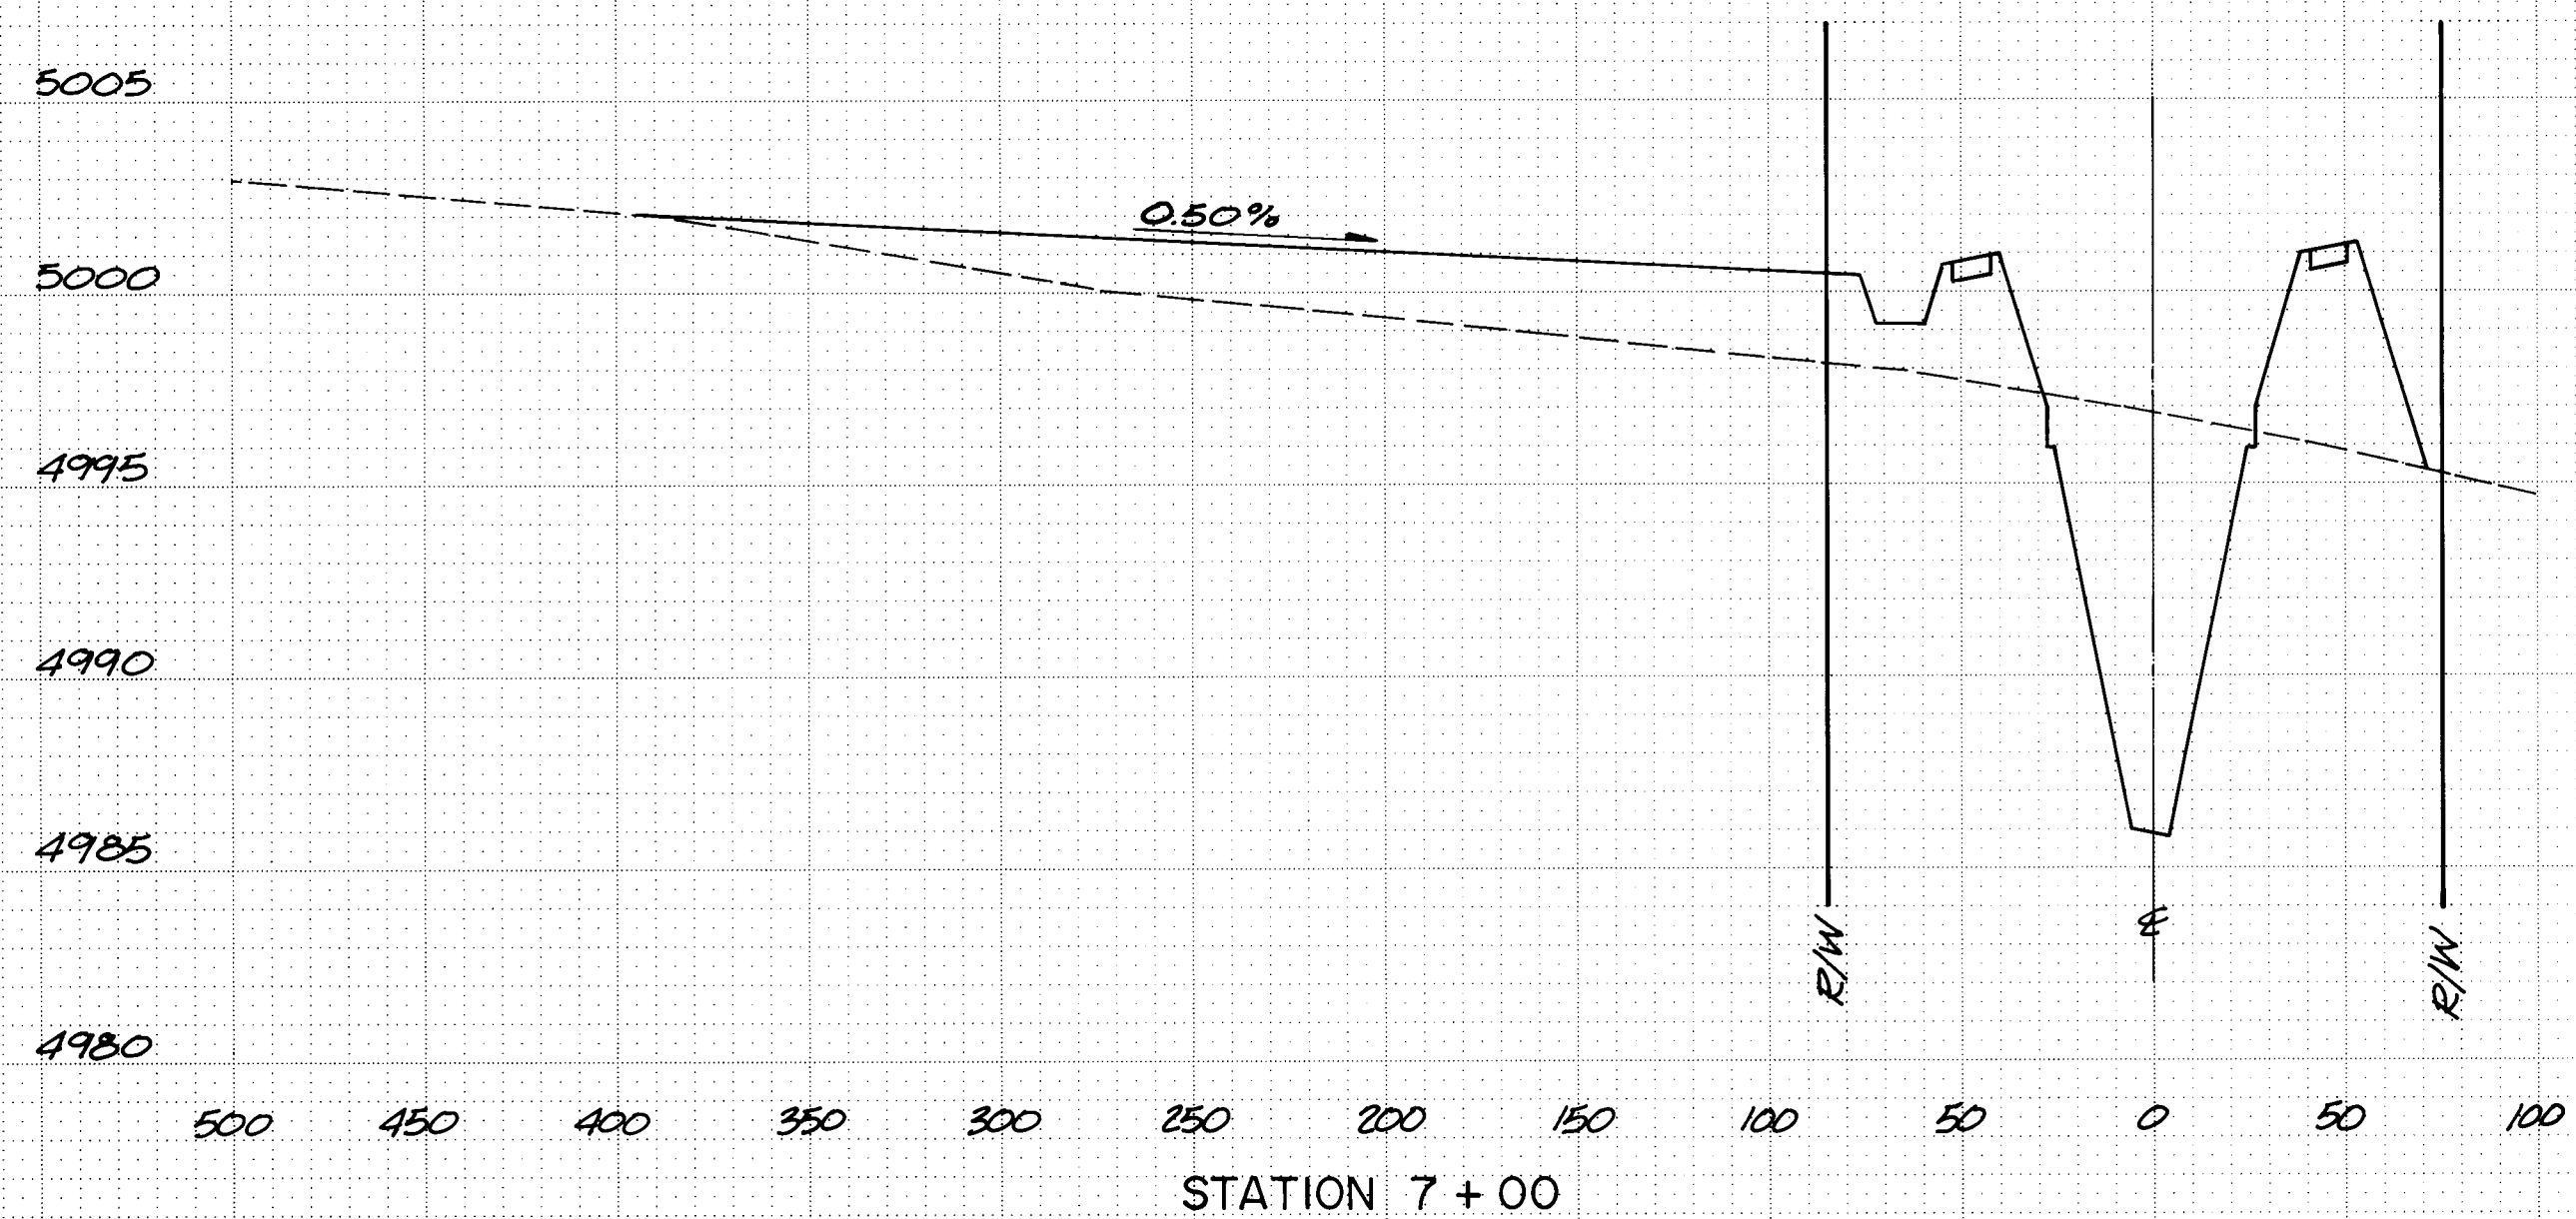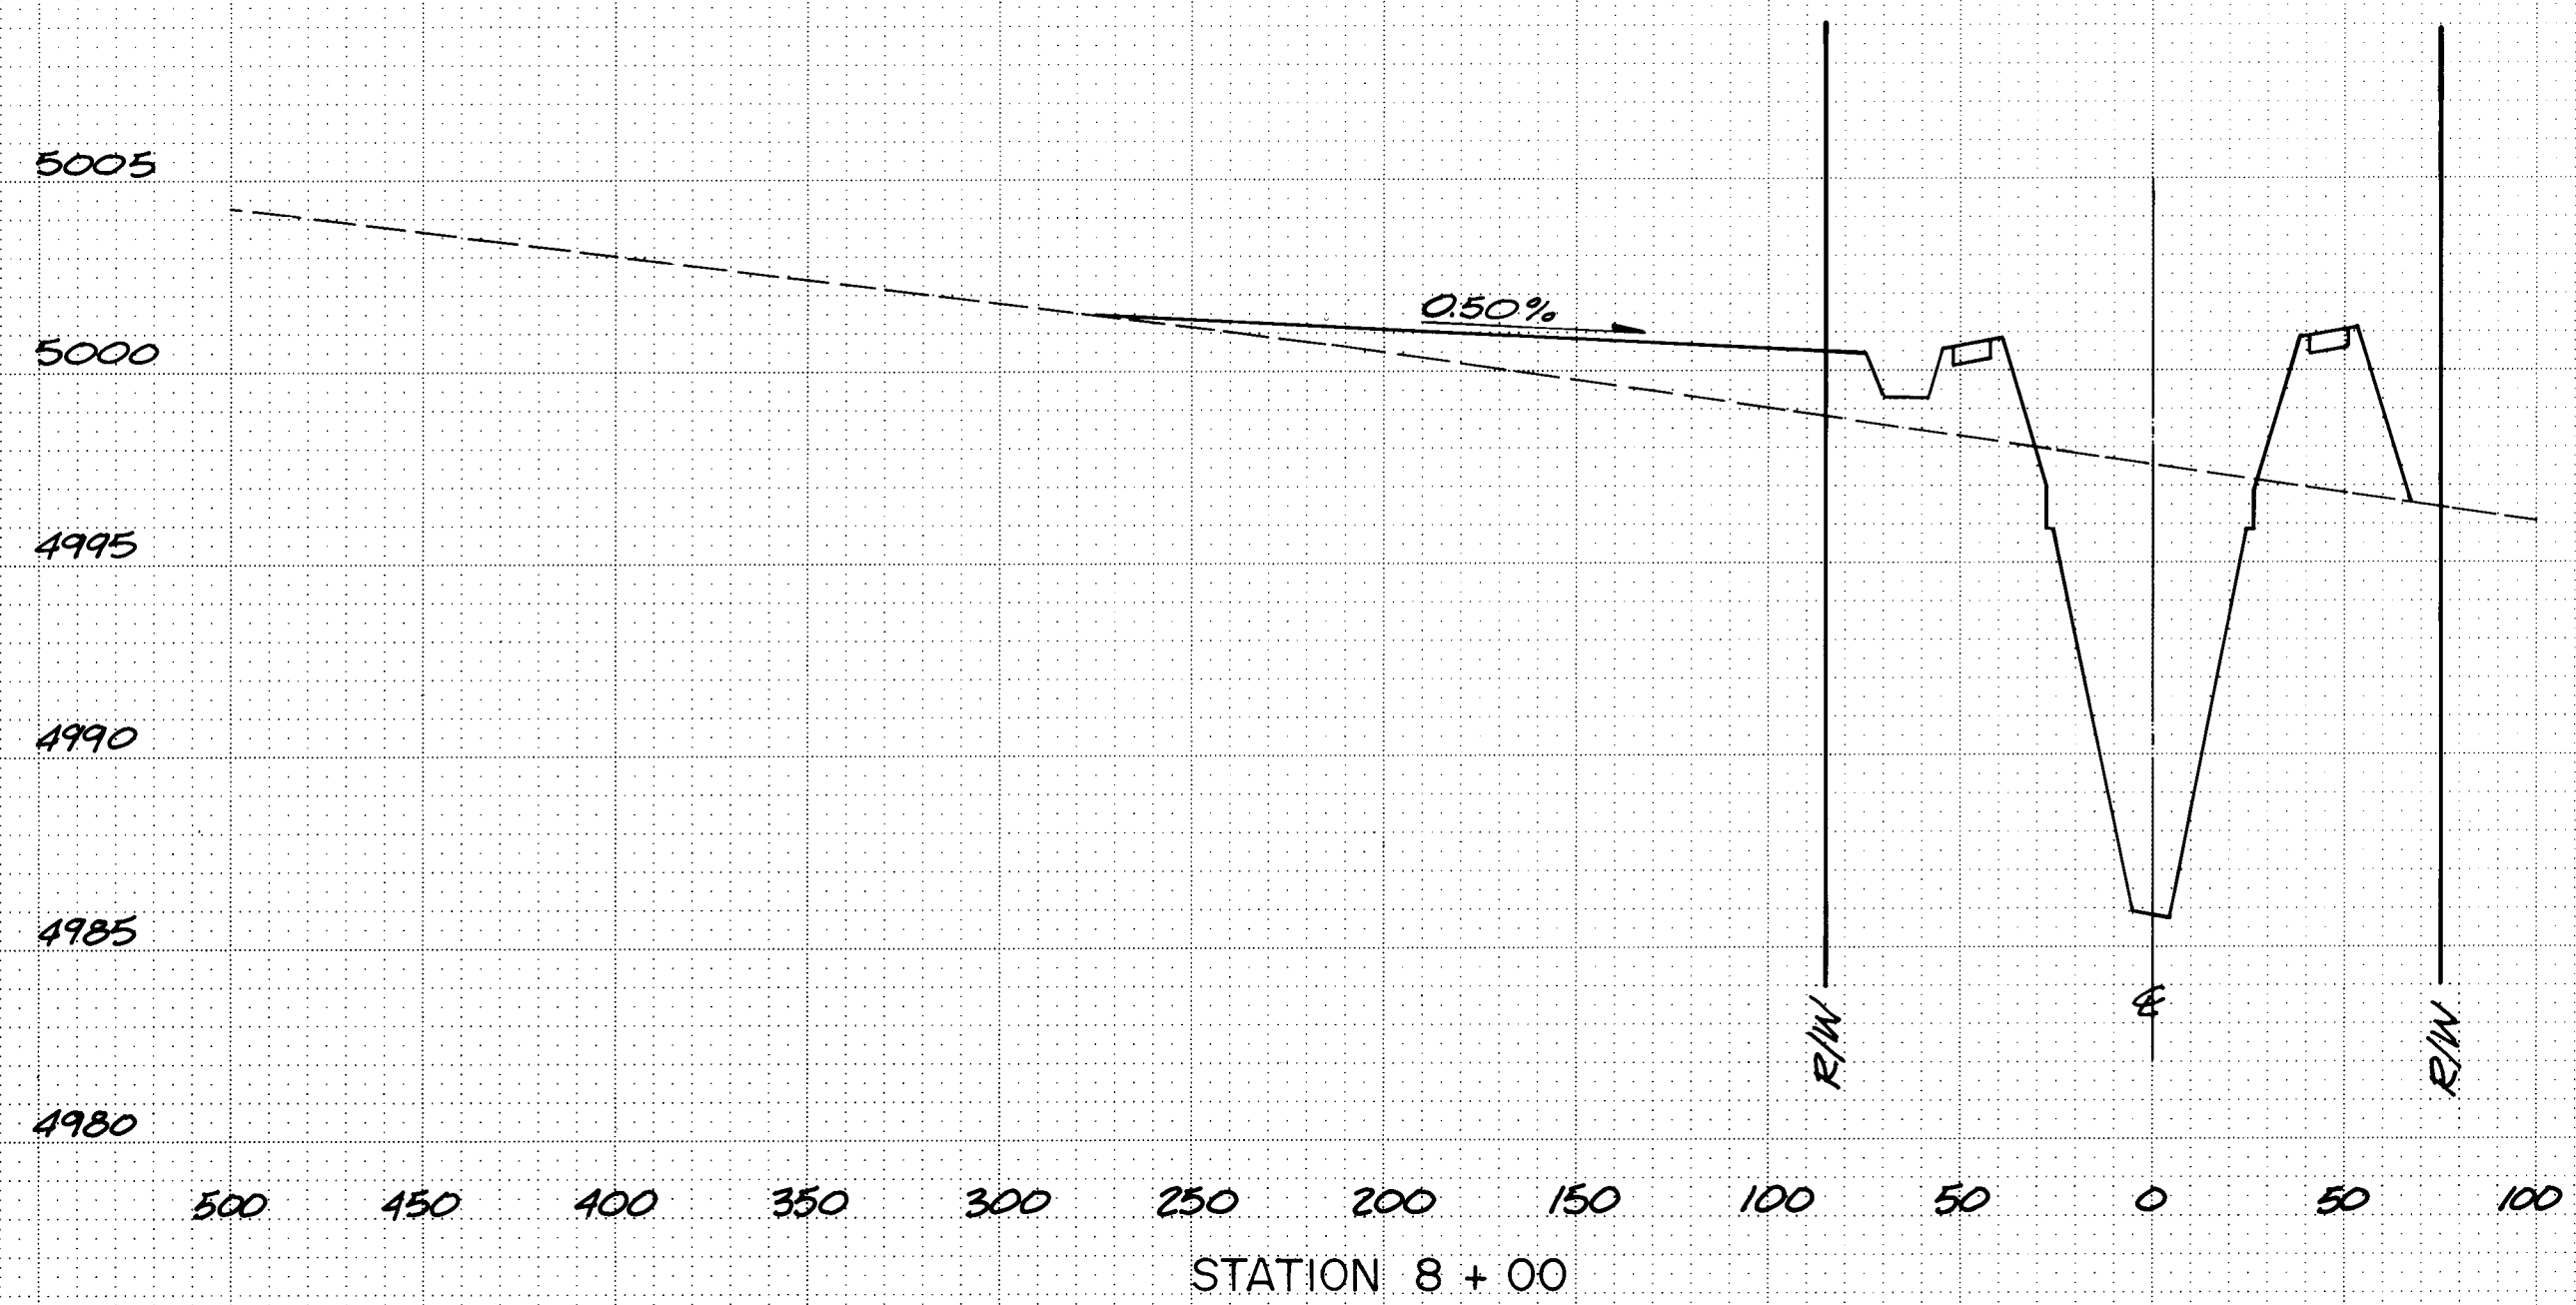


RECORD DRAWING
These record drawings apply only to those facilities constructed under the contract identified in the title block and are not to be used in part, on the basis of information compiled and furnished by others. Any Engineering Corporation will not be responsible for any errors or omissions which have been incorporated into this drawing as a result of the work by others.

SCALE:
1"=50' HORIZ.
1"=5' VERT.

THE FOLLOWING VERTICAL EQUATION IS NEEDED TO MATCH AMOLE DEL NORTE AERIAL TOPOGRAPHIC ELEVATIONS APPEARING IN THESE DRAWINGS WITH ALBUQUERQUE CITY SURVEY ELEVATIONS:
AMOLE DEL NORTE DATUM + 0.32 FT.
= ACS DATUM (1929 MSLD)














CHANNEL CROSS SECTIONS
STA. 6+00.00 TO STA. 13+00.00
AMOLE DEL NORTE STORM DIVERSION FACILITY

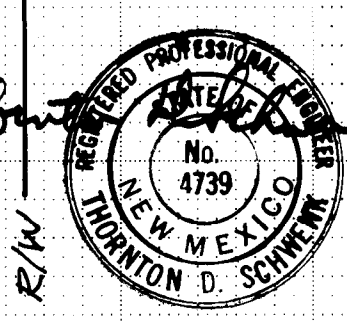

26 24801787

DATE	BY
SURVEYED	PLANNED
NOTED	AREAS CHECKED
NO.	NO.

DATE	BY
SURVEYED	PLANNED
NOTED	AREAS CHECKED
NO.	NO.

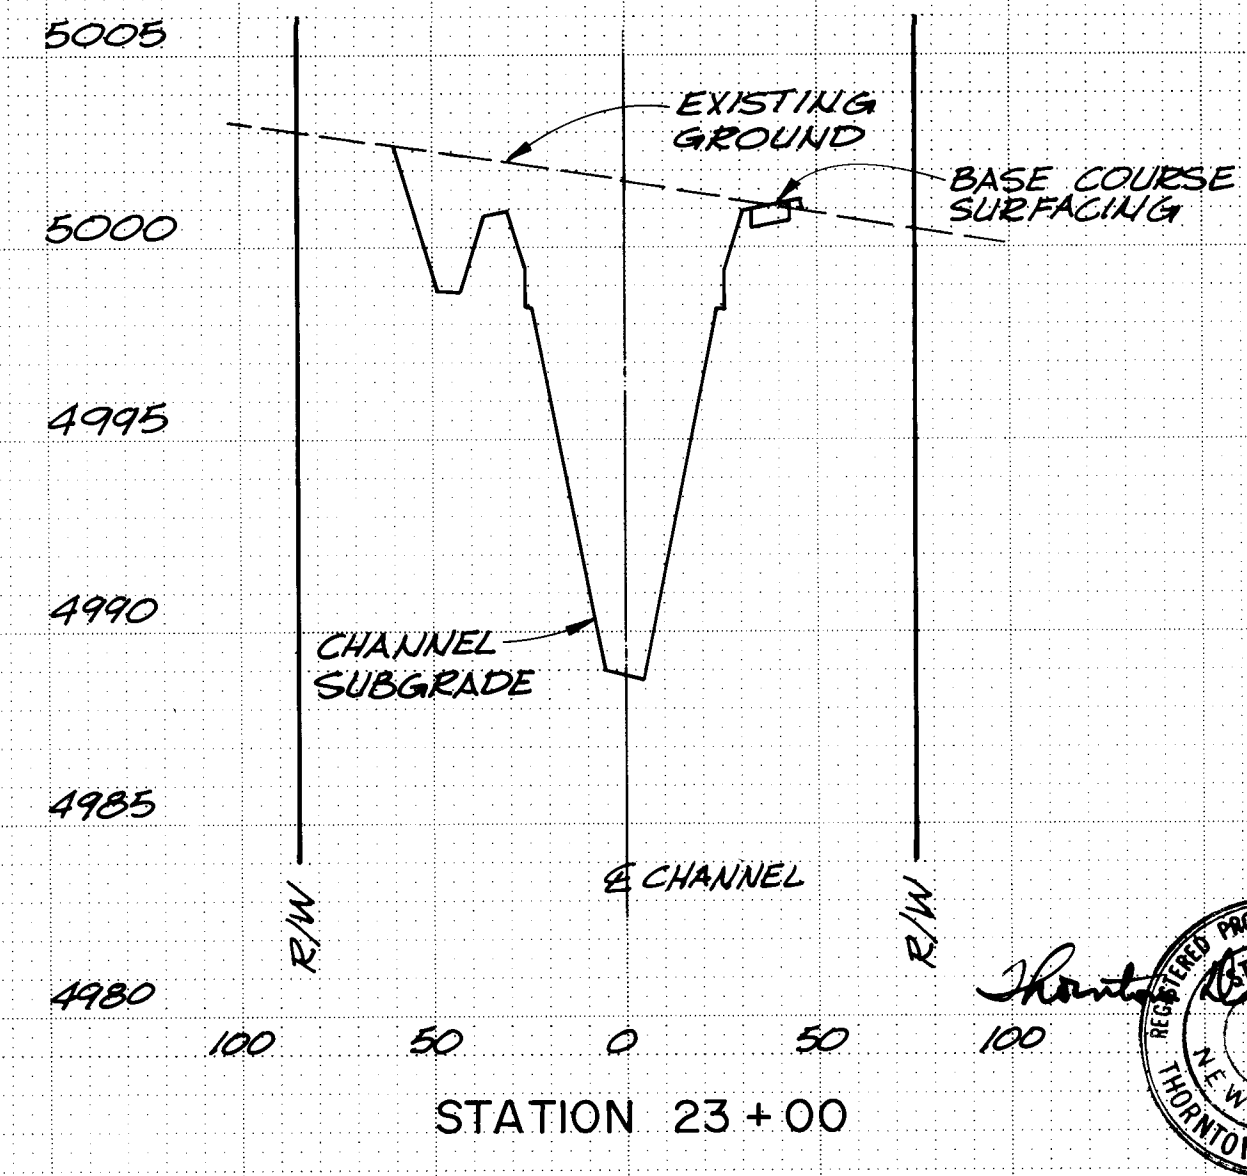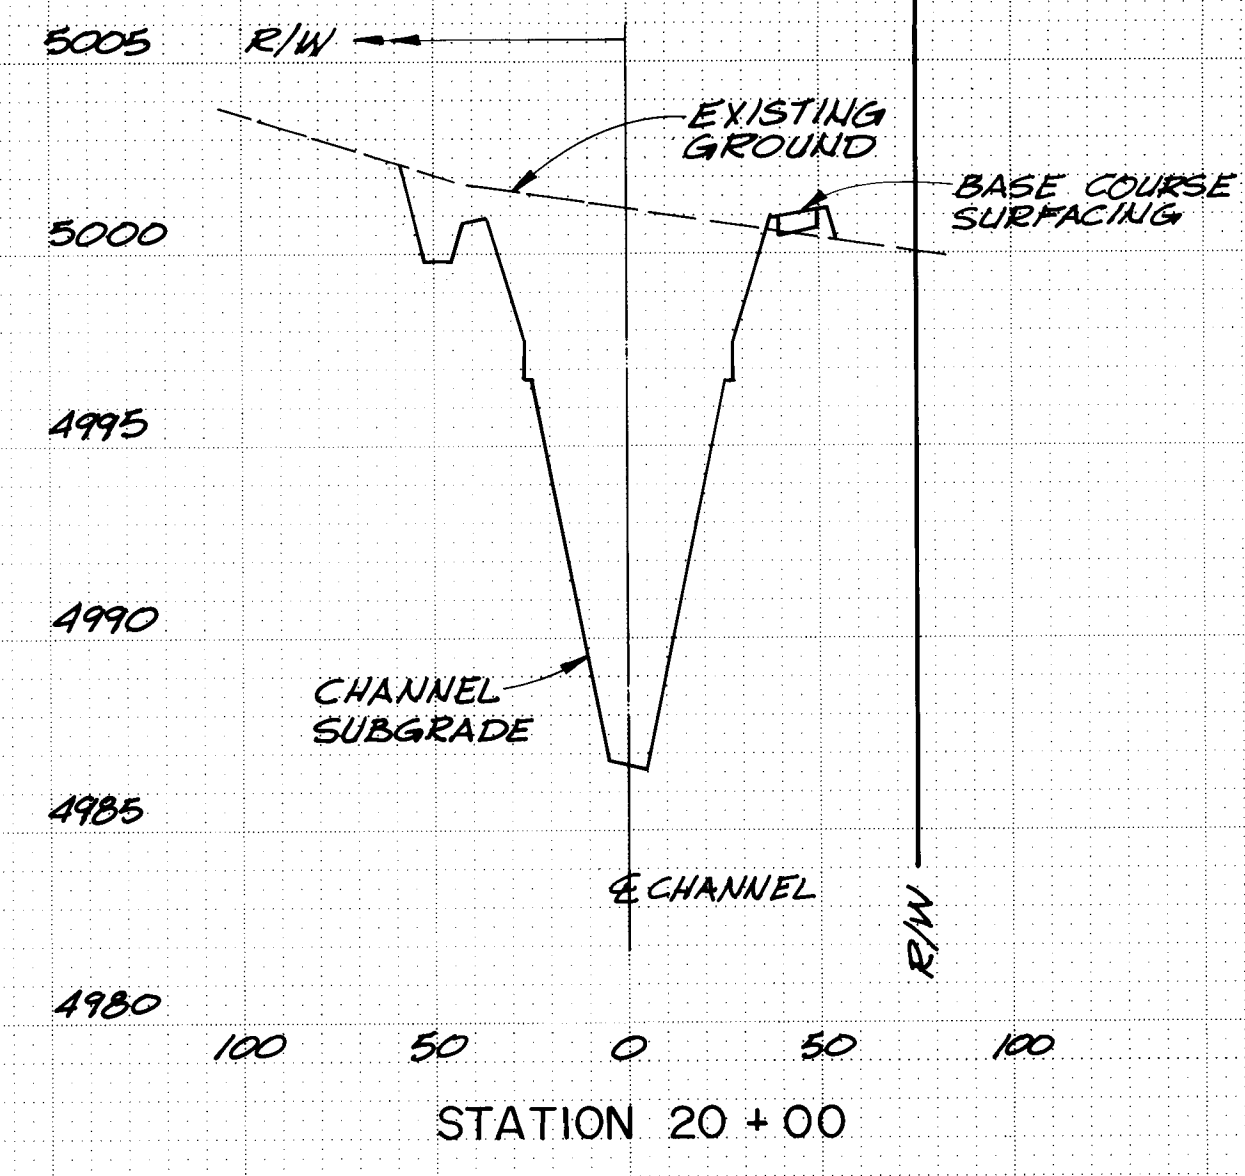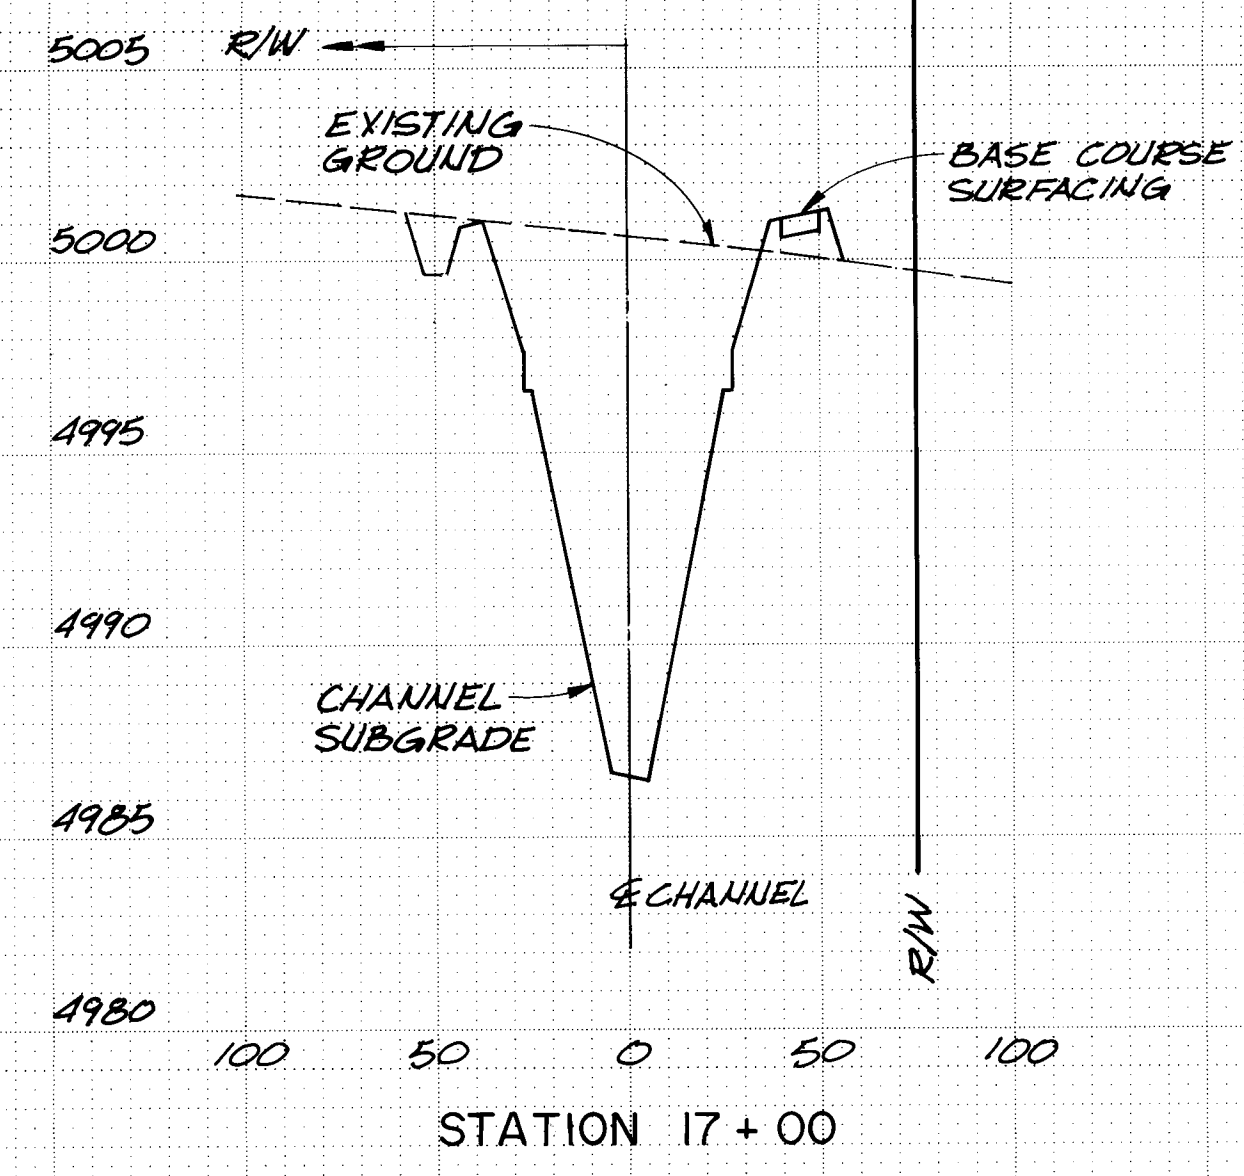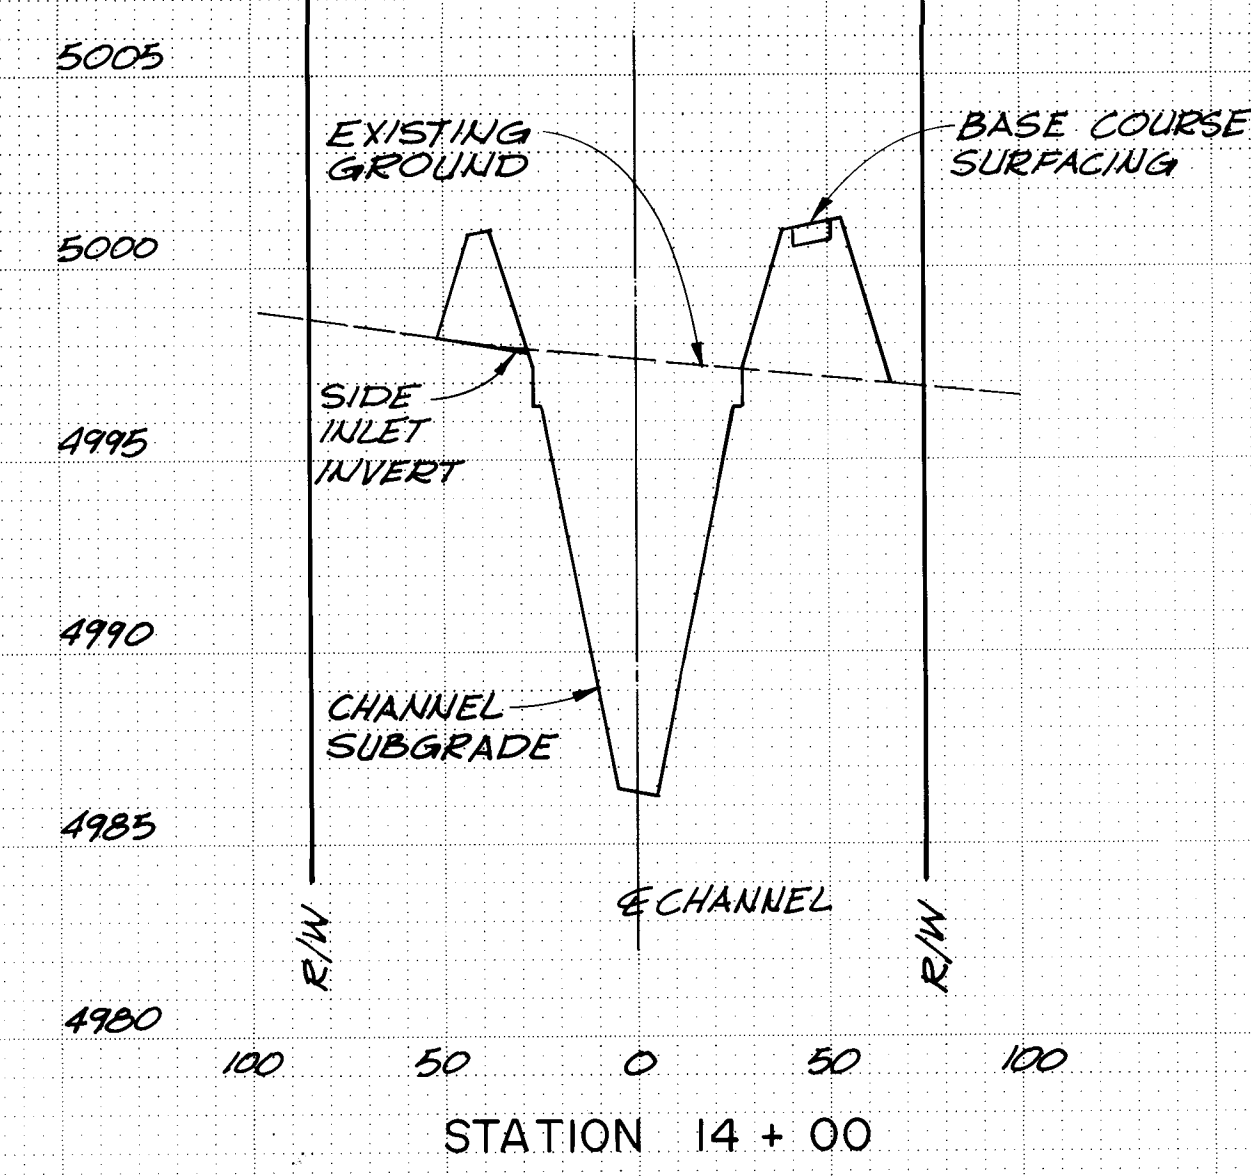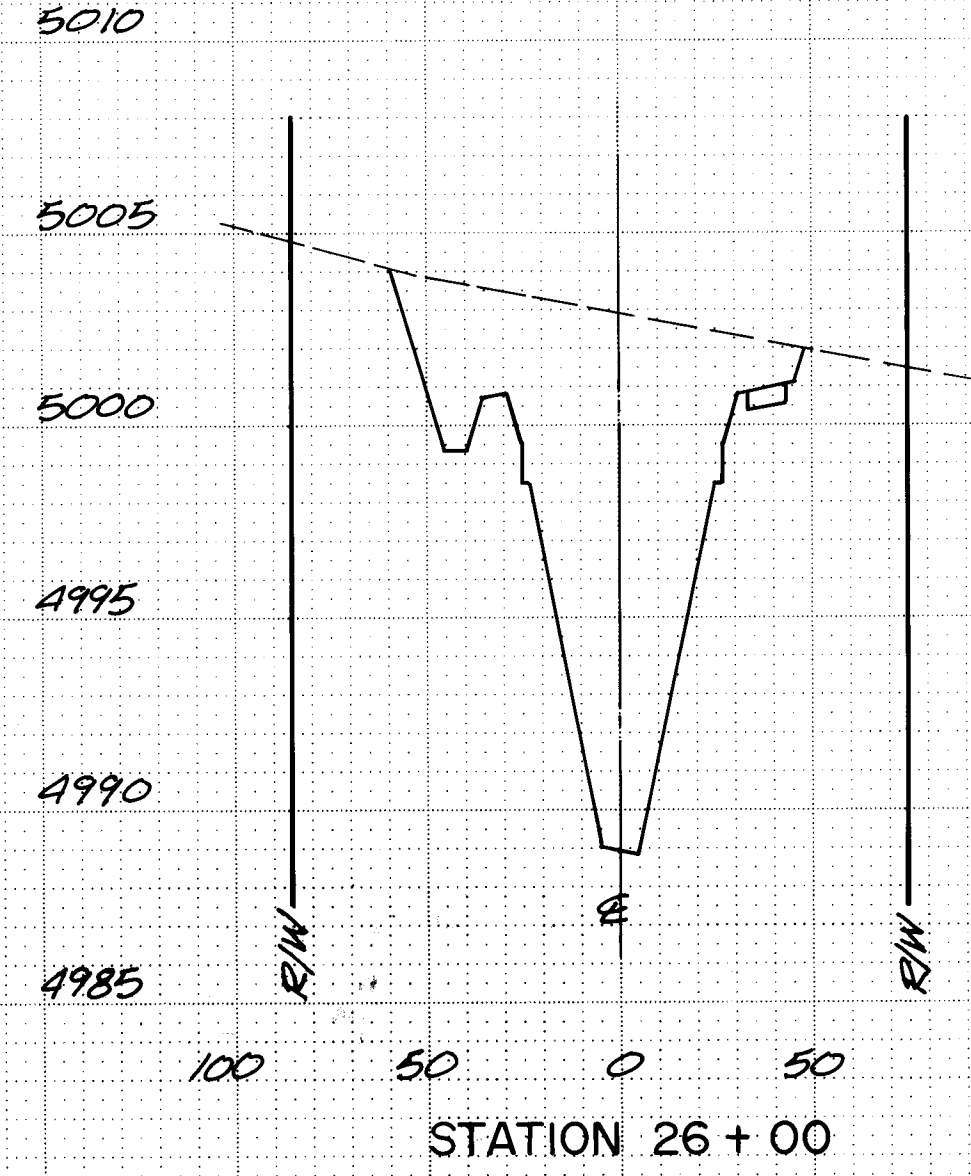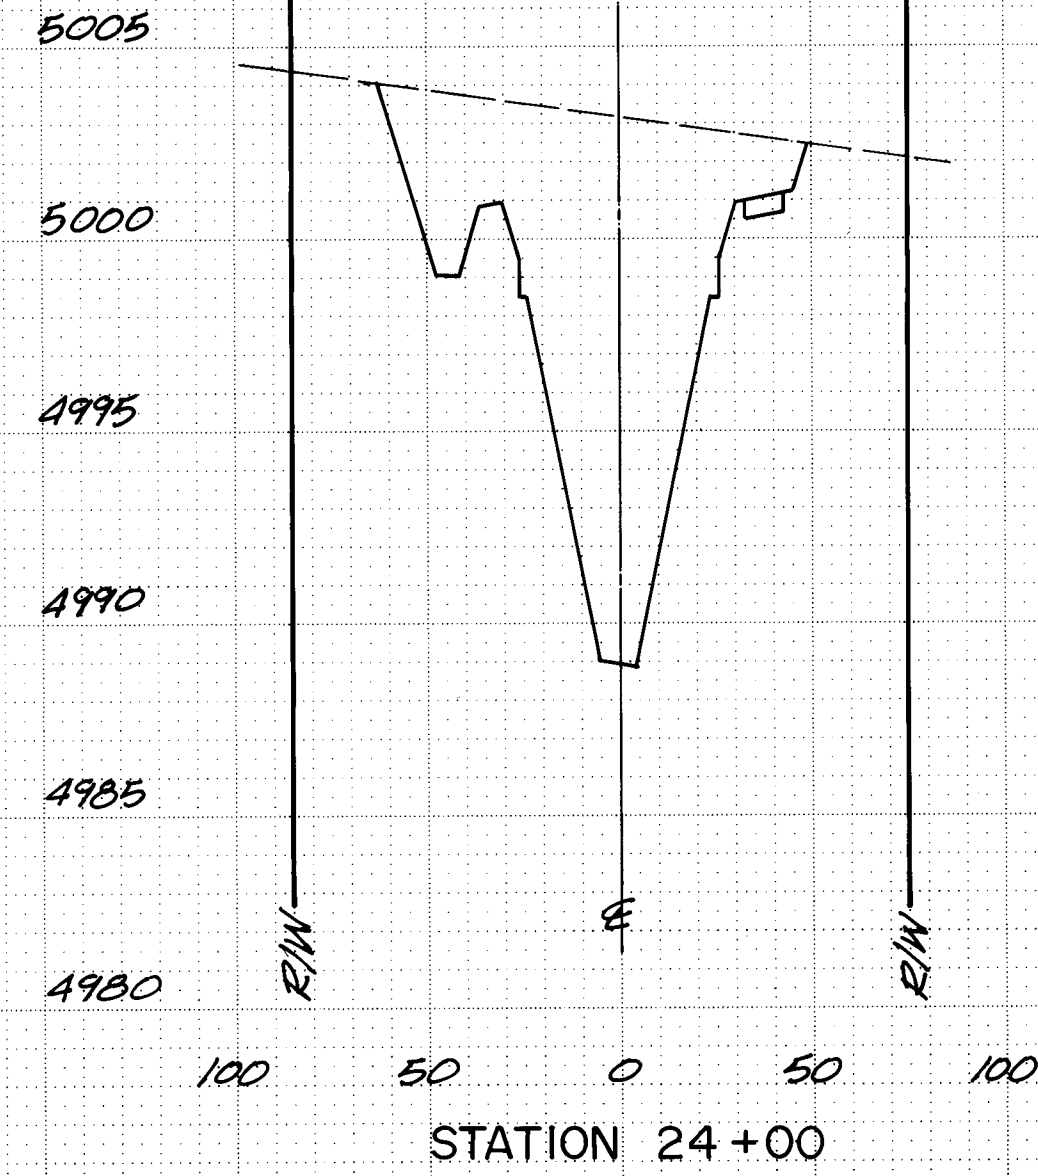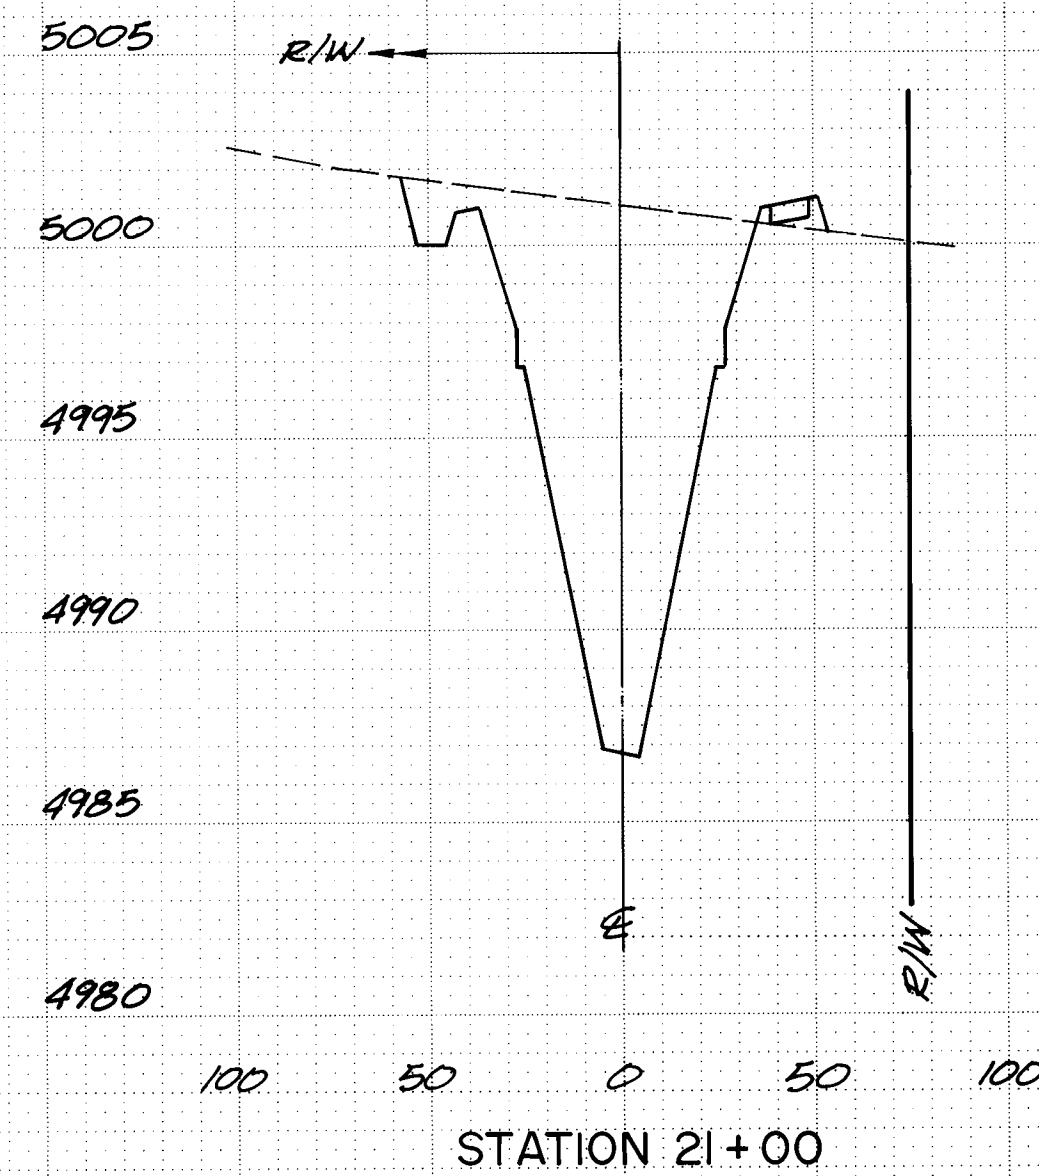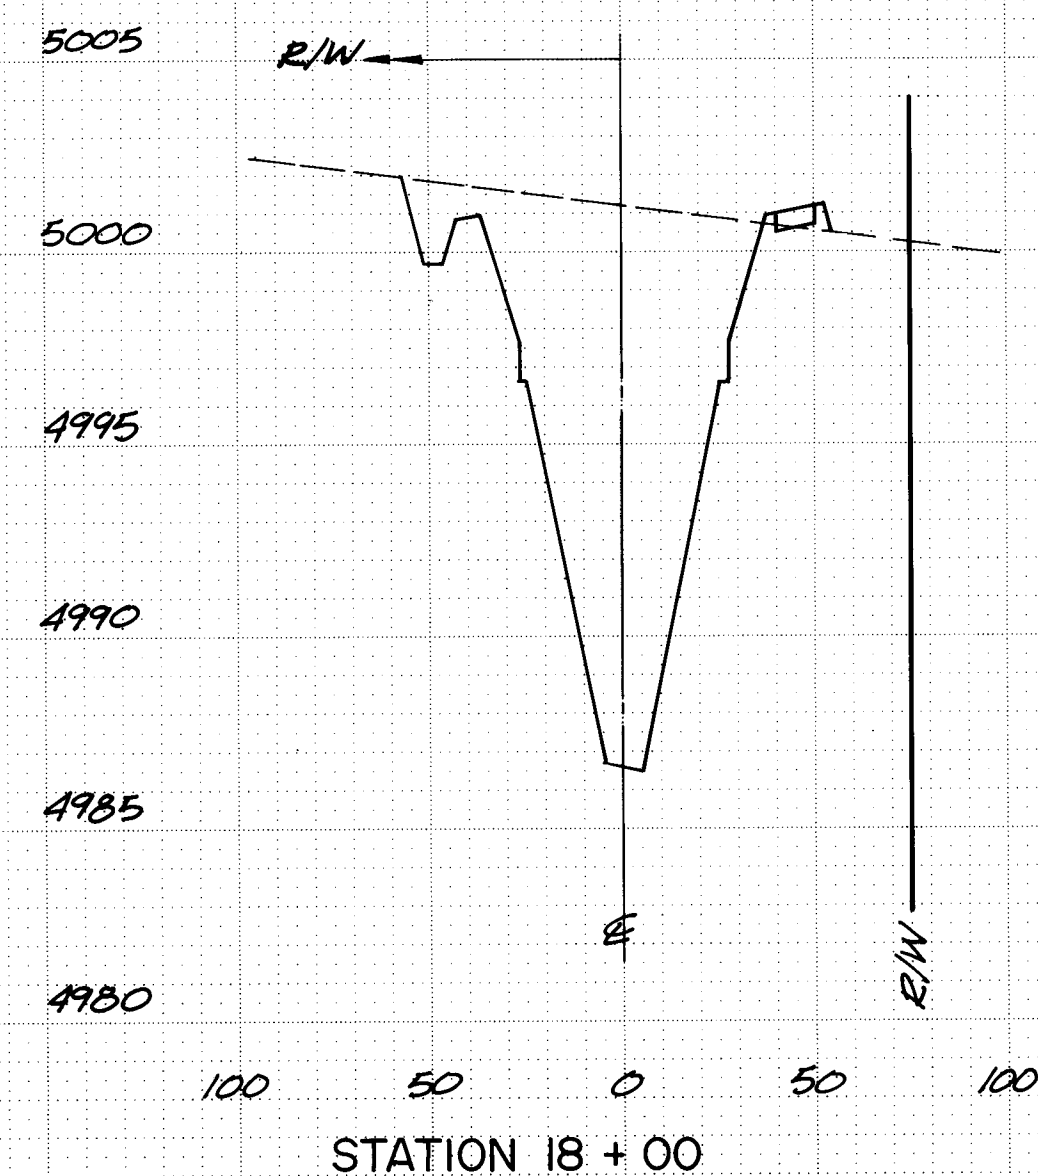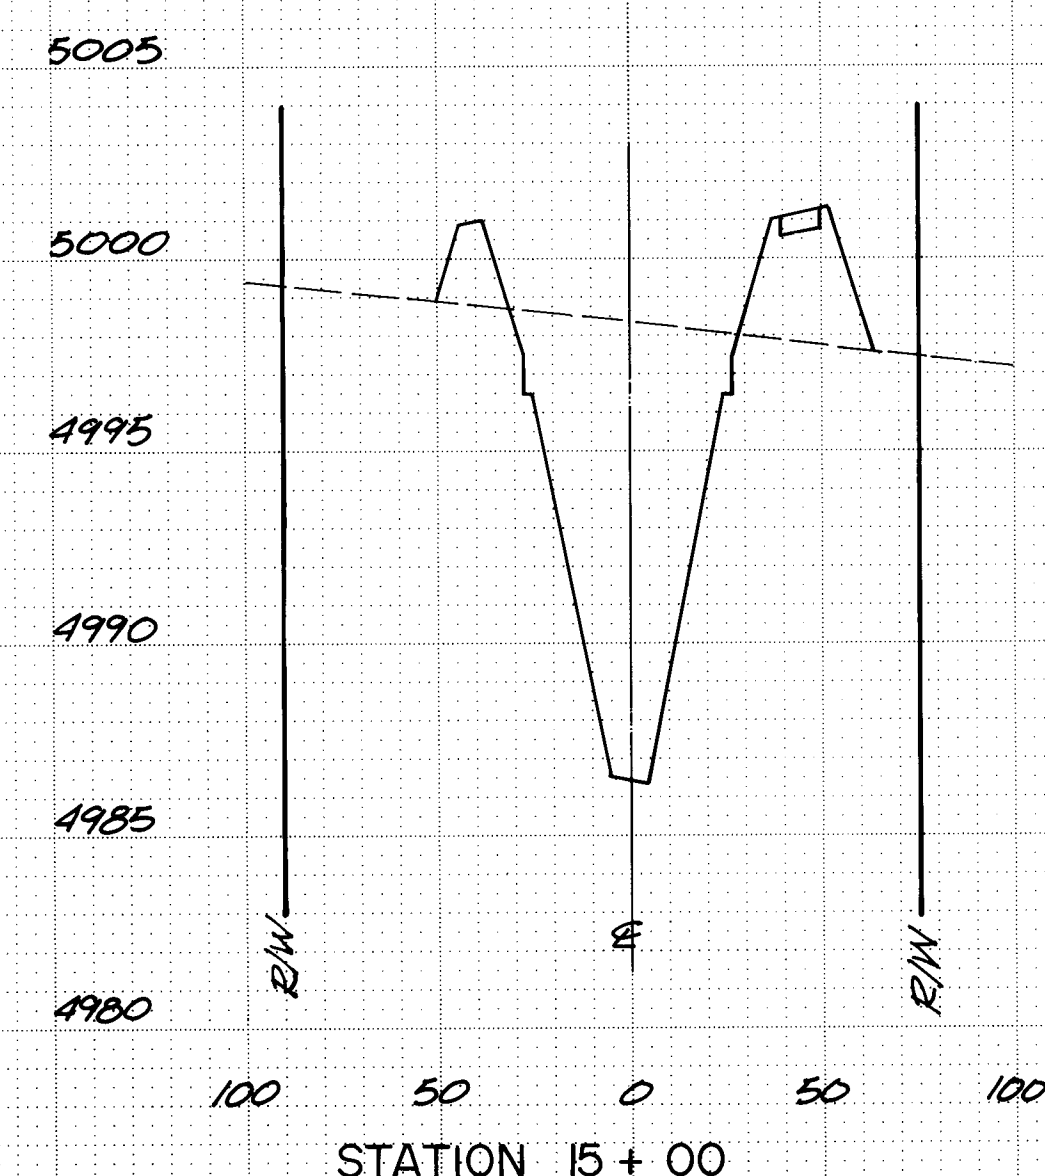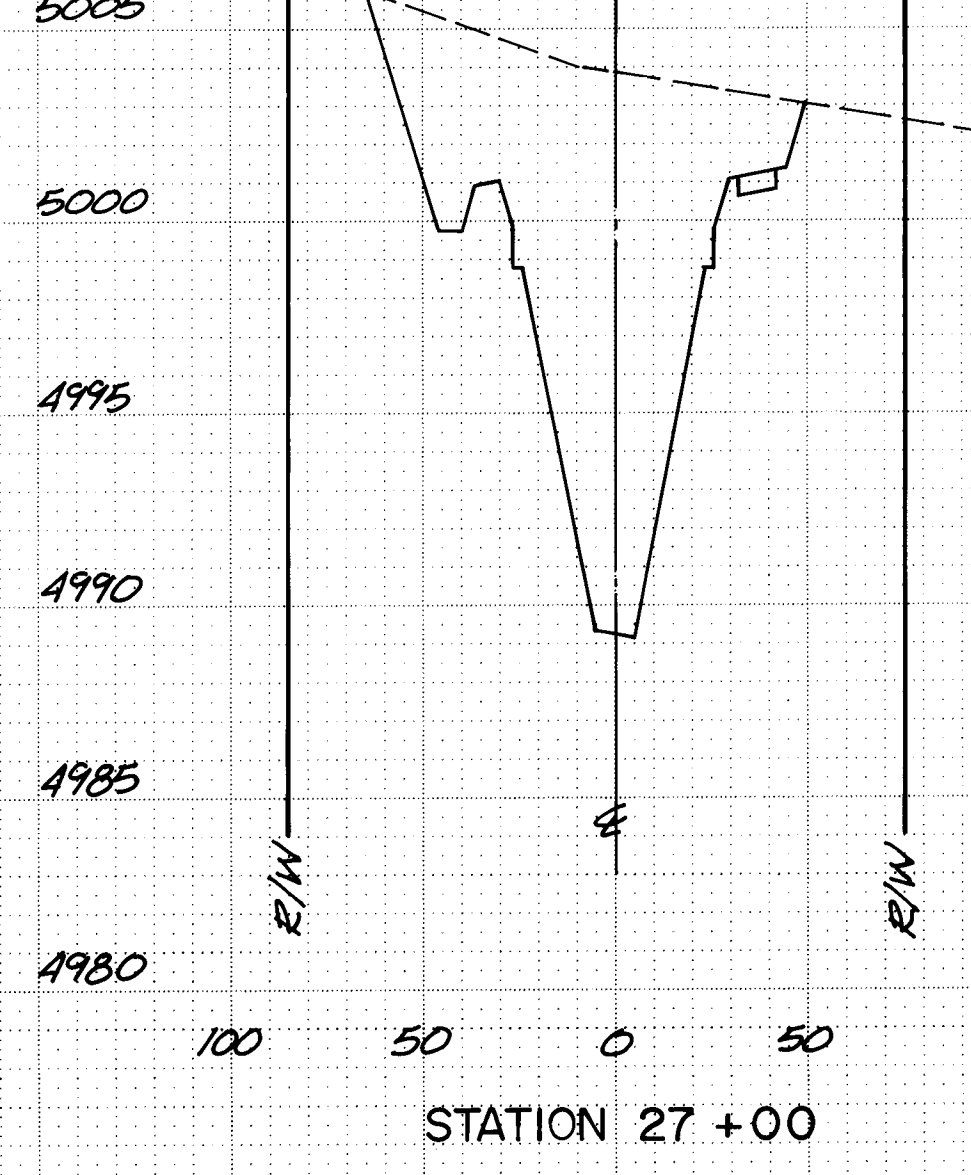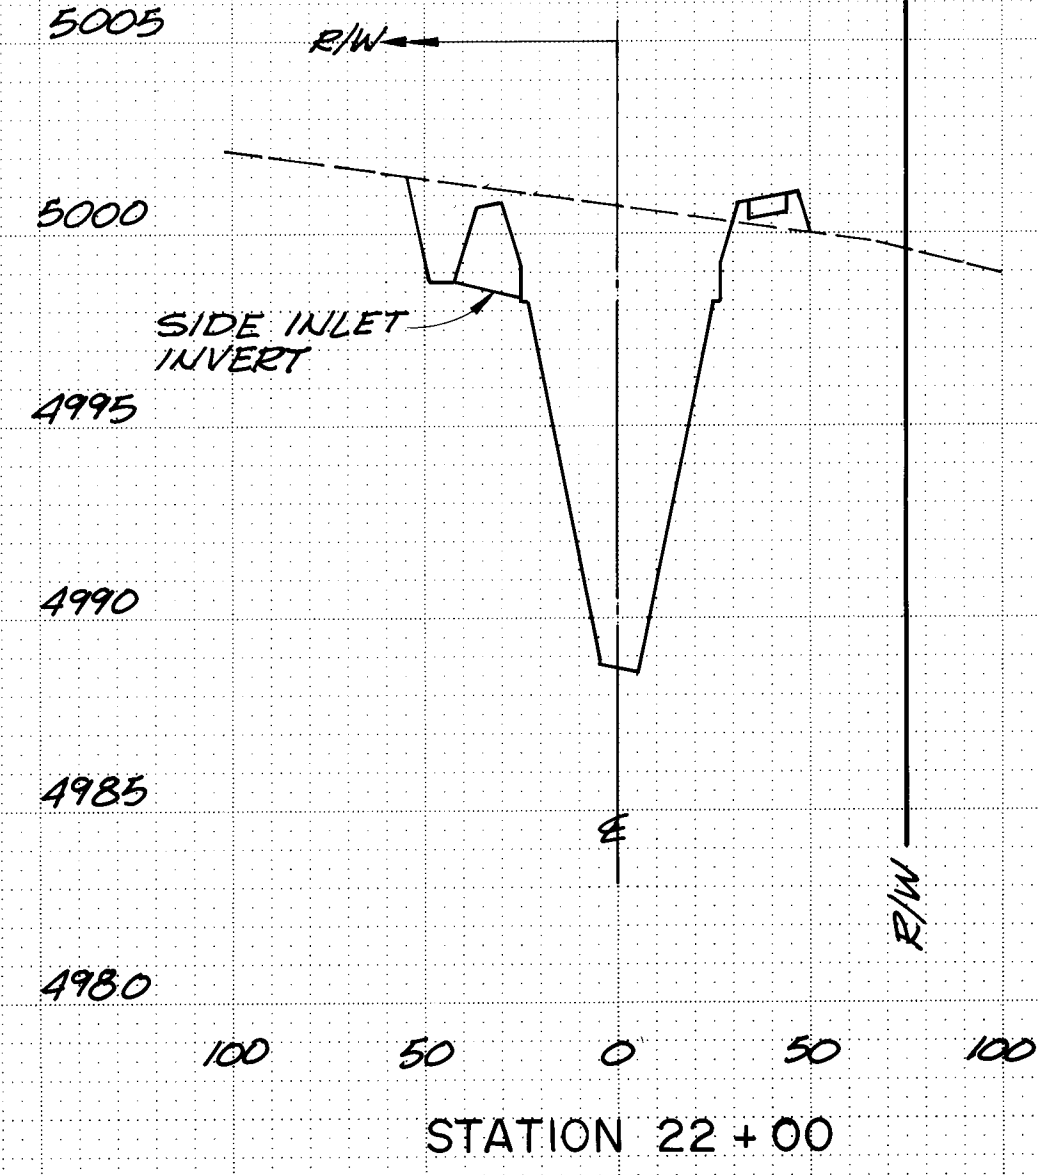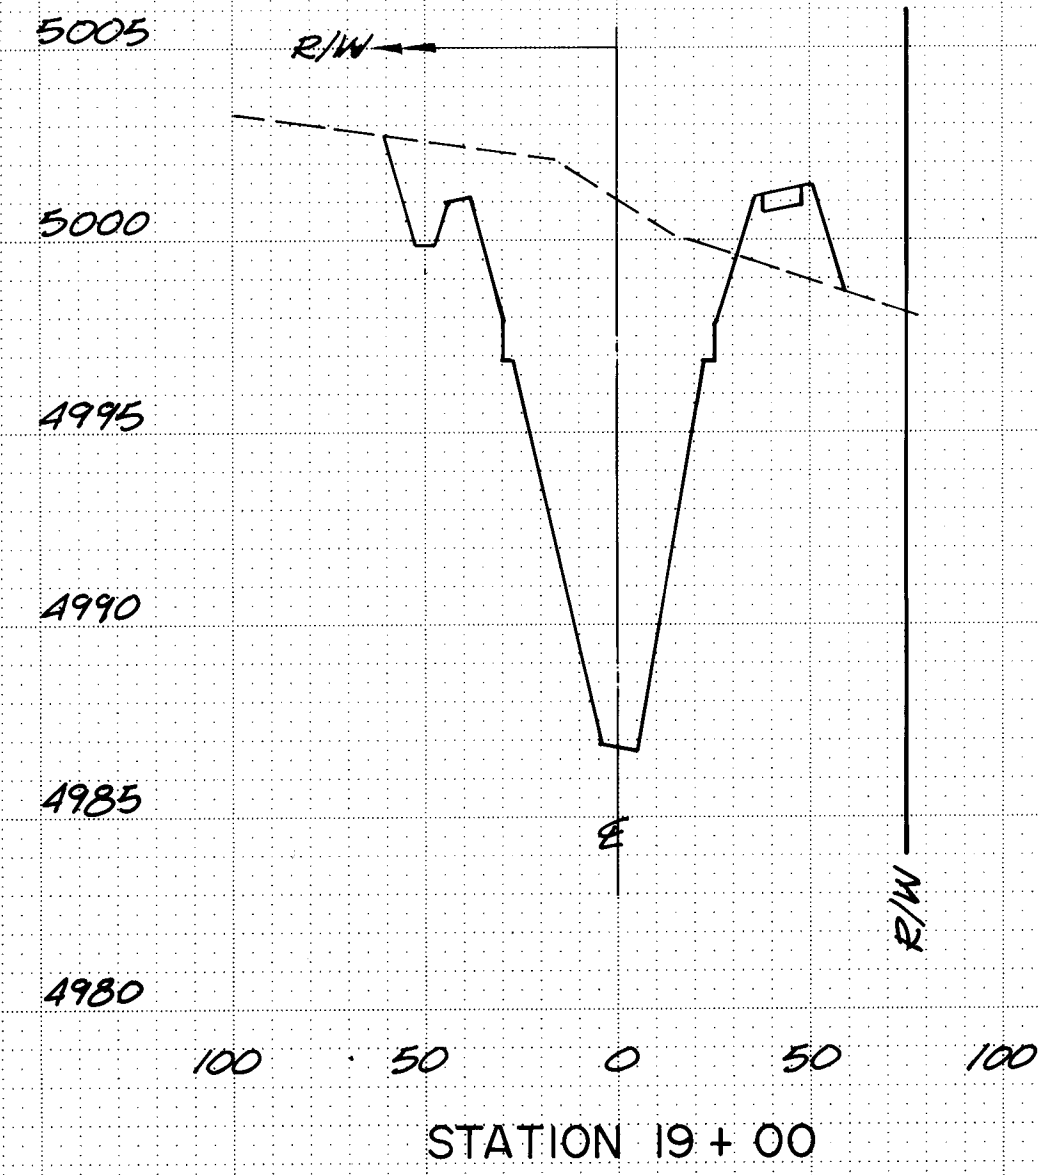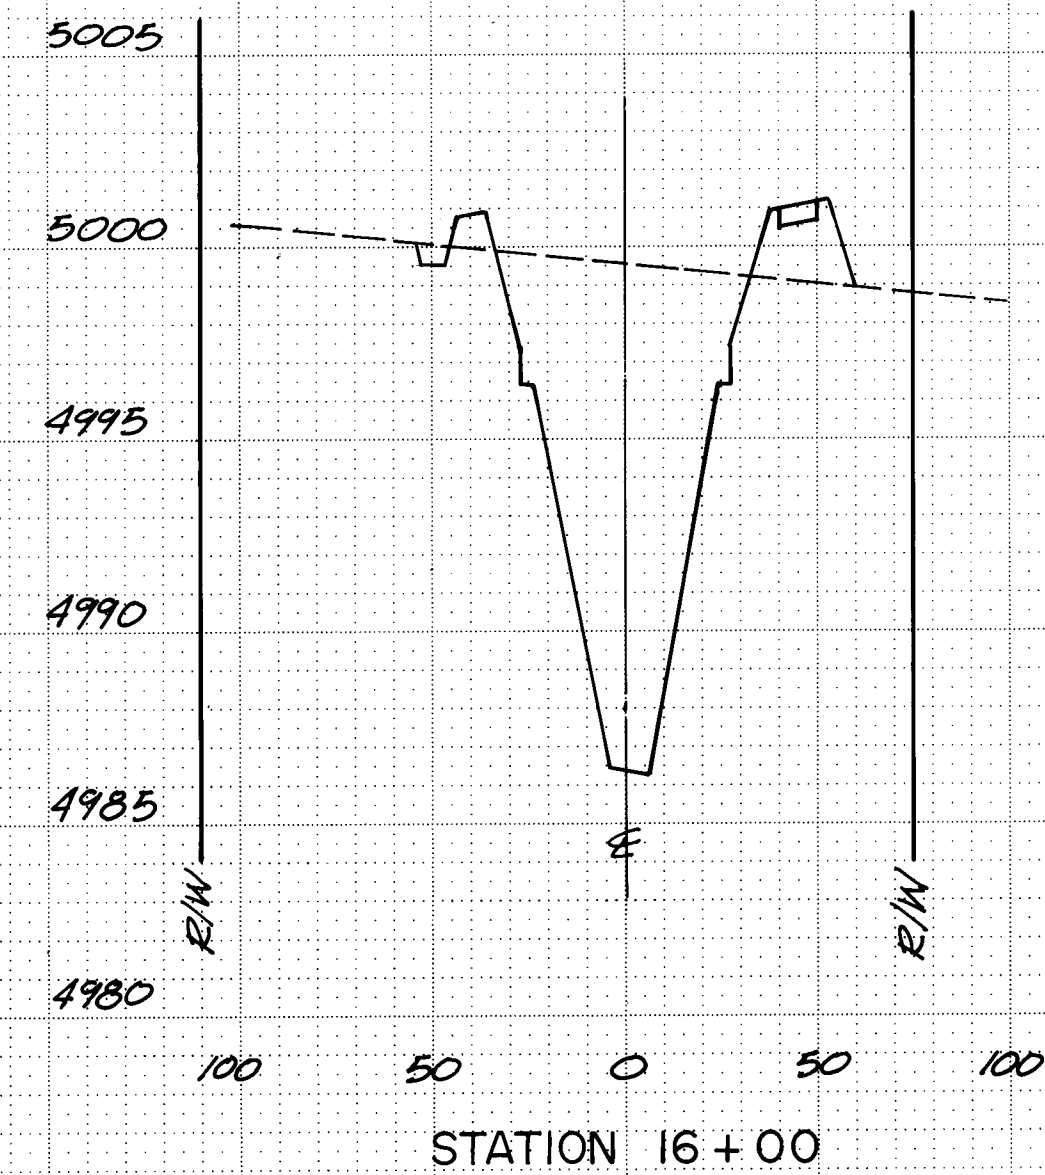


RECORD DRAWING

These record drawings were made by the engineer or his authorized representative under the supervision of the engineer or his authorized representative. They are to be used for the purpose of showing the location and construction of the work shown on the drawings. They are not to be used for any other purpose without the written consent of the engineer.

SCALE:
1"=50' HORIZ.
1"=5' VERT.

THE FOLLOWING VERTICAL EQUATION IS NEEDED TO MATCH AMOLE DEL NORTE AERIAL TOPOGRAPHIC ELEVATIONS APPEARING IN THESE DRAWINGS WITH ALBUQUERQUE CITY SURVEY ELEVATIONS:
AMOLE DEL NORTE DATUM + 0.32 FT.
= ACS DATUM (1929 MSLD)

CHANNEL CROSS SECTIONS
STA. 14+00.00 TO STA. 27+00.00
AMOLE DEL NORTE STORM DIVERSION FACILITY

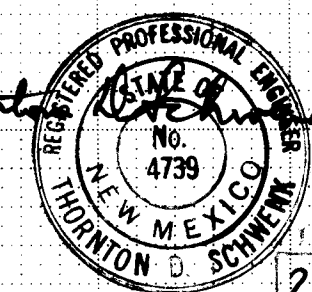













26 24801897

DRAWING NO.
2480

SHEET
18 OF 21

DATE	BY
ORIGINAL SURVEY	PLANNED
NO.	NO.
NOTED	NOTED
AREAS CHECKED	AREAS CHECKED

DATE	BY
ORIGINAL SURVEY	PLANNED
NO.	NO.
NOTED	NOTED
AREAS CHECKED	AREAS CHECKED

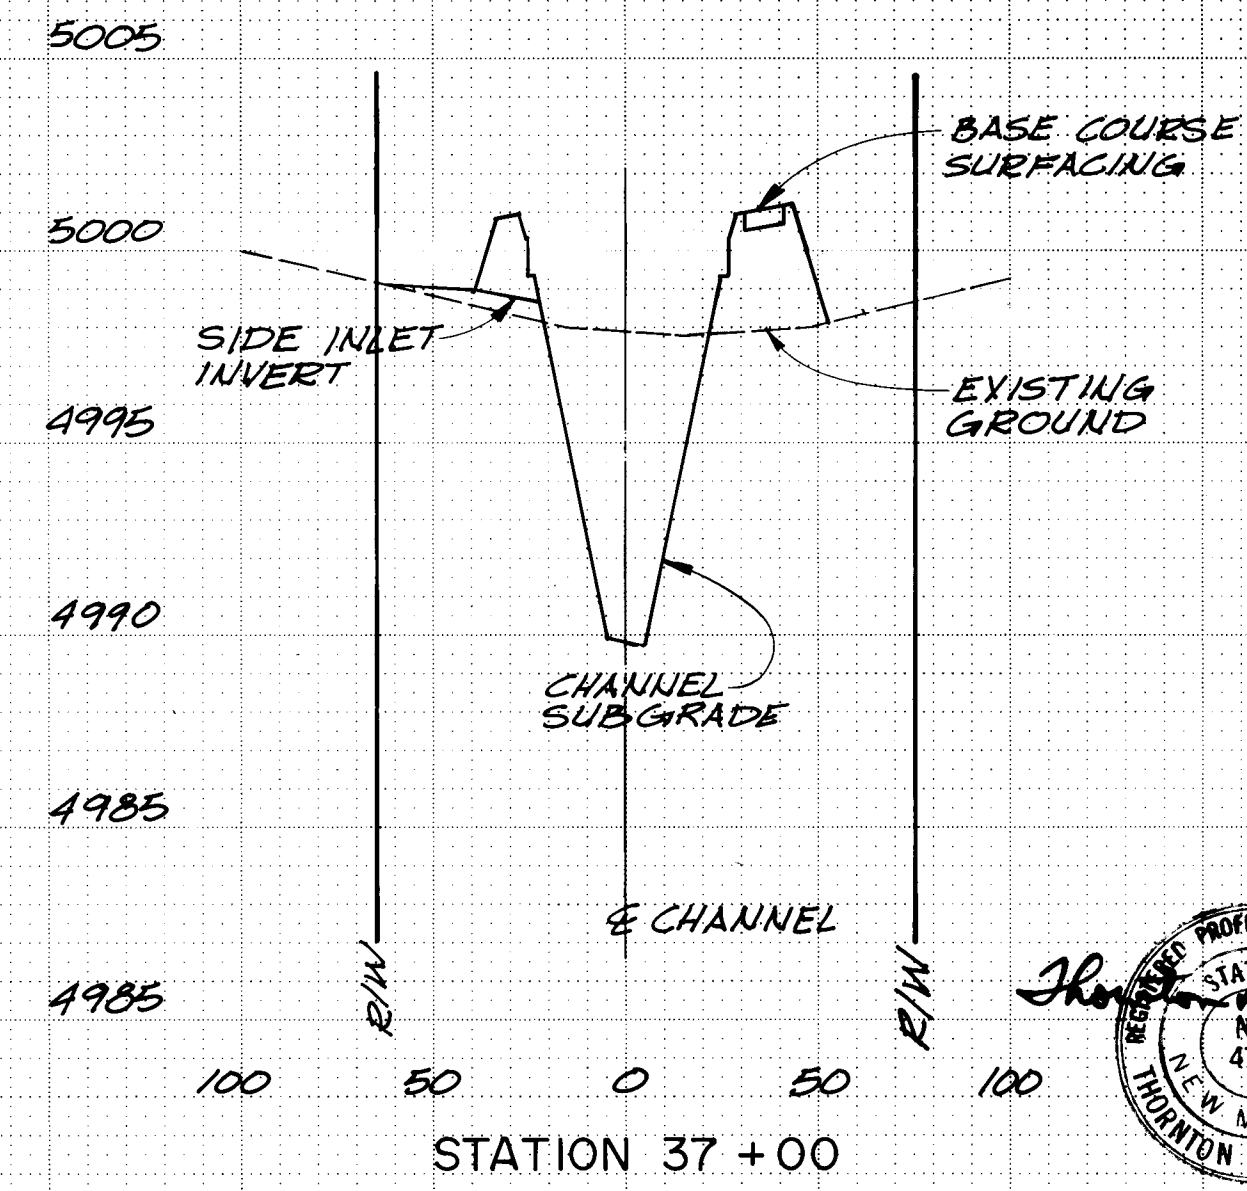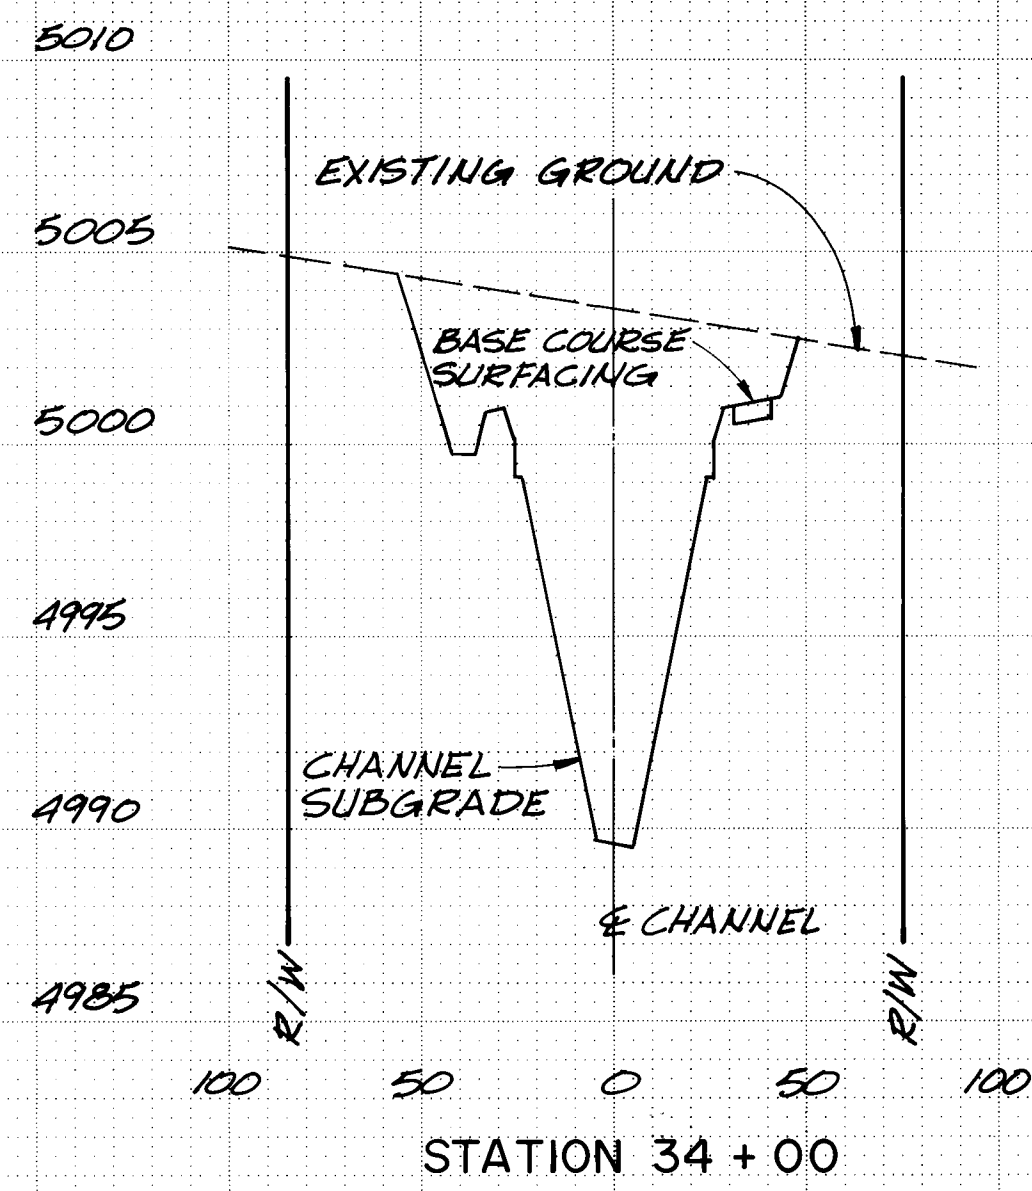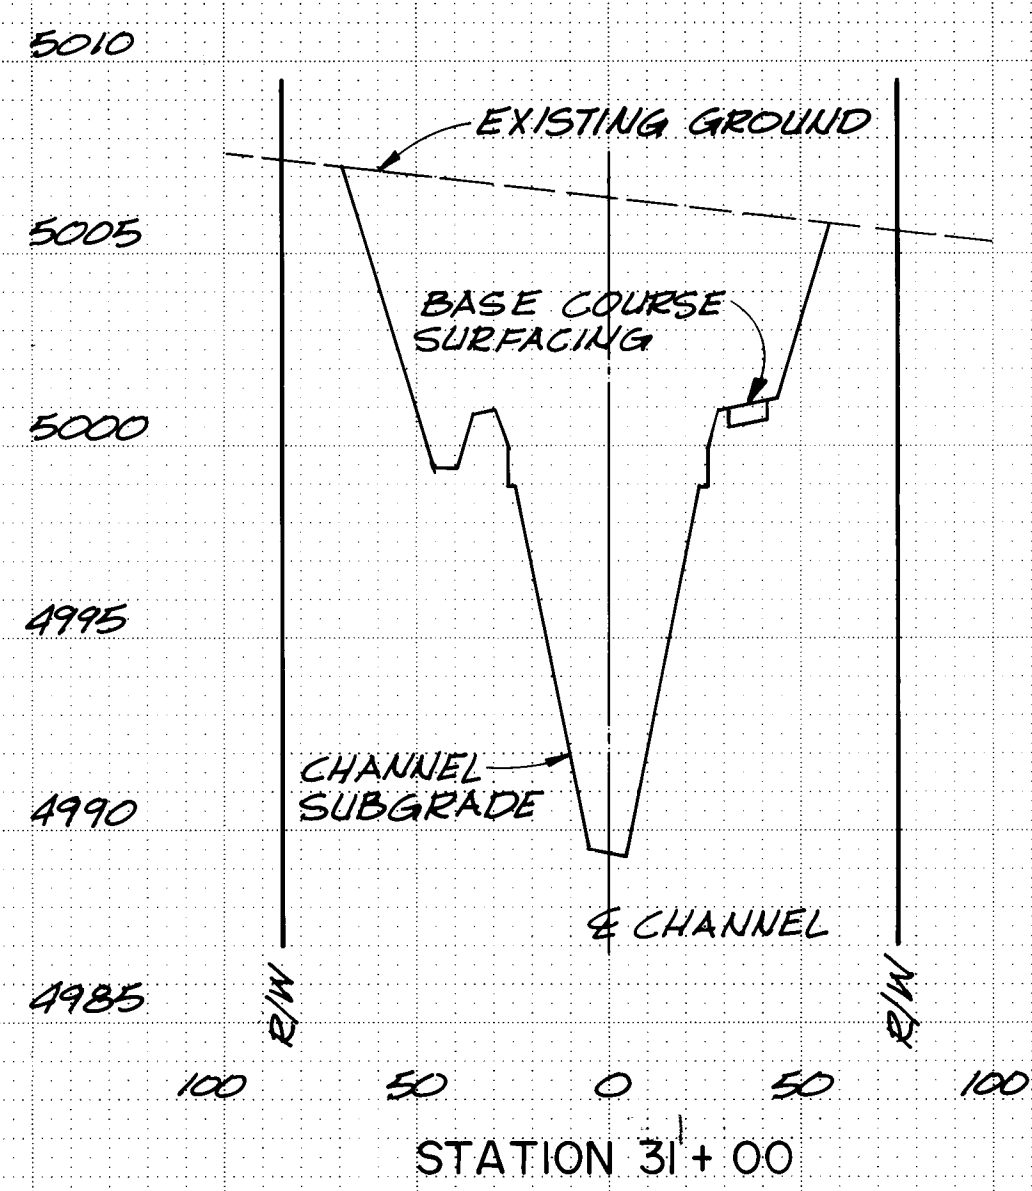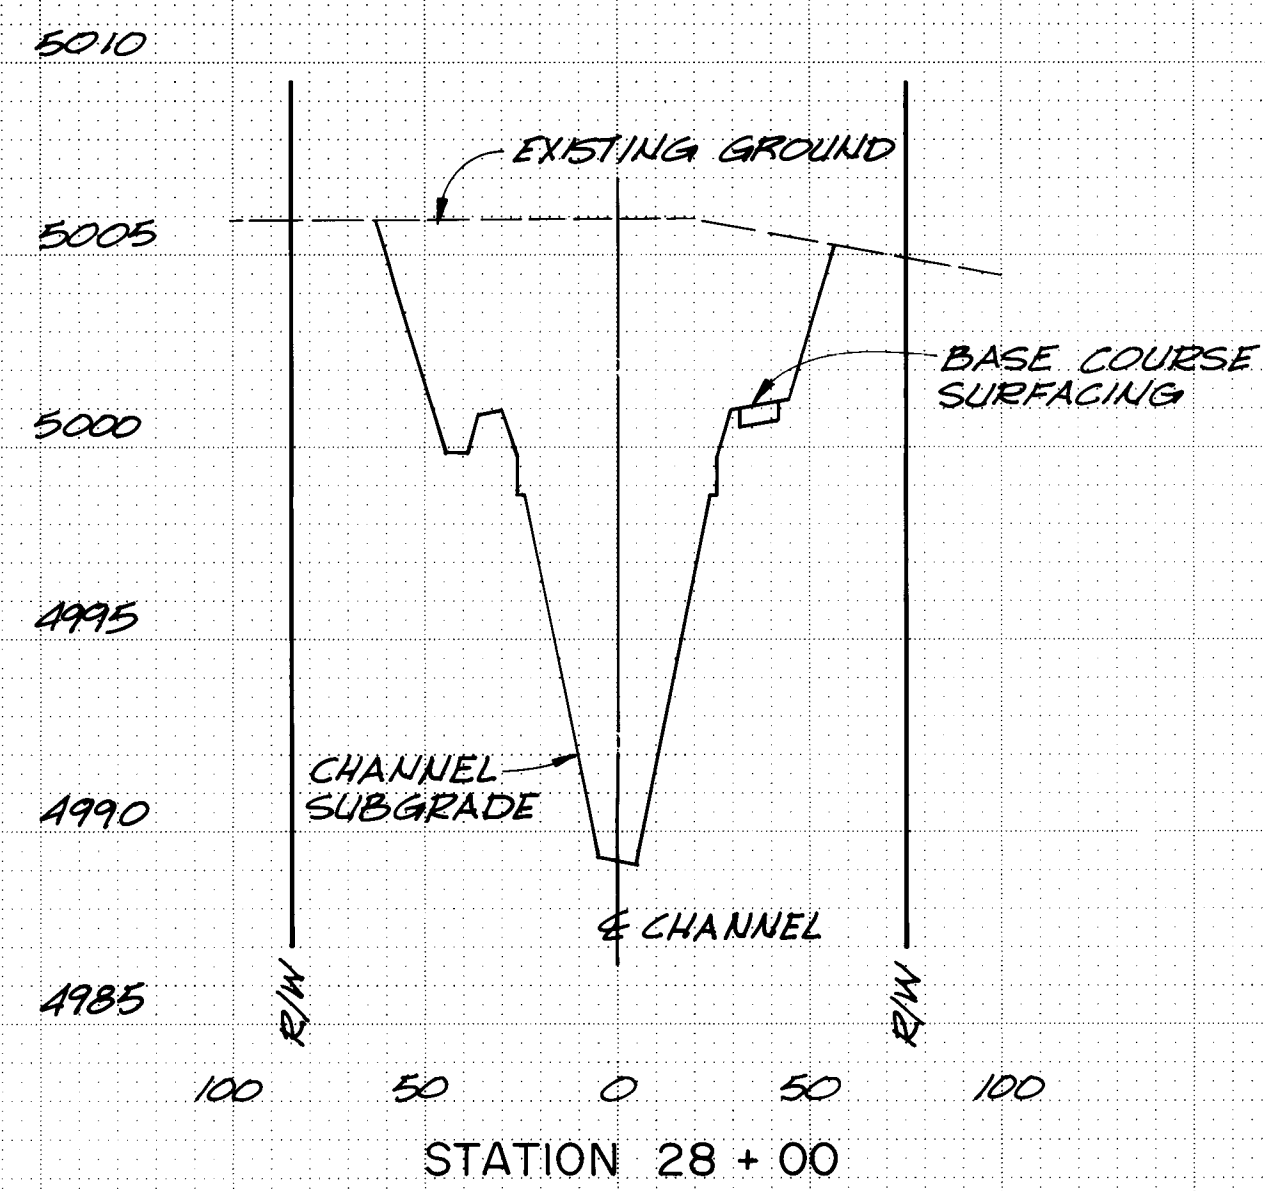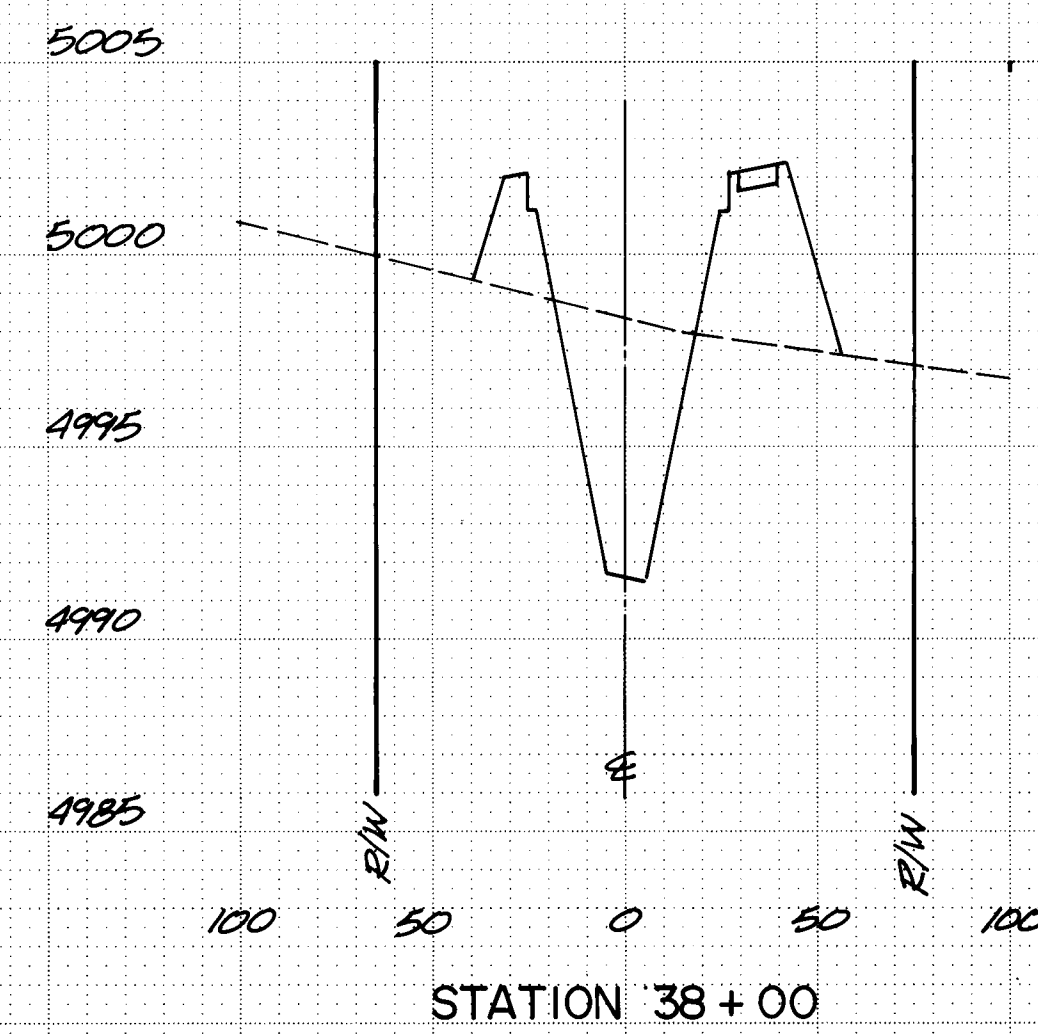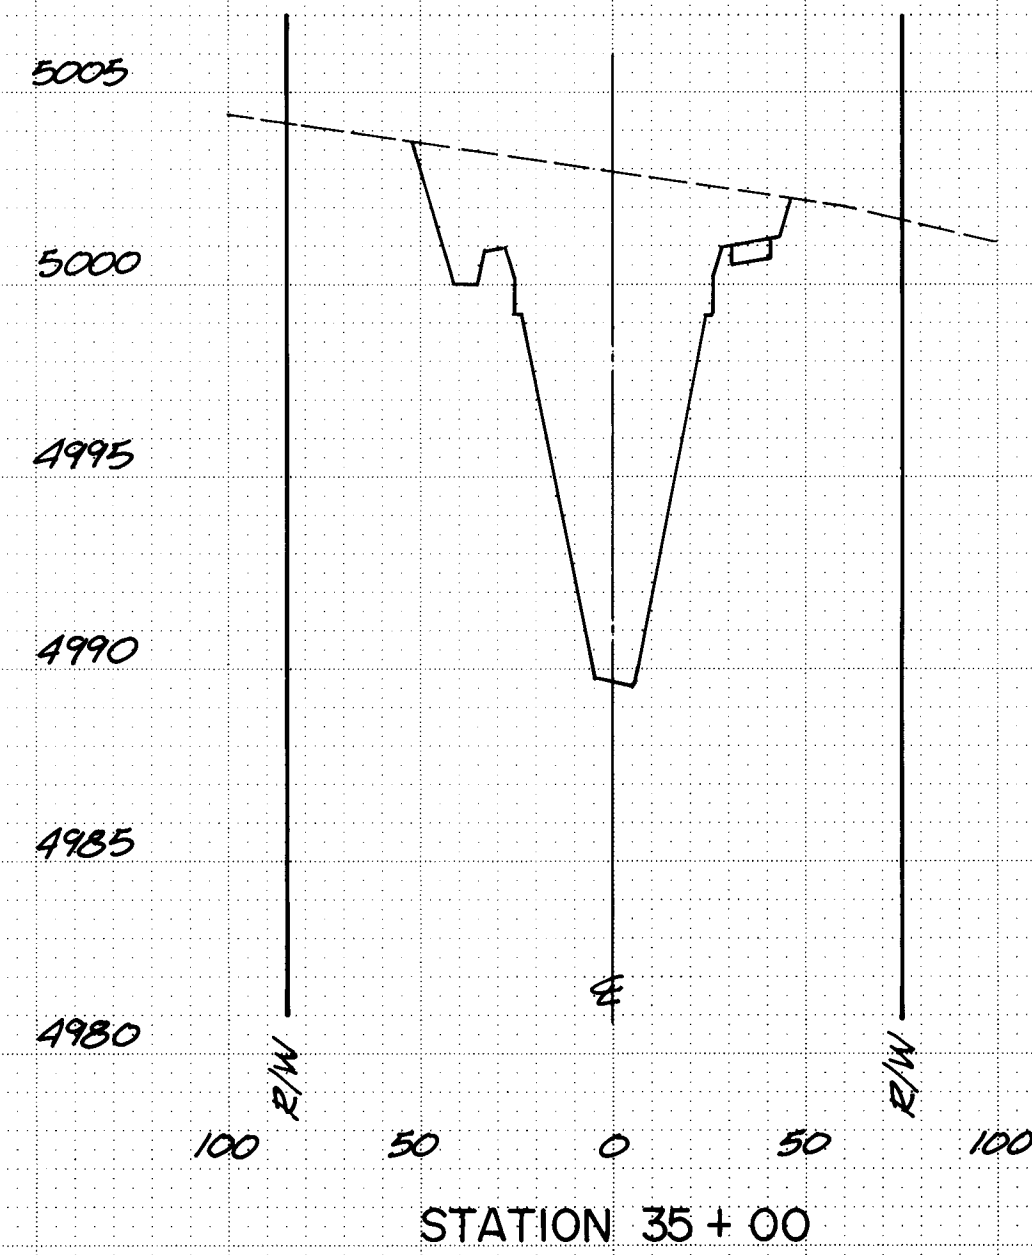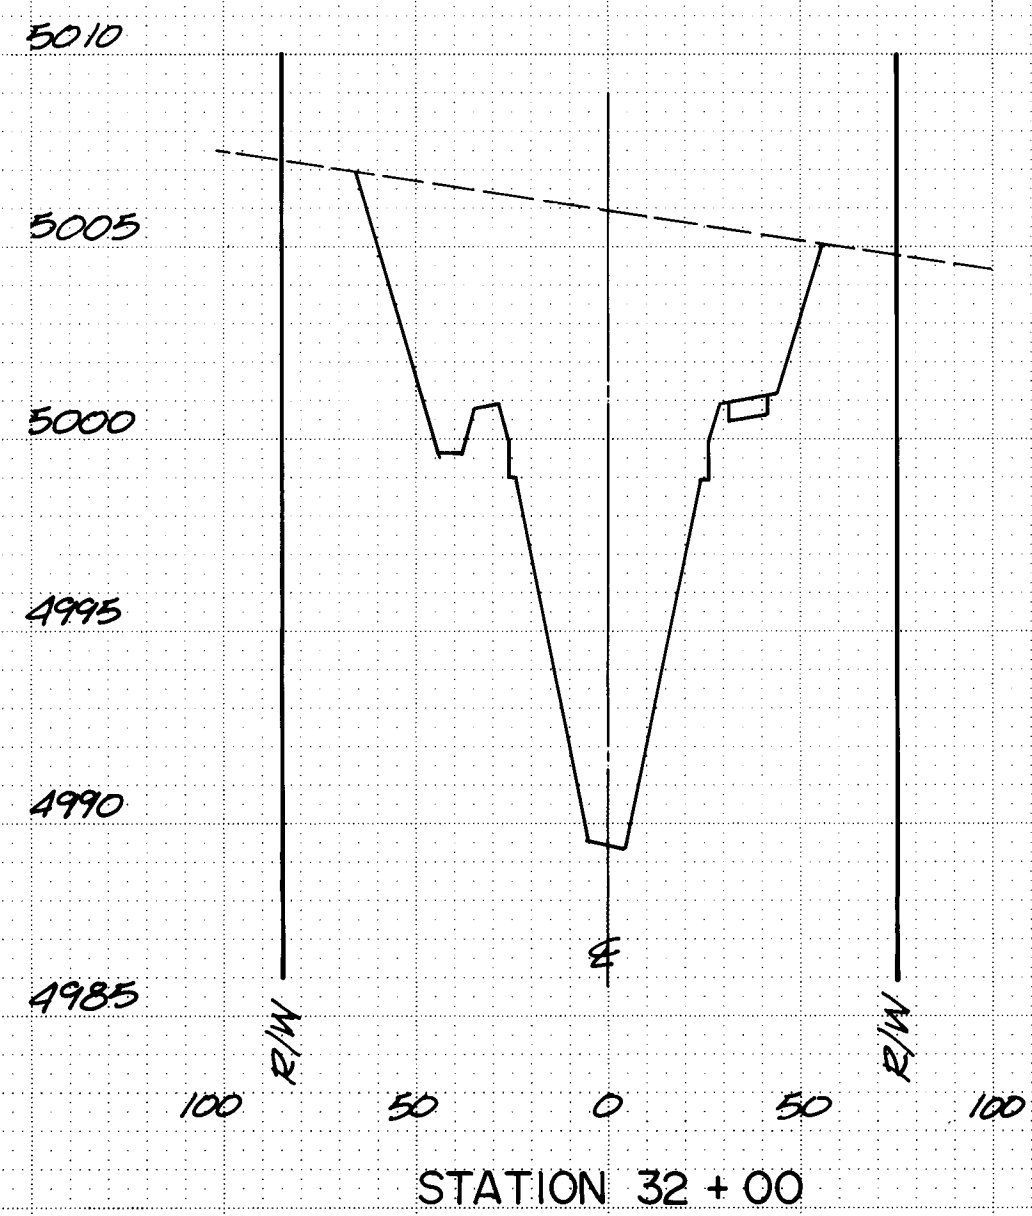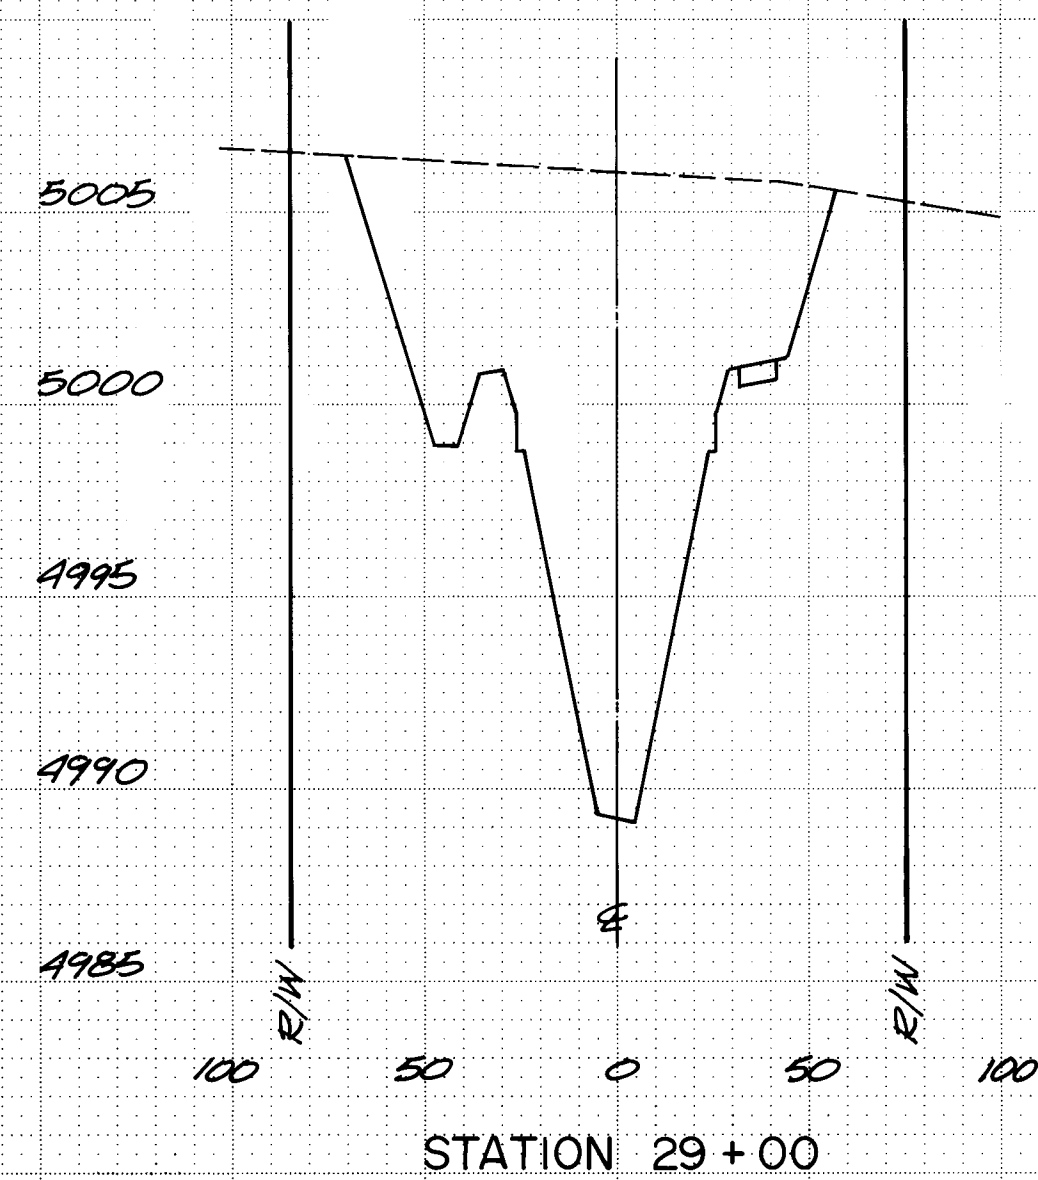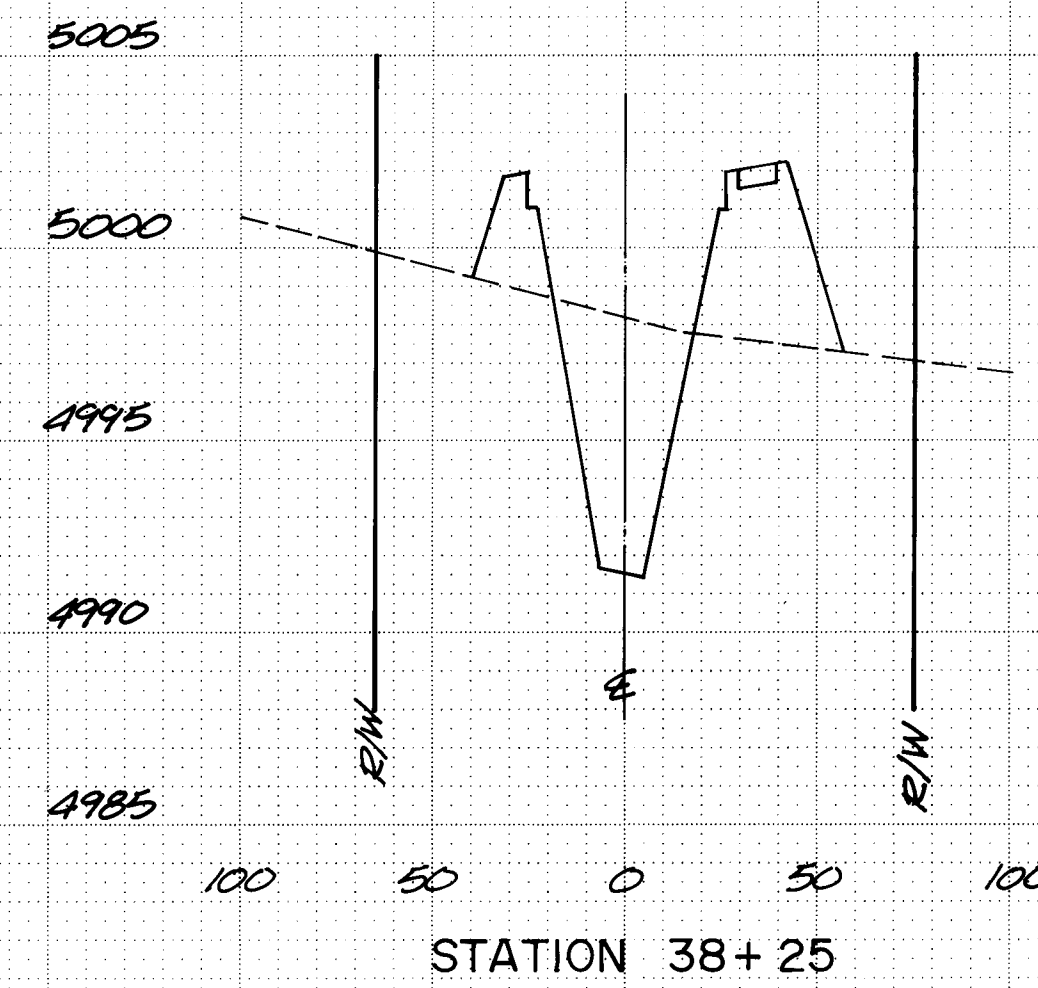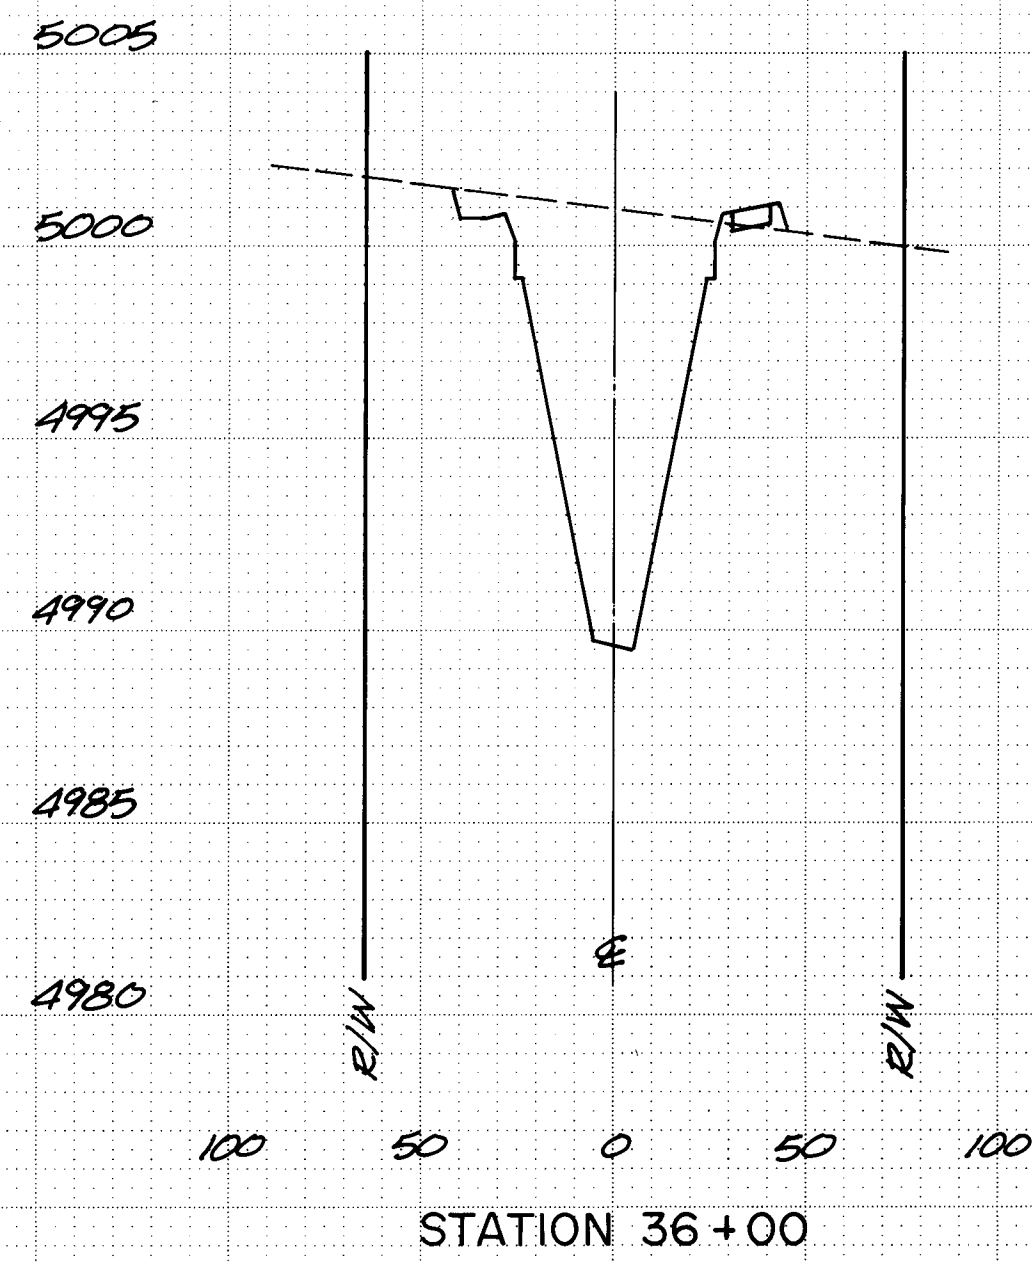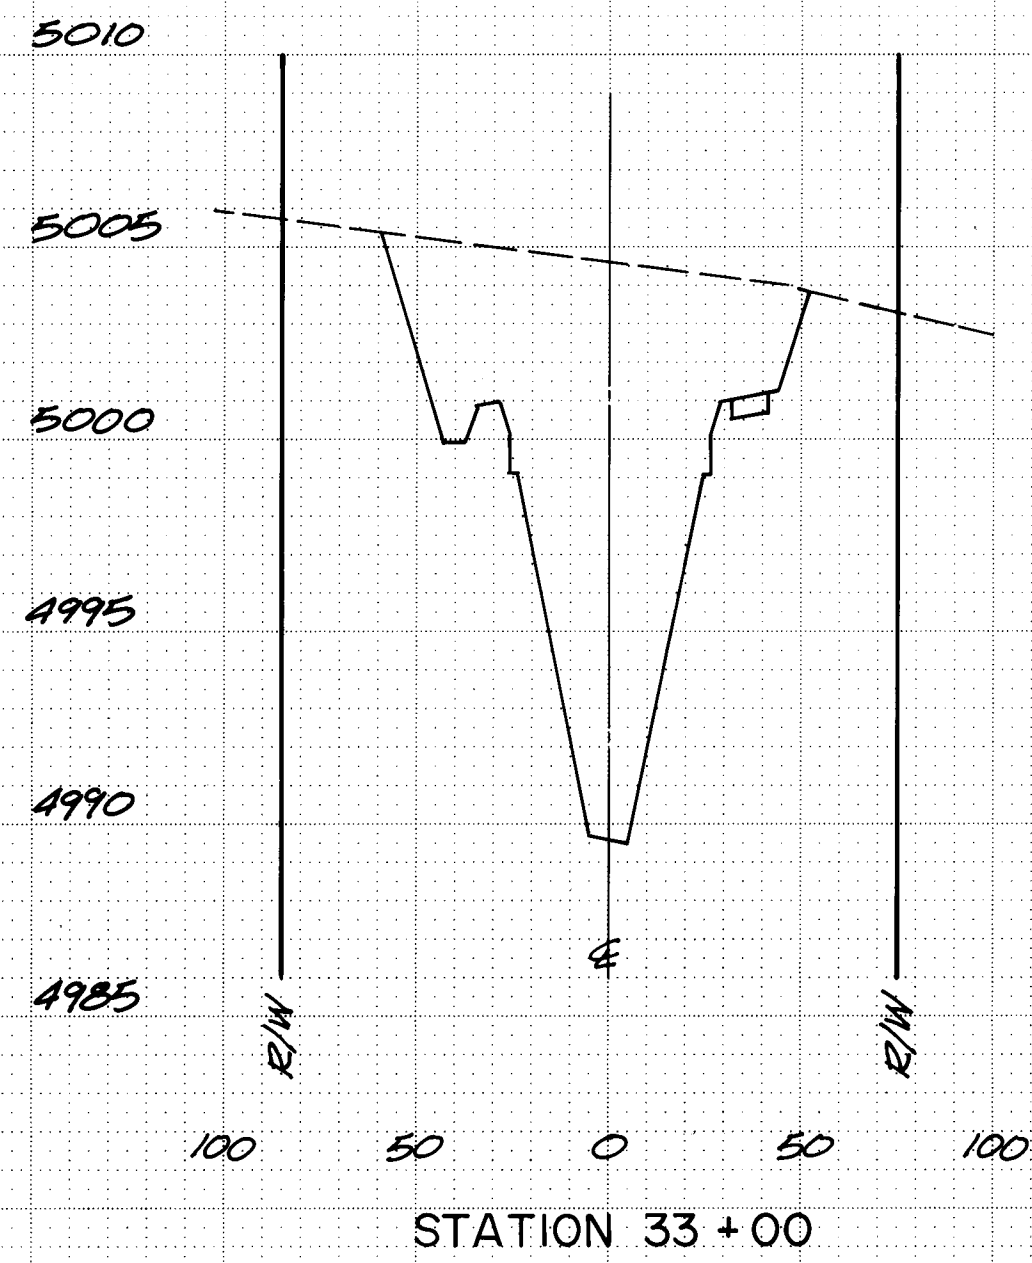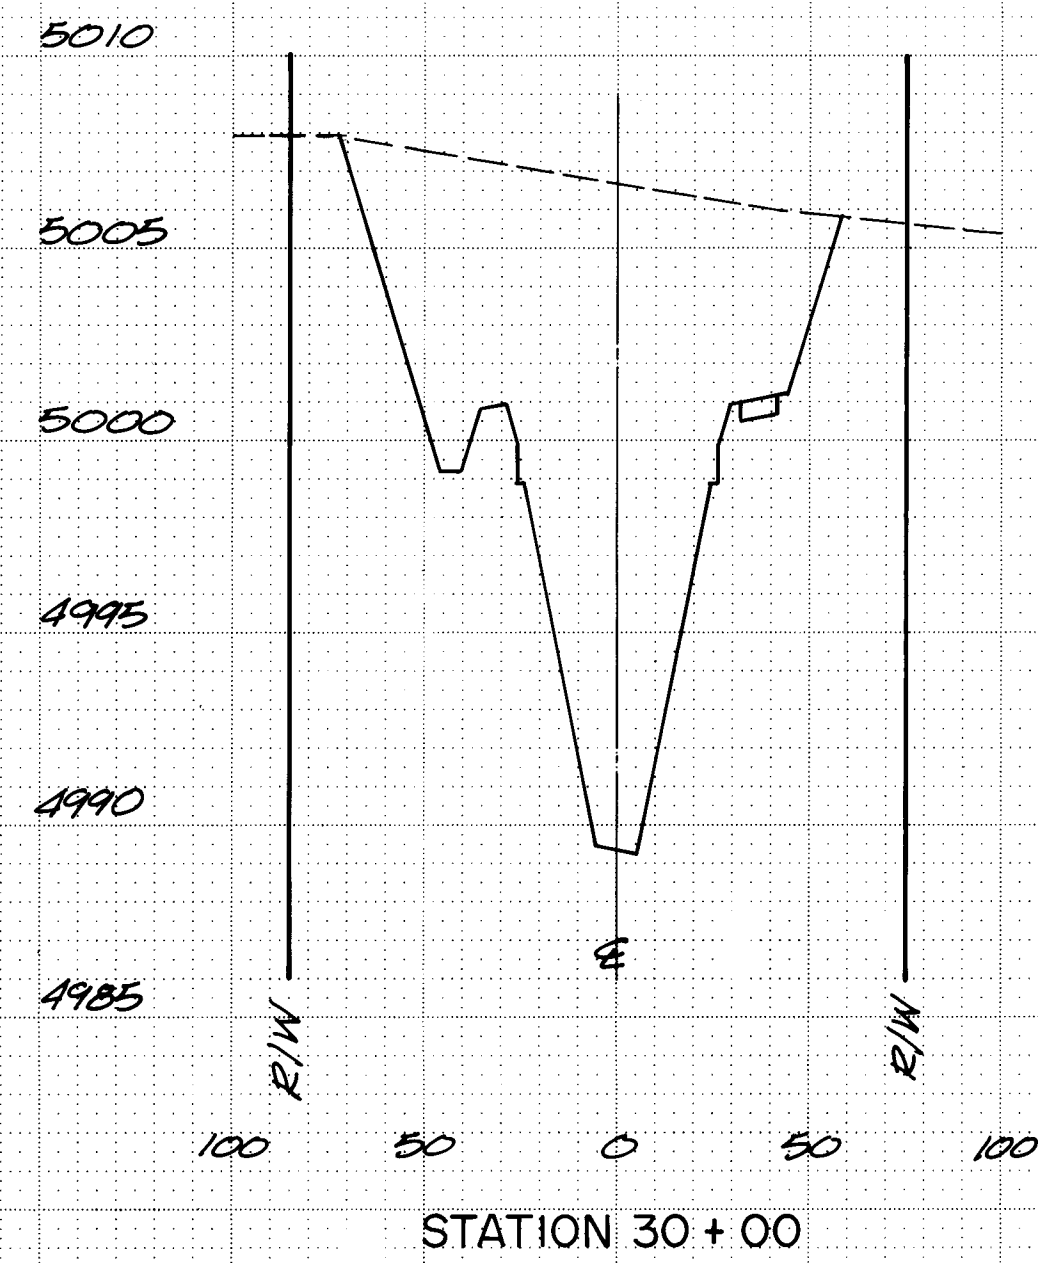

RECORD DRAWING


These record drawings apply only to those facilities constructed under the contract identified in the title block and have been prepared, in part, on the basis of information compiled and furnished by others. Any engineering or construction work not shown on these drawings is the responsibility of the contractor. No part of this drawing shall be used for any other purpose without the written consent of the engineer.

SCALE:
1" = 50' HORIZ.
1" = 5' VERT.

THE FOLLOWING VERTICAL EQUATION IS NEEDED TO MATCH AMOLE DEL NORTE AERIAL TOPOGRAPHIC ELEVATIONS APPEARING IN THESE DRAWINGS WITH ALBUQUERQUE CITY SURVEY ELEVATIONS
AMOLE DEL NORTE DATUM + 0.32 FT.
= ACS DATUM (1929 MSLD)


CHANNEL CROSS SECTIONS
STA 28+00.00 TO STA 38+25.00
AMOLE DEL NORTE STORM DIVERSION FACILITY

26 2480 1987

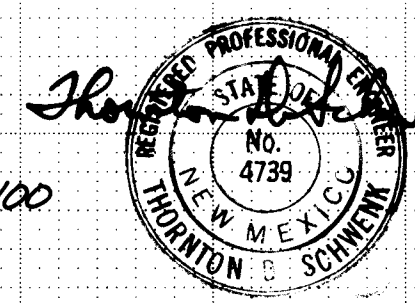

FINAL SURVEY NOTE BOOK NO.	SURVEYED PLOT TEMPLATE AREAS CHECKED	DATE	BY


ORIGINAL SURVEY NOTE BOOK NO.	SURVEYED PLOT TEMPLATE AREAS CHECKED	DATE	BY

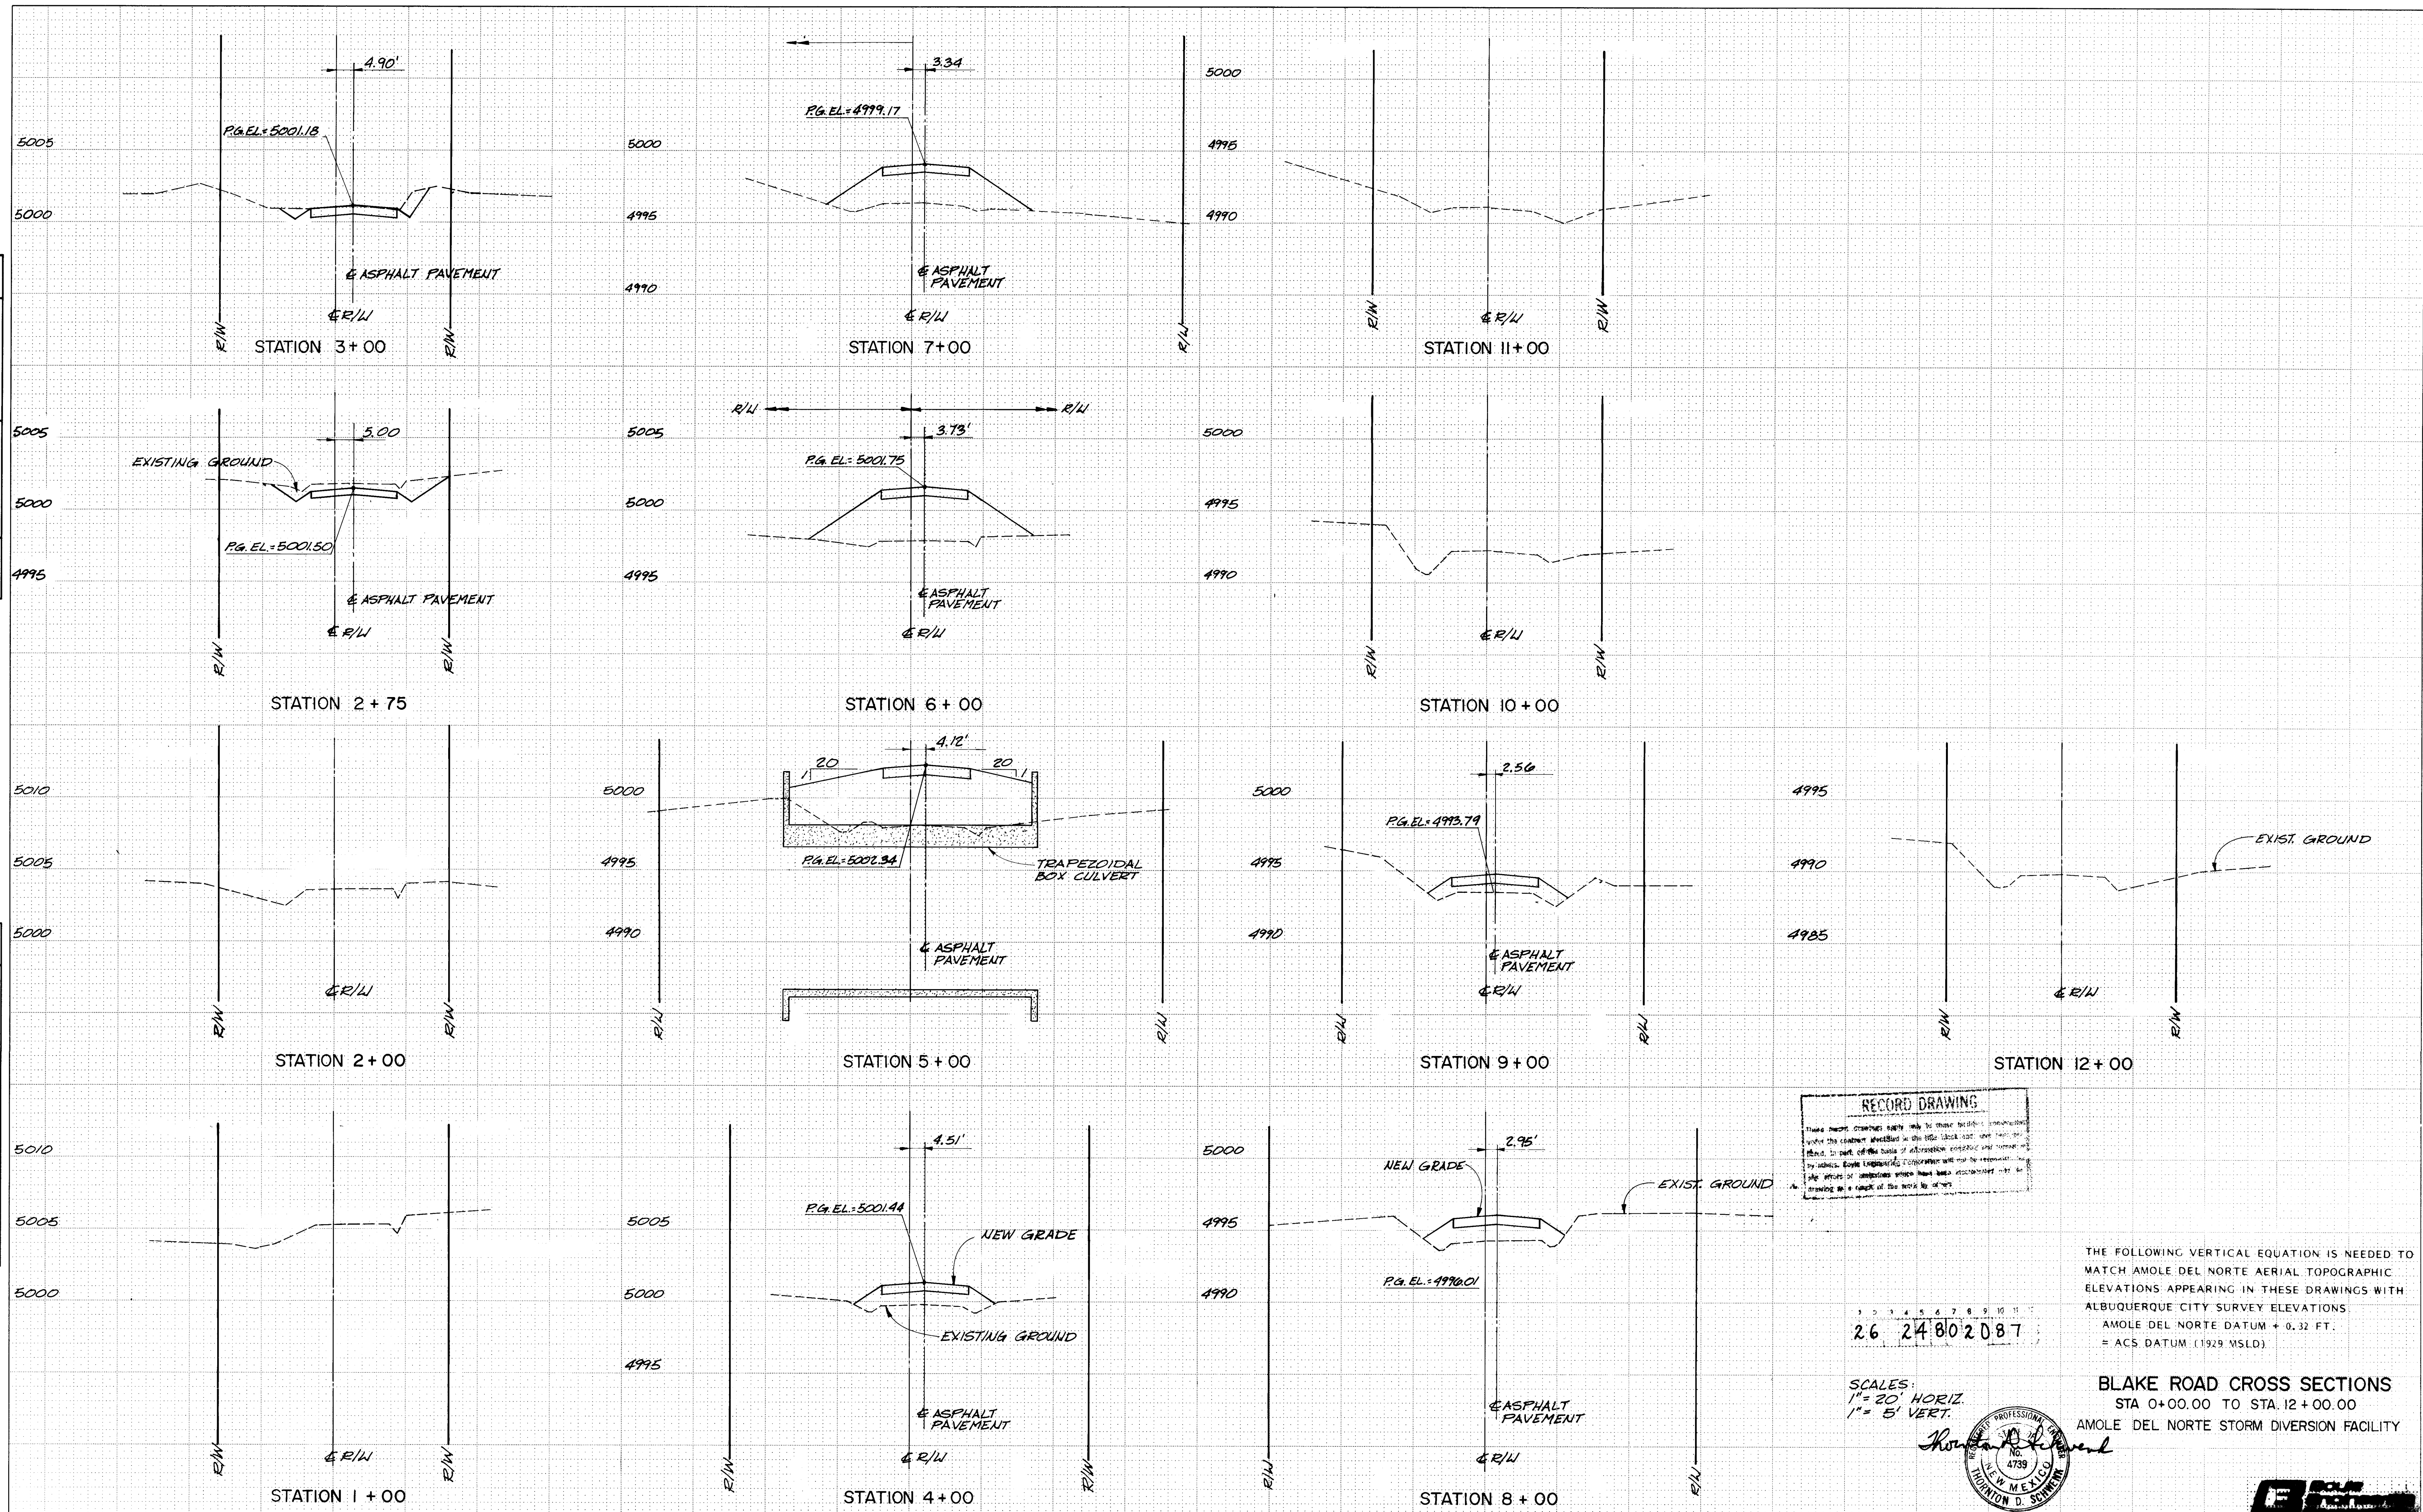

RECORD DRAWING
These drawings are to be used for the construction of the project. They are not to be used for any other purpose. The engineer is not responsible for the accuracy of the data used in these drawings. The engineer is not responsible for the accuracy of the data used in these drawings. The engineer is not responsible for the accuracy of the data used in these drawings.





26 24802087

SCALES:
1" = 20' HORIZ.
1" = 5' VERT.


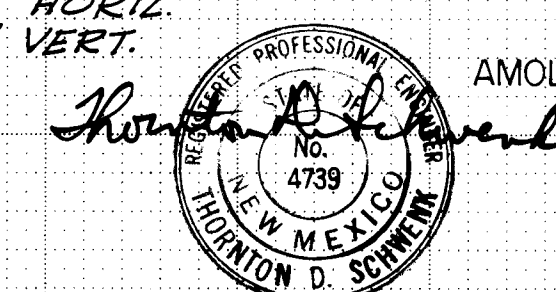


THE FOLLOWING VERTICAL EQUATION IS NEEDED TO MATCH AMOLE DEL NORTE AERIAL TOPOGRAPHIC ELEVATIONS APPEARING IN THESE DRAWINGS WITH ALBUQUERQUE CITY SURVEY ELEVATIONS.
AMOLE DEL NORTE DATUM + 0.32 FT.
= ACS DATUM (1929 MSLD)


BLAKE ROAD CROSS SECTIONS
STA 0+00.00 TO STA 12+00.00
AMOLE DEL NORTE STORM DIVERSION FACILITY

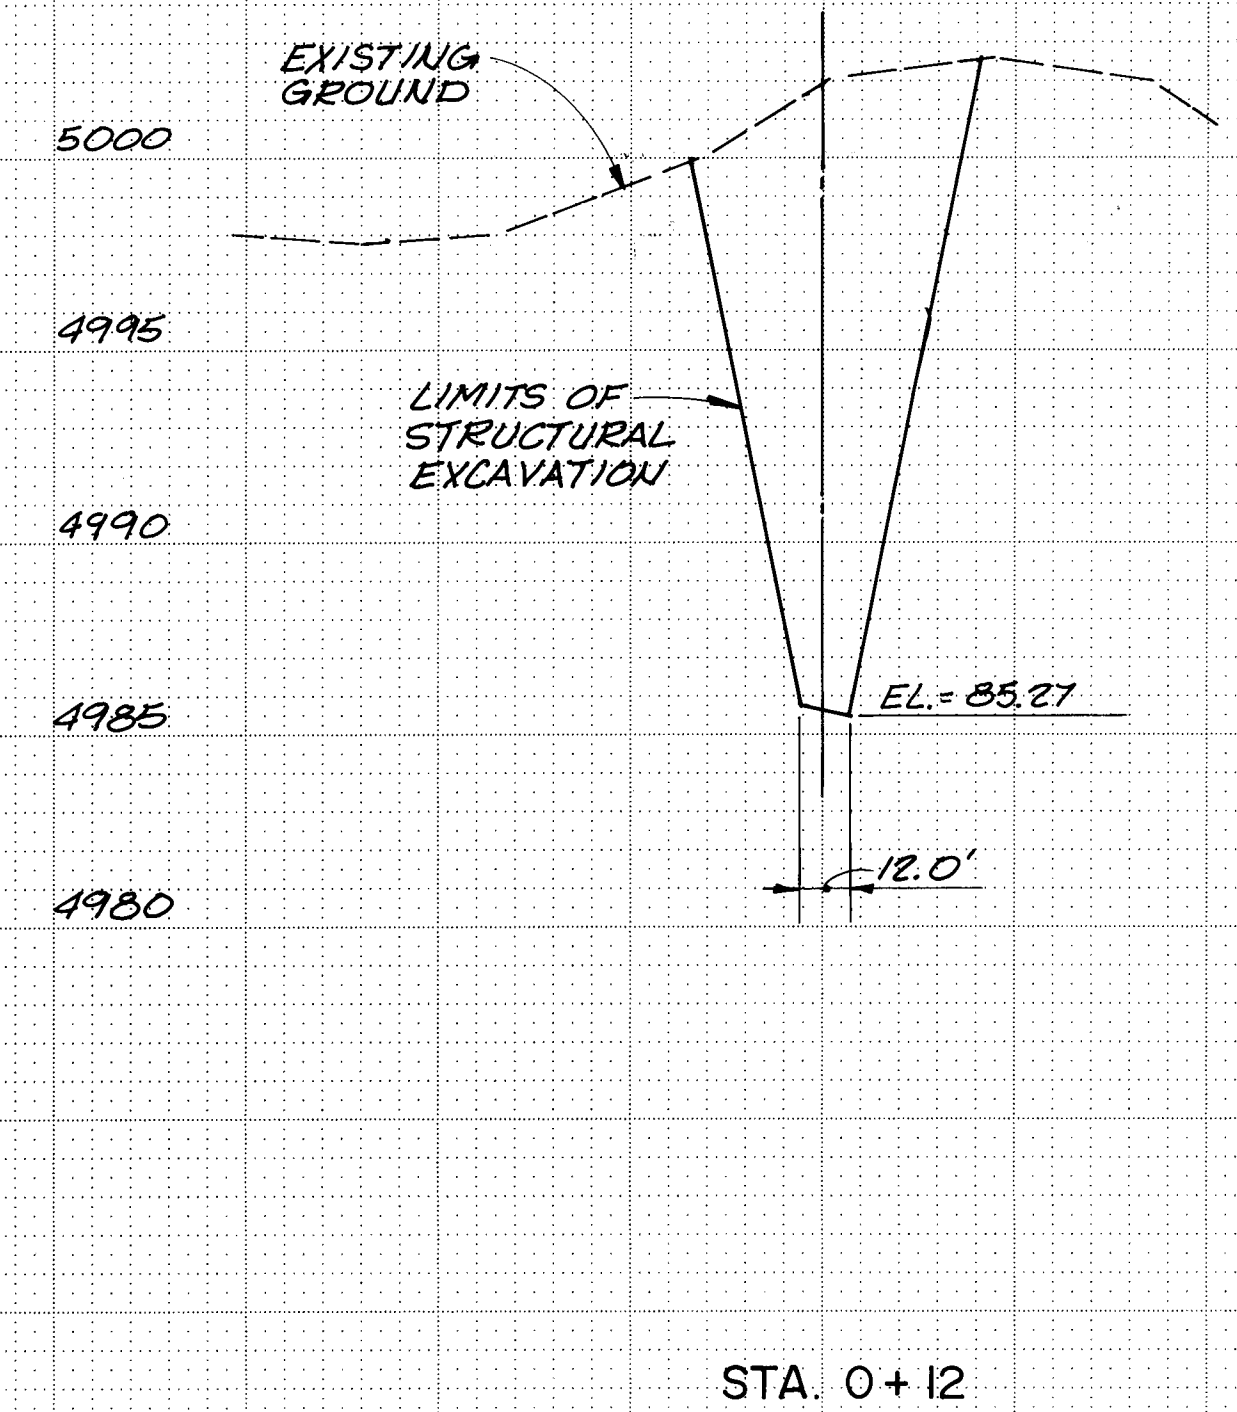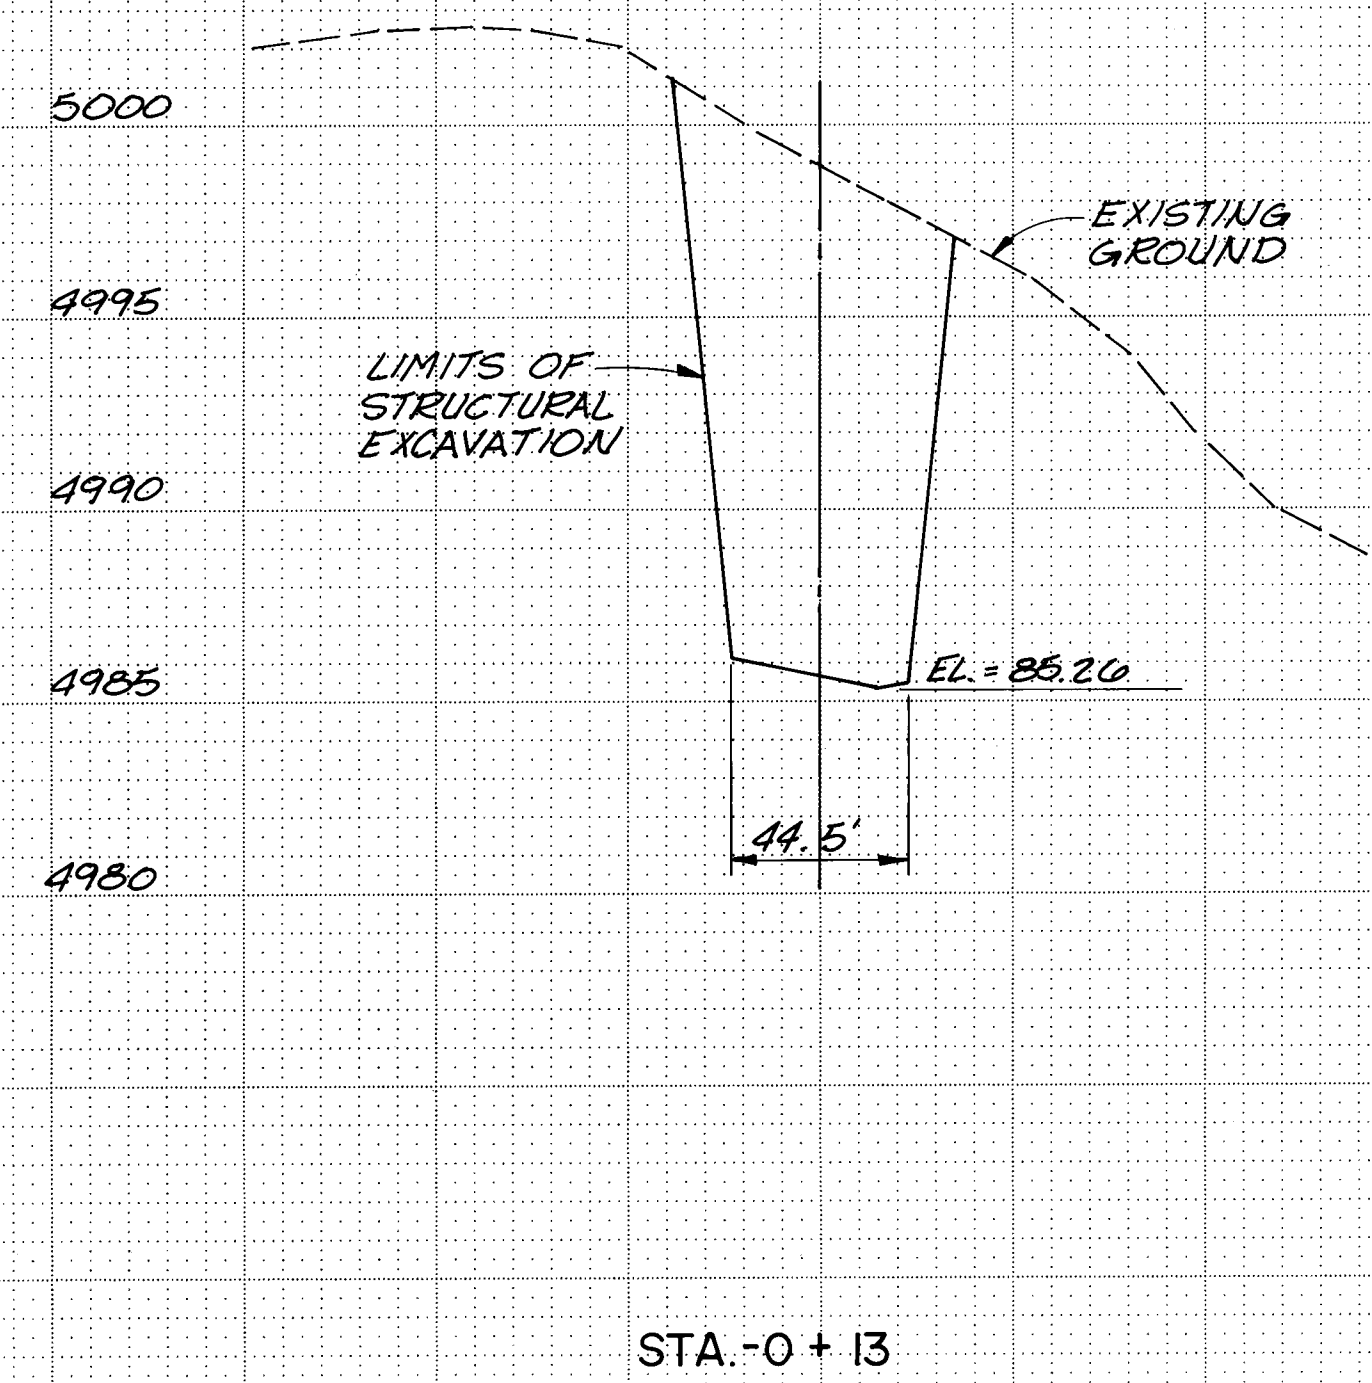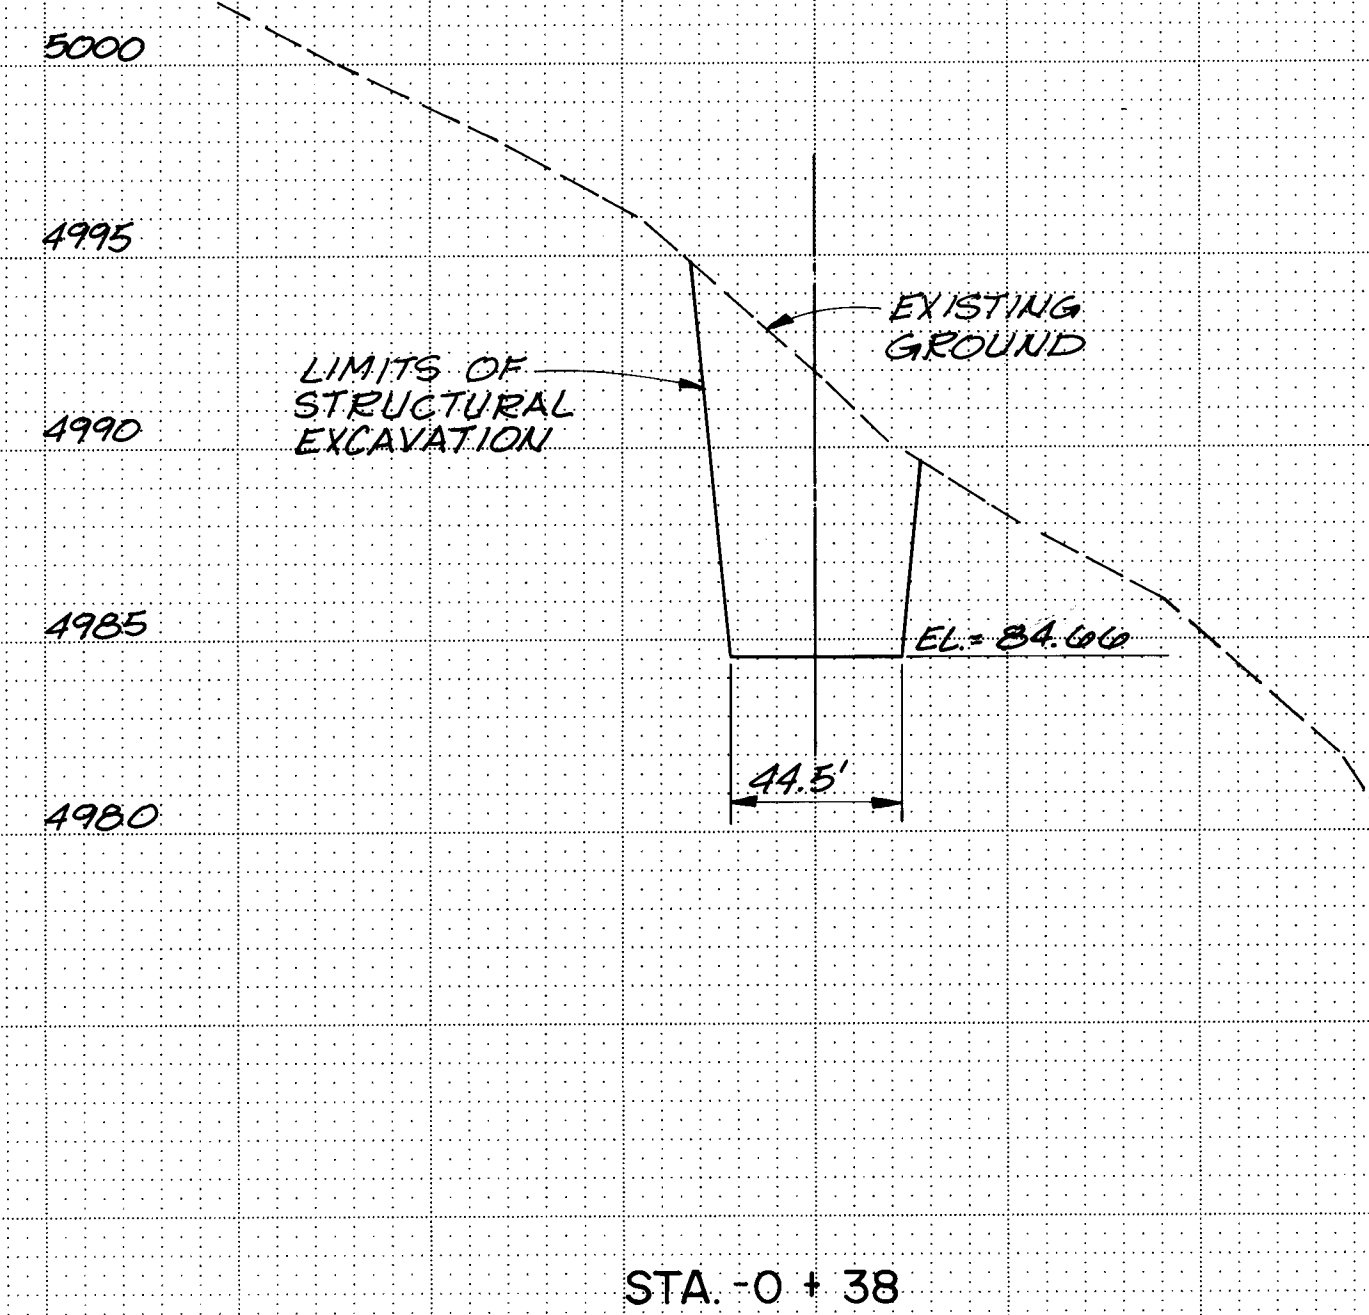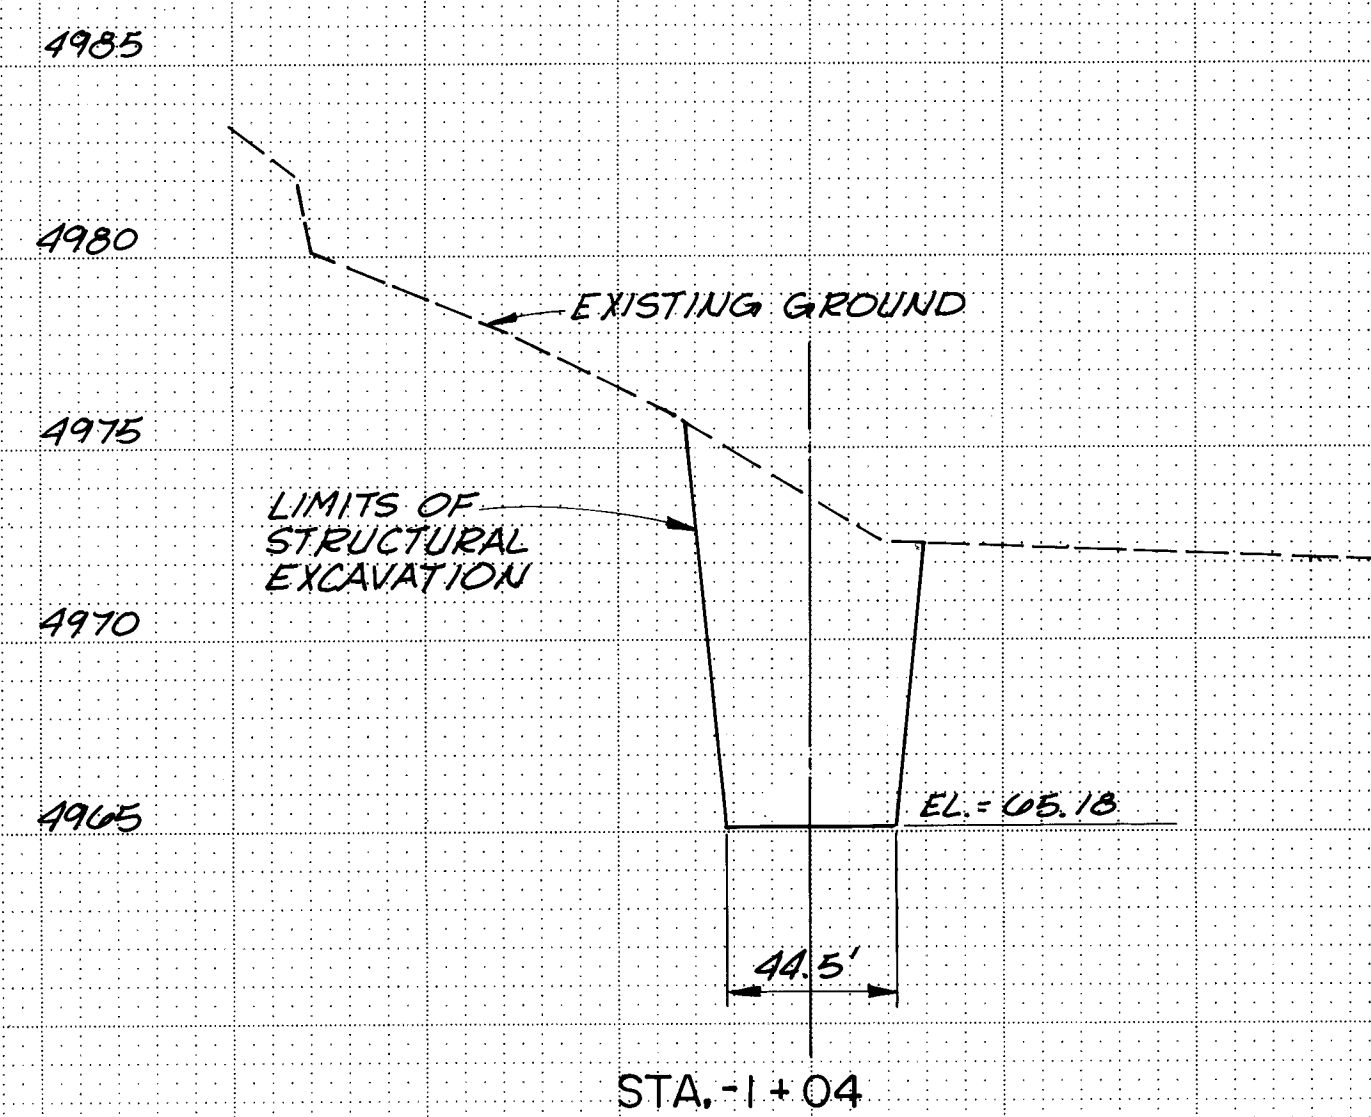[illegible]

STRUCTURAL EXCAVATION FOR ENERGY DISSIPATOR

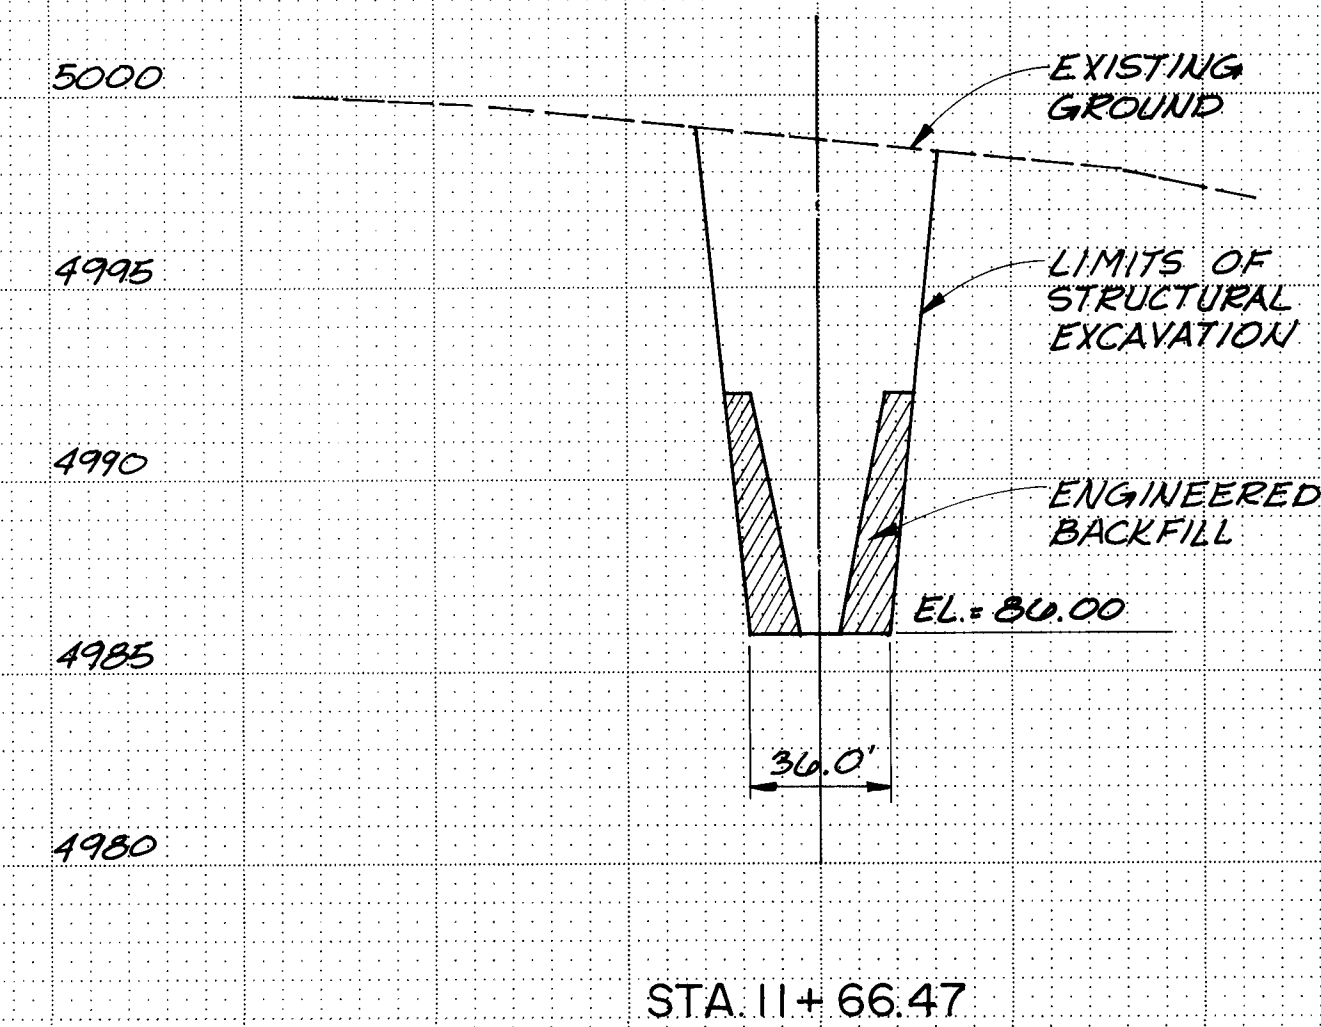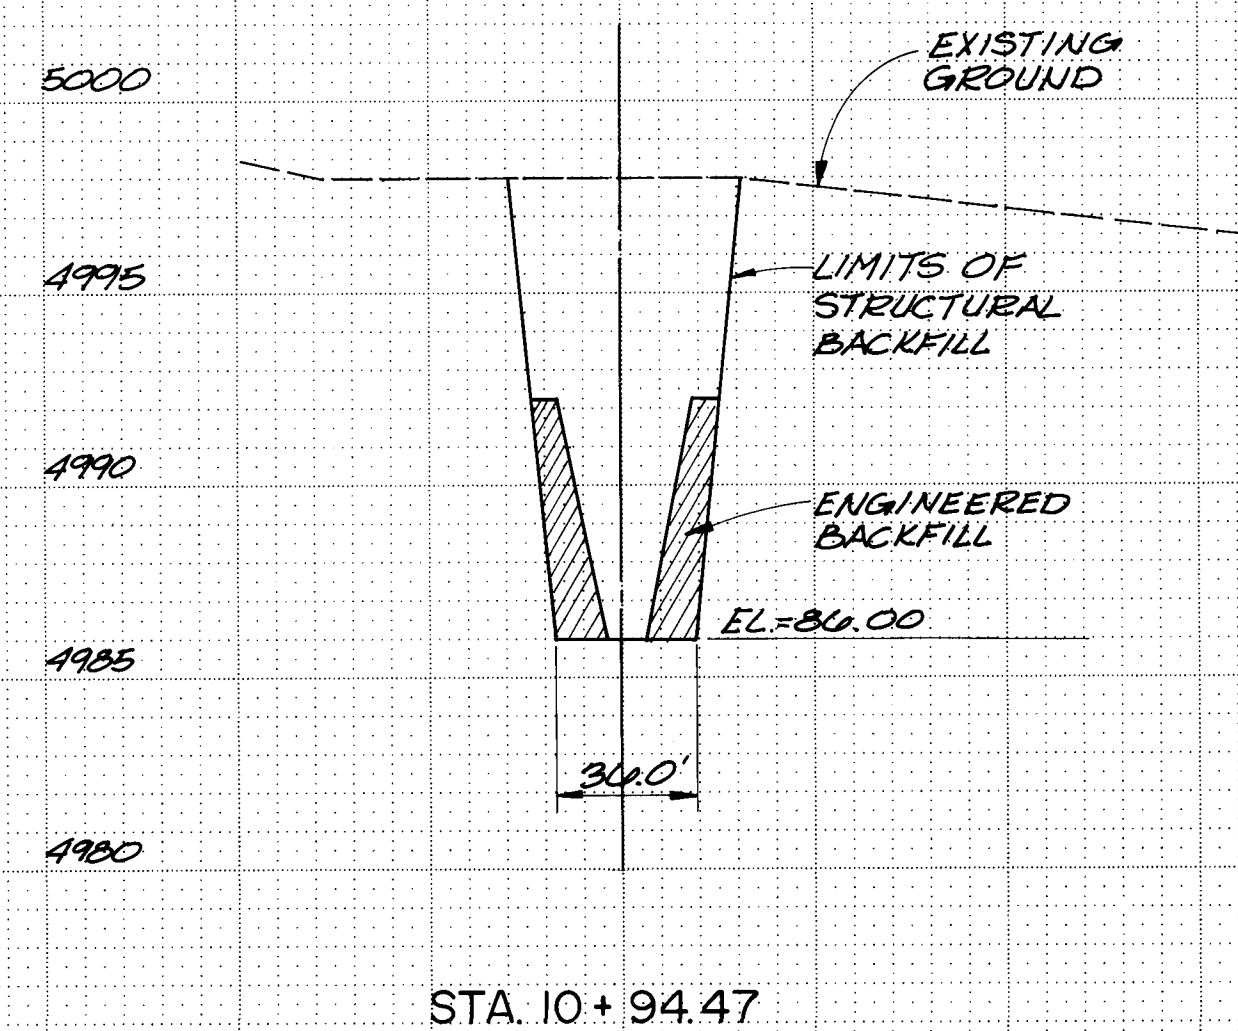

STRUCTURAL EXCAVATION FOR BLAKE ROAD CROSSING STRUCTURE

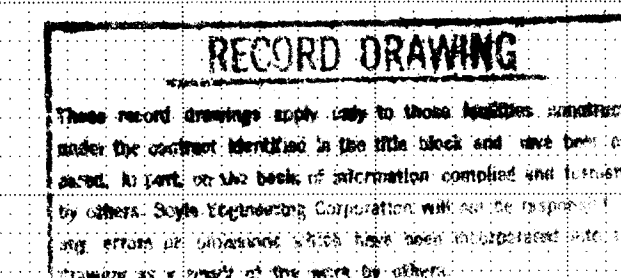

SCALE:
1" = 50' HORIZ.
1" = 5' VERT.

THE FOLLOWING VERTICAL EQUATION IS NEEDED TO
MATCH AMOLE DEL NORTE AERIAL TOPOGRAPHIC
ELEVATIONS APPEARING IN THESE DRAWINGS WITH
ALBUQUERQUE CITY SURVEY ELEVATIONS:

AMOLE DEL NORTE DATUM + 0.32 FT.
= ACS DATUM (1929 MSLD)

STRUCTURAL EXCAVATION CROSS SECTIONS

AMOLE DEL NORTE STORM DIVERSION FACILITY

26 24802187

