


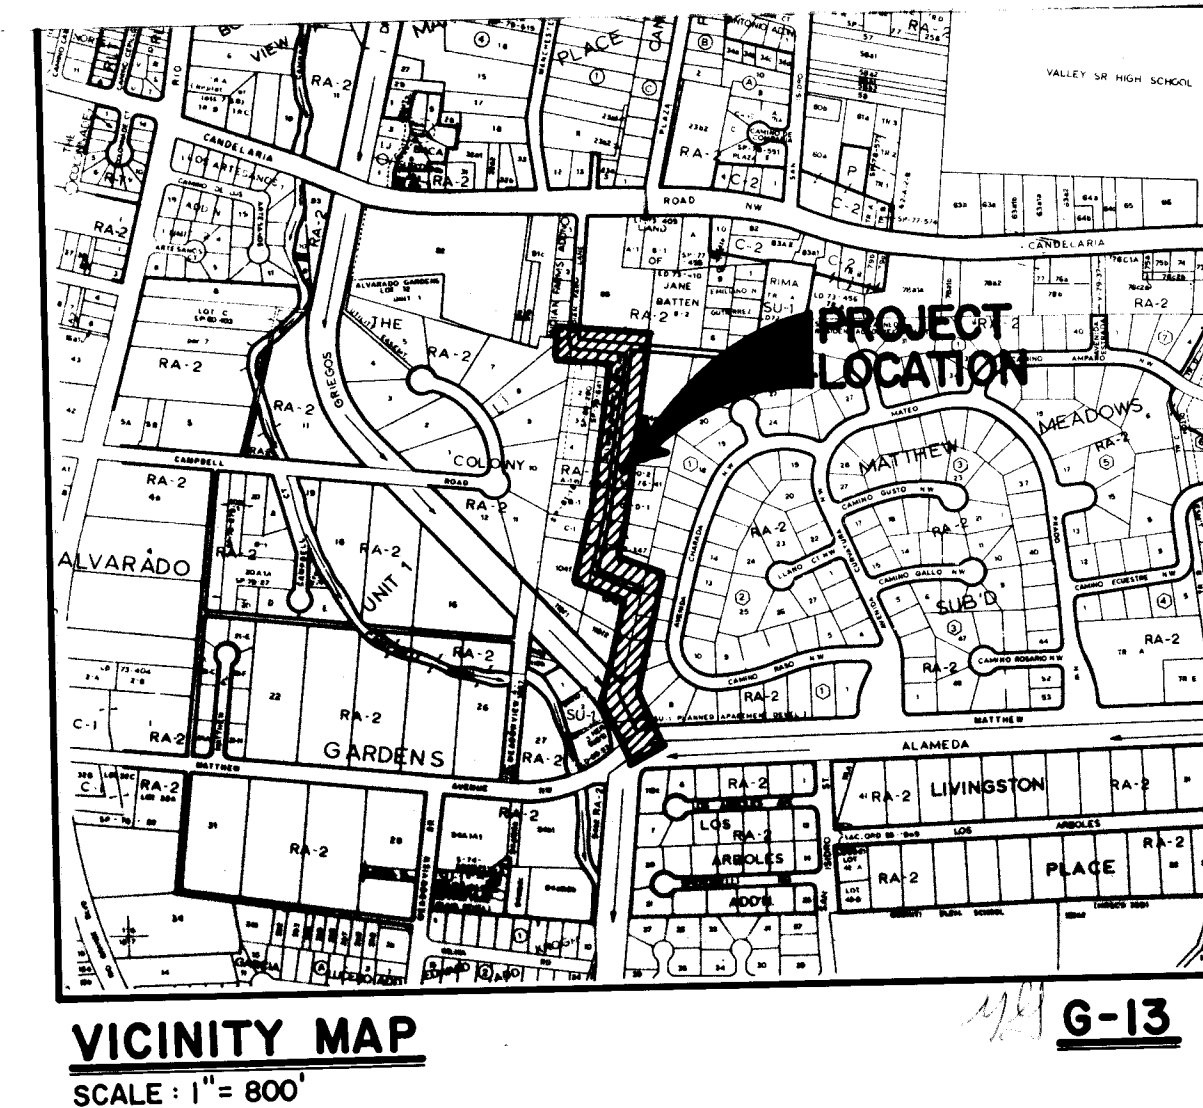

CONSTRUCTION PLANS FOR

INDIAN FARMS LANE NW

WATERLINE EXTENSION

<u>SHEET NO.</u>	<u>DESCRIPTION</u>
1	COVER SHEET
2	OVERALL WATER- LINE PLAN
3	WATERLINE PLAN & PROFILE

GENERAL NOTES


- All work detailed on these plans to be performed under contract shall, except otherwise stated or provided for hereon, be constructed in accordance with the New Mexico Standard Specifications for Public Works Construction - 1979 Edition (referred herein as the Standard Specifications) and the contract documents for Public Works Contract No. 85.
- Two (2) working days prior to any excavation, Contractor must contact line locating service, 765-1234, for location of existing utilities.
- Prior to construction, the Contractor shall excavate and verify the horizontal and vertical locations of all potential obstructions. Should a conflict exist, the Contractor shall notify the Engineer so that the conflict can be resolved with a minimum amount of delay.
- All work on this project shall be performed in accordance with applicable Federal, State and Local laws, rules, and regulations concerning construction safety and health.
- Contractor shall maintain access to adjacent properties during construction.
- All gas, electric, telephone lines, cables, and appurtenances encountered during construction that require relocation, shall be done by the responsible utility. Contractor shall be responsible for coordination of all necessary utility adjustments.
- It will be the Contractor's responsibility to protect and maintain in service all existing utilities.
- The Contractor will be required to confine his work within the construction limits and/or public right-of-way to preserve existing vegetation and private property. Overnight parking of construction equipment shall not obstruct driveways or designated traffic lanes.
- A disposal site for all excess excavation material, asphaltic paving, concrete curbs and sidewalks, etc., shall be obtained by the Contractor in compliance with applicable environmental regulations and approved by the Field Engineer. All costs incurred in obtaining a disposal site and haul there to shall be considered incidental to the project and no separate measurement or payment shall be made.
- Where removal of existing curbs and gutters, sidewalk or pavement is required, Contractor shall sawcut and/or remove to the nearest joint. Curb and gutter shown on these plans as existing and not to be removed under this contract, which is damaged or displaced by the Contractor shall be removed and replaced at the Contractor's expense.
- When abutting new pavement to existing, sawcut existing pavement to a straight edge and at a right angle, or as approved by the Project Engineer, to remove any broken or cracked pavement.
- The Contractor must submit a construction signing and barricading plan to Traffic Engineering a minimum of three (3) working days prior to construction to receive a barricading permit.
- Backfill compaction shall be according to specified street use.
- All trench backfill shall be compacted to a minimum 90% maximum density as per ASTM -D1557.

2 6 2 4 8 8 0 1 8 5

APPROVED FOR
CONSTRUCTION
DATE 11/8/85

REV	SHEETS	CITY	ENGR.	DATE	USER	DEPT.	DATE	USER	DEPT.	DATE
APPROVAL OF REVISIONS										

ENGINEERS SEAL 	ESPEY, HUSTON & ASSOC., INC. Engineering & Environmental Consultants 4801 INDIAN SCHOOL ROAD N.E. SUITE 204 ALBUQUERQUE, NEW MEXICO 87110 PHONE (505) 255-1625	APPROVED FOR CONSTRUCTION C.E.
PROJECT NUMBER 2488	SHEET 1	OF 3

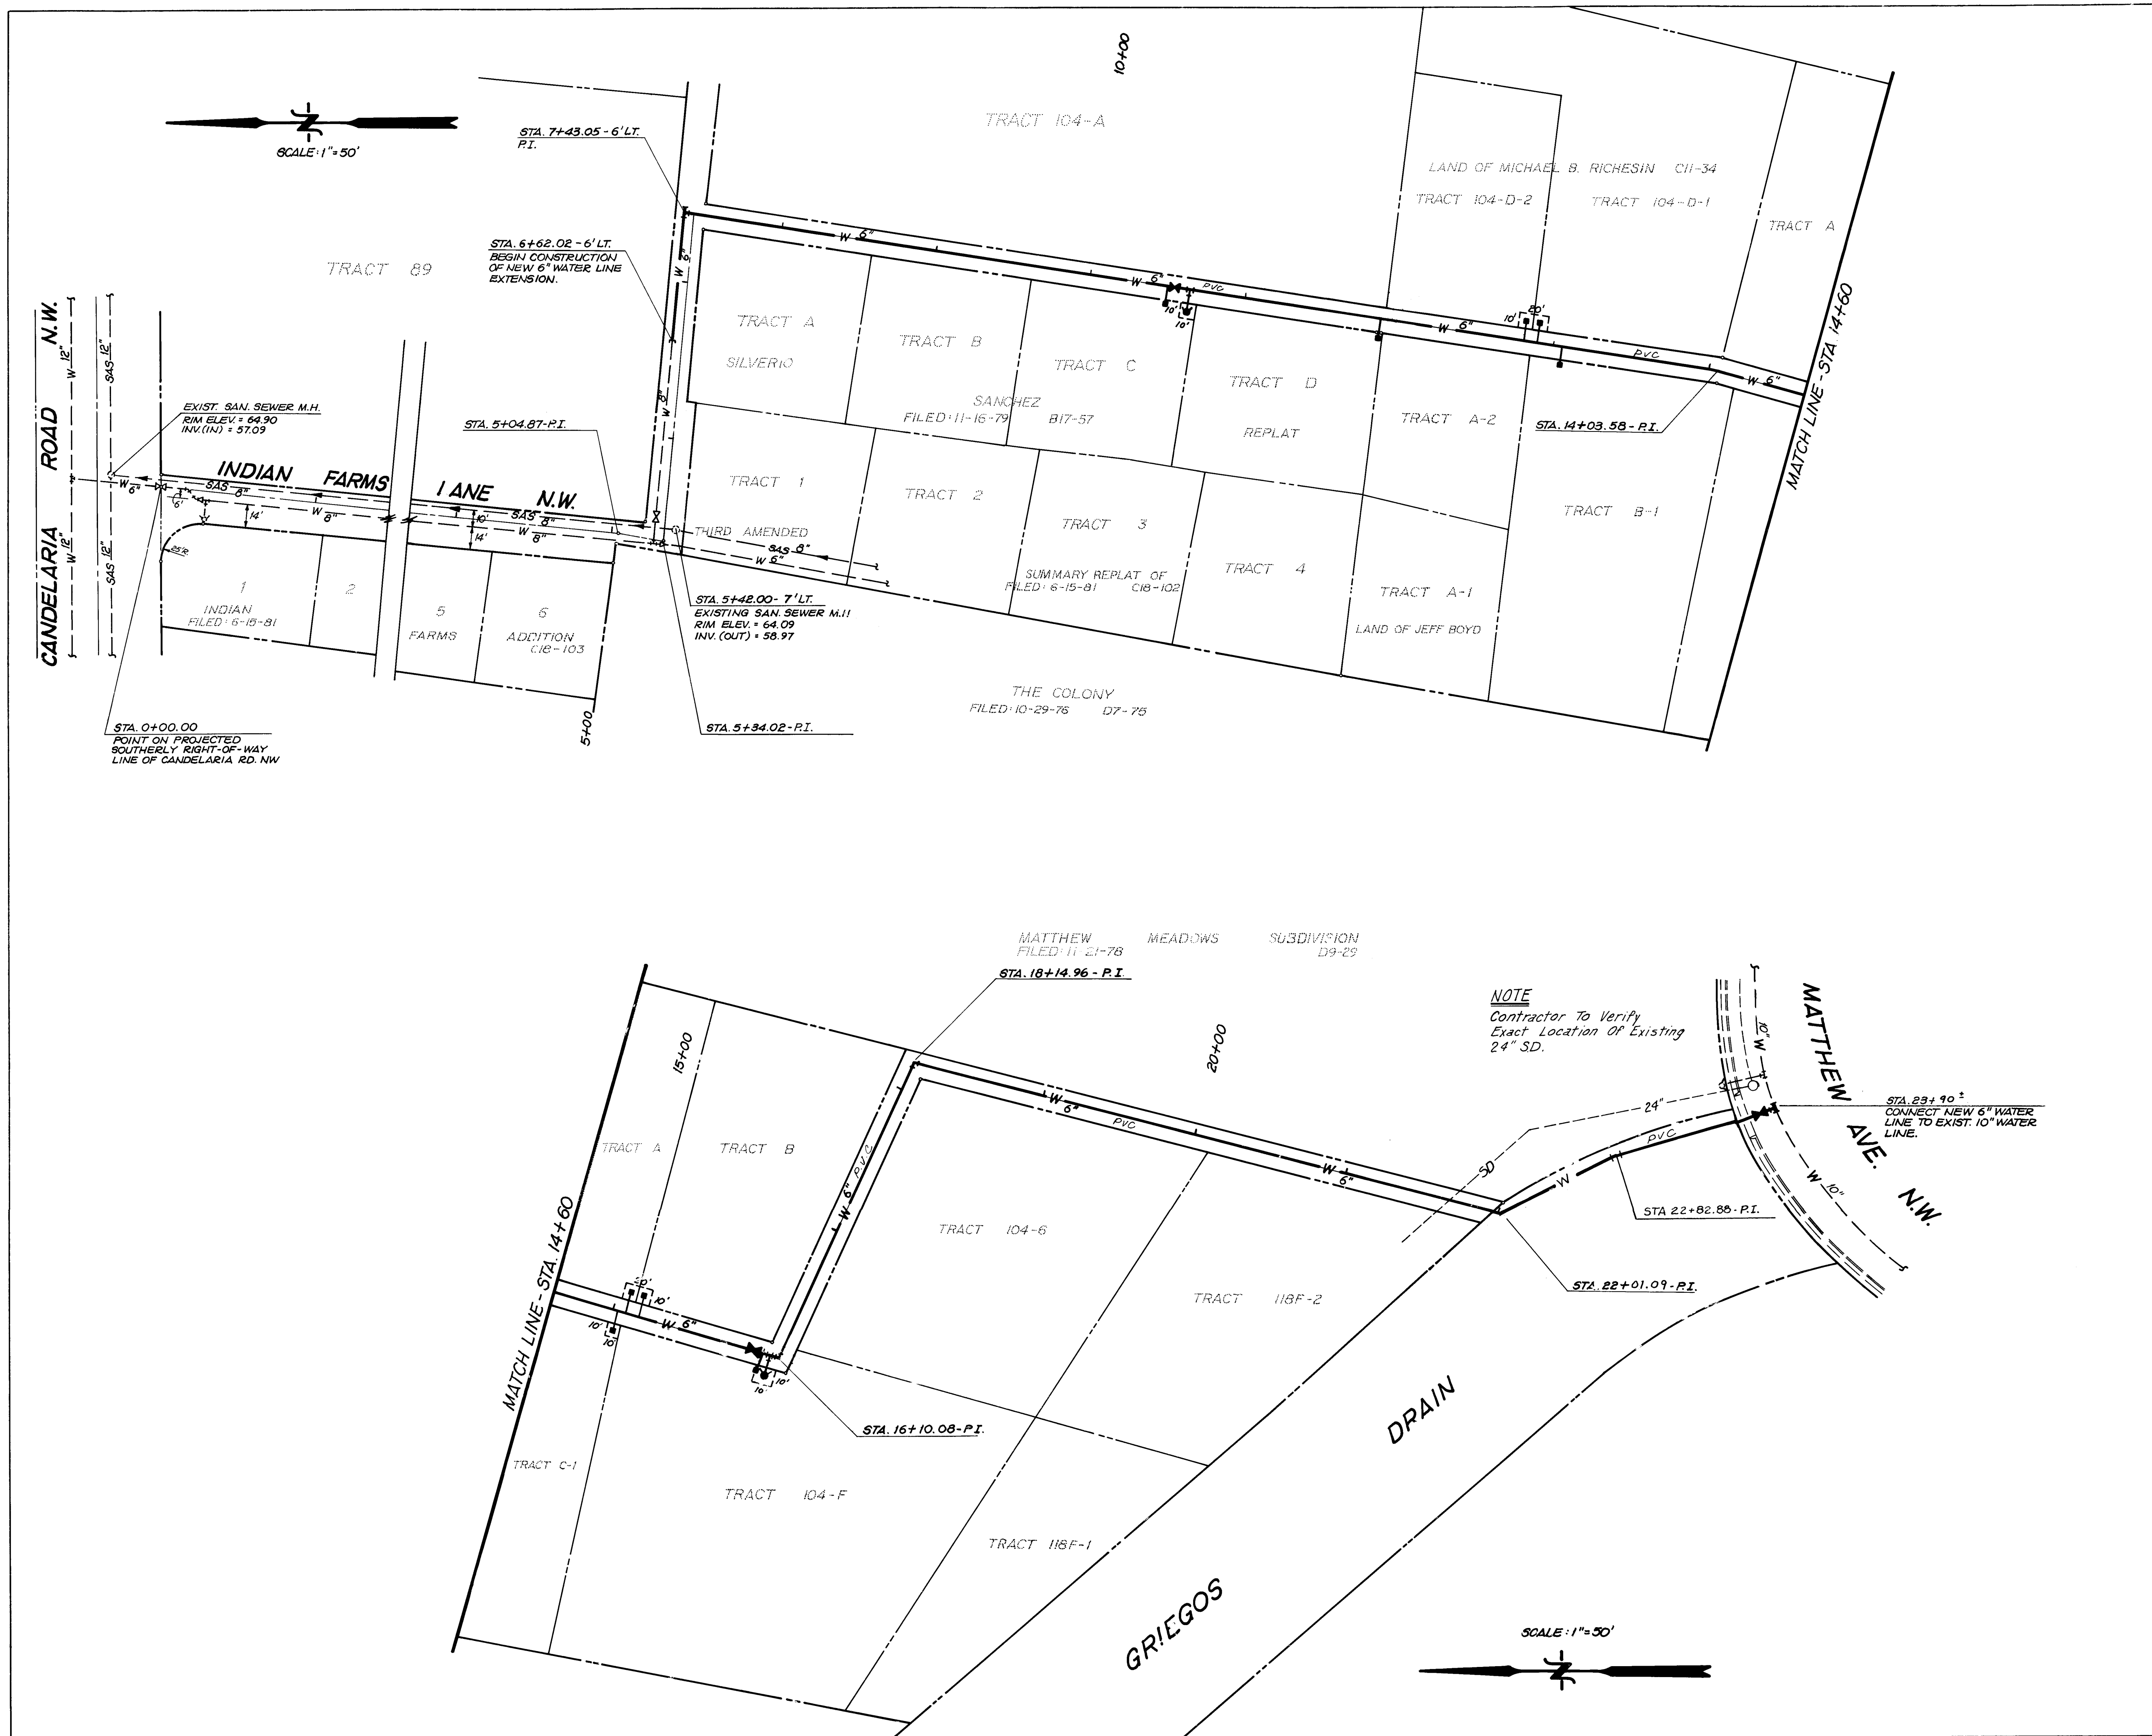

26 24880285

LEGEND

---	PROPERTY LINE
---	CENTERLINE OF STREET
---S45---	EXISTING SANITARY SEWER
---W---	EXISTING WATERLINE
=====	EXISTING CURB & GUTTER
Y	EXISTING FIRE HYDRANT
X	EXISTING GATE VALVE
O	EXISTING MANHOLE
---W---	PROPOSED WATERLINE

CITY OF ALBUQUERQUE
MUNICIPAL DEVELOPMENT DEPARTMENT
ENGINEERING DIVISION


TITLE: INDIAN FARMS LANE NW
OVERALL WATERLINE PLAN

APPROVALS	ENGINEER	DATE	APPROVALS	ENGINEER	DATE
City Engineer	<i>[Signature]</i>	5/26/85	Liquid Waste	<i>[Signature]</i>	5/15/85
A.C.E. - Design	<i>[Signature]</i>	5/26/85	Traffic	<i>[Signature]</i>	5/15/85
Hydrology	<i>[Signature]</i>	5/15/85	Water	<i>[Signature]</i>	5/15/85


DRAWING NO.	2488	MAP NO.	G-13	SHEET	2	OF	3
-------------	------	---------	------	-------	---	----	---

SURVEY INFORMATION		BENCH MARKS		AS BUILT INFORMATION	
NO.	FIELD NOTES	THE STATION IS LOCATED 2.5 MILES NORTH OF DOWN-TOWN ALBUQUERQUE, EAST OF THE INTERSECTION OF RIO GRANDE AND CANDELARIA BLVD. TO REACH THE STATION FROM THE INTERSECTION OF I-25 AND CANDELARIA GO WEST 2.5 MILES TO THE STATION ON THE RIGHT. THE STATION MARK IS A STANDARD ACS BRASS TABLET STAMPED "G-813A 1980" SET FLUSH WITH THE CURB.	CONTRACTOR	WORK LOG BY	DATE
				INSPECTED BY <td>DATE</td>	DATE
				ACCEPTANCE BY <td>DATE</td>	DATE
				REVISIONS <td>DATE</td>	DATE
				DESIGNED BY	DATE
				DRAWN BY	DATE
				CHECKED BY	DATE


CANDELARIA RD. NW

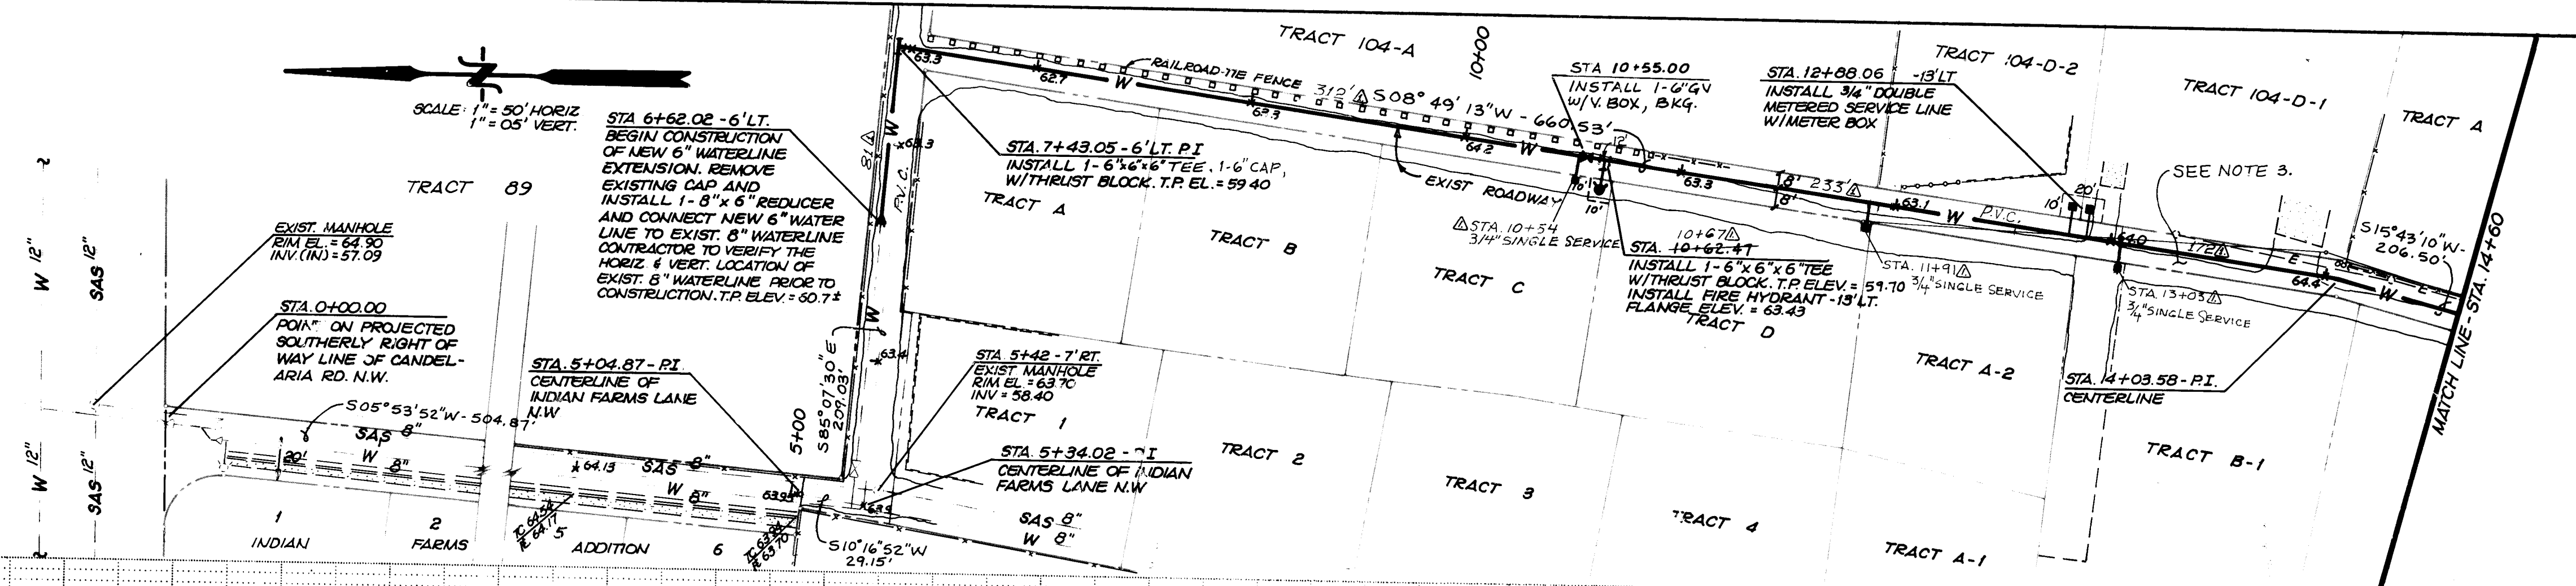

- NOTES:**
1. THE CONTRACTOR SHALL CO-ORDINATE THE WATER SHUT-OFF WITH THE CITY OF ALBUQUERQUE WATER SYSTEMS DIVISION. TELEPHONE 766-7100.
 2. THE FOLLOWING CITY OF ALBUQUERQUE STANDARD DETAIL DRAWINGS FOR THE WATER LINE CONSTRUCTION ARE APPLICABLE:
W-1 W-20
W-7 W-22
W-10
W-16
W-18
 3. PUBLIC R.O.W. ESTABLISHED BY ORDER OF STATE OF NEW MEXICO DISTRICT COURT. CASE NO. 12-72-05879.
 4. ALL STATIONING IS BASED ON CENTERLINE OF ROADWAY.
 5. ALL WATER SERVICE CONNECTIONS SHALL BE COORDINATED WITH WRD CUSTOMER SERVICES PH: 823-4044.

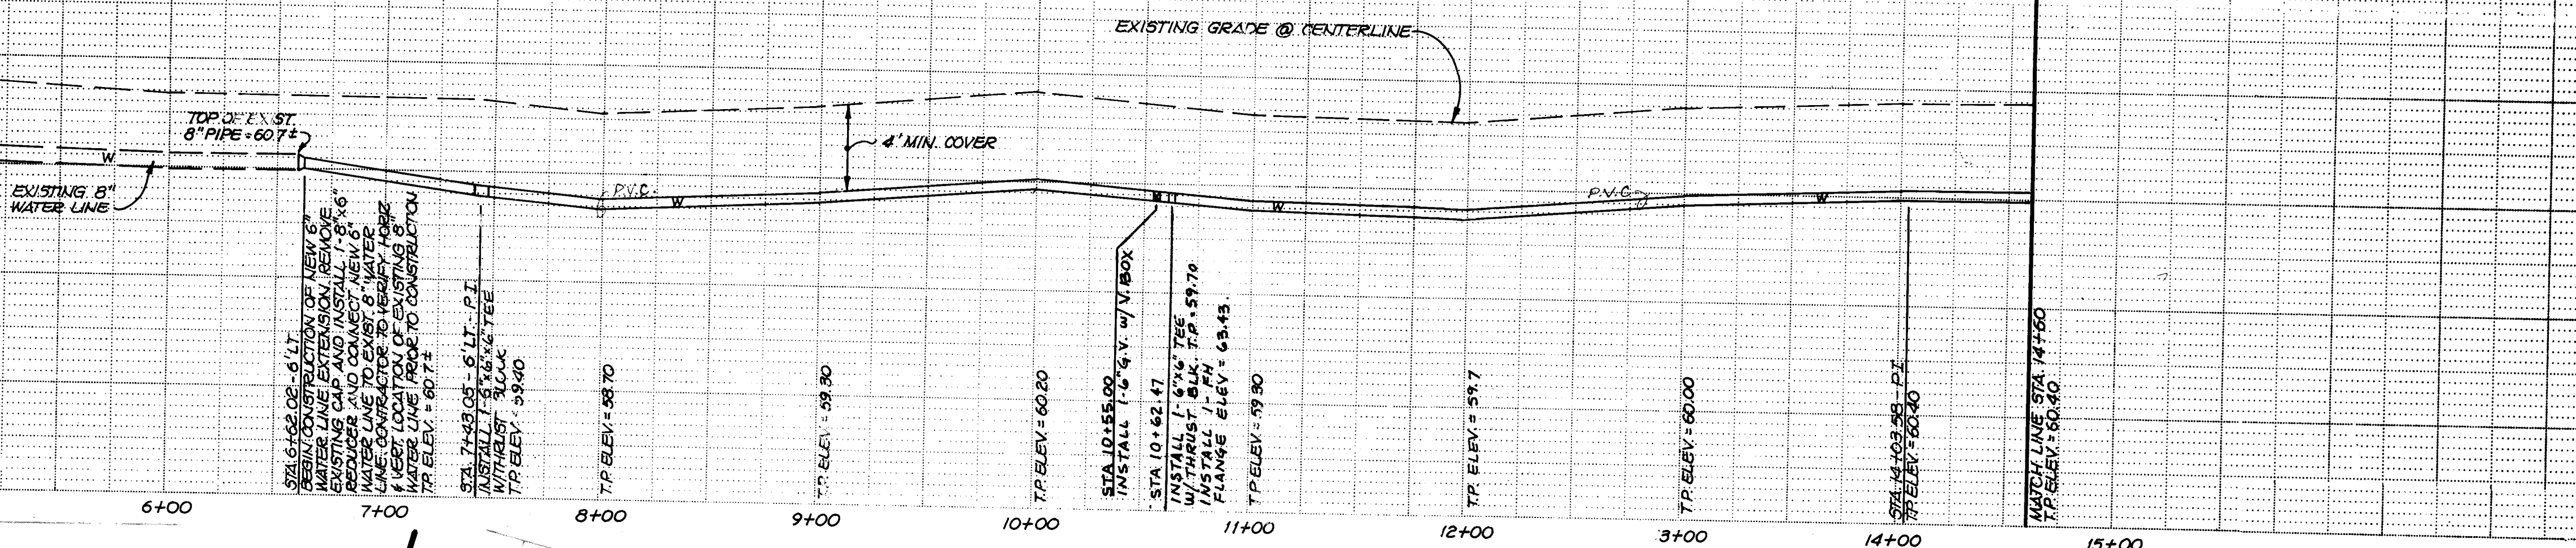

NOTE
Contractor To Verify
Exact Location Of Existing
24" SD.

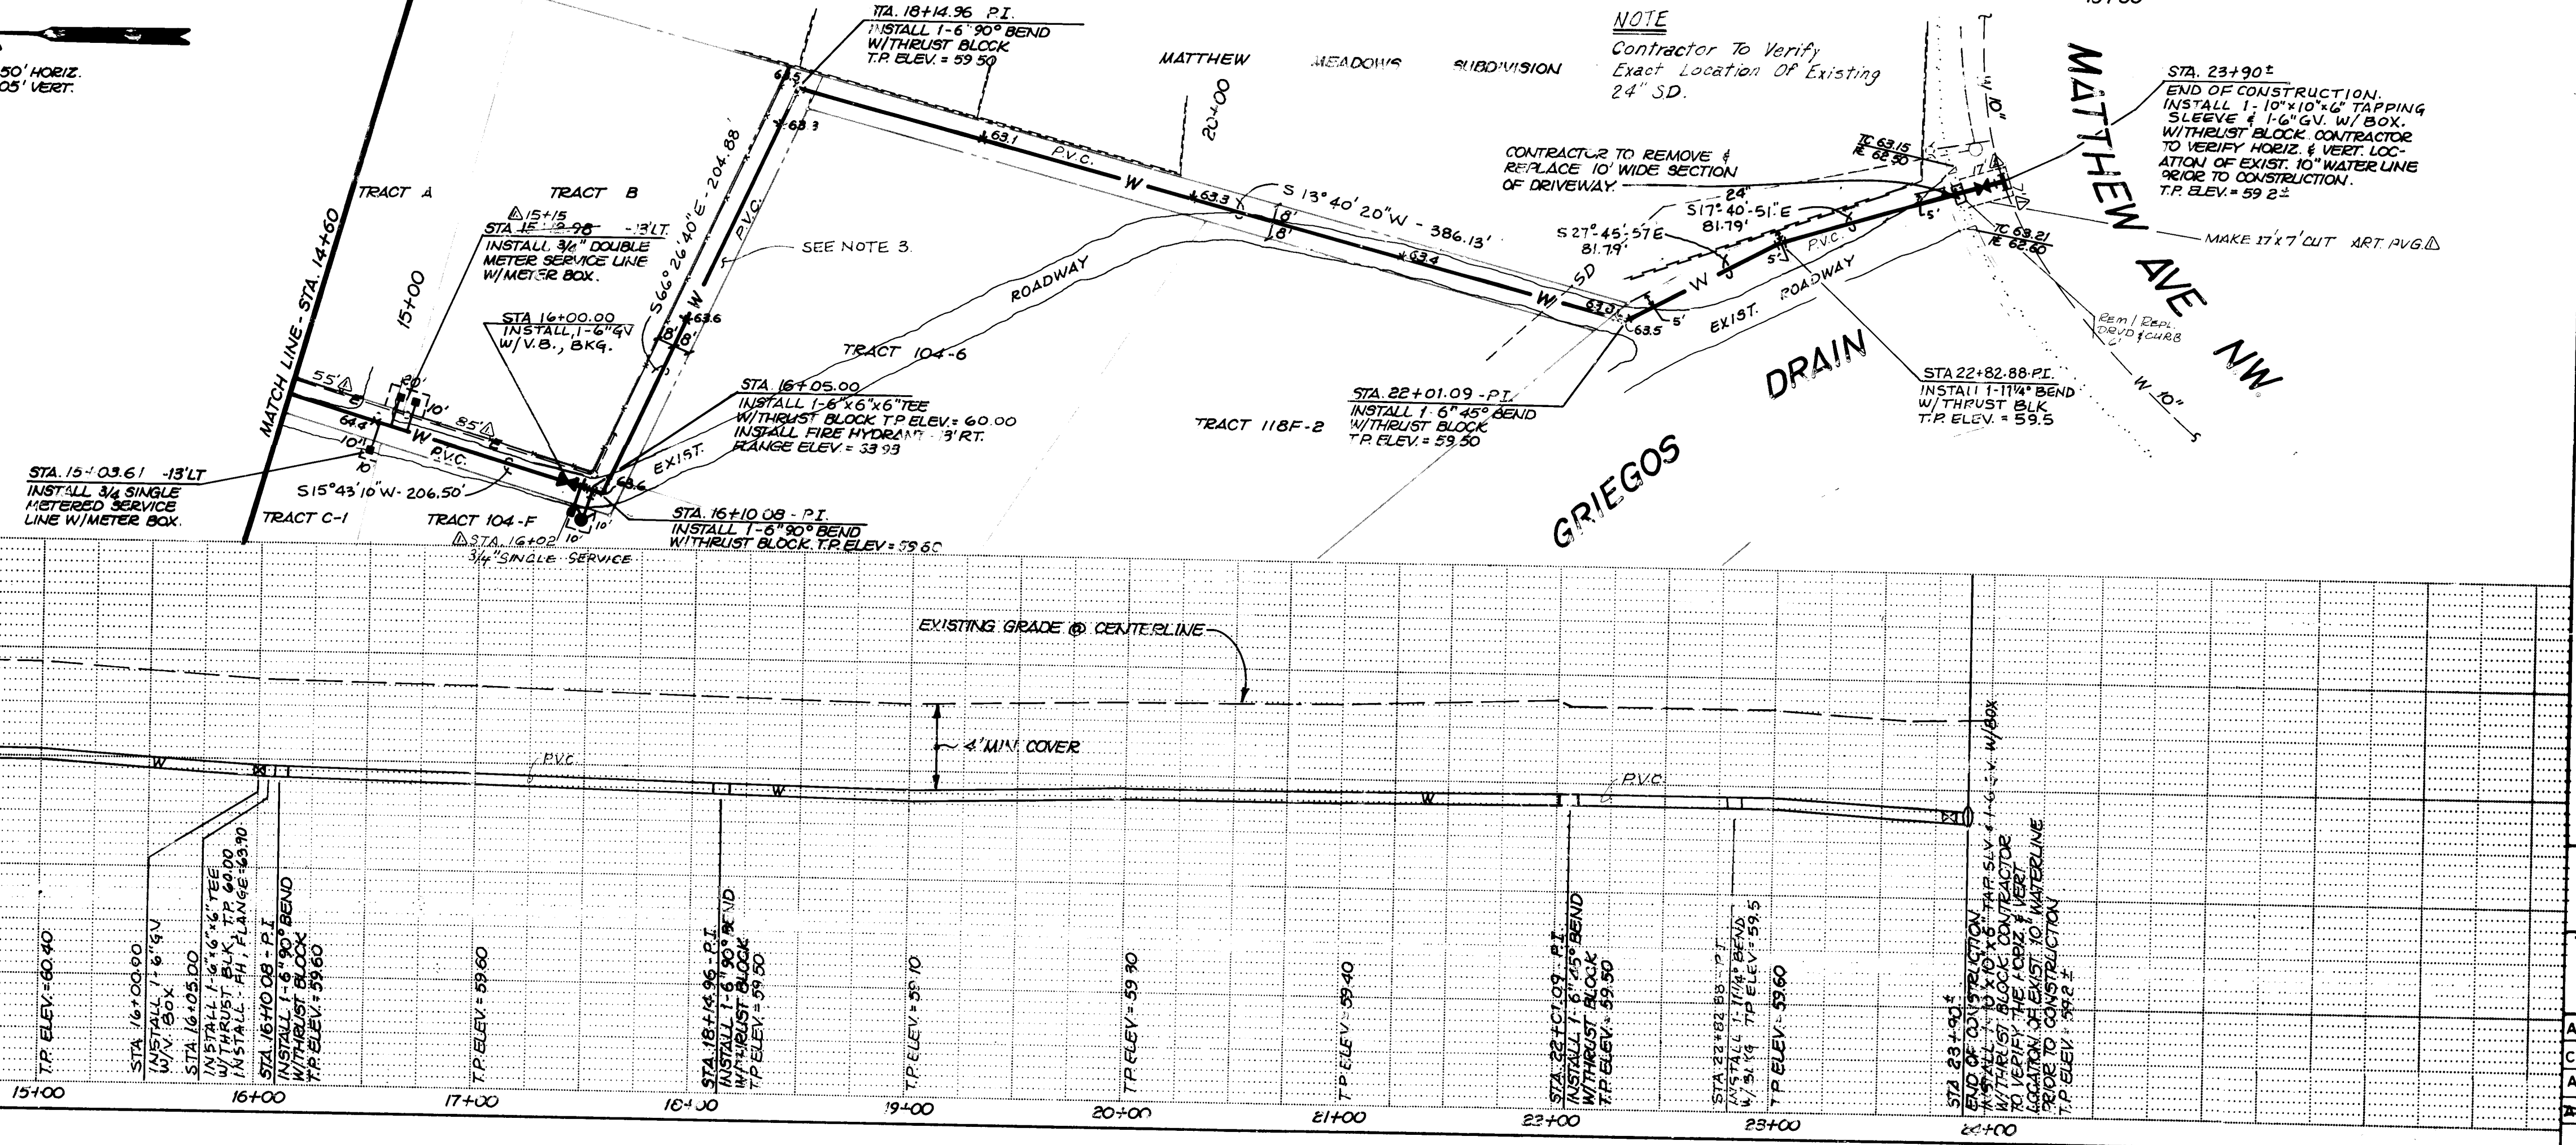

CITY OF ALBUQUERQUE
MUNICIPAL DEVELOPMENT DEPARTMENT
ENGINEERING DIVISION

TITLE: INDIAN FARMS LANE NW
WATERLINE PLAN AND PROFILE

APPROVALS	ENGINEER	DATE	APPROVALS	ENGINEER	DATE
CITY Engineer	<i>[Signature]</i>	5/15/85	Liquid Waste	<i>[Signature]</i>	5/15/85
A.C.E. Design	<i>[Signature]</i>	5/15/85	Traffic	<i>[Signature]</i>	5/15/85
Hydrology	<i>[Signature]</i>	5/15/85	Water	<i>[Signature]</i>	5/15/85

DRAWING NO. 2488 **MAP NO.** G-13 **SHEET** 3 **OF** 3

BENCH MARKS		AS BUILT INFORMATION	
THE STATION IS LOCATED 2.5 MILES NORTH OF DOWNTOWN ALBUQUERQUE, EAST OF THE INTERSECTION OF RIO GRANDE AND CANDELARIA BLVD. TO BEACH THE STATION FROM THE INTERSECTION OF I-25 AND CANDELARIA. GO WEST 2.5 MILES TO THE STATION ON THE RIGHT. THE STATION MARK IS A STANDARD ACS BRASS TABLET STAMPED "6-918A 1500' SET FLUSH WITH THE CURB		CONTRACTOR	NEW CONCEPTS
		WORK STAMPED BY	DATE
		ACCEPTANCE BY	DATE
		FIELD VERIFICATION BY	DATE
		CONDUCTED BY	DATE
		MICRO-FILM INFORMATION	
		RECORDED BY	DATE
		NO	

SURVEY INFORMATION		FIELD NOTES	
NO.	DATE	BY	DATE

ENGINEER'S SEAL		REVISIONS	
NO.	DATE	BY	DATE

REVISIONS		DESIGN	
NO.	DATE	BY	DATE