


PIEDRA LISA PARK
STORM DRAINAGE IMPROVEMENTS

INDEX

SHEET NO.	DESCRIPTION
1	TITLE SHEET
2	PLAN & PROFILE
3	CROSS SECTIONS 10+50 TO 14+00
4	CROSS SECTIONS 14+50 TO 15+83

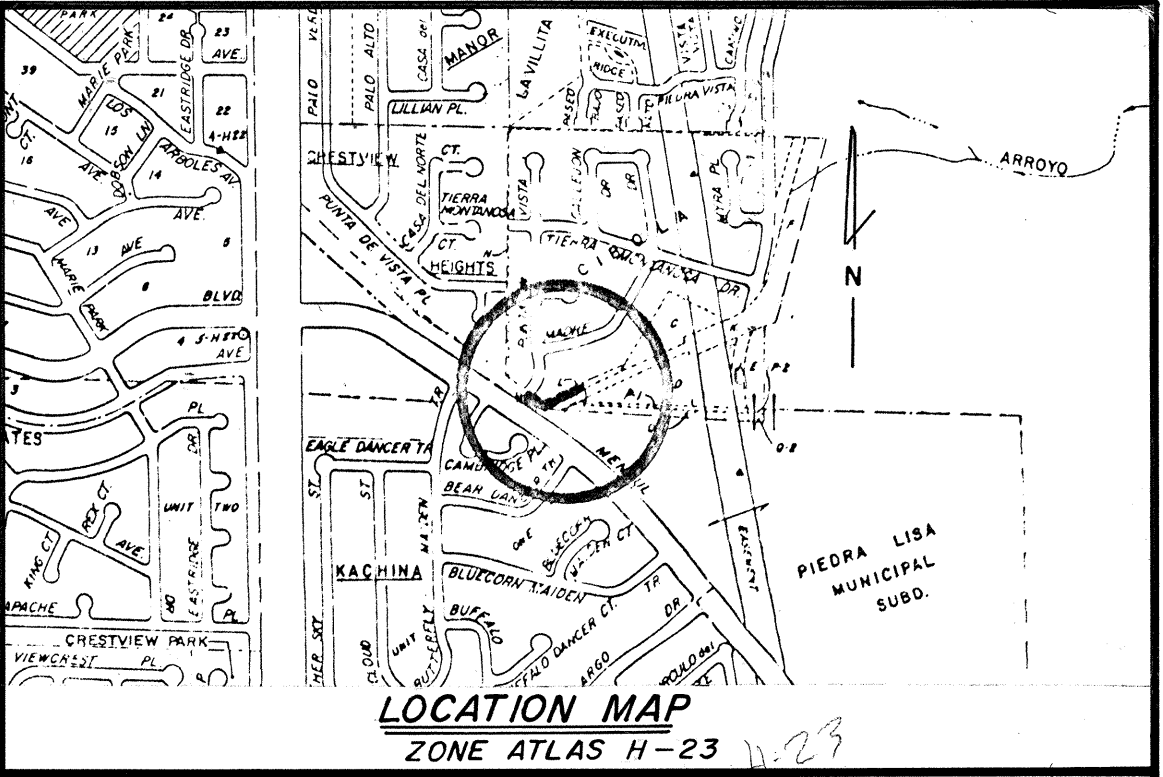

- NOTICE TO CONTRACTORS
- All work detailed on these plans to be performed under contract shall, except as otherwise stated or provided for hereon, be constructed in accordance with the City of Albuquerque Interim Standard Specifications for Public Works Construction 1985.
 - Two(2) working days prior to any excavation, the contractor must contact Line Locating Service, 765-1234 for location of existing utilities.
 - Prior to construction, the contractor shall excavate and verify the horizontal and vertical locations of all obstructions. Should a conflict exist, the contractor shall notify the engineer or surveyor so that the conflict can be resolved with minimum amount of delay.

THE FOLLOWING NOTES ALSO APPLY
WHEN CHECKED

- ☐ All utilities and utility service lines shall be installed prior to paving.
- ☒ Backfill compaction shall be according to specified street use.
- ☒ Tack coat requirements shall be determined by the City Engineer.
- ☐ Sidewalks and wheelchair ramps within the curb returns shall be constructed wherever a new curb return is constructed.
- ☐ If curb is depressed for a driveway or a handicap ramp, the driveway or ramp shall be constructed prior to acceptance of the curb and gutter.
- ☒ All storm drainage facilities shall be completed prior to final acceptance.

SCANNED
BY LASON

APPROVAL OF AS BUILT DRAWINGS
CHIEF CONSTRUCTION ENGINEER
W. J. McManus
DATE 6/30/86

REV.	SHEETS	CITY	ENGR.	DATE	USER	DEPT.	DATE	USER	DEPT.	DATE
APPROVAL OF REVISIONS										
						CITY OF ALBUQUERQUE		APPROVED FOR CONSTRUCTION <i>C. D. Chavez</i> CITY ENGINEER DATE 7/1/86		
DRAWING NO. 2497						SHEET 1 OF 4				

26 2497018C

AS BUILT INFORMATION

CONTRACTOR: Pride Construction

DATE: 11/8/85

INSPECTOR: By Geca

DATE: 11/8/85

FIELD VERIFICATION BY: EN

DATE: 11/8/85

CORRECTED BY: EN

DATE: 11/8/85

RECORDED BY: EN

DATE: 11/8/85

NO.

BENCH MARKS

Top of Headwall for 30" outlet pipe for Piedra Lisa Dam

Elevation = 5911.00 (Painted Sq.)

FIELD NOTES

NO.

DATE

BY

ENGINEER'S SEAL

ROBERT F. SYKES

1591

PROFESSIONAL ENGINEER

REVISIONS

NO.

DATE

BY

REMARKS

DESIGNED BY

WILSON & COMPANY, ENGINEERS & ARCHITECTS

DRAWN BY

DATE

CHECKED BY

DATE

CITY OF ALBUQUERQUE

MUNICIPAL DEVELOPMENT DEPARTMENT

PIEDRA LISA PARK

STORM DRAINAGE IMPROVEMENTS

APPROVALS

ENGINEER

DATE

APPROVALS

ENGINEER

DATE

City Engineer

AROLAN

11/8/85

Liquid Waste

DR. J. J. J. J.

11/8/85

A.C.E. - Design

AROLAN

11/8/85

Traffic

DR. J. J. J. J.

11/8/85

A.C.E. - Hydrology

AROLAN

11/8/85

Water

DR. J. J. J. J.

11/8/85

PAKES + REC.

DR. J. J. J. J.

11/12/85

DRAWING NO.

2497

MAP NO.

H-23

SHEET


2 OF 4

WILSON & COMPANY


ENGINEERS & ARCHITECTS

ALBUQUERQUE, NEW MEXICO

85-516

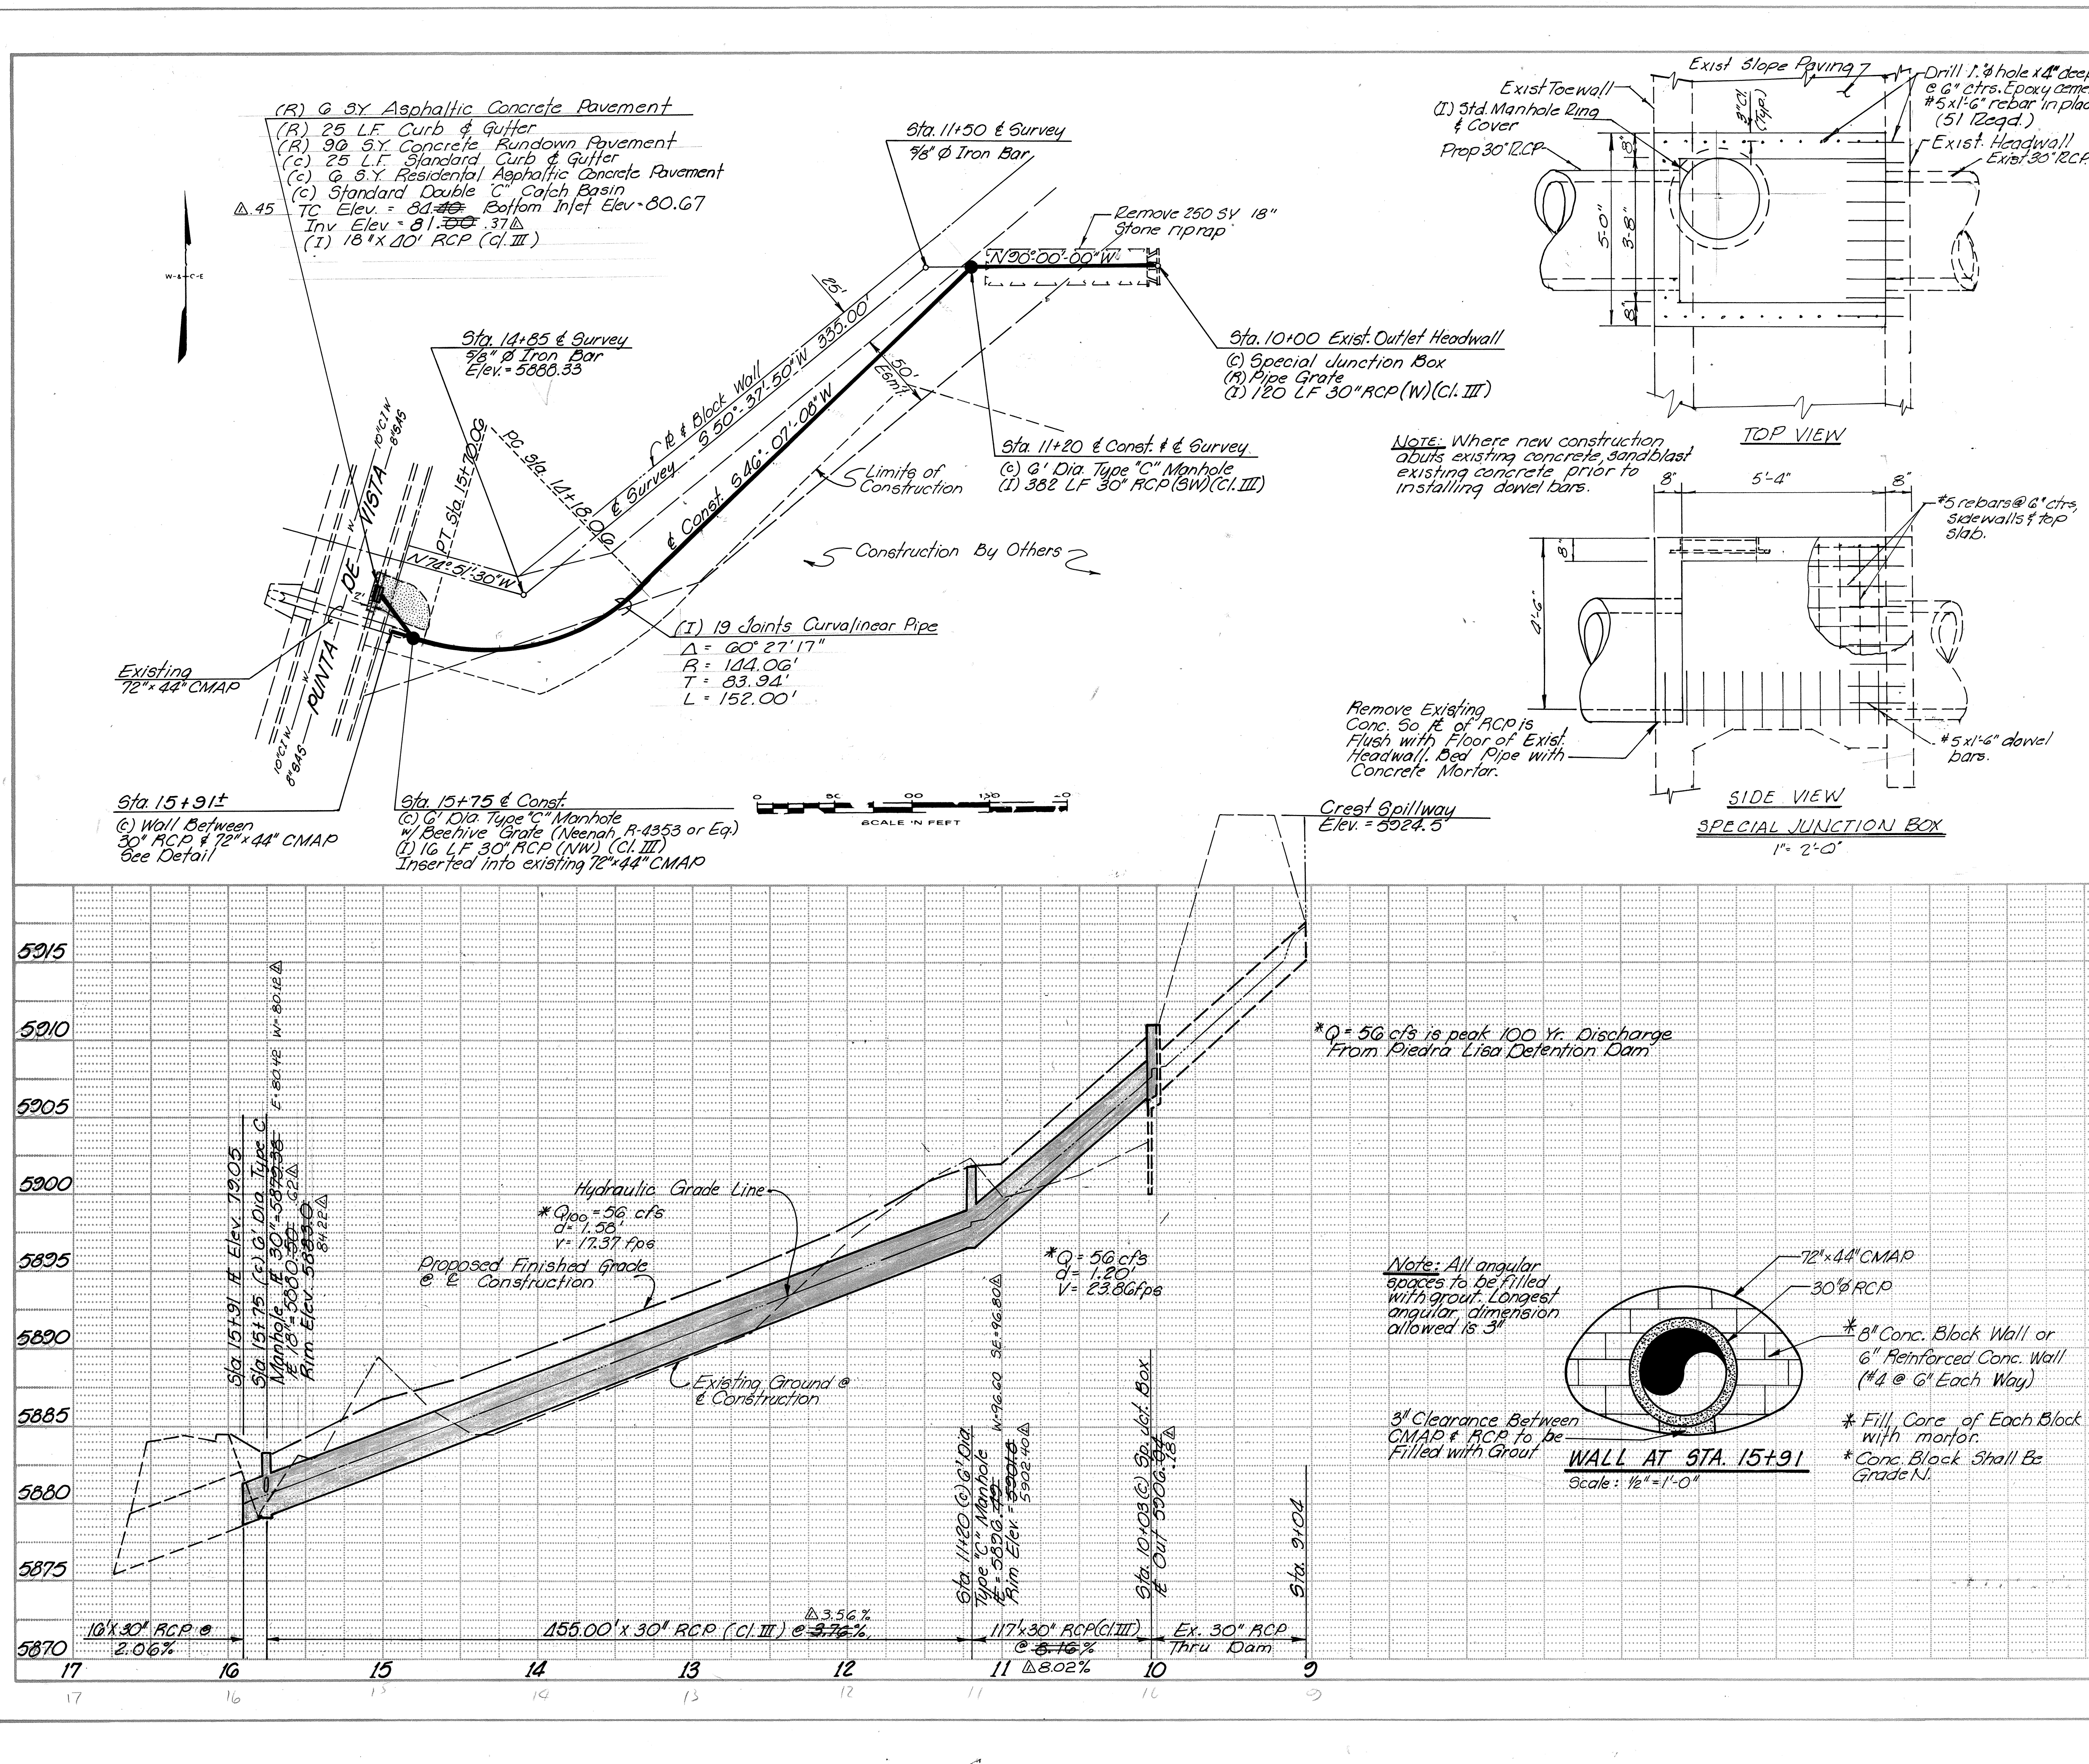

ORIGINAL			
SURVEY	SURVEYED	BY	DATE
NOTE BOOK	PLOTTED		
	TEMPLATE		
	AREAS		
NO. _____	AREAS CHECKED		

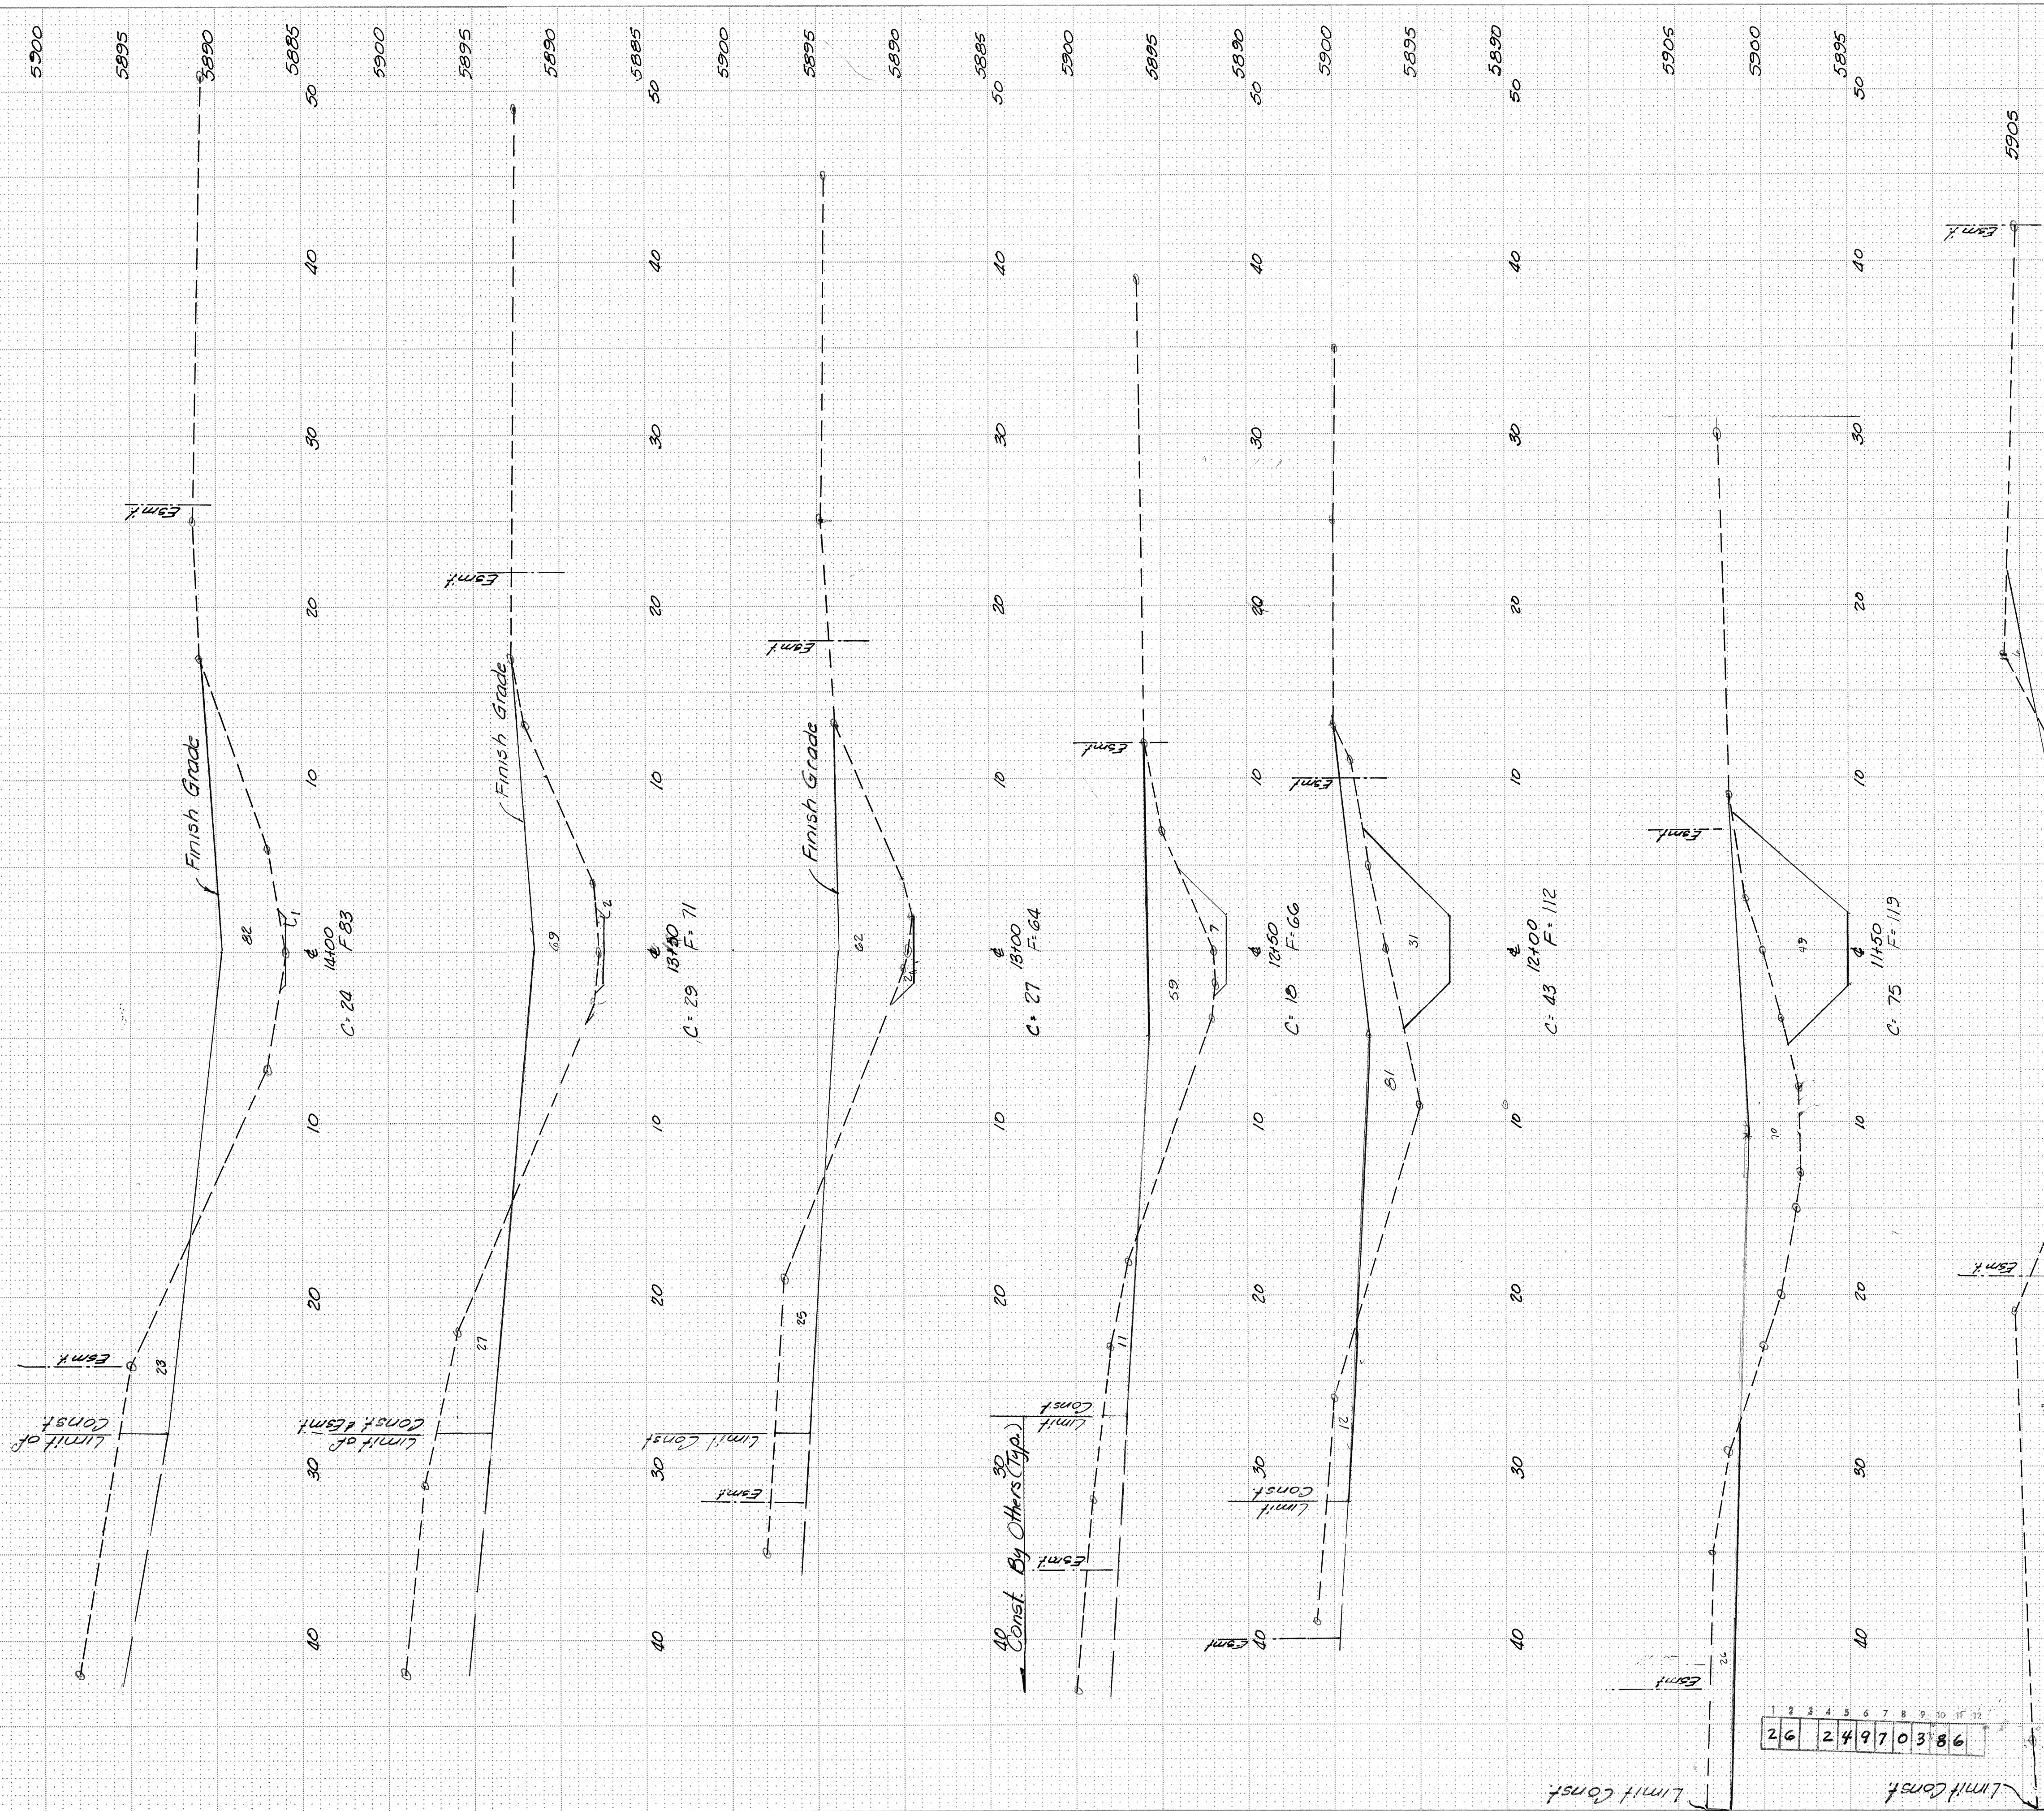[illegible]

F H W A REGION NO.	STATE	PROJECT NO.	FISCAL YEAR	SHEET NO.	TOTAL SHEETS
6	NEW MEXICO		19		

PROJ. 2497
PIEDRA LISA PARK
STORM DRAINAGE IMPROVEMENTS

FINAL	BY _____	DATE _____
SURVEY		
NOTE BOOK		
NO _____		

ORIGINAL	SURVEYED _____ BY _____ DATE _____
SURVEY	PLOTTED _____
NOTE BOOK	TEMPLATE _____
NO.	AREAS CHECKED _____ NO. _____

