


SCANNED BY LADON

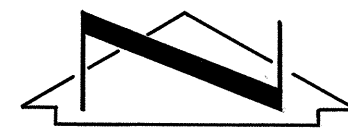


LOT 6A-2
BLOCK A, UNIT 1
INTERSTATE INDUSTRIAL TRACT
BOOK C28-PAGE 54
FILED 2-1-85

SE PROPERTY CORNER

CURVE TABLE

- ① $\Delta=161^{\circ}38'02''$
 $R=4.00'$
 $L=11.28'$
 $T=24.74'$
- ② $\Delta=49^{\circ}34'17''$
 $R=50.00'$
 $L=43.26'$
 $T=23.09'$
- ③ $\Delta=148^{\circ}47'41''$
 $R=8.00'$
 $L=20.78'$
 $T=28.65'$

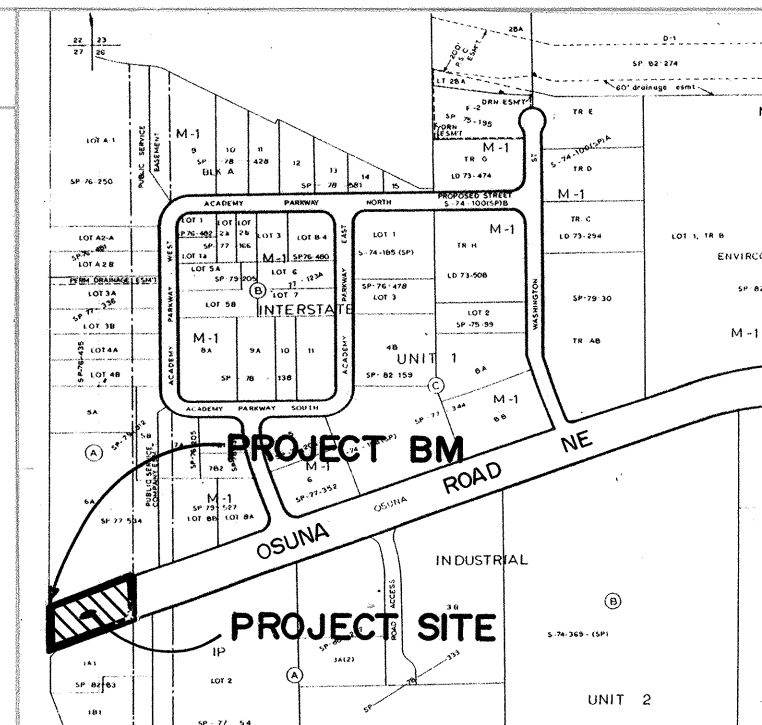


VICINITY MAP
SCALE: 1" = 800'

E-17

GENERAL NOTES

- All work detailed on these plans to be performed under contract shall, except otherwise stated or provided for hereon, be constructed in accordance with the City of Albuquerque Interim Standard Specifications-Public Works Construction-1985.
- Two working days prior to any excavation, Contractor must contact Line Locating Service, 765-1234, for the location of existing utilities.
- Prior to construction, the Contractor shall excavate and verify the horizontal and vertical locations of all existing utilities and potential obstructions. Should a conflict exist, the Contractor shall notify the Engineer so that the conflict can be resolved with a minimum amount of delay.
- The Contractor shall maintain access to adjacent properties at all times.
- All work on this project shall be performed in accordance with applicable Federal, State and Local laws, rules and regulations concerning construction safety and health.
- The Contractor must submit a construction signing and barricading plan to Traffic Engineering to receive a barricading permit prior to construction.
- All slopes as shown on profiles are based on centerline stationing.
- All dimensions and radii of curb and curb returns are shown to face of curb unless otherwise noted.
- The centerline has been established as the physical centerline of the street.
- Where removal of existing curb and gutter, sidewalk or pavement is required, the Contractor shall sawcut and/or remove to the nearest joint. Curb and gutter shown as existing and not to be removed under this contract which is damaged or displaced by the Contractor shall be removed and replaced by the Contractor at the Contractor's expense.
- Restriping of roadway shall be the responsibility of the City of Albuquerque and shall not be included in this contract.
- Where water meter boxes are encountered within the proposed project area, the water meter boxes shall be relocated in accordance with City of Albuquerque Standard Drawing W-16.
- All water valve boxes, water meter boxes and manholes encountered within the proposed project area shall be adjusted to finish grade.
- If an obstruction exists with the proposed location of a fire hydrant, it shall be relocated in accordance with City of Albuquerque Standard Drawing W-21.

"AS-BUILT" (HORIZONTAL AND VERTICAL LOCATION ONLY)

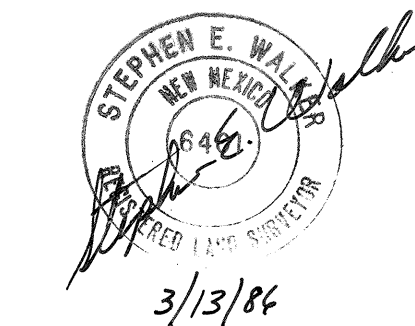

SCALE:
1" = 20' HORIZONTAL
1" = 2' VERTICAL

APPROVAL OF AS-BUILT DRAWINGS
ASST. CITY ENGINEER-FIELD
W. J. McNamee
DATE 3-19-86

1 2 3 4 5 6 7 8 9 10 11 12
26 25 19 01 86

OSUNA ROAD N.E.

5096.6
5094.4
5092.2

8+00 9+00 10+00

JOB NO. 40374

CITY OF ALBUQUERQUE
MUNICIPAL DEVELOPMENT DEPARTMENT
ENGINEERING DIVISION

TITLE: CAPITAL EQUIPMENT LEFT TURNBAY
EASTBOUND OSUNA ROAD N.E.

APPROVAL'S	ENGINEER	DATE	APPROVAL'S	ENGINEER	DATE
City Engineer	J. J. Nichols	8/16/85	Liquid Waste	P. B. McNamee	7/10/85
A.C.E.-Design	J. J. Nichols	8/15/85	Traffic	David W. Hanna	7/10/85
Hydrology	N.A. B. G. S.	7/10/85	Water	P. B. McNamee	7/10/85

DRAWING NO.	MAP NO.	SHEET	OF
2519	E-17	1	1