


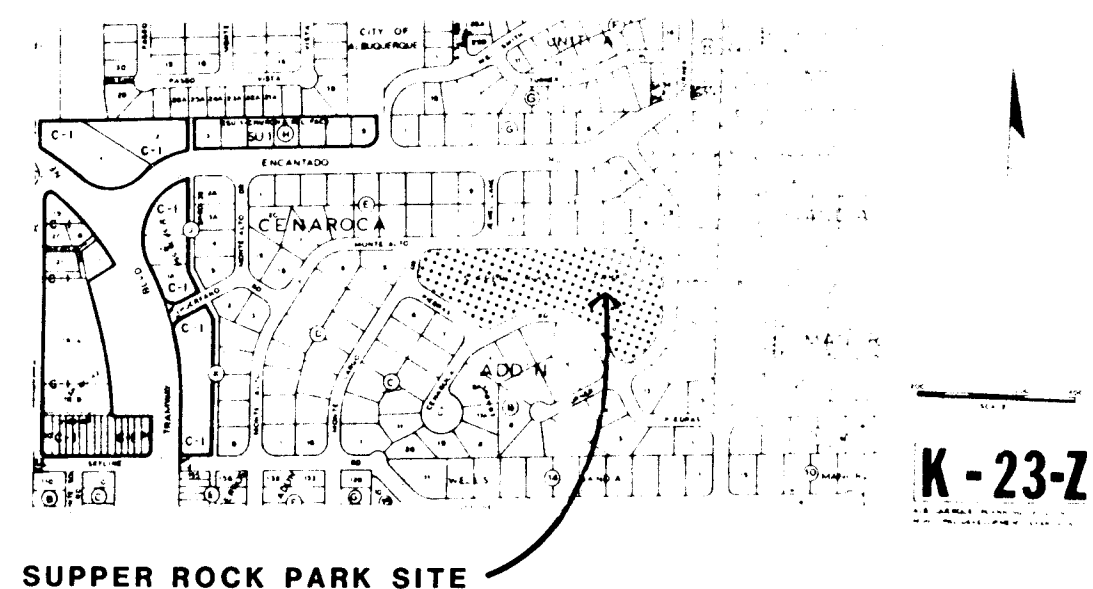

VICINITY MAP

NOTICE TO CONTRACTORS

1. ALL WORK UNDER THIS CONTRACT SHALL BE COMPLETED BY THE CONTRACTOR WITHIN THE TIME FRAME SPECIFIED IN THE CONTRACT. THE CONTRACTOR SHALL BE RESPONSIBLE FOR PROVIDING THE NECESSARY SKILLED LABORERS TO COMPLY WITH THE SPECIFIC REQUIREMENTS OF THE CONTRACT. THE CLIENT ROBINS CONSTRUCTION COMPANY LIMITED OFFERED TO HERMIAH THE CONTRACT AND SHE ACCEPTED THE CONTRACT BECAUSE:
2. THE 12 MONTH WORKING DAYS SPECIFIED IN THE CONTRACT, CONTRACTOR MUST COMPLY WITH THE SPECIFIC REQUIREMENTS OF THE CONTRACT, FOR THE CONTRACT TO BE COMPLETED.
3. THE CLIENT CONSIDERS THE CONTRACT TO BE A GOOD INVESTMENT AND SHE WILL BE ABLE TO RECOVER THE INVESTMENT IN THE LONG RUN. THE CONTRACTOR MUST COMPLY WITH THE SPECIFIC REQUIREMENTS OF THE CONTRACT TO BE COMPLETED.

THE FOLLOWING NOTES ALSO APPLY WHEN CHECKED

- [illegible]

SUPPER ROCK PARK JOGGING TRAIL

INDEX

SHEET 1 COVER SHEET
SHEET 2 SITE PLAN

AS BUILT

Name Ryszardo L. Konte
Date 10-14-85

APPROVAL OF AS BUILT DRAWINGS
CHIEF CONSTRUCTION ENGINEER
Russell B. Smith
DATE 5-22-87

1	2	3	4	5	6	7	8	9	10	11
2	6		2	5	3	1	0	1	8	7


REV	SHEETS	CITY ENG.	DATE	USER	DEPT.	DATE	USER
APPROVAL OF REVISIONS							

FINAL COPY
DATE: 2/8/85

**APPROVED FOR
CONSTRUCTION**

253/
PROJECT NUMBER

SHEET 1 OF 2

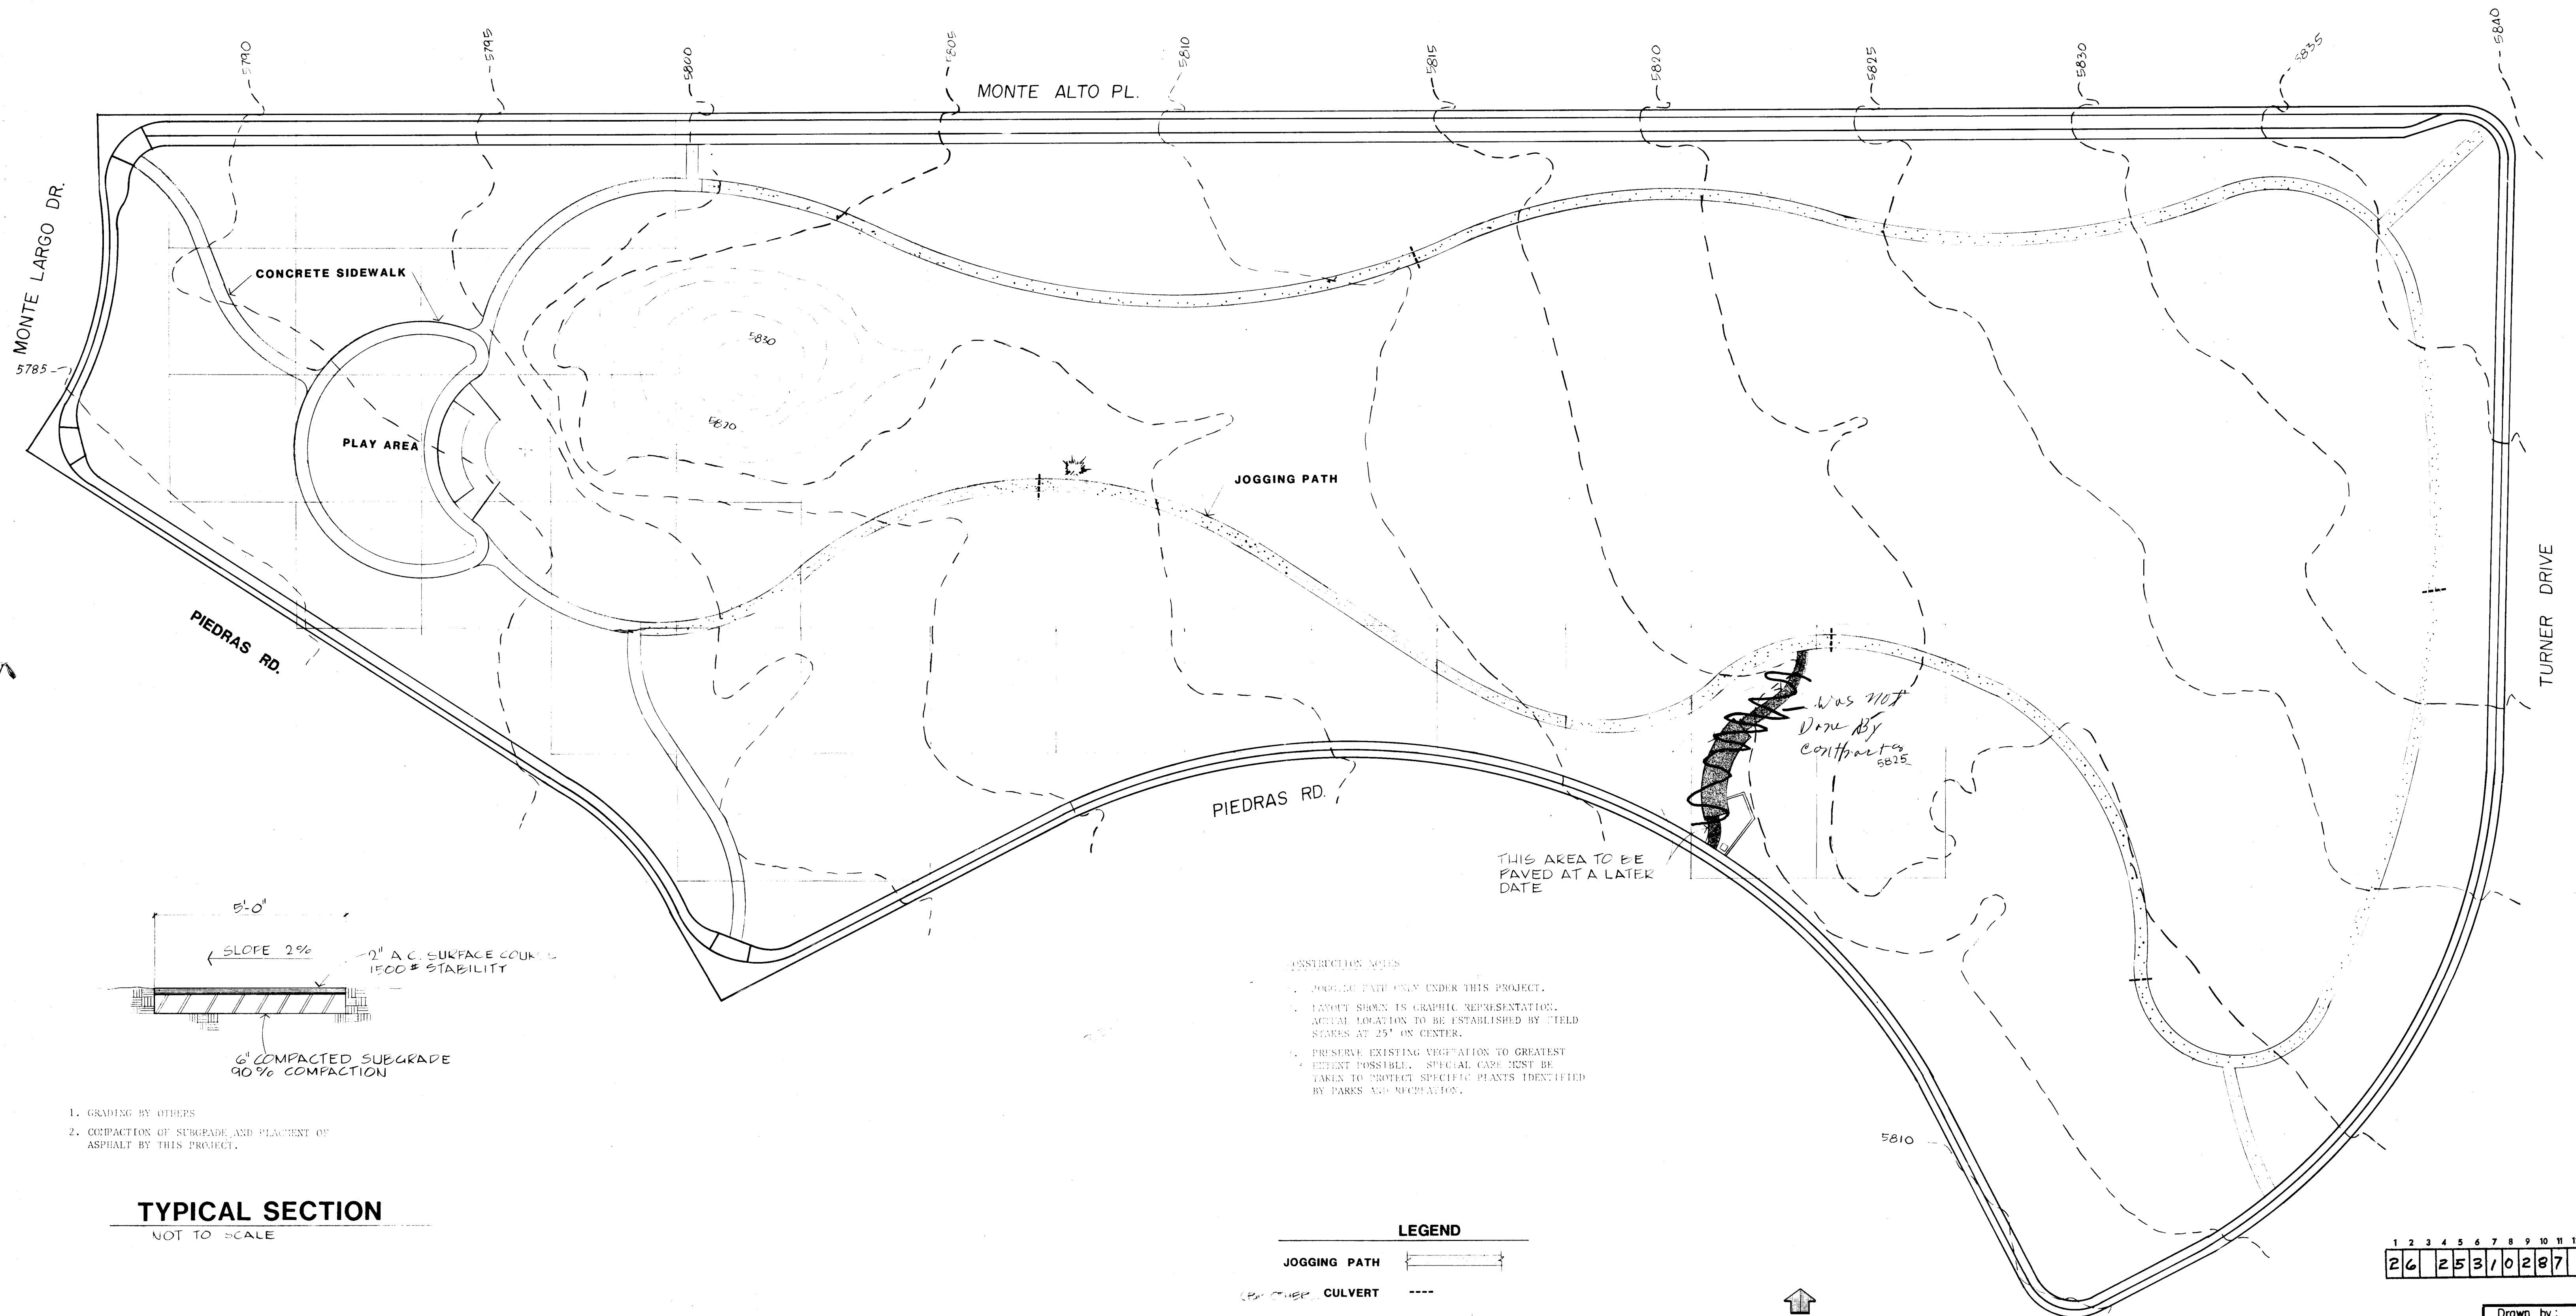

LEGEND

JOGGING PATH	
CULVERT	
CONC SIDEWALK	
EXISTING CONTOUR	
ASPHALT PATH (WORK TO BE DONE AT A LATER DATE)	

SCALE : 1" = 30'

1	2	3	4	5	6	7	8	9	10	11	12
26	25	31	02	87							

NO.				REVISIONS				BY		APPROV		DATE		Drawn by:
SUPPER ROCK PARK														Checked by:
City of Albuquerque Parks and Recreation Design and Development														Date: 6-12-85
														Scale: NOTED
														Sheet of 2