


• L E G E N D •

MATERIALS

CONCRETE

RIP · RAP

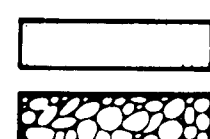

LINES

SUBDIVISION BOUNDARY

PROPERTY LINE (PLAN)


PROPERTY LINE (SECTION)

CENTERLINE

EASEMENT LINE

MATCH LINE

SECTION CUT LINE

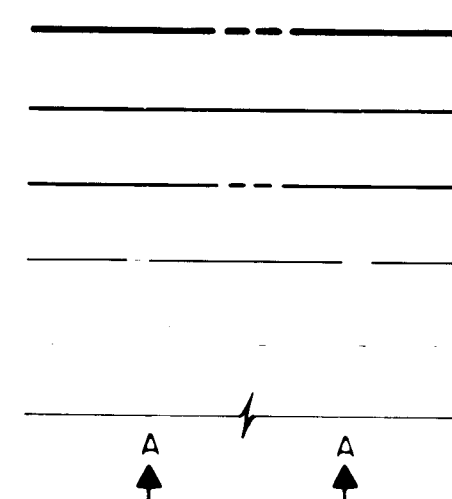

EARTHWORK


CONTOUR LINE

SPOT ELEVATION

PROJECT / PHASE BOUNDARY

SWALE

DIRECTION OF FLOW

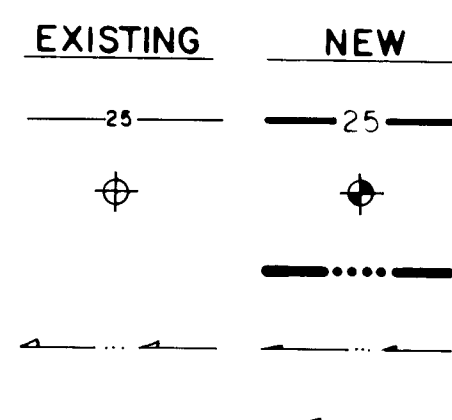

MISCELLANEOUS UTILITIES

GAS LINE


UNDERGROUND TELEPHONE

UNDERGROUND ELECTRICAL

STORM DRAIN

STORM DRAIN MANHOLE

STORM DRAIN INLET

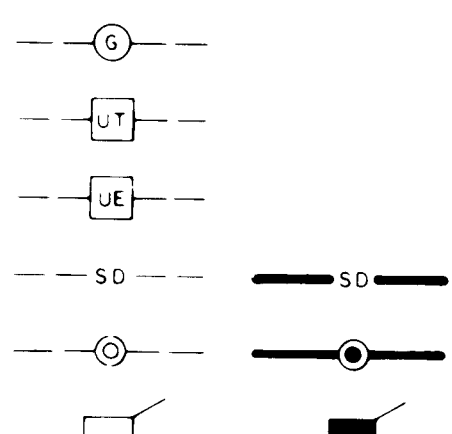

SANITARY SEWER


SANITARY SEWER LINE

SANITARY SEWER MANHOLE

SAS SERVICE CONNECTIONS

SAS CAP OR PLUG

ENCASEMENT

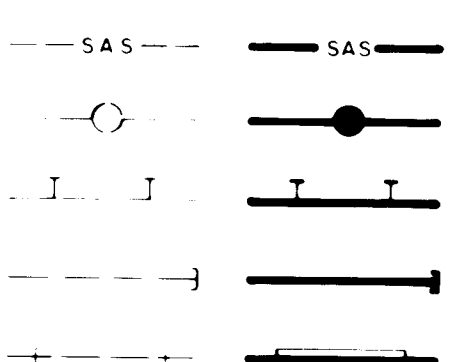

WATER

WATER LINE

WATER SERVICE CONNECTIONS


GATE VALVE

FIRE HYDRANT

BUTTERFLY VALVE

REDUCER

WATER PRESSURE ZONE BOUNDARY

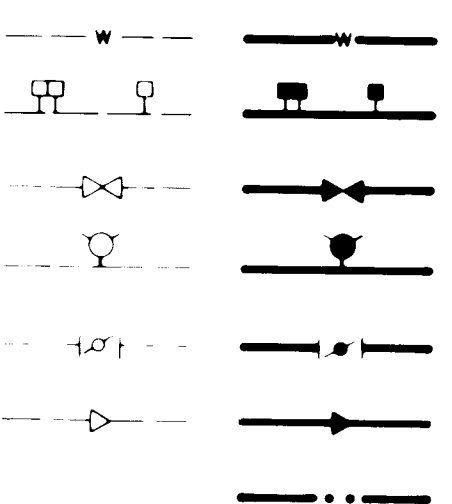


WATER FITTINGS

CAPS AND PLUGS

ELBOW

CROSS

TEE

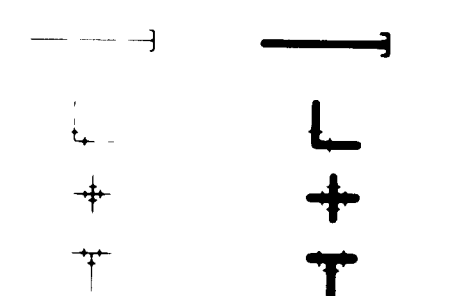

MISCELLANEOUS


CHAINLINK FENCE

FIELD FENCE

COMMON YARD WALL

RETAINING WALL


POWER OR TELEPHONE POLE

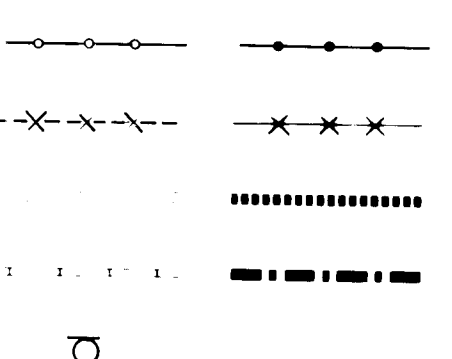

CONSTRUCTION PLANS FOR
**WYOMING & HARPER NEIGHBORHOOD
SHOPPING CENTER**
ALBUQUERQUE, NEW MEXICO
APRIL, 1985

INDEX OF DRAWINGS

SHEET NO.	TITLE
1	COVER SHEET
2	SUBDIVISION PLAT
3	UTILITY SITE PLAN
4	UTILITY PLAN & PROFILE
5	PAVING PLAN & PROFILE
6-7	GRADING & DRAINAGE PLAN

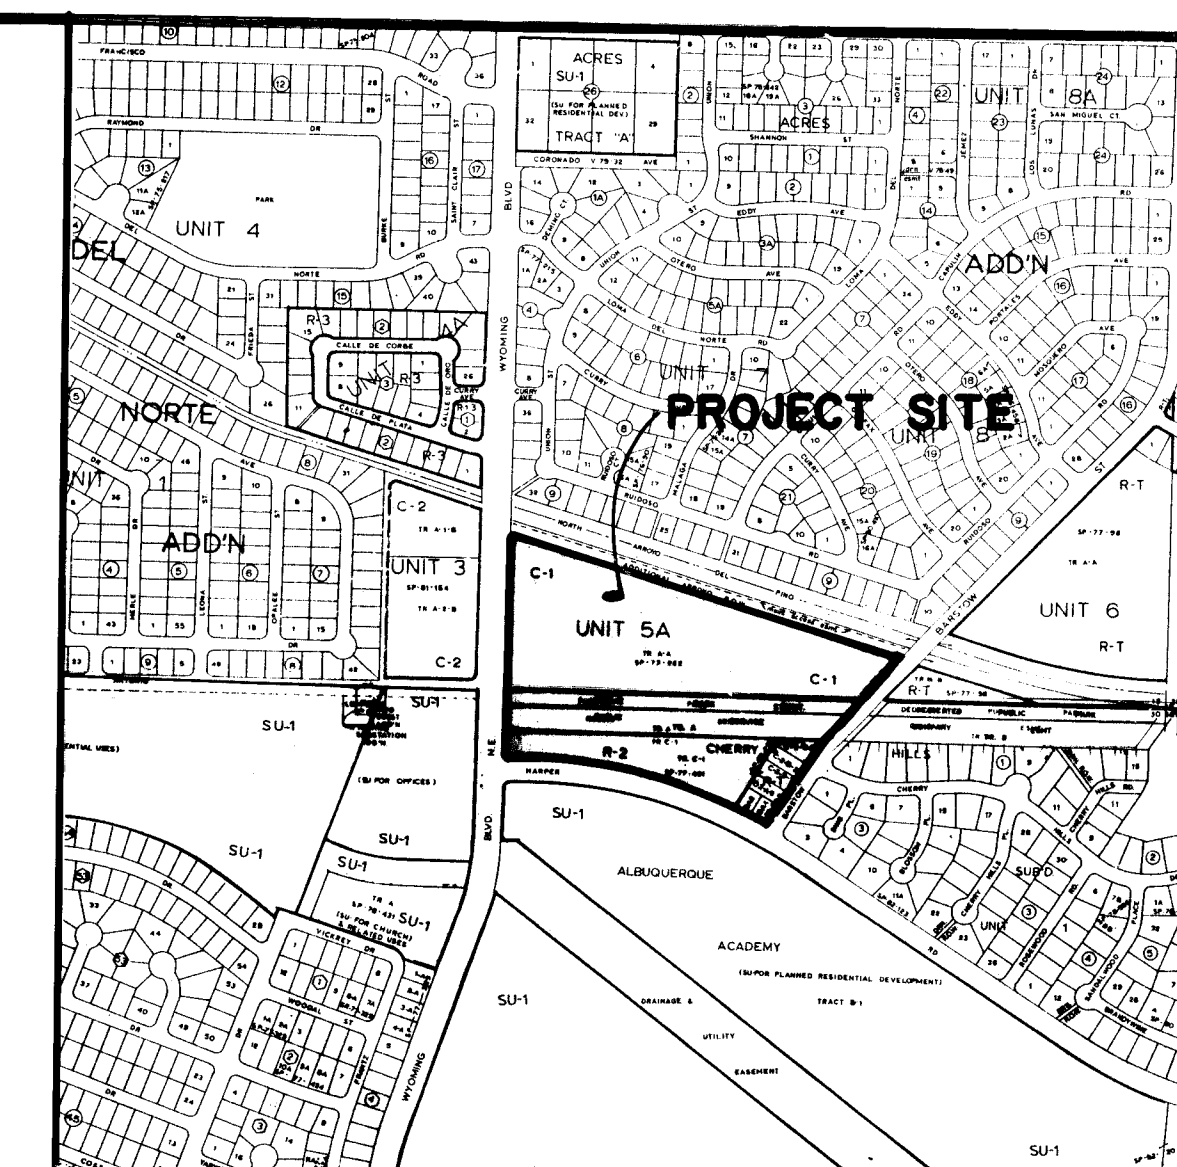

VICINITY MAP
SCALE : 1" = 800'

D-19
E-19

GENERAL NOTES

1. ALL WORK DETAILED ON THESE PLANS TO BE PERFORMED UNDER CONTRACT SHALL, EXCEPT AS OTHERWISE STATED OR PROVIDED FOR HEREON, BE CONSTRUCTED IN ACCORDANCE WITH THE CITY OF ALBUQUERQUE INTERIM STANDARD SPECIFICATIONS - PUBLIC WORKS CONSTRUCTION - 1985.
2. TWO (2) WORKING DAYS PRIOR TO ANY EXCAVATION, CONTRACTOR MUST CONTACT LINE LOCATING SERVICE, 765-1234, FOR LOCATION OF EXISTING UTILITIES.
3. PRIOR TO CONSTRUCTION, THE CONTRACTOR SHALL EXCAVATE AND VERIFY THE HORIZONTAL AND VERTICAL LOCATION OF ALL POTENTIAL OBSTRUCTIONS. SHOULD A CONFLICT EXIST, THE CONTRACTOR SHALL NOTIFY THE ENGINEER SO THAT THE CONFLICT CAN BE RESOLVED WITH A MINIMUM AMOUNT OF DELAY.
4. THE CONTRACTOR SHALL MAINTAIN ACCESS TO ADJACENT PROPERTIES DURING CONSTRUCTION.
5. ALL WORK ON THIS PROJECT SHALL BE PERFORMED IN ACCORDANCE WITH APPLICABLE FEDERAL, STATE AND LOCAL LAWS, RULES AND REGULATIONS CONCERNING CONSTRUCTION SAFETY AND HEALTH.
6. THE CONTRACTOR MUST SUBMIT A CONSTRUCTION SIGNING AND BARRICADING PLAN TO TRAFFIC ENGINEERING TO RECEIVE A BARRICADING PERMIT PRIOR TO CONSTRUCTION.

David B. Smith
10-9-86

26 25590186

REV	SHEETS	CITY ENGINEER	DATE	USER DEPARTMENT	DATE	USER DEPARTMENT	DATE
3,4		<i>David B. Smith</i>	2/20/86	WAD B. Smith	12/21/86		
APPROVAL OF REVISIONS							



2559

APPROVED FOR
CONSTRUCTION

SHEET 1 OF 7

PLAT OF 85 82580
TRACT A-A-1, UNIT 5-A
LOMA DEL NORTE &
TRACT A-1 CHERRY HILLS, UNIT I
A REPLAT OF
TRACT A-A, UNIT 5-A, LOMA DEL NORTE
&
TRACT A, CHERRY HILLS, UNIT I
ALBUQUERQUE, NEW MEXICO
APRIL, 1985

Thomas T. Mann, Jr., N.M.P.E. & S. 4/17/05
 Date

ACKNOWLEDGEMENT
 STATE OF NEW MEXICO)
 COUNTY OF BERNALILLO) SS.

The foregoing instrument was acknowledged before me on this
17th day of April, 1986.
Ruth A. Armand
 Notary Public

DESCRIPTION

A certain tract of land located within the Corporate limits of the City of Albuquerque, New Mexico, comprising Tract A-A, as shown on the plat of Unit 5-A, Loma Del Norte, filed in the Office of the County Clerk of Bernalillo County, New Mexico, on April 14, 1977, Book D-6, Page 166, and Tract A-A, as shown on the plat of Cherry Hills, Unit I, filed in the Office of the County Clerk of Bernalillo County, New Mexico, on April 12, 1975, Book D-6, Page 149, and being more particularly described as follows:

beginning at the southwest corner of the parcel herein described, being a point on the east right-of-way line of Wyoming Boulevard N.E., and being the same point as the southwest corner of Tract A; thence S 89°36'32" E a distance of 100.00 feet along said right-of-way line; thence S 89°36'32" E a distance of 3.25 feet along said right-of-way line; thence N 00°09'43" E a distance of 675.00 feet along said right-of-way line; thence the line of Parcel A; thence a distance of 1645.79 feet to a point on the west right-of-way line of Parcel A; thence along said west right-of-way line of Parcel A a distance of 1645.79 feet along the arc of a curve to the right - $R = 0746'17"$, $R = 2432.00$ feet, and $L = 75.19$ feet along said right-of-way line; thence S 89°36'32" E a distance of 100.00 feet along said right-of-way line; $R = 2568.00$ feet, and $L = 79.41$ feet along said right-of-way line; thence N 00°09'43" E a distance of 264.44 feet along said right-of-way line; thence along the line of Parcel A a distance of 1645.79 feet to a point on the west right-of-way line; $R = 1.58$ feet along said right-of-way line; thence S 89°36'32" W a distance of 1647.09 feet to the point of beginning and containing 20.0138 acres more or less.

Richard Kluck 4-29-85

DEL NORTE ASSOCIATES, A NEW MEXICO LIMITED PARTNERSHIP
HARTFORD CENTER, INC., A NEW MEXICO CORPORATION, GENERAL PARTNER
NICHOLAS J. BLACK, VICE-PRESIDENT

ACKNOWLEDGEMENT

STATE OF NEW MEXICO)
COUNTY OF BERNALILLO) SS

 OFFICIAL SEAL
RUTH A ARNAUD
My Commission Expires 6-23-88

Notary Public for the State of New Mexico
Notary Public with the Secretary of State

Luth D. Ormand
Notary Public
DB-06-206 SP-85-413

APPROVALS:  9.25.88
Planning Director, City of Albuquerque, N.M. Date

Jon E. Entsgaard 9-19-85
Water Resources, City of Albuquerque, N.M. Date

3rd J. Aragon 4-30-85
City Engineer, City of Albuquerque, N.M. Date

Frank J. Gagin 4-30-81
A.M.A.F.C.A., City of Albuquerque, N.M. Date

Robert A. Farnsworth *4-30-85*
Traffic Engineer, City of Albuquerque, N.M. Date

Manti Valley 4-30-85
Parks and Recreation, City of Albuquerque, N.M. Date

Chief City Surveyor, City of Albuquerque, N.M. Date 0429 65

Havaii Stewin 4/30/85
Property Manager, City of Albuquerque, N.M. Date



- Notes:
1. No field work was performed.
2. No street mileage was created.
3. All distances are ground distances.
4. Site located within Section 19, T11N, R4E, N.W.1/4.M.
5. Bearing base is plat of "Tract A-A, Unit 5-A, Loma Del Norte" filed April 21, 1977, Book D7, Page 166.
6. The purpose of this plat is to dedicate public right-of-way on the east side of Wyoming Blvd. N.E. and to grant an additional 60' wildlife easement along the north boundary of Tract A-A-1 as shown hereon.

CURVE	ARC	DELTA	RADIUS	CHORD LENGTH	CHORD BEARING	LINE	BEARING	DISTANCE
C1	75.1°	1° 17'	2432.00	75.41	S 43° 49' 34" W	L1	N 0° 03' 48" E	150.00
C2	79.41	1° 46' 18"	2568.00	79.41	S 43° 49' 32" W	L2	S 89° 33' 25" E	
C3	1.58	0° 06' 10"	884.00	1.58	S 42° 53' 18" W	L3	S 42° 56' 23" W	65.13
C4	28.55	28° 41' 31"	57.00	28.25	S 14° 11' 07" E	L4	S 42° 56' 23" W	62.42
C5	45.87	1° 30' 27"	162.00	45.62	S 87° 31' 31" W	L5	S 65° 47' 1" E	40.31
C6	39.46	18° 15' 37"	138.00	39.33	S 09° 43' 11" W			


811 DALLAS, N.E. • ALBUQUERQUE • NEW MEXICO • 87110
ENGINEERS

JOB NO. 40402

C28-94

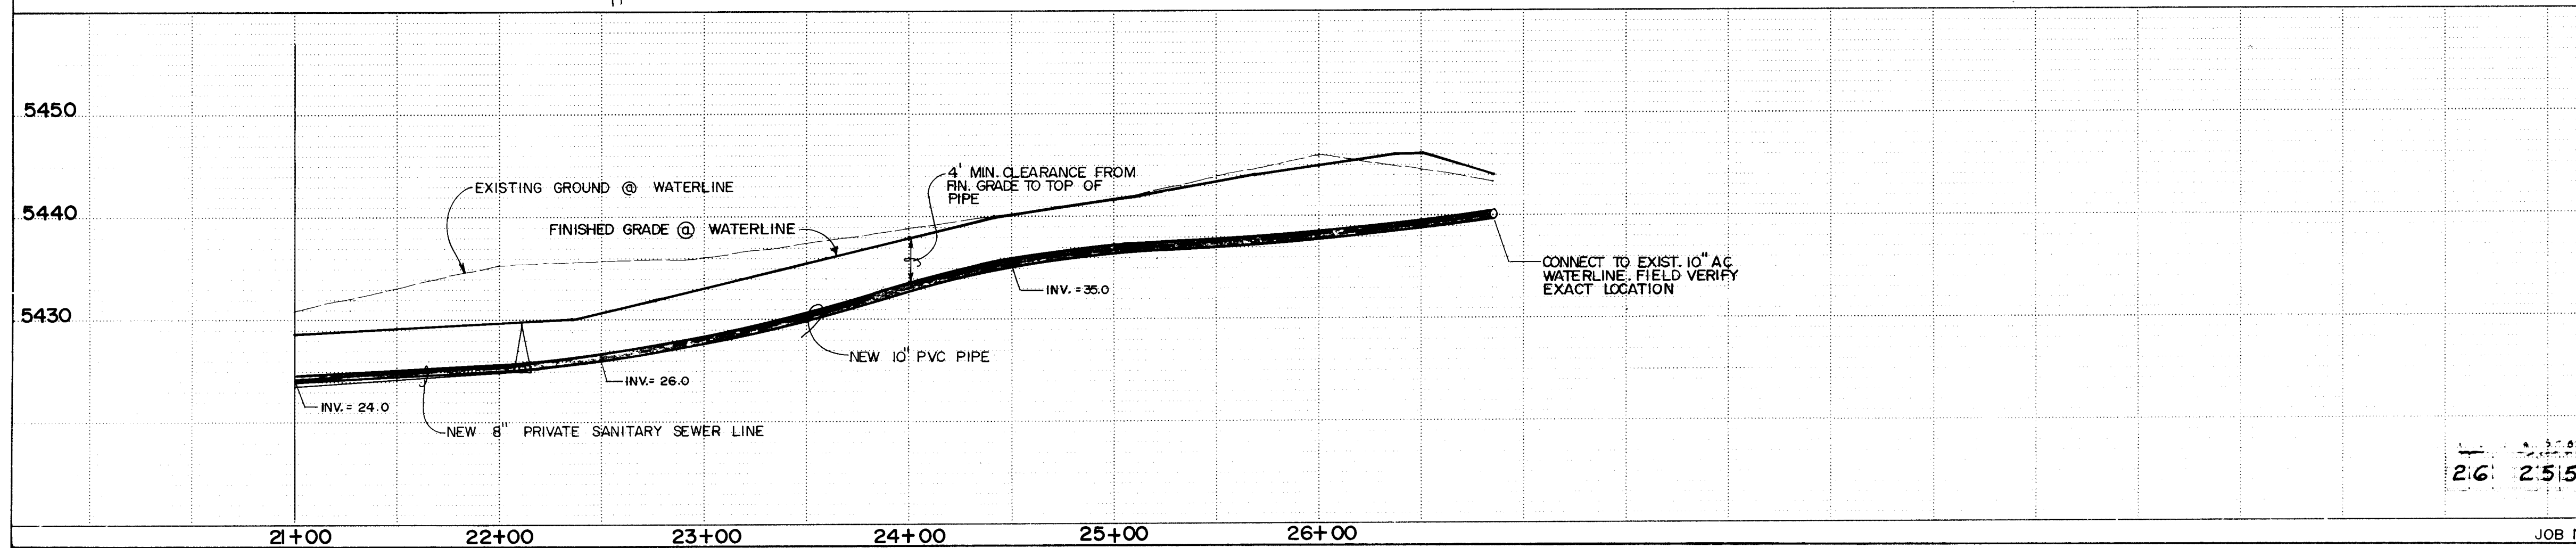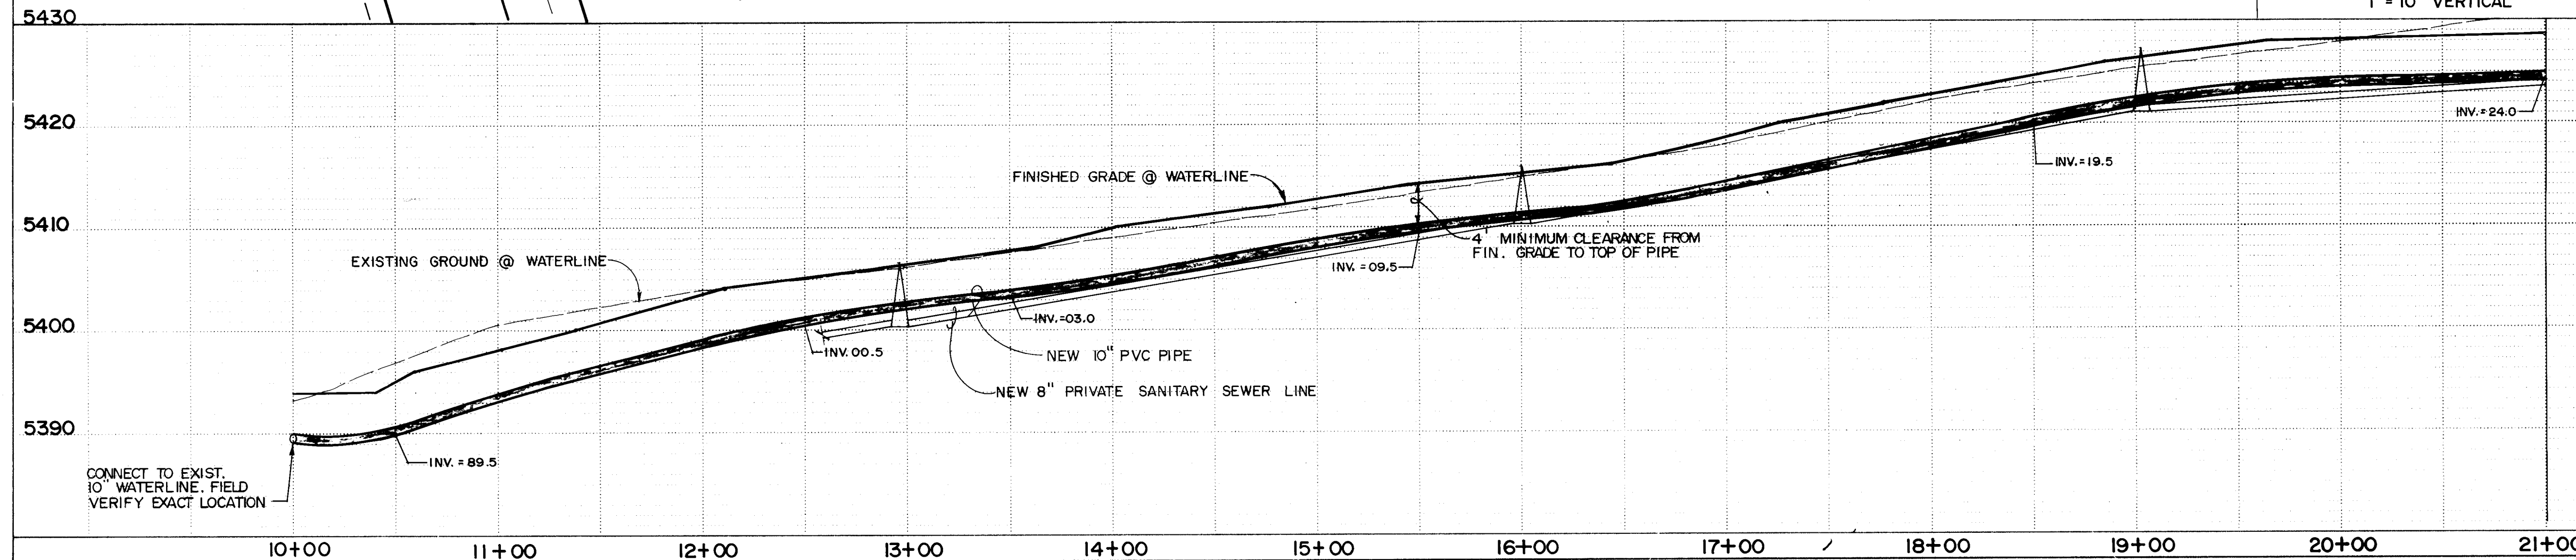


SURVEY		INFORMATION		BENCH MARKS	AS BUILT INFORMATION	
NO.	BY	FIELD NOTES	DATE		CONTRACTOR	DATE
				AN ACB BARRIS TABLET STAMPED 16-1910-1078, SET IN TOP OF A CONC. POST SET FLUSH W/ GROUND. STATION IS LOCATED 48' NORTH OF THE E. OF 3AN ANTONIO DR. NE 8 45' WEST OF THE E. OF WYOMING BLVD. NE. IN THE NORTHWEST QUADRANT OF THE INTERSECTION.	INSPECTED BY FIELD LANCE BY L. VALDEZ	DATE 08-11-93
				ELEV. @ 5403.54 FT. (MSLD)	VERIFICATION BY CORRECTED BY E.N.	DATE 02-05-96
					MICRO-FILM INFORMATION	DATE
					RECORDED BY	DATE
					NO	

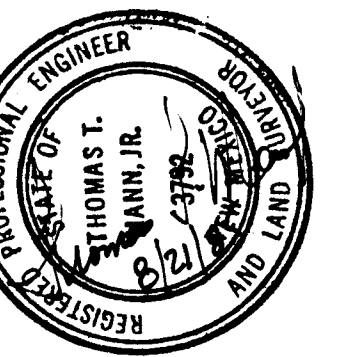[illegible]

Tom Mann Associates, Inc.

APPROVALS	ENGINEER	DATE	APPROVALS	ENGINEER	DATE
City Engineer	<i>[Signature]</i>	12/19/85	Liquid Waste	<i>[Signature]</i>	8/21/85
A C E - Design	<i>[Signature]</i>	12/19/85	Traffic	<i>[Signature]</i>	8/21/85
A C E - Hydrology	<i>[Signature]</i>	8/21/85	Water	<i>[Signature]</i>	8/21/85

DRAWING NO. 2559	MAP NO. D-19	SHEET 4 OF 7
---------------------	-----------------	--------------

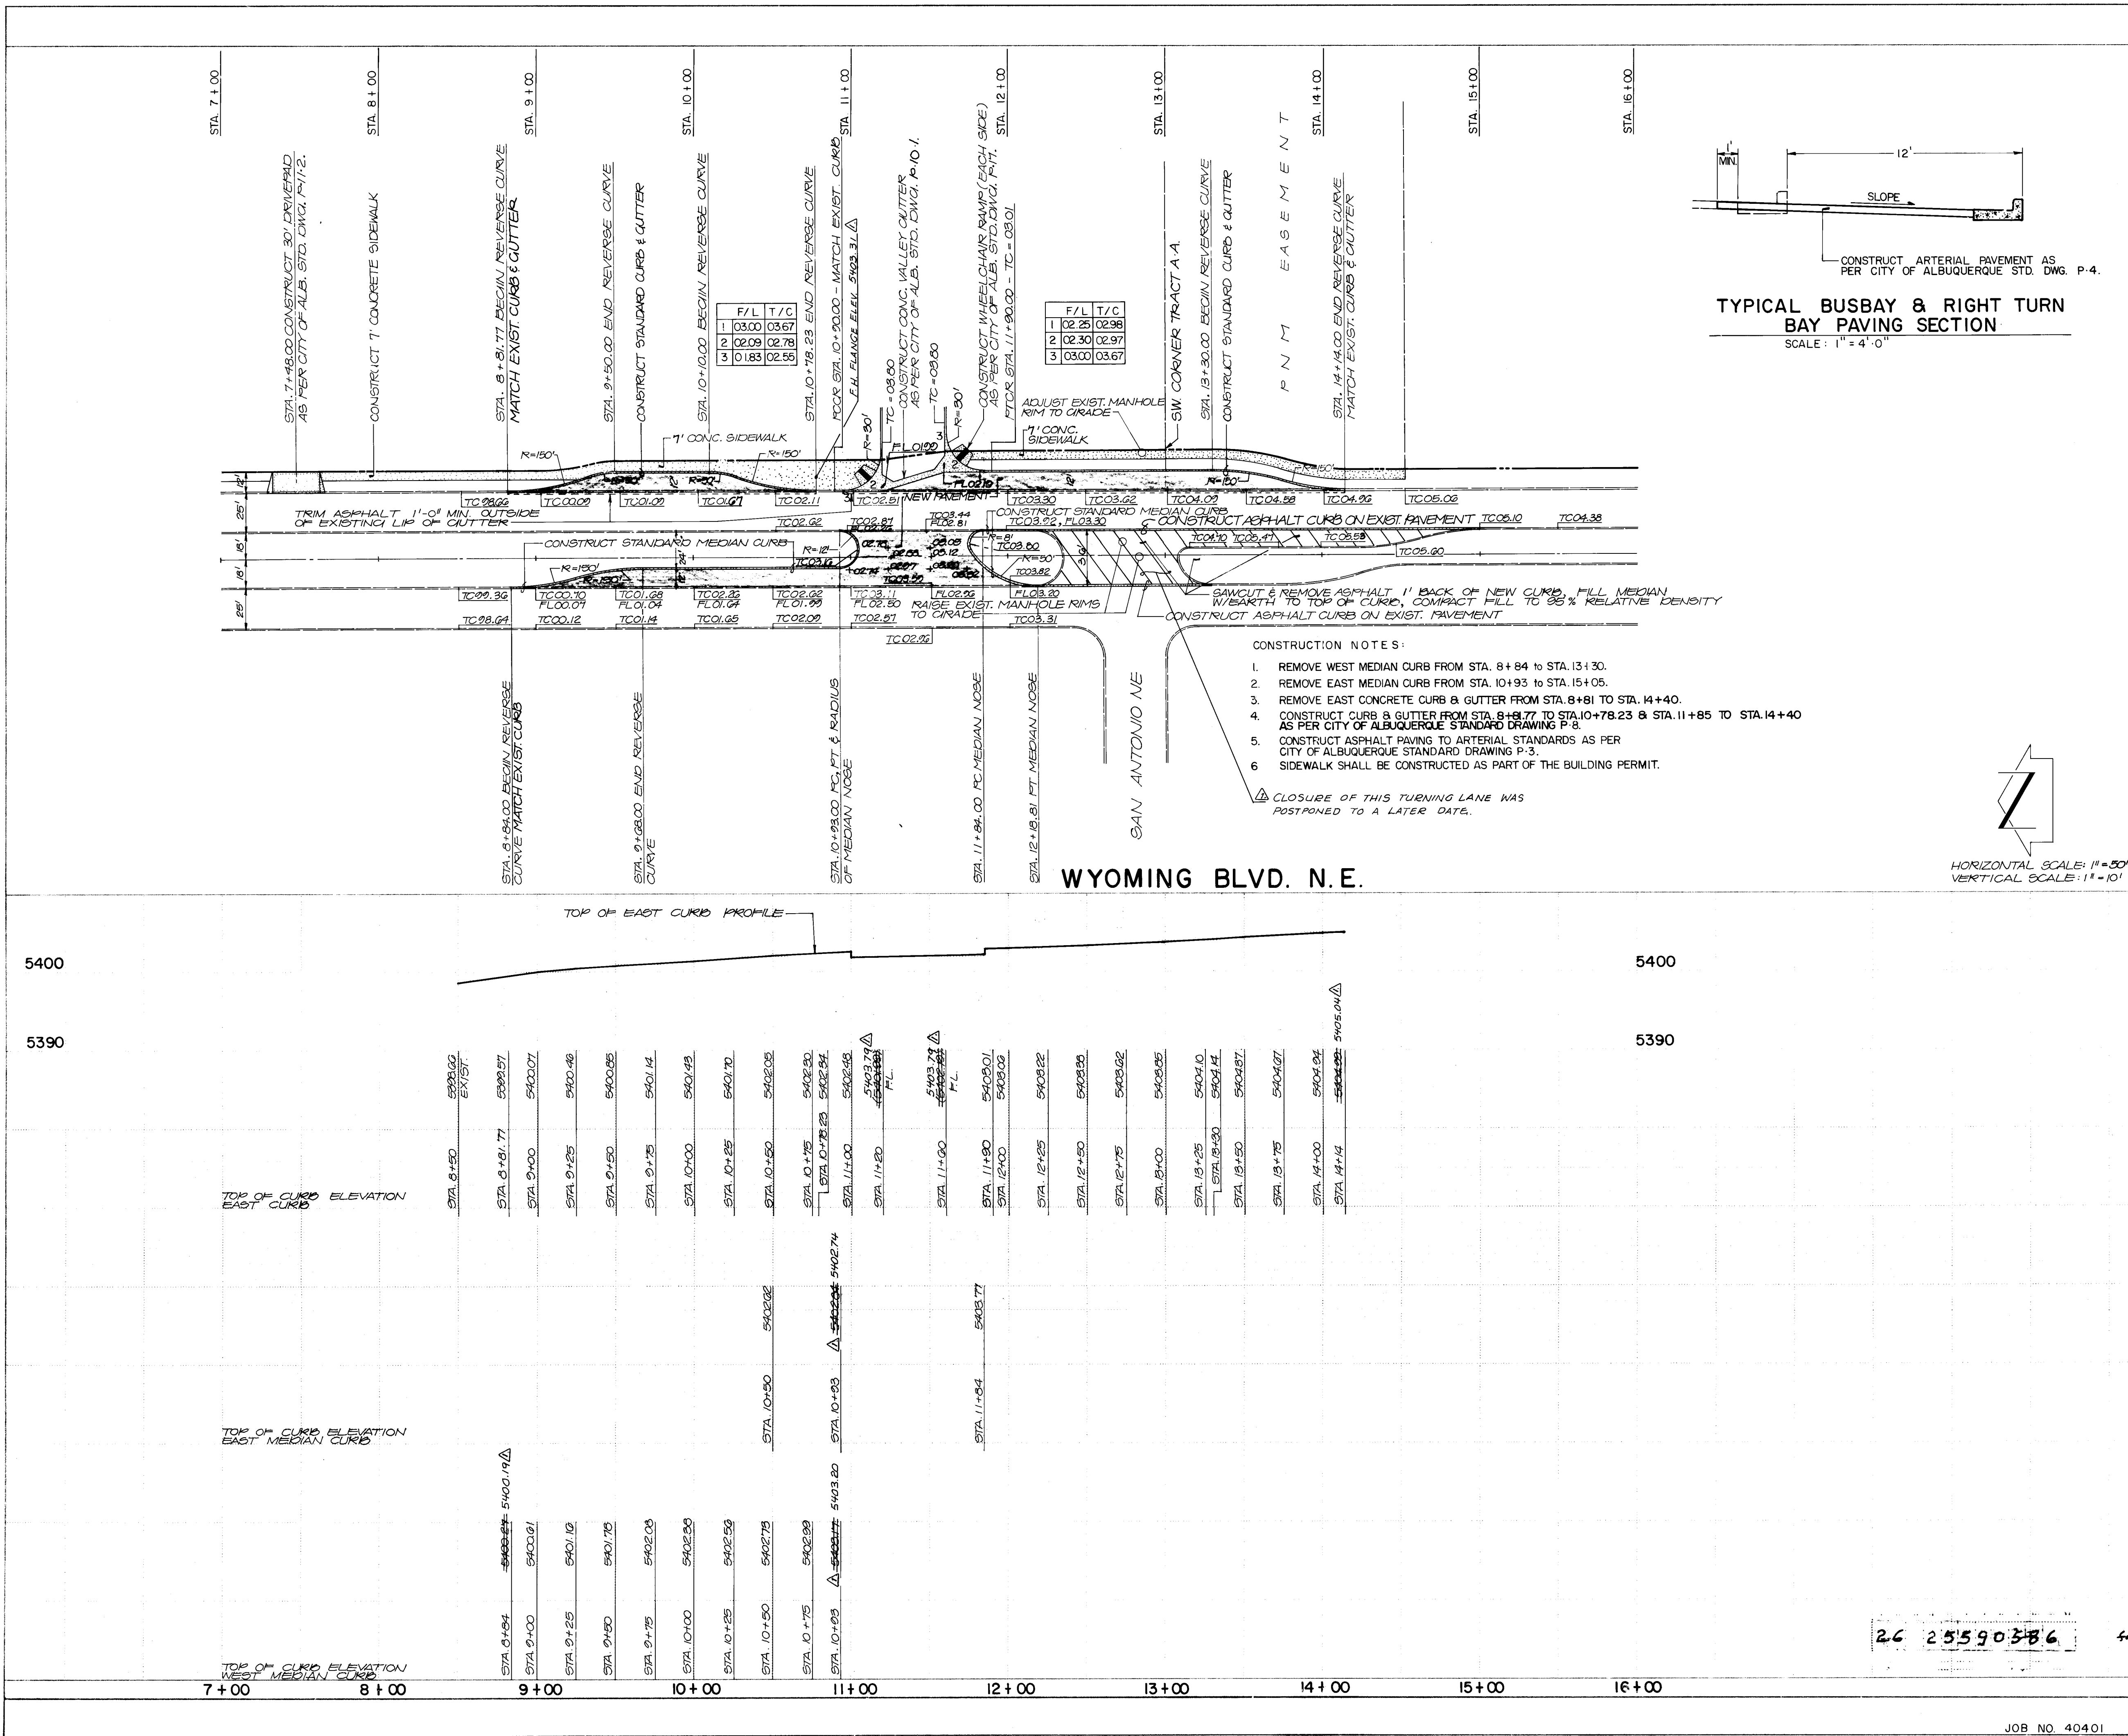

VICINITY MAP D&E-19

SCALE: 1" = 800'

GENERAL NOTES

1. All work detailed on these plans to be performed under contract shall, except otherwise stated or provided for herein, be constructed in accordance with the City of Albuquerque Interim Standard Specifications - Public Works Construction - 1985.
2. Two working days prior to any excavation, Contractor must contact Line Locating Service, 765-1234, for location of existing utilities.
3. Prior to construction, the Contractor shall excavate and verify the horizontal and vertical locations of all existing utilities and potential obstructions. Should a conflict exist, the Contractor shall notify the Engineer so that the conflict can be resolved with a minimum amount of delay.
4. The Contractor shall maintain access to adjacent properties at all times.
5. All work on this project shall be performed in accordance with applicable Federal, State and local laws, rules and regulations construction safety and health.
6. The Contractor must submit a construction signing and barricading plan to Traffic Engineering to receive a barricading permit prior to construction.
7. All slopes as shown on profiles are based on baseline stationing.
8. All dimensions and radii of curb and curb returns are shown to face of curb.
9. The baseline has been established by splitting the distances between the curbs.
10. Where removal of existing curb and gutter, sidewalk or pavement is required, the Contractor shall sawcut and/or remove to the nearest joint. Curb and gutter shown as existing and not to be removed under this contract which is damaged or displaced by the Contractor shall be removed and replaced by the Contractor at the Contractor's expense.

ENGINEER'S SEAL

REGISTERED PROFESSIONAL ENGINEER
THOMAS A. HARRIS
STATE OF NEW MEXICO
No. 12345
Exp. 12/31/2015

REVISIONS

NO.	DATE	REVISIONS
1	10/1/85	Revised from as-built drawings

DESIGN

DESIGNED BY: TTM
DRAWN BY: TMA
CHECKED BY: TTM


CITY OF ALBUQUERQUE
MUNICIPAL DEVELOPMENT DEPARTMENT
ENGINEERING DIVISION

TITLE:
WYOMING & HARPER NEIGHBORHOOD SHOPPING CENTER
PAVING PLAN & PROFILE

APPROVALS	ENGINEER	DATE	APPROVALS	ENGINEER	DATE
City Engineer	W. A. Harris	11/1/85	Liquid Waste	R. A. Harris	11/1/85
A.C.E. Design	W. A. Harris	11/1/85	Traffic	David O. Harris	11/1/85
Hydrology	W. A. Harris	11/1/85	Water	R. A. Harris	11/1/85

DRAWING NO. 2559 **MAP NO. D&E-19** **SHEET 5 OF 7**

JOB NO. 40401

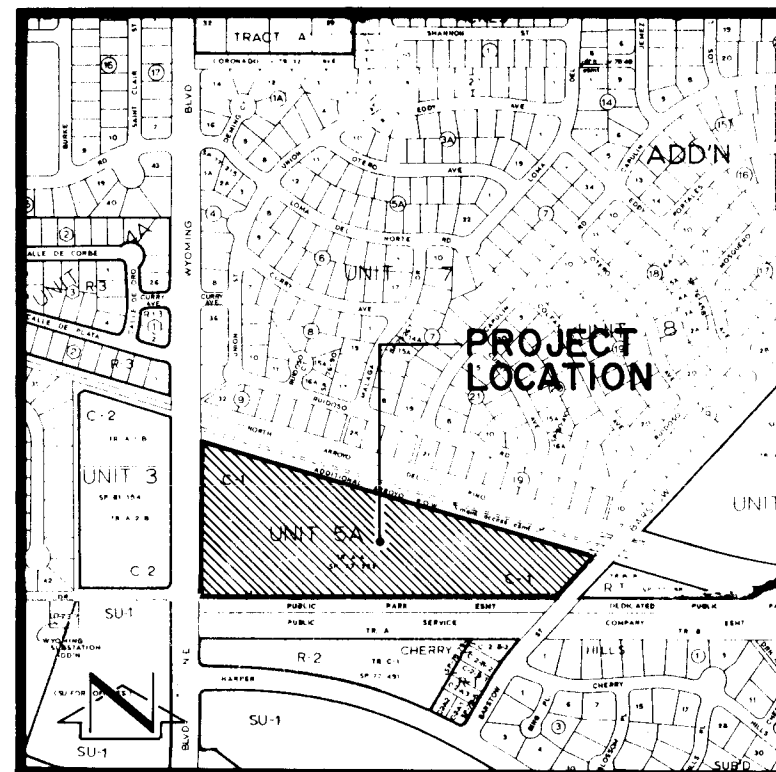

VICINITY MAP
SCALE: 1" = 800'

- LEGEND**
- 5410 EXISTING CONTOUR
 - 10 PROPOSED CONTOUR
 - EXISTING SPOT ELEVATION
 - PROPOSED SPOT ELEVATION
 - PROPOSED CONCRETE
 - PROPOSED RETAINING WALL




SCALE: 1" = 50'

PROJECT BENCHMARK:

THE STATION IS A STANDARD ACS BRASS TABLET, STAMPED "G-D19-1978", SET IN TOP OF A CONCRETE POST FLUSH WITH THE GROUND. THE STATION IS LOCATED 7.5 MILES NORTHEAST OF DOWNTOWN ALBUQUERQUE @ THE NORTHWEST CORNER OF THE INTERSECTION OF SAN ANTONIO DRIVE NE & WYOMING BLVD NE. ELEVATION: 5403.54 FEET (M.S.L.D.)

LEGAL DESCRIPTION:

TRACT A-A, UNIT 5-A, LOMA DEL NORTE

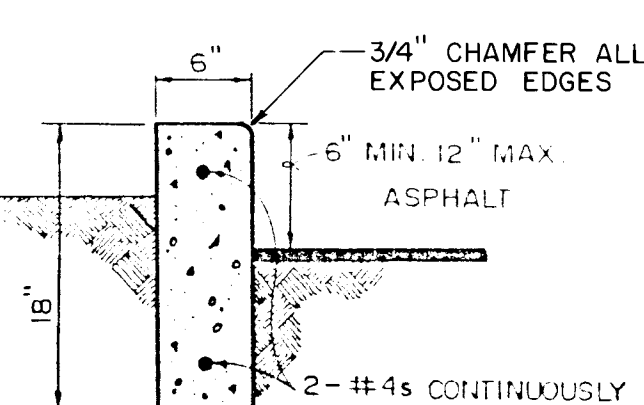

HEADER CURB DETAIL


SCALE: 1" = 1'-0"

CONSTRUCTION NOTES:

- TWO (2) WORKING DAYS PRIOR TO ANY EXCAVATION, CONTRACTOR MUST CONTACT LINE LOCATING SERVICE 765-1234, FOR LOCATION OF EXISTING UTILITIES.
- PRIOR TO CONSTRUCTION, THE CONTRACTOR SHALL EXCAVATE AND VERIFY THE HORIZONTAL AND VERTICAL LOCATION OF ALL POTENTIAL OBSTRUCTIONS. SHOULD A CONFLICT EXIST, THE CONTRACTOR SHALL NOTIFY THE ENGINEER SO THAT THE CONFLICT CAN BE RESOLVED WITH A MINIMUM AMOUNT OF DELAY.
- ALL WORK ON THIS PROJECT SHALL BE PERFORMED IN ACCORDANCE WITH APPLICABLE FEDERAL, STATE AND LOCAL LAWS, RULES AND REGULATIONS CONCERNING CONSTRUCTION SAFETY AND HEALTH.
- ALL CONSTRUCTION WITHIN PUBLIC RIGHT-OF-WAY SHALL BE PERFORMED IN ACCORDANCE WITH APPLICABLE CITY OF ALBUQUERQUE STANDARDS AND PROCEDURES.


EROSION CONTROL MEASURES

- THE CONTRACTOR SHALL ENSURE THAT NO SOIL ERODES FROM THE SITE INTO PUBLIC RIGHT-OF-WAY OR ONTO PRIVATE PROPERTY. THIS CAN BE ACHIEVED BY CONSTRUCTING TEMPORARY BERMS AT THE PROPERTY LINES AND WETTING THE SOIL TO KEEP IT FROM BLOWING.
- THE CONTRACTOR SHALL PROMPTLY CLEAN UP ANY MATERIAL EXCAVATED WITHIN THE PUBLIC RIGHT-OF-WAY SO THAT THE EXCAVATED MATERIAL IS NOT SUSCEPTIBLE TO BEING WASHED DOWN THE STREET.

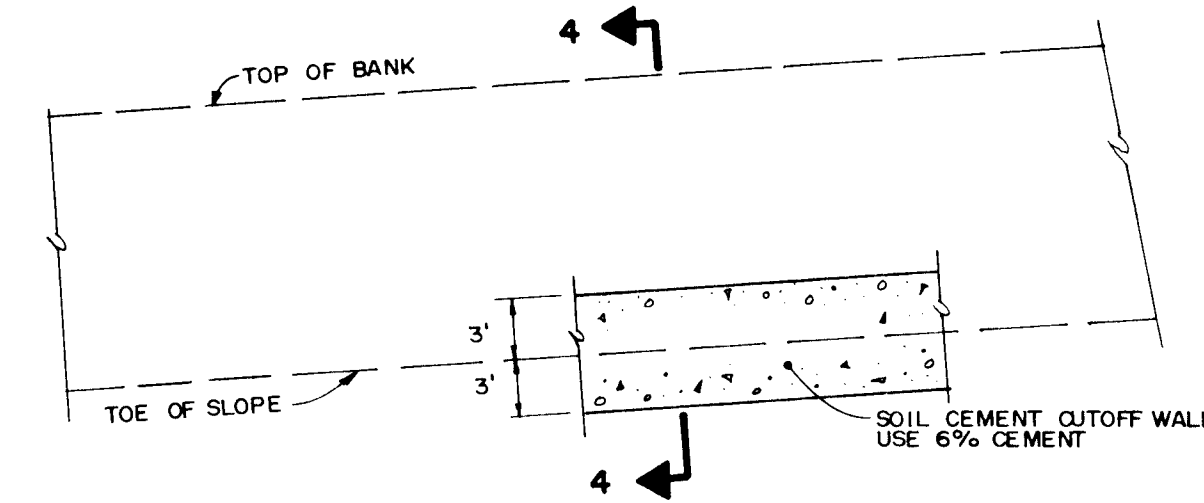


TYPICAL ELEVATION OF CUTOFF WALL

SCALE: 1" = 10'

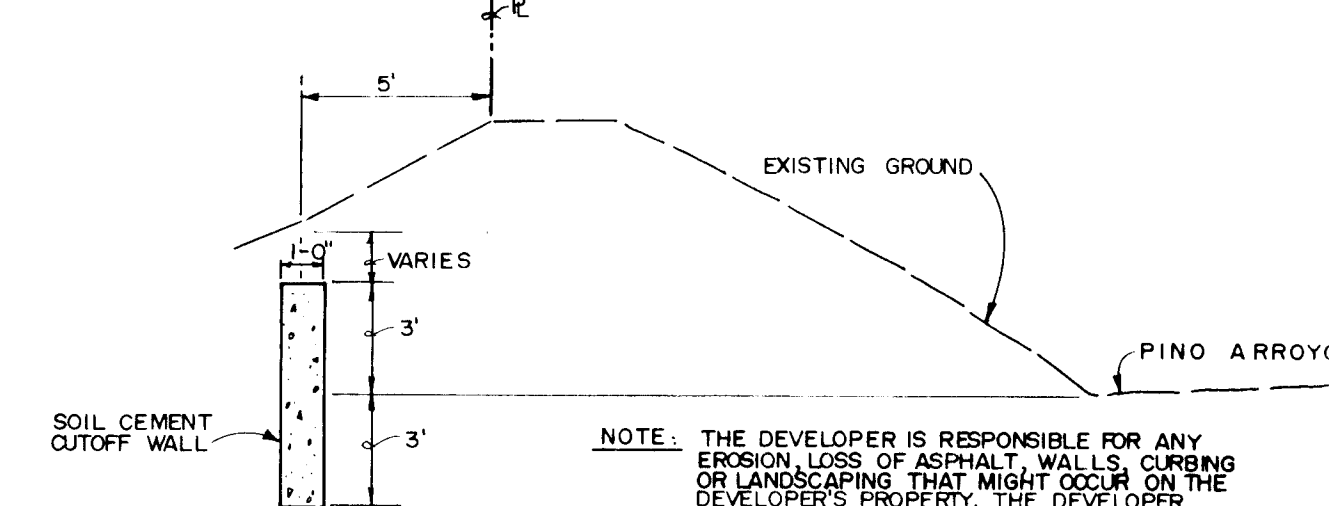


SECTION 4-4

SCALE: 1" = 5'

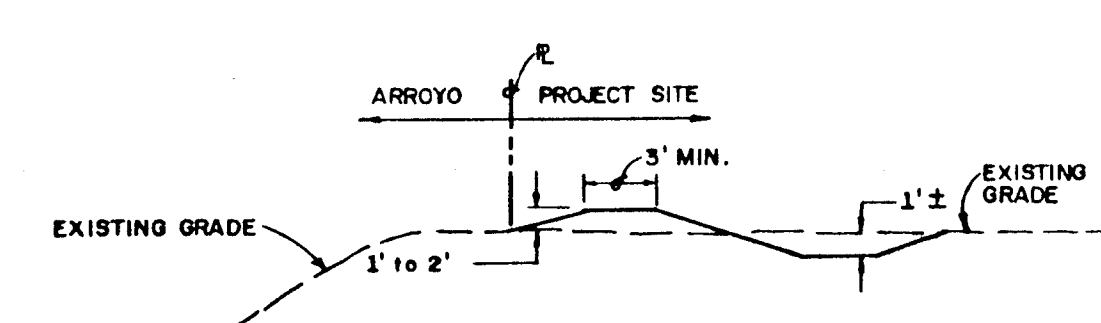



TEMPORARY EROSION CONTROL BERM SECTION

SCALE: 1" = 8'

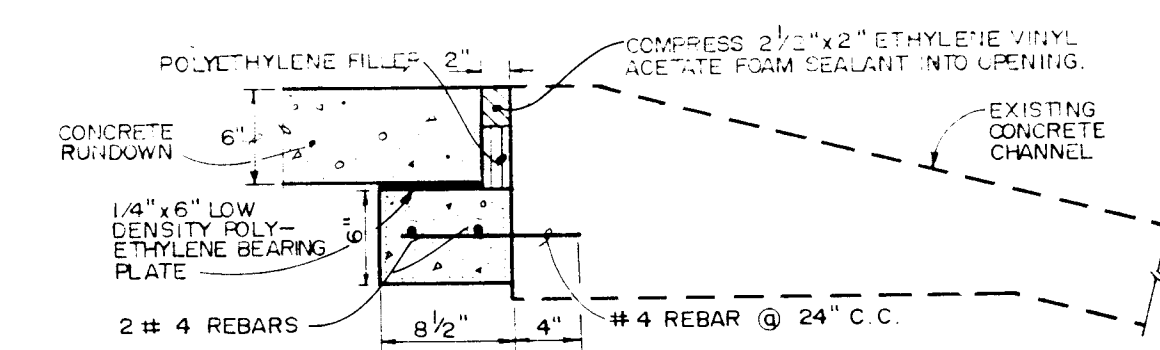


SECTION 5-5

SCALE: 1" = 1'

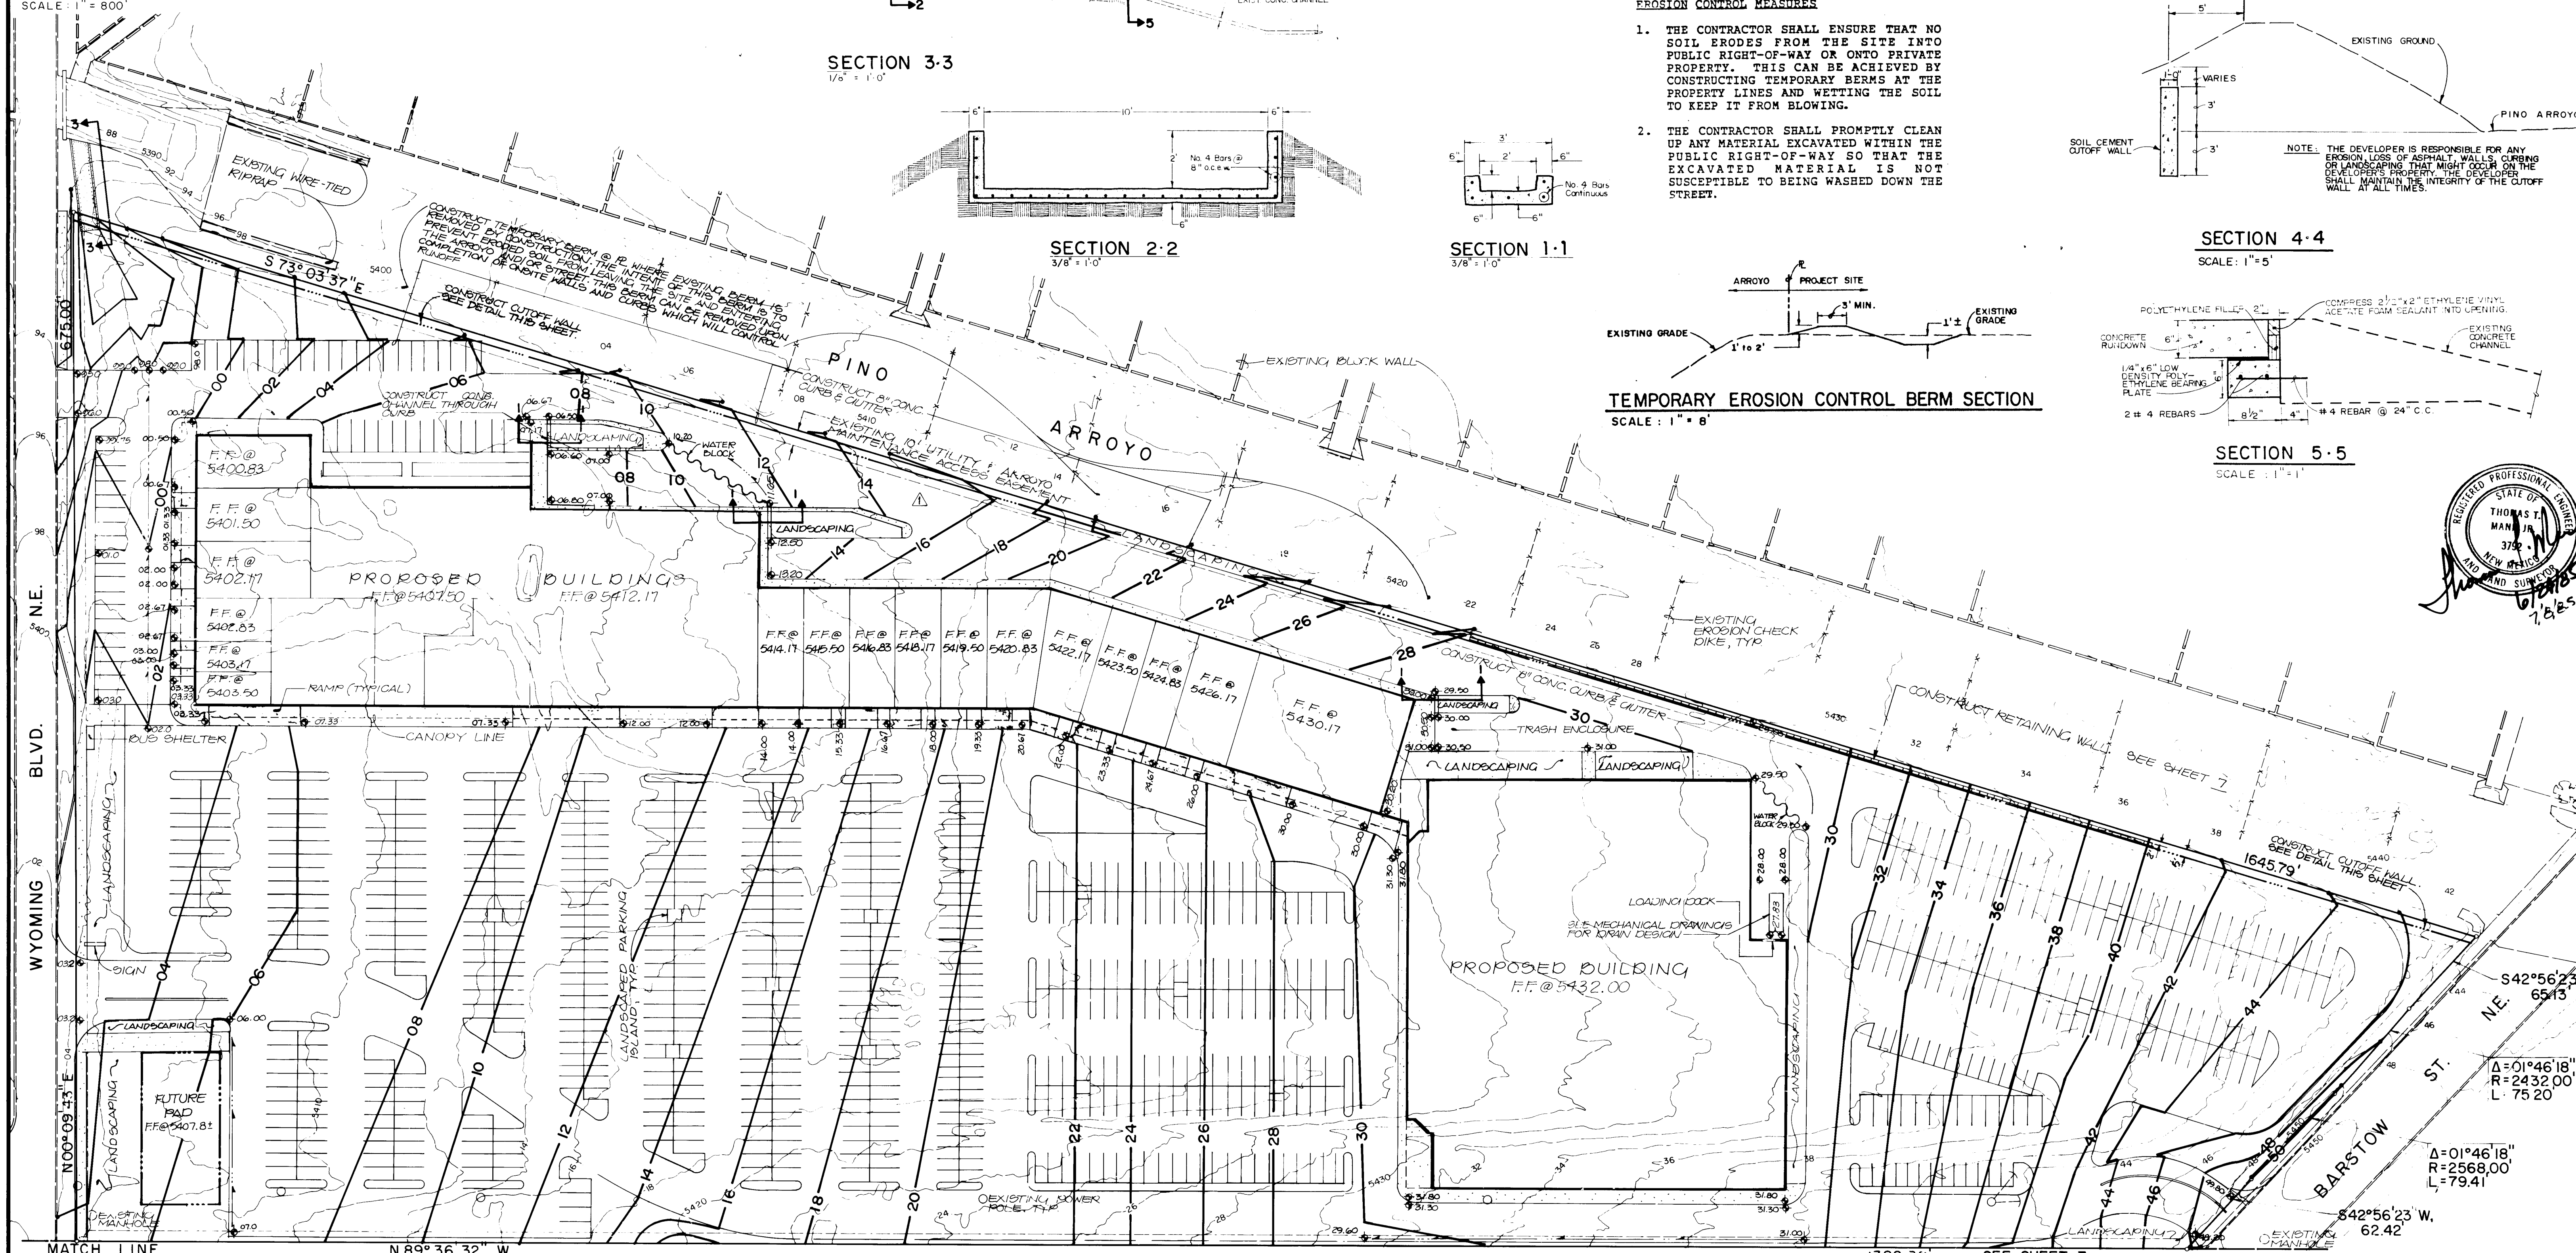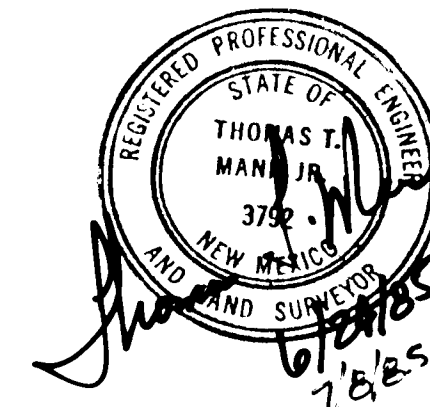

26 25590686

APPROVED FOR PRIVATE RUNDOWN ONLY					
APPROVALS	ENGINEER	DATE	APPROVALS	ENGINEER	DATE
A.C.E. - Design	W.C. Long	12/19/85	WUD	W.C. Long	12/21/85
MDD/ENG	W.C. Long	12/19/85	TRAN	D.A. Parks	12/16/85

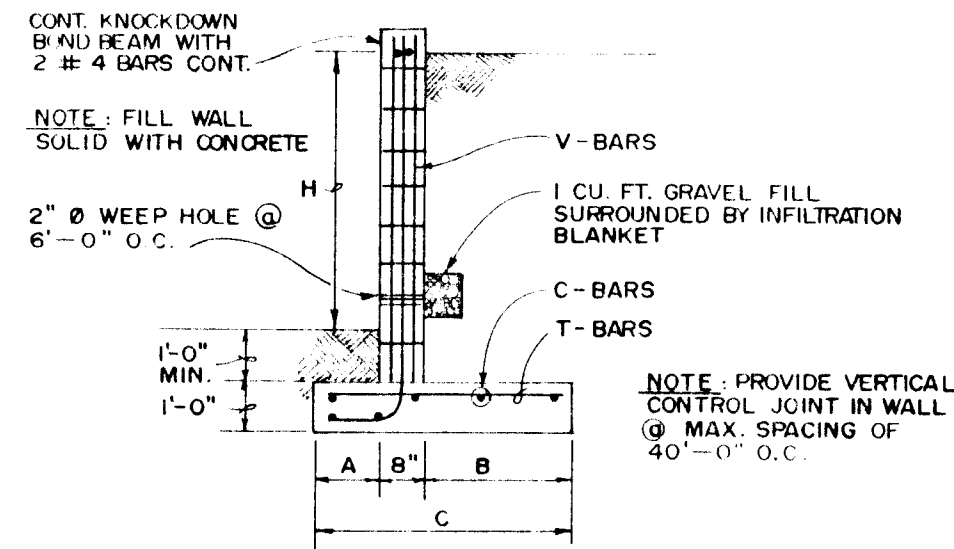

WALL	H DIMENSION	A	B	C	V-BAR	C-BARS	T-BARS
A	5'-0"	10"	2'-2"	3'-3"	#4 AT 16" O.C.	4-#4 CONT.	#4 AT 28" O.C.
B	4'-0"	8"	1'-8"	3'-0"	#4 AT 24" O.C.	4-#4 CONT.	#4 AT 32" O.C.
C	3'-0"	5"	1'-3"	2'-4"	#4 AT 32" O.C.	3-#4 CONT.	#4 AT 40" O.C.
D	0 TO 2'-0"	4"	4"	1'-4"	#4 AT 48" O.C.	2-#4 CONT.	#4 AT 48" O.C.

RETAINING WALL DETAIL
NO SCALE

VEGETATION FOR EROSION CONTROL

1. SEED RATE:

Species	Pure Live Seed (lbs/acre)*
Annual Rye Grass	8.0
Giant Dropseed	2.0
Sand Dropseed	1.0
Indian Ricegrass	4.0
Sideoats Grama	6.0
Total:	21.0

*Rates apply to drilled seed.
Double rates listed if seed is
broadcast.

2. SEED APPLICATION:

a. Flat areas - cultivate area to
produce an acceptable, friable seed
bed, then drill seed to a depth of
1/4 to 1/2 inches.

b. Slopes 3:1 or greater - hand
broadcast and cultivate into top 1/4
to 1/2 inch of soil.

3. FERTILIZER

16-20-0 @ 200 lbs. per acre applied
simultaneously with seed.

4. MULCH

5,000 lbs. hay mulch per acre. Hay
mulch shall be crimped into the soil
so as not to exceed 2 inches in
depth.

5. WATERING SCHEDULE

CONTRACTOR shall maintain a wet seed
bed for a period of at least 6 weeks
following seeding.

DRAINAGE PLAN

The following items concerning the Harper and Wyoming Neighborhood Commercial Center
Drainage Plan are contained hereon:

1. Vicinity Map
2. Grading Plan
3. Calculations

The proposed improvements, as shown by the Vicinity Map, are located between Wyoming
Boulevard N.E. and Barstow N.E., and north of Harper N.E. and the PNM right-of-way.
At present, the site is undeveloped.

As shown by Plate D-19 of the Albuquerque Master Drainage Study, this site does not
lie within a designated Flood Hazard Zone. Further study reveals that the site is
bordered on the north by the Pino Arroyo. The project site is higher than the
arroyo, and, therefore, flood waters are contained within the arroyo right-of-way.
Barstow N.E. lies to the east of the property. The project site is lower than
Barstow N.E., however, there is very little flow in Barstow adjacent to the site.
The PNM easement lies south of the site. The easement is higher than the project
site. The easement essentially traverses a ridge line, therefore, flows from the
south are at a minimum. Wyoming Boulevard N.E. lies to the west of the site. The
project site is higher than Wyoming Boulevard N.E. Offsite flows to the site are
minimal. Any offsite flows entering the site will be routed through the site to the
Pino Arroyo.

The Grading Plan shows 1) existing and proposed grades indicated by spot elevations
and contours at 1'-0" intervals, 2) continuity between existing and proposed
elevations, 3) the limit and character of existing improvements, and 4) the limit and
character of proposed improvements. As shown by this plan, the proposed improvements
consist of the construction of buildings and asphalt paving. A retaining wall will
be required along the north boundary at the east end of the project. The site will
be graded so that all flows converge to the northwest corner of the site. A ponding
area will be constructed to detain nuisance waters. All flows will be routed through
the pond and will then exit into the Pino Arroyo.

Both sides of the arroyo will be stabilized with soil cement. The depth of flow is
approximately 1.5'. A freeboard of 1.5' feet was added to the depth to give a
treatment depth of 3' above and below flow line. The soil cement will contain 6%
cement utilizing native soils.

The Calculations which appear hereon analyze both the existing and developed
conditions for the 100-year, 6-hour rainfall event. The Rational Method has been
used for this analysis in accordance with the City of Albuquerque Development Process
Manual, Volume II. As shown by these calculations, the proposed improvements will
result in an increase in runoff from the site. This pattern of runoff is consistent
with the conceptual drainage plan.

CALCULATIONS

Ground Cover Information

From SCS Bernalillo County Soil Survey, Plate 21:
Etc - Embudo Tijeras
Hydrologic Soil Group B

Rational Method

Discharge: $Q = CiA$
where C varies
 $i = P(6.44)^{-0.51} = 5.28 \text{ in/hr}$
 $P_6 = 2.5 \text{ in (DPM Plate 22.2 D-1)}$
 $P_6 = 10 \text{ min (minimum)}$
 $A = \text{area, acres}$

Volume: $V = CP_6A(1/12)$
where C varies
 $P_6 = 2.5 \text{ in (DPM Plate 22.2 D-1)}$
 $A = \text{area, sf}$

Existing Condition

$A_{\text{total}} = 674,352 \text{ sf} = 15.5 \text{ Ac}$
 $A_{\text{imp}} = 0 \text{ sf}; \% \text{ impervious} = 0$
 $C_{\text{imp}} = 0.34 \text{ (DPM Plate 22.2 C-1)}$
 $Q_{100} = CiA = 0.34(5.28)(15.5) = 27.8 \text{ cfs}$
 $V_{100} = CP_6A = 0.34(2.5/12)(674,356) = 47,767 \text{ cf}$

Developed Condition

$A_{\text{total}} = 674,352 \text{ sf} = 15.5 \text{ Ac}$
 $A_{\text{imp}} = 424,840 \text{ sf}; \% \text{ impervious} = 93\%$
 $C_{\text{imp}} = 0.89 \text{ (DPM Plate 22.2 C-1)}$
 $Q_{100} = CiA = 0.89(5.28)(15.5) = 72.8 \text{ cfs}$
 $V_{100} = CP_6A = 0.89(2.5/12)(674,356) = 125,036 \text{ cf}$

Comparison

$Q_{100} = 72.8 - 27.8 = 45.0 \text{ cf (increase)}$
 $V_{100} = 125,036 - 47,767 = 77,269 \text{ (increase)}$

Weir Capacity

$Q = 3.33 L H^{3/2}$
 $Q = 3.33(10)(2)^{3/2} = 94.3 \text{ cfs}$

PINO CALCULATIONS


$Q = 900 \text{ cfs}$
 $Q = 1.49/0.026 AR^{2/3} s^{1/2}$
 $s^{1/2} = (0.030)^{1/2} = 0.17$
 $A = 1.3(65+71/2) = 88 \text{ sf}$
 $R^{2/3} = (88/71)^{2/3} = 1.15$
 $Q = 1.49/0.026(88)(1.15)(0.17) = 986 \text{ cfs}$
 $d = 1.3 \text{ ft.}$

NOTES:

1. UNDERLYING OWNER OF PNM EASEMENT
IS OWNER OF TRACT 5-A.
2. GRADING ON TRACT IS WITH THE
WRITTEN CONSENT OF THE OWNER OF
TRACT

NOT A PART OF WORK
ORDER. FOR INFORMATION
ONLY.

26 25590786

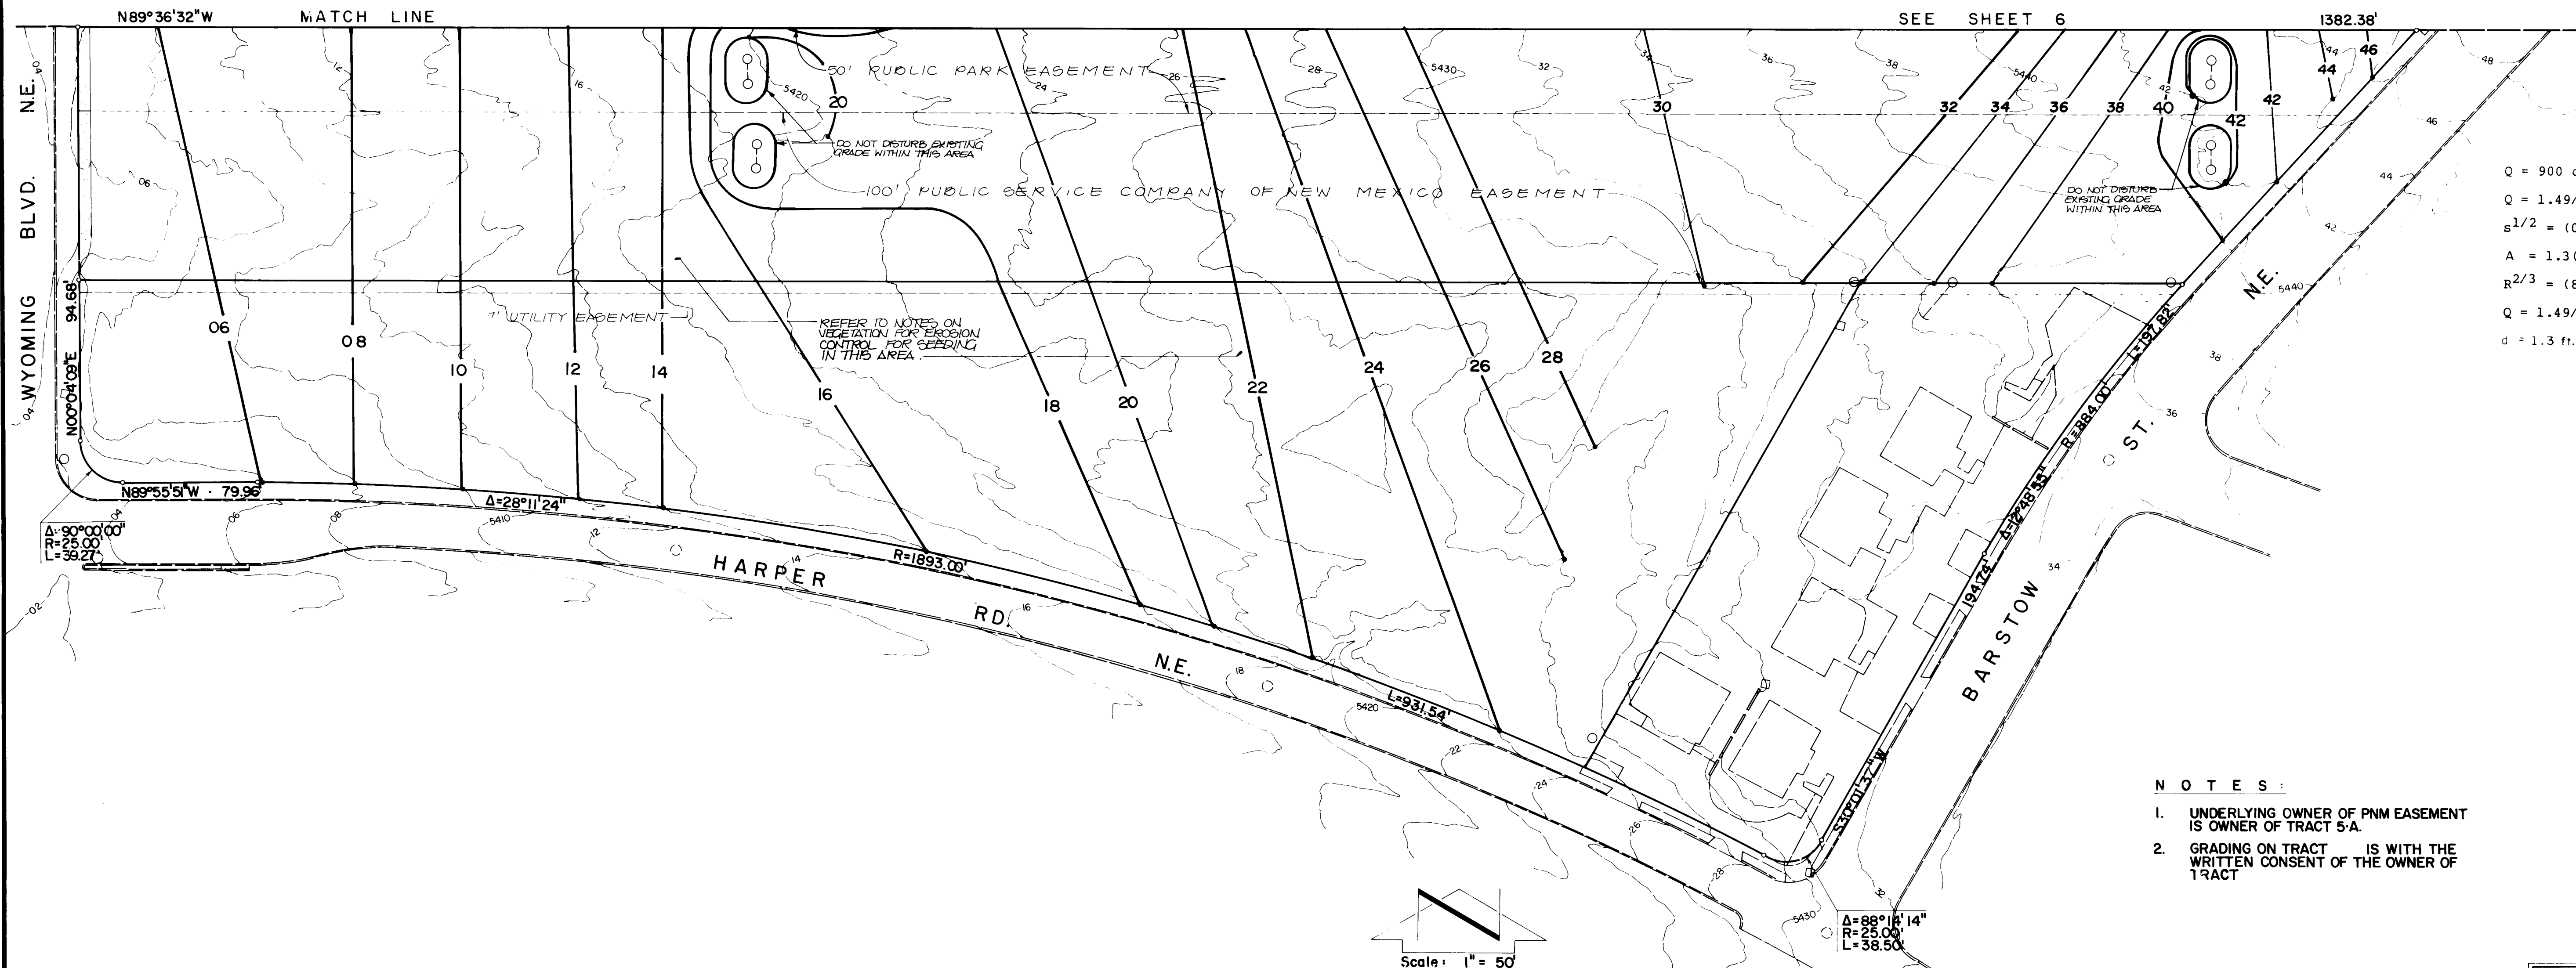

811 DALLAS N.E. • ALBUQUERQUE • NEW MEXICO • 87110
ENGINEERS

NO.	DATE	BY	REVISIONS

DESIGNED BY: TTM
DRAWN BY: LBD
APPROVED: TTM

JOB NO.
40401
DATE
01/85

GRADING & DRAINAGE PLAN

WYOMING & HARPER NEIGHBORHOOD SHOPPING CENTER

FILE NO.

SHEET 7 OF 7