

NORTH FOUR HILLS
A SUBDIVISION IN THE CITY OF ALBUQUERQUE

PREPARED FOR
M J B JOINT VENTURE


INDEX	
COVER SHEET	1
PLAT	2
DRAINAGE & GRADING PLAN	3
MASTER PAVING PLAN	4
PAVING PLANS & PROFILES	5-9
RUNDOWN PLANS & PROFILES	10
MASTER WATER & SEWER PLAN	11
WATER & SEWER PLANS & PROFILES	12-17
TYPICAL STREET SECTIONS	18
DRAINAGE CHANNEL & CULVERT	19
DETAILS	20-22
TRAFFIC CONTROL PLAN	22A

APPROVAL OF AS BUILT DRAWINGS
CHIEF CONSTRUCTION ENGINEER
Mark Goodwin
DATE 7-18-89

RECORD DRAWING

The improvements shown on this drawing have been as-built in accordance with field information provided by D. Mark Goodwin and Associates, PA, and by MJB Construction Company (Contractor) to reflect construction actually accomplished to the best of my knowledge and belief.

Mark Goodwin 6/26/89
Mark Goodwin, P.E. 8948 Date

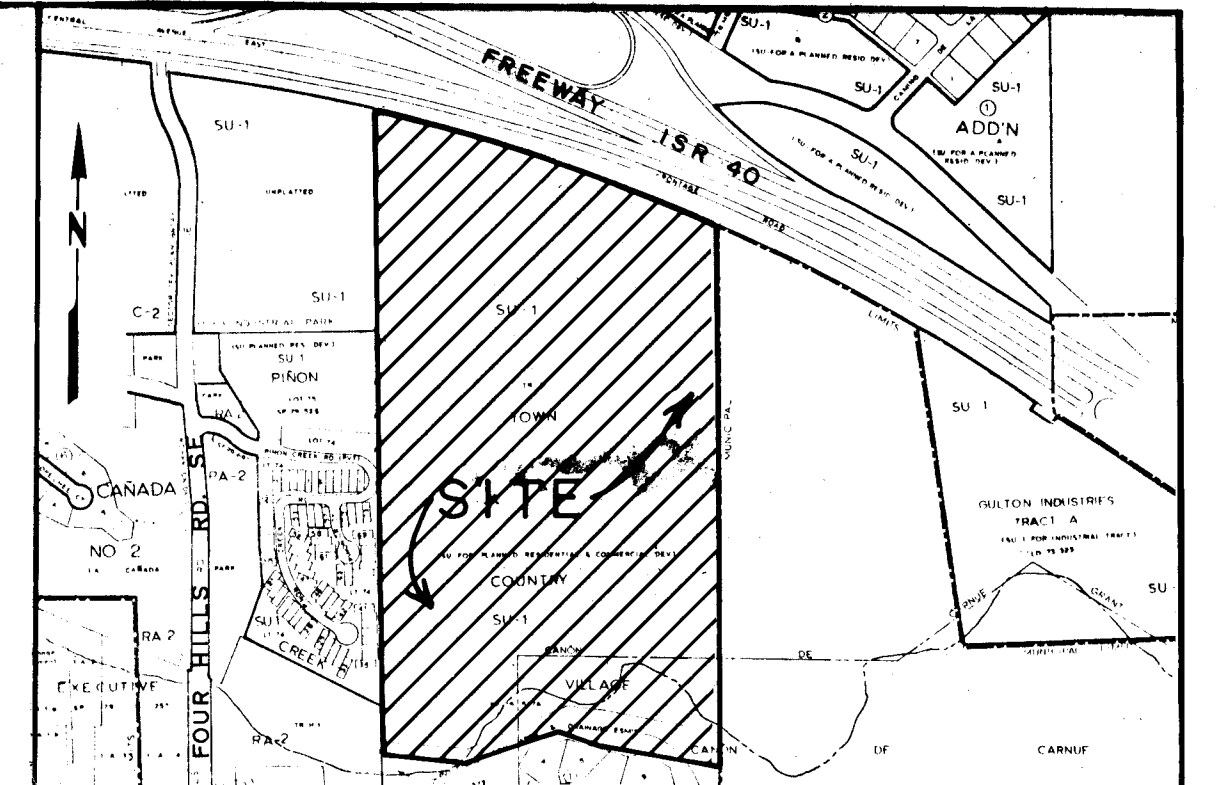

L-23 VICINITY MAP SCALE 1"=800'

GENERAL NOTES

- ALL WORK DETAILED ON THESE PLANS TO BE PERFORMED UNDER CONTRACT SHALL BE CONSTRUCTED IN ACCORDANCE WITH CITY OF ALBUQUERQUE INTERIM STANDARD SPECIFICATIONS PUBLIC WORKS CONSTRUCTION 1985.
- ALL CONSTRUCTION TO BE BASED ON RECOMMENDATIONS IN THE SOILS REPORT.
- WATER AND SEWER LINES SHALL BE INSTALLED PRIOR TO PAVING.
- ALL STATIONING IS FROM CENTER LINE OF ROAD EXCEPT WHERE NOTED OTHERWISE.
- TWO (2) WORKING DAYS PRIOR TO ANY EXCAVATION, CONTRACTOR MUST CONTACT LINE LOCATING SERVICES, 765-1234, FOR LOCATION OF EXISTING UTILITIES.
- PRIOR TO CONSTRUCTION, THE CONTRACTOR SHALL EXCAVATE AND VERIFY THE HORIZONTAL AND VERTICAL LOCATIONS OF ALL OBSTRUCTIONS. SHOULD A CONFLICT EXIST, THE CONTRACTOR SHALL NOTIFY THE ENGINEER OR SURVEYOR SO THAT THE CONFLICT CAN BE RESOLVED WITH MINIMUM AMOUNT OF DELAY.
- A REVISED DRAINAGE AND GRADING PLAN WAS REQUIRED AFTER ROUGH GRADING IN NOVEMBER 1984. THE STREET DESIGN WAS PREPARED PRIOR TO ROUGH GRADING, THEREFORE EXISTING TOPOGRAPHY ON THE STREET PLANS IS DIFFERENT THAN THAT SHOWN ON THE DRAINAGE AND GRADING PLAN.
- ALL WORK SHALL BE INSTALLED BY QUALIFIED PERSONNEL IN AN APPROVED STANDARD OF PRACTICE.
- THE COST OF ADDITIONAL DESIGN WORK DUE TO ERRORS AND OMISSIONS IN CONSTRUCTION SHALL BE BORNE BY THE CONTRACTOR.
- VERIFY ALL DIMENSIONS AND CONDITIONS PRIOR TO STARTING WORK. NOTIFY THE ENGINEER OF ANY DISCREPANCIES OR INCONSISTENCIES.
- VERIFY IN FIELD ALL EXISTING CONDITIONS SHOWN ON DRAWINGS.
- ALL UTILITIES SHOWN AND ANY OTHER UTILITIES THAT ARE NOT SHOWN ON THE PLANS BUT ARE WITHIN THE CONSTRUCTION AREA SHALL BE LOCATED, IDENTIFIED AND PROTECTED AT ALL TIMES DURING CONSTRUCTION BY THE CONTRACTOR.
- ALL WORK SHALL MEET ALL APPLICABLE CODES, INCLUDING UBC, 1982 EDITION, NATIONAL ELECTRICAL CODE, UNIFORM PLUMBING CODE, UNIFORM MECHANICAL CODE, AND NATIONAL FIRE CODE.
- WHERE DRAWINGS DO NOT CONFORM WITH MINIMUM CODE REQUIREMENTS THE WORK SHALL BE INSTALLED IN ACCORD WITH CODES AT NO ADDITIONAL COST TO OWNER.
- THE TRAFFIC CONTROL PLAN (SHEET 22A) COMPLIES WITH THE "MANUAL ON UNIFORM TRAFFIC CONTROL DEVICES FOR STREETS & HIGHWAYS."


MISTLETOE CT., WATERLILY CT.,
AND POINSETTIA CT. ARE PRIVATE STREETS
AND ITEMS INCLUDED IN WORK ORDER
ARE WATER AND SANITARY SEWER ONLY
FOR THOSE STREETS

1 2 3 4 5 6 7 8 9 10 11 12
26 25 65 01 89

REV.	SHEETS	CITY ENGINEER	DATE	DATE	DATE

APPROVAL OF REVISIONS

ENGINEERS SEAL <i>Edward V. Diaz</i> 6/25/89	PREPARED BY <i>Resource Technology, Inc.</i> PROJECT NO. 2565	APPROVED FOR CONSTRUCTION <i>Mark Goodwin</i> 6/25/89 C.E. SHEET 1 OF 22
--	---	---

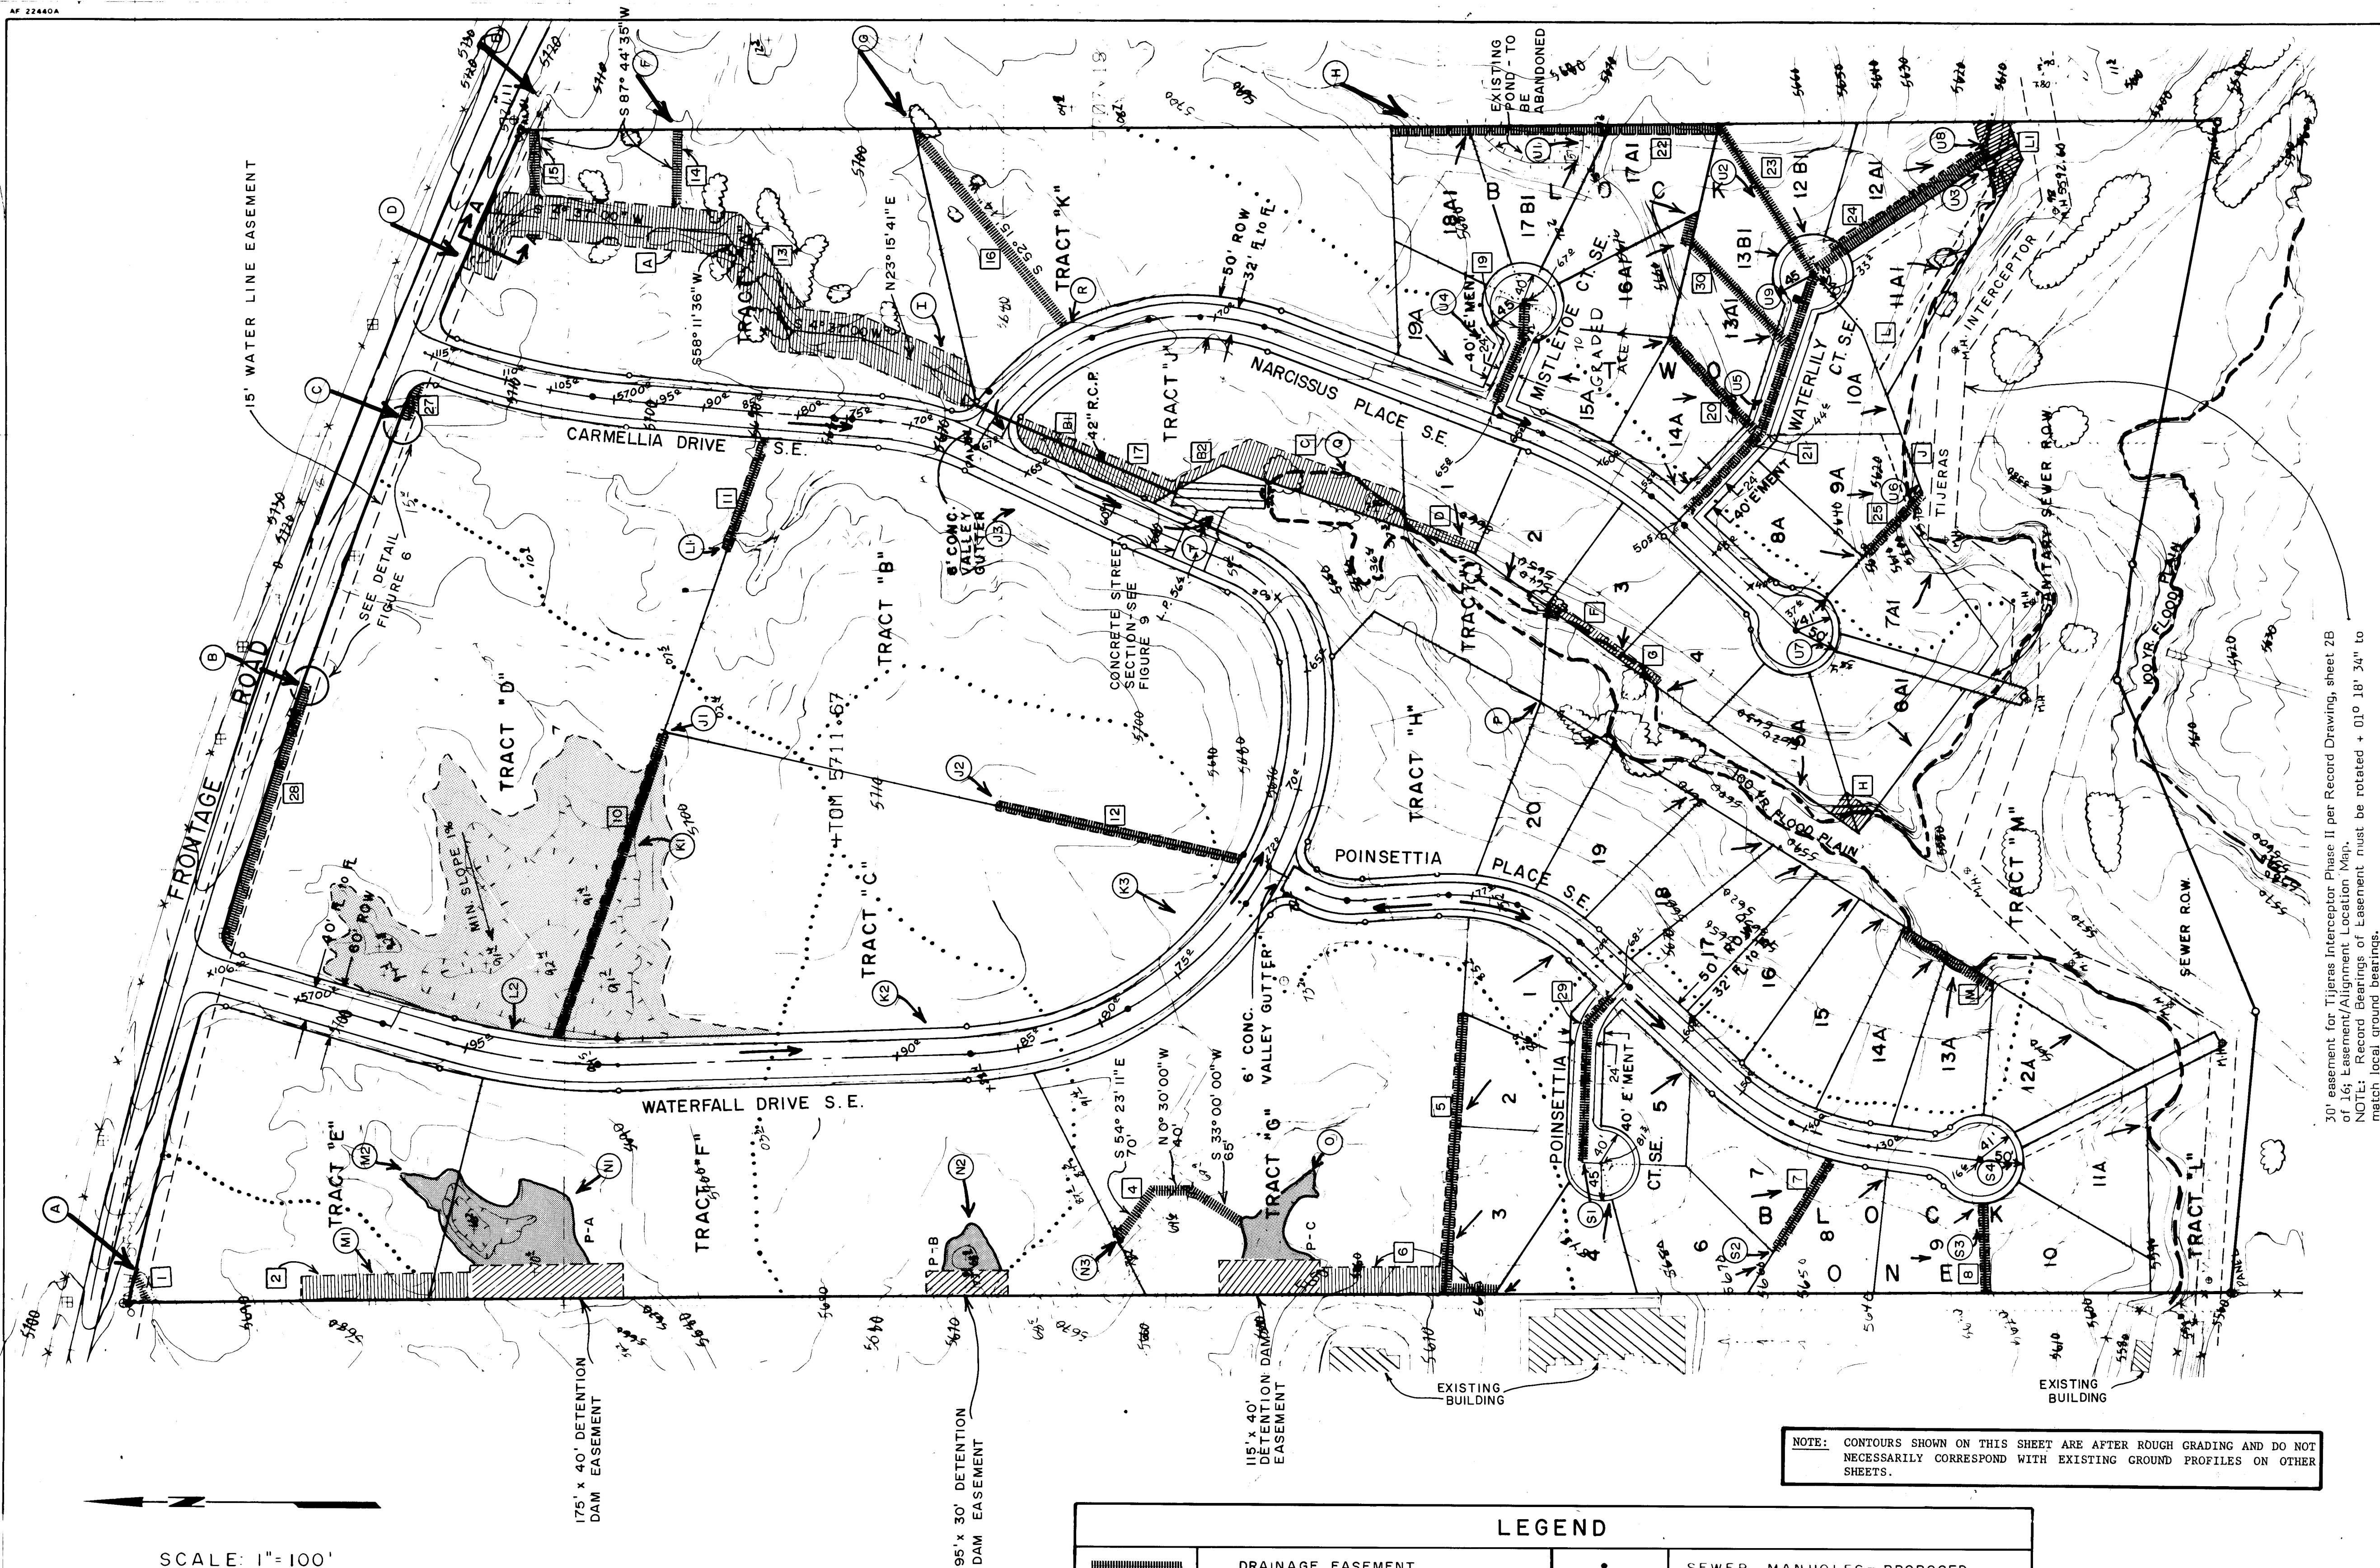

30' easement for Tijeras Interceptor Phase II per Record Drawing, sheet 2B of 16, Easement/Alignment Location Map.
NOTE: Record Bearings of Easement must be rotated + 01° 18' 34" to match local ground bearings.

NOTE: CONTOURS SHOWN ON THIS SHEET ARE AFTER ROUGH GRADING AND DO NOT NECESSARILY CORRESPOND WITH EXISTING GROUND PROFILES ON OTHER SHEETS.

LEGEND

	DRAINAGE EASEMENT		SEWER MANHOLES - PROPOSED
	DRAINAGE EASEMENT NO. SEE TABLE 4		DIRECTION OF STORM RUNOFF
	FLOOD PLAIN EASEMENT		EXISTING SEWER MANHOLE
	FLOOD PLAIN EASEMENT IDENTIFICATION SEE TABLE 1		DISCHARGE POINT IDENTIFICATION SEE TABLE 3
	PRE-DEVELOPED WATERSHED DIVIDE		100 YEAR FLOOD PLAIN
	DETENTION POND		
	FILL AREA FOR TRACTS "D" AND "C"		

NOTES

- ALL CUT AND FILL SLOPES ARE 3:1 V OR AS INDICATED WITH EROSION CONTROLS.
- FOR FLOOD PLAIN EASEMENT AND DRAINAGE EASEMENT DETAILS, SEE ACCOMPANYING REPORT.
- TEMPORARY CONSTRUCTION EASEMENTS OF 250' WIDTH ON CENTER LINE OF PUBLIC STREETS WILL BE PROVIDED.
- 7' UTILITY EASEMENTS WILL BE PROVIDED AROUND THE PROPERTY BOUNDARIES AND ALONG ALL PUBLIC AND PRIVATE STREET FRONTAGE.
- EASEMENT NUMBERS AND LETTERS ARE NON CONSECUTIVE.

AS BUILT INFORMATION	
CONTRACT NO.	AS BUILT
DATE	DATE
BY	BY
DATE	DATE
BY	BY
DATE	DATE
BY	BY
DATE	DATE

BENCH MARKS	
CONTROL: TOM, APPROX. 712' SOUTH OF 1/4 OF 1-40 FRONTAGE ROAD AND APPROX. 250' EAST OF 1/4 OF ROSEWOOD PLACE, S.E. AT APPROX. STA. 7+76 STANDARD A.C.S. BRASS CAP STAMPED "TOM".	EL. 5711.67'

SURVEY INFORMATION	
FIELD NOTES	DATE
NO.	BY

ENGINEER'S SEAL	
NO.	DATE
REMARKS	BY
DESIGN	DATE
DESIGNED BY EVD	DATE
DRAWN BY SD	DATE
CHECKED BY EVD	DATE

REVISION - JAN. 1985

20' SANITARY SEWER R.O.W.'S HAVE BEEN CHANGED TO 25' SANITARY SEWER & STORM DRAIN EASEMENTS


CITY OF ALBUQUERQUE
MUNICIPAL DEVELOPMENT DEPARTMENT
ENGINEERING DIVISION

TITLE: NORTH FOUR HILLS SUBDIVISION
DRAINAGE AND GRADING PLAN

APPROVALS	ENGINEER	DATE	APPROVALS	ENGINEER	DATE
City Engineer	<i>[Signature]</i>	2/12/87	Liquid Waste	N/A N/W	10/1/86
A.C.E. Design	<i>[Signature]</i>		Traffic	N/A D/H	10/1/86
Hydrology	N/A B.F.A.	2/12/87	Water	N/A N/W	10/1/86

DRAWING NO.	2565	MAP NO.	L-23	SHEET	3 OF 22
-------------	------	---------	------	-------	---------


1 2 3 4 5 6 7 8 9 10 11 12
26 25 65 03 89

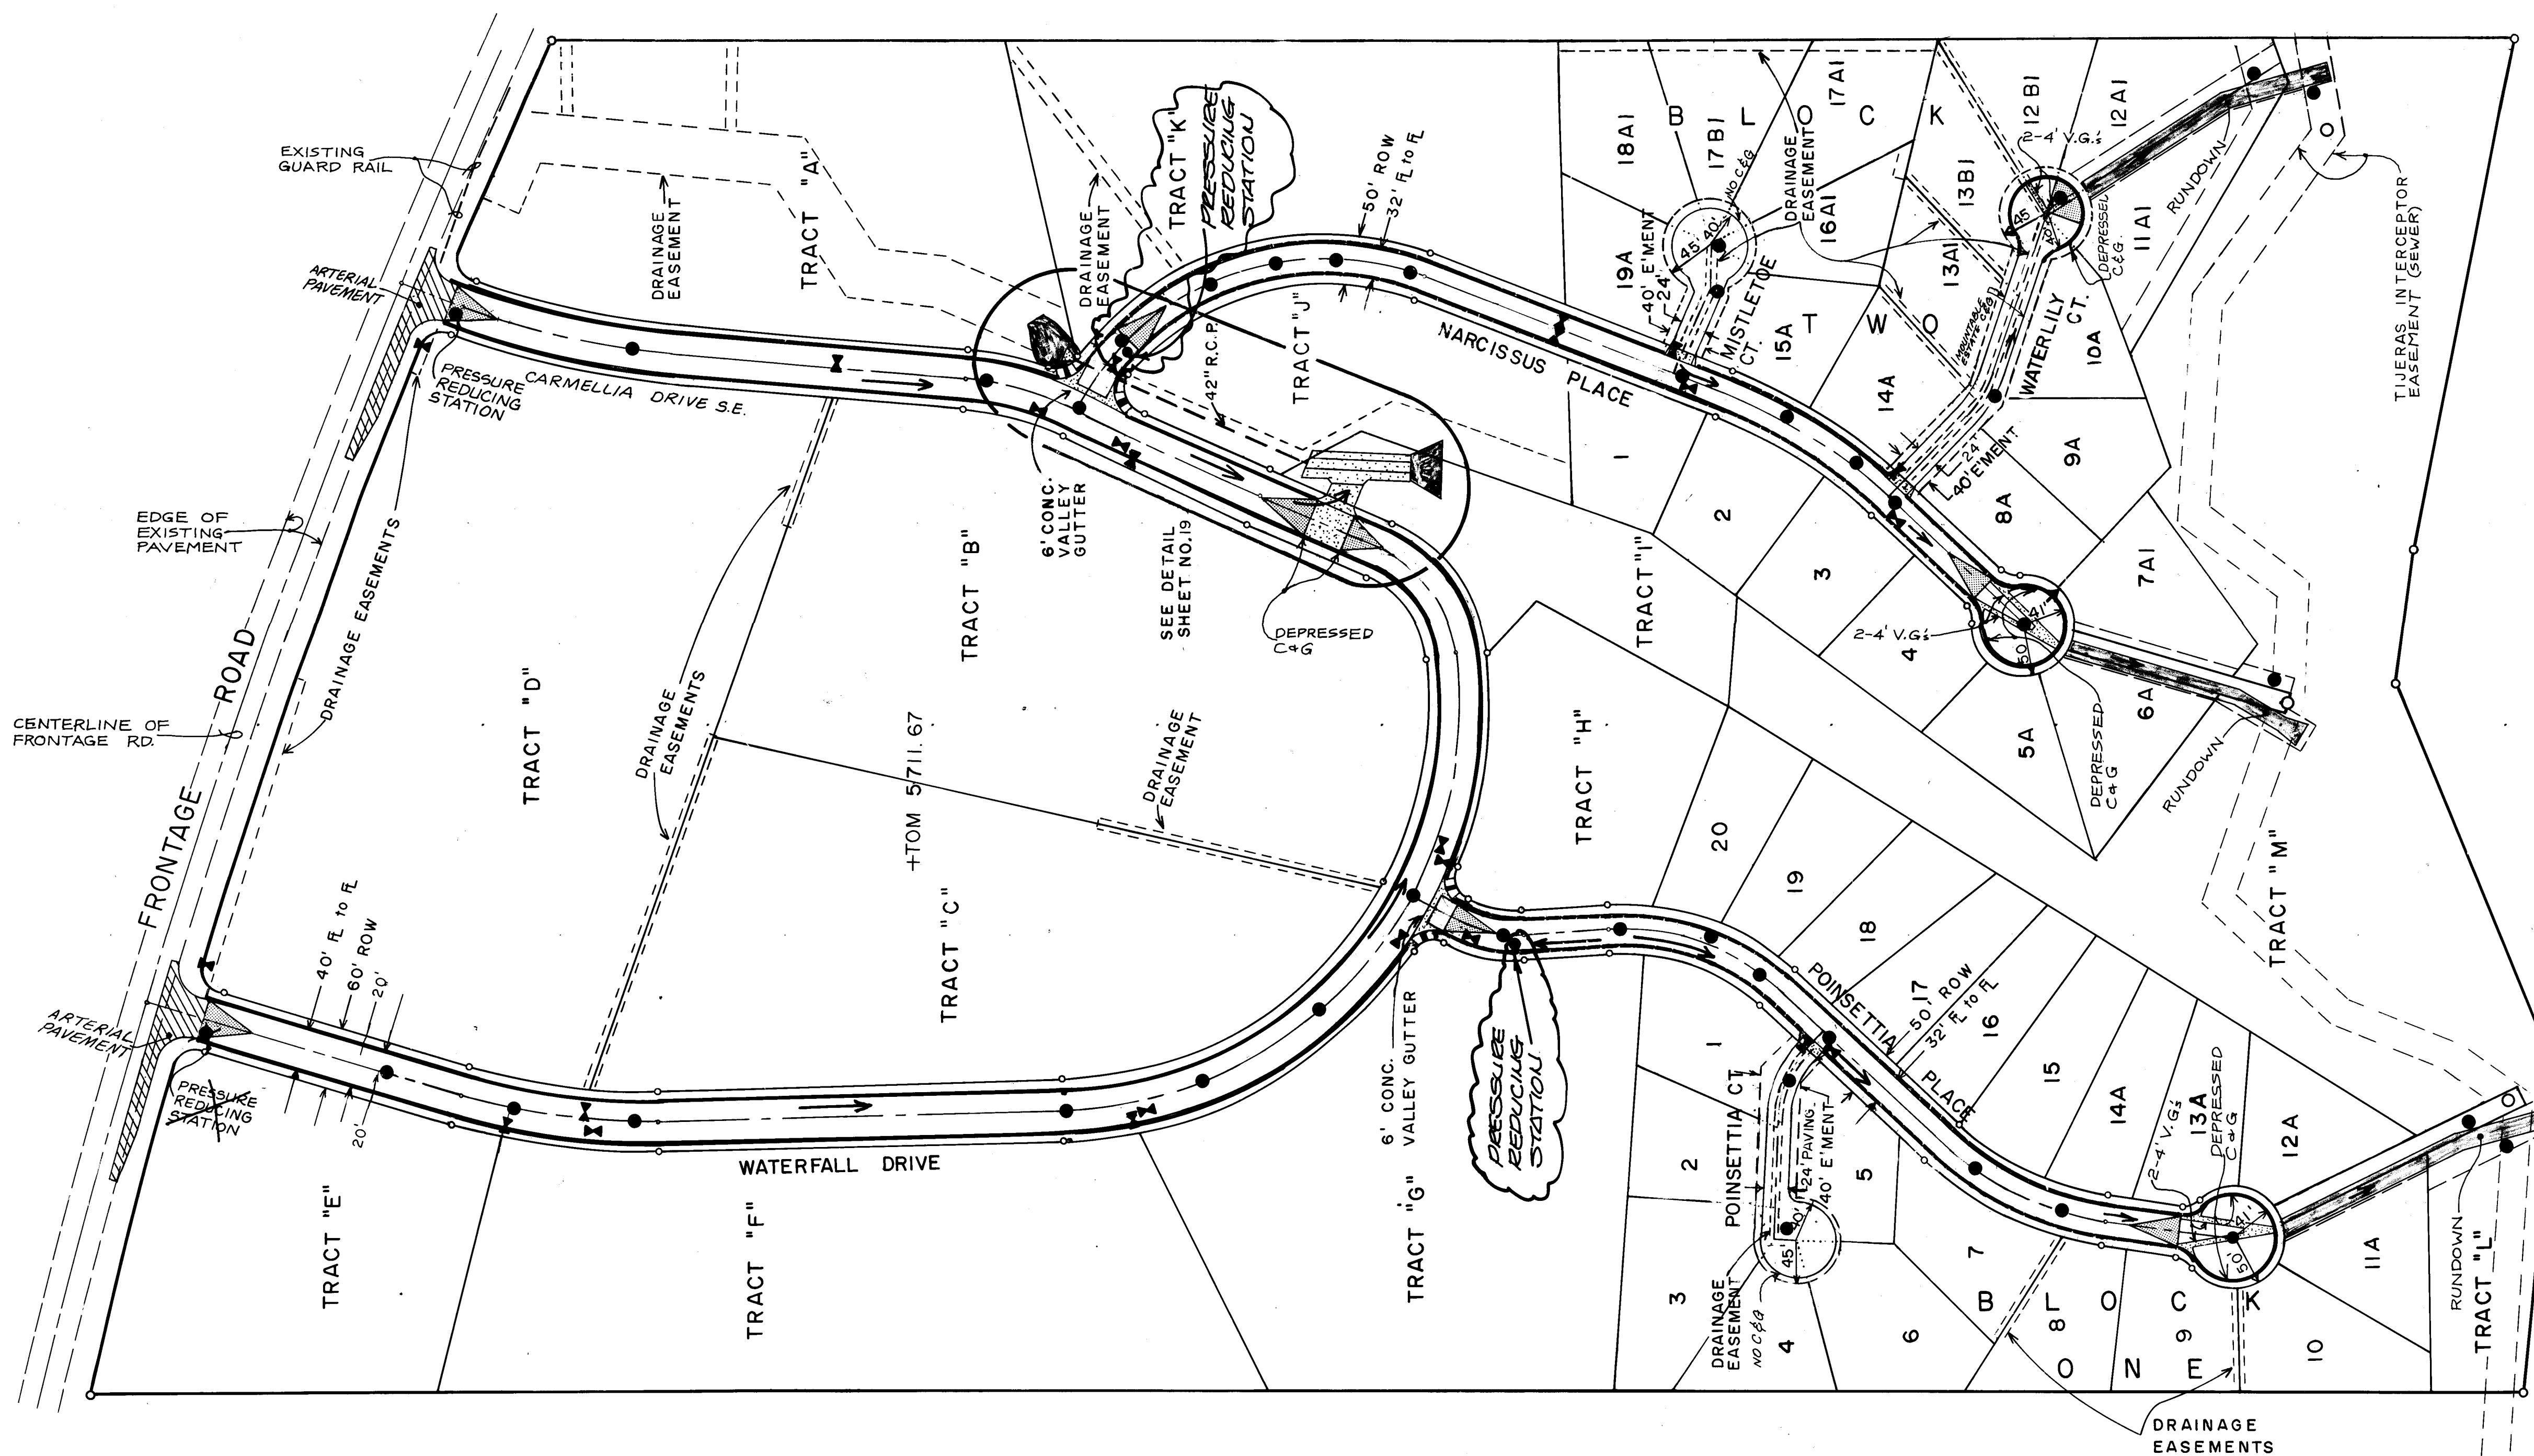

SCALE: 1"=100'

NOTE: FOR TYPICAL STREET
PAVING SECTIONS, REFER
TO DETAILS- SHEET NO. 18


LEGEND

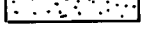-  ALL MANHOLES
 VALVE BOXES
 DIRECTION OF STORM RUNOFF
 EXISTING SEWER MANHOLE
 CONCRETE STRUCTURE
 RIP-RAP STRUCTURE
 STANDARD CURB & GUTTER AND DEPRESSED CURB & GUTTER
 CROWN TRANSITION AREA

1	2	3	4	5	6	7	8	9	10	11
2	6		2	5	6	5	0	4	8	9

The improvements shown on this drawing have been as-built in accordance with field information provided by D. Mark Goodwin and Associates, PA, and by MJB Construction Company (Contractor) to reflect construction actually accomplished to the best of my knowledge and belief.

Mark Goodwin 6/26/89
Mark Goodwin, P.E. 8948 Date

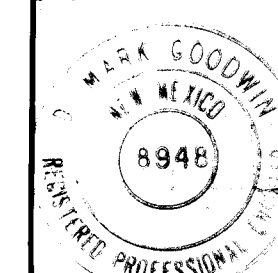

CITY OF ALBUQUERQUE
MUNICIPAL DEVELOPMENT DEPARTMENT
ENGINEERING DIVISION

**TITLE: NORTH FOUR HILLS SUBDIVISION
MASTER PAVING PLAN**

APPROVALS	ENGINEER	DATE	APPROVALS	ENGINEER	DATE
City Engineer	<i>[Signature]</i>	2/13/87	Liquid Waste	N/A w/w	10/1/86
A C E - Design	" "	"	Traffic	<i>[Signature]</i>	10/1/86
A C E - Hydrology	N.A. <i>[Signature]</i>	2/12/87	Water	N/A w/w	10/1/86


DRAWING NO.	2565	MAP NO.	L- 23	SHEET	OF	4	22
-------------	------	---------	-------	-------	----	---	----



RECORD DRAWING

SURVEY INFORMATION		FIELD NOTES	BENCH MARKS	AS BUILT	
NO.	BY			CONTRACTOR	DATE
		DATE: CONTROL: TOM, APPROX. 712' SOUTH OF C OF 1-40 FRONTAGE ROAD AND APPROX. 250' EAST OF C OF ROSEWOOD PLACE, S.E. AT APPROX. STA. 7+76 STANDARD A.C.S. BRASS CAP STAMPED "TOM".	WORK STAND BY: <i>Ties, Inc.</i>	DATE: <i>6/19</i>	CONTRACTOR: <i>MJB Const. Co.</i>
			FIELD ACCEPTANCE BY: <i>MBA</i>	DATE: <i>6/19</i>	
			DRAWINGS PREPARED BY: <i>MBA</i>		DATE: <i>6/19</i>
			CORRECTED BY: <i>MBA</i>		
			MICRO-FILM INFORMATION		DATE
			RECORDED BY		
			NO		
			FL 5711 671		

4/2/86
Eric V. Ding

[illegible]

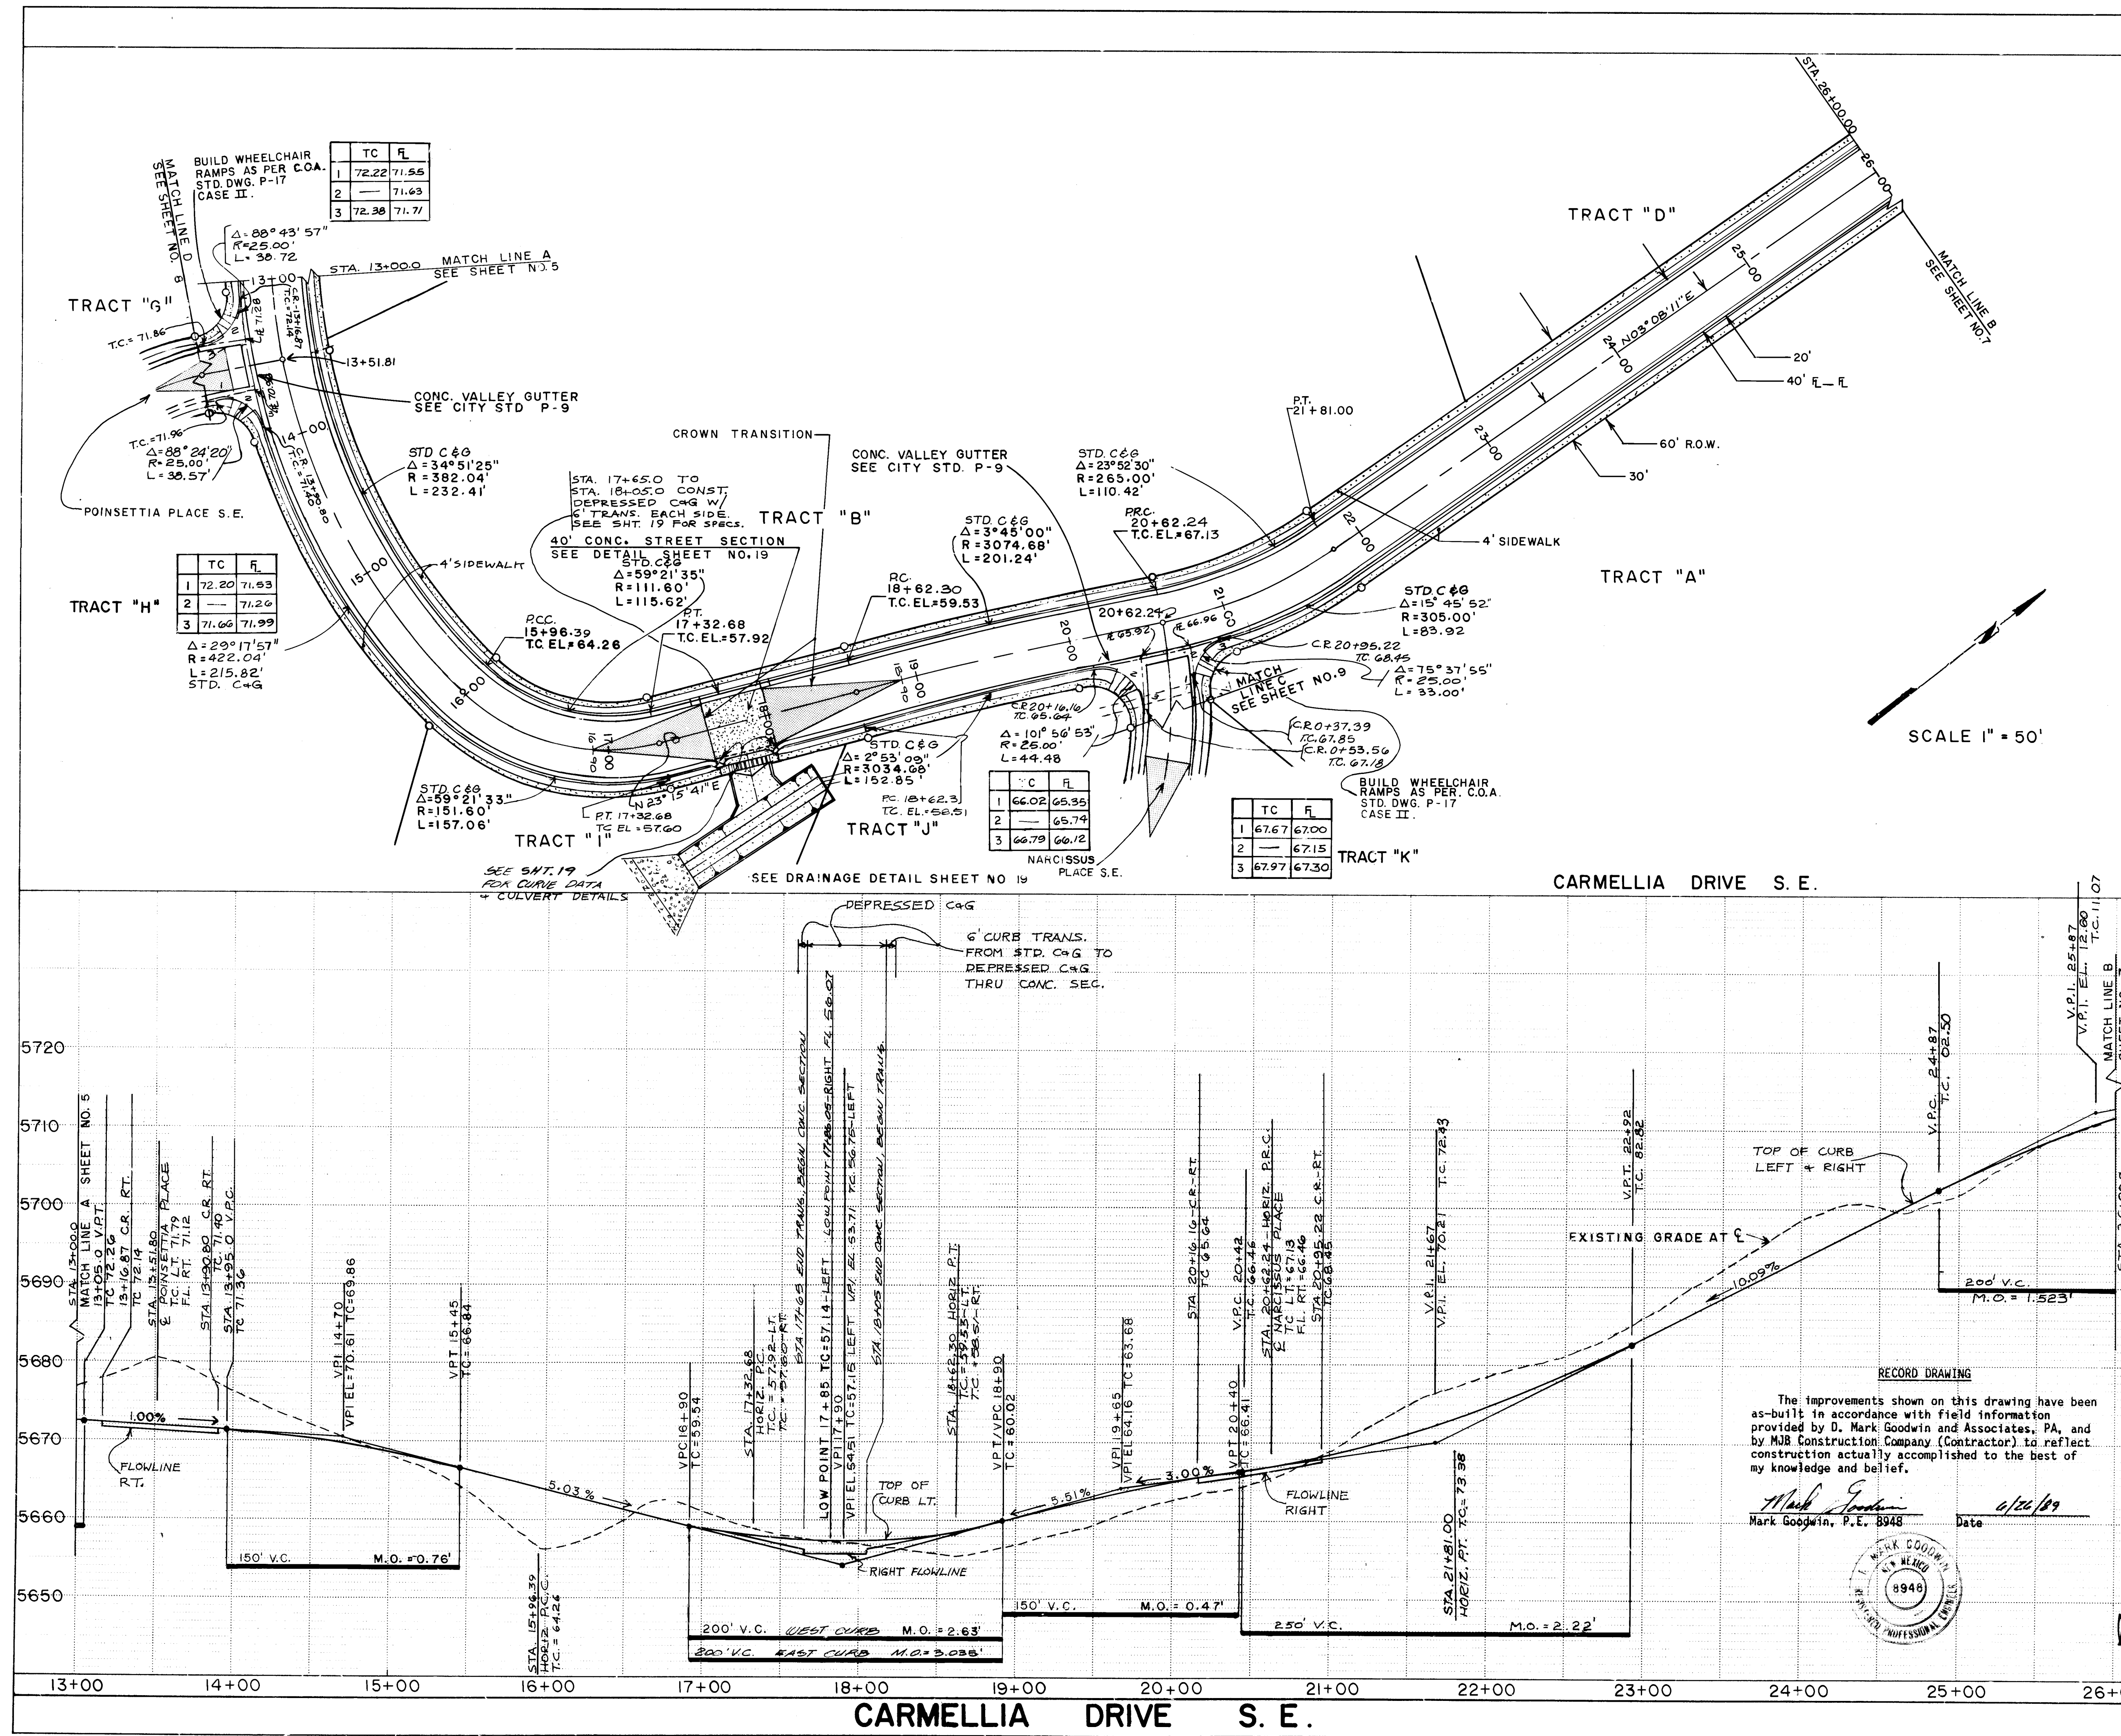

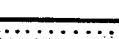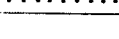LEGEND	
	TRANSITION AREA
	CATCH BASIN
	STORM DRAIN LINE
	PROPOSED STORM DRAIN MANHOLE
TC EL	TOP OF CURB ELEVATION

AS BUILT INFORMATION	
CONTRACTOR <i>NJB Const. Co.</i>	
DATE	<i>Tues, Dec. 6/1999</i>
DRAWN BY	<i>MSA</i>
IN-CHARGE BY	<i>MSA</i>
FIELD	
VERIFICATION BY	<i>MSA</i>
CHECKED BY	<i>MSA</i>
RECORDED BY	
DATE	<i>6/8/99</i>
NO	

CONTROL: TOM, APPROX. 712' SOUTH
OF E. OF I-40 FRONTAGE ROAD AND
APPROX. 250' EAST OF E. OF
ROSEWOOD PLACE, S.E. AT APPROX.
STA. 7+76. STANDARD A.C.S. BRASS
CAP STAMPED "TOM".

[illegible]

ENGINEER'S SEAL

Edwin V. Davis
9/22/86

[illegible]

The improvements shown on this drawing have been as-built in accordance with field information provided by D. Mark Goodwin and Associates, PA, and by MJB Construction Company (Contractor) to reflect construction actually accomplished to the best of my knowledge and belief.




Mark Goodwin 6/26/89
Mark Goodwin, P.E. 8948 Date

A circular library stamp from the Mark Goodwin Library in New Mexico. The text "MARK GOODWIN" is at the top, "NEW MEXICO" is in the middle, and "1948" is in the center. The words "LIBRARY" and "PROFESSIONAL COURSE" are partially visible at the bottom.

CITY OF ALBUQUERQUE
MUNICIPAL DEVELOPMENT DEPARTMENT
ENGINEERING DIVISION

TITLE: NORTH FOUR HILLS SUBDIVISION
CARMELLIA DRIVE
PAVING PLAN & PROFILE




APPROVALS	ENGINEER	DATE	APPROVALS	ENGINEER	DATE
City Engineer	<i>[Signature]</i>	2/12/86	Liquid Waste	N/A	N/A 10/1/86
A C E - Design	" "	" "	Traffic	<i>[Signature]</i>	1/4/86
ACE - Hydrology	<i>[Signature]</i>	2/2/87	Water	N/A	N/A 10/1/86

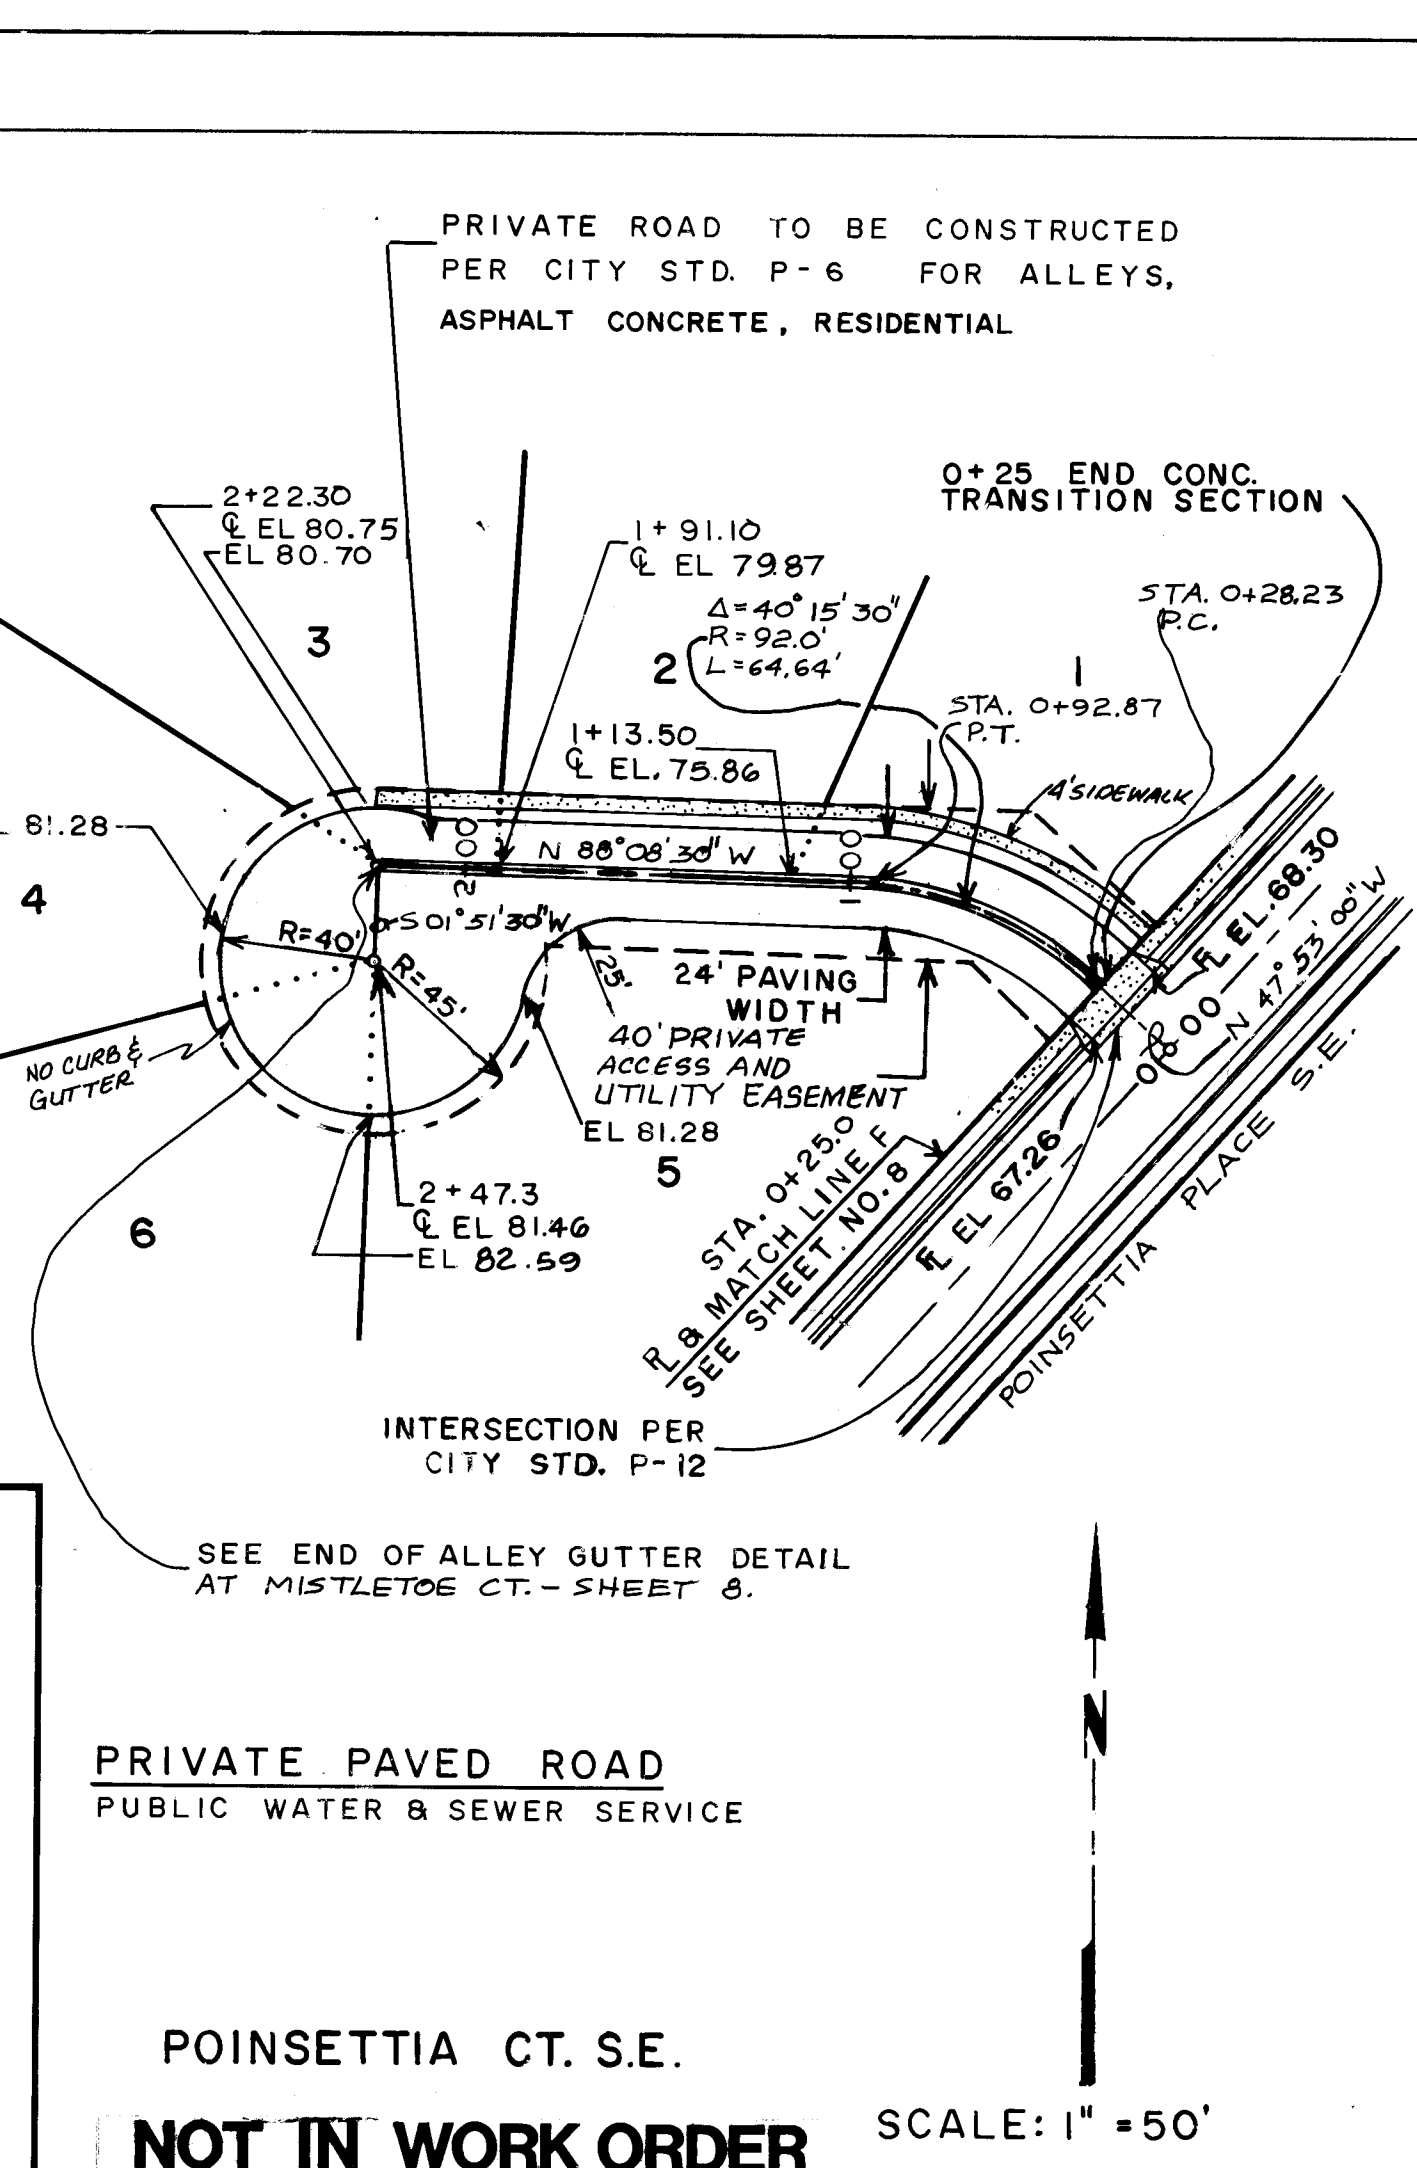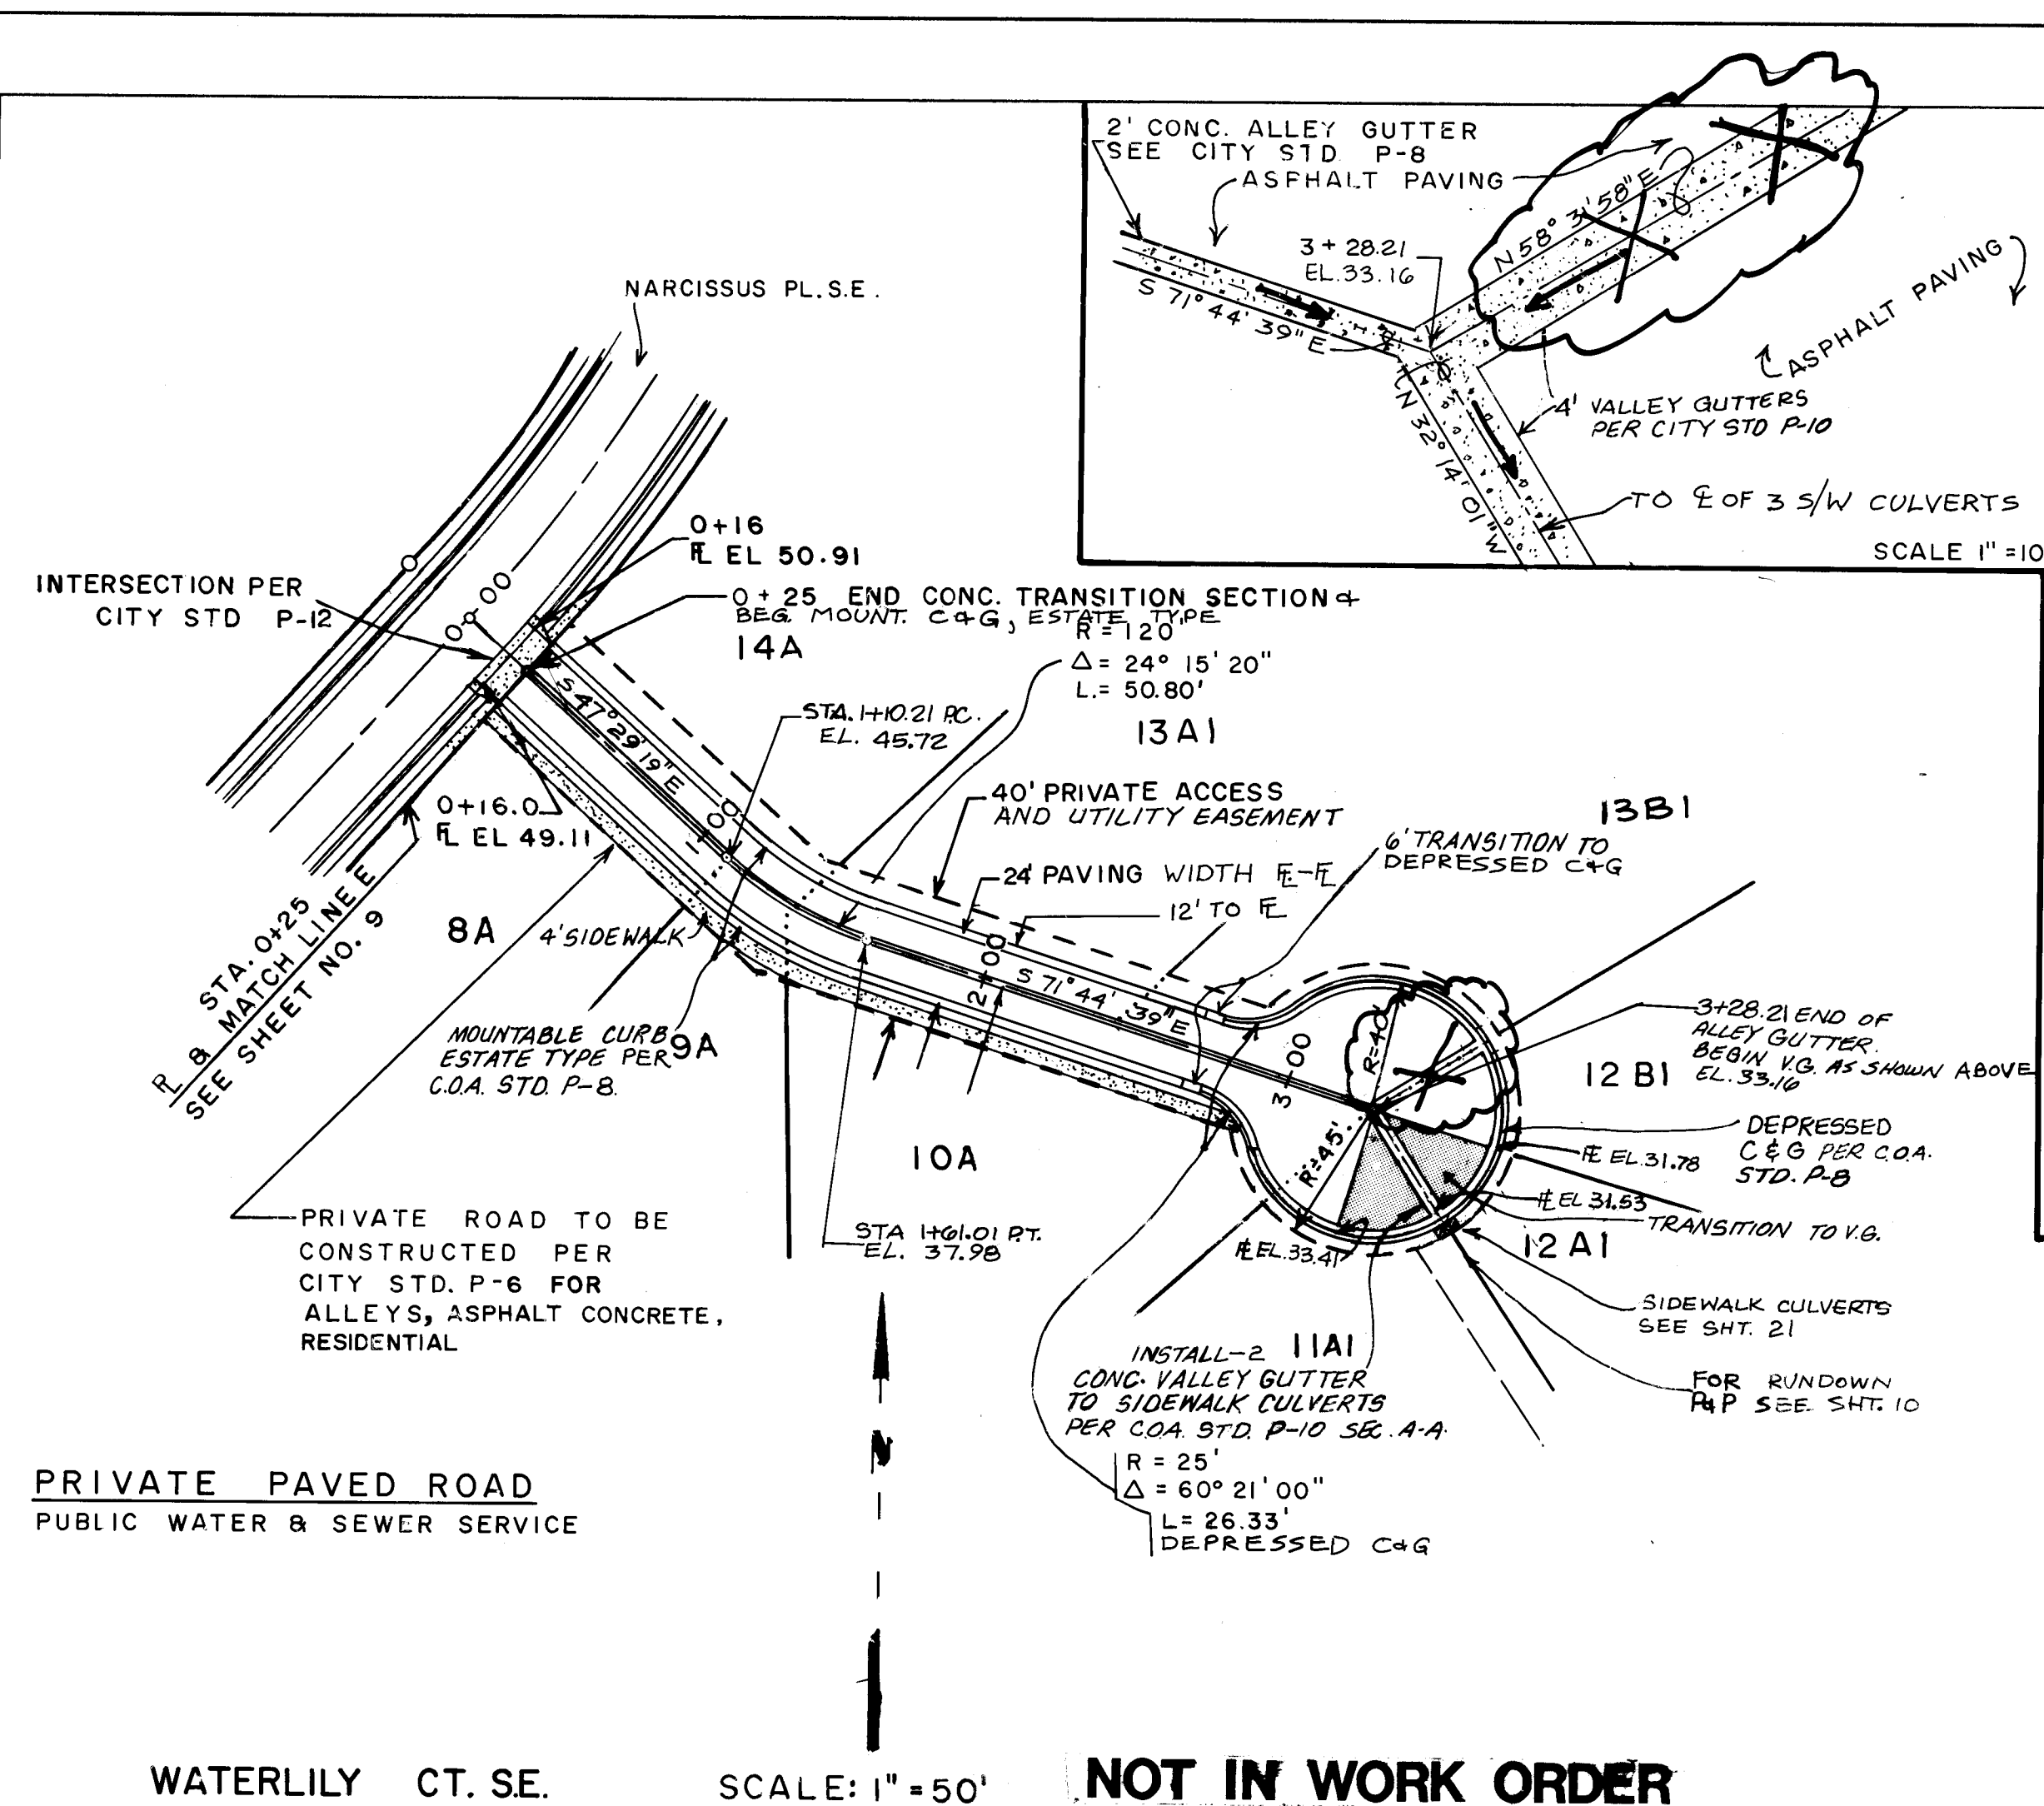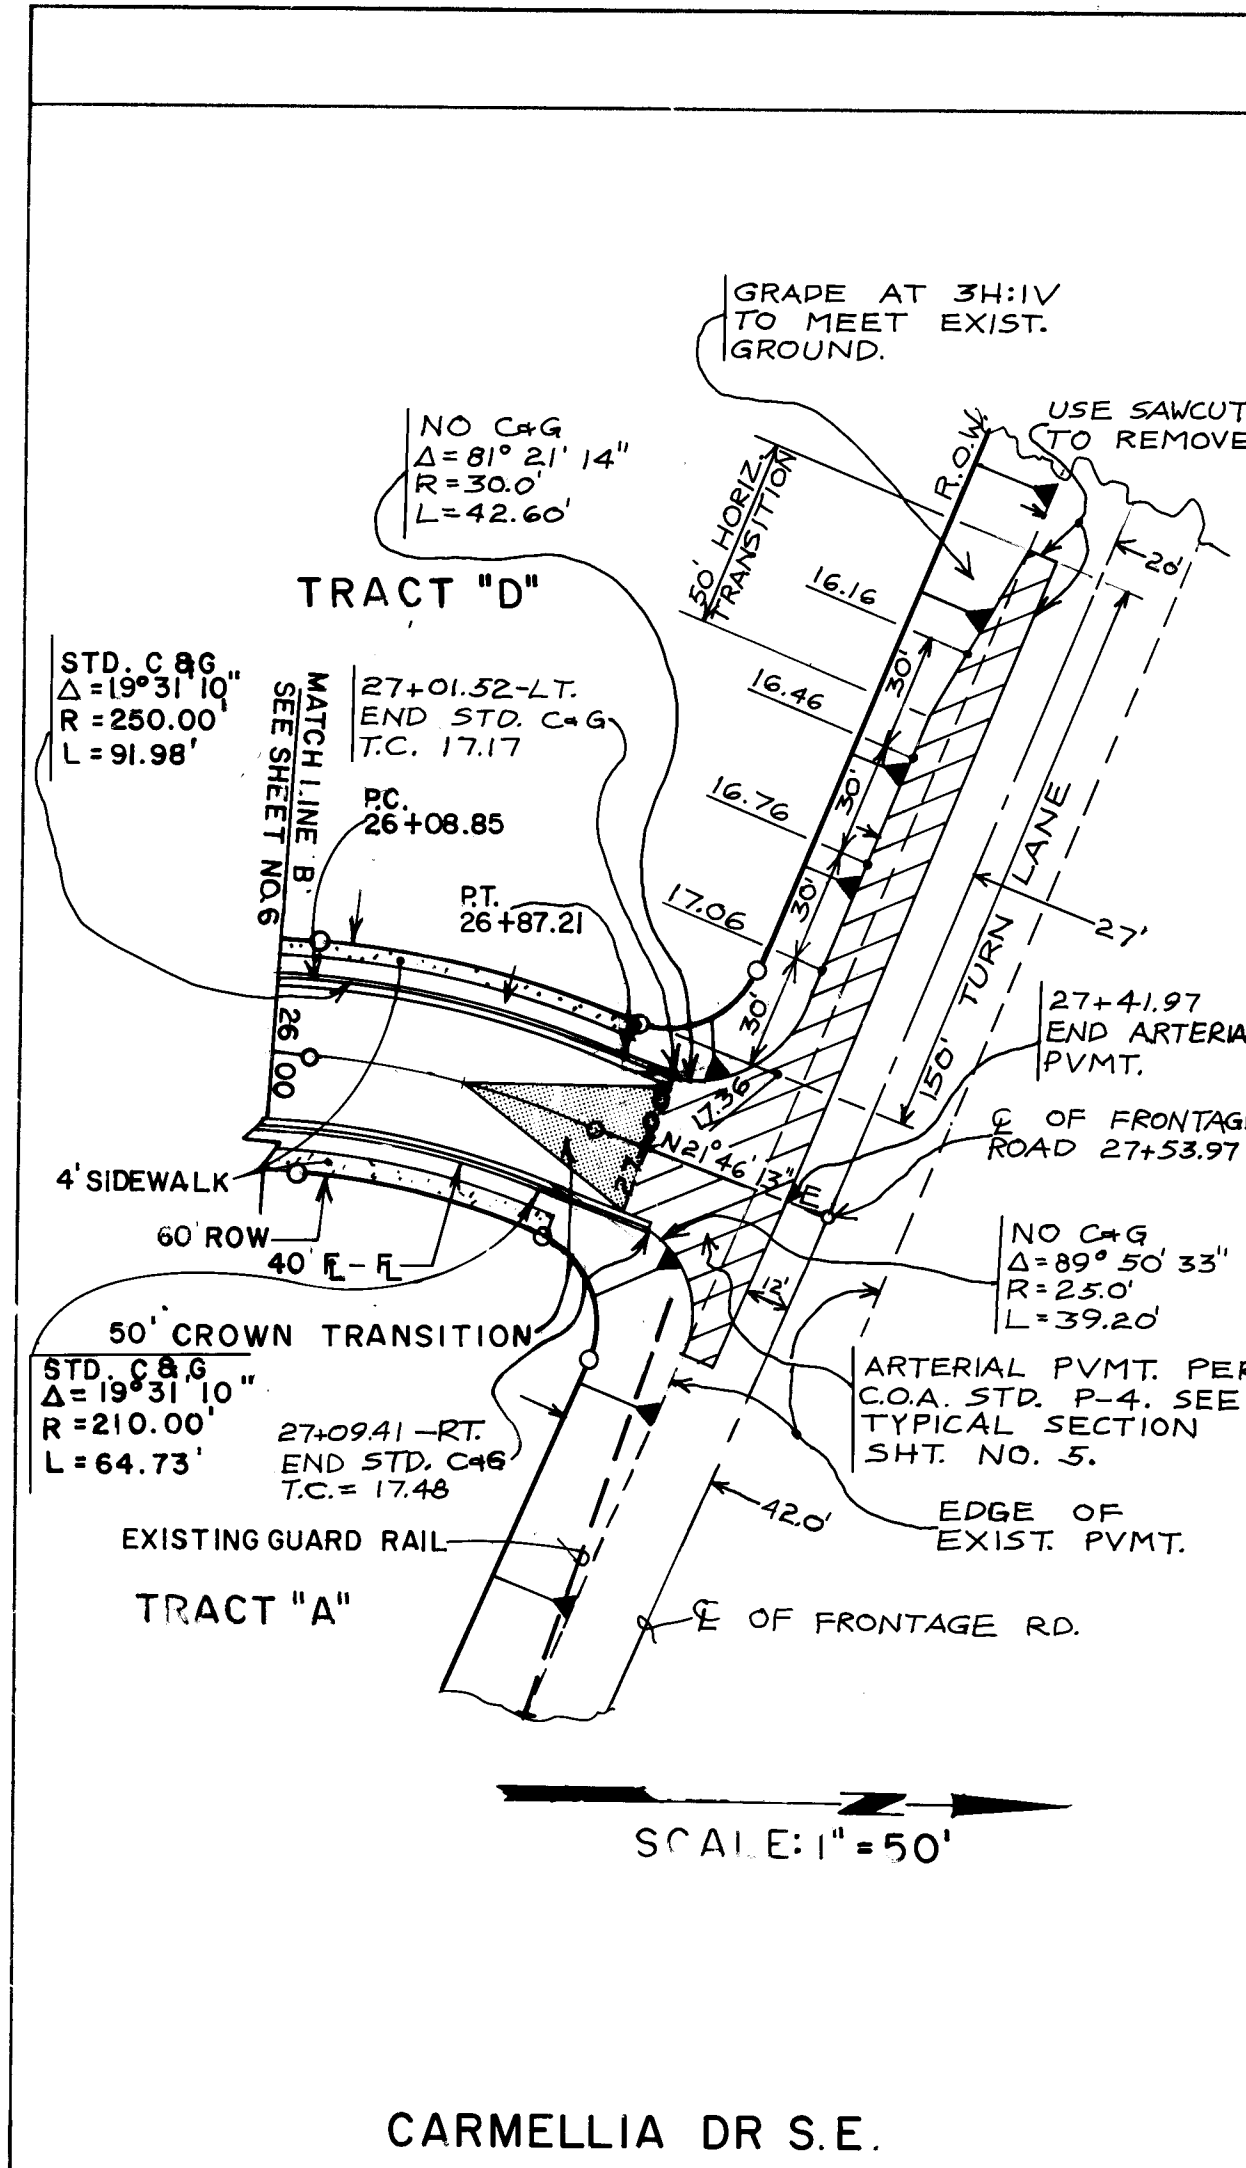

LEGEND	
---	TRANSITION AREA
■	CATCH BASIN
-SD-	STORM DRAIN LINE
○	PROPOSED STORM DRAIN MANHOLE
TC EL	TOP OF CURB ELEVATION

SEE SHEET 4 FOR GENERAL NOTES

AS BUILT INFORMATION		BENCH MARKS	
CONTRACT NO.	1178 Const. Co.	CONTROL: TOM, APPROX. 712 SOUTH	DATE
INSPECTOR'S NAME	DATE	OF 1-40 FRONTAGE ROAD AND	DATE
FIELD ENGINEER'S NAME	DATE	APPROX. 250' EAST OF C OF	DATE
VERIFICATION BY	DATE	ROSEWOOD PLACE, S.E. AT APPROX.	DATE
CORRECTED BY	DATE	STA. 1+76 STANDARD A.C.S. BRASS	DATE
RECORDED BY	DATE	CAP STAMPED "TOM"	DATE
NO.		EL. 5711.67'	

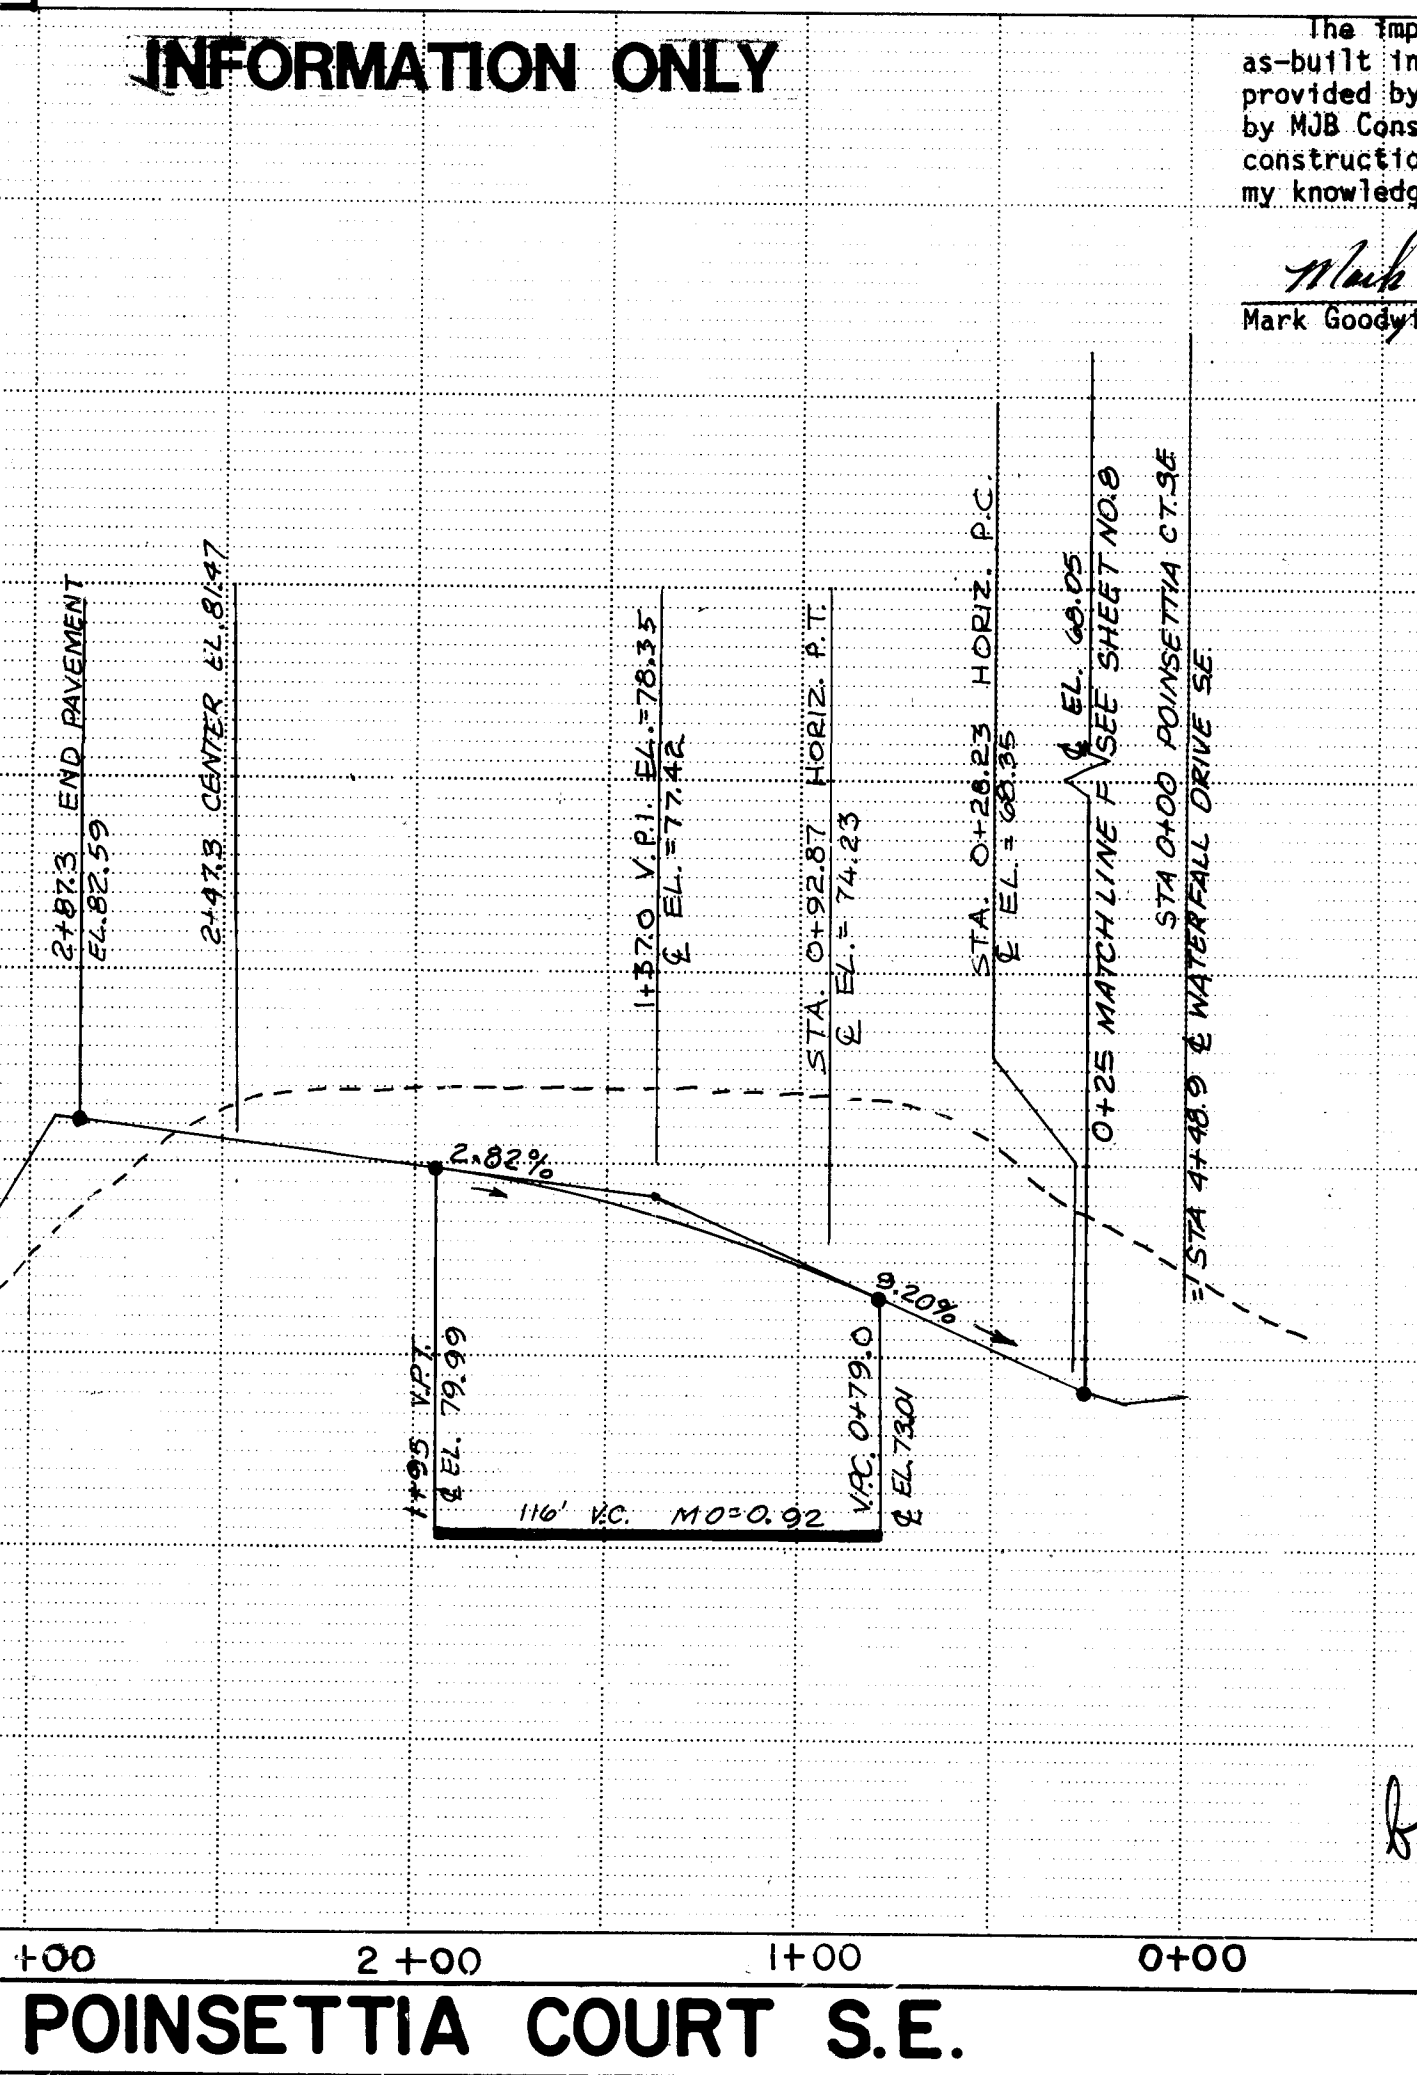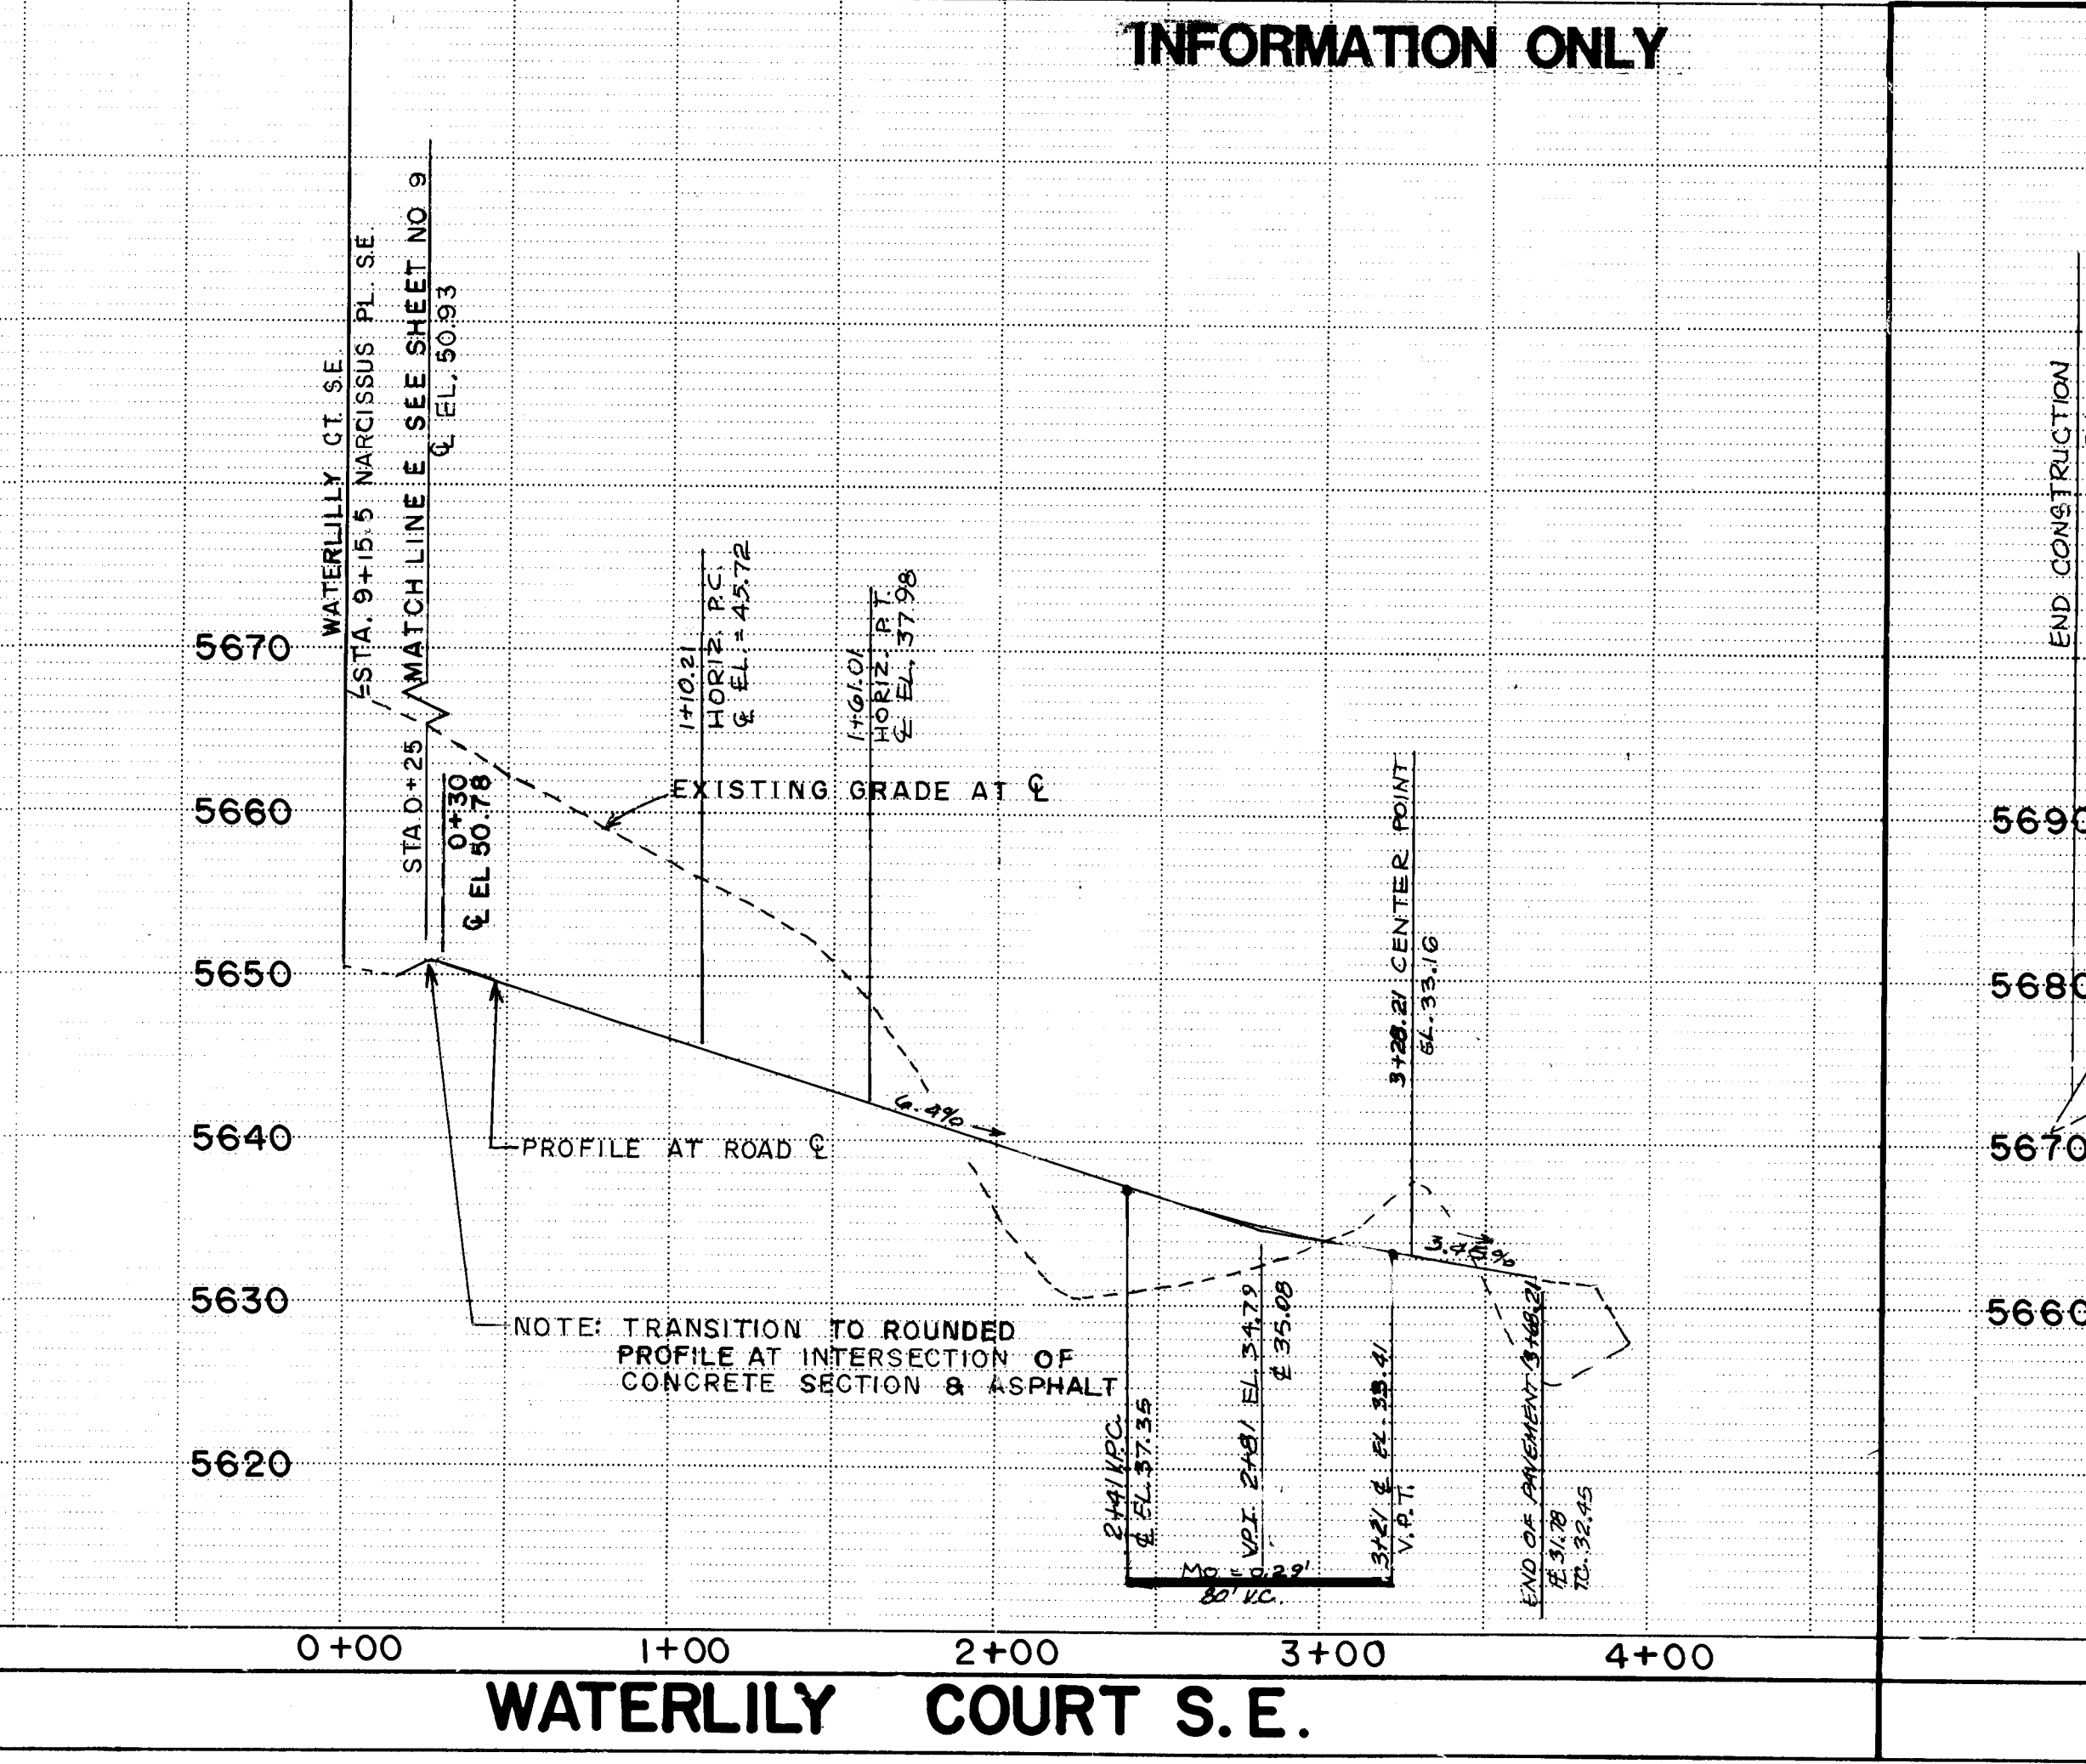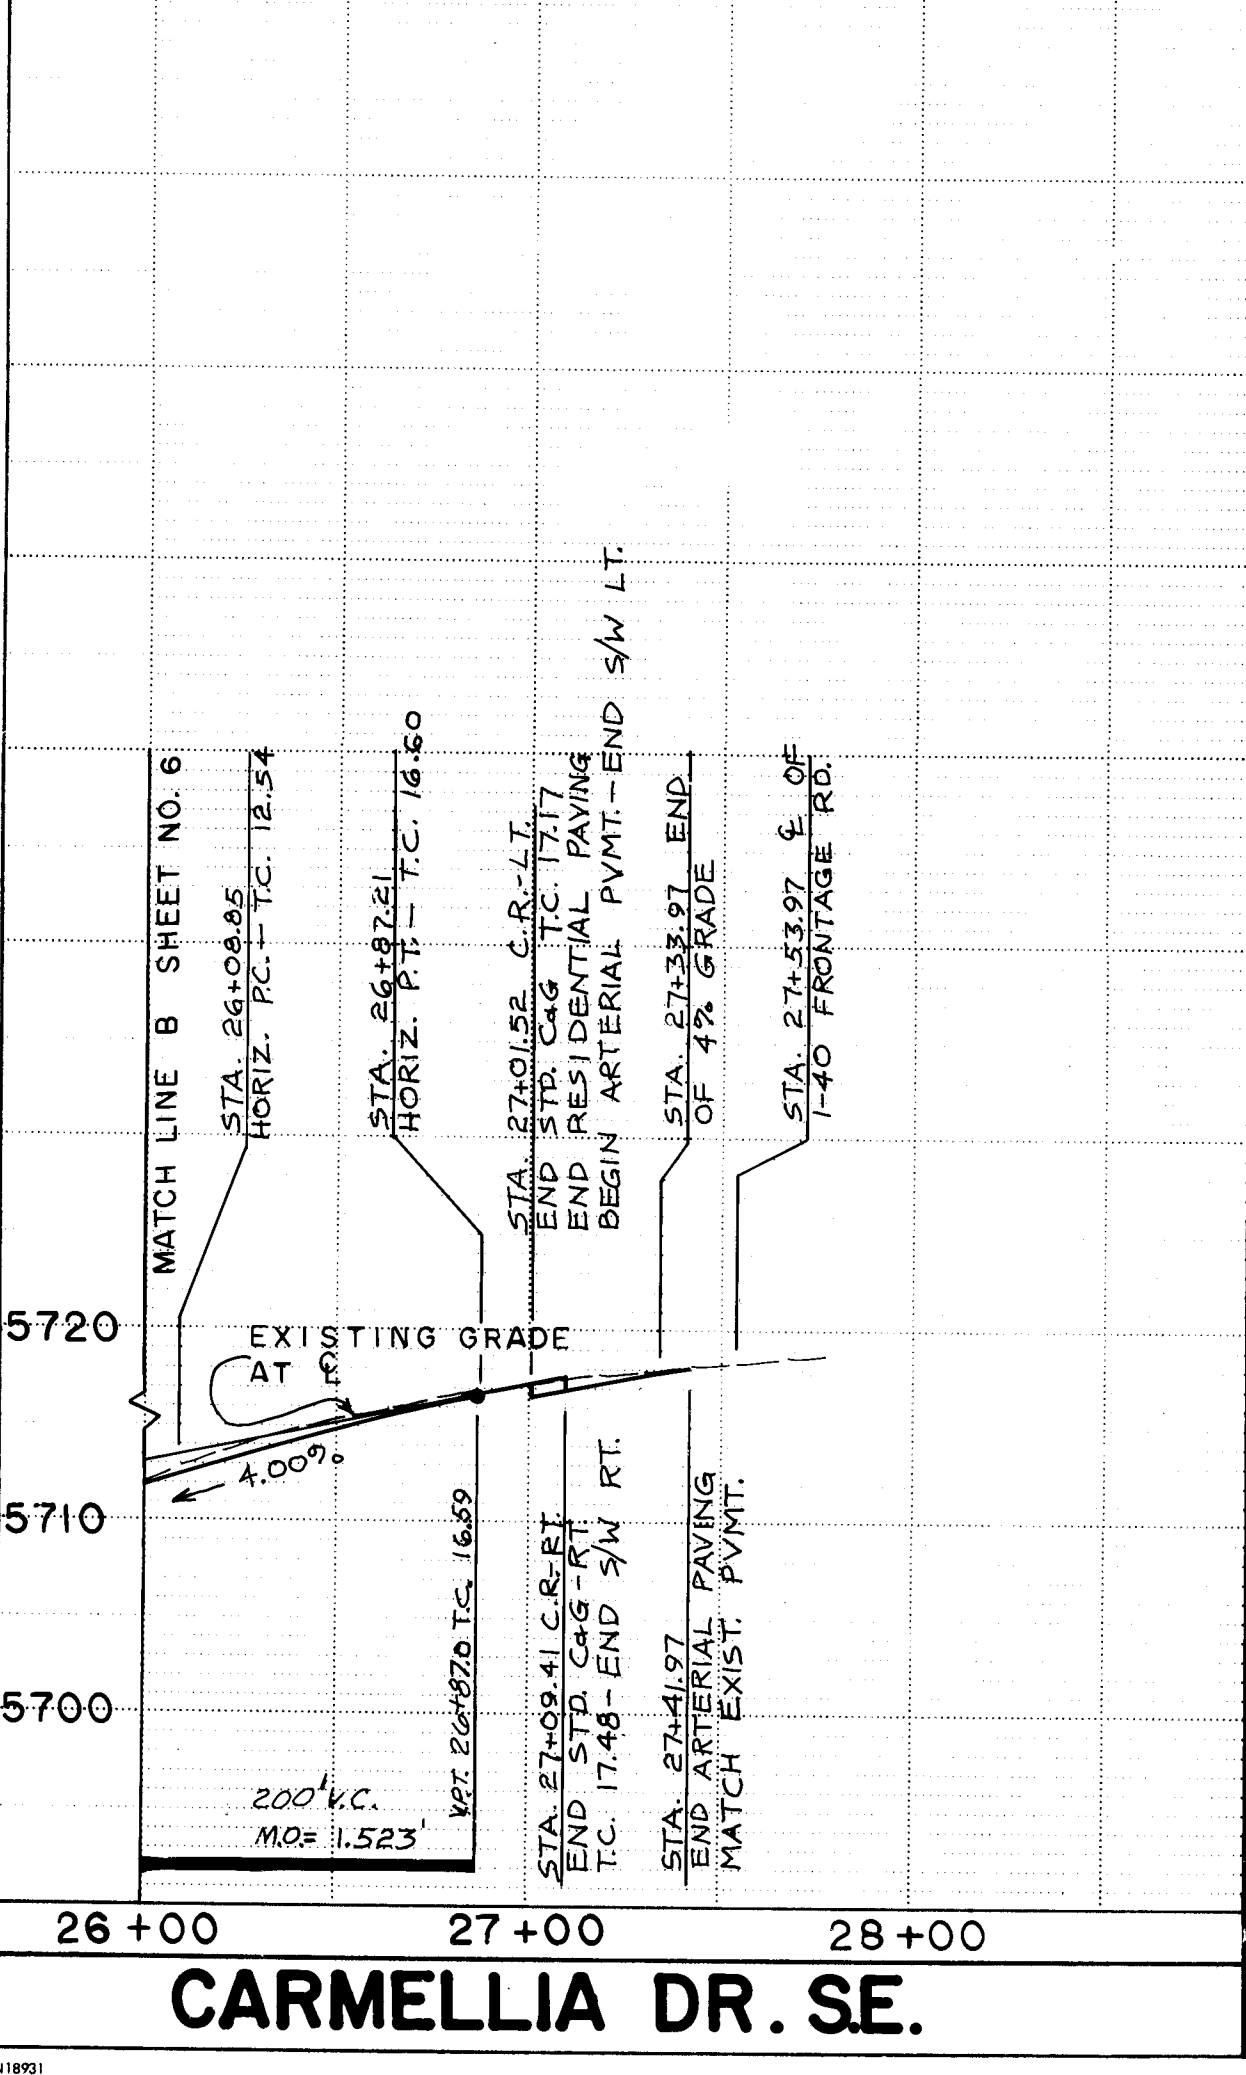

REVISIONS		ENGINEER'S SEAL	
NO.	DATE	BY	DATE
1		SD, ED	DATE MAY 1983
2		SD, CM, FM	DATE JAN 1985
3		ED	DATE JAN 1985

DESIGNED BY SD, ED DATE MAY 1983

DRAWN BY SD, CM, FM DATE JAN 1985

CHECKED BY ED DATE JAN 1985

THE IMPROVEMENTS SHOWN ON THIS DRAWING HAVE BEEN AS-BUILT IN ACCORDANCE WITH FIELD INFORMATION PROVIDED BY D. MARK GOODWIN AND ASSOCIATES, P.A., AND BY MJB CONSTRUCTION COMPANY (CONTRACTOR) TO REFLECT CONSTRUCTION ACTUALLY ACCOMPLISHED TO THE BEST OF MY KNOWLEDGE AND BELIEF.

Mark Goodwin, P.E. 8948 Date 6/26/87

MARK GOODWIN 8948 REGISTERED PROFESSIONAL ENGINEER

CITY OF ALBUQUERQUE MUNICIPAL DEVELOPMENT DEPARTMENT ENGINEERING DIVISION


TITLE: NORTH FOUR HILLS SUBDIVISION CARMELLIA DR., WATERLILY CT., POINSETTIA CT. PAVING PLAN & PROFILES

APPROVALS	ENGINEER	DATE	APPROVALS	ENGINEER	DATE
City Engineer	2/12/87	Liquid Waste	N/A	W/U	10/1/86
A.C.E. Design	2/12/87	Traffic	N/A	W/U	10/1/86
Hydrology	2/12/87	Water	N/A	W/U	10/1/86

DRAWING NO. 2565 MAP NO. L-23 SHEET 7 OF 22


SEE SHT. NO. 6
FOR C.R.
CURVE DATA

NOTE:
SEE SHEET NO. 6
FOR T.C. & F
QUARTER
POINT EL.


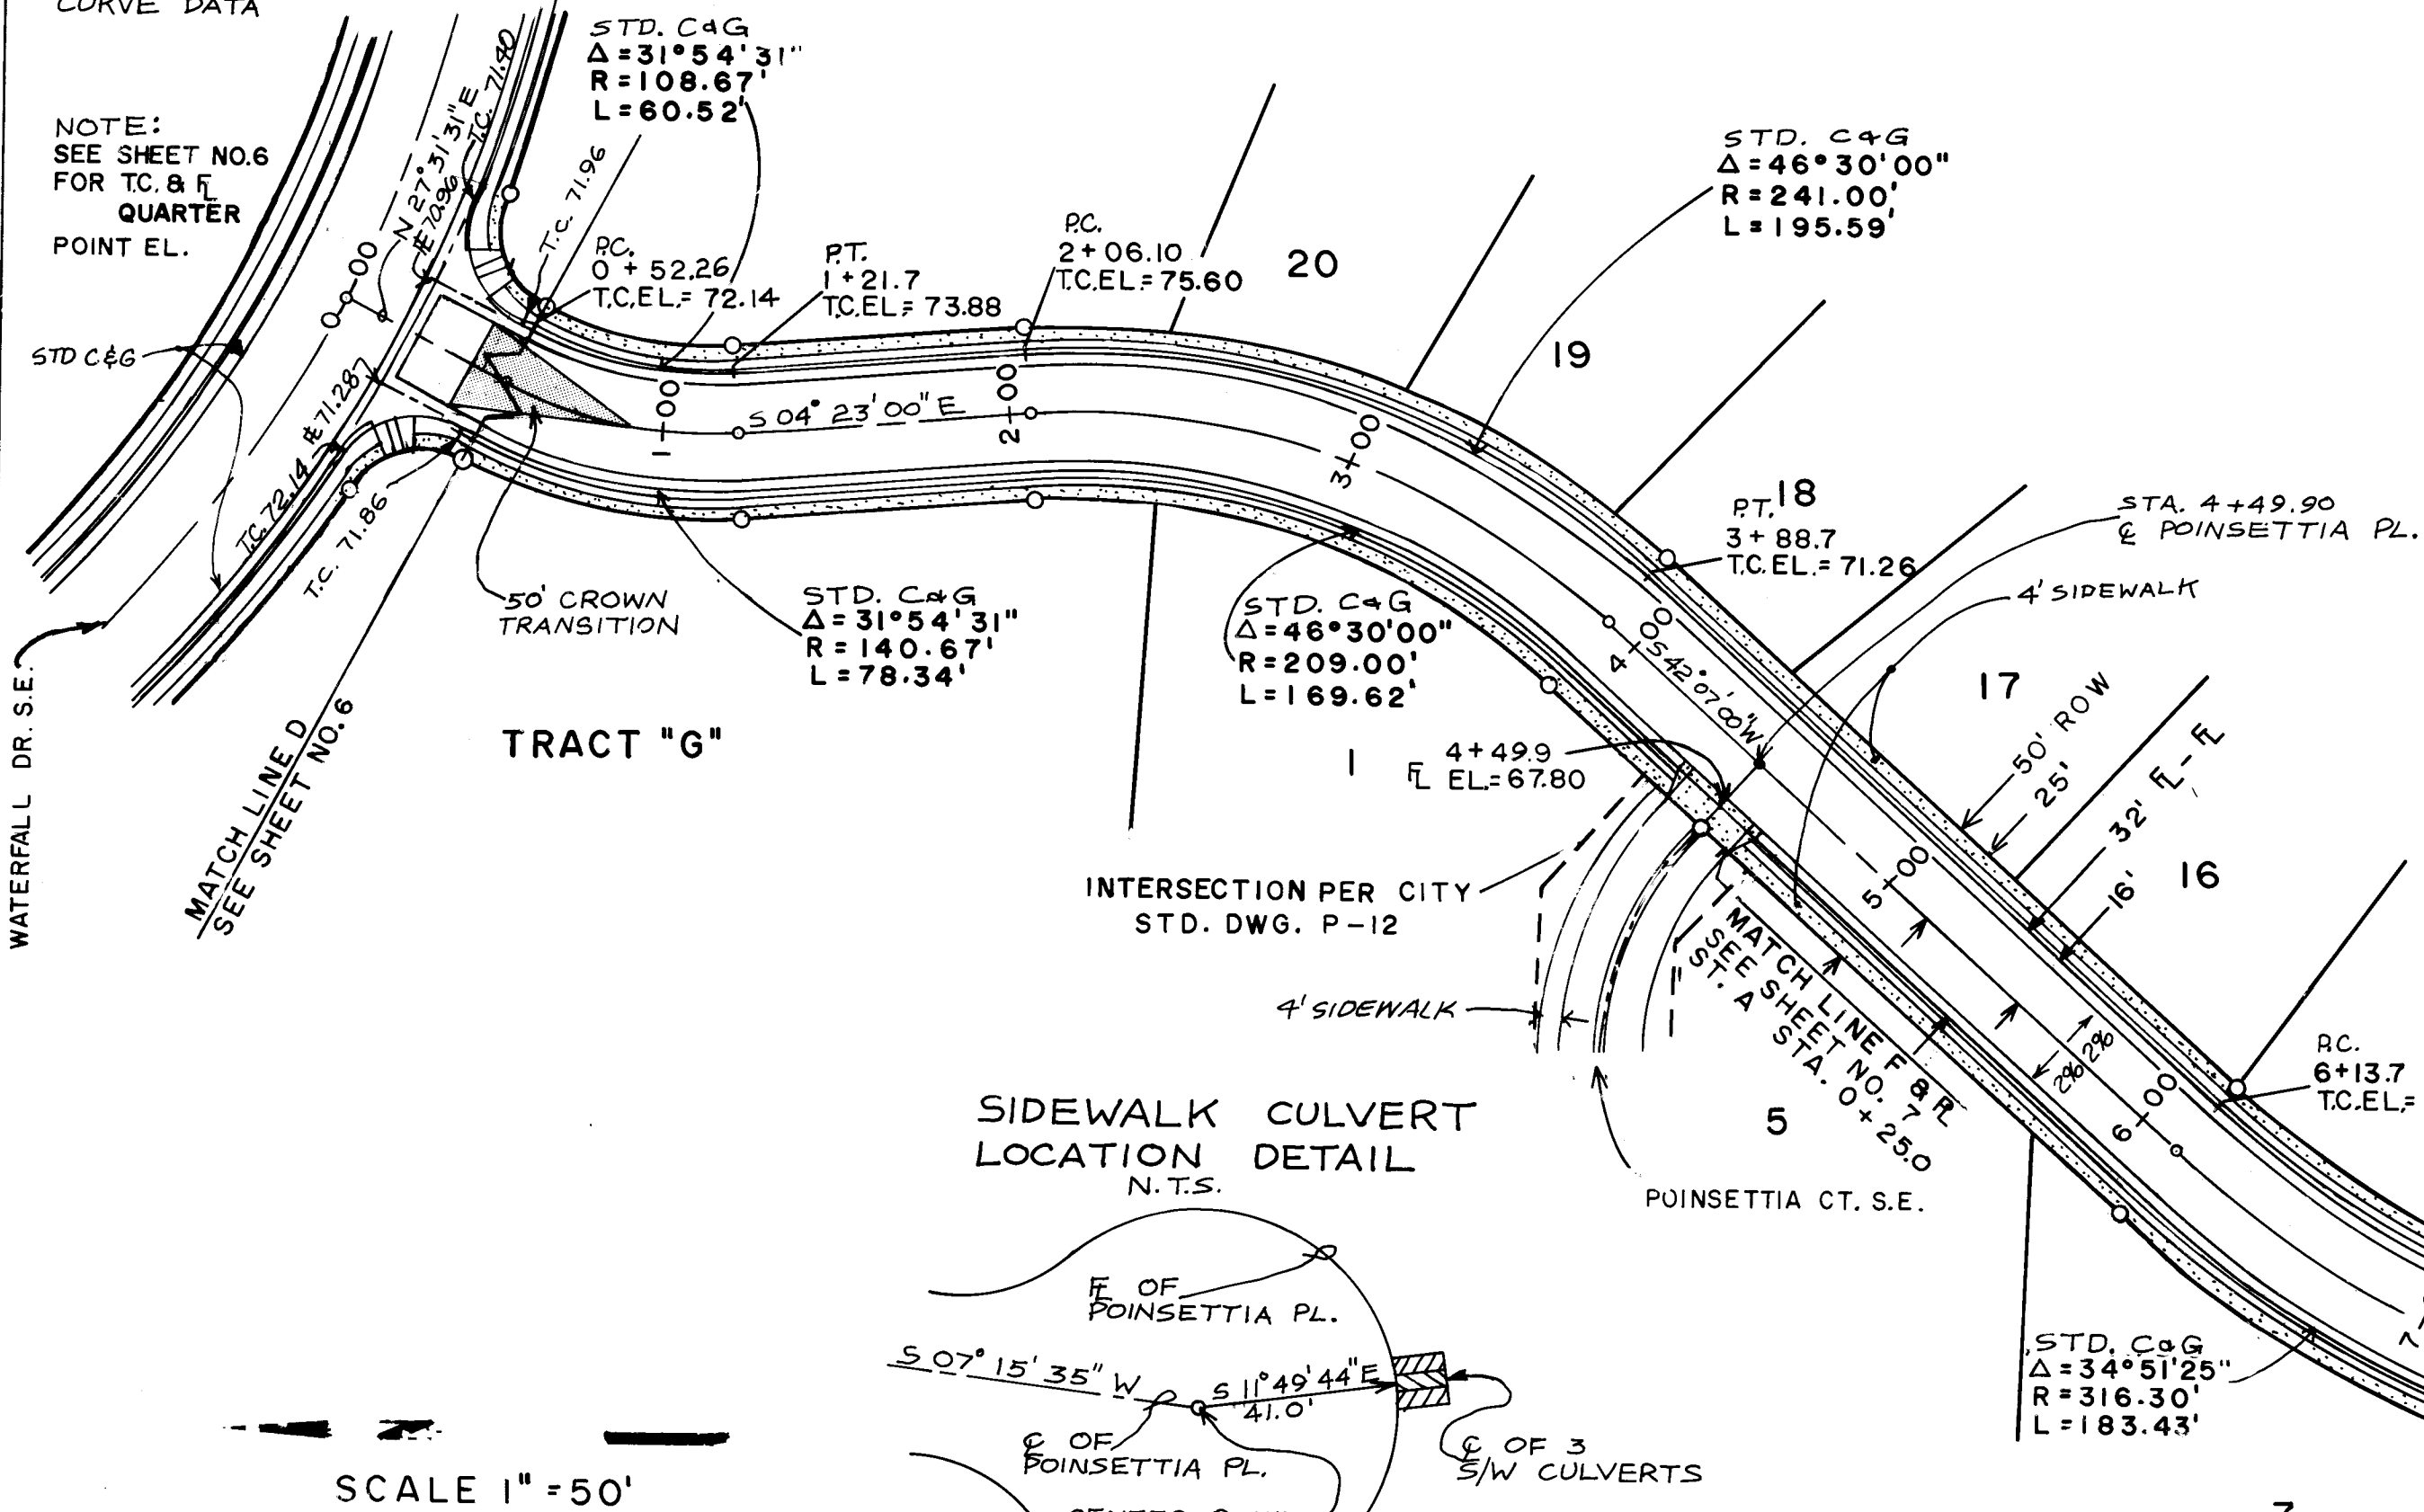


SCALE 1"=50'

POINSETTIA PLACE S.E.

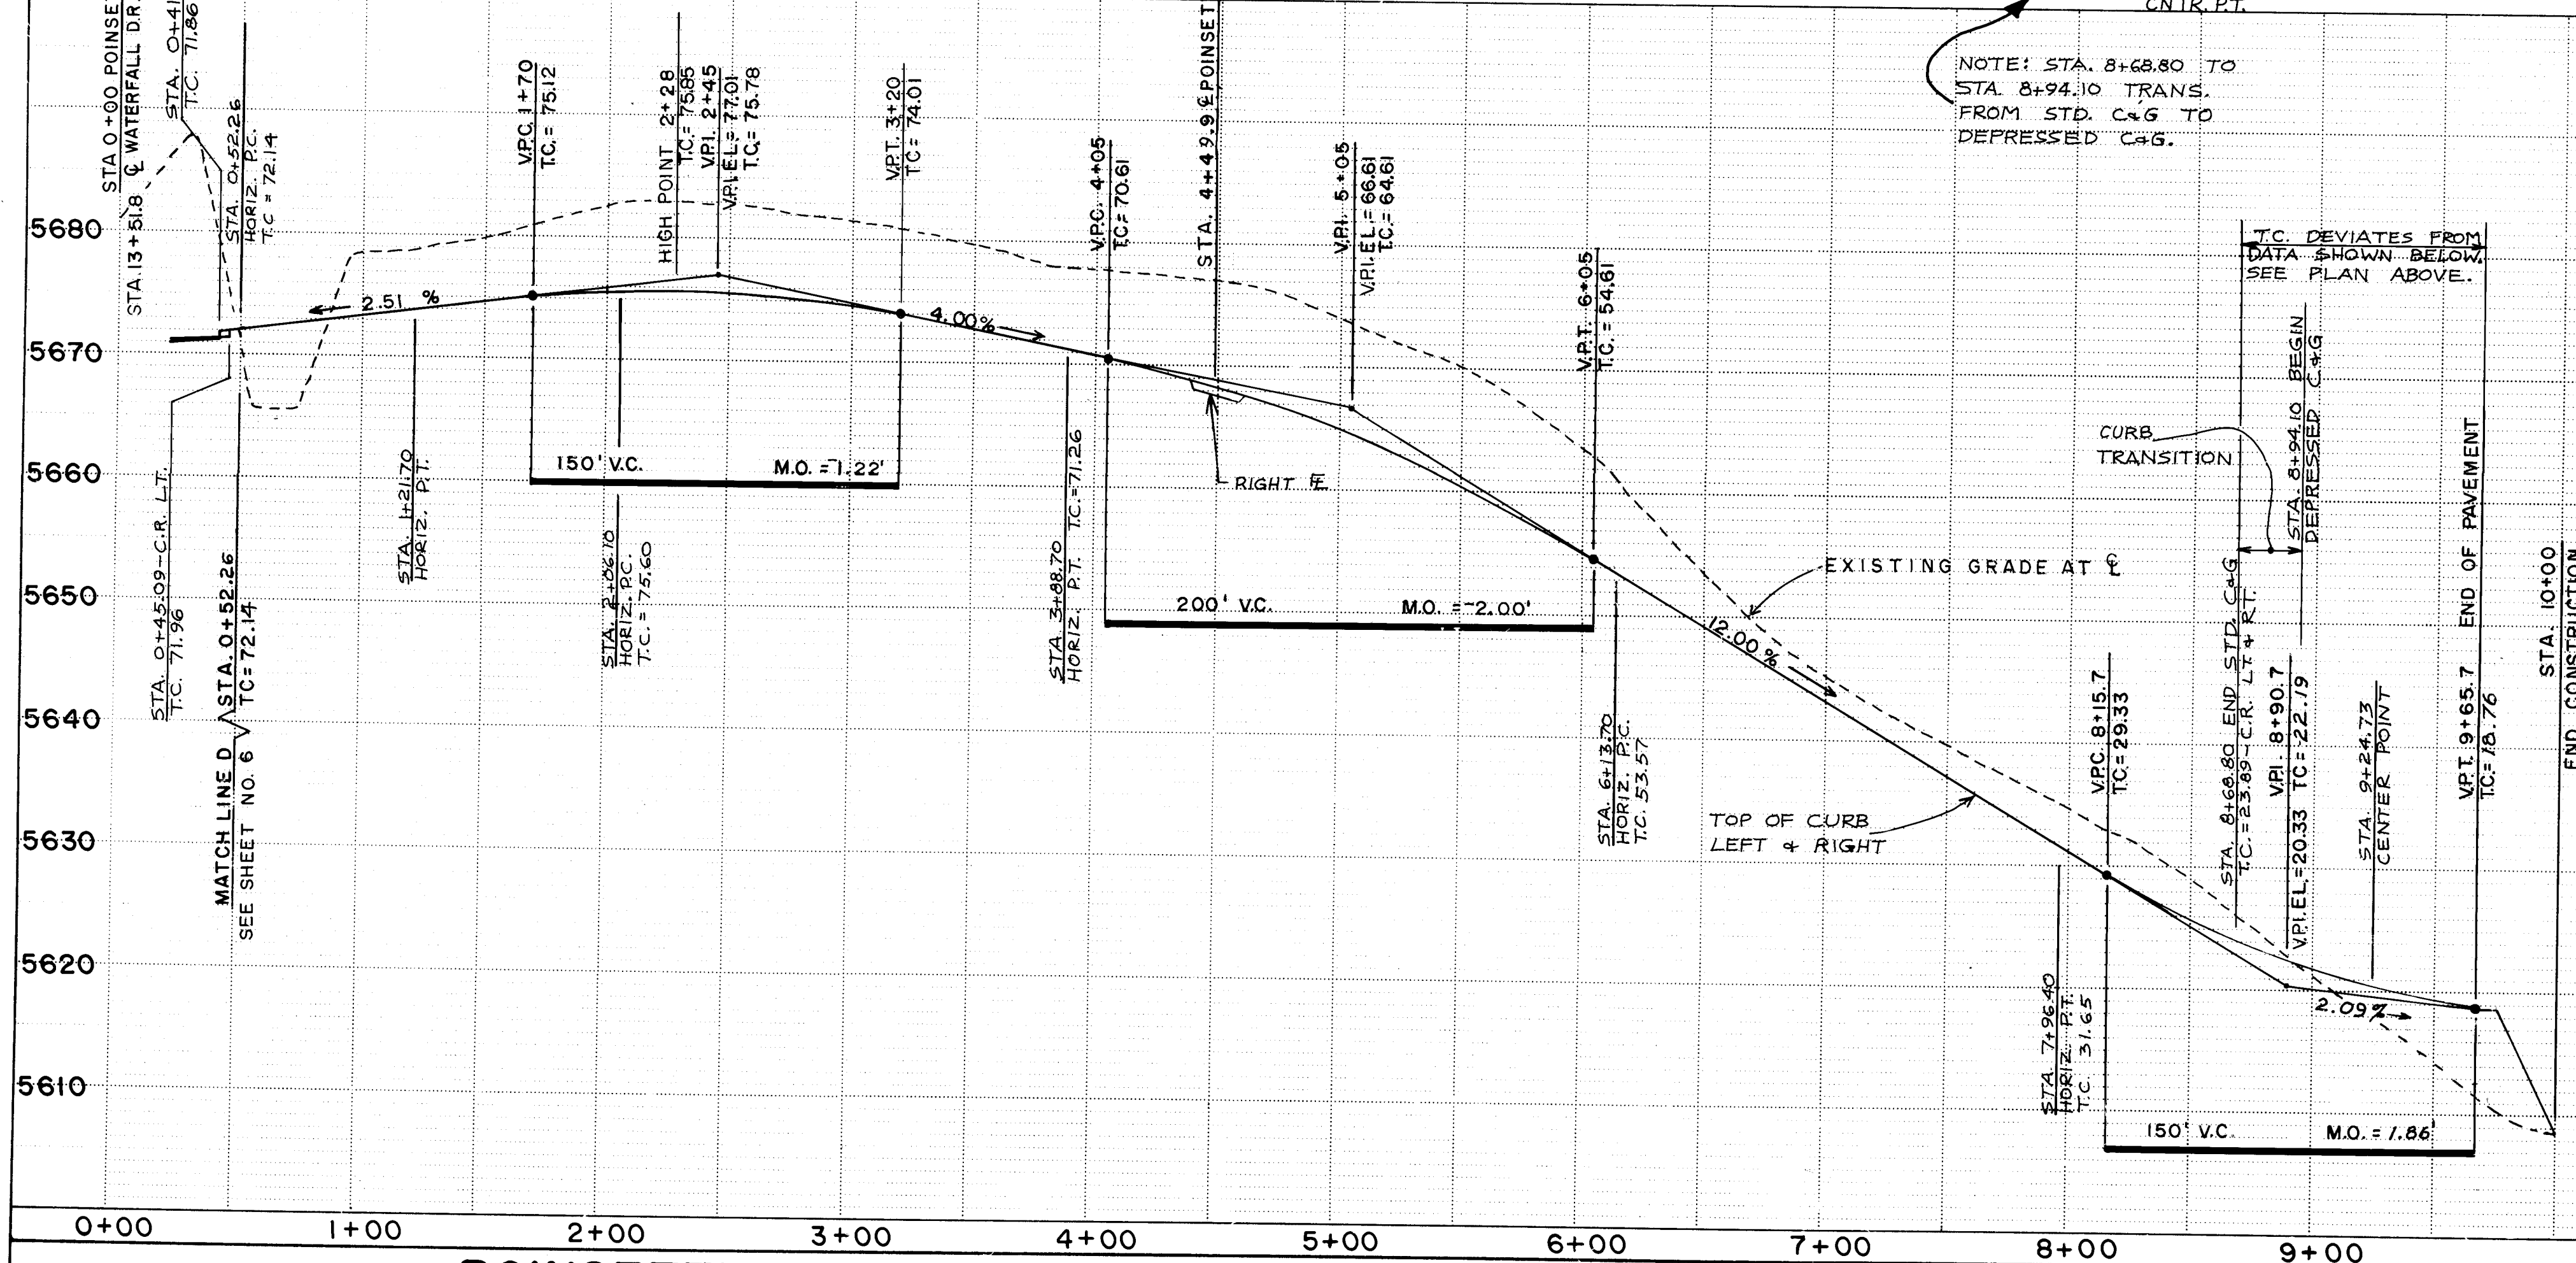


POINSETTIA PLACE S.E.

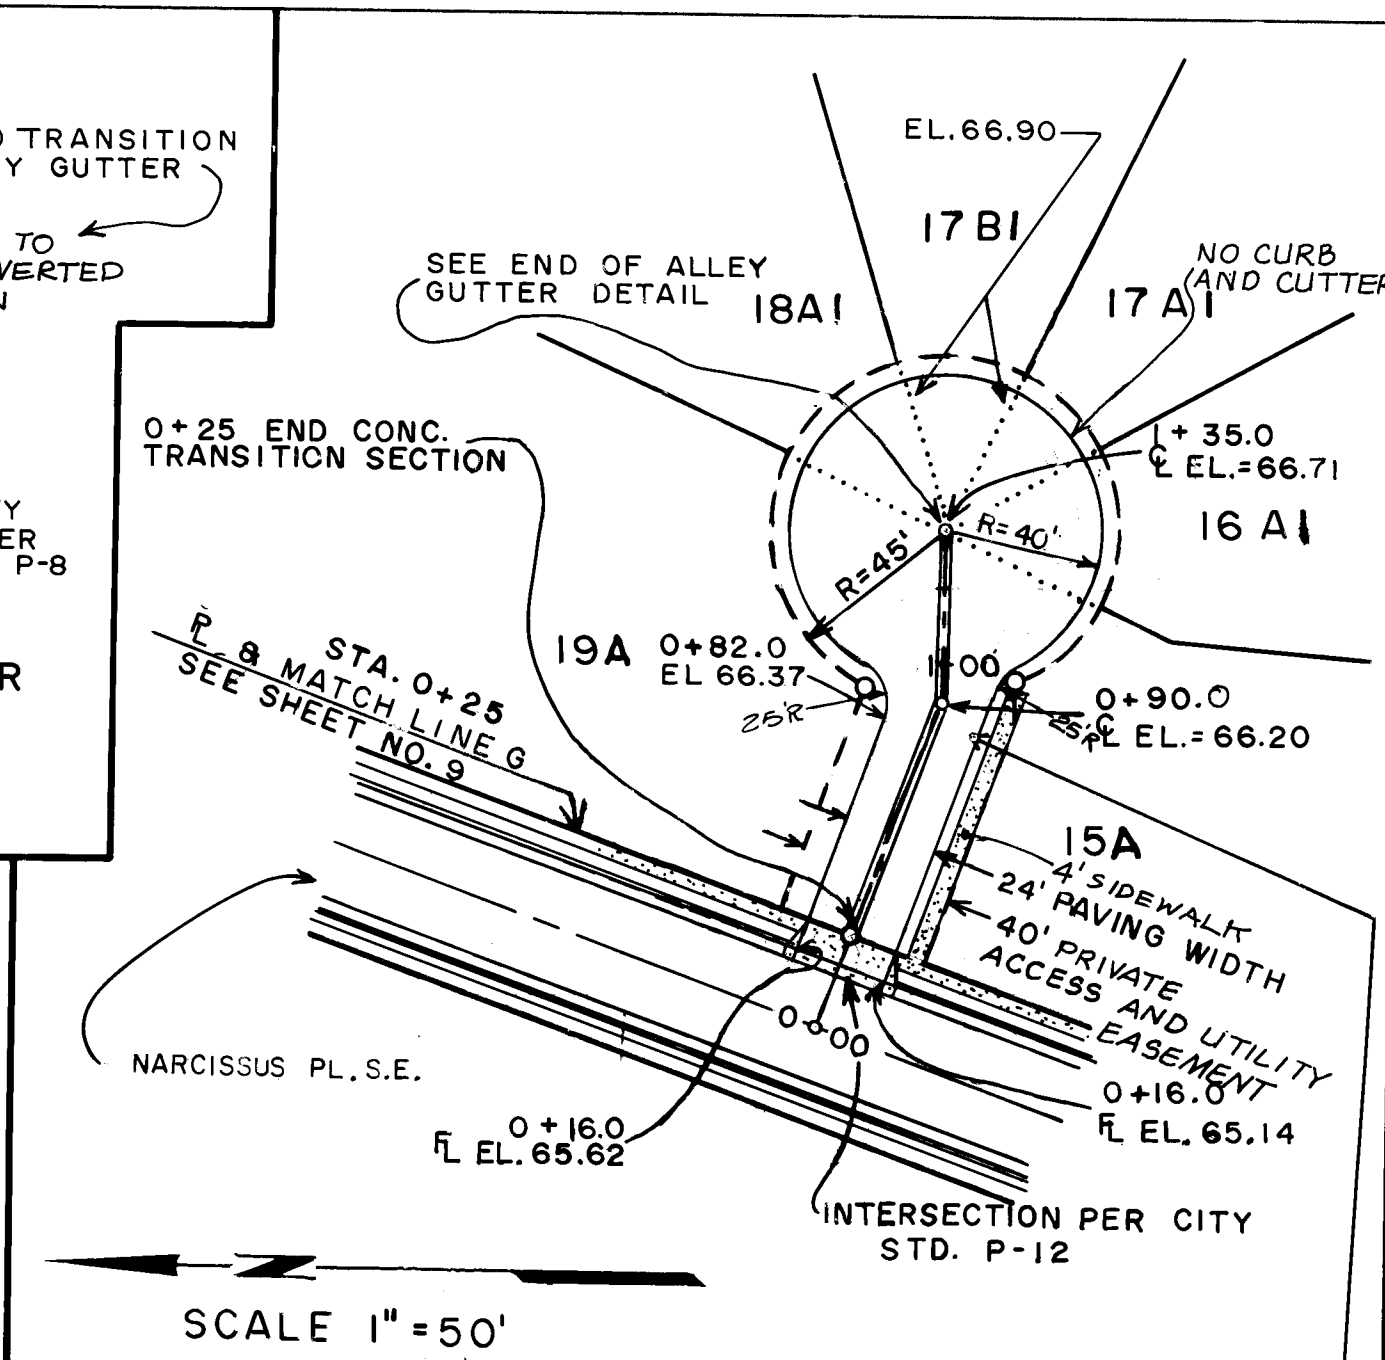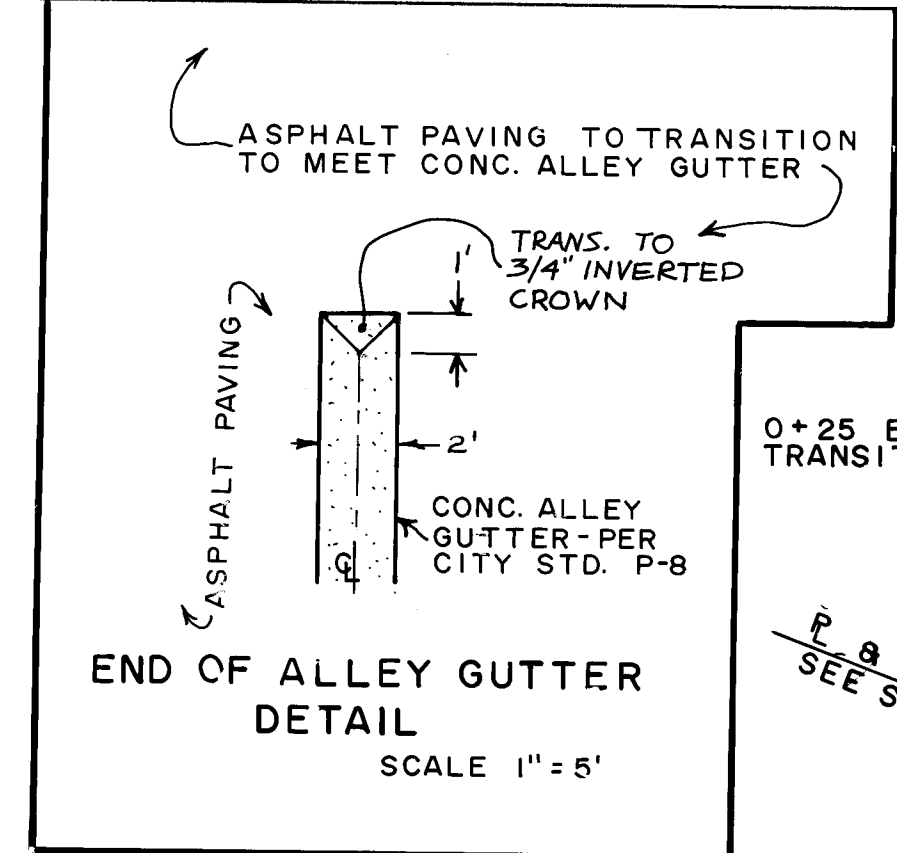

MISTLETOE CT. S.E.
PRIVATE ROAD TO BE
CONSTRUCTED PER
CITY STD. P-6
FOR ALLEYS, ASPHALT
CONCRETE, RESIDENTIAL

PRIVATE PAVED ROAD
PUBLIC WATER & SEWER SERVICE

NOT IN WORK ORDER
INFORMATION ONLY

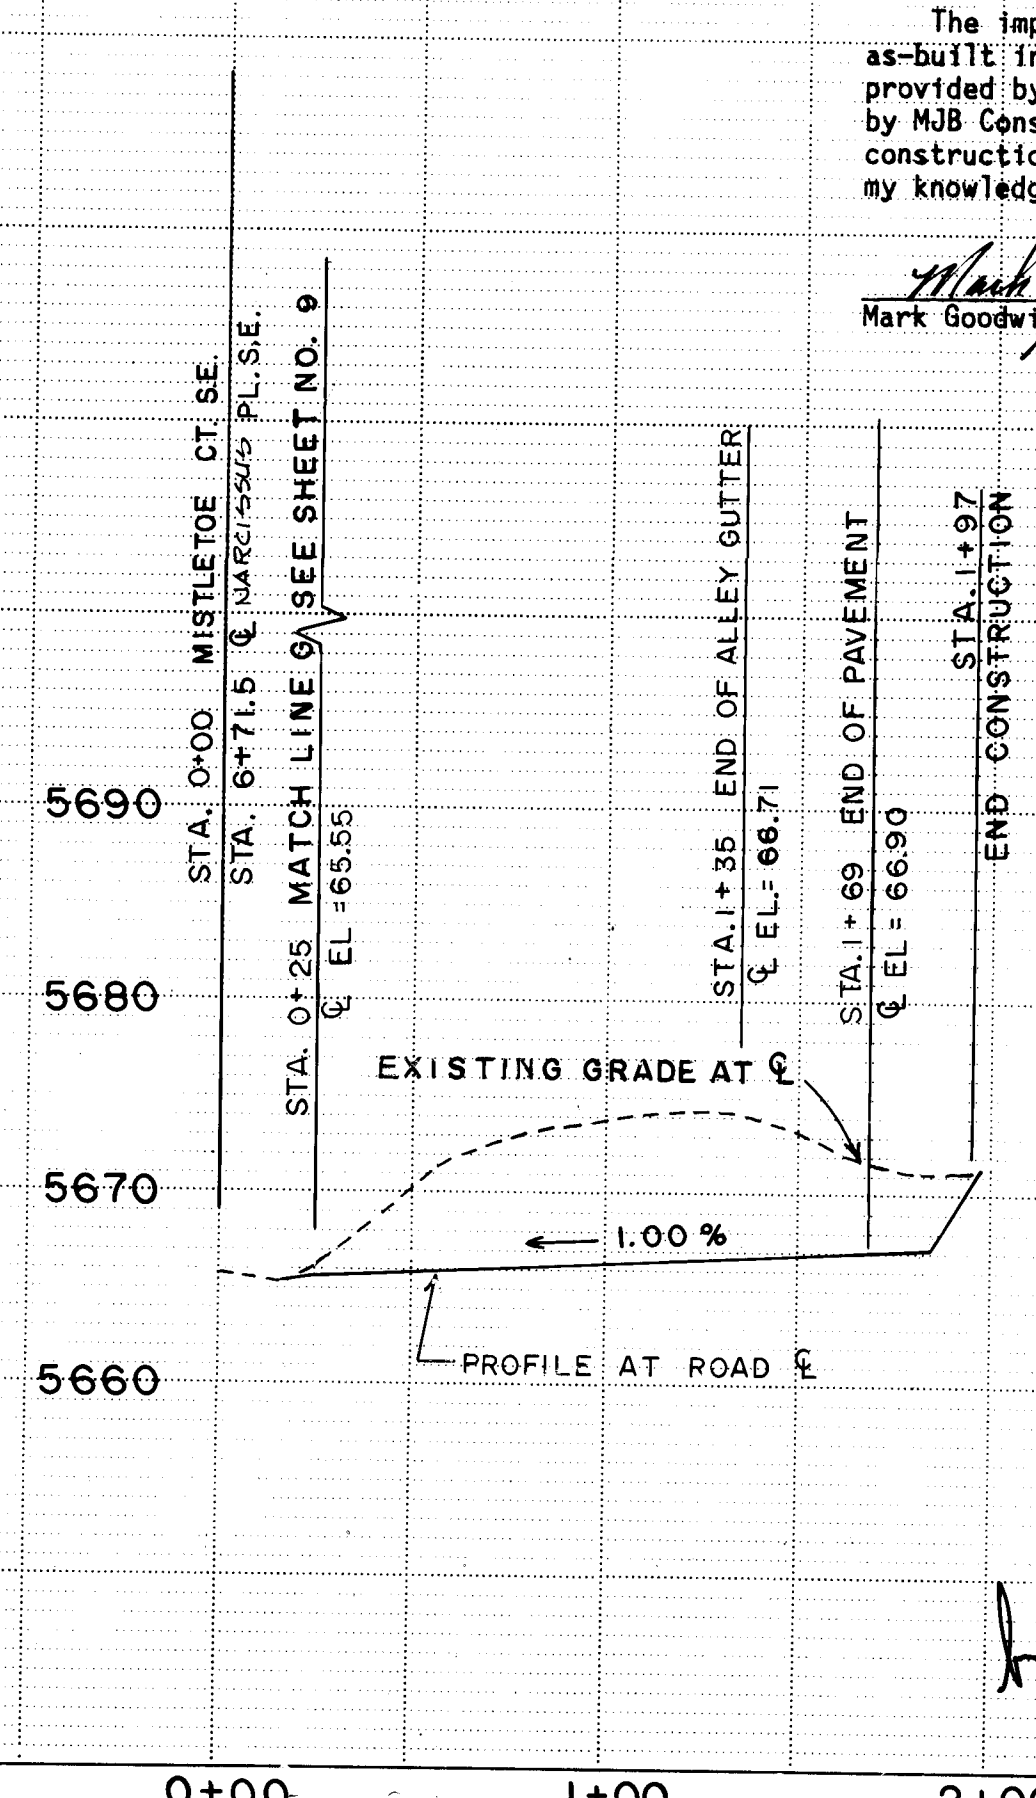

MISTLETOE CT. S.E.

LEGEND	
	TRANSITION AREA
	CATCH BASIN
	STORM DRAIN LINE
	PROPOSED STORM DRAIN MANHOLE
	TOP OF CURB ELEVATION

SEE SHEET 4 FOR GENERAL NOTES

RECORD DRAWING


The improvements shown on this drawing have been
as-built in accordance with field information
provided by D. Mark Goodwin and Associates, PA, and
by MJB Construction Company (Contractor) to reflect
construction actually accomplished to the best of
my knowledge and belief.

Mark Goodwin, P.E. 8948 Date 6/26/89



26 25 65 08 89

CITY OF ALBUQUERQUE MUNICIPAL DEVELOPMENT DEPARTMENT ENGINEERING DIVISION					
TITLE: NORTH FOUR HILLS SUBDIVISION POINSETTIA PLACE & MISTLETOE COURT PAVING PLAN & PROFILES					
APPROVALS	ENGINEER	DATE	APPROVALS	ENGINEER	DATE
City Engineer	<i>[Signature]</i>	2/13/89	Liquid Waste	<i>[Signature]</i>	10/1/86
A.C.E.-Design			Traffic	<i>[Signature]</i>	4/8/86
Hydrology	<i>[Signature]</i>	2/13/89	Water	<i>[Signature]</i>	10/1/86
DRAWING NO. 2565		MAP NO. L-23		SHEET 8 OF 22	

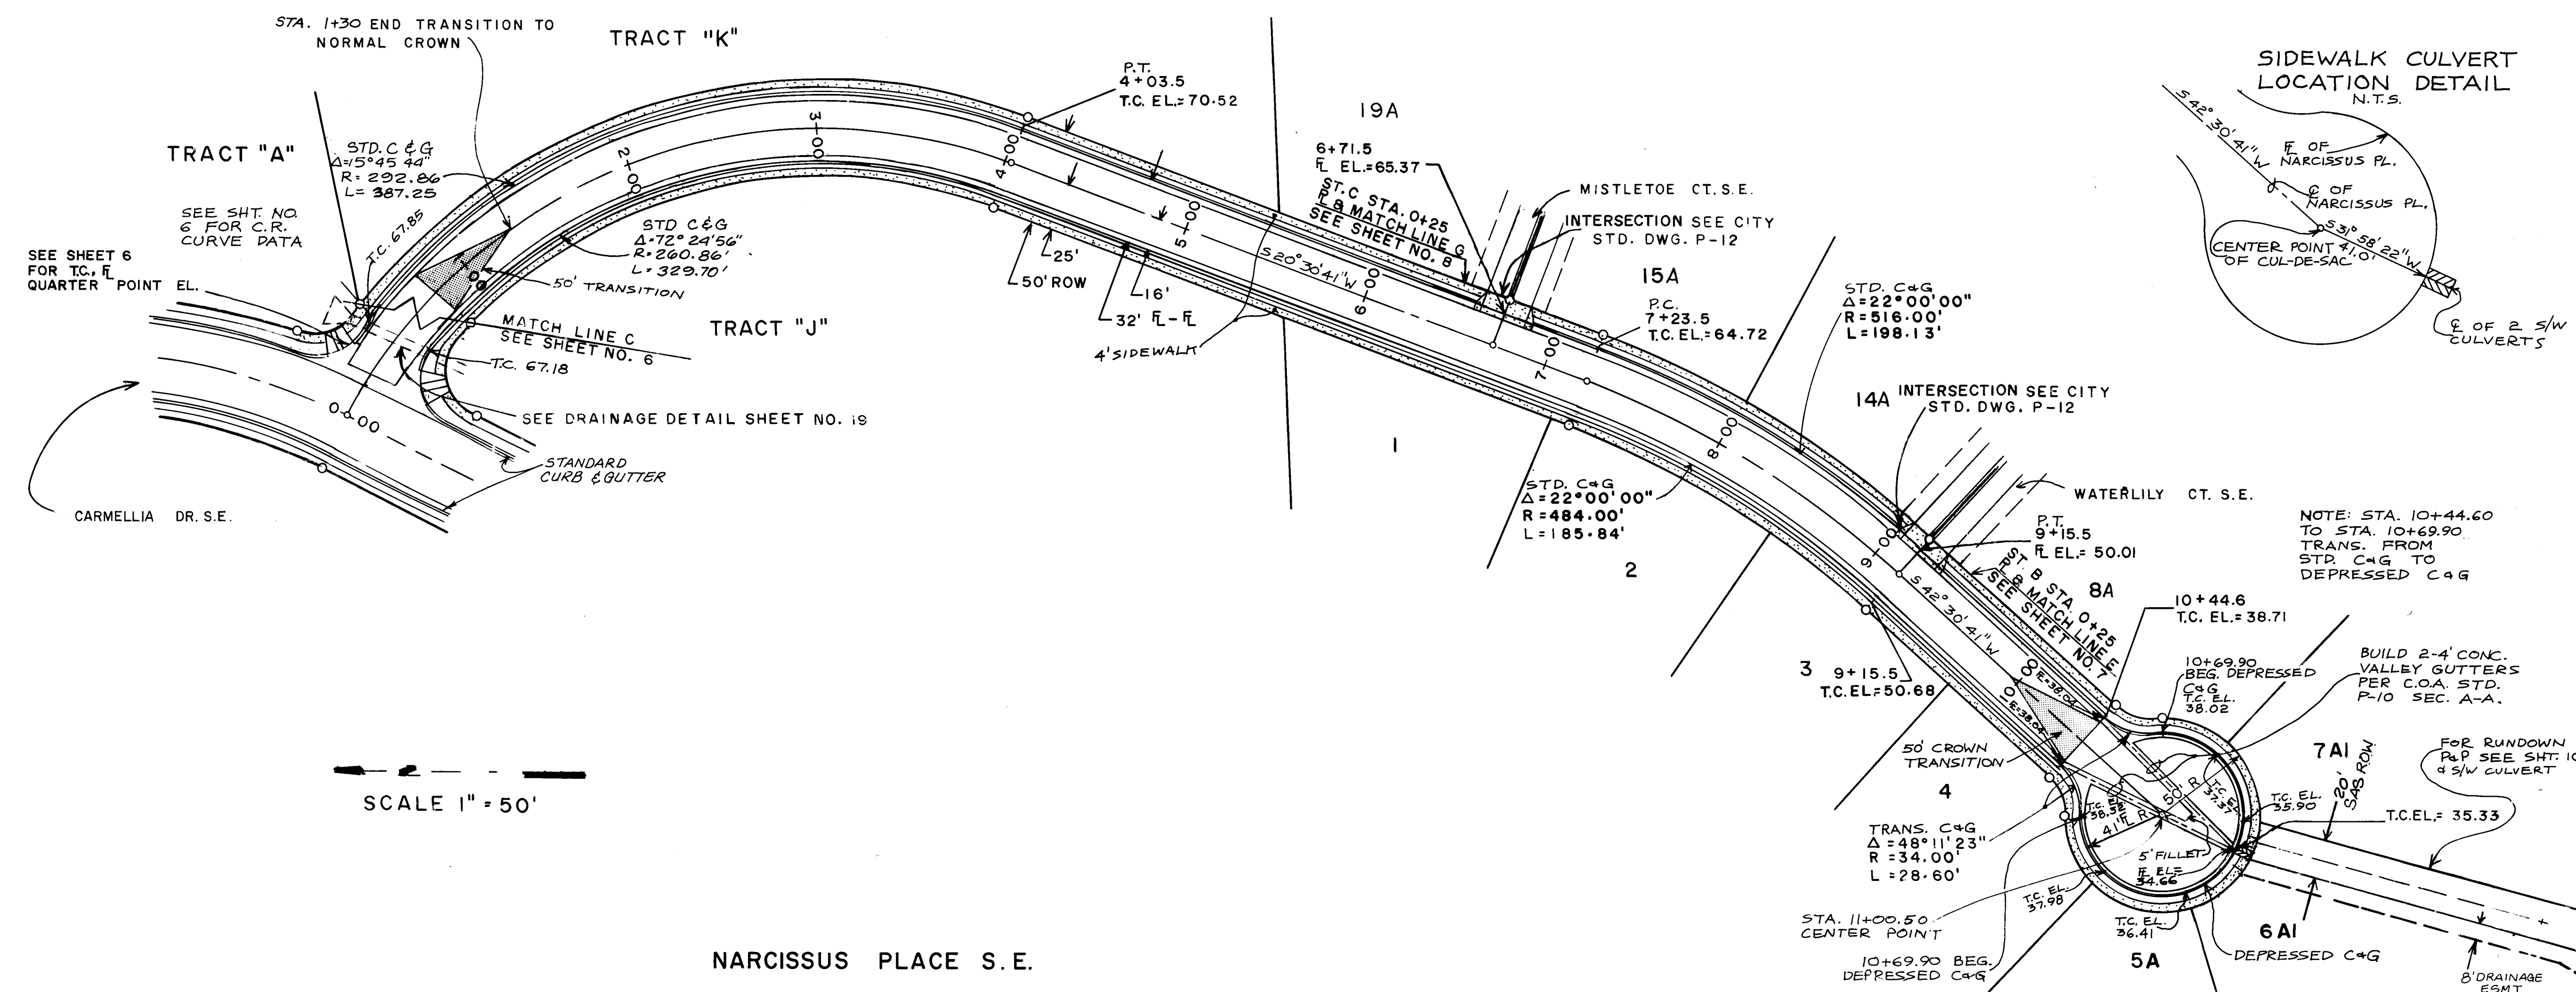


LEGEND	
	TRANSITION AREA
	CATCH BASIN
	STORM DRAIN LINE
	PROPOSED STORM DRAIN MANHOLE
	TOP OF CURB ELEVATION

AS BUILT INFORMATION	
CONTRACTOR	ASB Const. Co.
STARTED BY	THIS DATE
INSPECTED BY	DATE
FIELD ENGINEER	DATE
VERIFICATION BY	DATE
CORRECTED BY	DATE
MICRO-FILM INFORMATION	
RECORDED BY	DATE
NO	

SURVEY INFORMATION	
FIELD NOTES	DATE
NO.	BY

BENCH MARKS	
CONTROL: TOM, APPROX. 712' SOUTH OF E. OF 1-40 FRONTAGE ROAD AND APPROX. 250' EAST OF E. OF ROSEWOOD PLACE, S.E. AT APPROX. STA. 7+76 STANDARD A.C.S. BRASS CAP STAMPED "TOM".	EL. 5711.67'

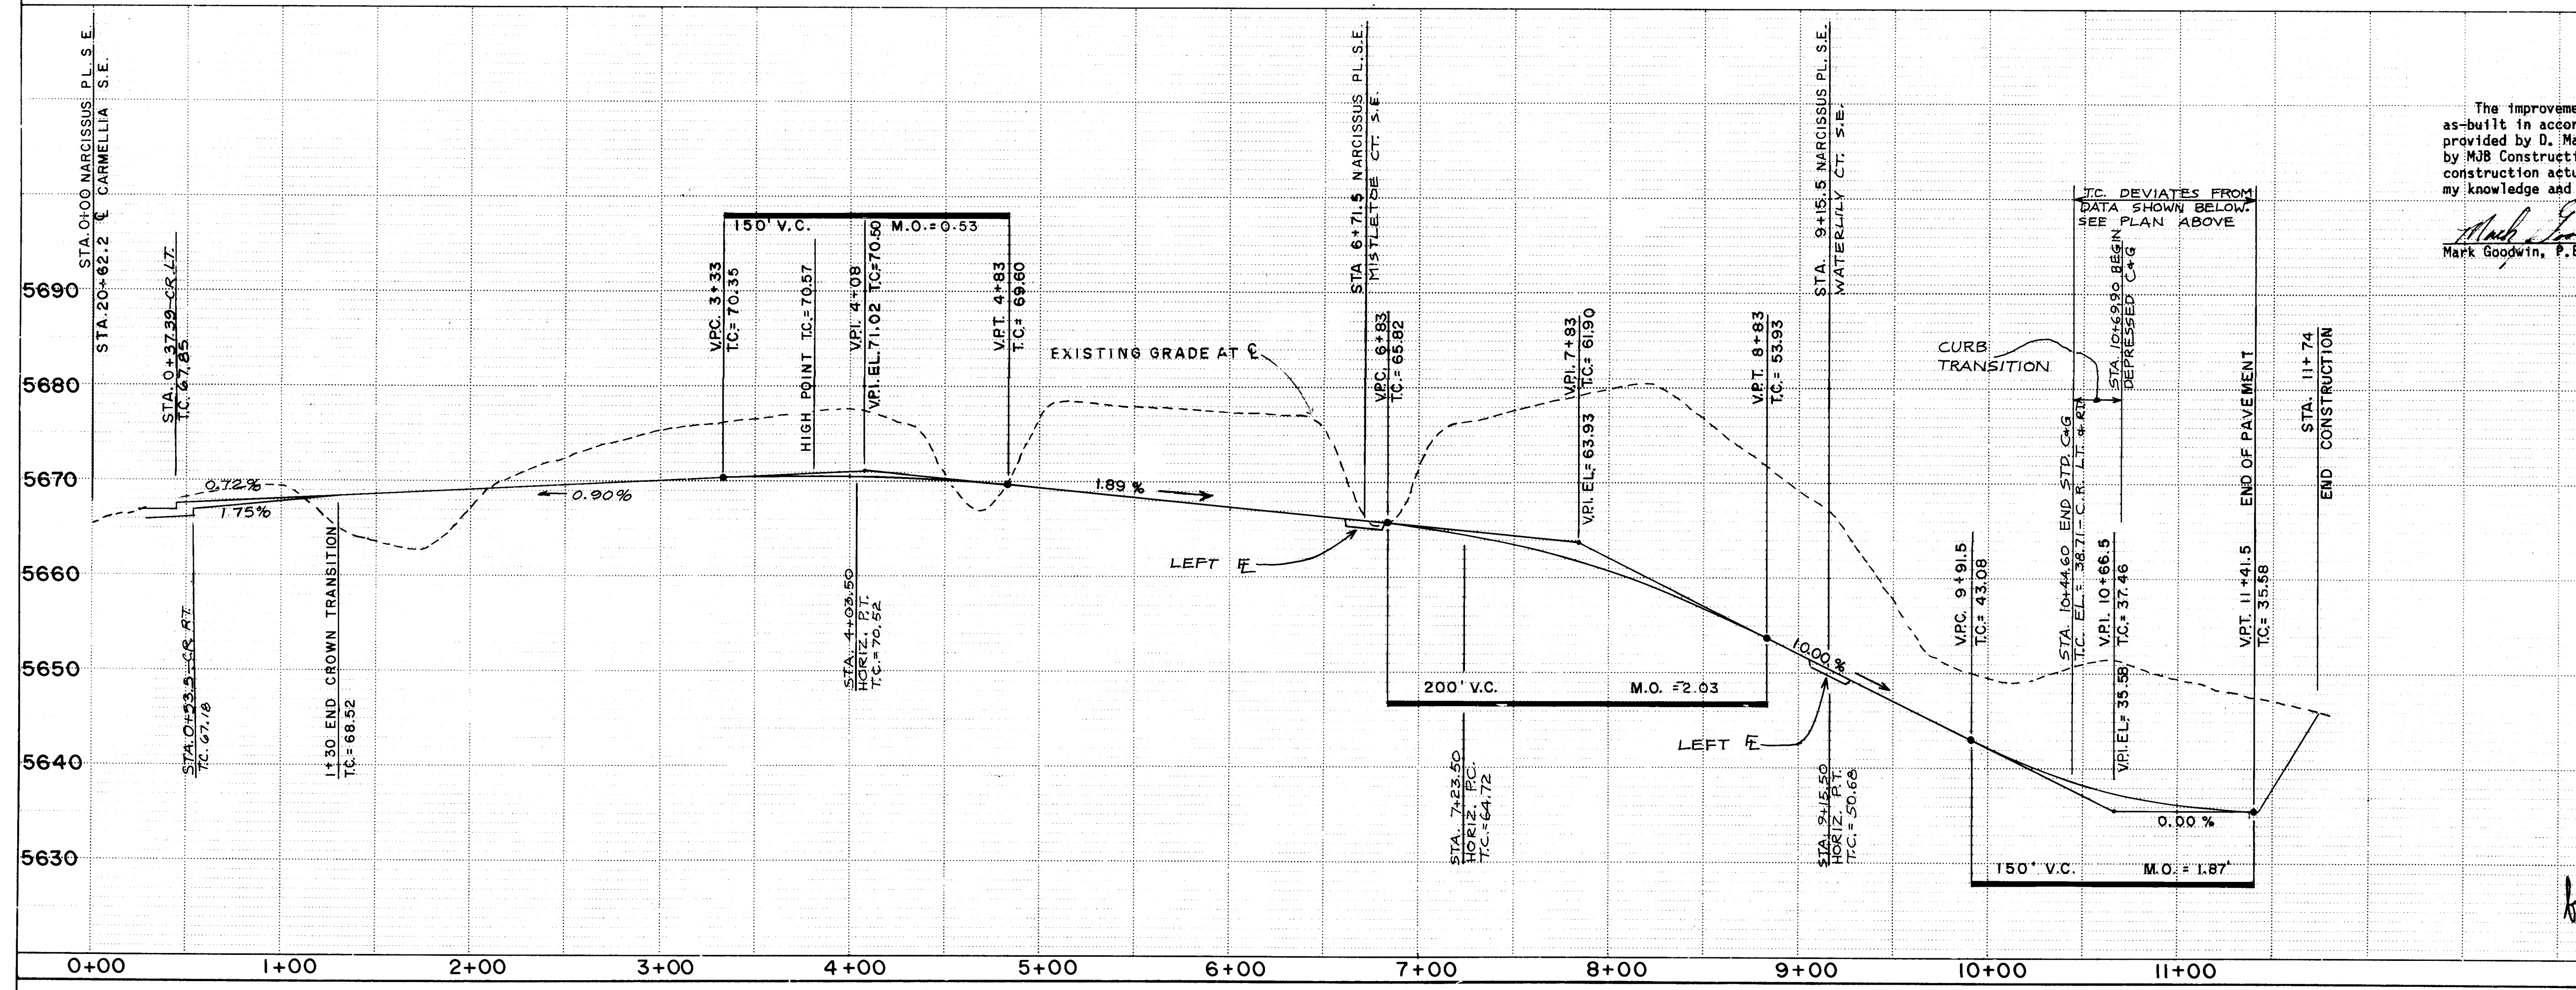

RECORD DRAWING

The improvements shown on this drawing have been as-built in accordance with field information provided by D. Mark Goodwin and Associates, PA, and by MJB Construction Company (Contractor) to reflect construction actually accomplished to the best of my knowledge and belief.

Mark Goodwin, P.E. 8948 Date 6/26/89




ENGINEER'S SEAL	
BY	REMARKS
NO	DATE

REVISIONS	
DESIGN	DATE
SD, ED	MAY 1983
SD, CM, FM	JAN 1985
ED	

CITY OF ALBUQUERQUE MUNICIPAL DEVELOPMENT DEPARTMENT ENGINEERING DIVISION					
TITLE: NORTH FOUR HILLS SUBDIVISION NARCISSUS PL PAVING PLAN & PROFILE					
APPROVALS	ENGINEER	DATE	APPROVALS	ENGINEER	DATE
City Engineer	<i>[Signature]</i>	2/13/97	Liquid Waste	N/A W/W	10/1/86
A.C.E. Design			Traffic	<i>[Signature]</i>	10/1/86
Hydrology	<i>[Signature]</i>	2/12/87	Water	N/A W/W	10/1/86

DRAWING NO.	2565	MAP NO.	L-23	SHEET	9	OF	22
-------------	------	---------	------	-------	---	----	----

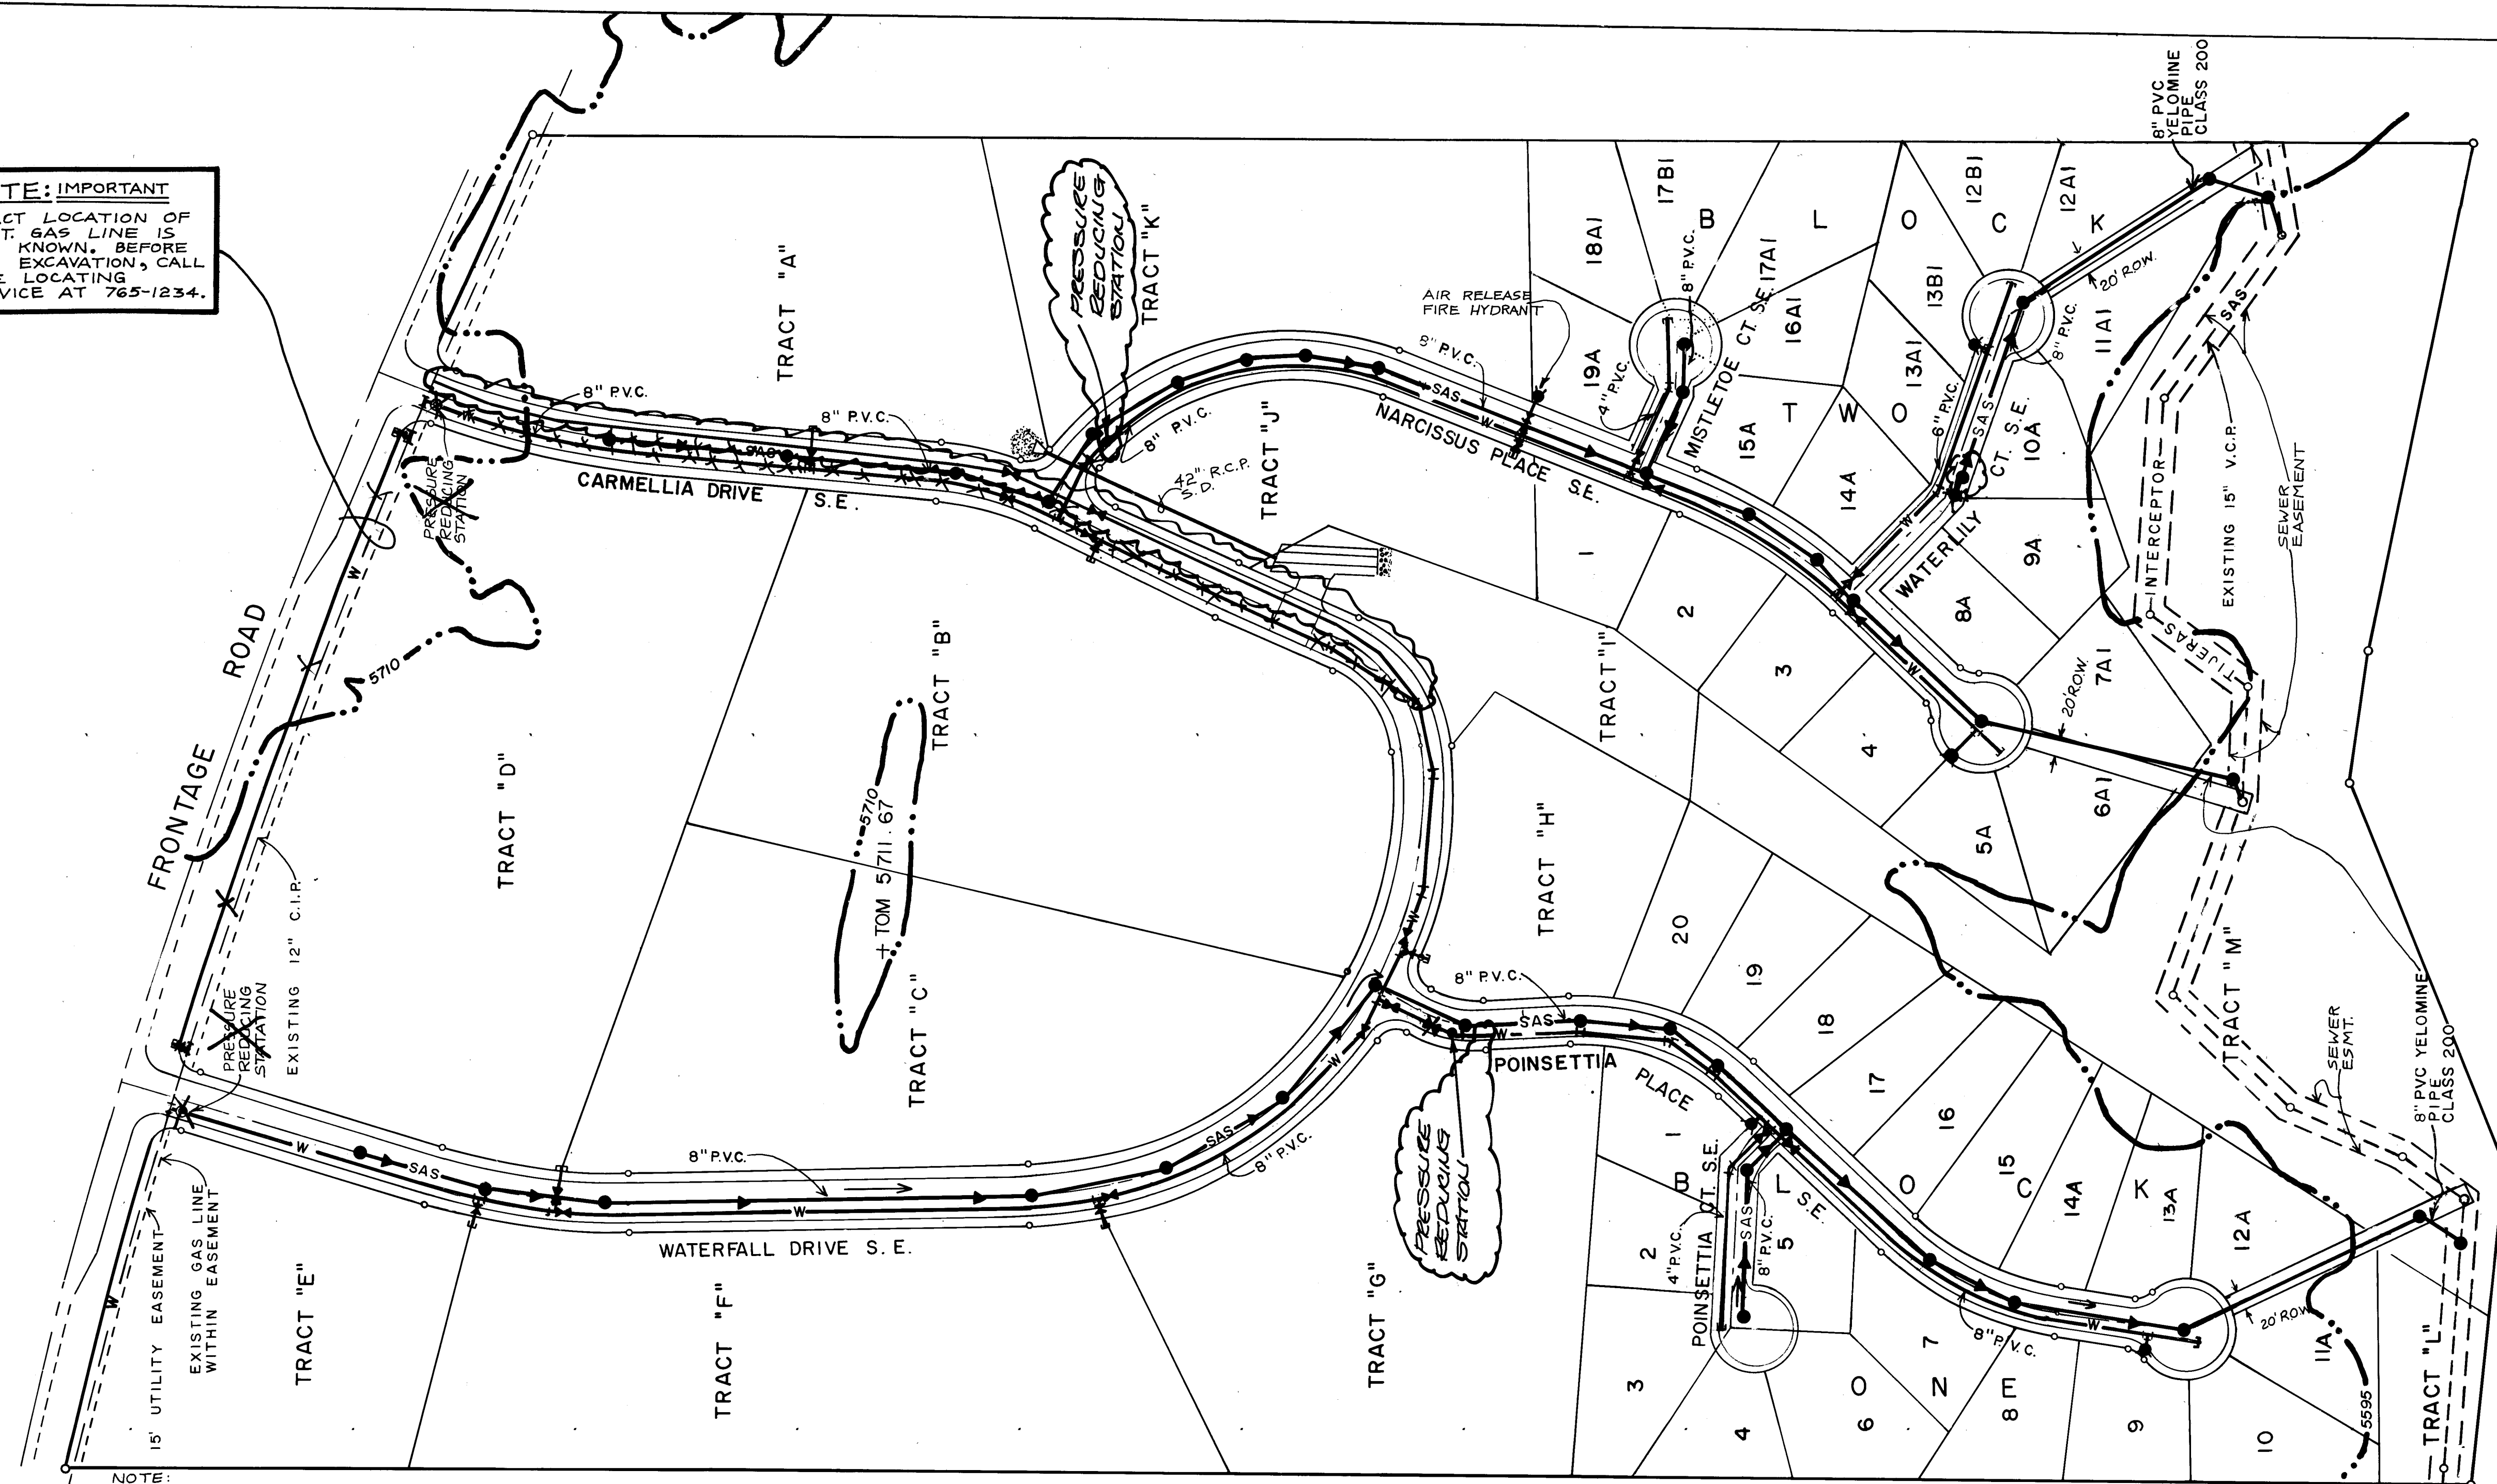

NOTE:
SEE GENERAL NOTES
PRIOR TO EXCAVATION
OF EXISTING UTILITIES




SCALE 1" = 100'

LEGEND

- | | |
|---|-------------------------------|
|  | NEW WATER LINES |
|  | EXISTING WATER LINES |
|  | FIRE HYDRANT |
|  | VALVE |
|  | NEW SANITARY SEWER LINES |
|  | EXISTING SANITARY SEWER LINES |
|  | SEWER MANHOLE |
|  | DIRECTION OF SEWER FLOW |
|  | EXISTING SEWER MANHOLE |
|  | WATER PRESSURE ZONE BOUNDARY |
|  | PRESSURE REDUCING STATION |

The improvements shown on this drawing have been as-built in accordance with field information provided by D. Mark Goodwin and Associates, PA, and by MJB Construction Company (Contractor) to reflect construction actually accomplished to the best of my knowledge and belief.

Mark Goodwin
Mark Goodwin, P.E. 8948

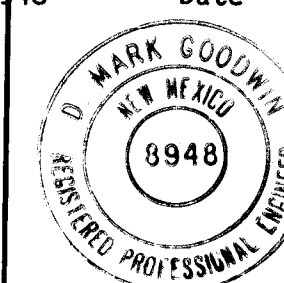

CITY OF ALBUQUERQUE
MUNICIPAL DEVELOPMENT DEPARTMENT
ENGINEERING DIVISION

TITLE: **MASTER WATER & SEWER PLAN**

APPROVALS	ENGINEER	DATE	APPROVALS	ENGINEER	DATE
City Engineer	<i>[Signature]</i>	2/12/87	Liquid Waste	<i>[Signature]</i>	10/1/86
ACE-Design	" "	"	Traffic	<i>[Signature]</i>	10/1/86
ACE-Hydrology	<i>[Signature]</i>	2/2/87	Water	<i>[Signature]</i>	9/1/86


DRAWING NO.	2565	MAP NO.	L-23	SHEET	11	OF	22
-------------	------	---------	------	-------	----	----	----

NOTE: IMPORTANT
EXACT LOCATION OF
EXIST. GAS LINE IS
NOT KNOWN. BEFORE
ANY EXCAVATION, CALL
LINE LOCATING
SERVICE AT 765-1234.

SCALE 1" = 50'

NOTE: SHUT DOWN AND CONNECTION TO EXISTING WATER
LINE SHALL BE COORDINATED THROUGH CITY OF ALBUQUERQUE
WATER SYSTEMS DIVISION - 823-4250

SEE GENERAL NOTES PRIOR TO ANY
EXCAVATION OF EXISTING UTILITIES

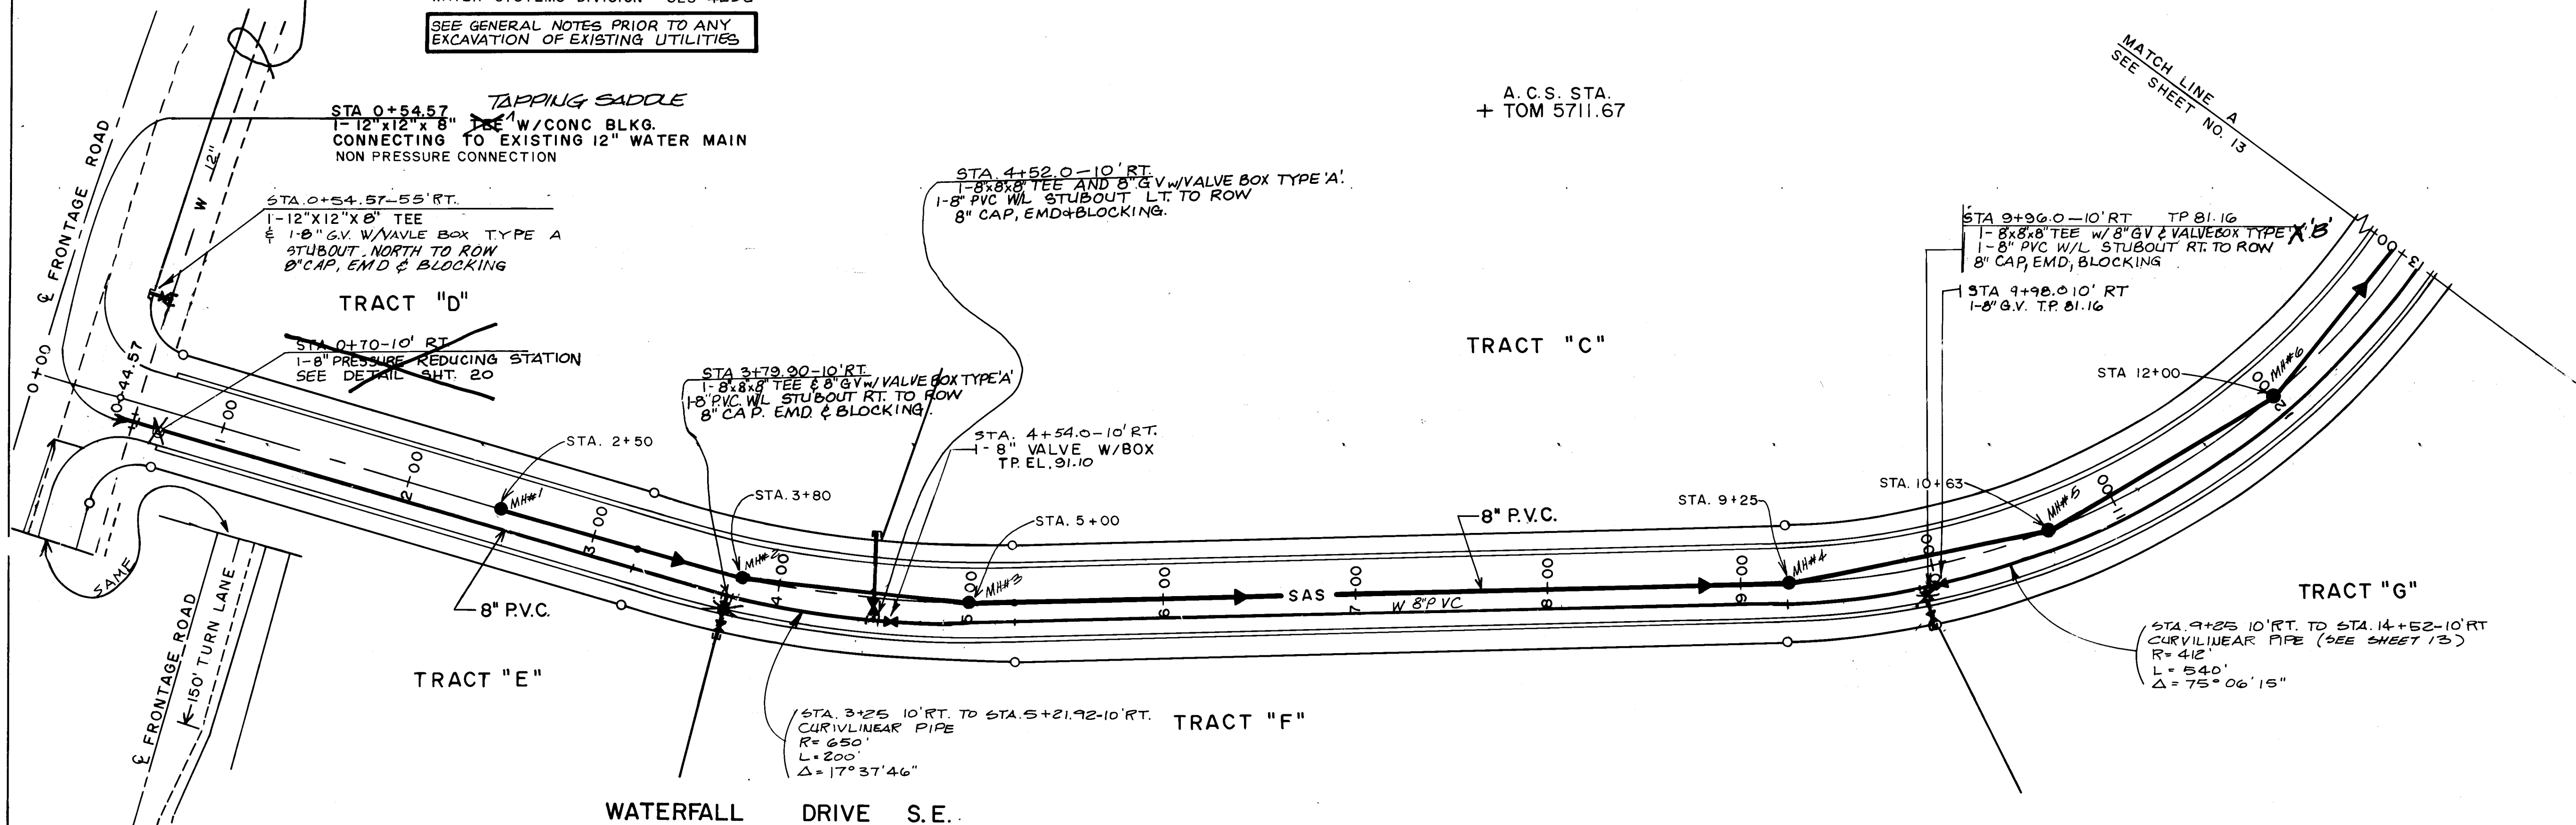

LEGEND	
—W—	WATER LINE
	WATER SERVICE CONNECTION
	FIRE HYDRANT
	VALVE BOX
	GATE VALVE
—SD—	STORM DRAIN LINE
	PROPOSED STORM DRAIN MANHOLE
—SAS—	SANITARY SEWER LINE
	SAS SERVICE CONNECTION
	EXISTING SEWER MANHOLE
	PROPOSED SEWER MANHOLE
T.P. EL.	TOP OF PIPE ELEVATION
FL. EL.	FLANGE ELEVATION


GENERAL NOTE:
WATERLINE SHALL BE 5' MIN.
FROM FACE OF CURB.

SEE NOTES SHEET 11

RECORD DRAWING

The improvements shown on this drawing have been
as-built in accordance with field information
provided by D. Mark Goodwin and Associates, PA, and
by MJB Construction Company (Contractor) to reflect
construction actually accomplished to the best of
my knowledge and belief.

Mark Goodwin, P.E. 8948 Date 6/26/89

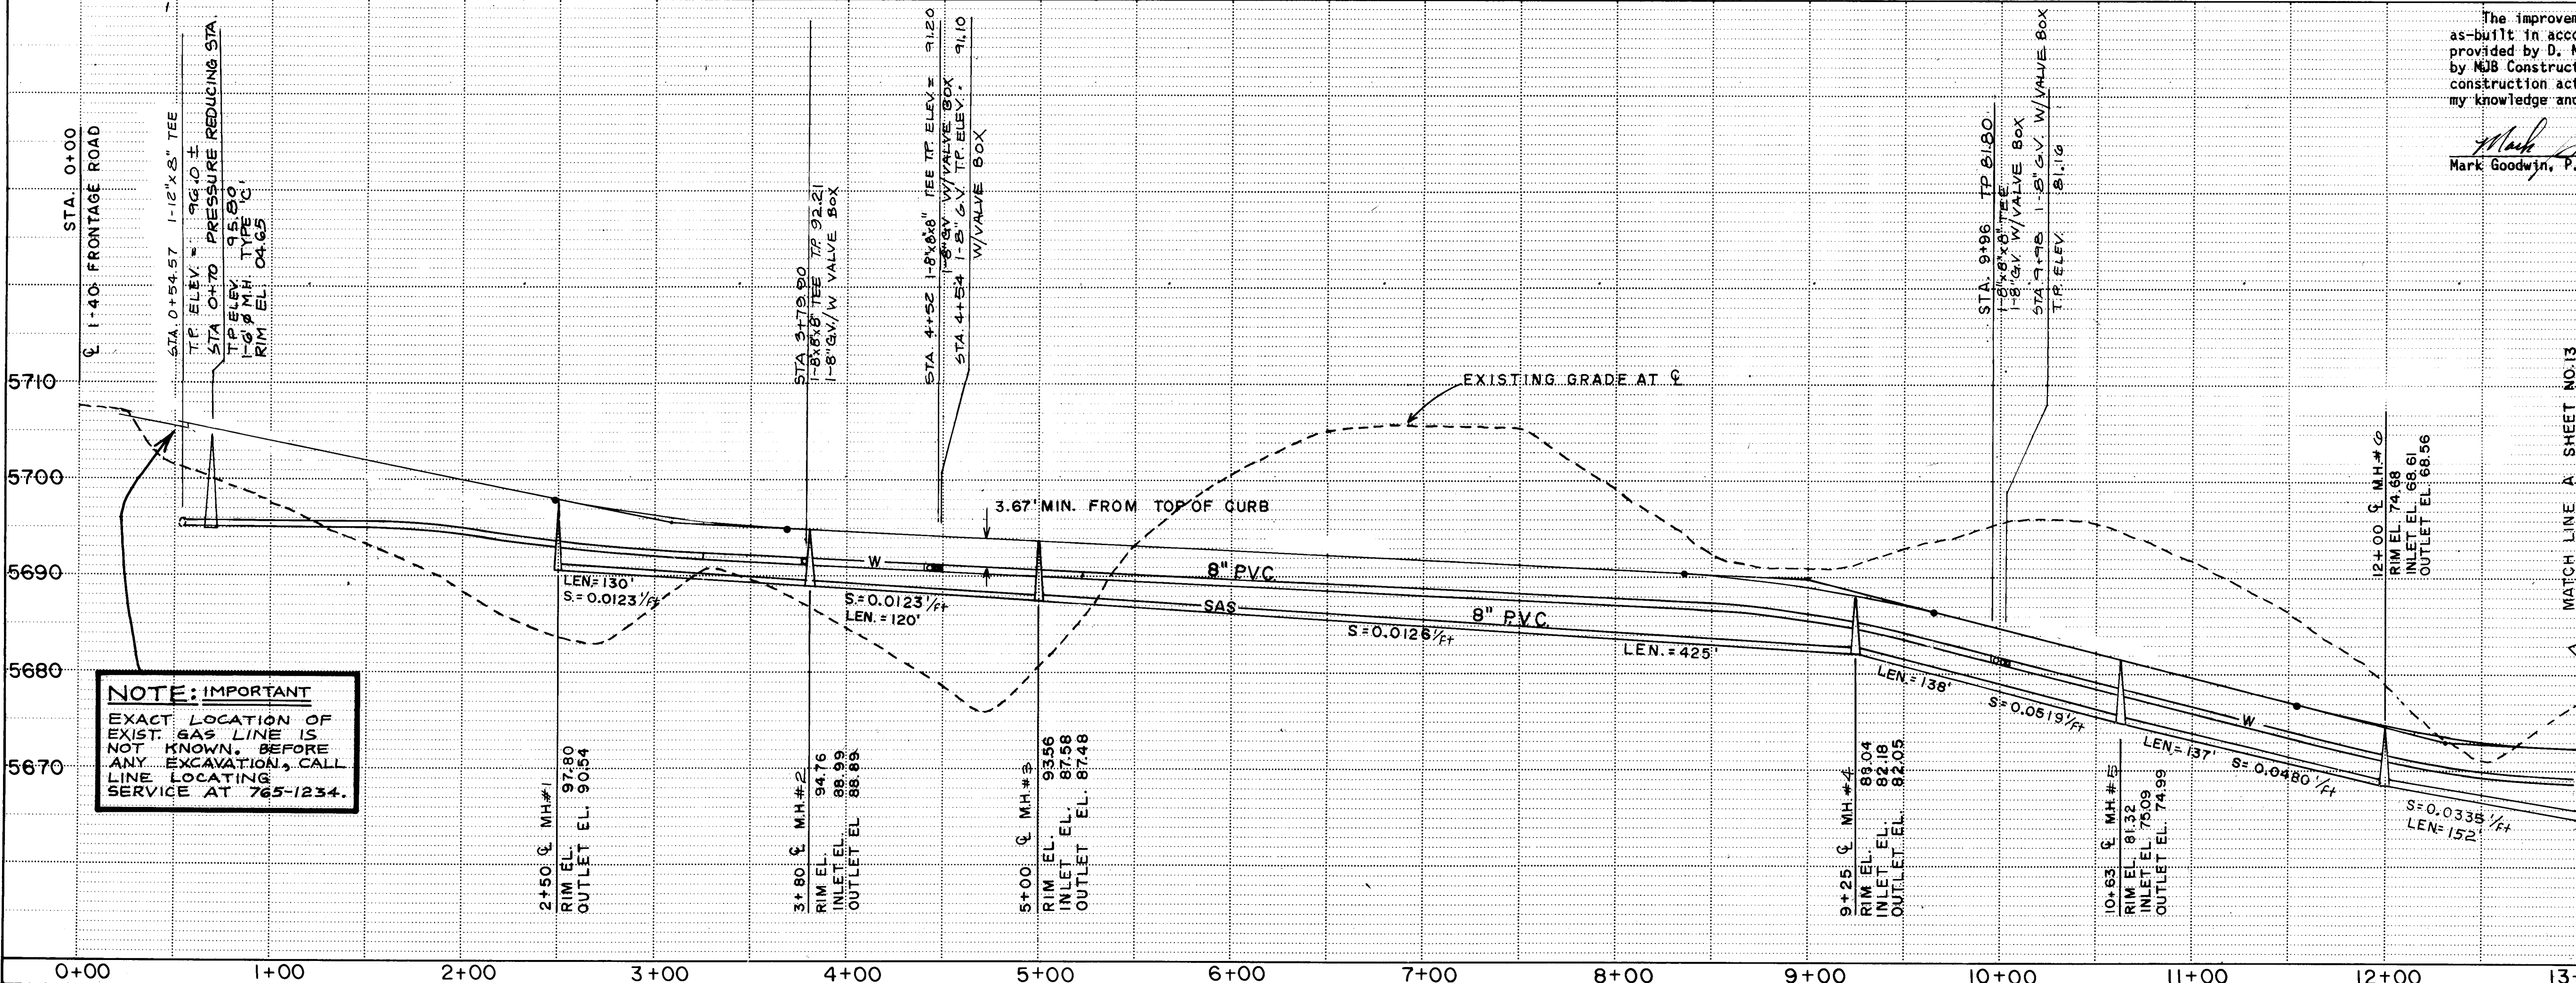


NOTE: IMPORTANT
EXACT LOCATION OF
EXIST. GAS LINE IS
NOT KNOWN. BEFORE
ANY EXCAVATION, CALL
LINE LOCATING
SERVICE AT 765-1234.



NO.	DATE	REVISIONS
1	2/5/87	DESIGN
2	5/6/87	DESIGN
3	6/5/87	DESIGN
4	1/28/89	DESIGN

CITY OF ALBUQUERQUE MUNICIPAL DEVELOPMENT DEPARTMENT ENGINEERING DIVISION			
TITLE: WATERFALL DRIVE UTILITIES PLAN & PROFILE			
APPROVALS	ENGINEER	DATE	APPROVALS
City Engineer	Mark Goodwin	2/13/87	Liquid Waste
A.C.E. Design	Mark Goodwin	2/13/87	Traffic
A.C.E. Hydrology	Mark Goodwin	2/13/87	Water
DRAWING NO. 2565		MAP NO. L-23	SHEET 12 OF 22

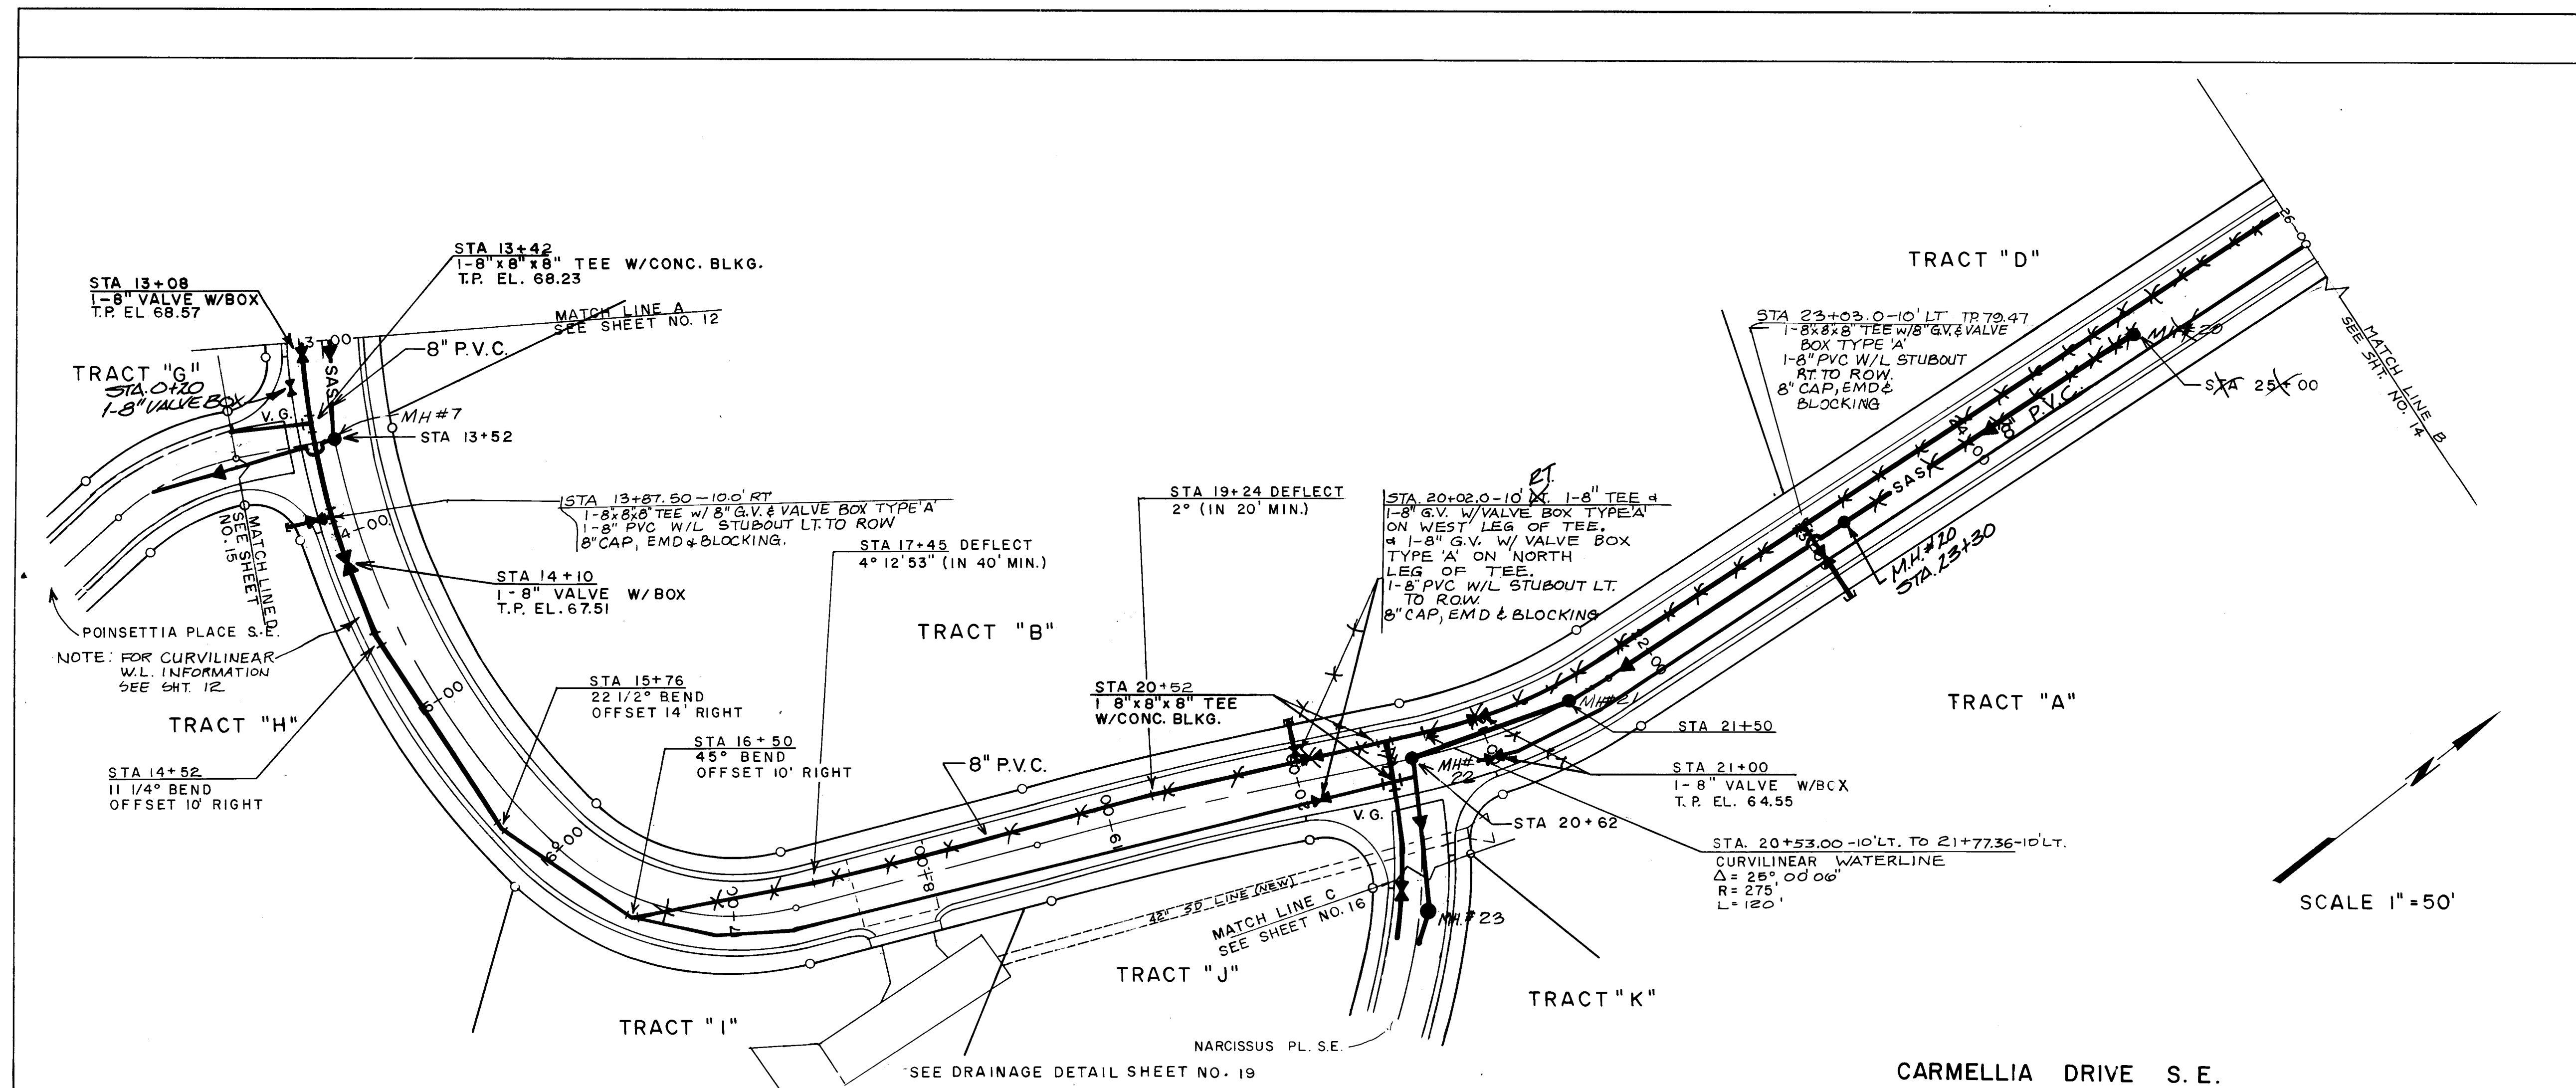

LEGEND

W	WATER LINE
	WATER SERVICE CONNECTION
	FIRE HYDRANT
	VALVE BOX
	GATE VALVE
SD	STORM DRAIN LINE
	PROPOSED STORM DRAIN MANHOLE
SAS	SANITARY SEWER LINE
	SAS SERVICE CONNECTION
	EXISTING SEWER MANHOLE
	PROPOSED SEWER MANHOLE
T.P. EL.	TOP OF PIPE ELEVATION
FL. EL.	FLANGE ELEVATION

GENERAL NOTE:

WATERLINE SHALL BE 5' MIN. FROM FACE OF CURB.

SEE NOTES SHEET 11

AS BUILT INFORMATION

CONTRACTOR	MJB Const. Co.
INSPECTOR	Tom, Inc.
DATE	6/89
APPROVED BY	MJB
DATE	6/89
VERIFIED BY	MJB
DATE	6/89
CORRECTED BY	MJB
DATE	6/89
RECORDED BY	MJB
DATE	6/89

SURVEY INFORMATION

FIELD NOTES	NO.	BY	DATE

ENGINEER'S SEAL

REMARKS

REVISIONS

NO.	DATE	REMARKS

DESIGNED BY SD, ED

DATE MAY 1983

DRAWN BY SD, CM, FM

DATE JAN 1985

CHECKED BY ED

DATE JAN 1985

CITY OF ALBUQUERQUE

MUNICIPAL DEVELOPMENT DEPARTMENT

ENGINEERING DIVISION

TITLE: CARMELLIA DRIVE UTILITIES PLAN & PROFILE


APPROVALS




ENGINEER	DATE	APPROVALS	ENGINEER	DATE
City Engineer	2/13/87	Liquid Waste	W. J. Johnson	10/1/86
A.C.E. Design		Traffic	PA Dwyer	10/1/86
A.C.E. Hydrology	N.A. 2/12/87	Water	W. J. Johnson	10/1/86

DRAWING NO. 2565

MAP NO. L-23

SHEET 13 OF 22

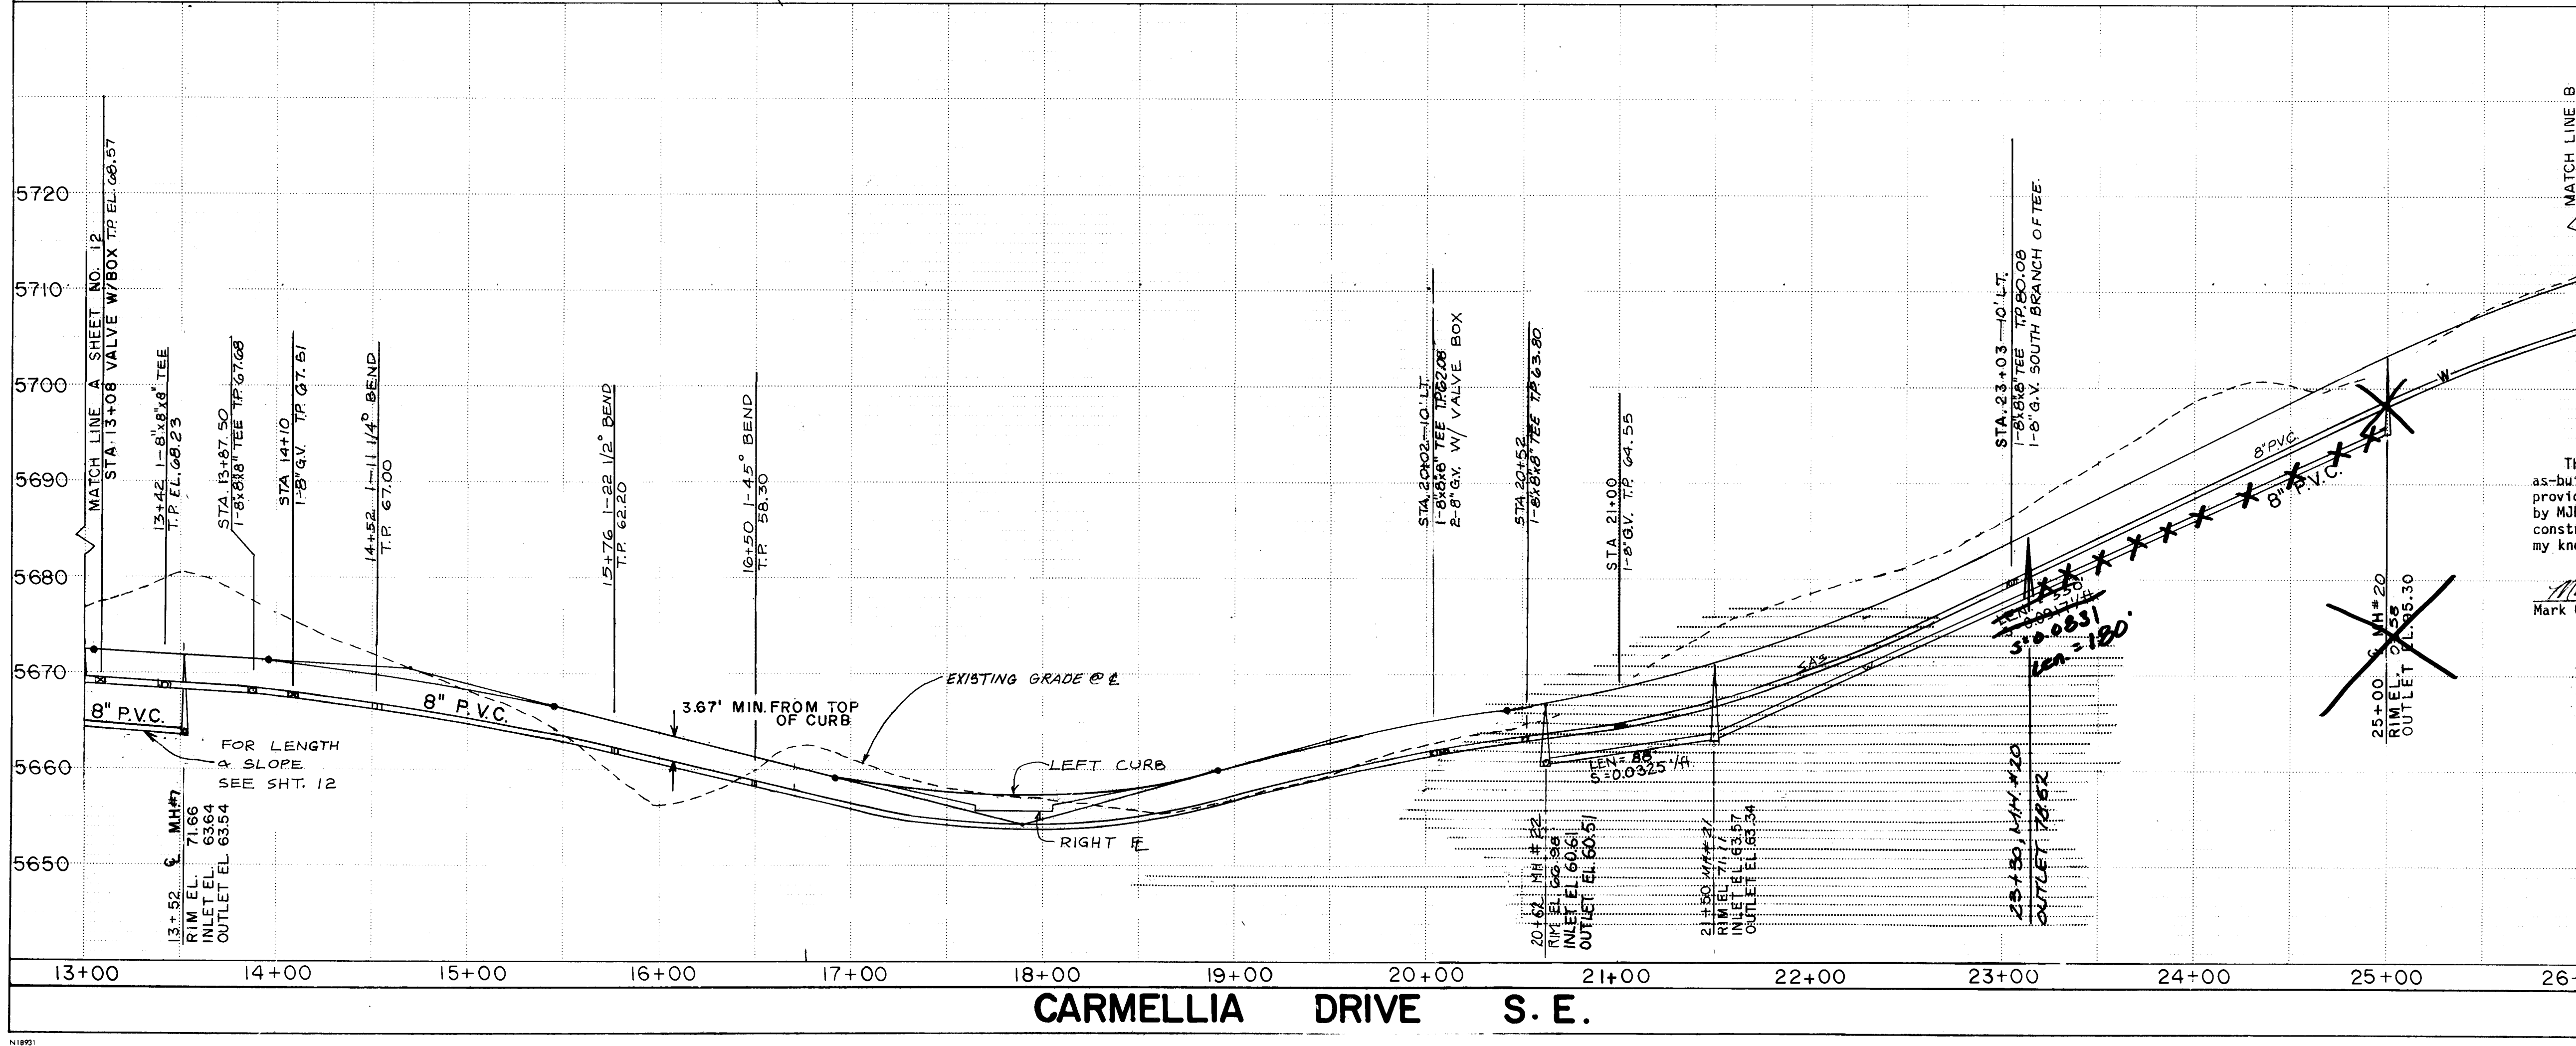

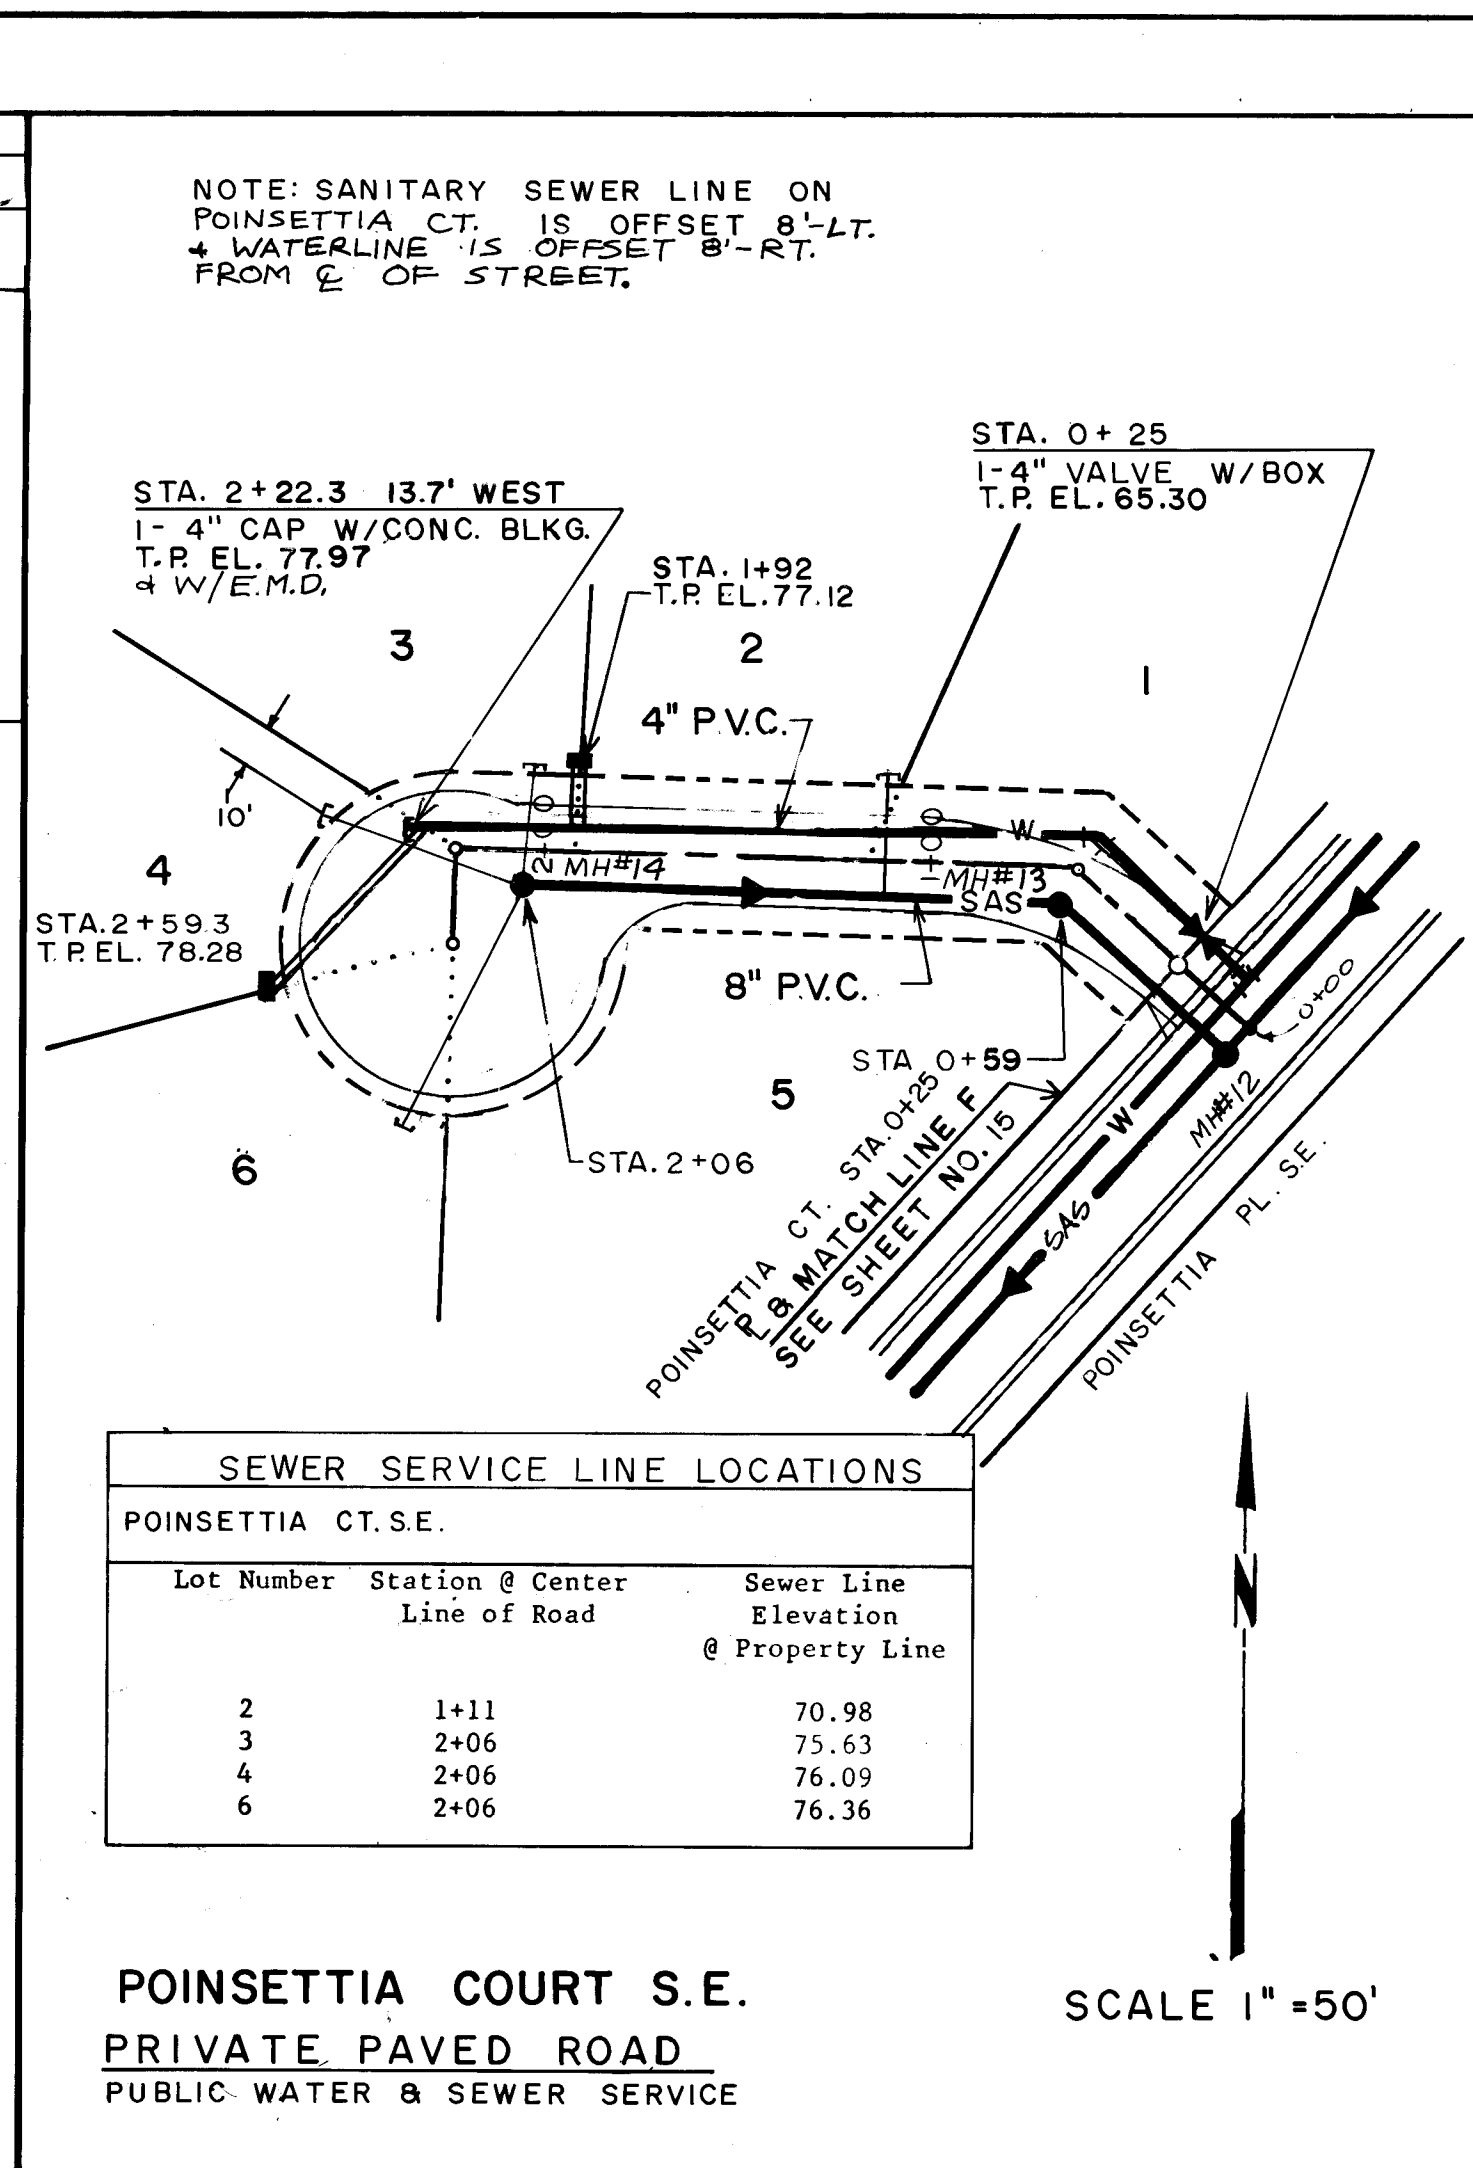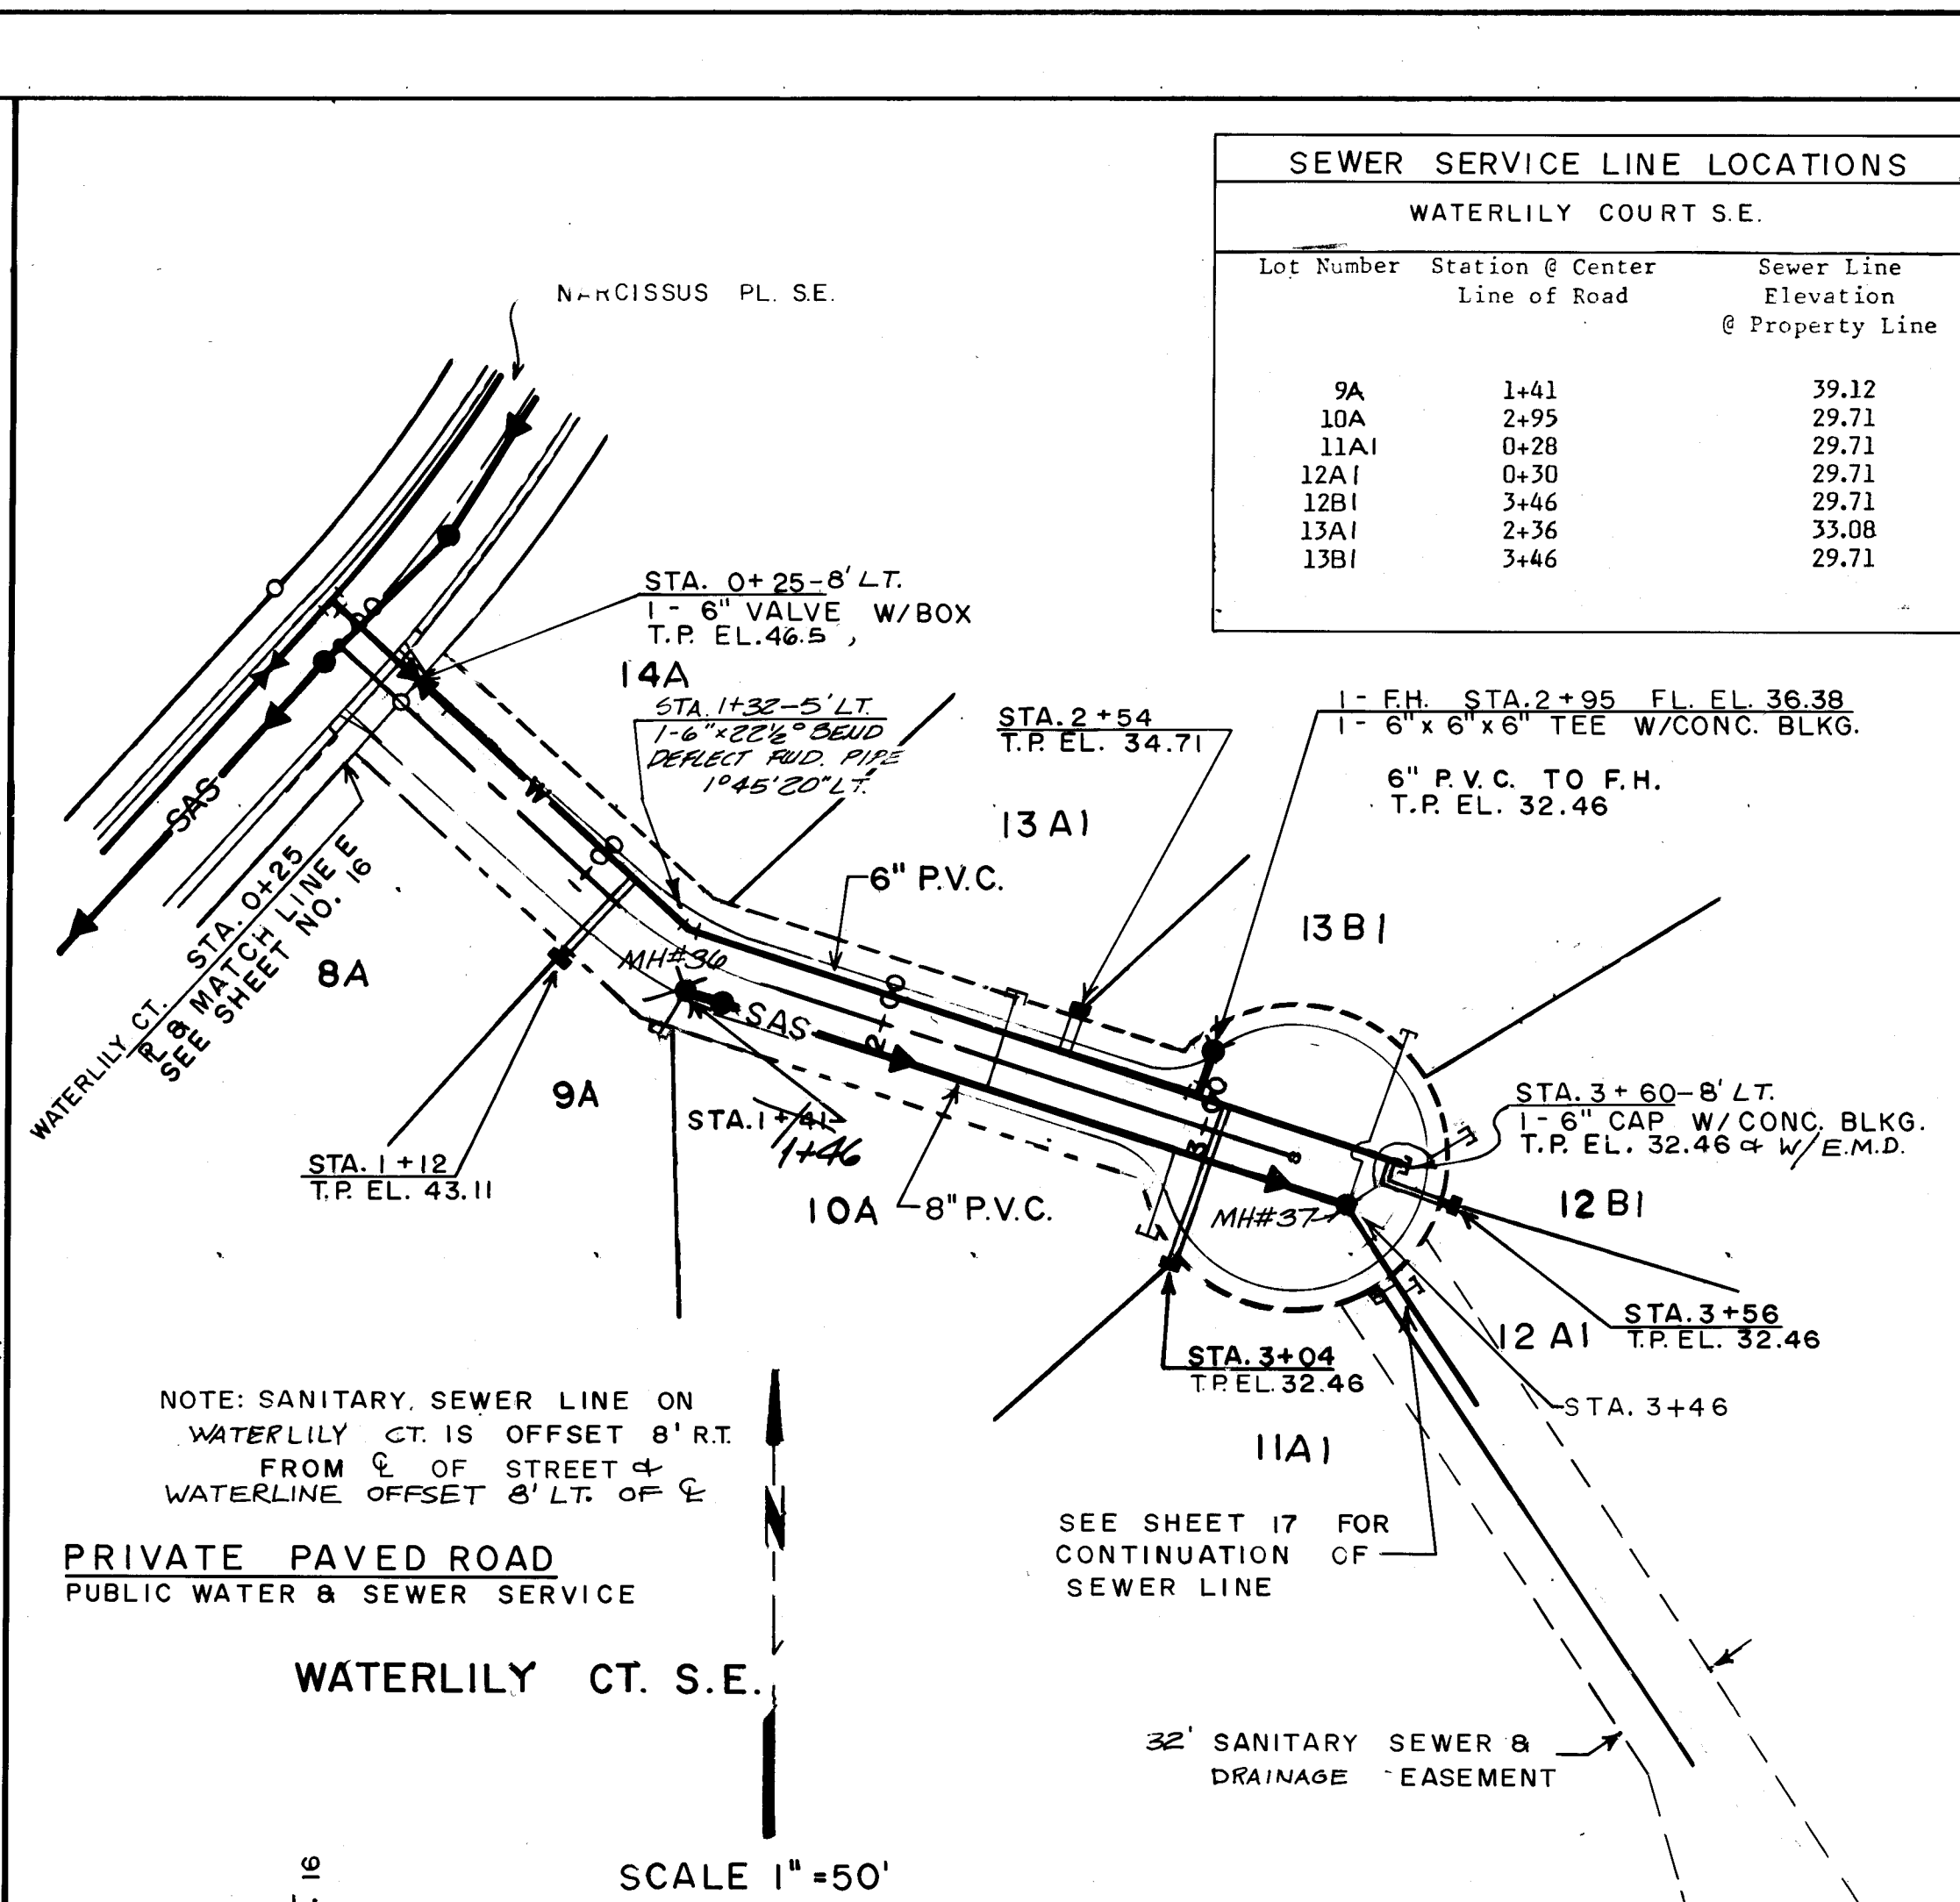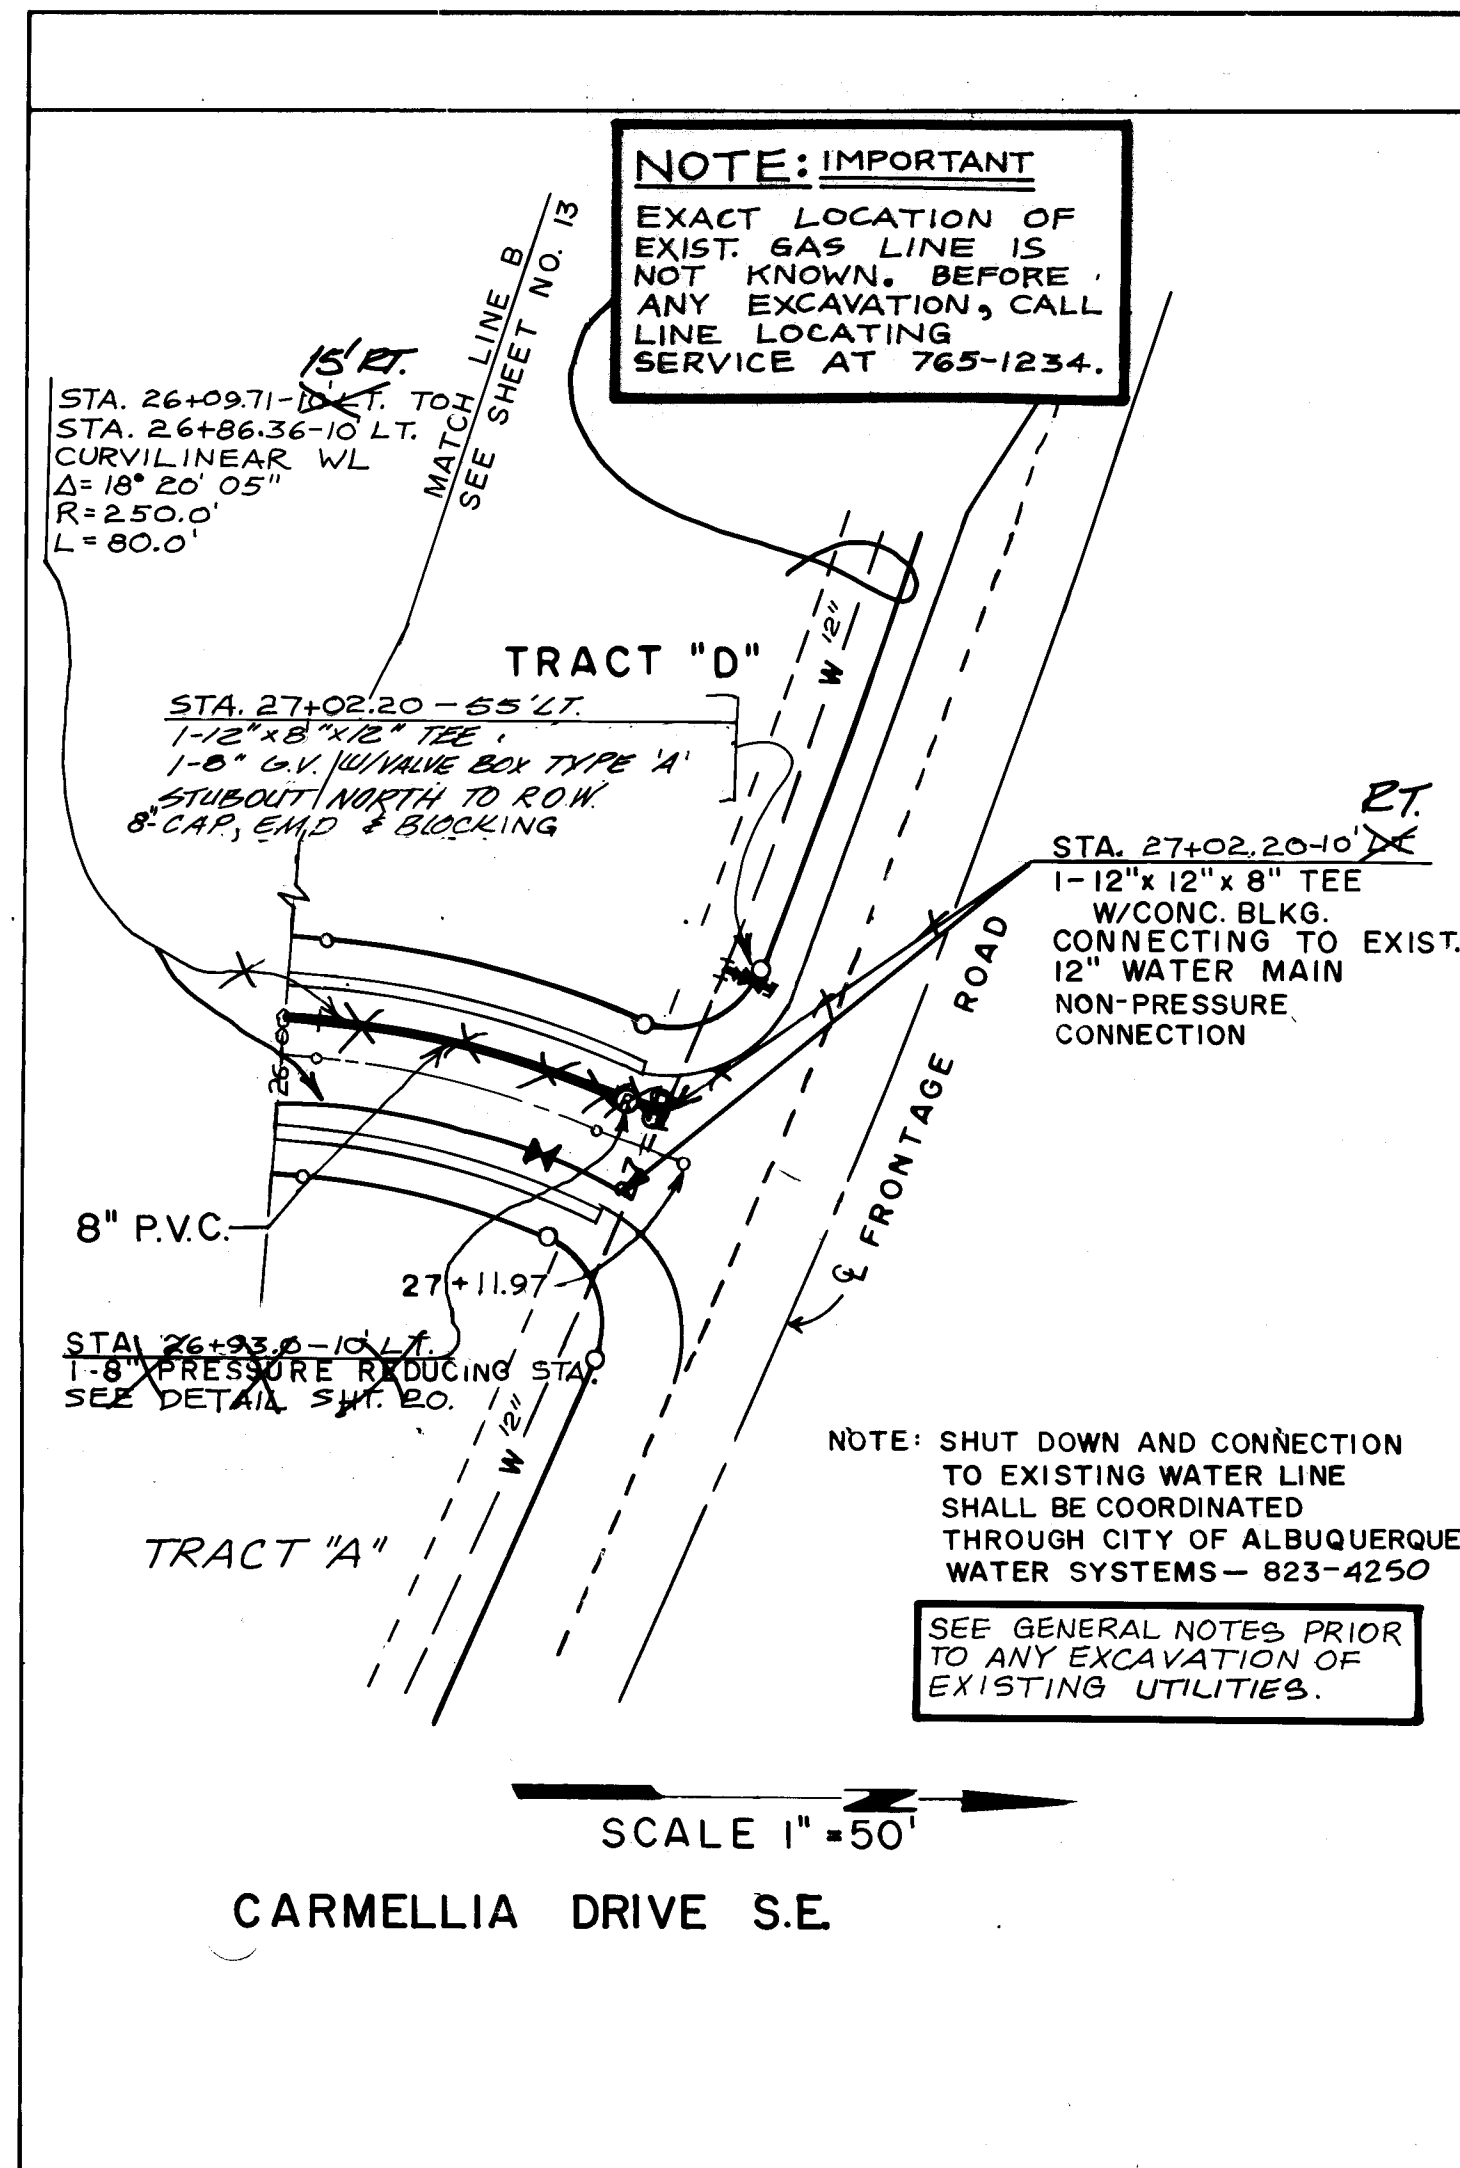

LEGEND

- W WATER LINE
- WATER SERVICE CONNECTION
- FIRE HYDRANT
- VALVE BOX
- GATE VALVE
- SD STORM DRAIN LINE
- PROPOSED STORM DRAIN MANHOLE
- SAS SANITARY SEWER LINE
- SAS SERVICE CONNECTION
- EXISTING SEWER MANHOLE
- PROPOSED SEWER MANHOLE
- T.P. EL. TOP OF PIPE ELEVATION
- FL. EL. FLANGE ELEVATION

GENERAL NOTE:
WATERLINE SHALL BE 5' MIN. FROM FACE OF CURB.

SEE NOTES SHEET II

AS BUILT INFORMATION




CONTRACTOR: MJB Const. Co.
DATE: 6/18/89
APPROVED BY: [Signature]
DATE: 6/18/89
FIELD CHECKED BY: [Signature]
DATE: 6/18/89
RECORDED BY: [Signature]
DATE: 6/18/89

ENGINEER'S SEAL

Mark Goodwin, P.E. 8948

DESIGNED BY: SD, ED
DRAWN BY: SD, CM, FM
CHECKED BY: ED

DATE MAY 1983
DATE JAN 1985
DATE JAN 1985

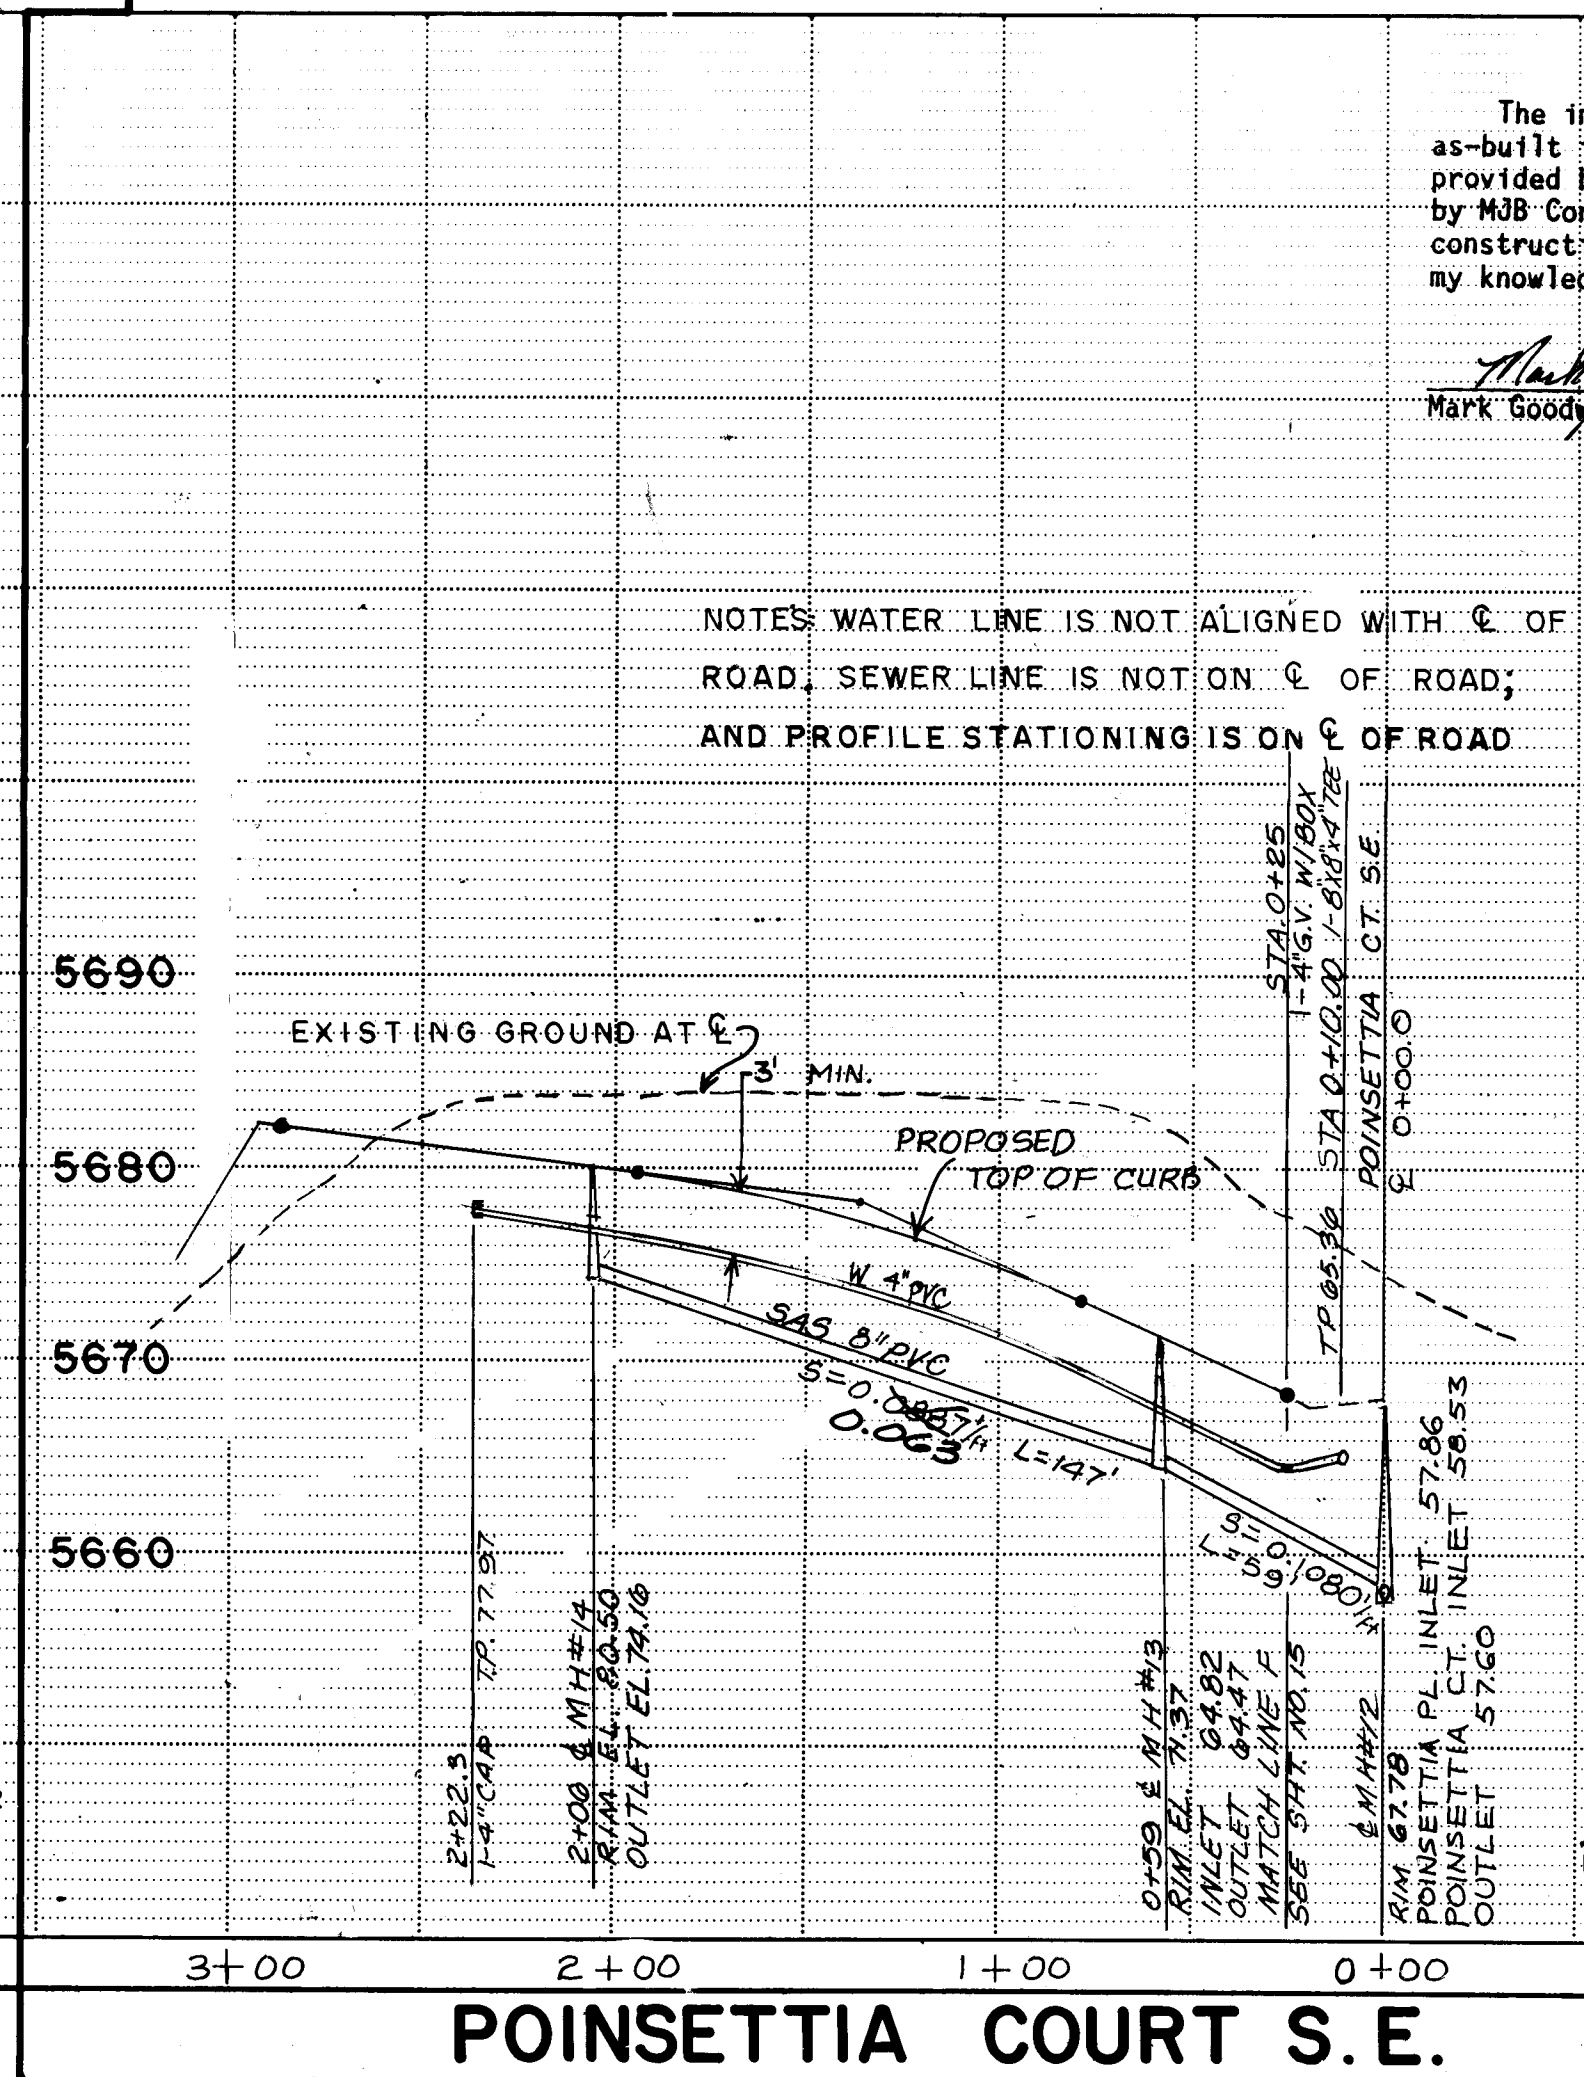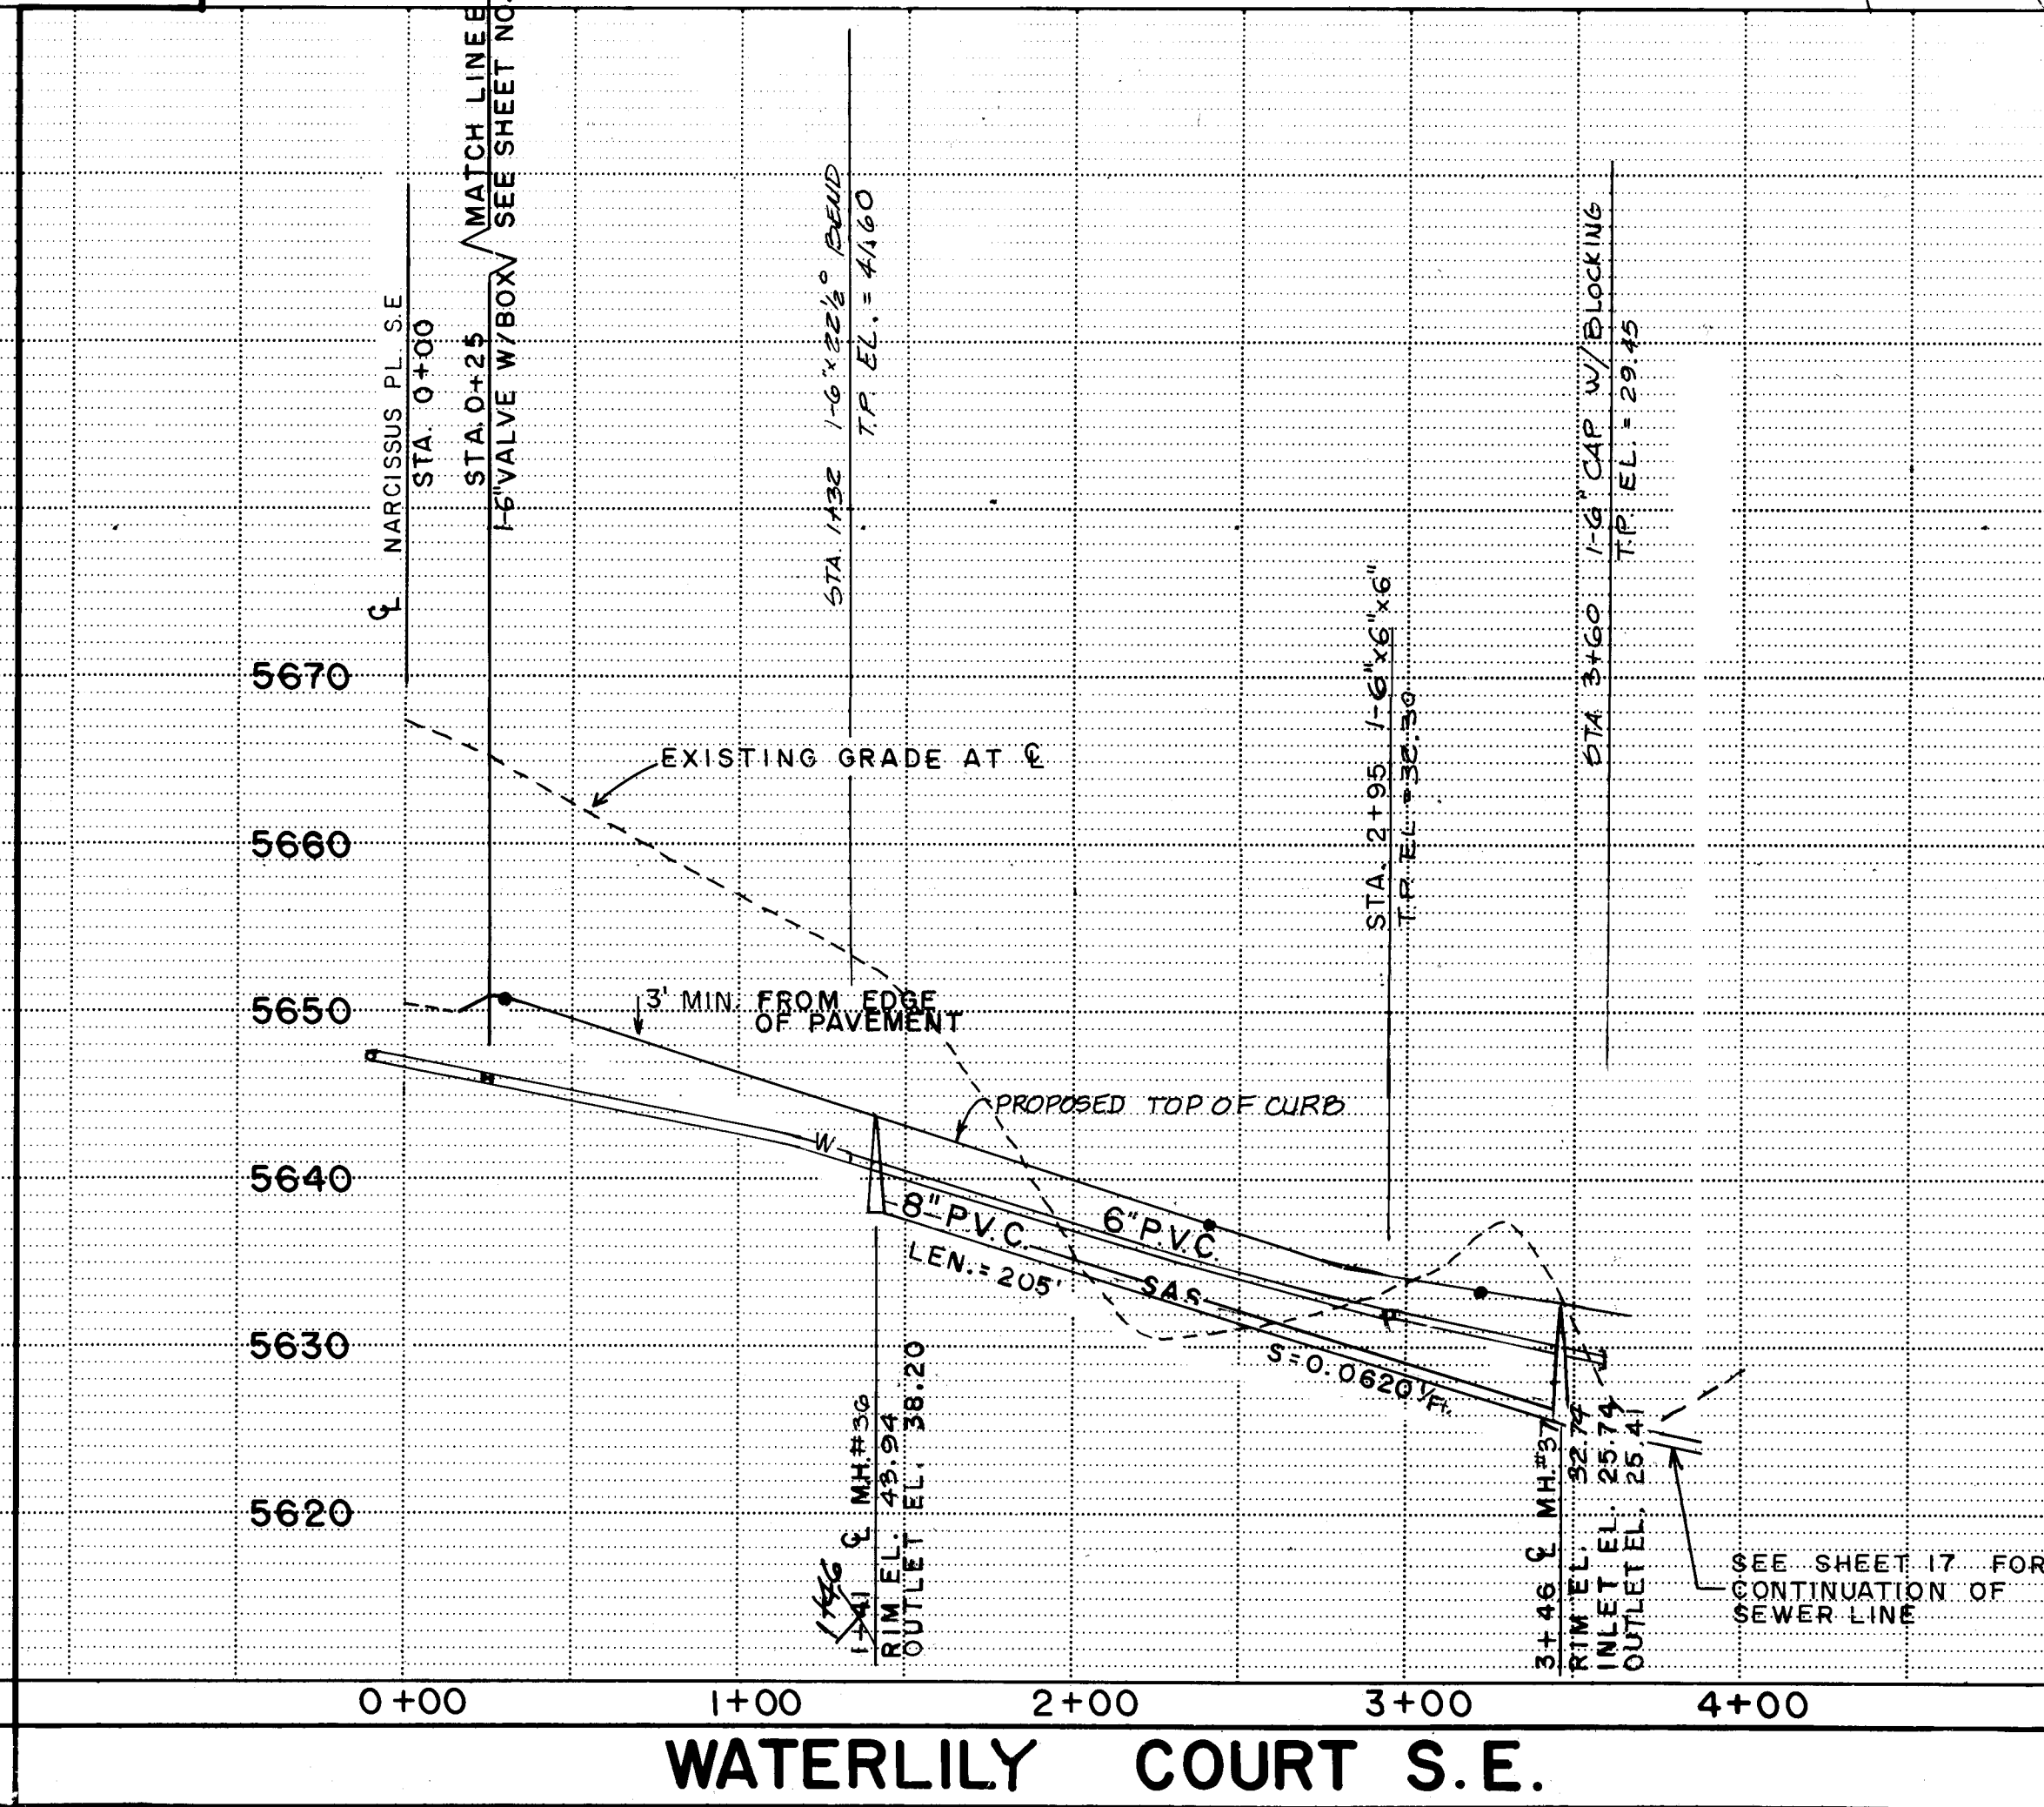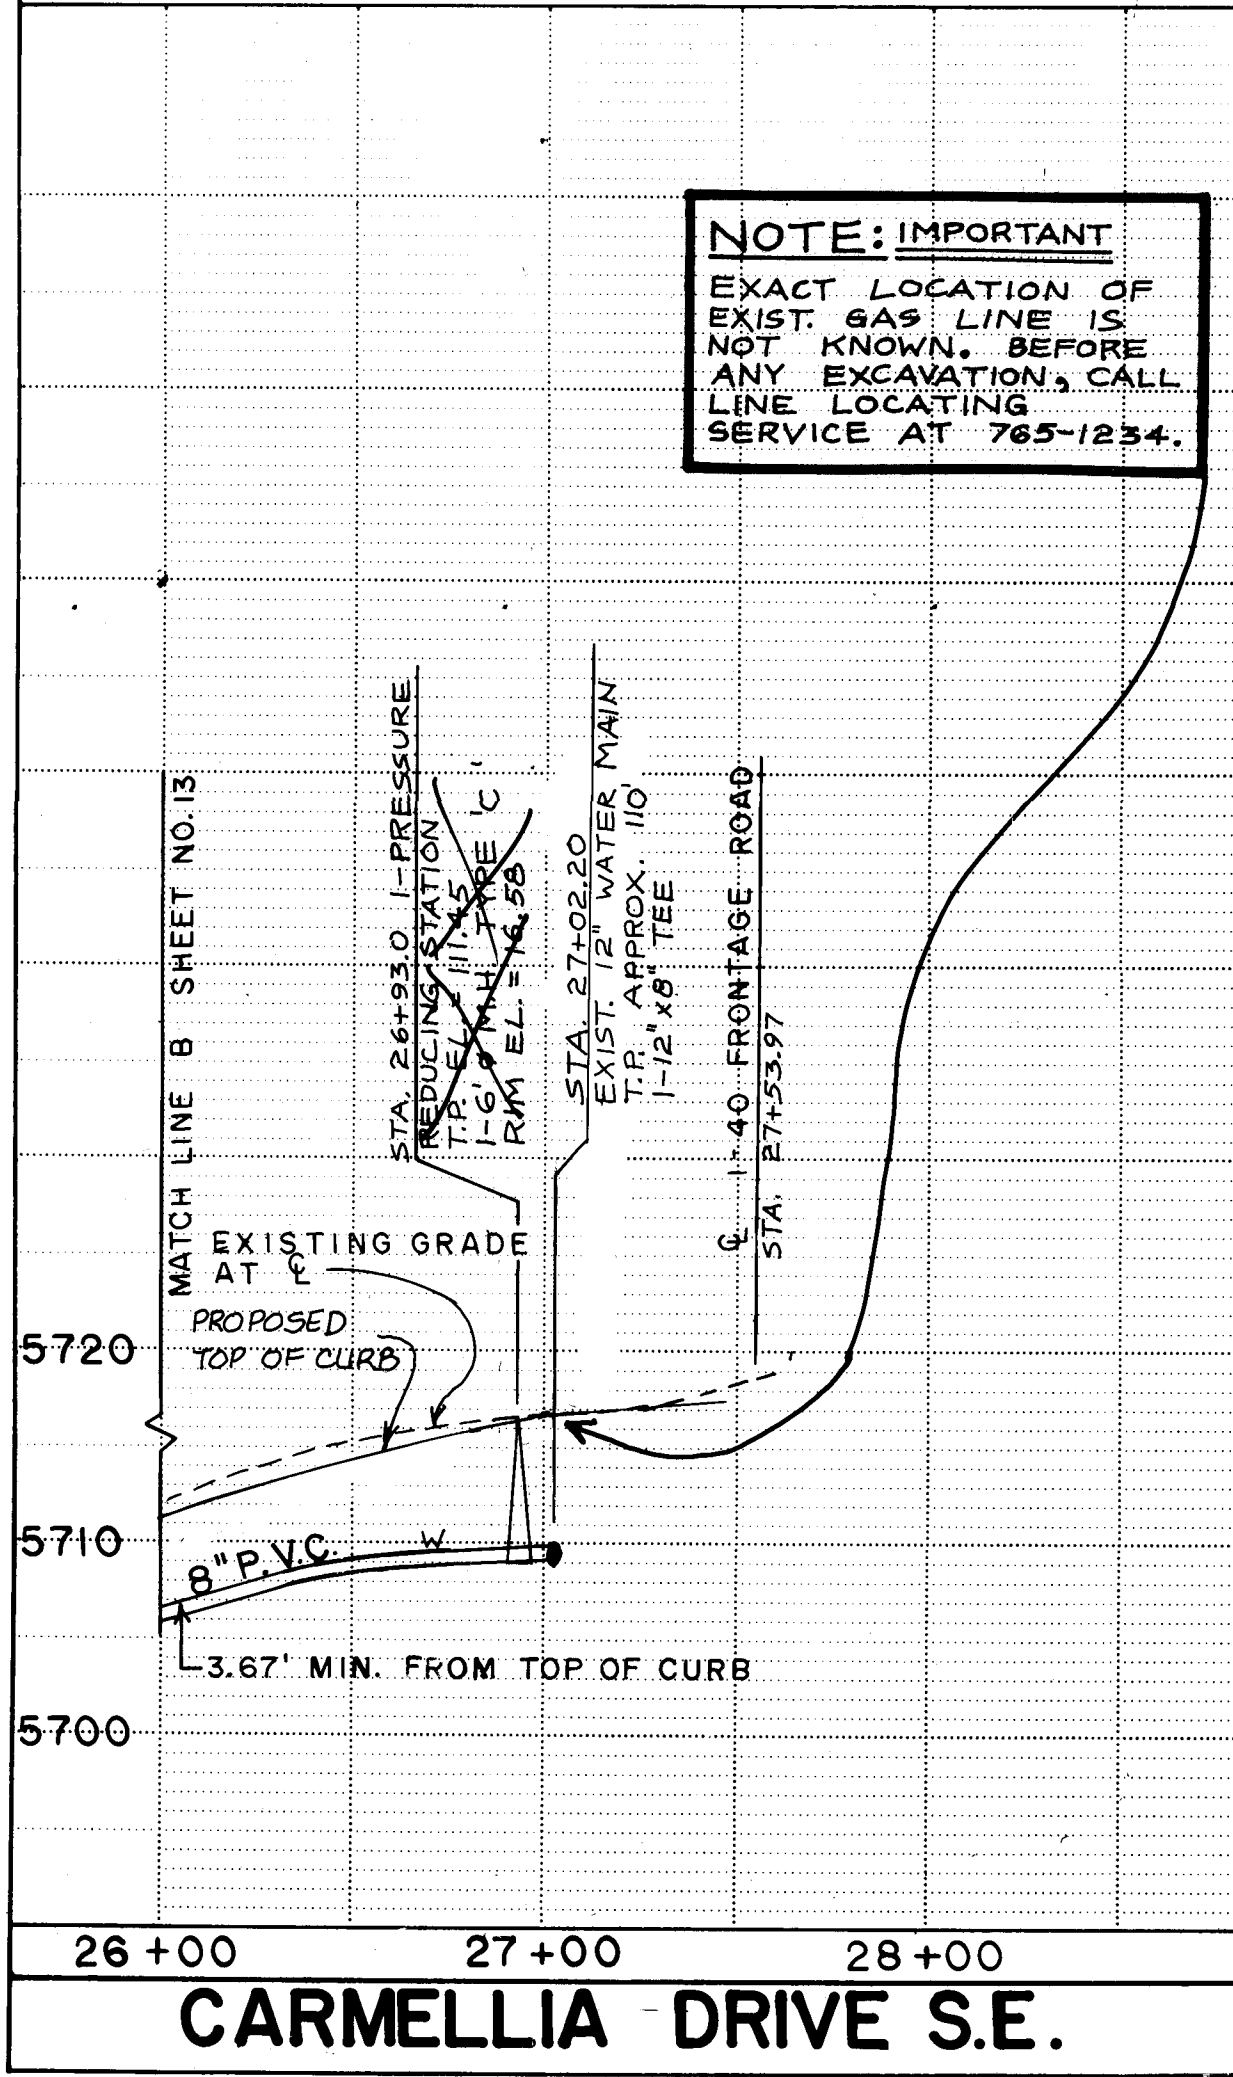

RECORD DRAWING

The improvements shown on this drawing have been as-built in accordance with field information provided by D. Mark Goodwin and Associates, PA, and by MJB Construction Company (Contractor) to reflect construction actually accomplished to the best of my knowledge and belief.

Mark Goodwin, P.E. 8948

DATE: 6/18/89

ENGINEER'S SEAL

Mark Goodwin, P.E. 8948

DESIGNED BY: SD, ED
DRAWN BY: SD, CM, FM
CHECKED BY: ED

DATE MAY 1983
DATE JAN 1985
DATE JAN 1985

CITY OF ALBUQUERQUE
MUNICIPAL DEVELOPMENT DEPARTMENT
ENGINEERING DIVISION


TITLE: CARMELLIA DR., WATERLILY CT. & POINSETTIA CT. UTILITIES PLAN & PROFILE

APPROVALS	ENGINEER	DATE	APPROVALS	ENGINEER	DATE
City Engineer	[Signature]	2/13/87	Liquid Waste	[Signature]	10/1/86
ACE - Design	[Signature]		Traffic	[Signature]	10/1/86
Hydrology	[Signature]	2/13/87	Water	[Signature]	10/1/86

DRAWING NO. 2565

MAP NO. L-23

SHEET 14 OF 22

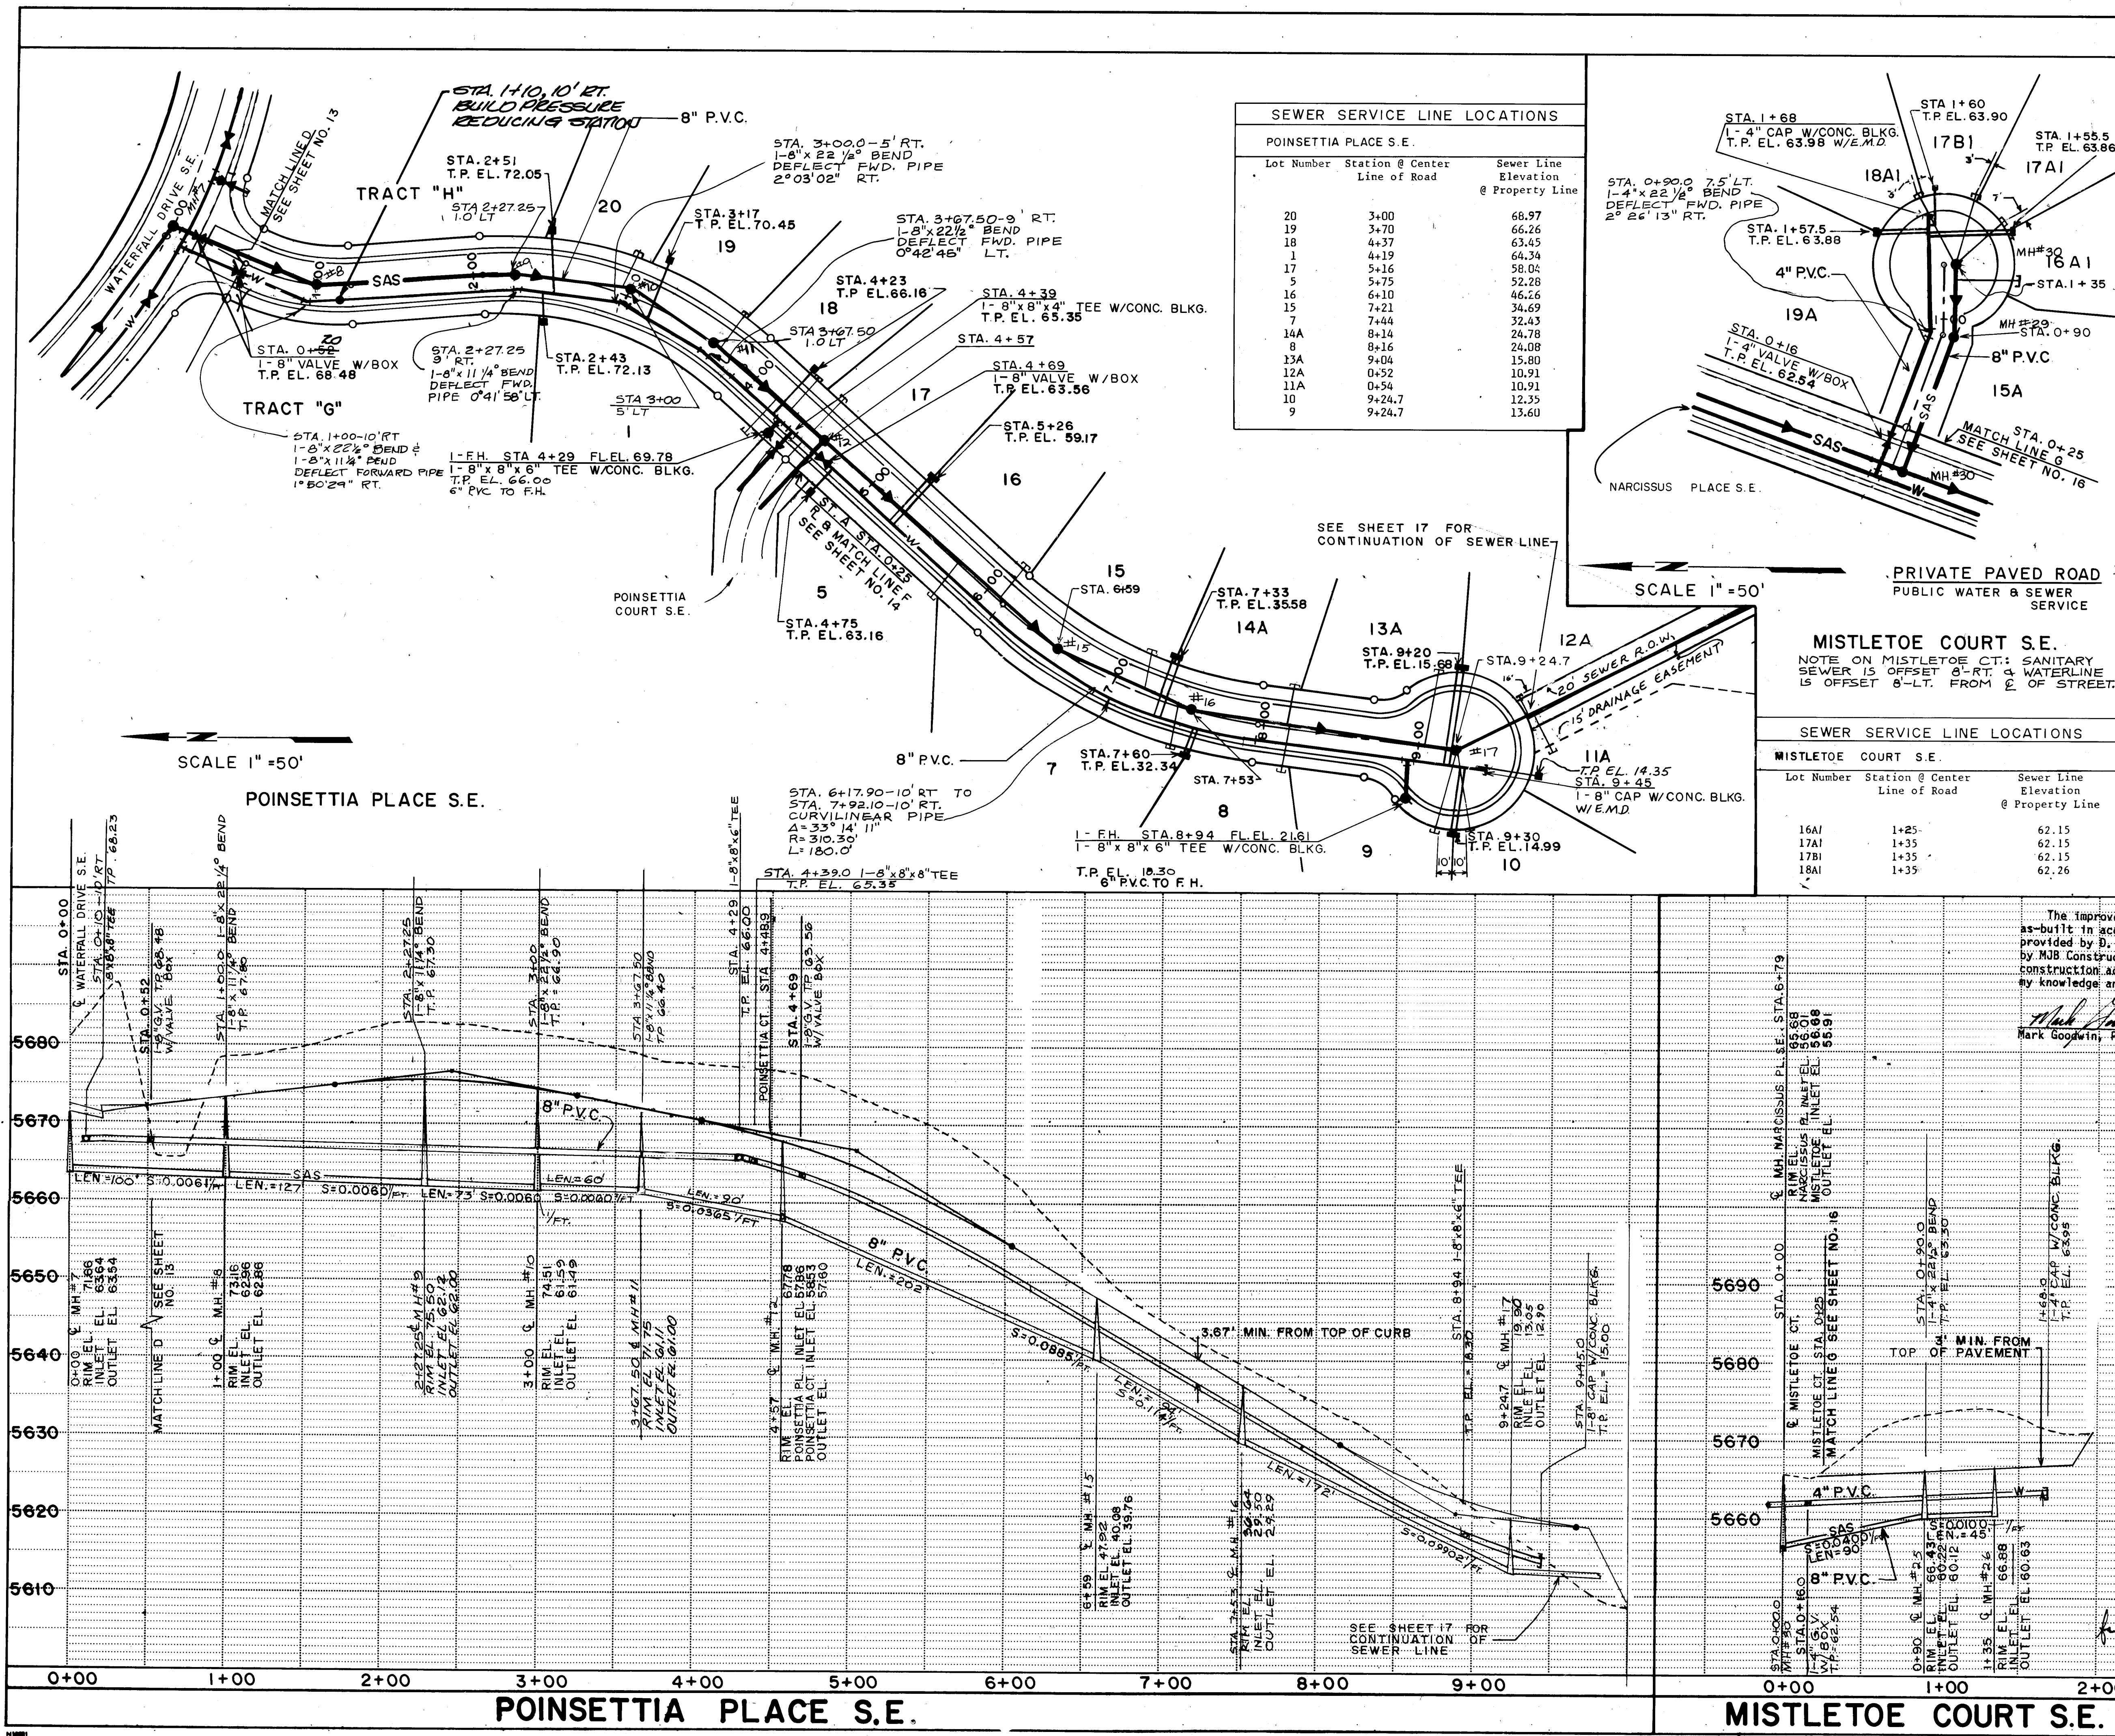

LEGEND

W

WATER LINE

W

WATER SERVICE CONNECTION

W

FIRE HYDRANT

W

VALVE BOX

W

GATE VALVE

SD

STORM DRAIN LINE

SD

PROPOSED STORM DRAIN MANHOLE

SAS

SANITARY SEWER LINE

SAS

SAS SERVICE CONNECTION

EXISTING SEWER MANHOLE

PROPOSED SEWER MANHOLE

T.P. EL.

TOP OF PIPE ELEVATION

FL. EL.

FLANGE ELEVATION

GENERAL NOTE:

WATERLINE SHALL BE 5' MIN. FROM FACE OF CURB.

SEWER SERVICE LINE LOCATIONS

Poinsettia Place S.E.

Lot Number	Station @ Center Line of Road	Sewer Line Elevation @ Property Line
20	3+00	68.97
19	3+70	66.26
18	4+37	63.45
1	4+19	64.34
17	5+16	58.04
5	5+75	52.28
16	6+10	46.26
15	7+21	34.69
7	7+44	32.43
14A	8+14	24.78
8	8+16	24.08
13A	9+04	15.80
12A	0+52	10.91
11A	0+54	10.91
10	9+24.7	12.35
9	9+24.7	13.60

Mistletoe Court S.E.

Lot Number	Station @ Center Line of Road	Sewer Line Elevation @ Property Line
16A	1+25	62.15
17A	1+35	62.15
18A	1+35	62.15
19A	1+35	62.26

AS BUILT INFORMATION

CONTRACTOR: MJB Const. Co.

WORKED BY: MJB Const. Co.

DATE: 1/22/89

ACCEPTED BY: MJB Const. Co.

DATE: 1/22/89

VERIFIED BY: MJB Const. Co.

DATE: 1/22/89

RECORDED BY: MJB Const. Co.

DATE: 1/22/89

NO.

EL. 5711.67

ENGINEER'S SEAL

Mark Goodwin, P.E. 8948

1/22/89

REVISIONS

NO. DATE

REMARKS

DESIGNED BY: SD, ED

DATE: MAY 1983

DRAWN BY: SD, CM, FM

DATE: JAN 1985

CHECKED BY: ED

DATE: JAN 1985

CITY OF ALBUQUERQUE

MUNICIPAL DEVELOPMENT DEPARTMENT

ENGINEERING DIVISION

TITLE: POINSETTIA PLACE UTILITIES PLAN & PROFILE

APPROVALS

ENGINEER: Mark Goodwin, P.E. 8948

DATE: 1/22/89

APPROVALS

ENGINEER: MJB Const. Co.

DATE: 1/22/89

APPROVALS

ENGINEER: MJB Const. Co.

DATE: 1/22/89

APPROVALS


ENGINEER: MJB Const. Co.




DATE: 1/22/89

DRAWING NO. 2565

MAP NO. L-23

SHEET 15 OF 22

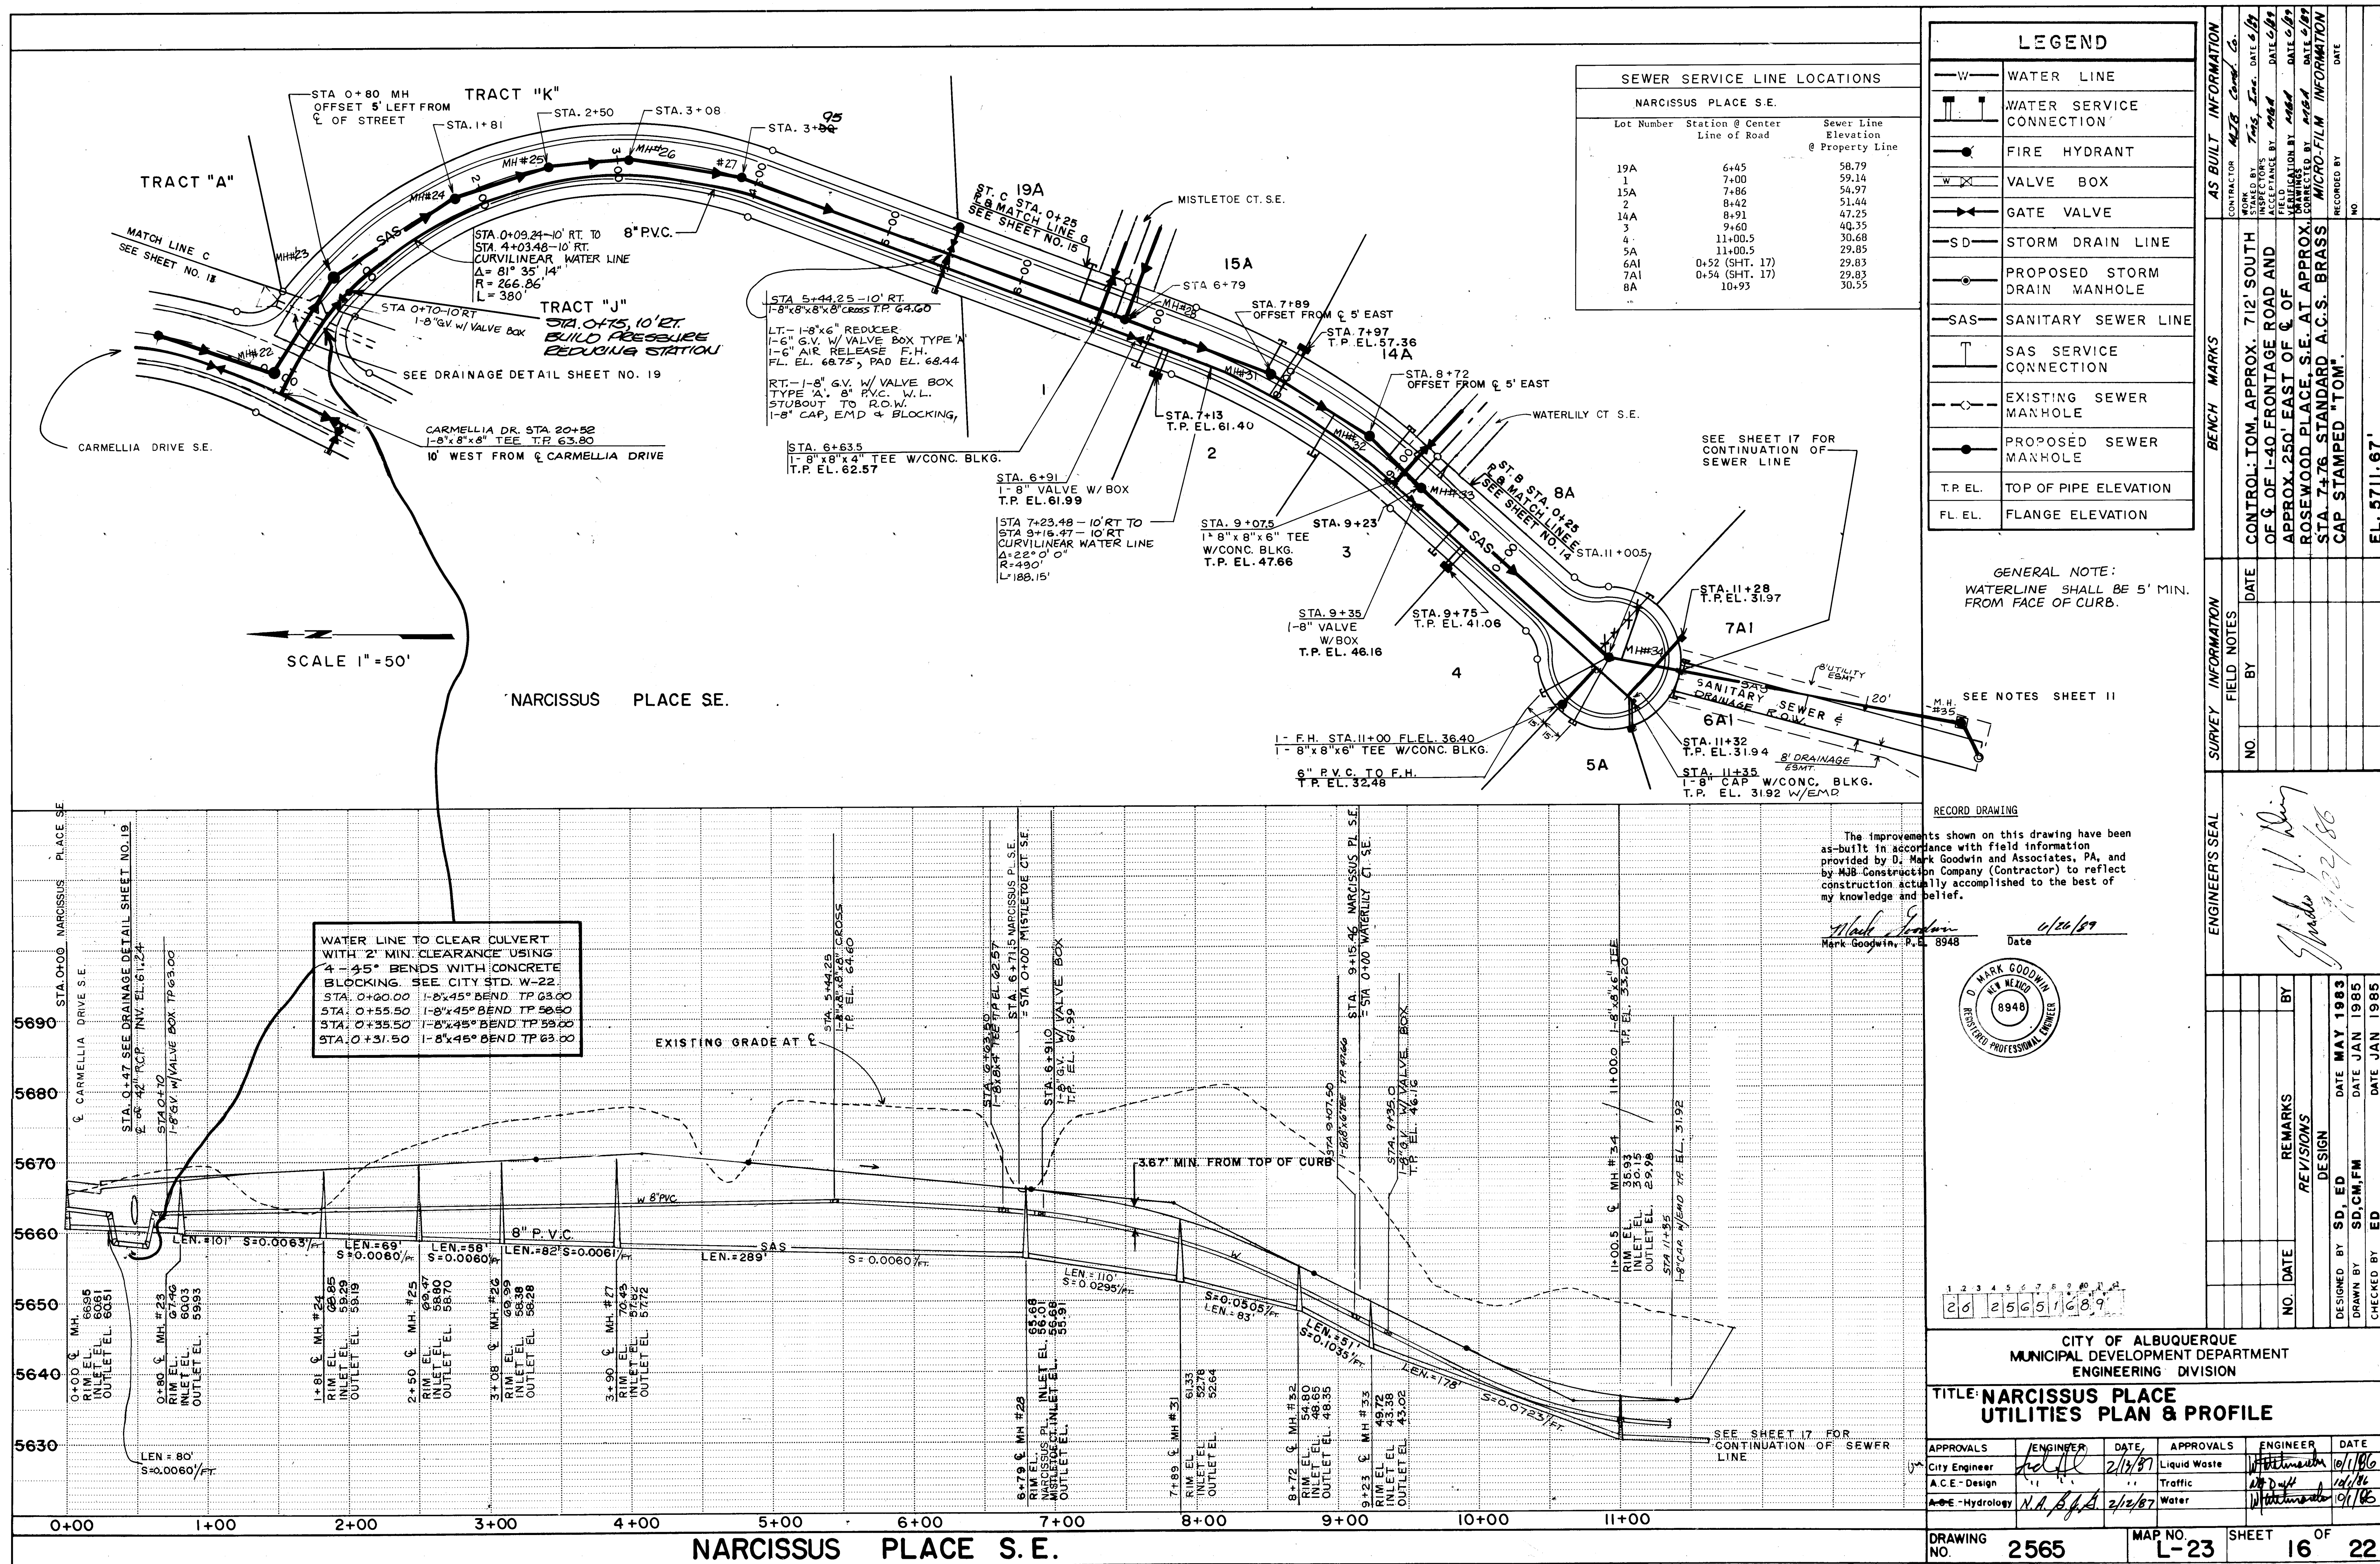

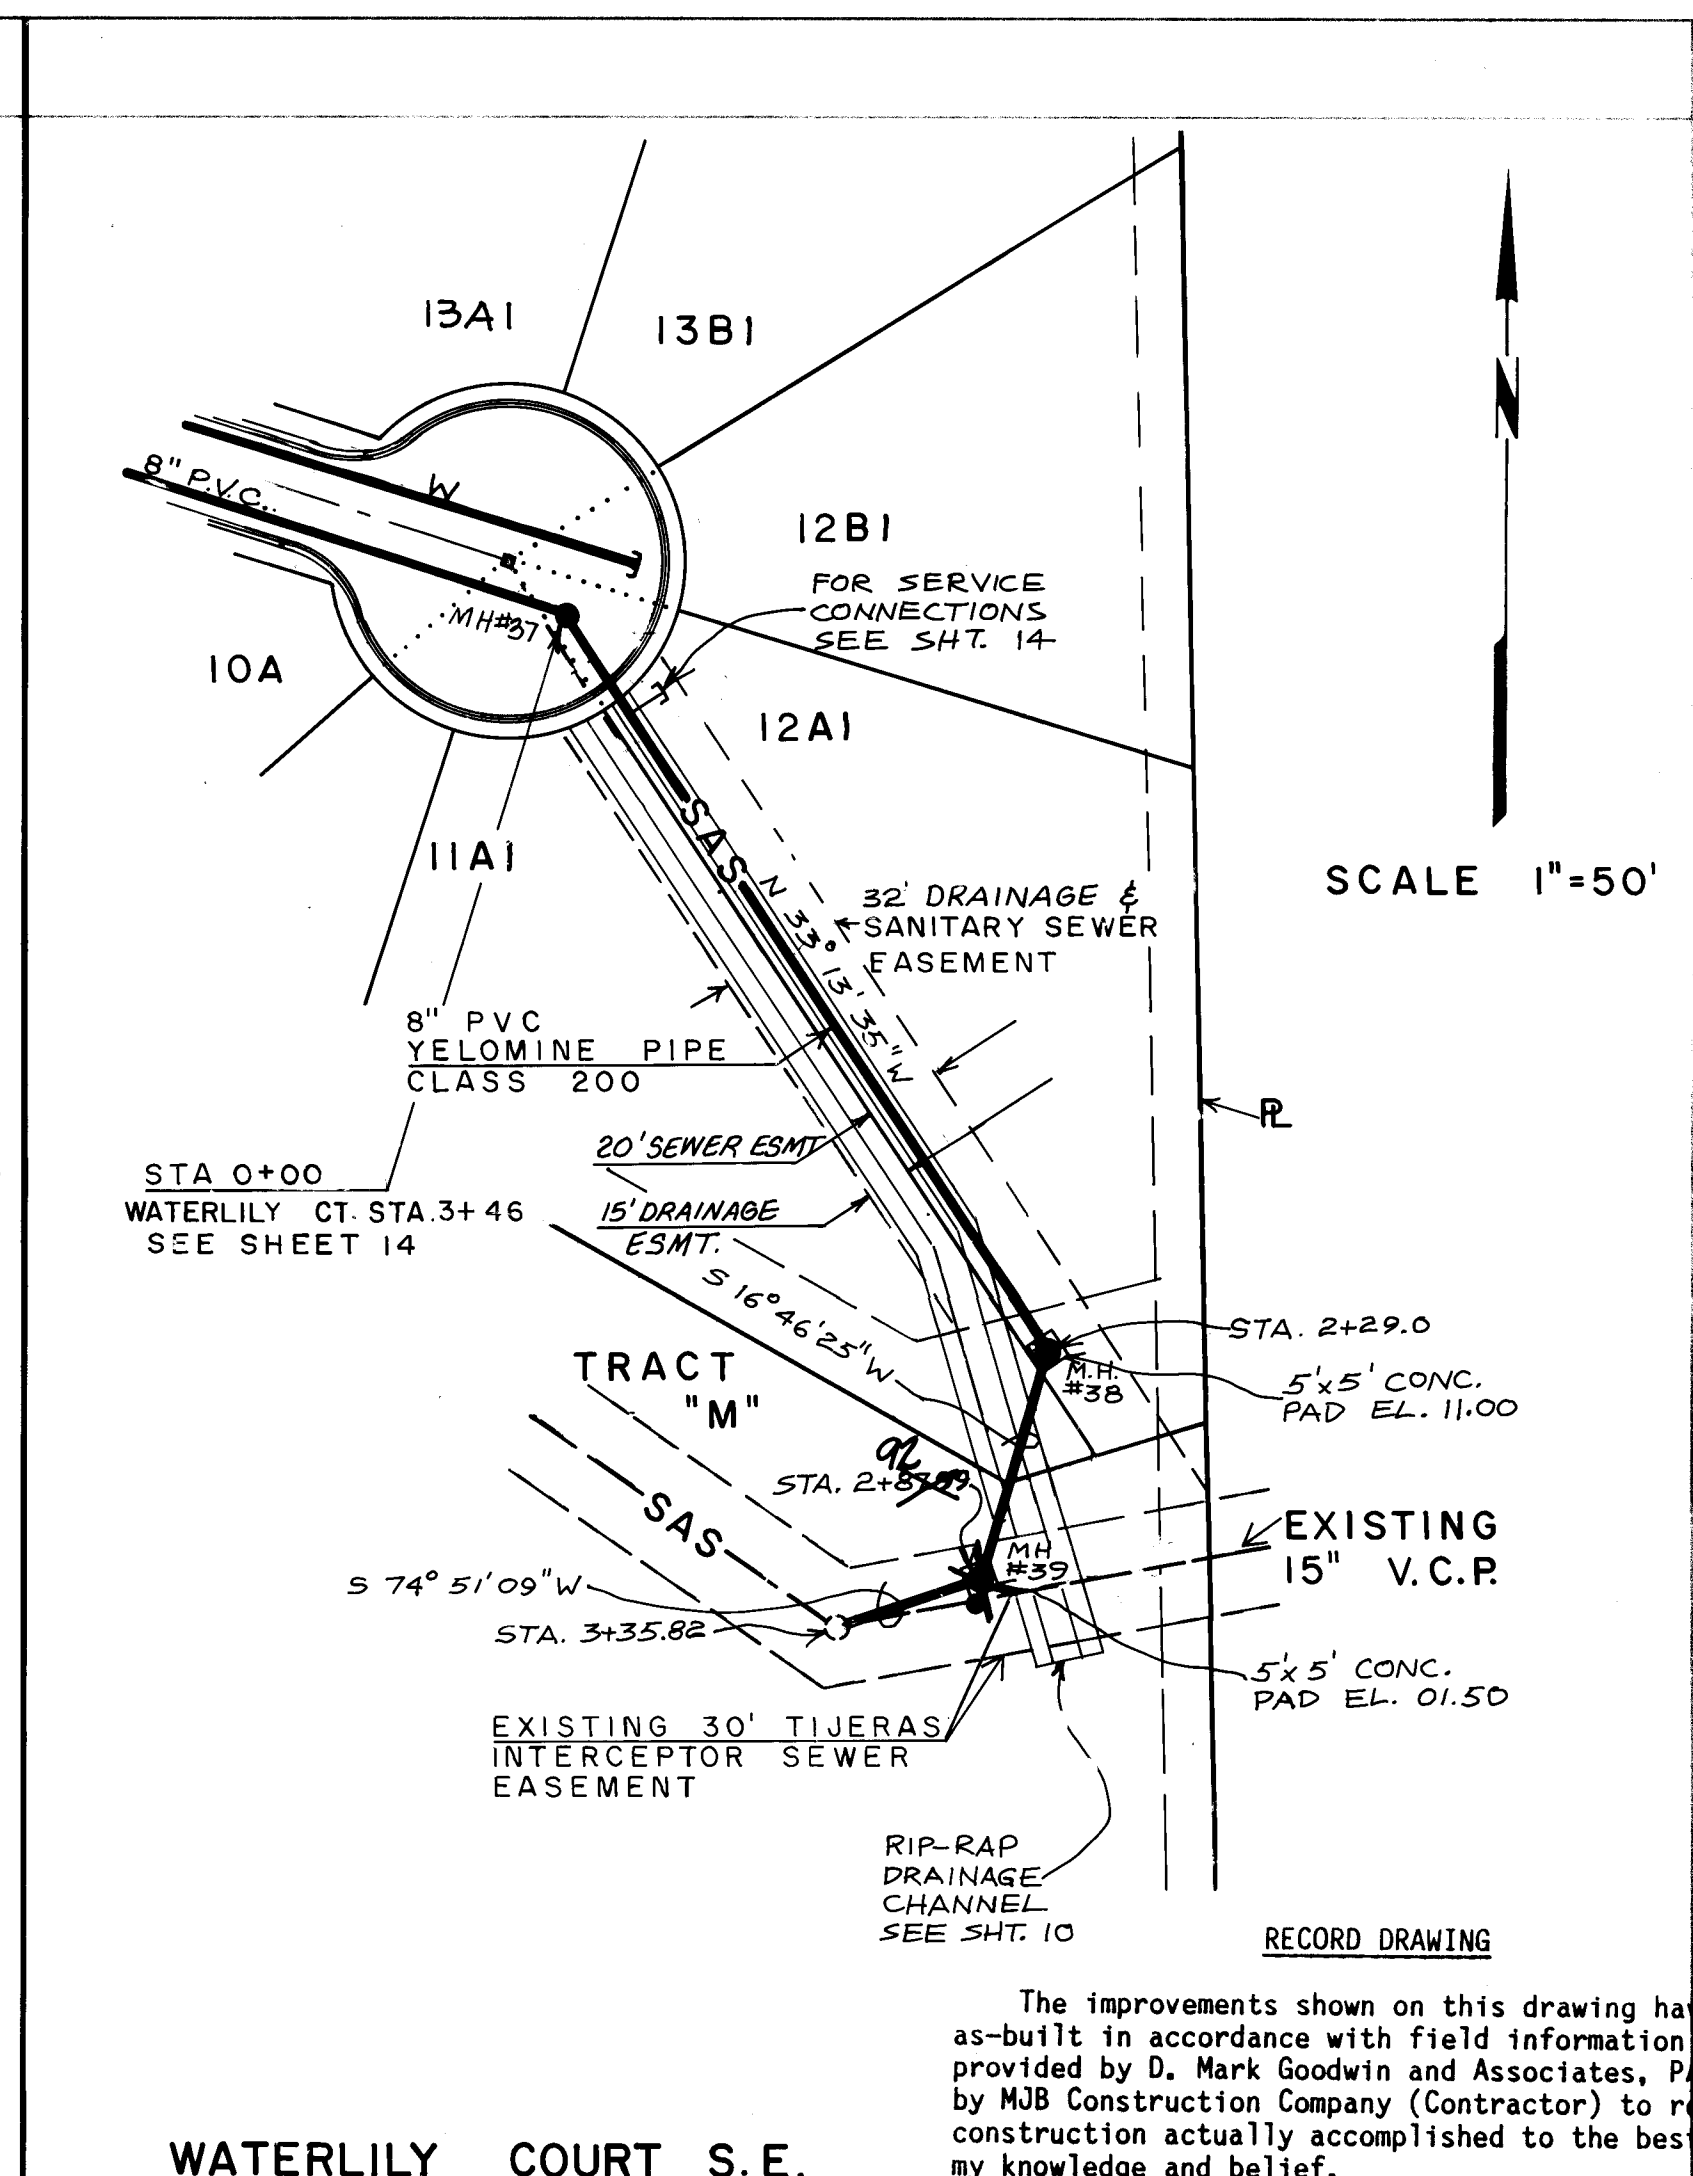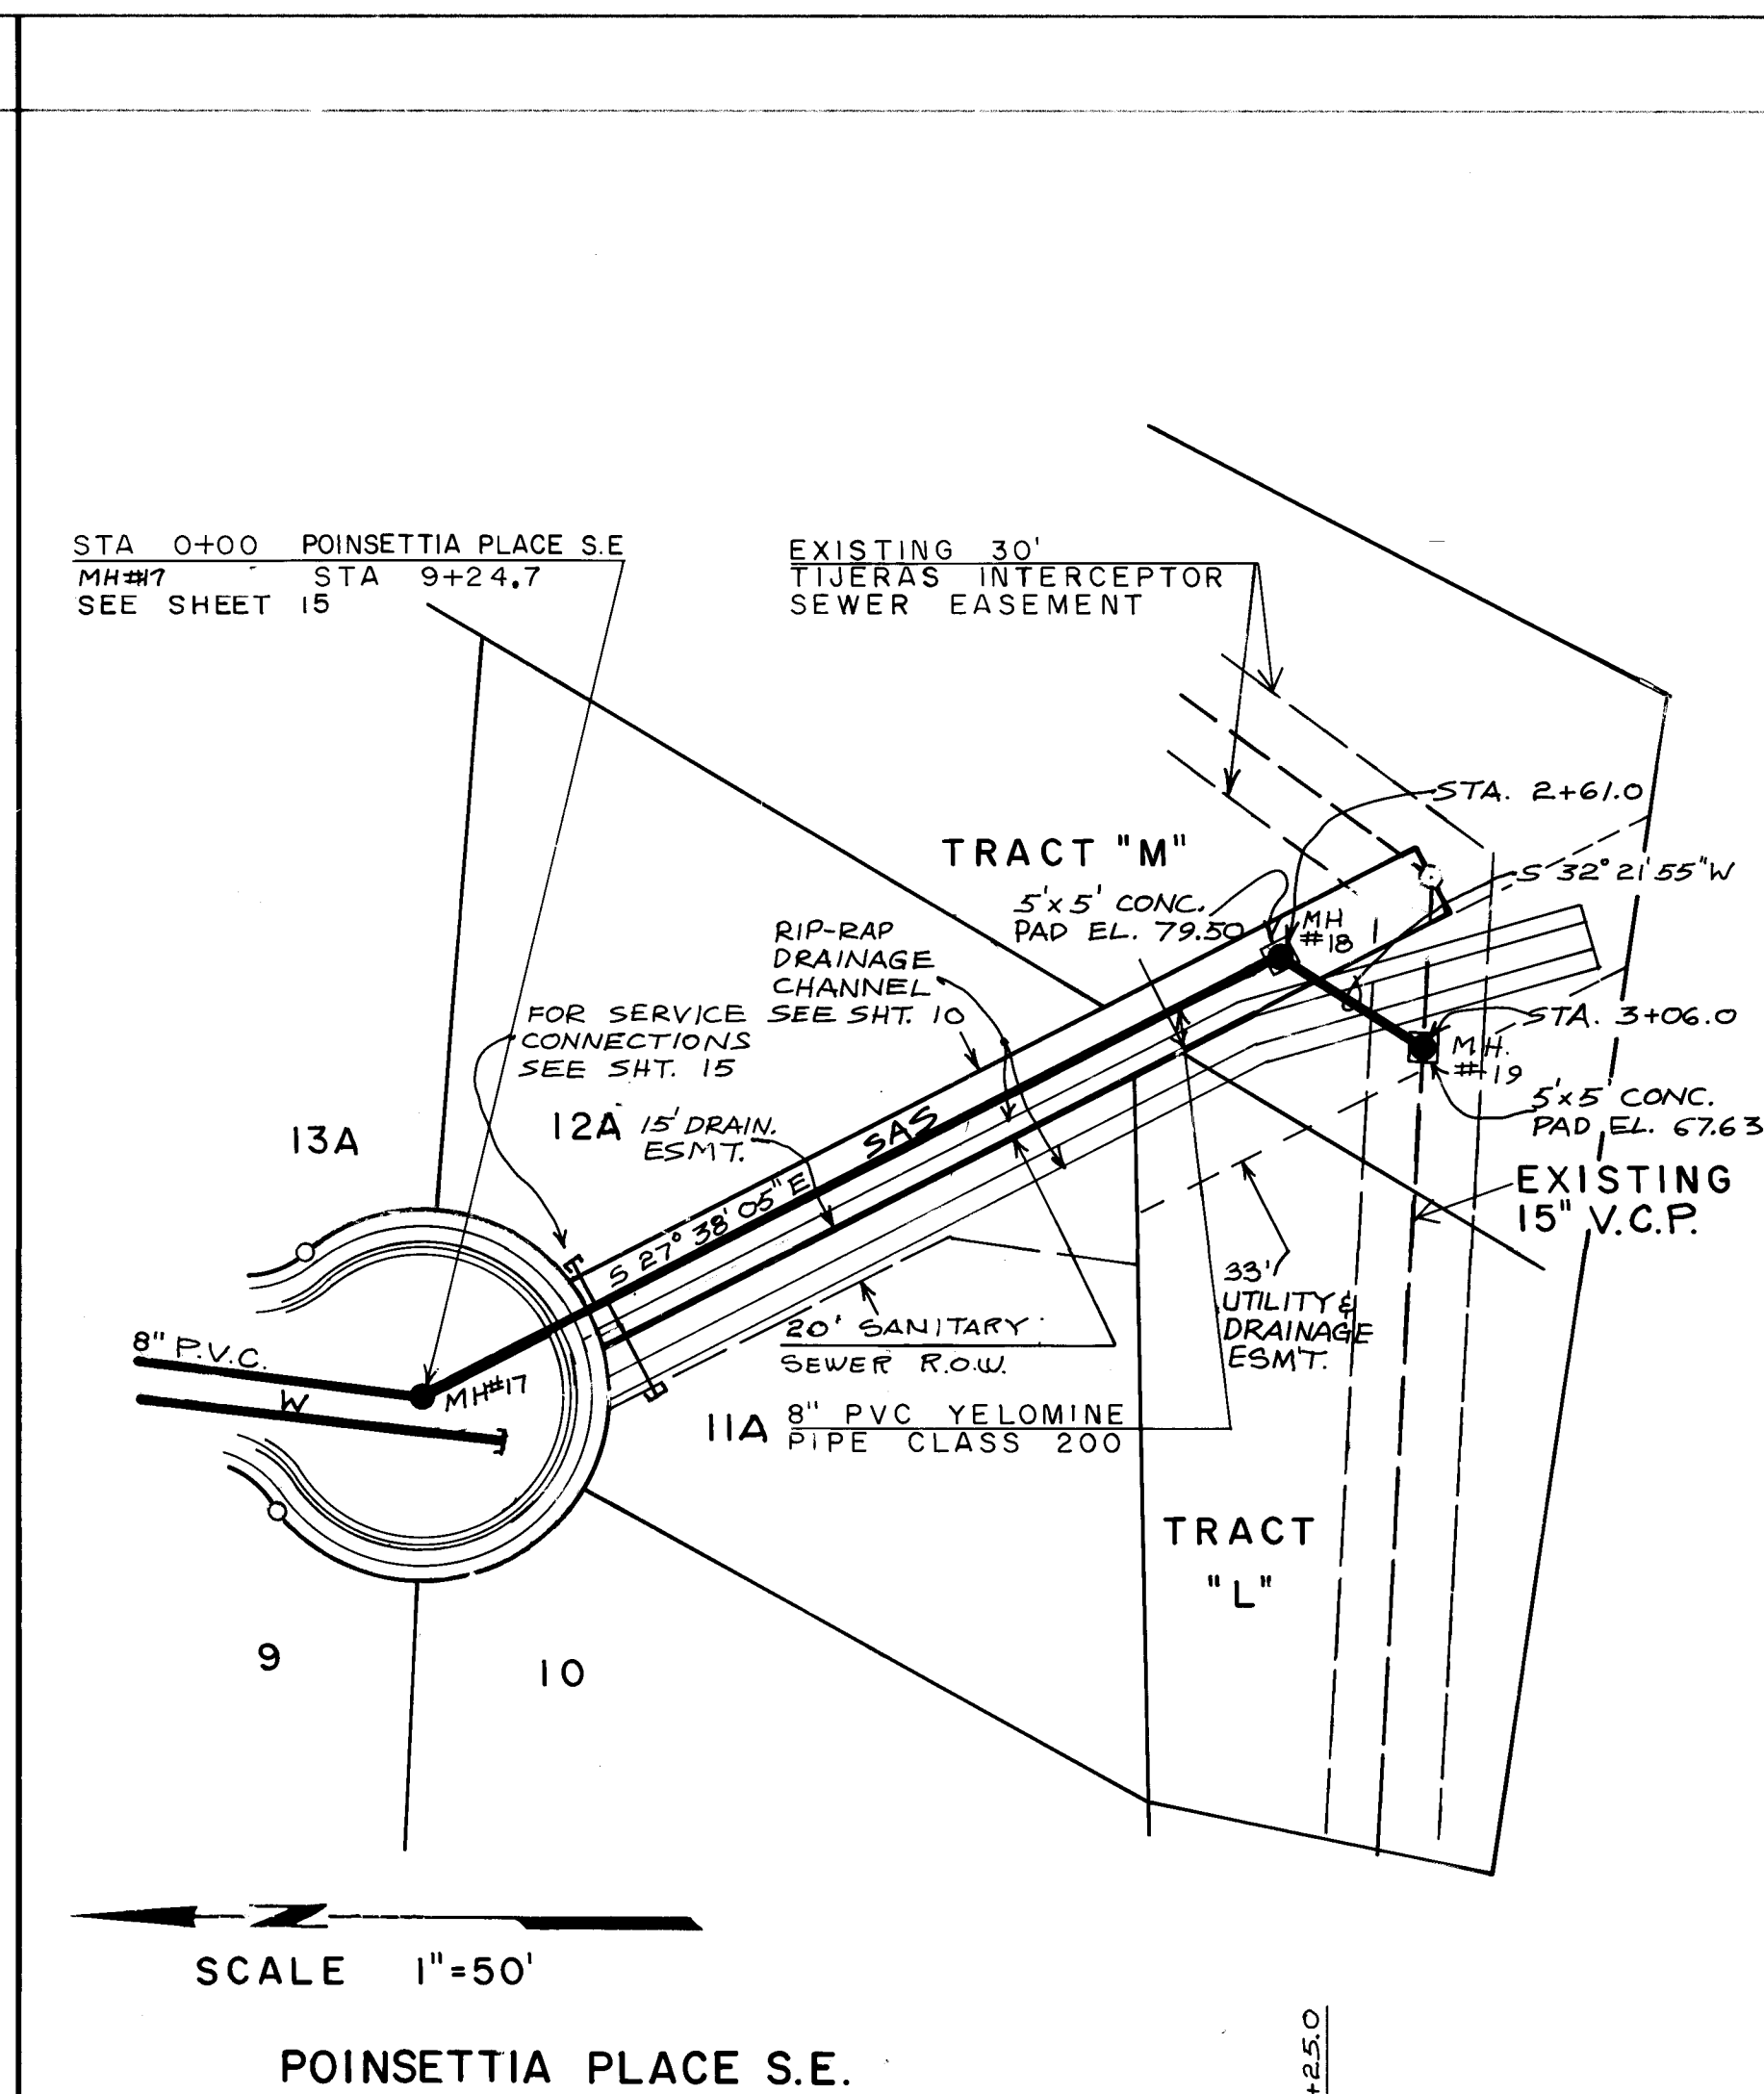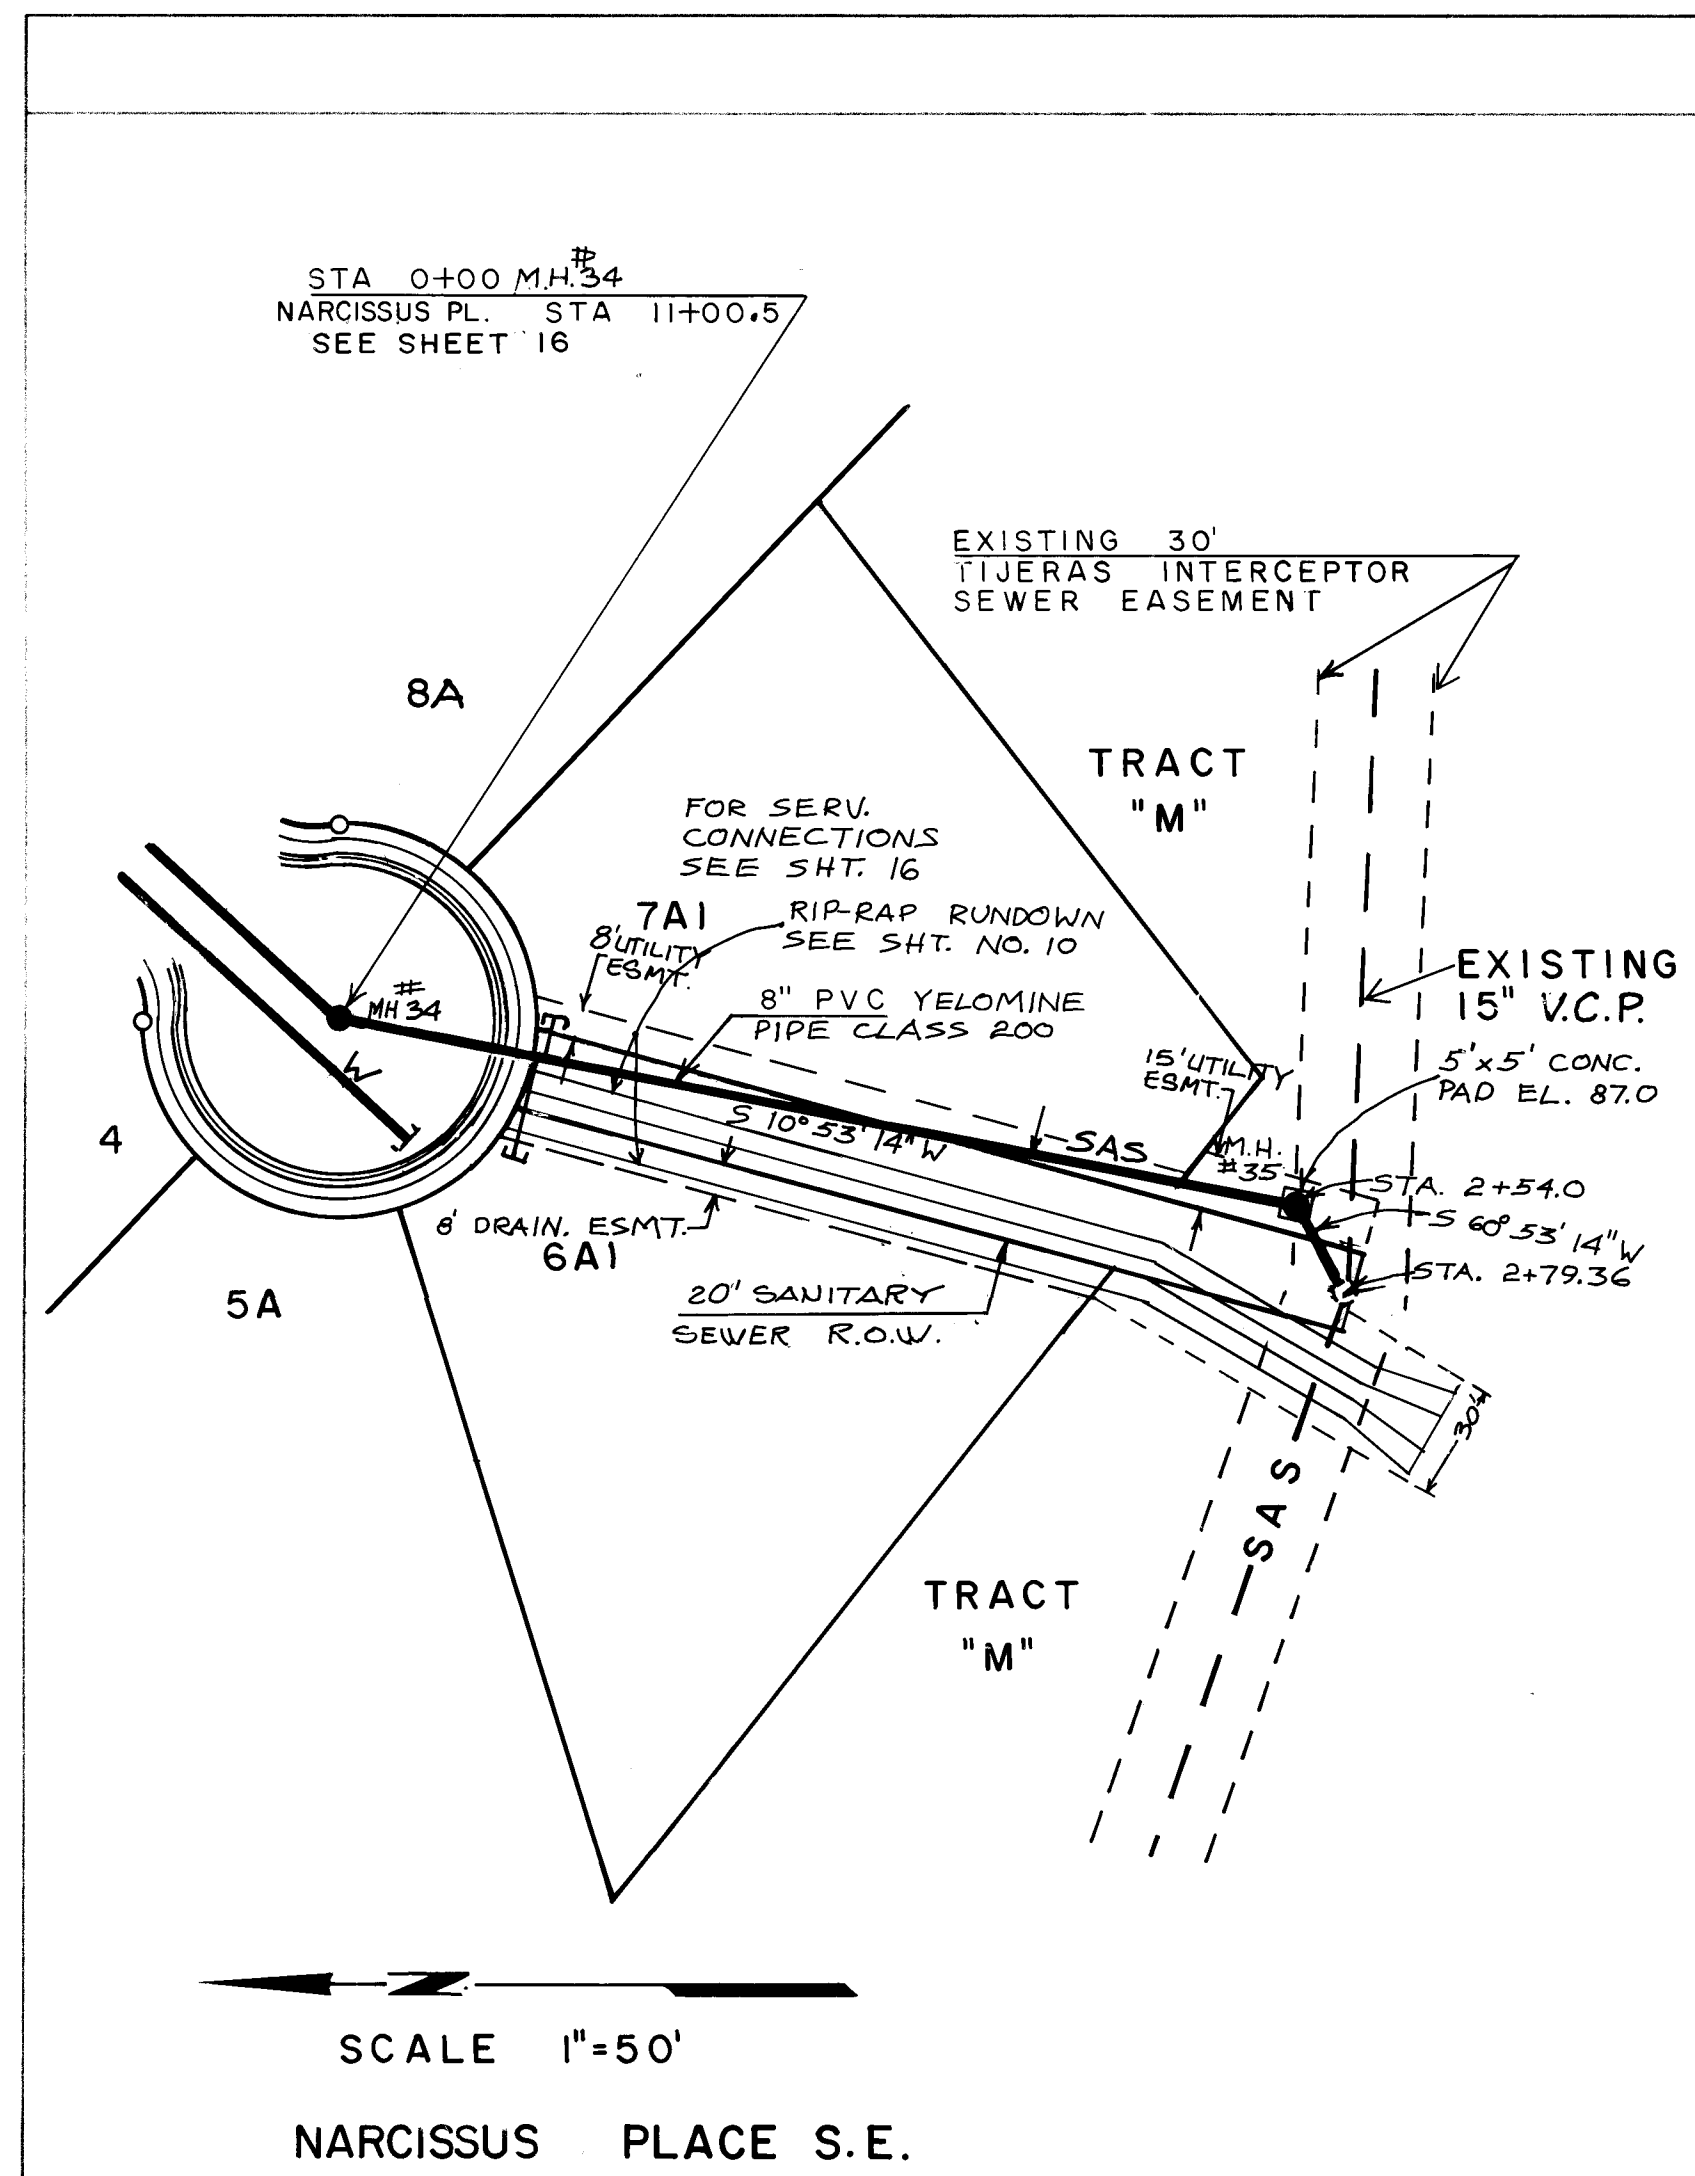

LEGEND

TRANSITION AREA
CATCH BASIN
SD STORM DRAIN LINE
PROPOSED STORM DRAIN MANHOLE
TC EL TOP OF CURB ELEVATION
SAS SANITARY SEWER LINE
EXISTING SEWER MANHOLE
PROPOSED SEWER MANHOLE

NOTES: 1. SEE SHEET 10 FOR RIP-RAP CHANNEL RUNDOWNS

2. ALL SEWER LINES SHOWN ON THIS SHEET WILL BE CERTAINTIED 8" PVC YELOMINE PIPE CLASS 200.

3. 4'x4'x0'10" ANCHOR BLOCKS WILL BE PROVIDED AT EVERY JOINT (20' MAX. BETWEEN JOINTS). SEE SHEET 20 FOR ANCHOR BLOCK DETAIL.

THE IMPROVEMENTS SHOWN ON THIS DRAWING HAVE BEEN AS-BUILT IN ACCORDANCE WITH FIELD INFORMATION PROVIDED BY D. MARK GOODWIN AND ASSOCIATES, P.A. AND BY MJB CONSTRUCTION COMPANY (CONTRACTOR) TO REFLECT CONSTRUCTION ACTUALLY ACCOMPLISHED TO THE BEST OF MY KNOWLEDGE AND BELIEF.

Mark Goodwin, P.E. 8948 Date 4/26/89

SEE NOTES SHEET 11

NOTE: THE FOLLOWING MANHOLES; #17, #18, #19, #24, #35, #37, #38, #39 REQUIRE SPECIAL INSIDE COATING PER PLASITE SPECIFICATIONS. SAND BLAST FULLY CURED CONCRETE THEN APPLY 2 COATS OF PLASITE 9028MI CONCRETE FILLER-SEALER OR APPROVED EQUAL, THEN APPLY 2 COATS OF PLASITE 7122H EPOXY-PHENOLIC COATING OR APPROVED EQUAL. APPLIED PER MANUFACTURERS INSTRUCTIONS.

NOTE: ALL MANHOLE RIM ELEVATIONS TO BE FIELD VERIFIED & APPROVED BY ENGINEER.




26 2565 1789

CITY OF ALBUQUERQUE
MUNICIPAL DEVELOPMENT DEPARTMENT
ENGINEERING DIVISION

TITLE: NARCISSUS PL., POINSETTIA PL. & WATERLILY CT. SEWER PLAN & PROFILES








APPROVALS	ENGINEER	DATE	APPROVALS	ENGINEER	DATE
City Engineer	2/13/87	2/13/87	City Engineer	2/13/87	2/13/87
A.C.E. - Design	N.A. RPT.	2/12/87	A.C.E. - Design	N.A. RPT.	2/12/87
Hydrology			Hydrology		

DRAWING NO 2565 MAP NO L-23 SHEET 17 OF 22

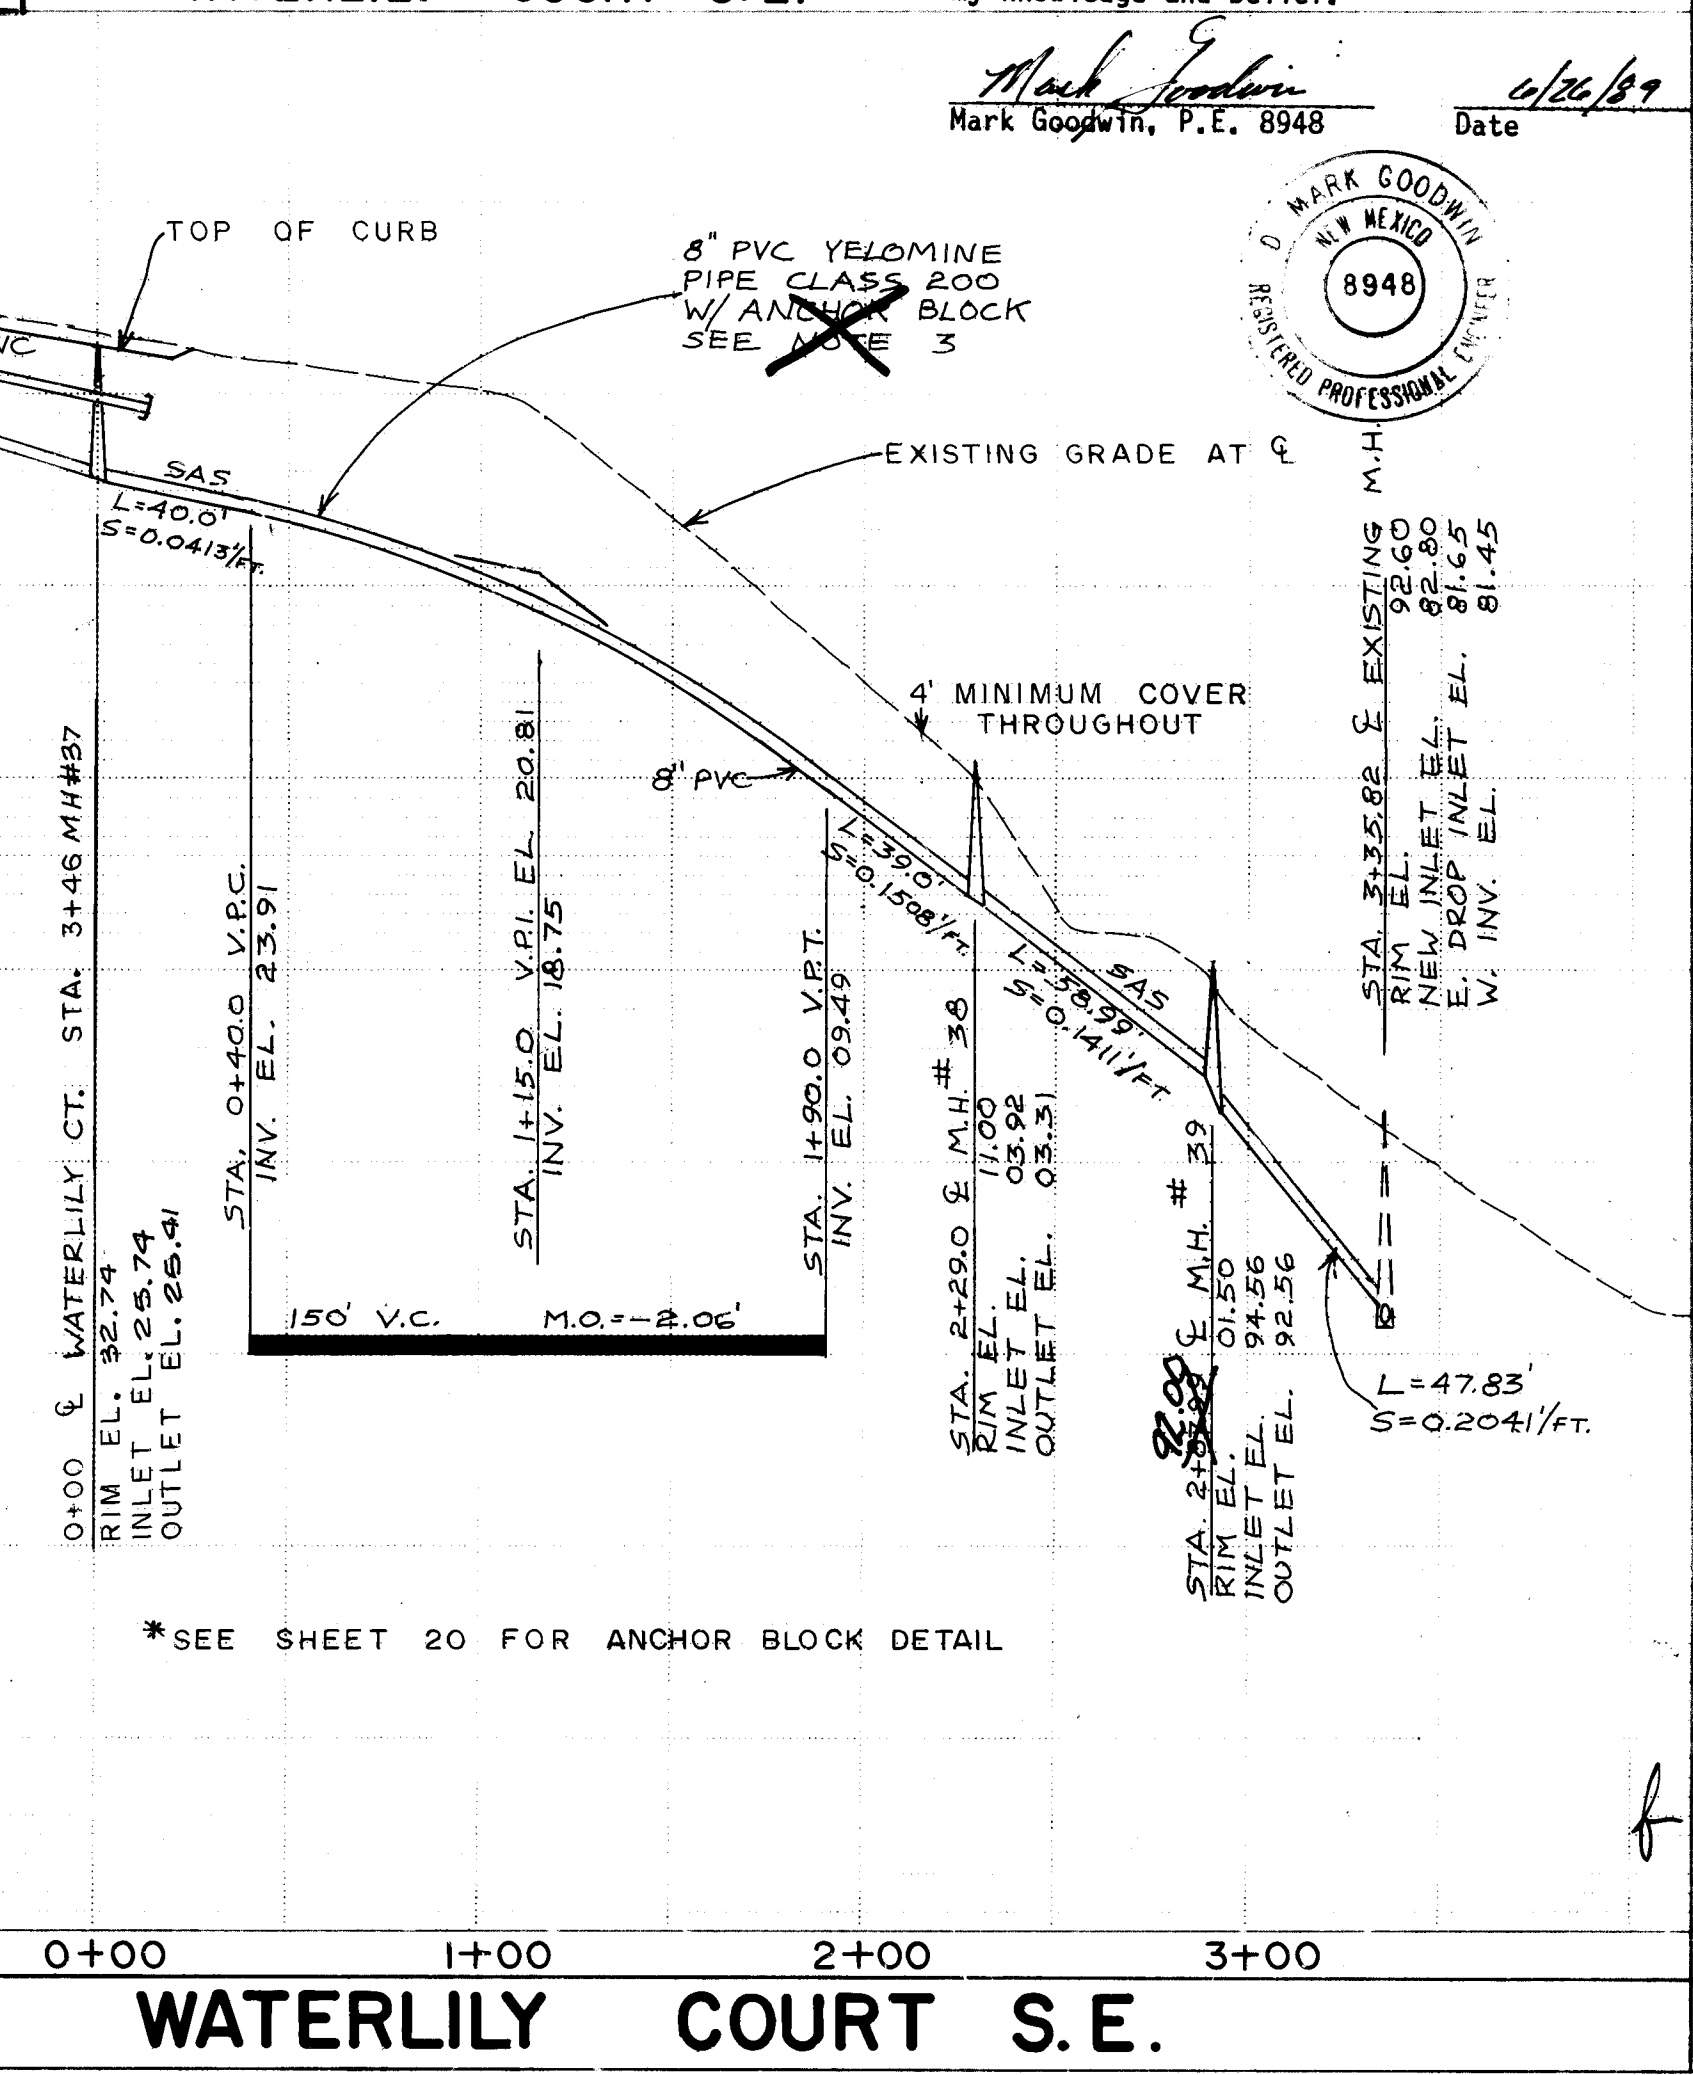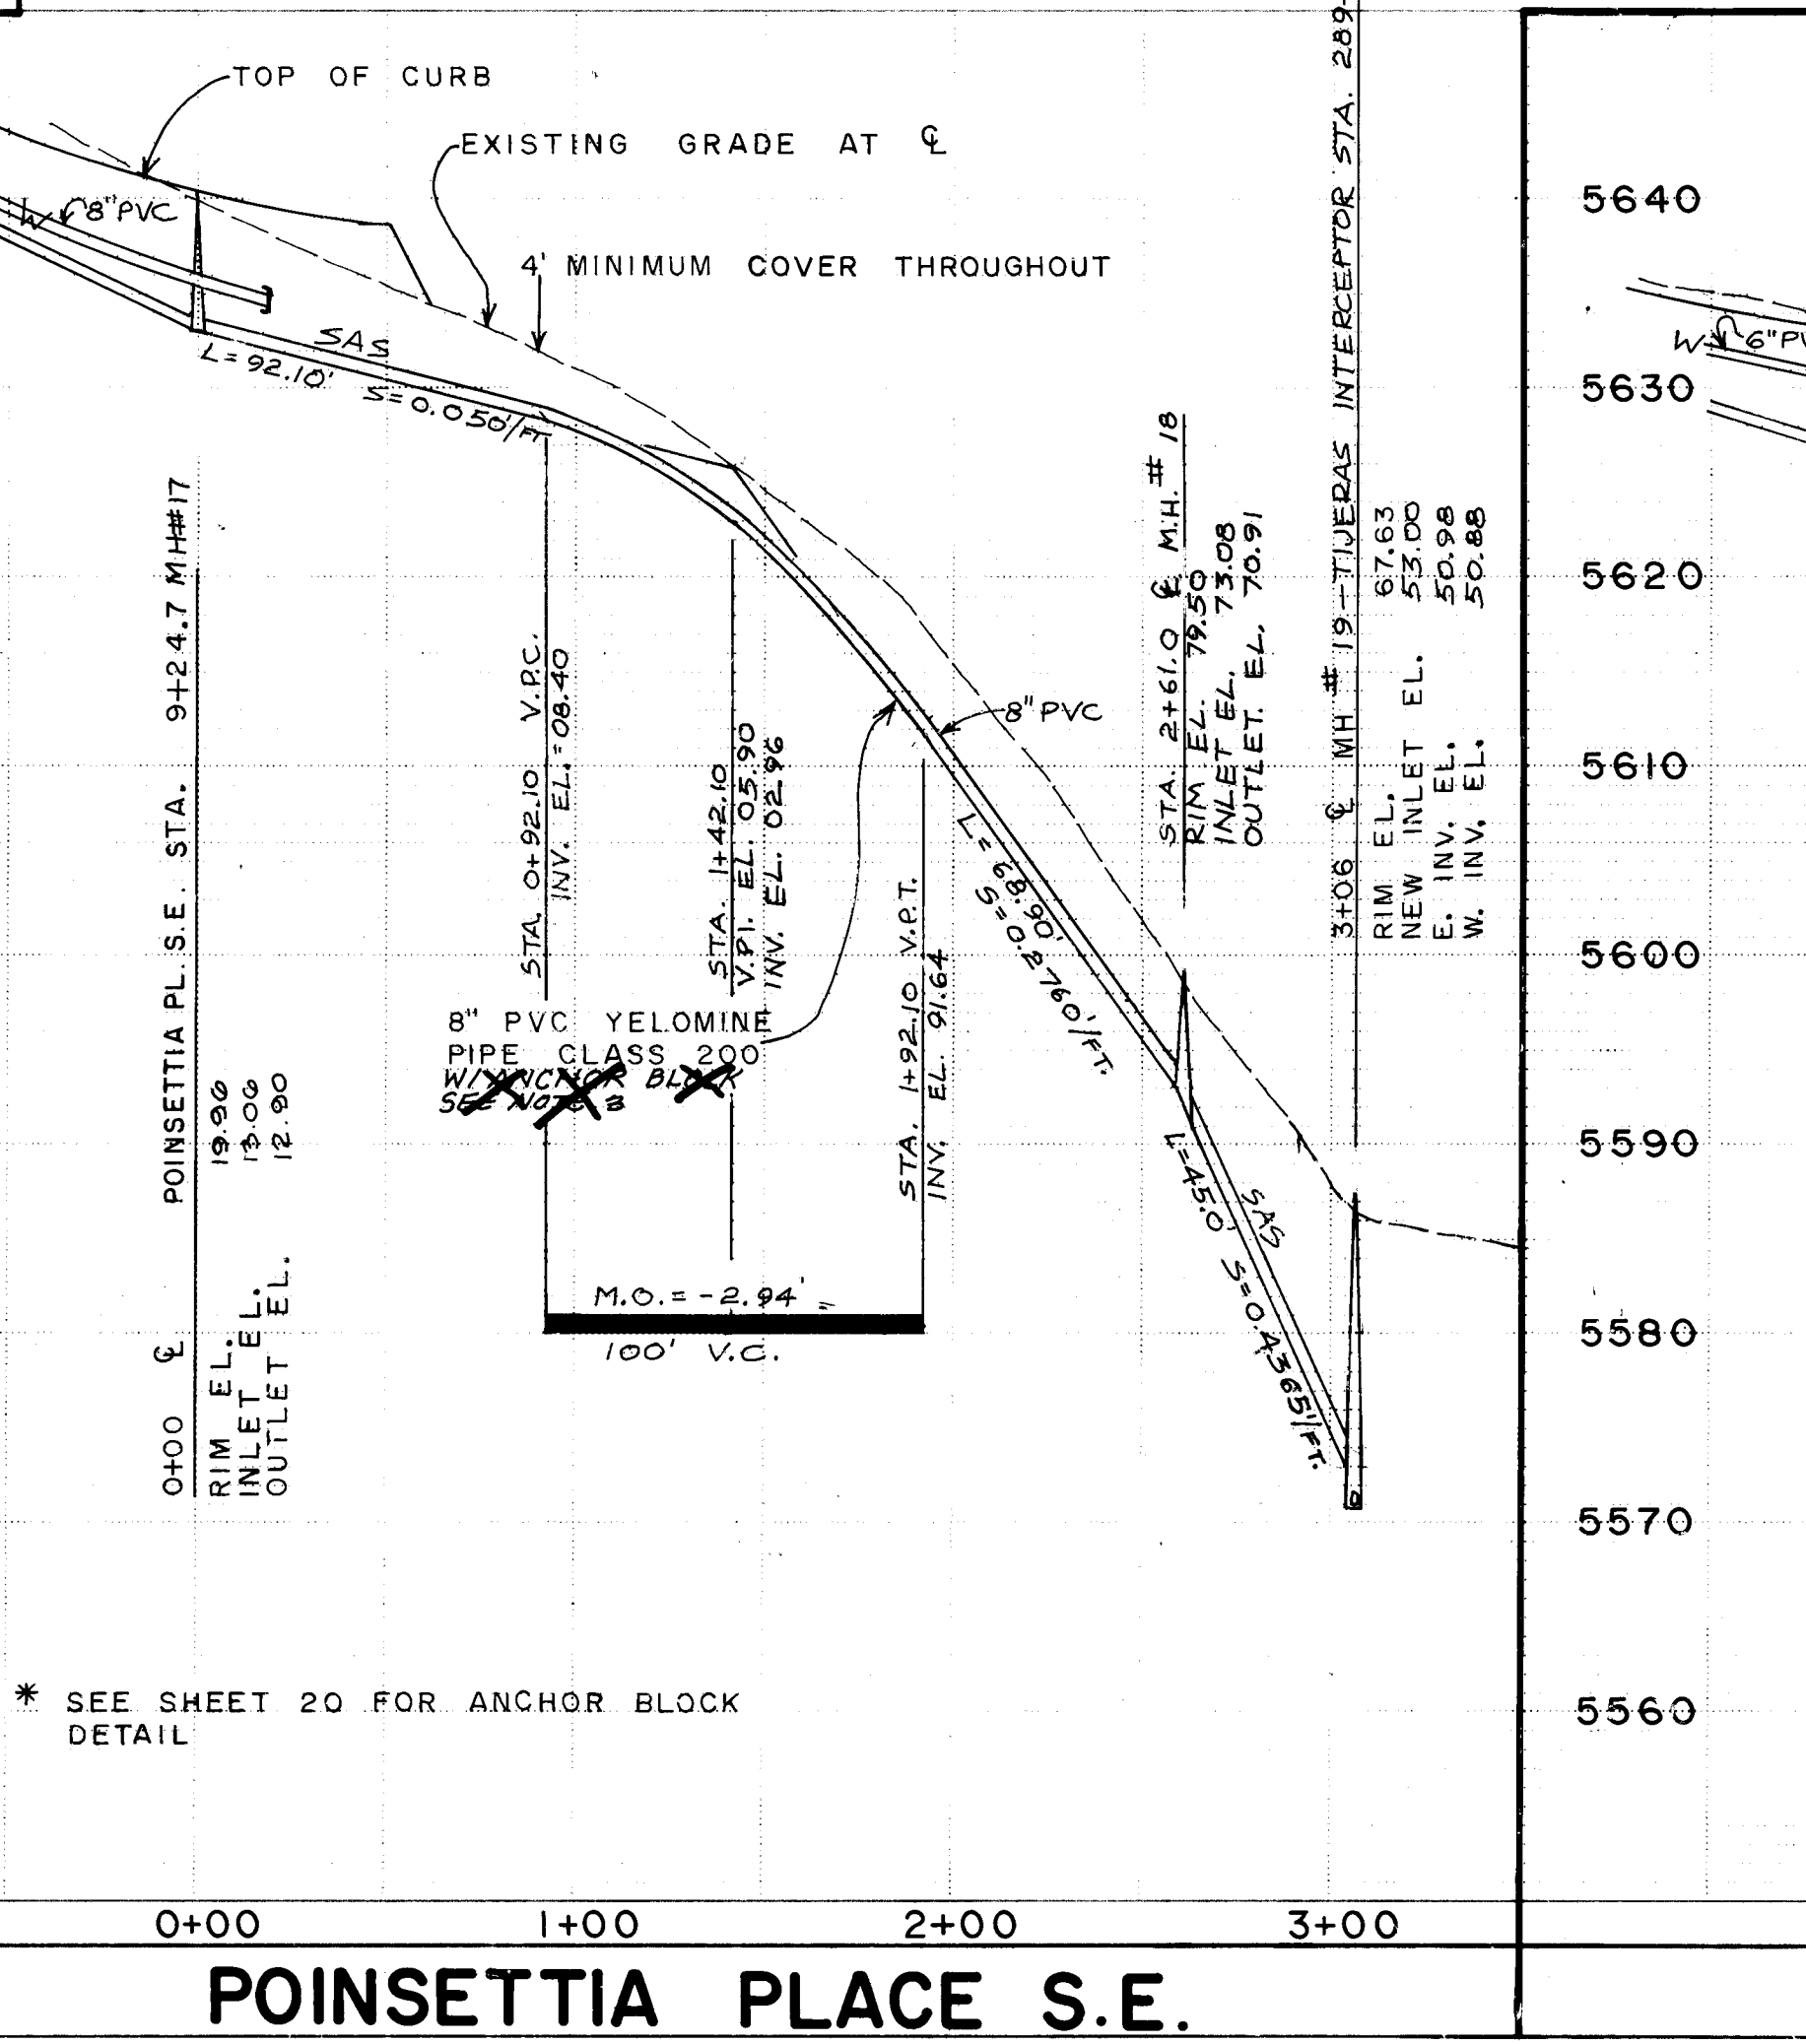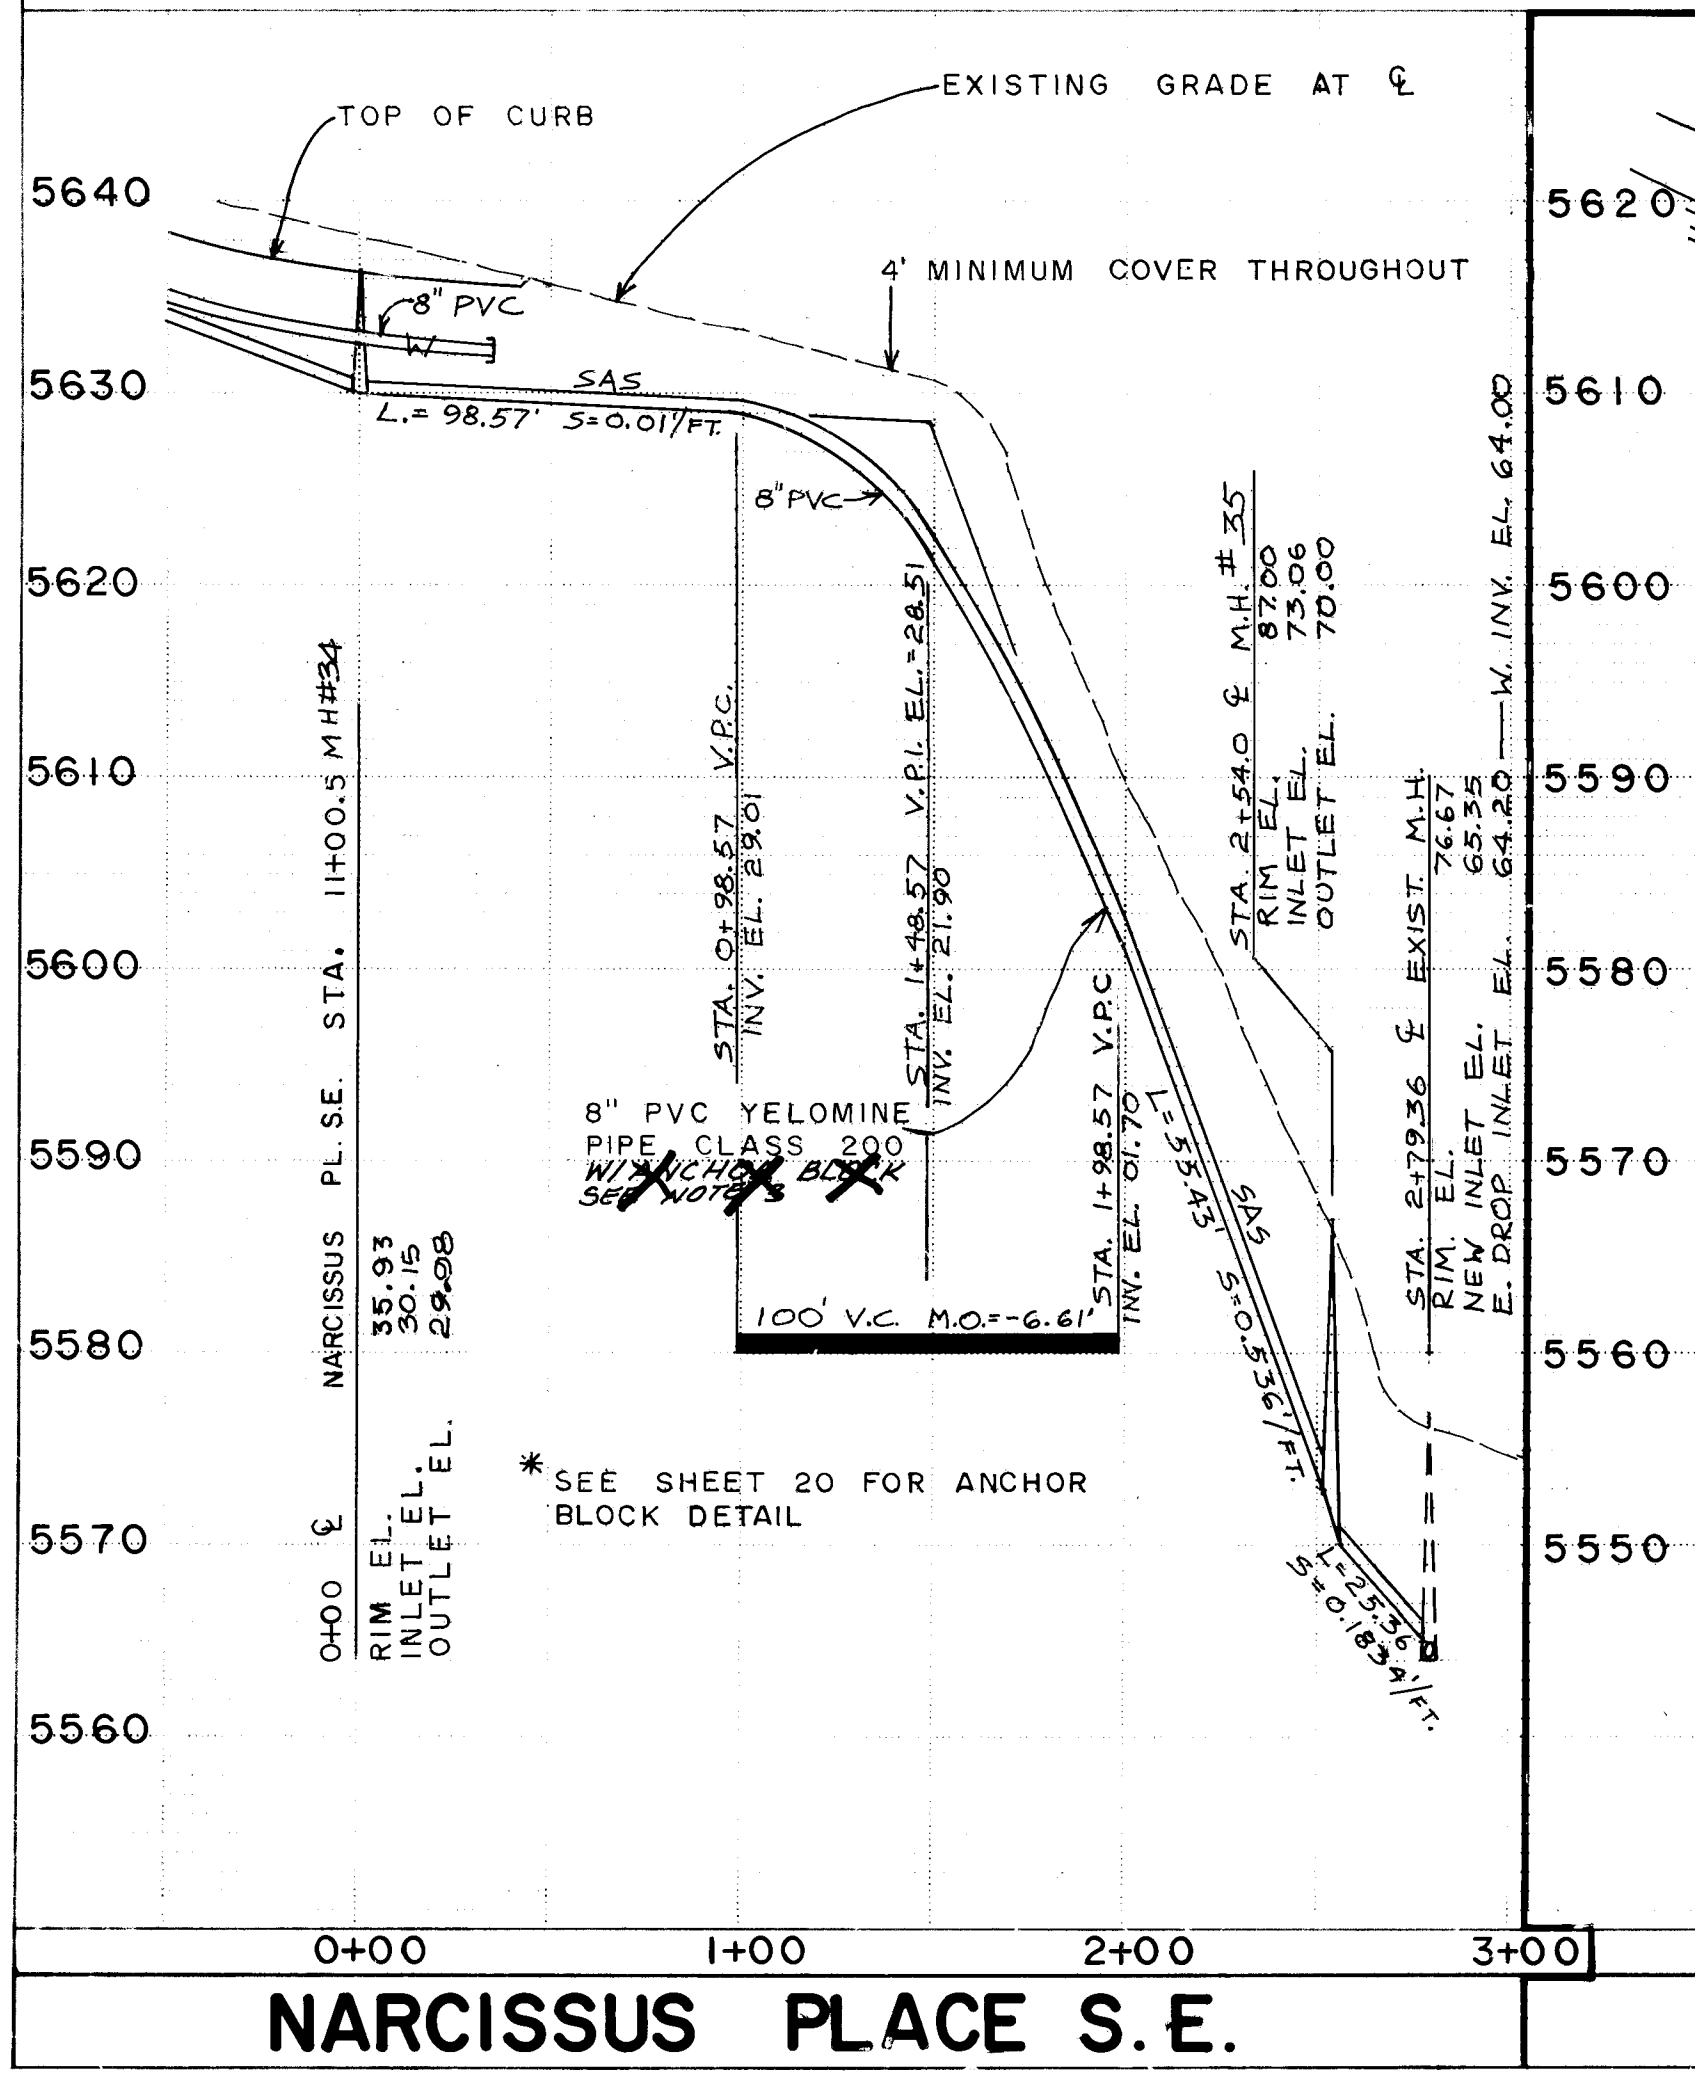

REVISIONS

NO	DATE	REMARKS
1	5/1/86	DESIGN
2	5/1/86	DESIGN
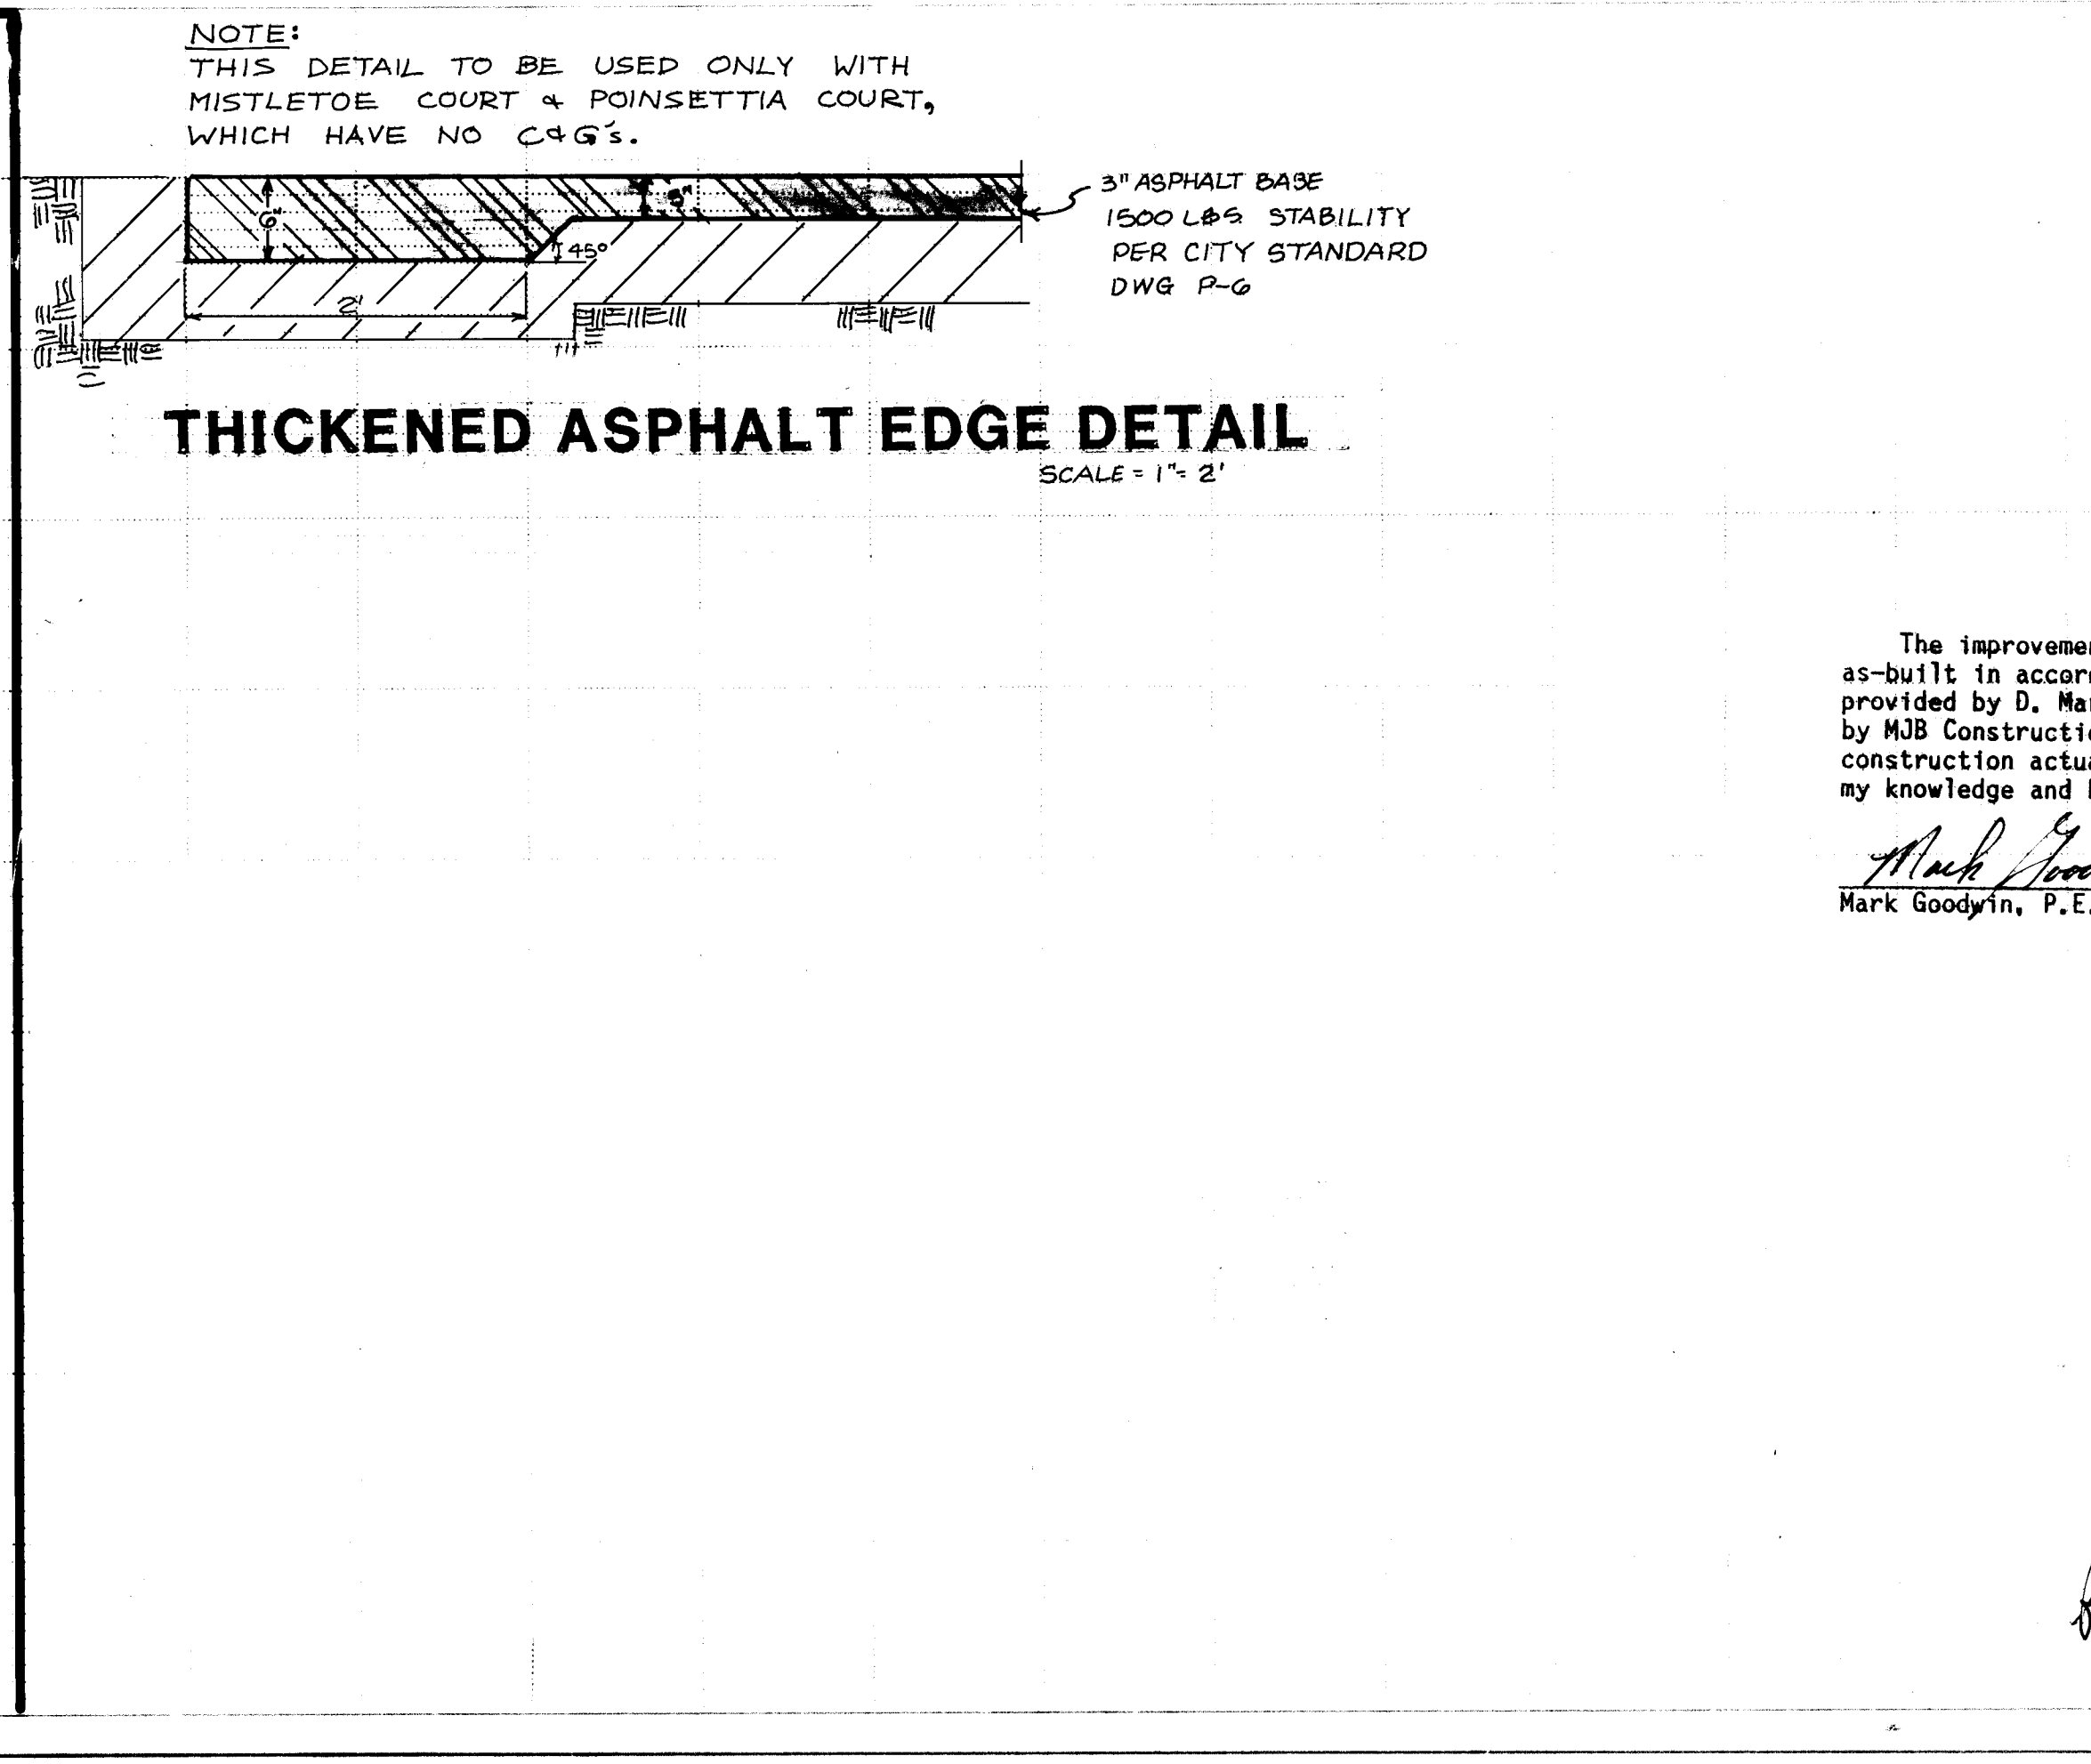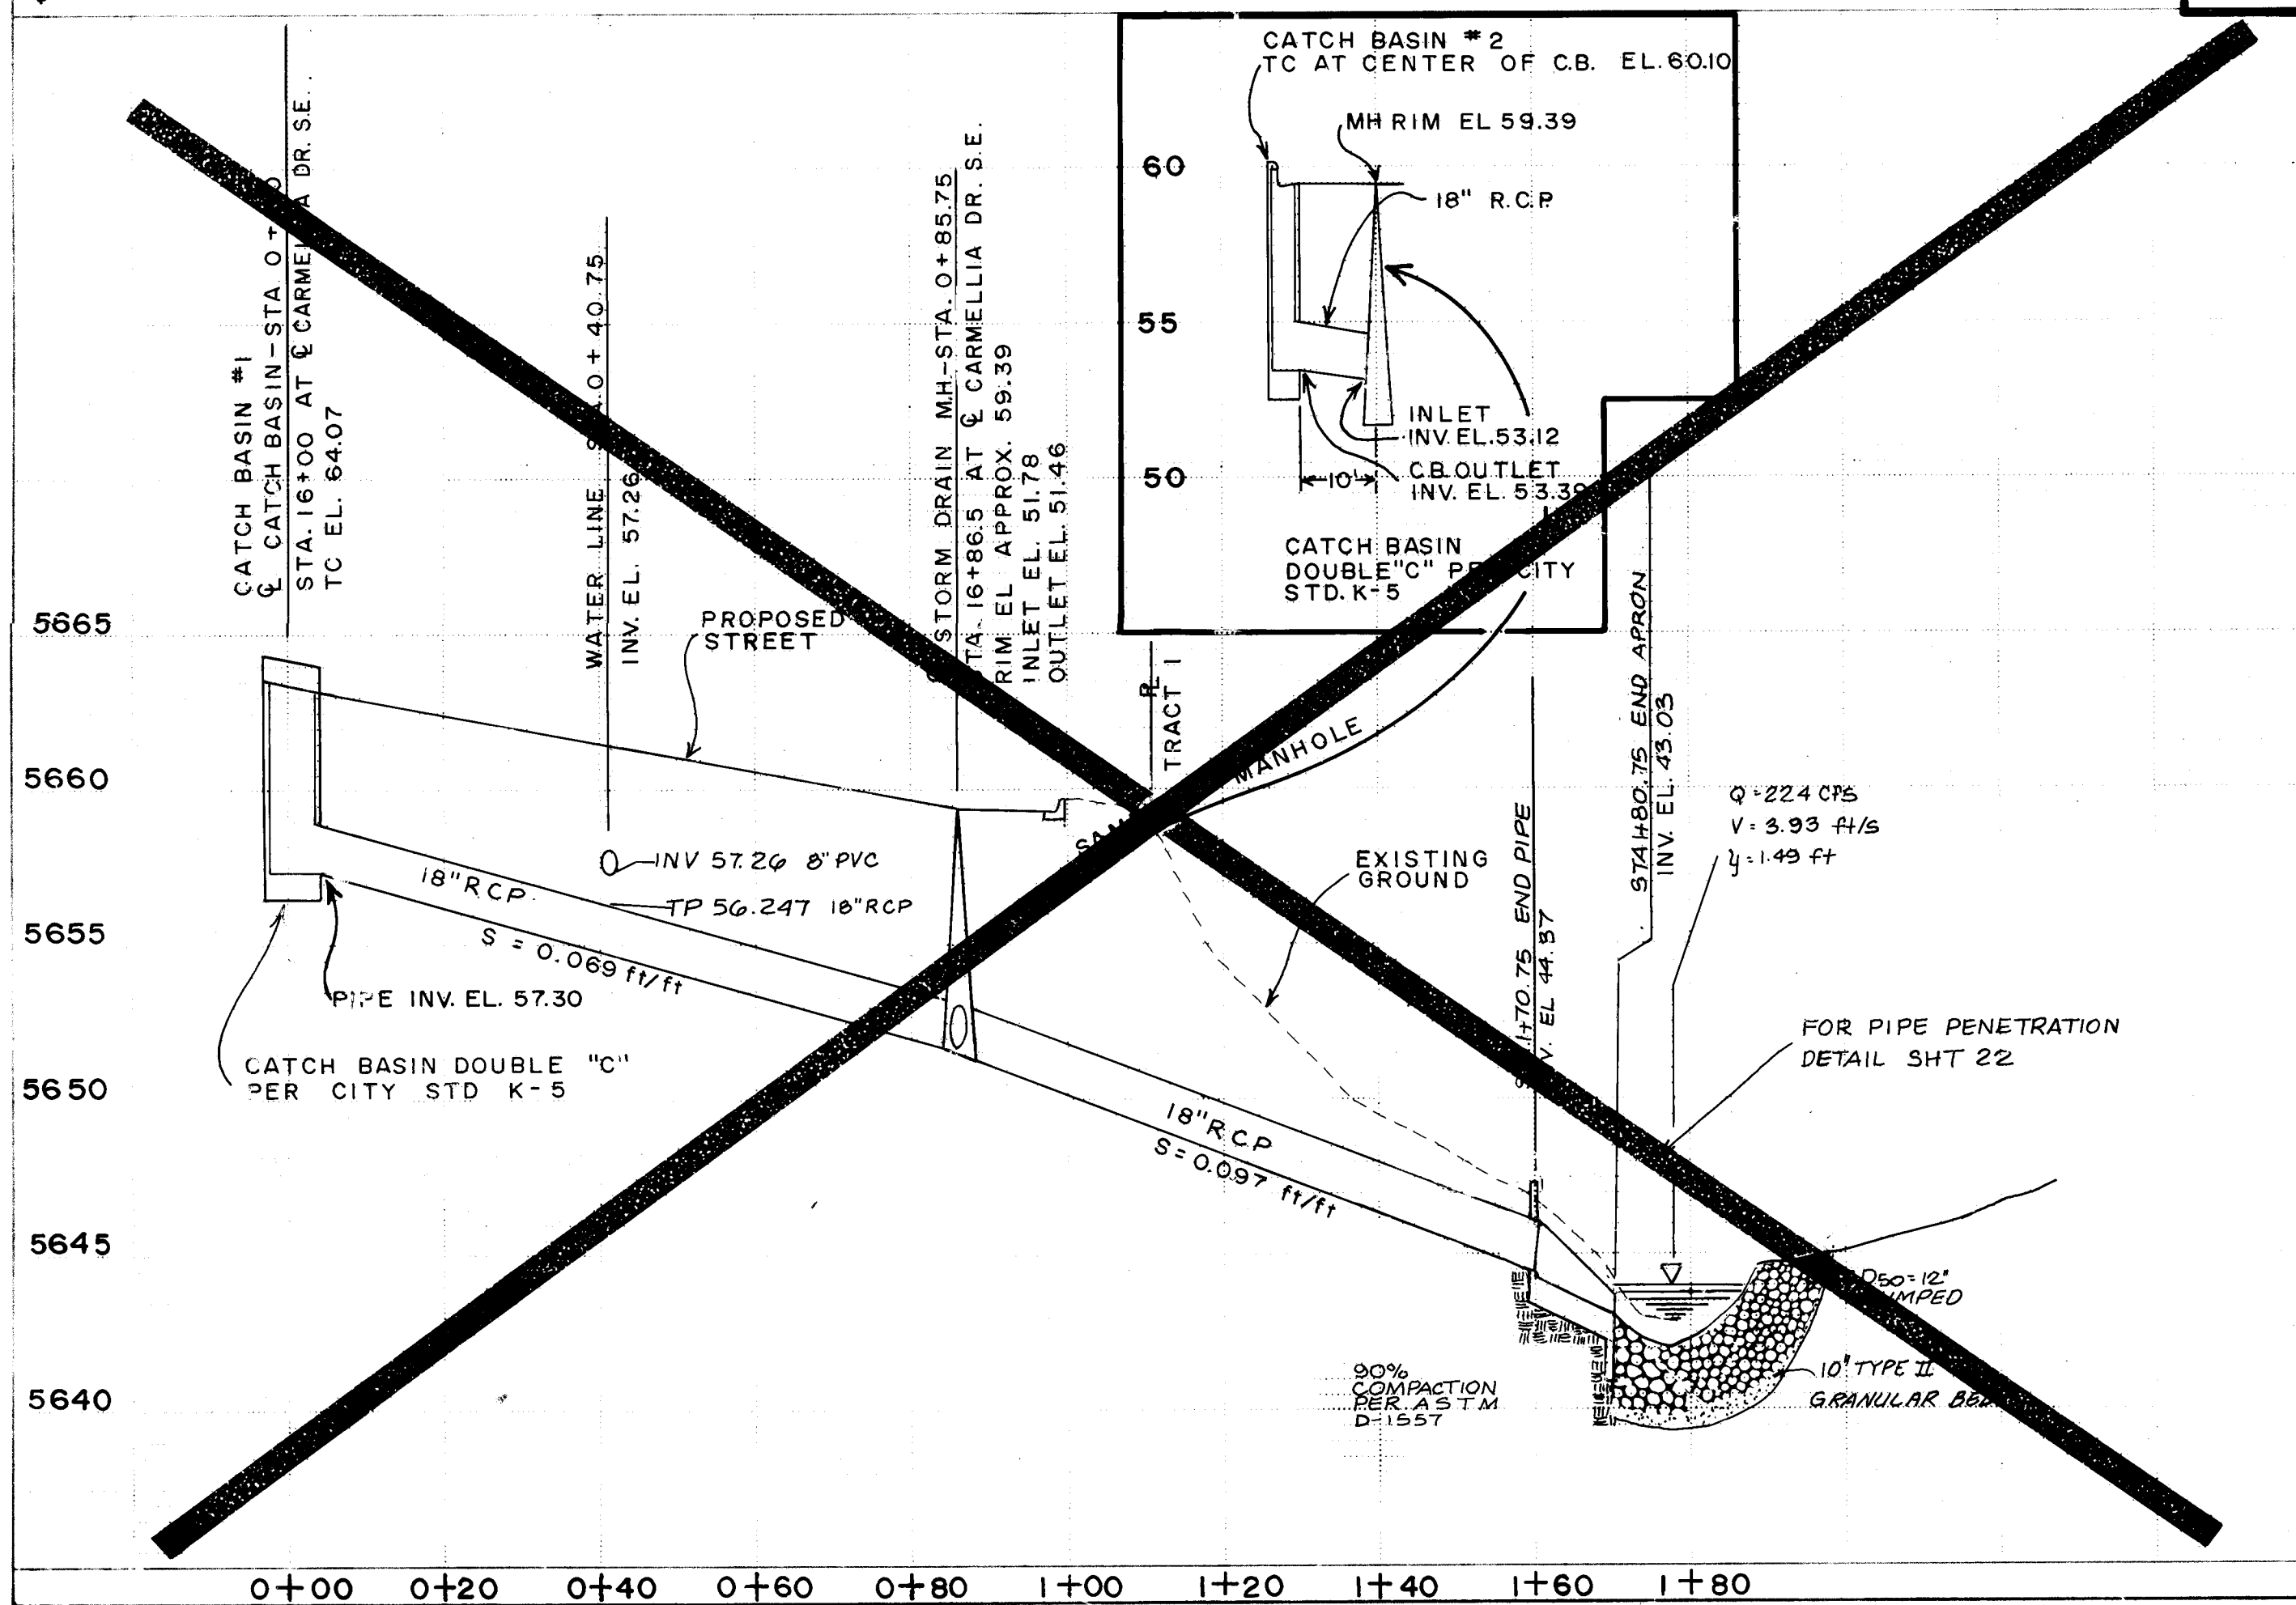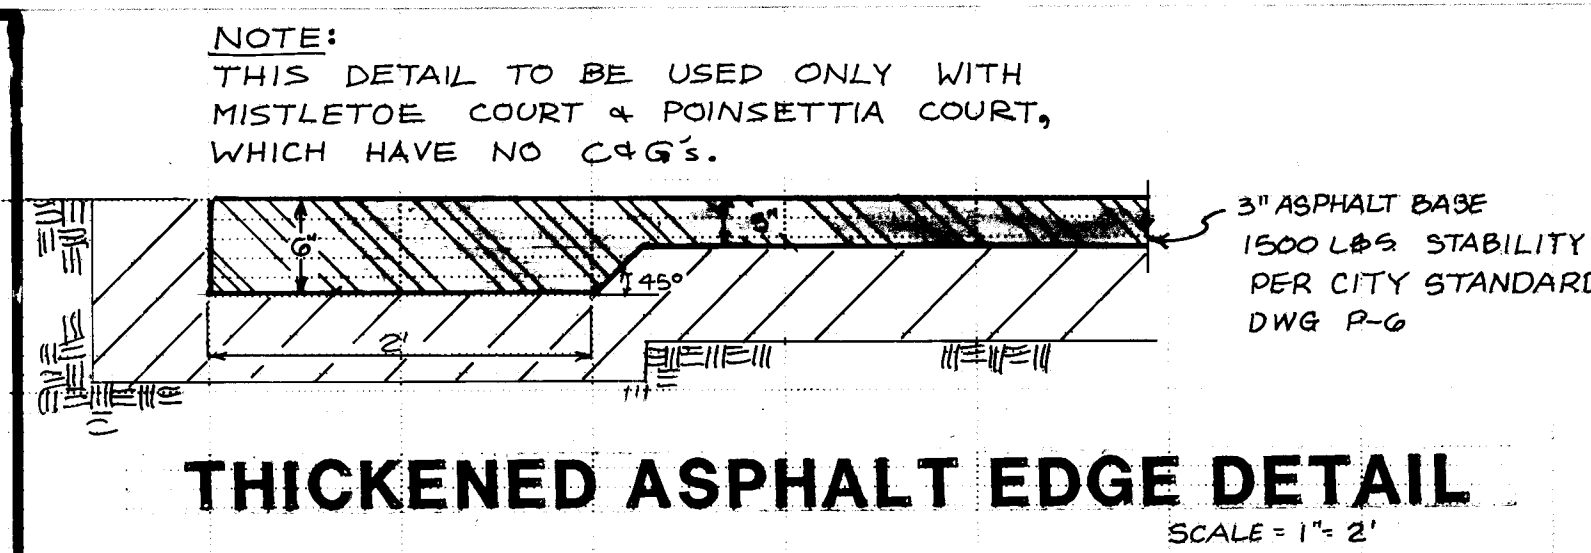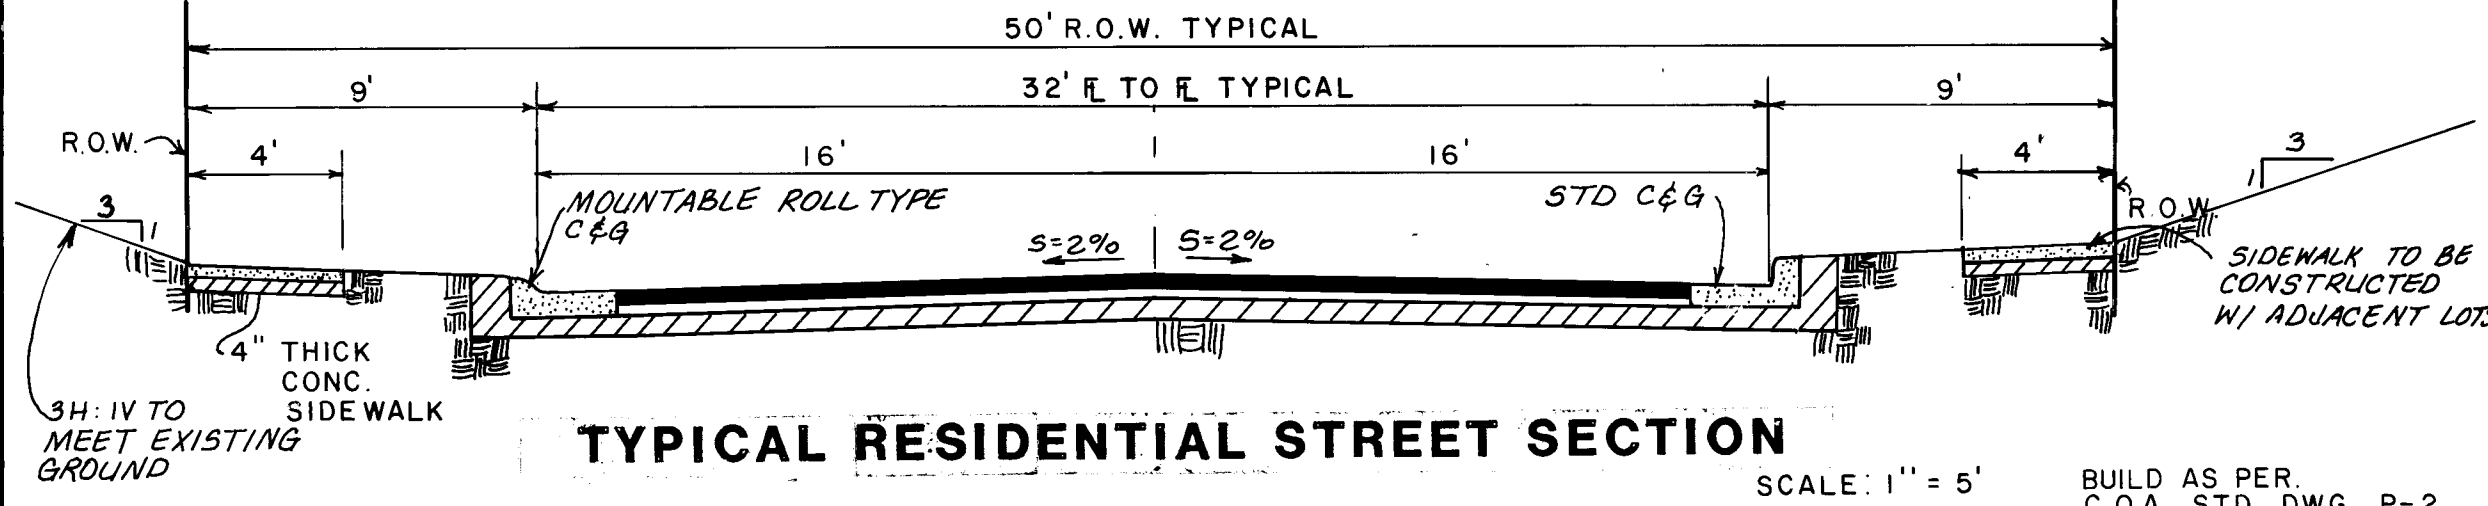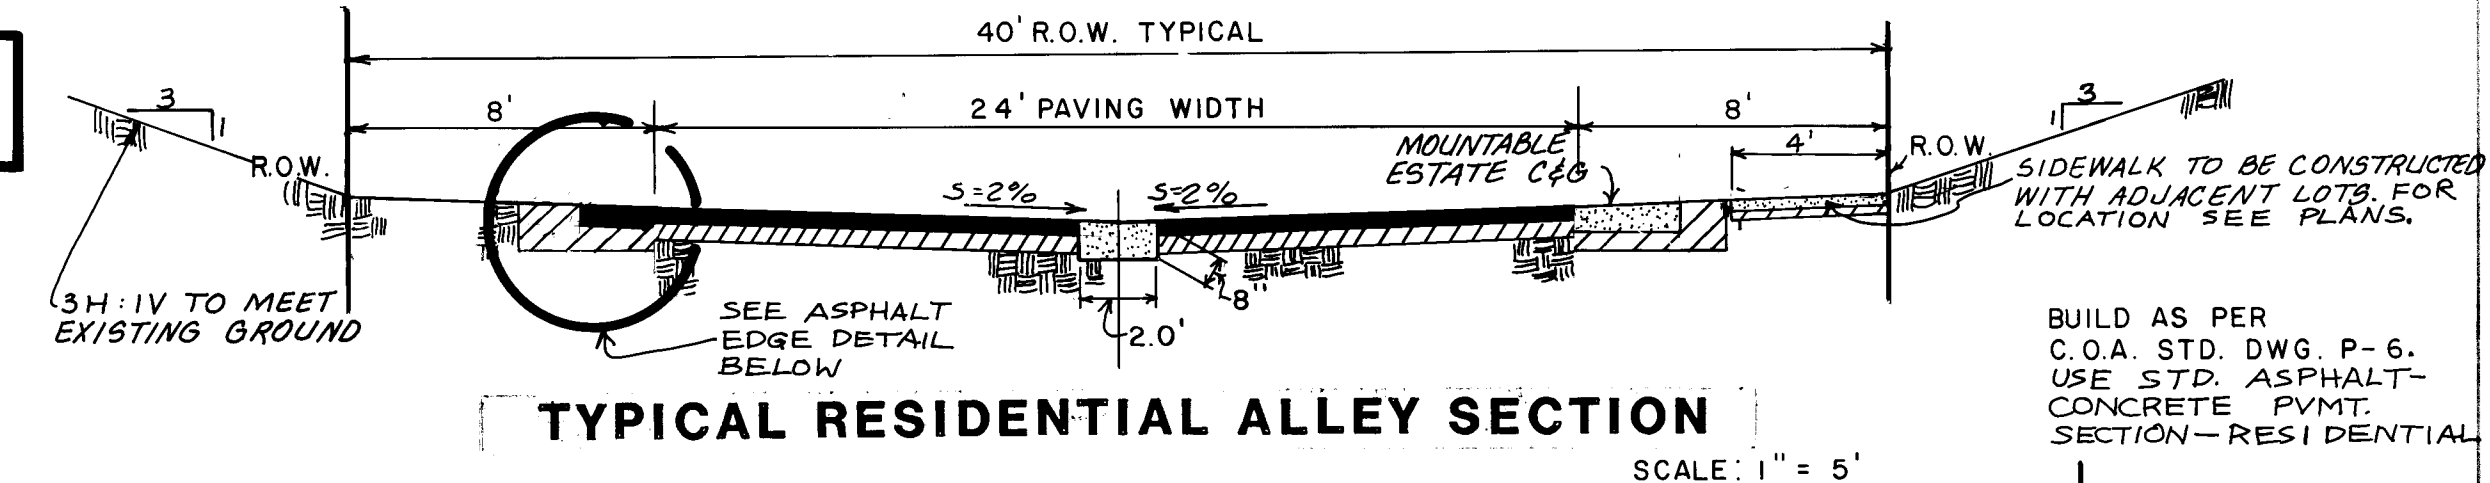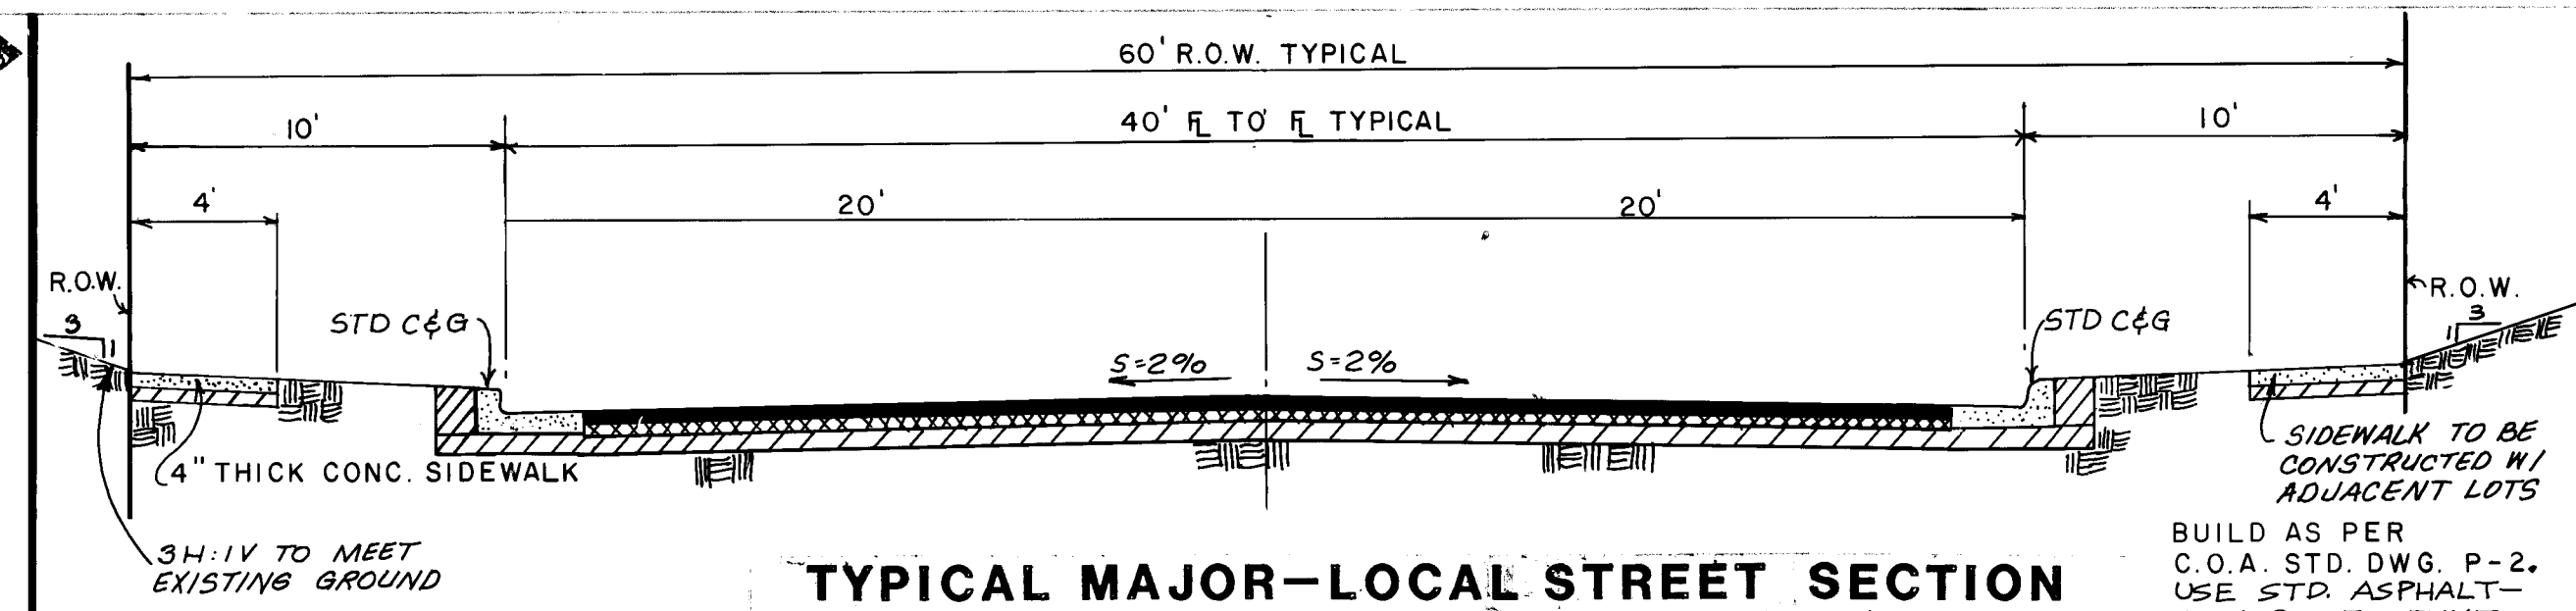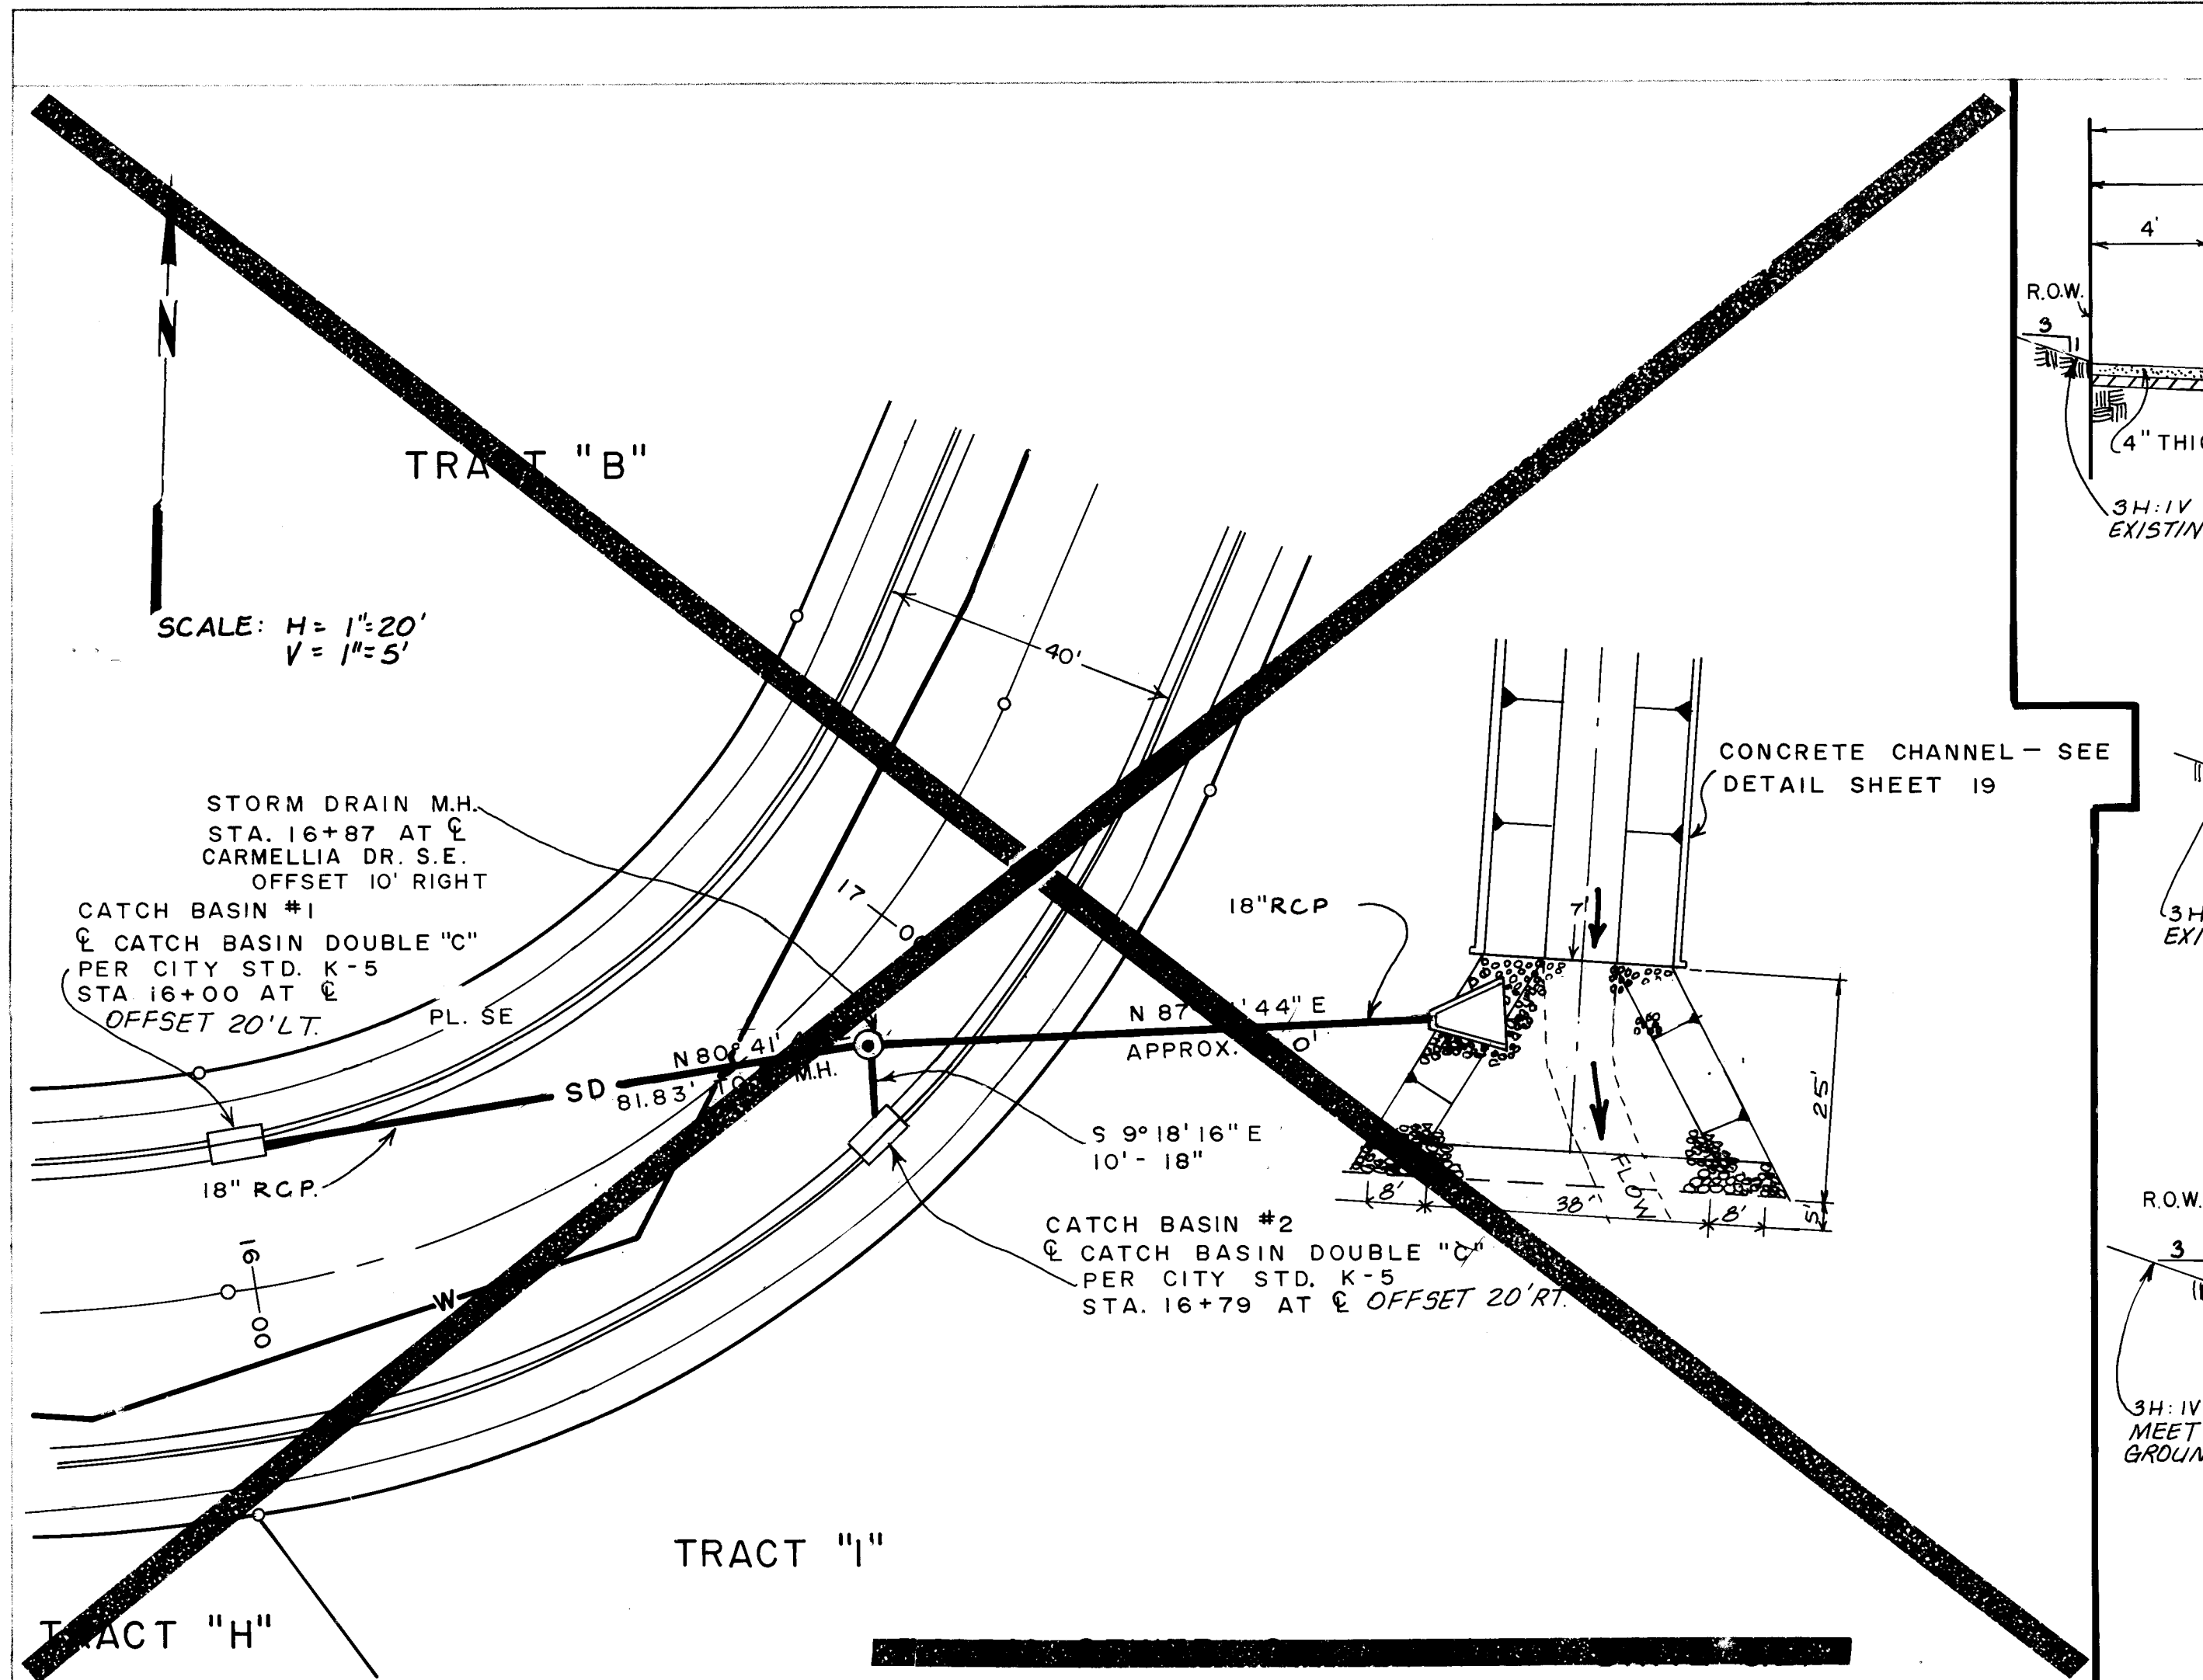

RECORD DRAWING

The improvements shown on this drawing have been as-built in accordance with field information provided by D. Mark Goodwin and Associates, PA, and by MJB Construction Company (Contractor) to reflect construction actually accomplished to the best of my knowledge and belief.

Mark Goodwin, P.E. 8948

Date 6/26/89



CITY OF ALBUQUERQUE
MUNICIPAL DEVELOPMENT DEPARTMENT
ENGINEERING DIVISION

TITLE NORTH FOUR HILLS SUBDIVISION
TYPICAL STREET SECTIONS

APPROVALS	ENGINEER	DATE	APPROVALS	ENGINEER	DATE
City Engineer	Mark Goodwin	2/2/97	Liquid Waste	N/A	10/1/86
A.C.E. Design	N/A		Traffic	N/A	10/1/86
Hydrology	N/A		Water	N/A	10/1/86

DRAWING NO. 2565 MAP NO. L-23 SHEET 18 OF 22

CONTROL: TO M, APPROX. 712' SOUTH OF 1-40 FRONTAGE ROAD AND APPROX. 250' EAST OF ROSEWOOD PLACE, SE AT APPROX. STA. 7+76 STANDARD A.C.S. BRASS CAP STAMPED "TOM".

EL. 5711.67

REVISIONS

NO. DATE BY

1 10/1/86 SD, ED

2 10/1/86 SD, CM, FM

3 10/1/86 ED

REMARKS




REVISIONS

NO. DATE BY

1 10/1/86 SD, ED

2 10/1/86 SD, CM, FM

3 10/1/86 ED

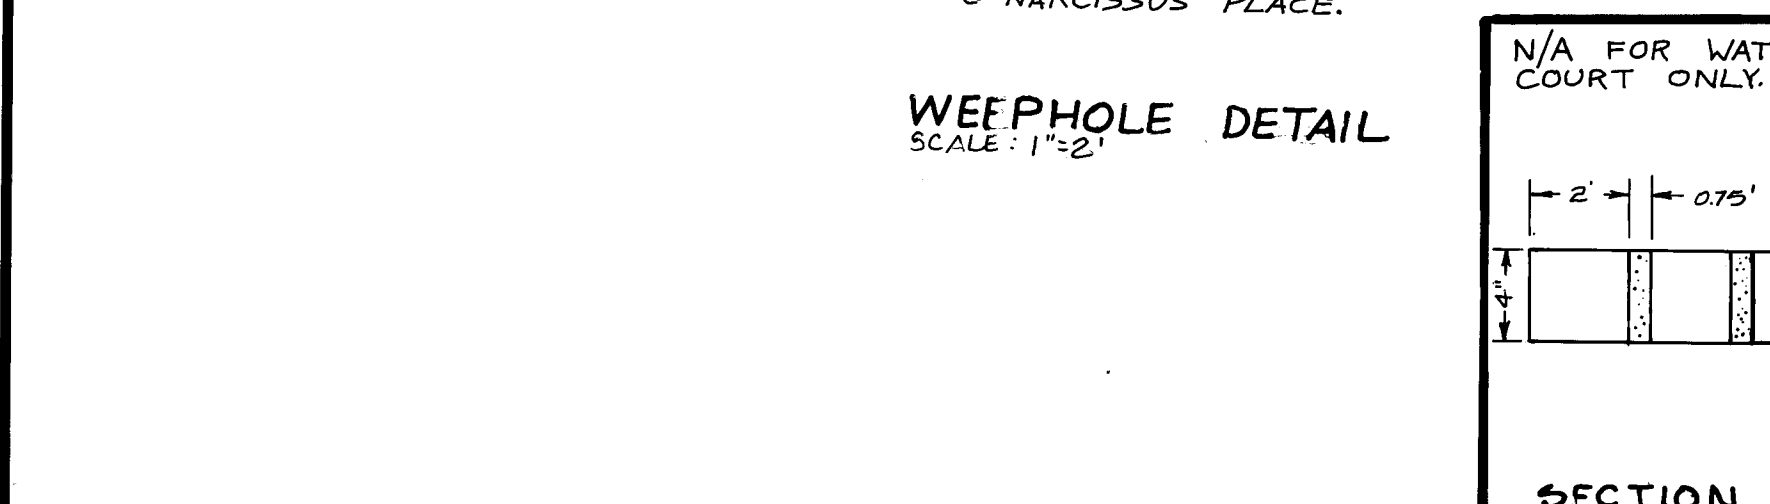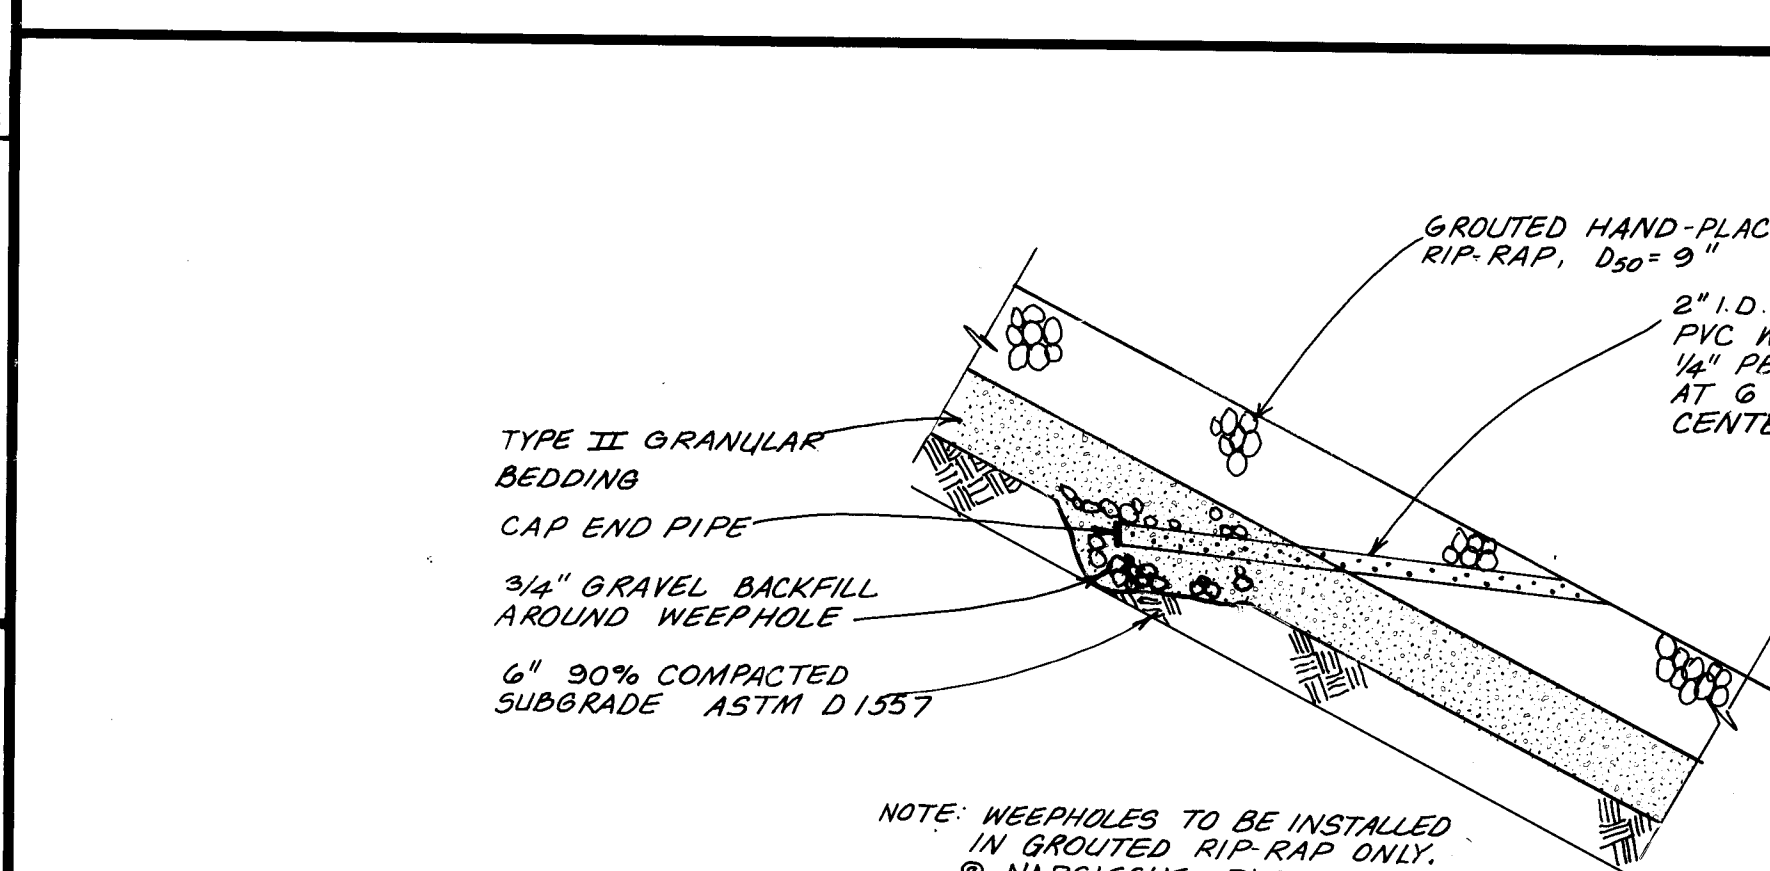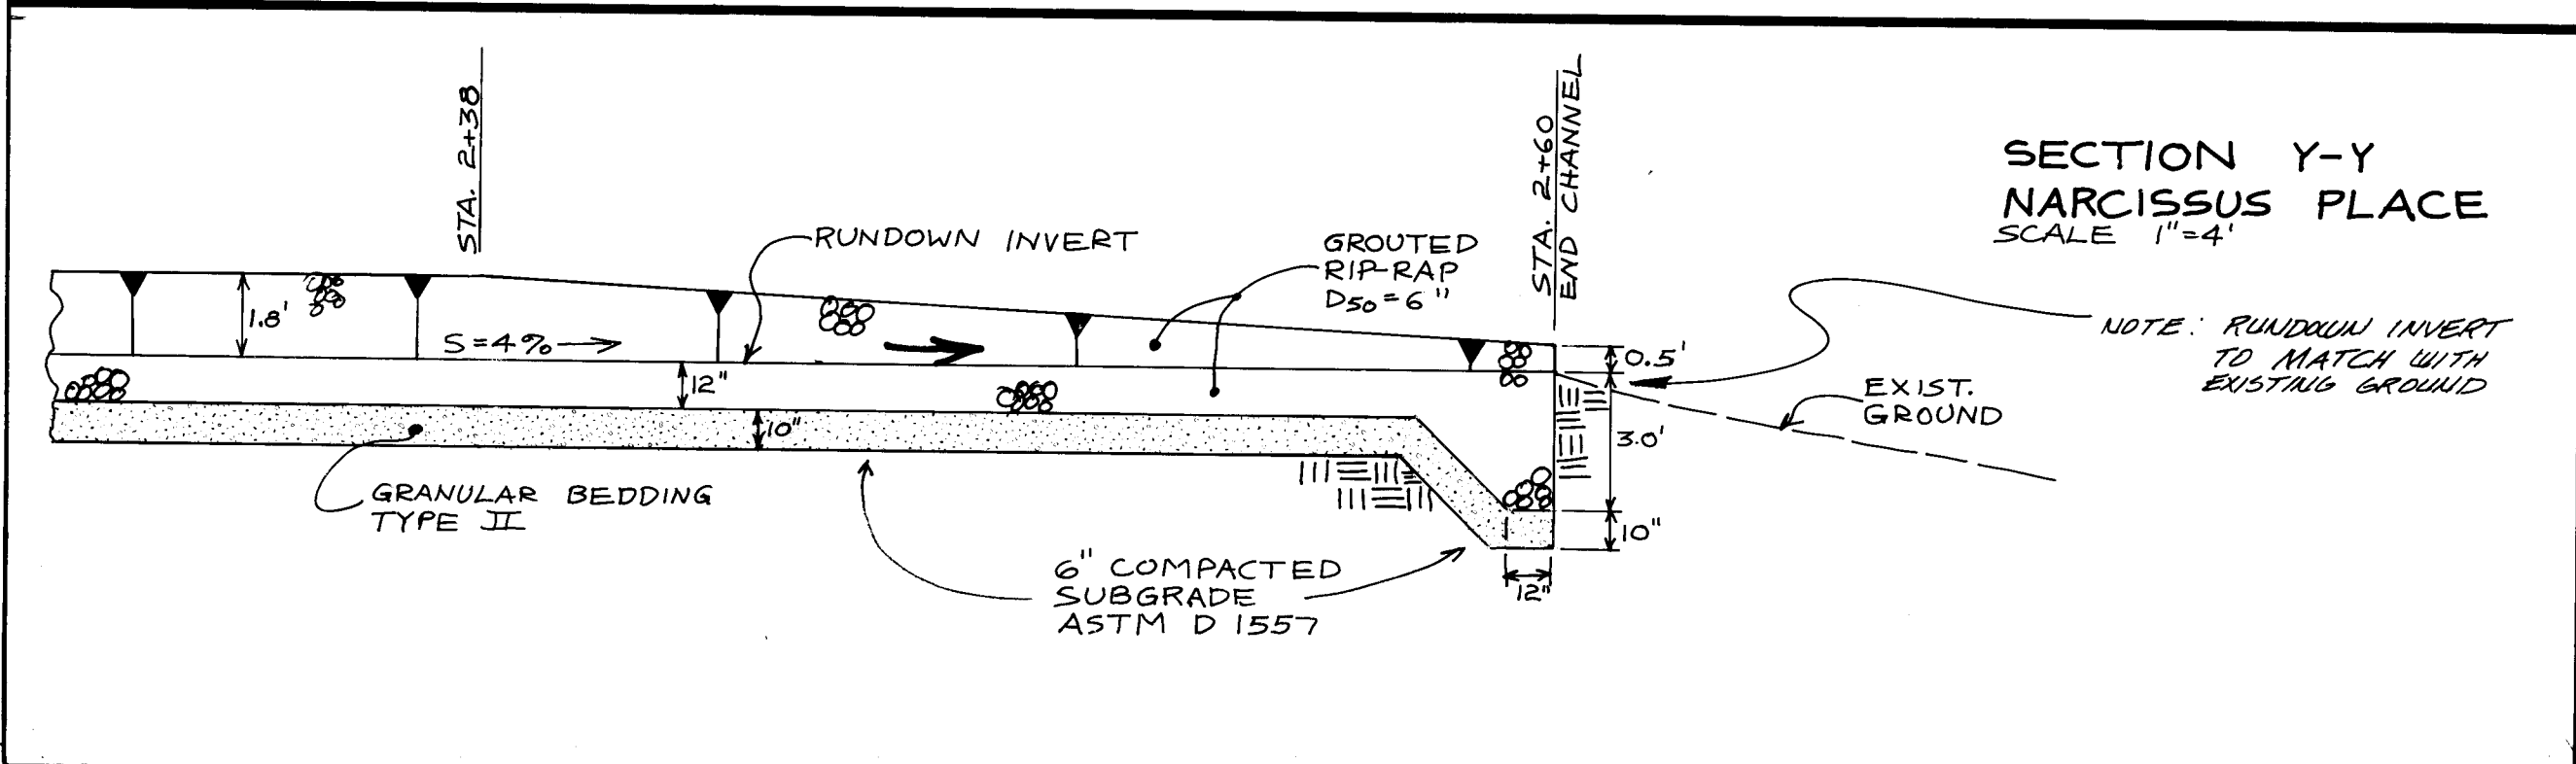

RUNDOWN ENTRANCE
PLAN VIEW FOR
POINSETTIA PLACE &
WATERLILY COURT
5041 E. 4TH ST.



The improvements shown on this drawing have been as-built in accordance with field information provided by D. Mark Goodwin and Associates, PA, and by MJB Construction Company (Contractor) to reflect construction actually accomplished to the best of my knowledge and belief.

Mark Goodwin, P.F. 8948 6/26/89
Date

Sieve Size	% by Weight passing Square Mesh Sieves	
	Type I	Type II
2"	-	90-100
1-1/2"	-	-
3/4"	-	20-90
3/8"	100	-
#4	95-100	0-20
#16	45-80	-
#50	10-30	-
#100	2-10	-
#200	0-2	0-3

CITY OF ALBUQUERQUE
MUNICIPAL DEVELOPMENT DEPARTMENT
ENGINEERING DIVISION

TITLE: NORTH FOUR HILLS SUBDIVISION				
RIP-RAP RUNDOWN DETAILS				
APPROVALS	ENGINEER	DATE	APPROVALS	ENGINEER
City Engineer	<i>Justin L. ...</i>	2/13/67	Liquid Waste	N/A N/W 10/1/86
A.C.E. - Design	<i>...</i>	...	Traffic	N/A N/W 10/1/86
A.C.E. - Hydrology	<i>J. J. ...</i>	2/12/67	Water	N/A N/W 10/1/86
DRAWING NO. 2565		MAP NO. 23		SHEET 21 OF 22

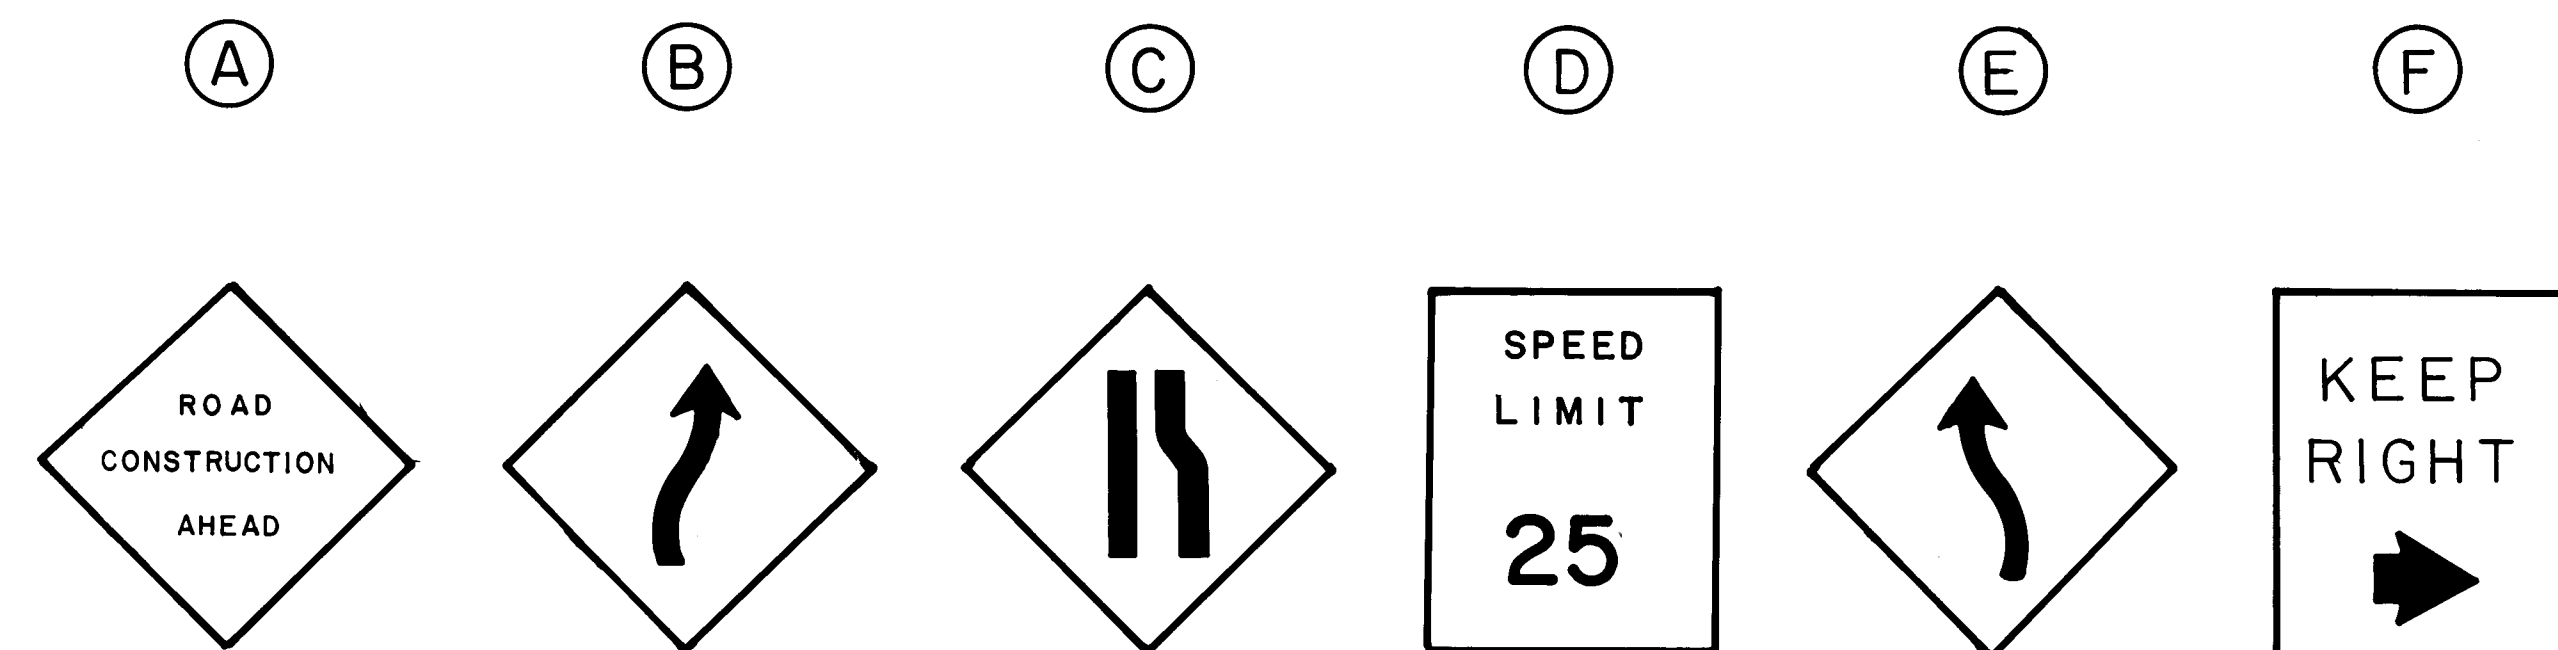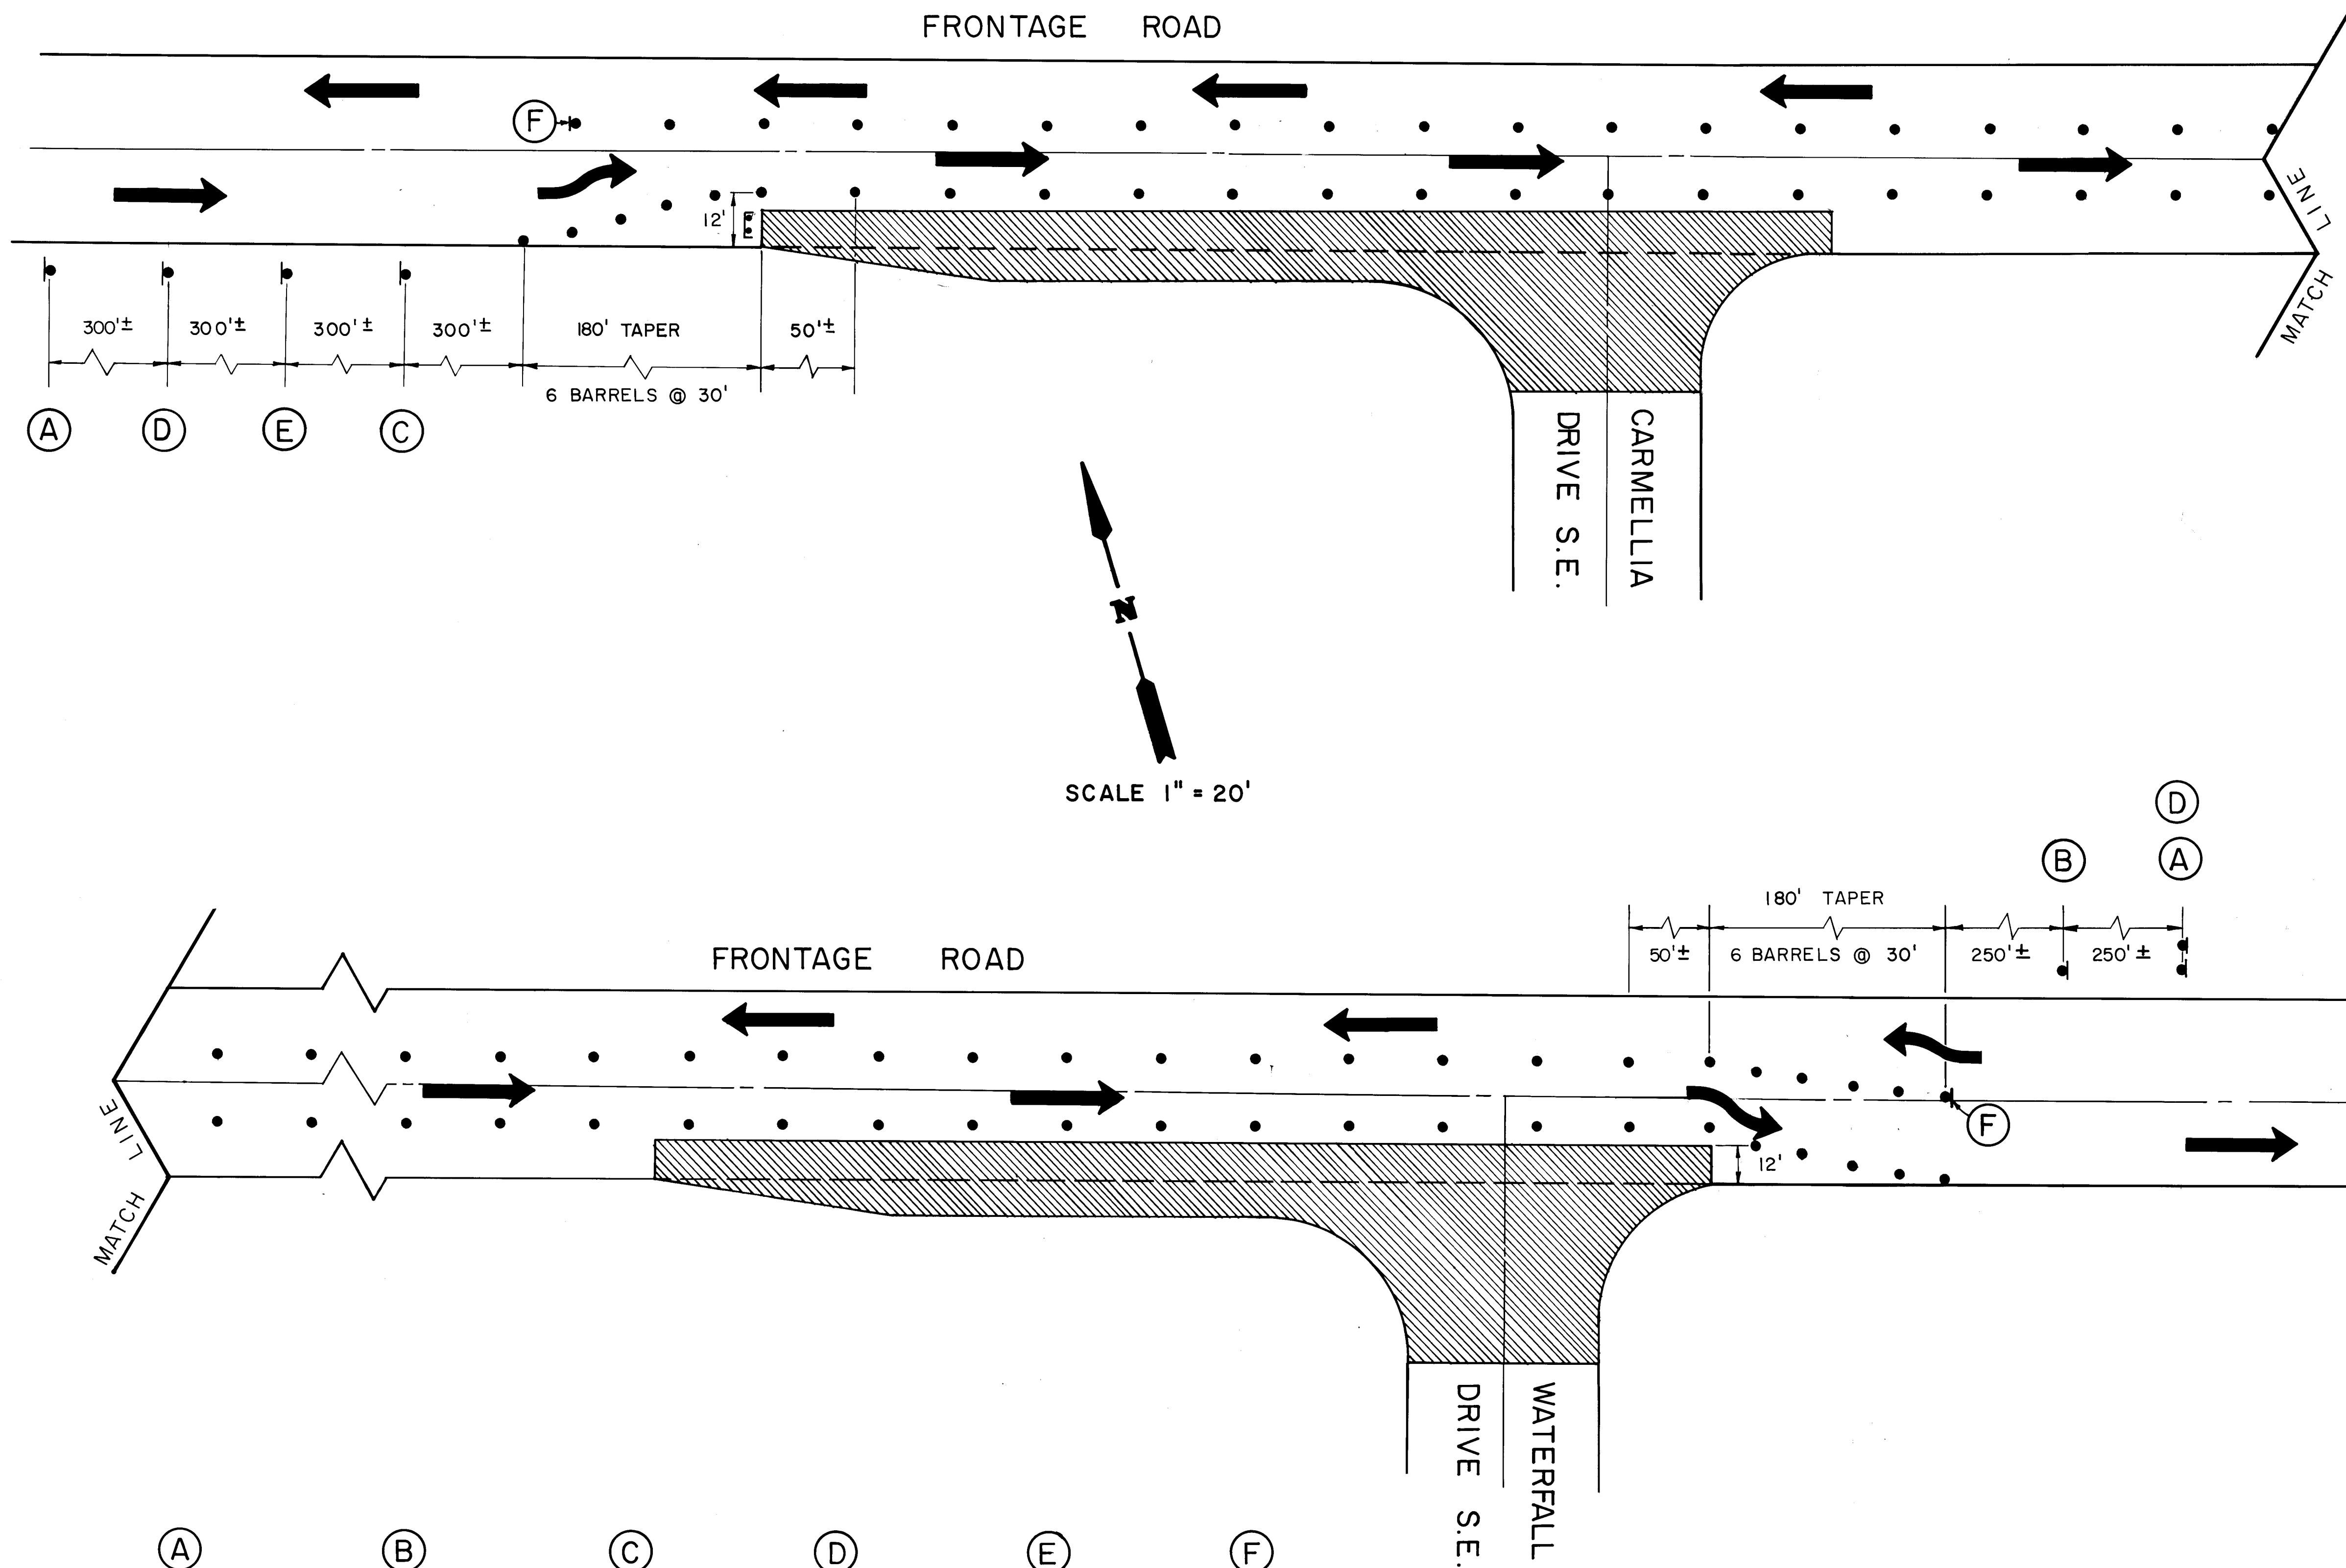

NOT TO SCALE

The improvements shown on this drawing have been as-built in accordance with field information provided by D. Mark Goodwin and Associates, PA, and by MJB Construction Company (Contractor) to reflect construction actually accomplished to the best of my knowledge and belief.

Mark Goodwin, P.E. 8948

6/26/87



2 6 2 5 6 5 2 2 8 9 4

LEGEND


WORKSITE

BARRELS

ADVANCE WARNING

DIRECTION OF TRAFFIC





TYPE THREE BARRICADE

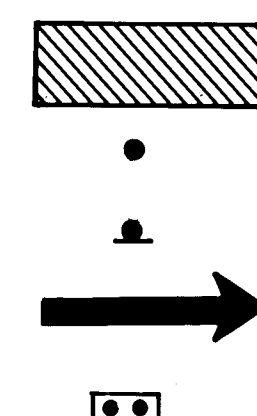


RECORD DRAWING

AS BUILT INFORMATION			BENCH MARKS			SURVEY INFORMATION			ENGINEER'S SEAL		
DATE	BY	REMARKS	DATE	BY	REMARKS	NO.	DATE	BY	NO.	DATE	BY
12/16/86	BT	DESIGNED BY	12/16/86	BT	DESIGNED BY	1	12/16/86	BT	1	12/16/86	BT
12/16/86	VVH	DRAWN BY	12/16/86	VVH	DRAWN BY	2	12/16/86	VVH	2	12/16/86	VVH
12/16/86	VVH	CHECKED BY	12/16/86	VVH	CHECKED BY	3	12/16/86	VVH	3	12/16/86	VVH
12/16/86	VVH	REVISIONS	12/16/86	VVH	REVISIONS	4	12/16/86	VVH	4	12/16/86	VVH
12/16/86	VVH	DESIGN	12/16/86	VVH	DESIGN	5	12/16/86	VVH	5	12/16/86	VVH
12/16/86	VVH	TRAFFIC CONTROL PLAN	12/16/86	VVH	TRAFFIC CONTROL PLAN	6	12/16/86	VVH	6	12/16/86	VVH
12/16/86	VVH	APPROVALS	12/16/86	VVH	APPROVALS	7	12/16/86	VVH	7	12/16/86	VVH
12/16/86	VVH	ENGINEER	12/16/86	VVH	ENGINEER	8	12/16/86	VVH	8	12/16/86	VVH
12/16/86	VVH	DATE	12/16/86	VVH	DATE	9	12/16/86	VVH	9	12/16/86	VVH
12/16/86	VVH	LIQUID WASTE	12/16/86	VVH	LIQUID WASTE	10	12/16/86	VVH	10	12/16/86	VVH
12/16/86	VVH	TRAFFIC	12/16/86	VVH	TRAFFIC	11	12/16/86	VVH	11	12/16/86	VVH
12/16/86	VVH	WATER	12/16/86	VVH	WATER	12	12/16/86	VVH	12	12/16/86	VVH

CITY OF ALBUQUERQUE			MUNICIPAL DEVELOPMENT DEPARTMENT		
ENGINEERING DIVISION			TITLE: NORTH FOUR HILLS SUBDIVISION		
TRAFFIC CONTROL PLAN			DRAWING NO. 2565		
APPROVALS			MAP NO. L-23		
ENGINEER			SHEET 22A OF 22		
DATE					
12/16/86	BT	DESIGNED BY	12/16/86	BT	DESIGNED BY
12/16/86	VVH	DRAWN BY	12/16/86	VVH	DRAWN BY
12/16/86	VVH	CHECKED BY	12/16/86	VVH	CHECKED BY
12/16/86	VVH	REVISIONS	12/16/86	VVH	REVISIONS
12/16/86	VVH	DESIGN	12/16/86	VVH	DESIGN
12/16/86	VVH	TRAFFIC CONTROL PLAN	12/16/86	VVH	TRAFFIC CONTROL PLAN
12/16/86	VVH	APPROVALS	12/16/86	VVH	APPROVALS
12/16/86	VVH	ENGINEER	12/16/86	VVH	ENGINEER
12/16/86	VVH	DATE	12/16/86	VVH	DATE
12/16/86	VVH	LIQUID WASTE	12/16/86	VVH	LIQUID WASTE
12/16/86	VVH	TRAFFIC	12/16/86	VVH	TRAFFIC
12/16/86	VVH	WATER	12/16/86	VVH	WATER

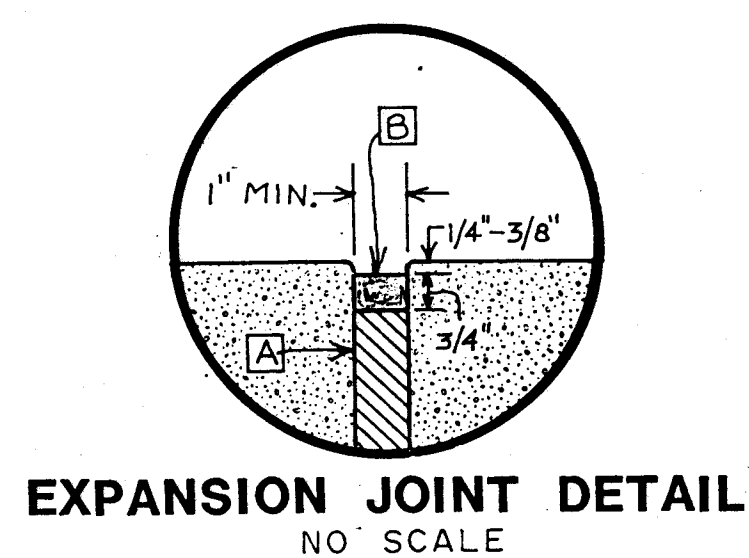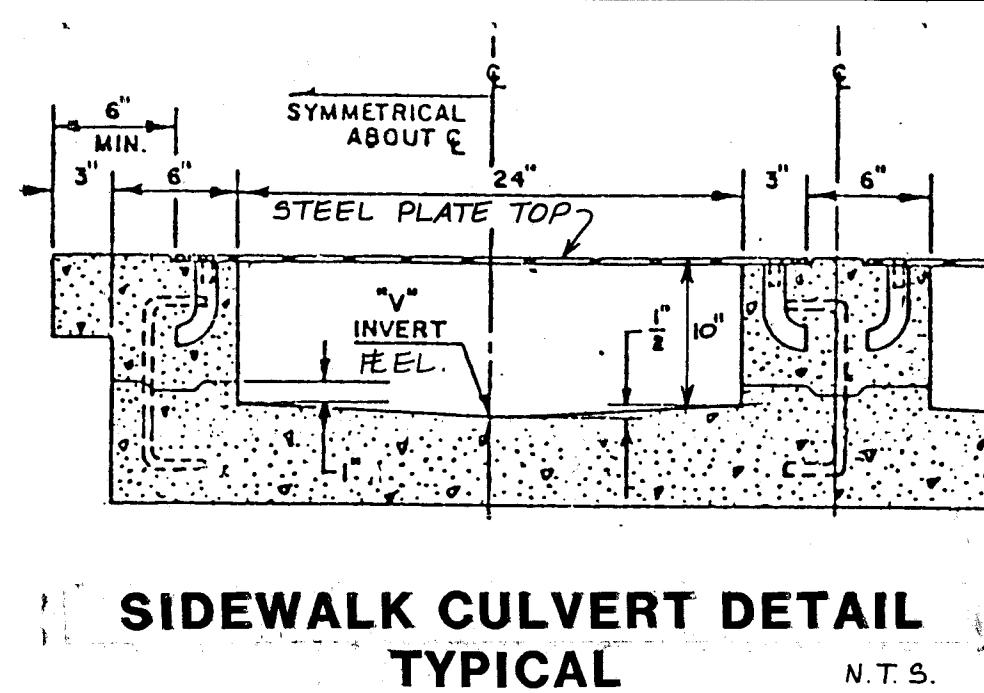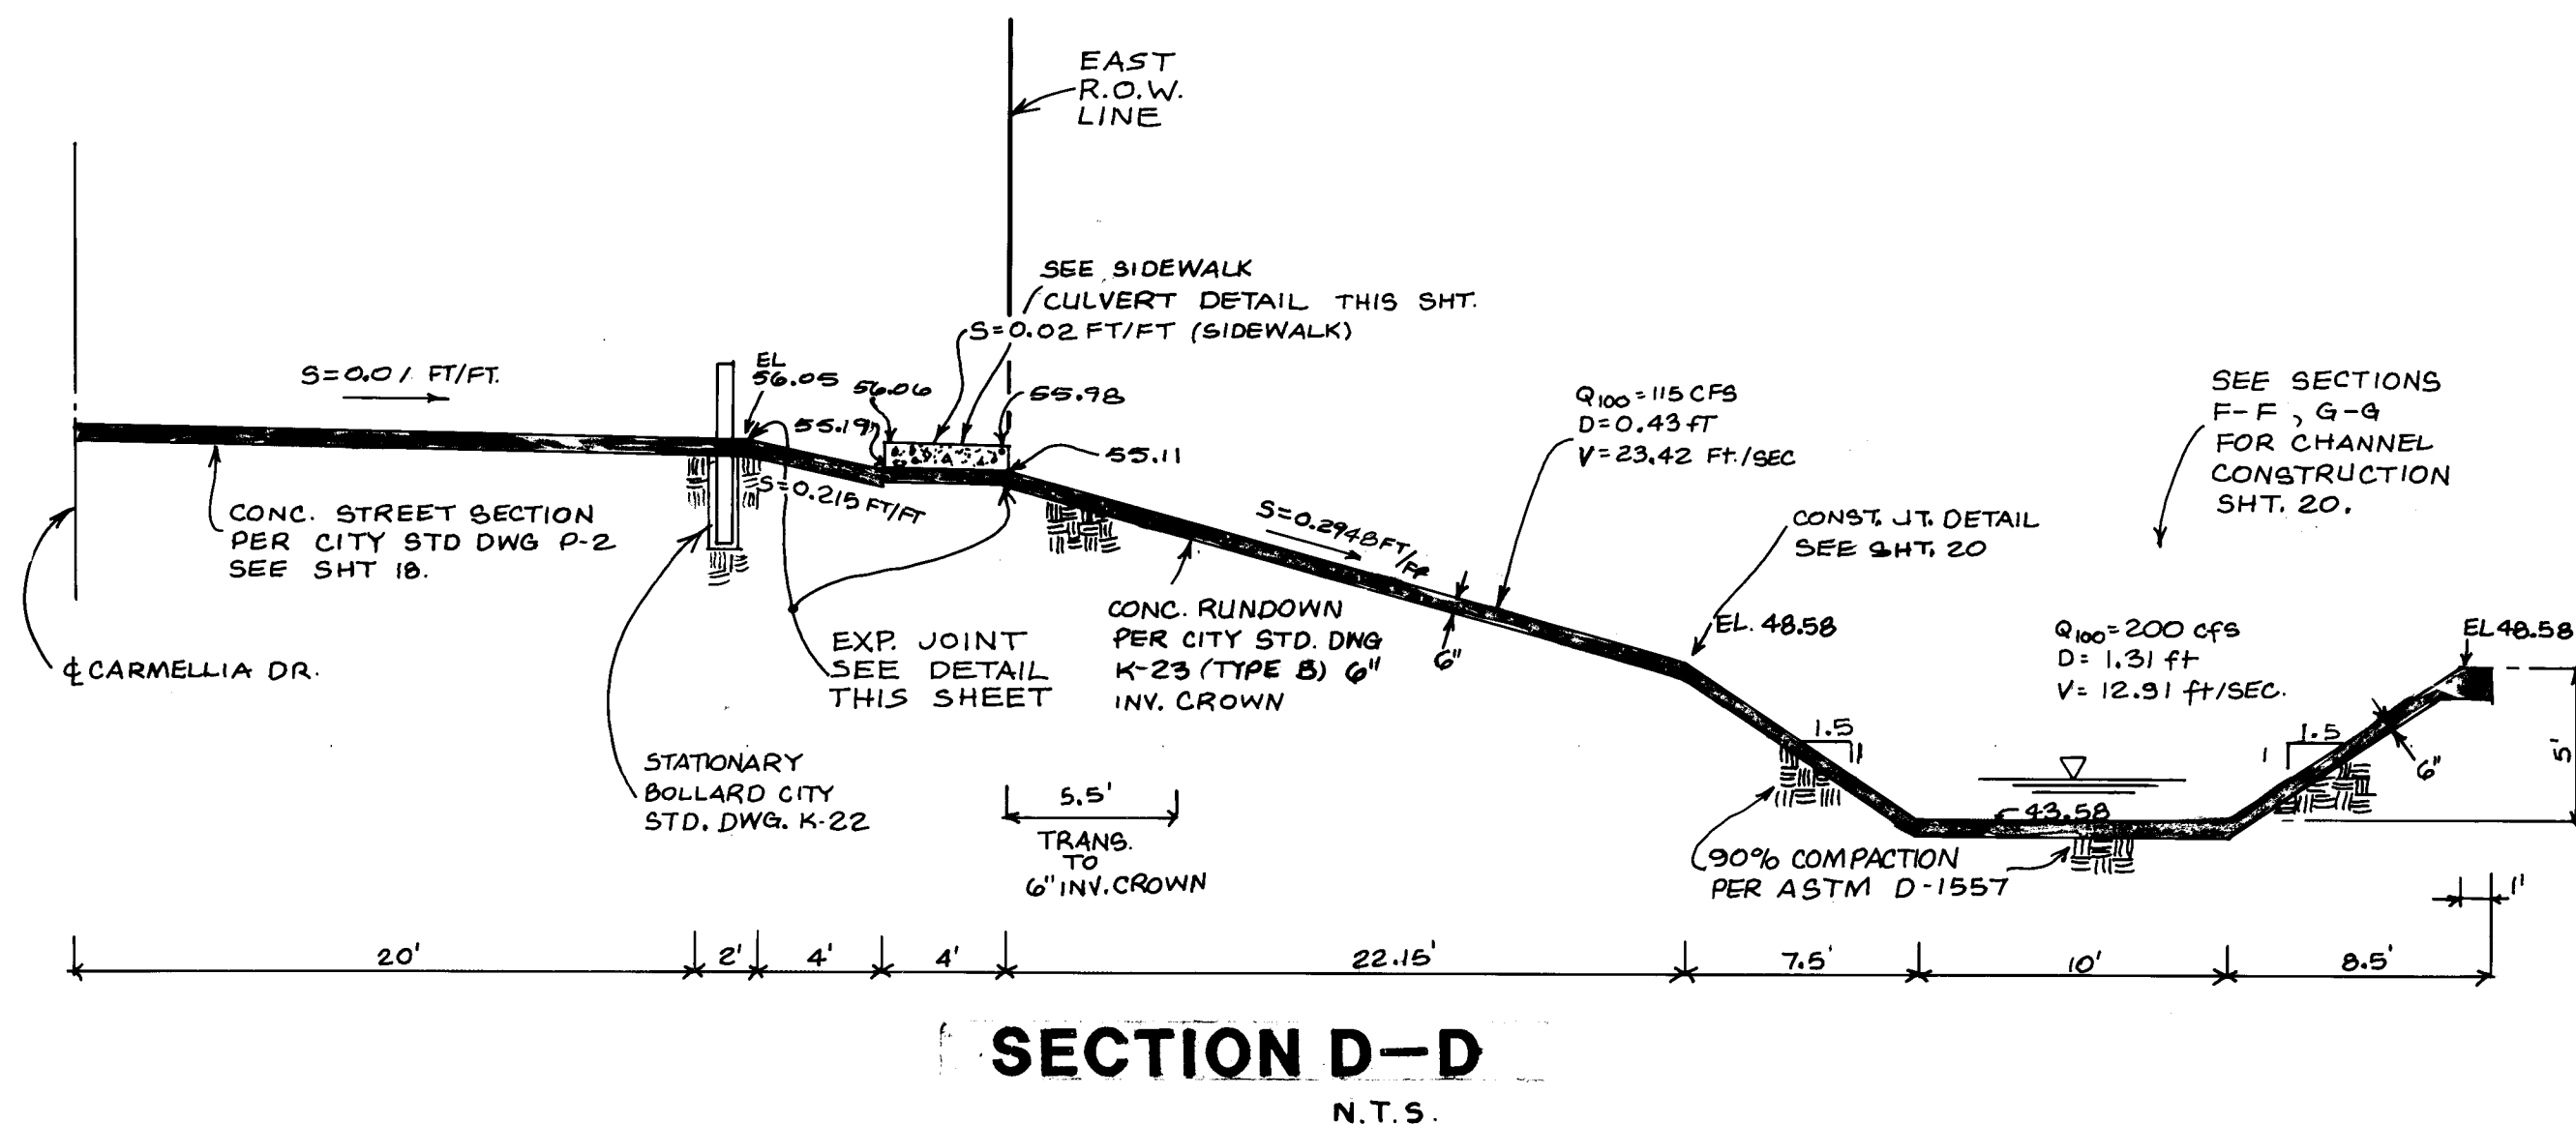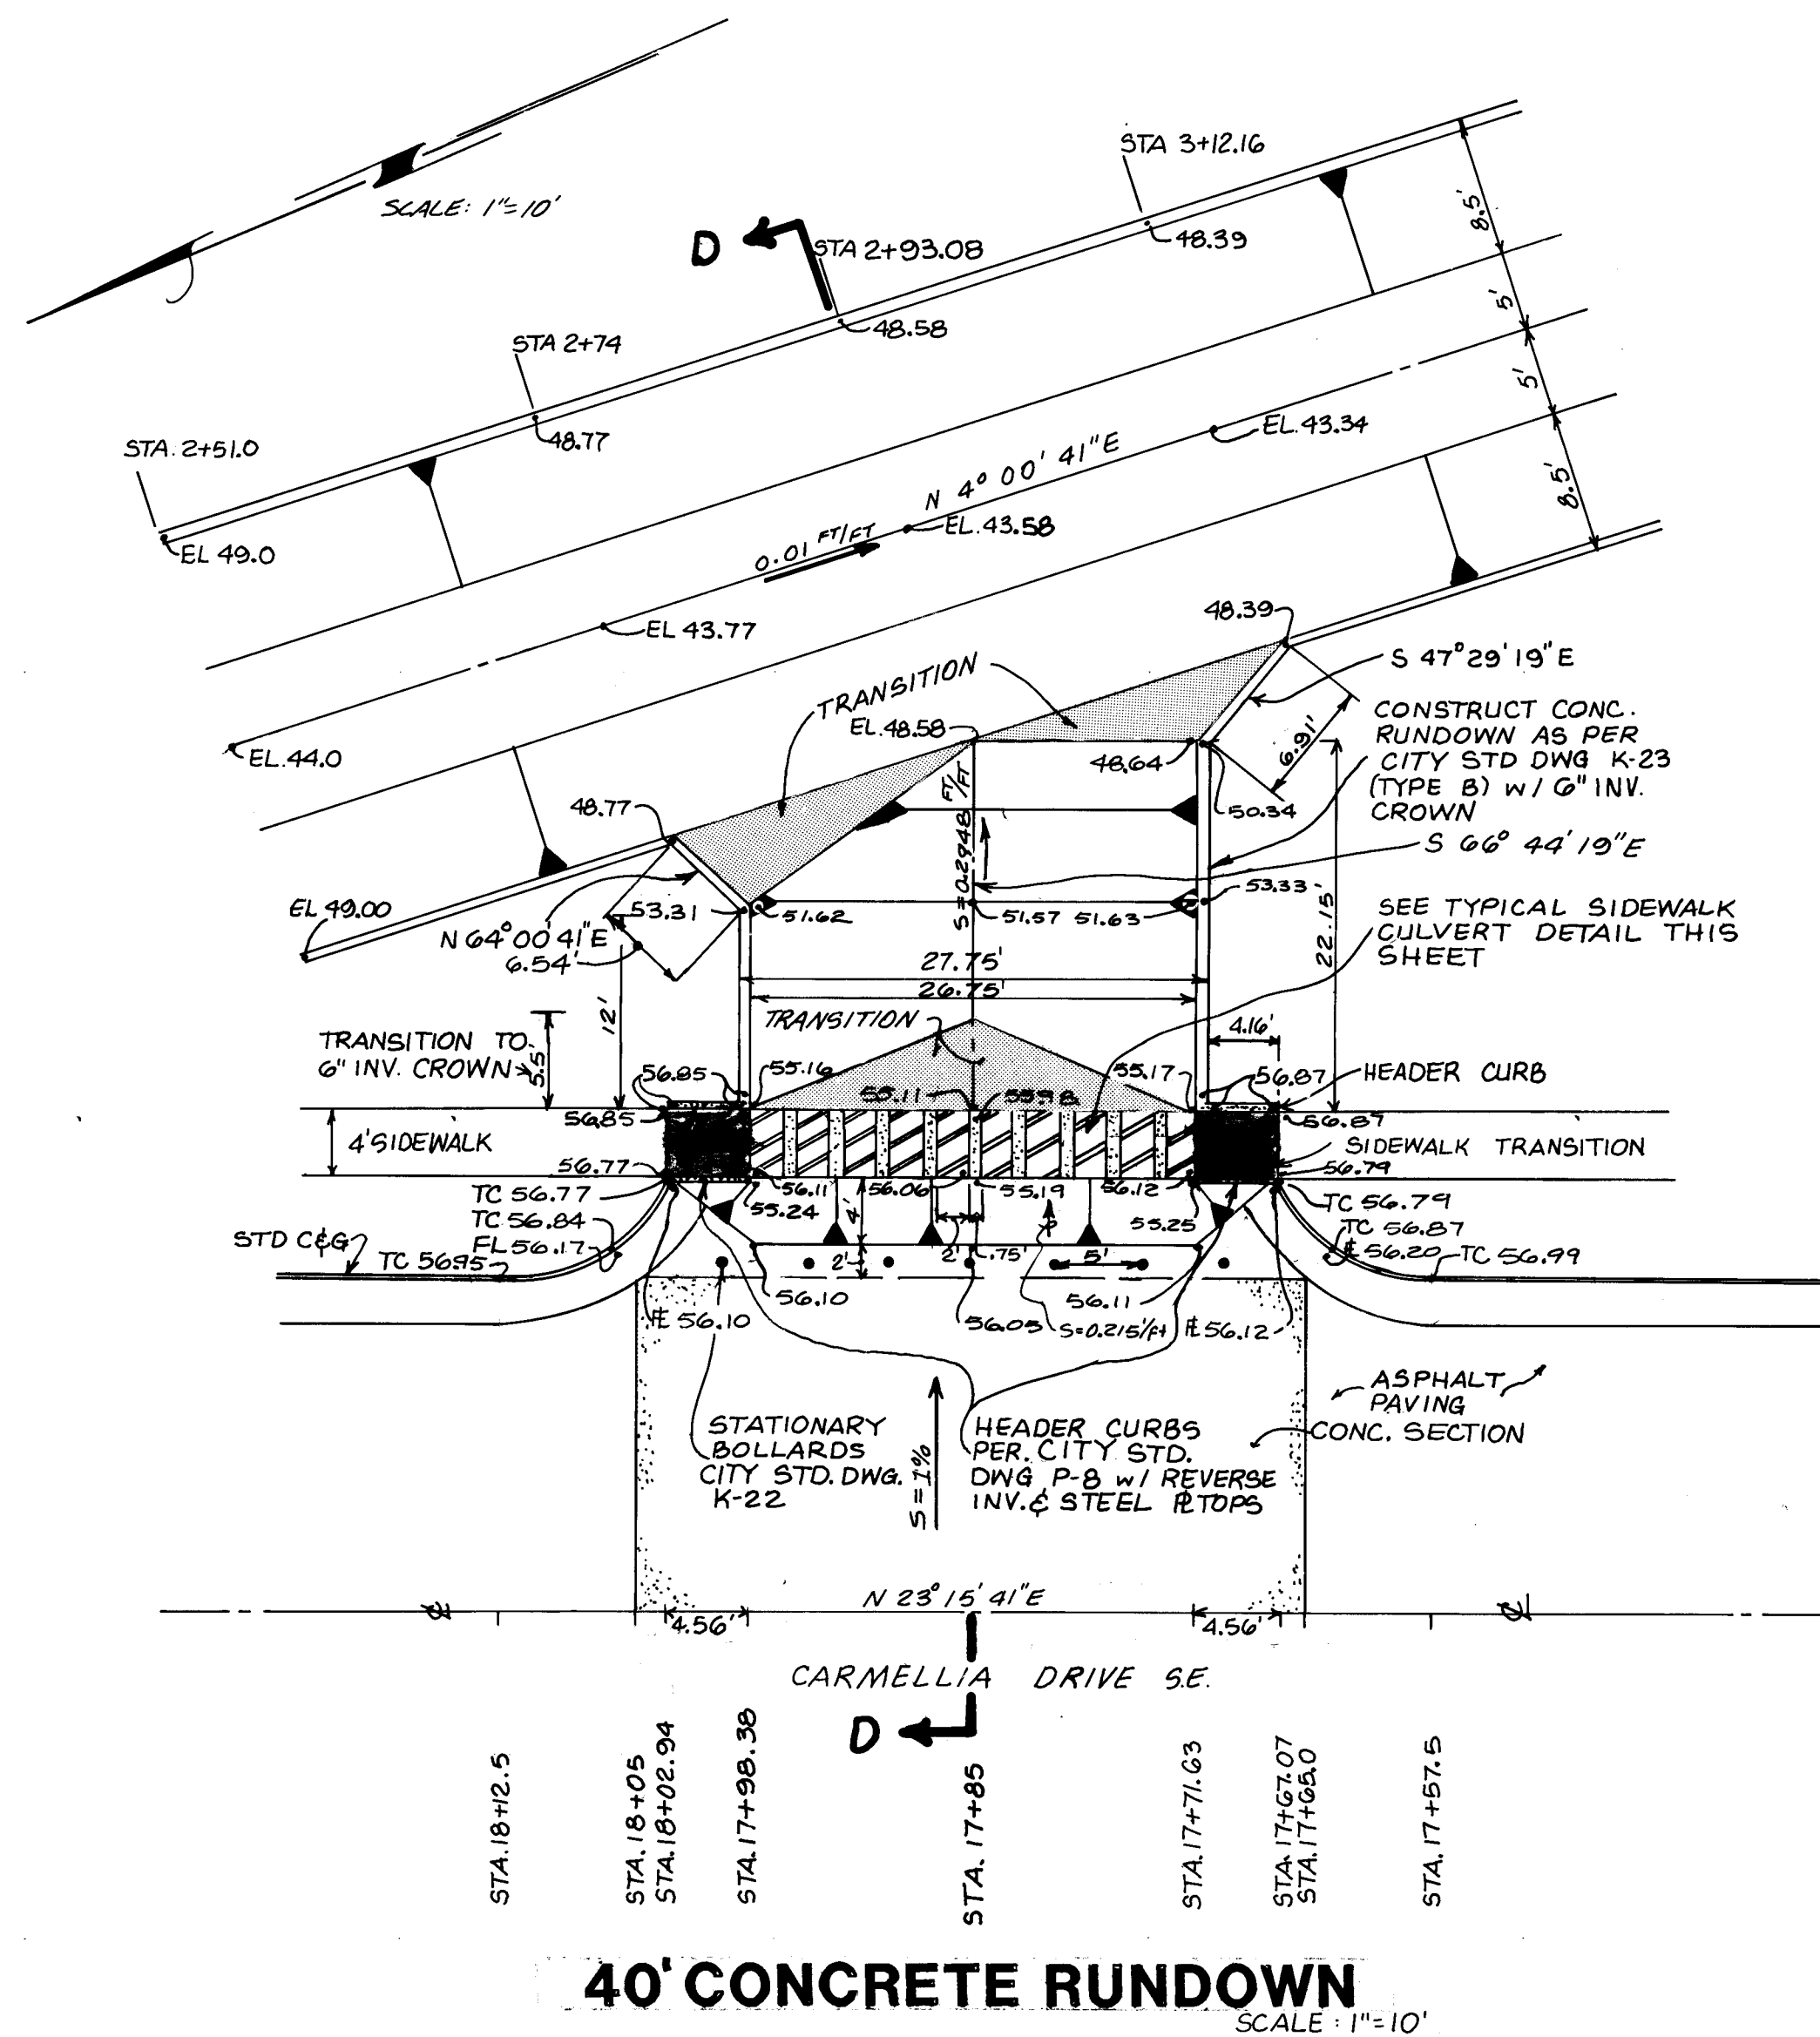


- CONSTRUCTION NOTES
- INSTALL CLOSED CELL POLYETHYLENE FILLER SHEET, PLASTAZOTE OR EQUAL, OR FOAM POLYETHYLENE BACKER ROD, HBR OR EQUAL, WITHOUT BENDING.
 - APPLY TWO COMPONENT EPOXY BONDER, EVA-POX BONDER #2 OR EQUAL AND ETHYLENE VINYL ACETATE SEALANT, EVA-SEAL OR EQUAL, 3/4" THICK AND 1/4" WIDER THAN FORMED JOINT.

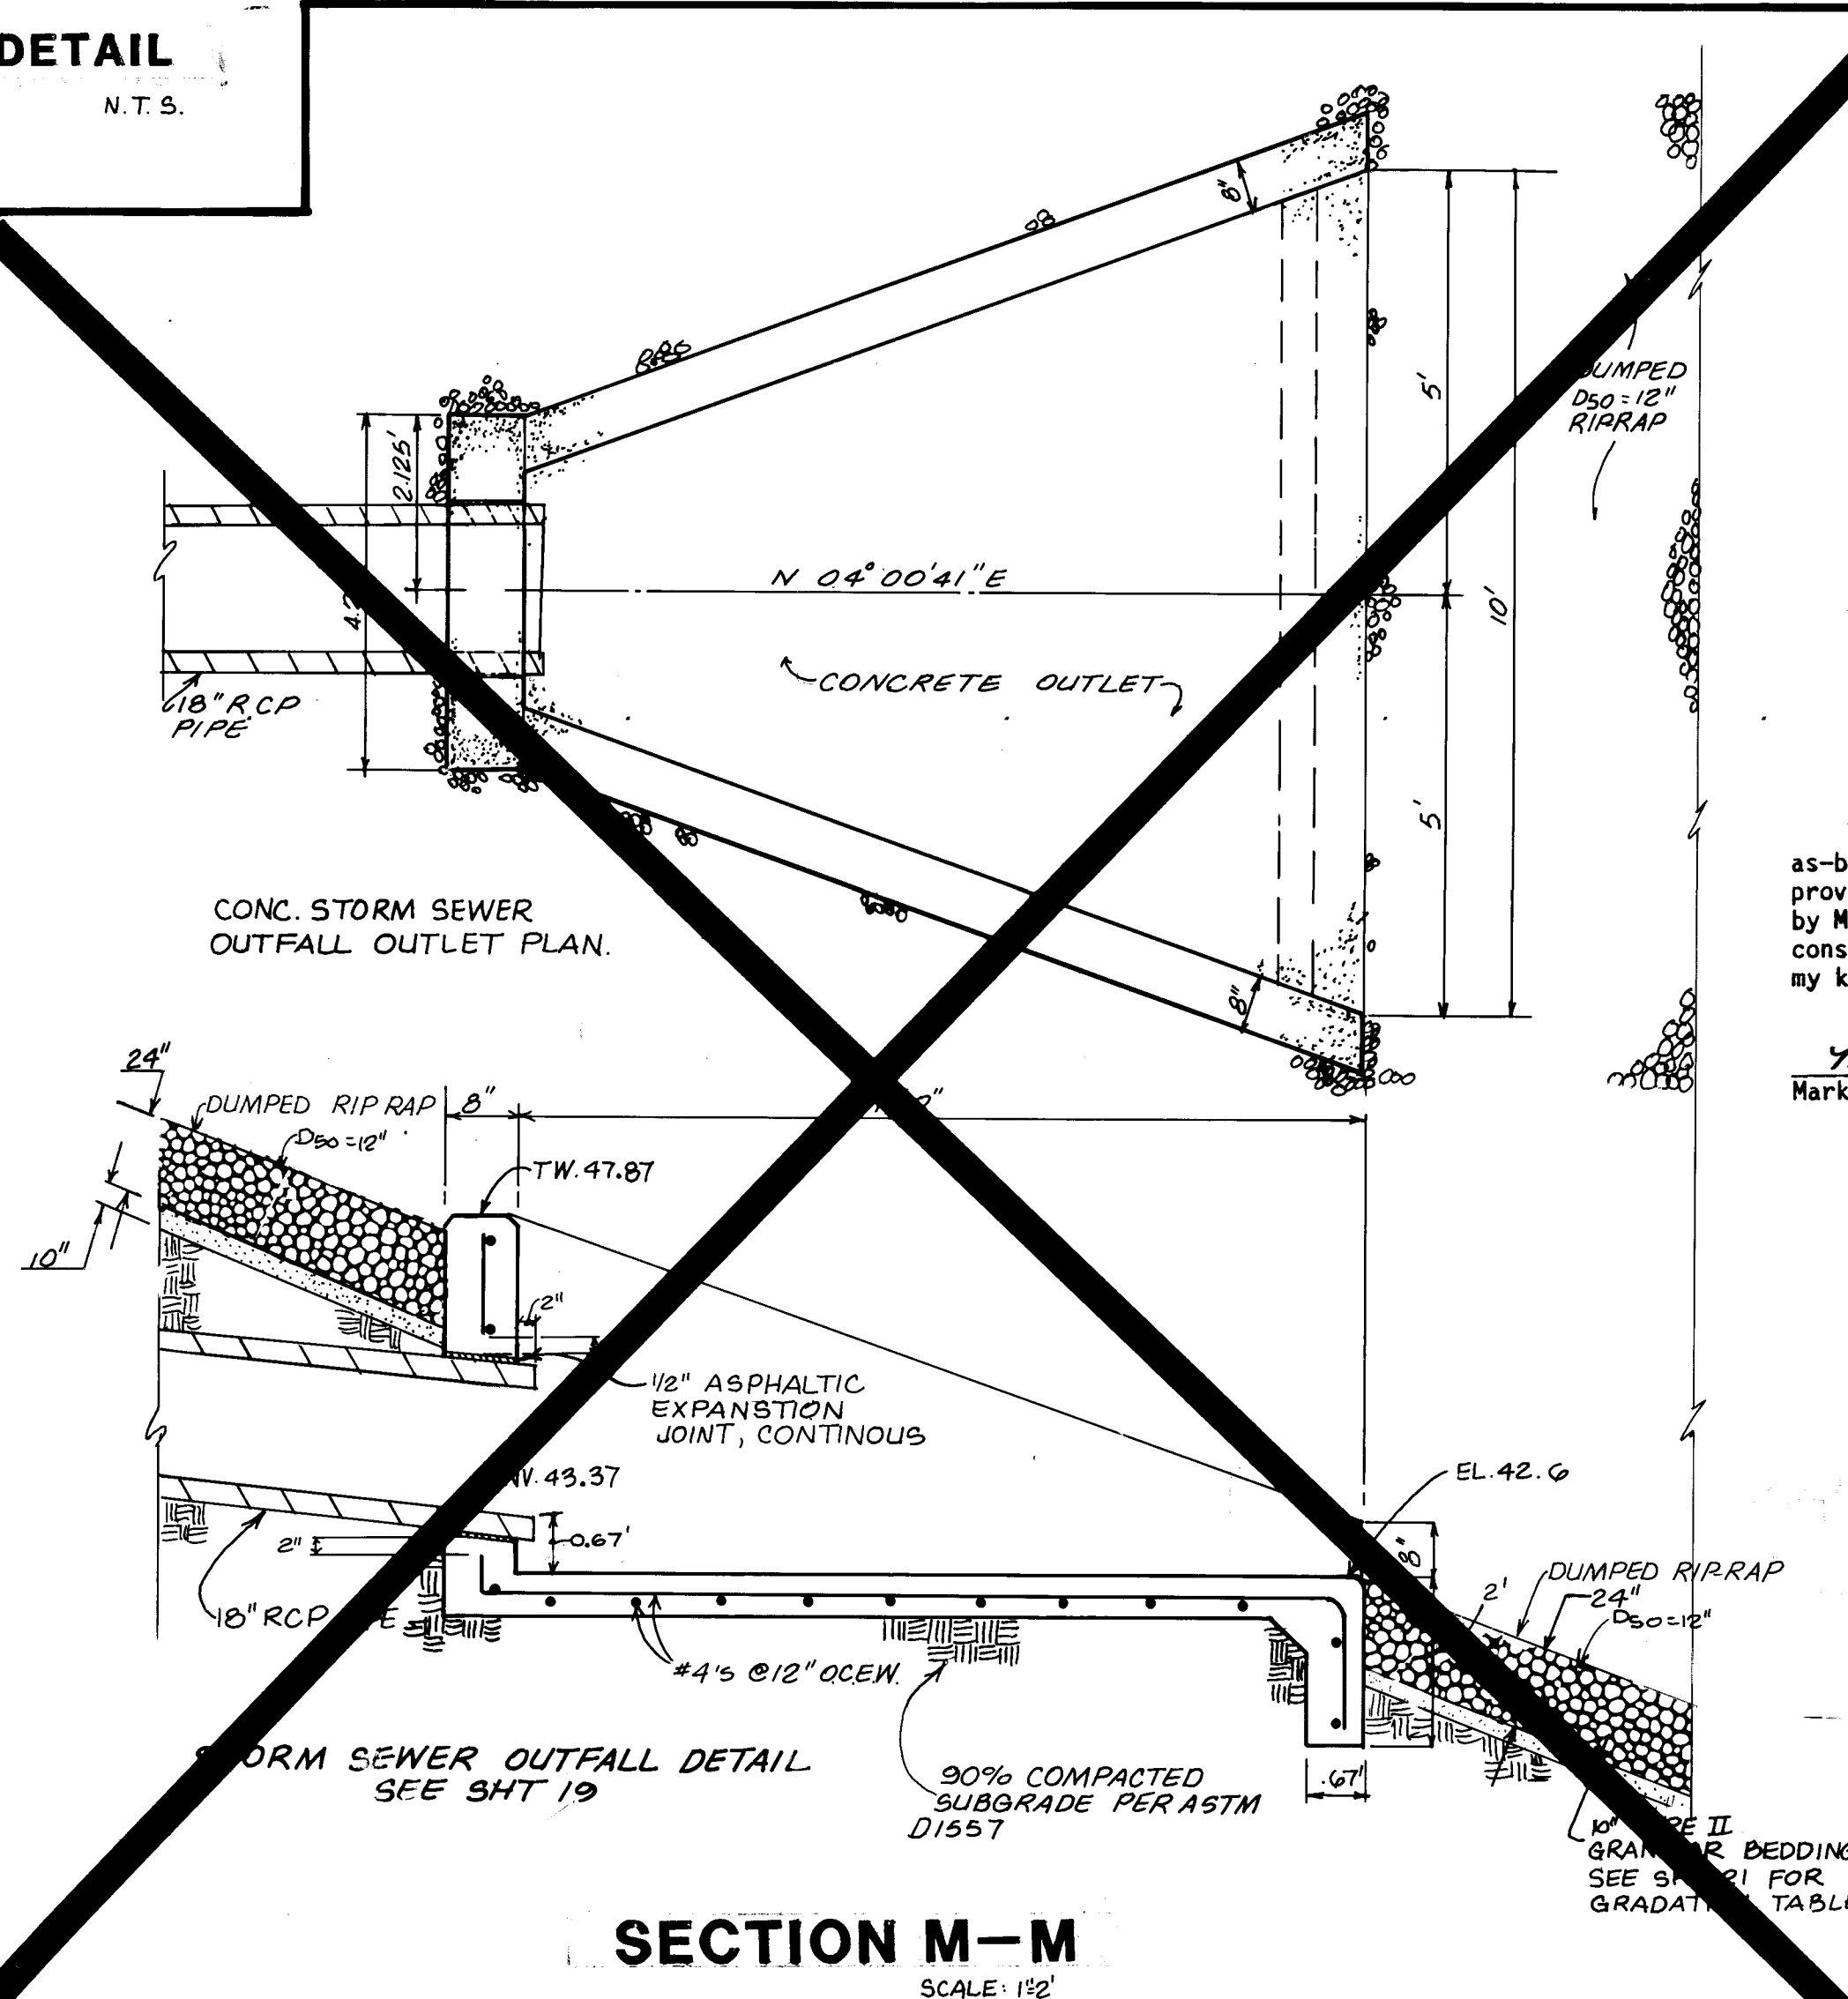

RECORD DRAWING

The improvements shown on this drawing have been as-built in accordance with field information provided by D. Mark Goodwin and Associates, PA, and by MJB Construction Company (Contractor) to reflect construction actually accomplished to the best of my knowledge and belief.

Mark Goodwin
Mark Goodwin, P.E. 8948
Date 6/26/89

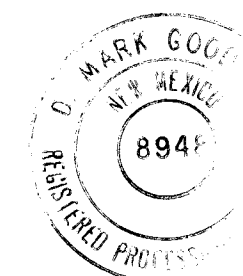

CITY OF ALBUQUERQUE
MUNICIPAL DEVELOPMENT DEPARTMENT
ENGINEERING DIVISION

TITLE: NORTH FOUR HILLS SUBDIVISION
DRAINAGE DETAILS

APPROVALS	ENGINEER	DATE	APPROVALS	ENGINEER	DATE
City Engineer	<i>Mark Goodwin</i>	2/13/87	Liquid Waste	N/A	NW 10/1/86
A.C.E. Design	<i>Mark Goodwin</i>	2/13/87	Traffic	N/A	NW 10/1/86
Hydrology	<i>Mark Goodwin</i>	2/13/87	Water	N/A	NW 10/1/86

DRAWING NO. 2565 MAP NO. L-23 SHEET 22 OF 22

AS BUILT INFORMATION		BENCH MARKS		SURVEY INFORMATION		ENGINEER'S SEAL	
CONTRACTOR	DATE	CONTROL	DATE	NO.	BY	NO.	BY
MJB Const. Co.	10/1/86	712' SOUTH	10/1/86				
WORK BY	DATE	OF 1-40 FRONTAGE ROAD AND	DATE				
SUPERVISOR	DATE	APPROX. 250' EAST OF	DATE				
ACCEPTANCE BY	DATE	ROSEWOOD PLACE, S.E. AT APPROX.	DATE				
FIELD CHECK BY	DATE	STA. 7+76 STANDARD A.C.S. BRASS	DATE				
DRAWINGS	DATE	CAP STAMPED "TOM"	DATE				
CORRECTED BY	DATE		DATE				
RECORDED BY	DATE		DATE				
NO.							