

• L E G E N D •

MATERIALS

CONCRETE	
RIP - RAP	

LINES

SUBDIVISION BOUNDARY	
PROPERTY LINE (PLAN)	
PROPERTY LINE (SECTION)	
CENTERLINE	
EASEMENT LINE	
MATCH LINE	
SECTION CUT LINE	

EARTHWORK

	EXISTING	NEW
CONTOUR LINE		
SPOT ELEVATION		
PROJECT / PHASE BOUNDARY		
SWALE		
DIRECTION OF FLOW		

MISCELLANEOUS UTILITIES

GAS LINE	
UNDERGROUND TELEPHONE	
UNDERGROUND ELECTRICAL	
STORM DRAIN	
STORM DRAIN MANHOLE	
STORM DRAIN INLET	

SANITARY SEWER

SANITARY SEWER LINE	
SANITARY SEWER MANHOLE	
SAS SERVICE CONNECTIONS	
SAS CAP OR PLUG	
ENCASEMENT	

WATER

WATER LINE	
WATER SERVICE CONNECTIONS	
GATE VALVE	
FIRE HYDRANT	
BUTTERFLY VALVE	
REDUCER	
WATER PRESSURE ZONE BOUNDARY	

WATER FITTINGS

CAPS AND PLUGS	
ELBOW	
CROSS	
TEE	

MISCELLANEOUS

CHAINLINK FENCE	
FIELD FENCE	
COMMON YARD WALL	
RETAINING WALL	
POWER OR TELEPHONE POLE	

CONSTRUCTION PLANS
FOR
MILES ROAD S.E.
FROM
**WALKER DR. S.E. TO
BUENA VISTA DR. S.E.**
ALBUQUERQUE, NEW MEXICO


SEPTEMBER, 1985

INDEX OF DRAWINGS

SHEET NO.	DESCRIPTION
1.	TITLE, LEGEND, VICINITY MAP, GENERAL NOTES, INDEX OF DRAWINGS
2.	FINAL PLAT
3.	PAVING IMPROVEMENTS PLAN & PROFILE

1 2 3 4 5 6 7 8 9 10 11 12
26 26 24 01 86

APPROVAL OF AS BUILT DRAWINGS
ASST. CITY ENGINEER - FIELD
W. J. McNamee
DATE 4-22-86

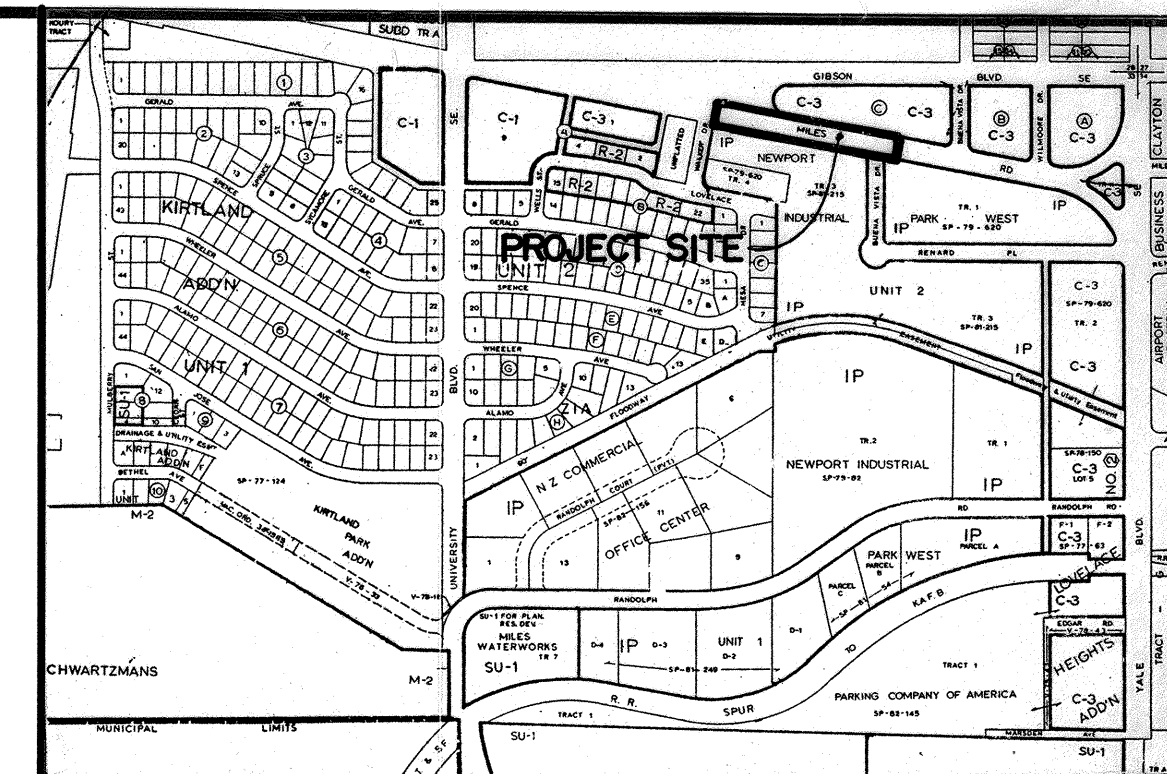

VICINITY MAP
SCALE : 1" = 800'

M-15


GENERAL NOTES

- ALL WORK DETAILED ON THESE PLANS TO BE PERFORMED UNDER CONTRACT SHALL, EXCEPT AS OTHERWISE STATED OR PROVIDED FOR HEREON, BE CONSTRUCTED IN ACCORDANCE WITH THE CITY OF ALBUQUERQUE INTERIM STANDARD SPECIFICATIONS - PUBLIC WORKS CONSTRUCTION - 1985.
- TWO (2) WORKING DAYS PRIOR TO ANY EXCAVATION, CONTRACTOR MUST CONTACT LINE LOCATING SERVICE, 765-1234, FOR LOCATION OF EXISTING UTILITIES.
- PRIOR TO CONSTRUCTION, THE CONTRACTOR SHALL EXCAVATE AND VERIFY THE HORIZONTAL AND VERTICAL LOCATION OF ALL POTENTIAL OBSTRUCTIONS. SHOULD A CONFLICT EXIST, THE CONTRACTOR SHALL NOTIFY THE ENGINEER SO THAT THE CONFLICT CAN BE RESOLVED WITH A MINIMUM AMOUNT OF DELAY.
- THE CONTRACTOR SHALL MAINTAIN ACCESS TO ADJACENT PROPERTIES DURING CONSTRUCTION.
- ALL WORK ON THIS PROJECT SHALL BE PERFORMED IN ACCORDANCE WITH APPLICABLE FEDERAL, STATE AND LOCAL LAWS, RULES AND REGULATIONS CONCERNING CONSTRUCTION SAFETY AND HEALTH.
- THE CONTRACTOR MUST SUBMIT A CONSTRUCTION SIGNING AND BARRICADING PLAN TO TRAFFIC ENGINEERING TO RECEIVE A BARRICADING PERMIT PRIOR TO CONSTRUCTION.

Miles Rd SE.
Walker Dr SE to Buena Vista
Dr SE
2624

REV.	SHEETS	CITY ENGINEER	DATE	USER DEPARTMENT	DATE	USER DEPARTMENT	DATE

APPROVAL OF REVISIONS

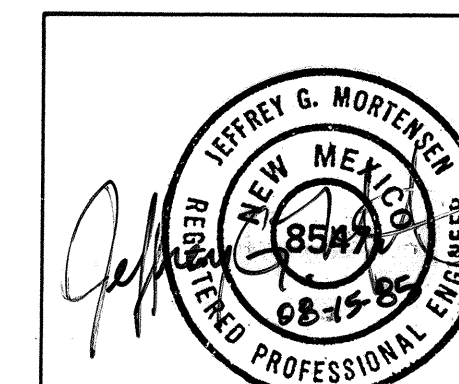

2624

APPROVED FOR
CONSTRUCTION

Approved Plan 2/19/86
DESIGN - A.C.E.

SHEET 1 OF 3

