


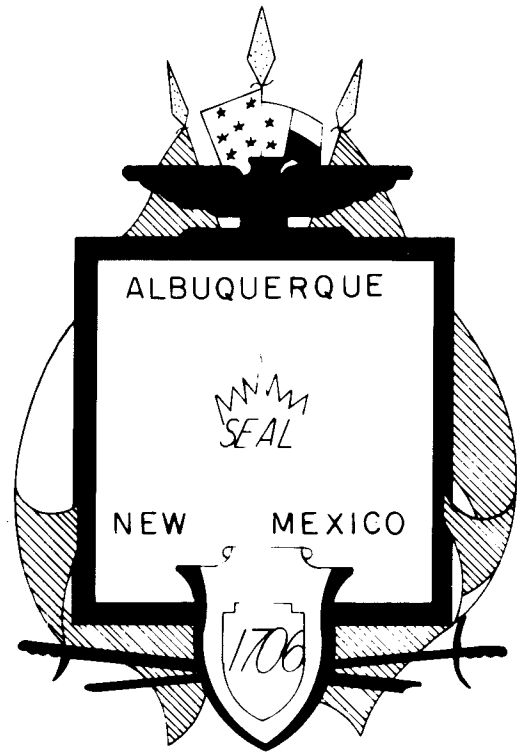

CITY OF ALBUQUERQUE, NEW MEXICO

PLAZA LADERA

WATER AND SEWER EXTENSION

AUGUST 1985


INDEX

SHEET NO.	DESCRIPTION
1	TITLE, VICINITY MAP & GENERAL NOTES
2	PLAT
3	PLAN & PROFILE



DENNEY-GROSS & ASSOCIATES, INC.
ENGINEERS-PLANNERS
ALBUQUERQUE, NEW MEXICO 87107

26280186
w.f. McManus
3-31-86

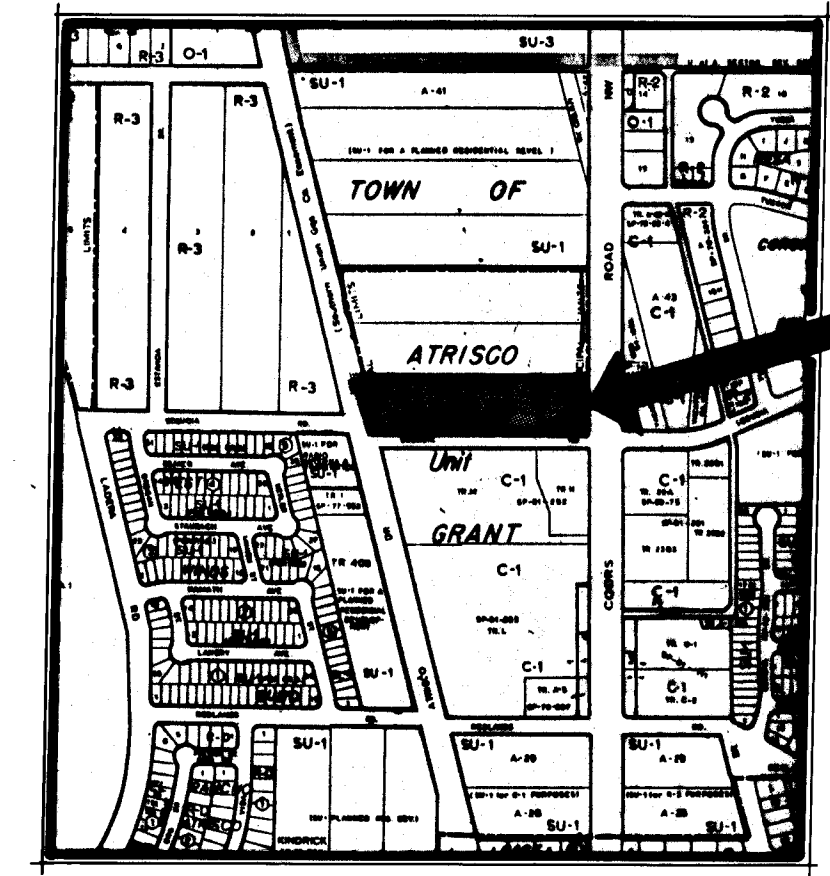

PROJECT SITE

VICINITY MAP
ZONE ATLAS NO. G-II
N.T.S.

GENERAL NOTES

- All work detailed on these plans to be performed under contract shall, except otherwise stated or provided for hereon, be constructed in accordance with the "City Of Albuquerque Interim Standard Specifications For Public Works Construction 85."
- Two working days prior to any excavation, Contractor must contact Line Locating Service, 765-1234, for the location of existing utilities.
- Prior to construction, the Contractor shall excavate and verify the horizontal and vertical locations of all existing utilities and potential obstructions. Should a conflict exist, the Contractor shall notify the Engineer so that the conflict can be resolved with a minimum amount of delay.
- The Contractor shall maintain access to adjacent properties at all times.
- All work on this project shall be performed in accordance with applicable Federal, State and Local laws, rules and regulations concerning construction safety and health.
- The Contractor must submit a construction signing and barricading plan to Traffic Engineering to receive a barricading permit prior to construction.
- All dimensions and radii of curb and curb returns are shown to face of curb unless otherwise noted.
- Where removal of existing curb and gutter, sidewalk or pavement is required the Contractor shall sawcut and/or remove to the nearest joint. Curb and gutter shown as existing and not to be removed under this contract which is damaged or displaced by the Contractor shall be removed and replaced by the Contractor at the Contractor's expense.
- Restriping of roadway shall be the responsibility of the City of Albuquerque and shall not be included in this contract.
- Backfill compaction shall be according to specified street use.
- Tack coat requirements shall be determined by the City Engineer.
- Sidewalks and wheelchair ramps within the curb returns shall be constructed wherever a new curb return is constructed.
- If curb is depressed for a driveway or a handicap ramp, the driveway or ramp shall be constructed prior to acceptance of the curb and gutter.
- All storm drainage facilities shall be completed prior to final acceptance.

REV.	SHEETS	CITY ENGR.	DATE	USER DEPT.	DATE	USER DEPT.	DATE
APPROVAL OF REVISIONS							

DENNEY-GROSS & ASSOC., INC.
ENGINEERS SURVEYORS PLANNERS
2400 COMANCHE RD. N.E., ALBUQ. N.M. 87107
(505) 884-0696


APPROVED FOR CONSTRUCTION

[Signature] 12/2/85
for C.E.


DRAWING NO. **2628**

SHEET 1 OF 3




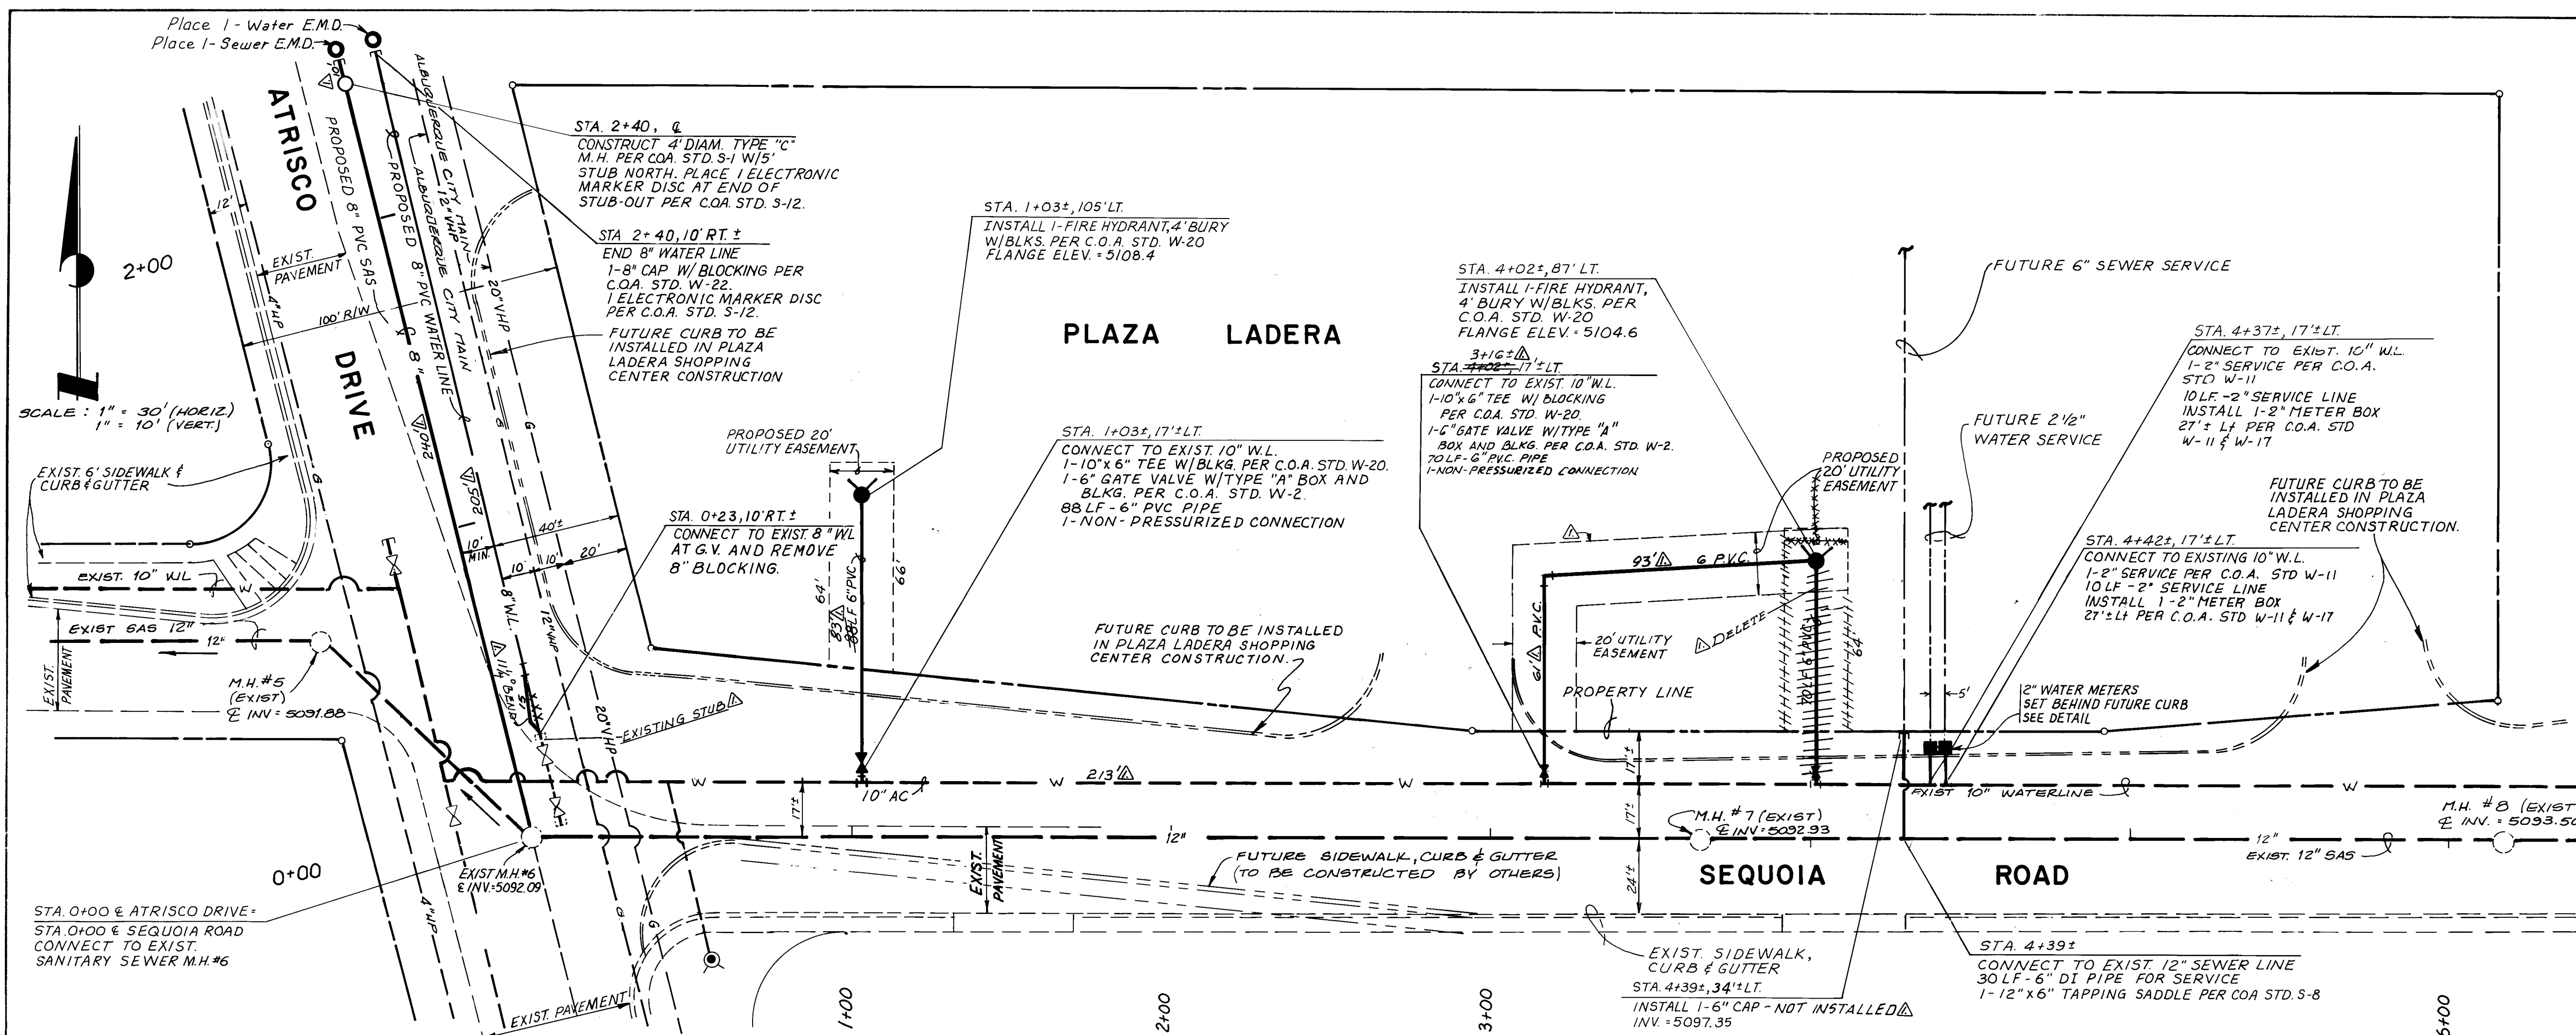

- NOTES:
1. For utility connections on Sequoia Rd. this work order to include water service & sewer service in Sequoia Rd. R/W up to the existing property line.
 2. All non-pressurized connections to be installed at the same time.

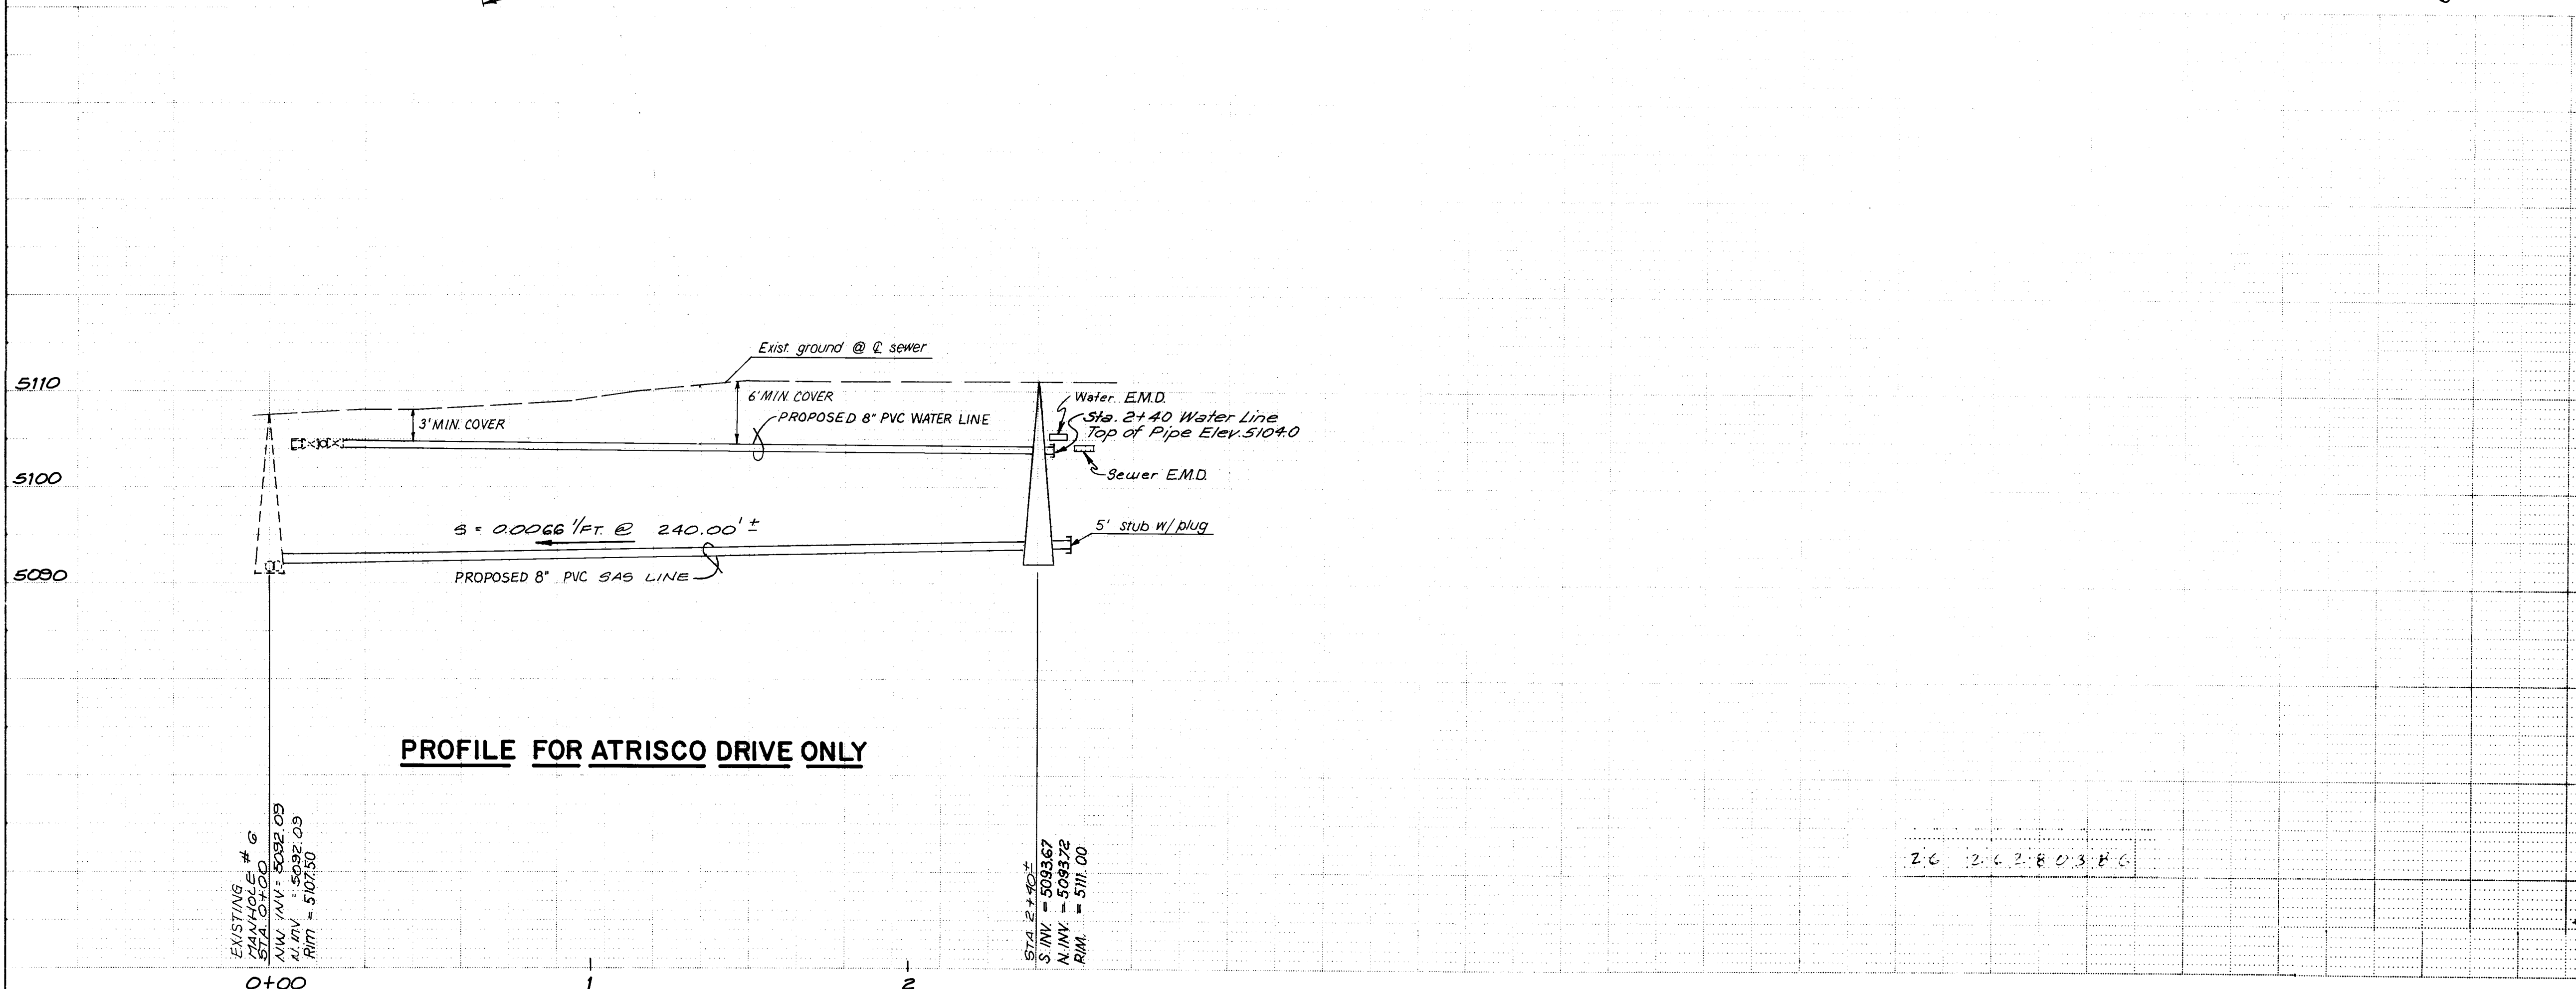

PROFILE FOR ATRISCO DRIVE ONLY

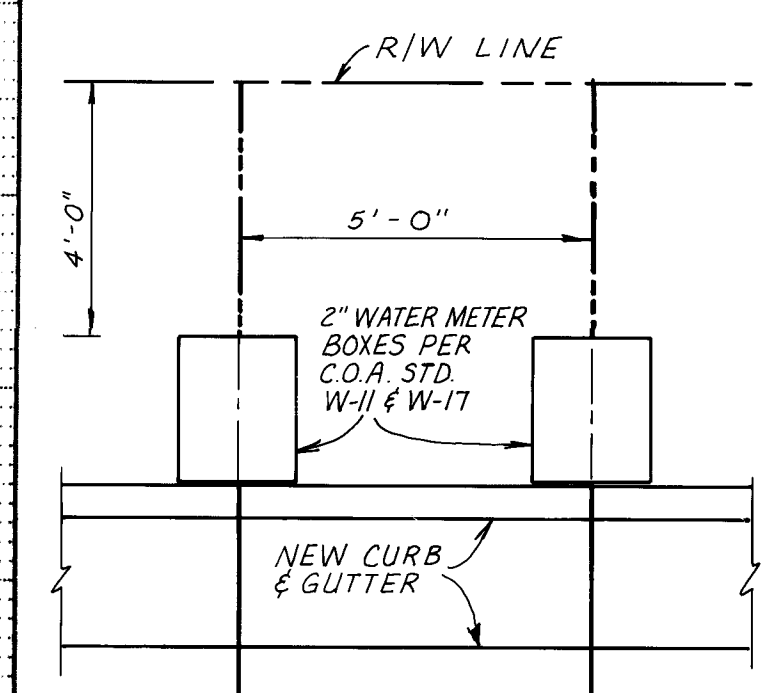

2" WATER METER SETTING DETAIL

NOTE: Set new water meters behind new curb and gutter.

[illegible]

CITY OF ALBUQUERQUE
MUNICIPAL DEVELOPMENT DEPARTMENT
ENGINEERING DIVISION

TITLE: PLAZA LADERA—WATER & SEWER EXTENSION

PLAN & PROFILE

APPROVALS	ENGINEER	DATE	APPROVALS	ENGINEER	DATE
City Engineer	<i>W.C. Lee</i>	<i>11/26/85</i>	Liquid Waste	<i>William G. Probst</i>	<i>10-30-85</i>
A C E - Design	<i>W.C. Lee</i>	<i>11/26/85</i>	Traffic	<i>NA Duth</i>	<i>10-30-85</i>
ACE - Hydrology	<i>N.A. B.G.A.</i>	<i>10/30/85</i>	Water	<i>William G. Probst</i>	<i>10-30-85</i>

DRAWING NO.	2628	MAP NO.	G-II	SHEET	3	OF	3
----------------	------	---------	------	-------	---	----	---