
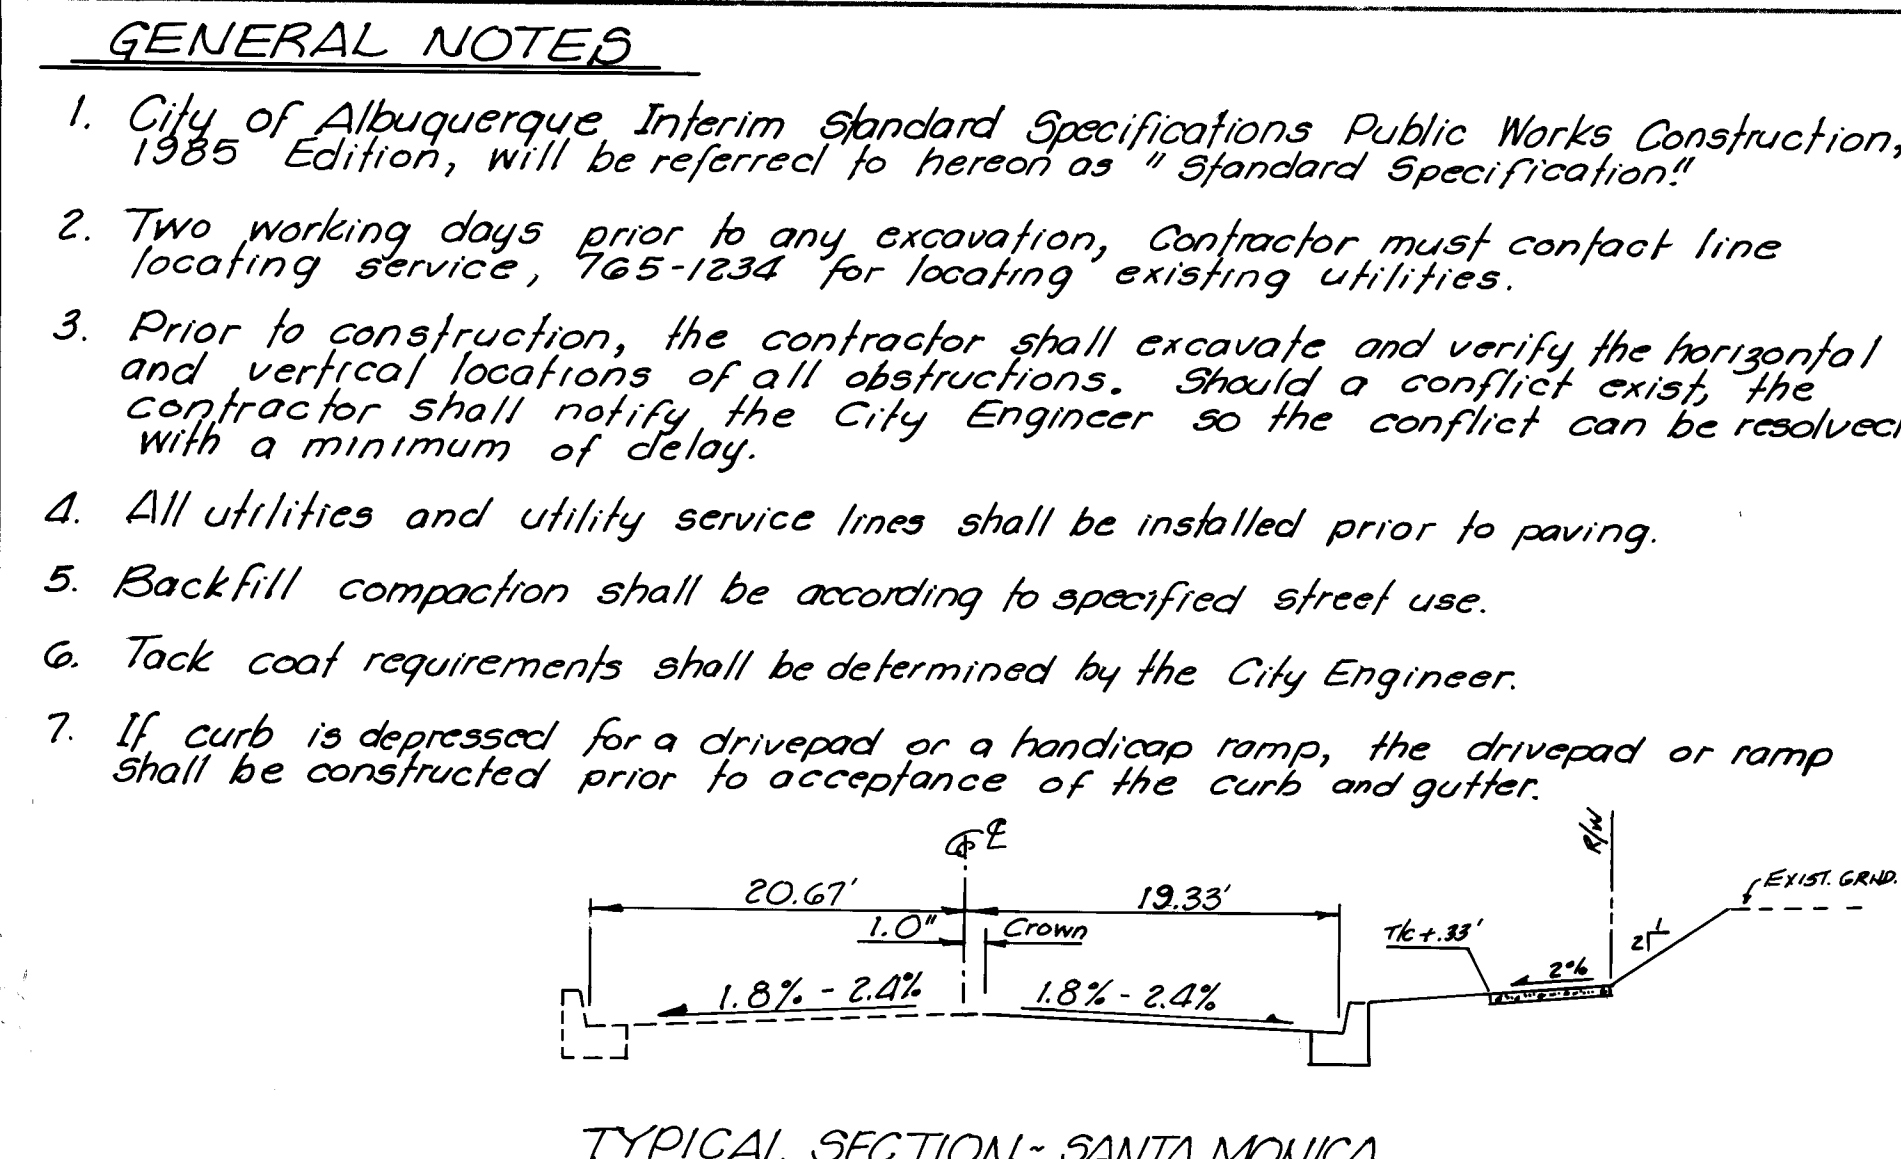
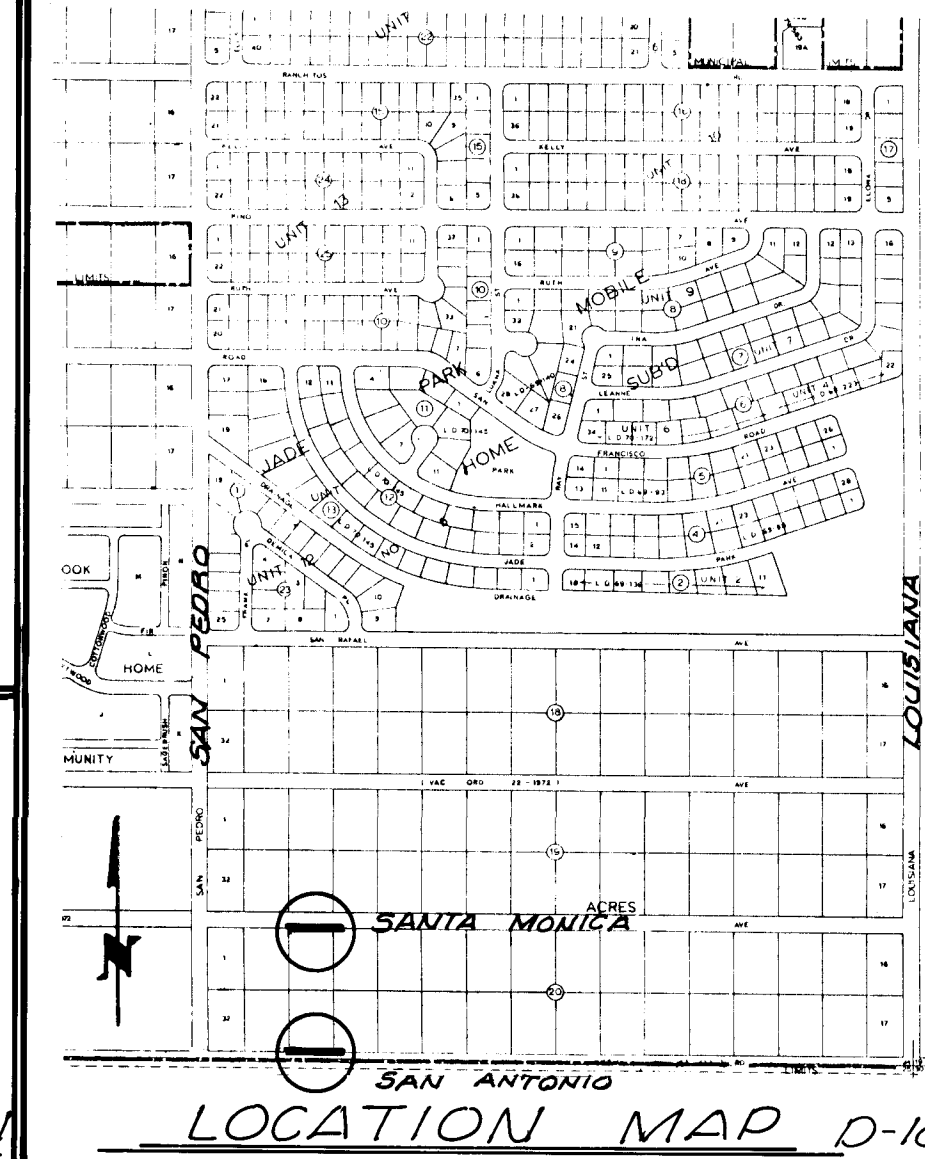
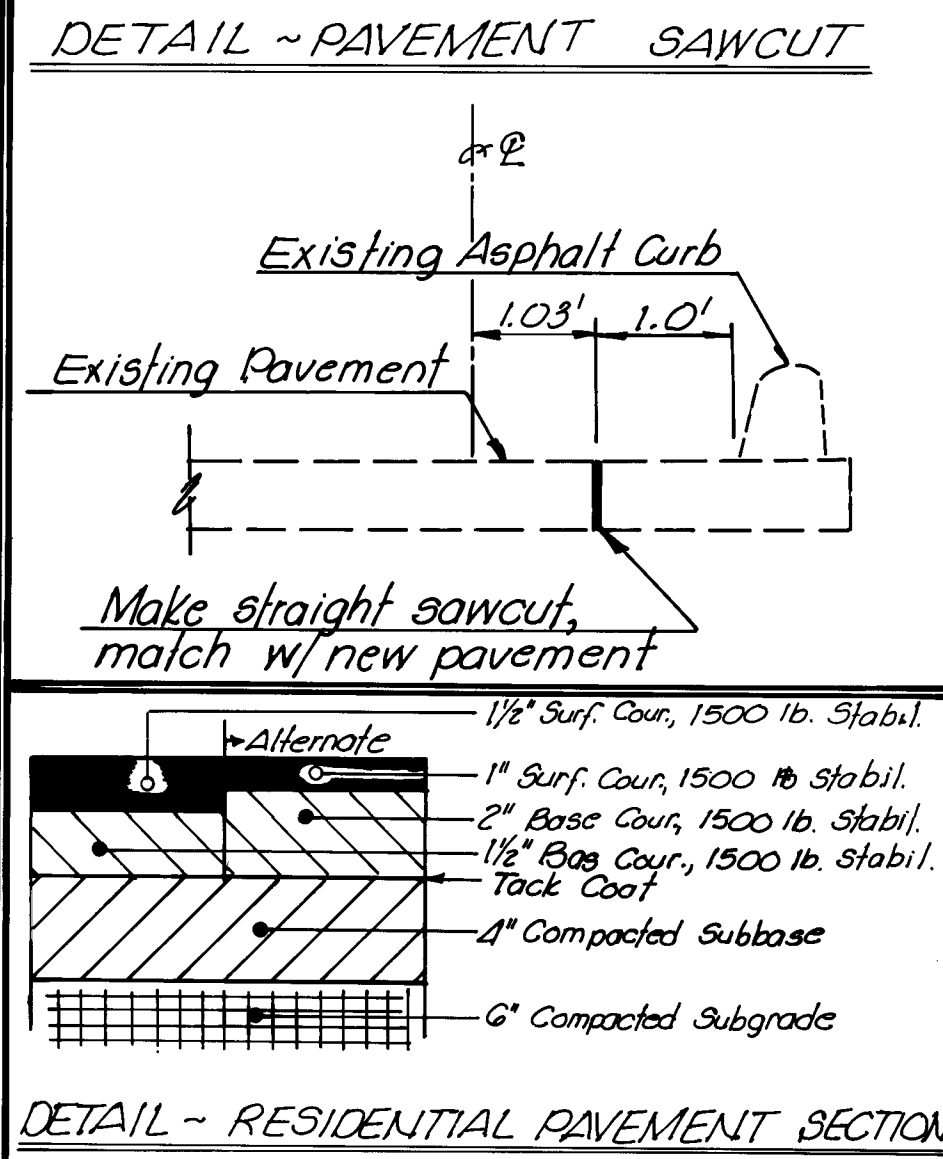
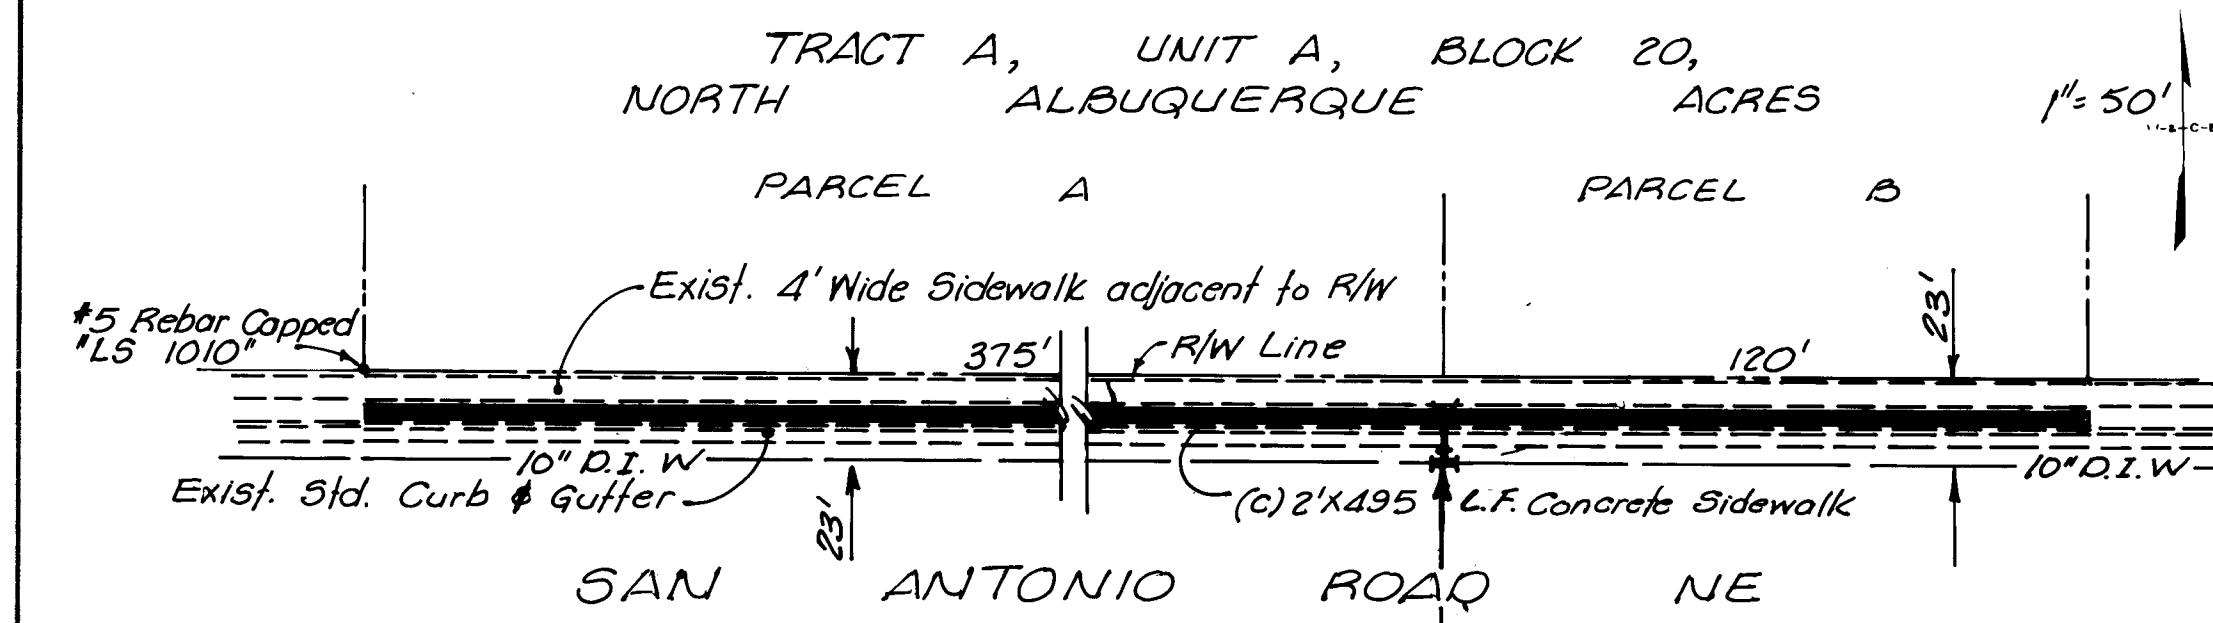


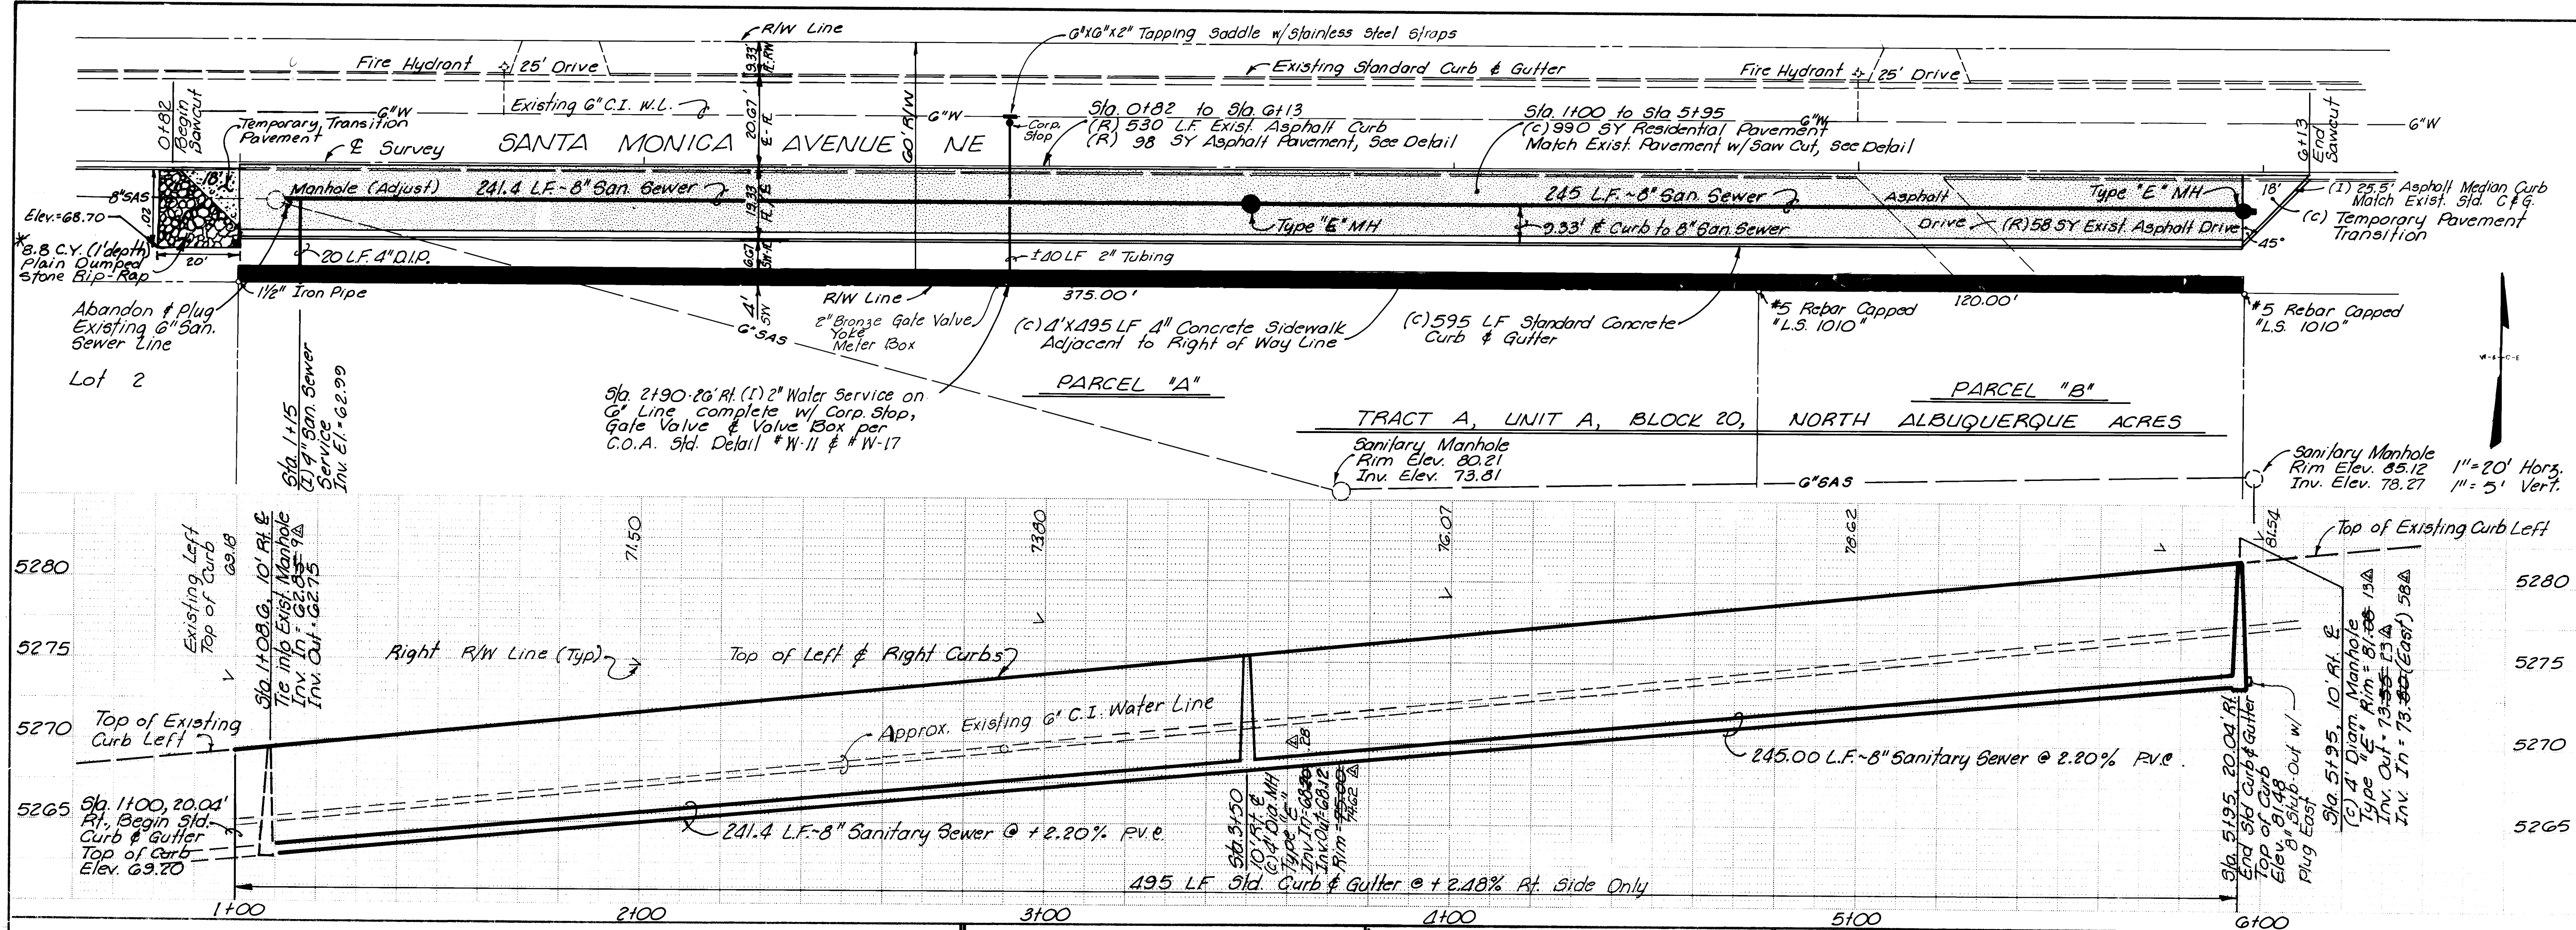

* Rip-Rap Material:
Material shall be of broken portland cement concrete structures, curb & gutter, sidewalk, concrete pavement, existing rip-rap structures, concrete masonry units, or other sound stones, as approved by the engineer. Material shall be reduced to no greater than one (1) foot in any dimension prior to placing.

Locate New F.H. @ 10' Between Parcel A & Parcel B per C.O.A. Std. Detail Pg. W-20
(1) 10" x 10" x 6" Tapping Sleeve
(2) 6" Gate Valve w/Type 'A' Valve Box
(1) 17.5 L.F. 6" Water Line
(1) 6" Fire Hydrant, 4' Bury w/Concrete Blocking
Remove & Replace:
12 L.F. Curb & Gutter
10 S.Y. Arterial Pymt.

26 26340187

APPROVED AS BUILT DRAWING
CONSTRUCTION NUMBER
10-21-87

10/21/87

CITY OF ALBUQUERQUE			
SANTA MONICA AVENUE NE, EAST OF SAN PEDRO - WATER, SEWER & PAVING			
SAN ANTONIO ROAD NE - SIDEWALK			
APPROVALS	ENGINEER	DATE	APPROVALS
City Engineer	<i>H. O. H.</i>	<i>11/15/85</i>	Traffic
Liquid Waste	<i>W. J. W.</i>	<i>11-15-85</i>	Water
A.C.E. - Design	<i>J. L. J.</i>	<i>11/21/85</i>	2634
A.C.E. - Hydrology	<i>J. L. J.</i>	<i>11/21/85</i>	
SHEET <u>1</u>			OF <u>1</u>

AS BUILT INFORMATION			
CONTRACT	SUNDANCE	CITY	ALBUQUERQUE
DATE	10/15/87	DATE	10/15/87
BY	R. GARCIA	BY	R. GARCIA
EN	10/21/87	EN	10/21/87
DATE	10/21/87	DATE	10/21/87
REFERENCES			
1. A.C.S. Brass Cap #13-E18 Located 78' South of E. San Antonio Dr. and 20' West of E. San Pedro Dr NE. Elevation = 5200.92			
MAP NO. D-18-Z			
EN	BY	DATE	DATE
Revised from as built information	WILSON & CO. ENG.	9-1985	9-1985
DESIGN	MDJ	DATE	DATE
CHECKED BY	WFB	DATE	DATE