
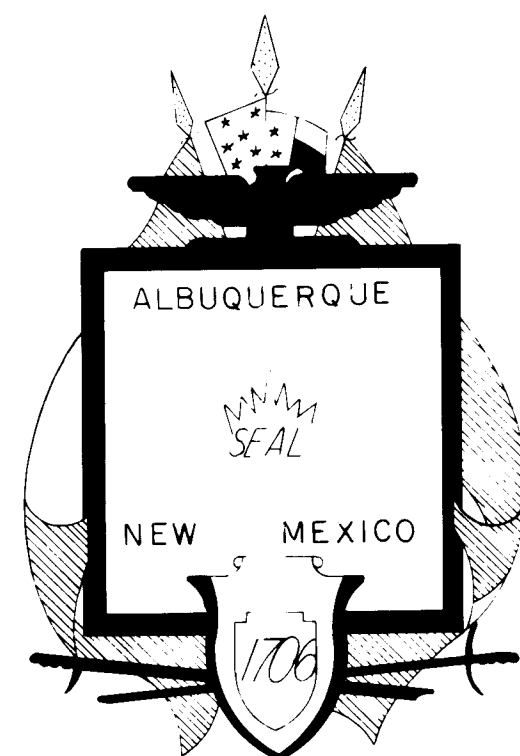


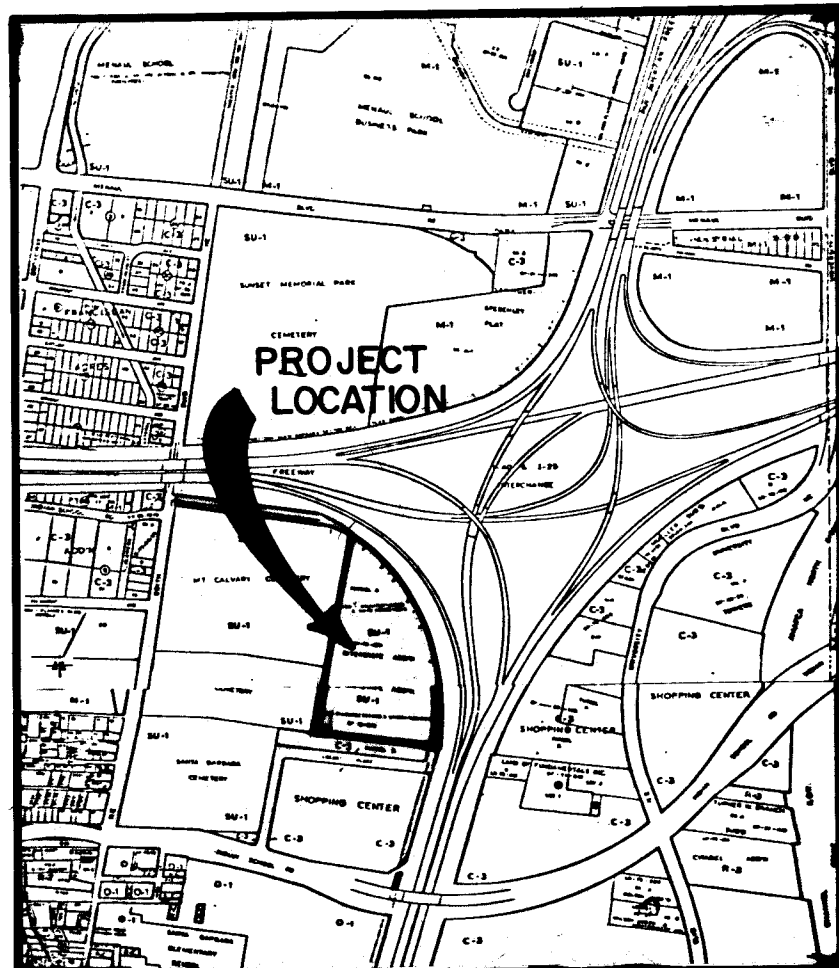

CITY OF ALBUQUERQUE, NEW MEXICO

## GENERAL NOTES

All work detailed on these plans to be performed under contract shall, except otherwise stated or provided for hereon, be constructed in accordance with the "City Of Albuquerque Interim Standard Specifications For Public Works Construction 1985."

Two working days prior to any excavation, Contractor must contact Line Locating Service, 765-1234, for the location of existing utilities.

Prior to construction, the Contractor shall excavate and verify the horizontal and vertical locations of all existing utilities and potential obstructions. Should a conflict exist, the Contractor shall notify the Engineer so that the conflict can be resolved with a minimum amount of delay.

The Contractor shall maintain access to adjacent properties at all times.

All work on this project shall be performed in accordance with applicable Federal, State and Local laws, rules and regulations concerning construction safety and health.

The Contractor must submit a construction signing and barricading plan to Traffic Engineering to receive a barricading permit prior to construction.

All dimensions and radii of curb and curb returns are shown to face of curb unless otherwise noted.

Where removal of existing curb and gutter, sidewalk or pavement is required the Contractor shall sawcut and/or remove to the nearest joint. Curb and gutter shown as existing and not to be removed under this contract which is damaged or displaced by the Contractor shall be removed and replaced by the Contractor at the Contractor's expense.

Restriping of roadway shall be the responsibility of the City of Albuquerque and shall not be included in this contract.

Backfill compaction shall be according to specified street use.

Tack coat requirements shall be determined by the City Engineer.

Sidewalks and wheelchair ramps within the curb returns shall be constructed wherever a new curb return is constructed.

If curb is depressed for a driveway or a handicap ramp, the driveway or ramp shall be constructed prior to acceptance of the curb and gutter.

All storm drainage facilities shall be completed prior to final acceptance.

The max. deflection angle for the W.L. shall be 2/3 of pipe manufactures recommended maximum 8" W.L. - 4" max. per length of joint 10" W.L. - 3" max. per length of joint

# SUNVILLAGE APARTMENTS

## 801 LOCUST PLACE N.E.

## ALBUQUERQUE, NEW MEXICO

# EDITH ACCESS ROAD, LOCUST STREET

# AND MASTERPLAN WATERLINES

## EMPIRE WEST COMPANIES.

## DEVELOPER

dtm & associates, inc.

Denney-Tibjias-McLean & Associates, Inc.  
Consulting Engineers ■ Planners ■ Surveyors  
2400 COMANCHE ROAD, NE ■ ALBUQUERQUE, NM 87107  
TELEPHONE (505) 884-0696

## INDEX

| SHEET No.      | DESCRIPTION                                        |
|----------------|----------------------------------------------------|
| 1              | Title Sheet & Vicinity Map                         |
| 1A-1B          | Plats                                              |
| 2-3. . . . .   | Locust Street Plan & Profile                       |
| 4. . . . .     | Locust Place & 10" Public Waterline Plan & Profile |
| 5-6. . . . .   | 10" Public Waterline Plan & Profile                |
| 7-9. . . . .   | 8" Public Waterline Plan & Profile                 |
| 10-11. . . . . | Access To Edith Blvd. Plan & Profile               |
| 12. . . . .    | Street Section & Details                           |

AS OF AS BUILT DRAWINGS  
CONSTRUCTION ENGINEER  
DATE 7-24-86

1 2 3 4 5 6 7 8 9 10 11 12  
26 26 42 01 86

| REV. | SHEETS | DATE    | USER    | DEPT.        | DATE    | USER | DEPT. | DATE |
|------|--------|---------|---------|--------------|---------|------|-------|------|
| 3-4  | 11     | 7/24/86 | 5/16/86 | Transp. Dev. | 7/14/86 |      |       |      |


APPROVAL OF REVISIONS

|  |                                                                                                                                                |                                                   |
|--|------------------------------------------------------------------------------------------------------------------------------------------------|---------------------------------------------------|
|  | DENNEY-TIBJIAS-McLEAN & ASSOC., INC.<br>CONSULTING ENGINEERS PLANNERS SURVEYORS<br>2400 COMANCHE RD. N.E., ALBUQ. N.M. 87107<br>(505) 884-0696 | APPROVED FOR CONSTRUCTION<br>A.R. Olson<br>A.C.E. |
|  | 2642                                                                                                                                           | SHEET 1 OF 12                                     |

AF 22460A

1-514 681-137

99 T0073 SUMMARY PLAT  
SHOWING  
PARCELS "A" & "B"  
INTERSTATE ADDITION  
WITHIN  
TOWN OF ALBUQUERQUE GRANT  
ALBUQUERQUE, NEW MEXICO  
OCTOBER, 1979  
H-15-Z & J-15-Z  
SP-9-79-915

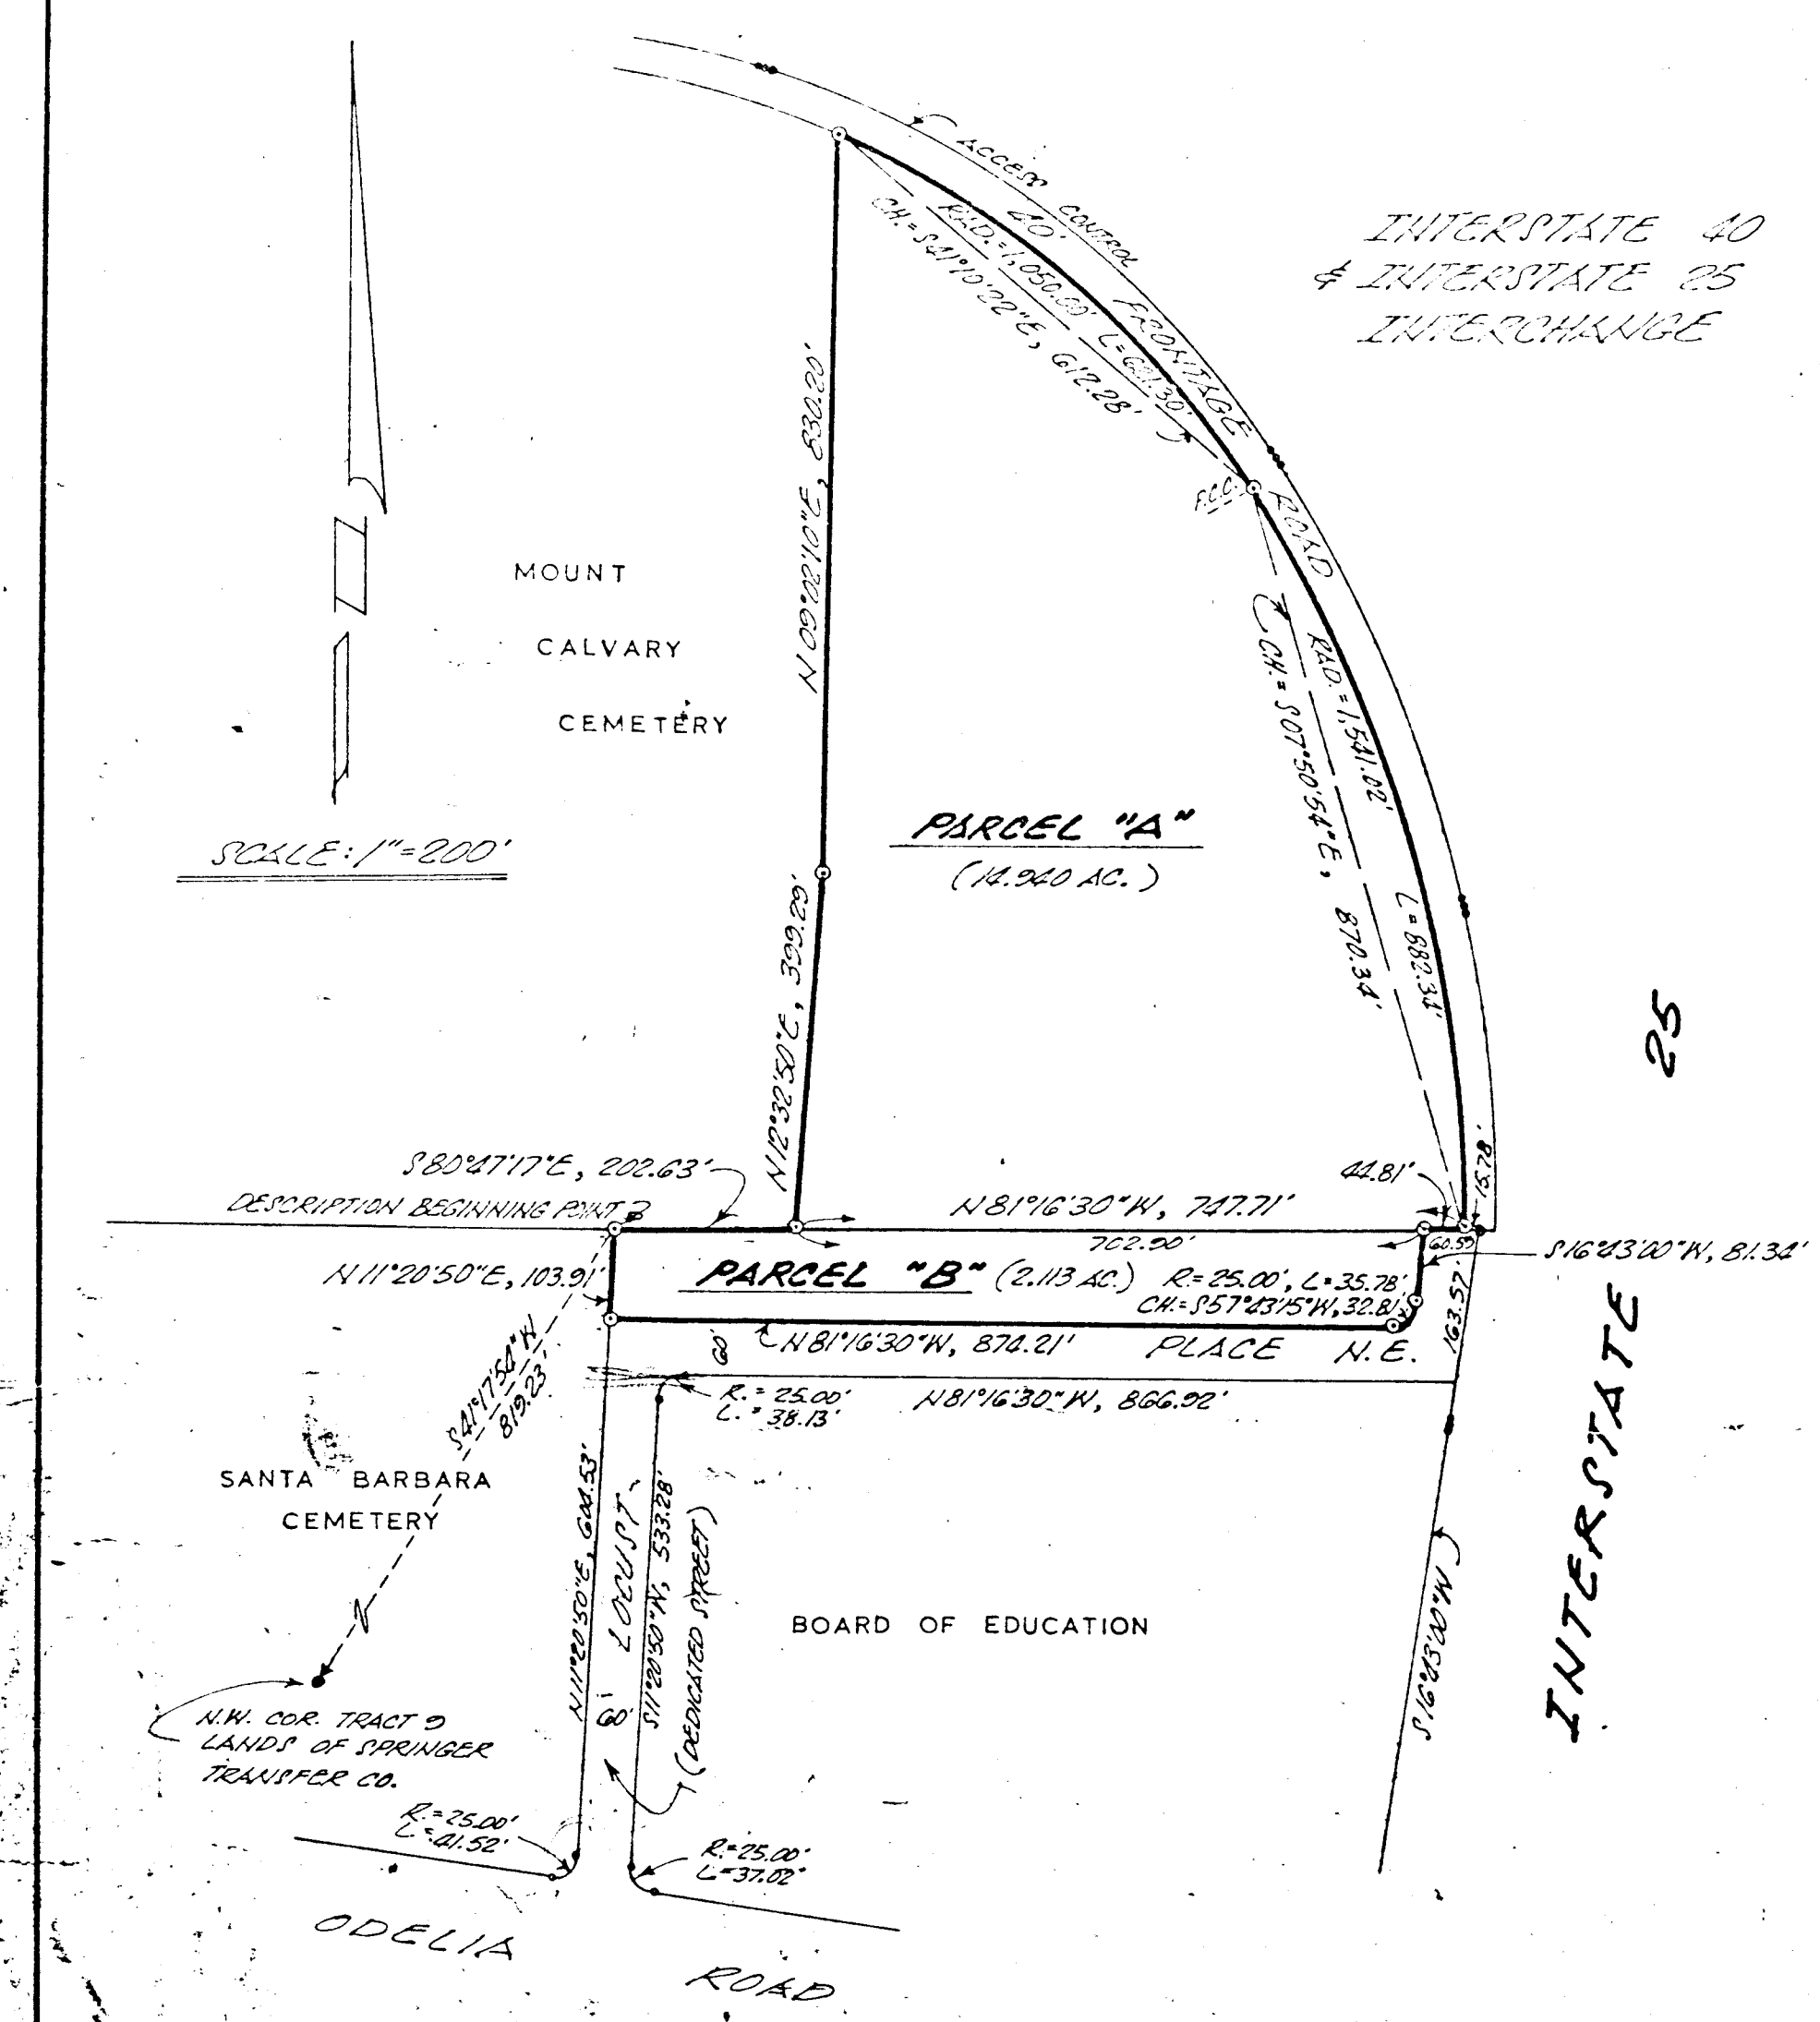

APPROVAL: [Signature] DATE: 10/12/79  
CITY OF ALBUQUERQUE, N.M. - PROPERTY MANAGEMENT

I, D.T. MORRISON, NEW MEXICO REGISTERED LAND SURVEYOR NO. 1010, DO HEREBY CERTIFY THAT THE PLAT AND SURVEY SHOWN HEREON WAS PREPARED BY ME OR UNDER MY SUPERVISION AND DIRECTIONS, AND THAT THE SAME IS TRUE AND CORRECT TO THE BEST OF MY BELIEF AND KNOWLEDGE.

D.T. Morrison  
D.T. MORRISON, N.M.L.S. NO. 1010



MAP AND SURVEY BY D.T. MORRISON - SURVEYOR, INC.  
ALBUQUERQUE, NEW MEXICO

215-137

THE FOREGOING REPLAT OF THAT CERTAIN PARCEL OF LAND SITUATE WITHIN THE CITY LIMITS OF THE CITY OF ALBUQUERQUE, BERNALILLO COUNTY, NEW MEXICO, WITHIN THE TOWN OF ALBUQUERQUE GRANT, BEING MORE PARTICULARLY DESCRIBED BY METES AND BOUNDS SURVEY AS FOLLOWS:

BEGINNING AT A POINT ON THE WESTERLY BOUNDARY LINE OF THE PARCEL HEREIN DESCRIBED, (SAID POINT BEING COMMON TO THE NORTHEAST CORNER OF THE SANTA BARBARA CEMETERY, AND ALSO BEING A POINT ON THE SOUTHERLY LINE OF MOUNT CALVARY CEMETERY); THENCE, FROM SAID POINT OF BEGINNING THE NORTHWEST CORNER (1/4" PIPE IN PLACE) OF TRACT NINE (9) OF THE LANDS OF SPRINGER TRANSFER COMPANY; AS THE SAME IS SHOWN AND DESIGNATED ON A MAP PREPARED BY ROSS-BEYER ENGINEERING OFFICE, ALBUQUERQUE, NEW MEXICO, ON MARCH 30, 1946, AND REVISED ON MARCH 11, 1952, BEARS: S 41°17'54"W, 819.23 FEET DISTANCE; THENCE, LEAVING SAID BEGINNING POINT,

S 80°47'17"E, 202.63 FEET DISTANCE TO A POINT BEING COMMON TO THE SOUTHEAST CORNER OF THE MOUNT CALVARY CEMETERY; THENCE,

N 12°32'50"E, 399.29 FEET DISTANCE ALONG THE EASTERLY LINE OF SAID MOUNT CALVARY CEMETERY TO A POINT; THENCE,

N 09°02'10"E, 630.20 FEET DISTANCE CONTINUING ALONG THE EASTERLY LINE OF SAID MOUNT CALVARY CEMETERY TO THE NORTHWEST CORNER OF THE PARCEL HEREIN DESCRIBED, [A POINT ON CURVE ON THE SOUTHERLY LINE OF A FORTY FOOT (40') WIDE FRONTAGE ROAD ALONG THE EAST-SOUTH RAMP OF NEW MEXICO STATE ROAD 422], SAID POINT ALSO BEING COMMON TO THE NORTHEAST CORNER OF THE MOUNT CALVARY CEMETERY; THENCE,

SOUTHEASTERLY, 621.30 FEET DISTANCE ALONG THE ARC OF A CURVE BEARING TO THE RIGHT ALONG SAID SOUTHERLY LINE OF A FORTY FOOT (40') WIDE FRONTAGE ROAD ALONG THE EAST-SOUTH RAMP OF NEW MEXICO STATE ROAD 422, (SAID CURVE HAVING A RADIUS OF 1,050.00 FEET AND A CHORD WHICH BEARS S 41°10'22"E, 612.28 FEET DISTANCE), TO A POINT OF COMPOUND CURVE; THENCE,

SOUTHEASTERLY, 882.34 FEET DISTANCE CONTINUING ALONG THE ARC OF A CURVE BEARING TO THE RIGHT ALONG SAID FORTY FOOT (40') WIDE FRONTAGE ROAD, (SAID CURVE HAVING A RADIUS OF 1,541.02 FEET AND A CHORD WHICH BEARS S 07°50'54"E, 870.34 FEET DISTANCE), TO A POINT ON CURVE; THENCE,

N 81°16'30"W, 44.81 FEET DISTANCE TO A POINT ON THE WESTERLY LINE OF LOCUST PLACE N.E.; THENCE,

S 16°43'00"W, 81.34 FEET DISTANCE ALONG SAID WESTERLY LINE OF LOCUST PLACE N.E. TO A POINT OF CURVATURE; THENCE,

SOUTHWESTERLY, 35.78 FEET DISTANCE ALONG THE ARC OF A CURVE BEARING TO THE RIGHT, (SAID CURVE HAVING A RADIUS OF 25.00 FEET AND A CHORD WHICH BEARS S 57°43'15"W, 32.81 FEET DISTANCE) TO A POINT OF TANGENCY ON A NORTHERLY LINE OF SAID LOCUST PLACE N.E.; THENCE,

N 81°16'30"W, 874.21 FEET DISTANCE ALONG SAID NORTHERLY LINE OF LOCUST PLACE N.E. TO THE SOUTHWEST CORNER OF THE PARCEL HEREIN DESCRIBED, SAID POINT ALSO BEING A POINT ON THE EASTERLY LINE OF THE FOREMENTIONED SANTA BARBARA CEMETERY; THENCE,

N 11°20'50"E, 103.91 FEET DISTANCE ALONG SAID EASTERLY LINE OF THE SANTA BARBARA CEMETERY TO THE POINT AND PLACE OF BEGINNING OF THE PARCEL HEREIN DESCRIBED AND CONTAINING 17,053 ACRES, MORE OR LESS,

SURVEYED, PLATTED, AND NOW BEING IDENTIFIED AS PARCELS LETTERED "A" AND "B" OF THE INTERSTATE ADDITION, (WITHIN THE TOWN OF ALBUQUERQUE GRANT), TO THE CITY OF ALBUQUERQUE, BERNALILLO COUNTY, NEW MEXICO, WITH THE FREE CONSENT OF AND IN ACCORDANCE WITH THE WISHES AND DESIRES OF THE UNDERSIGNED OWNER(S) AND PROPRIETOR(S), THEREOF.

T G K INVESTMENTS CORP. TRUSTEE  
(A TEXAS CORPORATION)

Joseph B. Karam  
JOSEPH B. KARAM, PRESIDENT

STATE OF TEXAS )  
COUNTY OF BERNALILLO ) SS:

ON THIS 10th DAY OF October, 1979, BEFORE ME, A NOTARY PUBLIC IN AND FOR SAID COUNTY AND STATE, THE FOREGOING INSTRUMENT WAS ACKNOWLEDGED.

IN WITNESS WHEREOF, I HAVE HEREUNTO SET MY HAND AND OFFICIAL SEAL ON THE DAY AND DATE LAST ABOVE WRITTEN.

NOTARY PUBLIC: Carolyn S. Tandy  
MY COMMISSION EXPIRES: April 30, 1981

CAROLYN S. TANDY, Notary Public  
In and for the County of Bernalillo, Texas  
My commission expires April 30, 1981

APPROVAL AND CONDITIONAL ACCEPTANCE, AS SPECIFIED BY SUBSECTION 22.A.20 OF THE ALBUQUERQUE SUBDIVISION ORDINANCE.

G. D. Morrison 10-12-79 SP-79-574  
PLANNING DIRECTOR, CITY OF ALBUQUERQUE, N.M. DATE SP NO.  
CITY ✓ H-15 COUNTY

26 264201864

H-15-1 215-137 PR-553-A


| AS BUILT INFORMATION |         |      | BENCH MARKS                                  |      |      | SURVEY INFORMATION |    |      | ENGINEER'S SEAL |      |      | REVISIONS |      |    | DESIGN |      |      |
|----------------------|---------|------|----------------------------------------------|------|------|--------------------|----|------|-----------------|------|------|-----------|------|----|--------|------|------|
| CONTRACTOR           | WORK BY | DATE | STATION                                      | MARK | DATE | NO.                | BY | DATE | SEAL            | DATE | DATE | NO.       | DATE | BY | DATE   | DATE | DATE |
|                      |         |      | Station is a standard NMSHD brass tablet     |      |      |                    |    |      |                 |      |      |           |      |    |        |      |      |
|                      |         |      | tamped "STA 1-25-24", set in top of concrete |      |      |                    |    |      |                 |      |      |           |      |    |        |      |      |
|                      |         |      | post flush with the ground. The station is   |      |      |                    |    |      |                 |      |      |           |      |    |        |      |      |
|                      |         |      | located 1.5 mi. NorthEast of downtown        |      |      |                    |    |      |                 |      |      |           |      |    |        |      |      |
|                      |         |      | Albuquerque, at the SouthEast corner of the  |      |      |                    |    |      |                 |      |      |           |      |    |        |      |      |
|                      |         |      | Indian School Road bridge crossing of U.S.   |      |      |                    |    |      |                 |      |      |           |      |    |        |      |      |
|                      |         |      | Highway 1-25.                                |      |      |                    |    |      |                 |      |      |           |      |    |        |      |      |
|                      |         |      | Elev. = 5070.23                              |      |      |                    |    |      |                 |      |      |           |      |    |        |      |      |

CITY OF ALBUQUERQUE  
MUNICIPAL DEVELOPMENT DEPARTMENT  
ENGINEERING DIVISION

TITLE: **SUNVILLAGE APARTMENTS PLAT**

|                  |          |      |              |          |      |
|------------------|----------|------|--------------|----------|------|
| APPROVALS        | ENGINEER | DATE | APPROVALS    | ENGINEER | DATE |
| City Engineer    |          |      | Liquid Waste |          |      |
| A.C.E.-Design    | NA       |      | Traffic      | NA       |      |
| A.C.E.-Hydrology |          |      | Water        |          |      |

DRAWING NO. **2642** MAP NO. **H-15, J-15** SHEET **1a** OF **12**

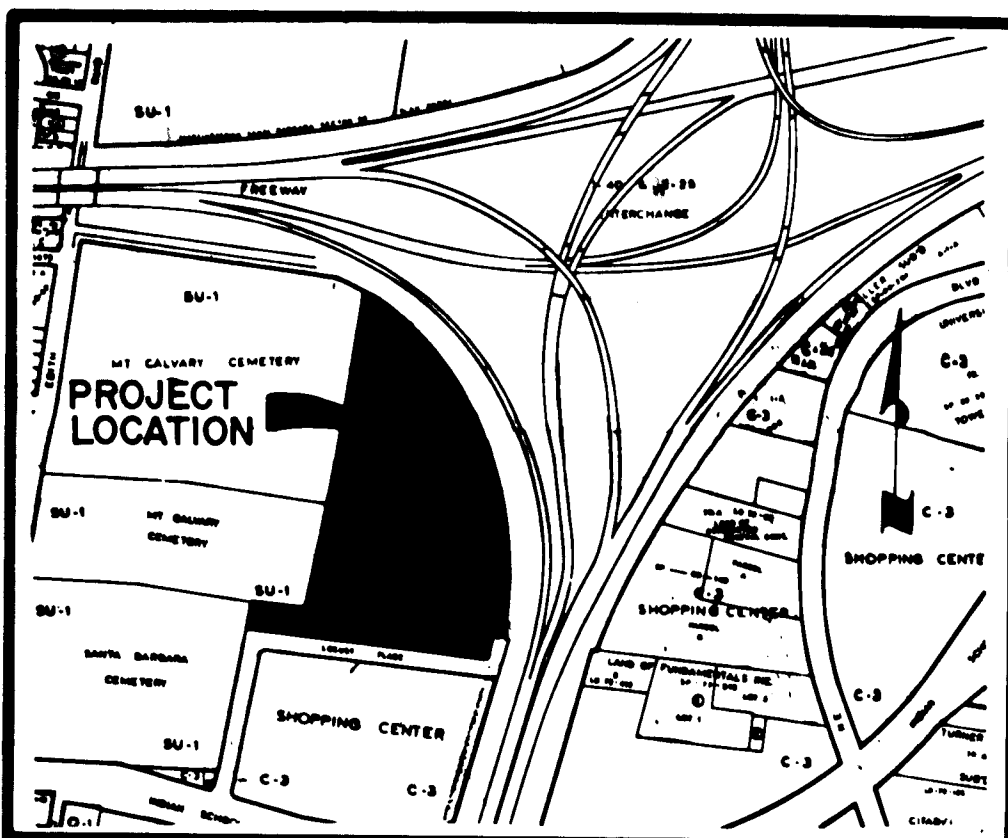

VICINITY MAP  
H15-Z & J15-Z

SUBDIVISION DATA

1. DB Case No. 85-752
2. Zone Atlas No. H & J15-Z
3. Net Acreage 7.0600 AC
4. Total Number of Tracts Created 1
5. Log No. 10-23-1885

DISCLOSURE STATEMENT

The purpose and intent of this plat is to combine Parcels "A" & "B".

NOTES

1. Basis of bearings is the common boundary line between Parcel "A" and Parcel "B" of the Summary Plat Showing Parcels "A" & "B", Interstate Addition, filed in the Office of the County Clerk of Bernalillo County on October 12, 1979, in Volume C18, Folio 137.
2. All distances are ground distances.
3. Bearings and distances in parenthesis are of record.

FREE CONSENT DEDICATION

The subdivision and dedication of all Public Rights-of-Way shown and the granting of the easements shown hereon is with the free consent and in accordance with the desires of the undersigned owner(s) and proprietor(s) thereof.

EMPIRE WEST COMPANIES  
KATY JOHNSON

11/3/85

ACKNOWLEDGEMENT

STATE OF NEW MEXICO )  
COUNTY OF BERNALILLO ) ss.

The foregoing instrument was acknowledged before me this  
5 day of November, 1985, by

Notary Public

My Commission Expires:

SURVEYOR'S CERTIFICATION

I, Fred Denney, do hereby certify that I am a Registered Engineer and Land Surveyor under the Laws of the State of New Mexico, that this Plat was prepared by me or under my supervision, and meets the minimum requirements of the Albuquerque Subdivision Ordinance and shows all easements of record, and is correct to the best of my knowledge and belief.

FRED DENNEY, N.M. P.E. & L.S. No. 1874

December 4, 1985

ACKNOWLEDGEMENT

STATE OF NEW MEXICO )  
COUNTY OF BERNALILLO ) ss.

The foregoing instrument was acknowledged before me this  
24 day of November, 1985, by

Notary Public

My Commission Expires:

PLAT OF  
SUNVILLAGE  
ALBUQUERQUE, NEW MEXICO

A REPLAT OF THE SUMMARY PLAT  
SHOWING PARCELS "A" AND "B",  
INTERSTATE ADDITION  
OCTOBER, 1985

DESCRIPTION

Beginning at the southwest corner of the tract herein described, said corner also being the southwest corner of Parcel "B" as said Parcel is shown and designated on the plat entitled "Summary Plat Showing Parcels 'A' & 'B', Interstate Addition", filed in the Office of the Bernalillo County Clerk on October 12, 1979, in Volume C18, Page 137, and whence for a tie the Standard A.C.S. tablet marked "I-25-24" bears S 43°41'46" E, 1403.74 feet; thence,  
N 11°16'38" E, 103.93 feet; thence,  
S 80°53'45" E, 202.59 feet; thence,  
N 12°32'33" E, 399.67 feet; thence,  
N 09°00'27" E, 830.53 feet to the northernmost corner of the tract herein described, said corner being a point on the southwesterly right-of-way line of a 40 foot frontage road lying adjacent to the Eastbound I-40 and Southbound I-25 ramp; thence,  
Southeasterly along said right-of-way line 621.78 feet along an arc of a curve to the right, said curve having a radius of 1,080.00 feet, a central angle of 33°55'43" and a chord that bears S 41°10'19" E, 612.73 feet to a point of compound curvature; thence,  
Continuing southerly along aforementioned right-of-way line 882.51 feet along the arc of a curve to the right, said curve having a radius of 1,668.18 feet, a central angle of 32°43'23" and a chord that bears S 07°50'44" E, 870.56 feet to a point on the northeasterly right-of-way line of Locust Place, N.E.; thence,  
S 18°40'57" W, 81.32 feet to the intersecting point of the north and east right-of-way lines of Locust Place, N.E.; thence,  
Southeasterly, 35.79 feet along the arc of a curve to the right, said curve having a radius of 25.00 feet, a central angle of 82°00'58" and a chord that bears S 57°41'26" W, 32.81 feet to the point of tangency, said point being on the north right-of-way line of Locust Place, N.E.; thence,  
Continuing N 81°18'04" W, 874.03 feet along said north right-of-way line to the point of beginning and containing 17.0600 Acres, more or less.

APPROVALS


11-17-85  
11-19-85  
11-19-85  
11-19-85  
11-19-85  
2/26/86  
2/26/86  
2-27-86

S.P. 86-82

dtm & associates, inc.  
Surveying Engineers & Planners & Architects  
3600 CONVERSE ROAD NE ALBUQUERQUE, NM 87107  
TELEPHONE (505) 264-1000

Sheet 1 of 2

D.T.M. & A. JOB NO. 823.12

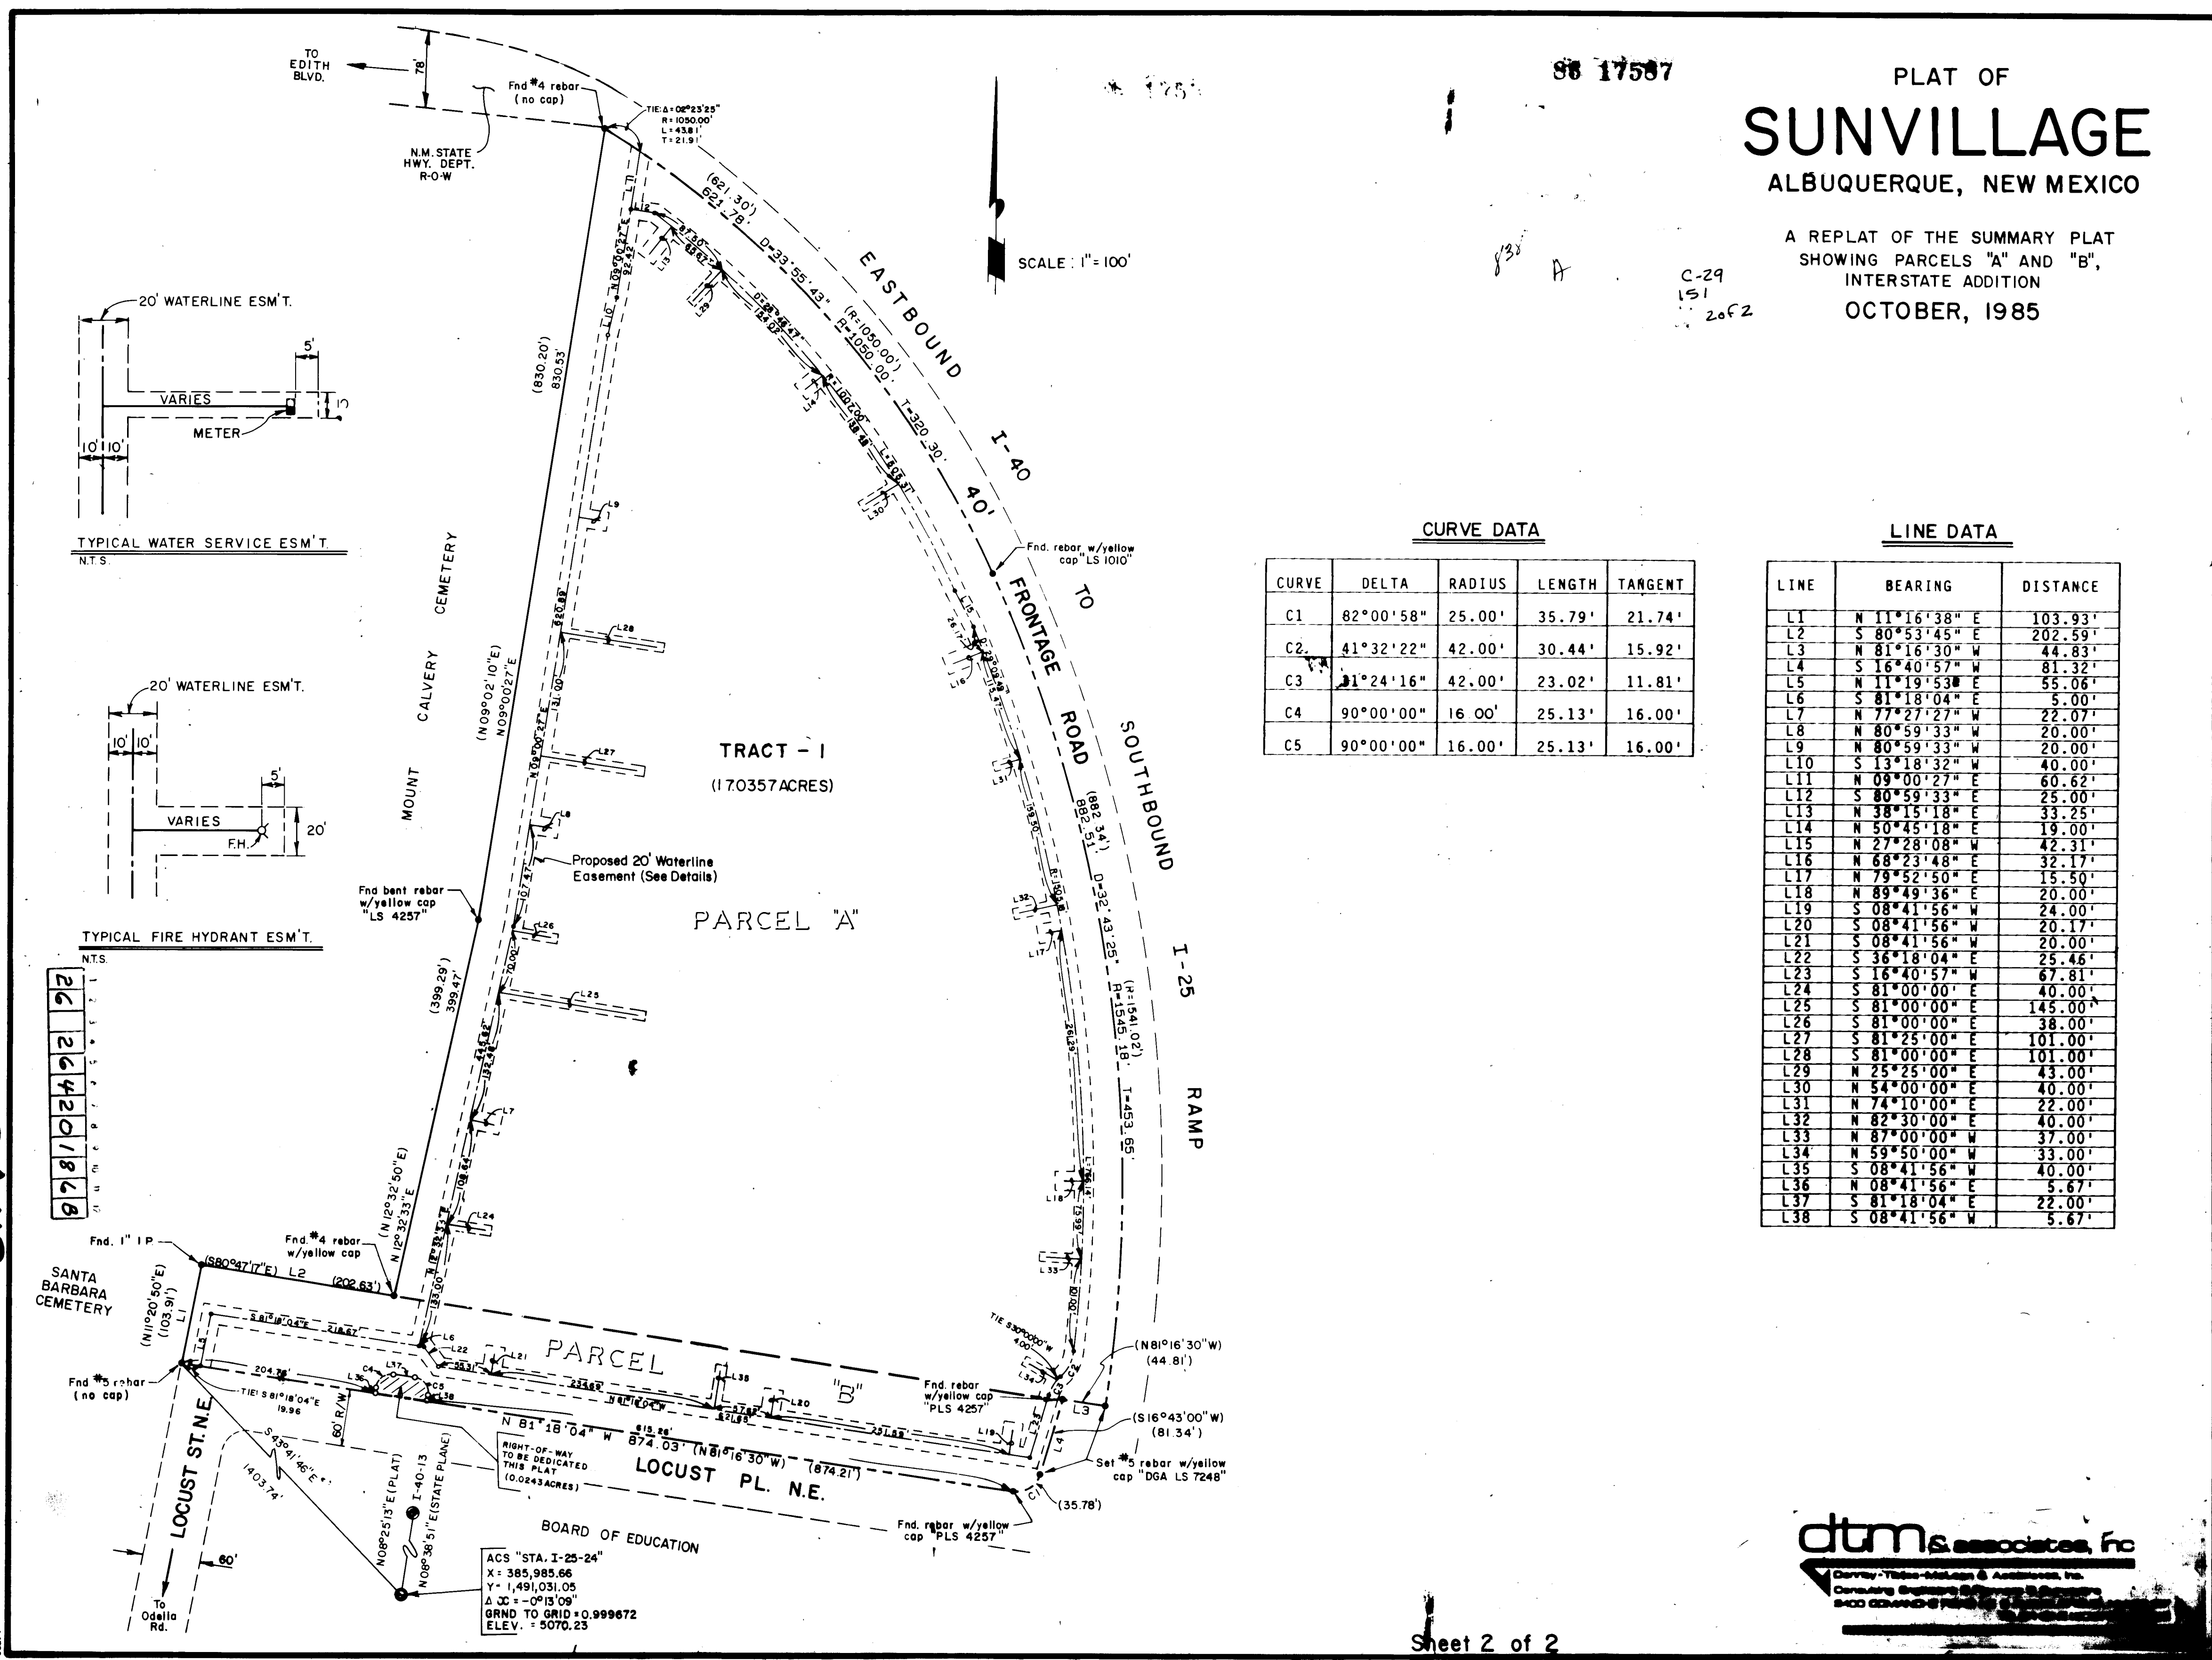


| CURVE DATA |           |        |        |         |
|------------|-----------|--------|--------|---------|
| CURVE      | DELTA     | RADIUS | LENGTH | TANGENT |
| C1         | 82°00'58" | 25.00' | 35.79' | 21.74'  |
| C2         | 41°32'22" | 42.00' | 30.44' | 15.92'  |
| C3         | 31°24'16" | 42.00' | 23.02' | 11.81'  |
| C4         | 90°00'00" | 16.00' | 25.13' | 16.00'  |
| C5         | 90°00'00" | 16.00' | 25.13' | 16.00'  |

| LINE DATA |                |          |
|-----------|----------------|----------|
| LINE      | BEARING        | DISTANCE |
| L1        | N 11°16'38" E  | 103.93'  |
| L2        | S 80°53'45" E  | 202.59'  |
| L3        | N 12°32'33" E  | 399.67'  |
| L4        | N 09°00'27" E  | 830.53'  |
| L5        | N 11°19'23" E  | 25.06'   |
| L6        | S 81°18'04" W  | 5.00'    |
| L7        | N 77°27'27" W  | 22.07'   |
| L8        | N 80°59'33" W  | 20.00'   |
| L9        | N 80°59'33" W  | 20.00'   |
| L10       | S 134°18'37" W | 40.00'   |
| L11       | N 09°00'27" E  | 60.62'   |
| L12       | S 80°59'33" E  | 25.00'   |
| L13       | N 18°15'18" E  | 35.25'   |
| L14       | N 50°45'18" E  | 19.00'   |
| L15       | N 77°28'08" W  | 42.31'   |
| L16       | N 68°23'48" E  | 36.15'   |
| L17       | N 78°52'50" E  | 15.50'   |
| L18       | N 85°49'36" E  | 20.00'   |
| L19       | S 08°41'56" W  | 24.00'   |
| L20       | S 08°41'56" W  | 20.17'   |
| L21       | S 08°41'56" W  | 20.00'   |
| L22       | S 16°18'04" E  | 25.46'   |
| L23       | S 84°40'57" W  | 87.81'   |
| L24       | S 81°00'00" E  | 40.00'   |
| L25       | S 81°00'00" E  | 145.00'  |
| L26       | S 81°00'00" E  | 38.00'   |
| L27       | S 81°25'00" E  | 101.00'  |
| L28       | S 81°00'00" E  | 101.00'  |
| L29       | N 75°25'00" E  | 43.00'   |
| L30       | N 54°00'00" E  | 40.00'   |
| L31       | N 75°10'00" E  | 22.00'   |
| L32       | N 89°30'00" E  | 40.00'   |
| L33       | N 87°00'00" W  | 37.00'   |
| L34       | N 55°50'00" W  | 31.00'   |
| L35       | S 08°41'56" W  | 40.00'   |
| L36       | N 08°41'56" E  | 5.67'    |
| L37       | S 81°18'04" E  | 22.00'   |
| L38       | S 08°41'56" W  | 5.67'    |

dtm & associates, inc.  
Surveying Engineers & Planners & Architects  
3600 CONVERSE ROAD NE ALBUQUERQUE, NM 87107  
TELEPHONE (505) 264-1000

Sheet 2 of 2

D.T.M. & A. JOB NO. 823.12

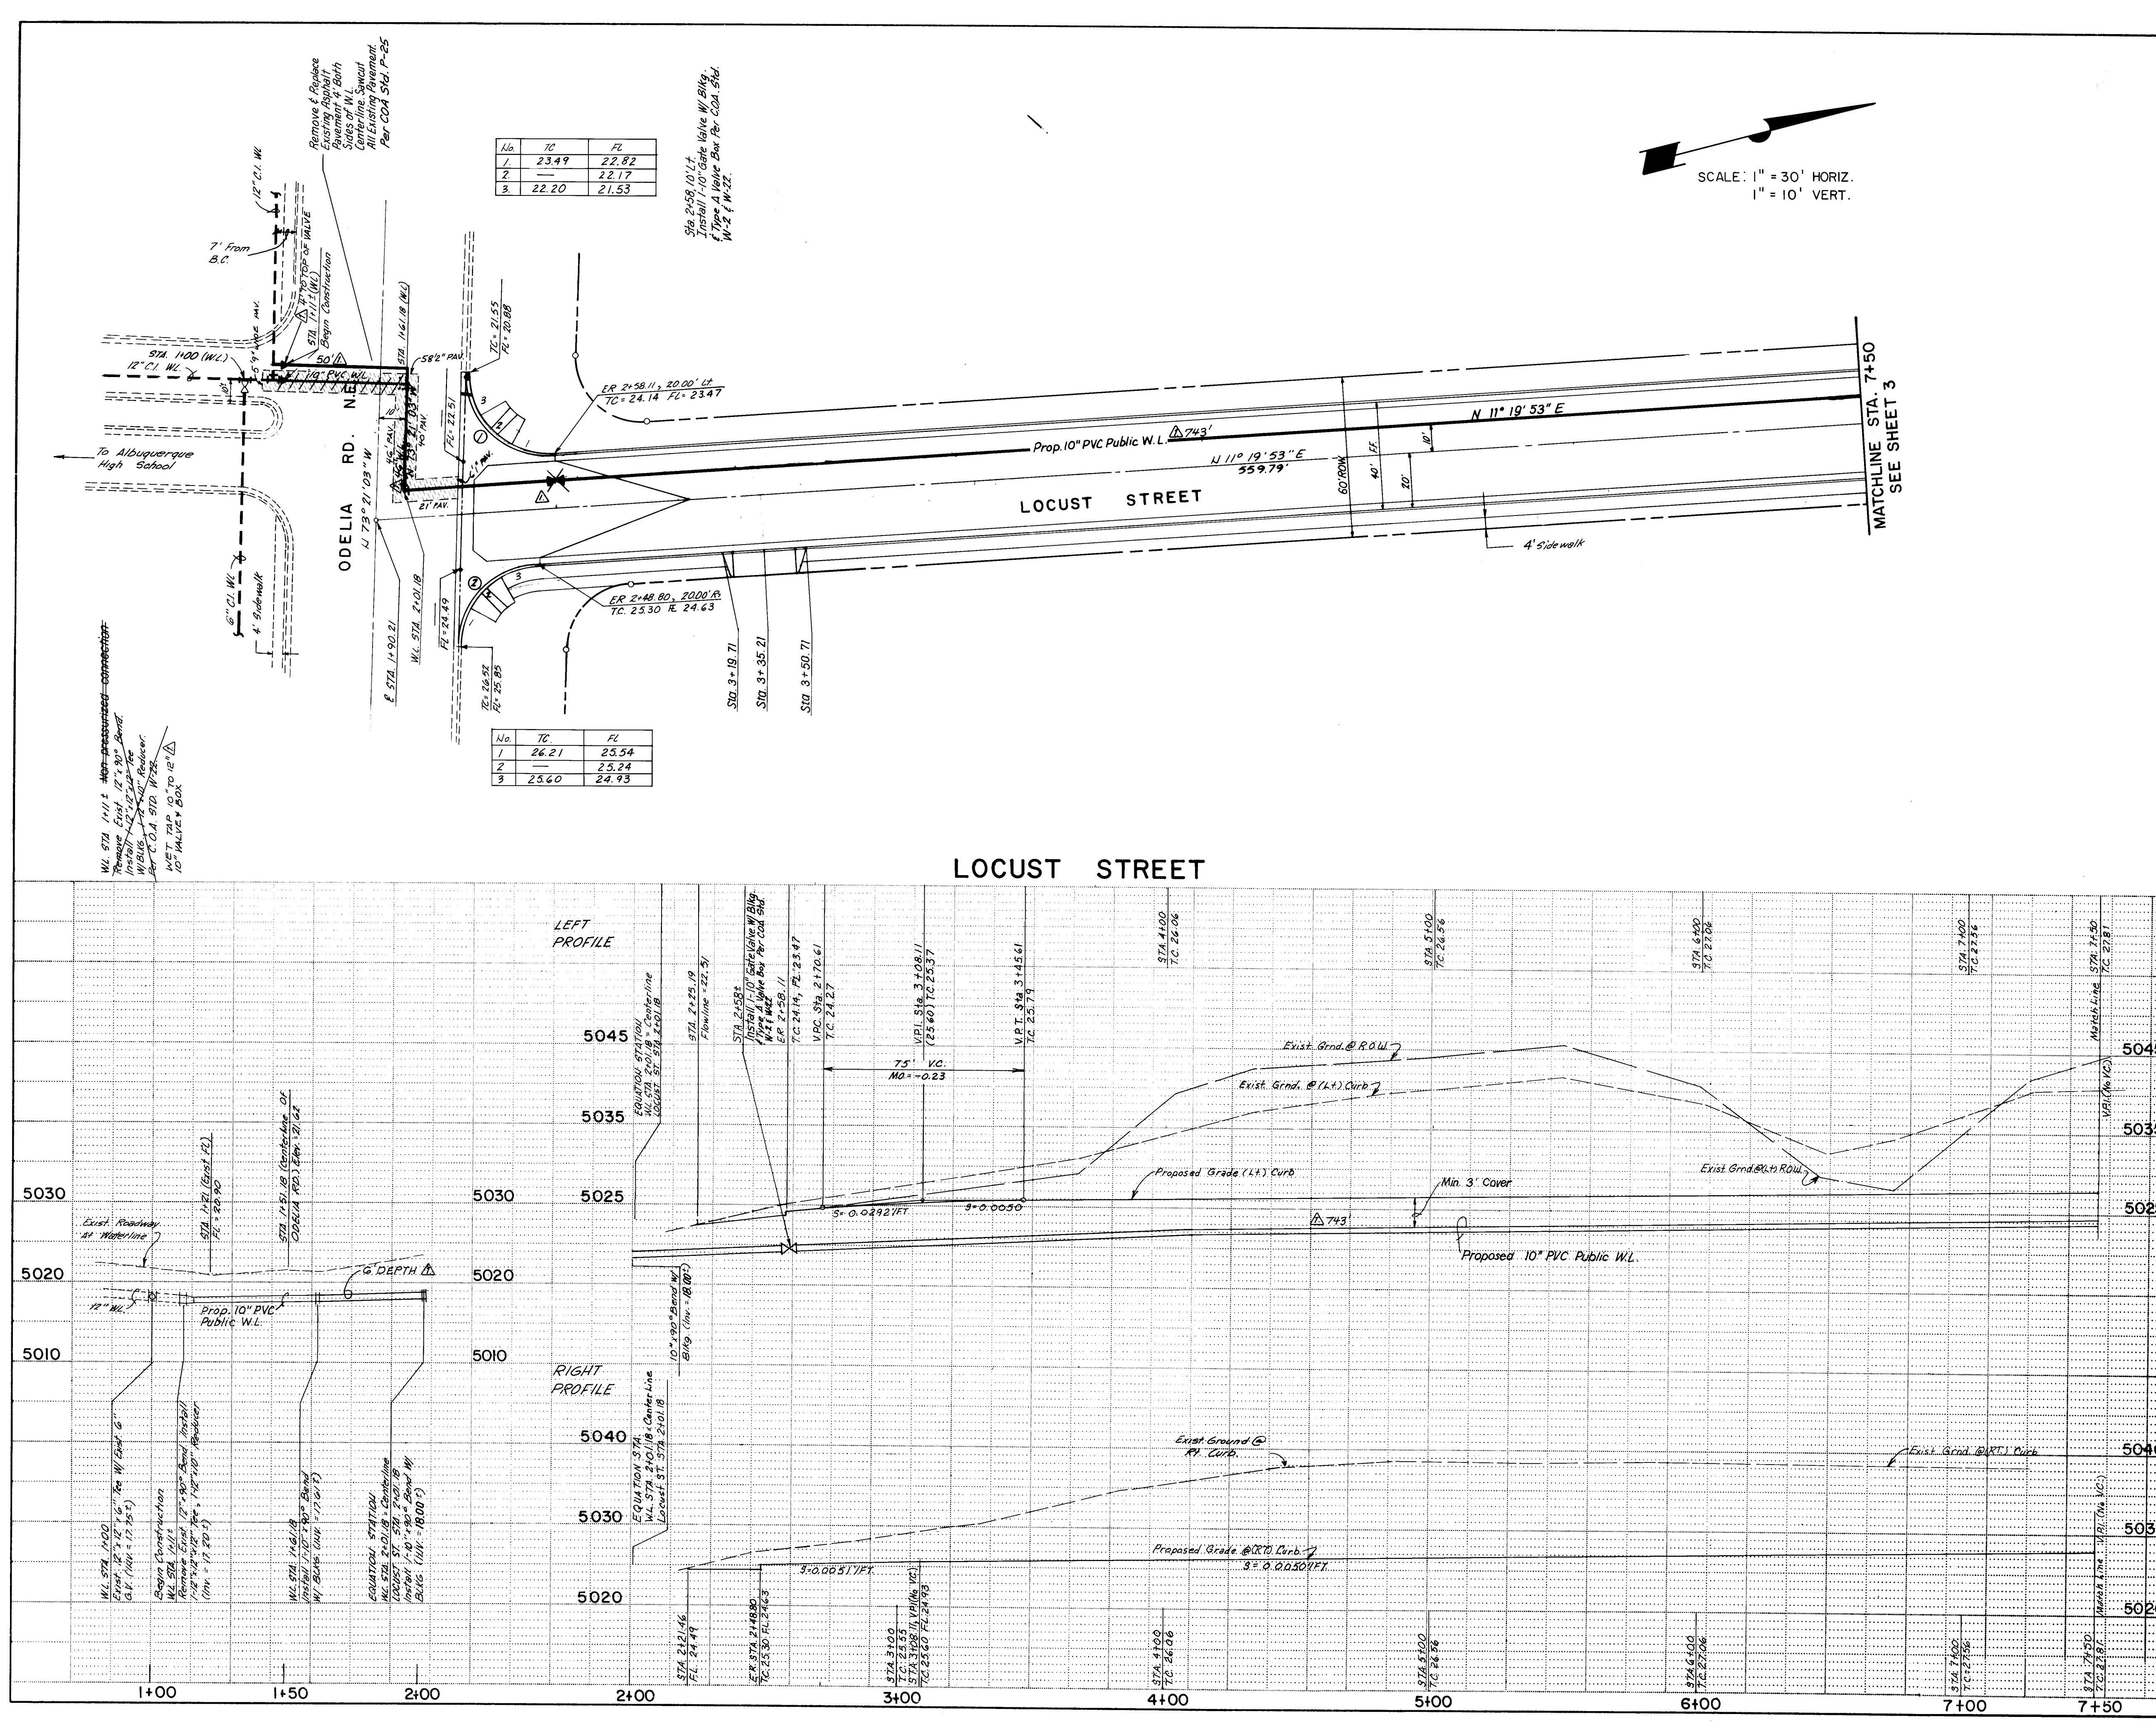

FACE OF CURB CURVE DATA

| CURVE NO. | DELTA     | RADIUS | LENGTH | TANGENT |
|-----------|-----------|--------|--------|---------|
| ①         | 95°19'04" | 30.00' | 49.91' | 32.85'  |
| ②         | 84°40'56" | 30.00' | 44.34' | 27.34'  |

NOTE:  
SIDEWALK ON WEST SIDE HAS BEEN  
WAIVED. REF SV-85-35

WL STA 1+11.2 Not pressure connection  
Remove End 12" x 10" Band  
W/BLK. 12" x 10" Band  
Per C.O.A. STD. W/BLK.  
WET. MAP 10" to 12" Δ  
10" VALVE BOX

Sta. 2+58.11/12  
Install 10" Gate Valve W/BLK.  
F-Type Valve Box Per C.O.A. Std.  
W-2 & W-22

SCALE: 1" = 30' HORIZ.  
1" = 10' VERT.

LOCUST STREET

NOTE:  
WORK ORDER INCLUDES: LOCUST STREET,  
LOCUST PLACE, ACCESS ROAD TO  
EDITH BLVD. & PUBLIC WATER LINES.

CITY OF ALBUQUERQUE  
MUNICIPAL DEVELOPMENT DEPARTMENT  
ENGINEERING DIVISION

TITLE:  
SUNVILLAGE APARTMENTS  
LOCUST STREET


| APPROVALS        | ENGINEER           | DATE     | APPROVALS    | ENGINEER           | DATE     |
|------------------|--------------------|----------|--------------|--------------------|----------|
| City Engineer    | <i>[Signature]</i> | 11/02/85 | Liquid Waste | <i>[Signature]</i> | 11/21/85 |
| A.C.E.-Design    | <i>[Signature]</i> | 11/22/85 | Traffic      | <i>[Signature]</i> | 11/22/85 |
| A.C.E.-Hydrology | <i>[Signature]</i> | 11/22/85 | Water        | <i>[Signature]</i> | 11/22/85 |

DESIGNED BY T.J.M.  
DRAWN BY M.F.  
CHECKED BY L.C.G.


DATE SEP-1985  
DATE SEP-1985  
DATE SEP-1985

DRAWING NO. 2642  
MAP NO. H-15, J-15  
SHEET 2 OF 12

| SURVEY INFORMATION |    | BENCH MARKS                                                                                                                                                                                                                                                                  |         | AS BUILT INFORMATION |      |
|--------------------|----|------------------------------------------------------------------------------------------------------------------------------------------------------------------------------------------------------------------------------------------------------------------------------|---------|----------------------|------|
| NO.                | BY | DATE                                                                                                                                                                                                                                                                         | STATION | CONTRACTOR           | DATE |
|                    |    |                                                                                                                                                                                                                                                                              |         | J.R. HALE            |      |
| FIELD NOTES        |    | Station is a standard NMSD Brass Tablet, stamped "STA 1-25-24", set in top of concrete post flush with the ground. The station is located 1.5 mi. Northeast of downtown Albuquerque, at the Southeast corner of the Indian School Road bridge crossing of U.S. Highway 1-25. |         |                      |      |
| ENGINEER'S SEAL    |    | MICRO-FILM INFORMATION                                                                                                                                                                                                                                                       |         |                      |      |
|                    |    | RECORD BY                                                                                                                                                                                                                                                                    |         |                      |      |
|                    |    | DATE                                                                                                                                                                                                                                                                         |         |                      |      |

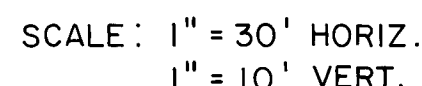

| No. | TC    | FL    |
|-----|-------|-------|
| 1   | 28.69 | 28.02 |
| 2   | —     | 28.20 |
| 3   | 29.05 | 28.38 |

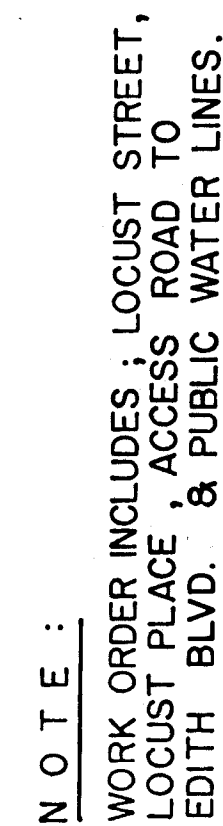

26 26420386

FACE OF CURB CURVE DATA


| <u>CURVE NO.</u> | <u>DELTA</u> | <u>RADIUS</u> | <u>LENGTH</u> | <u>TANGENT</u> |
|------------------|--------------|---------------|---------------|----------------|
| ①                | 87°22'03"    | 30.00'        | 45.75'        | 28.65'         |
| ②                | 180°03'15"   | 9.00'         | 28.27'        | —              |
| ③                | 53°07'48"    | 25.00'        | 23.18'        | 12.50'         |
| ④                | 126°52'12"   | 5.00'         | 11.07'        | 10.00'         |

| ENGINEER'S SEAL |                                | SURVEY INFORMATION |             | BENCH MARKS |                                                                                                                                                                                                                                                                                 | AS BUILT INFORMATION            |                  |
|-----------------|--------------------------------|--------------------|-------------|-------------|---------------------------------------------------------------------------------------------------------------------------------------------------------------------------------------------------------------------------------------------------------------------------------|---------------------------------|------------------|
|                 |                                | FIELD NOTES        |             |             |                                                                                                                                                                                                                                                                                 |                                 |                  |
|                 |                                | NO.                | BY          | DATE        |                                                                                                                                                                                                                                                                                 |                                 |                  |
| 5/86            | Least Entry Change             |                    |             |             | Station is a standard MMSHD brass tablet stamped " STA 1-25-24", set in top of concrete post flush with the ground . The station is located 1.5 mi. Northeast of downtown Albuquerque , at the SouthEast corner of the Indian School Road bridge crossing of U.S. Highway 1-25. | CONTRACTOR <i>J.R. HALE</i>     | DATE             |
| 9/85            | Revised from as-built drawings |                    |             |             |                                                                                                                                                                                                                                                                                 | INSPECTORS                      | DATE             |
|                 |                                |                    |             |             |                                                                                                                                                                                                                                                                                 | ACCEPTANCE BY <i>D. Herrera</i> | DATE <i>9/86</i> |
| NO.             | DATE                           | REMARKS            | BY          |             |                                                                                                                                                                                                                                                                                 | VERIFICATION BY                 | DATE             |
|                 |                                | REV/SIONS          |             |             |                                                                                                                                                                                                                                                                                 | DRAWINGS                        | DATE <i>9/86</i> |
|                 |                                | DESIGN             |             |             |                                                                                                                                                                                                                                                                                 | SCALE                           | DATE <i>9/86</i> |
| DESIGNED BY     | <i>TJM</i>                     | DATE               | <i>9/85</i> |             |                                                                                                                                                                                                                                                                                 | MICRO-FILM INFORMATION          |                  |
| DRAWN BY        | <i>M/RJ</i>                    | DATE               | <i>9/85</i> |             |                                                                                                                                                                                                                                                                                 | RECORDED BY                     | DATE             |
| CHECKED BY      | <i>LCC</i>                     | DATE               | <i>9/85</i> |             |                                                                                                                                                                                                                                                                                 | NO.                             |                  |
|                 |                                |                    |             |             |                                                                                                                                                                                                                                                                                 | Elev. = 5070.23 Feet            |                  |

|                                                                                 |                                        |
|---------------------------------------------------------------------------------|----------------------------------------|
| CITY OF ALBUQUERQUE<br>MUNICIPAL DEVELOPMENT DEPARTMENT<br>ENGINEERING DIVISION |                                        |
| TITLE:                                                                          | SUNVILLAGE APARTMENTS<br>LOCUST STREET |

| APPROVALS        | ENGINEER                 | DATE    | APPROVALS    | ENGINEER            | DATE    |
|------------------|--------------------------|---------|--------------|---------------------|---------|
| City Engineer    | <i>H. B. [Signature]</i> | 1/10/85 | Liquid Waste | <i>[Signature]</i>  | 4/22/85 |
| A.C.E. Design    | <i>[Signature]</i>       | 1/22/85 | Traffic      | <i>D. G. Pender</i> | 1/22/85 |
| A.C.E. Hydrology | <i>[Signature]</i>       | 1/22/85 | Water        | <i>[Signature]</i>  | 4/22/85 |

|                            |                       |            |          |
|----------------------------|-----------------------|------------|----------|
| DRAWING<br>NO. <b>2642</b> | MAP NO.<br>H-15, J-15 | SHEET<br>3 | OF<br>12 |
|----------------------------|-----------------------|------------|----------|

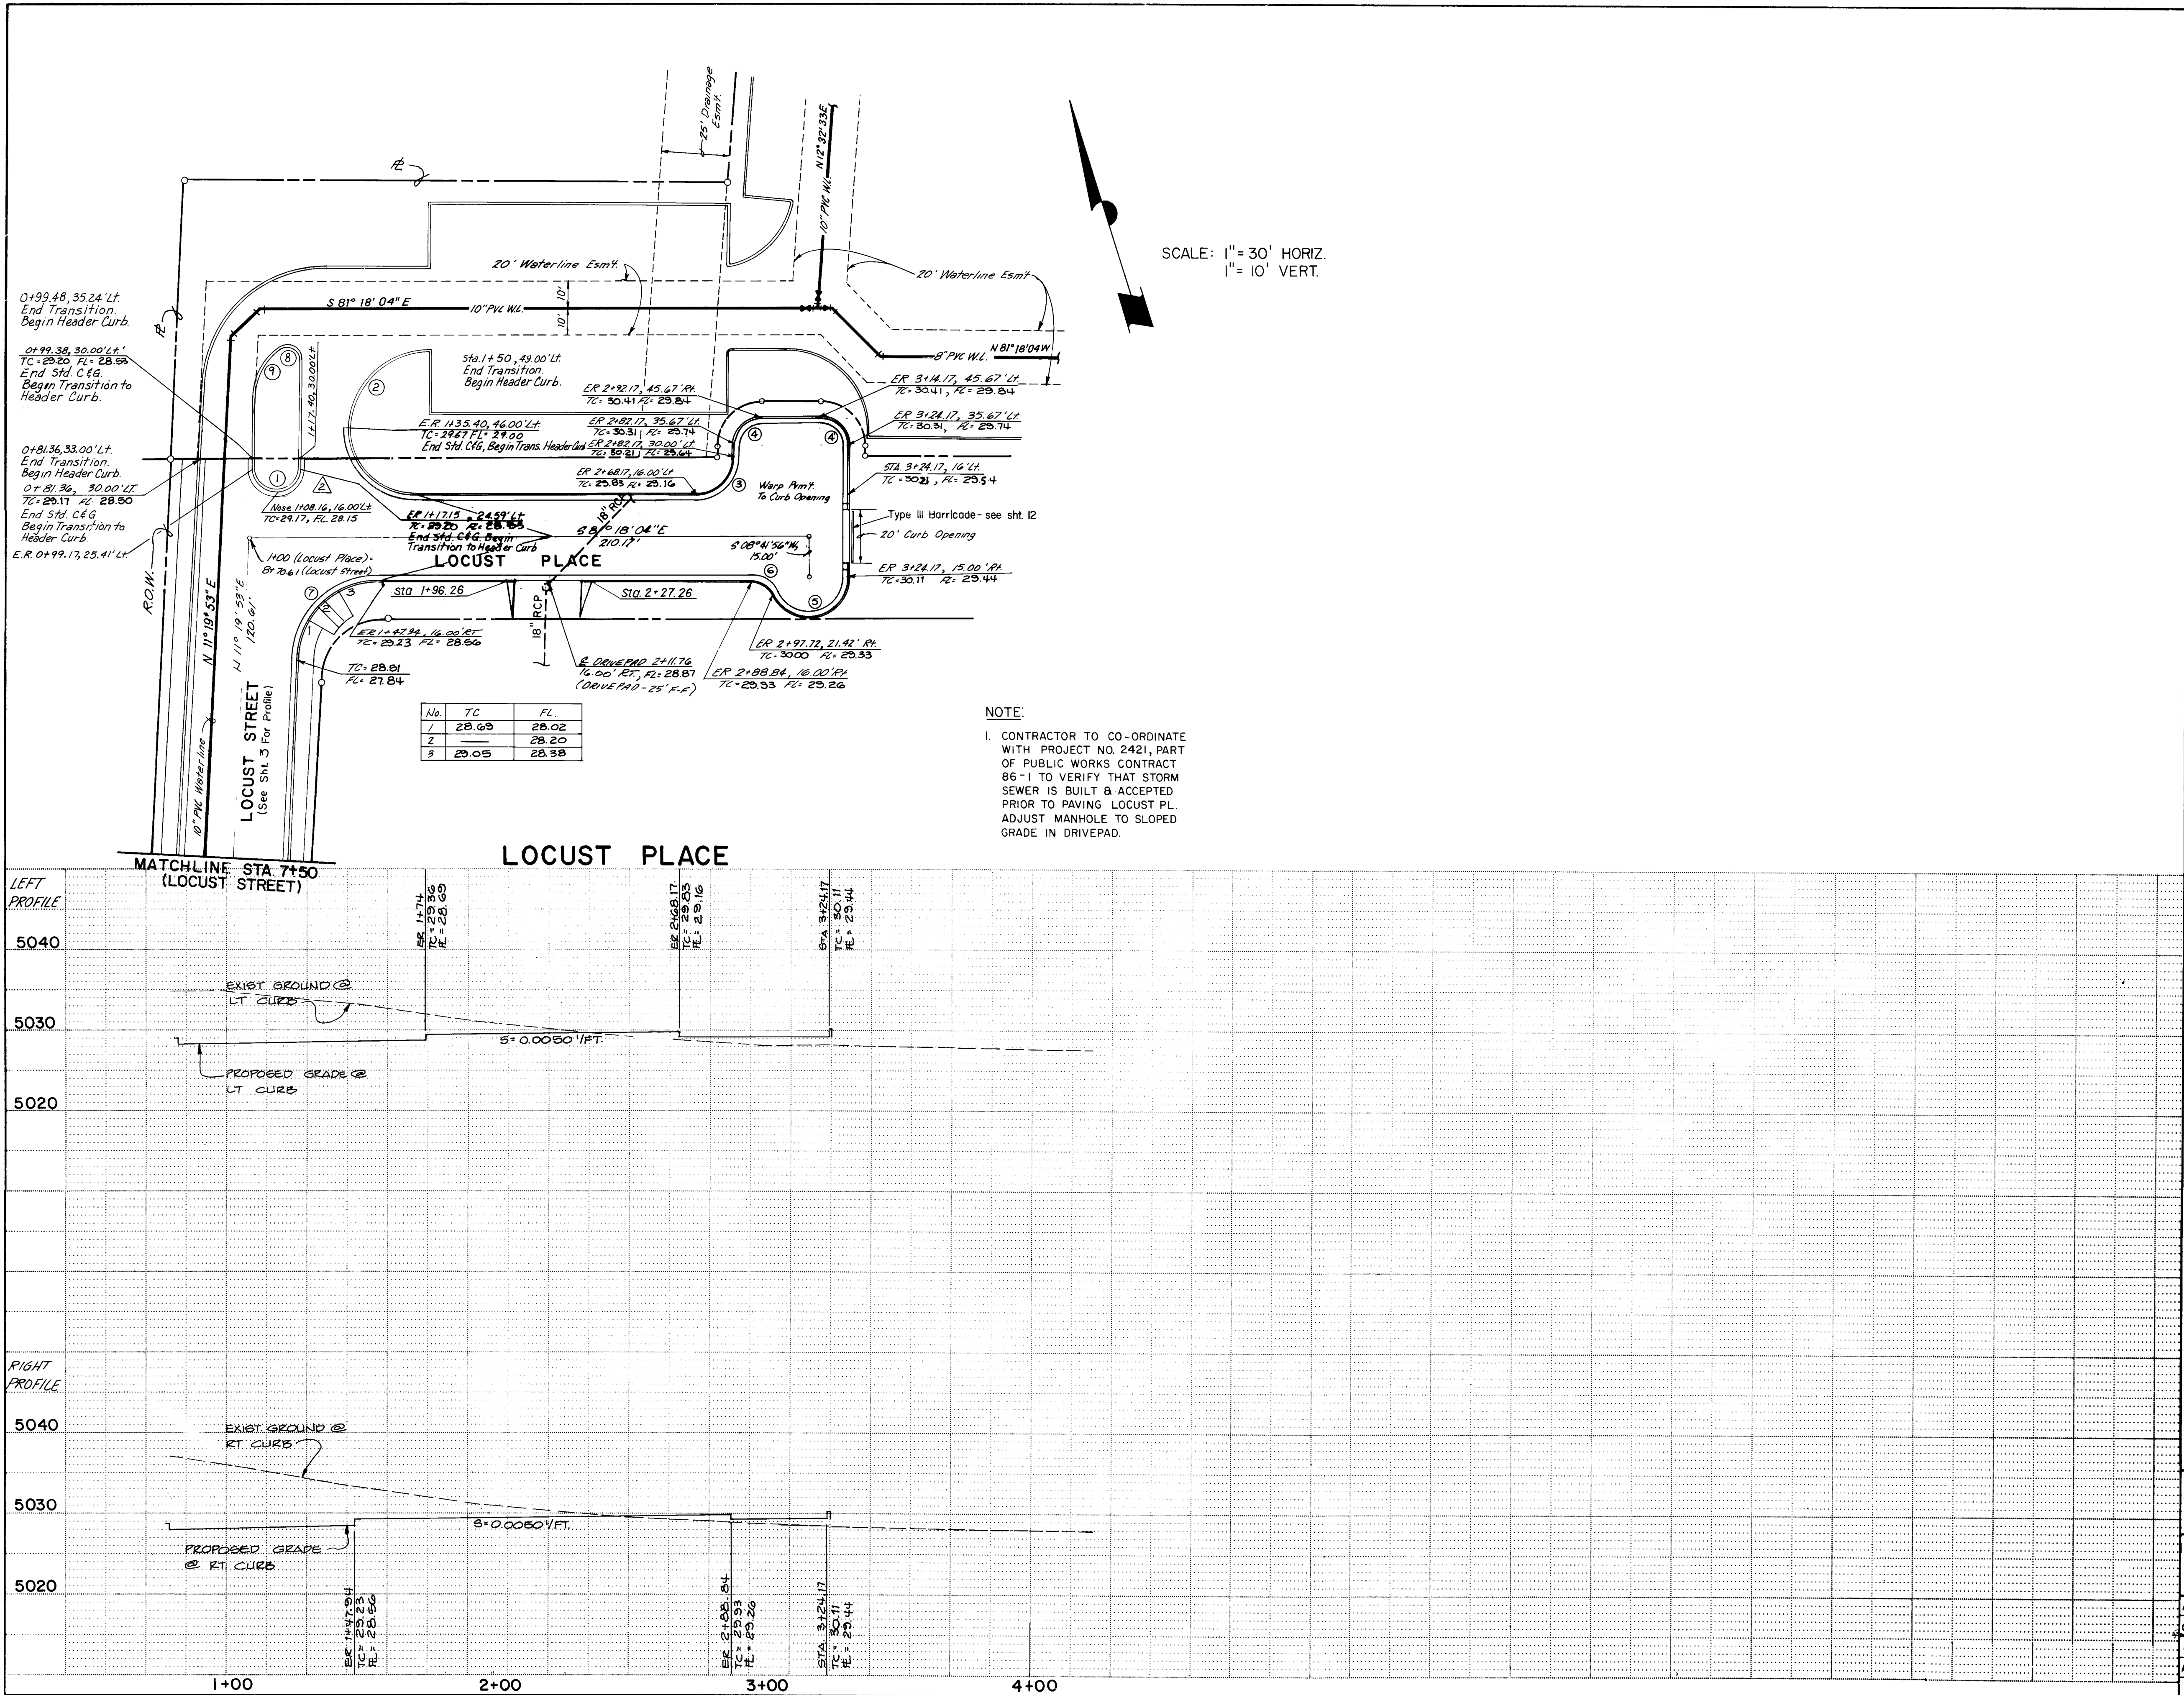

FACE OF CURB CURVE DATA


| CURVE NO. | DELTA      | RADIUS | LENGTH | TANGENT |
|-----------|------------|--------|--------|---------|
| ①         | 180°00'00" | 9.00'  | 28.27' | —       |
| ②         | 101°32'13" | 25.00' | 44.30' | 30.62'  |
| ③         | 90°00'00"  | 14.00' | 21.99' | 14.00'  |
| ④         | 90°00'00"  | 10.00' | 15.71' | 10.00'  |
| ⑤         | 152°43'13" | 14.00' | 37.32' | 57.69'  |
| ⑥         | 62°43'13"  | 10.00' | 10.95' | 6.09'   |
| ⑦         | 87°22'03"  | 30.00' | 45.75' | 28.65'  |
| ⑧         | 126°52'12" | 5.00'  | 11.07' | 10.00'  |
| ⑨         | 53°07'48"  | 25.00' | 23.18' | 12.50'  |

| AS BUILT INFORMATION                                                                                                                                                                                                                                                         |              | BENCH MARKS |      | SURVEY INFORMATION |    | ENGINEER'S SEAL |    |
|------------------------------------------------------------------------------------------------------------------------------------------------------------------------------------------------------------------------------------------------------------------------------|--------------|-------------|------|--------------------|----|-----------------|----|
| CONTRACTOR                                                                                                                                                                                                                                                                   | WORK         | STATION     | DATE | NO.                | BY | NO.             | BY |
| Station is a standard WMSD Brass Tablet, stamped "STA 1-25-24", set in top of concrete post flush with the ground. The station is located 1.5 mi. NorthEast of downtown Albuquerque, at the Southeast corner of the Indian School Road bridge crossing of U.S. Highway 1-25. | INSPECTORS   | DATE        | DATE | NO.                | BY | NO.             | BY |
|                                                                                                                                                                                                                                                                              | FIELD        | DATE        | DATE | NO.                | BY | NO.             | BY |
|                                                                                                                                                                                                                                                                              | VERIFICATION | DATE        | DATE | NO.                | BY | NO.             | BY |
|                                                                                                                                                                                                                                                                              | CORRECTION   | DATE        | DATE | NO.                | BY | NO.             | BY |
|                                                                                                                                                                                                                                                                              | RECORDED     | DATE        | DATE | NO.                | BY | NO.             | BY |
|                                                                                                                                                                                                                                                                              | NO           |             |      | NO.                | BY | NO.             | BY |

NOTE:  
WORK ORDER INCLUDES: LOCUST STREET,  
LOCUST PLACE, ACCESS ROAD TO  
EDITH BLVD. & PUBLIC WATER LINES.

26 26420486

|                                                                                 |                    |                    |              |                    |          |
|---------------------------------------------------------------------------------|--------------------|--------------------|--------------|--------------------|----------|
| CITY OF ALBUQUERQUE<br>MUNICIPAL DEVELOPMENT DEPARTMENT<br>ENGINEERING DIVISION |                    |                    |              |                    |          |
| TITLE: SUNVILLAGE APARTMENTS<br>LOCUST PLACE                                    |                    |                    |              |                    |          |
| APPROVALS                                                                       | ENGINEER           | DATE               | APPROVALS    | ENGINEER           | DATE     |
| City Engineer                                                                   | <i>[Signature]</i> | 11/16/86           | Liquid Waste | <i>[Signature]</i> | 11/22/86 |
| A.C.E.-Design                                                                   | <i>[Signature]</i> | 11/22/86           | Traffic      | <i>[Signature]</i> | 11/22/86 |
| A.C.E.-Hydrology                                                                | <i>[Signature]</i> | 11/22/86           | Water        | <i>[Signature]</i> | 11/22/86 |
| DRAWING NO. 2642                                                                |                    | MAP NO. H-15, J-15 |              | SHEET 4 OF 12      |          |

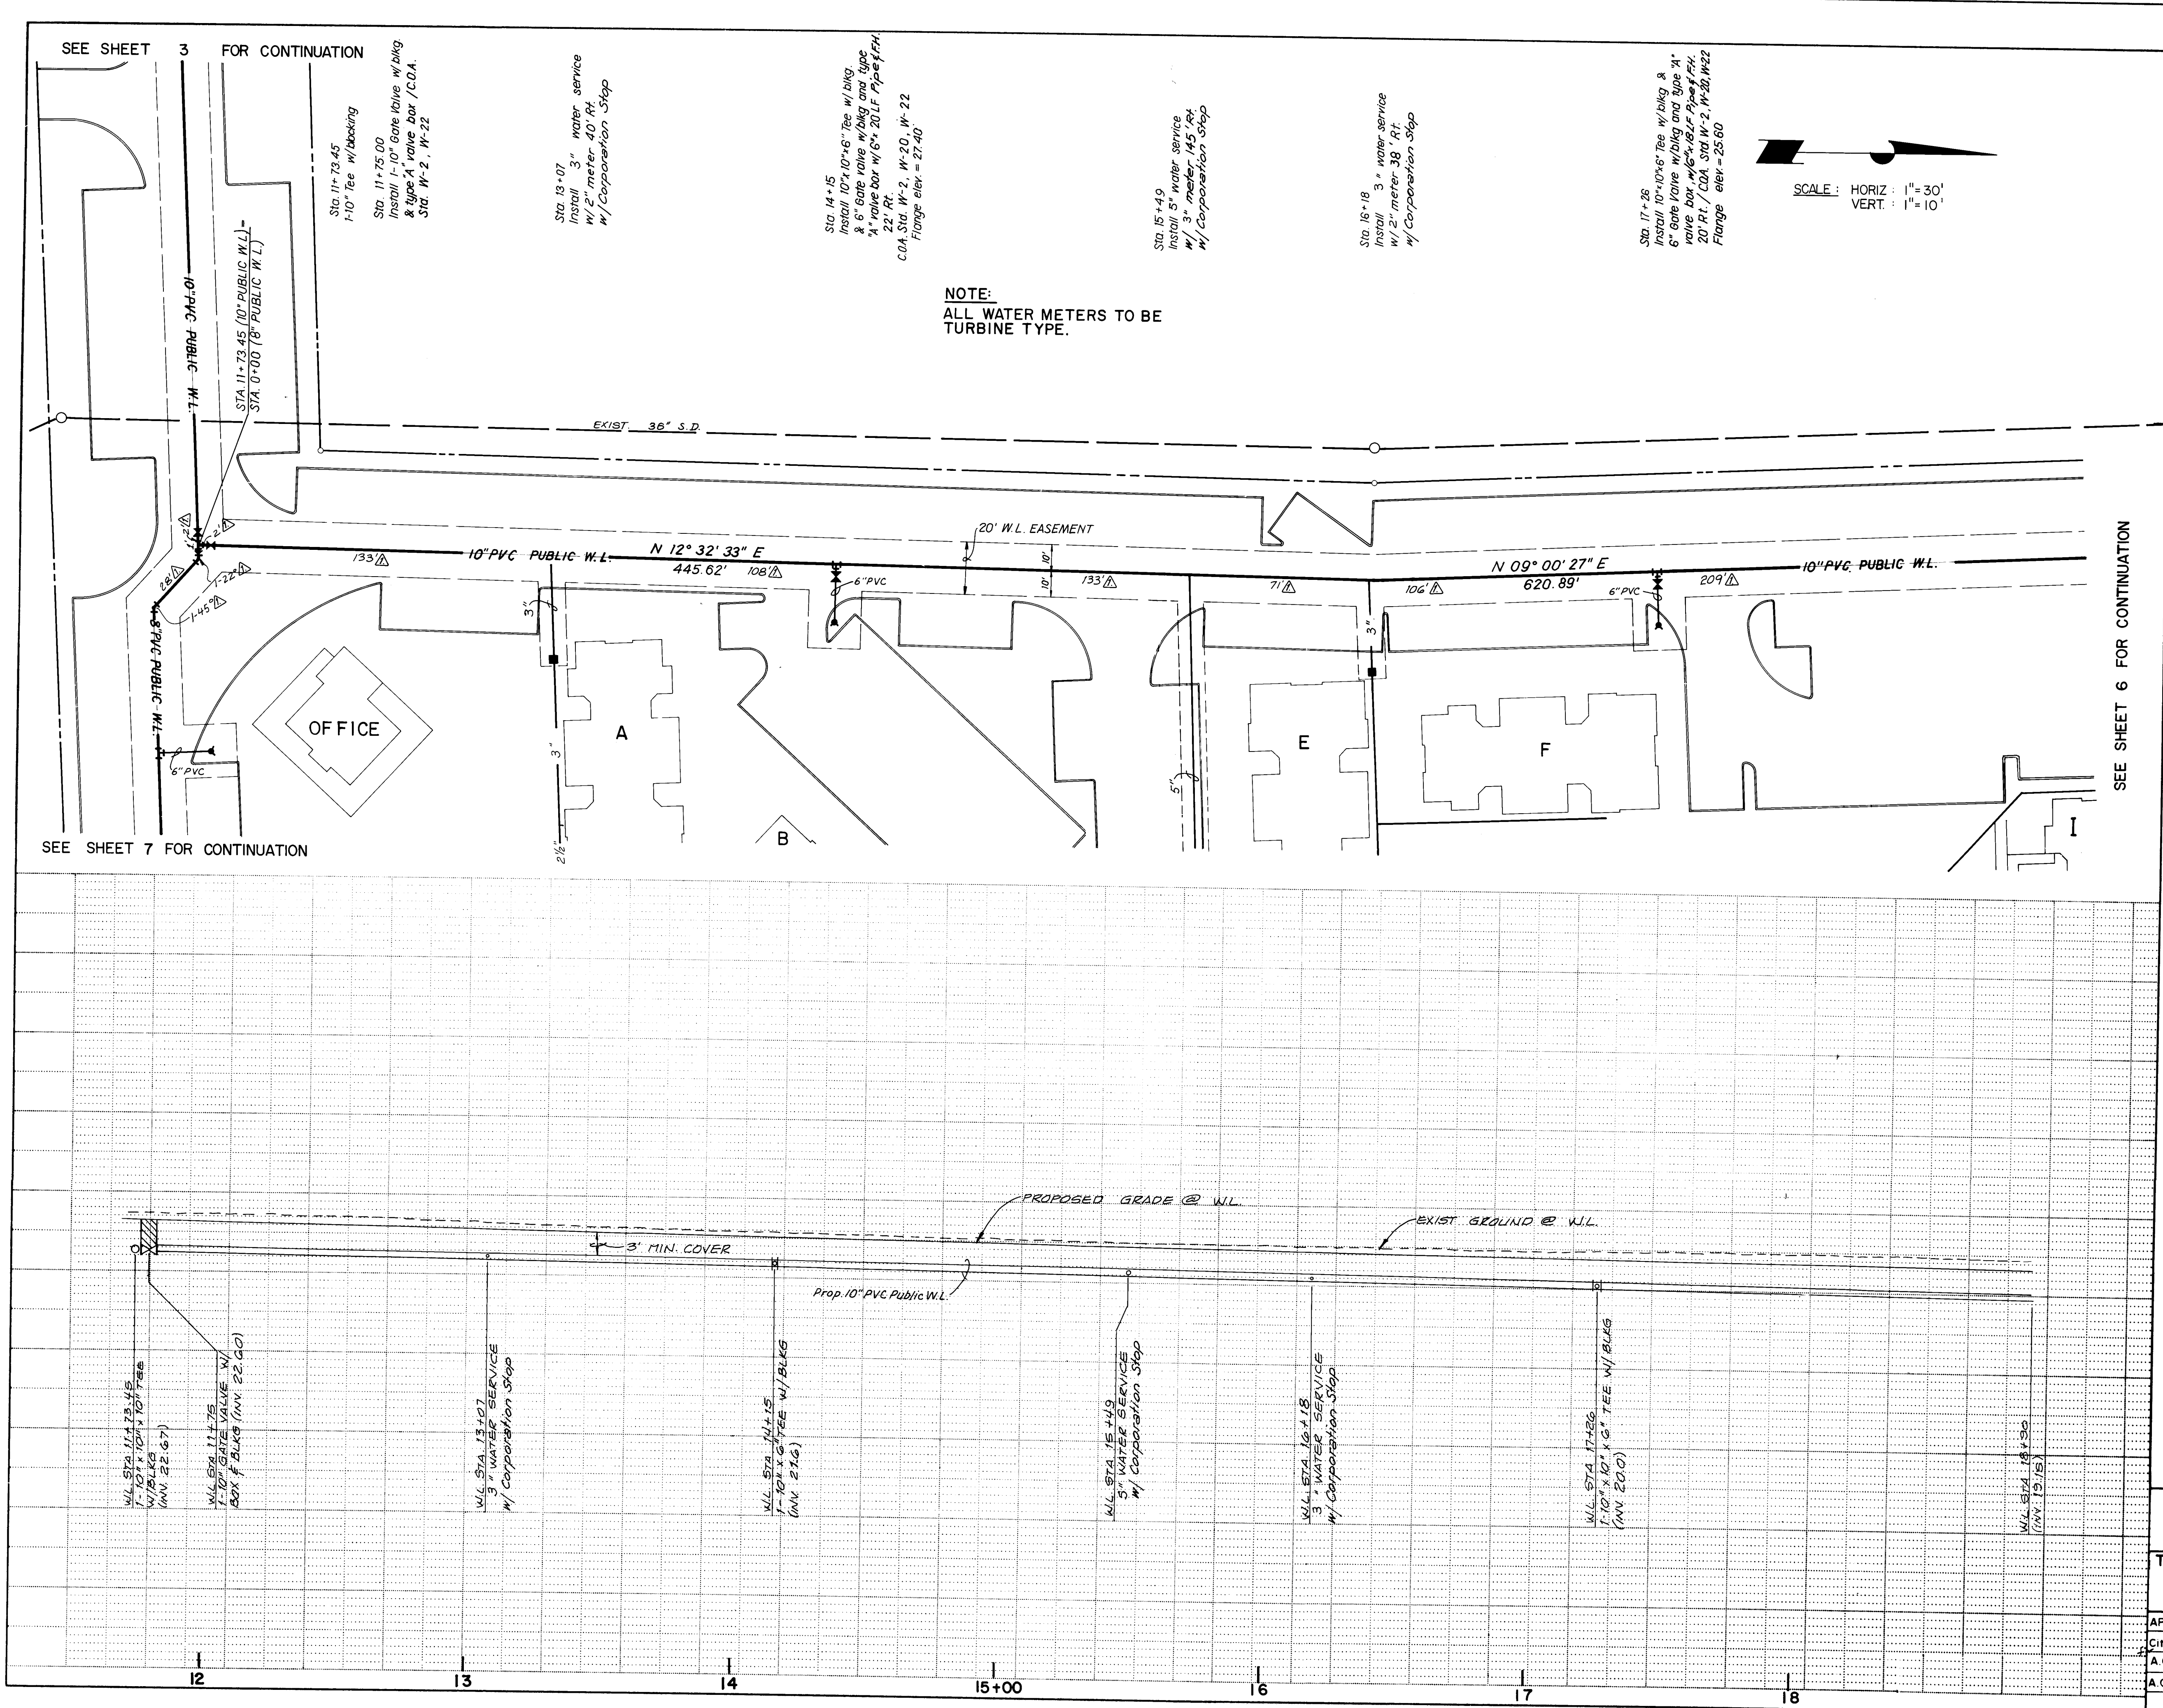

NOTE:  
WORK ORDER INCLUDES: LOCUST STREET,  
LOCUST PLACE, ACCESS ROAD TO  
EDITH BLVD. & PUBLIC WATER LINES.

26 26420586

CITY OF ALBUQUERQUE  
MUNICIPAL DEVELOPMENT DEPARTMENT  
ENGINEERING DIVISION


TITLE: SUNVILLAGE APARTMENTS  
10" PUBLIC WATER LINE

| APPROVALS          | ENGINEER           | DATE     | APPROVALS    | ENGINEER           | DATE     |
|--------------------|--------------------|----------|--------------|--------------------|----------|
| City Engineer      | <i>[Signature]</i> | 11/09/05 | Liquid Waste | <i>[Signature]</i> | 11/09/05 |
| A.C.E. - Design    | <i>[Signature]</i> | 11/02/05 | Traffic      | N/A                | 11/02/05 |
| A.C.E. - Hydrology | <i>[Signature]</i> | 11/02/05 | Water        | <i>[Signature]</i> | 11/02/05 |

DRAWING NO. 2642 MAP NO. H-15, J-15 SHEET 5 OF 12

D.T.M. & A. JOB NO. 823.12

| ENGINEER'S SEAL    |  | SURVEY INFORMATION |      | BENCH MARKS                                  |  | AS BUILT INFORMATION   |  |
|--------------------|--|--------------------|------|----------------------------------------------|--|------------------------|--|
|                    |  | NO.                | DATE | Station is a standard INSIDE DRAIN TIE IN    |  | CONSTRUCTION J.E. HALE |  |
| DESIGNED BY: SWT   |  | BY: [Signature]    |      | Stamped "SIA 1-25-24" set in top of concrete |  | DATE                   |  |
| DRAWN BY: JSP, JCS |  | DATE: 11/09/05     |      | Post flush with the ground - The station is  |  | DATE                   |  |
| CHECKED BY: LCG    |  | DATE: 11/02/05     |      | Located 1.5 mi. Northeast of downtown        |  | DATE                   |  |
|                    |  |                    |      | Albuquerque, at the southeast corner of the  |  | DATE                   |  |
|                    |  |                    |      | Indian School Road bridge crossing of U.S.   |  | DATE                   |  |
|                    |  |                    |      | Highway 1-25.                                |  | DATE                   |  |
|                    |  |                    |      | Elev. = 5070.23 Feet                         |  | DATE                   |  |

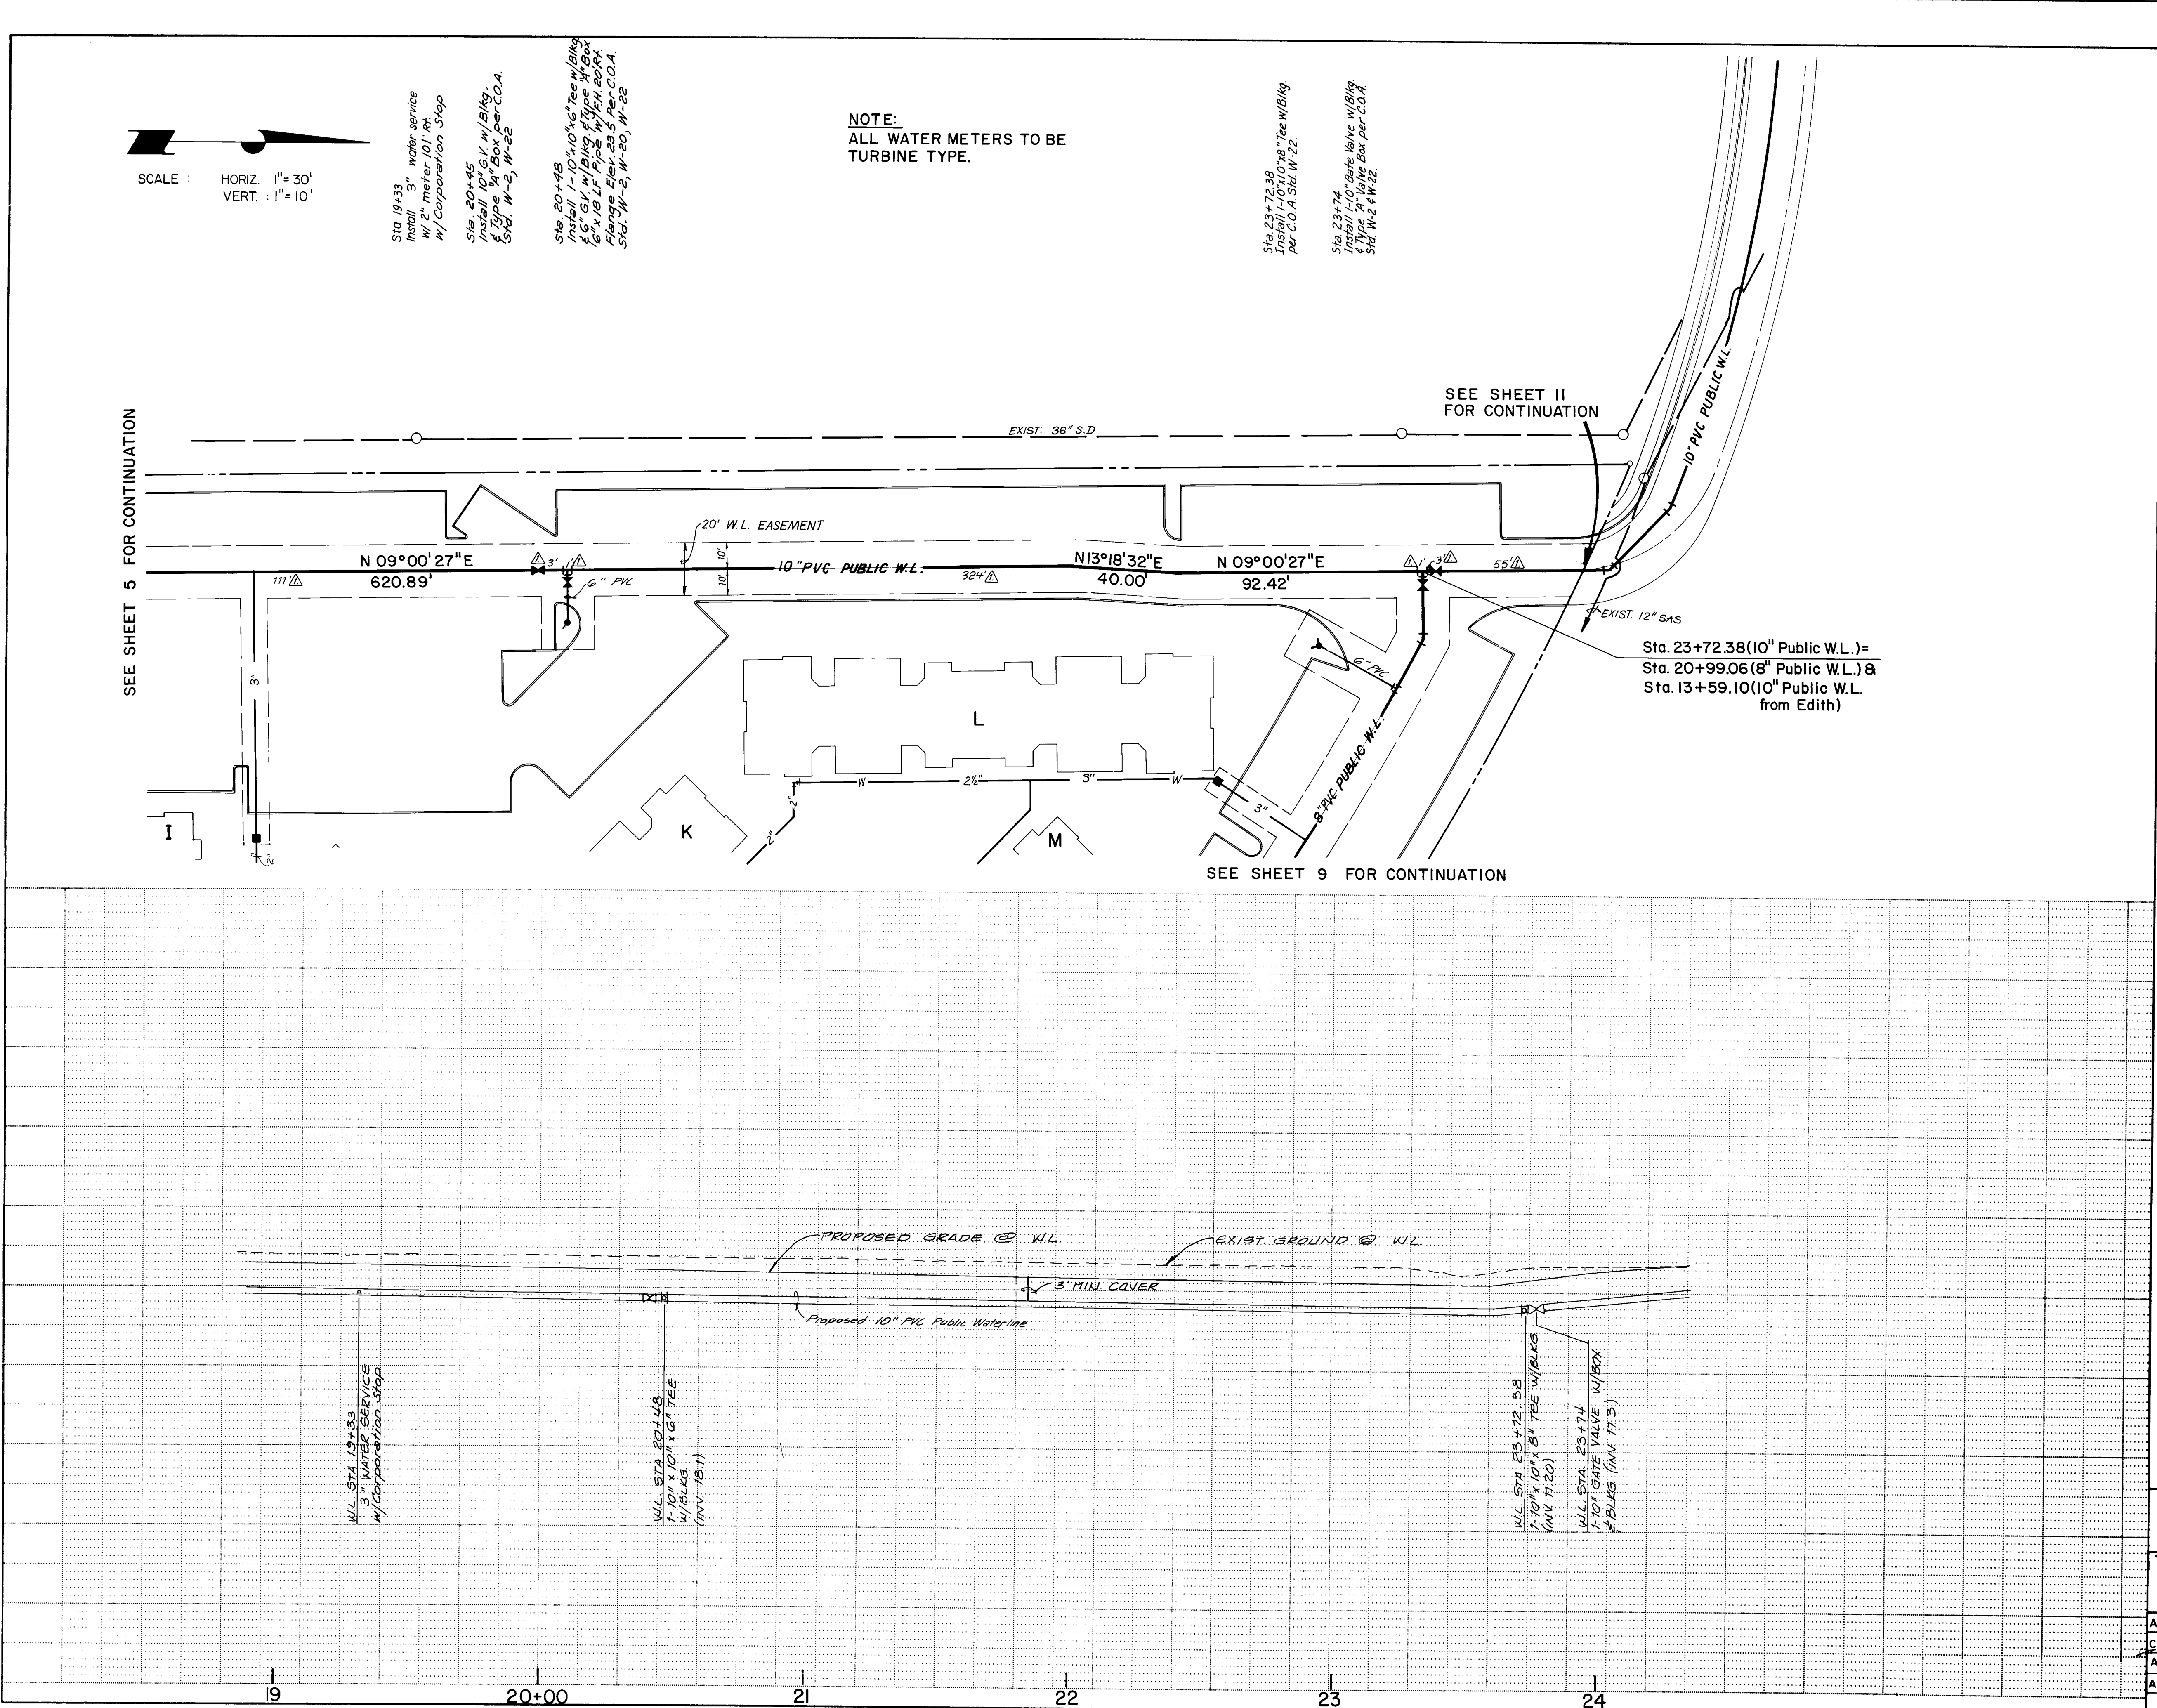

NOTE :

WORK ORDER INCLUDES : LOCUST STREET, LOCUST PLACE , ACCESS ROAD TO EDITH BLVD. & PUBLIC WATER LINES.

26 264206816

CITY OF ALBUQUERQUE  
MUNICIPAL DEVELOPMENT DEPARTMENT  
ENGINEERING DIVISION

TITLE: SUNVILLAGE APARTMENTS  
10" PUBLIC WATER LINE

| APPROVALS        | ENGINEER           | DATE    | APPROVALS    | ENGINEER           | DATE    |
|------------------|--------------------|---------|--------------|--------------------|---------|
| City Engineer    | <i>[Signature]</i> | 11/2/85 | Liquid Waste | <i>[Signature]</i> | 11/2/85 |
| A.C.E.-Design    | <i>[Signature]</i> | 11/2/85 | Traffic      | <i>[Signature]</i> | 11/2/85 |
| A.C.E.-Hydrology | <i>[Signature]</i> | 11/2/85 | Water        | <i>[Signature]</i> | 11/2/85 |

DRAWING NO. 2642

MAP NO. H-15, J-15

SHEET 6 OF 12

ENGINEER'S SEAL

8117

REGISTERED PROFESSIONAL ENGINEER


| REVISIONS |         |
|-----------|---------|
| NO.       | DATE    |
| 1         | 9/15/86 |

DESIGNED BY G.W.T. DATE Sept 1985

DRAWN BY J.S.P. DATE " "

CHECKED BY L.C.G. DATE " "

| SURVEY INFORMATION |    | BENCH MARKS |                                                                                                                                                                                                                                                                               | AS BUILT INFORMATION   |      |
|--------------------|----|-------------|-------------------------------------------------------------------------------------------------------------------------------------------------------------------------------------------------------------------------------------------------------------------------------|------------------------|------|
| NO.                | BY | DATE        | STATION                                                                                                                                                                                                                                                                       | CONTRACTOR             | DATE |
|                    |    |             | Station is a standard MMSID brass tablet stamped " STA 1-25-24", set in top of concrete post flush with the ground. The station is located 1.5 mi. NorthEast of downtown Albuquerque, at the Southeast corner of the Indian School Road bridge crossing of U.S. Highway 1-25. | J.R. HALE              |      |
|                    |    |             |                                                                                                                                                                                                                                                                               | INSPECTOR'S            | DATE |
|                    |    |             |                                                                                                                                                                                                                                                                               | ACCEPTANCE BY          | DATE |
|                    |    |             |                                                                                                                                                                                                                                                                               | VERIFICATION BY        | DATE |
|                    |    |             |                                                                                                                                                                                                                                                                               | CORRECTED BY           | DATE |
|                    |    |             |                                                                                                                                                                                                                                                                               | MICRO-FILM INFORMATION |      |
|                    |    |             |                                                                                                                                                                                                                                                                               | RECORDED BY            | DATE |
|                    |    |             |                                                                                                                                                                                                                                                                               | NO                     |      |

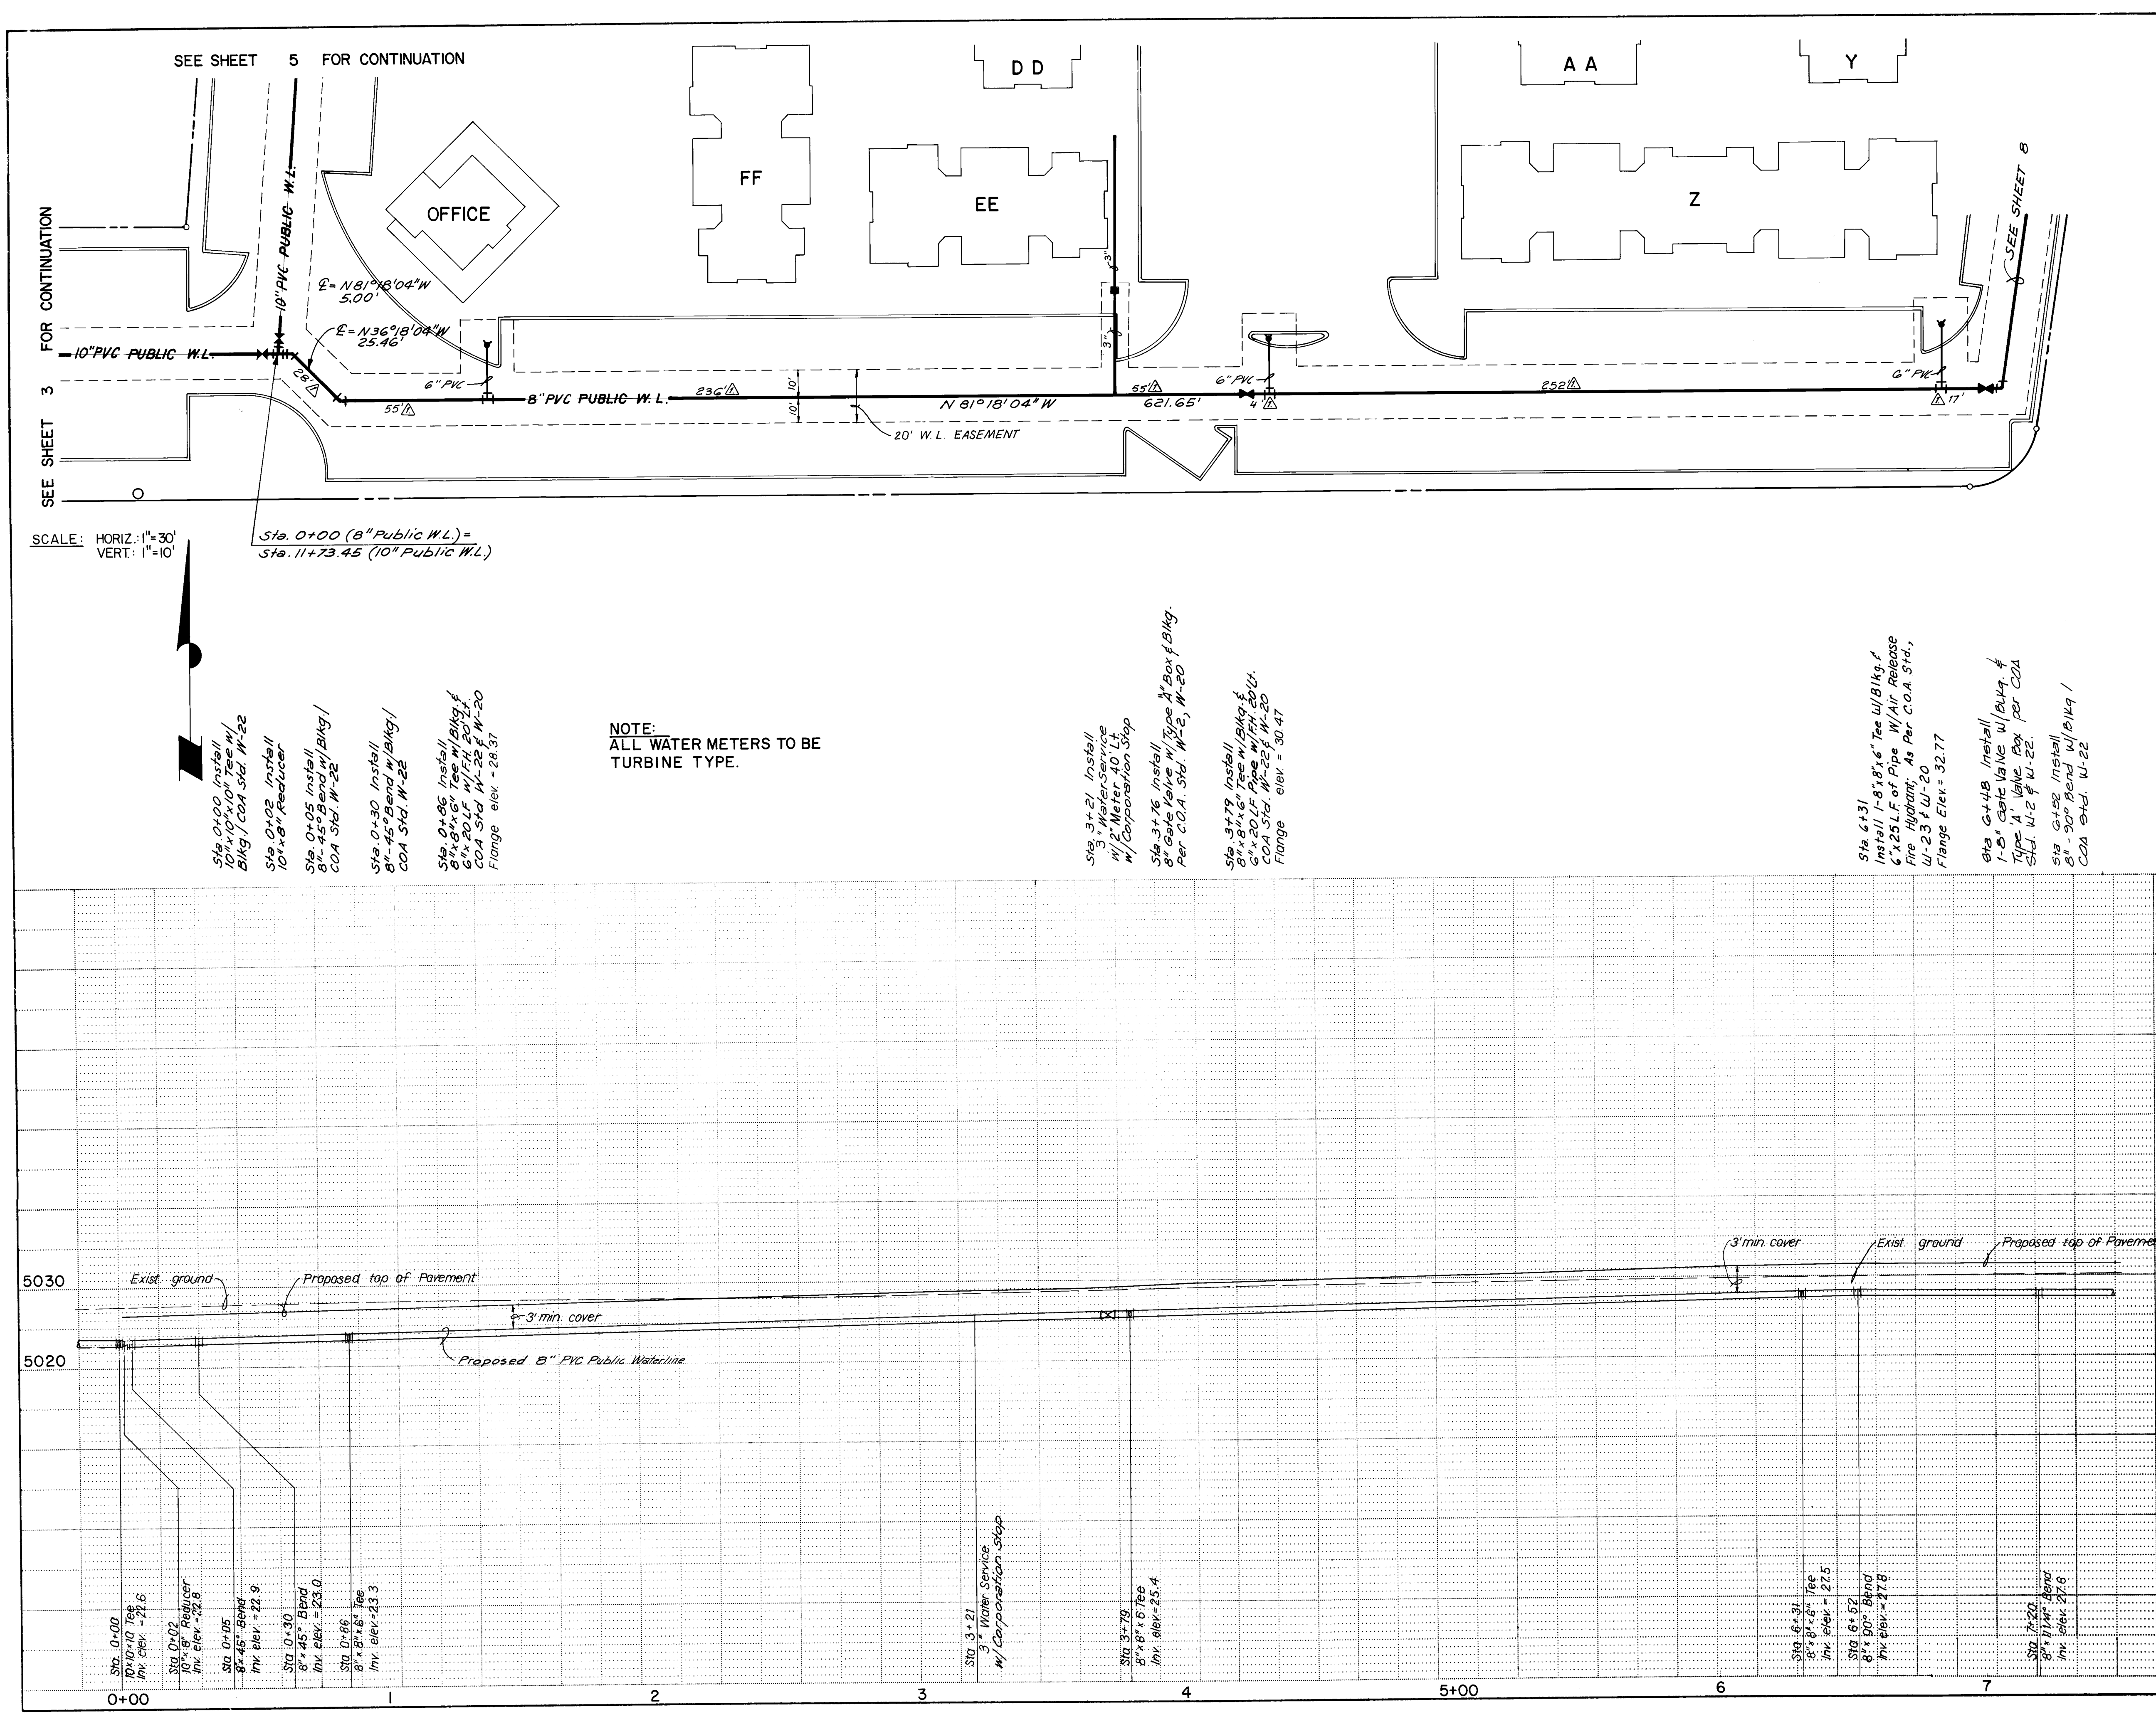

SCALE: HORIZ.: 1"=30'  
VERT.: 1"=10'

Sta. 0+00 (8" Public W.L.) =  
Sta. 11+73.45 (10" Public W.L.)

NOTE:  
ALL WATER METERS TO BE  
TURBINE TYPE.


- Sta. 0+00 Install  
10"x10"x10" Tee w/  
Blkg / COA Std. W-22
- Sta. 0+02 Install  
10"x8" Reducer
- Sta. 0+05 Install  
8"x45° Bend w/Blkg /  
COA Std. W-22
- Sta. 0+30 Install  
8"x45° Bend w/Blkg /  
COA Std. W-22
- Sta. 0+86 Install  
8"x8"x6" Tee w/Blkg &  
6"x20 LF Pipe w/Flt. 20' L.  
COA Std. W-22 & W-20  
Flange elev. = 28.31

- Sta. 3+21 Install  
3" Water Service  
w/ 1/2" Meter 40' Long  
w/ Corporation Stop
- Sta. 3+75 Install  
8" Gate Valve w/Type A Box & Blkg.  
Per C.O.A. Std. W-22, W-20

- Sta. 3+79 Install  
8"x8"x6" Tee w/Blkg &  
6"x20 LF Pipe w/Flt. 20' L.  
COA Std. W-22 & W-20  
Flange elev. = 30.41

- Sta. 6+31  
Install 1-8"x8"x6" Tee w/Blkg &  
6"x25 LF of Pipe w/Air Release  
Fire Hydrant; As Per C.O.A. Std.,  
W-23 & W-20  
Flange Elev. = 32.77

- Sta. 6+48 Install  
1-8" Gate Valve w/Blkg &  
Type A Valve Box per COA  
Std. W-22 & W-20
- Sta. 6+52 Install  
8"x90° Bend w/Blkg /  
COA Std. W-22

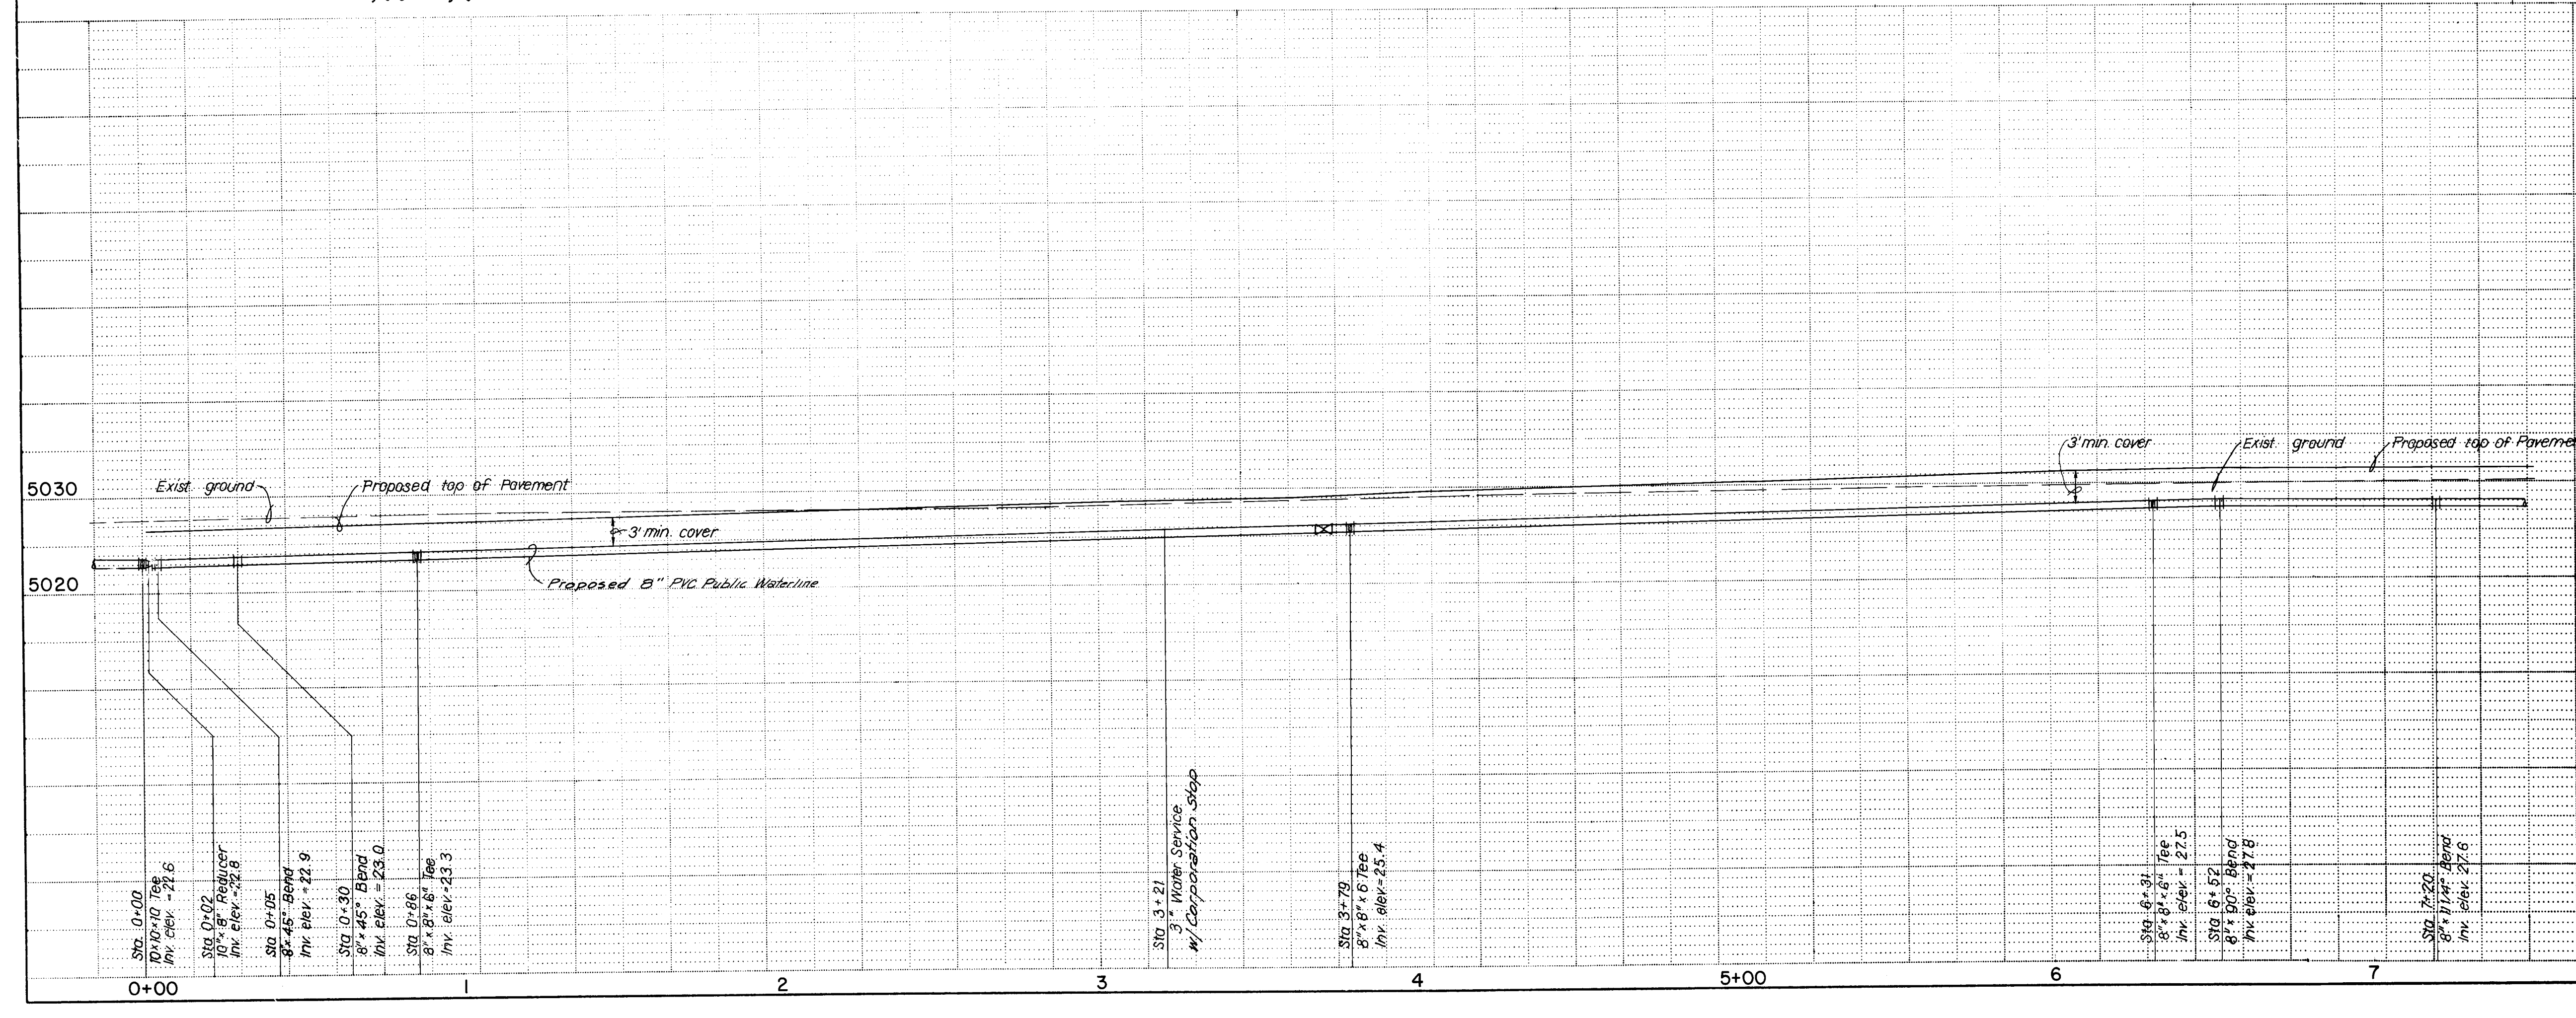


NOTE:  
WORK ORDER INCLUDES: LOCUST STREET,  
LOCUST PLACE, ACCESS ROAD TO  
EDITH BLVD. & PUBLIC WATER LINES.

26 26\*20786

|                                                                                 |                    |              |                           |                    |              |
|---------------------------------------------------------------------------------|--------------------|--------------|---------------------------|--------------------|--------------|
| CITY OF ALBUQUERQUE<br>MUNICIPAL DEVELOPMENT DEPARTMENT<br>ENGINEERING DIVISION |                    |              |                           |                    |              |
| TITLE: SUNVILLAGE APARTMENTS<br>8" PUBLIC WATER LINE                            |                    |              |                           |                    |              |
| APPROVALS                                                                       | ENGINEER           | DATE         | APPROVALS                 | ENGINEER           | DATE         |
| City Engineer                                                                   | <i>[Signature]</i> | 11/2/06      | Liquid Waste              | <i>[Signature]</i> | 11/2/06      |
| A.C.E. Design                                                                   | <i>[Signature]</i> | 11/2/05      | Traffic                   | N/A                | 11/2/05      |
| A.C.E. Hydrology                                                                | <i>[Signature]</i> | 11/2/05      | Water                     | <i>[Signature]</i> | 11/2/05      |
| DRAWN BY: JCS / J.S.P.                                                          |                    | DATE: 9/7/05 | DESIGNED BY: JCS / J.S.P. |                    | DATE: 9/7/05 |
| CHECKED BY: JCS                                                                 |                    | DATE: 9/7/05 | CHECKED BY: JCS           |                    | DATE: 9/7/05 |

|             |      |         |            |       |   |    |    |
|-------------|------|---------|------------|-------|---|----|----|
| DRAWING NO. | 2642 | MAP NO. | H-15, J-15 | SHEET | 7 | OF | 12 |
|-------------|------|---------|------------|-------|---|----|----|

|                 |  |                    |  |                                                                                                                                                                                                                                                                             |  |                       |  |
|-----------------|--|--------------------|--|-----------------------------------------------------------------------------------------------------------------------------------------------------------------------------------------------------------------------------------------------------------------------------|--|-----------------------|--|
| ENGINEER'S SEAL |  | SURVEY INFORMATION |  | BENCH MARKS                                                                                                                                                                                                                                                                 |  | AS BUILT INFO         |  |
|                 |  | FIELD NOTES        |  | Station is a standard NMSD brass tablet stamped "STA 1-25-24", set in top of concrete post flush with the ground. The station is located 1.5 mi. Northeast of downtown Albuquerque, at the Southeast corner of the Indian School Road bridge crossing of U.S. Highway 1-25. |  | CONTRACTOR: J.R. HALE |  |
| NO.             |  | BY                 |  | DATE                                                                                                                                                                                                                                                                        |  | WORK ORDER NO.        |  |
| REVISIONS       |  | DATE               |  | DATE                                                                                                                                                                                                                                                                        |  | DATE                  |  |
| DESIGNED BY     |  | DATE               |  | DATE                                                                                                                                                                                                                                                                        |  | DATE                  |  |
| CHECKED BY      |  | DATE               |  | DATE                                                                                                                                                                                                                                                                        |  | DATE                  |  |

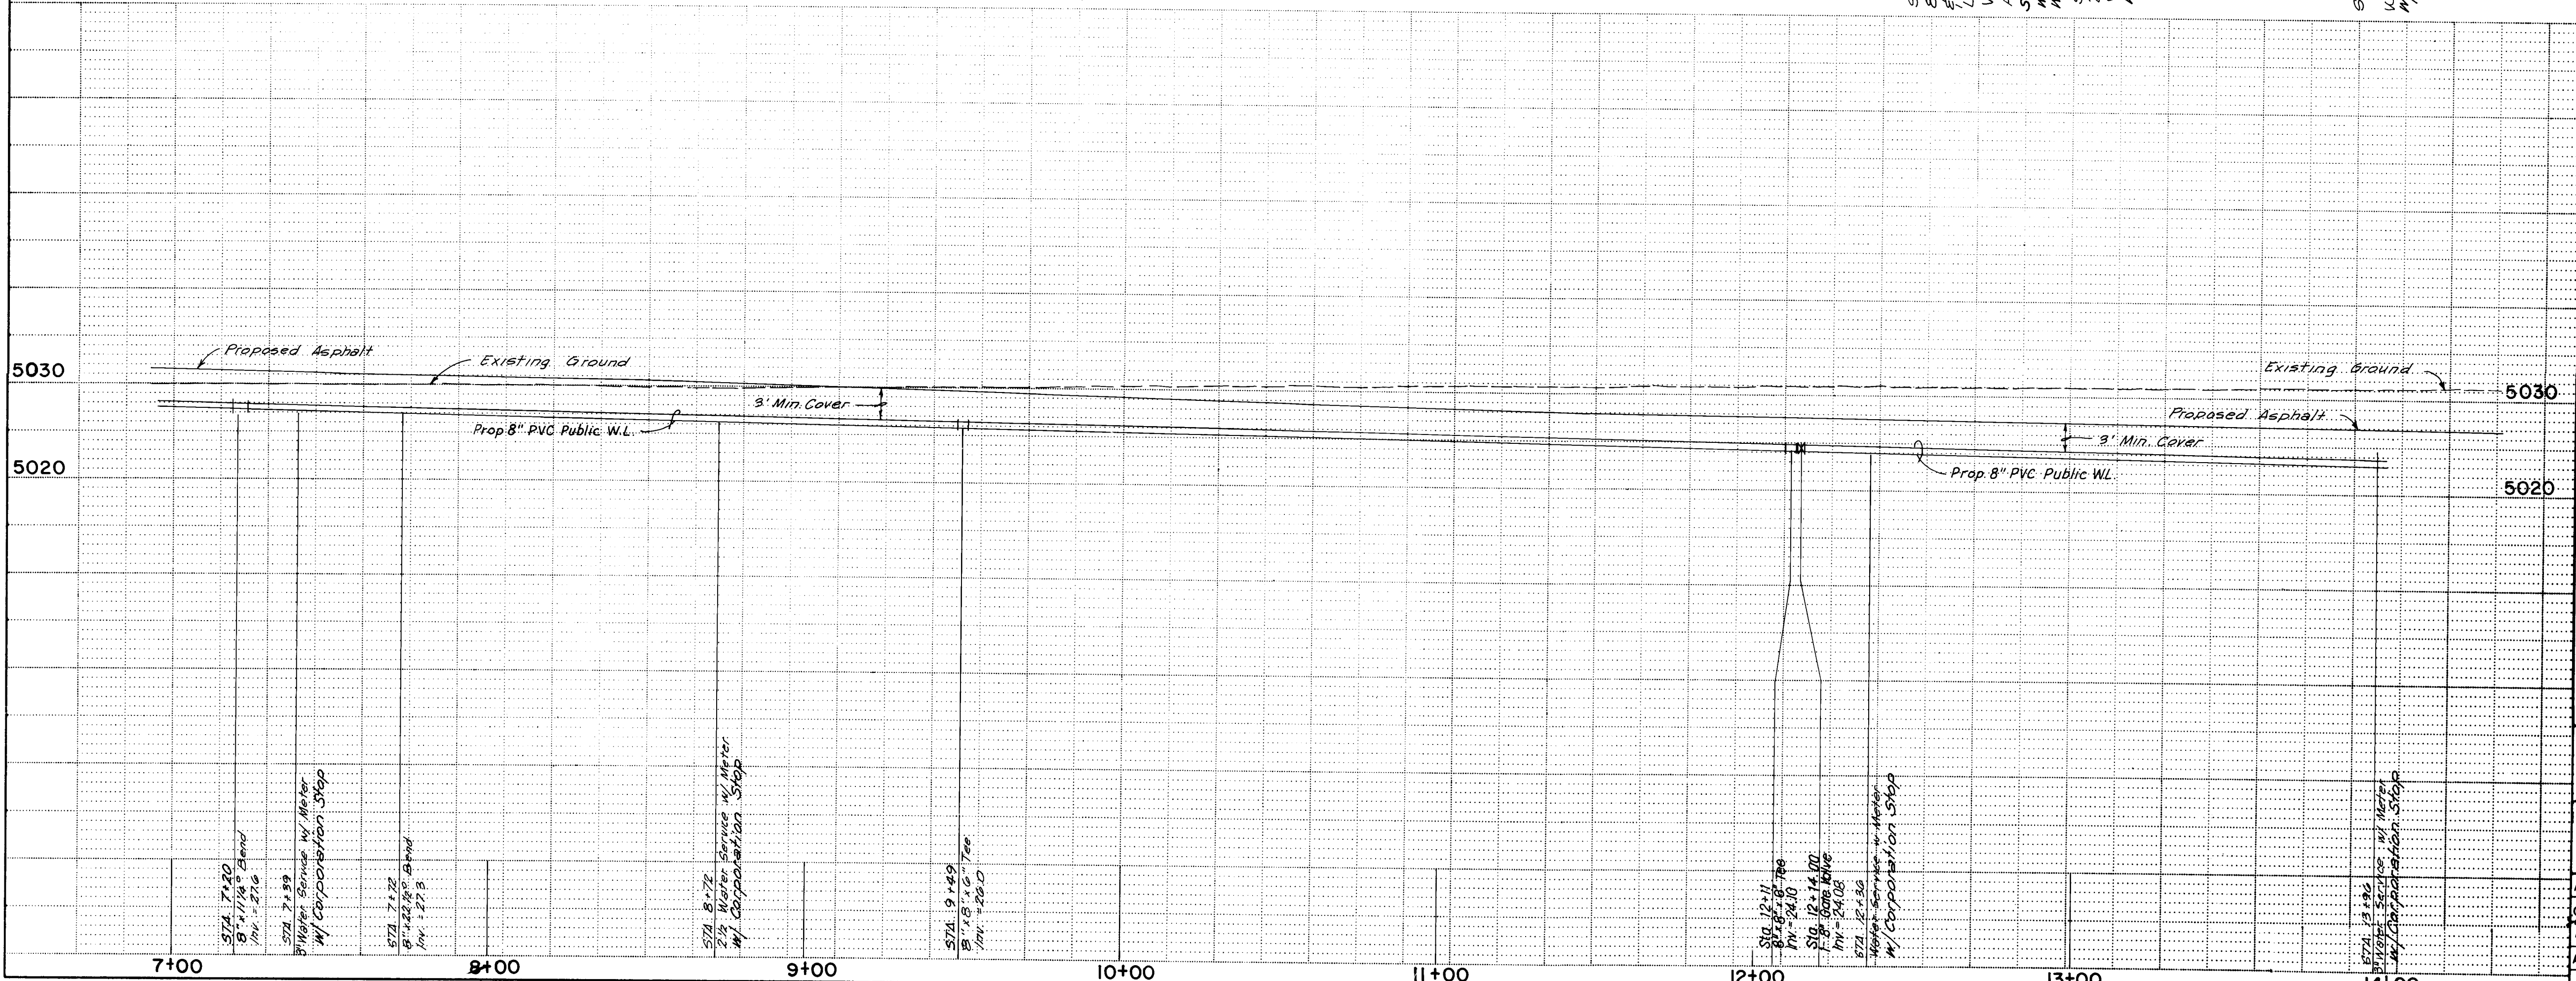

SCALE: HORIZ. : 1" = 30'  
VERT. : 1" = 10'

STA 6+52 INSTALL  
8" x 8" G. Tee W/ BULK  
COA STD W/ 22

STA 7+30 INSTALL  
8" x 8" G. Tee W/ BULK  
COA STD W/ 22

STA 7+39 INSTALL  
3" WATER SERVICE  
W/ 2" Meter 30' Lt  
W/ Corporation Stop

STA 7+73 INSTALL  
8" x 8" G. Tee W/ BULK  
COA STD W/ 22

STA 8+72 INSTALL  
2 1/2" WATER SERVICE  
W/ 2" Meter 30' Lt  
W/ Corporation Stop

STA 9+49 INSTALL  
8" x 8" G. Tee W/ BULK  
COA STD W/ 22

STA 12+11 INSTALL  
8" x 8" G. Tee W/ BULK  
COA STD W/ 22

STA 13+30 INSTALL  
3" WATER SERVICE  
W/ 2" Meter 30' Lt  
W/ Corporation Stop

NOTE:  
ALL WATER METERS TO BE  
TURBINE TYPE.


NOTE:  
WORK ORDER INCLUDES: LOCUST STREET,  
LOCUST PLACE, ACCESS ROAD TO  
EDITH BLVD. & PUBLIC WATER LINES.

ESM'T & CURVE DATA


Δ = 31° 24' 16"  
R = 42.00'  
L = 23.02'  
T = 11.81'

Δ = 41° 31' 22"  
R = 42.00'  
L = 30.44'  
T = 15.92'

Δ = 29° 09' 49"  
R = 1505.18'  
L = 766.14'  
T = 391.56'

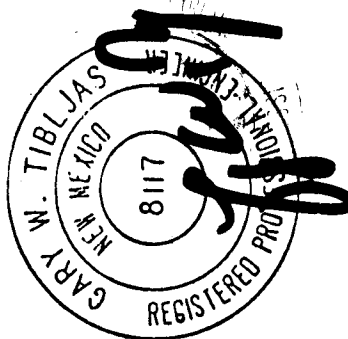
| ENGINEER'S SEAL                                                                       |  |  | SURVEY INFORMATION             |    | BENCH MARKS                                                                                                                                                                                                                                                                                         |                             | AS BUILT INFORMATION |      |  |      |  |
|---------------------------------------------------------------------------------------|--|--|--------------------------------|----|-----------------------------------------------------------------------------------------------------------------------------------------------------------------------------------------------------------------------------------------------------------------------------------------------------|-----------------------------|----------------------|------|--|------|--|
|  |  |  | FIELD NOTES                    |    | Station is a standard NMSHD brass tablet stamped " STA 1-25-24", set in top of concrete post flush with the ground. The station is located 1.5 mi. Northeast of downtown Albuquerque, at the Southeast corner of the Indian School Road bridge crossing of U.S. Highway 1-25.<br>Elev.=5070.23 Feet | CONTRACTOR <i>J.R. HALE</i> | DATE                 |      |  |      |  |
|                                                                                       |  |  | NO.                            | BY |                                                                                                                                                                                                                                                                                                     |                             |                      | DATE |  |      |  |
| DESIGNED BY                                                                           |  |  | REVISIONS                      |    |                                                                                                                                                                                                                                                                                                     |                             |                      | DATE |  | DATE |  |
| DRAWN BY                                                                              |  |  | DESIGN                         |    |                                                                                                                                                                                                                                                                                                     |                             |                      | DATE |  | DATE |  |
| CHECKED BY                                                                            |  |  | REVISIONS                      |    |                                                                                                                                                                                                                                                                                                     |                             |                      | DATE |  | DATE |  |
| REMARKS                                                                               |  |  | BY                             |    | DATE                                                                                                                                                                                                                                                                                                |                             | DATE                 |      |  |      |  |
| 4/15/86                                                                               |  |  | Revised from as-built drawings |    | E.N.                                                                                                                                                                                                                                                                                                |                             | DATE                 |      |  |      |  |
| NO.                                                                                   |  |  | DATE                           |    | DATE                                                                                                                                                                                                                                                                                                |                             | DATE                 |      |  |      |  |
| DATE                                                                                  |  |  | DATE                           |    | DATE                                                                                                                                                                                                                                                                                                |                             | DATE                 |      |  |      |  |
| DATE                                                                                  |  |  | DATE                           |    | DATE                                                                                                                                                                                                                                                                                                |                             | DATE                 |      |  |      |  |
| DATE                                                                                  |  |  | DATE                           |    |                                                                                                                                                                                                                                                                                                     |                             |                      |      |  |      |  |

|                                                                                 |                    |          |              |                    |          |
|---------------------------------------------------------------------------------|--------------------|----------|--------------|--------------------|----------|
| CITY OF ALBUQUERQUE<br>MUNICIPAL DEVELOPMENT DEPARTMENT<br>ENGINEERING DIVISION |                    |          |              |                    |          |
| TITLE: SUNVILLAGE APARTMENTS<br>8" PUBLIC WATER LINE                            |                    |          |              |                    |          |
| APPROVALS                                                                       | ENGINEER           | DATE     | APPROVALS    | ENGINEER           | DATE     |
| City Engineer                                                                   | <i>[Signature]</i> | 11/18/85 | Liquid Waste | <i>[Signature]</i> | 11/21/85 |
| A.C.E. Design                                                                   | <i>[Signature]</i> | 11/22/85 | Traffic      | N/A                | 11/22/85 |
| A.C.E. Hydrology                                                                | <i>[Signature]</i> | 11/22/85 | Water        | <i>[Signature]</i> | 11/22/85 |
| DRAWING NO.                                                                     | 2642               | MAP NO.  | H-15, J-15   | SHEET              | 8 OF 12  |

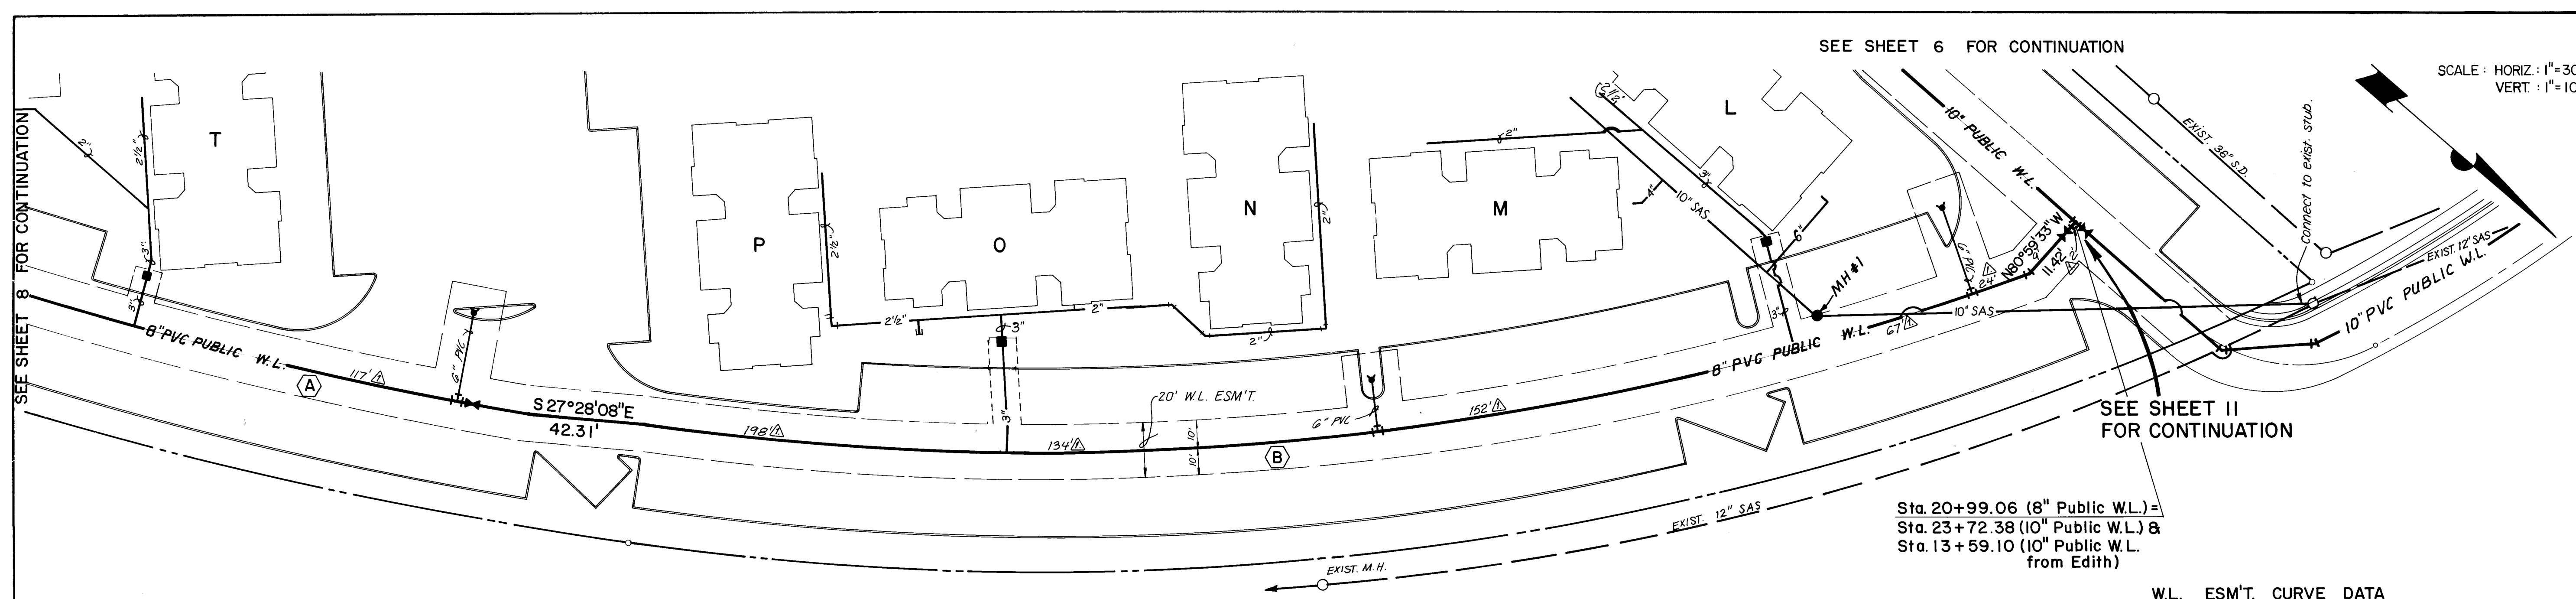

W.L. ESM'T. CURVE DATA

|   | (A)       | (B)       |
|---|-----------|-----------|
| Δ | 29°09'49" | 28°46'47" |
| R | 1505.18'  | 1007.00'  |
| L | 766.14'   | 505.81'   |
| T | 391.56'   | 258.36'   |

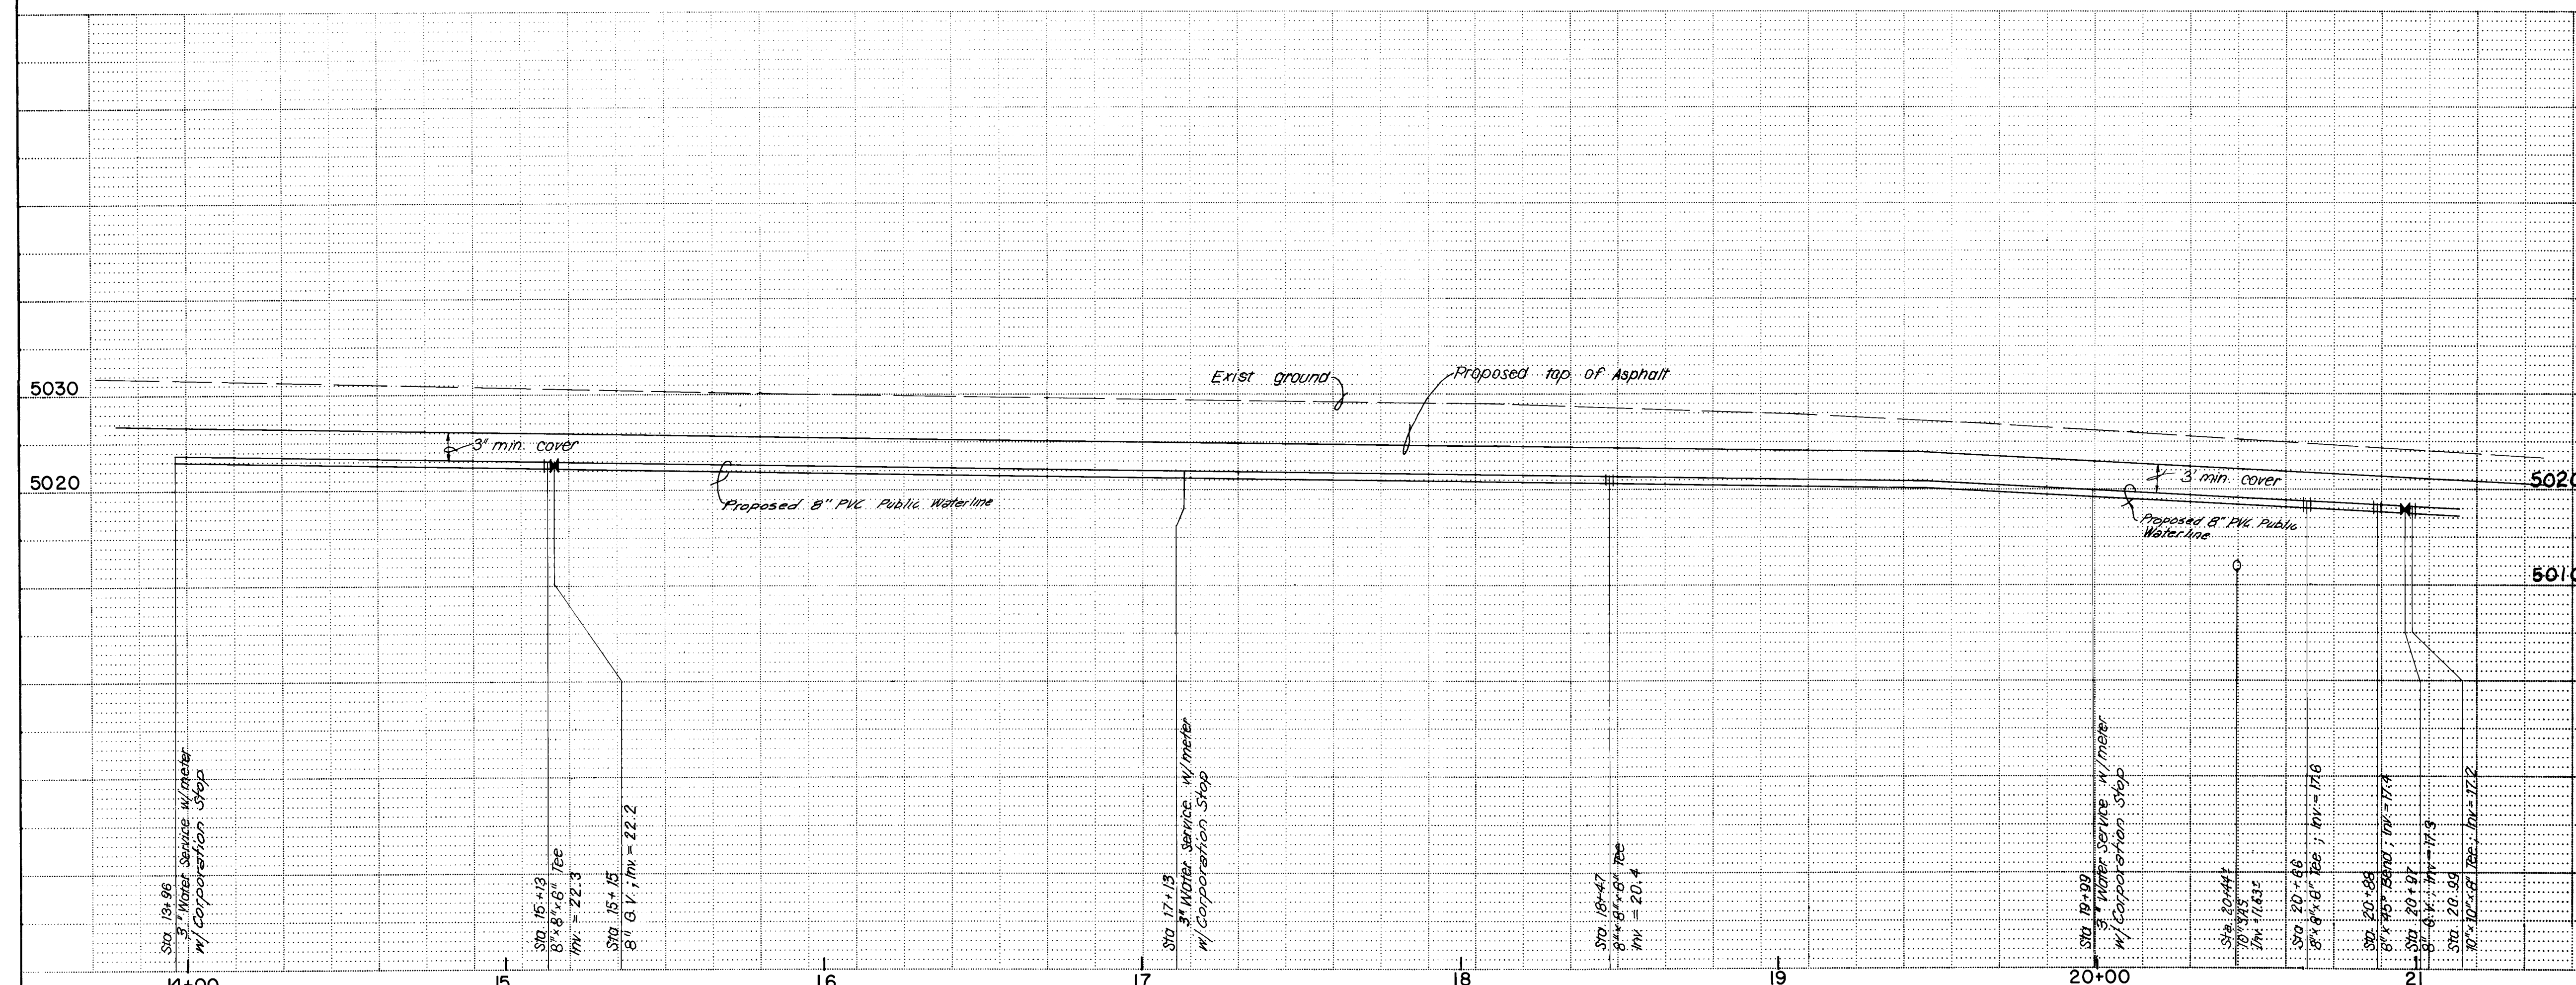




NOTE:  
WORK ORDER INCLUDES: LOCUST STREET,  
LOCUST PLACE, ACCESS ROAD TO  
EDITH BLVD. & PUBLIC WATER LINES.

264 2642098.6

|                                                                                 |                    |          |              |                    |          |
|---------------------------------------------------------------------------------|--------------------|----------|--------------|--------------------|----------|
| CITY OF ALBUQUERQUE<br>MUNICIPAL DEVELOPMENT DEPARTMENT<br>ENGINEERING DIVISION |                    |          |              |                    |          |
| TITLE: SUNVILLAGE APARTMENTS<br>8" PUBLIC WATER LINE                            |                    |          |              |                    |          |
| APPROVALS                                                                       | ENGINEER           | DATE     | APPROVALS    | ENGINEER           | DATE     |
| CITY Engineer                                                                   | <i>[Signature]</i> | 11/22/95 | Liquid Waste | <i>[Signature]</i> | 11/22/95 |
| A.C.E. - Design                                                                 | <i>[Signature]</i> | 11/22/95 | Traffic      | <i>[Signature]</i> | 11/22/95 |
| A.C.E. - Hydrology                                                              | <i>[Signature]</i> | 11/22/95 | Water        | <i>[Signature]</i> | 11/22/95 |
| DRAWING NO.                                                                     | 2642               | MAP NO.  | H-15, J-15   | SHEET              | 9 OF 12  |

| SURVEY INFORMATION |    | BENCH MARKS |                                                                                                                                                                                                                                                                             | AS BUILT INFORMATION |           |
|--------------------|----|-------------|-----------------------------------------------------------------------------------------------------------------------------------------------------------------------------------------------------------------------------------------------------------------------------|----------------------|-----------|
| NO.                | BY | DATE        | STATION                                                                                                                                                                                                                                                                     | CONTRACTOR           | J.R. HALE |
| 1                  | BY | DATE        | Station is a standard NMSD brass tablet stamped "STA 1-25-24", set in top of concrete post flush with the ground. The station is located 1.5 mi. NorthEast of downtown Albuquerque, at the Southeast corner of the Indian School Road bridge crossing of U.S. Highway 1-25. | WORK                 | DATE      |
| 2                  | BY | DATE        |                                                                                                                                                                                                                                                                             | FIELD                | DATE      |
| 3                  | BY | DATE        |                                                                                                                                                                                                                                                                             | REVISIONS            | DATE      |
| 4                  | BY | DATE        |                                                                                                                                                                                                                                                                             | DESIGN               | DATE      |
| 5                  | BY | DATE        |                                                                                                                                                                                                                                                                             | RECORDED BY          | DATE      |
| 6                  | BY | DATE        |                                                                                                                                                                                                                                                                             | NO                   | DATE      |

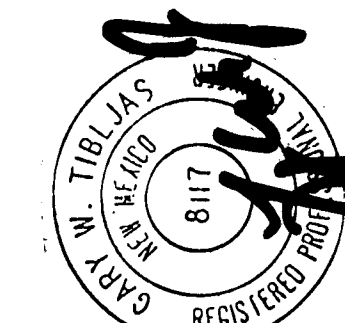

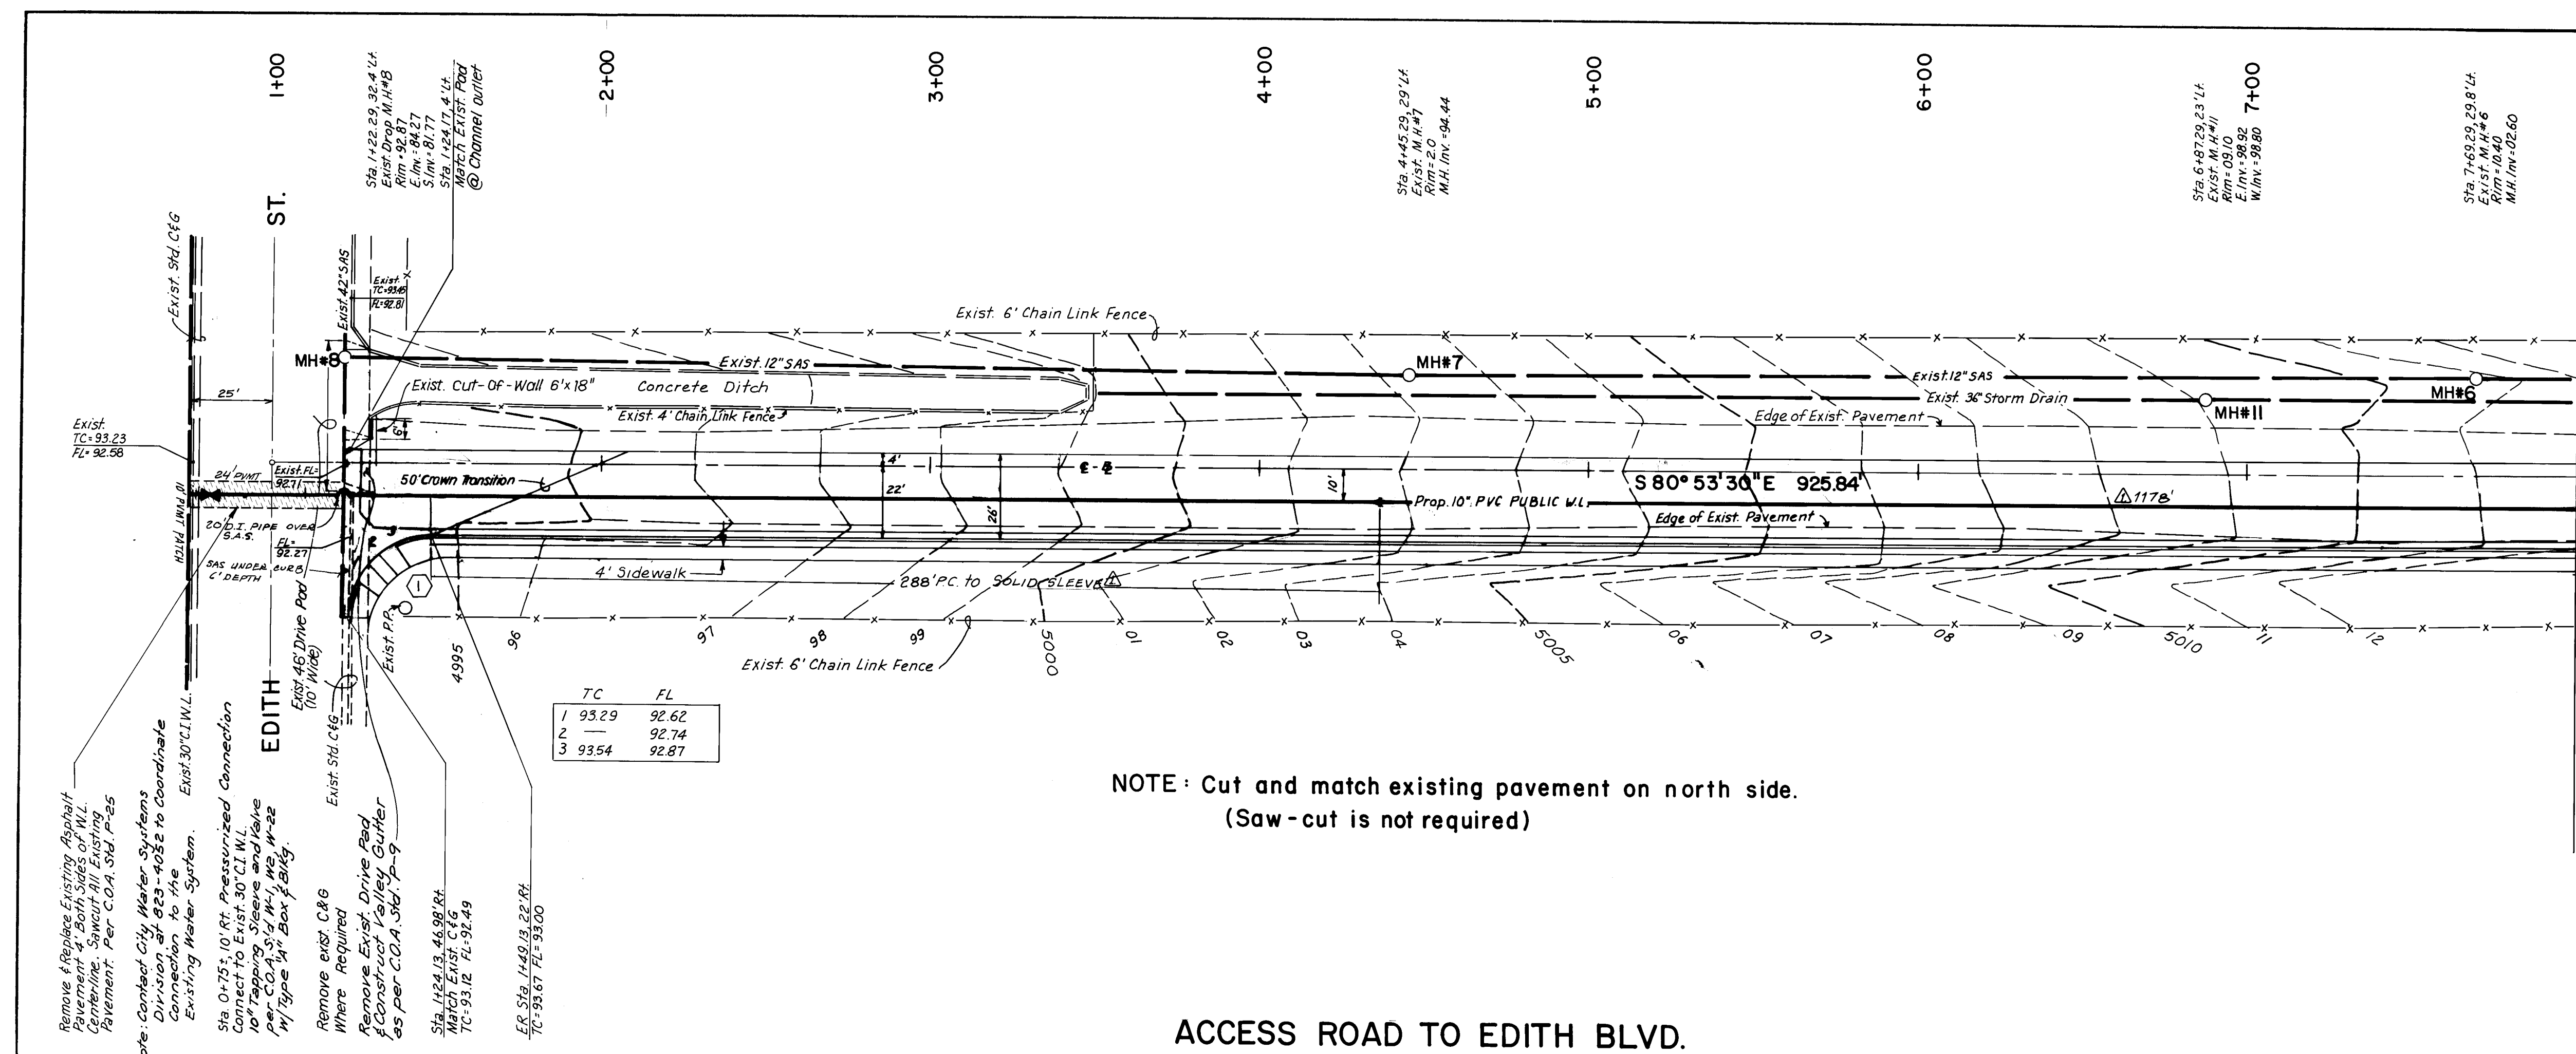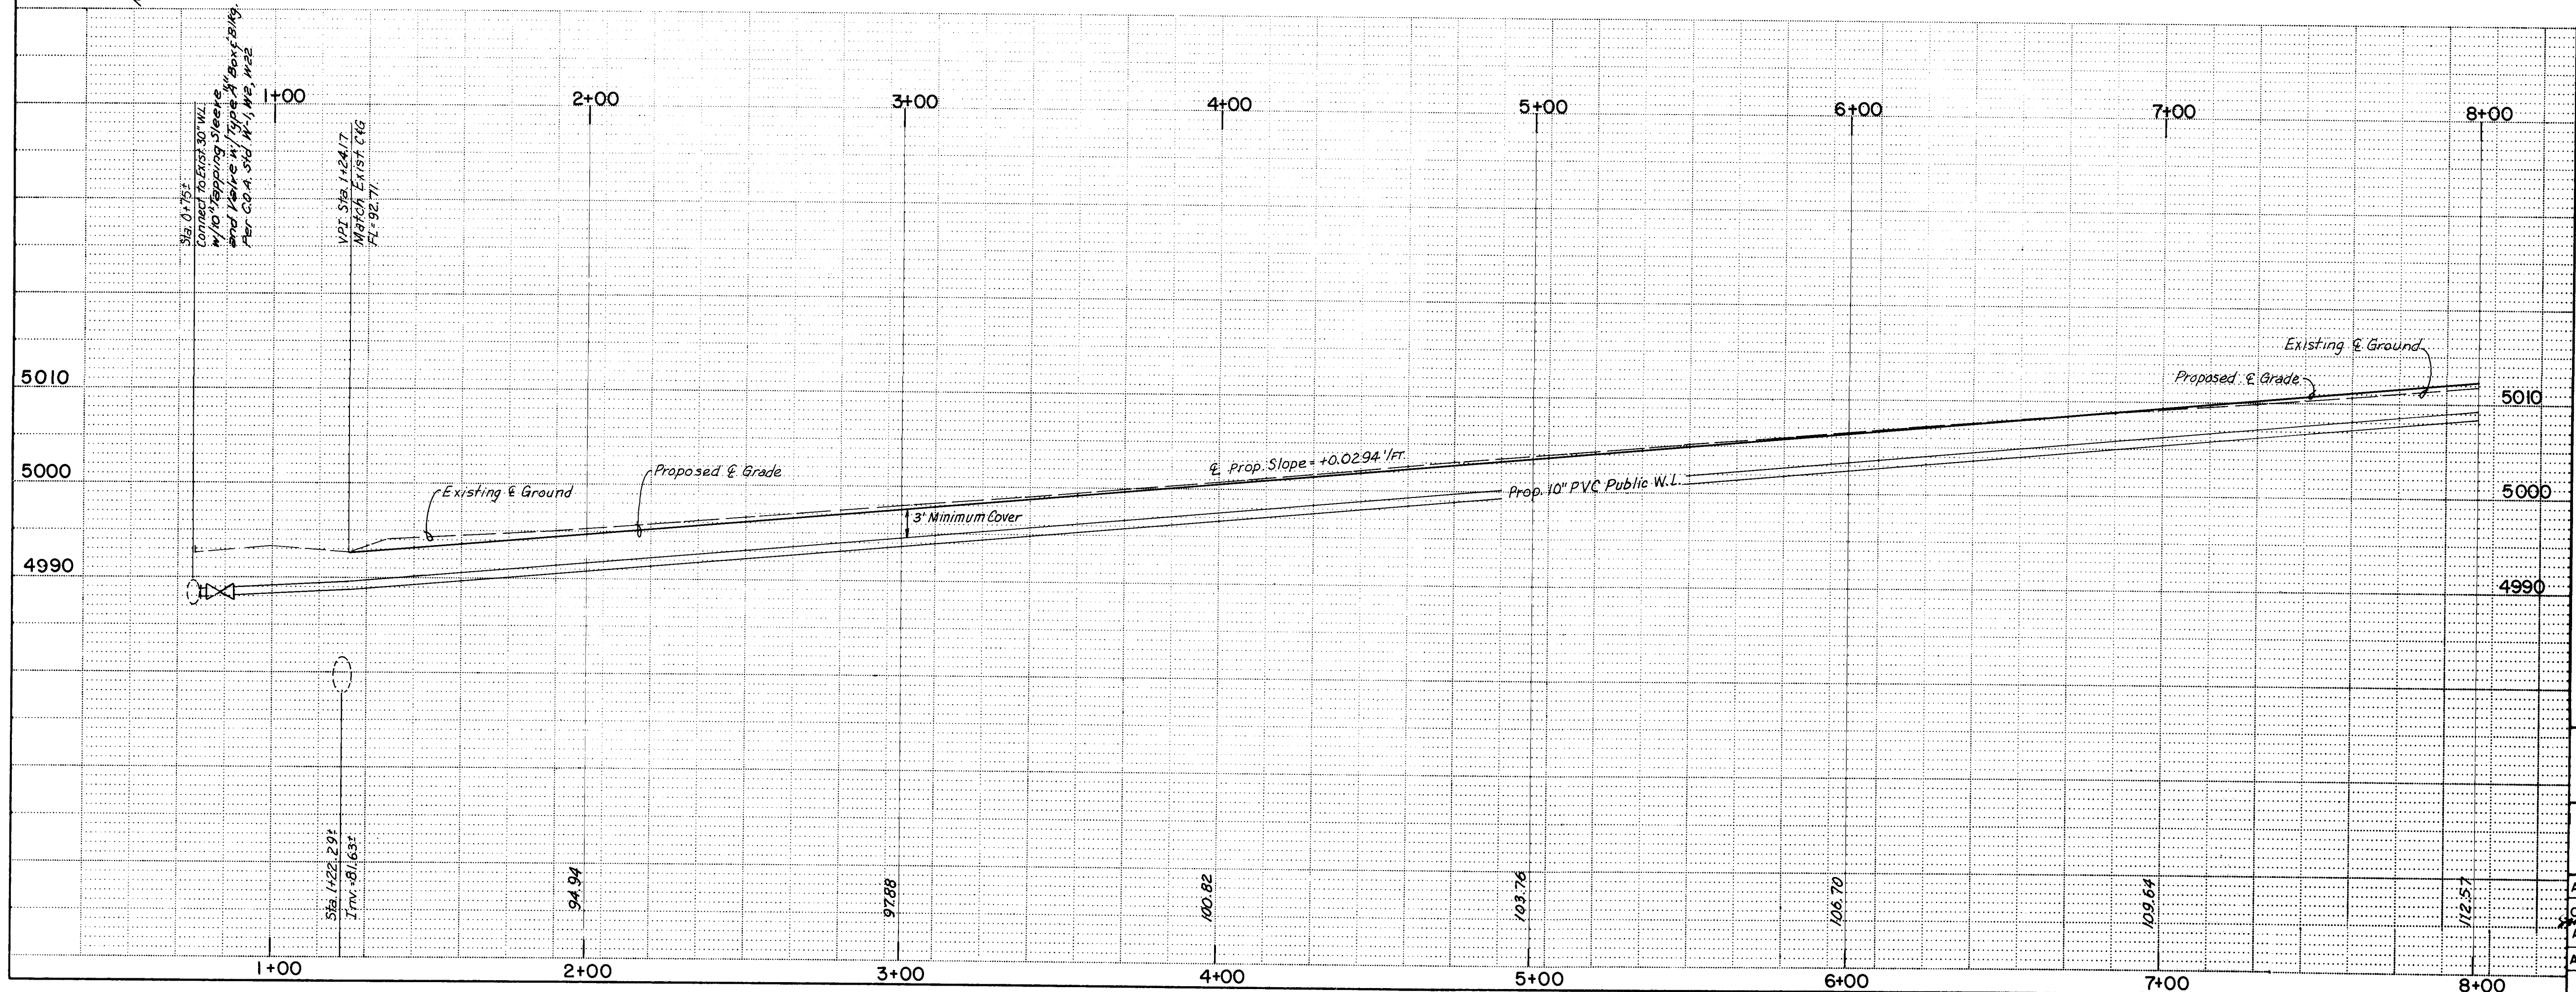

NOTE: Cut and match existing pavement on north side.  
(Saw-cut is not required)

ACCESS ROAD TO EDITH BLVD.

CURB CURVE DATA TABLE

| ARC    | RADIUS    | TANGENT |
|--------|-----------|---------|
| 39.25' | 89°57'30" | 25.00'  |
| 24.98' |           |         |

SCALE  
HORIZ 1"=30'  
VERT 1"=10'


NOTE:  
WORK ORDER INCLUDES: LOCUST STREET,  
LOCUST PLACE ACCESS ROAD TO  
EDITH BLVD. & PUBLIC WATER LINES.

26 26421086

|                                                                                 |                    |                       |              |                    |          |
|---------------------------------------------------------------------------------|--------------------|-----------------------|--------------|--------------------|----------|
| CITY OF ALBUQUERQUE<br>MUNICIPAL DEVELOPMENT DEPARTMENT<br>ENGINEERING DIVISION |                    |                       |              |                    |          |
| TITLE: SUNVILLAGE APARTMENTS<br>ACCESS ROAD TO EDITH BLVD.                      |                    |                       |              |                    |          |
| APPROVALS                                                                       | ENGINEER           | DATE                  | APPROVALS    | ENGINEER           | DATE     |
| City Engineer                                                                   | <i>[Signature]</i> | 1/10/85               | Liquid Waste | <i>[Signature]</i> | 11/20/85 |
| A.C.E. - Design                                                                 | <i>[Signature]</i> | 11/22/85              | Traffic      | <i>[Signature]</i> | 11/20/85 |
| A.C.E. - Hydrology                                                              | <i>[Signature]</i> | 11/22/85              | Water        | <i>[Signature]</i> | 11/20/85 |
| DESIGNED BY G.W.T./J.J.                                                         |                    |                       | DATE 9/85    |                    |          |
| DRAWN BY J.C.R.                                                                 |                    |                       | DATE 9/85    |                    |          |
| CHECKED BY L.C.G.                                                               |                    |                       | DATE 9/85    |                    |          |
| DRAWING NO. 2642                                                                |                    | MAP NO. 15-H-15, J-15 |              | SHEET 10 OF 12     |          |

|                 |  |                            |  |                                                                                                                                                                                                                                                                                                   |  |                                                                                                                                                                                                                           |  |
|-----------------|--|----------------------------|--|---------------------------------------------------------------------------------------------------------------------------------------------------------------------------------------------------------------------------------------------------------------------------------------------------|--|---------------------------------------------------------------------------------------------------------------------------------------------------------------------------------------------------------------------------|--|
| ENGINEER'S SEAL |  | SURVEY INFORMATION         |  | BENCH MARKS                                                                                                                                                                                                                                                                                       |  | AS BUILT INFORMATION                                                                                                                                                                                                      |  |
|                 |  | FIELD NOTES<br>NO. BY DATE |  | Station is a standard NMSD brass tablet stamped "STA 1-25-24", set in top of concrete post flush with the ground. The station is located 1.5 mi. NorthEast of downtown Albuquerque, at the Southeast corner of the Indian School Road bridge crossing of U.S. Highway 1-25.<br>Elev: 5070.23 Feet |  | CONTRACTOR J.R. DALE<br>ENGINEER BY J.R. DALE<br>INSPECTOR BY J.R. DALE<br>ACCEPTANCE BY J.R. DALE<br>DATE 9/85<br>VERIFICATION BY J.R. DALE<br>DATE 9/85<br>MICRO-FILM INFORMATION<br>RECORDED BY J.R. DALE<br>DATE 9/85 |  |



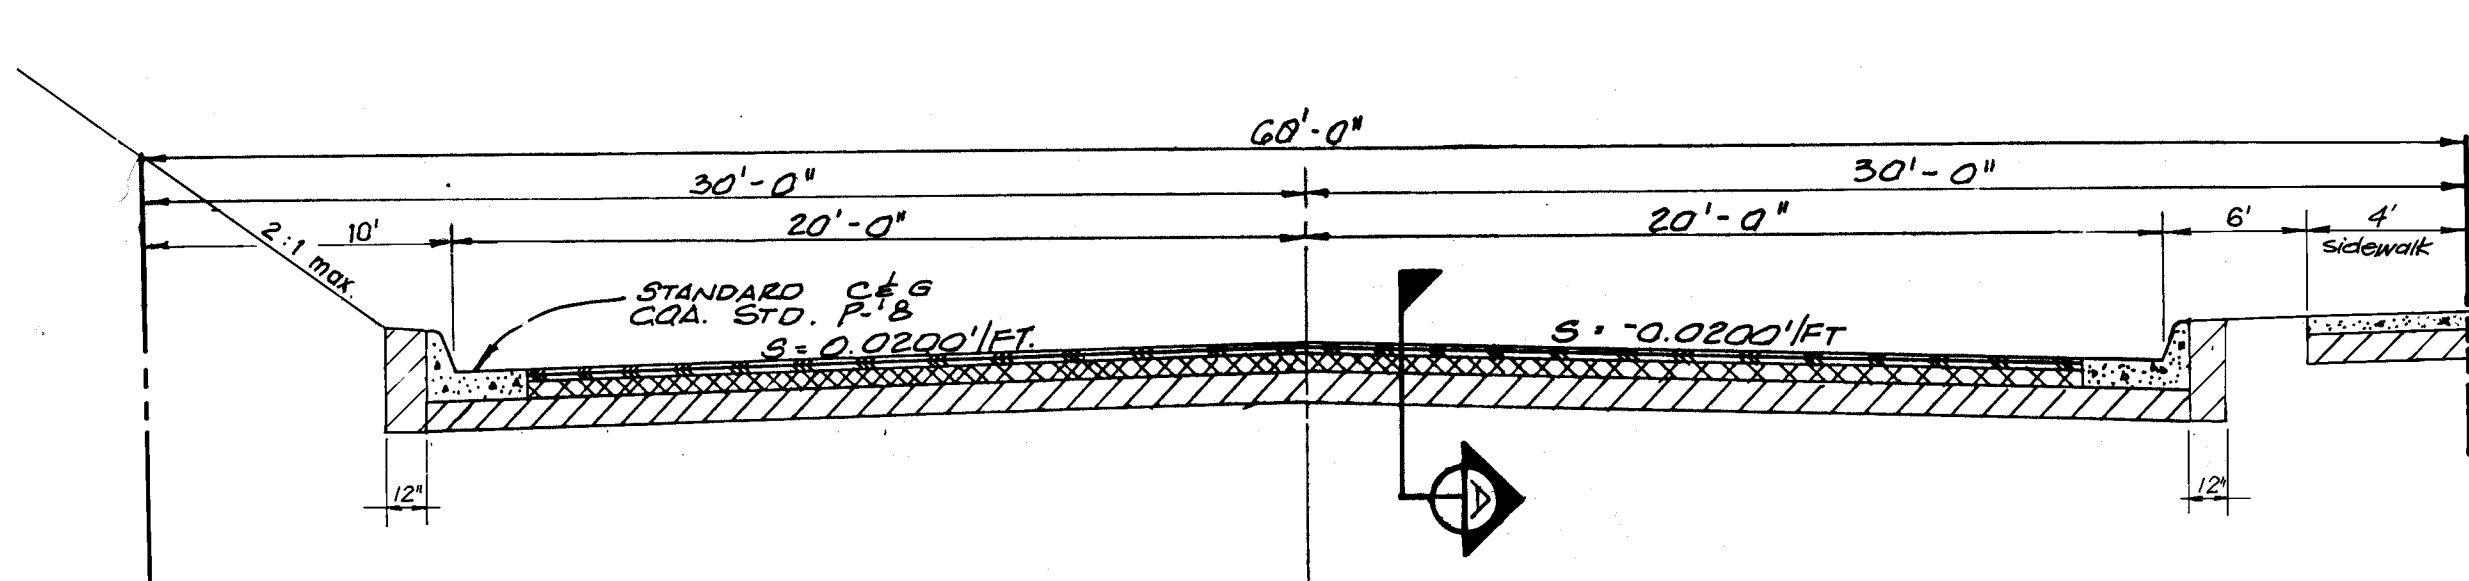


NOTE:  
SIDEWALK WAVED ON WEST SIDE  
REF: SV-85-35

Required off-site grading to be  
determined at a future date.  
Due to NMSHD excavation  
in immediate area.

RESIDENTIAL STREET SECTION

LOCUST STREET


SCALE 1" = 5' JCS  
COA STD. P-2

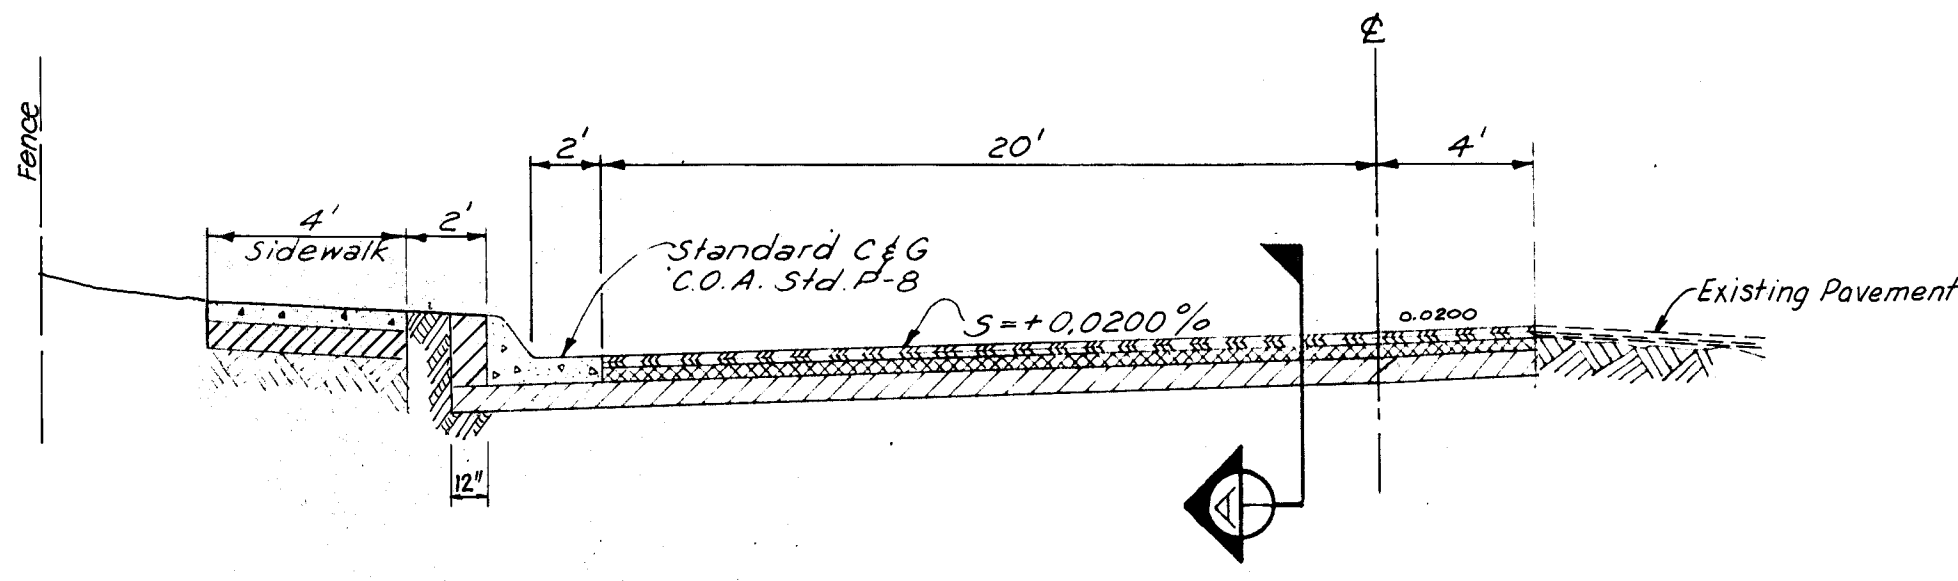

TYPICAL ACCESS STREET SECTION


N.T.S.

Note: Cut and match existing pavement  
on north side. (Saw-cut is not  
required)

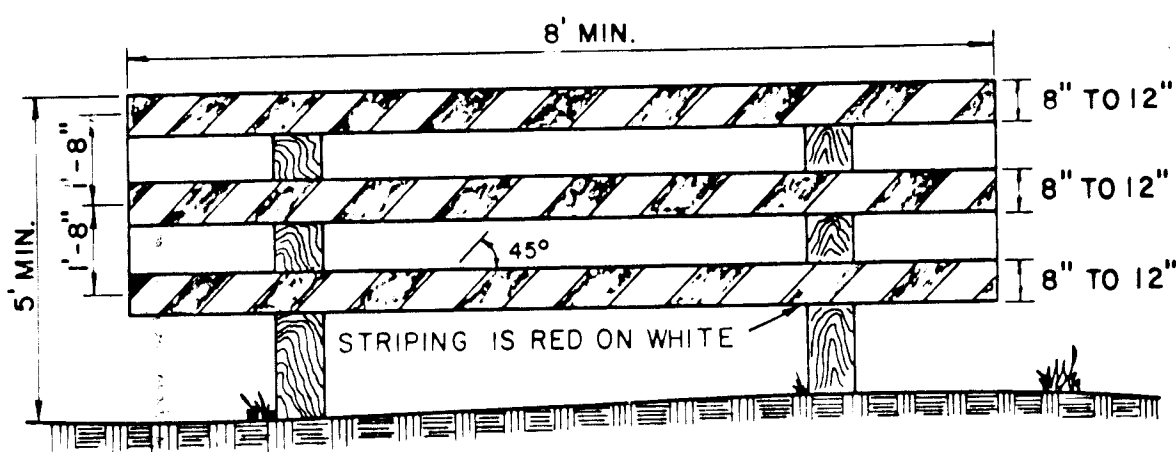

TYPE III BARRICADE (TYP)

N.T.S.

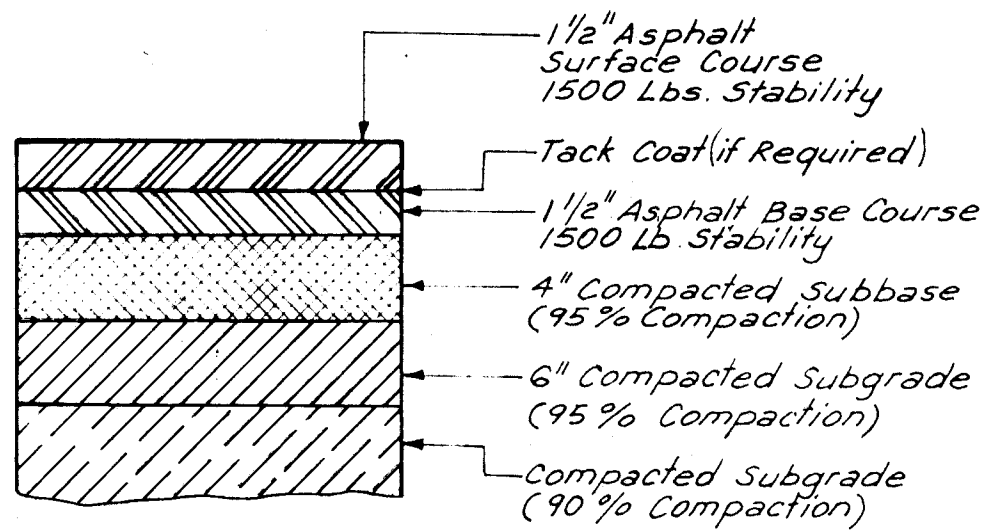

RESIDENTIAL SECTION

COA STD P-2

| AS BUILT INFORMATION |     |      |      | BENCH MARKS |      |    |      | SURVEY INFORMATION |    |      |      | ENGINEER'S SEAL |  |  |  |
|----------------------|-----|------|------|-------------|------|----|------|--------------------|----|------|------|-----------------|--|--|--|
| CONTRACTOR           | NO. | DATE | DATE | STATION     | DATE | BY | DATE | NO.                | BY | DATE | DATE |                 |  |  |  |
| INSPECTOR            | NO. | DATE | DATE | STATION     | DATE | BY | DATE | NO.                | BY | DATE | DATE |                 |  |  |  |
| ACCEPTANCE BY        | NO. | DATE | DATE | STATION     | DATE | BY | DATE | NO.                | BY | DATE | DATE |                 |  |  |  |
| FIELD                | NO. | DATE | DATE | STATION     | DATE | BY | DATE | NO.                | BY | DATE | DATE |                 |  |  |  |
| DRAWINGS             | NO. | DATE | DATE | STATION     | DATE | BY | DATE | NO.                | BY | DATE | DATE |                 |  |  |  |
| CONDUCTED BY         | NO. | DATE | DATE | STATION     | DATE | BY | DATE | NO.                | BY | DATE | DATE |                 |  |  |  |
| RECORDED BY          | NO. | DATE | DATE | STATION     | DATE | BY | DATE | NO.                | BY | DATE | DATE |                 |  |  |  |
| NO.                  | NO. | DATE | DATE | STATION     | DATE | BY | DATE | NO.                | BY | DATE | DATE |                 |  |  |  |

26 26421286

|                                                                                 |          |          |              |          |          |                    |          |
|---------------------------------------------------------------------------------|----------|----------|--------------|----------|----------|--------------------|----------|
| CITY OF ALBUQUERQUE<br>MUNICIPAL DEVELOPMENT DEPARTMENT<br>ENGINEERING DIVISION |          |          |              |          |          |                    |          |
| TITLE: SUNVILLAGE APARTMENTS<br>STREET SECTION AND DETAILS                      |          |          |              |          |          |                    |          |
| APPROVALS                                                                       | ENGINEER | DATE     | APPROVALS    | ENGINEER | DATE     | APPROVALS          | ENGINEER |
| City Engineer                                                                   |          | 11/22/85 | Liquid Waste |          | 11/22/85 | City Engineer      |          |
| A.C.E. - Design                                                                 |          | 11/22/85 | Traffic      |          | 11/22/85 | A.C.E. - Design    |          |
| A.C.E. - Hydrology                                                              |          | 11/22/85 | Water        |          | 11/22/85 | A.C.E. - Hydrology |          |
| DRAWING NO.                                                                     | 2642     | MAP NO.  | H-15, J 15   | SHEET    | 12       | OF                 | 12       |