

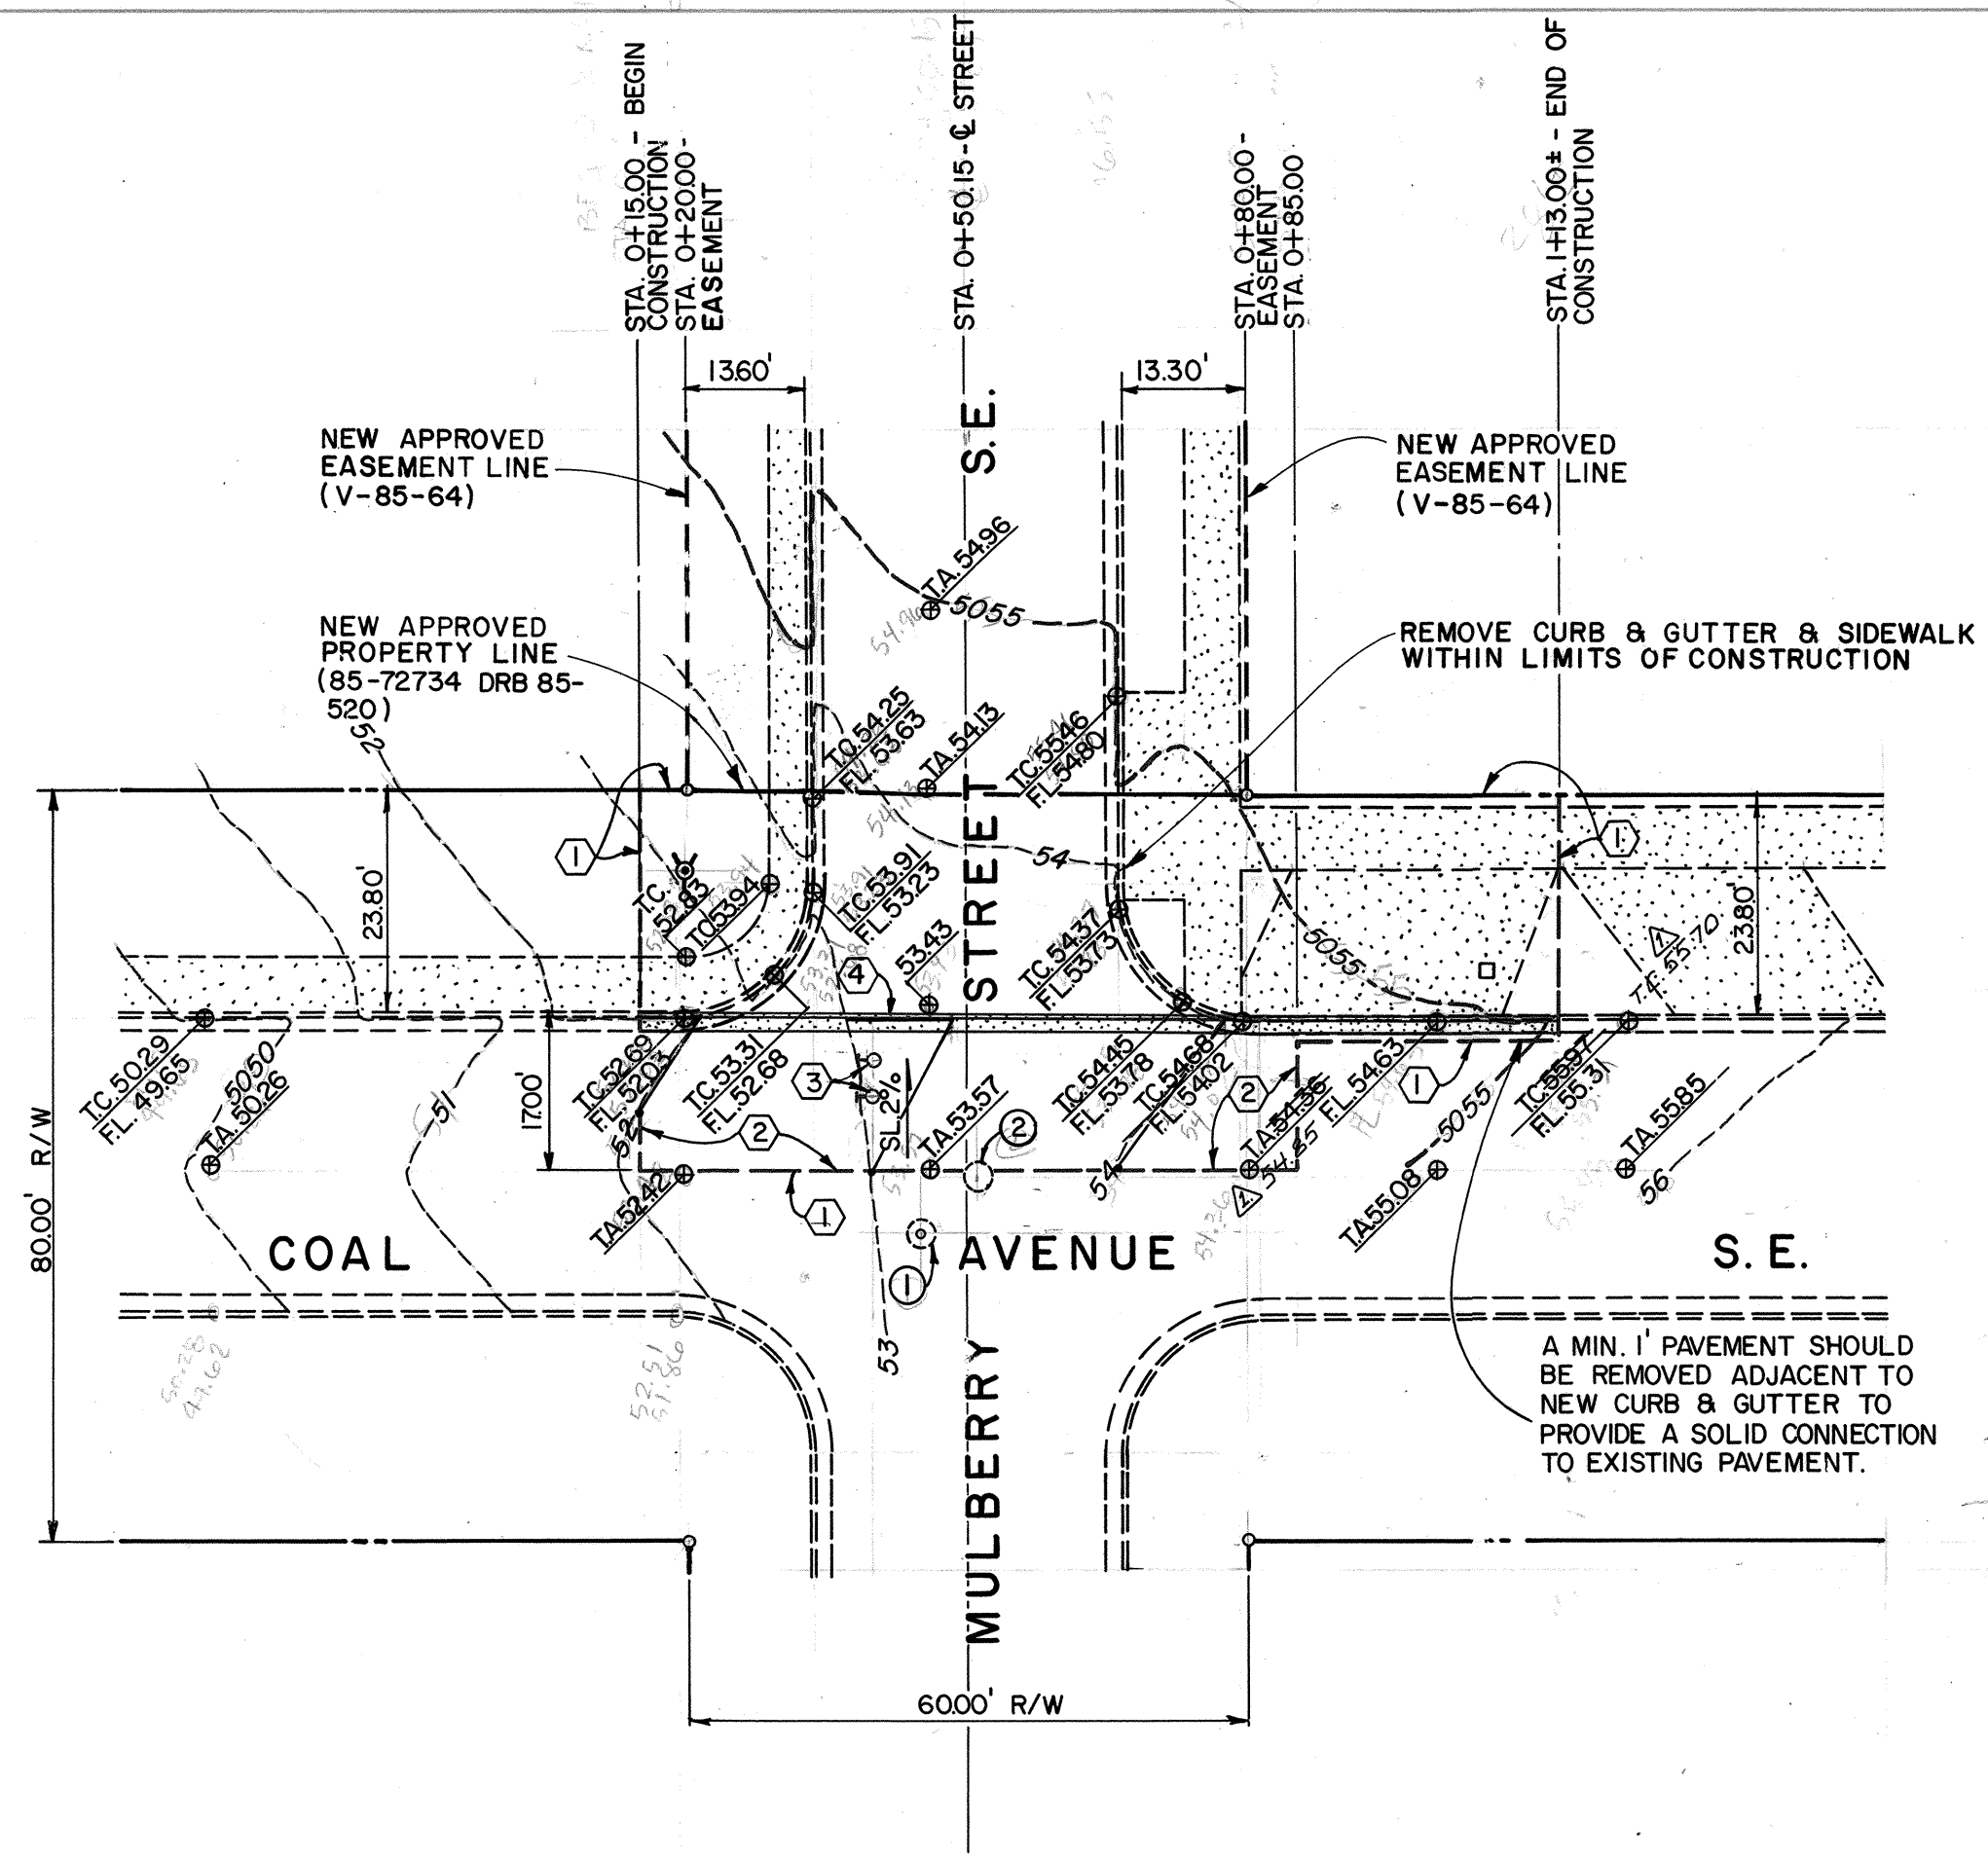


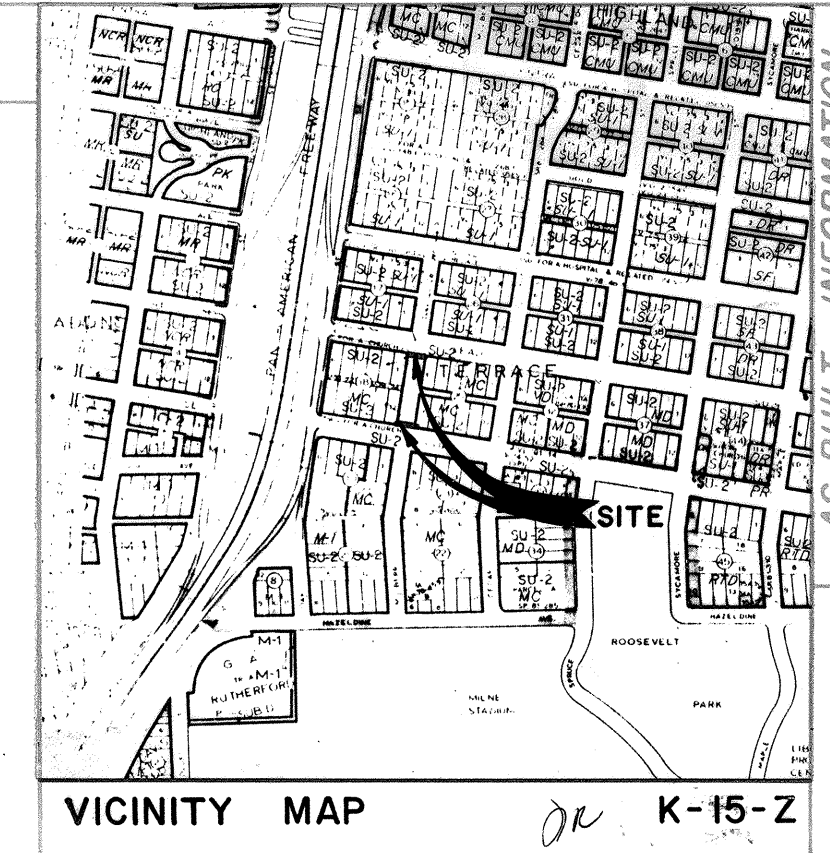

Note: Sidewalks to be constructed by others.

SCALES:
HORIZONTAL: 1" = 20'
VERTICAL: 1" = 5'

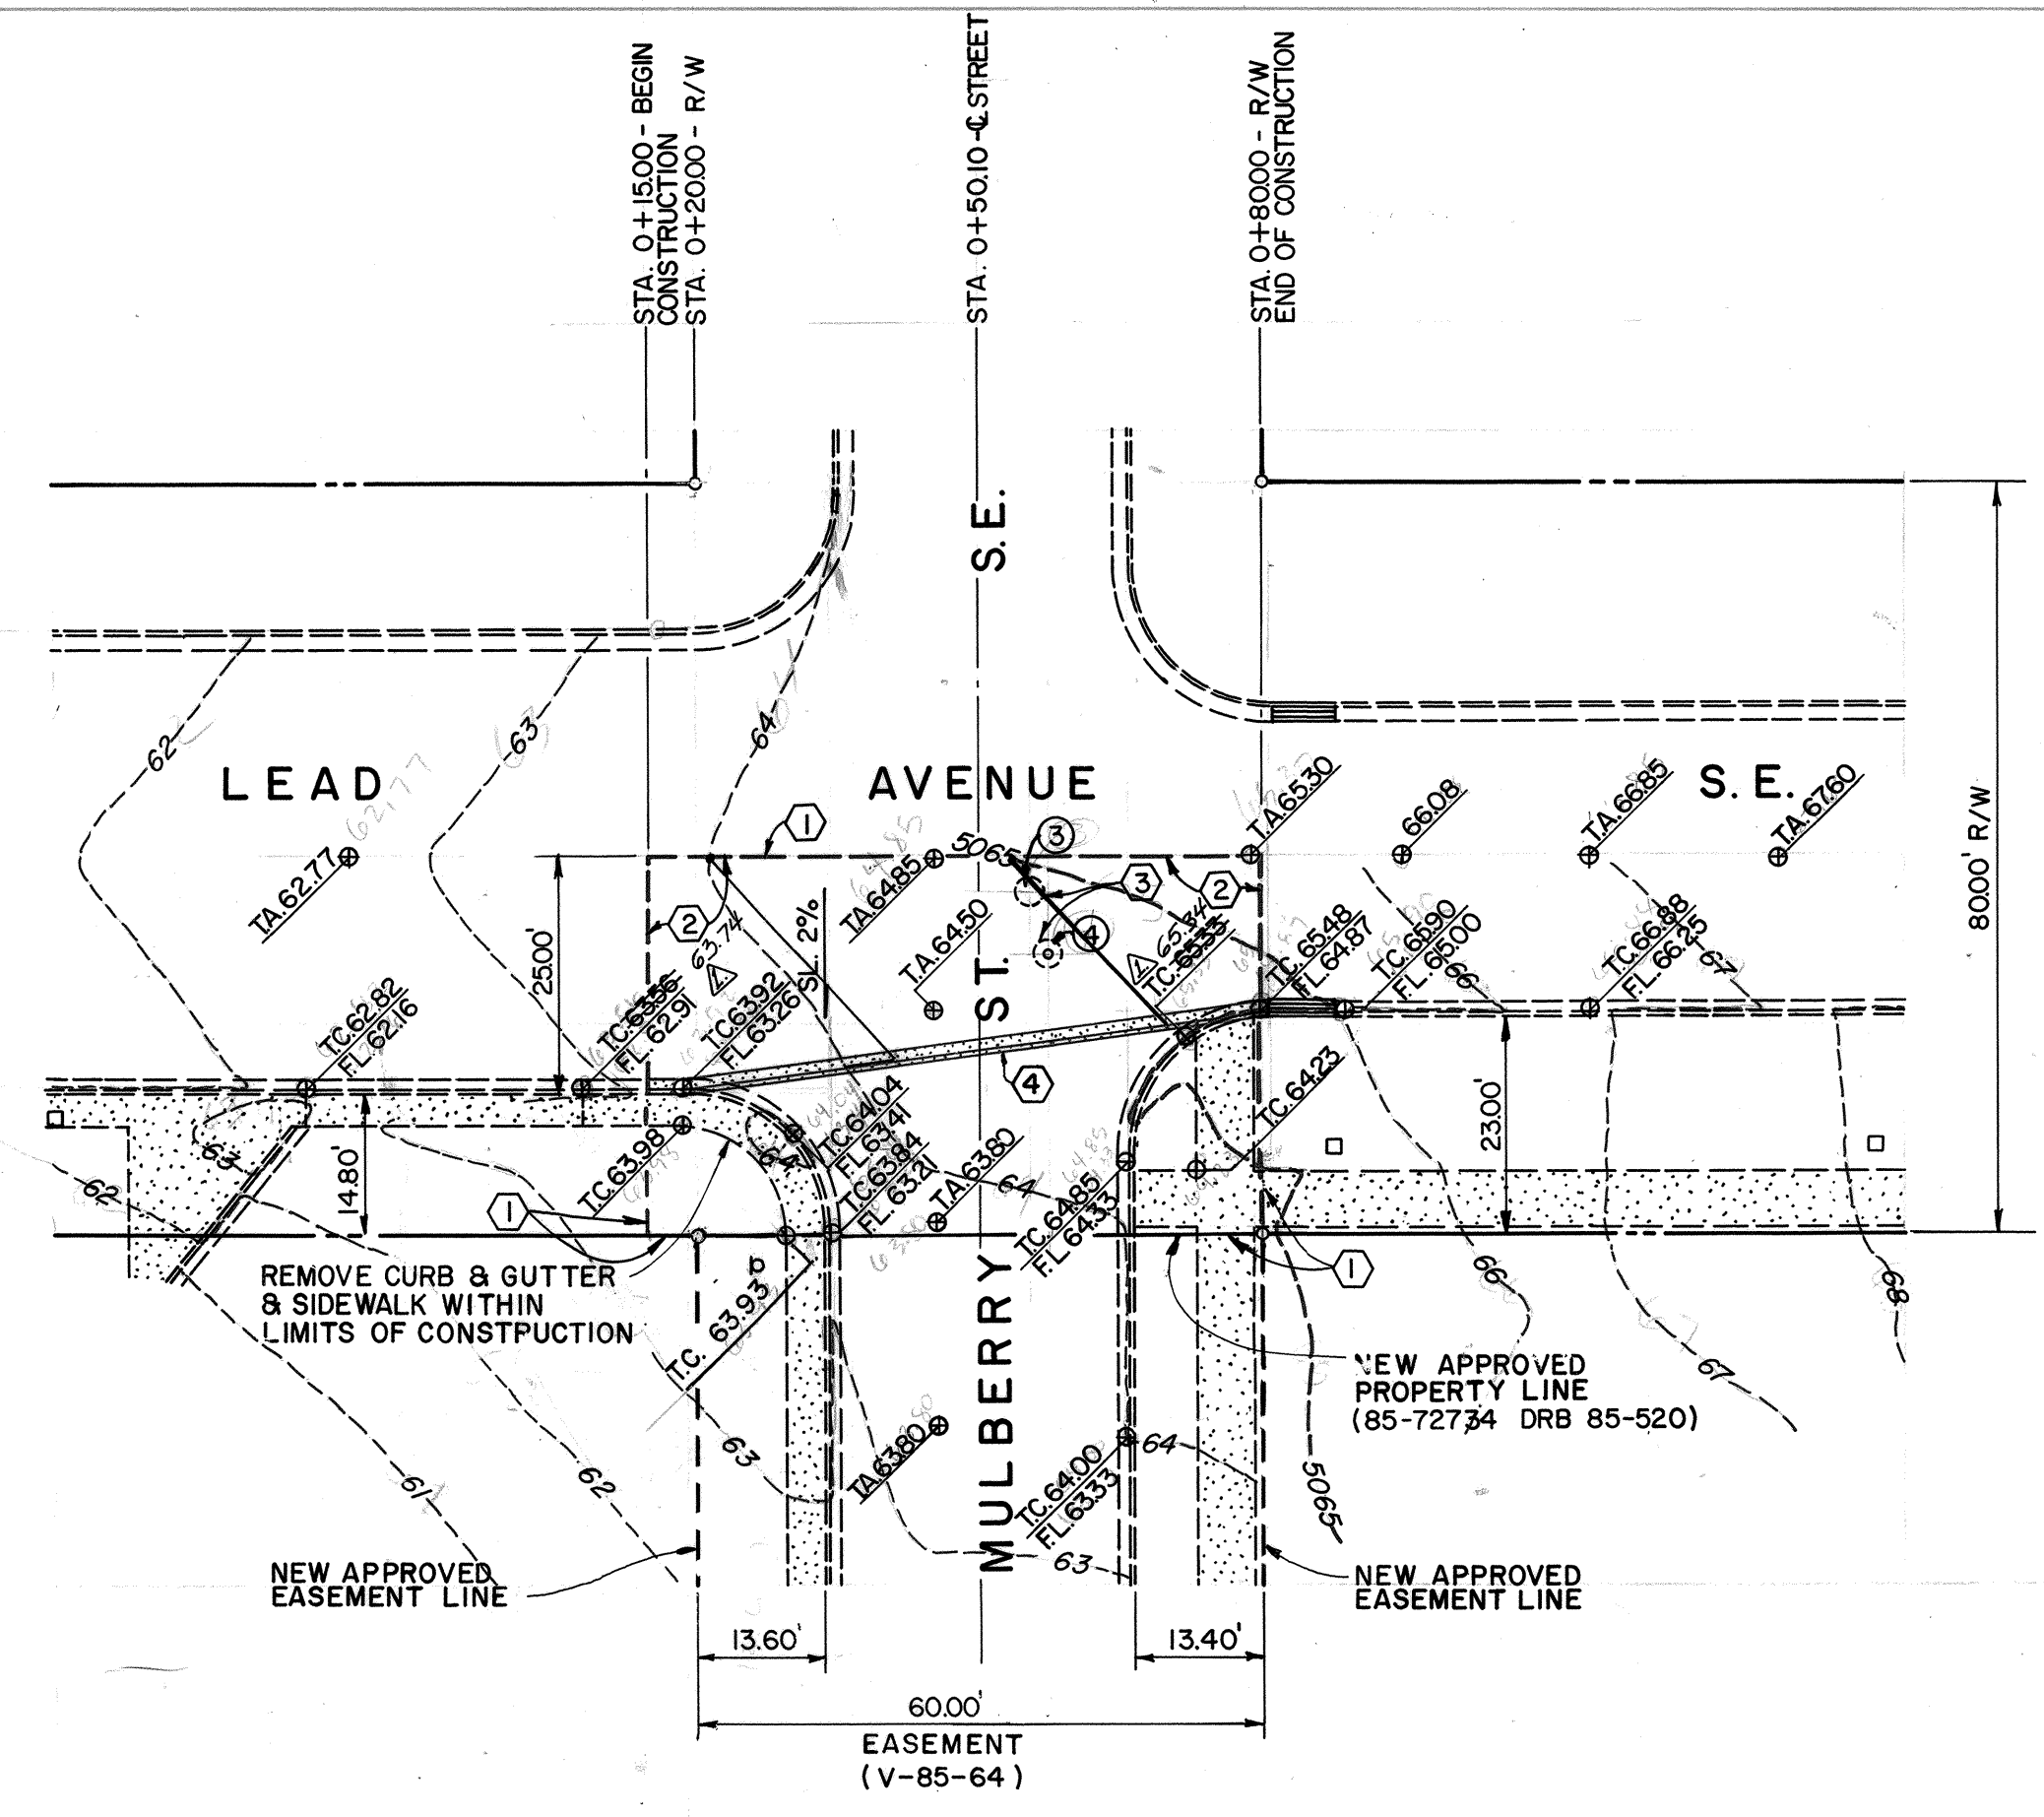

- NOTICE TO CONTRACTOR**
- ALL WORK DETAILED ON THESE PLANS TO BE PERFORMED UNDER CONTRACT SHALL, EXCEPT AS OTHERWISE STATED OR PROVIDED FOR HEREON, BE CONSTRUCTED IN ACCORDANCE WITH THE CITY OF ALBUQUERQUE, INTERIM STANDARD SPECIFICATIONS, PUBLIC WORKS CONSTRUCTION, 1985.
 - TWO (2) WORKING DAYS PRIOR TO ANY EXCAVATION, CONTRACTOR MUST CONTACT LINE LOCATING SERVICE, 765-1234, FOR LOCATION OF EXISTING UTILITIES.
 - PRIOR TO CONSTRUCTION, THE CONTRACTOR SHALL EXCAVATE AND VERIFY THE HORIZONTAL AND VERTICAL LOCATIONS OF ALL OBSTRUCTION. SHOULD A CONFLICT EXIST, THE CONTRACTOR SHALL NOTIFY THE ENGINEER OR SURVEYOR SO THAT THE CONFLICT CAN BE RESOLVED WITH MINIMUM AMOUNT OF DELAY.
 - BACKFILL COMPACTION SHALL BE ACCORDING TO ARTERIAL STREET USE.
 - TACK COAT REQUIREMENTS SHALL BE DETERMINED BY THE CITY ENGINEER.
 - SIDEWALK CONSTRUCTION NOT INCLUDED IN THIS CONTRACT.
 - CONTRACTOR IS TO ACQUIRE A BARRICADING PERMIT AND SUBMIT TRAFFIC CONTROL PLANS TO CITY TRAFFIC ENGINEERING THREE FULL WORKING DAYS IN ADVANCE OF DESIRED CLOSURES FOR APPROVAL.
- NOTES:**
- LIMITS OF NEW CONSTRUCTION.
 - SAW CUT EXISTING PAVEMENT. EDGE OF NEW PAVEMENT TO MATCH EXISTING ELEVATIONS. NEW PAVEMENT TO BE ARTERIAL PAVING AS PER CITY STD. DWG. P-4.
 - ADJUST MANHOLE OR VALVE BOX FRAMES TO NEW GRADE AS PER CITY STANDARD DWG. P-24.
 - CONSTRUCT NEW STD. CURB & GUTTER AS PER CITY STANDARD DWG. P-8.



NO.	DATE	DESCRIPTION
1	1985	ALBUQUERQUE SURVEY
2	1985	CO. NMLS NO. 4078

DESCRIPTION	EXISTING	NEW
RIGHT-OF-WAY	---	---
CURB & GUTTER	=====	=====
SIDEWALK	=====	=====
PAVEMENT	=====	=====
POWER POLE	o	o
WATER METER	o	o
FIRE HYDRANT	o	o
DROP INLET	o	o
SANITARY M.H.	o	o
STORM M.H.	o	o
SPOT ELEVATIONS	o	o
CONTOURS	o	o

MANHOLE DATA (EXISTING)
1. N. RIM ELEV. = 5053.189
2. N. RIM ELEV. = 5053.491
3. N. RIM ELEV. = 5064.792
4. N. RIM ELEV. = 5064.744

CITY OF ALBUQUERQUE MUNICIPAL DEVELOPMENT DEPARTMENT ENGINEERING DIVISION					
TITLE: MULBERRY ST CURB & GUTTER EXTENSIONS NORTH INTERSECTION OF MULBERRY ST. S.E. AND COAL AVE. S.E. & SOUTH INTERSECTION OF MULBERRY ST. S.E. AND LEAD AVE. S.E.					
APPROVALS	ENGINEER	DATE	APPROVALS	ENGINEER	DATE
City Engineer	ALL	12/1/85	Liquid Waste	ALL	12/1/85
A.C.E. - Design	ALL	11/22/85	Traffic	ALL	11/22/85
A.C.E. - Hydrology	ALL	11/22/85	Water	ALL	11/22/85

DRAWING NO.	MAP NO.	SHEET	OF
2672	K-15-Z	1	1

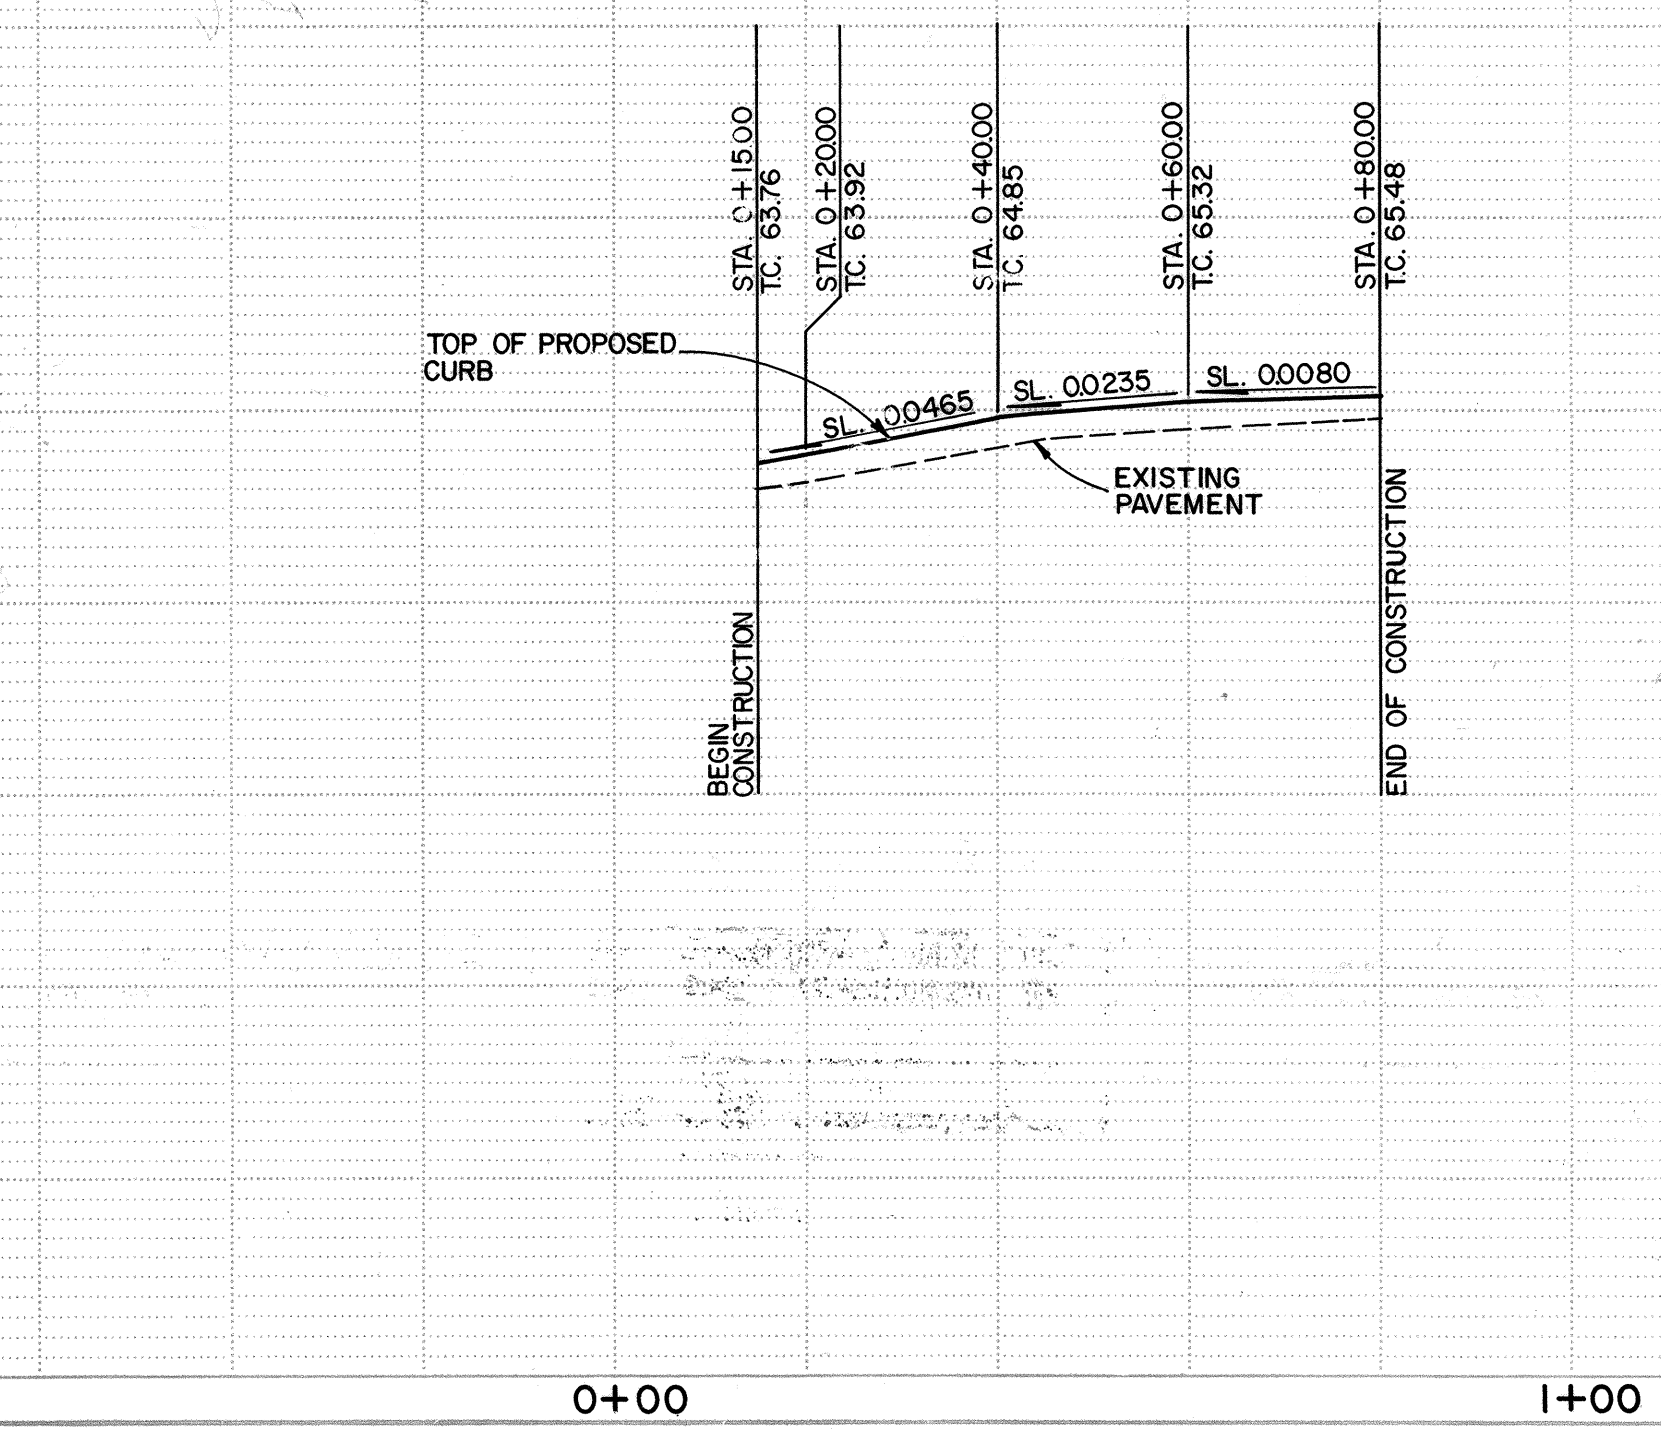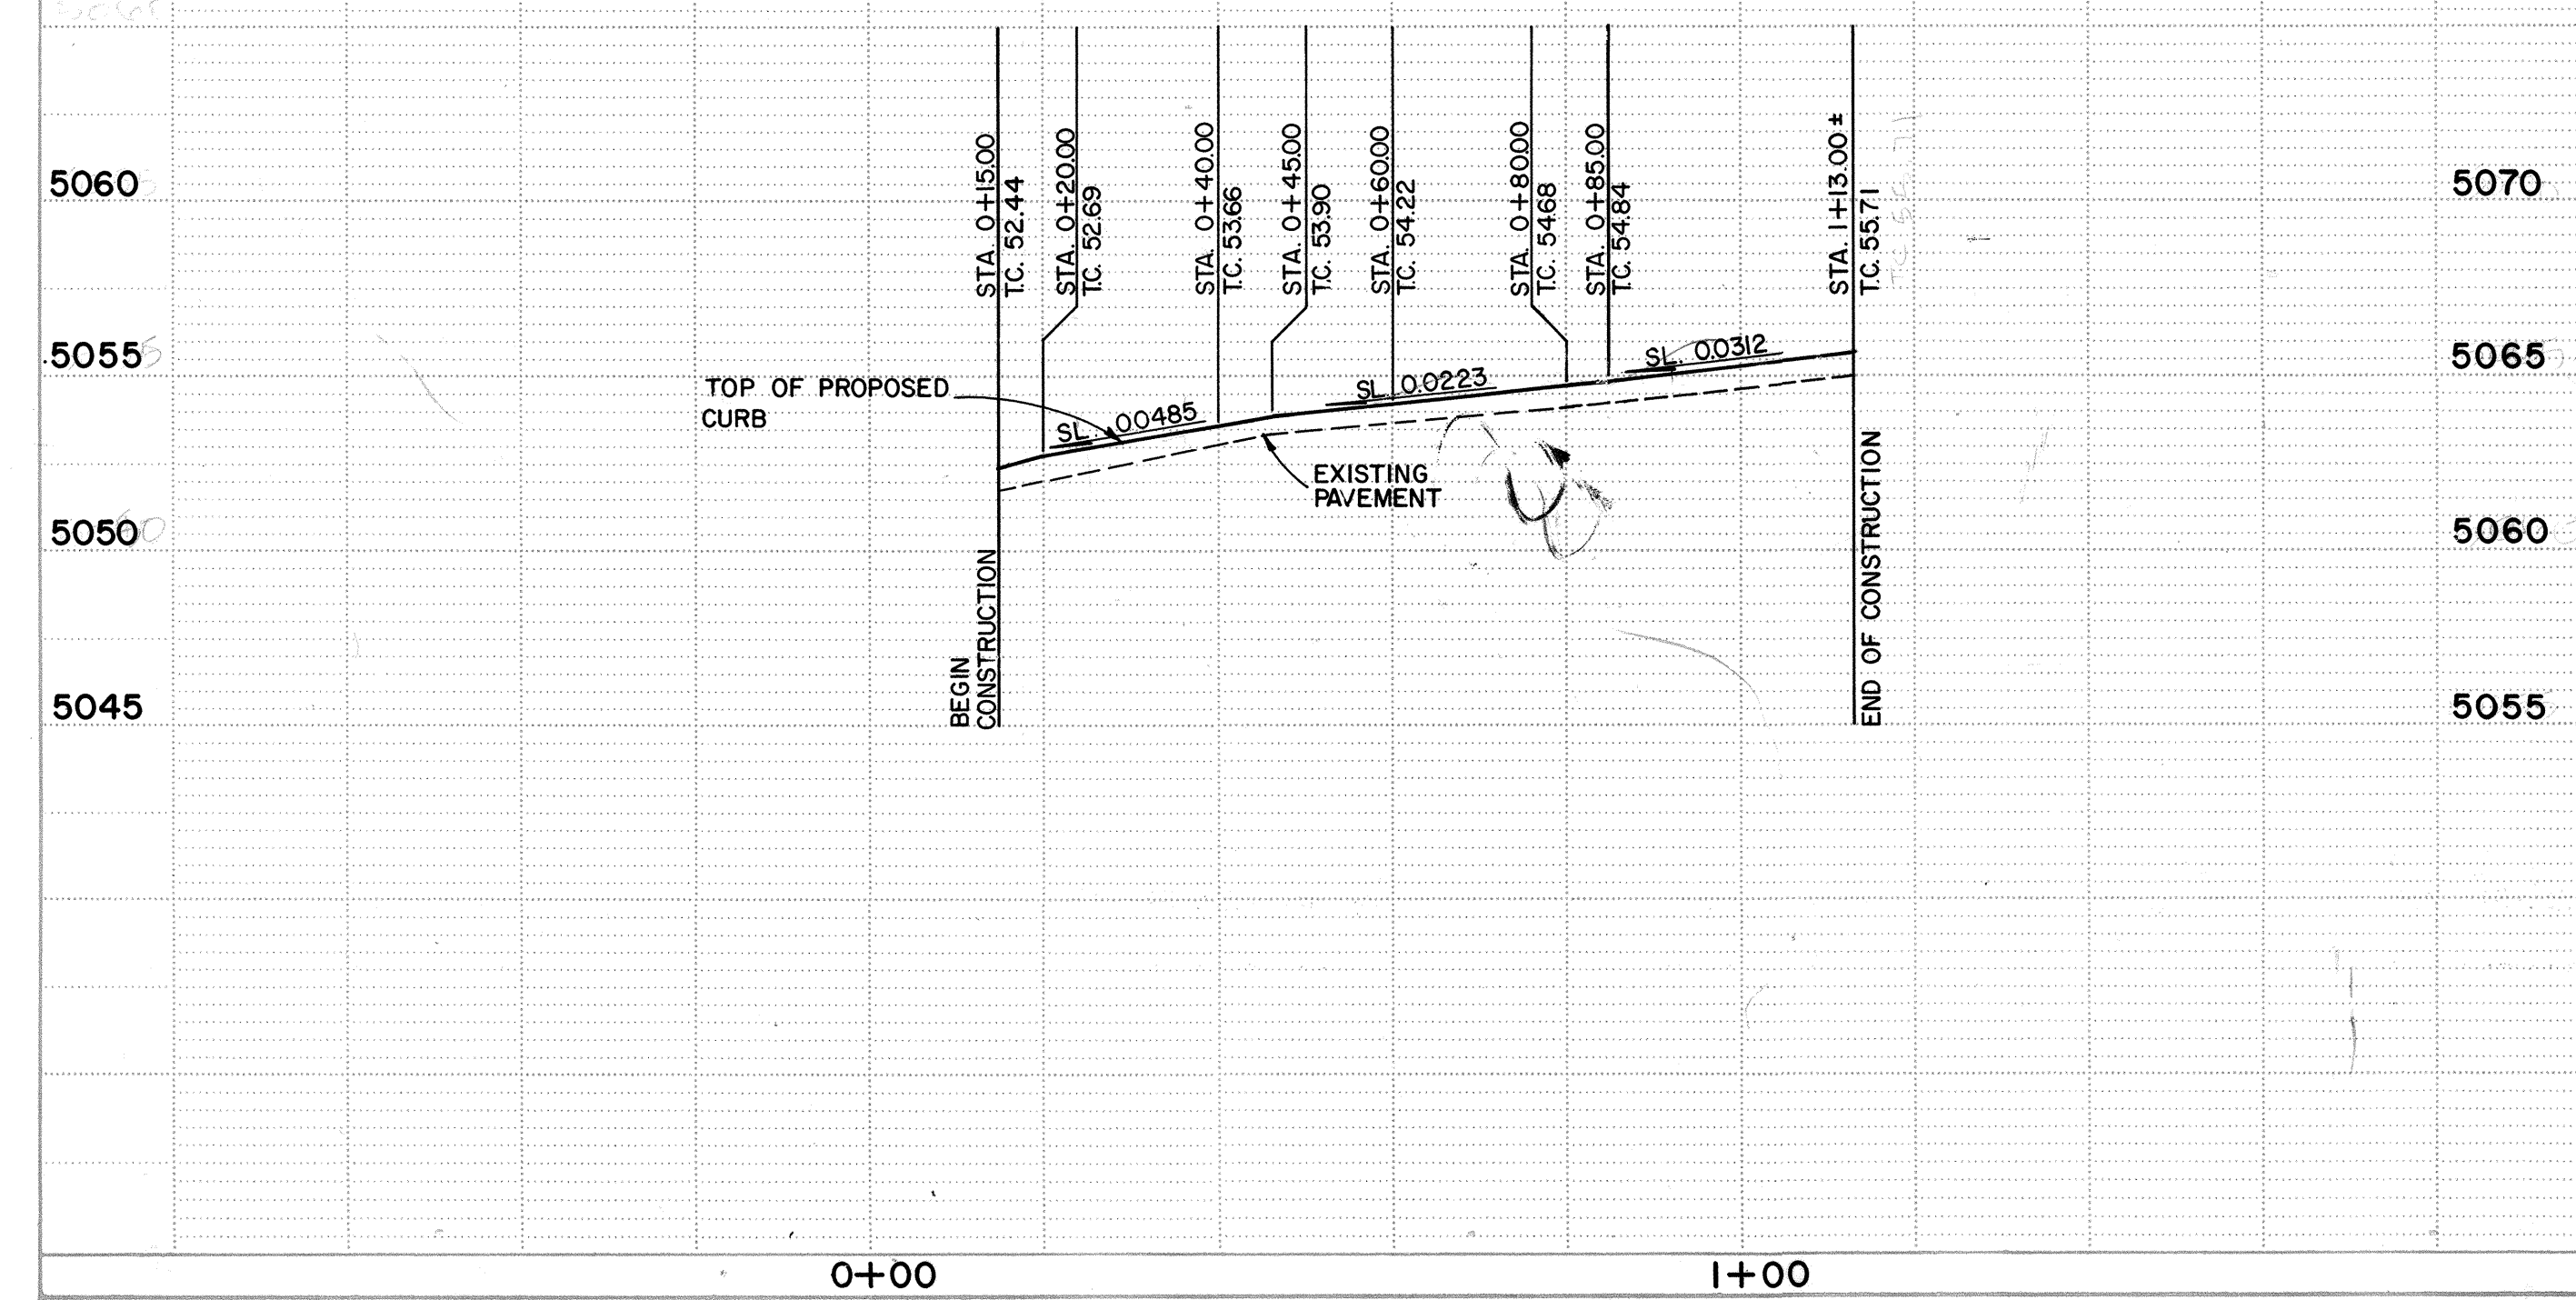

APPROVAL OF AS BUILT DRAWINGS
DATE 10-28-86

26 2672 0186

10/1/86