
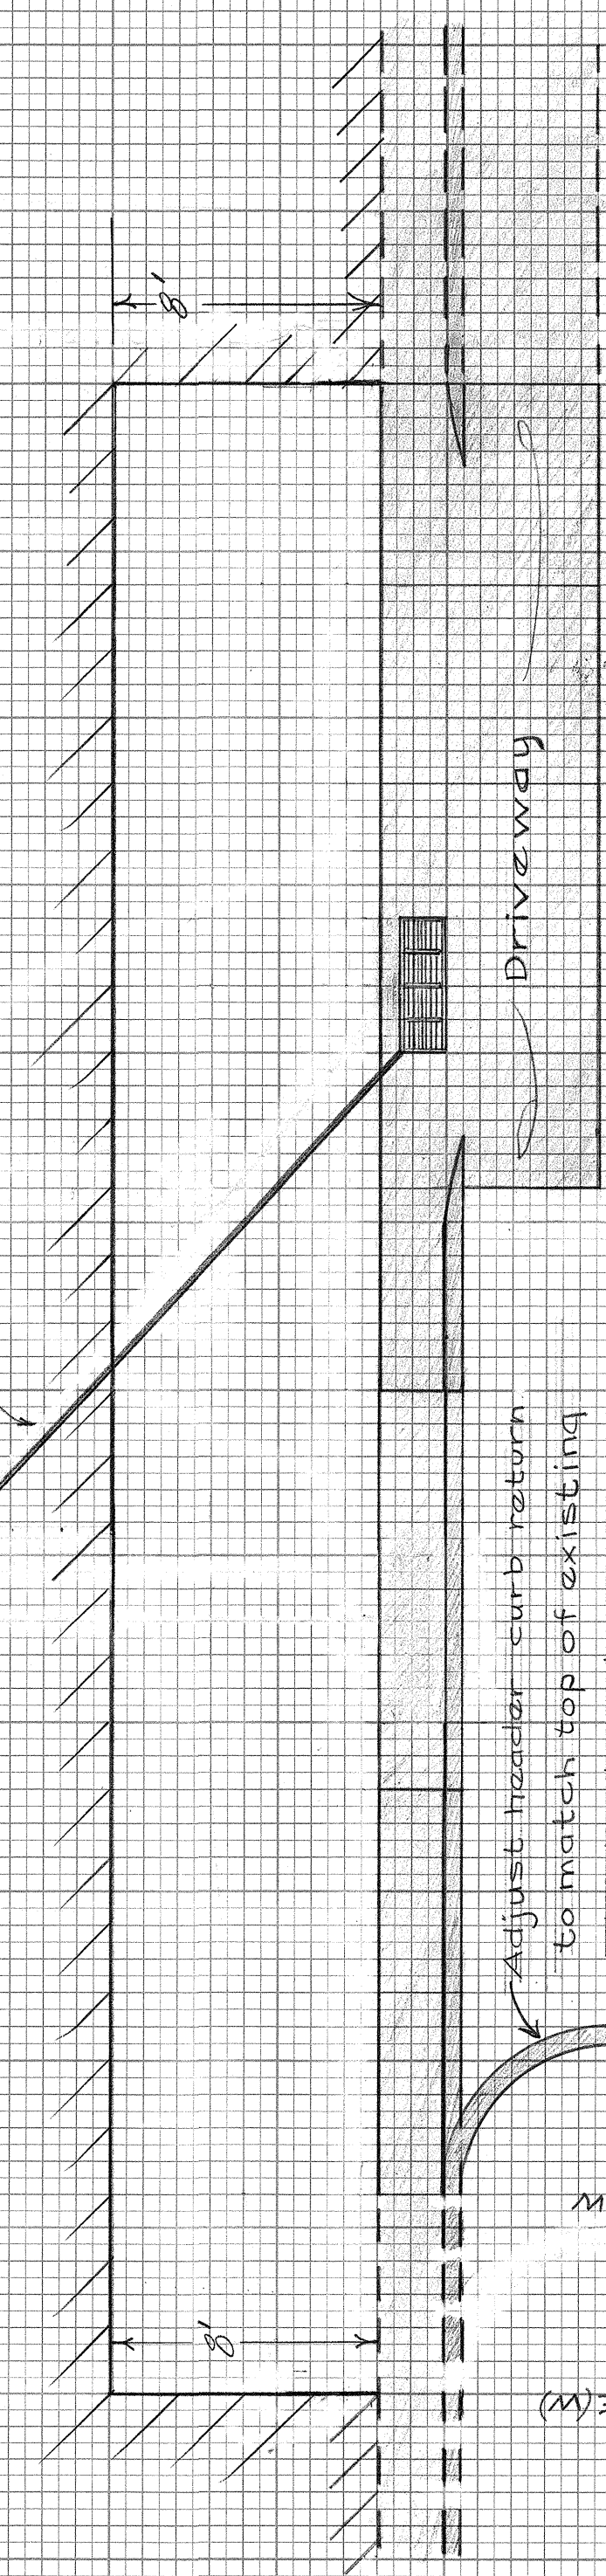
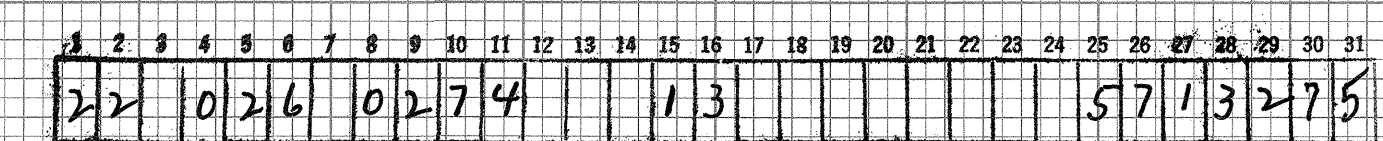
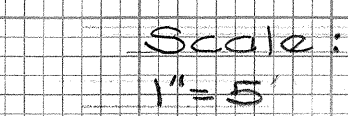


ORIGINAL SURVEY	SURVEYED	BY	DATE
	PLOTTED		
NOTE BOOK	TEMPLATE		
	AREAS		
NO. _____	AREAS CHECKED		

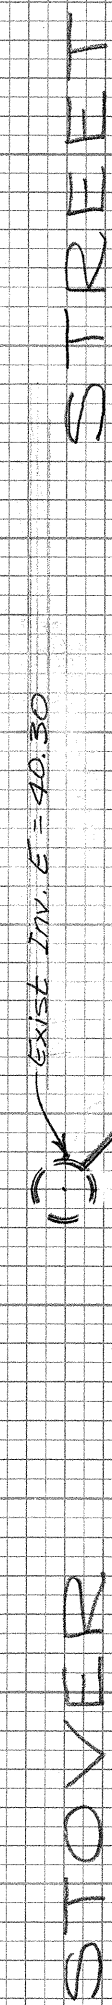

0+45
0+60

0+0 NE

OLD EXIST $E(N)$

Map No. K-13-S

△ 1/23/75 Revised drop in izt, added sheet 2		RECORDED BY 	
NO. DATE		REMARKS 	
REVISIONS			
CITY OF ALBUQUERQUE PUBLIC WORKS DEPARTMENT ENGINEERING DIVISION			
TITLE CROSS SECTION STOVER #9TH (SOUTH SIDE)			
DESIGNED BY 		DRAWN BY <i>1/23/75</i> 	
TITLE 		AS BUILT 	
DATE 		DATE <i>1/17/75</i> 	
APPROVAL			
ASST CITY ENGINEER 		CITY ENGINEER 	
DATE 		DATE 	
WATER ENGINEER 		LIQUID WASTE ENGINEER 	
DATE 		DATE 	
DRAWING NUMBER 		SHEET NO. <i>2</i> OF <i>2</i> SHEETS	
55-26-74			

Scale:
1" = 5' Horiz.

W
—
—
L
O
V
A