

IMPROVEMENT PLANS


MONTGOMERY BLVD. WATER LINE

PITT TO INCA

CITY OF ALBUQUERQUE
NEW MEXICO

INDEX

COVER SHEET	1
PLAN & PROFILE	2

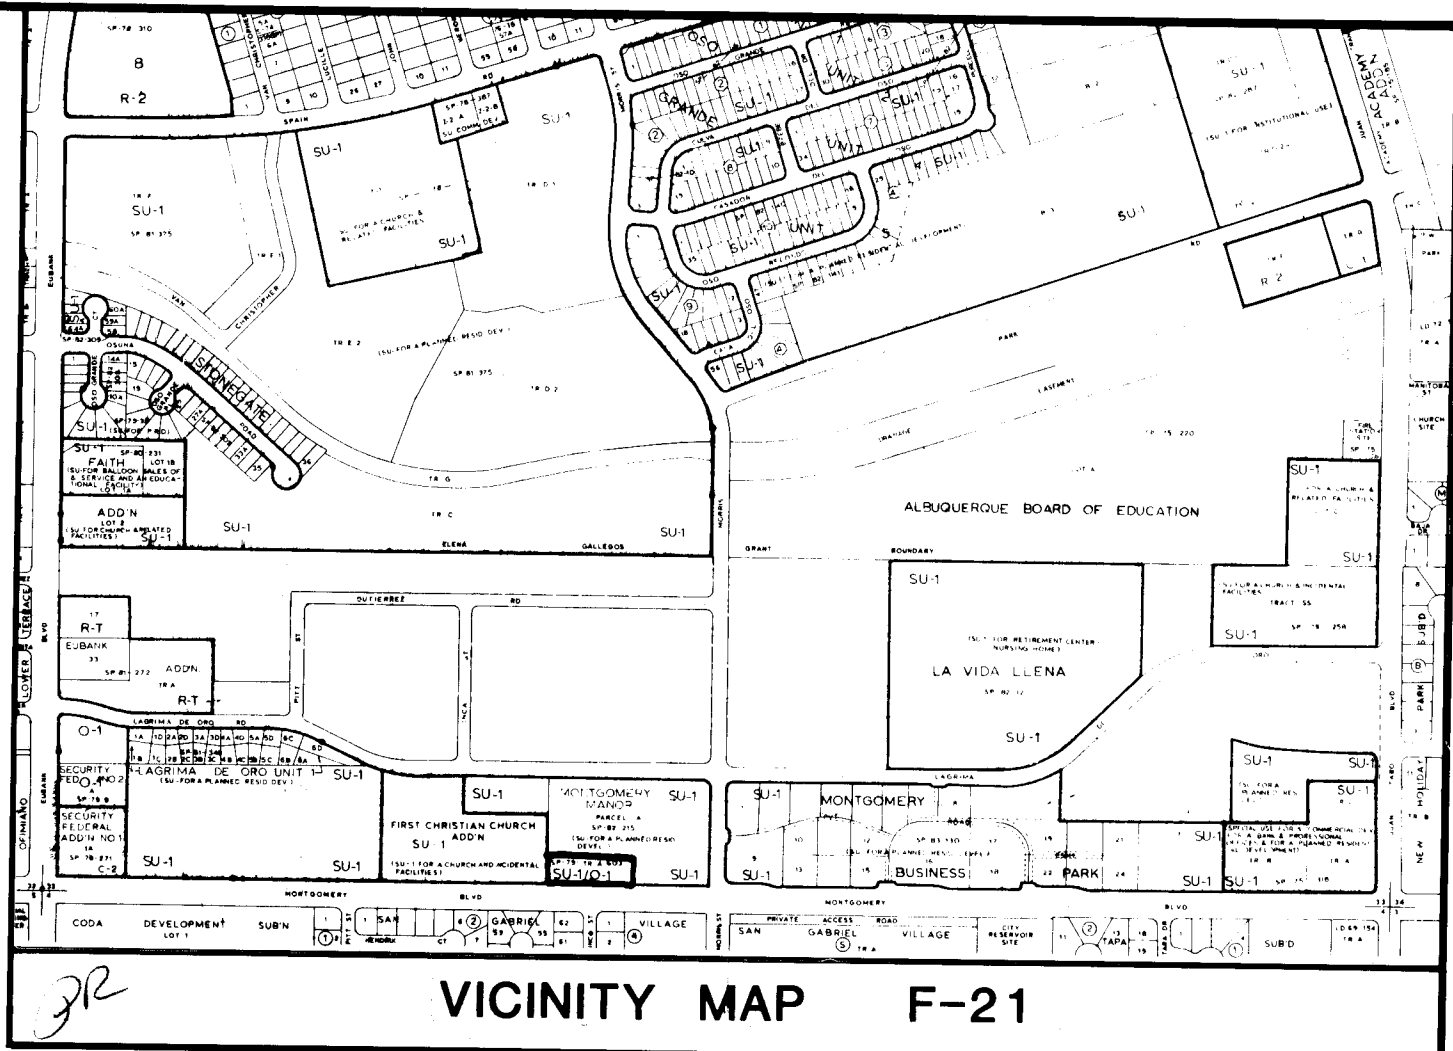

GENERAL NOTES:

1. All work detailed on these plans to be performed under contract shall, except as otherwise stated or provided for herein, be constructed in accordance with "City of Albuquerque Interim Standard Specifications for Public Works Construction, 1985."
2. Two (2) working days prior to any excavation, Contractor shall contact Line Locating Service at 765-1234, for location of existing lines.
3. The contractor shall prepare and submit a detailed traffic control plan, which is subject to the approval of the City Traffic Engineer, three (3) working days in advance of any required closures. See SECTION 19 of the General Conditions.
4. Stations shown are street centerline stations.
5. Prior to construction, the Contractor shall excavate and verify the horizontal and vertical locations of all obstructions. Should a conflict exist, the Contractor shall notify the engineer so that the conflict can be resolved with a minimum amount of delay. Facilities which are not specifically located with actual horizontal and vertical controls are located only approximately.
6. All utilities and utility service lines shall be installed prior to paving.
7. A disposal site for all excess earth material and for removal items shall be obtained by the Contractor. The site shall be in compliance with applicable environmental regulations and approved by the City Engineering Department. All costs incurred in obtaining a disposal site and haul thereto shall be considered incidental to construction and no direct payment will be made therefor.
8. It will be the responsibility of the Contractor to support all gas main and service lines where they are within the area of excavation.
9. Cast iron fittings will not be measured and paid for separately, but shall be considered incidental to the construction of the water line and shall be included in the price bid for water line.
10. Concrete blocking will not be measured and paid for separately, but shall be considered incidental to the construction of the water line and shall be included in the price bid for water line.
11. Where a water line passes beneath or less than 18 in. above an existing sewer line, the sewer line shall be encased in concrete 6 in. thick as per the standard drawings, for at least 10 ft. on each side of the water line, or the sewer line shall be D.I. or C.I. pipe with pressure-type joints for at least 10 ft. on each side of the water line. This shall also apply where parallel water line is less than 10 ft. horizontally and less than 2 ft. above the sewer line.
12. All sewerlines in this project shall be constructed of DIP, WCP or PVC and installed in accordance with the specifications and standard drawings unless otherwise noted.
13. All waterlines in this project shall be constructed of DIP, ACP or PVC and installed in accordance with the specifications and standard drawings unless otherwise noted.
14. The contractor shall coordinate connection to existing water system in accordance with the specifications. (See SECTION 18 of the General Conditions.)
15. The Contractor shall repair and restore private or public property which is damaged during construction. (See SECTION 6 and SECTION 18 of the General Conditions.)
16. Dimensions shown are to the face of curb unless otherwise noted.

26 26920186
RECEIVED BY AS BUILT DRAWINGS
CITY ENGINEER FIELD
W. J. McQuinn
5/1/86

REV.	SHEETS	CITY ENGINEER	DATE	USER	DEPT.	DATE	USER	DEPT.	DATE
APPROVAL OF REVISIONS									







DMJM/Adam, Hamlyn, Anderson
5700 Harper Drive NE, Suite 280
Albuquerque, New Mexico 87109
(505) 822-7955

APPROVED FOR
CONSTRUCTION
W. J. McQuinn
5/1/86
C.E.

2692


SHEET 1 OF 2

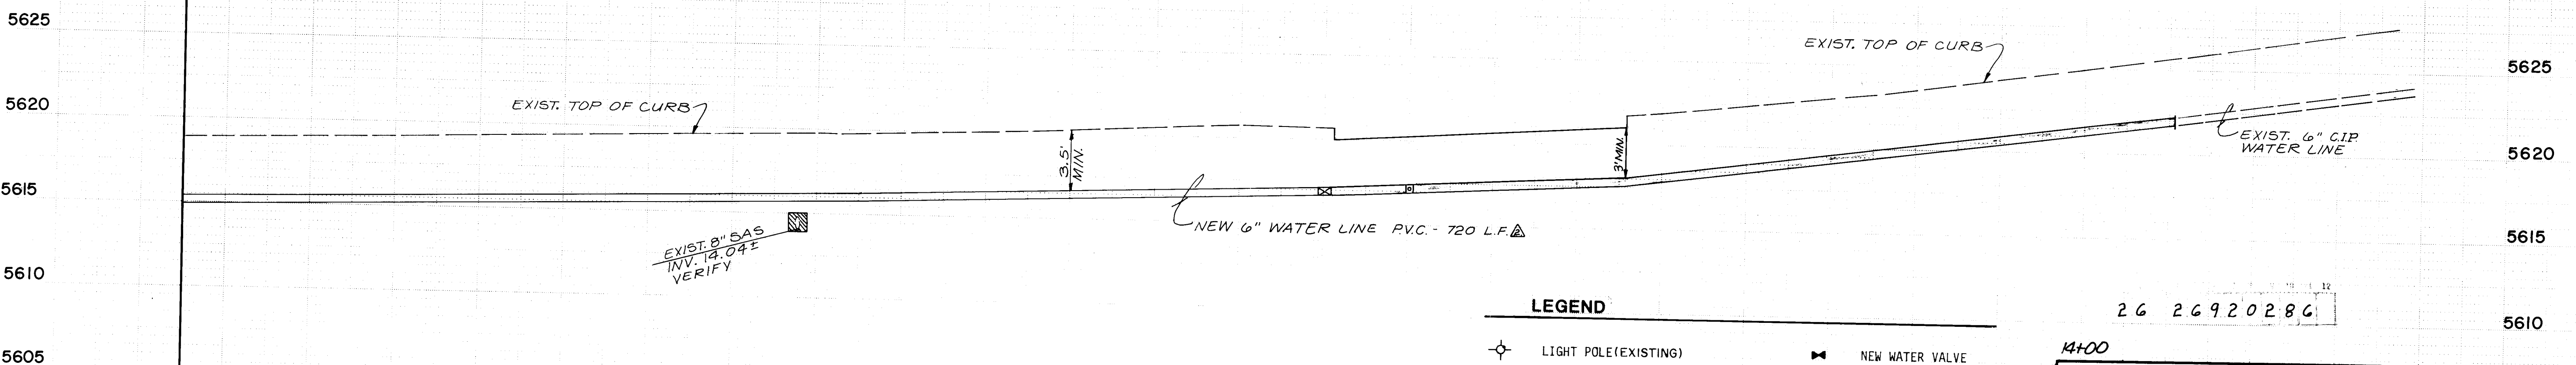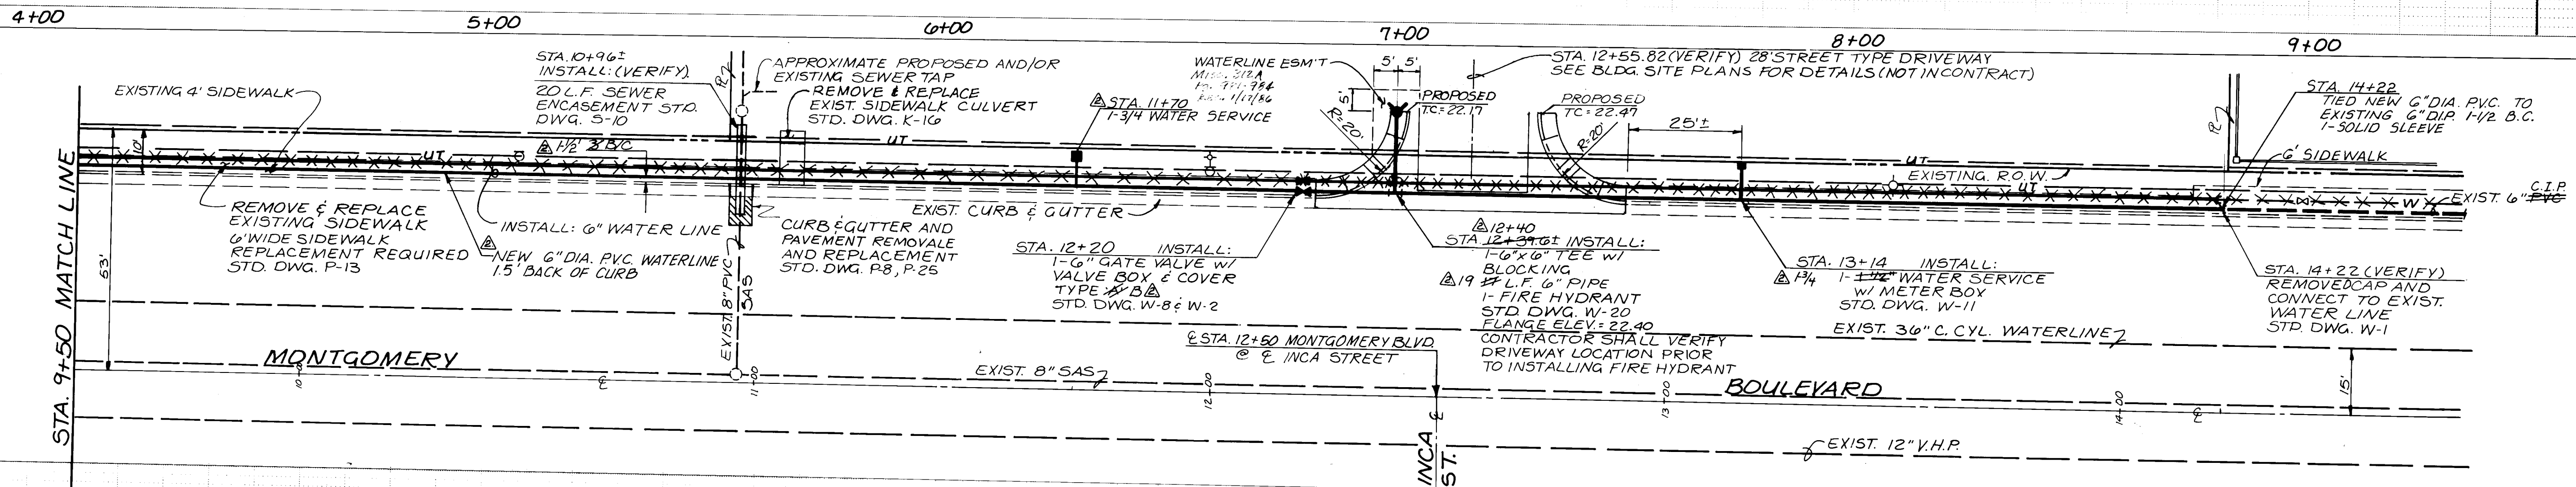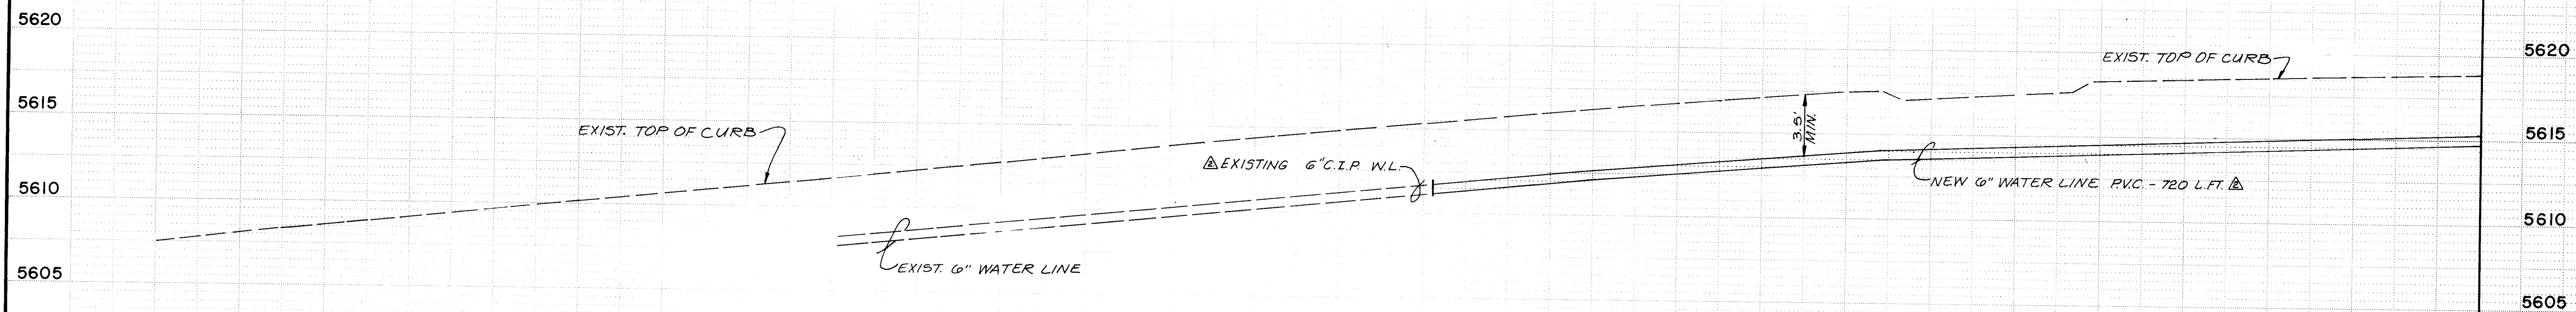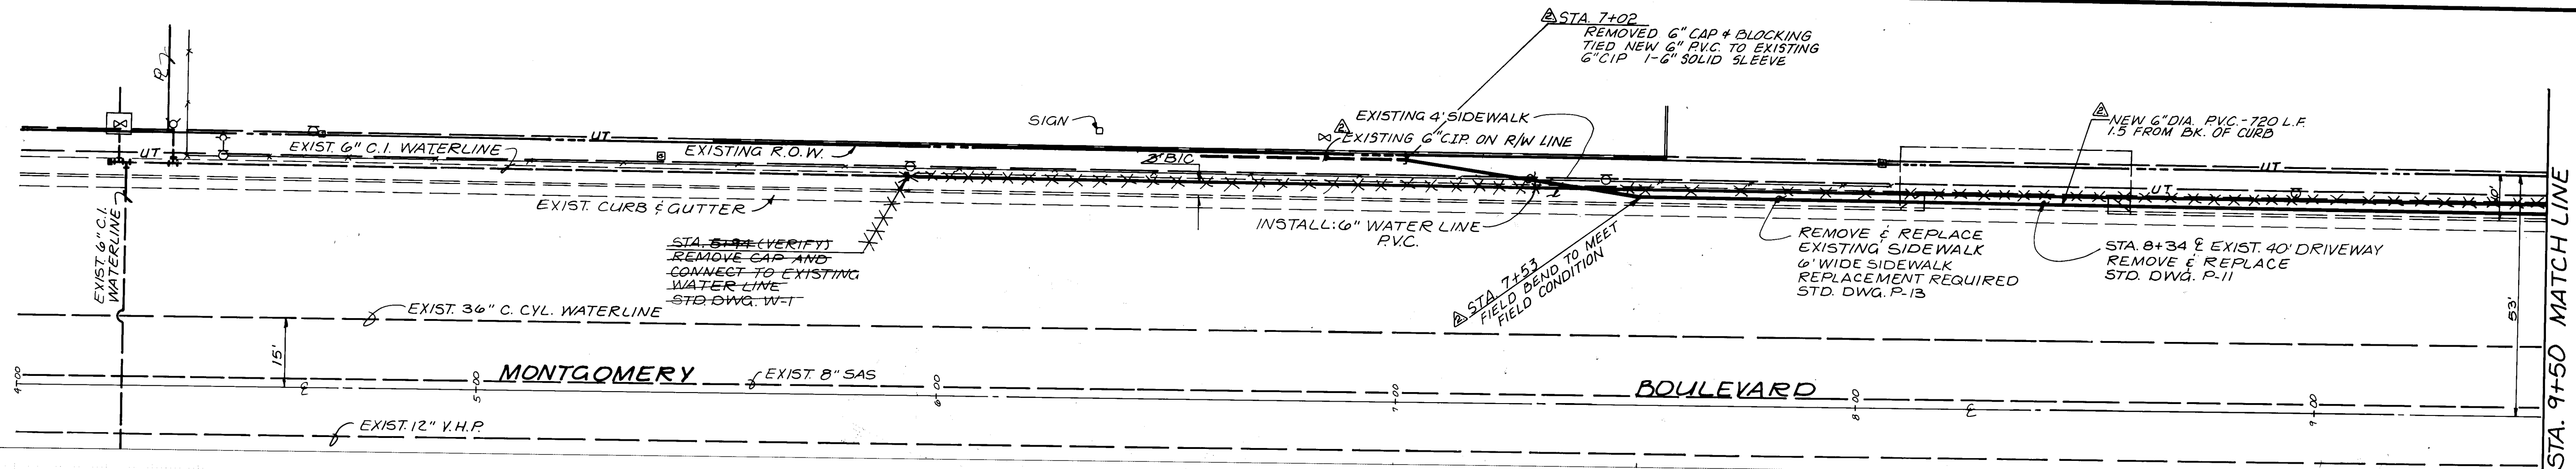

LEGEND

⊙	LIGHT POLE (EXISTING)	⊙	NEW WATER VALVE
⊙	POWER POLE (EXISTING)	⊙	NEW FIRE HYDRANT
⊙	POWER POLE WITH LIGHT (EXISTING)	---	EXIST CURB & GUTTER
⊙	TELEPHONE BOX (EXISTING)	UT	UNDERGROUND TELEPHONE
⊙	GAS METER (EXISTING)	TC	TOP OF CURB
⊙	EXIST MANHOLE	---	NEW WATER LINE
⊙	EXIST WATER VALVE	B/C	BACK OF CURB
		---	RIGHT OF WAY

26 26920286

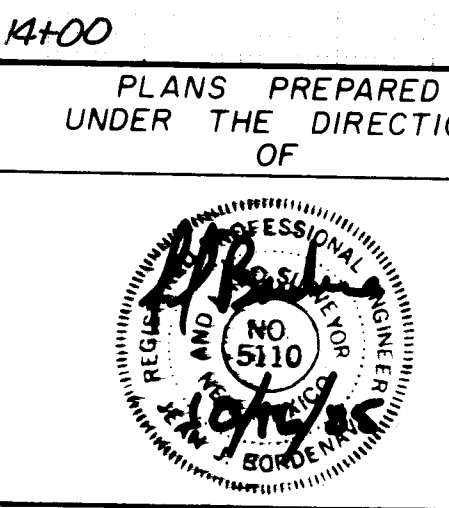

APPROVED FOR CONSTRUCTION

CITY ENGINEER DATE

CITY OF ALBUQUERQUE
MUNICIPAL DEVELOPMENT DEPARTMENT
ENGINEERING DIVISION

TITLE: **MONTGOMERY BLVD. WATER LINE
PITT TO INCA**

APPROVALS	ENGINEER	DATE	APPROVALS	ENGINEER	DATE
City Engineer	[Signature]	10/25/85	Liquid Waste	[Signature]	11/21/85
A.C.E. Design	[Signature]	11/22/85	Traffic	[Signature]	11/22/85
A.C.E. Hydrology	[Signature]	11/22/85	Water	[Signature]	11/22/85

DESIGNED BY CBB DATE 10-85
DRAWN BY SP DATE 10-85
CHECKED BY CBB DATE 10-85

DRAWING NO. **2692**

SHEET **2** OF **2**

AS BUILT INFORMATION			
CONTRACTOR	Price Construction	DATE	4/25/86
STAMPED BY	DATE	DATE	4/25/86
ACCEPTANCE BY	DATE	DATE	4/25/86
FIELD DRAWINGS	DATE	DATE	4/25/86
CORRECTED BY	DATE	DATE	4/25/86
MICRO-FILM INFORMATION			
RECORDED BY	DATE	DATE	
NO.			

SURVEY INFORMATION		FIELD NOTES	
AC'S C-541	ELEVATION: 5636.11	DATE	
CITY OF ALBUQUERQUE	BRASS CAP IN	BY	
CURB RETURN @ THE SW CORNER OF		NO.	
MONTGOMERY & MORRIS		W.O. NO.	
SOURCE ACS PAGE C-541 W/REV #6		EST. NO.	
TBM	ELEVATION: 5621.09		
CHISLED "D" SQUARE SE CORNER OF			
CONC. SILT BOX @ SW CORNER OF			
PROPERTY.			

REFERENCES		EX	
MAP NO. F-21		BY	
EST. NO.		REMARKS	
		NO. DATE	
		REVISIONS	
		DESIGN	
		DRAWN BY	
		CHECKED BY	

SCALE: HORIZONTAL 1" = 20'
VERTICAL 1" = 5'