

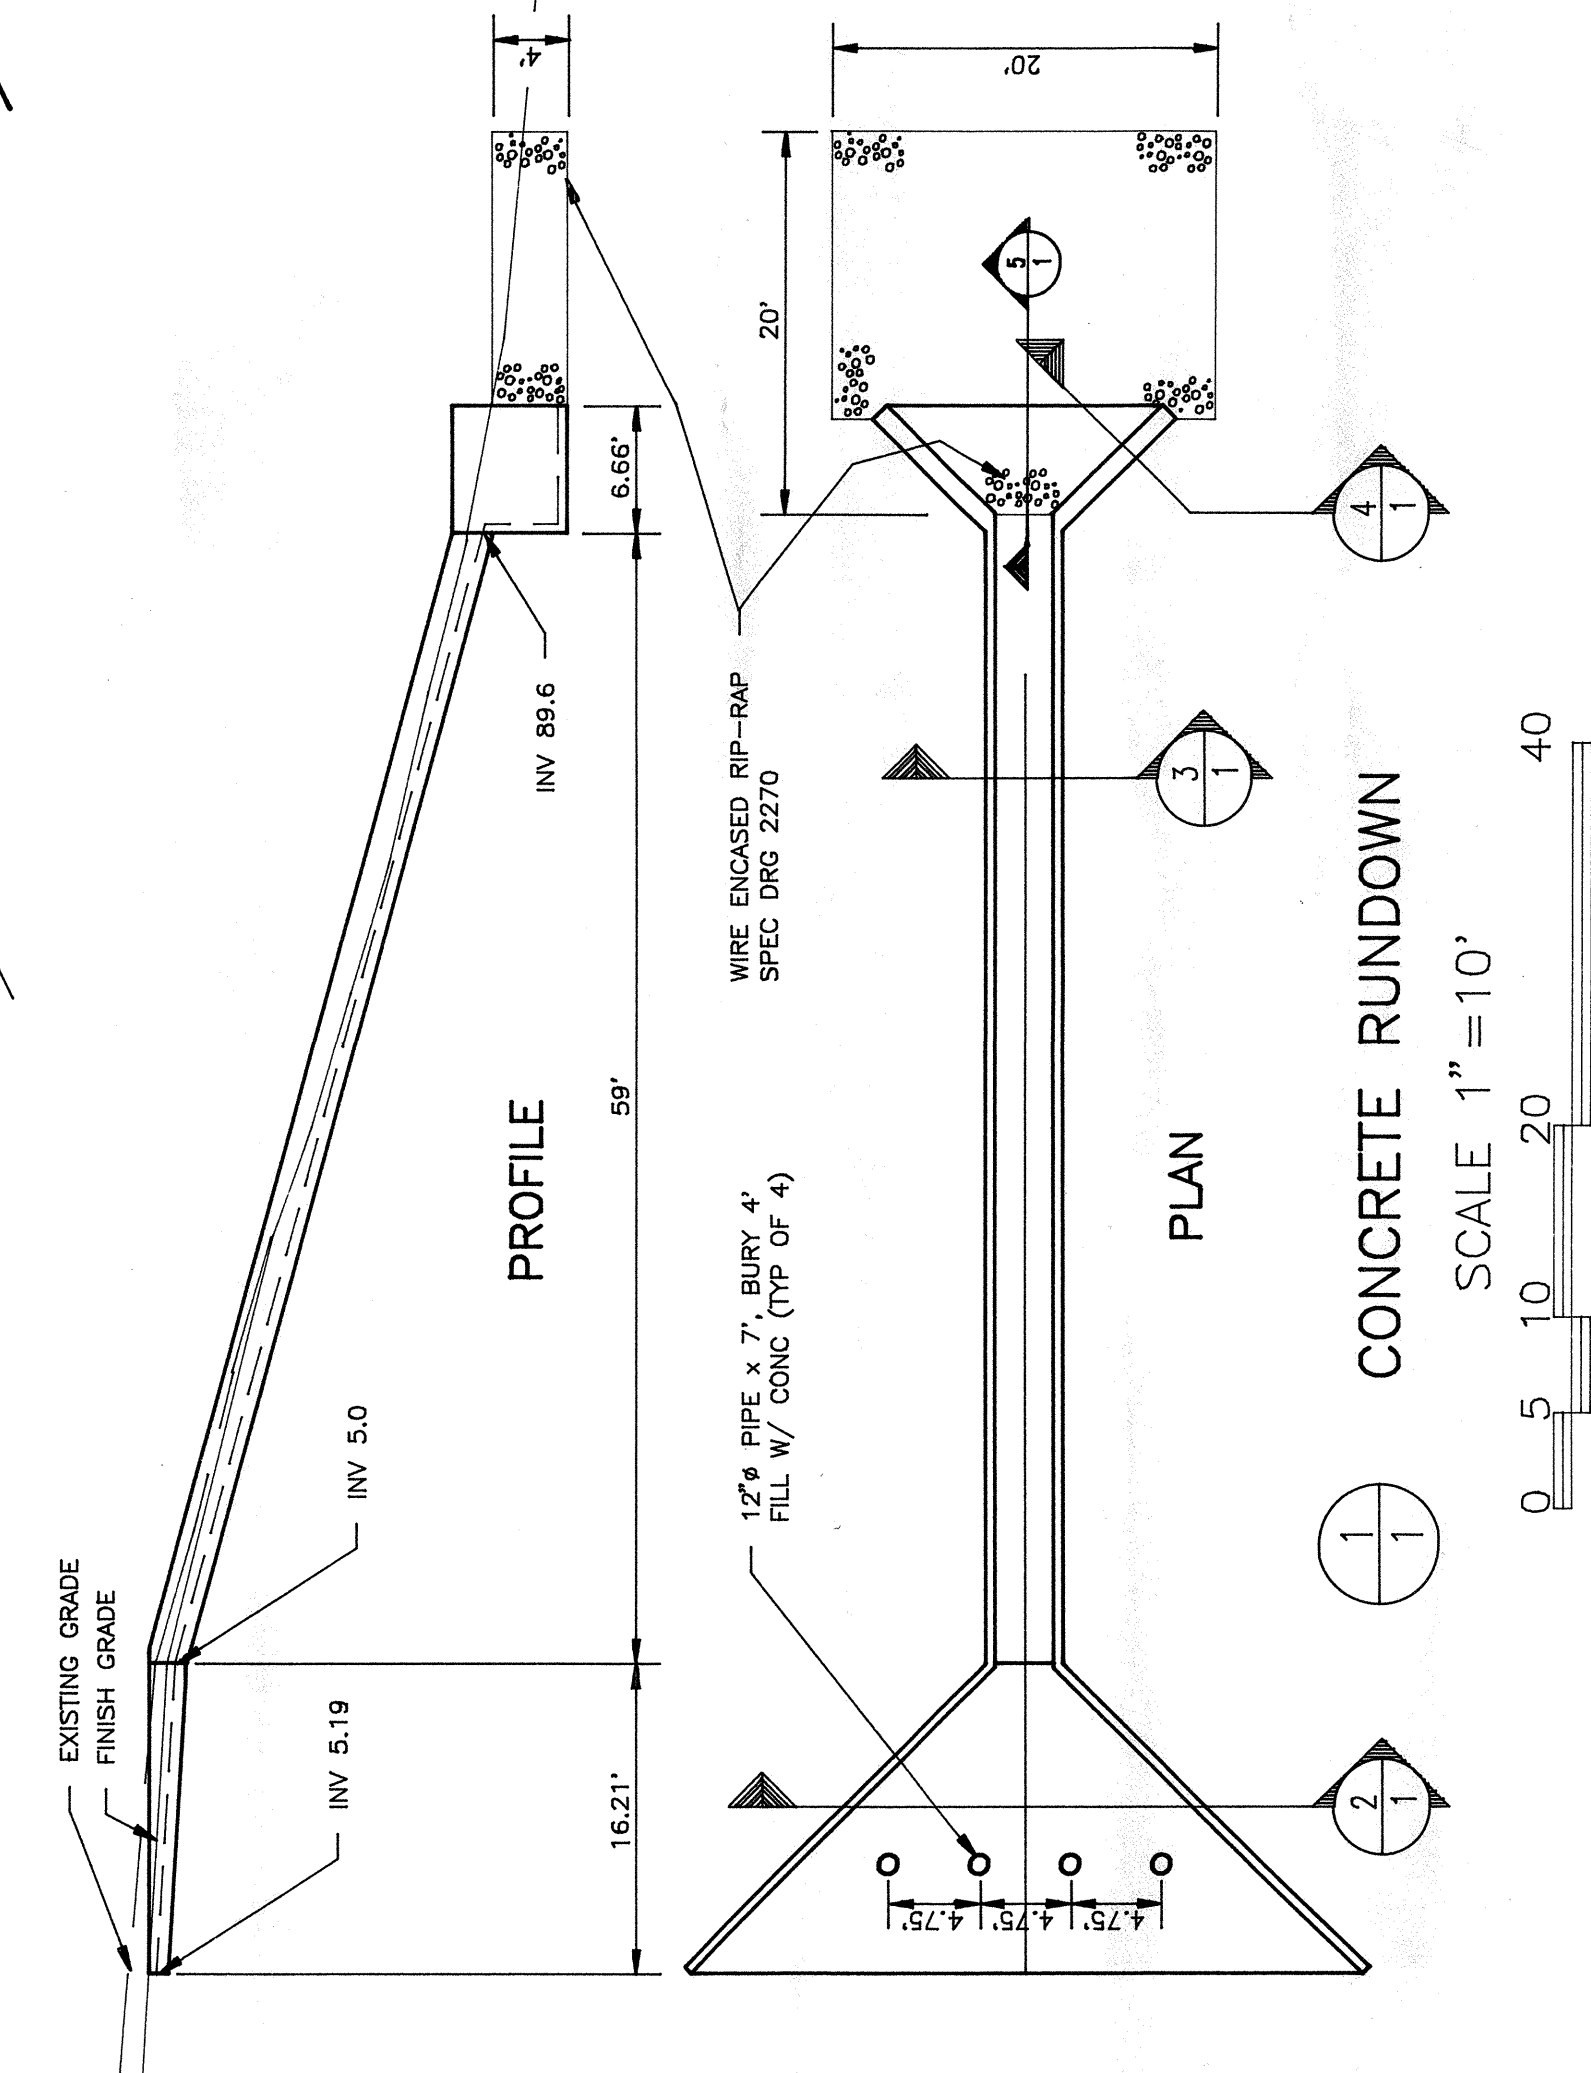


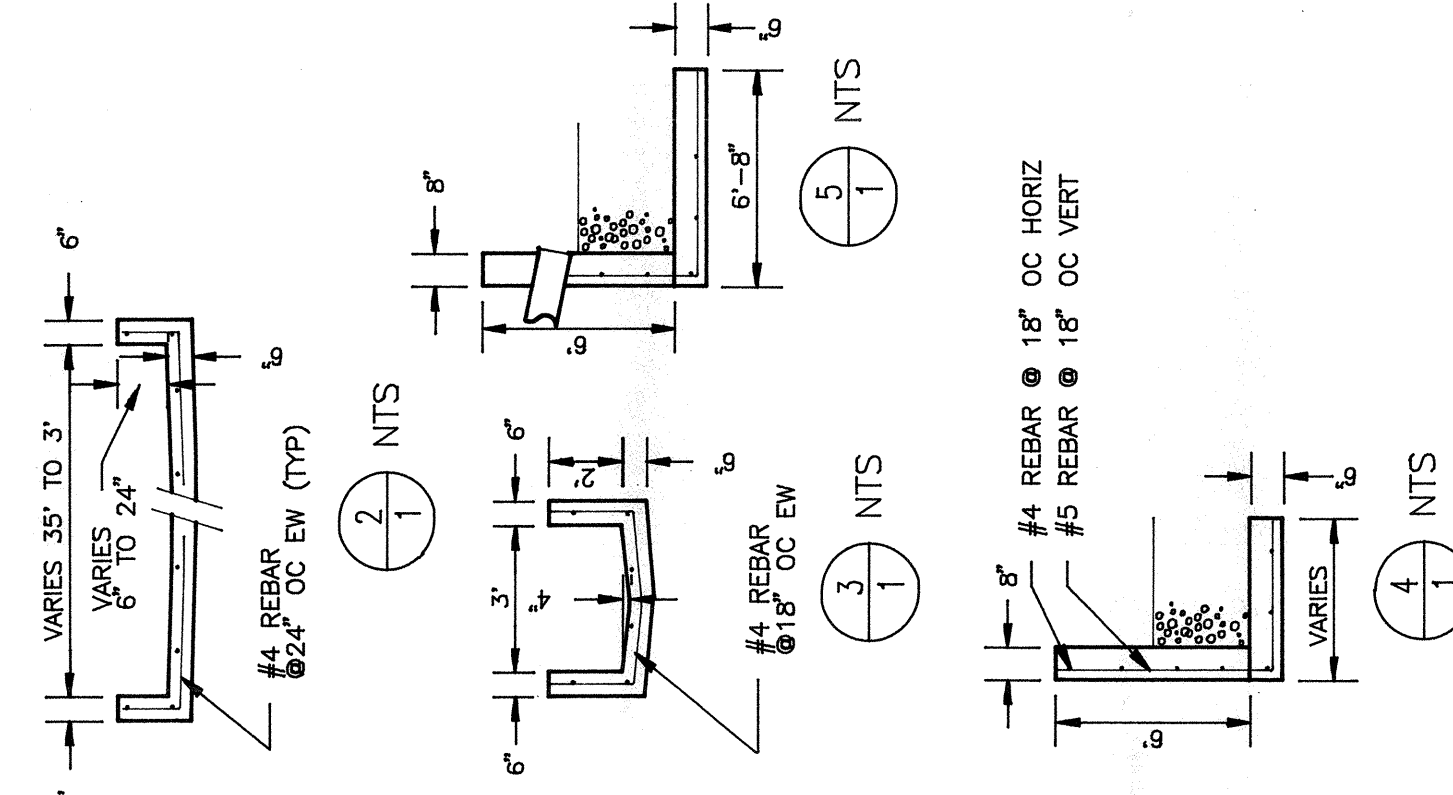

REV	SHEETS	CITY ENGR.	DATE	USER DEPT.	DATE	USER DEPT.	DATE

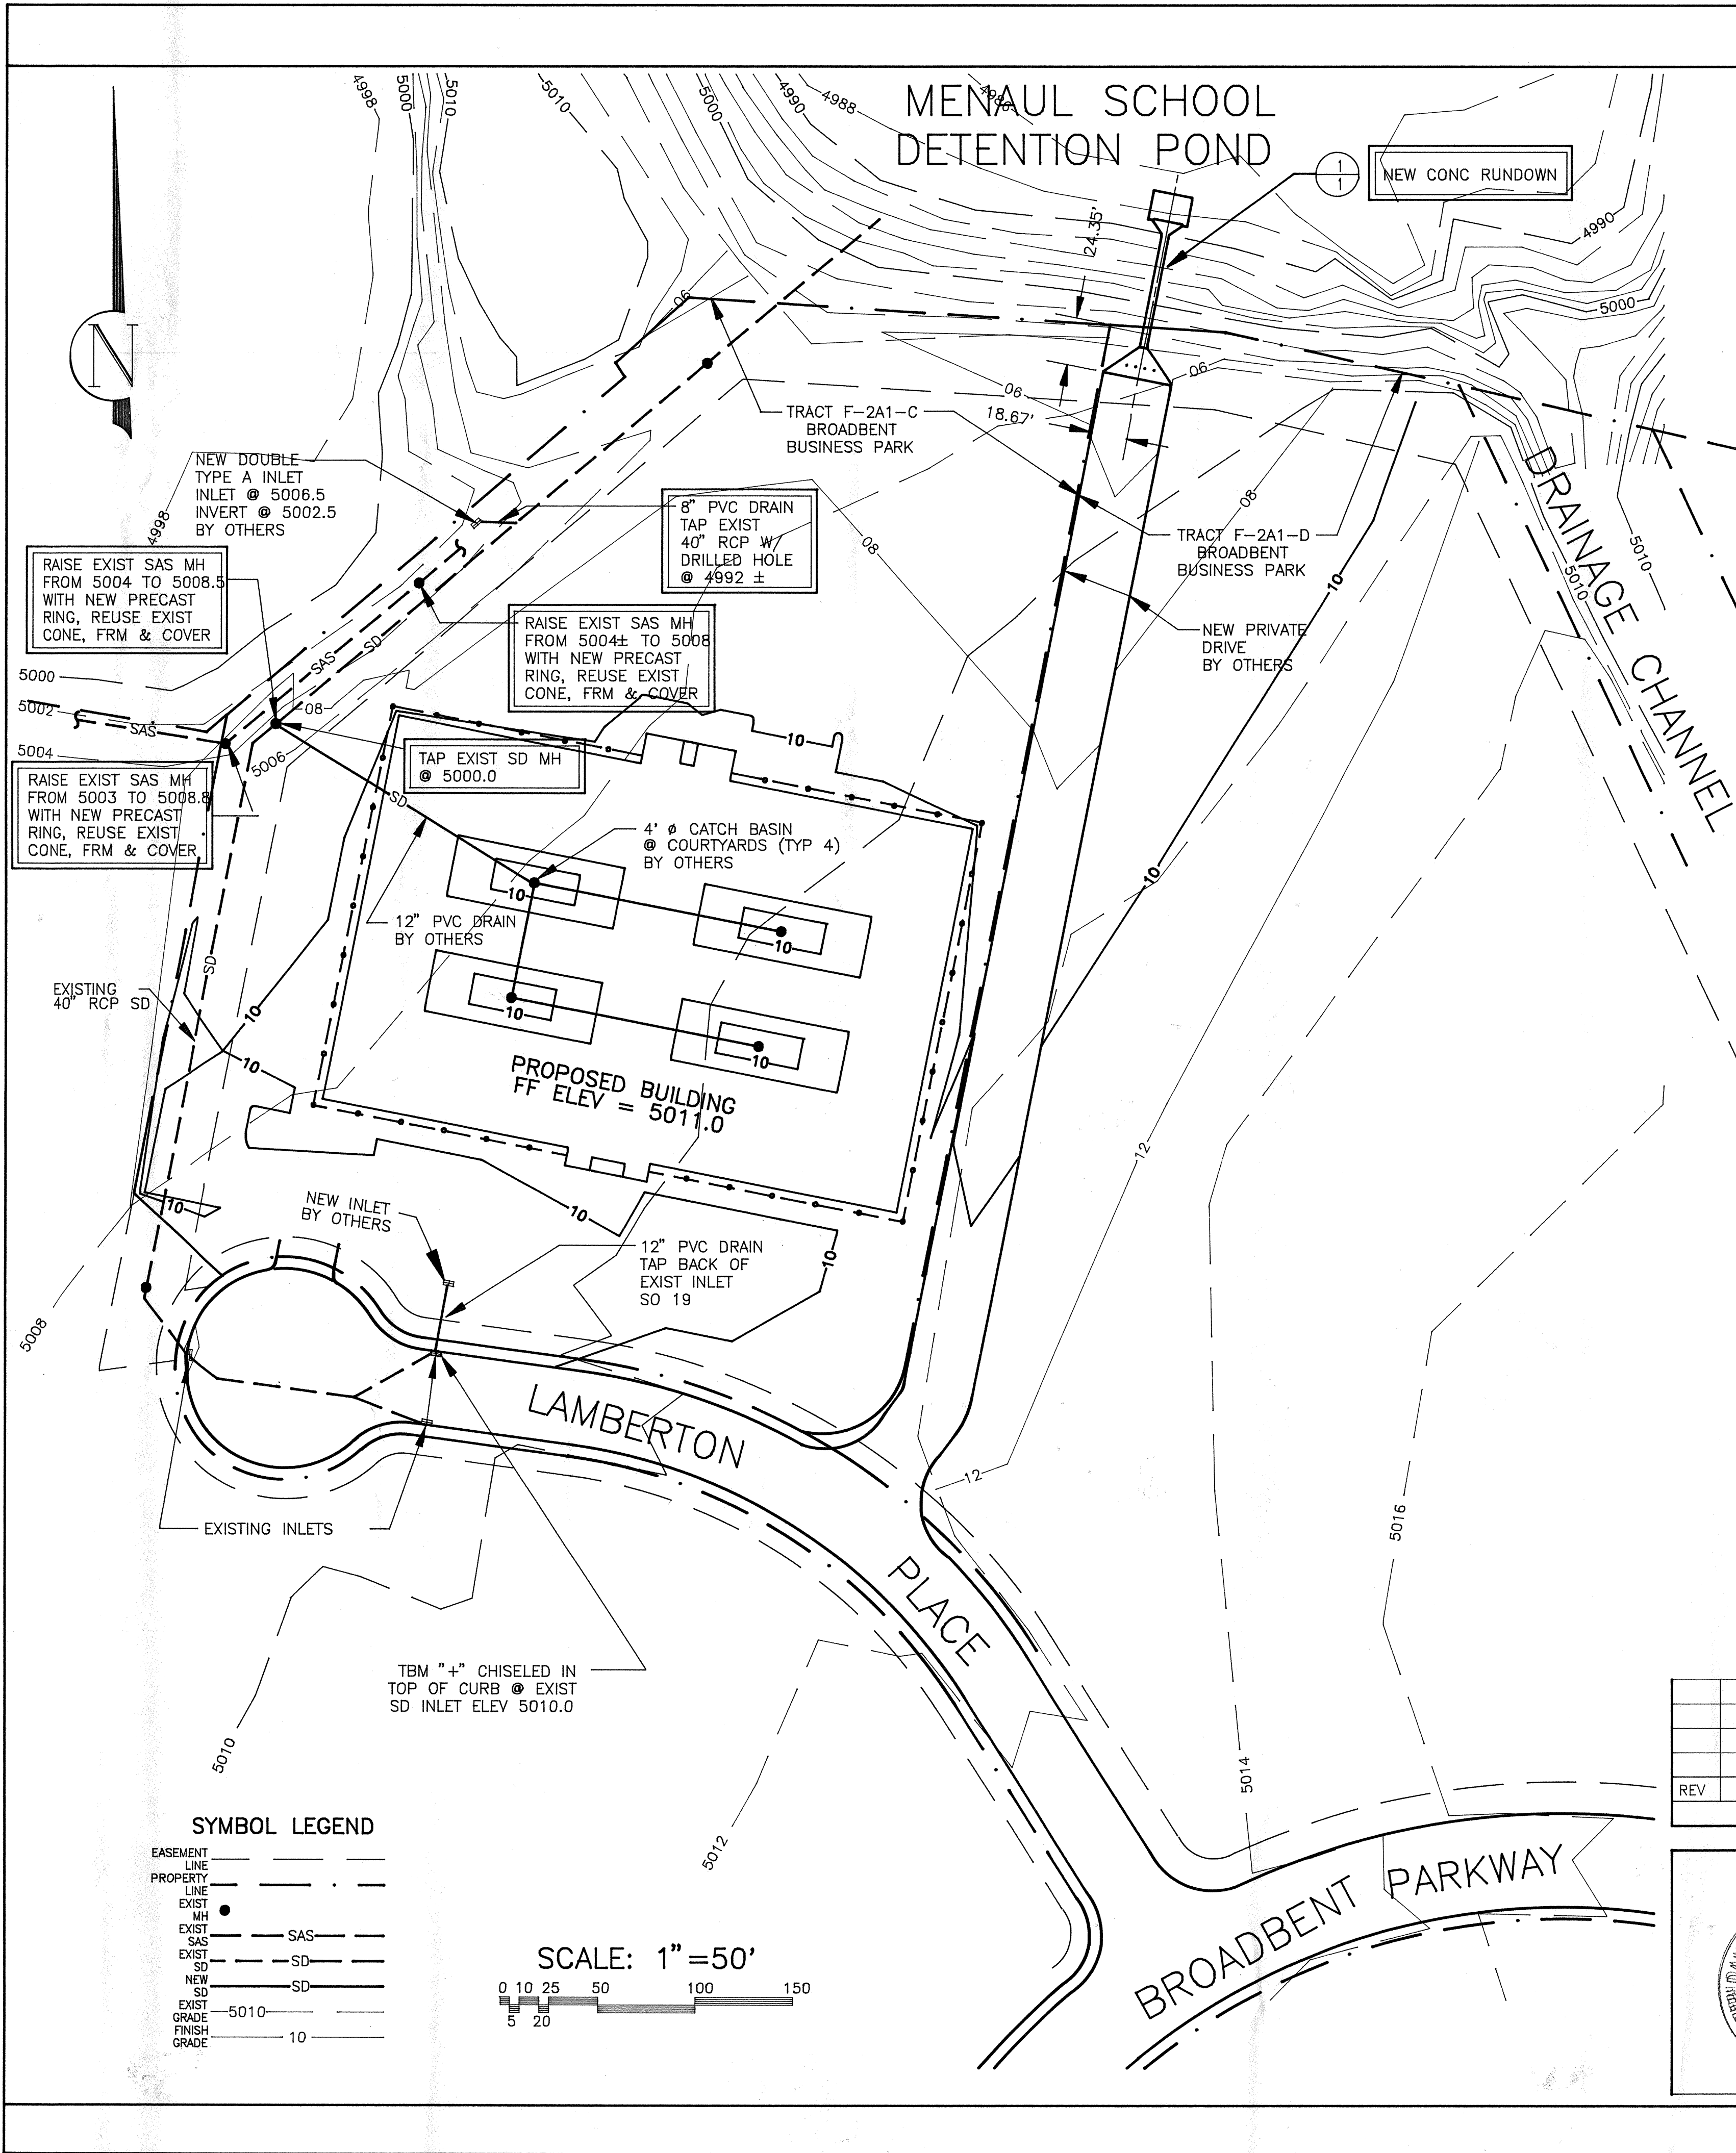

DAN ARMSTRONG, PE

P.O. BOX 25722

ALBUQUERQUE, NM 87125


842-5992

APPROVED FOR CONSTRUCTION

[Signature]

6-10-91

SHEET 1 OF 1

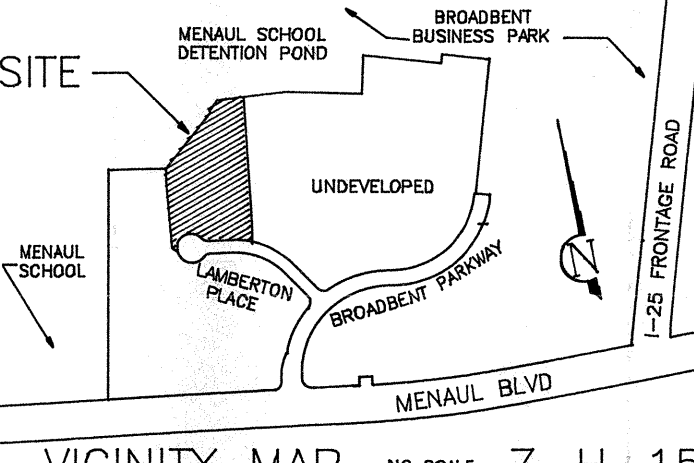

VICINITY MAP NO. SCALE Z-H-15

NOTES:

ALL WORK DETAILED ON THESE PLANS TO BE PERFORMED UNDER CONTRACT SHALL BE CONSTRUCTED IN ACCORDANCE WITH THE CITY OF ALBUQUERQUE STANDARD CONTRACT FOR PUBLIC WORKS CONSTRUCTION, 1996 EDITION.

TWO (2) WORKING DAYS PRIOR TO ANY EXCAVATION, CONTRACTOR MUST CONTACT LINE LOCATING SERVICE, 280-1990, FOR LOCATION OF EXISTING UTILITIES.

PRIOR TO CONSTRUCTION, THE CONTRACTOR SHALL EXCAVATE AND VERIFY THE HORIZONTAL AND VERTICAL LOCATIONS OF ALL OBSTRUCTIONS SHOULD A CONFLICT EXIST, THE CONTRACTOR SHALL NOTIFY THE ENGINEER OR SURVEYOR SO THAT THE CONFLICT CAN BE RESOLVED WITH A MINIMUM AMOUNT OF DELAY.

BACKFILL AND COMPACTION SHALL BE 95% PER ASTM D1557

THIS WORK ORDER INCLUDES:

CONCRETE RUNDOWN CHANNEL TO MENAUL SCHOOL RETENTION POND

TAPPING OF EXIST SD MH

TAPPING OF EXIST 40" RCP SD

RAISING RIM OF 2 EXISTING SAS MH'S

RAISING RIM OF 1 EXISTING SD MH

AS BUILT INFORMATION

CONTRACTOR *[Signature]* MECHANICAL

DATE *4/4/91*

INSPECTOR'S SIGNATURE *[Signature]* DATE *7/3/91*

VERIFICATION BY *[Signature]* DATE *10/3/91*


CORRECTED BY *[Signature]* DATE *10/3/91*

MICRO-FILM INFORMATION

RECORDED BY *[Signature]* DATE

NO. DATE

ENGINEER'S SEAL

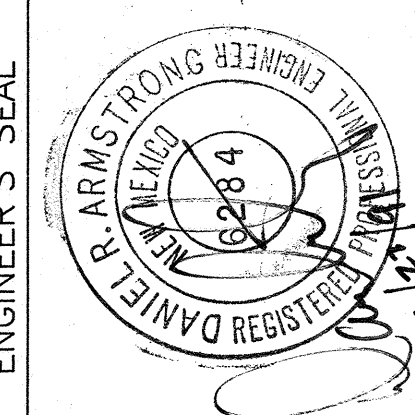

DESIGNED BY D. ARMSTRONG DATE 2/1/91

DRAWN BY D. ARMSTRONG DATE 2/1/91

CHECKED BY D. ARMSTRONG DATE 2/1/91

CITY OF ALBUQUERQUE

PUBLIC WORKS DEPARTMENT

ENGINEERING GROUP

TITLE: 1991 DRAINAGE IMPROVEMENTS BROADBENT BUSINESS PARK

APPROVALS	ENGINEER	DATE	APPROVALS	ENGINEER	DATE
D.R.C. Chair	<i>[Signature]</i>	3/22/91			
Trans. Dev.	<i>[Signature]</i>	3-22-91			
Utility Dev.	<i>[Signature]</i>	3/18/91			
Hydrology	<i>[Signature]</i>	3/1/91			

DRAWING NO. 2697.92 MAP NO. H-15 SHEET 1 OF 1