

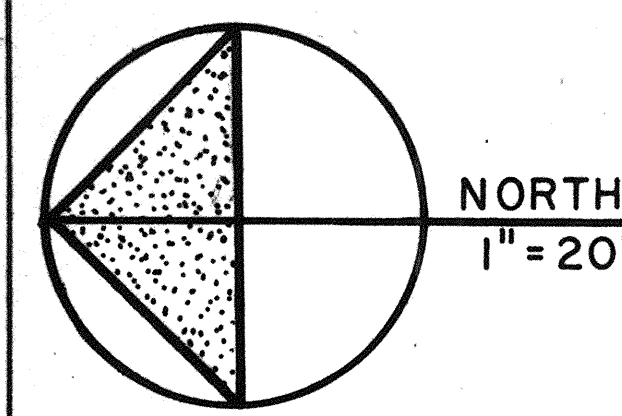


CITY OF ALBUQUERQUE
PAVING ALLEY
AND ESTATE TYPE STREETS
DWG. P-5-2
NOV. 1979

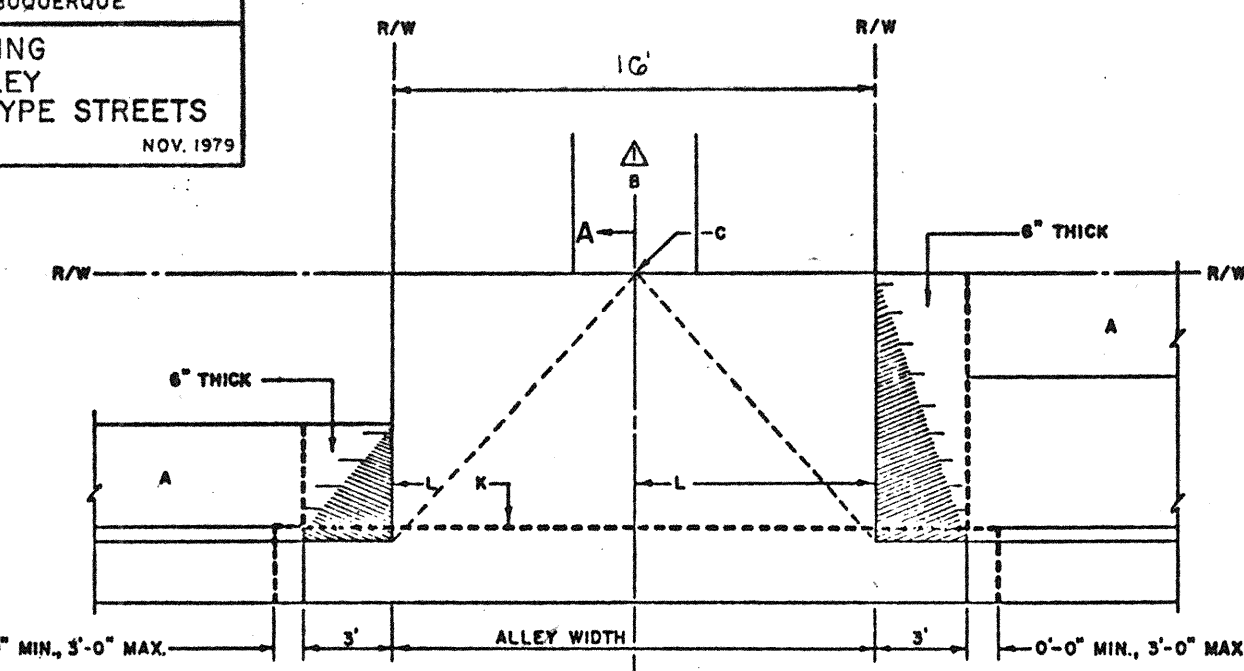

HUNING HIGHLAND ADD.
(PLAT FILED: MAY 12, 1887)

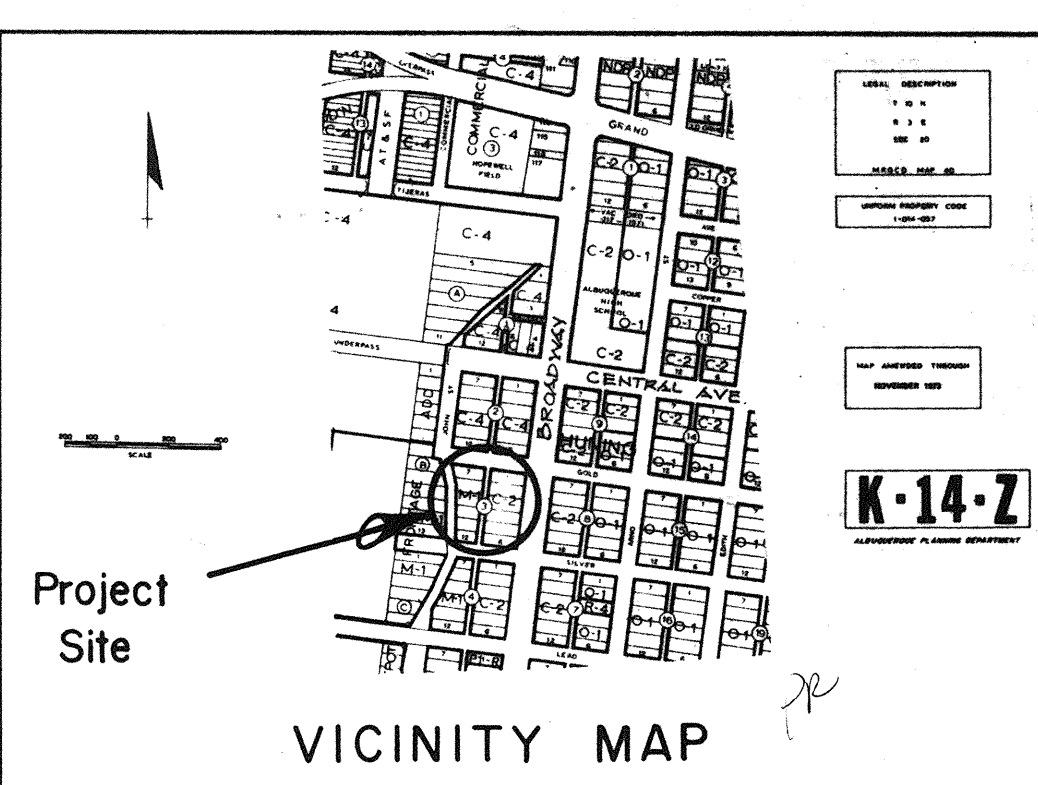

NOTICE TO CONTRACTORS


- 1) New Mexico Standard Specifications for Public Works Construction - 1979 Edition will be referred to here on as the "Standard Specifications."
- 2) All work detailed on these plans to be performed under contract shall, except as otherwise stated or provided herein, be constructed in accordance with "Contract Documents for City-Wide Utilities and Cash Paving No. 30 and the Standard Specifications."
- 3) Two working days prior to any excavation, contractor must contact Line Locating Service, 765-1234, for location of existing utilities.
- 4) Prior to construction, the contractor shall excavate and verify the horizontal and vertical locations of all obstructions. Should a conflict exist, the contractor shall notify the engineer or surveyor so that the conflict can be resolved with minimum of delay.

NOTES: (WHEN APPLICABLE)

- GENERAL NOTES:
1. MIN. ELEVATION AT PROPERTY LINE SHALL BE EQUIVALENT TO CENTER LINE ELEVATION OF PAVED STREET.
 2. FOR HEAVY COMMERCIAL OR INDUSTRIAL ALLEYS, USE ARTERIAL PAVING, SEE DWG. P-4.
 3. FOR RESIDENTIAL OR LIGHT COMMERCIAL ALLEYS, USE RESIDENTIAL PAVING, SEE DWG. P-2.
 4. DETAILS OF DITCH AND SIDEWALK CONFIGURATIONS WILL BE DEFINED ON CONSTRUCTION PLANS.
 5. FOR PAVING SECTIONS, SEE DWG. P-7.
 6. SIDEWALK LOCATIONS TO BE APPROVED BY THE CITY ENGINEER.
- CONSTRUCTION NOTES:
- A. SEE NOTE 1.
 - B. SEE NOTE 4.
 - C. ESTATE TYPE MOUNTABLE CURB, SEE DWG. P-8.
 - D. 3" ASPHALTIC CONCRETE, SEE DWG. P-7.
 - E. 6" COMPACTED SUBGRADE.
 - F. 6" COMPACTED SUBGRADE.
 - G. 4" x 12" P.C. CUT-OFF WALL.
 - H. 3" INVERTED CROWN, UNLESS OTHERWISE DIRECTED OR REQUIRED TO MATCH EXIST. PAVEMENT.
 - I. SEE NOTES 2 AND 3.
 - J. 6" PORTLAND CEMENT CONC.
 - K. 2" x 8" REDWOOD, MAY BE USED AS ALTERNATE TO G.

CONSTRUCTION NOTES:

- A. SIDEWALK.
- B. ALLEY CUTTER.
- C. TRANSITION FROM 3" INVERTED ALLEY CROWN TO NO CROWN AT BACK OF CURB.
- D. TOP OF CURB.
- E. 3" INVERTED CROWN.
- F. TOP OF SIDEWALK 0.35' ABOVE TOP OF CURB AT PROPERTY LINE.
- G. CURB AND GUTTER.
- H. SLOPE TO BE ADJUSTED TO PROVIDE A UNIFORM TRANSITION BETWEEN DRIVEPAD AND SIDEWALK.
- I. DRIVEPAD, PORTLAND CEMENT CONCRETE.
- J. WEAKENED PLANE (SAW CUT OR SCORE TO 1/2 OF DEPTH OF SLAB).

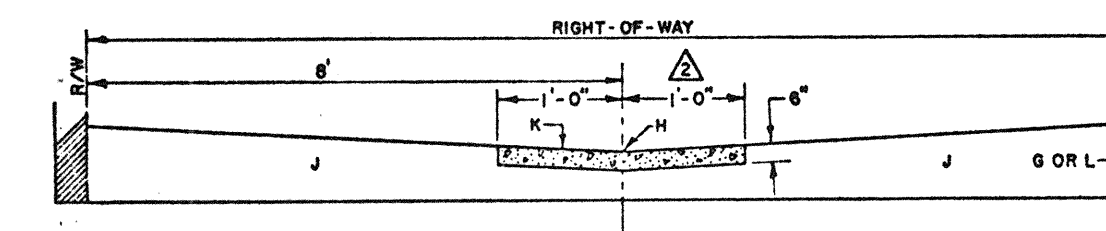


ALLEY SECTION

KEYED NOTES:

1. Verify location of existing MH & adjust to grade.


SCALE: HORIZONTAL = 1" = 20'
VERTICAL = 1" = 2.0'

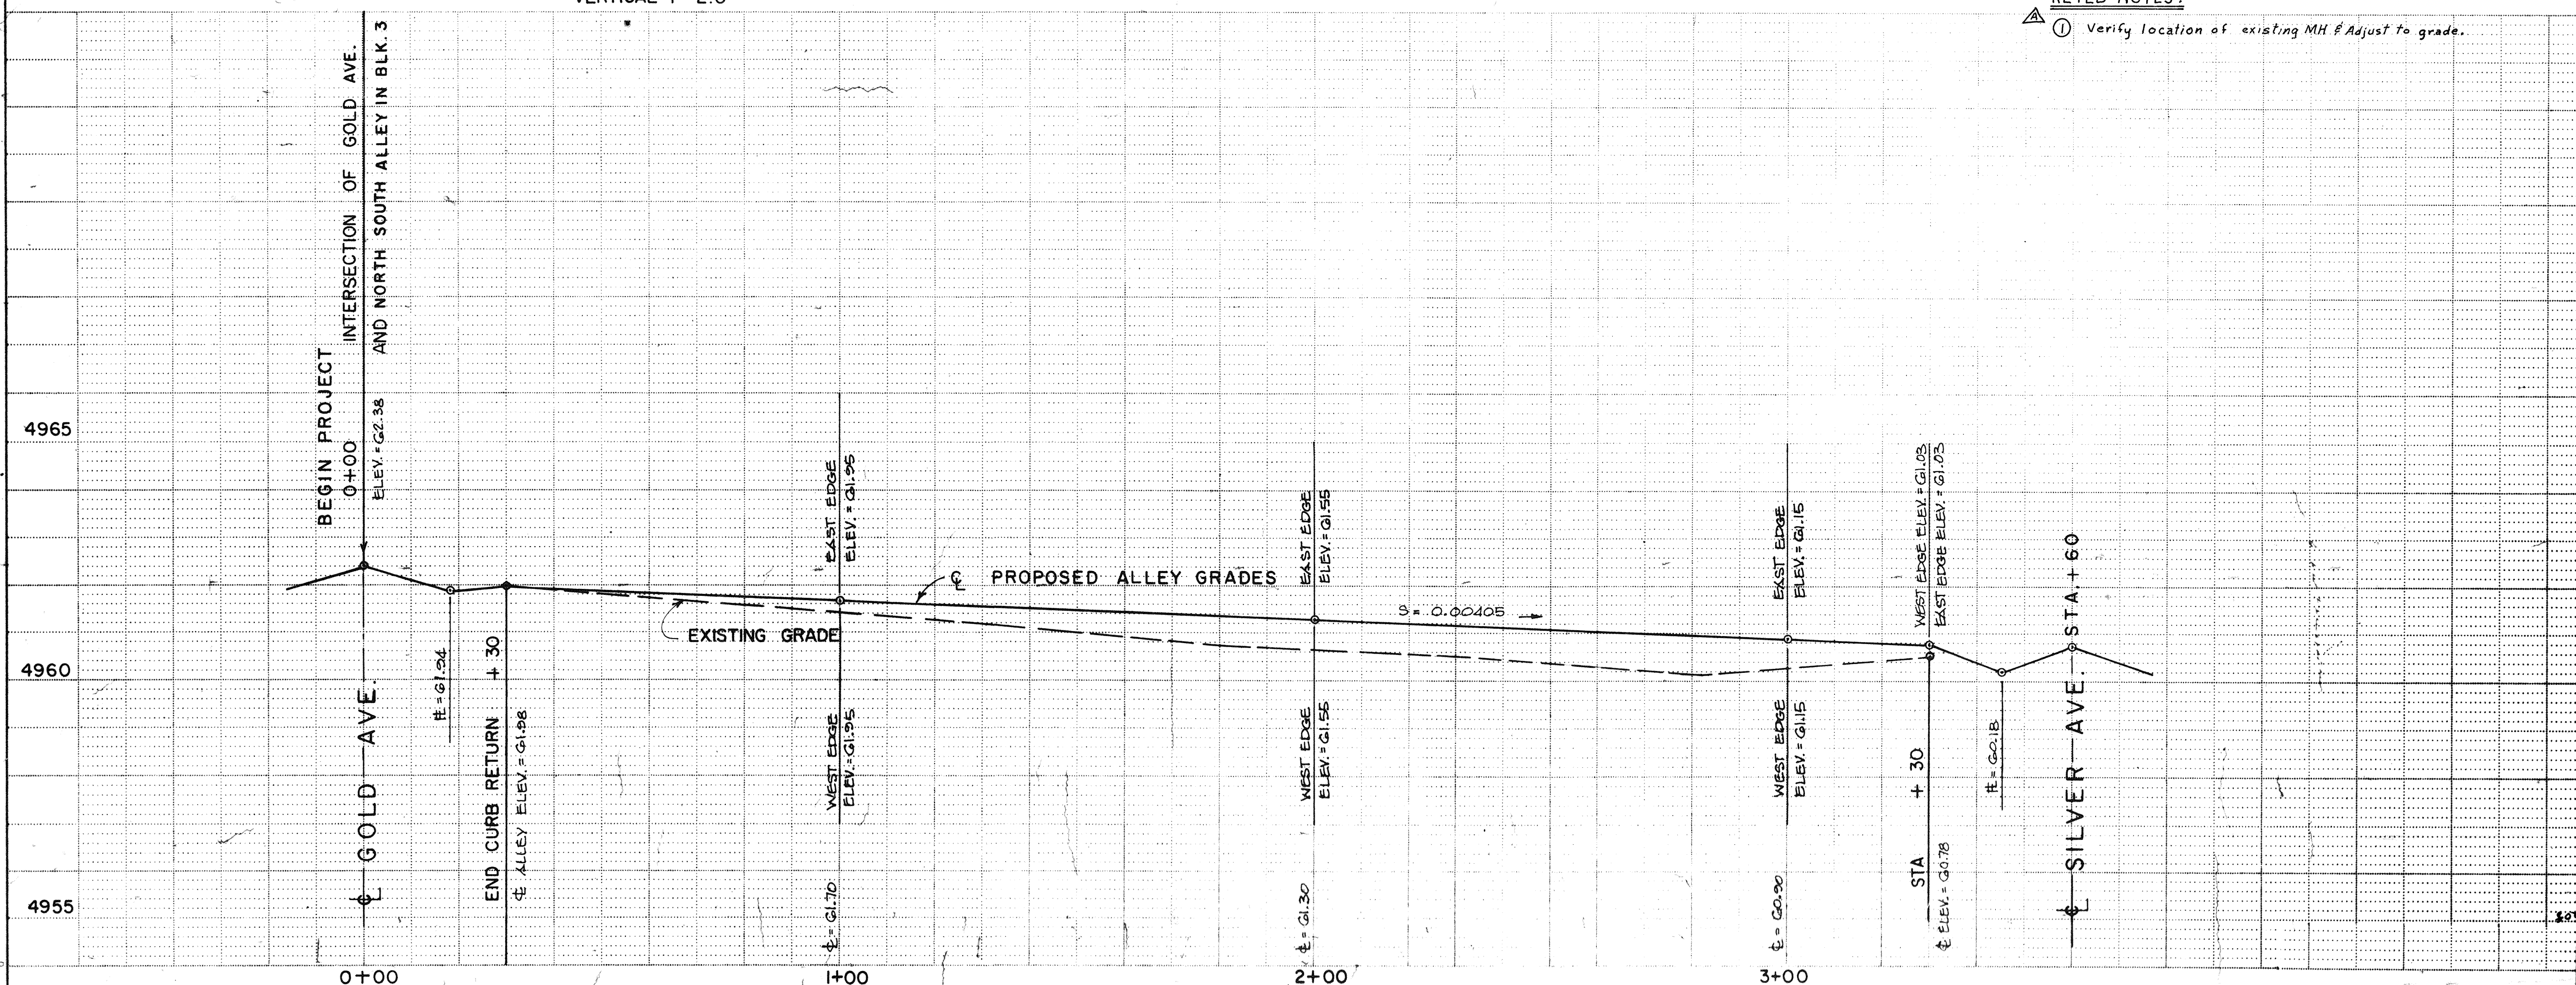

THE FOLLOWING NOTES APPLY WHEN CHECKED:

- ☐ All utilities and utility service lines shall be installed prior to paving.
- ☒ Backfill compaction shall be according to specified street use.
- ☒ Tack coat requirements shall be determined by the City Engineer.
- ☐ Sidewalks and wheelchair ramps within the curb returns shall be constructed whenever a new curb return is constructed.
- ☐ If curb is depressed for a driveway, the driveway shall be constructed prior to acceptance of the curb and gutter.
- ☐ All storm drain facilities shall be completed prior to final acceptance.

BENCH MARKS		AS BUILT INFORMATION	
MEAN SEA LEVEL ELEVATIONS WERE DETERMINED FROM CITY	CONTRACTOR	WORKED BY	DATE
OF ALBUQUERQUE BENCH MARK NO. 11-K14 LOCATED AT THE INTERSECTION OF BROADWAY BLVD. AND SILVER AVE., S.E., IN THE SOUTHWEST QUADRANT OF THE INTERSECTION, (A SQUARE CHECKED ON TOP OF CONCRETE CURB AT THE SOUTH SOUTHWEST CURB RETURN), ELEVATION		INSPECTOR'S ACCEPTANCE BY	DATE
		VERIFICATION BY	DATE
		CORRECTED BY	DATE
		MICRO-FILM INFORMATION	RECORDED BY
			DATE
			NO
			4981.864

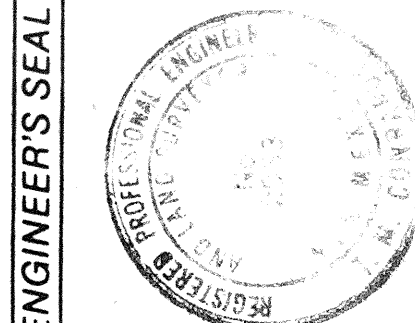

26 27 30 186

APPROVAL OF AS BUILT DRAWINGS
ASST. CITY ENGINEER FIELD
W. J. McNamee
DATE 1-15-86

APPROVED FOR GRADES ONLY

CITY OF ALBUQUERQUE MUNICIPAL DEVELOPMENT DEPARTMENT ENGINEERING DIVISION					
TITLE: PROPOSED GRADING OF NORTH-SOUTH ALLEY LOCATED IN BLOCK 3, HUNING HIGHLAND ADDITION, ALBUQUERQUE, NEW MEXICO					
APPROVALS	ENGINEER	DATE	APPROVALS	ENGINEER	DATE
City Engineer	W. J. McNamee	12-2-85	Liquid Waste	B. K. P. 11/17/85	
A.C.E. - Design			Traffic	B. K. P. 11/17/85	
A.C.E. - Hydrology			Water	B. K. P. 11/17/85	
DESIGNED BY E.R. & ASSOCIATES			DATE 7-10-82		
DRAWN BY G.T.R.			DATE 7-10-82		
CHECKED BY J.F.E.			DATE 7-10-82		
DRAWING NO.	2713		MAP NO.	K-14	
			SHEET	1	OF 1