




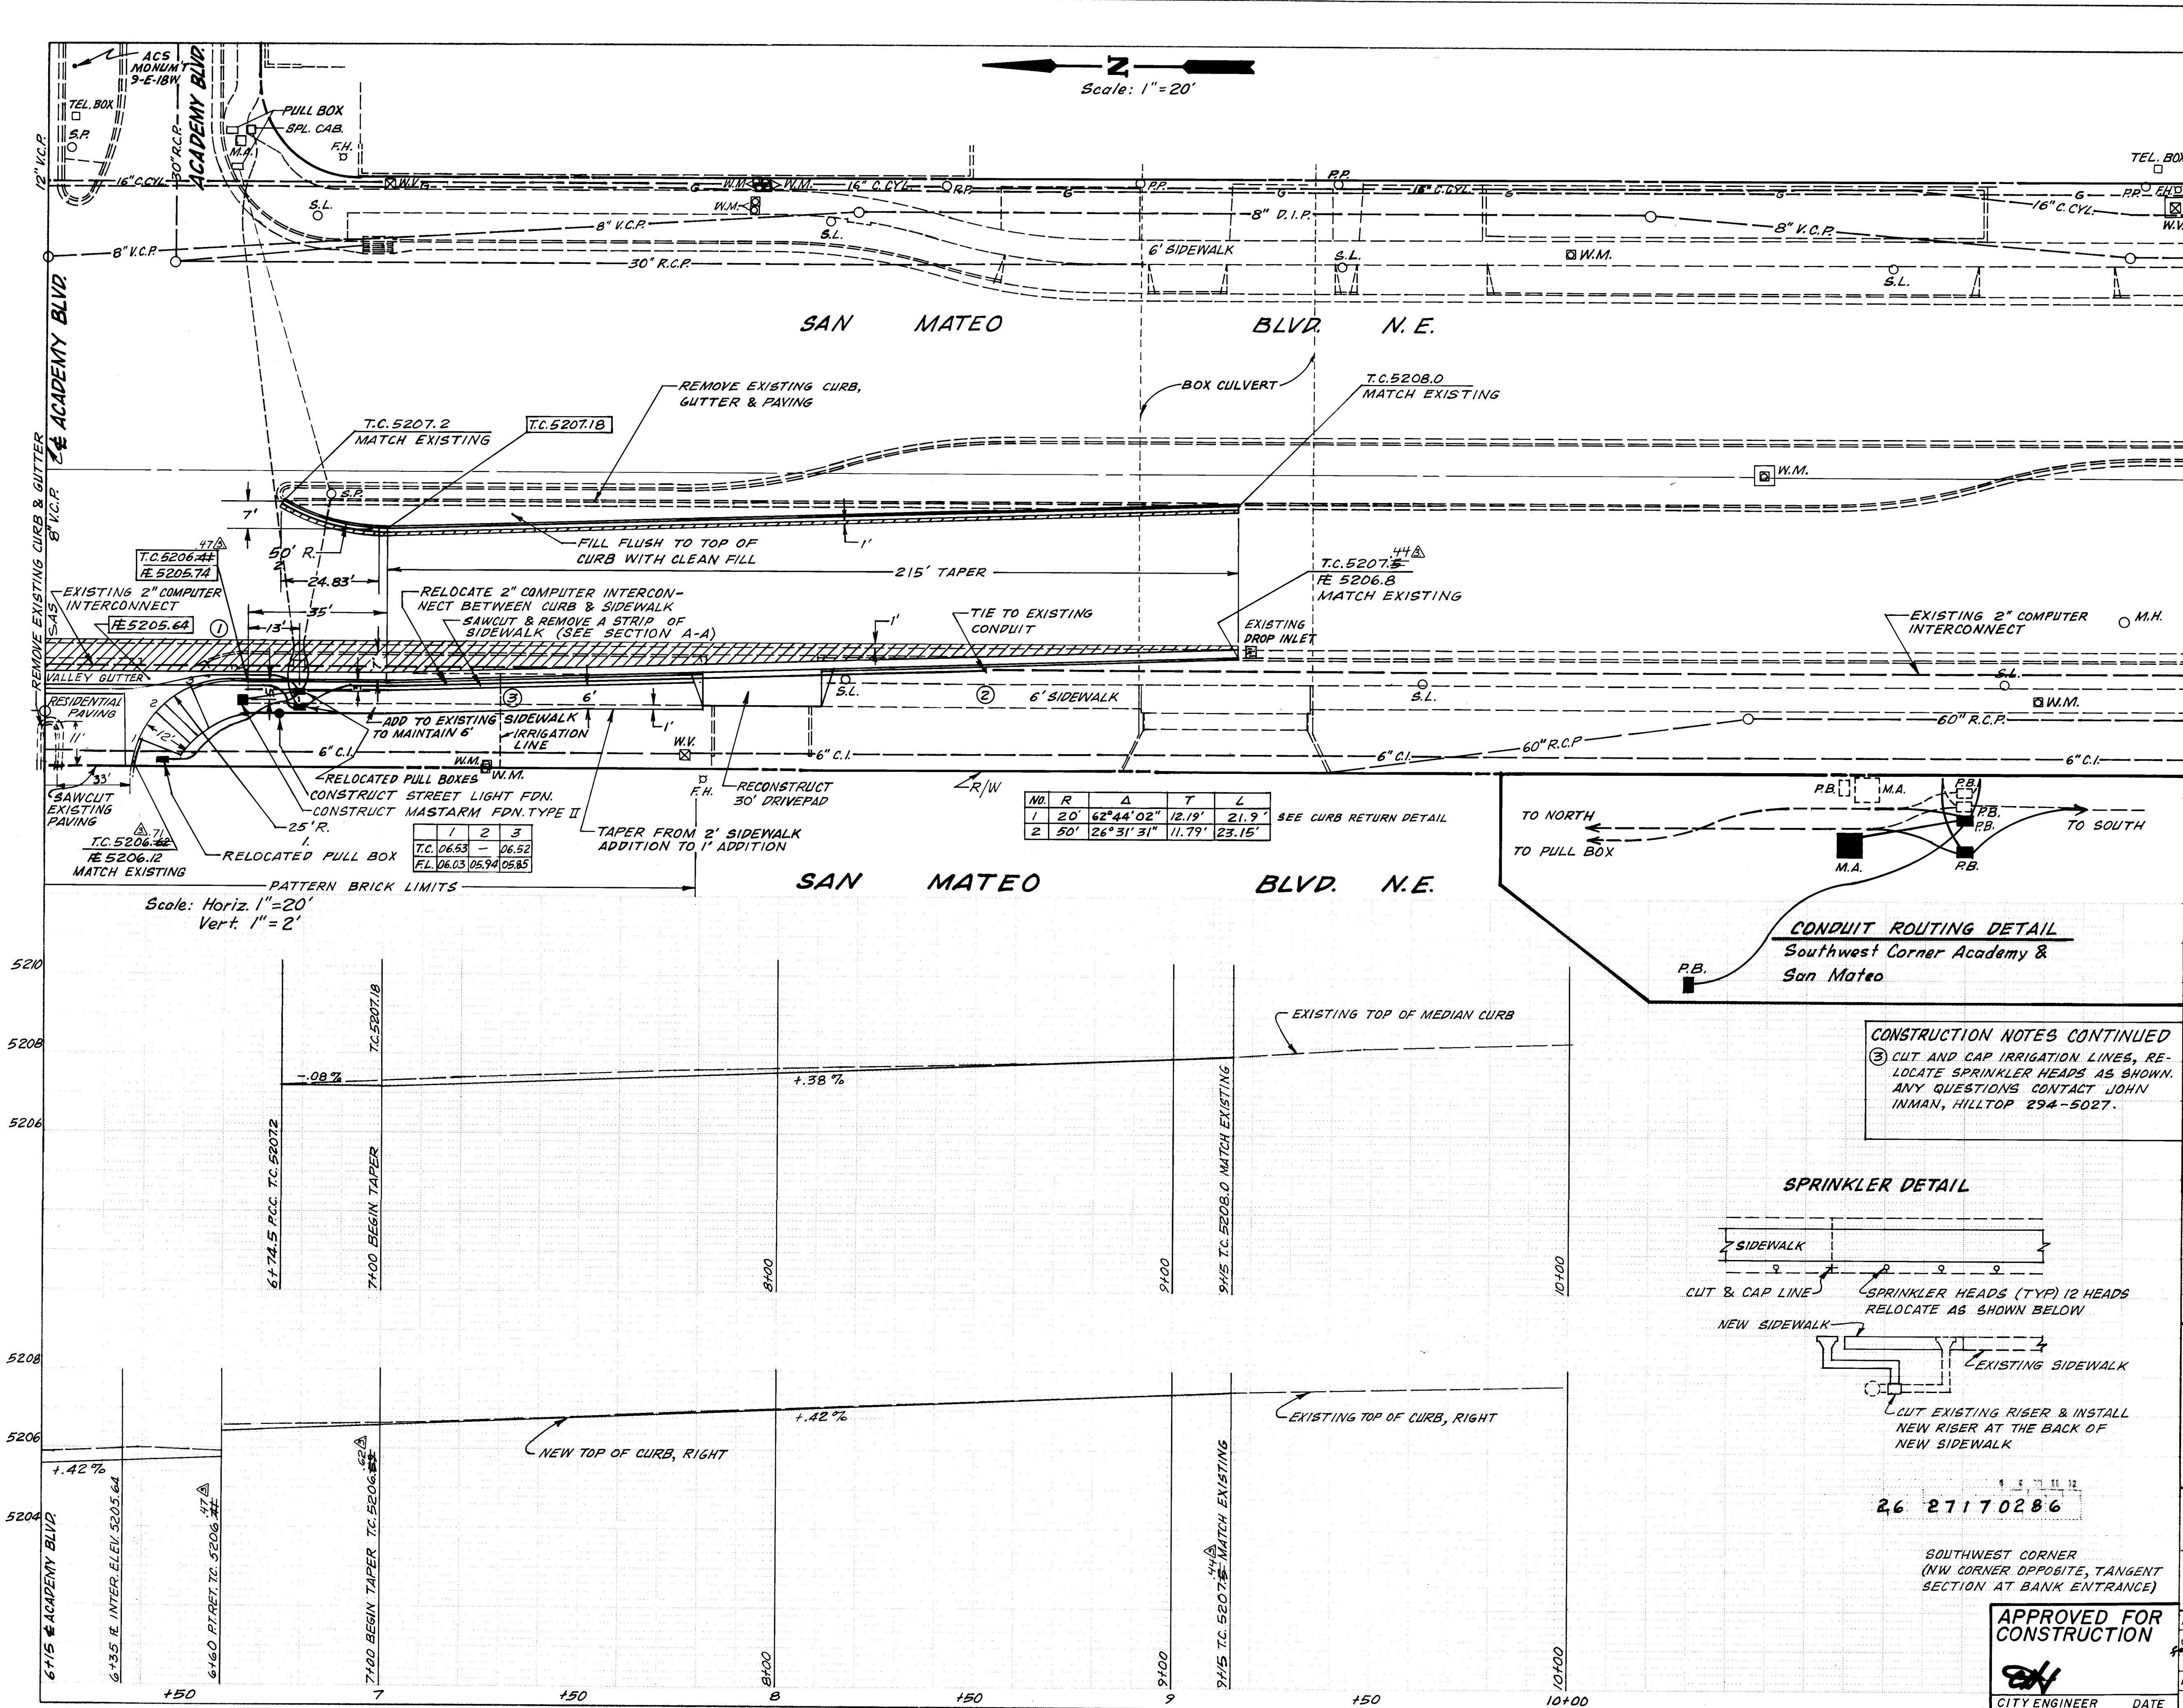

### TRAFFIC HANDLING NOTES

- CONTRACTOR MUST SUBMIT A CONSTRUCTION SIGNING AND BARRICADING PLAN TO TRAFFIC ENGINEERING DIVISION AND RECEIVE A BARRICADING PERMIT PRIOR TO CONSTRUCTION.
- ALL CONSTRUCTION SIGNING AND BARRICADING TO COMPLY WITH MANUAL ON UNIFORM TRAFFIC CONTROL DEVICES, 1978 EDITION AND SUBSEQUENT REVISIONS.
- CONTRACTOR'S OPERATION, BARRICADING AND SIGNING SHALL NOT AFFECT THRU LANES OF SAN MATEO BETWEEN 7 AM AND 9 AM OR 4 PM AND 6 PM.
- ACCESS TO ALL PROPERTIES MUST BE MAINTAINED AT ALL TIMES.

### Foundation Detail - Arterial Street Light

CONSTRUCTION NOTES CONTINUED

③ CUT AND CAP IRRIGATION LINES, RELOCATE SPRINKLER HEADS AS SHOWN. ANY QUESTIONS CONTACT JOHN INMAN, HILLTOP 294-5027.

### SPRINKLER DETAIL

26 27170286

SOUTHWEST CORNER (NW CORNER OPPOSITE, TANGENT SECTION AT BANK ENTRANCE)

APPROVED FOR CONSTRUCTION

CITY ENGINEER DATE

### CONSTRUCTION NOTES

- REMOVE EXISTING MASTARM AND STREET LIGHT FOUNDATIONS.
- CONNECT NEW 2" CONDUIT TO EXISTING.

### LEGEND

- NEW CONC. MEDIAN CURB
- NEW STD. CONC. CURB
- CONCRETE MEDIAN PAVING
- NEW ARTERIAL PAVING
- EXISTING ELEVATIONS
- NEW ELEVATIONS

| NO. | DATE     | REVISIONS |
|-----|----------|-----------|
| 1   | 11/17/85 | DESIGN    |
| 2   | 11/17/85 | REMARKS   |

DESIGNED BY DAVID W. HARMON DATE 11-19-85  
DRAWN BY EUGENIA D. FEGETTE DATE 11-19-85  
CHECKED BY [Signature] DATE 11/17/85

CITY OF ALBUQUERQUE  
MUNICIPAL DEVELOPMENT DEPARTMENT  
ENGINEERING DIVISION

TITLE: **SAN MATEO - INTERSECTION WIDENING AT ACADEMY BLVD. N.E.**

| APPROVALS          | ENGINEER    | DATE    | APPROVALS    | ENGINEER    | DATE    |
|--------------------|-------------|---------|--------------|-------------|---------|
| City Engineer      | [Signature] | 2/10/86 | Liquid Waste | [Signature] | 1/22/86 |
| A.C.E. - Design    | [Signature] | 1/22/86 | Traffic      | [Signature] | 1/22/86 |
| A.C.E. - Hydrology | [Signature] | 1/22/86 | Water        | [Signature] | 1/22/86 |

DRAWING NO. **2717** MAP NO. **E-17,18** SHEET **2** OF **2**