


CITY OF ALBUQUERQUE NEW MEXICO

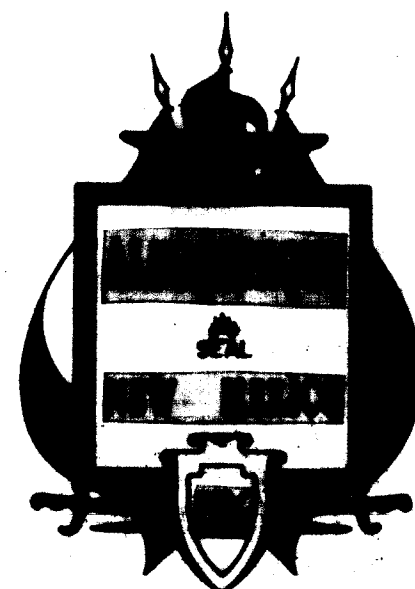


HUNTER'S RIDGE CONSTRUCTION DRAWINGS FOR:

- 12" DIA MASTERPLAN WATERMAIN
- 8" DIA FIRE PROTECTION WATERMAIN
- 8" DIA SANITARY SEWER MAIN

INDEX TO SHEETS

1. TITLE SHEET
2. PLAT SHEET
3. WATERMAIN PLAN & PROFILE SHEET
4. SANITARY SEWER PLAN & PROFILE

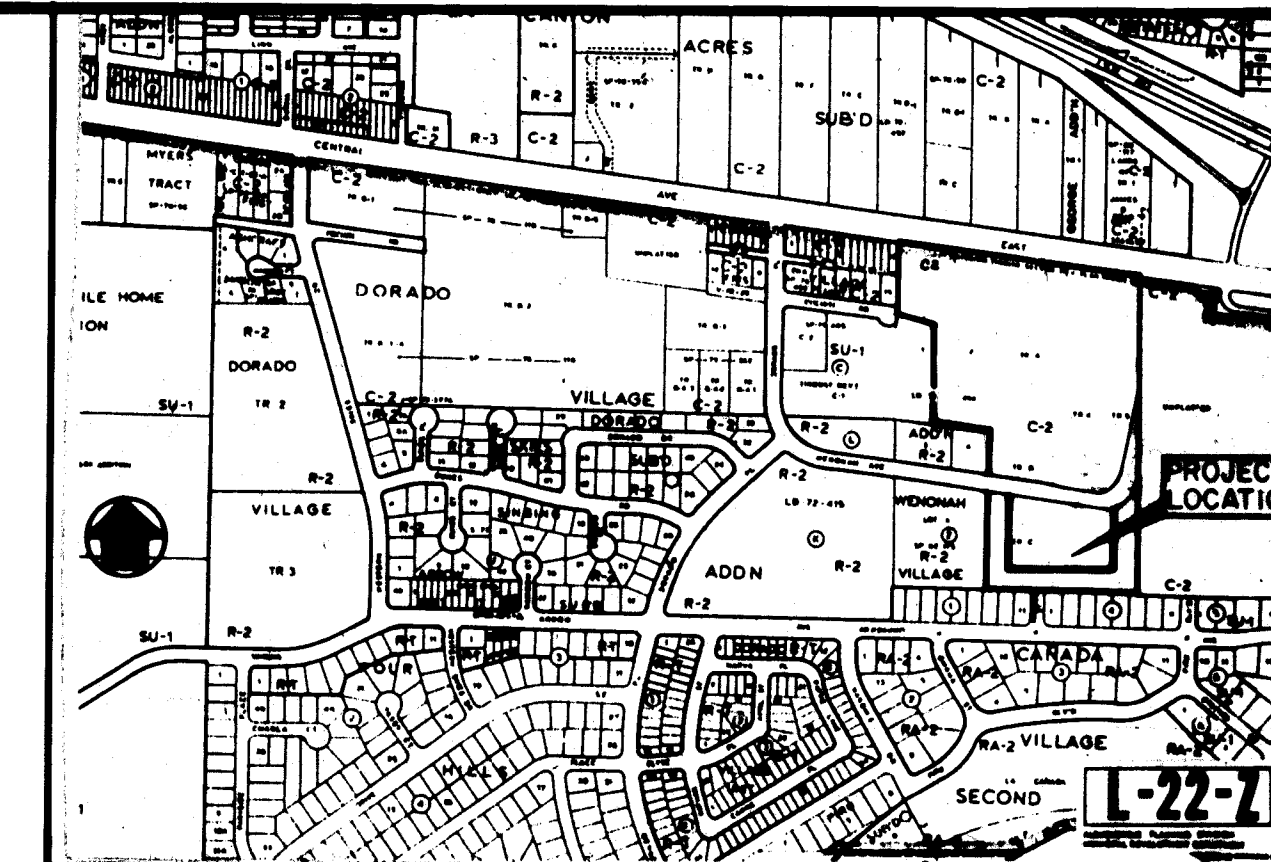

VICINITY MAP

GENERAL NOTES:

1. ALL WORK PERFORMED UNDER THIS CONTRACT SHALL BE IN ACCORDANCE WITH THE CITY OF ALBUQUERQUE INTERIM SPECIFICATION FOR PUBLIC WORK CONSTRUCTION - 1985.
2. TWO (2) WORKING DAYS PRIOR TO ANY EXCAVATION, CONTRACTOR MUST CONTACT LINE LOCATING SERVICE, 765-1234, FOR LOCATION OF EXISTING UTILITIES.
3. PRIOR TO CONSTRUCTION, THE CONTRACTOR SHALL EXCAVATE AND VERIFY THE HORIZONTAL AND VERTICAL LOCATION OF ALL OBSTRUCTIONS. SHOULD A CONFLICT EXIST, THE CONTRACTOR SHALL NOTIFY THE ENGINEER OR SURVEYOR SO THAT THE CONFLICT CAN BE RESOLVED WITH MINIMUM AMOUNT OF DELAY.
4. BACKFILL COMPACTION SHALL BE ACCORDING TO SPECIFIED STREET USE.

APPROVAL OF AS BUILT DRAWINGS
ASST. CITY ENGINEER - FIELD
<i>[Signature]</i>
DATE 10/1/86

1	2	3	4	5	6	7	8	9	10	11	12
2	6	2	7	2	5	0	1	8	6		

REV.	SHEETS	CITY ENGINEER	DATE	USER	DEPT.	DATE	USER	DEPT.	DATE
APPROVAL OF REVISIONS									

	PLANS PREPARED UNDER DIRECTION OF:	Santiago Romero Jr.	APPROVED FOR CONSTRUCTION <i>[Signature]</i> CITY ENGINEER
	and Associates Inc. ENGINEERING - SURVEYING 2020 12TH STREET N.W. SUITE B ALBUQUERQUE, NEW MEXICO 87107 (505) 346-2733		
PROJECT NO. 2725		SHEET 1 OF 4	

CENTRAL AVENUE EAST

98 32 27

FOUR HILLS VILLAGE
SHOPPING CENTER AND APARTMENT COMPLEX

CITY OF ALBUQUERQUE
BERNALILLO COUNTY, NEW MEXICO

JANUARY, 1985

TRACT A

TRACT C

TRACT D

TRACT H


TRACT B

TRACT G

WATER LINE EASEMENTS

DELEGATE TO THE CITY
OF ALBUQUERQUE
BY THIS PLAT
EXCEPT TR. E & F

Scale 1" = 100'

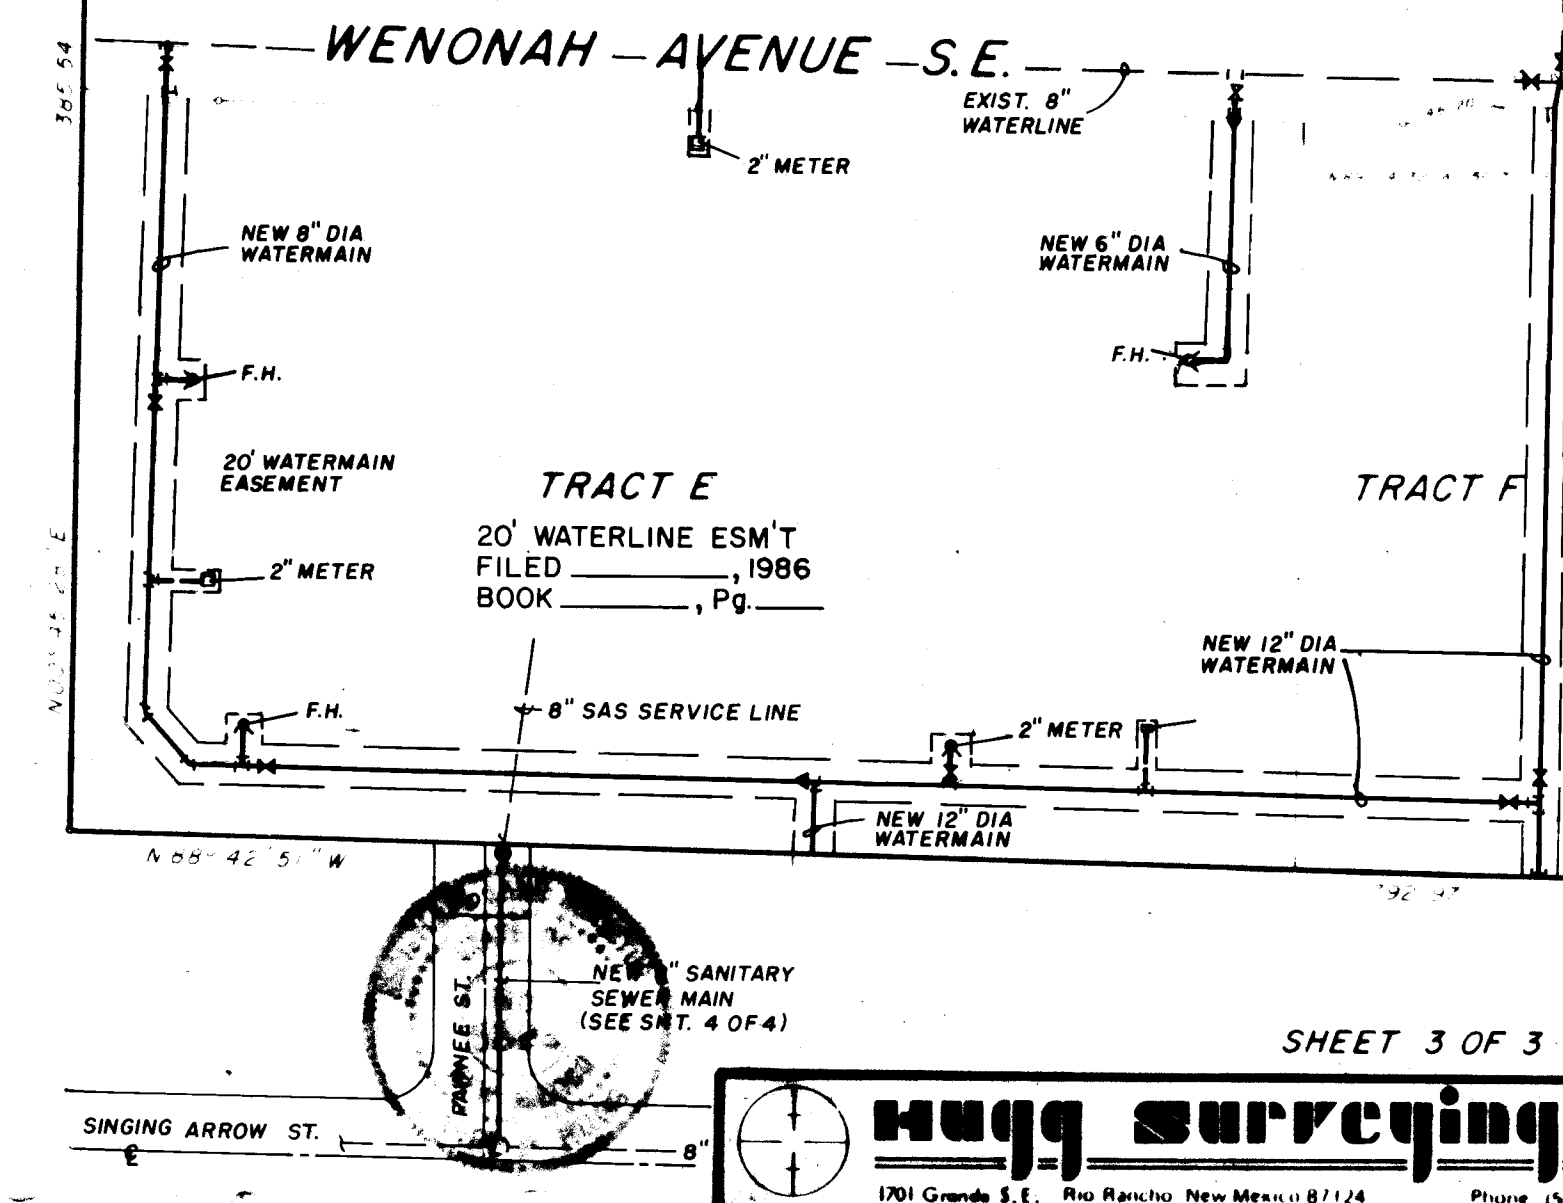

SHEET 3 OF 3

Hugg surveying co.
1701 Grande S.E. P.O. Box 871124 Albuquerque, N.M. 87114 Phone (505) 892-8800

LASON 1-505-344-9404
BEST COPY AVAILABLE

FOR CONTRACTOR INFORMATION ONLY

HUNTER'S RIDGE
8" & 12" DIA WATER LINE
& 8" DIA SANITARY SEWER


PLAT SHEET

2 6 2 7 2 5 0 2 8 6

BC-3C

DRAWING NO 2725

SHEET of
2 4

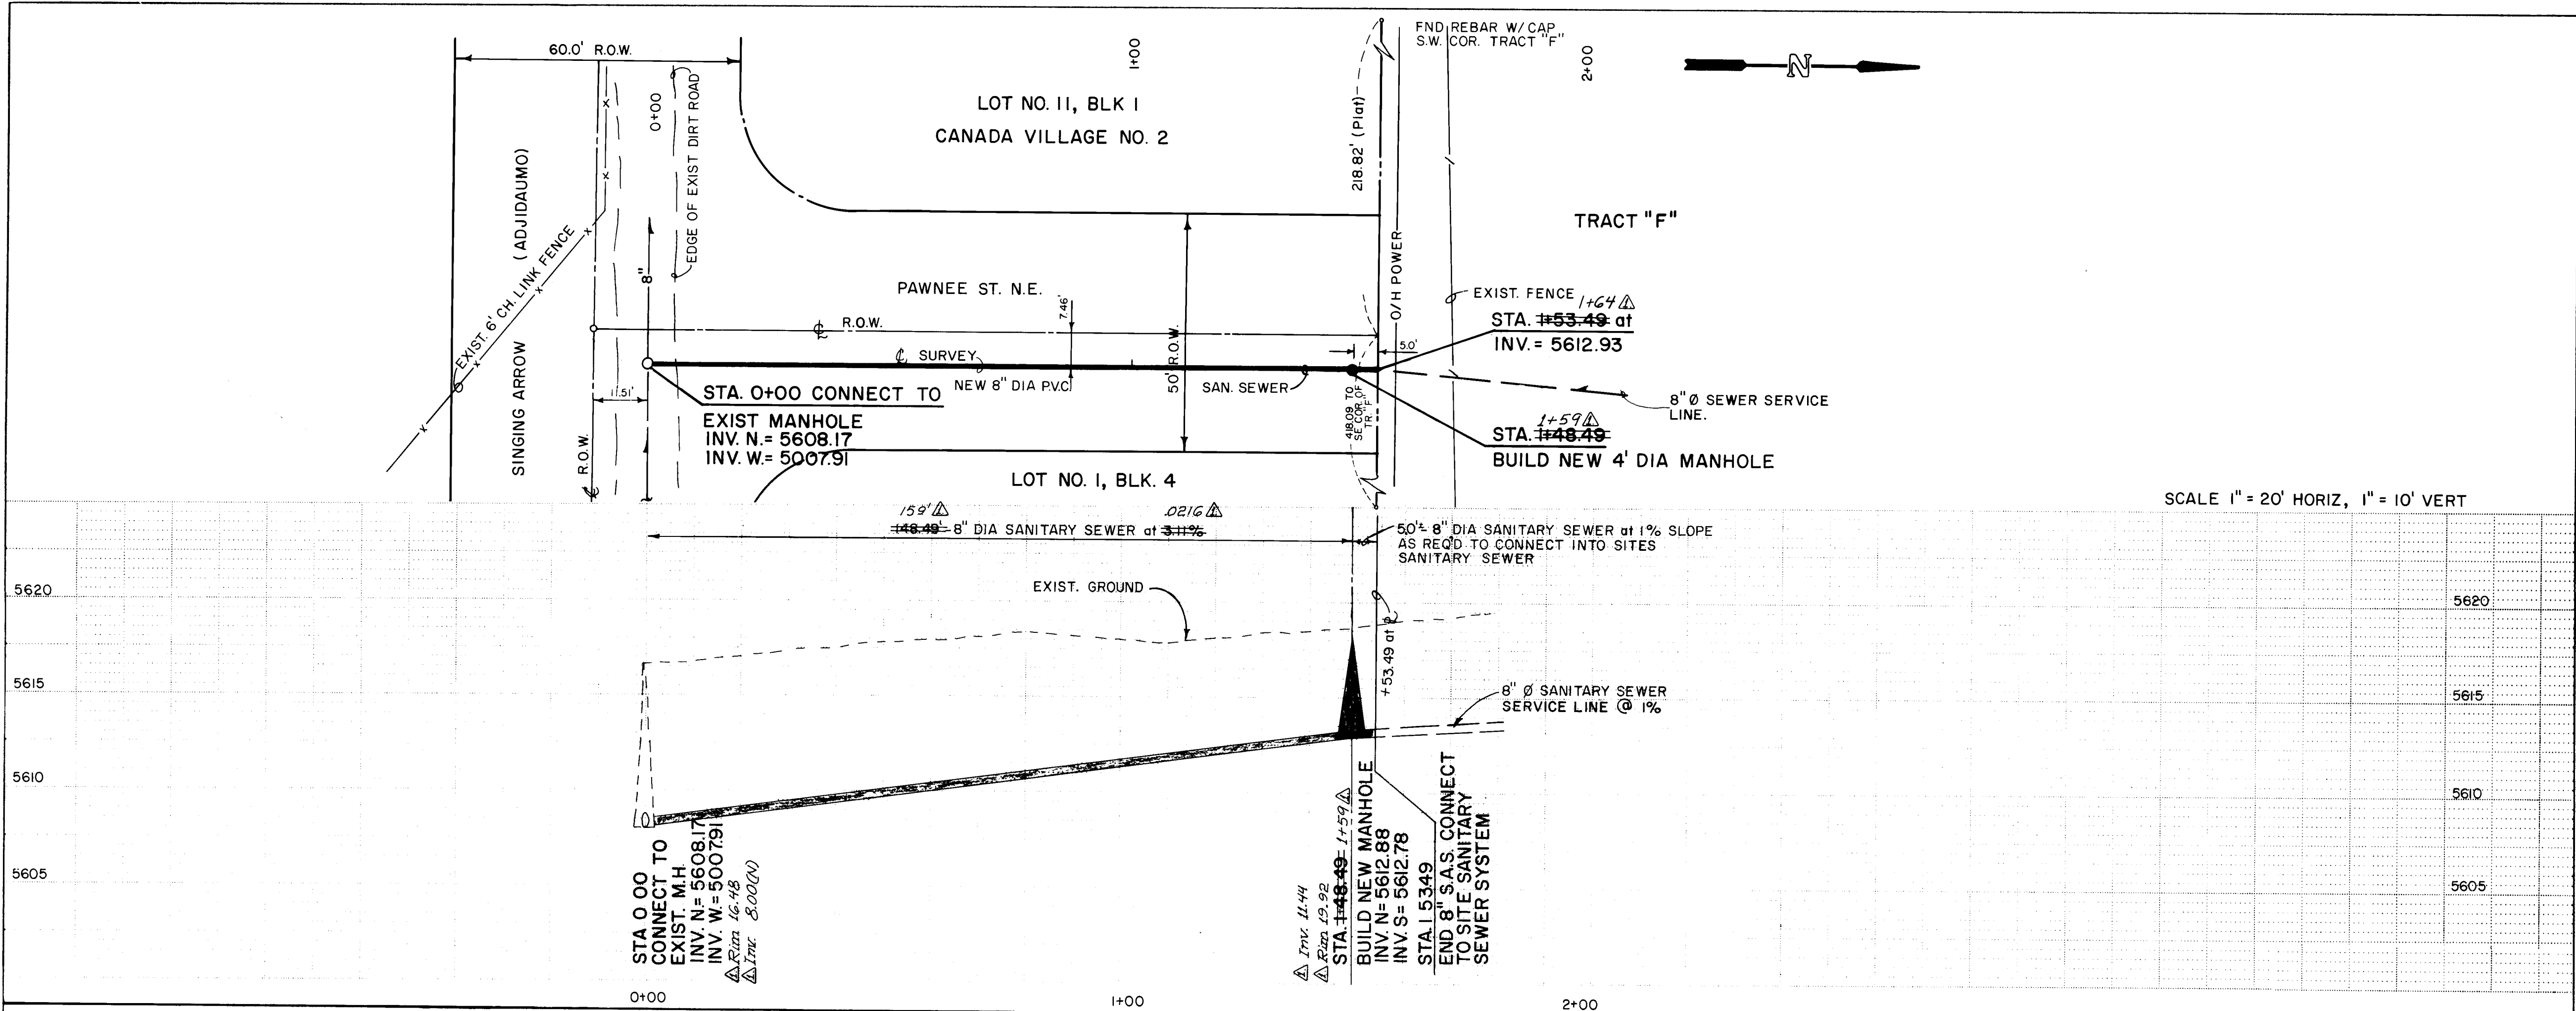

2 6 2 1 7 2 5 0 4 8 6

CITY OF ALBUQUERQUE MUNICIPAL DEVELOPMENT DEPARTMENT ENGINEERING DIVISION					
TITLE: HUNTER'S RIDGE 8" DIA SANITARY SEWER PLAN & PROFILE					
APPROVALS	ENGINEER	DATE	APPROVALS	ENGINEER	DATE
City Engineer	<i>[Signature]</i>	2/2/86	Liquid Waste	<i>[Signature]</i>	2-7-86
A.C.E. - Design	<i>[Signature]</i>	2/2/86	Traffic	N/A	2-7-86
A.C.E. - Hydrology	<i>[Signature]</i>	2/2/86	Water	<i>[Signature]</i>	2-7-86
DRAWING NO.	2725	MAP NO.	L-22	SHEET	4 OF 4

SURVEY INFORMATION		BENCH MARKS		AS BUILT INFORMATION	
NO.	FIELD NOTES	ACS BRASS CAP STAMPED "2-L-22"	ELEV. 5659.96	CONTRACTOR	NEW CONCEPTS
BY	DATE	LOCATED 1015 FT. WEST OF CENTERLINE OF ROAD AND 55 FT. NORTH OF CENTERLINE OF CENTRAL AVE.		INSPECTED BY	D. HERRERA
				ACCEPTANCE DATE	
				REVISIONS	
				DESIGNED BY	DATE
				DRAWN BY	DATE
				CHECKED BY	DATE
				RECORDED BY	DATE
				NO.	

