

DRAWING NUMBER

SACD PRODUCTS • NEW HOPE, MINNESOTA
1" = 40' (VERTICAL SCALE OF POINT ON THIS LINE)

DRAWING NUMBER

SACD PRODUCTS • NEW HOPE, MINNESOTA
1" = 40' (VERTICAL SCALE OF POINT ON THIS LINE)

DRAWING NUMBER

SACD PRODUCTS • NEW HOPE, MINNESOTA
1" = 40' (VERTICAL SCALE OF POINT ON THIS LINE)

DRAWING NUMBER

SACD PRODUCTS • NEW HOPE, MINNESOTA
1" = 40' (VERTICAL SCALE OF POINT ON THIS LINE)

SCANNED
BY *Jason*


CIBOLA LOOP

SEVEN BAR RANCH

PAVING AND DRAINAGE FACILITY PLANS

INDEX

SHEET NO.	TITLE
1	TITLE SHEET
2	PLAT
3	CIBOLA LOOP PLAN & PROFILE
4	DETAIL SHEET

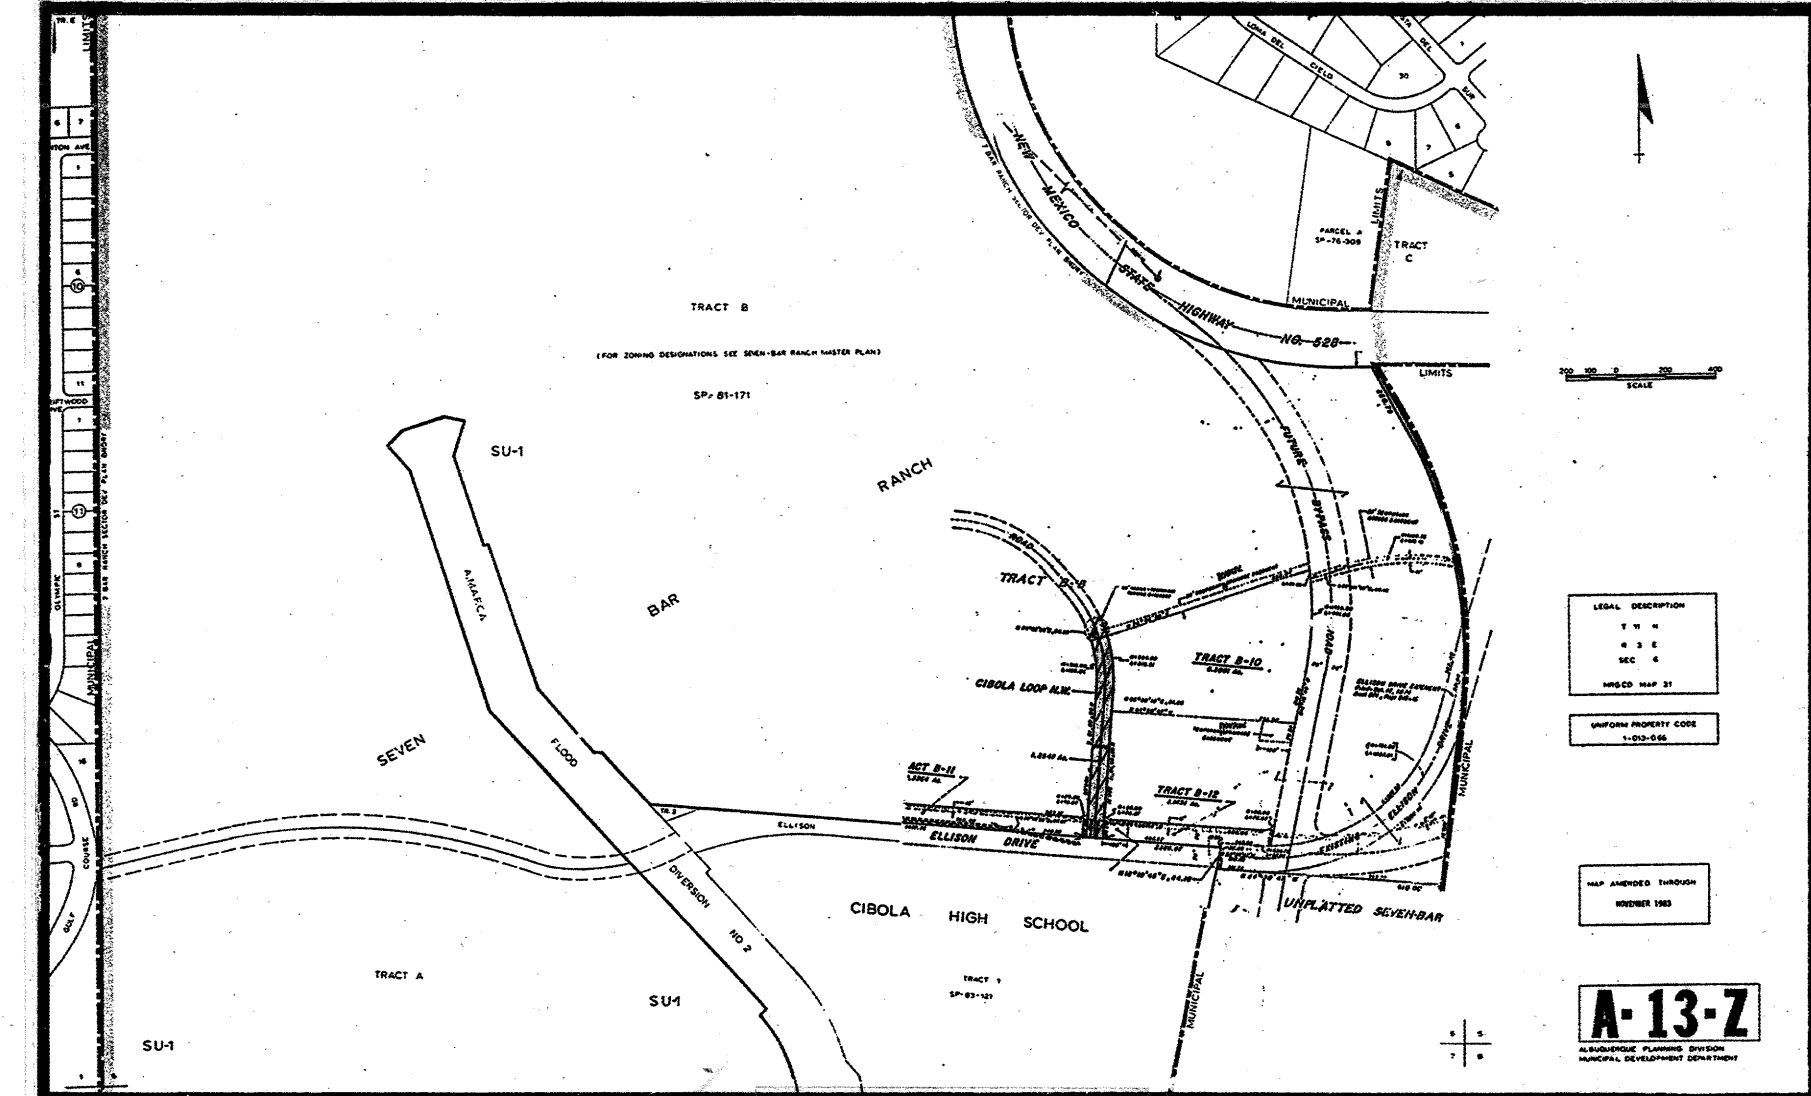

VICINITY MAP


NOTES

- ALL WORK DETAILED ON THESE PLANS TO BE PERFORMED UNDER CONTRACT SHALL, EXCEPT AS OTHERWISE STATED OR PROVIDED FOR HEREON, BE CONSTRUCTED IN ACCORDANCE WITH THE CITY OF ALBUQUERQUE INTERIM STANDARD SPECIFICATIONS FOR PUBLIC WORKS CONSTRUCTION, 1985.
- TWO (2) WORKING DAYS PRIOR TO ANY EXCAVATION, CONTRACTOR MUST CONTACT LINE LOCATING SERVICE, 765-1234, FOR LOCATION OF EXISTING UTILITIES.
- PRIOR TO CONSTRUCTION, THE CONTRACTOR SHALL EXCAVATE AND VERIFY THE HORIZONTAL AND VERTICAL LOCATIONS OF ALL OBSTRUCTIONS. SHOULD A CONFLICT EXIST, THE CONTRACTOR SHALL NOTIFY THE ENGINEER OR SURVEYOR SO THAT THE CONFLICT CAN BE RESOLVED WITH MINIMUM AMOUNT OF DELAY.
- ALL UTILITIES AND UTILITY SERVICE LINES SHALL BE INSTALLED PRIOR TO PAVING.
- TACK COAT REQUIREMENTS SHALL BE DETERMINED BY THE CITY ENGINEER.
- BACKFILL COMPACTION SHALL BE ACCORDING TO SPECIFIED STREET USE.
- IF CURB IS DEPRESSED FOR A DRIVEPAD OR A HANDICAP RAMP, THE DRIVEPAD OR RAMP SHALL BE CONSTRUCTED PRIOR TO ACCEPTANCE OF THE CURB AND GUTTER.
- ALL STORM DRAINAGE FACILITIES SHALL BE COMPLETED PRIOR TO FINAL ACCEPTANCE.

APPROVAL OF AS BUILT DRAWINGS
CHIEF CONSTRUCTION ENGINEER
Russell D. Smith
DATE 11-24-86

1 2 3 4 5 6 7 8 9 10 11 12
26 27 28 01 86

REV.	SHEETS	CITY ENGR.	DATE	USER DEPT.	DATE	USER DEPT.	DATE
APPROVAL OF REVISIONS							

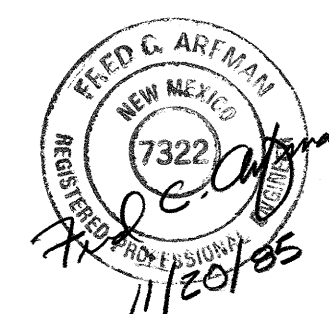


Isaacson & Arfman, P.A.
CONSULTING ENGINEERING ASSOCIATES
Albuquerque, New Mexico

PROJECT NO. 2728

APPROVED FOR
CONSTRUCTION

Quinn
8/24/86

SHEET 1 OF 4

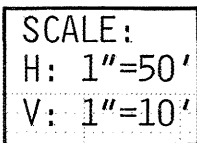

1. START ASPHALT CURB, RIGHT SIDE ONLY
2. ASPHALTIC DRAINAGE RUNDOWN
3. ASPHALT CURB (DRAINAGE RUNDOWN TO STA. 0+80.0), DWG. P-8.
4. WHEELCHAIR RAMP (NON-STANDARD), SEE DETAIL, SHEET 4 OF 4
5. CONCRETE VALLEY GUTTER, PER COA DWG. P-9.
6. TEMPORARY ASPHALTIC PAVING, SEE SECTION A-A, SHT. 4 OF 4.
7. ASPHALTIC CURB ALONG EDGE OF TEMP. PAVING PER COA DWG. P-8.
8. TYPE III BARRICADE, SEE DETAIL SHEET 4 OF 4.
9. FUTURE CURB & GUTTER
10. TEMP. ASPHALTIC PAVING FROM ELLISON RD. TO STA. 0+80.0 (CIBOLA LOOP)
11. DIP SECTION (STA. -0+23.0)
12. TEMPORARY STORM WATER RETENTION POND, SEE PLAN, SHEET 4 OF 4.
13. RESIDENTIAL ASPHALTIC PAVING (SEE SECTION SHEET 4 OF 4).

	EXISTING CONTOUR
	EXISTING FENCE LINE
	PROPOSED CONC. SIDEWALK
	LIMITS OF PROPOSED ASPHALTIC PAVING
	PROPOSED <u>TOP OF CURB</u> ELEV.
	<u>FLOWLINE</u>
	KEYED CONSTRUCTION NOTE, SEE ABOVE
	FUTURE CURB & GUTTER
	PERMANENT PAVING
	TEMPORARY PAVING

1	2	3	4	5	6	7	8	9	10	11	12
26			27	28	03	86					


CITY OF ALBUQUERQUE
ECONOMIC DEVELOPMENT DEPARTMENT
ENGINEERING DIVISION
TITLE: CIBOLA LOOP (TR. B-9, SEVEN BAR RANCH)
STREET PLAN & PROFILE

PERSONNEL	ENGINEER	DATE	APPROVALS	ENGINEER	DATE
Asst. Engineer	<i>H. B. Baker</i>	1/19/86	Liquid Waste	N/A B. Ryck	12/30/85
S.C.E. - Design	<i>H. B. Baker</i>	1/17/86	Trickle	D. A. Parks	12/27/85
S.C.E. - Hydrology	<i>H. B. Baker</i>	1/17/86	Water	N/A B. Ryck	12/30/85


DRAWING NO.	2728	MAP NO.	A-13	SHEET	3	OF	4
-------------	------	---------	------	-------	---	----	---

CITY OF ALBUQUERQUE SCS/ACS NW-5 (STAMPED BRASS)
CAP "ELE. 5160.19, NW-5" LOCATED 1000' WEST
FROM E. ON HWG. 528 & 1000' SOUTH FROM RIO RANCHO'S
SOUTH PROPERTY LINE.
ELEV. =5160.19




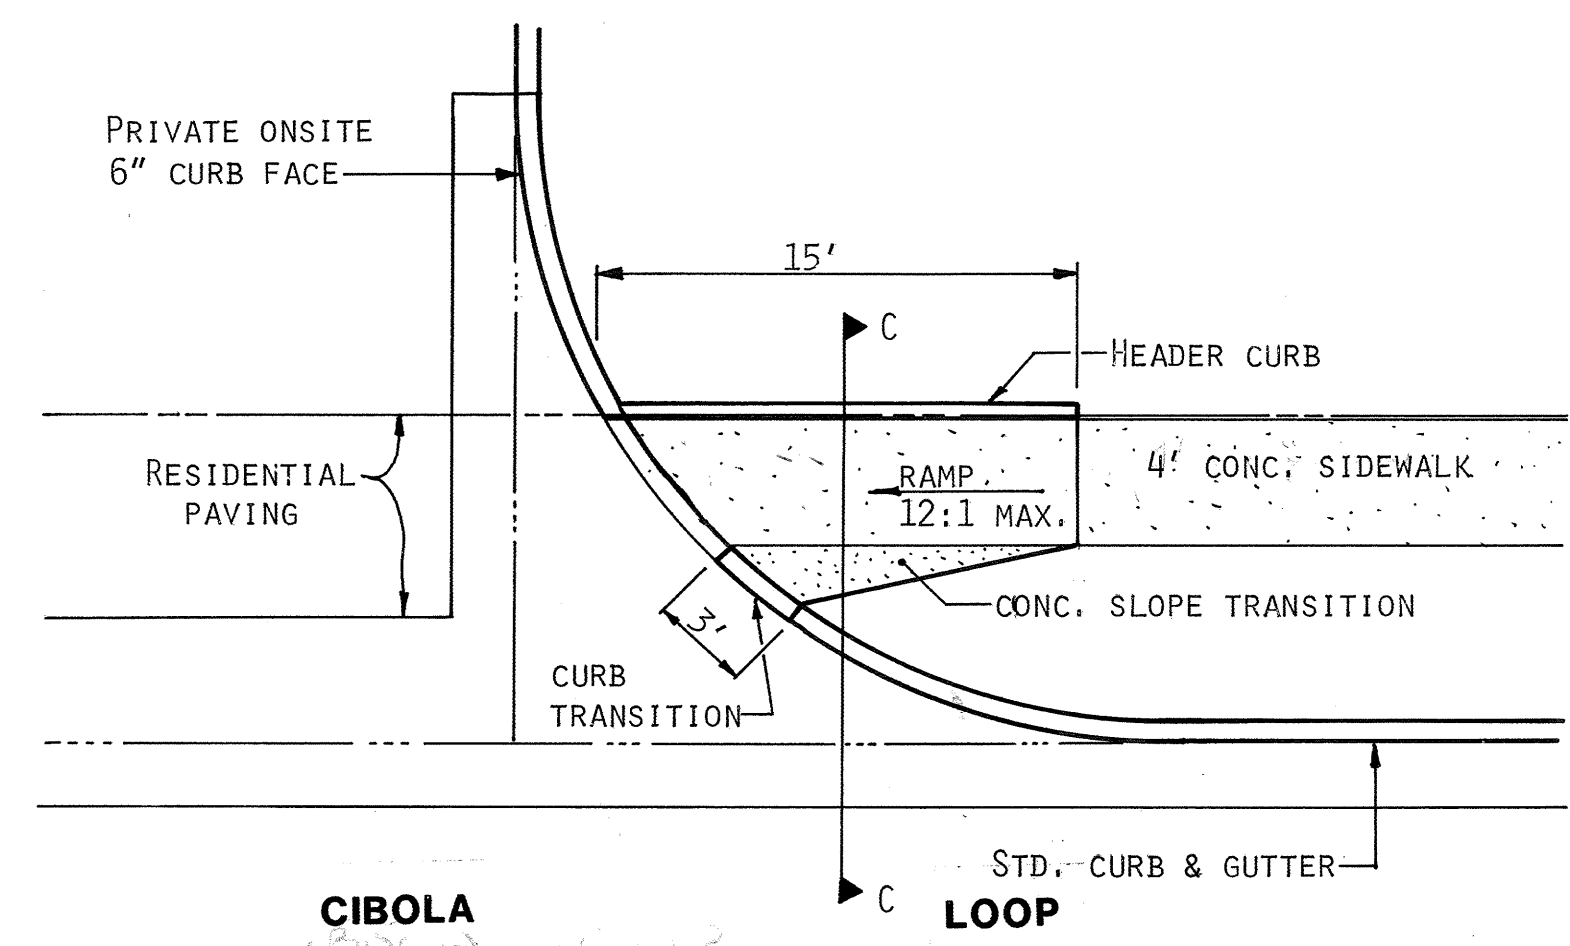

MODIFIED WHEELCHAIR RAMP
1"=6'-0"



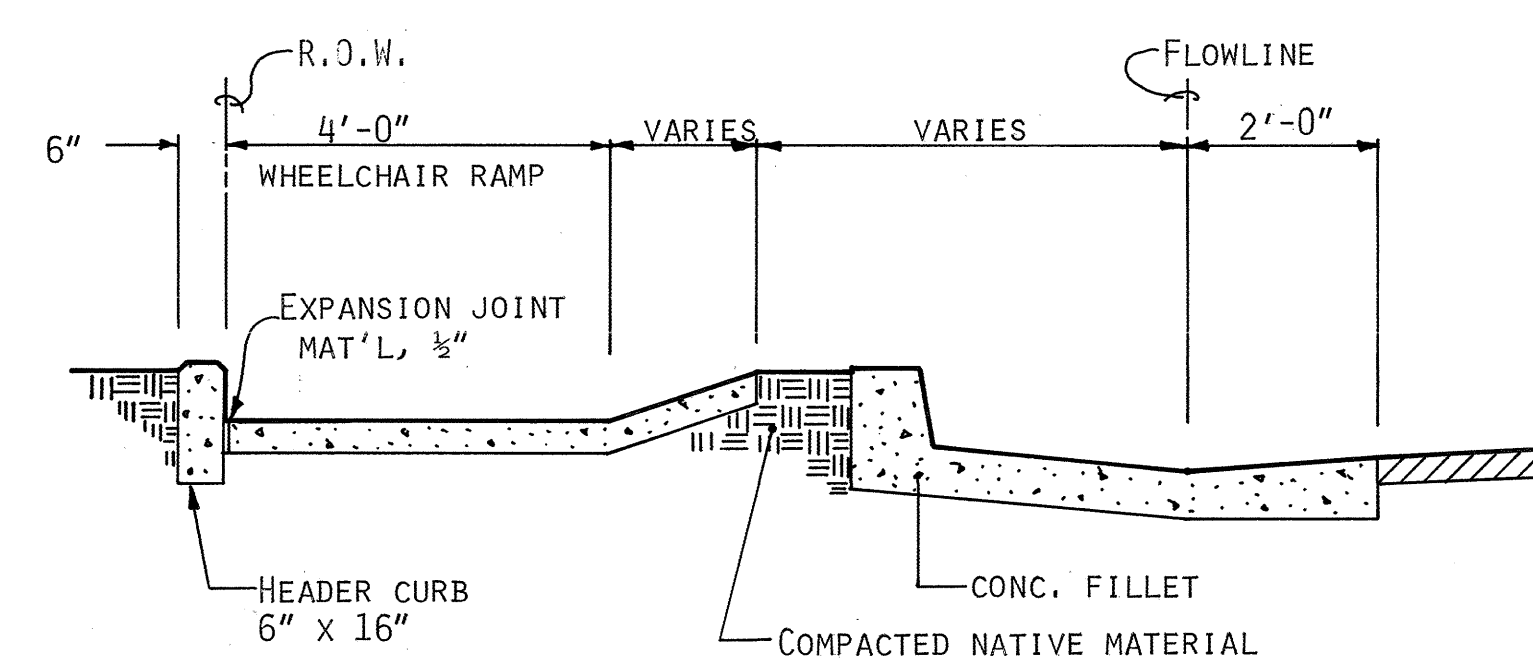


SECTION C-C: WHEELCHAIR RAMP
1"=2'-0"

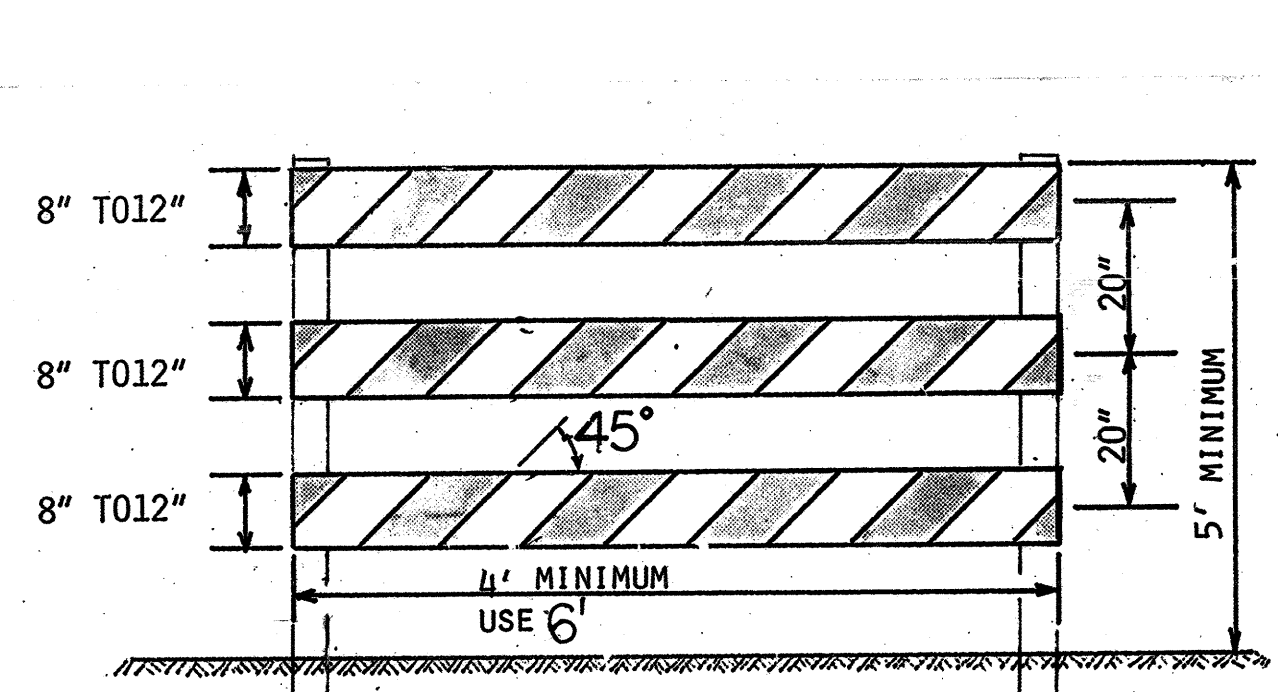


NOTE: DIAGONAL STRIPING TO BE ORANGE FOR CONSTRUCTION USES AND RED FOR PERMANENT USES.


TYPE III BARRICADE

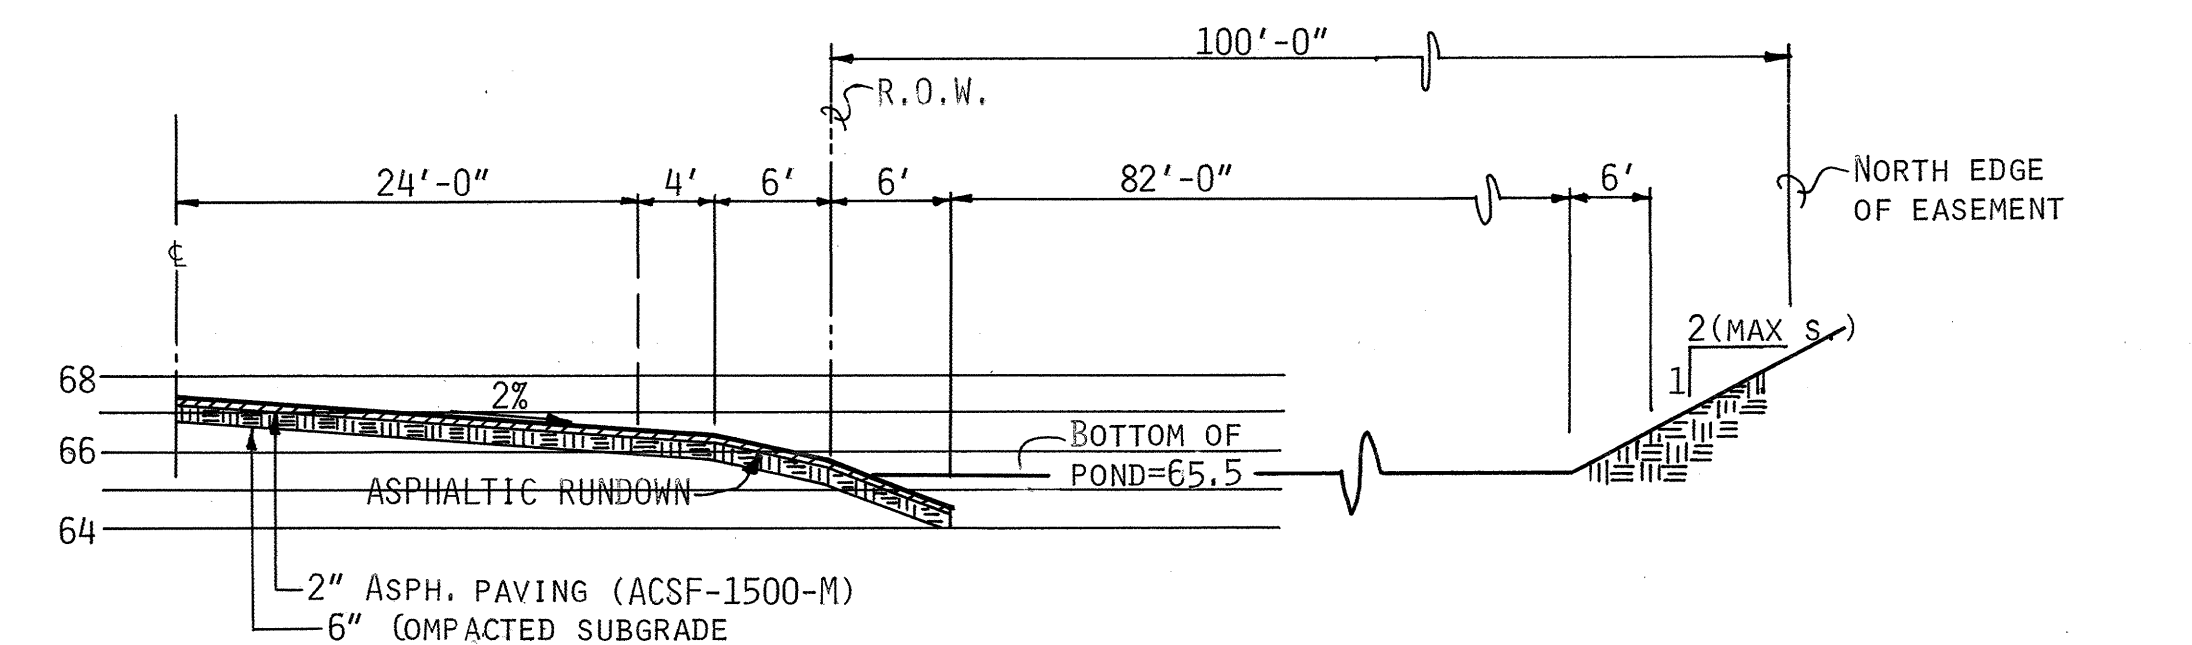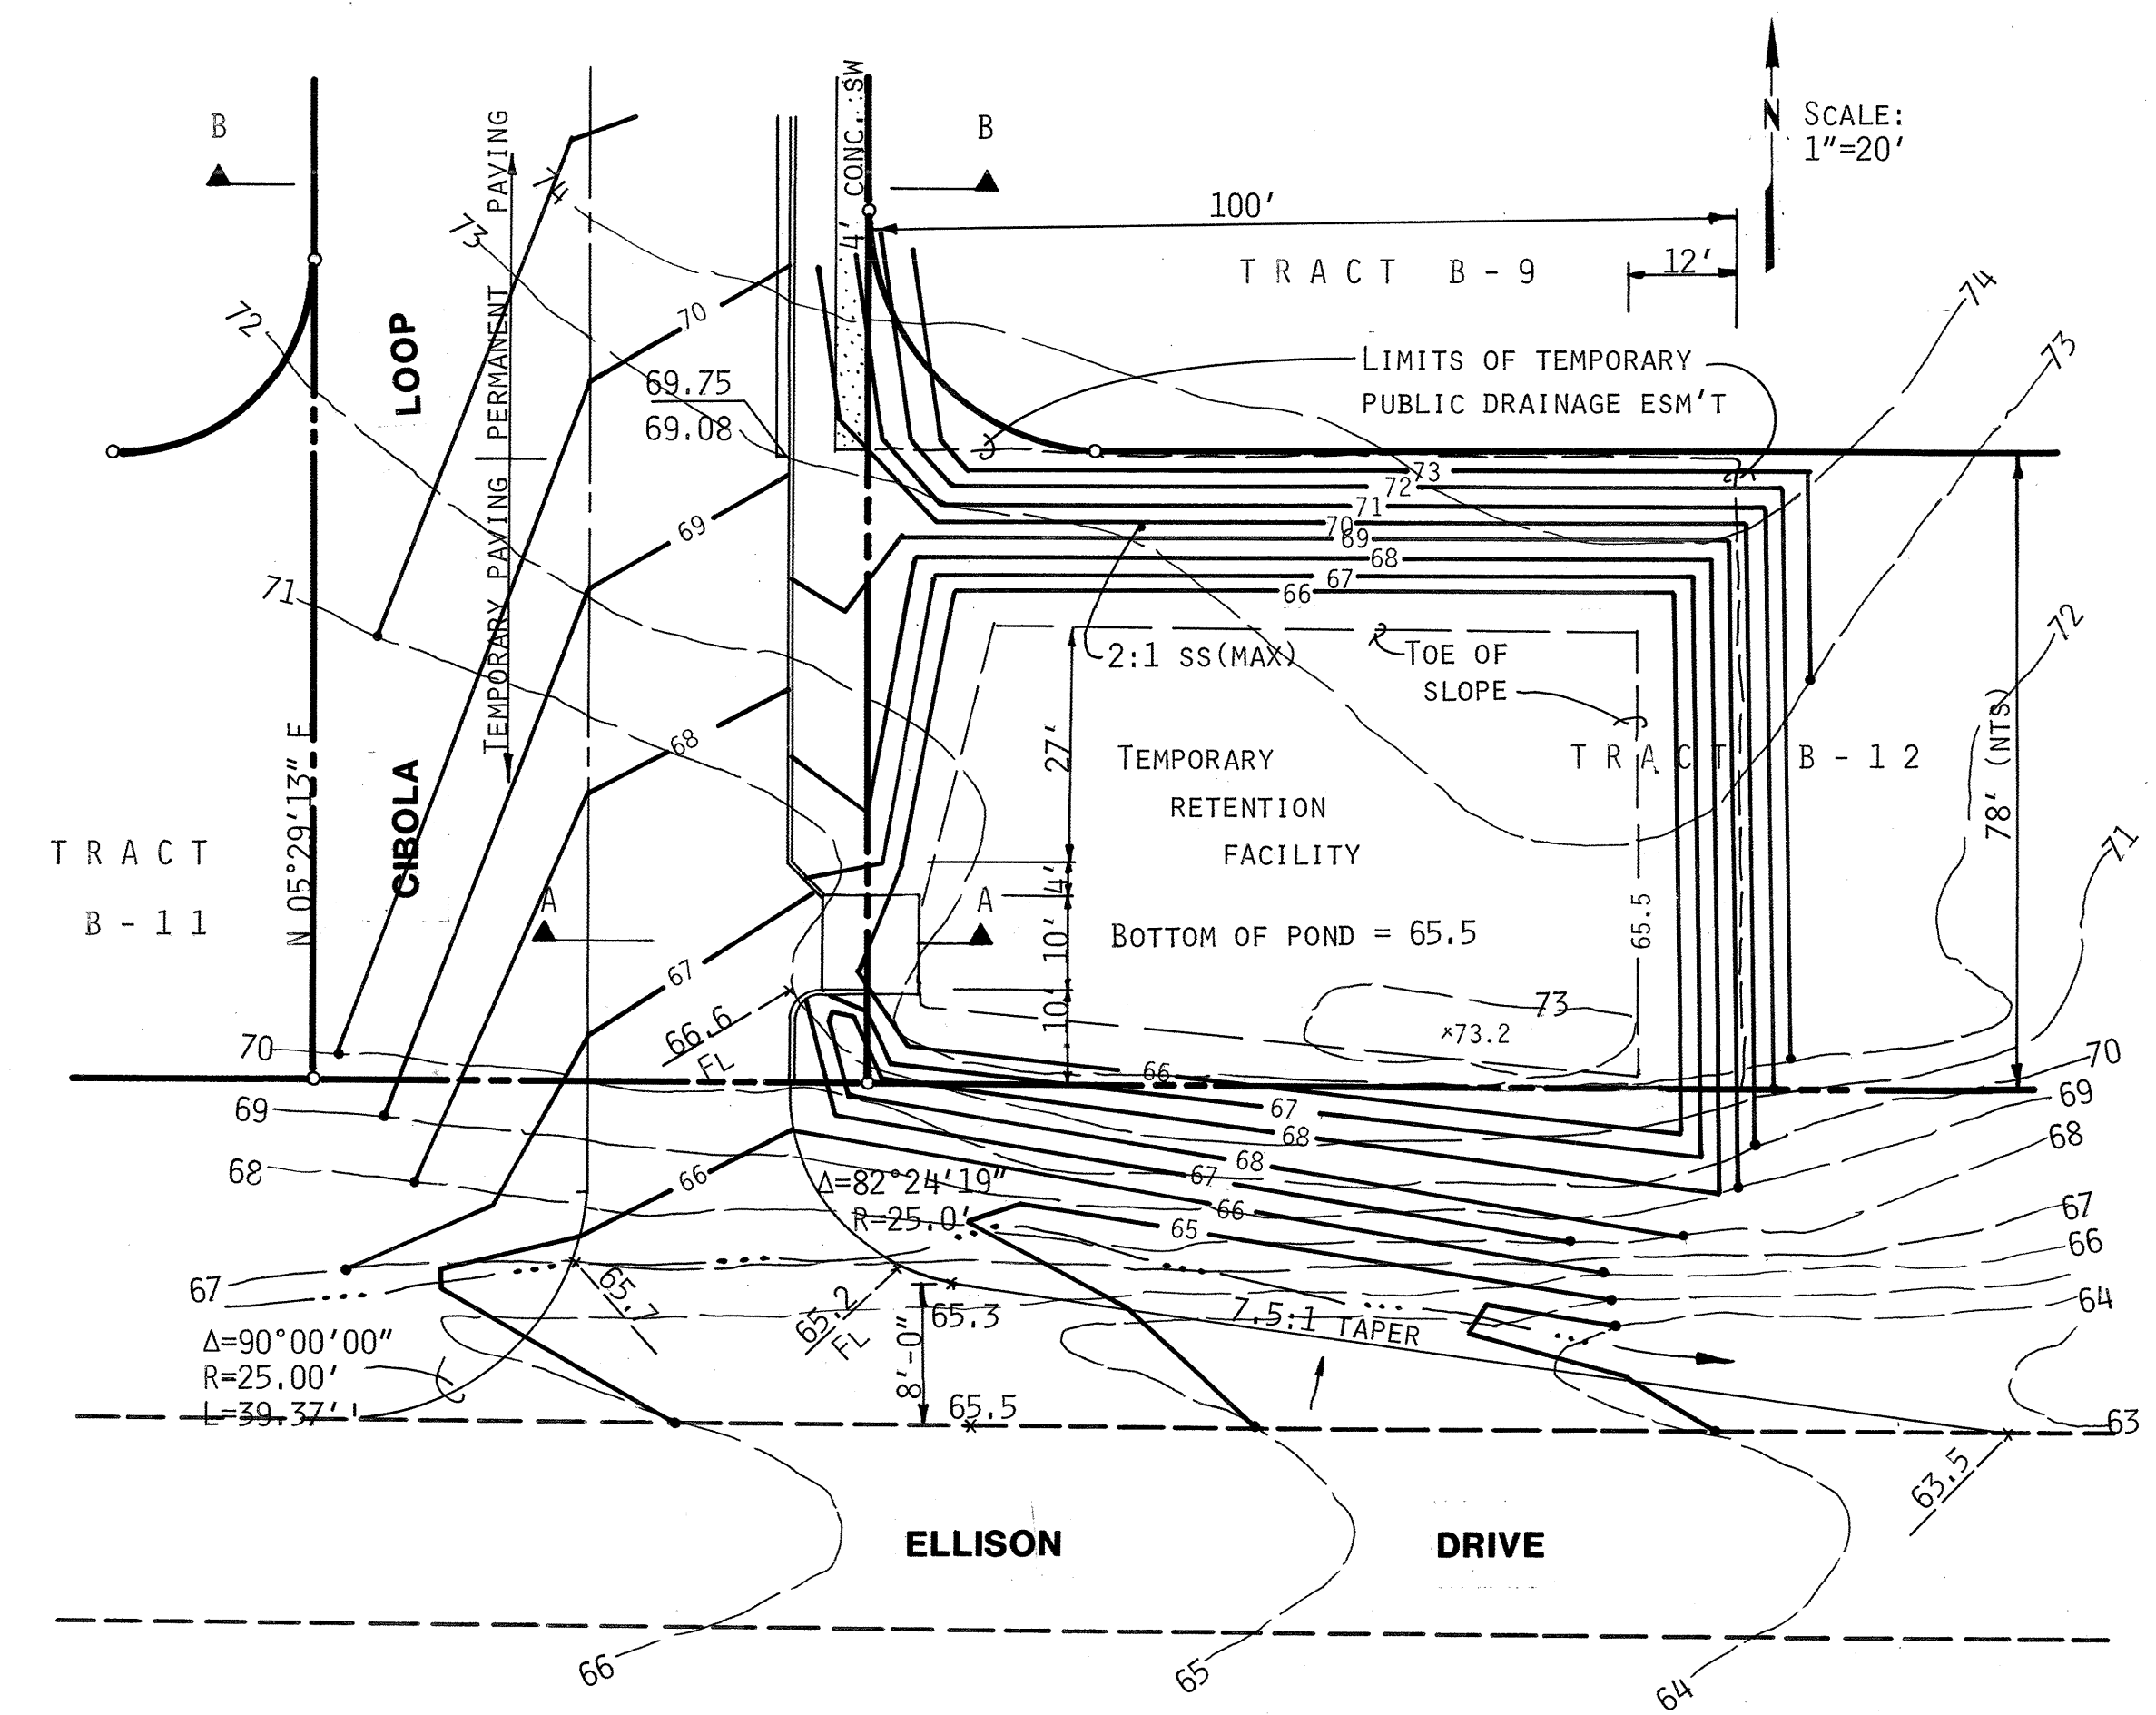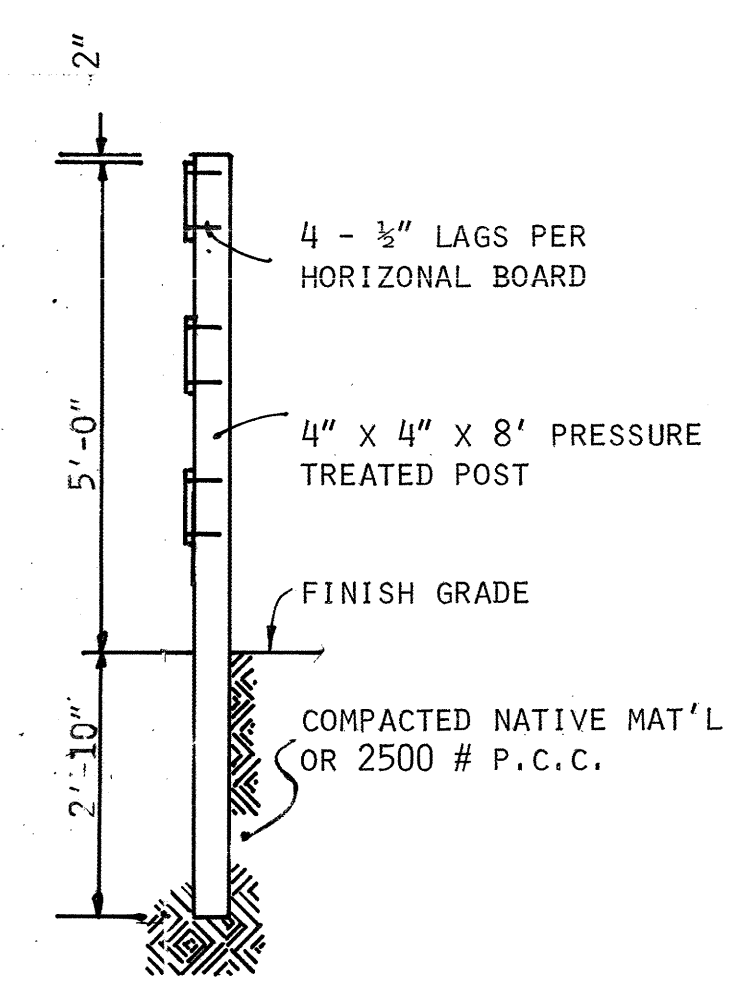

SECTION A-A: DRAINAGE RUNDOWN & TEMP. PAVING SECTION
SCALE: 1"=10' H., 1"= 5' V.

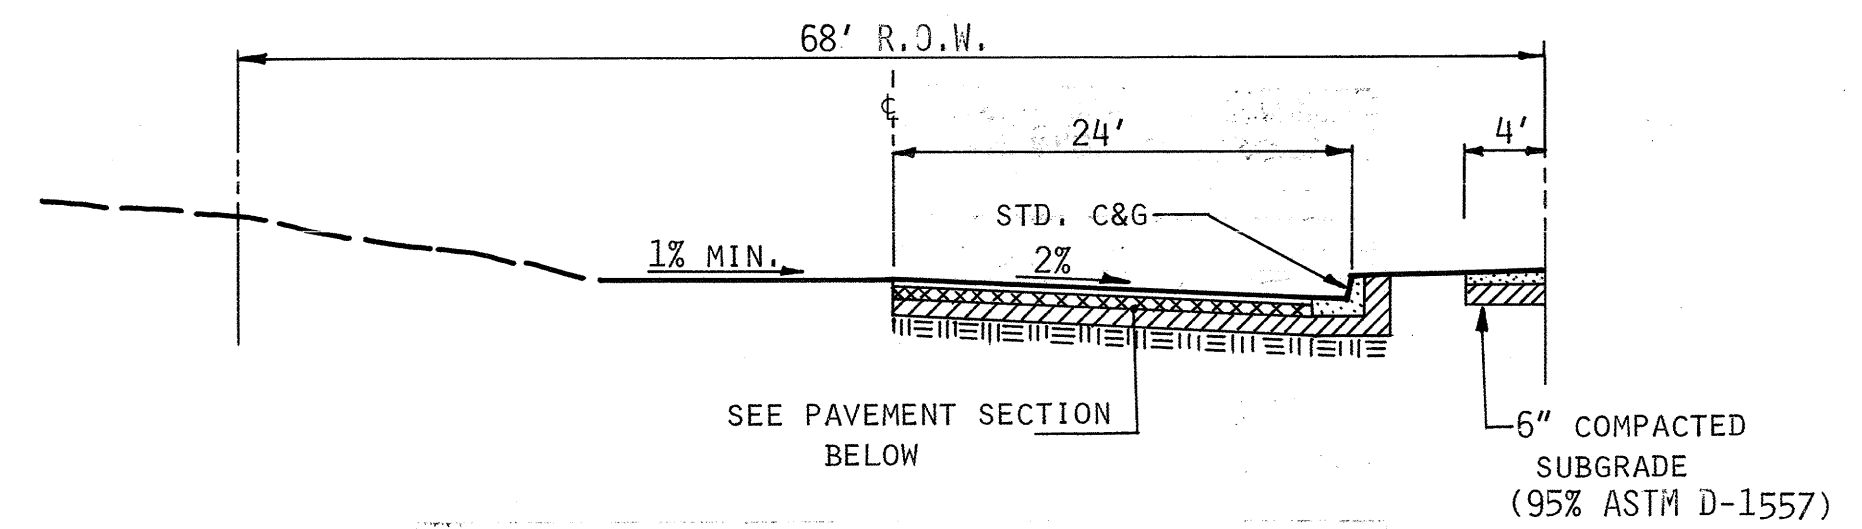

SECTION B-B: CIBOLA LOOP
SCALE: 1"=10' H., 1"= 5' V.

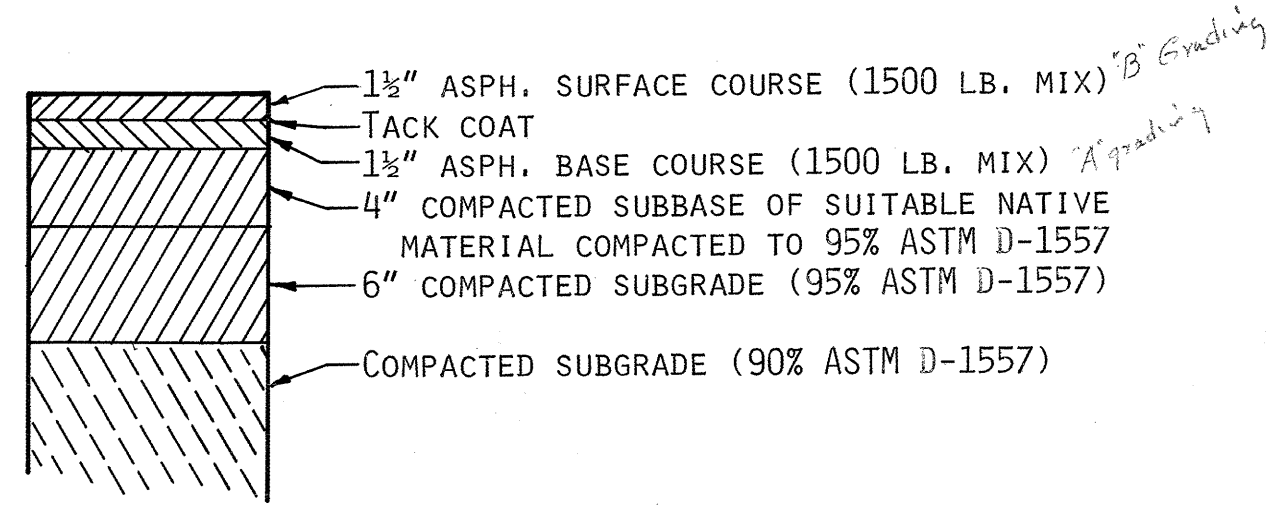

PAVEMENT SECTION
NO SCALE

TEMPORARY RETENTION POND CAPACITY: (90x57)+(79x47)x0.5 = 4,422 S.F. X 1.1' DEPTH = 4,864 CU.FT. 4,864 CU.FT. > 4,337 CU.FT. (REQ'D)					
CITY OF ALBUQUERQUE MUNICIPAL DEVELOPMENT DEPARTMENT ENGINEERING DIVISION TITLE: CIBOLA LOOP (TR. B-9, SEVEN BAR RANCH) DETAIL SHEET					
APPROVALS	ENGINEER	DATE	APPROVALS	ENGINEER	DATE
City Engineer	<i>[Signature]</i>	1/19/06	Liquid Waste	<i>[Signature]</i>	12/30/05
A.C.E. Design	<i>[Signature]</i>	1/18/06	Traffic	<i>[Signature]</i>	12/30/05
A.C. E.-Hydrology	<i>[Signature]</i>	1/18/06	Water	<i>[Signature]</i>	12/30/05
DRAWING NO.	2728	MAP NO.	A-13	SHEET	4 OF 4