

PHIL CHACON PARK PHASES I & II

7600 SOUTHERN AVENUE S.E.
ALBUQUERQUE, NEW MEXICO

CLASS I CONSTRUCTION

INDEX OF DRAWINGS

COVER SHEET	1
DEMOLITION PLAN, WEST	2
DEMOLITION PLAN, EAST	3
GRADING PLAN, WEST	4
GRADING PLAN, EAST	5
BIKE TRAIL PLAN AND PROFILE	6
DIMENSION PLAN, WEST	7
DIMENSION PLAN, EAST	8
SITE UTILITY PLAN, WEST	9
SITE UTILITY PLAN, EAST	10
CONSTRUCTION PLAN	11
IRRIGATION PLAN, WEST	12
IRRIGATION PLAN, EAST	13
PLANTING PLAN, WEST	14
PLANTING PLAN, EAST	15
ELECTRICAL PLAN, WEST	16
ELECTRICAL PLAN, EAST AND ELECTRICAL DETAILS	17
CONSTRUCTION DETAILS	18
CONSTRUCTION DETAILS	19
CONSTRUCTION DETAILS	20
CONSTRUCTION DETAILS	21
CONSTRUCTION DETAILS	22
CONSTRUCTION DETAILS	23
IRRIGATION DETAILS	24
IRRIGATION DETAILS	25
PLANTING DETAILS	26
FOUNTAIN CONSTRUCTION DETAILS	27
FOUNTAIN CONSTRUCTION DETAILS	28
FOUNTAIN MECHANICAL DETAILS	29
FOUNTAIN MECHANICAL DETAILS	29A

Q of A PWD Maps & Records
1 2 3 4 5 6 7 8 9 10 11 12
26 27 28 29 30 31 32

APPROVAL OF AS BUILT DRAWINGS
CHIEF CONSTRUCTION ENGINEER
Samuel D. Smith
2-18-93

CONSULTANTS

JEAN J. "JAKE" BORDENAVE, P.E., L.S. CIVIL ENGINEERING

PROFESSIONAL ENGINEERS GROUP


BRIDGERS & PAXTON CONSULTING ENGINEERS, INC. . . . MECHANICAL ENGINEERING

CHAVEZ - GRIEVES CONSULTING ENGINEERS, INC. . . . STRUCTURAL ENGINEERING INC.

TIERRA DEL SOL ENGINEERING INC. ELECTRICAL ENGINEERING

CHERRY/SEE ARCHITECTS ARCHITECTURAL

SEPTEMBER 1990

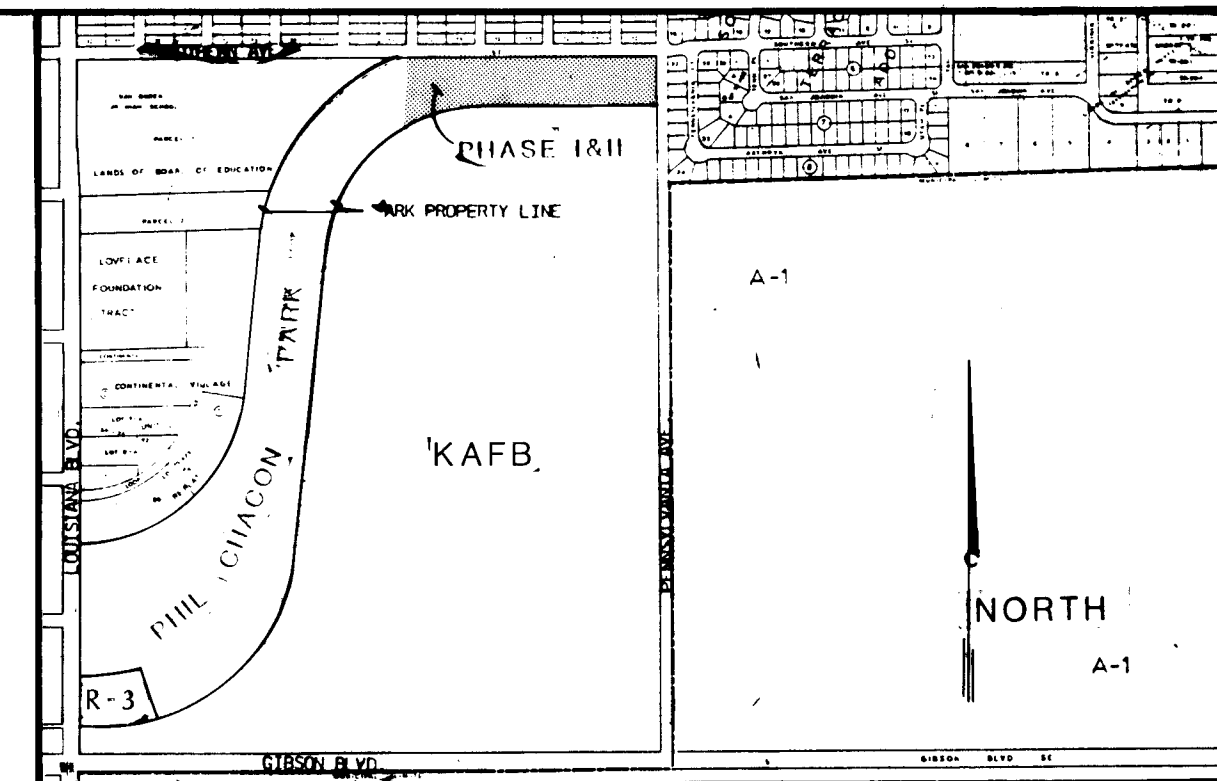

LOCATION MAP

ZONE MAP NUMBER L-19

GENERAL NOTES

- All work detailed on these plans to be performed under contract, except as otherwise stated or provided herein, shall be constructed in accordance with the City of Albuquerque Standard Specifications for Public Works Construction, 1986.
- The rules and regulations governing construction safety and health shall additionally be in accordance with applicable Federal, State and local laws.
- The Contractor must submit a plan for signs and barricades to the Construction Coordination Division at 768-2551 prior to any work on a public right-of-way and obtain a barricading permit.
- It is the Contractor's responsibility to locate all pertinent utilities in the field. Two (2) working days prior to any excavation, the Contractor must contact the New Mexico One-Call System, Inc. at 260-1990 for location of existing utilities in public rights-of-way.
- Locations of utilities are approximate. It shall be Contractor's responsibility to pot hole and/or field check to determine actual locations of lines, fittings, or connections as a incidental requisite to the construction contract.
- Prior to construction, the Contractor shall excavate and verify the horizontal and vertical locations of all obstructions. Should a conflict exist, the Contractor shall notify the Landscape Architect so that the conflict can be resolved with a minimum amount of delay.
- The Contractor shall be responsible for protecting, supporting and maintaining in service, all existing utilities exposed during construction.
- Existing structures or underground utilities that are damaged by the Contractor shall be removed and replaced at the Contractor's expense. This expense shall be considered incidental to the contract and no separate payment will be made.
- All underground utilities and service lines shall be installed, inspected, tested, approved and accepted by the Owner prior to backfilling work.
- Backfill compaction, subgrade/surface courses and tack coat requirements shall be according to specified street use.
- If curb is depressed for a driveway or handicap ramp, the driveway or ramp shall be constructed prior to acceptance of the curb and gutter.
- All storm drainage facilities at the project site shall be restored, completed and/or cleaned prior to final acceptance.
- Contractor shall notify the Landscape Architect not less than seven (7) days prior to starting work in order that the Landscape Architect may take necessary measures to insure the preservation of survey monuments. The Contractor shall not disturb permanent survey monuments without the consent of the Landscape Architect and shall notify the Landscape Architect and bear the expense of replacing any that may be disturbed without permission. Replacement shall be done only by the Owner. When a change is made in the finished elevation of the pavement of any roadway in which a permanent survey monument is located, Contractor shall, at his own expense, adjust the monument cover to the new grade unless otherwise specified.



MORROW & COMPANY
LANDSCAPE ARCHITECTS
210 La Veta Drive NE
Albuquerque, New Mexico 87108
505-268-2266

AS BUILT

REV.	SHEETS	CITY ENGINEER	DATE	USER DEPT.	DATE	USER DEPT.	DATE
APPROVAL OF REVISIONS							
CITY OF ALBUQUERQUE				APPROVED FOR CONSTRUCTION			
DRAWING NO. 2746				CITY ENGINEER <i>Samuel D. Smith</i> 9/18/90			
				SHEET 1 OF 29			

ALBUQUERQUE PUBLIC SCHOOLS

ESPANOLA ST.

EXISTING CHAINLINK FENCE TO BE CAREFULLY REMOVED AND RETURNED TO OWNER FOR RE-USE. CONTRACTOR SHALL PROTECT AND AVOID DAMAGING EXISTING FENCE DURING REMOVAL OPERATIONS IN ORDER TO ASSURE THAT THE OWNER CAN RE-USE THE FENCE MATERIAL. (SEE NOTE #2, THIS SHEET)

SAN PABLO ST.

EMIL MANN ADDITION

GROVE ST.

SOUTHERN AVE.

70'

PROPERTY LINE

EXISTING INTERMEDIATE POLE TO BE RELOCATED BY PHM TO OPPOSITE SIDE OF STREET (SEE ELECTRICAL PLAN, SHEET 16)

REMOVE EXISTING SIDEWALK CURB & GUTTER TO NEAREST JOINT TO ACCOMMODATE PROPOSED CURB RETURN & WHEELCHAIR RAMPS (SEE DIMENSION PLAN & CONSTRUCTION PLAN, SHEET 7 AND SHEET 11)

EXISTING CONC SIDEWALK TO REMAIN

EXISTING POLE/LIGHT TO BE RELOCATED BY PHM TO OPPOSITE SIDE OF STREET (SEE ELECTRICAL PLAN)

EXISTING CHAINLINK FENCE TO BE CAREFULLY REMOVED AND RETURNED TO OWNER FOR RE-USE. CONTRACTOR SHALL PROTECT AND AVOID DAMAGING EXISTING FENCE DURING REMOVAL OPERATIONS IN ORDER TO ASSURE THAT THE OWNER CAN RE-USE THE FENCE MATERIAL. (SEE NOTE #2, THIS SHEET)

EXISTING CONC SIDEWALK TO REMAIN EXCEPT WHERE SHOWN OTHERWISE

RELOCATED CHAINLINK FENCE

EXISTING POLE/LIGHT TO BE RELOCATED BY PHM TO OPPOSITE SIDE OF STREET (SEE ELECTRICAL PLAN, SHEET 16)

EXISTING CHAINLINK FENCE TO BE RELOCATED (SEE #1) RETURN BALANCE OF FENCE TO OWNER (100LFT). CONTRACTOR SHALL PROTECT AND AVOID DAMAGING FENCE DURING REMOVAL IN ORDER TO ASSURE THAT THE OWNER CAN RE-USE THE FENCE. (SEE NOTE #2, THIS SHEET)

EXISTING TREES TO BE REMOVED (3 EA.)

REMOVE EXISTING TRASH AND MISCELLANEOUS DEBRIS THROUGHOUT THE SITE

EXISTING TREES TO BE REMOVED (5 EA.)


EXISTING CHAINLINK FENCE TO REMAIN

EXISTING CHAINLINK FENCE TO REMAIN

PROPERTY LINE

KIRTLAND AIR FORCE BASE

MATCHLINE SHEET 3

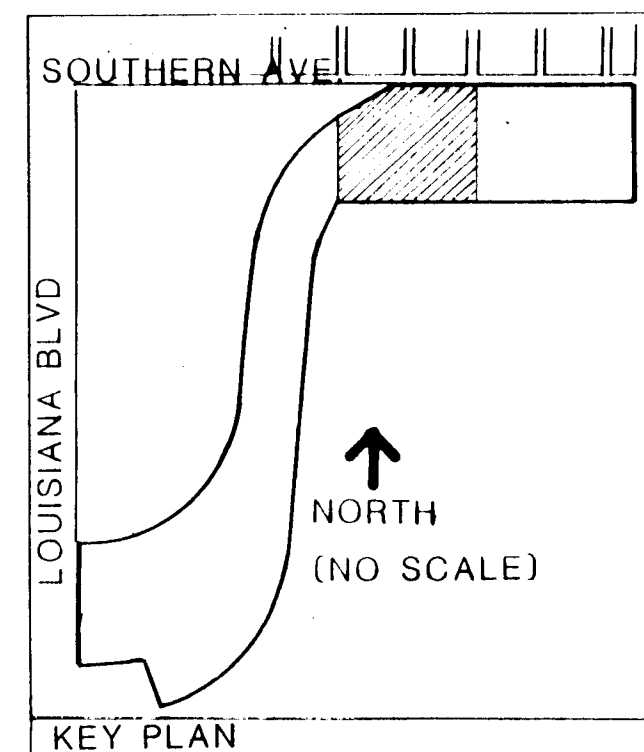

1" = 50'

0 50 100 150

NORTH (NO SCALE)

MORROW & COMPANY
LANDSCAPE ARCHITECTS
210 La Veta Drive NE
Albuquerque, New Mexico 87108
505 268-2266

NOTES


- The Contractor shall protect existing trees, shrubs, grasses, and exercise trail outside the Phase I and II area. The Contractor shall repair or replace any damaged material, including, but not limited to, re-seeding of all disturbed native grasses as specified on the Planting Plan. Repair and replacement of damaged material shall be incidental to the Contract.
- The Contractor shall transport the existing fence to be removed to the City Yards at 5501 Pino NE. The Contractor shall unload the fence in the designated storage area as instructed by the Parks and Recreation Department.

AS BUILT INFORMATION			BENCH MARKS			SURVEY INFORMATION			ENGINEER'S SEAL			REVISIONS			DESIGN		
CONTRACTOR	DATE	NO.	CONTRACTOR	DATE	NO.	NO.	BY	DATE	SEAL	NO.	DATE	NO.	DATE	NO.	DATE	NO.	DATE
ACCENT LANDSCAPE																	
INSPECTOR'S	DATE	NO.															
FIELD	DATE	NO.															
VERIFICATION BY	DATE	NO.															
CORRECTED BY	DATE	NO.															
RECORDED BY	DATE	NO.															


26 27460293

CITY OF ALBUQUERQUE PUBLIC WORKS DEPARTMENT ENGINEERING GROUP					
TITLE: PHIL CHACON PARK PHASES I & II DEMOLITION PLAN					
APPROVALS	ENGINEER	DATE	APPROVALS	ENGINEER	DATE
D.R.C. Chair		1.0.00	Hydrology	N/A	9/7/30
Trans. Dev		4.12.30			
Utility Dev		9.17.90			
Drawn		4.5.10			
DRAWING NO.	2746	MAP NO.	L-19	SHEET	2 OF 29

MATCHLINE SHEET 2

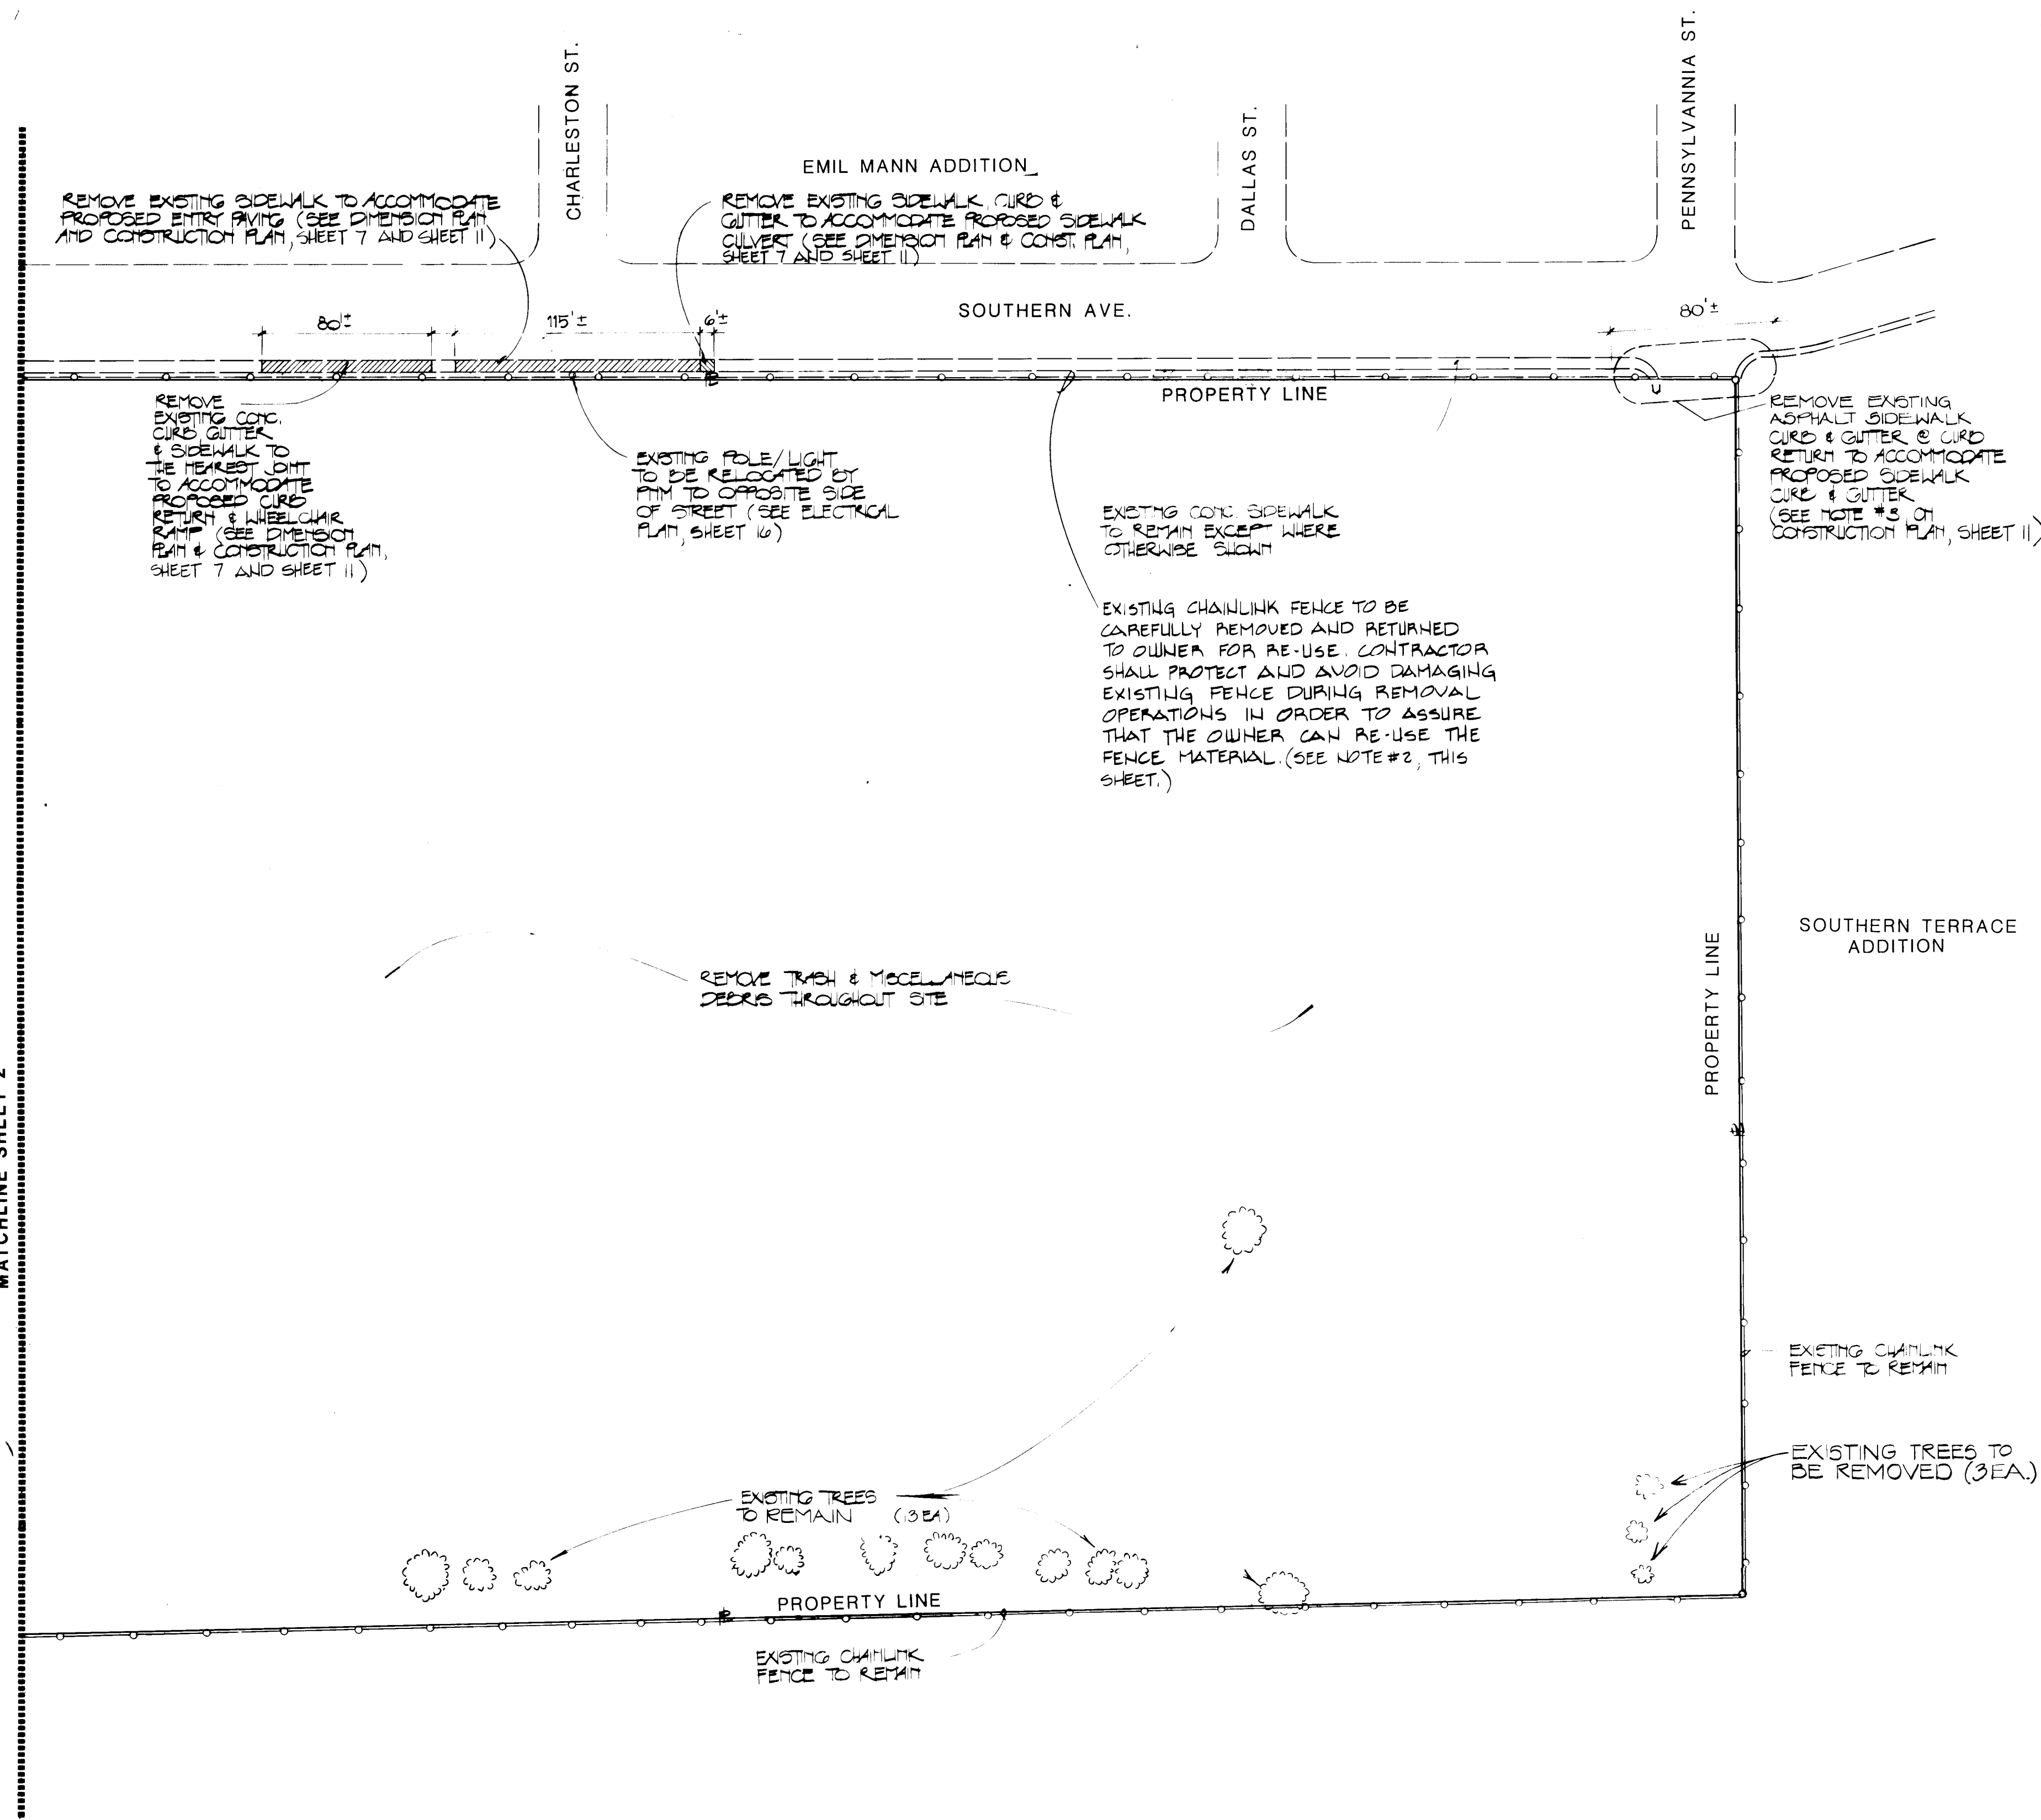

KIRTLAND AIR FORCE BASE

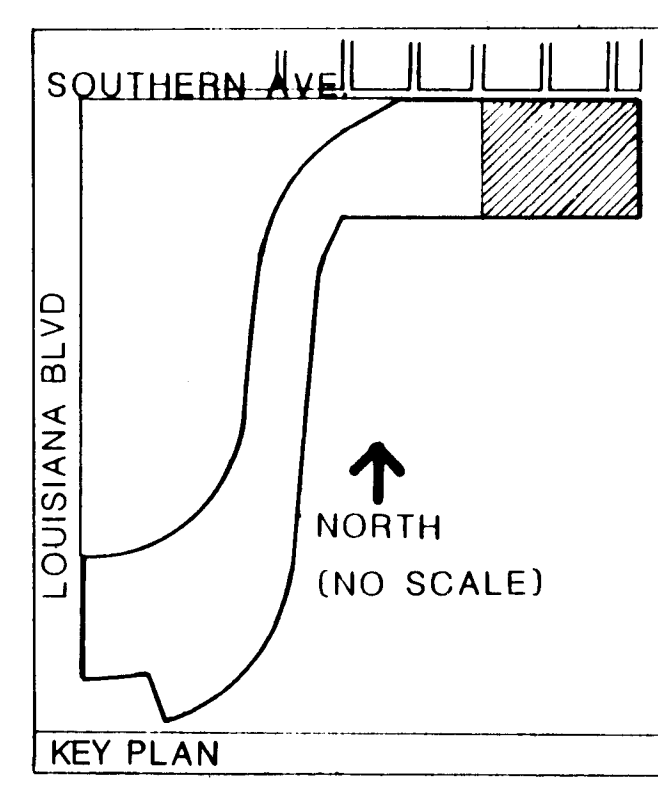


1" = 50'






0 50 100 150

MORROW & COMPANY
LANDSCAPE ARCHITECTS
210 La Veta Drive NE
Albuquerque, New Mexico 87108
505 268-2266

- NOTES**
1. The Contractor shall protect existing trees, shrubs, grasses, and exercise trail outside the Phase I and II area. The Contractor shall repair or replace any damaged material, including, but not limited to, re-seeding of all disturbed native grasses as specified on the Planting Plan. Repair and replacement of damaged material shall be incidental to the Contract.
 2. The Contractor shall transport the existing fence to be removed to the City Yards at 5501 Pino NE. The Contractor shall unload the fence in the designated storage area as instructed by the Parks and Recreation Department.

C of A PWD Maps & Records											
1	2	3	4	5	6	7	8	9	10	11	12
26	27	46	63	93							

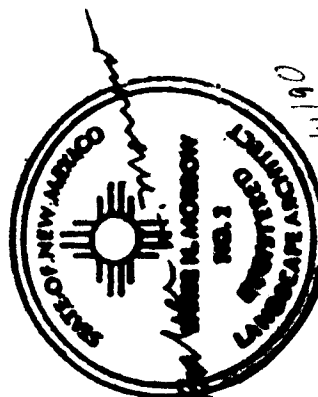
ENGINEER'S SEAL		SURVEY INFORMATION		BENCH MARKS	
		FIELD NOTES			
		NO.	BY	DATE	
REVISIONS					
DESIGN					
DESIGNED BY	BHM	DATE	5/90		
DRAWN BY	PMH	DATE	5/90		
CHECKED BY	ELH	DATE	6/90		

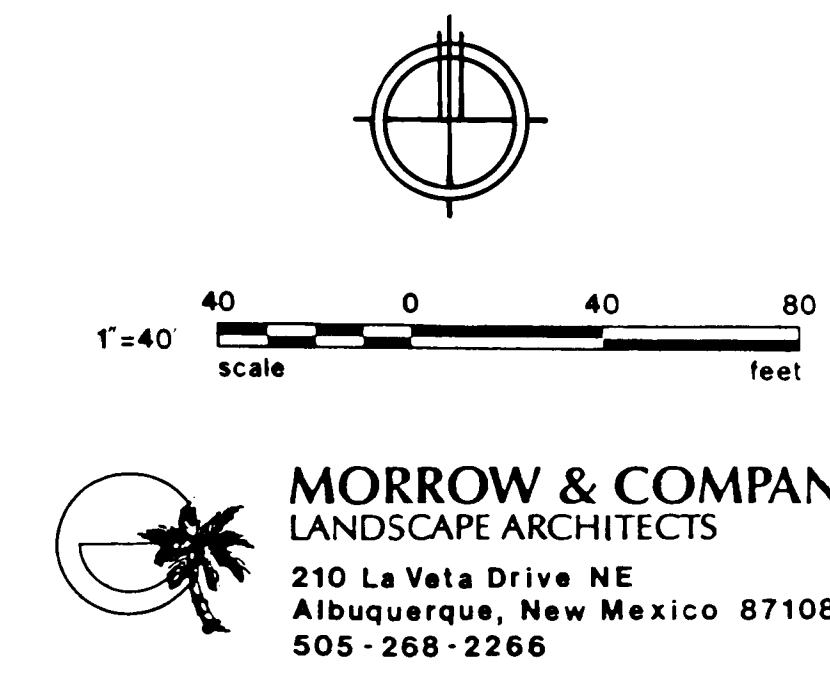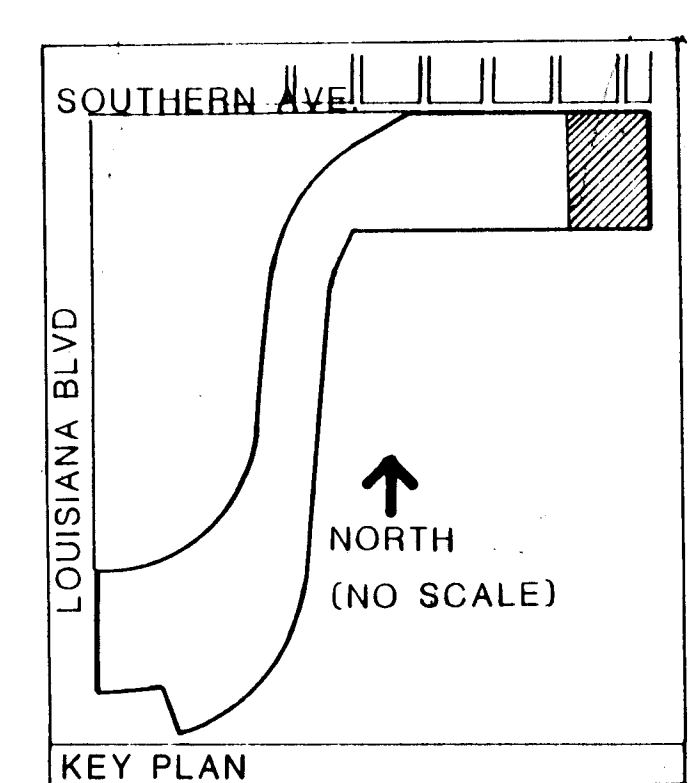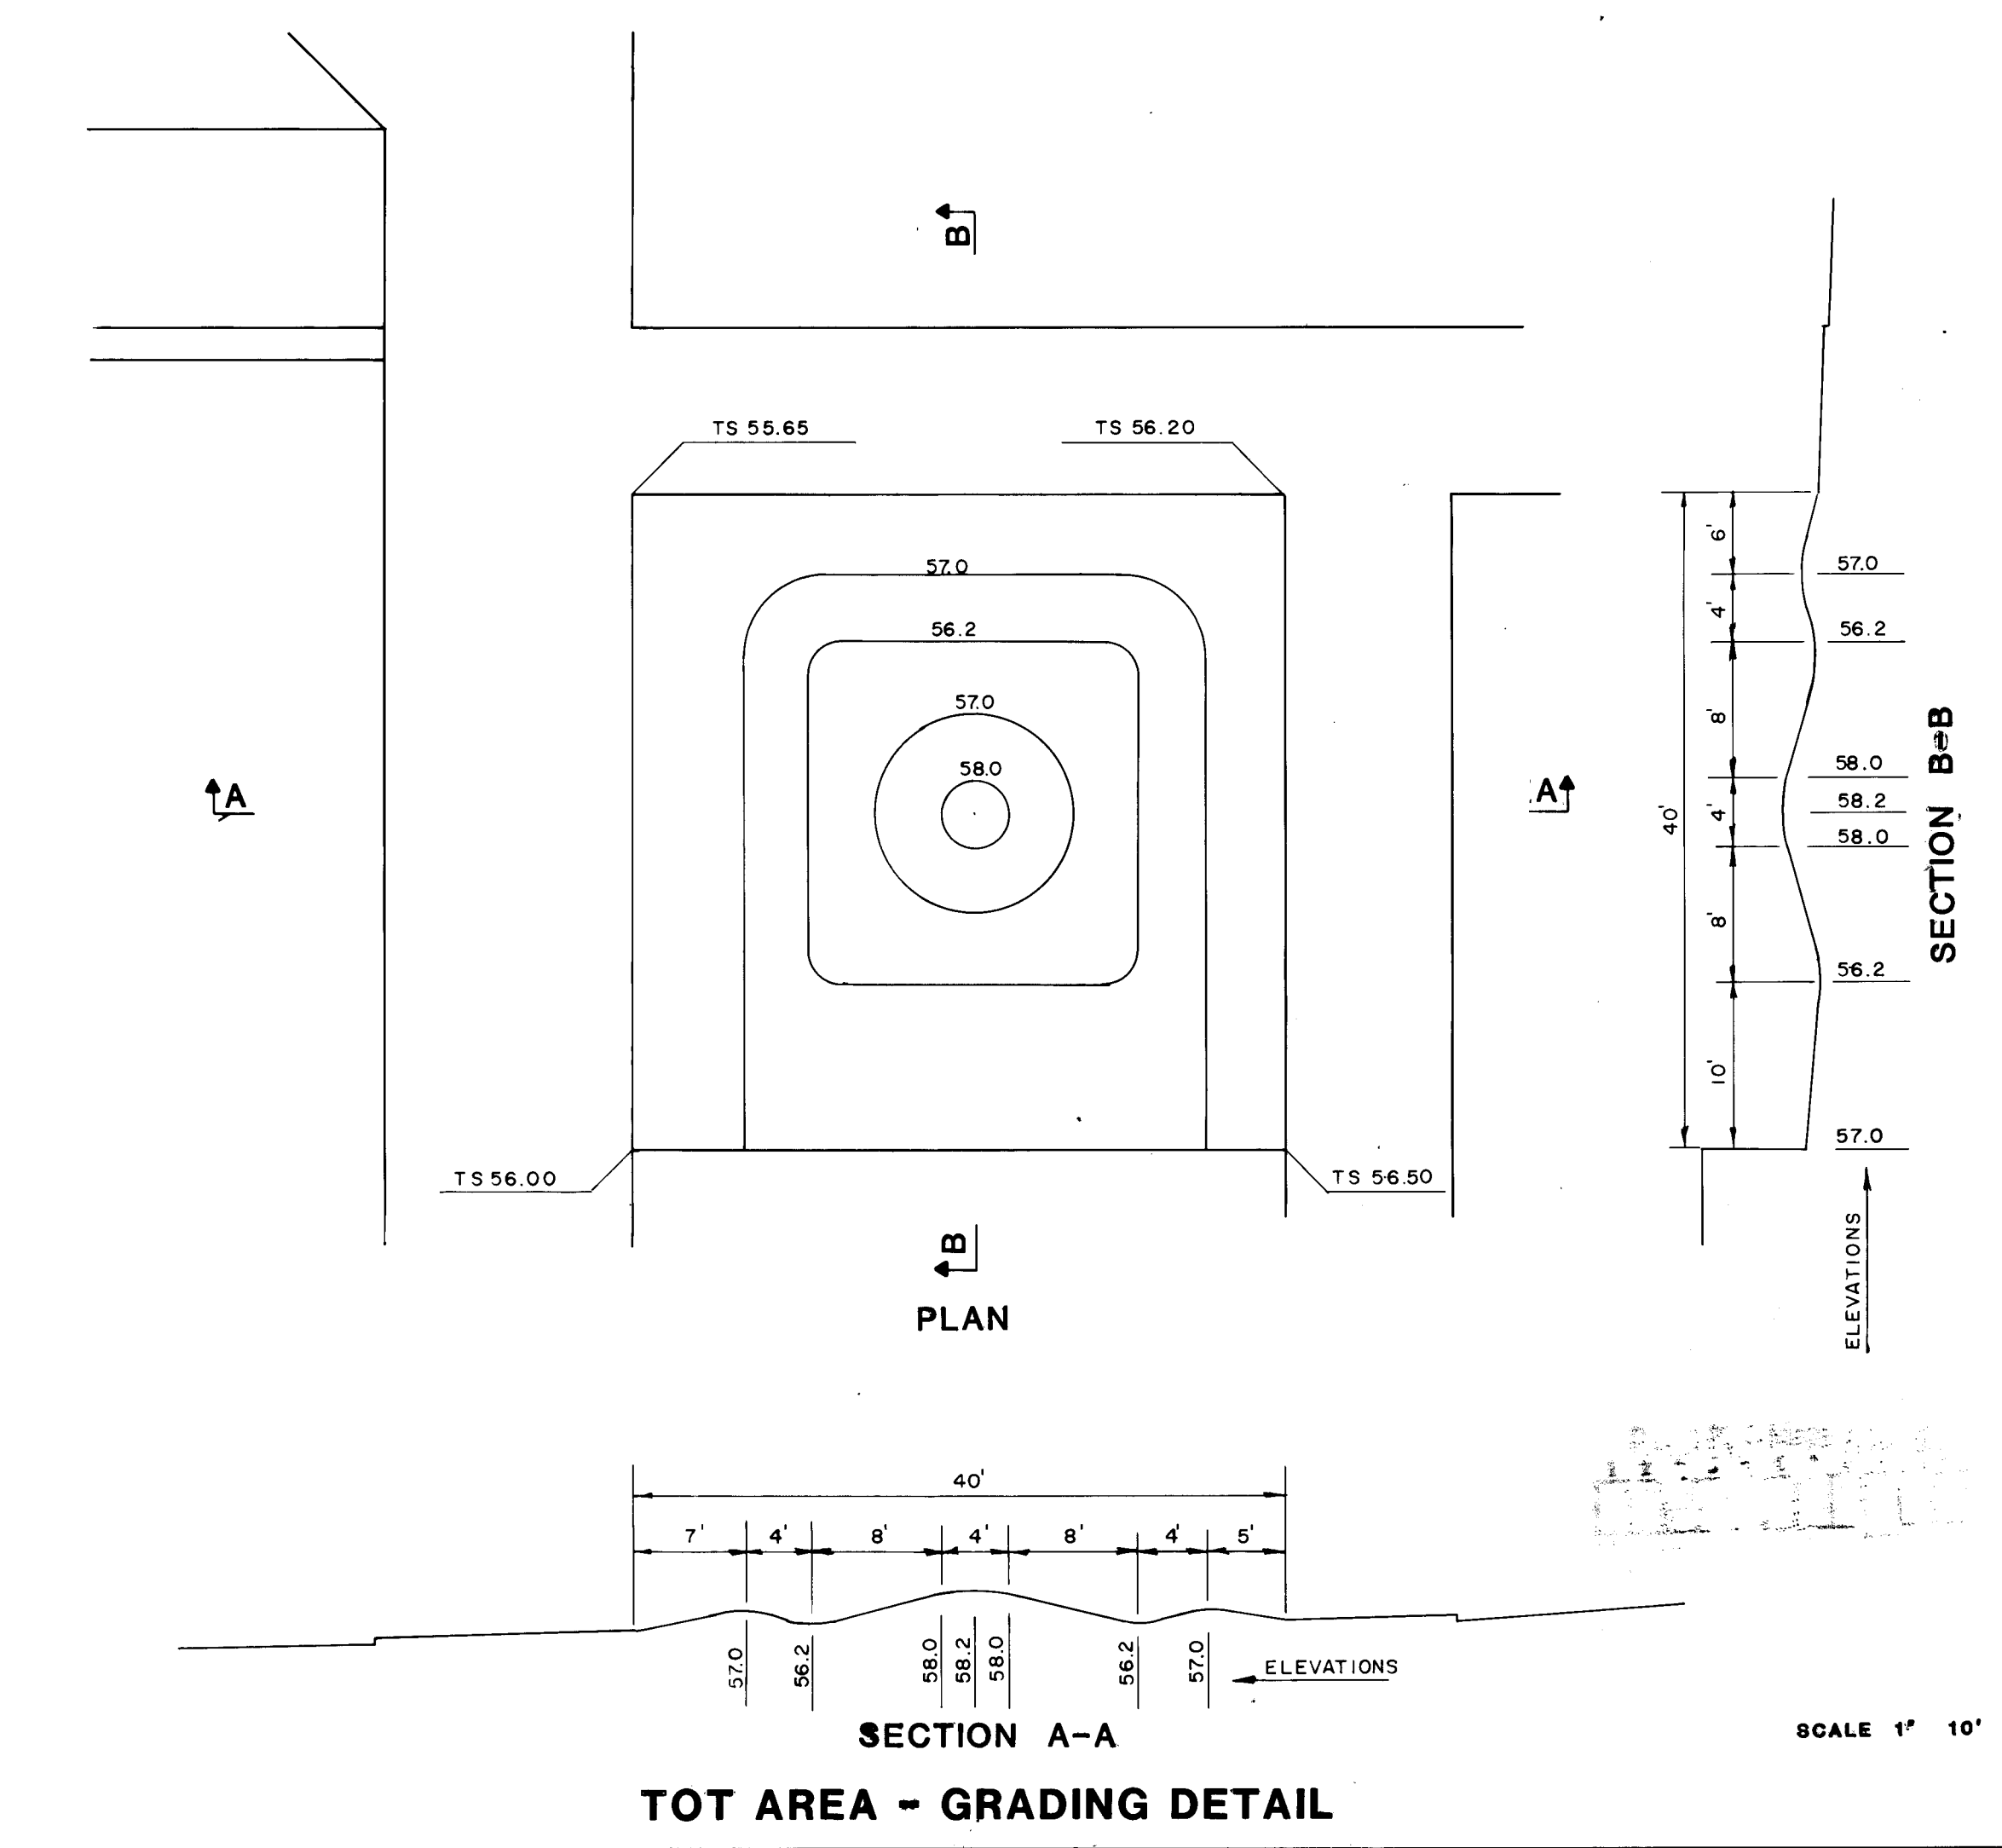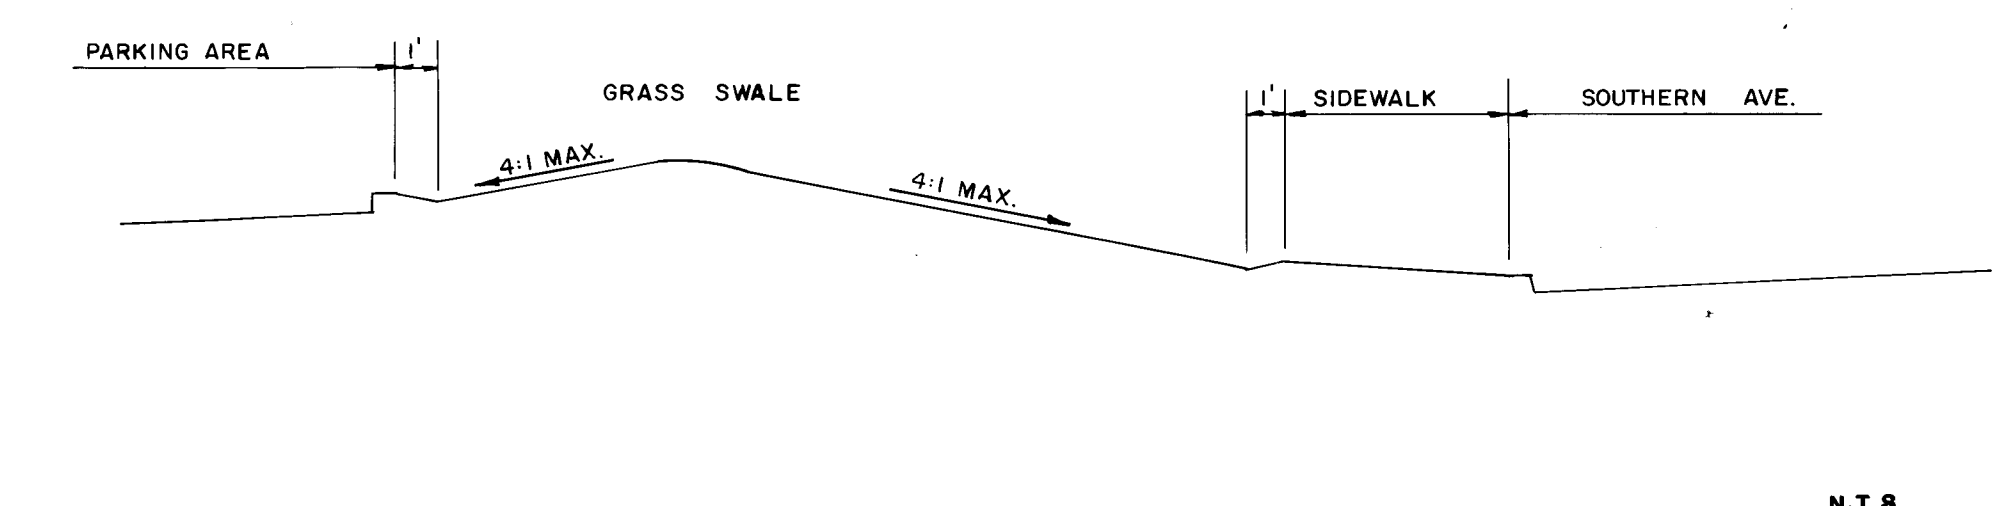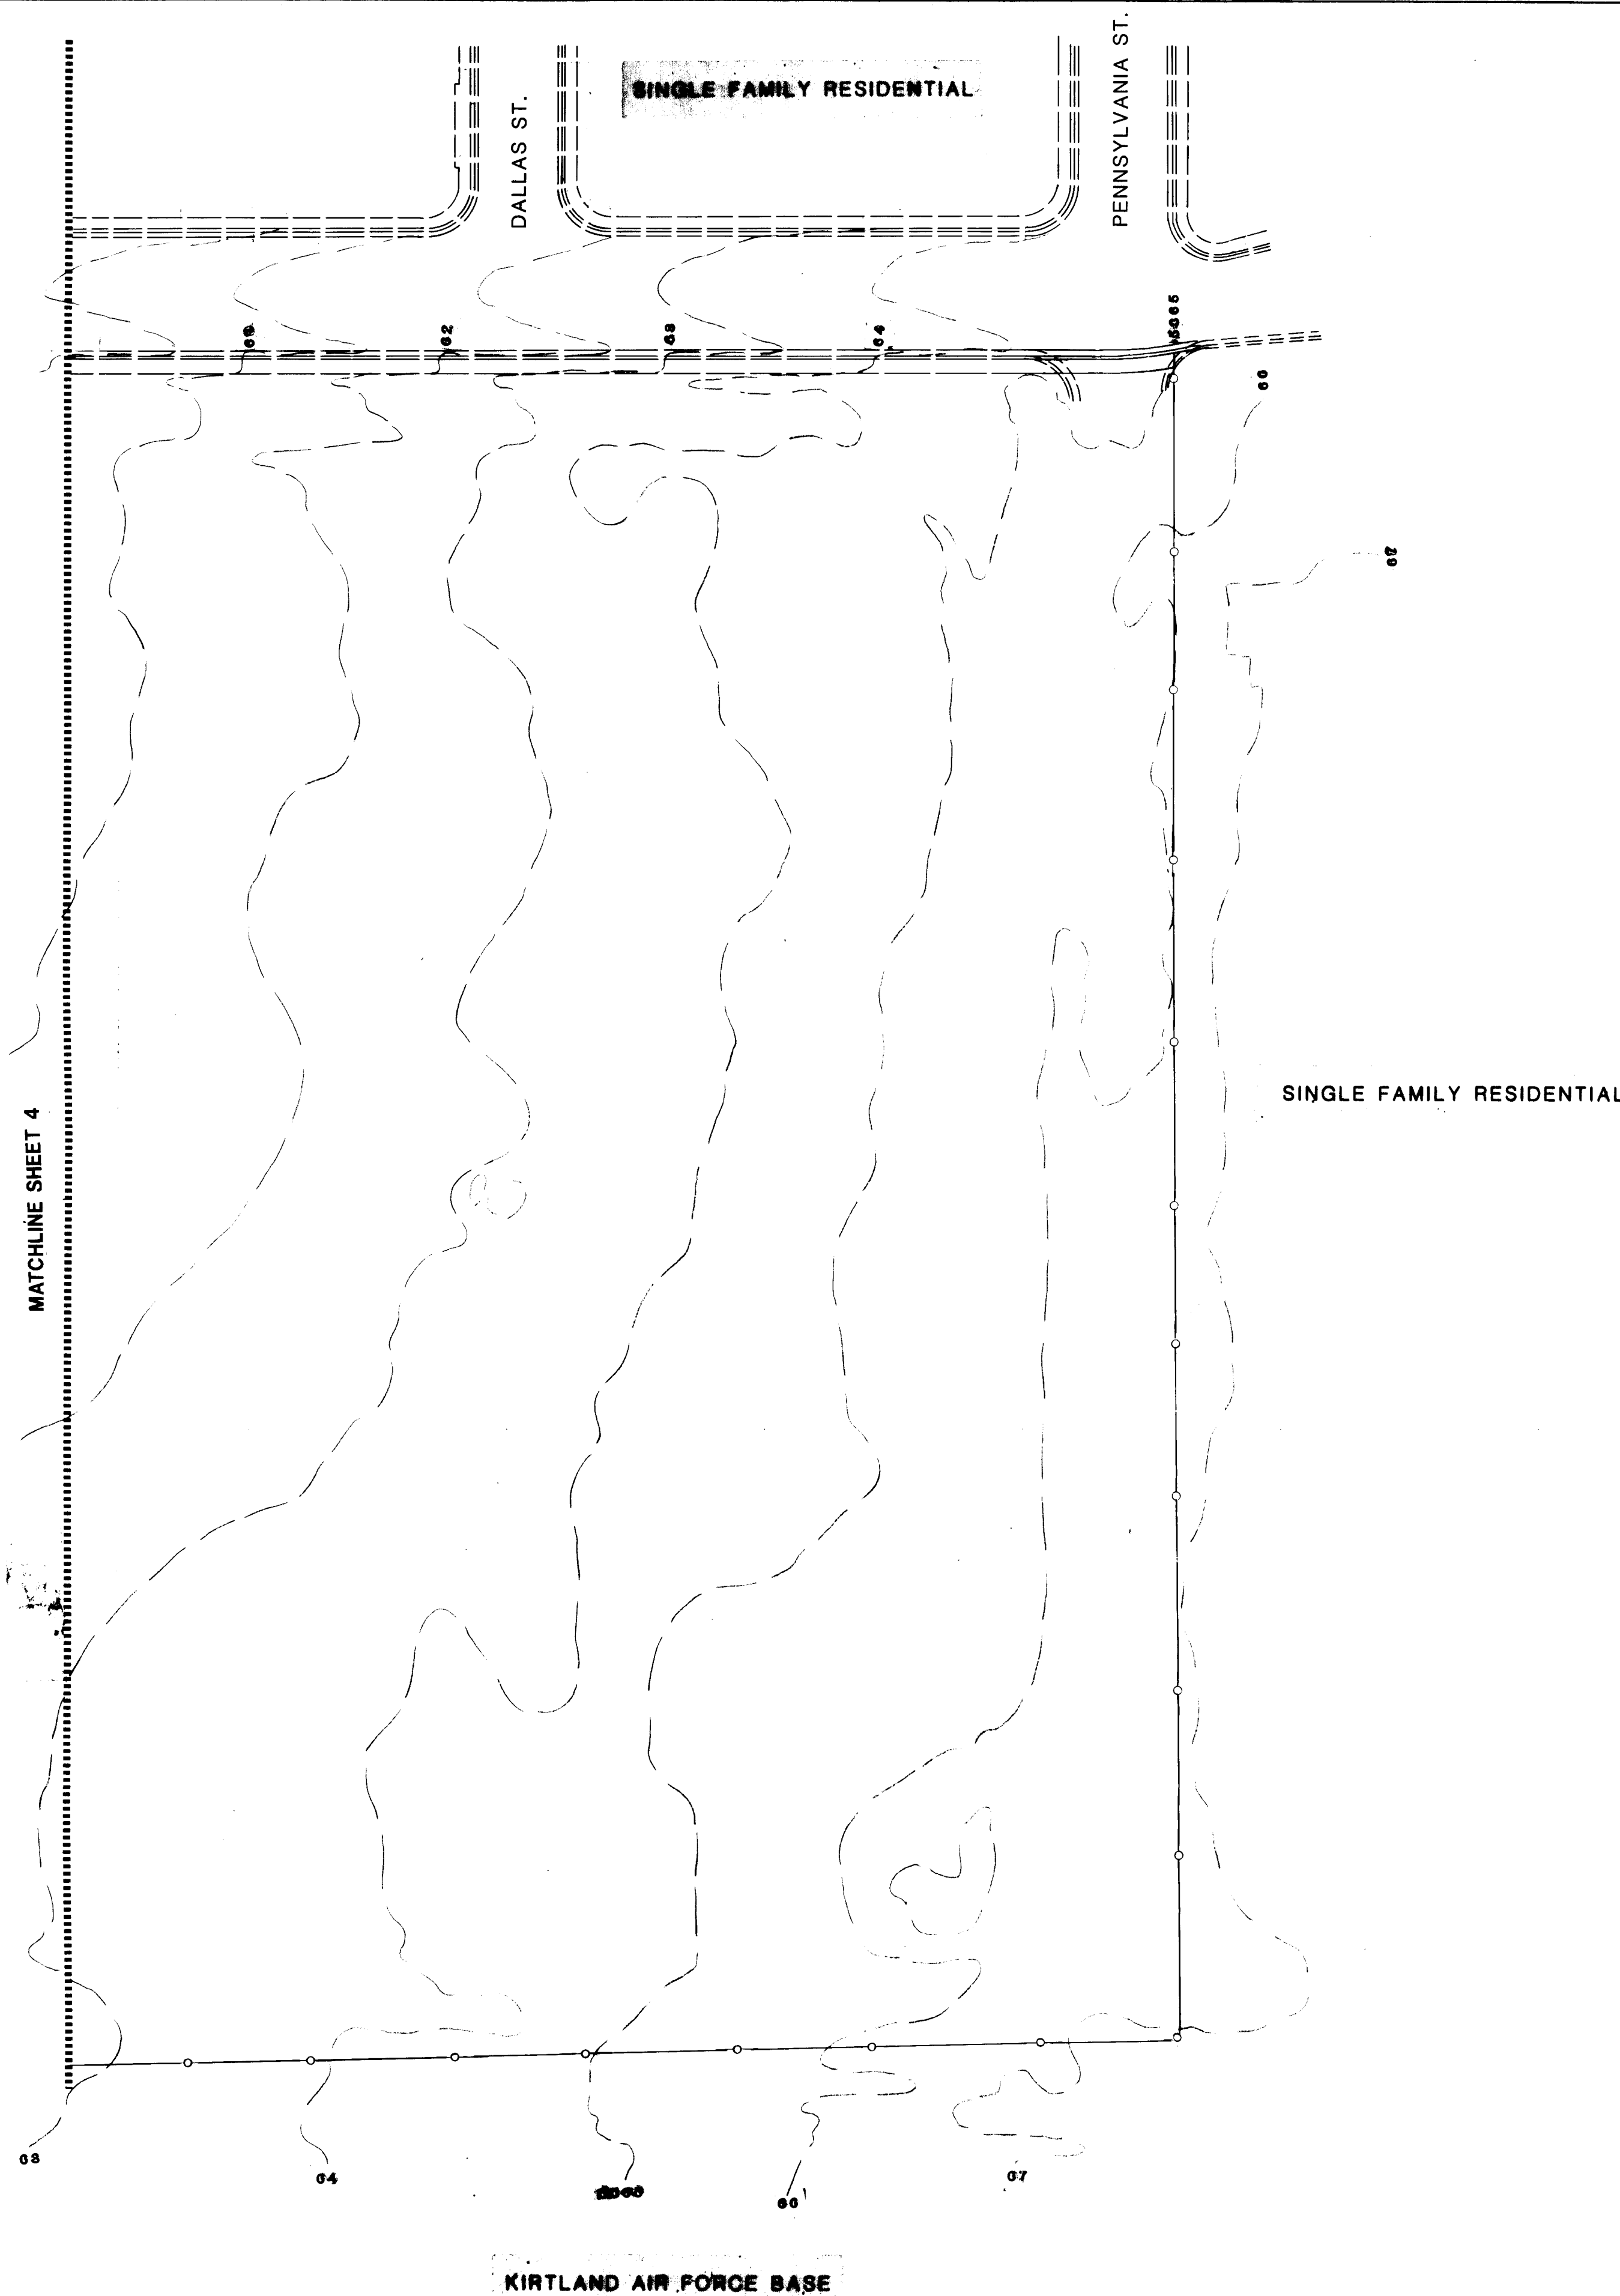

CITY OF ALBUQUERQUE PUBLIC WORKS DEPARTMENT ENGINEERING GROUP					
TITLE: PHIL CHACON PARK - PHASES I & II GRADING PLAN					
APPROVALS	ENGINEER	DATE	APPROVALS	ENGINEER	DATE
D.R.C. Chair	<i>[Signature]</i>	6/12/90	Hydrology	<i>[Signature]</i>	9/1/90
Trans. Dev	<i>[Signature]</i>	9-17-90			
Utility Dev	<i>[Signature]</i>	9-5-90			
DRAWING NO.	2746	MAP NO.	L-19	SHEET	5 OF 5

ENGINEER'S SEAL		SURVEY INFORMATION		BENCH MARKS		AS BUILT INFORMATION									
	FIELD NOTES		NO.		BY	DATE	BW ACS 7-LIB	ELEV. 5335.039	3"BRASS TABLET IN THE TOP OF SIDEWALK AT SW CORNER OF LOUISIANA AND KATHRYN, 34' WEST OF CENTERLINE LOUISIANA AND 27.5' SOUTH OF CENTERLINE KATHRYN.	TBM NO. 4 REBAR	ELEV. 5350.61	3480 NORTH, 1503 EAST	TBM NO. 4 REBAR	ELEV. 5357.68	2917 NORTH, 1996 EAST
	REMARKS		BY												
	REVISIONS														
	DESIGN														
	DESIGNED BY JJB		DATE 04/90												
	DRAWN BY EER		DATE 04/90												
	CHECKED BY JJB		DATE 04/90												
				</											

125872

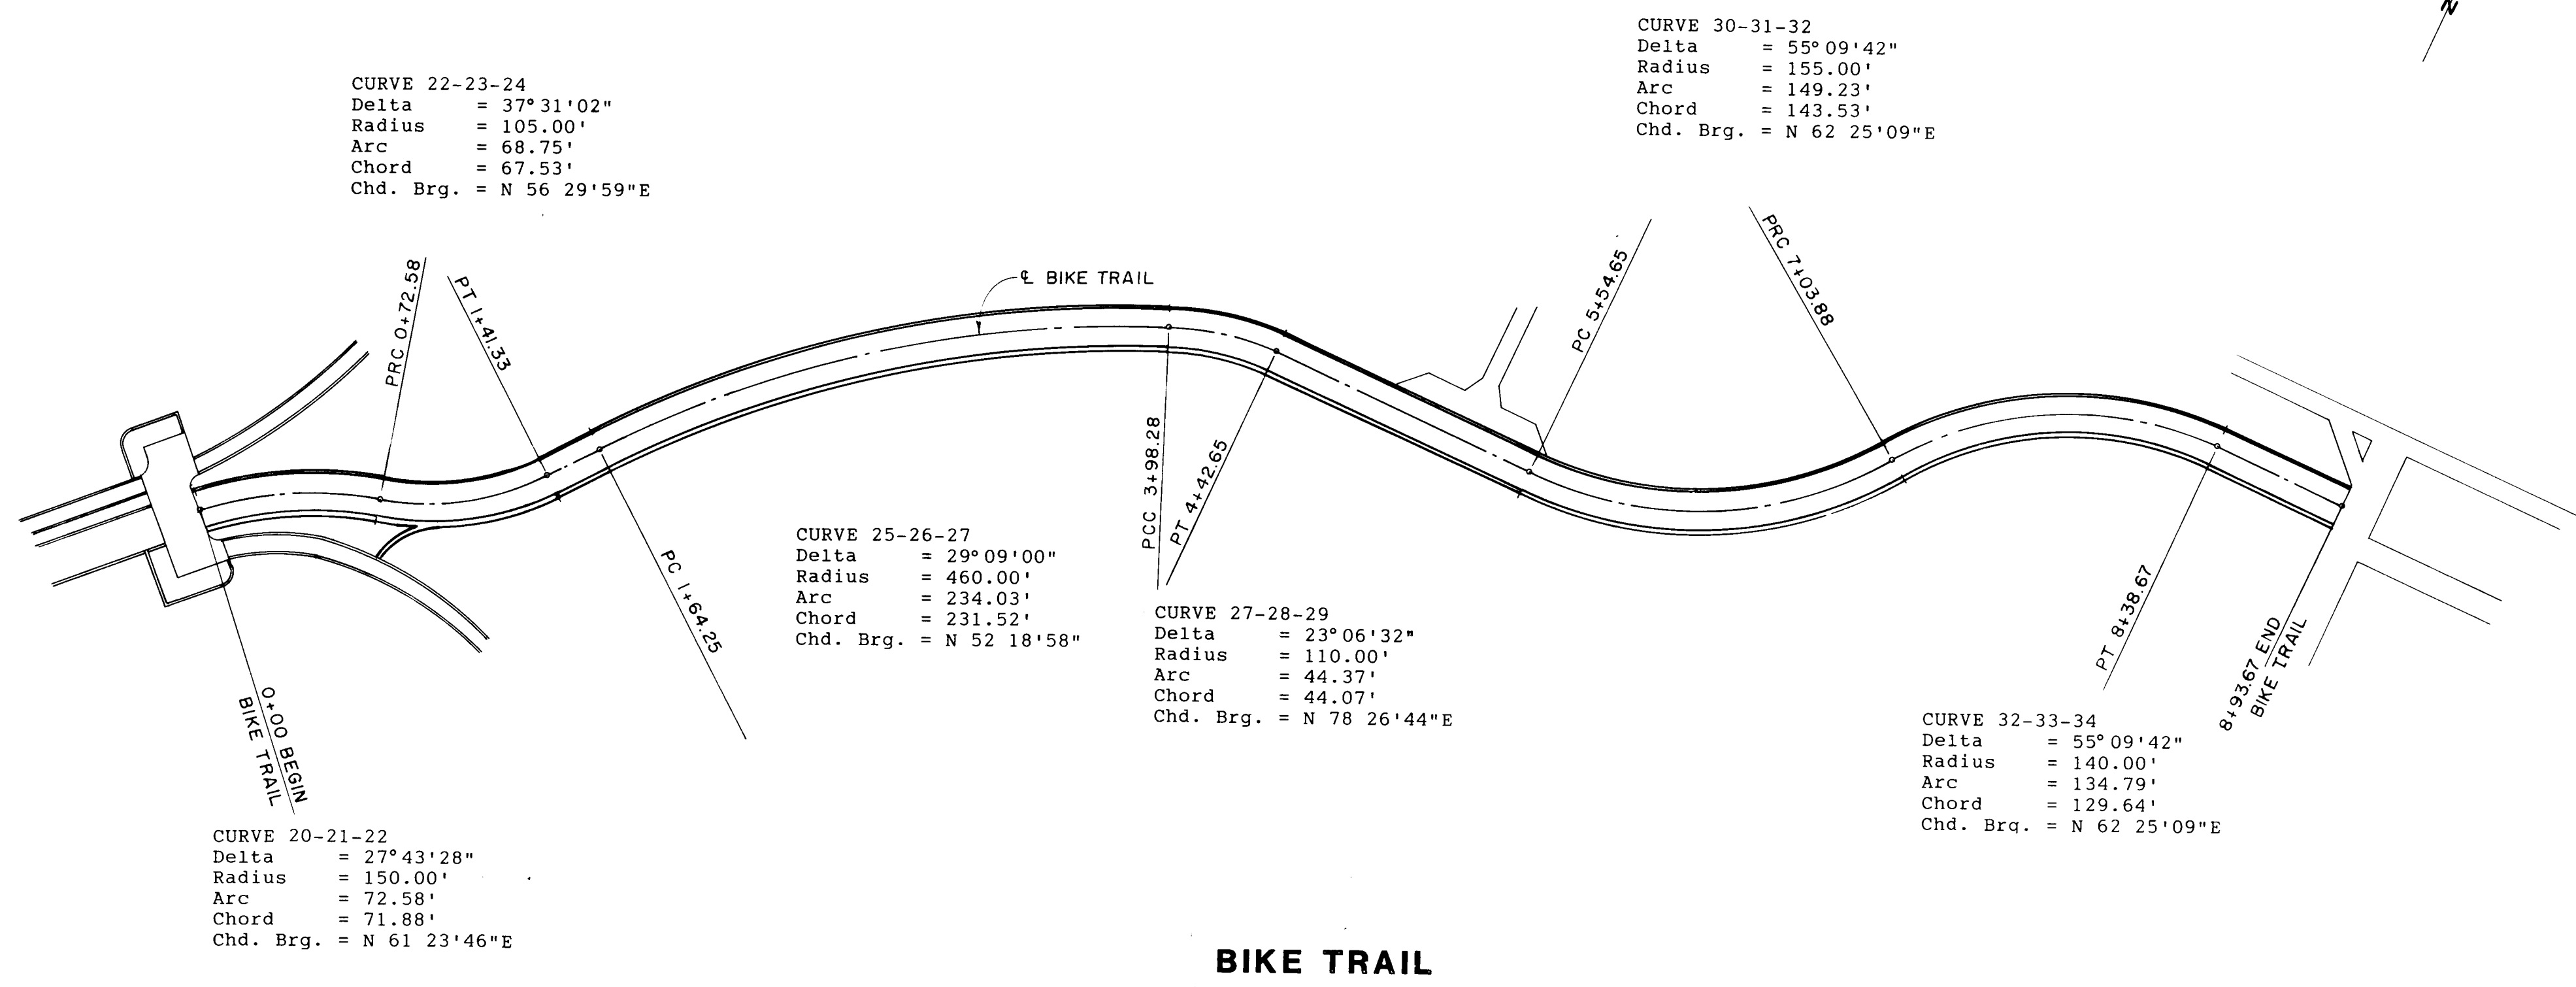

CURVE 20-21-22
Delta = 27°43'28"
Radius = 150.00'
Arc = 72.58'
Chord = 71.88'
Chd. Brg. = N 61°23'46"E

CURVE 22-23-24
Delta = 37°31'02"
Radius = 105.00'
Arc = 68.75'
Chord = 67.53'
Chd. Brg. = N 56°29'59"E

CURVE 25-26-27
Delta = 29°09'00"
Radius = 460.00'
Arc = 234.03'
Chord = 231.52'
Chd. Brg. = N 52°18'58"




CURVE 27-28-29
Delta = 23°06'32"
Radius = 110.00'
Arc = 44.37'
Chord = 44.07'
Chd. Brg. = N 78°26'44"E

CURVE 30-31-32
Delta = 55°09'42"
Radius = 155.00'
Arc = 149.23'
Chord = 143.53'
Chd. Brg. = N 62°25'09"E

CURVE 32-33-34
Delta = 55°09'42"
Radius = 140.00'
Arc = 134.79'
Chord = 129.64'
Chd. Brg. = N 62°25'09"E

BIKE TRAIL


SCALE
HORIZONTAL 1"=50'
VERTICAL 1"=5'

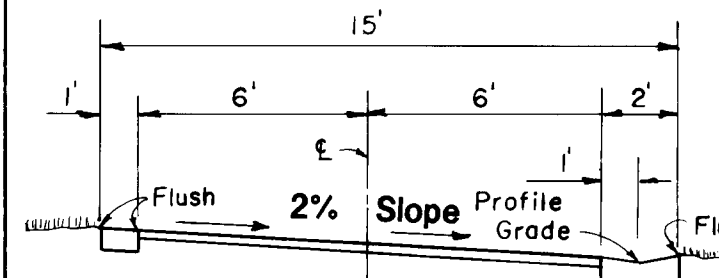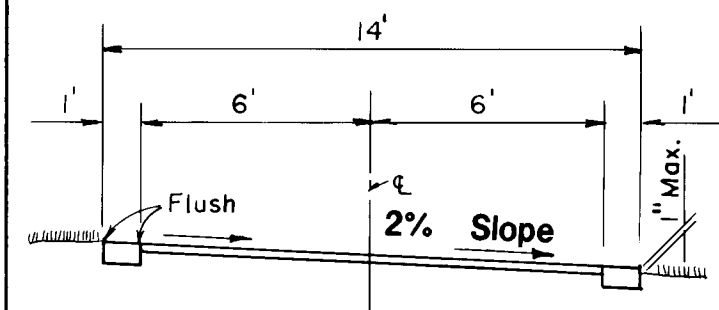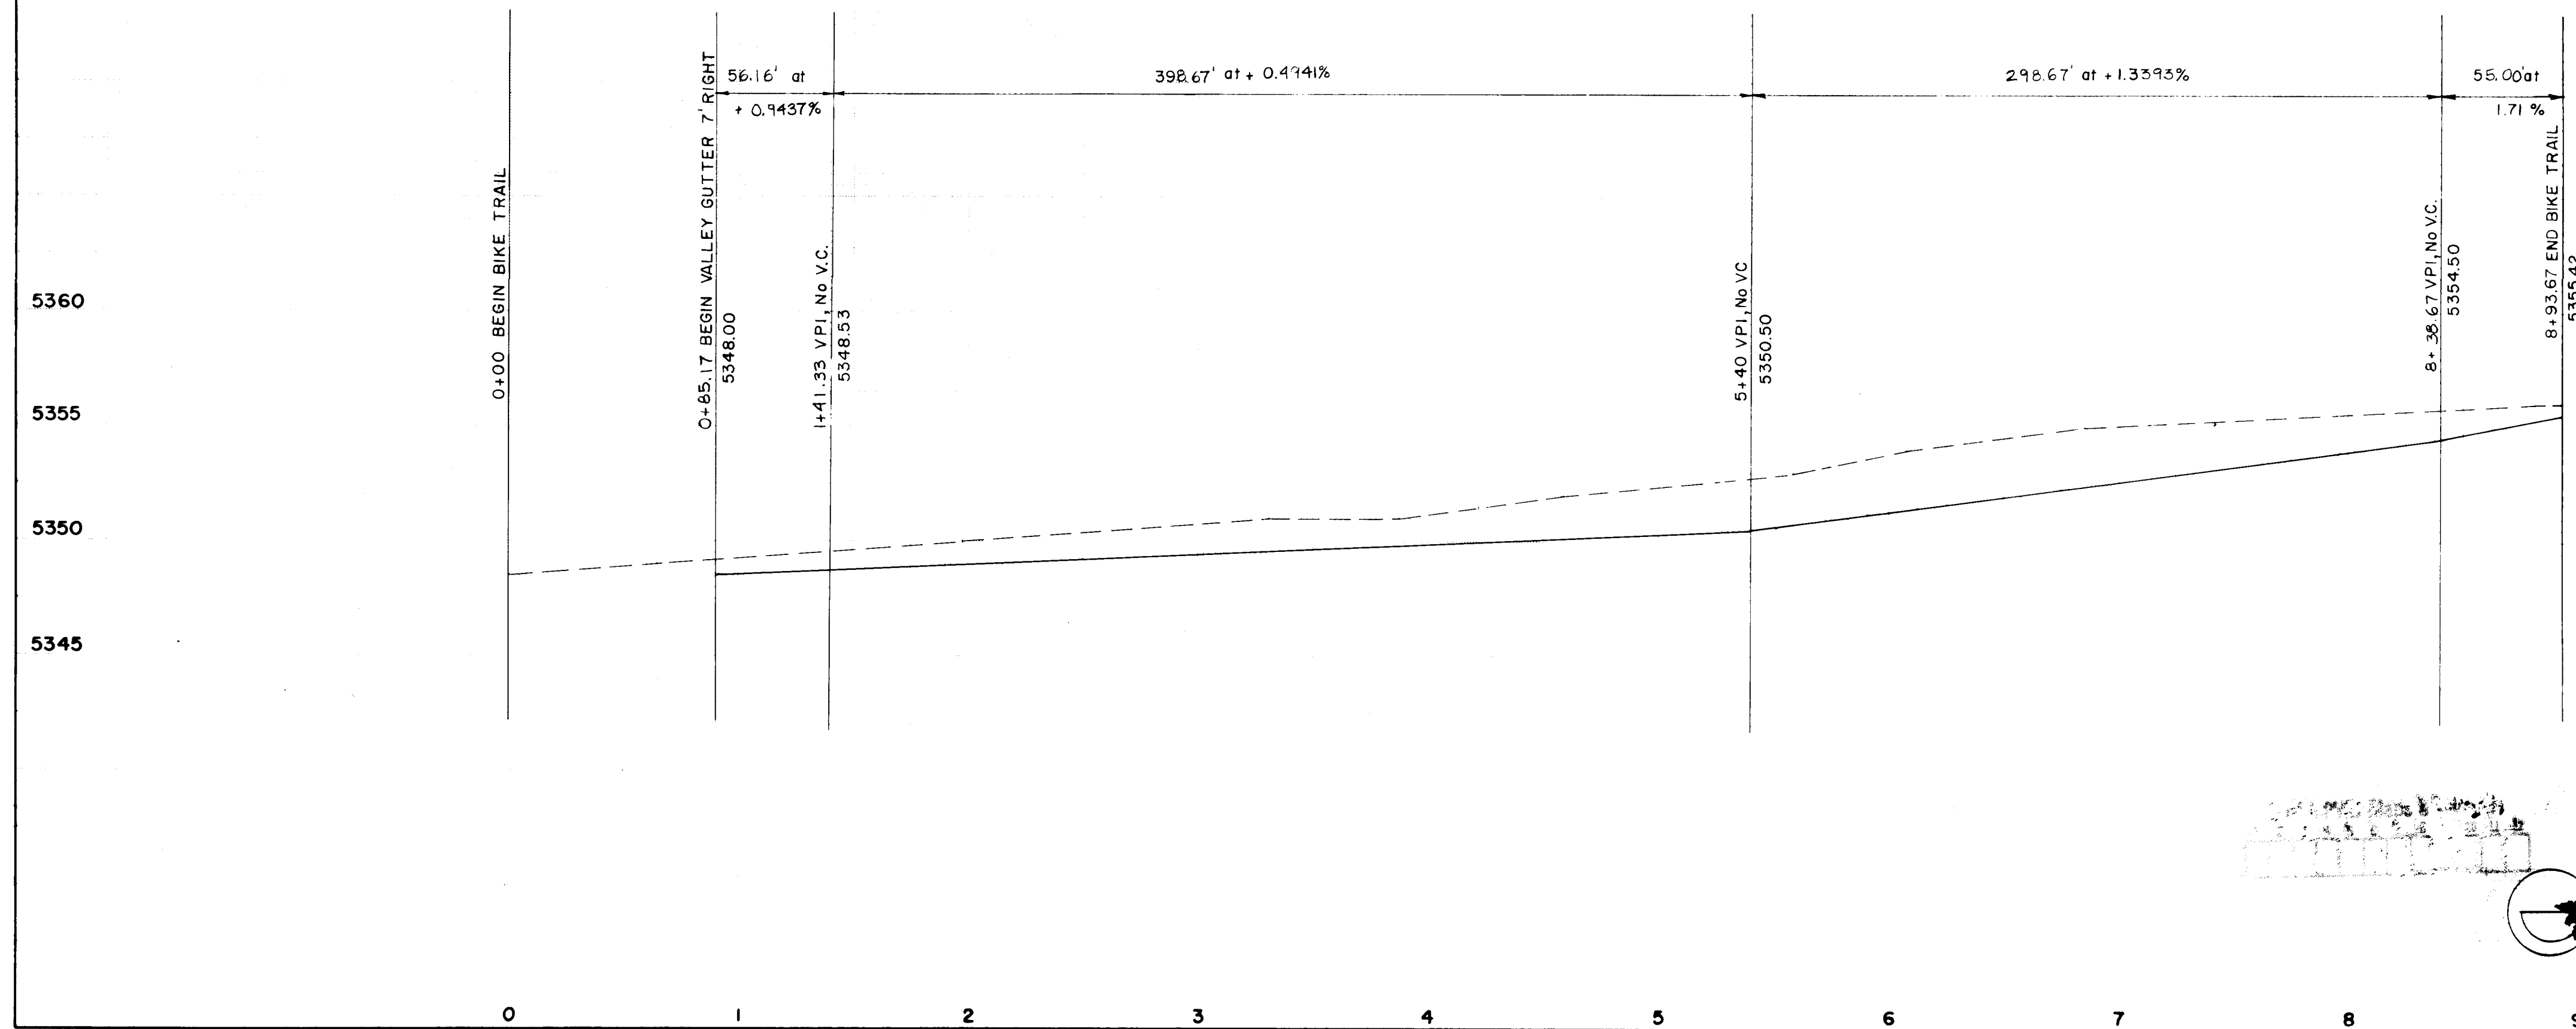

TYPICAL SECTIONS

NOTE:
SEE DETAILS H18 & H18 FOR
PAVING MATERIALS.

C of A PWD Maps & Records
26 27460693

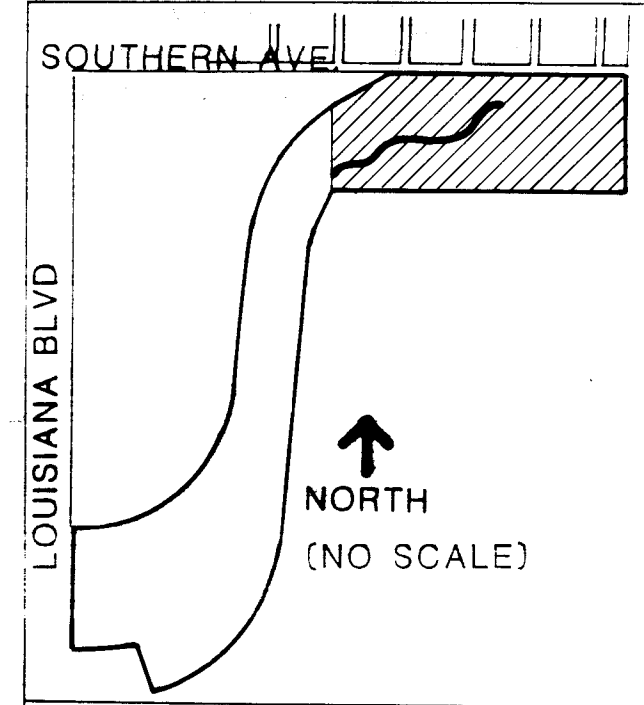

ENGINEER'S SEAL			SURVEY INFORMATION		BENCH MARKS		AS BUILT INFORMATION	
			FIELD NOTES		ELEV. 5335.039		CONTRACTOR ACCEPT LANDSCAPE	
			NO.	BY	DATE	WORK STAMPED BY		
			DATE		DATE			
					BM ACS 7-LIB		3" BRASS TABLET IN THE TOP OF SIDEWALK AT SW CORNER OF LOUISIANA AND KATHRYN, 34' WEST OF CENTERLINE LOUISIANA AND 275' SOUTH OF CENTERLINE KATHRYN.	
					TBM NO. 4 REBAR		ELEV. 5350.61	
					3480 NORTH, I503 EAST		RECORDED BY	
					TBM NO. 4 REBAR		NO	
					2917 NORTH, 1996 EAST			


CITY OF ALBUQUERQUE
PUBLIC WORKS DEPARTMENT
ENGINEERING GROUP

TITLE: **PHIL CHACON PARK PHASES I & II**
BIKE TRAIL P&P

APPROVALS	ENGINEER	DATE	APPROVALS	ENGINEER	DATE
D.R.C. Chair		9/7/90	Hydrology	N/A	9/7/90
Trans. Dev	R.W. Kane	9-17-90			
Utility Dev	Tanks	15-90			

DRAWING NO. 2746 MAP NO. L 19 SHEET 6 OF 29

MORROW & COMPANY
LANDSCAPE ARCHITECTS
210 La Veta Drive NE
Albuquerque, New Mexico 87108
505 268-2266

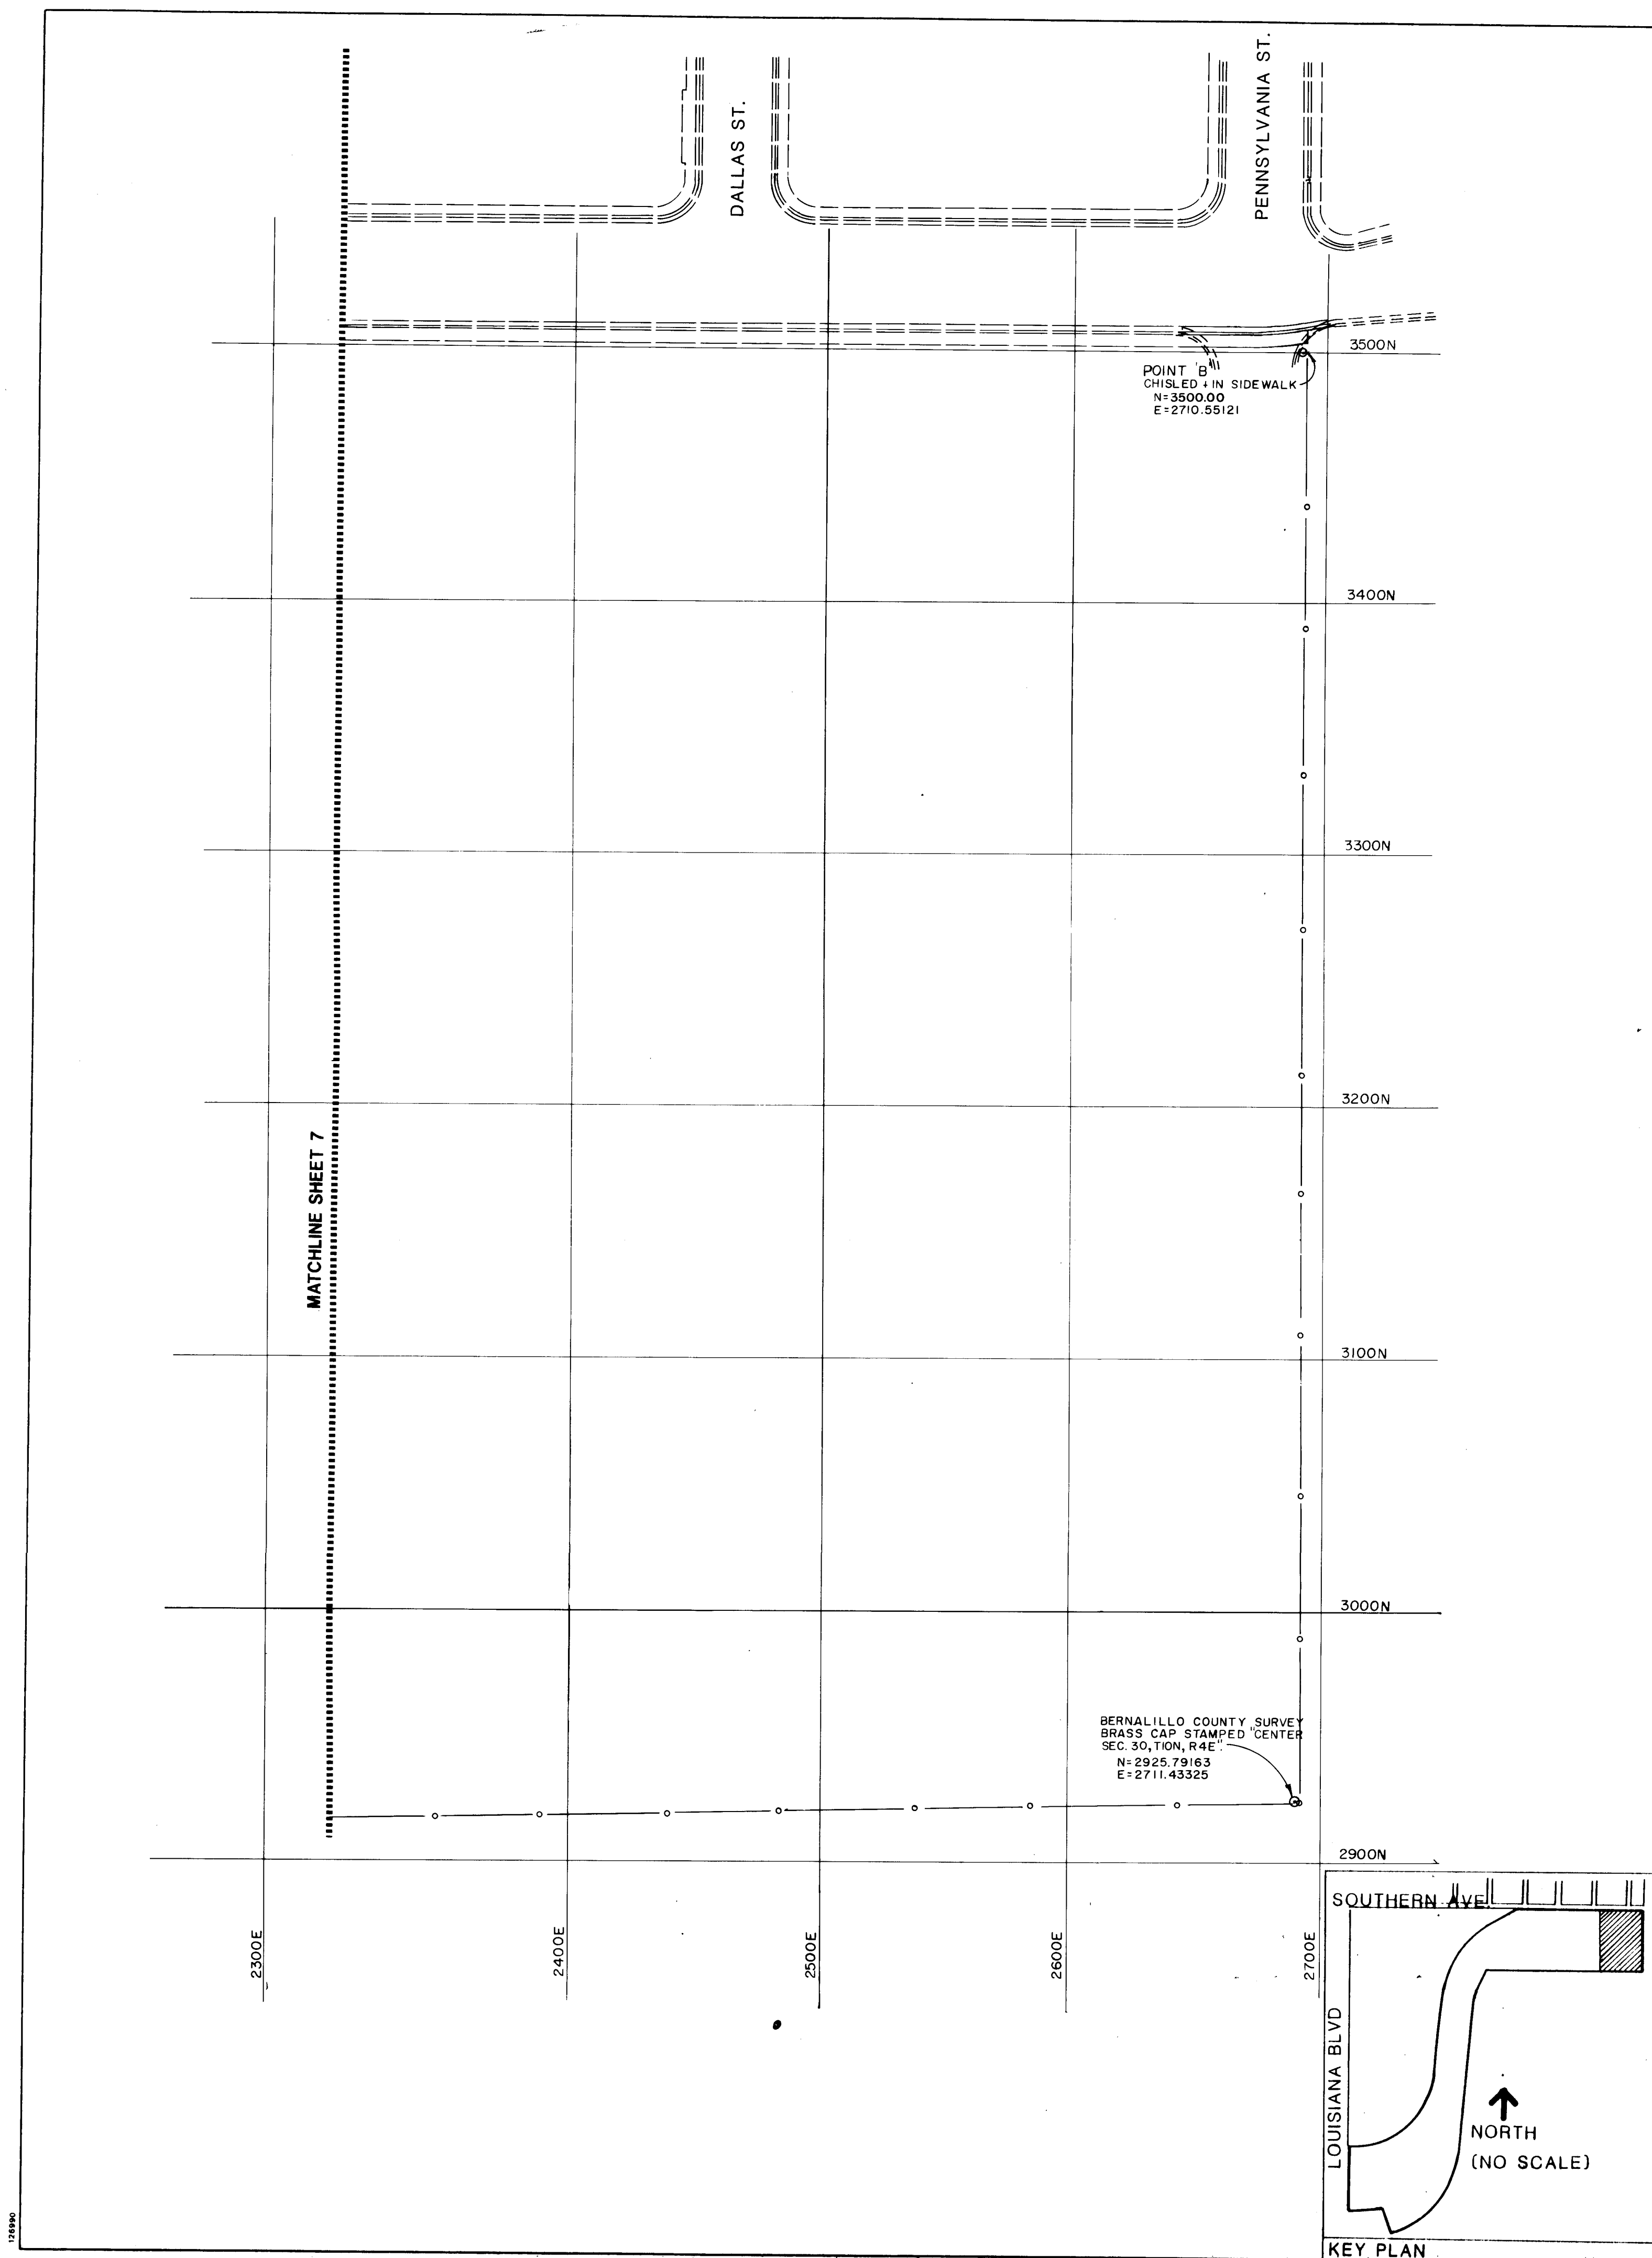


COORDINATE DATA

PT. NO.	NORTH	EAST	PT. NO.	NORTH	EAST
PED. TRAIL 'A'			PARKING LOT		
2	3504.00000	1588.50000	68	3510.00	1587.00
3	3462.50000	1588.50000	69	3490.00	1587.00
4	3462.50000	1638.50000	70	3490.00	1607.00
5	3412.50000	1638.50000	71	3466.00	1607.00
PED. TRAIL 'B'			72	3466.00	1637.00
6	3452.12348	1588.50000	73	3436.00	1637.00
7	3452.12348	1488.50000	74	3436.00	1641.50
8	3385.66599	1563.22227	75	3428.00	1641.50
PED. TRAIL 'C'			76	3428.00	1649.50
9	3412.50000	1623.00000	77	3431.00	1769.50
10	3332.50000	1623.00000	78	3431.00	1774.50
11	3369.54203	1552.09240	79	3431.00	1779.50
12	3306.16836	1518.98609	80	3431.00	1889.50
13	3452.02134	1239.78740	81	3431.00	1894.50
14	3152.80925	1338.26139	82	3431.00	1899.50
15	3146.86955	1320.21367	83	3424.00	2032.00
16	3051.89159	1351.47526	84	3466.00	2032.00
17	3090.37153	1259.17941	85	3466.00	2074.00
18	3186.59640	1028.43978	86	3490.00	2074.00
19	3028.14991	1221.81690	87	3490.00	2094.00
PED. TRAIL 'D'			88	3510.00	2094.00
36	3195.00000	1987.50000	89	3490.00	2038.00
37	3195.00000	1982.50000	90	3490.00	2018.00
38	3175.00000	1980.50000	91	3510.00	2018.00
39	3188.89191	1968.11199	92	3475.00	2038.00
40	3119.43235	2040.05203	93	3475.00	2023.00
41	3135.92707	1941.42199	94	3460.00	2023.00
51	3078.15059	1931.75937	95	3463.50	2019.50
52	3103.71763	1778.88248	96	3463.50	2019.50
53	2952.05049	1746.91275	97	3465.00	1899.50
54	2963.96175	1690.40449	98	3465.00	1894.50
55	2817.18705	1659.46603	99	3465.00	1889.50
56	2961.41692	1618.26236	100	3465.00	1779.50
57	2941.77650	1549.51278	101	3465.00	1774.50
58	3076.39106	1511.05602	102	3465.00	1769.50
59	2964.79690	1426.51760	103	3475.00	1631.00
60	2993.93246	1388.05747	104	3475.00	1646.00
61	2878.35279	1300.49983	105	3460.00	1646.00
62	3021.68781	1278.58924	106	3463.50	1646.00
63	2932.72125	1292.18892	107	3463.50	1649.50
64	3007.64381	1242.32300	108	3490.00	1631.00
PED. TRAIL 'E'			109	3490.00	1651.00
42	3131.97045	1940.75963	110	3510.00	1651.00
43	3279.47221	2184.62072	111	3480.00	1649.50
44	3070.44277	1990.88974	112	3480.00	1769.50
45	3040.87330	2022.79423	113	3480.00	1779.50
46	2996.86710	1982.00876	114	3480.00	1889.50
47	2937.00000	1986.00000	115	3480.00	1899.50
48	2925.9568	1820.3677	116	3480.00	2019.50
49	2980.63496	1816.70912	117	3424.00	2012.50
50	2948.87276	1771.94956	118	3416.00	2012.50
PED. TRAIL 'F'			119	3416.00	1899.50
155	3269.34495	2219.00	120	3416.00	1889.50
156	3271.91819	2251.20749	121	3416.00	1779.50
157	3334.70282		122	3416.00	1769.50
PED. TRAIL 'G'			123	3416.00	1649.50
158	3341.79234	2246.50090	COURTS		
159	3317.20001	2322.62722	124	3409.00	1670.00
160	3392.63867	2296.00	125	3364.00	1567.50
PED. TRAIL 'H'			126	3364.00	1647.50
161	3390.36294	2290.26696	127	3371.00	1647.50
162	3481.81659	2249.81664	128	3371.00	1692.50
163	3386.68334	2219.00	129	3384.00	1692.50
BIKE TRAIL			130	3384.00	1796.50
20	3014.36133	1228.53442	131	3314.00	1796.50
21	2903.70981	1329.80752	132	3314.00	1692.50
22	3048.77225	1291.63833	133	3307.00	1692.50
23	3150.31597	1264.91989	134	3306.00	1647.50
24	3086.04604	1347.95227	135	3284.00	1647.50
25	3104.16983	1361.98073	136	3284.00	1670.00
26	2822.60631	1725.74162	137	3307.00	1670.00
27	3245.69620	1545.20090	138	3307.00	1670.00
28	3144.52253	1588.37368	139	3271.52253	1670.00
29	3254.52253	1588.37368	140	3261.52253	1637.50
30	3254.52253	1700.37368	141	3271.52253	1647.50
31	3409.52253	1700.37368	142	3271.52253	1692.50
32	3320.97680	1827.59259	143	3261.52253	1702.50
33	3241.00000	1942.50000	TURN AROUND		
34	3381.00000	1942.50000	144	3043.70626	1206.26055
35	3381.00000	1997.50000	145	2980.06665	1233.83772
BASEBALL DIAMOND			ENTRY		
66	3441.00000	1244.00000	146	3180.00	1987.50
65	3441.00000	1524.00000	147	3180.00	2134.50
67	3161.00000	1244.00000	148	3365.00	2109.00
UTILITY AREA			149	3365.00	2134.50
165	3495.66667	2236.50	150	3365.00	2219.00
166	3495.66667	2278.50	151	3504.00	2219.00
167	3474.00	2278.50	WEST FENCE		
168	3474.00	2236.50	152	3504.00	1215.00
VALLEY GUTTER			153	3177.00	1215.00
169	3046.18842	1306.16856	VALLEY GUTTER		
170	3009.00	1320.90021	BIKE TRAIL		
171	3009.00	1280.90021	PARKING LOT		

CENTERLINE & CURVE DATA

STATION	CURVE	DELTA	RADIUS	ARC	CHORD	CHD BRG
PED. TRAIL 'A'						
BOS 0+00.00 =	BACK OF WALK SOUTHERN AVE.					
PC 0+41.50						
PT 1+20.04 =	3-4-5	90 00'00"	50.00	78.54	70.71	S45 00'00"E
EOS = PARKING LOT WALK						
PED. TRAIL 'B'						
BOS 0+00.00 =	PC 0+41.50 PED. TRAIL 'A'					
PC 0+10.38						
PT 0+83.07 =	6-7-8	41 38'59"	100.00	72.69	71.10	S20 49'30"W
EOS						
PED. TRAIL 'C'						
BOS 0+00.00 =	PT 1+20.04 PED. TRAIL 'A'					
PC 0+15.50						
PT 1+02.65	9-10-11	62 25'03"	80.00	87.15	82.91	S58 47'29"W
PC 1+74.15						
PT 4+17.16	12-13-14	44 12'02"	315.00	243.01	237.02	S49 40'58"W
PC 4+36.16						
PT 5+21.94	15-16-17	49 08'44"	100.00	85.78	83.17	S47 12'37"W
PC 5+94.77 =	17-18-19	16 41'33"	250.00	72.83	72.58	S30 59'02"W
EOS = TURNAROUND						
PED. TRAIL 'D'						
BOS 0+00.00 =	TOT LOT WALK					
PC 0+05.00						
PT 37-38-39	37-38-39	46 00'18"	20.00	16.06	13.68	S69 59'51"W
PC 0+18.96	39-40-41	34 30'03"	100.00	60.22	59.31	S26 44'40"W
PC 1+37.76						
PT 51-52-53	51-52-53	92 24'32"	155.00	249.99	223.76	S58 06'27"W
PC 3+74.72						
PT 5+05.37	54-55-56	27 50'48"	150.00	72.90	72.19	S87 58'47"W
PC 5+76.87	57-58-59	53 05'22"	140.00	129.72	125.13	N79 23'56"W
PT 7+06.59						
PC 7+54.85	60-61-62	45 50'13"	145.00	116.00	112.93	N75 46'22"W
PC 8+70.84	62-63-64	24 57'19"	90.00	39.20	38.89	S68 49'52"W
PT 9+10.04 =	EOS = TURNAROUND					
PED. TRAIL 'E'						
BOS 0+00.00 =	POT 0+83.19 PED. TRAIL 'D'					
PC 0+00.00	42-43-44	16 00'26"	285.00	79.62	79.36	S55 10'44"E
PT 0+79.62						
PC 1+23.12	45-46-47	133 21'39"	60.00	139.66	110.20	S16 21'30"W
PT 2+62.78						
PC 4+28.78	48-49-50	58 17'04"	55.00	55.95	51.33	N66 23'02"W
PT 4+84.73 =	EOS = POC 3+49.45 PED. TRAIL 'D'					
PED. TRAIL 'F'						
BOS 0+00.00 =	ENTRY WALK					
PC 0+00.00						
PT 0+47.61 =	155-156-157	22 44'00"	120.00	47.61	47.30	S42 54'51"E
EOS						
PED. TRAIL 'G'						
BOS 0+00.00 =	POC 0+39.10 PED. TRAIL 'F'					
PC 0+00.00						
PT 0+00.00 =	158-159-160	52 39'22"	80.00	73.52	70.96	N44 13'51"E
EOS						
PED. TRAIL 'H'						
BOS 0+00.00 =	POC 0+67.35 PED. TRAIL 'G'					
PC 0+00.00						
PT 0+72.97 =	161-162-163	41 48'32"	100.00	72.97	71.36	S87 02'40"W
EOS						
BIKE TRAIL						
BOS 0+00.00 =	TURNAROUND					
PC 0+00.00						
PT 20-21-22	20-21-22	27 43'28"	150.00	72.58	71.88	N61 23'46"E
PC 0+72.58	22-23-24	37 31'02"	105.00	68.75	67.53	N52 18'58"E
PC 1+64.25						
PT 25-26-27	25-26-27	29 09'00"	460.00	234.03	231.52	N52 29'59"E
PC 3+98.28	27-28-29	23 06'32"	110.00	44.37	44.07	N78 26'44"E
PT 4+42.65						
PC 5+54.65	30-31-32	55 09'42"	155.00	149.23	143.53	N62 25'09"E
PC 7+03.88	32-33-34	55 09'42"	140.00	134.79	129.64	N62 25'09"E
PT 8+38.67						
EOS 8+93.67 =	TOT LOT WALK					
PARKING LOT						
68-69-70	68-69-70	89-90-91	90 00'00"	20.00	31.42	28.28
86-87-88	86-87-88	108-109-110				
77-78-79	77-78-79	97-98-99	180 00'00"	5.00	15.71	10.00
80-81-82	80-81-82	100-101-102				
92-93-94	92-93-94	103-104-105	90 00'00"	15.00	23.56	21.28
94-95-96	94-95-96	105-106-107	90 00'00"	3.50	5.50	4.85
71-72-73	71-72-73	90 00'00"	30.00	47.12	42.45	
74-75-76	74-75-76	90 00'00"	8.00	12.57	11.31	
83-84-85	83-84-85	90 00'00"	42.00	65.97	59.40	
VALLEY GUTTER						
BOS 0+00.00 =	7 RT 0+85.17 BIKE TRAIL					
PC 0+00.00 =	169-170-171					
EOS 0+4775	68 23' 23"	40.00	47.75	44.96	S34 11' 42"	


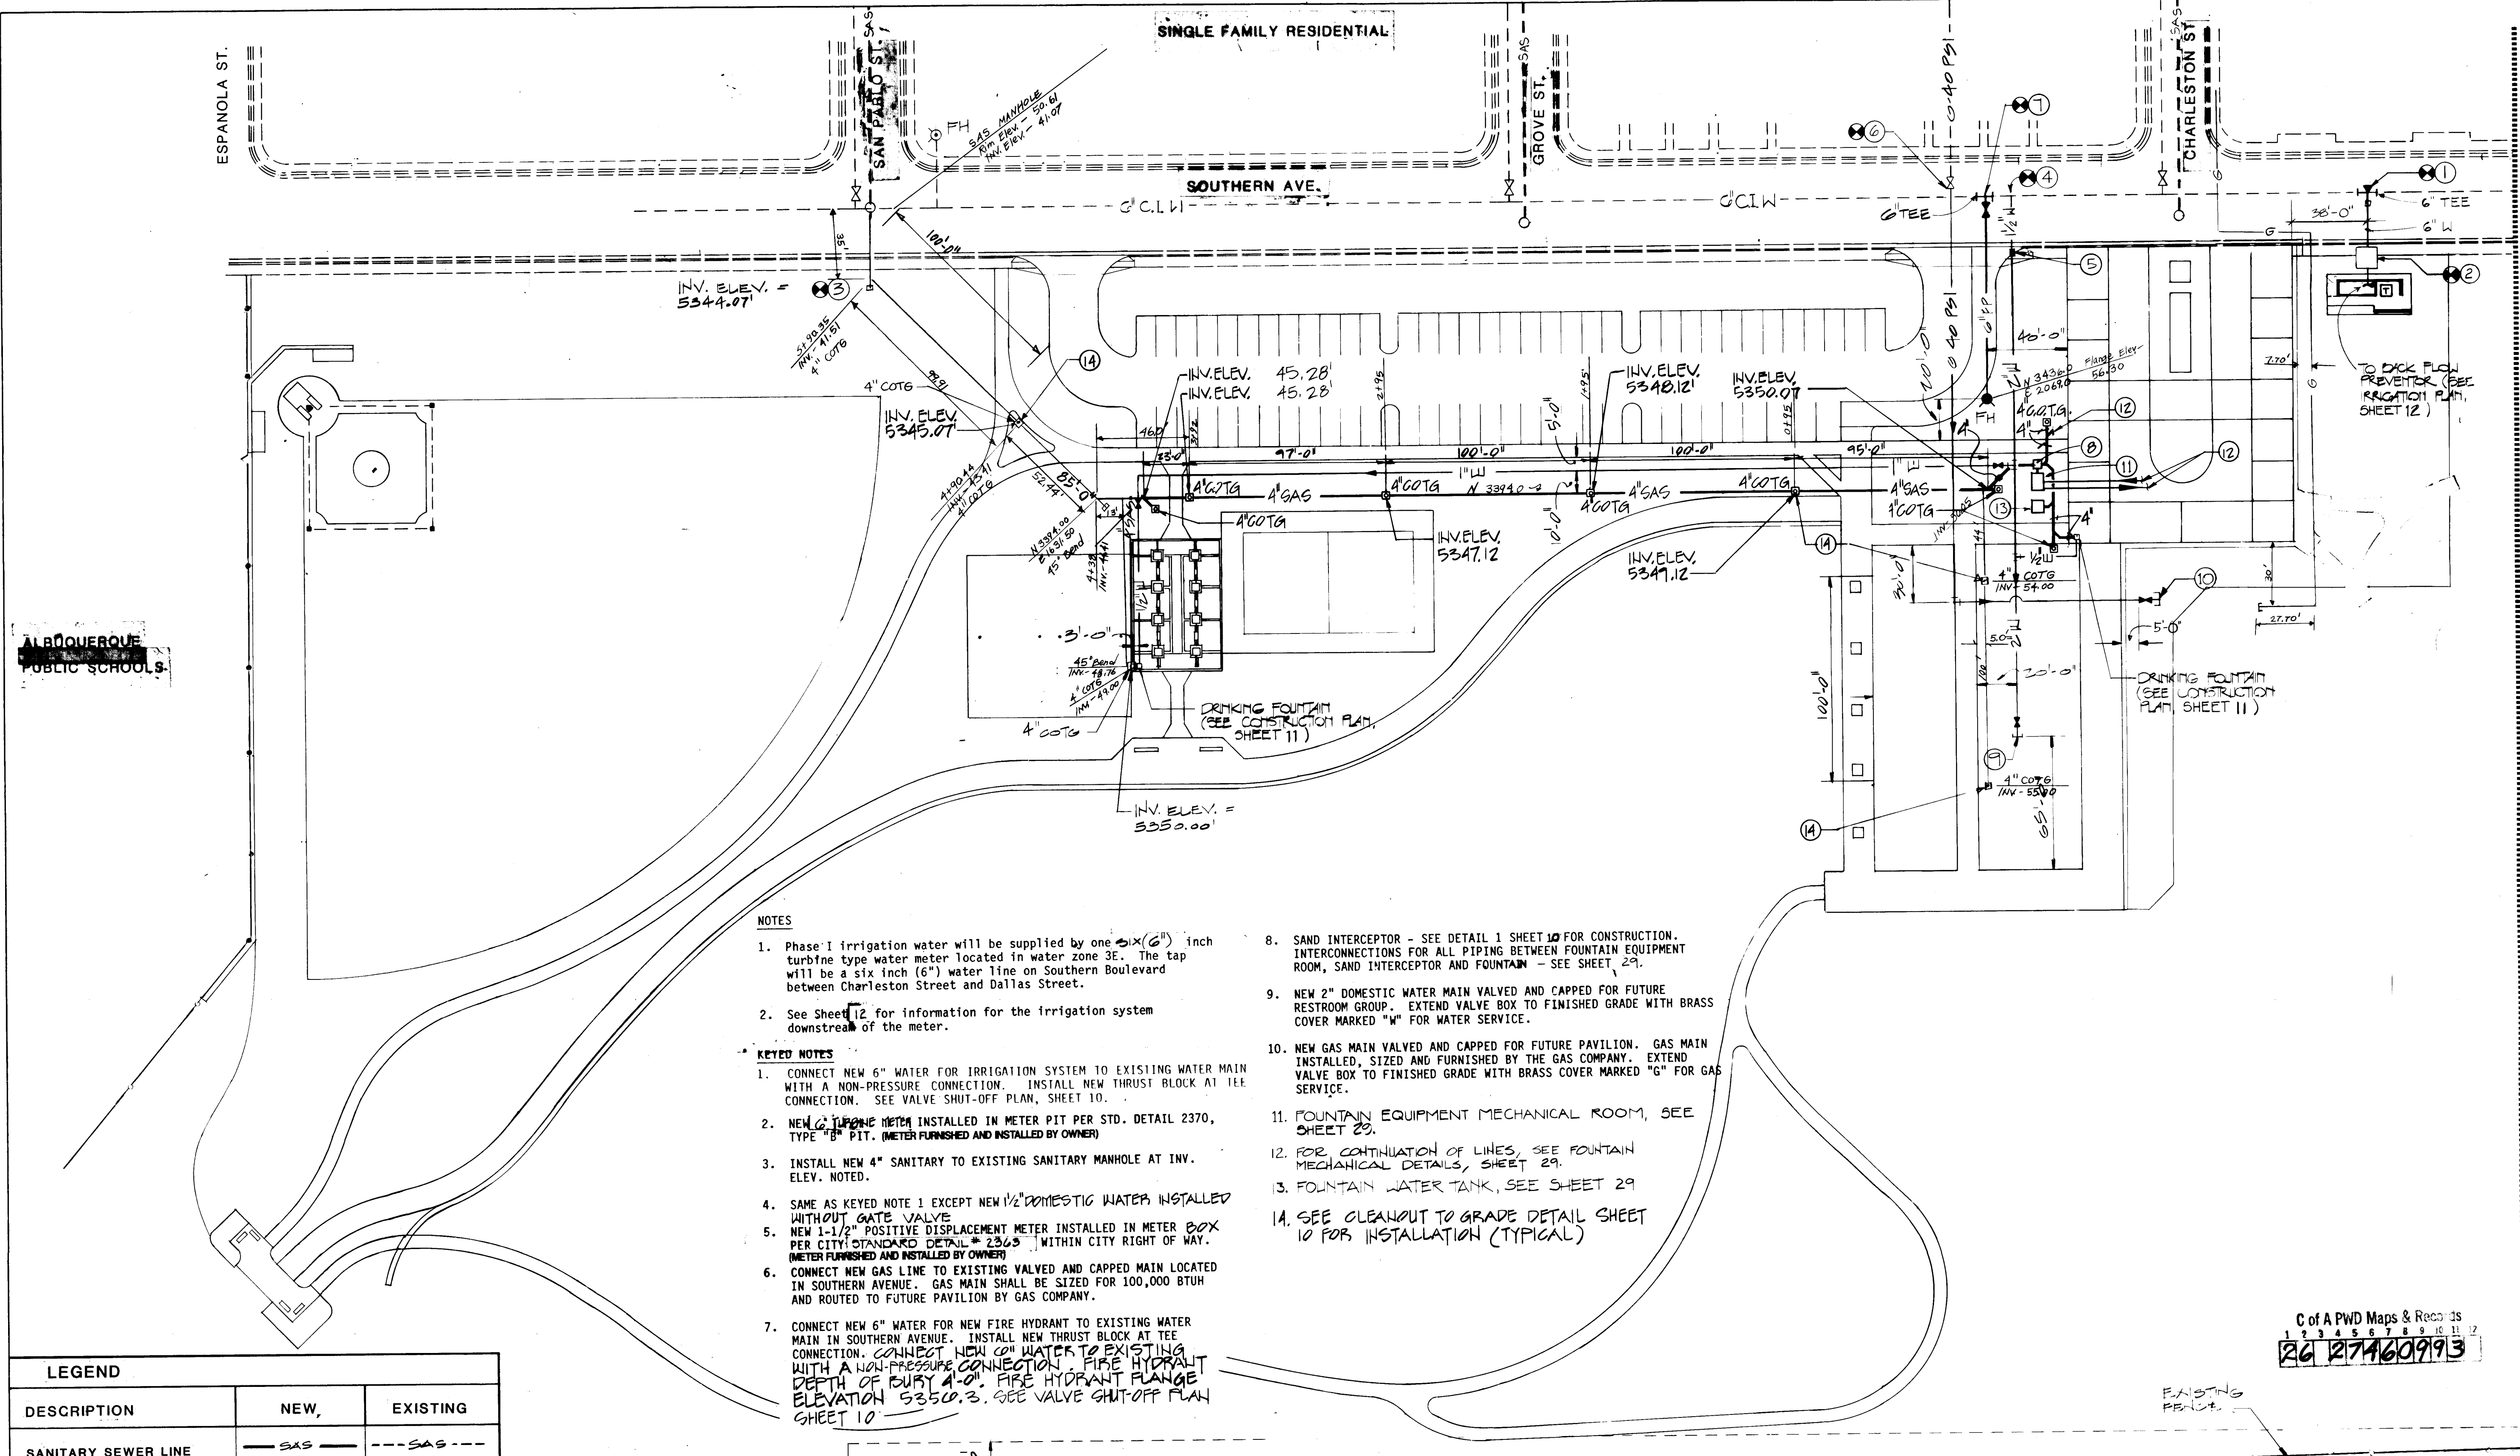


LEGEND		
DESCRIPTION	NEW	EXISTING
SANITARY SEWER LINE	— SAS —	--- SAS ---
SANITARY SEWER MANHOLE	●	○
NATURAL GAS LINE	— GAS —	--- GAS ---
WATER LINE	— W —	--- W ---
GATE VALVE	⋈	⋈
FIRE HYDRANTS	⋈	⋈
TEES	⋈	⋈
CROSSES	⋈	⋈
BENDS	⋈	⋈
CAPS & PLUGS	⋈	⋈
FIELD FENCE	— X — X —	--- X ---
PUBLIC EASEMENTS	—	---
WATER PRESSURE	—	---
ZONE BOUNDARY	—	---
PIPE RISE OR DROP	○	○
NEW TO EXISTING CONNECTION	—	---
CLEANOUT TO GRADE	—	---
THRUST BLOCK	—	---

NOTES

- Phase I irrigation water will be supplied by one 6" (6") inch turbine type water meter located in water zone 3E. The tap will be a six inch (6") water line on Southern Boulevard between Charleston Street and Dallas Street.
- See Sheet 12 for information for the irrigation system downstream of the meter.
- NEW 2" TURBINE METER INSTALLED IN METER PIT PER STD. DETAIL 2370, TYPE "B" PIT. (METER FURNISHED AND INSTALLED BY OWNER)
- INSTALL NEW 4" SANITARY TO EXISTING SANITARY MANHOLE AT INV. ELEV. NOTED.
- SAME AS KEYED NOTE 1 EXCEPT NEW 1/2" DOMESTIC WATER INSTALLED WITHOUT GATE VALVE
- NEW 1-1/2" POSITIVE DISPLACEMENT METER INSTALLED IN METER BOX PER CITY STANDARD DETAIL # 2345 WITHIN CITY RIGHT OF WAY. (METER FURNISHED AND INSTALLED BY OWNER)
- CONNECT NEW GAS LINE TO EXISTING VALVED AND CAPPED MAIN LOCATED IN SOUTHERN AVENUE. GAS MAIN SHALL BE SIZED FOR 100,000 BTUH AND ROUTED TO FUTURE PAVILION BY GAS COMPANY.
- CONNECT NEW 6" WATER FOR NEW FIRE HYDRANT TO EXISTING WATER MAIN IN SOUTHERN AVENUE. INSTALL NEW THRUST BLOCK AT TEE CONNECTION. CONNECT NEW 6" WATER TO EXISTING WITH A NON-PRESSURE CONNECTION. FIRE HYDRANT FLANGE DEPTH OF BURIAL 4'-0". FIRE HYDRANT FLANGE ELEVATION 5350.3. SEE VALVE SHUT-OFF PLAN SHEET 10

- SAND INTERCEPTOR - SEE DETAIL 1 SHEET 10 FOR CONSTRUCTION. INTERCONNECTIONS FOR ALL PIPING BETWEEN FOUNTAIN EQUIPMENT ROOM, SAND INTERCEPTOR AND FOUNTAIN - SEE SHEET 29.
- NEW 2" DOMESTIC WATER MAIN VALVED AND CAPPED FOR FUTURE RESTROOM GROUP. EXTEND VALVE BOX TO FINISHED GRADE WITH BRASS COVER MARKED "W" FOR WATER SERVICE.
- NEW GAS MAIN VALVED AND CAPPED FOR FUTURE PAVILION. GAS MAIN INSTALLED, SIZED AND FURNISHED BY THE GAS COMPANY. EXTEND VALVE BOX TO FINISHED GRADE WITH BRASS COVER MARKED "G" FOR GAS SERVICE.
- FOUNTAIN EQUIPMENT MECHANICAL ROOM, SEE SHEET 29.
- FOR CONTINUATION OF LINES, SEE FOUNTAIN MECHANICAL DETAILS, SHEET 29.
- FOUNTAIN WATER TANK, SEE SHEET 29
- SEE CLEANOUT TO GRADE DETAIL SHEET 10 FOR INSTALLATION (TYPICAL)

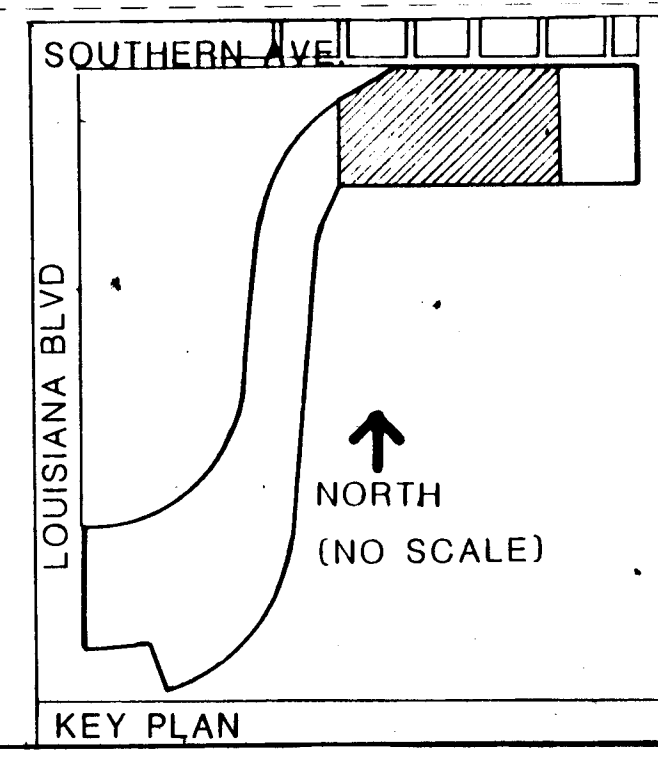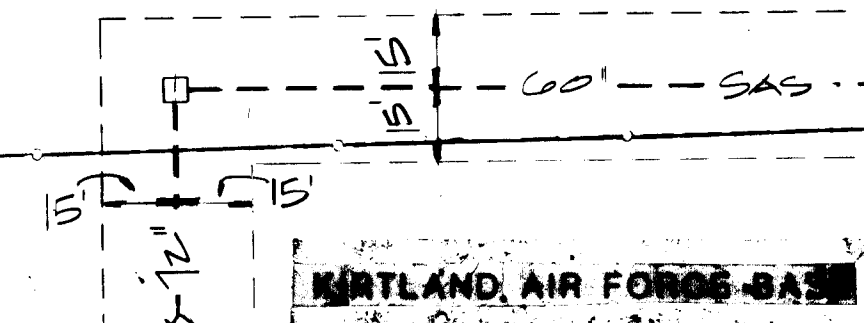



1"=40' scale

40 0 40 80 feet


MORROW & COMPANY
LANDSCAPE ARCHITECTS
210 La Veta Drive NE
Albuquerque, New Mexico 87108
505-268-2266

CITY OF ALBUQUERQUE PUBLIC WORKS DEPARTMENT ENGINEERING GROUP					
TITLE: PHIL CHACON PARK PHASES I & II SITE UTILITY PLAN					
APPROVALS	ENGINEER	DATE	APPROVALS	ENGINEER	DATE
DRC Chair			Hydrology	N/A	9/17/90
Trans. Dev	N/A	6-12-90			
Utility Dev	R.W. Kane	9-17-90			
Drawn	D. Silva	9-5-90			
DRAWING NO.	2746	MAP NO.	L-19	SHEET	OF

AS BUILT INFORMATION		BENCH MARKS		SURVEY INFORMATION		ENGINEER'S SEAL		REVISIONS		REMARKS	
CONTRACTOR	DATE	CONTRACTOR	DATE	NO.	DATE	NO.	DATE	NO.	DATE	NO.	DATE
INSPECTOR	DATE	INSPECTOR	DATE	BY	DATE	BY	DATE	BY	DATE	BY	DATE
ACCURACY	DATE	ACCURACY	DATE								
VERIFICATION	DATE	VERIFICATION	DATE								
CORRECTION	DATE	CORRECTION	DATE								
MICRO-FILM	DATE	MICRO-FILM	DATE								
RECORDED	DATE	RECORDED	DATE								

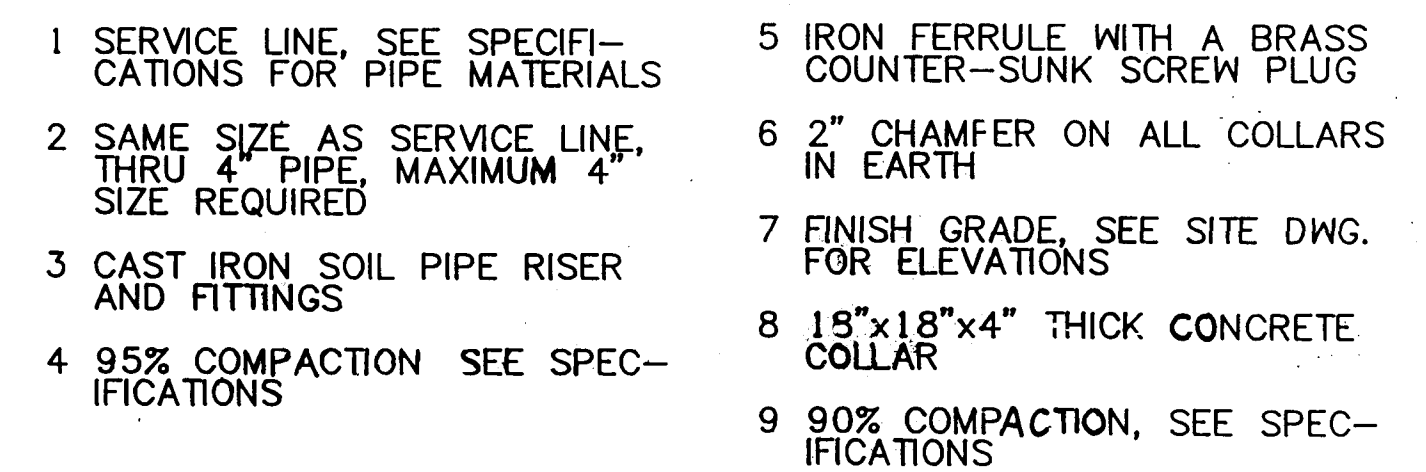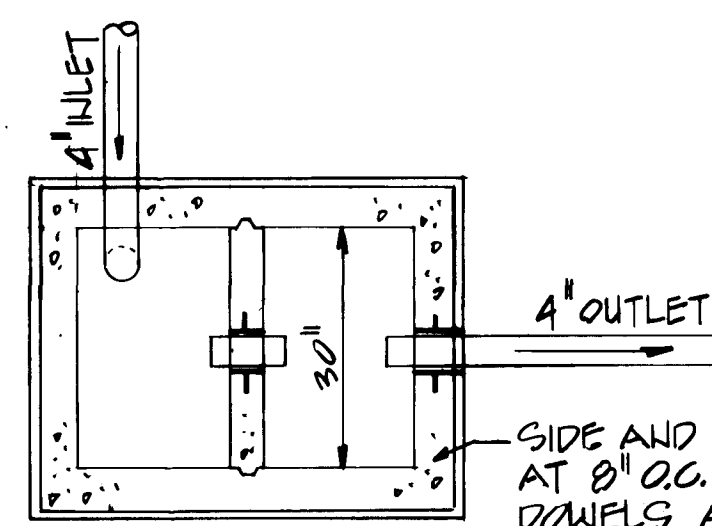

2
SHEET 10

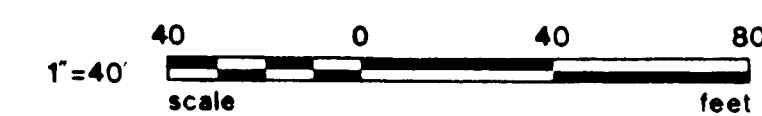

MORROW & COMPANY
LANDSCAPE ARCHITECTS
210 La Veta Drive NE
Albuquerque, New Mexico 87108
505-268-2266

THE CONTRACTOR SHALL NOTIFY THE CITY WATER SYSTEM DIVISION THREE WORKING DAYS BEFORE COMMENCING WORK. WATER SYSTEMS PHONE NUMBER 857-8200


ONLY WATER SYSTEM DIVISION PERSONEL SHALL BE AUTHORIZED TO SHUT-OFF VALVES

ENGINEER'S SEAL						SURVEY INFORMATION		BENCH MARKS	AS BUILT INFORMATION	
						FIELD NOTES				
						NO.	BY	DATE		
 5/11/90									WORK	
									STARTED BY	
									ACCEPTANCE BY	
									DATE	
									FIELD CALCULATION BY	
									DRAWINGS	
									CORRECTED BY	
									DATE	
									MICRO-FILM INFORMATION	
									RECORDED BY	
									DATE	
									NO	


STATE OF NEW MEXICO
 REGISTERED PROFESSIONAL ENGINEER
 BRIDGES & PAVING
 No. 12916 & 1402
 ALBUQUERQUE
 N. M.
 5/11/90

CITY OF ALBUQUERQUE PUBLIC WORKS DEPARTMENT ENGINEERING GROUP					
TITLE: PHIL CHACON PARK - PHASES I & II SITE UTILITY PLAN					
APPROVALS	ENGINEER	DATE	APPROVALS	ENGINEER	DATE
D.R.C. Chair			Hydrology	N/A	9/17/90
Trans. Dev	N/A RMD	6-17-90			
Utility Dev	S.W. Kane	9-17-90			
Drains	D. Smith	9-5-90			
DRAWING NO.	2746		MAP NO.		
			L-19		
			SHEET 1 OF 1		

MATCHLINE SHEET 12

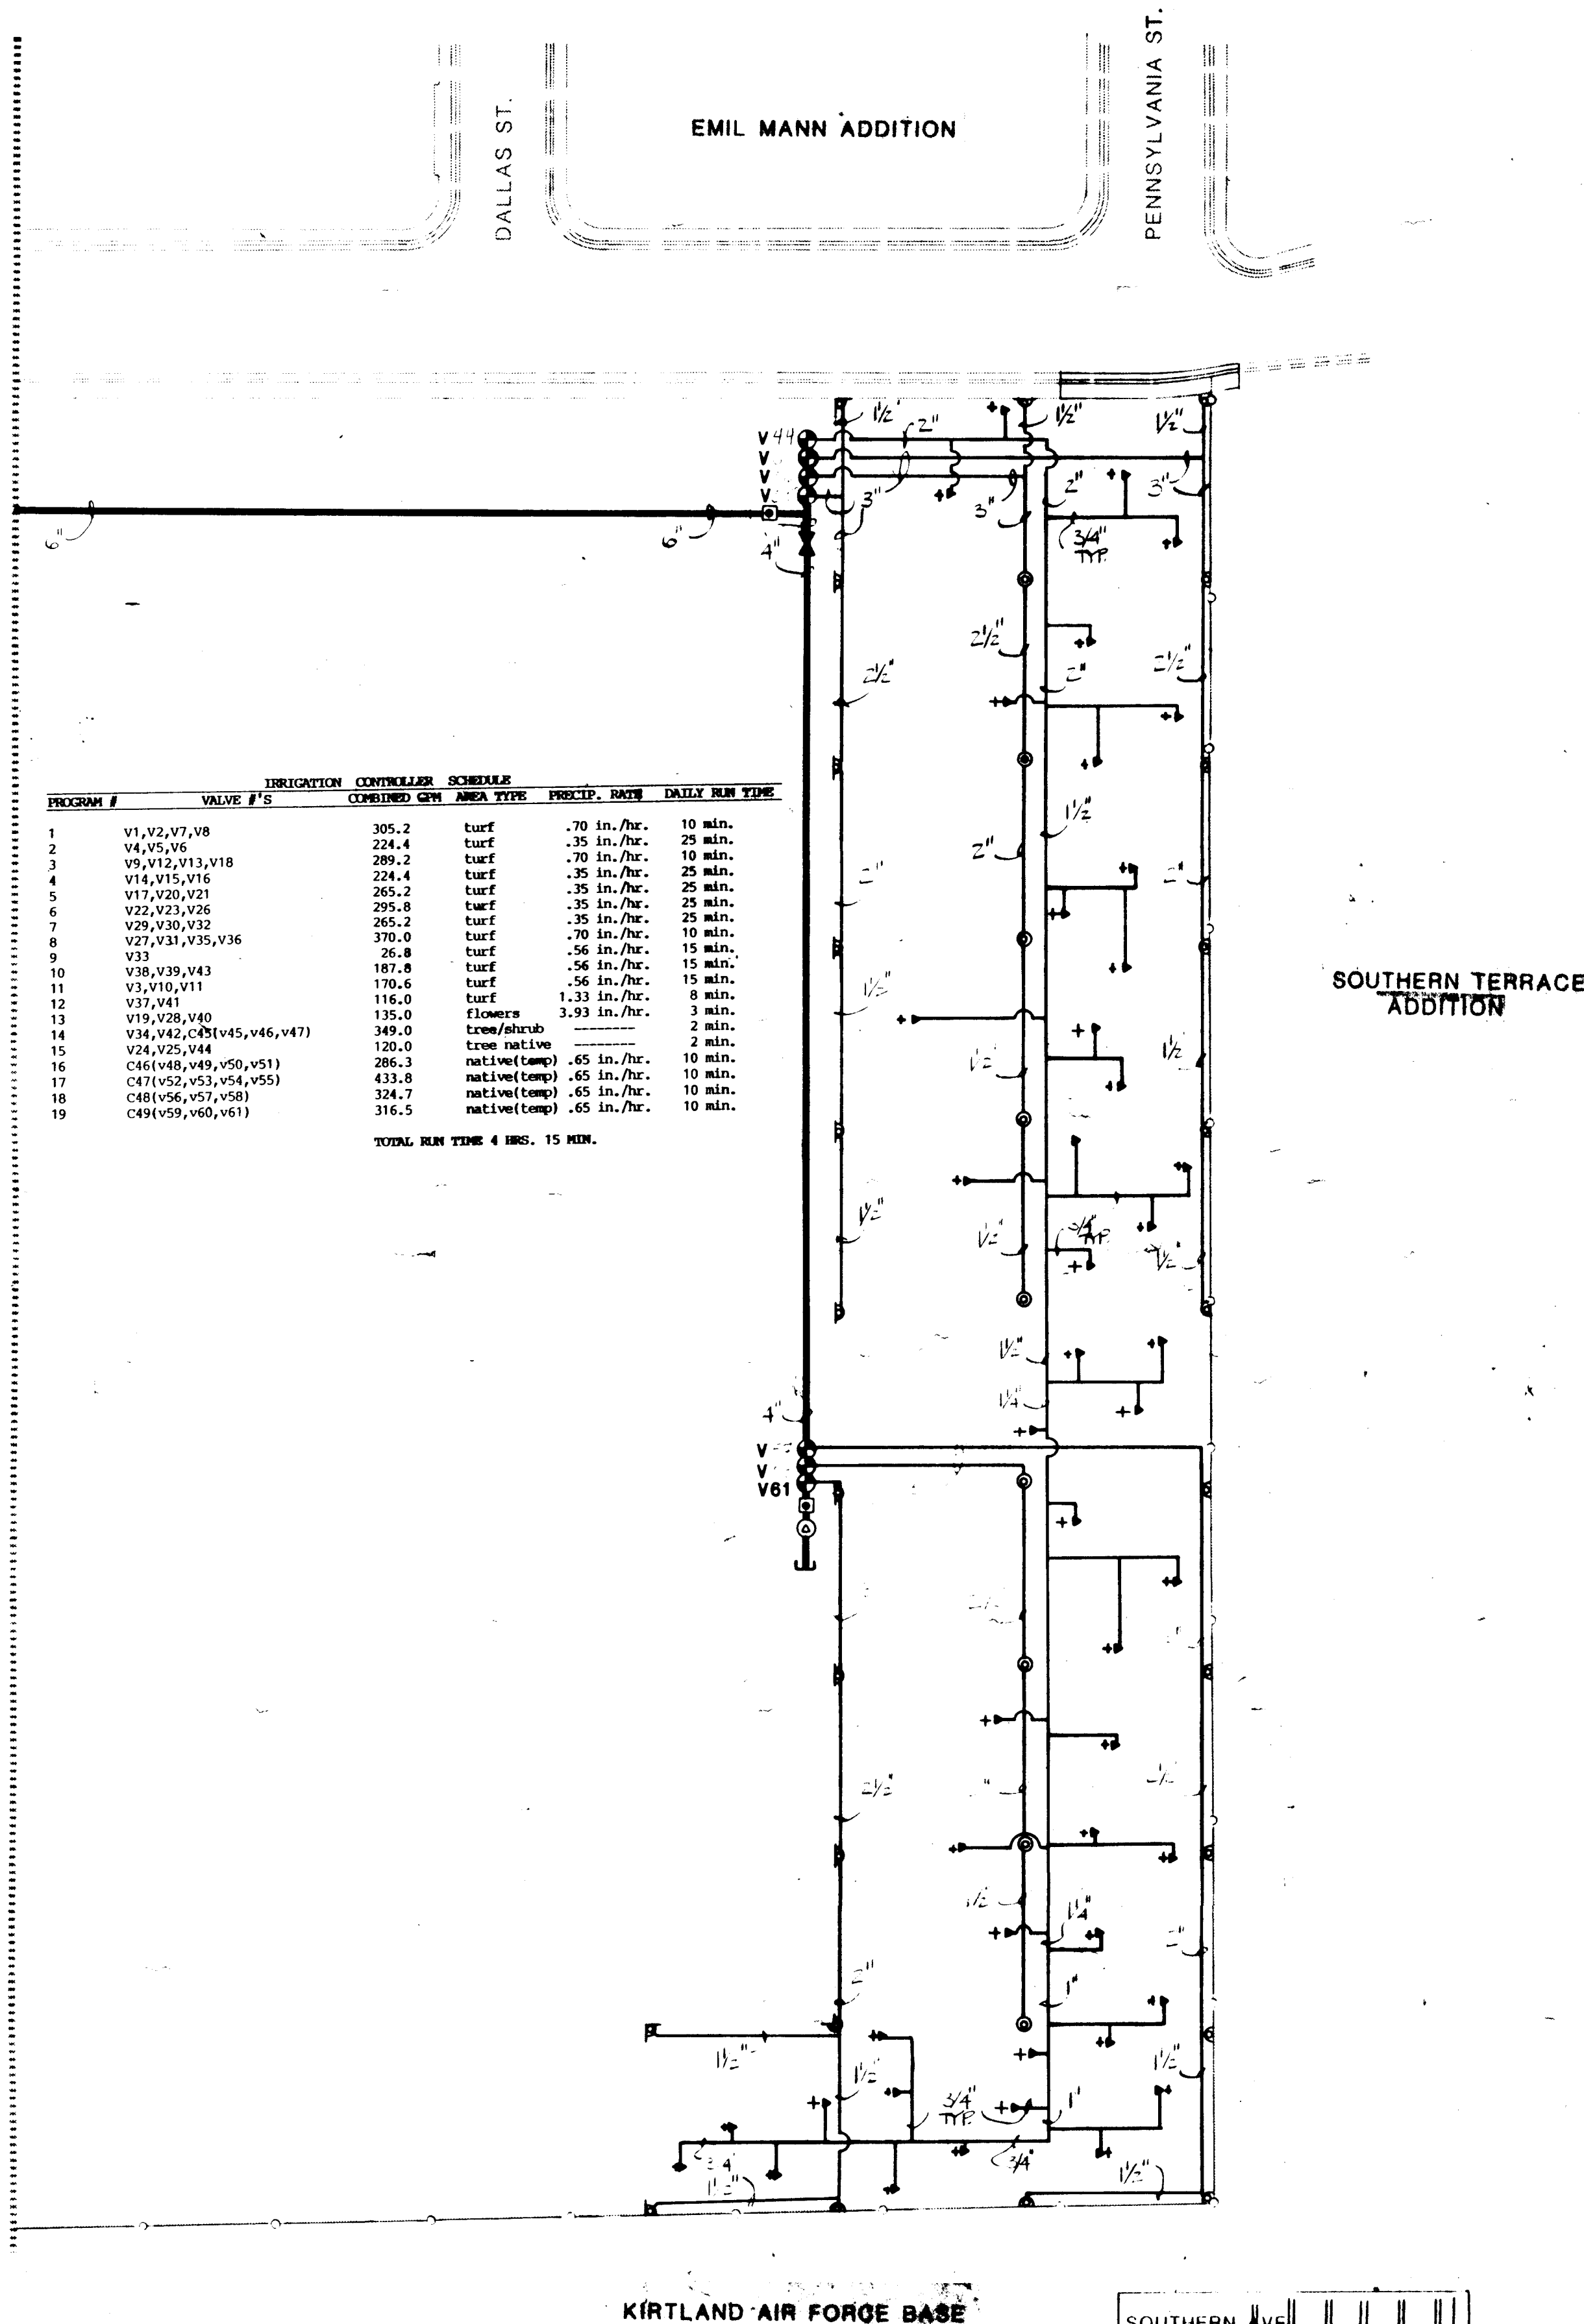

KIRTLAND AIR FORCE BASE

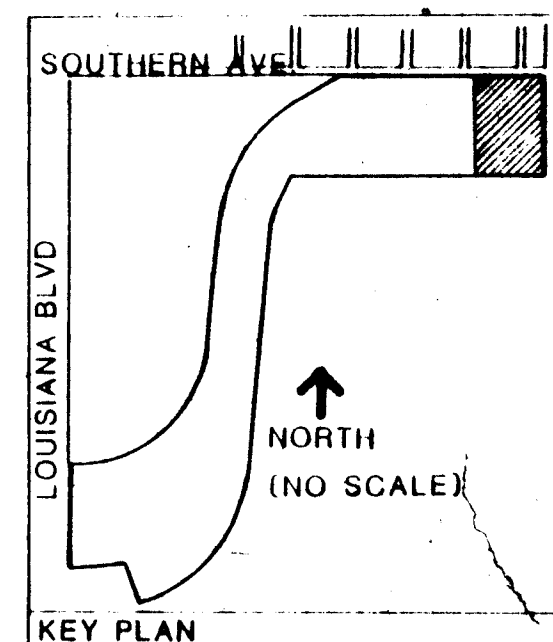

IRRIGATION LEGEND

- TORO 5700-AP POP-UP SPRINKLER**.....SEE DETAIL
- △ SB-4-180-PC PRESSURE COMPENSATING STREAM BUBBLER - .9 GPM (NO CHECK VALVE)
 - SB-360-PC PRESSURE COMPENSATING STREAM BUBBLER - 1.9 GPM (NO CHECK VALVE)
 - ▲ SB-180-PC PRESSURE COMPENSATING STREAM BUBBLER - 1.0 GPM (NO CHECK VALVE)
 - FB-100-PC PRESSURE COMPENSATING FLOOD BUBBLER - 1.0 GPM (NO CHECK VALVE)
 - 12-0-PC 12" RADIUS; 90° ARC; .5 GPM PRESSURE COMPENSATING WITH INTERNAL CHECK VALVE
 - 12-4-PC 12" RADIUS; 180° ARC; 1.0 GPM PRESSURE COMPENSATING WITH INTERNAL CHECK VALVE
 - 12-F-PC 12" RADIUS; 360° ARC; 2.0 GPM PRESSURE COMPENSATING WITH INTERNAL CHECK VALVE

- TORO 5700-12P HIGH POP SPRINKLER**.....SEE DETAIL
- 12-0-PC 12" RADIUS; 90° ARC; .5 GPM PRESSURE COMPENSATING (NO CHECK VALVE)
 - 12-H-PC 12" RADIUS; 180° ARC; 1.0 GPM PRESSURE COMPENSATING (NO CHECK VALVE)
 - 12-F-PC 12" RADIUS; 360° ARC; 2.0 GPM PRESSURE COMPENSATING (NO CHECK VALVE)
 - 12-270-PC 12" RADIUS; 270° ARC; 1.4 GPM PRESSURE COMPENSATING (NO CHECK VALVE)

- GEAR DRIVEN ROTARY SPRINKLER WITH INTERNAL CHECK VALVE**.....SEE DETAIL
- 24" RADIUS; 90° ARC; .9 GPM @ 50 PSI
 - 24" RADIUS; 180° ARC; 1.8 GPM @ 50 PSI
 - 24" RADIUS; 360° ARC; 3.6 GPM @ 50 PSI

- GEAR DRIVEN ROTARY SPRINKLER WITH INTERNAL CHECK VALVE**.....SEE DETAIL
- 38" RADIUS; ADJUSTABLE PART CIRCLE; 1.7 GPM @ 50 PSI
 - 42" RADIUS; ADJUSTABLE PART CIRCLE; 3.4 GPM @ 50 PSI
 - 40" RADIUS; ADJUSTABLE PART CIRCLE; 1.6 GPM @ 50 PSI
 - 42" RADIUS; ADJUSTABLE PART CIRCLE; 3.5 GPM @ 50 PSI
 - 48" RADIUS; 360° ARC; 6.2 GPM @ 50 PSI

- GEAR DRIVEN ROTARY SPRINKLER WITH INTERNAL CHECK VALVE**.....SEE DETAIL
- 1" RADIUS; 90° ARC; 8.0 GPM @ 50 PSI
 - RADIUS; 180° ARC; 10.2 GPM @ 50 PSI
 - RADIUS; 270° ARC; 11.0 GPM @ 50 PSI
 - RADIUS; 360° ARC; 10.2 GPM @ 50 PSI

(SPECIAL ARCS AS NOTED ON PLAN)

- TORO 292-06-04 1" PLASTIC AUTOMATIC VALVE ASSEMBLY**.....SEE DETAIL

- TORO 292-06-06 1-1/2" PLASTIC AUTOMATIC VALVE ASSEMBLY**.....SEE DETAIL

- TORO 292-06-08 2" PLASTIC AUTOMATIC VALVE ASSEMBLY**.....SEE DETAIL

- TORO 474-04 1" QUICK COUPLER VALVE**.....SEE DETAIL

- TORO 404-02 SERIES IMPACT DRIVE SPRINKLER**.....SEE DETAIL
- 63" RADIUS; 360° ARC; 24.5 GPM @ 60 PSI

- TORO 434-01 SERIES IMPACT DRIVE SPRINKLER**.....SEE DETAIL
- 58" RADIUS; ADJUSTABLE PART CIRCLE; 14.6 GPM @ 60 PSI

- DATE VALVE ASSEMBLY - LINE SIZE**

- 3" AND LARGER: REGULAR 700A SERIES RING END-N.R.S.SEE DETAIL

- 2-1/2" AND SMALLER: REGULAR 6-60 SERIES THREADEDSEE DETAIL

- FEBCO 825 6" REDUCED PRESSURE PRINCIPLE BACKFLOW PREVENTER**.....SEE DETAIL

- WATERMAN AV-150 2" AIR RELEASE VALVE**.....SEE DETAIL

- MOTOROLA MIR 3000 SATELLITE CONTROLLER**.....SEE DETAIL

- AQUA ENGINEERING WEATHER STATION # 012**.....SEE DETAIL

- 20 H.P. CENTRIFUGAL BOOSTER PUMP**.....SEE DETAIL

- LATERAL PIPE - CLASS 200 SOLVENT WELD PVC; 18" BURY MIN. (SIZES AS INDICATED)**

- MAINLINE PIPE - 28" BURY MIN. (SIZES AS INDICATED)**

- 3" AND LARGER: CLASS 200 RING END PVC

- 2-1/2" AND SMALLER: SCHEDULE 40 SOLVENT WELD PVC

- SLEEVE PIPE - CLASS 200 PVC (2 SIZES LARGER THAN PIPE BEING SLEEVED)**

- LIGHT FIXTURE (SEE ELECTRICAL PLAN, SHEET 16)

- + TREE CENTER (SEE PLANTING PLAN, SHEET 14 & 15)

IRRIGATION NOTES

- Where crossing existing hard construction, the Contractor shall saw-cut existing asphalt and/or concrete prior to trenching, remove and properly dispose of debris, install sleeve piping, compact subgrade to 95%, and replace asphalt and/or concrete to match existing areas, in accordance with City Standard Detail 2469.
- The Contractor shall adjust all valves, bubblers, and sprinklers for optimum coverage, and shall provide and install nozzles other than those specified as instructed by the Landscape Architect at no additional cost to the Owner.
- Exposed conduit for 24 volt conductors above grade and outside of buildings shall be rigid steel conduit.
- All 24 volt wire shall be marked with a 6" wide yellow marker tape and marked "Warning-Electrical". Lay marker tape horizontally 4" above wire.
- Temporary irrigation piping shall be Sch. 40 PVC and shall be installed with invert of pipe flush to finish grade. Contractor shall secure pipe to ground at sprinkler head locations and changes of direction using ground staples or equal device to be approved by the Landscape Architect.
- Heads on automatic valve # V2 system shall have # 43 nozzle size.
- Heads on automatic valve # V11 system shall have # 28 nozzle size.
- Contractor shall install all bubblers on high side of tree wells.
- Where sprinkler heads are adjacent to light poles, Contractor shall install sprinkler head at front face of light pole.
- Contractor shall group valves V29 and V32; V30 and V31; V36, V37 and V38; V37, V38, V39 and V40; V54, V56 and V61 and wire to a single station for each group. Splices shall be made at controller location.
- Irrigation head counts on Valve Schedule are approximate. Plans shall govern actual quantities.
- Bubblers to be installed on uphill side of trees and shrubs (typ.).
- Anticipated run time of Irrigation System is approximately 6.5 hours. Each automatic valve shall be wired to a single controller station, except as noted. Automatic valves shall run in groups as noted in controller schedule.
- Booster Pump shall provide 30 psi boost at 325 GPM flow.


IRRIGATION VALVE SCHEDULE

VALVE #	GPM	SIZE	HEAD TYPE	# OF HEADS	AREA TYPE	PRECIPITATION RATE (IN./HR.)
V1	69.2	2"	ROTARY	7	TURF	.70
V2	56.8	2"	ROTARY	4	TURF	.56
V3	25.3	1-1/2"	ROTARY	17	TURF	.56
V4	61.2	2"	ROTARY	6	TURF	.56
V5	71.4	2"	ROTARY	7	TURF	.56
V6	91.8	2"	ROTARY	9	TURF	.56
V7	77.2	2"	ROTARY	8	TURF	.56
V8	102	2"	ROTARY	10	TURF	.56
V9	51	2"	ROTARY	5	TURF	.56
V10	85.5	2"	ROTARY	45	TURF	.56
V11	59.8	2"	ROTARY	31	TURF	.56
V12	91.8	2"	ROTARY	9	TURF	.56
V13	64.8	2"	ROTARY	7	TURF	.56
V14	71.4	2"	ROTARY	7	TURF	.56
V15-C46	70	2"	ROTARY	19	NATIVE	.56
V16-C46	73.2	2"	ROTARY	20	NATIVE	.56
V17-C46	72.5	2"	ROTARY	16	NATIVE	.56
V18	81.6	2"	ROTARY	8	TURF	.56
V19	71.4	2"	ROTARY	17	TURF	.56
V20	91.8	2"	ROTARY	9	TURF	.56
V21	81.6	2"	ROTARY	8	TURF	.56
V22-C46	70.8	2"	ROTARY	21	NATIVE	.56
V23-C46	83.0	2"	BUBBLER	78	SHRUB	2.9
V24	45.0	2"	FIXED	50	SHRUB	2.9
V25	81.6	2"	ROTARY	8	TURF	.56
V26	91.8	2"	ROTARY	9	TURF	.56
V27	91.8	2"	ROTARY	9	TURF	.56
V28	102	2"	ROTARY	10	TURF	.56
V29	53	2"	BUBBLER	53	TREE	1.33
V30-C45	76	2"	BUBBLER	76	VINE	1.33
V31-C45	84	2"	BUBBLER	84	VINE	1.33
V32	20	1-1/2"	BUBBLER	20	TREE	1.33
V33	102	2"	ROTARY	10	TURF	.56
V34	102	2"	ROTARY	10	TURF	.56
V35	78	2"	FIXED	64	NATIVE	1.33
V36-C47	126.7	2"	TEMP. ROTARY	8	NATIVE	.65
V37-C47	117.3	2"	TEMP. ROTARY	6	NATIVE	.65
V38-C47	102.2	2"	TEMP. ROTARY	7	NATIVE	.65
V39	91.8	2"	ROTARY	9	TURF	.56
V40	91.8	2"	ROTARY	9	TURF	.56
V41	72.8	2"	ROTARY	8	TURF	.56
V42	26.8	1-1/2"	ROTARY	12	TURF	.56
V43	81.6	2"	ROTARY	8	TURF	.56
V44	32	1-1/2"	BUBBLER	32	SHRUB/TREE	1.33
V45	107.8	2"	ROTARY	11	TURF	.56
V46	87.4	2"	ROTARY	9	TURF	.56
V47	86.0	2"	FIXED	84	TURF	1.33
V48	57.8	2"	ROTARY	36	TURF	.56
V49	36.4	1-1/2"	ROTARY	18	TURF	.56
V50	12	1"	FIXED	18	FLOWER	3.93
V51	30	1-1/2"	FIXED	25	TURF	1.33
V52	74	2"	BUBBLER	63	SHRUB/TREE	1.33
V53	95.6	2"	ROTARY	50	TURF	.56
V54-C49	126.7	2"	TEMP. ROTARY	8	NATIVE	.65
V55	47.0	2"	BUBBLER	47	TREE	1.33
V56-C49	87.6	2"	TEMP. ROTARY	6	NATIVE	.65
V57-C49	139.1	2"	TEMP. ROTARY	6	NATIVE	.65
V58-C49	87.6	2"	TEMP. ROTARY	6	NATIVE	.65
V59-C49	87.6	2"	TEMP. ROTARY	6	NATIVE	.65
V60-C49	98.0	2"	TEMP. ROTARY	4	NATIVE	.65
V61-C49	102.2	2"	TEMP. ROTARY	7	NATIVE	.65

IRRIGATION CONTROLLER SCHEDULE

VALVE #S	COMBINED GPM	AREA TYPE	PRECIP. RATE	DAILY RUN TIME
1	V9, V26, V45	320	TURF	.47 IN/HR. 30 MIN.
2	V47, V15, V43	285	TURF	.47 IN/HR. 30 MIN.
3	V47, V14, V40	306	TURF	.47 IN/HR. 30 MIN.
4	V5, V19, V28	357	TURF	.47 IN/HR. 30 MIN.
5	V6, V18, V41	358	TURF	.47 IN/HR. 30 MIN.
6	V7, V18, V41	348	TURF	.47 IN/HR. 30 MIN.
7	V8, V12, V27	285	TURF	.47 IN/HR. 30 MIN.
8	V3, V11, V42, V4	148	TURF	.47 IN/HR. 25 MIN.
9	V10, V48, V55	129	TURF	.47 IN/HR. 25 MIN.
10	V47, V51	133	TURF	.47 IN/HR. 12 MIN.
11	V15, V16, V17, V22	137	NATIVE	.56 IN/HR. 25 MIN.
12	V24, V30, V31, V44	174	NATIVE	2.9 IN/HR. 1 MIN.
13	V23, V30, V31, V44	275	NATIVE	2 MIN.
14	V29, V32, V52, V55	194	SHRUB	2 MIN.
15	V36, V37, V38, V58	395	SHRUB (TEMP)	.54 IN/HR. 20 MIN.
16	V57, V59, V60	323	SHRUB (TEMP)	.54 IN/HR. 20 MIN.
17	V54, V56, V61	317	NATIVE (TEMP)	.54 IN/HR. 20 MIN.

This Controller Schedule has been provided to group valves to service similar landscape areas. Precipitation rates in order to match plant material within a four-hour water window. Initial run times for seeded areas will be divided into six-minute cycles until seed has been established. Calculations are based on the condition of 7.5 inches of evapotranspiration during the month of July with no rainfall considered. The schedule will need to be adjusted by the Owner depending on climatic conditions month by month. The schedule will also need to be adjusted after the plant material is established to reduce the amount of water used by trees and shrubs.

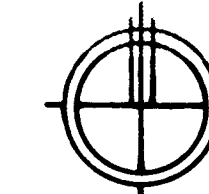

40 0 40 80
scale feet


MORROW & COMPANY
LANDSCAPE ARCHITECTS
210 La Veta Drive NE
Albuquerque, New Mexico 87108
505-268-2266

CITY OF ALBUQUERQUE
PUBLIC WORKS DEPARTMENT
ENGINEERING GROUP

TITLE: PHIL CHACON PARK - PHASES I & II
IRRIGATION PLAN


APPROVALS	ENGINEER	DATE	APPROVALS	ENGINEER	DATE
D.R.C. Chair	Phil Chacon	6-12-90	Hydrology	N/A	9/1/90
Trans Dev	R.W. Kane	9-17-90			
Utility Dev	D. Kline	9-5-90			
DRAWING NO.	2746		MAP NO.		
			SHEET		

L-19

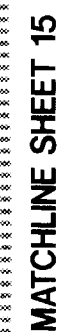



APPROVALS DATE 5/15/90 ENGINEER N/A DATE 5/15/90			PHASES I & II			BERQUE DEPARTMENT GROUP		
DESIGNED BY BWH DATE 5/90			NO. DATE REMARKS BY			ENGINEER'S SEAL 		
DRAWN BY SIMI DATE 5/90			REVISIONS DESIGN			SURVEY INFORMATION FIELD NOTES NO. BY DATE		
CHECKED BY ECR DATE 5/90			BENCH MARKS			AS BUILT INFORMATION CONTRACTOR ACCENT LANDSCAPE		
MICRO-FILM INFORMATION RECORDED BY DATE			WORK STARTED BY DATE FIELD LOCATION BY DATE CORRECTED BY DATE			NO		

MATCHLINE SHEET 14

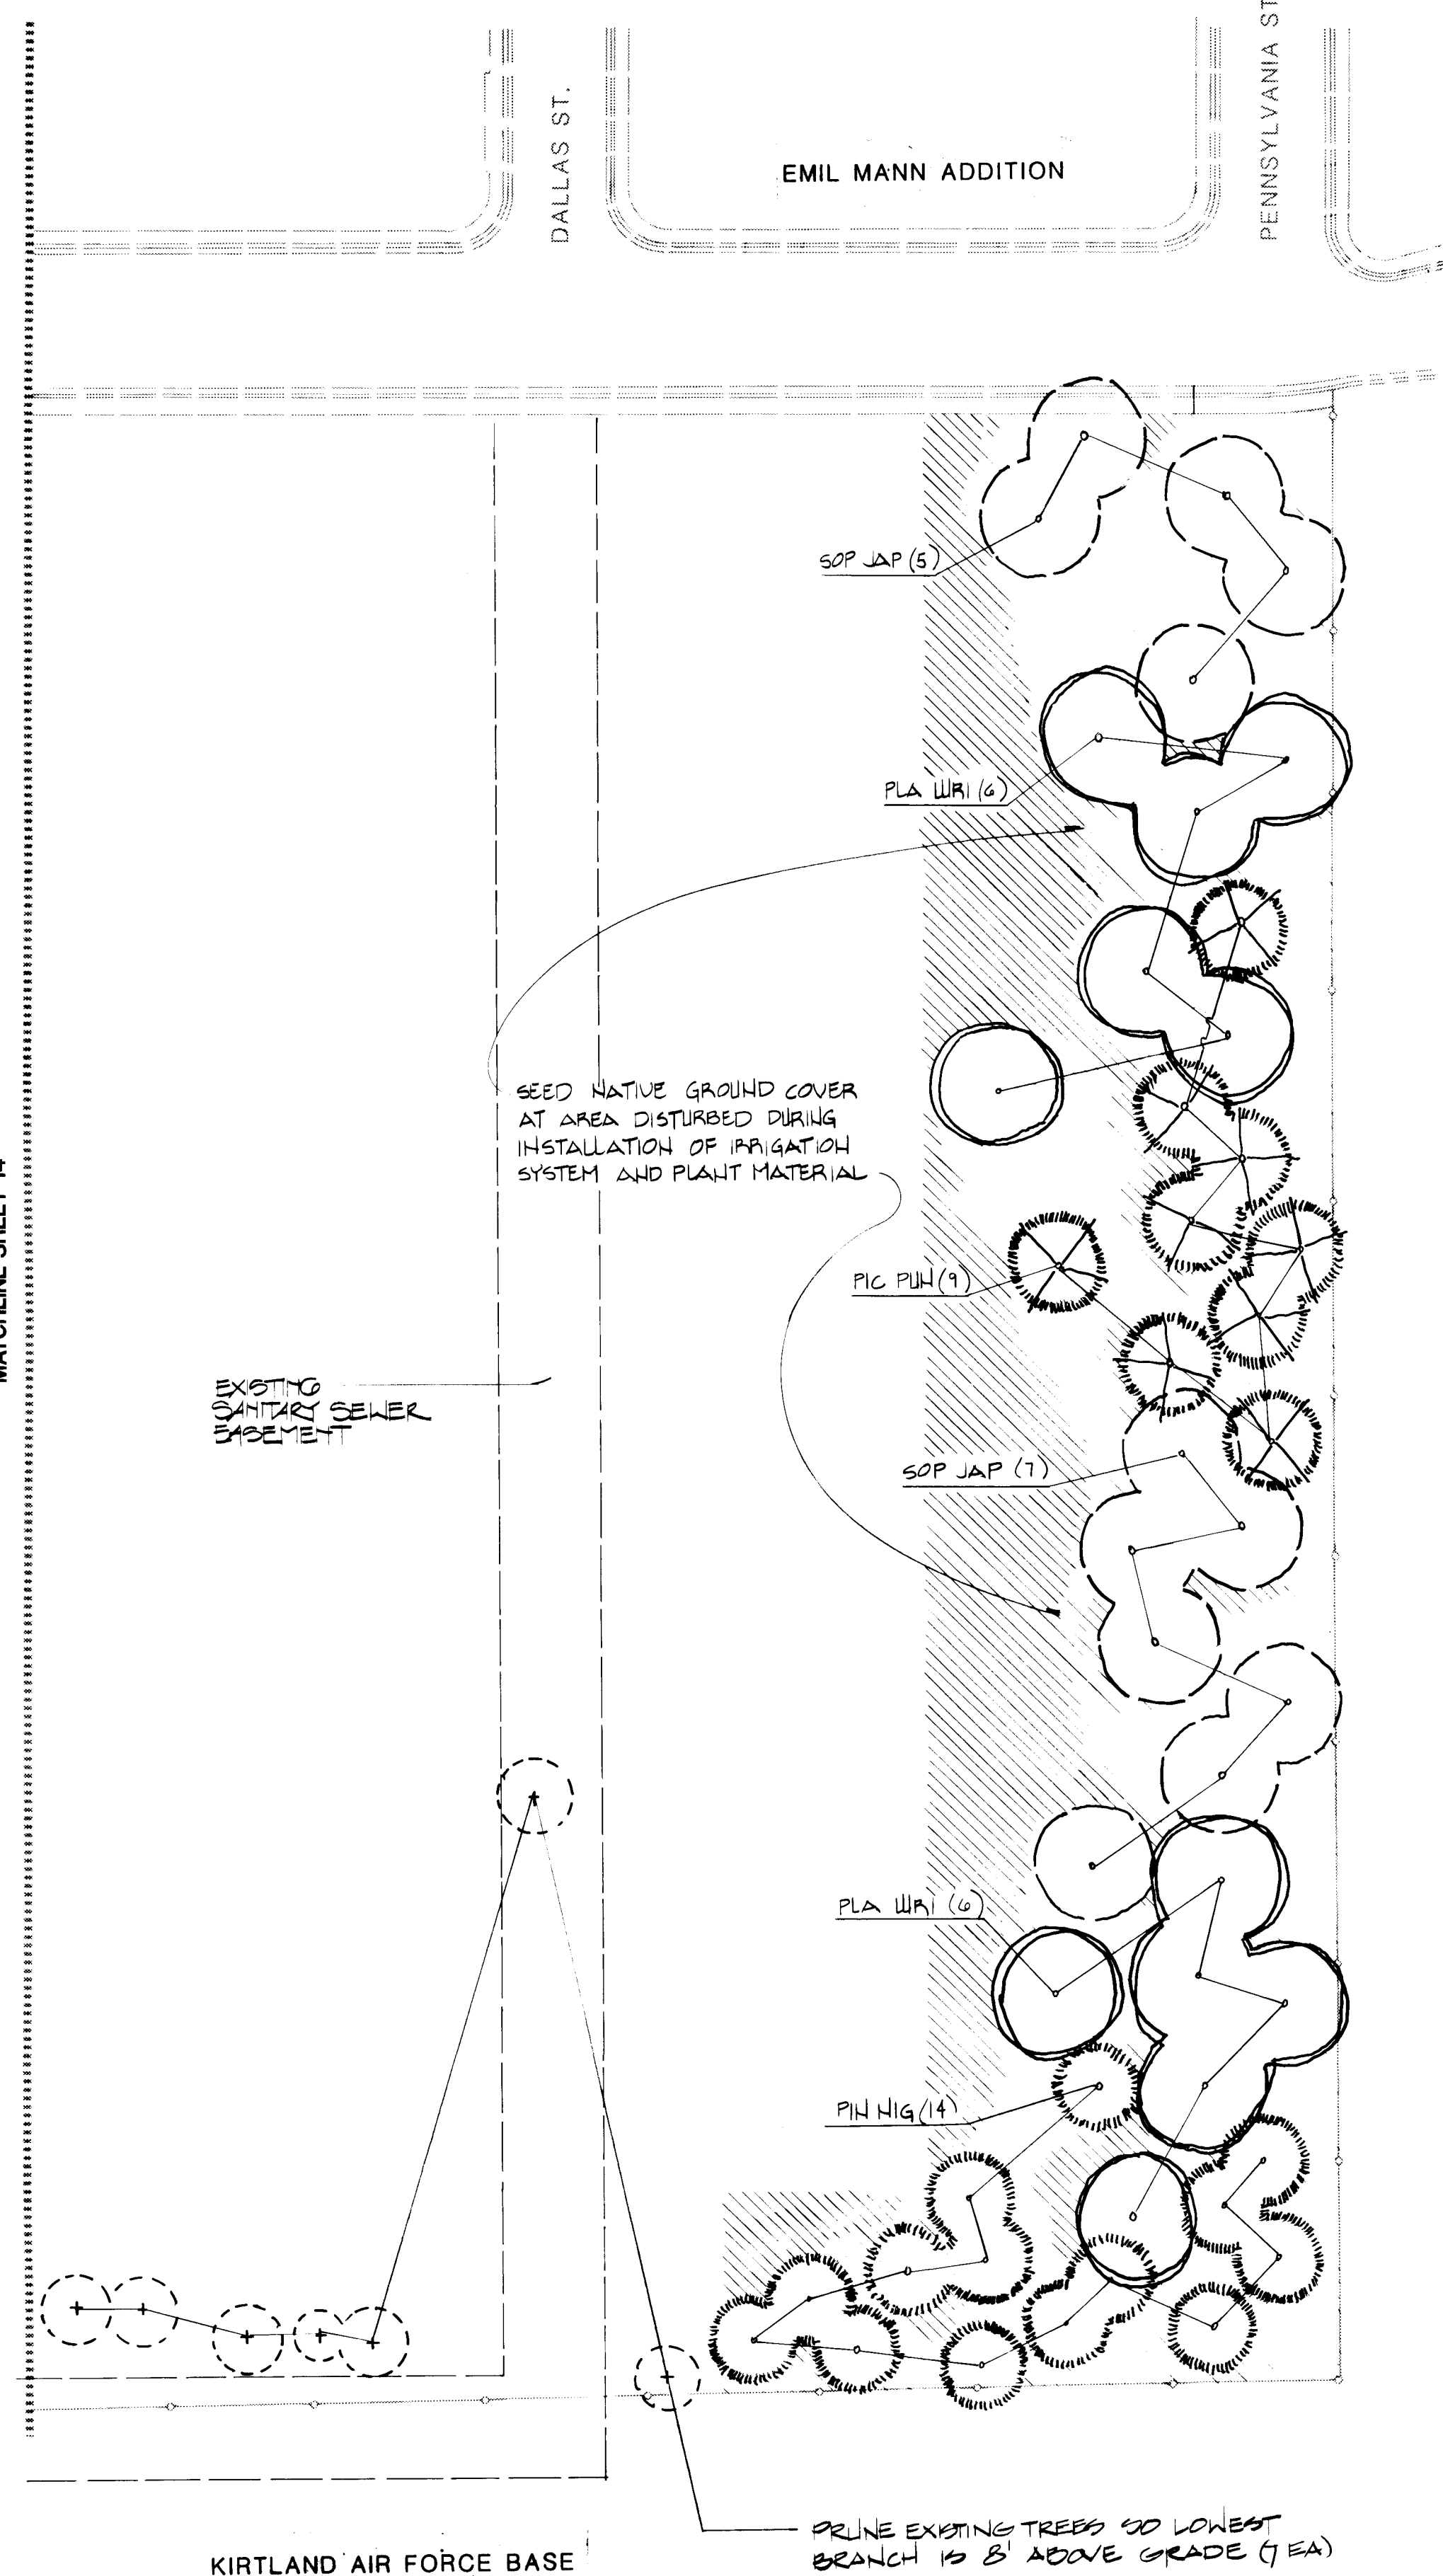

PLANT LIST

SYMBOL	BOTANICAL NAME	COMMON NAME	QUANTITY	SIZE	REMARKS	SYMBOL	BOTANICAL NAME	COMMON NAME	QUANTITY	REMARKS
TREES						FLOWERS				
CEL RET	Celtis reticulata	Western Hackberry	10	2" cal., 12'-14' ht., 3' min. spd.	24" box	ACH MIL	Achillea millefolium	Yarrow	450 SF	Seed @ 1 oz. per 2000 SF
CHI LIN	Chilopsis linearis	Desert Willow	8	2" cal., 10'-12' ht., 3' min. spd.	24" box	COR LAN	Coreopsis lanceolata	Coreopsis	480 SF	Seed @ 1 oz. per 250 SF
ELA ANG	Elaeagnus angustifolia	Russian Olive	19	2" cal., 10'-12' ht., 3' min. spd.	24" box	ECH PUR	Echinacea purpurea	Purple Coneflower	670 SF	Seed @ 1 oz. per 200 SF
FRA AME	Fraxinus americana 'Autumn Purple'	Autumn Purple Ash	76	2" cal., 12'-14' ht., 3' min. spd.	24" box	GAI ARI	Gaillardia aristata	Gaillardia	310 SF	Seed @ 1 oz. per 250 SF
FRA OXY	Fraxinus oxycarpa	Raywood Ash	12	2" cal., 12'-14' ht., 3' min. spd.	24" box	LIN PER	Linum perenne 'Lewisii'	Blue Flax	175 SF	Seed @ 1 oz. per 300 SF
FRA VEL	Fraxinus velutina 'Modesto'	Modesto Ash	26	2" cal., 12'-14' ht., 3' min. spd.	24" box	PEN PIN	Penstemon pinifolius	Pineleaf Penstemon	260 SF	Seed @ 1 oz. per 200 SF
GLE TRI	Gleditsia triacanthos inermis 'Skyline'	Skyline Honey Locust	31	2" cal., 12'-14' ht., 3' min. spd.	24" box	VO WIT	Voea witrockiana 'Pale Lavender'	Pansy	151 SF	Flats, 6" o.c.
KOE PAN	Koeleruteria paniculata	Goldenrain Tree	16	2" cal., 12'-14' ht., 3' min. spd.	24" box	VO WIT	Voea witrockiana 'Deep Purple'	Pansy	122 SF	Flats, 6" o.c.
PIC PUN	Picea pungens	Blue Spruce	26	6'-8' ht., 3' min. spd.	24" box	TURF				
PIN NIG	Pinus nigra	Austrian Pine	46	6'-8' ht., 3' min. spd.	24" box	Poa pratensis 'Adelphi'	Adelphi Kentucky Bluegrass	390,000 SF	----	Seed at 250 lbs. per acre with equal amounts (by weight) of each
PIN PIN	Pinus pinea	Italian Stone Pine	13	6'-8' ht., 3' min. spd.	24" box	Lolium perenne 'Manhattan'	Manhattan Ryegrass	----	----	
						Festuca elatior 'Rebel'	Tall Fescue	----	----	
						NATIVE GROUND COVER				
PLA ACE	Platanus acerifolia	London Plane Tree	22	2" cal., 12'-14' ht., 3' min. spd.	24" box	Bouteloua eriopoda	Black Grama			2 lbs. PLS/acre at 1/2" depth
PLA WRI	Platanus wrightii	Arizona Sycamore	44	2" cal., 12'-14' ht., 3' min. spd.	24" box	Bouteloua gracilis	Blue Grama			2 lbs. PLS/acre at 1/2" depth
PLA WRI	Platanus wrightii	Arizona Sycamore	5	Multi-trunk consisting of: (1) 2" cal., 12'-14' ht., 3' min. spd. (1) 1-1/2" cal., 10'-12' ht., 3' min. spd. (1) 1" cal., 8'-10' ht., 3' min. spd.	24" box	Hilaria jamesii	Galleta			5 lbs. PLS/acre at 1/2" depth
						Sporobolus cryptanarus	Sand Dropseed			3 lbs. PLS/acre at 1/2" depth
PYR CAL	Pyrus calleryana 'Bradford'	Bradford Pear	58	2" cal., 10'-12' ht., 3' min. spd.	24" box	PLANTING NOTES				
SOP JAP	Sophora japonica	Japanese Pagoda	25	2" cal., 12'-14' ht., 3' min. spd.	24" box	1. In case of a discrepancy in plant quantities shown on the Plant List and those shown on the Planting Plans, the quantities shown on the plans shall govern.				
SHRUBS						2. Quantities shown on the Plant List are estimates only. Contractor shall verify all quantities prior to bid and installation. No additional payment will be made for any discrepancies in quantities between the Planting Plans and the Plant List.				
CHR NAU	Chrysothamnus nauseosus	Rubber Rabbitbrush	35	2'-3' ht.	5 gallon, 6'-0" o.c.	3. See Sheet 26 for Tree and Shrub Planting Details.				
COT DAM	Cotoneaster dammeri	Bearberry Cotoneaster	39	2'-3' ht.	5 gallon, 2'-3' min. spd.	4. A 2" depth of splintered decorative bark mulch shall be installed throughout all shrub beds and under tree trunks.				
FAL PAR	Fallugia paradoxa	Apache Plume	52	2'-3' ht.	5 gallon, 6'-0" o.c.	5. A 36" diameter ring of 2" depth bark mulch shall be provided at the base of all trees outside shrub beds including at existing trees.				
JUN SAB	Juniperus sabina 'Broadmoor'	Broadmoor Juniper	21	10" min. ht., 18" min. spd.	5 gallon, 4'-0" o.c.	6. A 2' wide strip of 2" depth bark mulch shall be installed at the base of vines at fence. (Add Alt. #4)				
PEN SET	Pennisetum setaceum	Fountain Grass	30	8" min. ht.	5 gallon, 30" o.c.	7. The Contractor shall prune lower branches of deciduous trees to 6 feet above finish grade.				
RHU TRI	Rhus trilobata	Skunkbush	47	2'-3' ht., 6'-0" min. spd.	5 gallon,	8. Where trees are adjacent to walks, trails, or other hard construction items, the distance between the tree center and the adjacent hard construction shall be a minimum of 7'-0", unless specifically noted at easements. (See Note #13)				
SAM MEX	Sambucus mexicana	Mexican Elder	31	2'-3' ht., 2'-3' min. spd.	5 gallon	9. If there is a discrepancy in field or nursery trees between the container size called out under "Size" and the caliper and height called out under "Remarks", the specified tree must meet the caliper and height requirements specified under "Remarks," even if a larger container size is required to meet these specifications, at no additional cost to the Owner.				
SYR VUL	Syringa vulgaris	Lilac	6	2'-3' ht., 2'-3' min. spd.	5 gallon	10. Balled and burlapped (B & B) trees will be an acceptable substitute for container trees. B & B trees must meet the size requirements specified under "Remarks". Root ball sizes must meet the following specifications.				
VINES AND GROUND COVER						Deciduous Trees	Caliper	Min. Root Ball Diameter		
LON SEM	Lonicera sempervirens 'Majolica'	Trumpet Honeysuckle	84	Min. 4 stems of 12" min. length	1 gallon, 3'-0" o.c.		2"	24"		
GEL SEM	Gelsemium sempervirens	Carolina Jessamine	32	Min. 4 stems of 12" min. length	1 gallon, 5'-0" o.c.	Evergreen Trees	Height	Min. Root Ball Diameter		
HED HEL	Hedera helix	English Ivy	33	Min. 4 stems of 12" min. length	1 gallon, 12" o.c.		4'-6"	20"		
LON JAP	Lonicera japonica 'Halliana'	Hall's Honeysuckle	21	Min. 4 stems of 12" min. length	1 gallon, 12" o.c.		6'-8"	24"		
PAR QUI	Parthenocissus quinquefolia	Virginia Creeper	27	Min. 4 stems of 12" min. length	1 gallon, 10'-0" o.c.		8'-10"	30"		

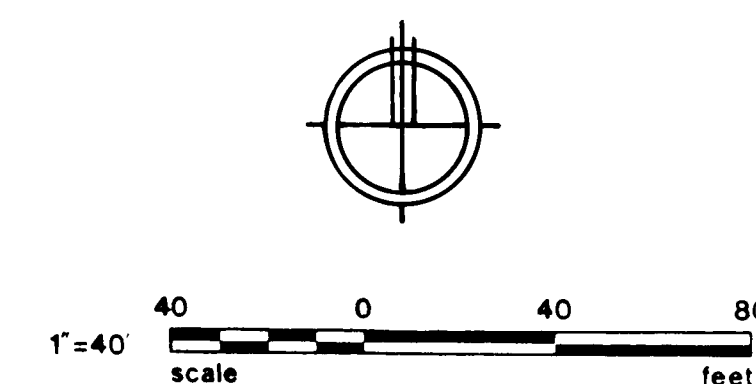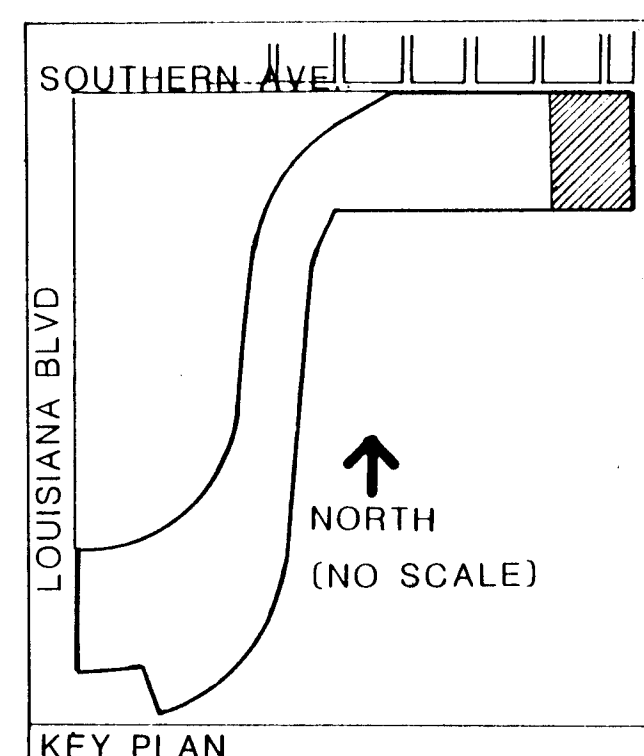

MORROW & COMPANY
LANDSCAPE ARCHITECTS
210 La Veta Drive NE
Albuquerque, New Mexico 87108
505-268-2266

26 27461593

CITY OF ALBUQUERQUE PUBLIC WORKS DEPARTMENT ENGINEERING GROUP					
TITLE: PHIL CHACON PARK - PHASES I & II PLANTING PLAN					
APPROVALS	ENGINEER	DATE	APPROVALS	ENGINEER	DATE
D.R.C. Chair				N/A	5/7/90
Trans Dev					
Utility Dev					
DRAWING NO.	2746	MAP NO.	L-19	SHEET	15 OF 29

ESPANOLA ST.
SAN PABLO ST.
SOUTHERN AVENUE
GROVE ST.
CHARLESTON ST.

SINGLE FAMILY RESIDENTIAL

BOOSTER PUMP
TRANSFORMER 200/400

WEATHER
STATION

CONNECT DIRECTLY
TO TRANSFORMER


FIXTURE
TYPE "D" (20)

2#12 THW &
1#12 THW GND
- 1/2" C

OUTLINE
OF UTILITY
EASEMENT

FIXTURE TYPE "A"
(TYPICAL OF 21)

FIXTURE TYPE "E"
(TYPICAL OF 7)

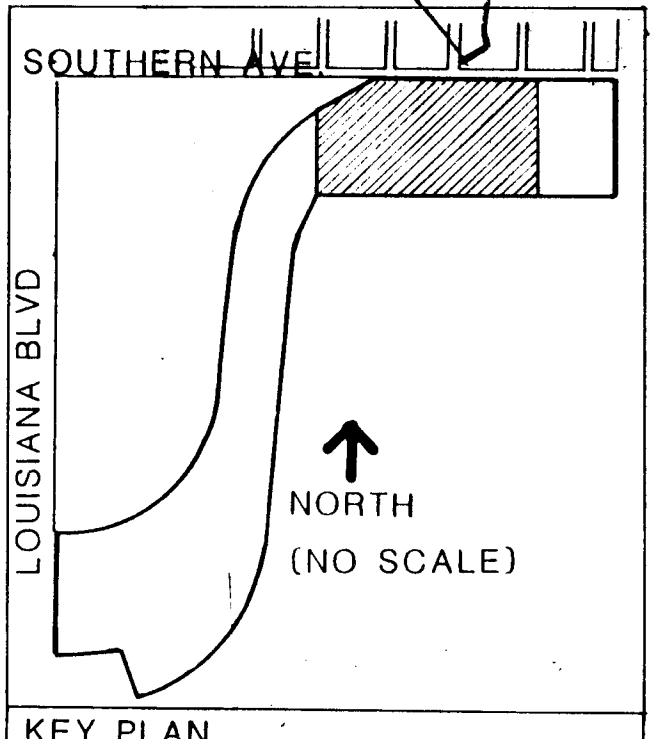

GENERAL NOTES

- ALL EMPTY CONDUITS SHALL INCLUDE PULL WIRE.
- ALL CONDUITS BELOW GRADE SHALL BE BURIED A MINIMUM OF 24" UNLESS OTHERWISE NOTED.

APPROVED FOR
CONSTRUCTION

APPROVED BY: *R. Morrow* PNM
DATE: 4/1/90

KEYED NOTES (CONT.)

- 3#8 THW AND 1#12 THW GROUND IN 1" CONDUIT.
- 2#8 THW AND 1#12 THW GROUND IN 3/4" CONDUIT.
- 2" EMPTY CONDUIT WITH PULL WIRE, STUB AND CAP 24" BELOW GRADE FOR FUTURE EXTENSION.
- FIELD VERIFY EXACT LOCATION OF SIGN PRIOR TO ROUGH-IN OF LIGHT FIXTURE.
- CONTRACTOR SHALL SUPPLY AND INSTALL APPROXIMATELY 100 FEET OF HEAT TAPE AT 6 WATTS PER FOOT AROUND BACK FLOW PREVENTER AND ALL EXPOSED WATER PIPES IN THE AREA OF THE BOOSTER PUMP.
- 3#4 THW AND 1#6 THW GROUND IN 1 1/4" CONDUIT.
- CONTRACTOR SHALL SUPPLY AND INSTALL APPROX. 100 FEET OF HEAT TAPE AT 6 WATTS/FOOT AROUND BACKFLOW PREVENTER AND ALL EXPOSED WATER PIPES FOR FOUNTAIN.

KEYED NOTES

- CONCRETE PAD PER PNM STANDARD DRAWING NUMBER DS-7-16.4.
- 4" CONCRETE ENCASED PVC, 42" MINIMUM BURIAL, WITH RGS OR IMC ELBOWS (CENTERED IN UTILITY EASEMENT).
- 200 AMP METER (BY PNM), METERING CAN BY CONTRACTOR.
- 42 CIRCUIT PANELBOARD WITH A 200A/3P MAIN BREAKER, SEE PANEL SCHEDULE FOR ADDITIONAL INFORMATION.
- PHOTOCELL LOCATED ON TOP OF POLE. MOUNT ON 6" RGS CONDUIT WITH WINDOW FACING NORTH.
- HUBBELL #5661 SINGLE RECEPTACLE WITH A HUBBELL #96067 LOCKING COVER AND PLATE. MOUNT FLUSH UP 6" IN WALL.
- JUNCTION BOX MOUNTED FLUSH IN SCREEN WALL FOR CONNECTION TO IRRIGATION CONTROLLER.
- PNM TO RELOCATE EXISTING POLE/LIGHTS TO NORTH SIDE OF SOUTHERN AVENUE.
- PNM TO RELOCATE EXISTING INTERMEDIATE POLE TO NORTH SIDE OF SOUTHERN AVENUE.
- 2#10 THW AND 1#12 THW GROUND IN 2" CONDUIT.
- CONTRACTOR TO INSTALL POLE BASE PER DETAIL ON SHEET 17. POLE AND LIGHTING FIXTURE PROVIDED AND INSTALLED BY PNM.
- FOUNTAIN PUMP CONTROLLER, BY OTHERS.
- 3/4" CONDUIT STUBBED AND CAPPED FOR PAVILION LIGHTING. EXTEND TO PANEL "A".
- 1" CONDUIT STUBBED AND CAPPED FOR FUTURE CONNECTION TO PAVILION LIGHTING. EXTEND TO PANEL "A".
- 3/4" CONDUIT STUBBED AND CAPPED FOR FUTURE TRELLIS LIGHTING. EXTEND TO PANEL "A".
- 1" CONDUIT STUBBED AND CAPPED FOR ELECTRICAL CONNECTIONS TO FUTURE RESTROOM. EXTEND TO PANEL "A".
- JUNCTION BOX FLUSH MOUNTED IN SCREEN WALL FOR CONNECTION TO WEATHER STATION.
- 4#6 THW AND 1#10 THW GROUND IN 1" CONDUIT.
- BOOSTER PUMP CONTROLLER & DISCONNECT SWITCH BY OTHERS.
- 4#10 THW AND 1#12 THW GROUND IN 3/4" CONDUIT.
- 6#8 THW AND 1#12 THW GROUND IN 1 1/4" CONDUIT.
- INDICATES WHICH PHASE LIGHTING FIXTURE IS TO BE CONNECTED TO.

KIRTLAND AIR FORCE BASE

26 27461693




1"=40'
scale
feet

MORROW & COMPANY
LANDSCAPE ARCHITECTS
210 La Veta Drive NE
Albuquerque, New Mexico 87108
505-268-2266




CITY OF ALBUQUERQUE PUBLIC WORKS DEPARTMENT ENGINEERING GROUP					
TITLE: PHIL CHACON PARK PHASES I & II ELECTRICAL PLAN					
APPROVALS	ENGINEER	DATE	APPROVALS	ENGINEER	DATE
DRC Chair					
Trans. Dev					
Utility Dev					
DRAWING NO.	27461693		MAP NO.	L-19	
			SHEET 17 OF 17		

MATCHLINE SHEET 16

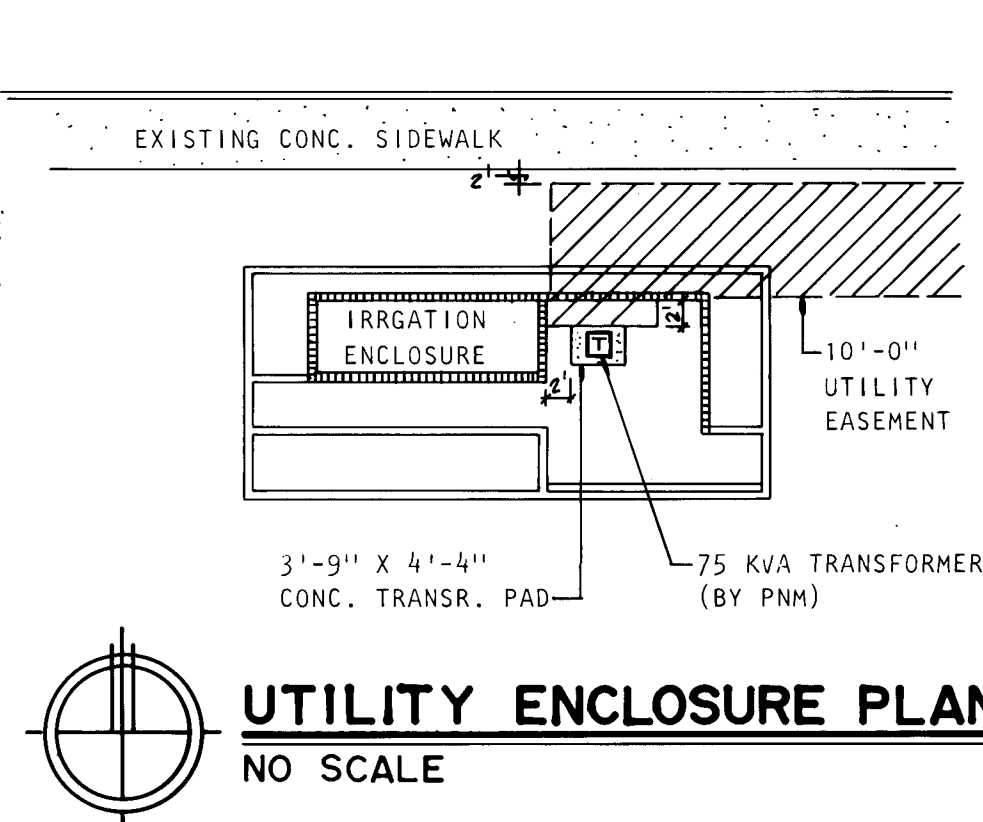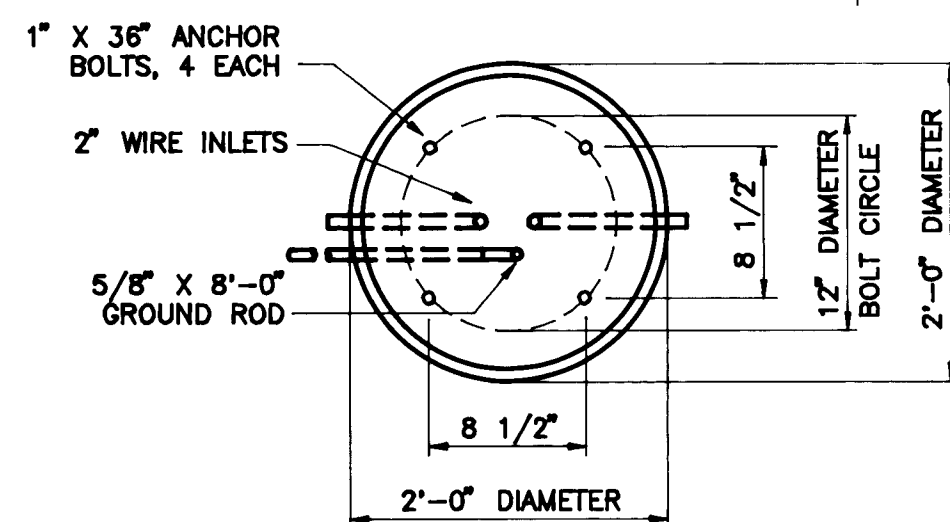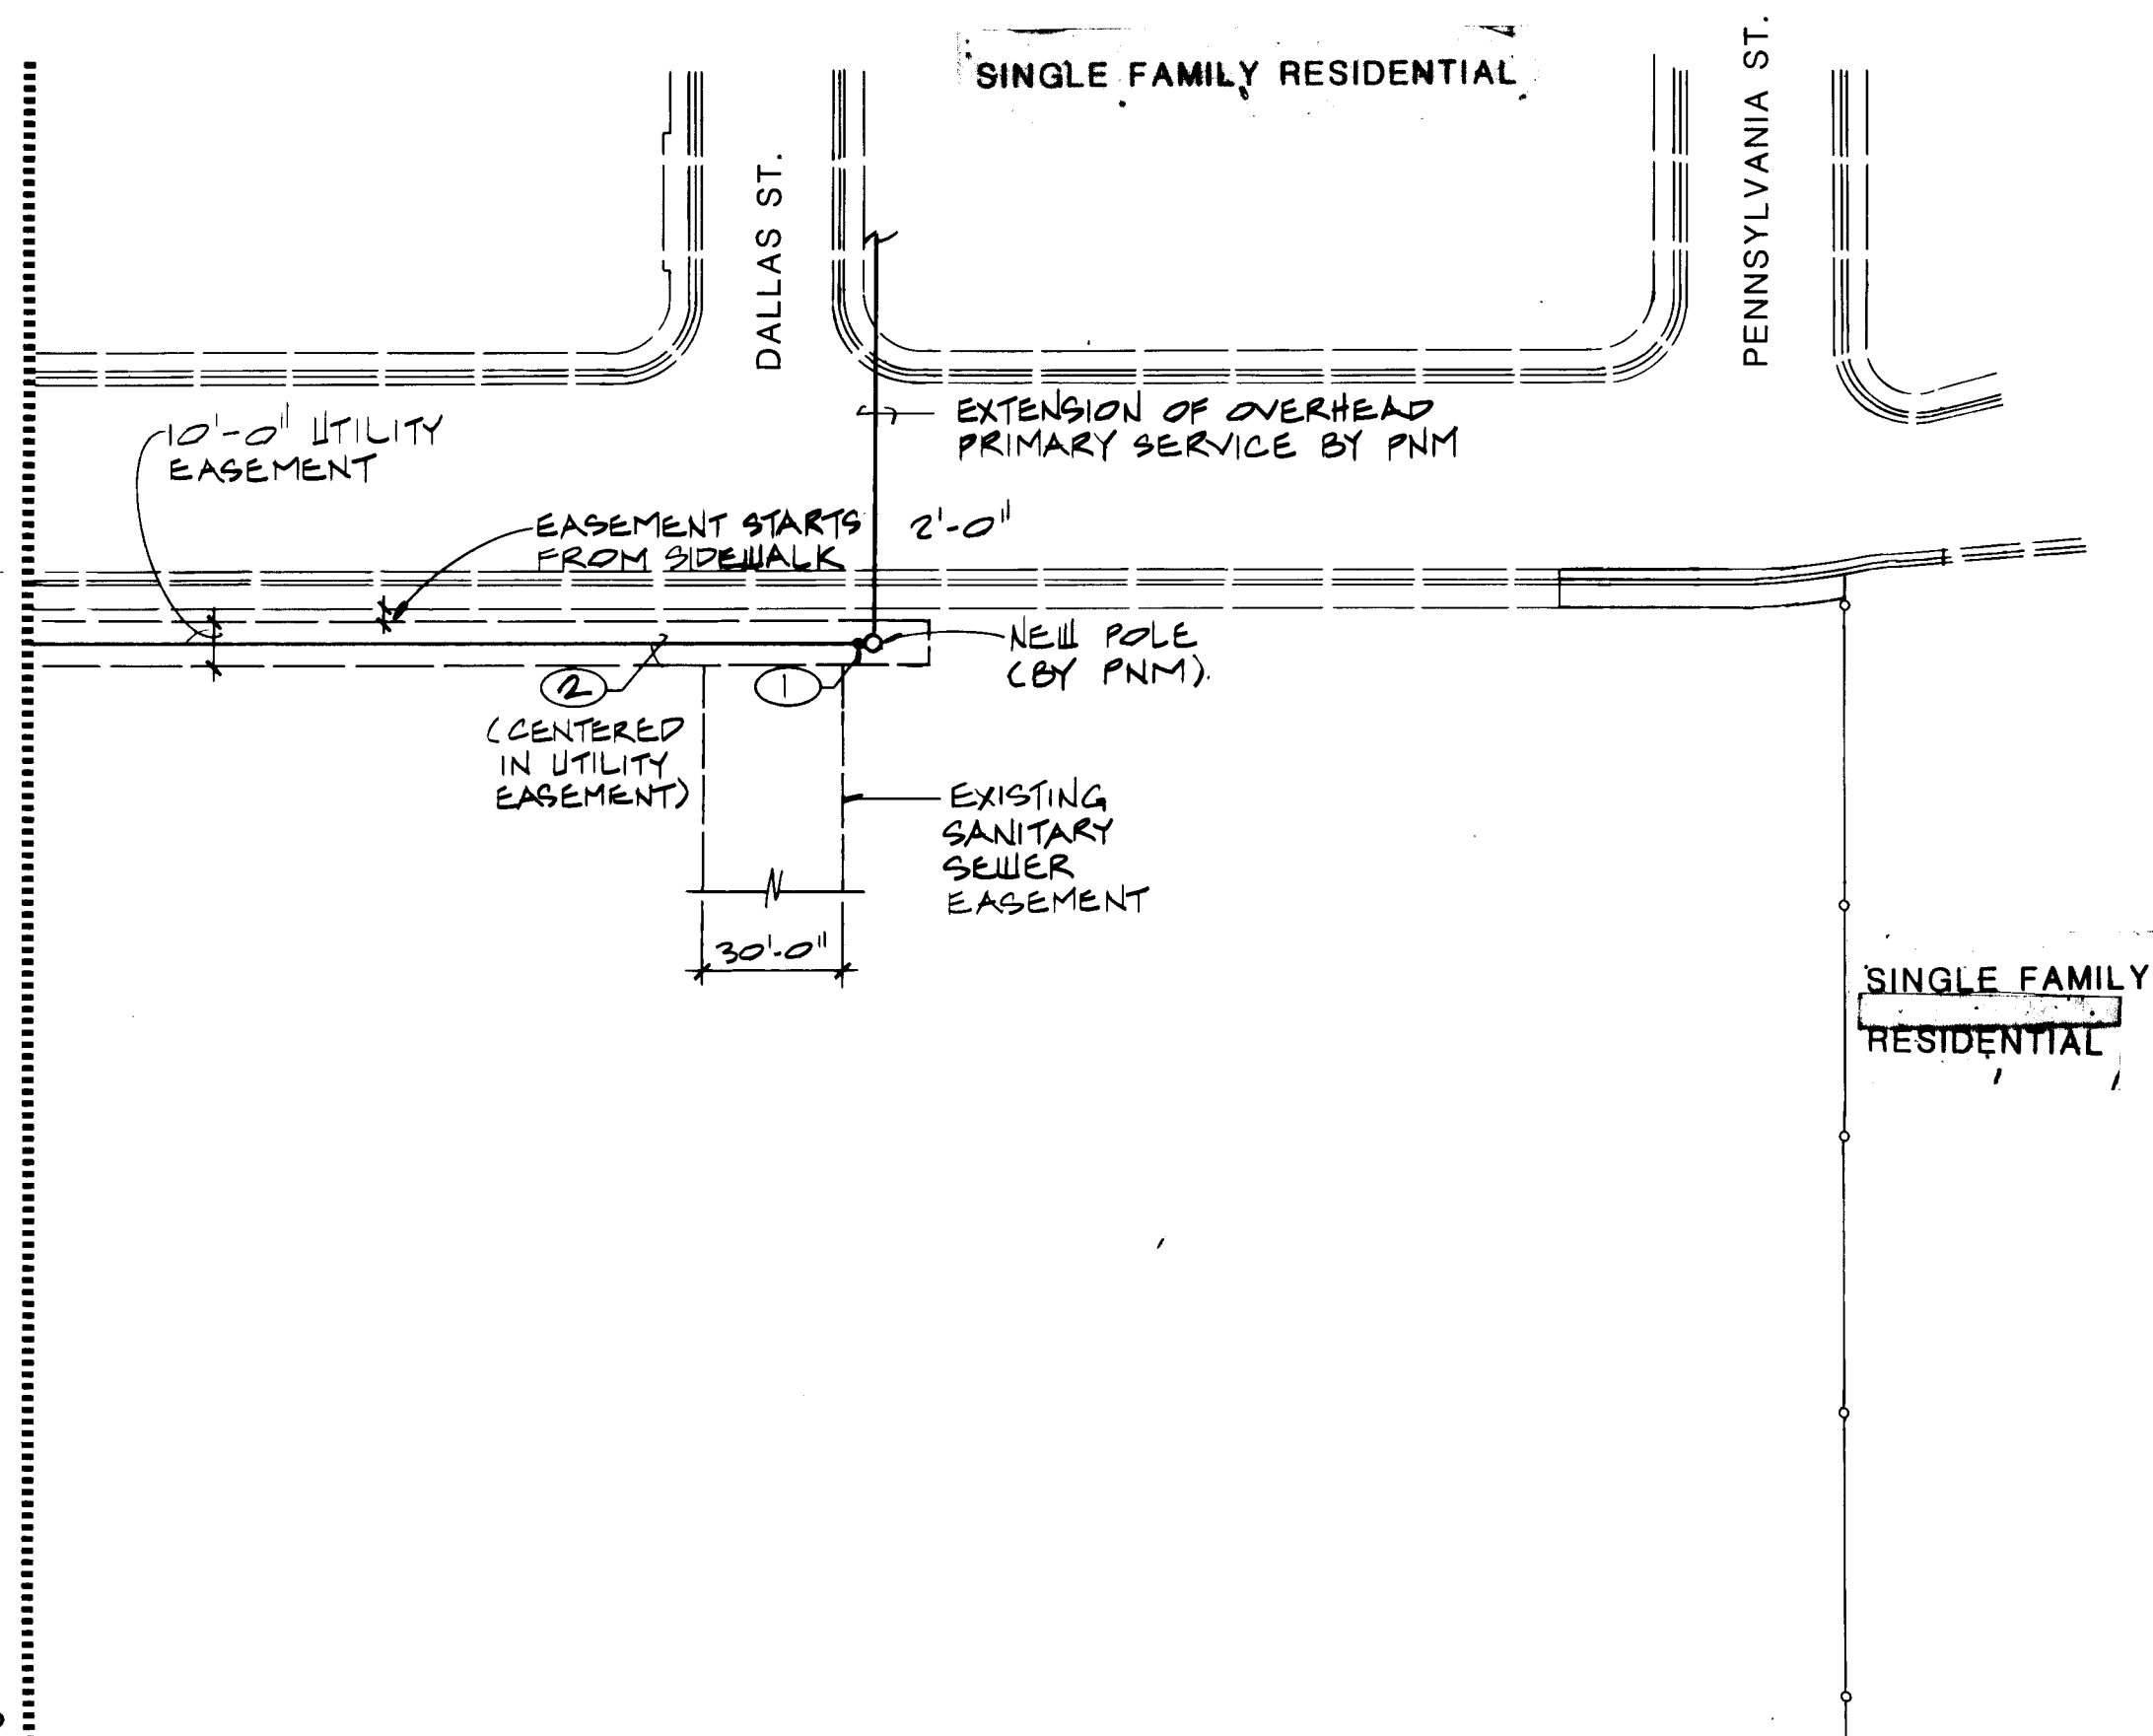

KIRTLAND AIR FORCE BASE

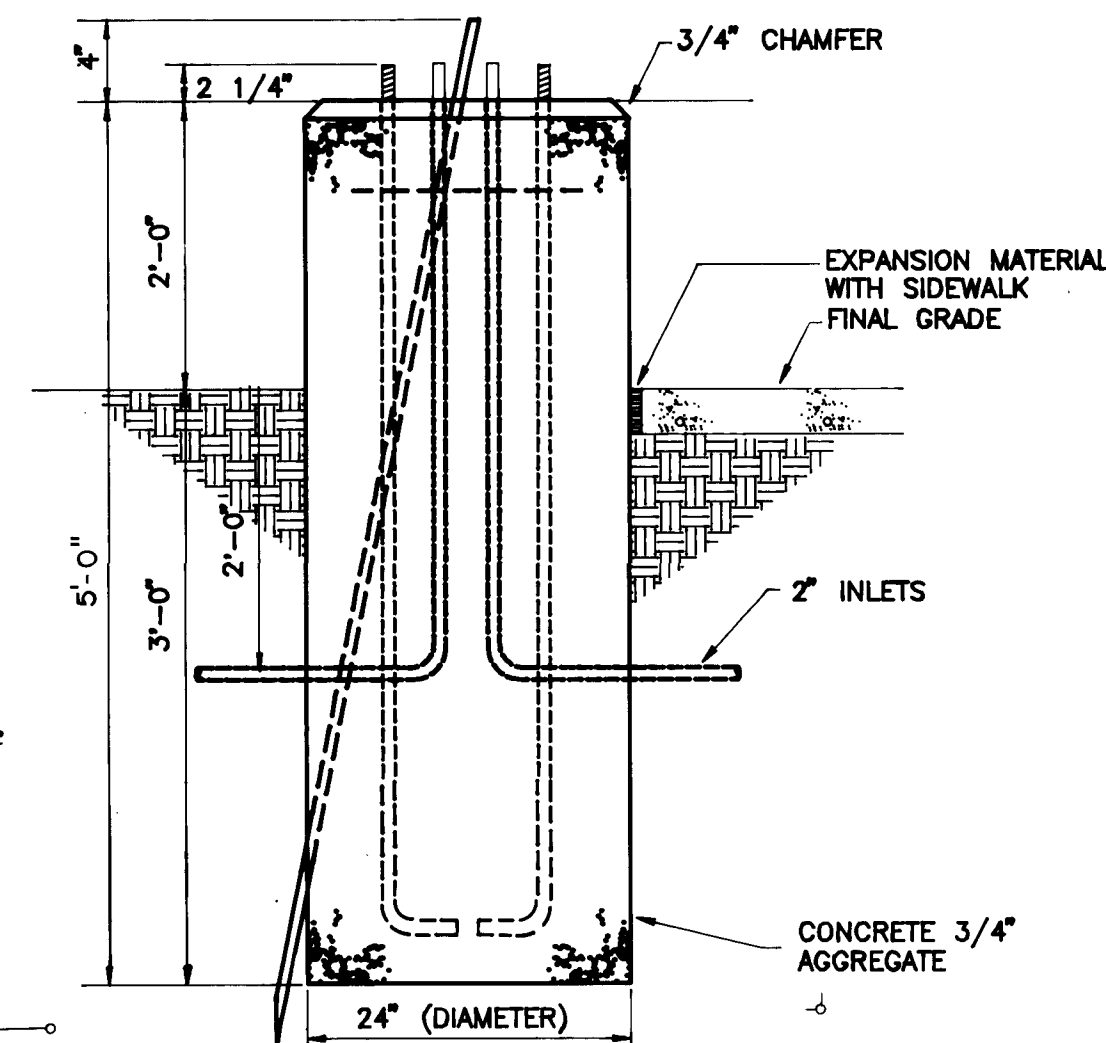

PARKING LOT POLE BASE DETAIL
NO SCALE


NOTES:

- (1) CONCRETE SHALL BE 3,000 PSI STRENGTH MIN. AT 28 DAYS.
- (2) SOIL OUTSIDE OF FOUNDATION DIMENSIONS MUST NOT BE DISTURBED.
- (3) USE EXPANSION MATERIAL IN AND AGAINST SIDEWALK INSTALLATION.
- (4) ALLOW A MINIMUM 14 DAYS OF CURING TIME BEFORE ERECTING POLE.

PANEL: "A"		VOLTAGE: 120/208		MAINS: 225A		A/C: 10,000	
		SKIRTS: N/A		FEED: BOTTOM		MAIN BREAKER: 200A	
						MOUNTING: SURFACE	
DESCRIPTION	BKR	LOAD (VA)	CCT NO	#A	#B	#C	DESCRIPTION
LIGHTING	20A	917	1	2050			LIGHTING
	3P	917	3	2050			
LIGHTING	20A/1P	600	7	1000			RECEPTACLES
WEATHER STATION	20A/1P	500	8	1364			1/3 HP PUMP
FOUNTAIN (MISC.)	20A/1P	500	11	1364			1/3 HP PUMP
FOUNTAIN (MISC.)	20A/1P	500	13	2158			3/4 HP PUMP
FOUNTAIN (MISC.)	20A/1P	500	15	3273			FOUNTAIN PUMPS + CONTROLS
HEAT TAPE	20A	500	17	3273			HEAT TAPE
SPARE	20A/1P	500	19	3273			
IRRIGATION CONTROLLER	20A/1P	500	23		1000		
LIGHTING (CONTROL)	20A/1P	200	25	200			SPARE
RECEPTACLES	20A/1P	400	27		400		SPARE
SPARE	20A/1P	200	29				SPARE
FOSTER	60A		31				SPACE
PUMP			33				SPACE
TRANS	3P		35				SPACE
SPACE			37	7128			SPACE
SPACE			39	7128			SPACE
SPACE			41	7128			SPACE
		TOTAL (VA)		15,807		14,715	
				14,715		14,815	
		TOTAL CONNECTED (KVA): 45.3		ESTIMATED DEMAND (KVA): 39.5		DOOR-IN-DOOR GROUND BUS	

LIGHT FIXTURE SCHEDULE


TYPE	DESCRIPTION	LAMPS	MOUNTING
A	GARDCO #EH1411208150HPSBRP - POLY WITH #GSP15D1PP (15' DARK BRONZE POLE)	1/150W/HPS	SEE DETAIL
B	GARDCO #EH1421208150HPSBRP - POLY WITH #GSP15D2PP (15' DARK BRONZE POLE)	2/150W/HPS	SEE DETAIL
C	GARDCO #EH141120870HPSBRP - POLY WITH #GSP15D1PP (15' DARK BRONZE POLE)	1/70W/HPS	SEE DETAIL
D	ADRA #TLM-647-70E-17HPS-6153-6193	1/70W/HPS	GROUND, 2'-6" AWAY FROM SIGN
E	ADRA #TLM-647-75E-17MV	1/75W/MV	GROUND, IN TREE GRATE OPENING.

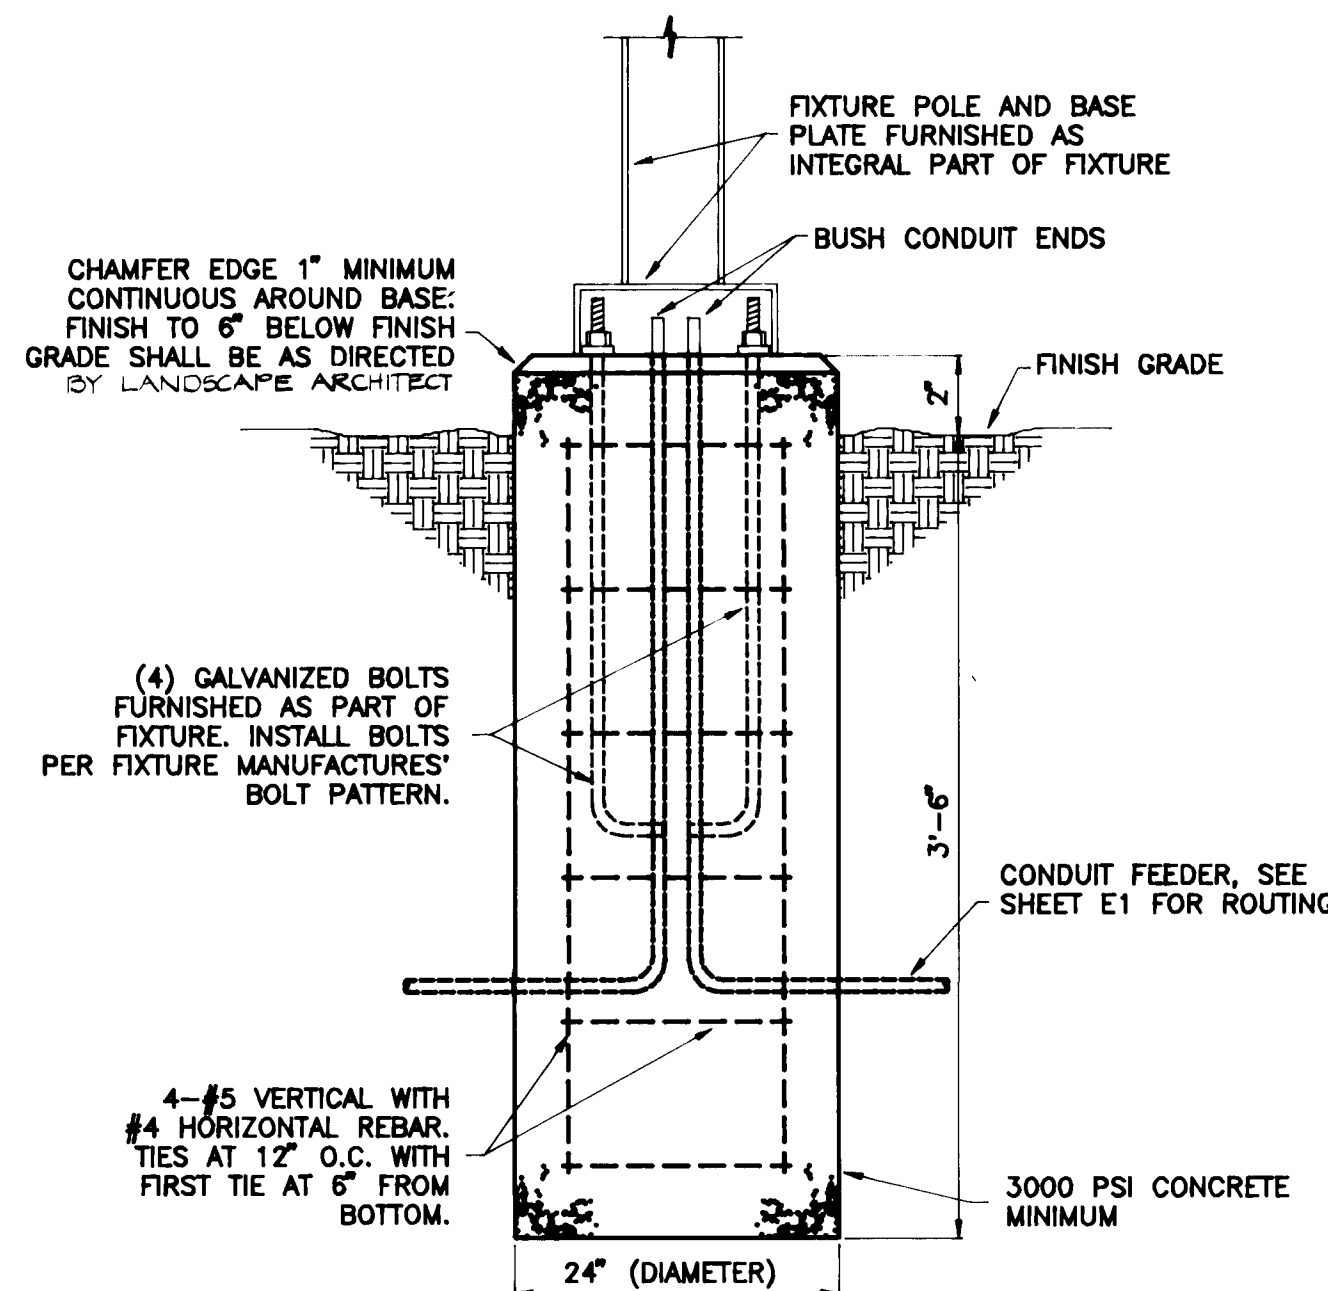



FIXTURE TYPES "A,B, & C" MOUNTING DETAIL
NO SCALE

KEYED NOTES

- (1) 4" IMC CONDUIT RISER UP POLE PER PNM STANDARD DRAWING NO. DS-7-15.0.
- (2) 4" CONCRETE ENCASED PVC, 42" MINIMUM BURIAL WITH RGS OR IMC ELBOWS.
- (3) 200 AMP METER (BY PNM), METERING CAN, BY CONTRACTOR.
- (4) 4-250 MCM TWH AND 1#2 TWH GROUND IN 3" CONDUIT.
- (5) 42 CIRCUIT PANELBOARD WITH A 200A/3P MAIN CIRCUIT BREAKER, SEE PANEL SCHEDULE FOR ADDITIONAL INFORMATION. NEMA 3R ENCLOSURE WITH PROVISIONS FOR PAD LOCKING.
- (6) 10 POLE ELECTRICALLY HELD LIGHTING CONTACTOR IN NEMA 3R LOCKING ENCLOSURE, SQUARE "D" NO. LH-1000.
- (7) 2" EMPTY CONDUIT WITH PULL WIRE, STUB AND CAP 24" BELOW GRADE FOR FUTURE EXTENSION.
- (8) 2" CONDUIT FOR PARKING LOT LIGHTING, W/PULL WIRE.
- (9) NEMA 3R 12x12x6" J-BOX - PHOTOCELLS ON EACH POLE LIGHT PROVIDED BY PNM

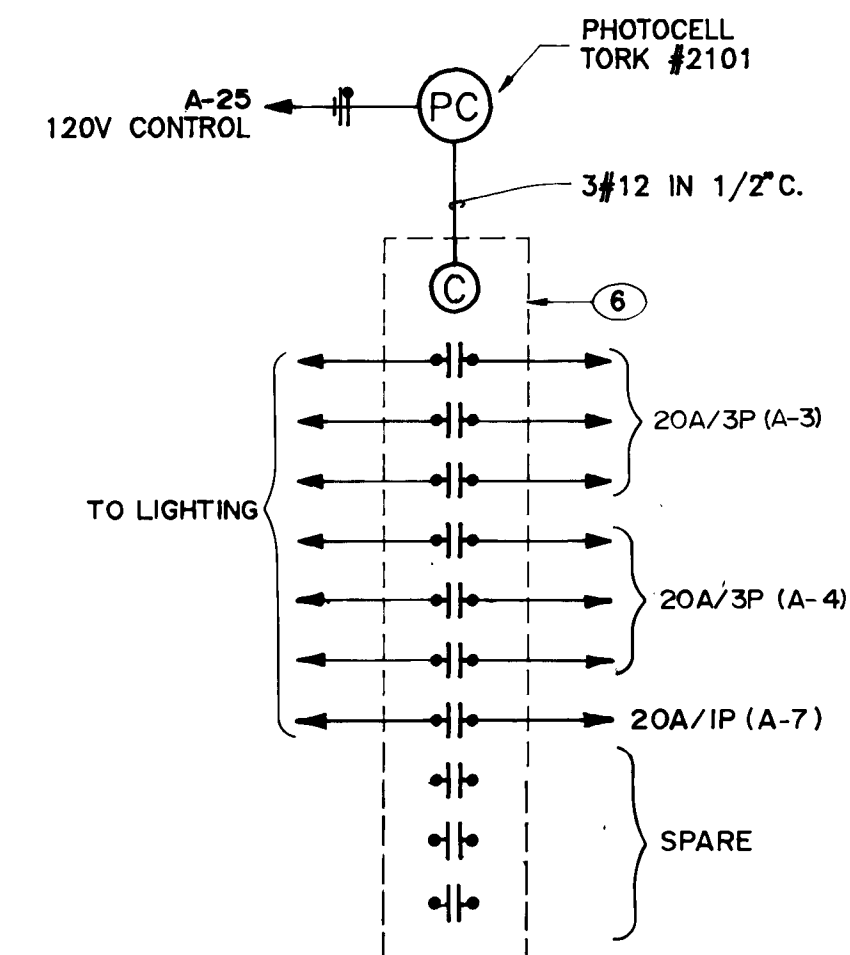

LIGHTING CONTROL DIAGRAM

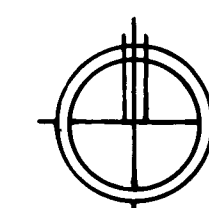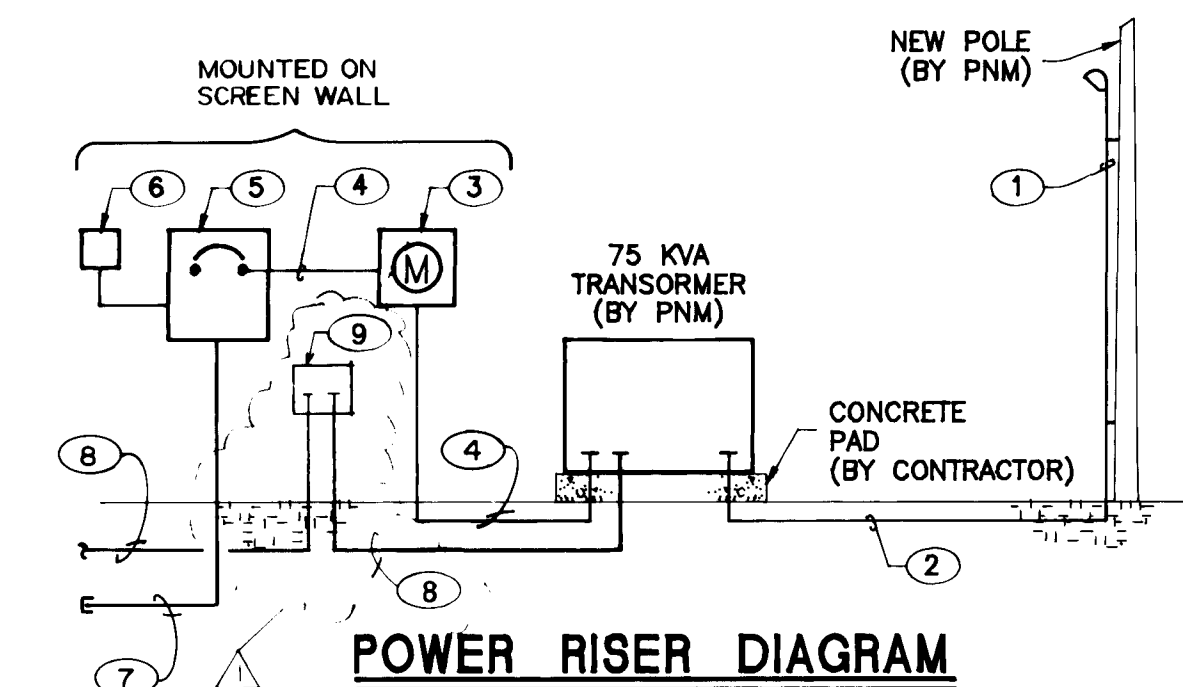

1"=40' scale

MORROW & COMPANY
LANDSCAPE ARCHITECTS
210 La Veta Drive NE
Albuquerque, New Mexico 87108
505-268-2266

CITY OF ALBUQUERQUE PUBLIC WORKS DEPARTMENT ENGINEERING GROUP					
TITLE: PHIL CHACON PARK - PHASES I & II ELECTRICAL DETAILS					
APPROVALS	ENGINEER	DATE	APPROVALS	ENGINEER	DATE
D.R.C. Chair			Hydrology	N/A	9/7/90
Trans. Dev	N/A	9-17-90			
Utility Dev	R.W. Kane	9-17-90			
Drawn By	D. Selma	9-5-90			
DRAWING NO.	2746	MAP NO.	L-19	SHEET 17	OF 20

[illegible]

BRICK PAVING SET
IN RUNNING/BOND
MIXTURE
PATTERN

CONC PAVING

DEL. COURSE
BRICK EDGING





PLAN

CONCRETE WALK/PAVING SECTION

③ CONG. WALK W/ INTEGRAL HEADER CURB

① C HEADER CURB SECTION


 BRICK PAVING DETAIL
 1" = 1'-0"

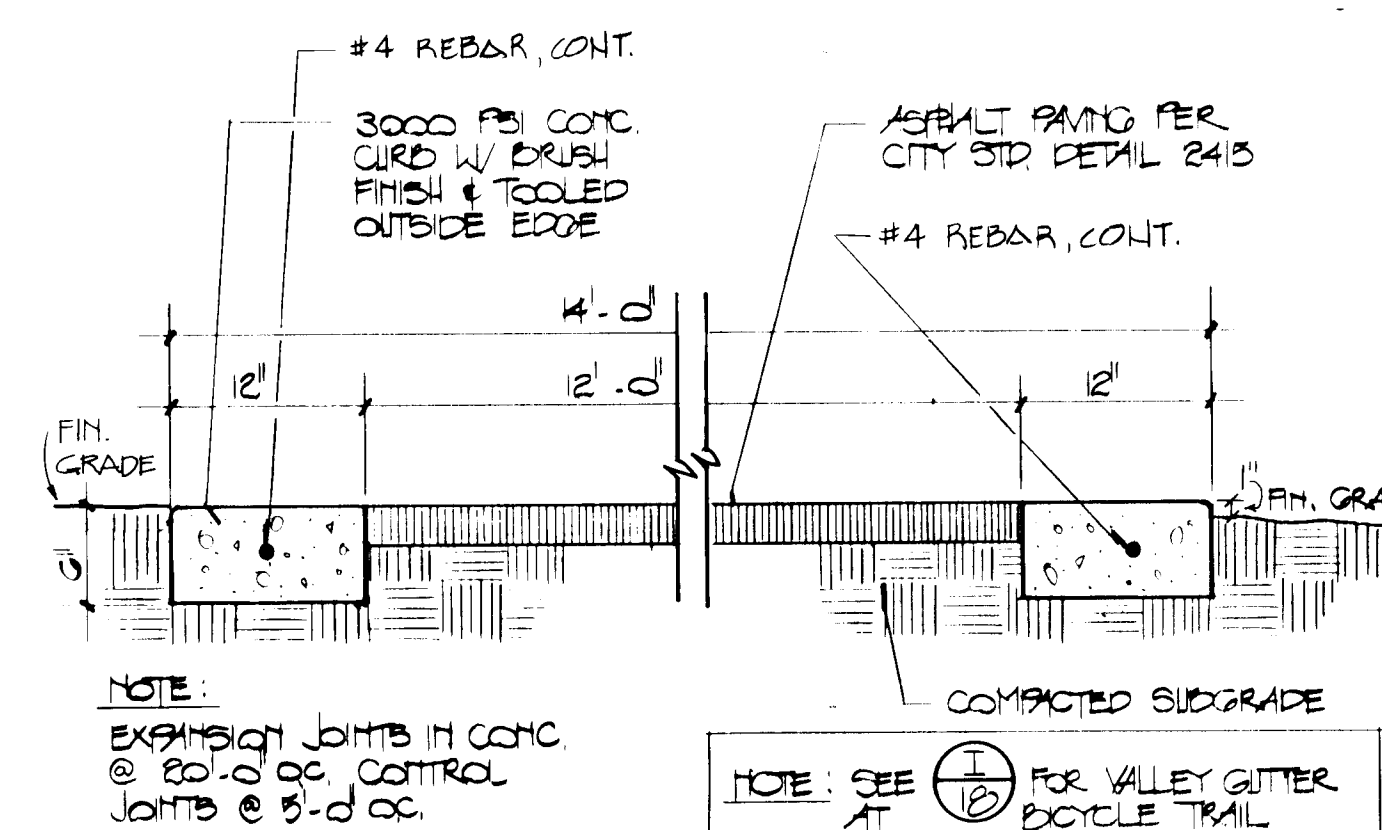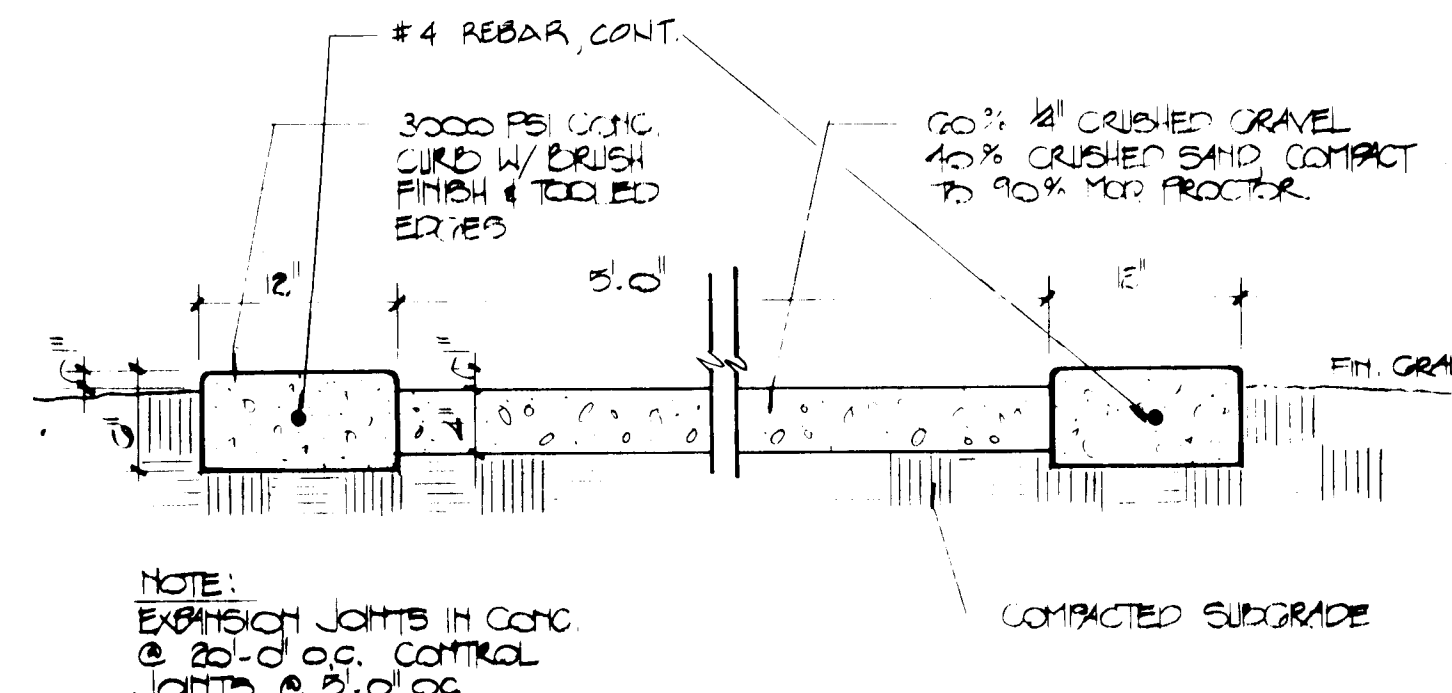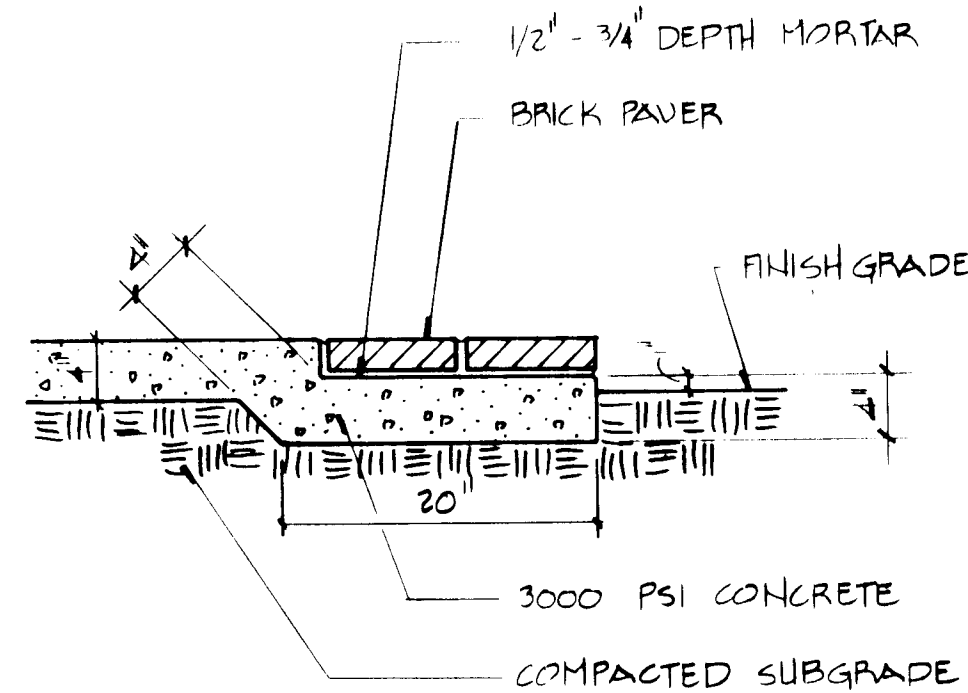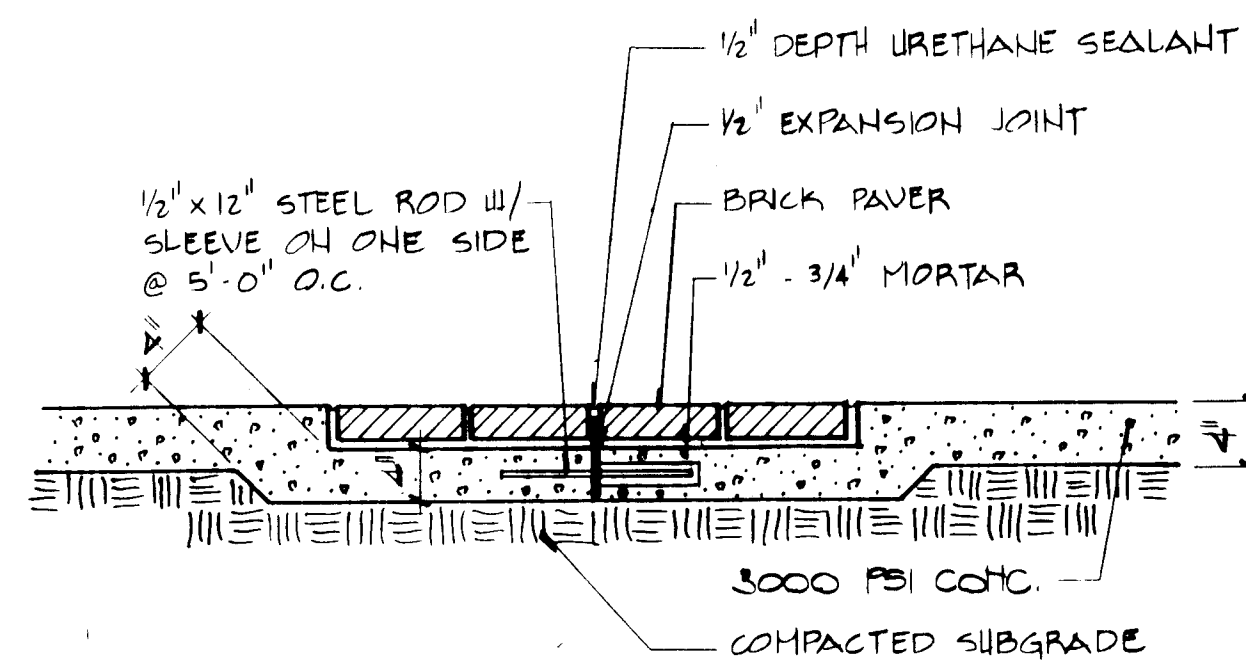

BRICK EDGING @ EXPANSION JOINT

BRICK EDGING @ EDGE OF CONCRETE SECTION


 PEDESTRIAN TRAIL SECTION
 || = 1'-0"

BICYCLE TRAIL SECTION - WITH CURB

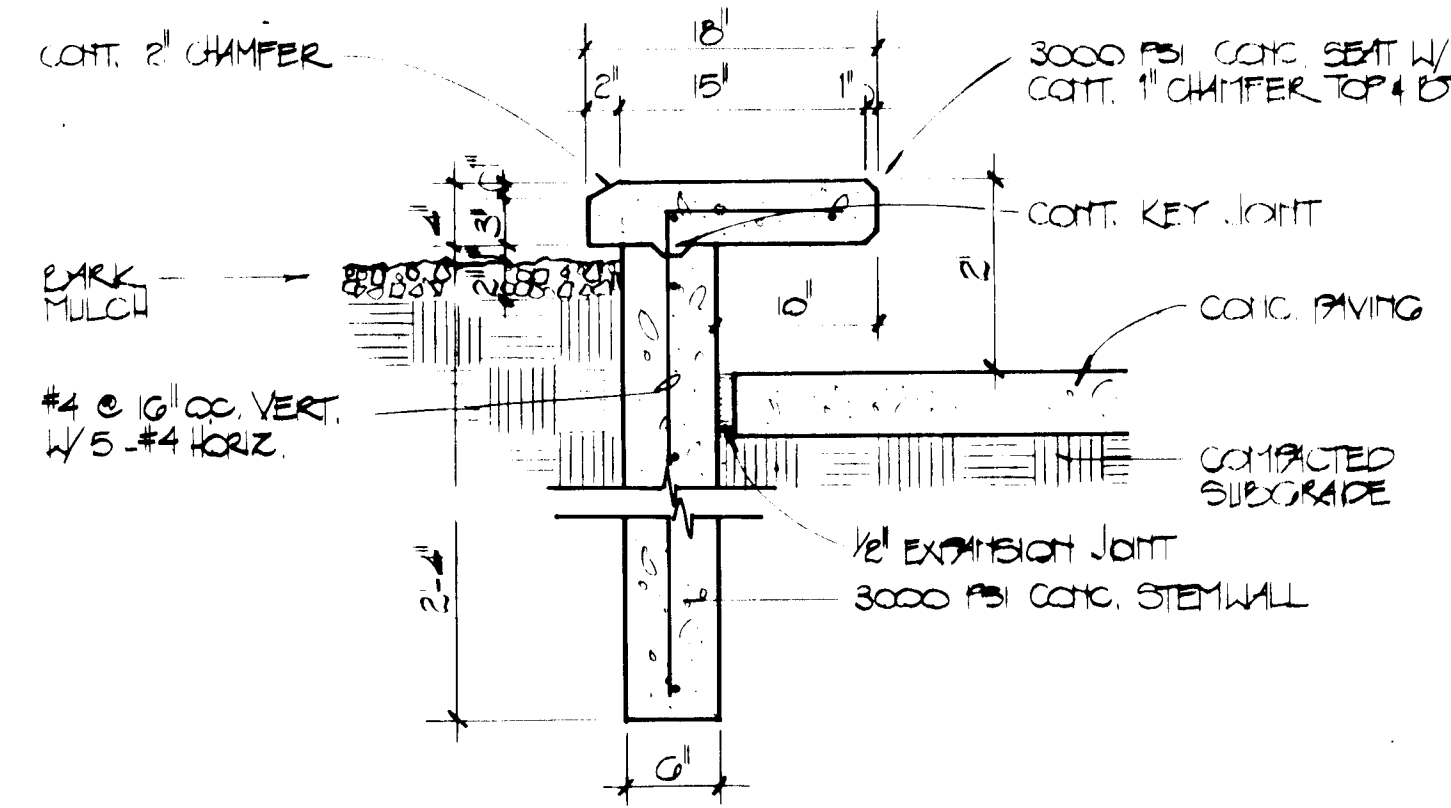
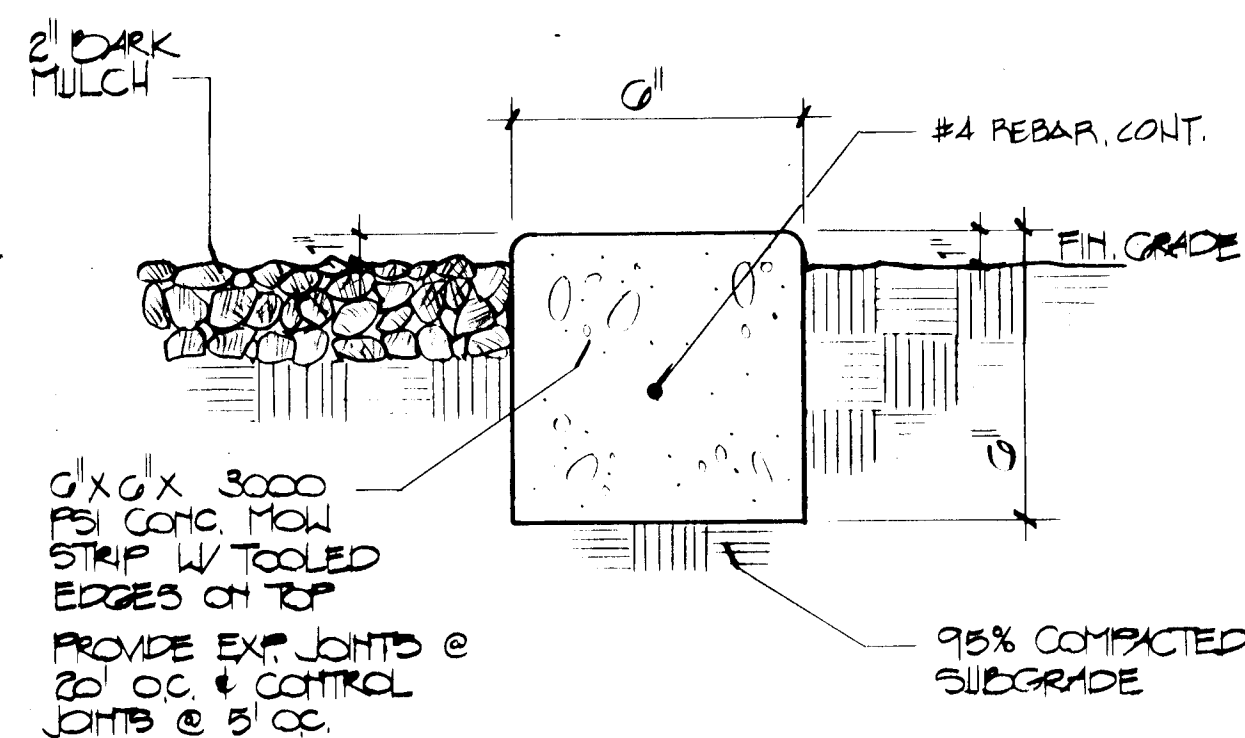
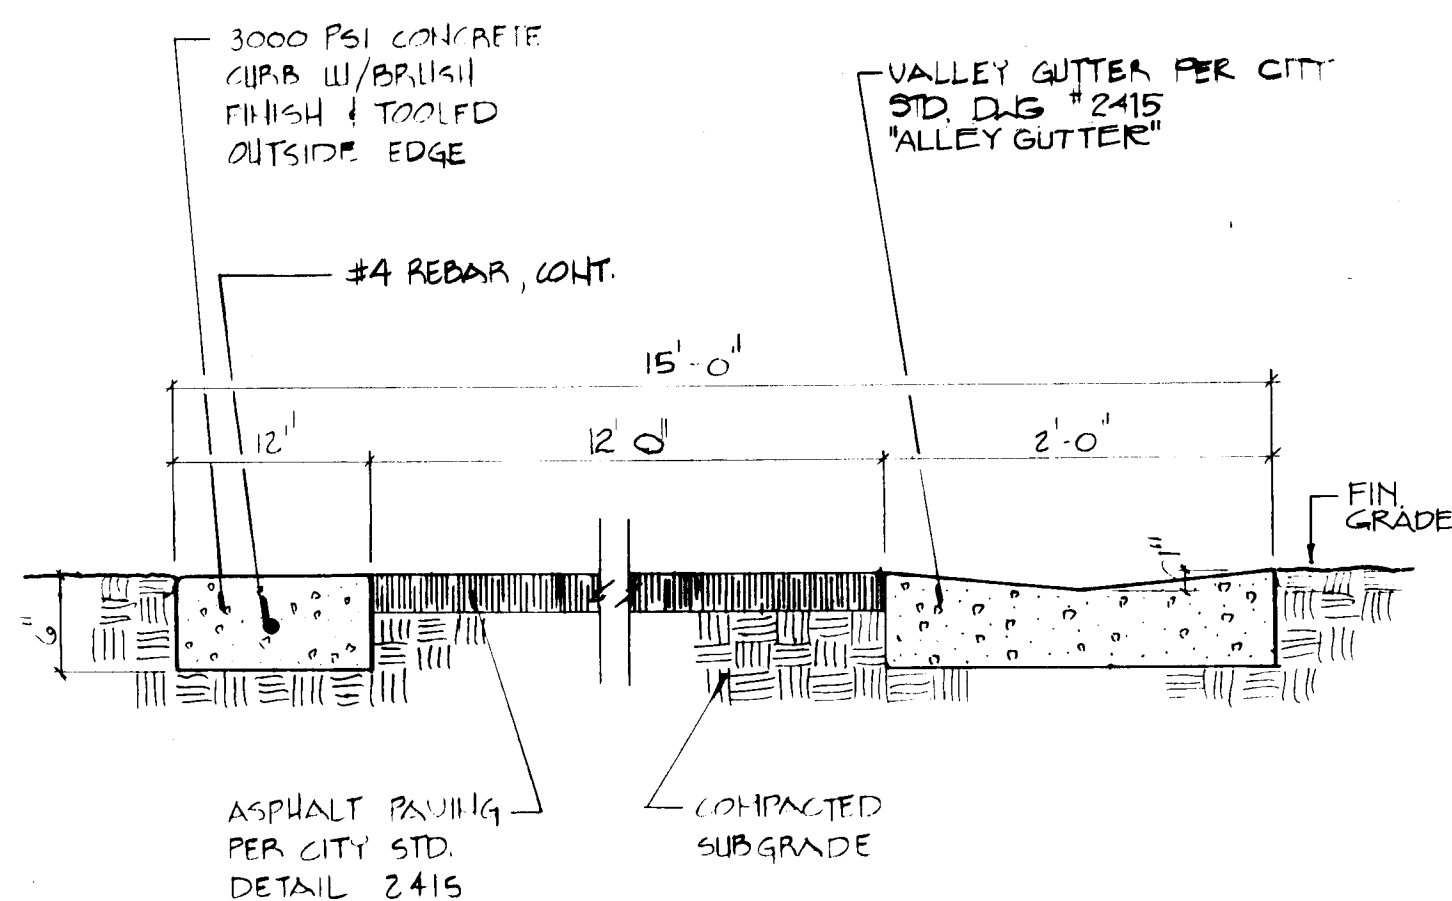


Diagram of a T-beam cross-section with dimensions and labels:

- Top flange width: $1'-6''$
- Top flange thickness: $6''$
- Web width: $10''$
- Web height: $2''$
- Stem height: $6'-0''$
- Stem width: $6'-0''$
- Stem thickness: C''
- Labels: E , J , O , M

① BICYCLE TRAIL W/ VALLEY GUTTER 1" = 1' - 0"



 MOW STRIP SECTION
 $3'' = 1'-0''$

(K) RAISED PLANTER DETAIL
(B) 1"=1'-0"


26 27461893

MORROW & COMPANY
LANDSCAPE ARCHITECTS
210 La Veta Drive NE
Albuquerque, New Mexico 87108
505 268-2266


CITY OF ALBUQUERQUE PARKS & RECREATION DESIGN & DEVELOPMENT						
TITLE: PHIL CHACON PARK PHASES I & II CONSTRUCTION DETAILS						
APPROVALS	ENGINEER	DATE	APPROVALS	ENGINEER	DATE	
DRC CHAIRMAN			WATER	R.W. Kane	9-17-90	
TRANSPORTATION	M. Bush	6-12-90	WASTE WATER	R.W. Kane	9-17-90	
HYDROLOGY	N/A	9/1/90				
THANKS	D. Sierra	9-05-90				
PROJECT NO. 2746			MAP NO. L-19 SHEET 18 OF 29			

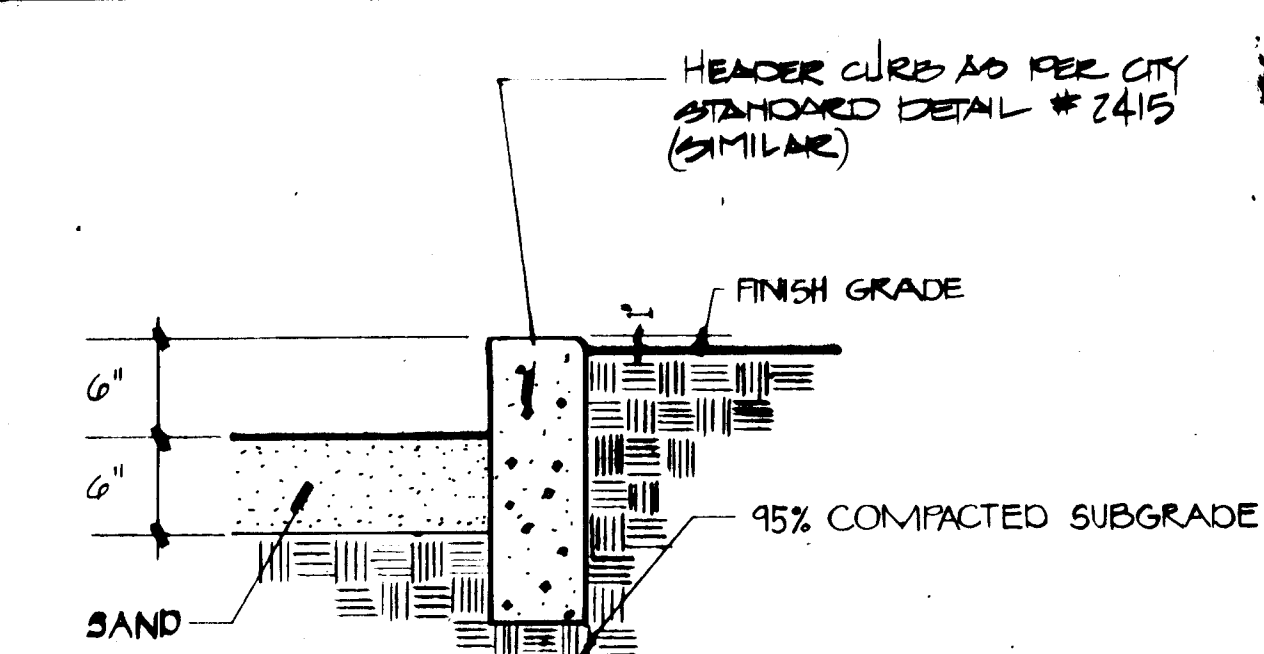


(A) HEADER CURB AT VOLLEYBALL COURT 1"=1'-0"

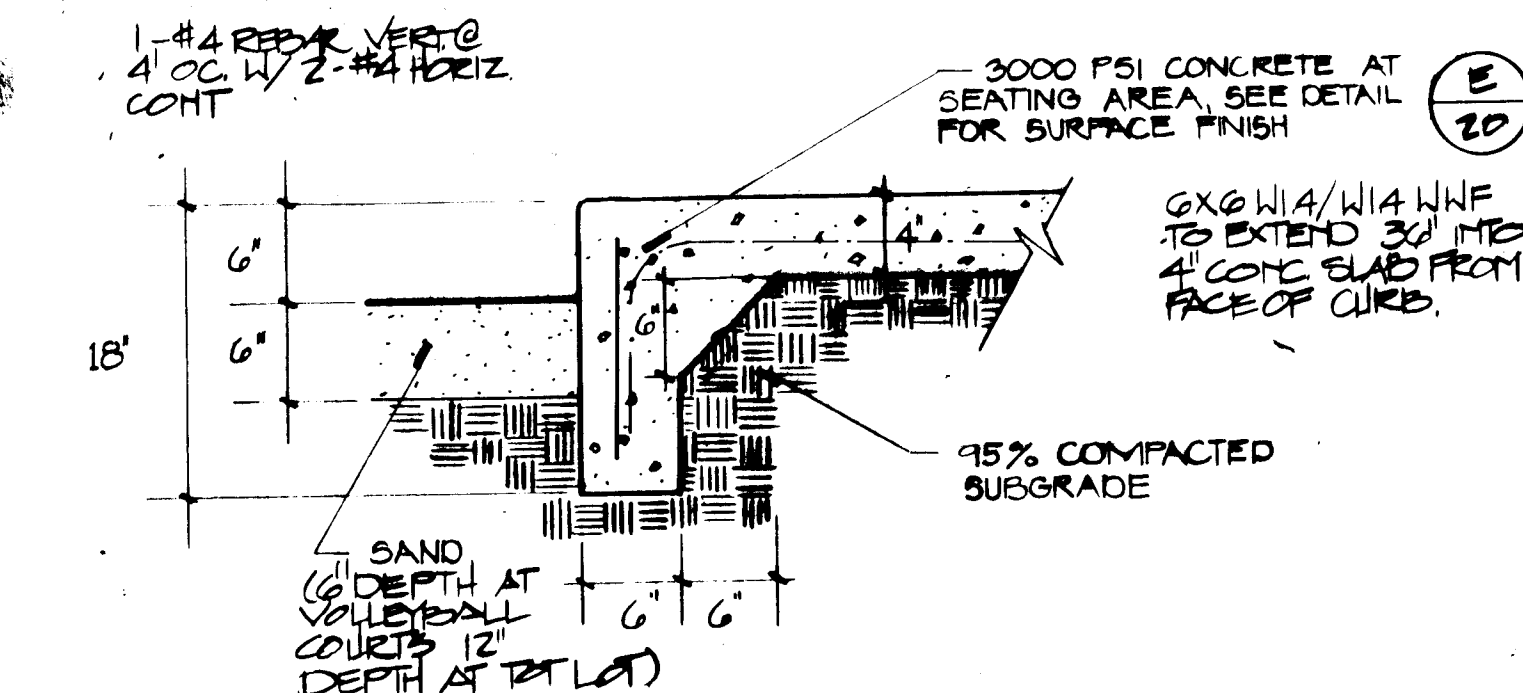


(B) INTEGRAL HEADER AT SEATING AREA / VOLLEYBALL COURT & TOT LOT 1"=1'-0"

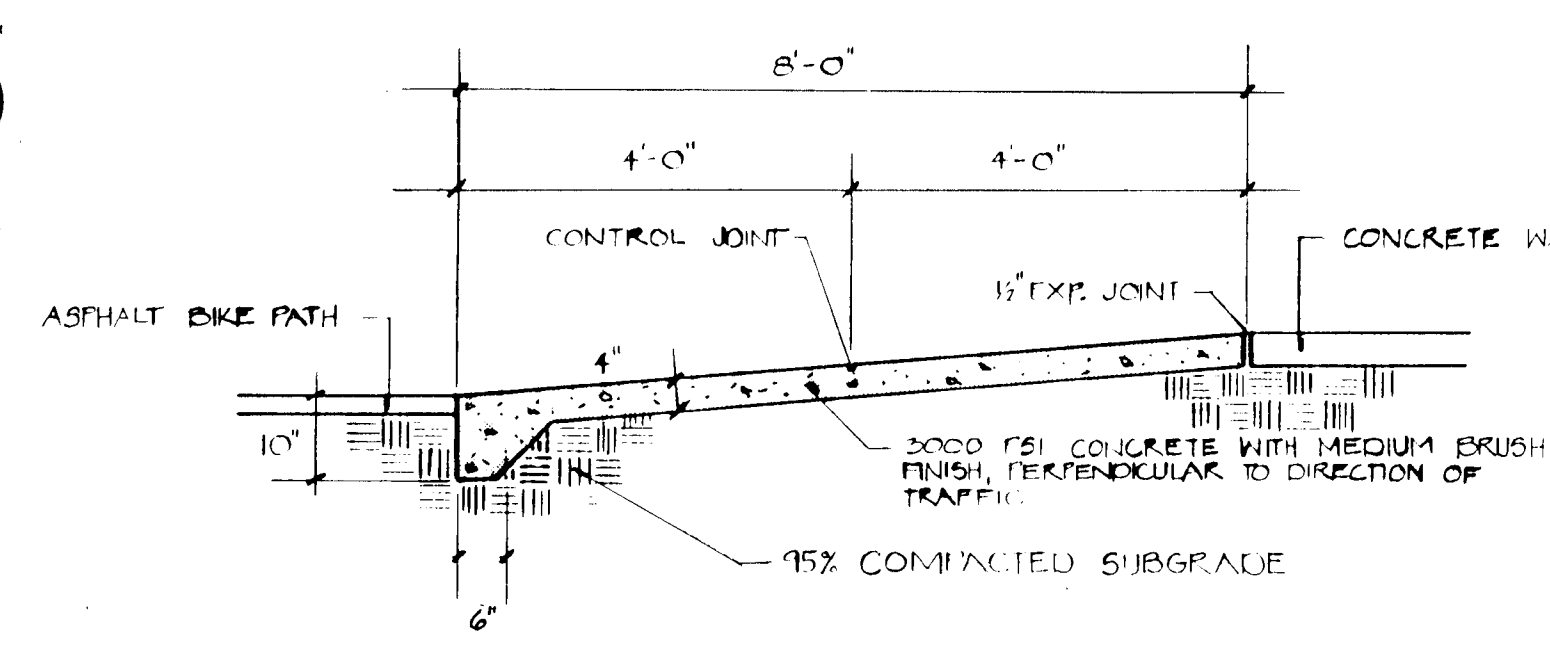


(C) BIKE RAMP SECTION 1/2"=1'-0"

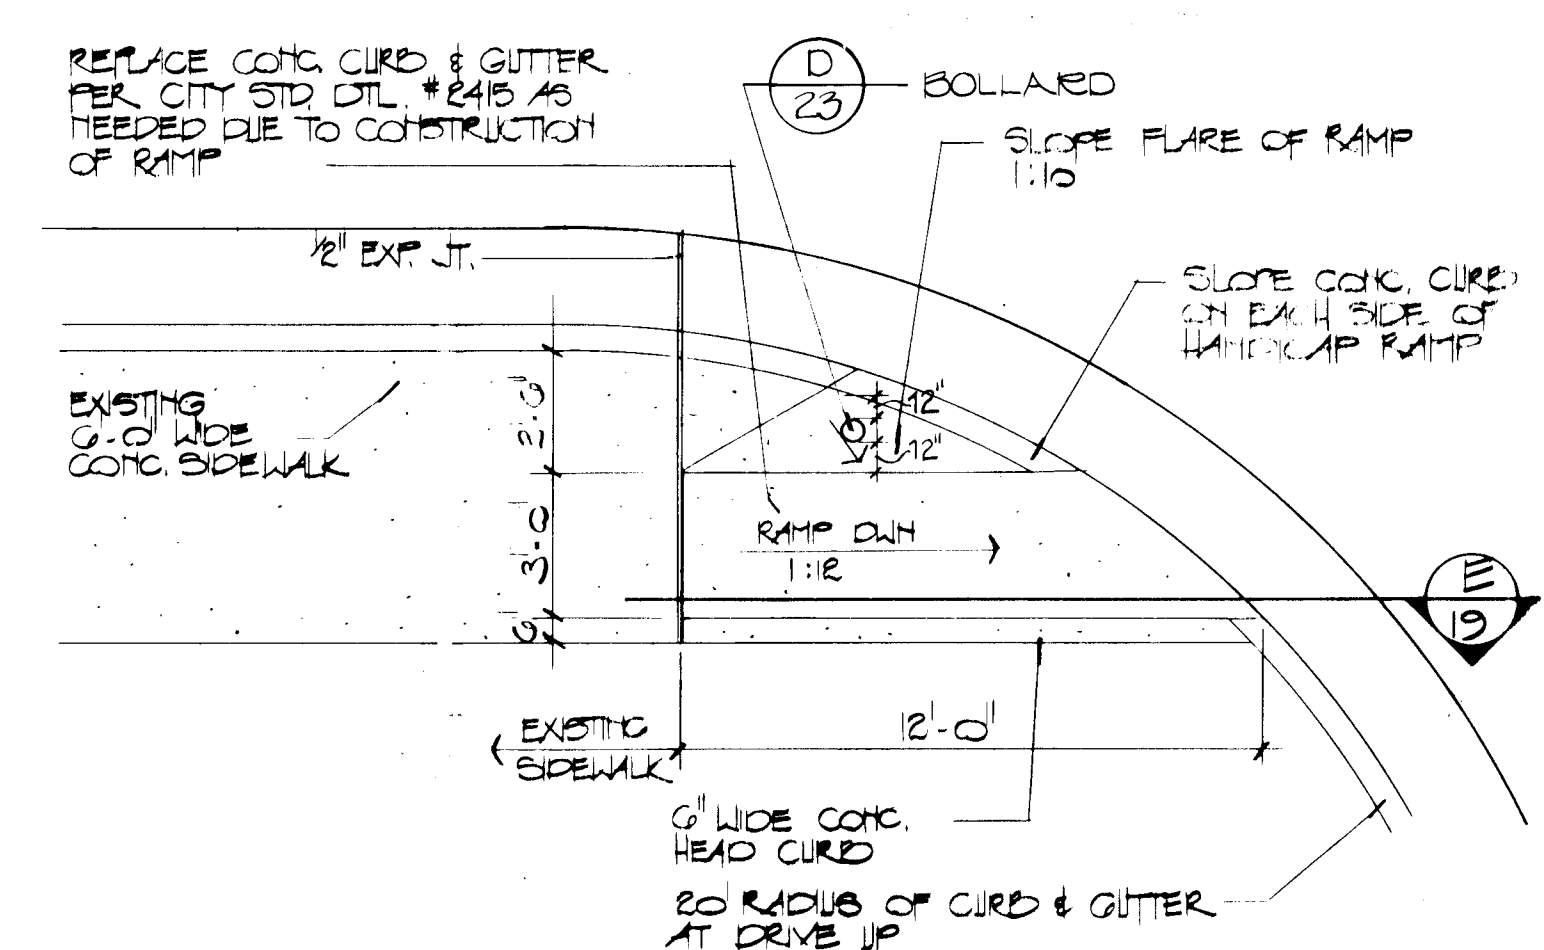


(D) HANDICAP RAMP PLAN 1/4"=1'-0"

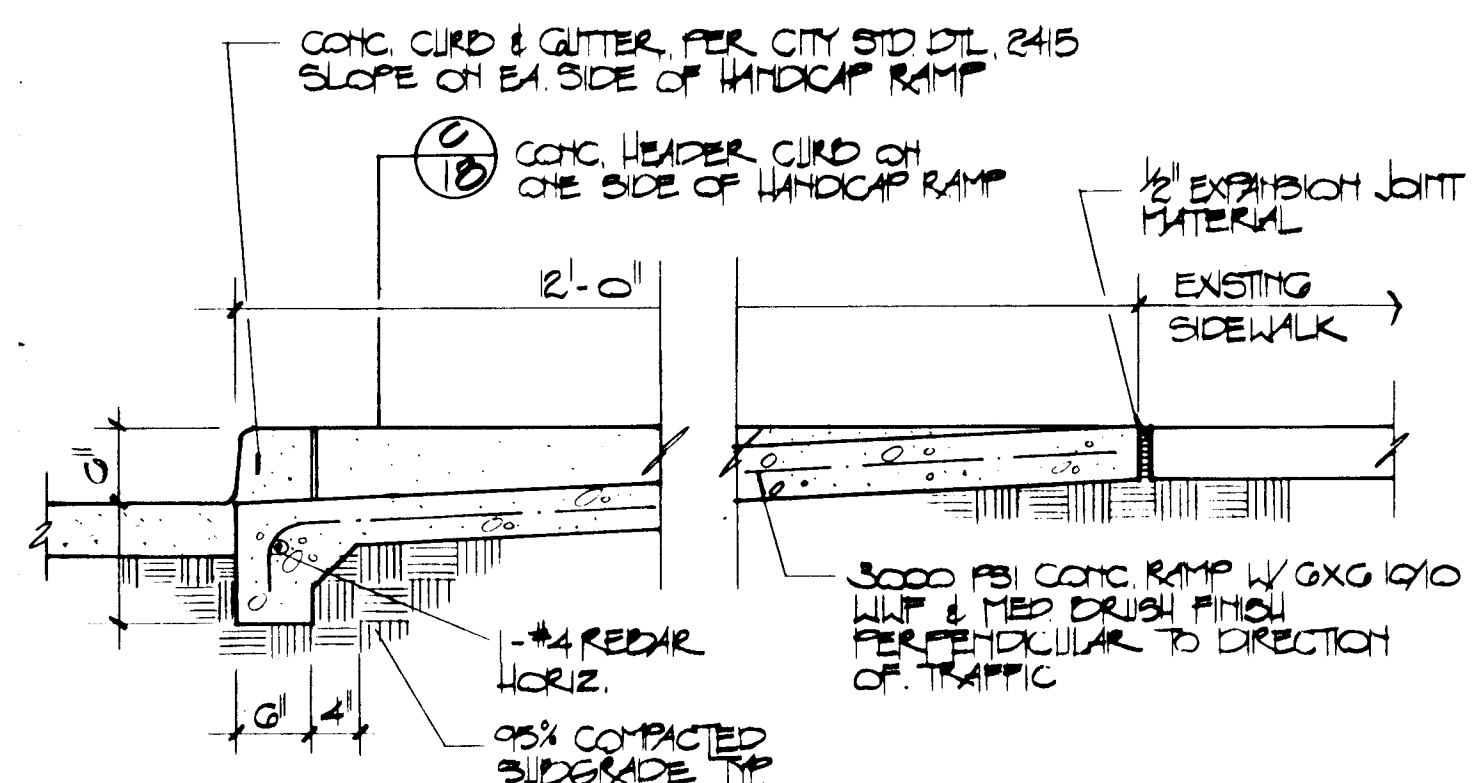


(E) HANDICAP RAMP SECTION 3/4"=1'-0"

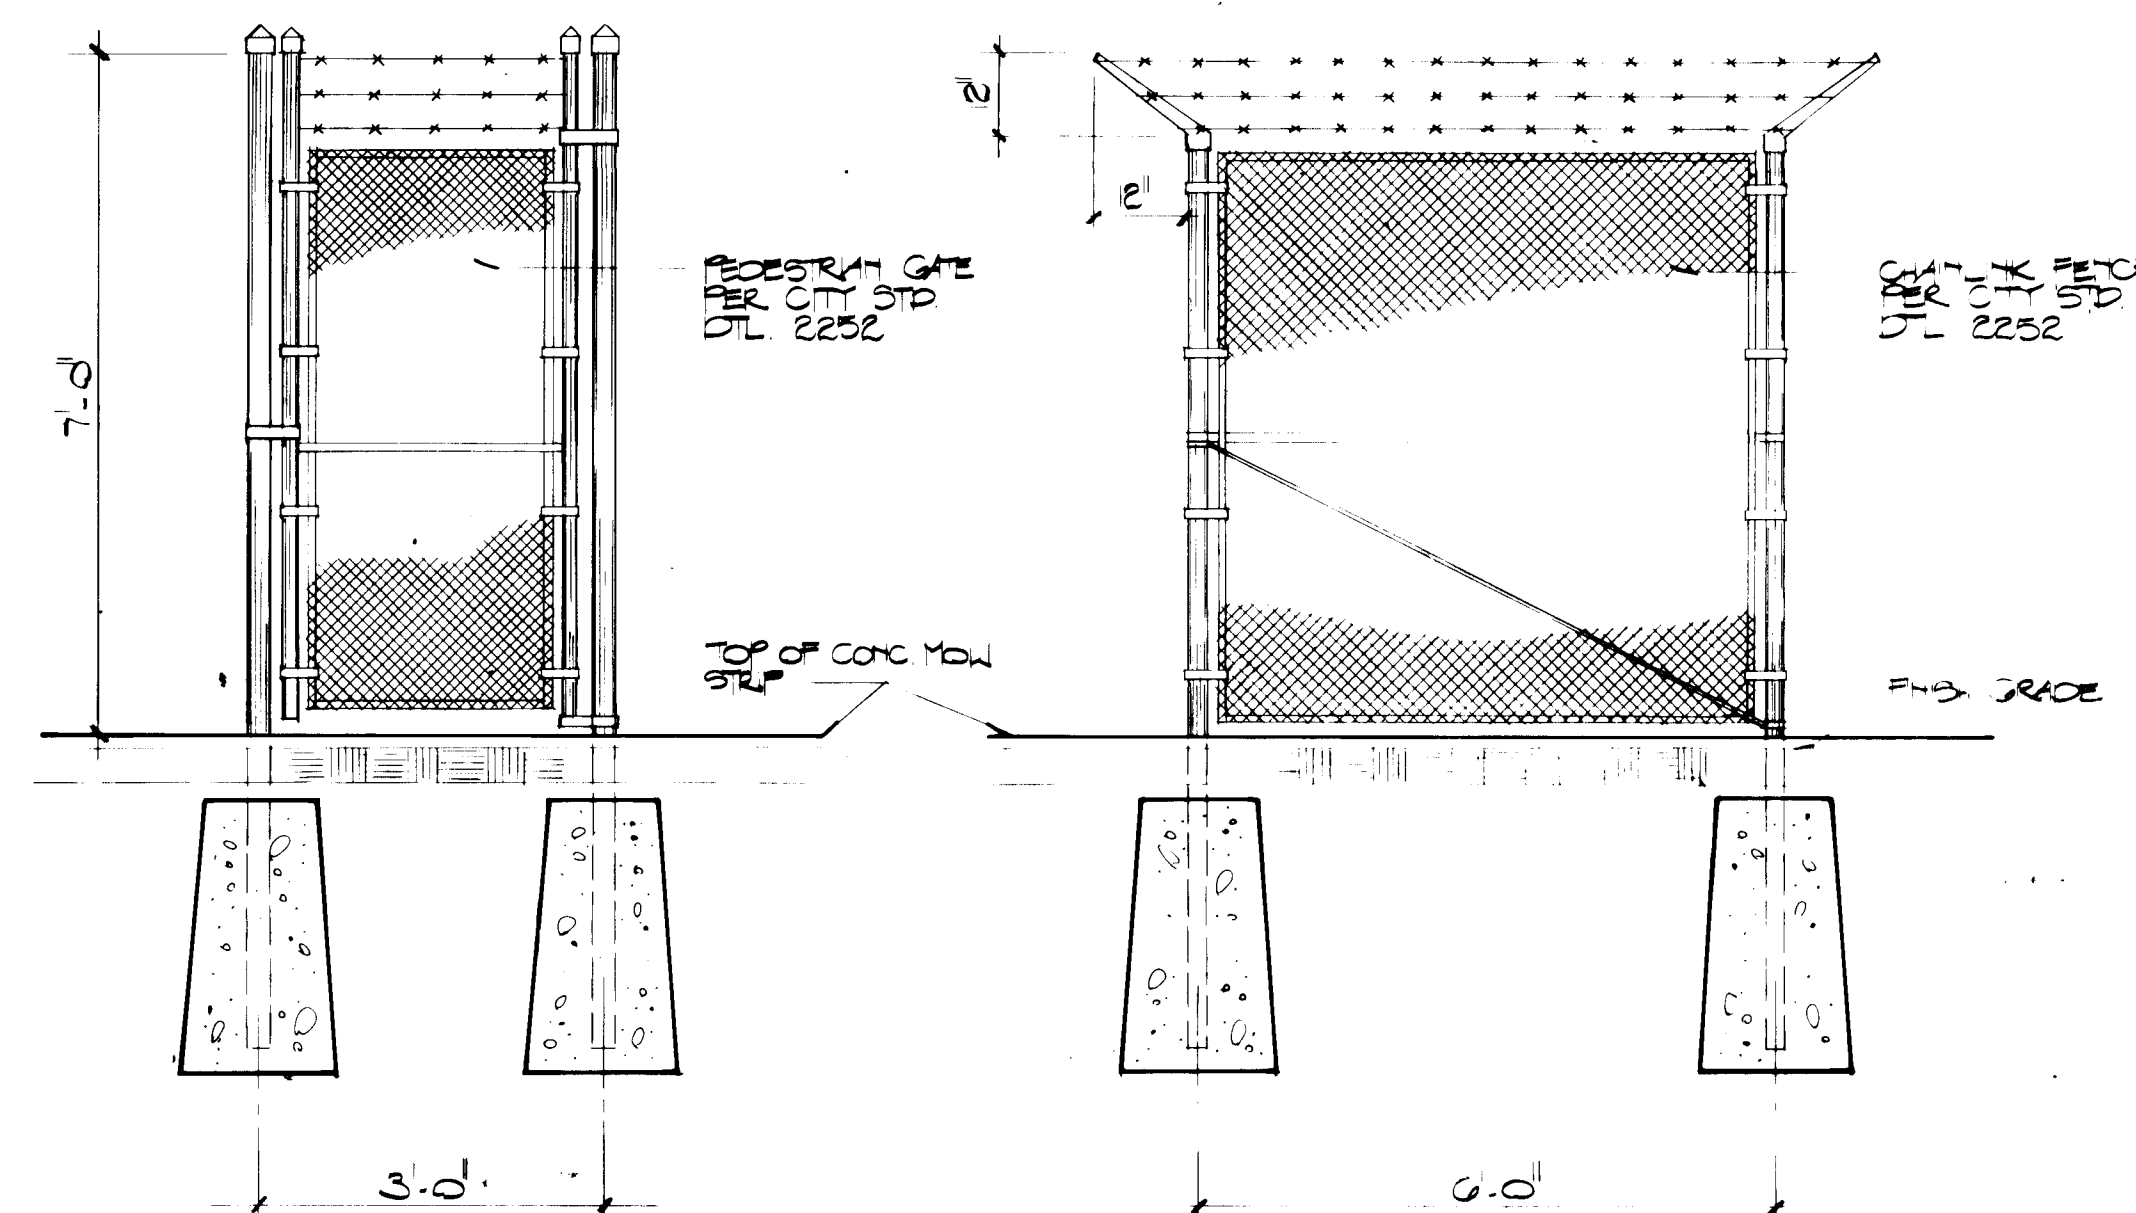


(F) CHAINLINK FENCE & GATE WITH BARBED WIRE

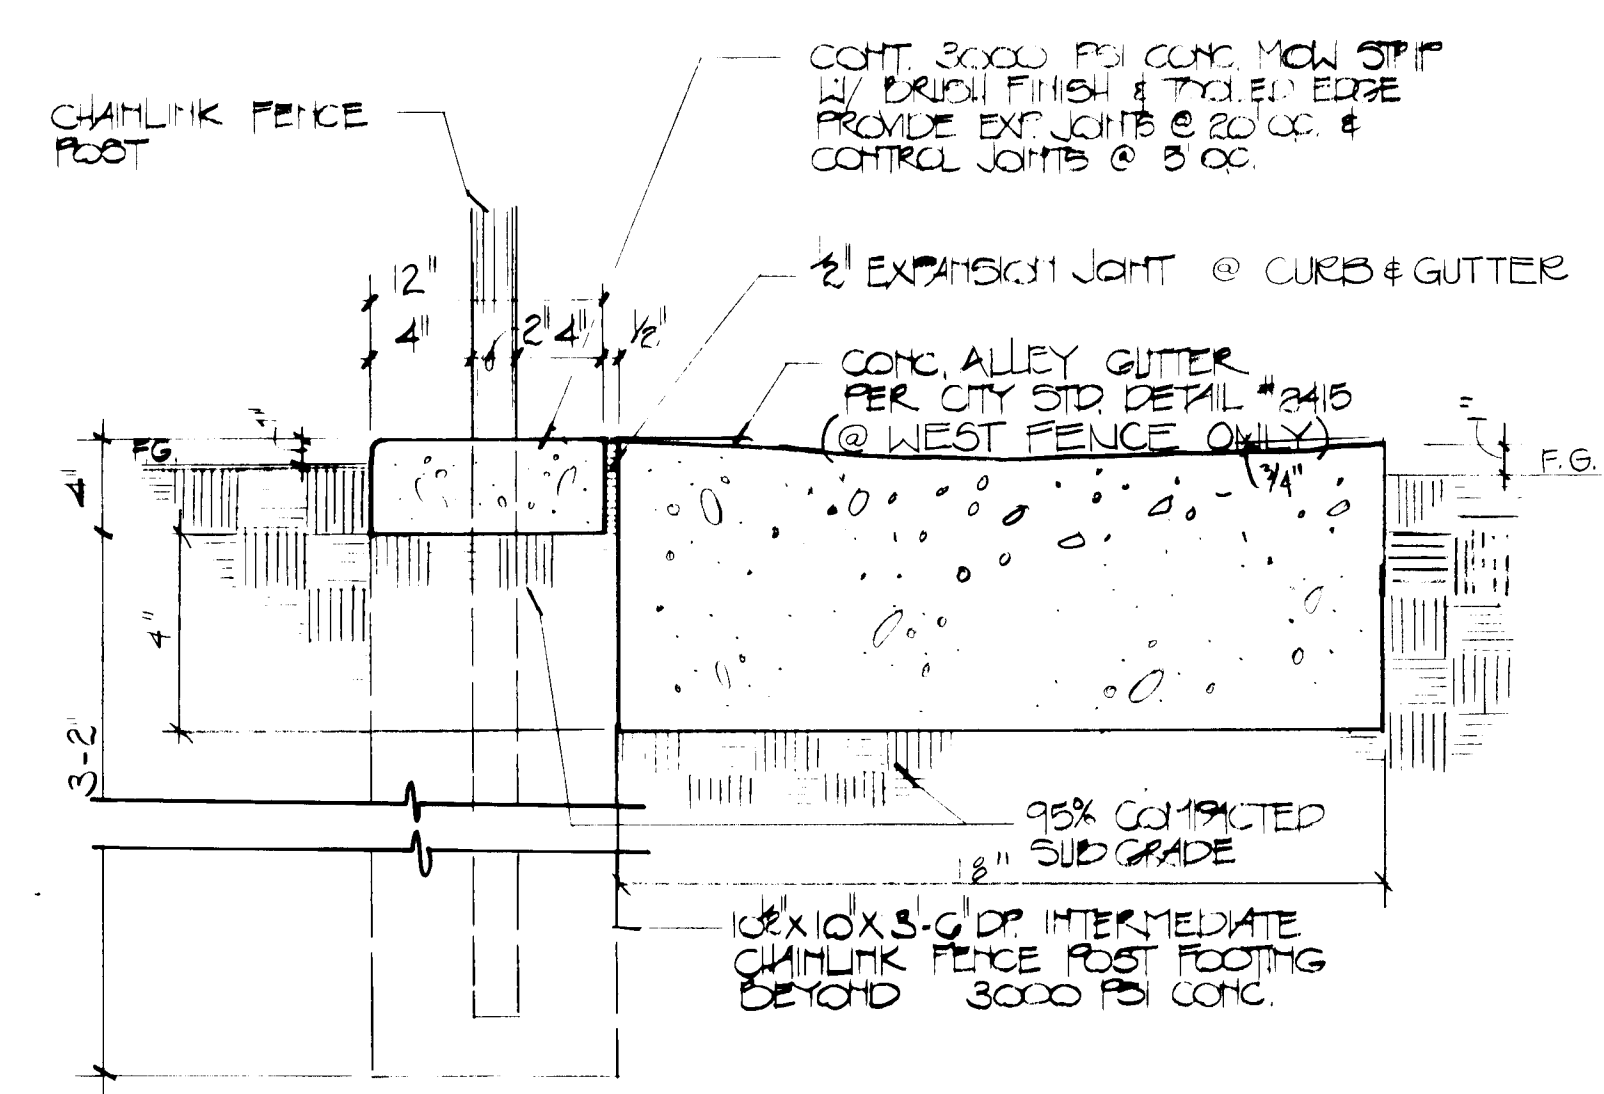


(HA) CONCRETE APRON / FENCE POST FTG. N.T.S.

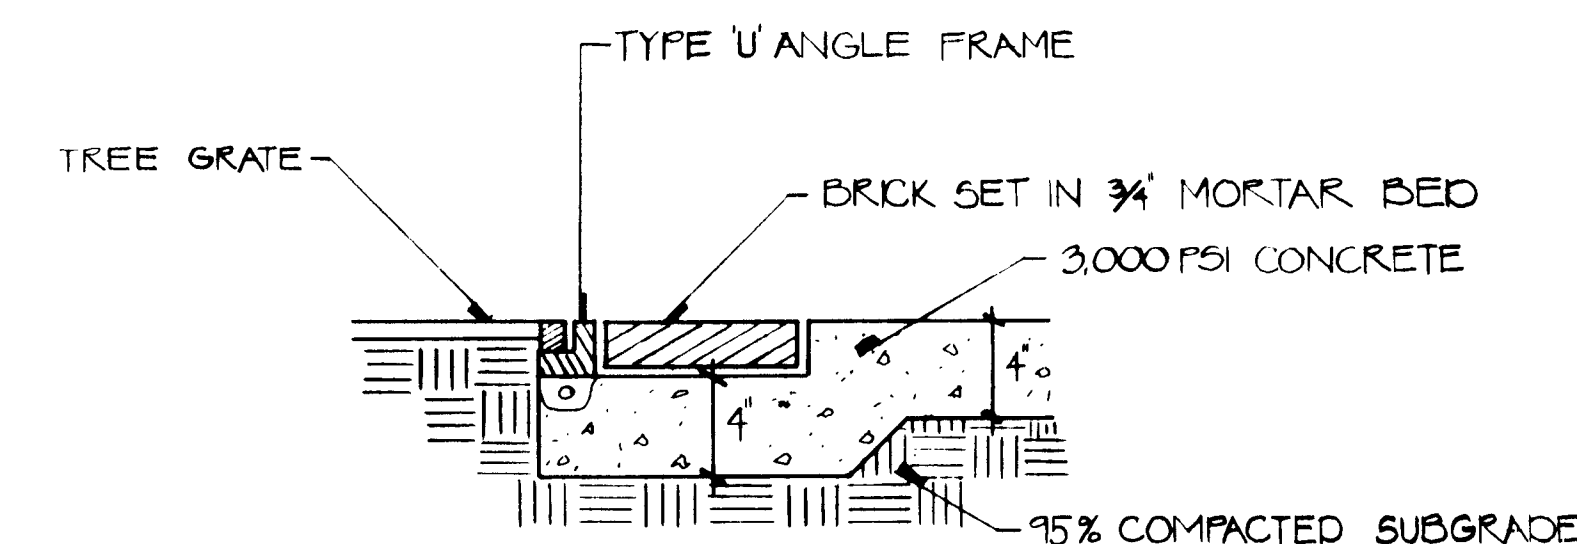


(F) TREE GRATE MOUNTING AT MASONRY 1/2"=1'-0"

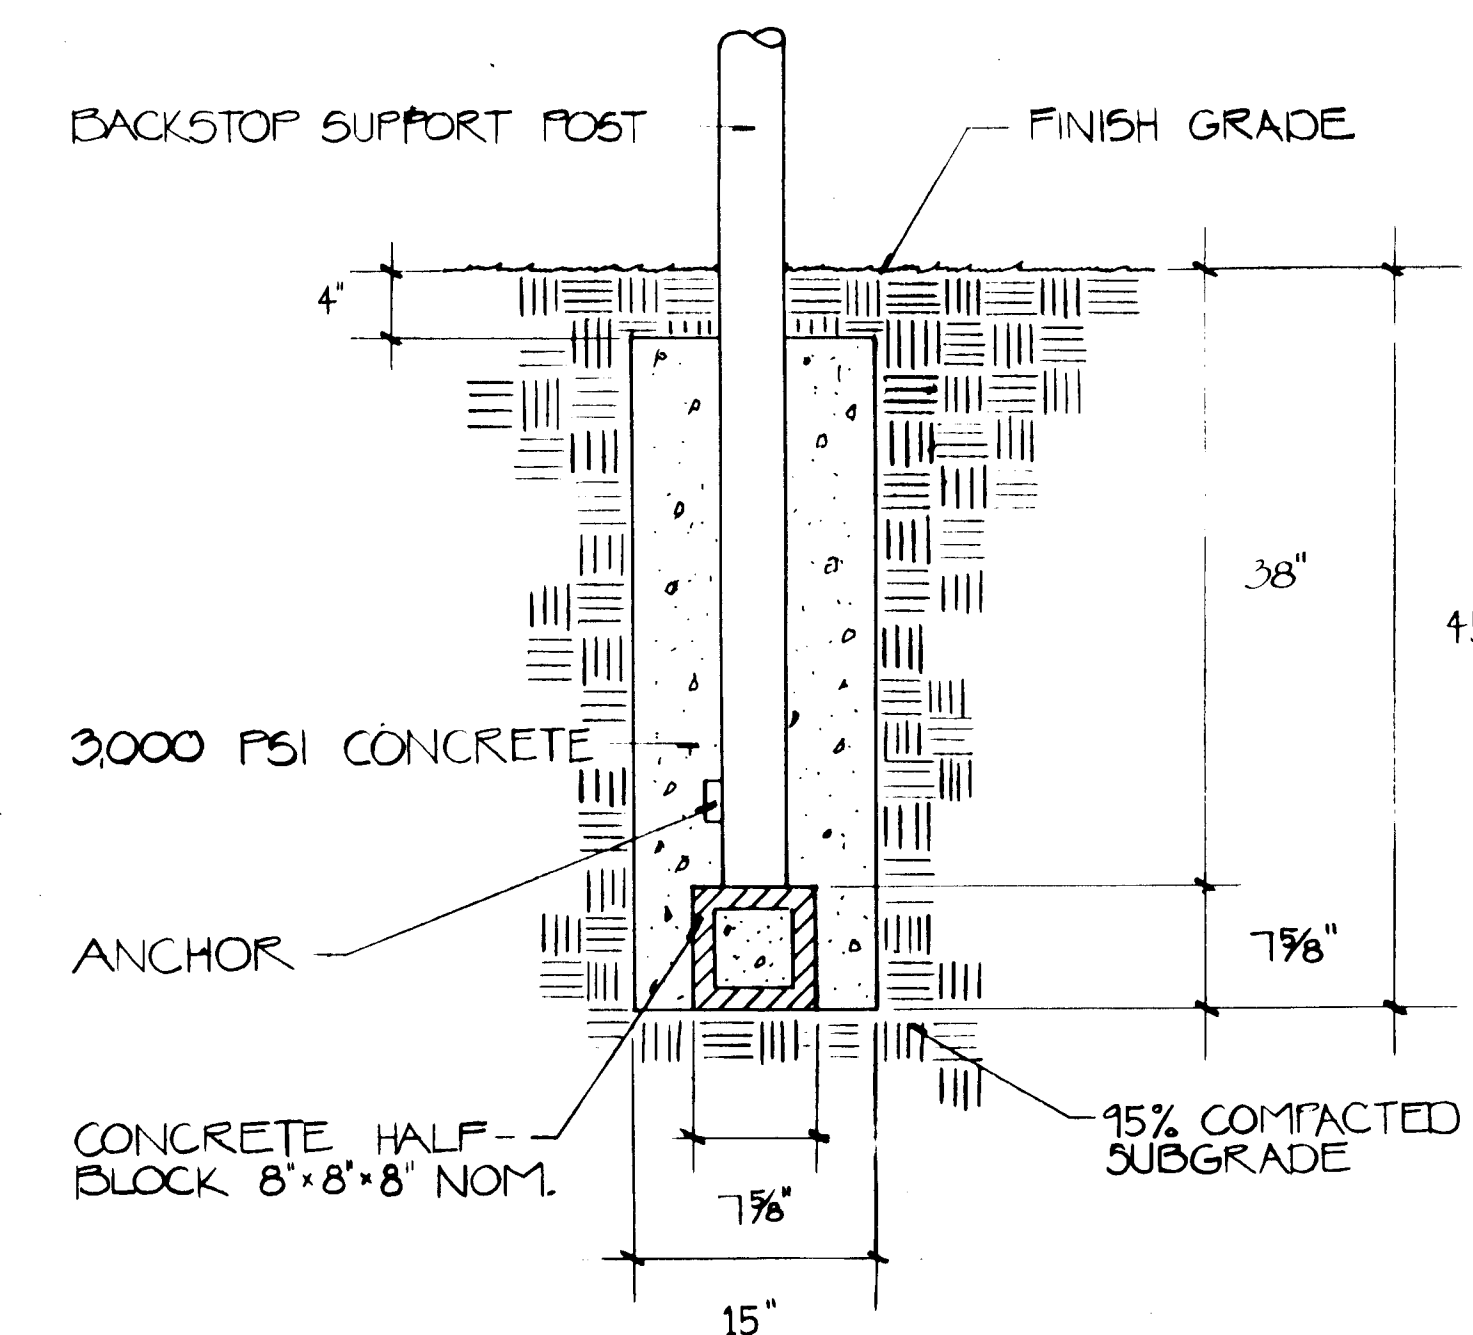

(J) BACKSTOP FOOTING DETAIL 1"=1'-0"

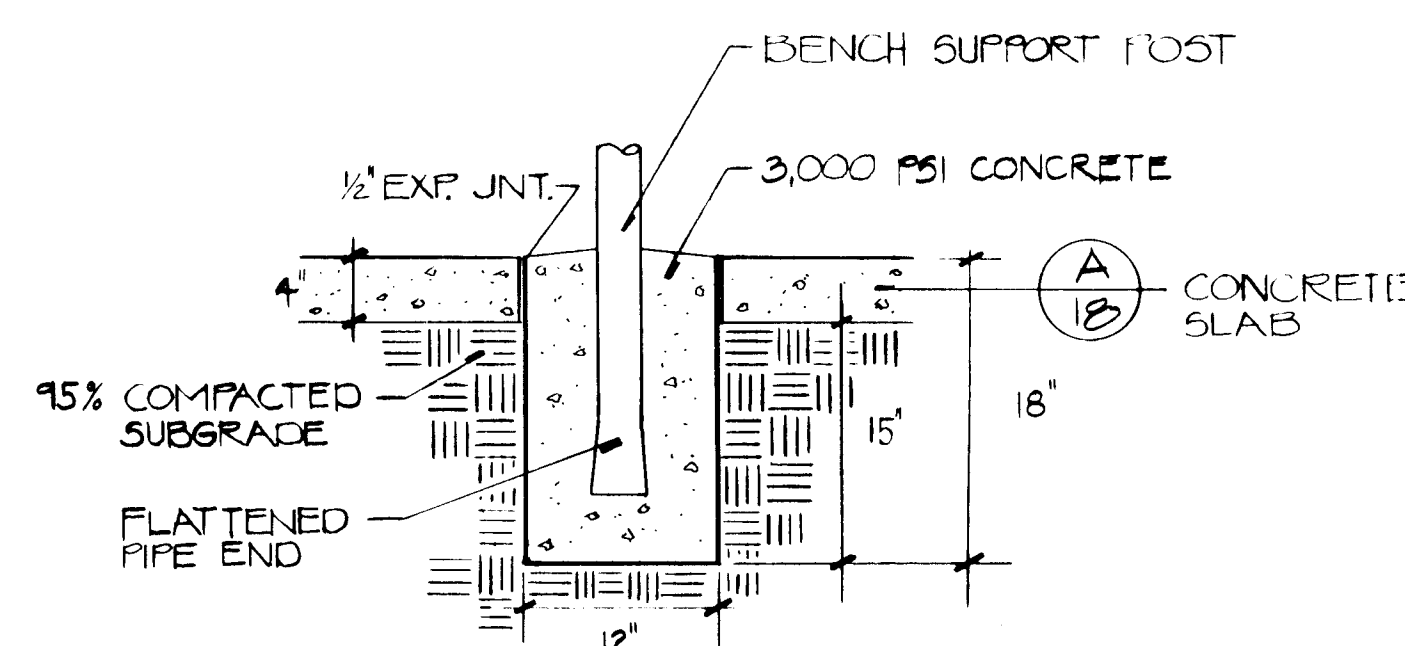


(K) PLAYER BENCH FOOTING DETAIL 1"=1'-0"

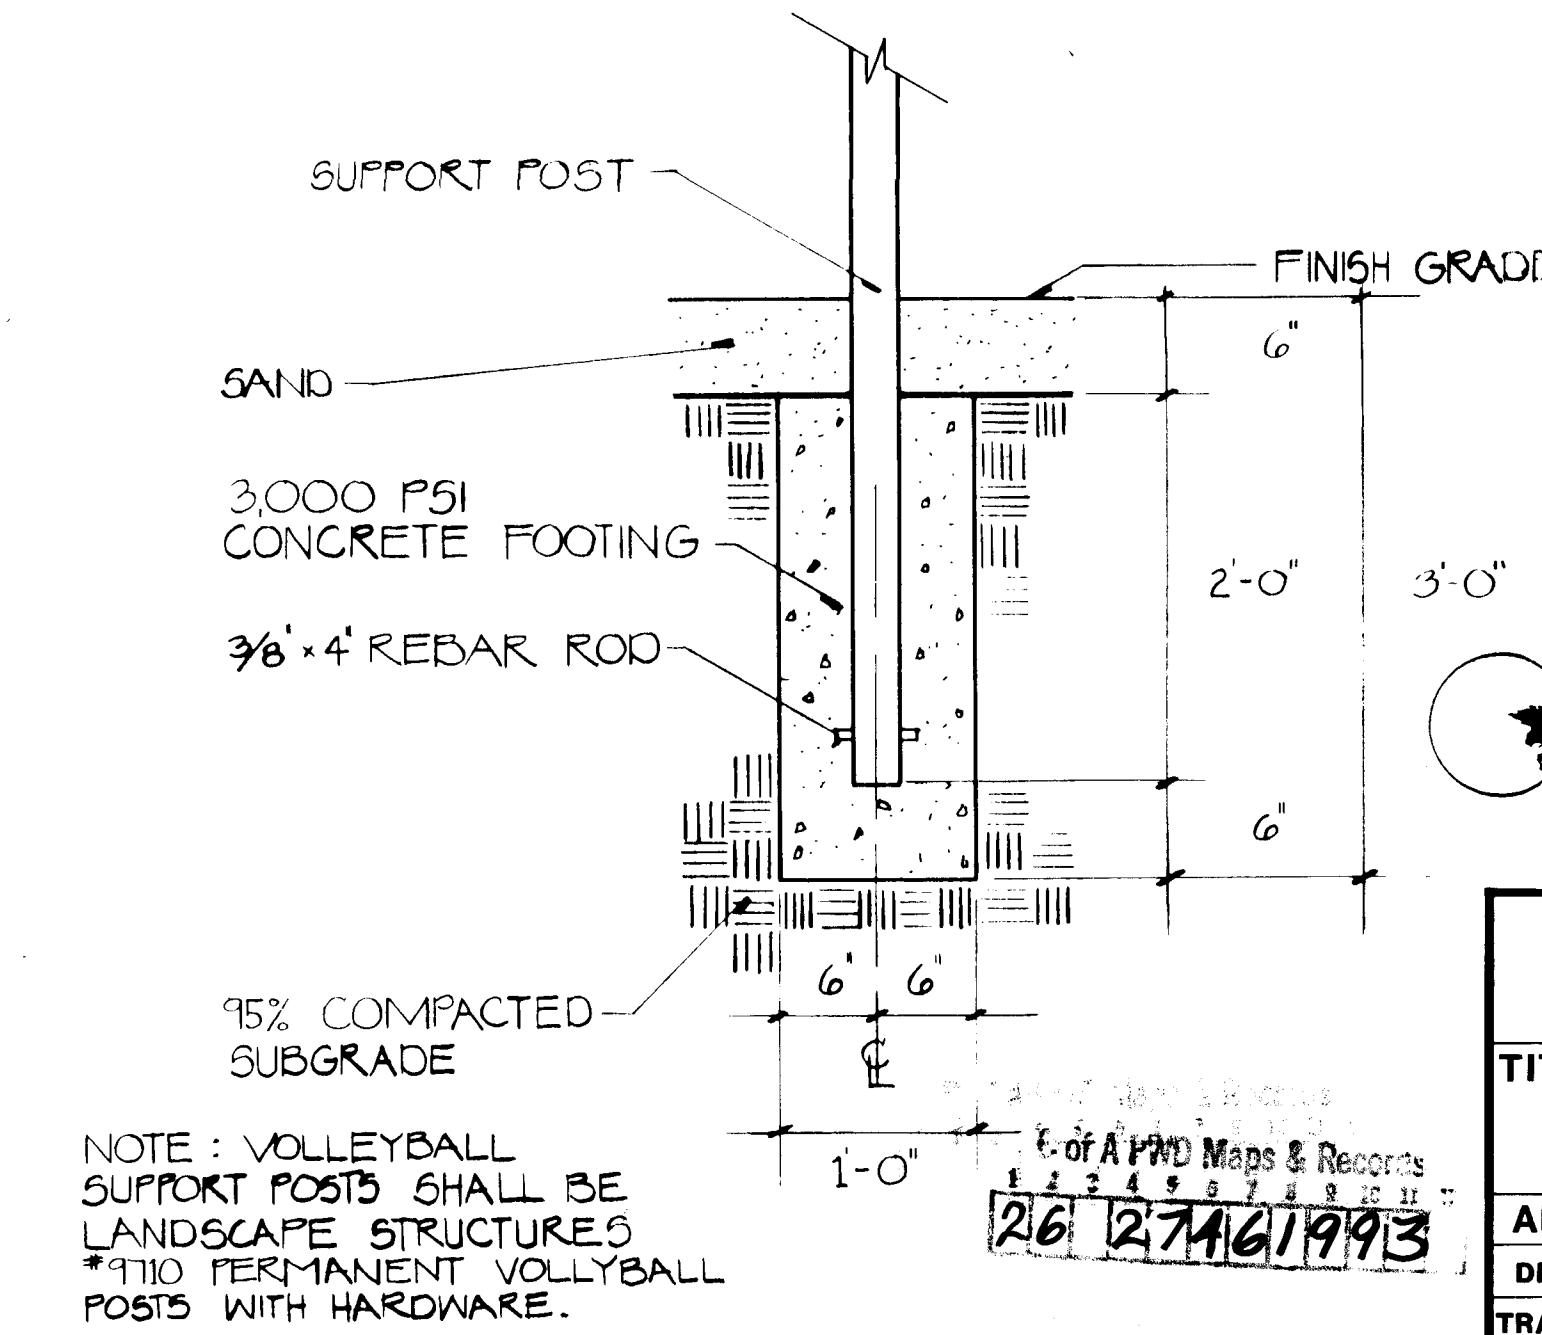




(L) CONC. FOOTING FOR VOLLEYBALL SUPPORT POST 1"=1'-0"

AS BUILT INFORMATION			BENCH MARK			SURVEY INFORMATION			ENGINEER'S SEAL			REVISIONS / REMARKS			BY			DATE			DESIGNED BY:			DRAWN BY:			CHECKED BY:			DATE		
CONTRACTOR	ACCENT	LANDSCAPE	NO.	BY	DATE	NO.	BY	DATE	NO.	BY	DATE	NO.	BY	DATE	NO.	BY	DATE	NO.	BY	DATE	NO.	BY	DATE	NO.	BY	DATE	NO.	BY	DATE	NO.	BY	DATE
WORK STAKED BY	DATE:		INSPECTORS APPROVAL	DATE:		FIELD VERIFICATION BY	DATE:		DRAWING CORRECTED BY	DATE:		RECORDED BY	DATE:		NO.	BY	DATE	NO.	BY	DATE	NO.	BY	DATE	NO.	BY	DATE	NO.	BY	DATE	NO.	BY	DATE

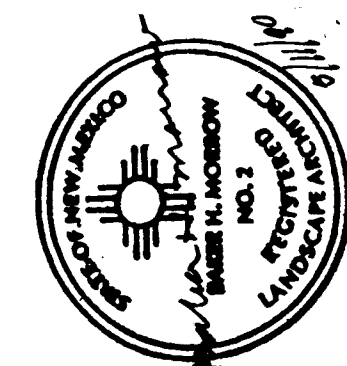

MORROW & COMPANY
LANDSCAPE ARCHITECTS
210 La Veta Drive NE
Albuquerque, New Mexico 87108
505 268-2266

CITY OF ALBUQUERQUE PARKS & RECREATION DESIGN & DEVELOPMENT					
TITLE: PHIL CHACON PARK PHASES I & II CONSTRUCTION DETAILS					
APPROVALS	ENGINEER	DATE	APPROVALS	ENGINEER	DATE
DRC CHAIRMAN			WATER	R.W. Kane	9-17-90
TRANSPORTATION	K. Kane	6-17-91	WASTE WATER	R.W. Kane	9-17-90
HYDROLOGY	N/H	9/7/90			
Parks	D. Kane	9-15-90			
PROJECT NO. 2746		MAP NO. L-19		SHEET 19 OF 29	

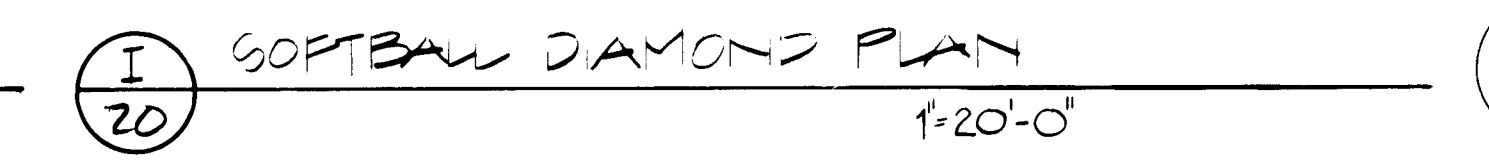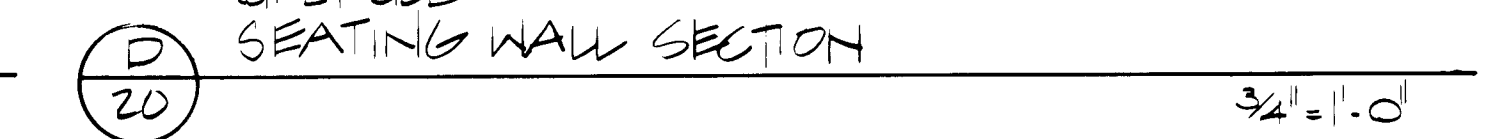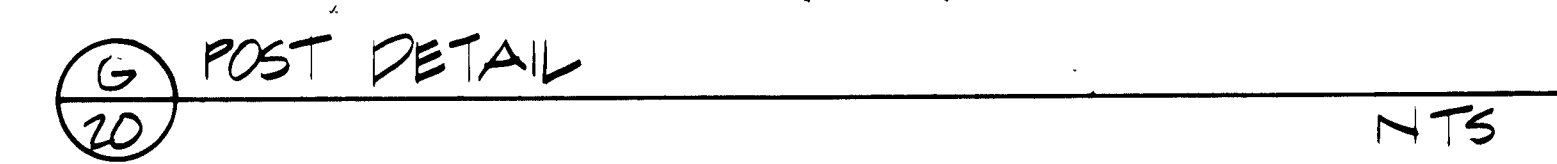

NO.		DATE	REVISIONS / REMARKS	BY	ENGINEER'S SEAL	SURVEY INFORMATION		BENCH MARK	AS BUILT INFORMATION	
						FIELD NOTES				
						NO.	BY	DATE		
									CONTRACTOR <u>ACCENT LANDSCAPE</u>	
									WORK STAKED BY _____ DATE: _____	
									INSPECTORS APPROVAL _____ DATE: _____	
									FIELD VERIFICATION BY _____ DATE: _____	
									DRAWING CORRECTED BY <u>JD</u> DATE: <u>2/13</u>	
									MICRO-FILM INFORMATION	
									RECORDED BY _____ DATE _____	
									NO. _____	



5/11/00

DESIGNED BY:	BHM	DATE:	5/90
DRAWN BY:	PHM/PLK	DATE:	5/90
CHECKED BY:	ECR	DATE:	5/90

APPROVE

DATE

PROJECT

NO.

SEALS I & II










3.

VALS	ENGINEER	DATE
TER	<u>R.W. Kane</u>	<u>9-17-90</u>
WATER	<u>R.W. Kane</u>	<u>9-17-90</u>

19

SHEET 20 OF 29

[illegible]

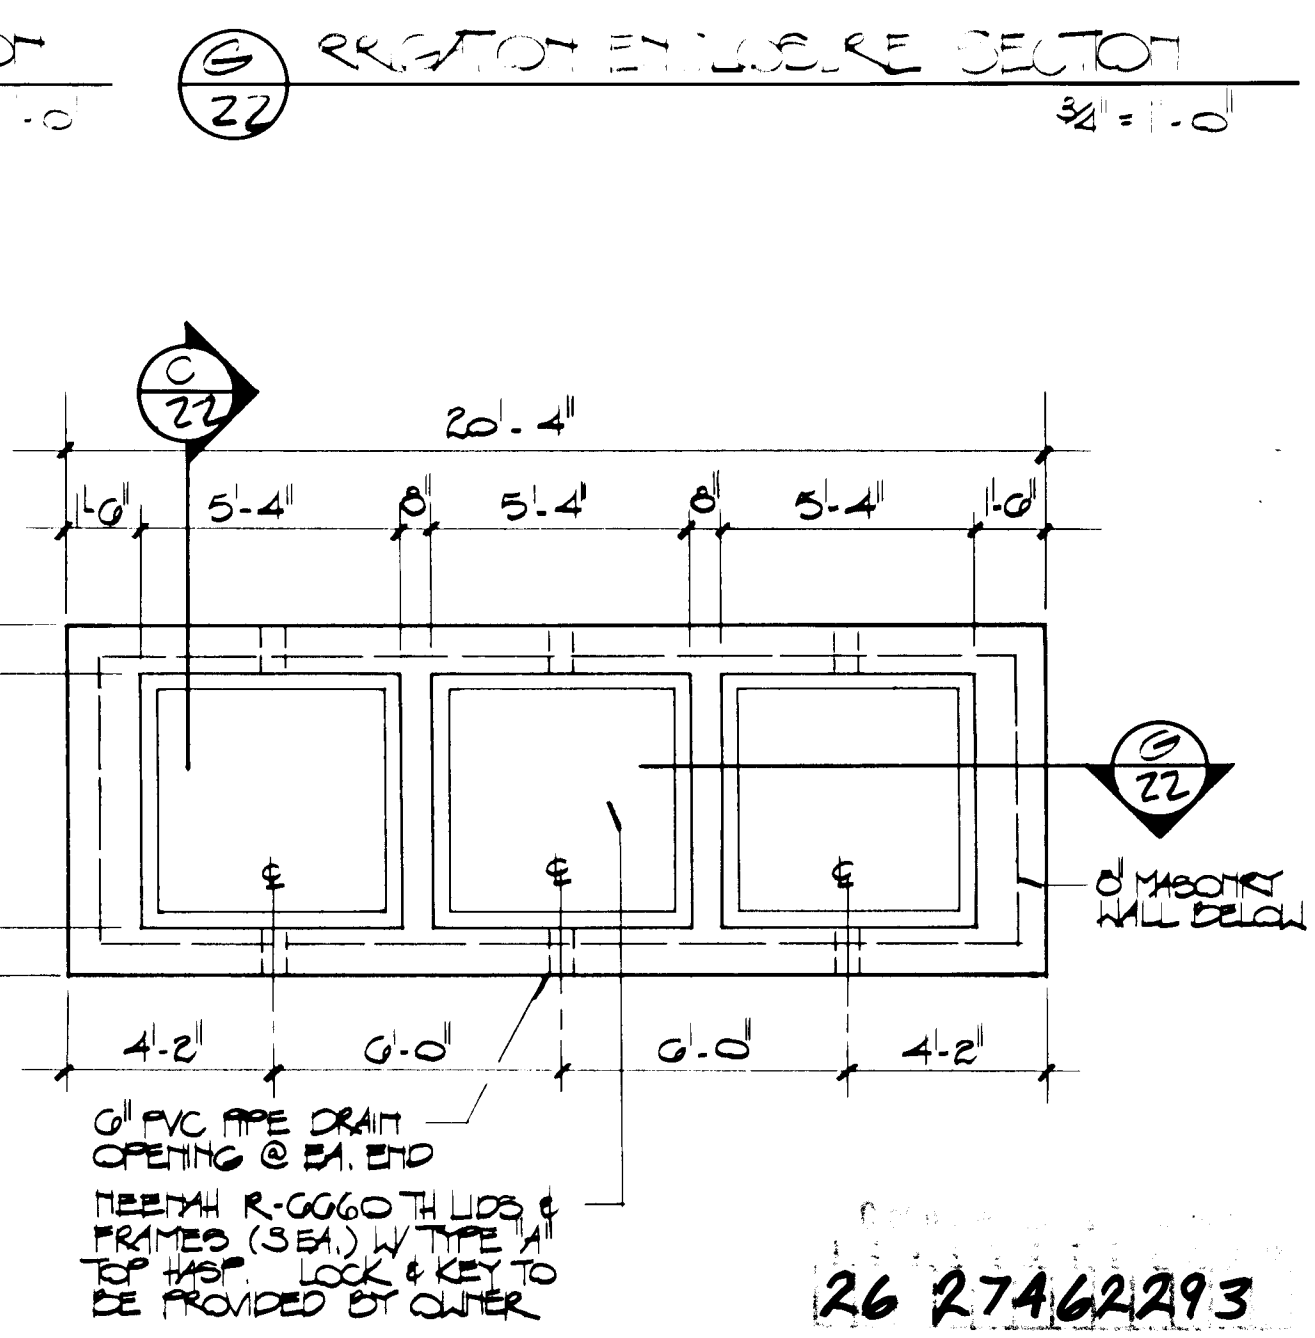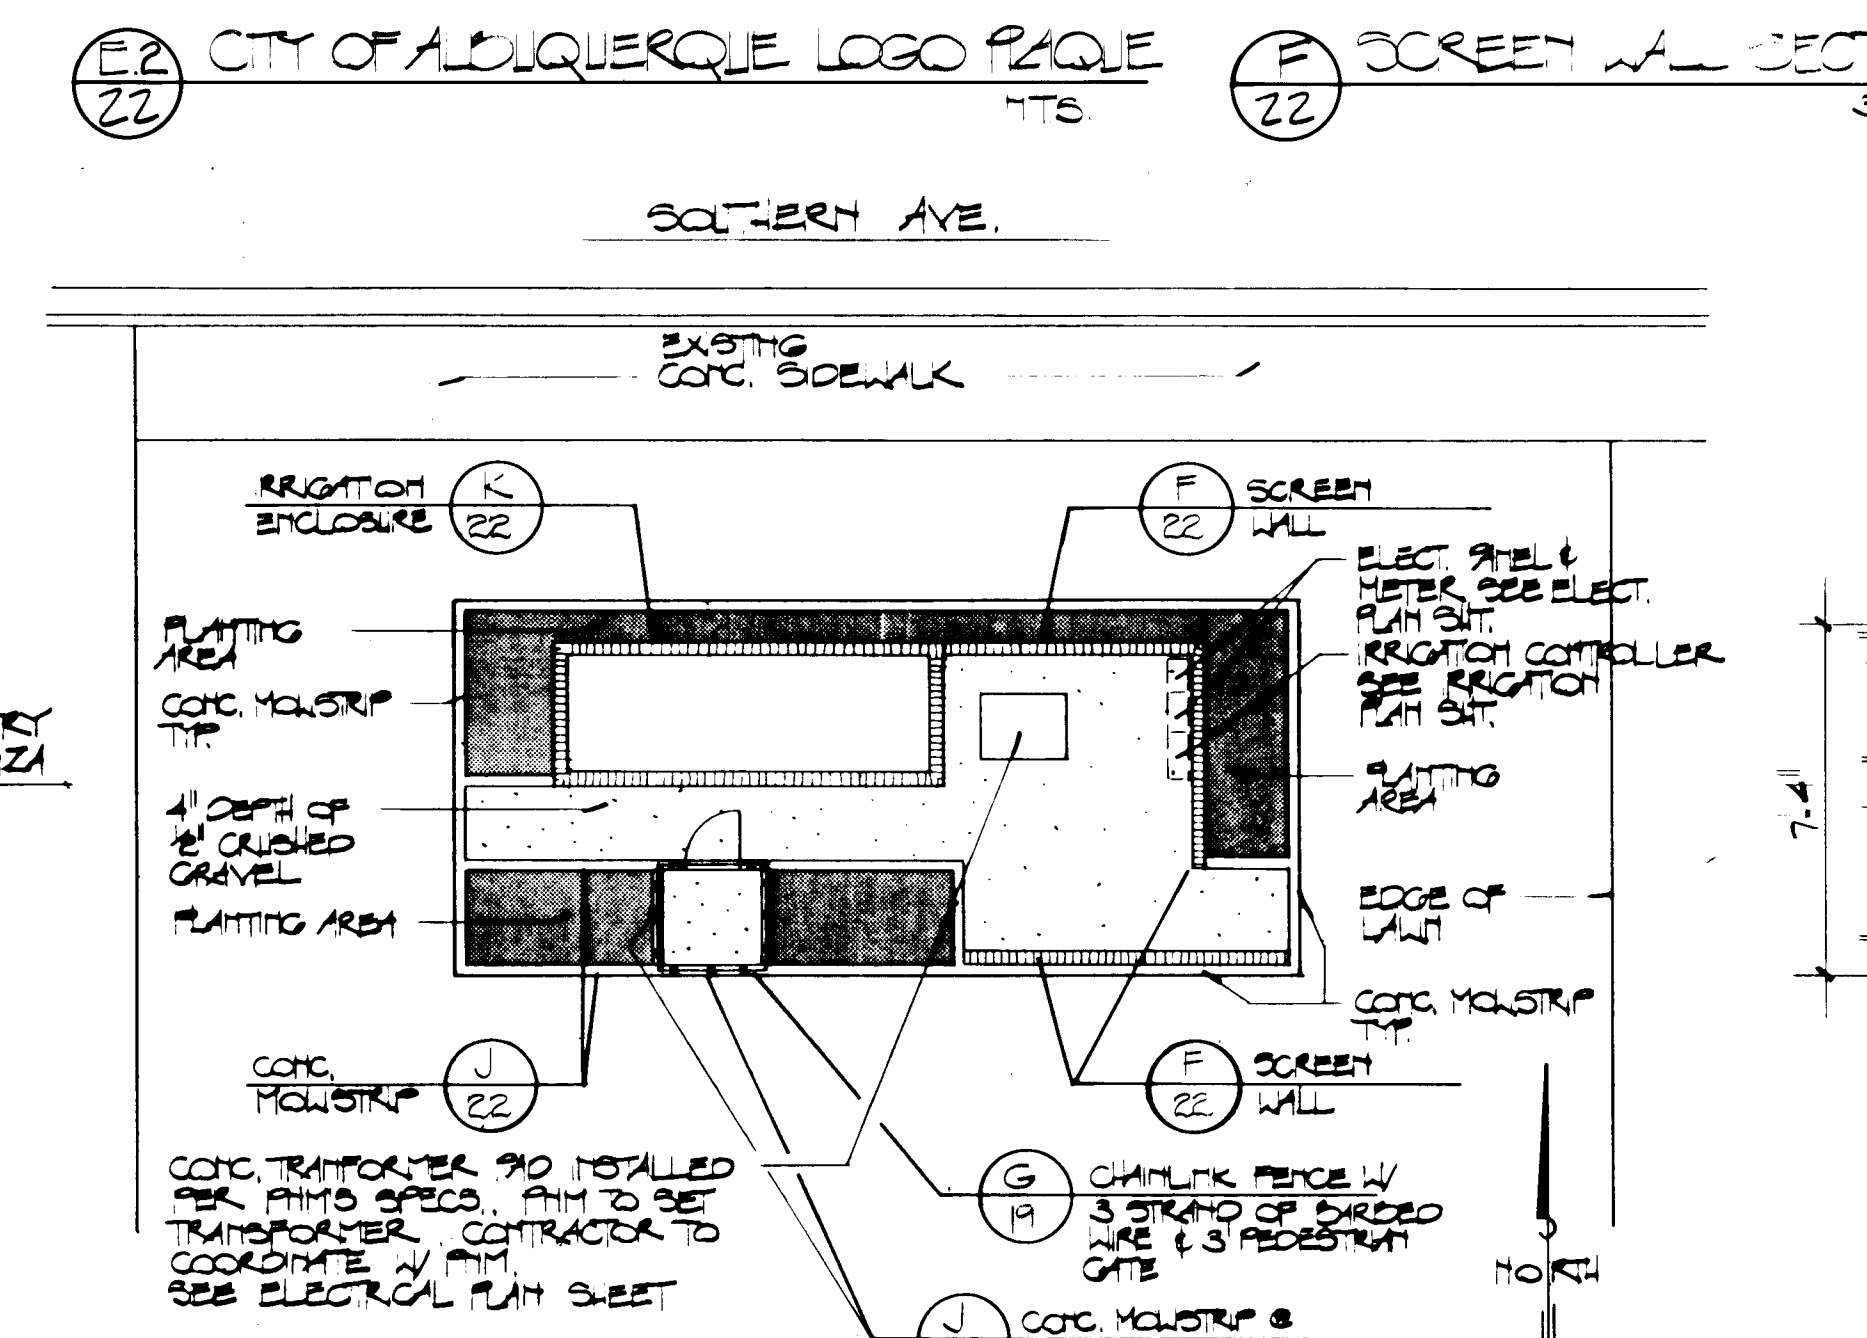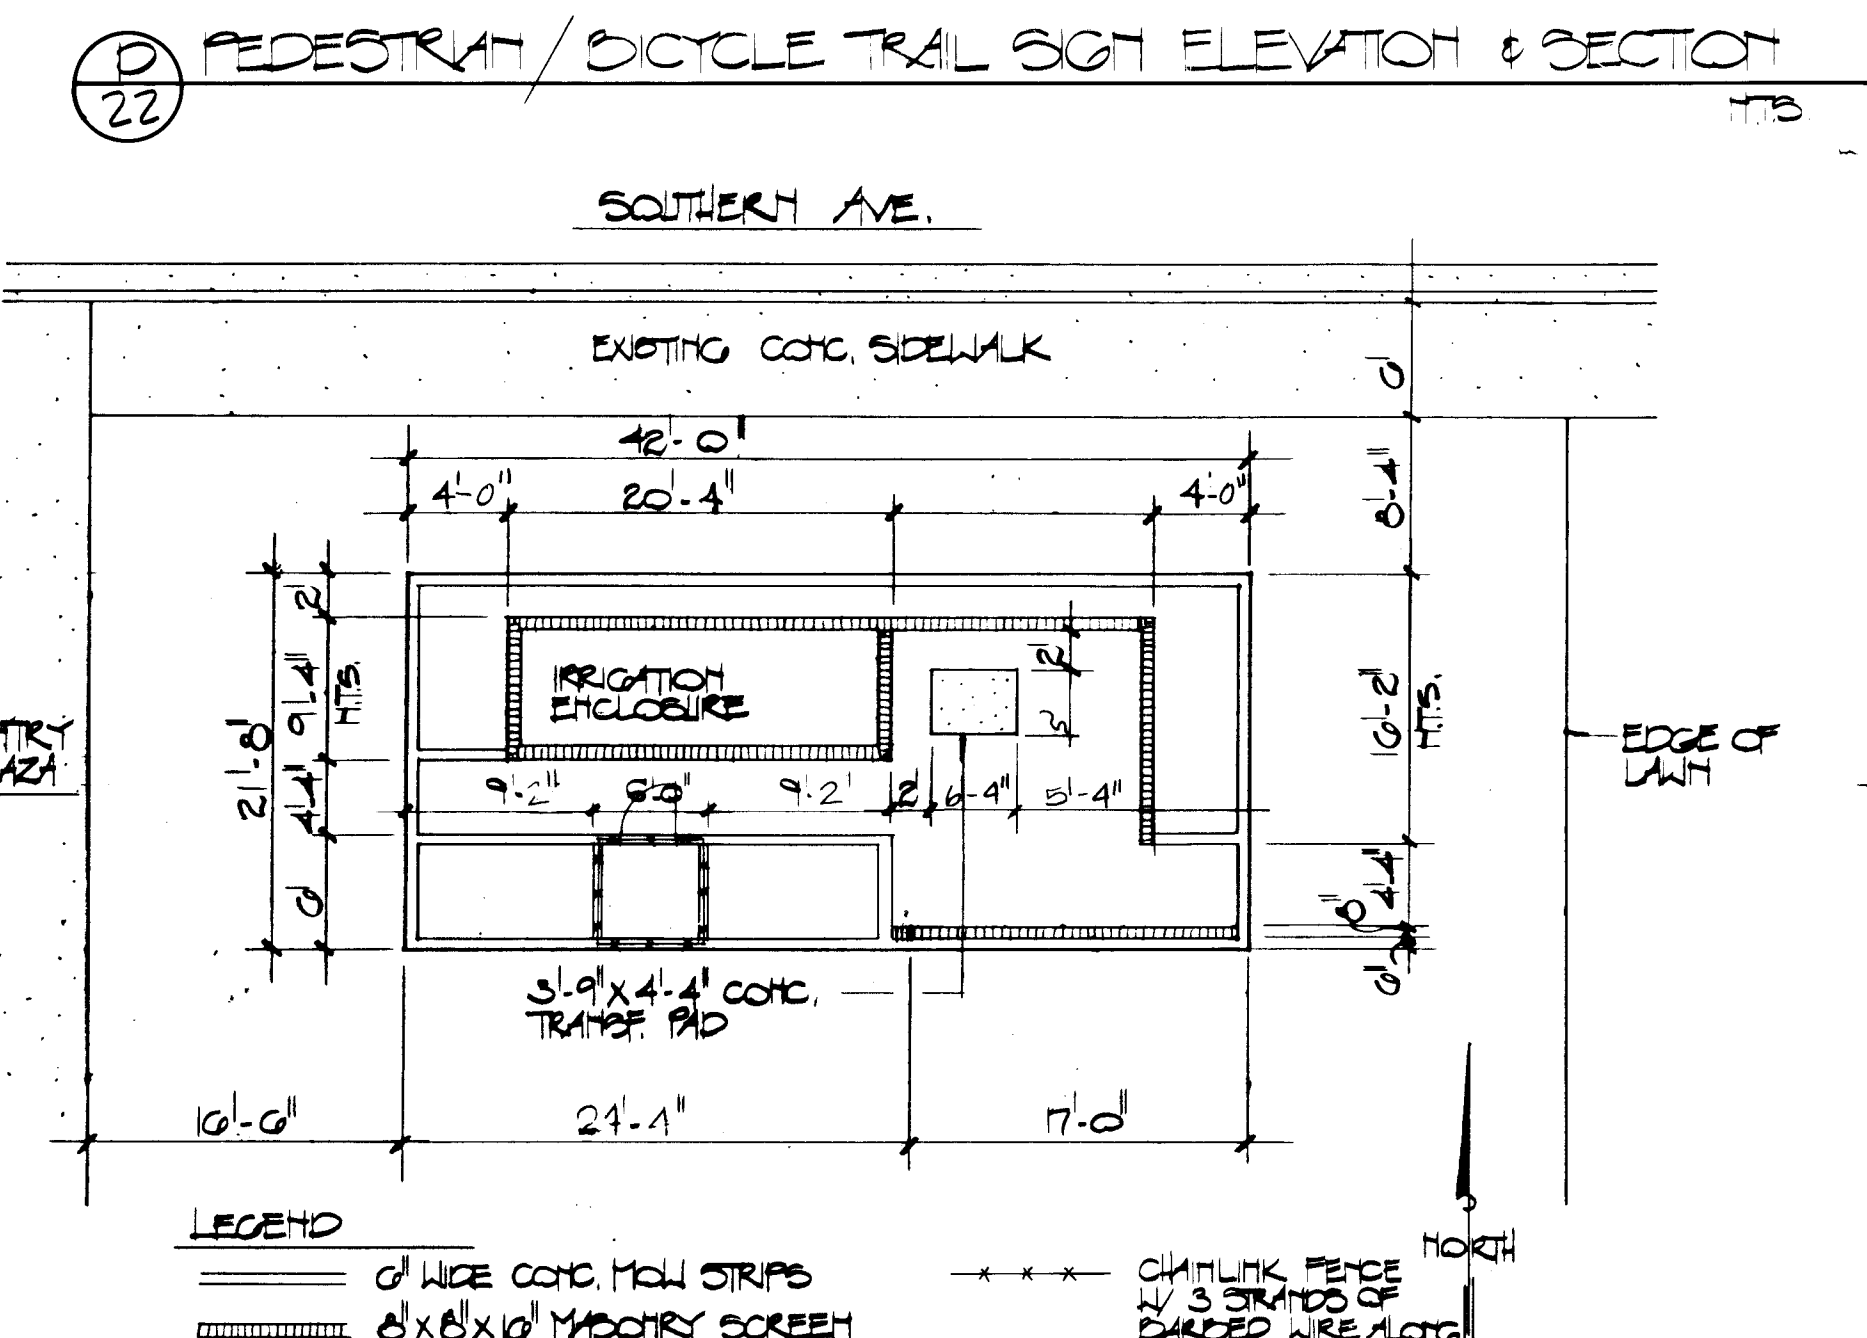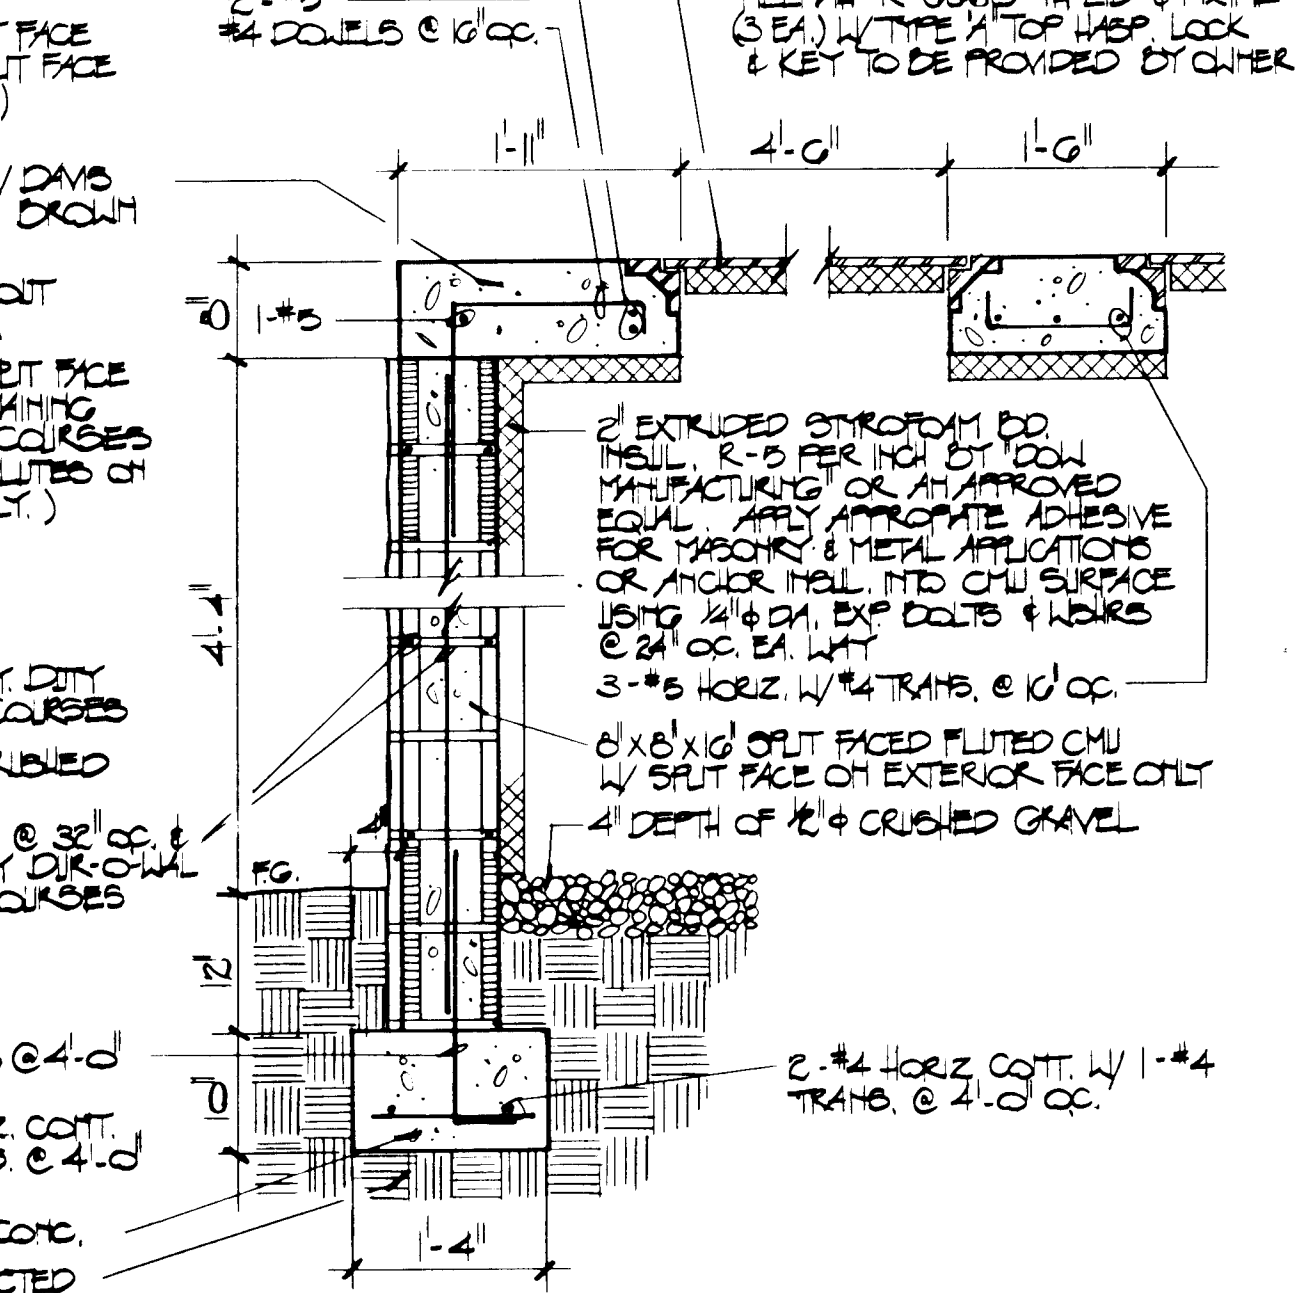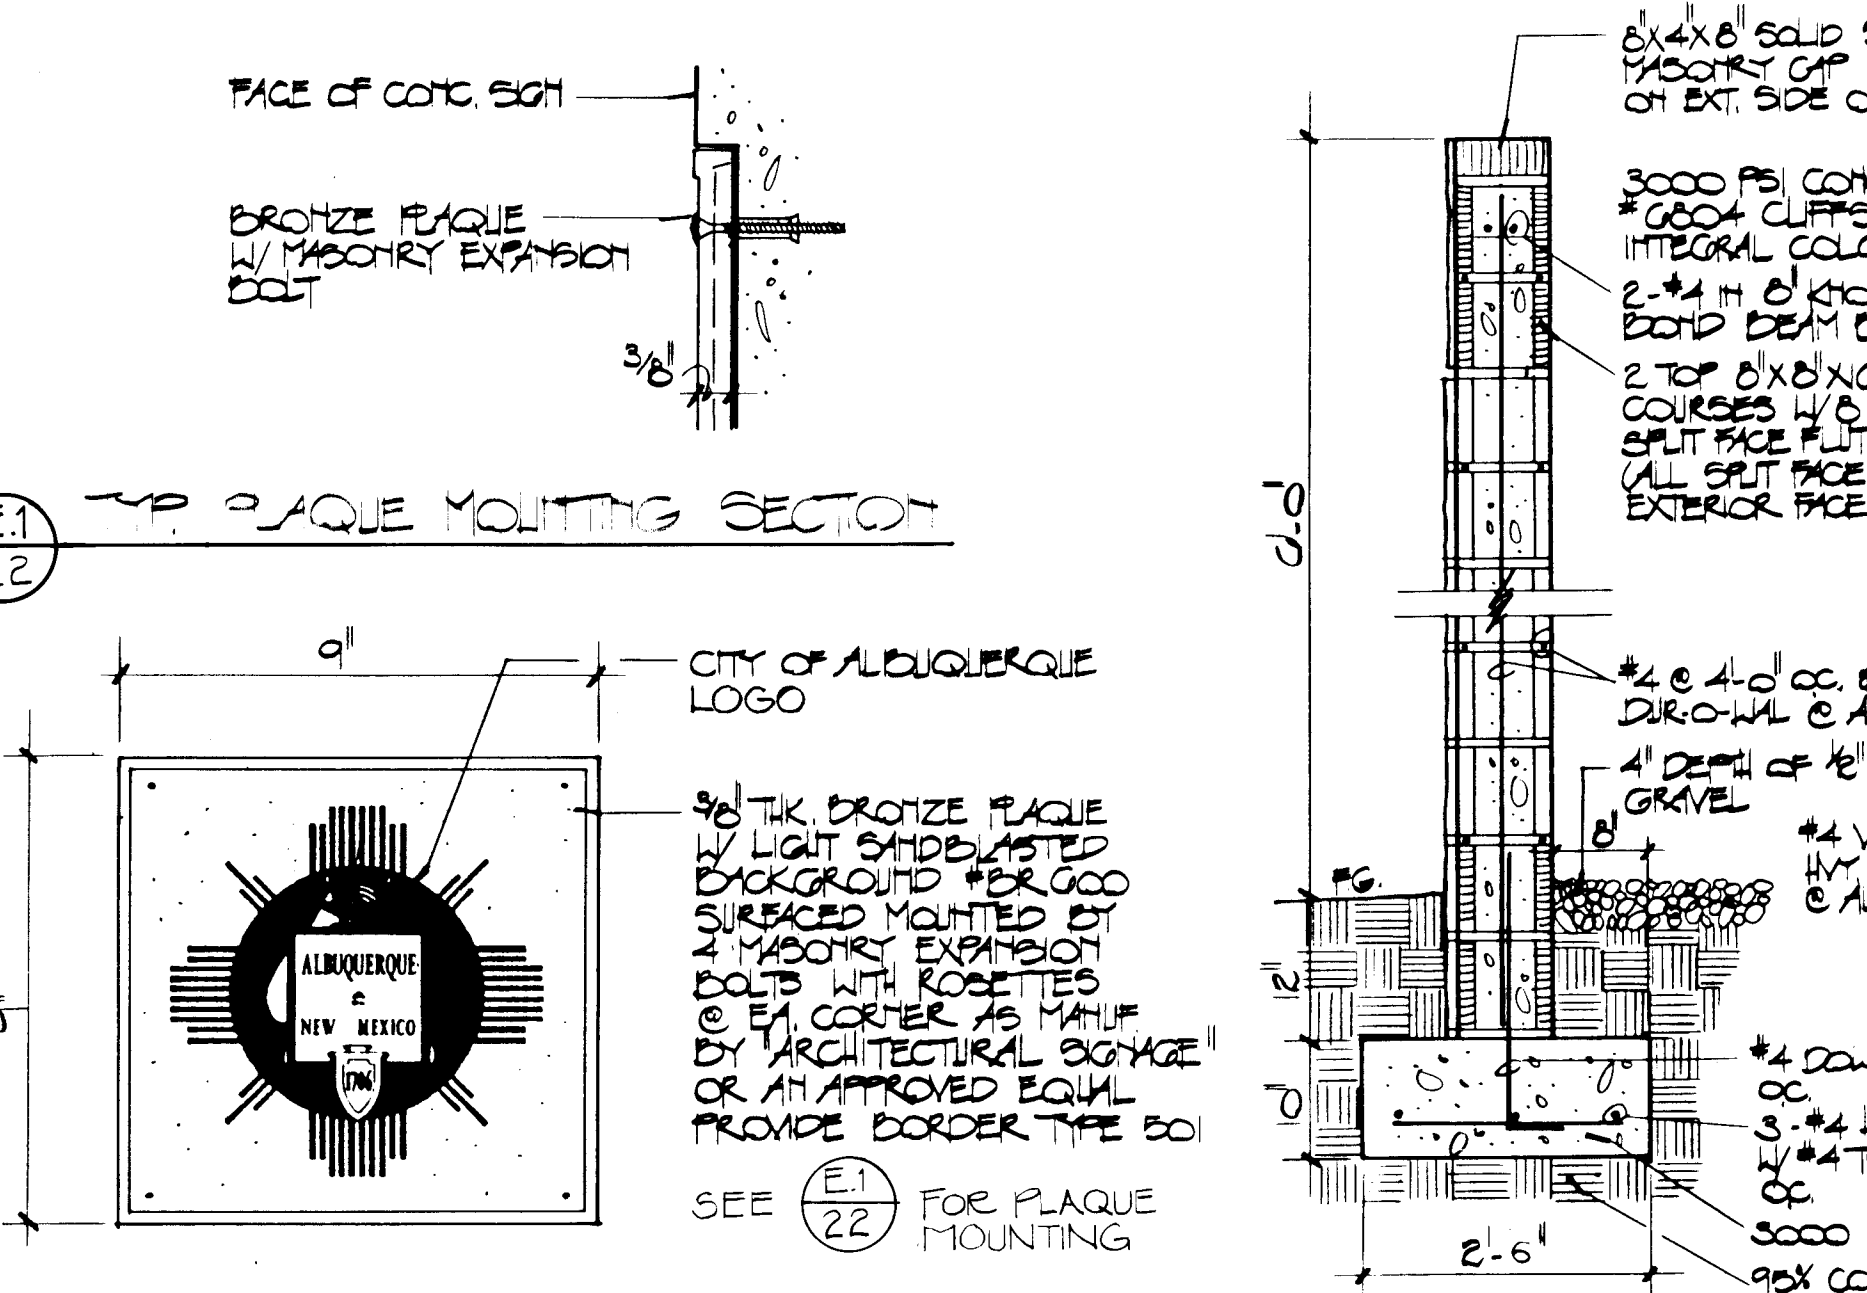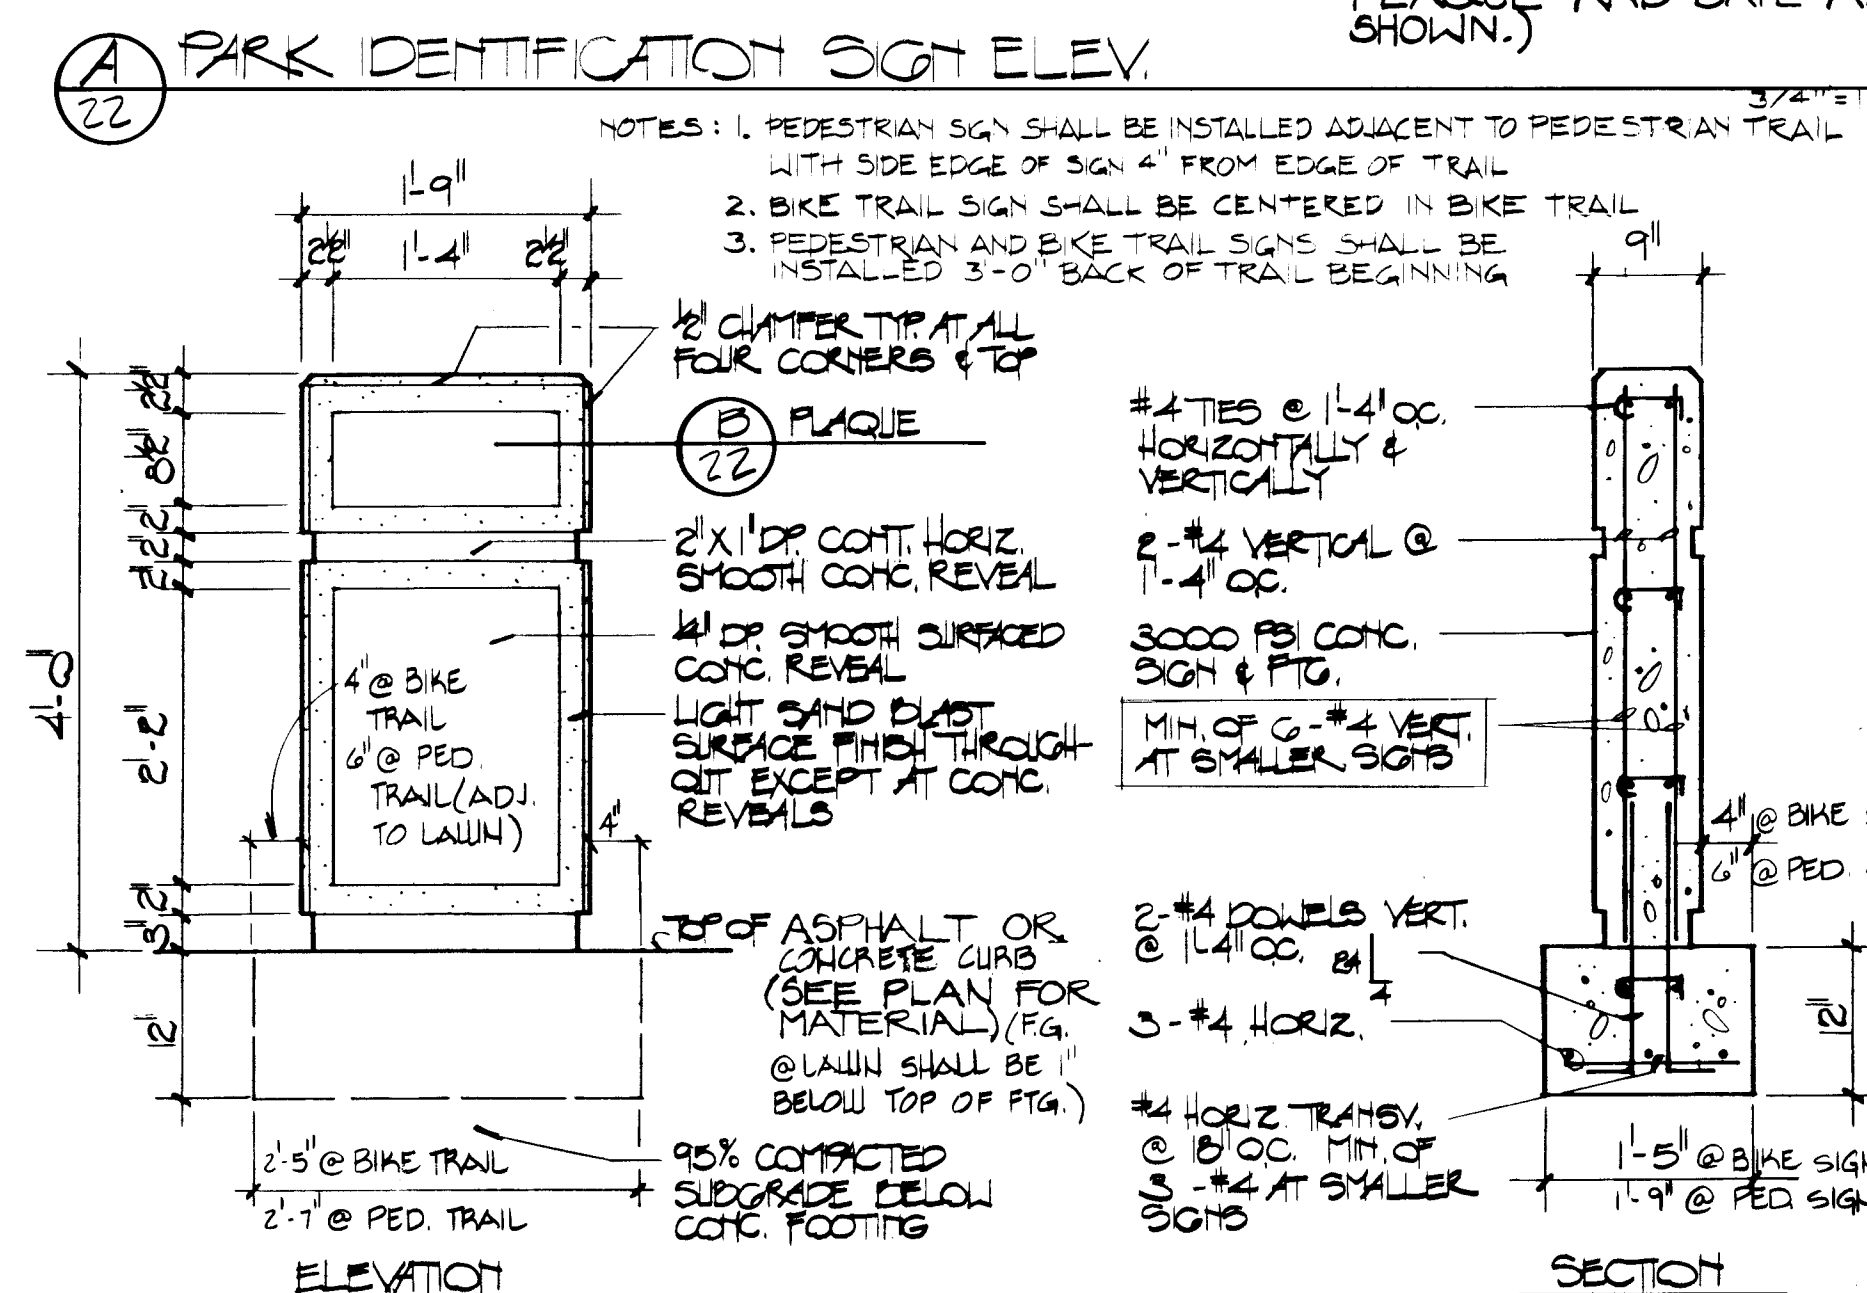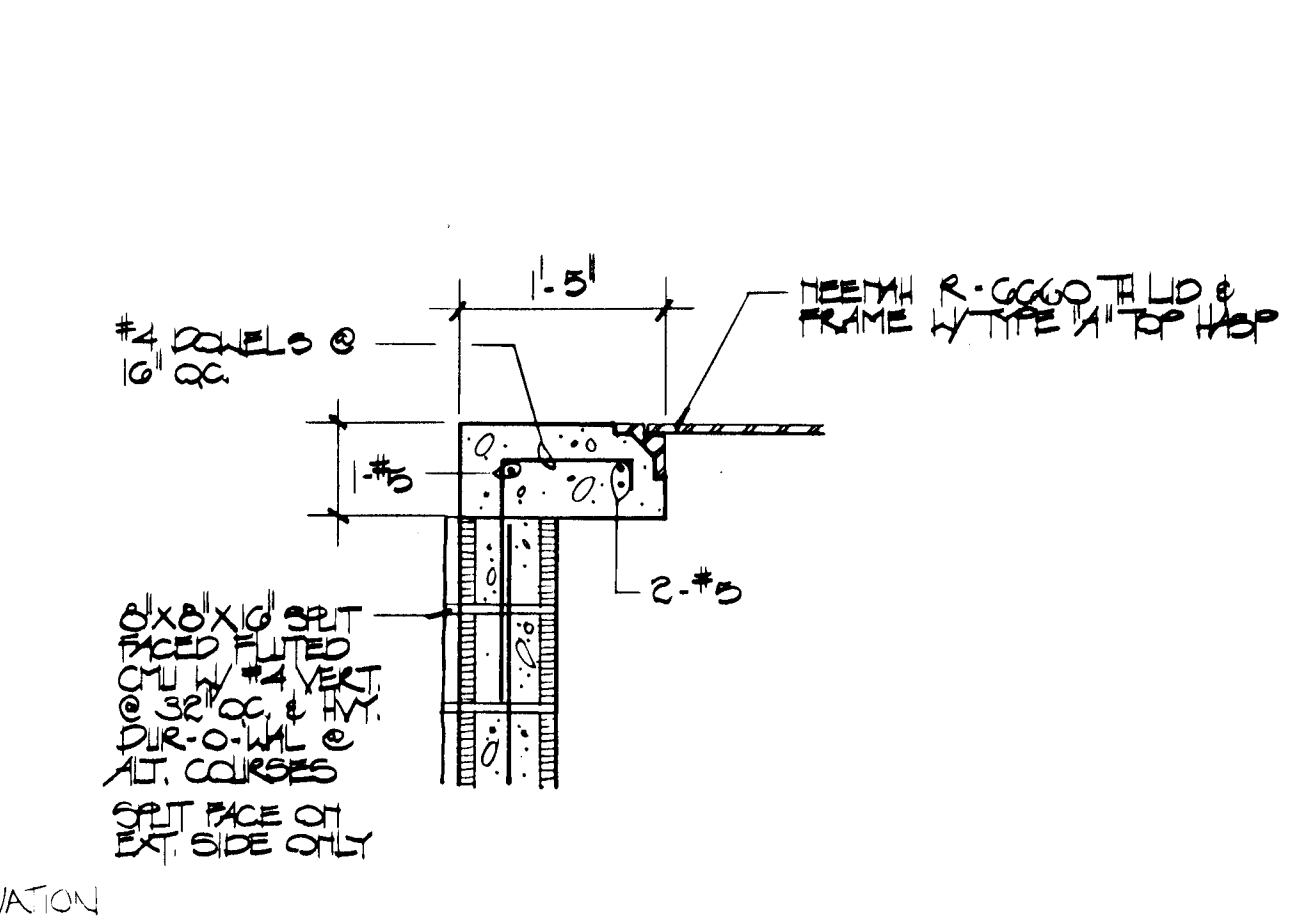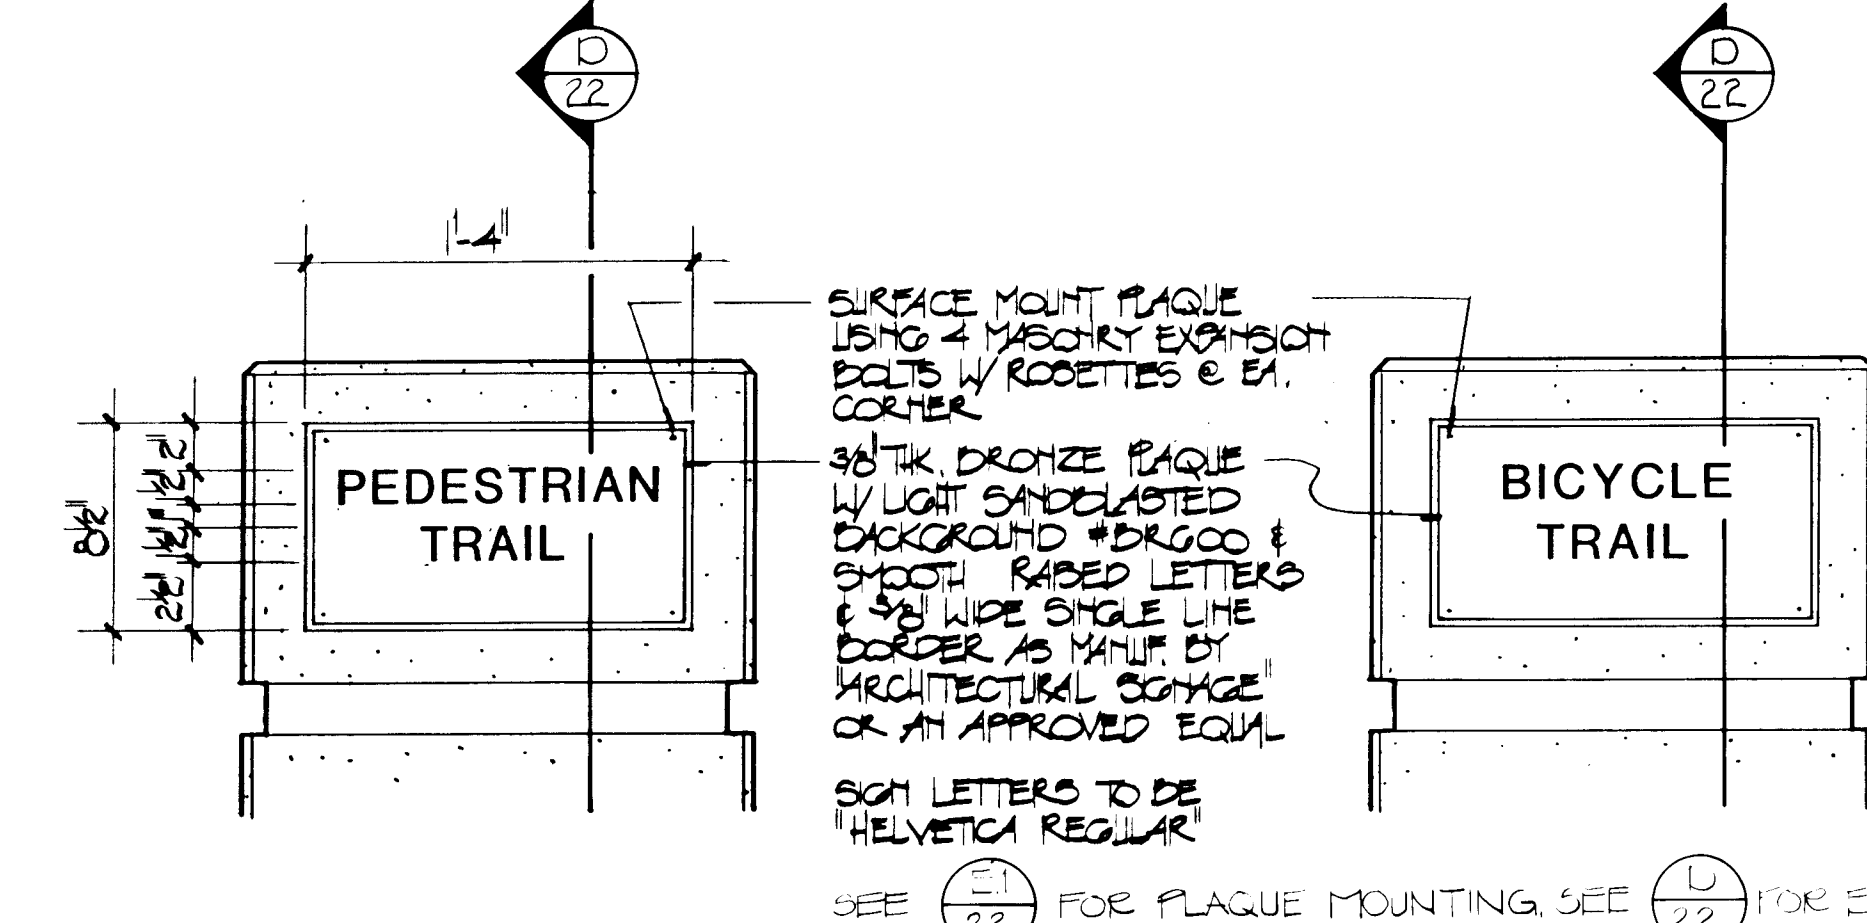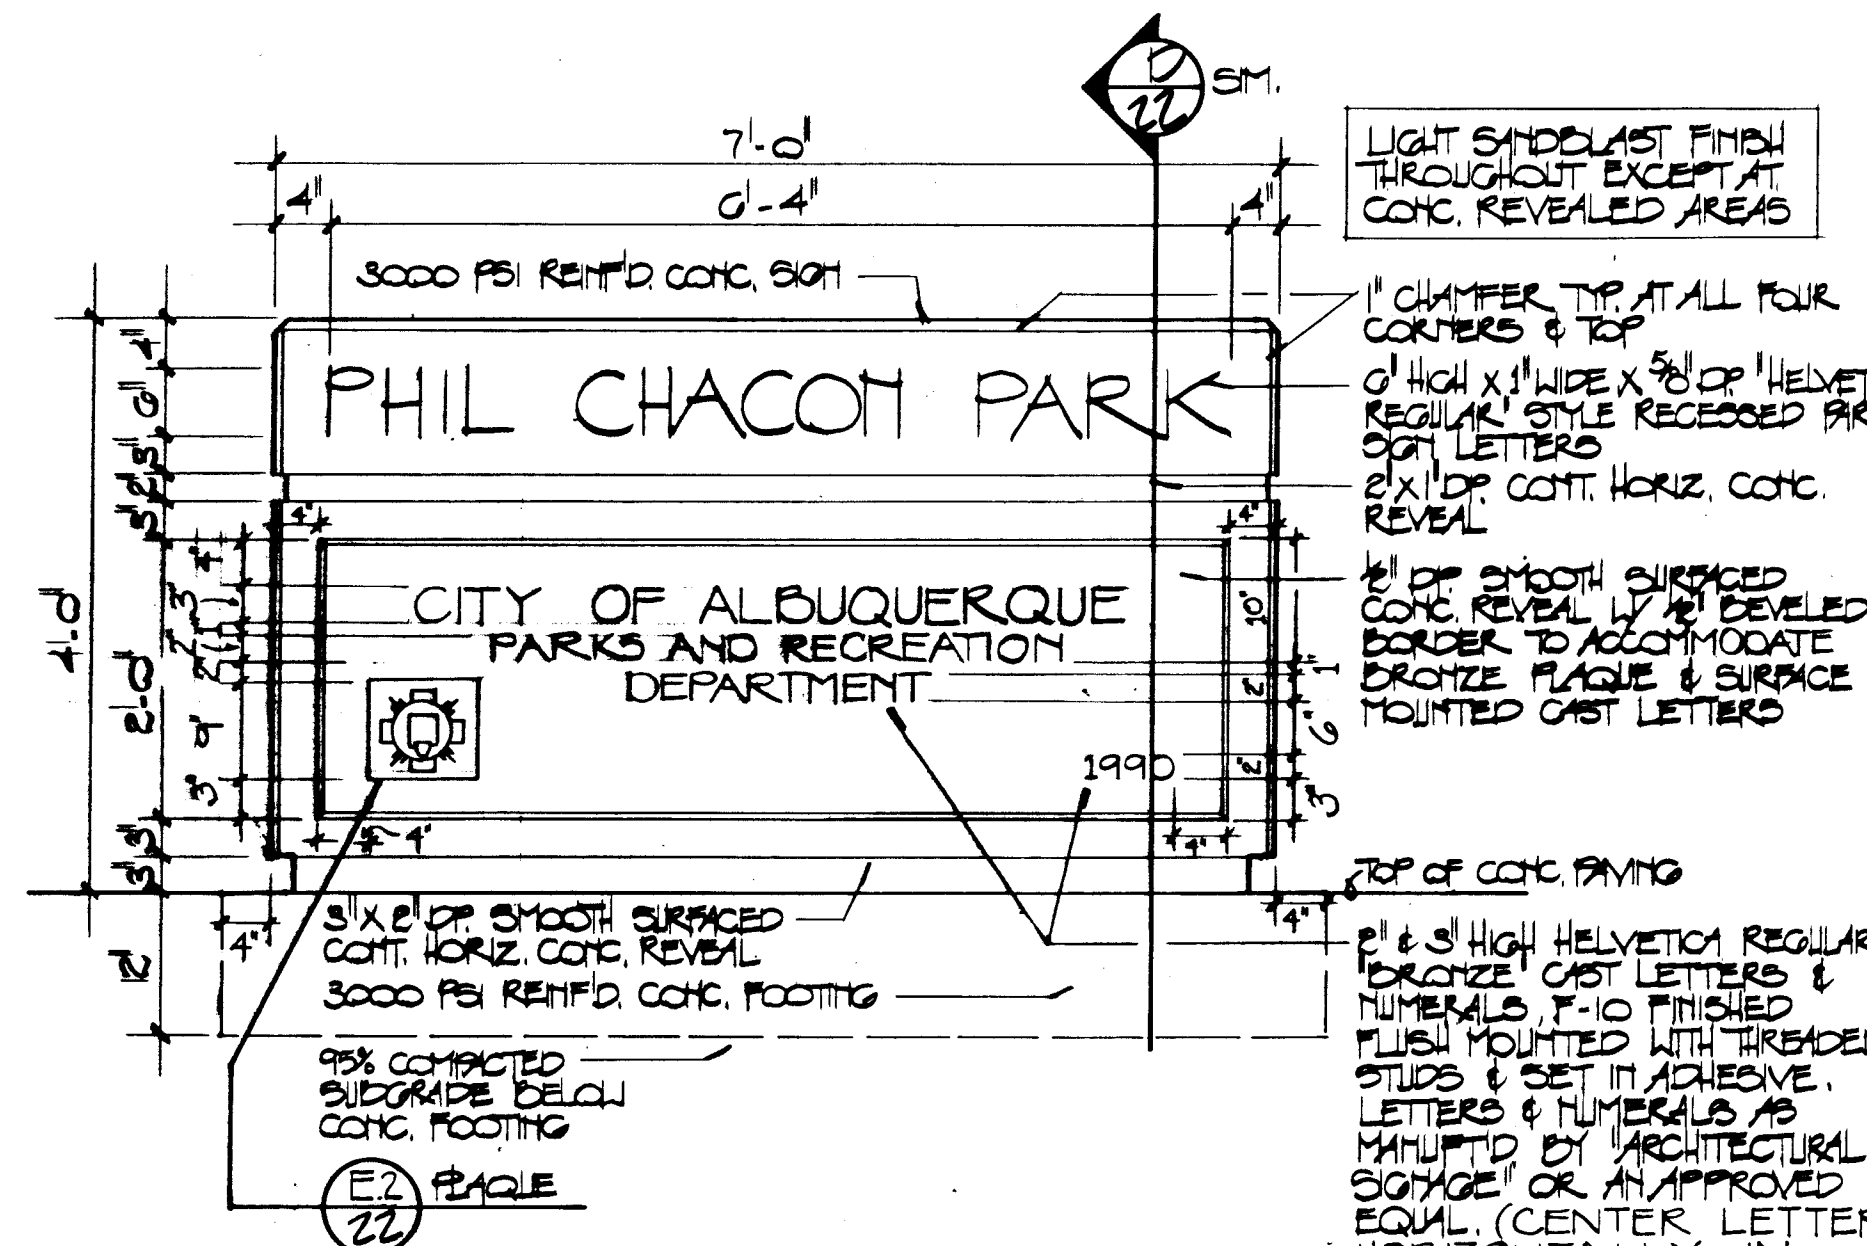


UTILITY ENCLOSURE DIMENSION PLAN
NTS



UTILITY ENCLOSURE CONSTRUCTION PLAN
NTS

IRRIGATION ENCLOSURE TOP PLAN VIEW
2" = 1'-0"









AS BUILT INFORMATION			BENCH MARKS			SURVEY INFORMATION			ENGINEER'S SEAL			REVISIONS			DESIGN		
CONTRACT NO.	DATE	BY	CONTRACT NO.	DATE	BY	NO.	DATE	BY	NO.	DATE	BY	NO.	DATE	BY	NO.	DATE	BY
MORROW & COMPANY LANDSCAPE ARCHITECTS 210 La Veta Drive NE Albuquerque, New Mexico 87108 505-268-2266			CITY OF ALBUQUERQUE PUBLIC WORKS DEPARTMENT ENGINEERING GROUP			TITLE: PHIL CHACON PARK PHASE I & II CONSTRUCTION DETAILS			APPROVALS			ENGINEER			DATE		
D.R.C. Chair			DATE			DATE			DATE			DATE			DATE		
Trans. Dev			DATE			DATE			DATE			DATE			DATE		
Utility Dev			DATE			DATE			DATE			DATE			DATE		
D. SALAS			DATE			DATE			DATE			DATE			DATE		
DRAWING NO. 2746			MAP NO. L-19			SHEET 22			OF 29			DATE 5/10			DATE 5/10		

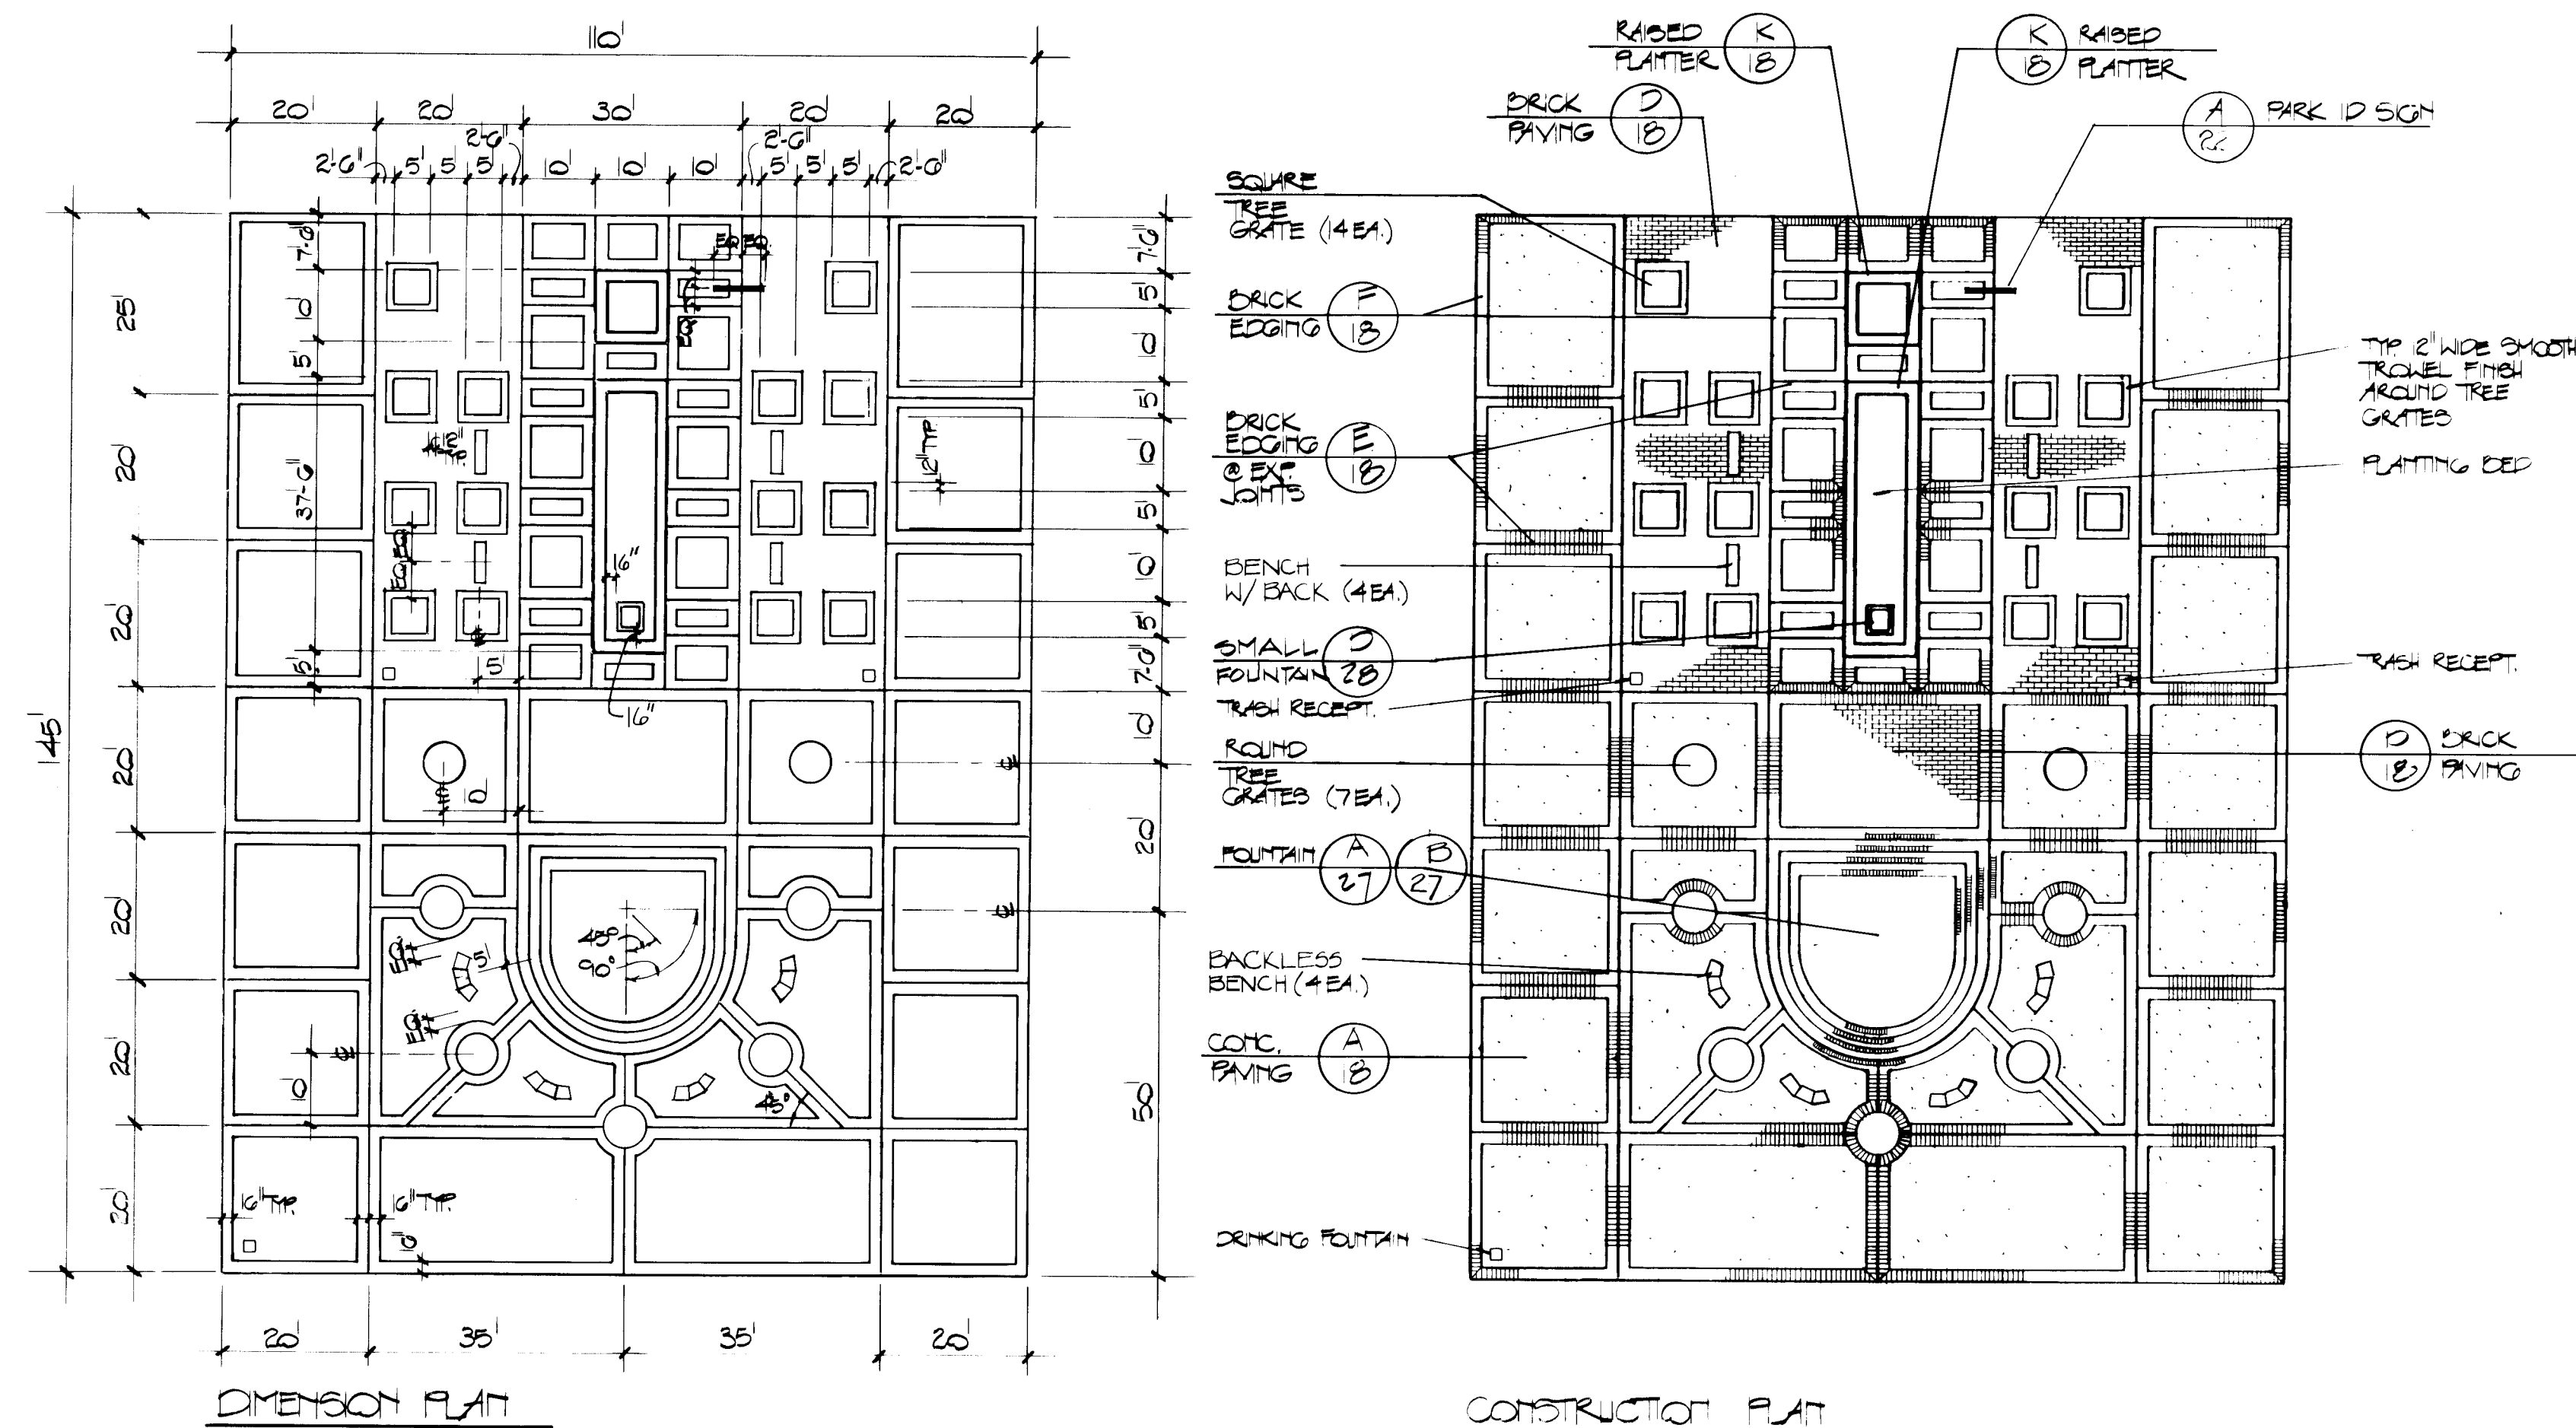

- NOTES:
1. SQUARE TREE GRATES SHALL BE NEENAH R-8734 180" SQUARE WITH TYPE 'U' ANGLE FRAME MOUNTED INTO SURROUNDING CONCRETE.
 2. ROUND TREE GRATES SHALL BE NEENAH R-8855 181" ROUND WITH TYPE 'U' ANGLE FRAME MOUNTED INTO SURROUNDING CONCRETE. SEE DETAIL 50 FOR MOUNTING AT MASONRY.
 3. BACKLESS BENCHES SHALL BE ULTRUM #UF 9210 15" CONCAVE FLAT SEATS (3 SEATS PER BENCH) WITH IN GROUND MOUNT (GREEN) (4EACH).
 4. BENCHES WITH BACKS SHALL BE ULTRUM #UF-5111 SERIES STRAIGHT CHAIRS (3 CHAIRS PER BENCH) WITH IN GROUND MOUNT (GREEN) (4EACH).
 5. BRCK SHALL BE ENDICOTT #77 MED. IRON SPOT PAVERS.
 6. DRINKING FOUNTAIN SHALL BE HANS # 3380 (GREEN).
SEE PER ULTRAFLEX REFR. RECOMMENDATIONS (NO FREEZE-PROOF VALVE SYSTEM).
 7. TRASH RECEPTACLE SHALL BE ULTRUM #UL 5005 (GREEN) WITH UL 5130 CONTRAFLOR SHALL SECURE RECEPTACLE TO THE CONCRETE PAVING WITH 2 EACH SECURITY LATCHES AND BOLTS.

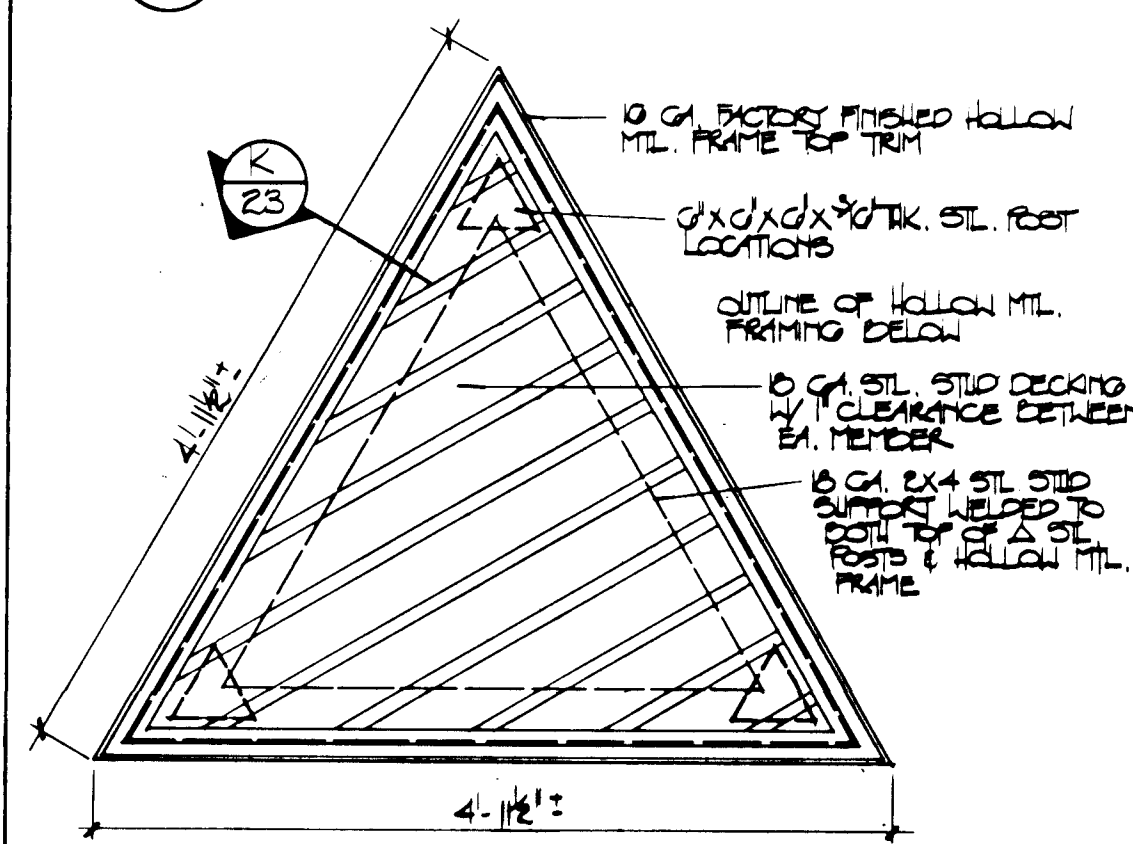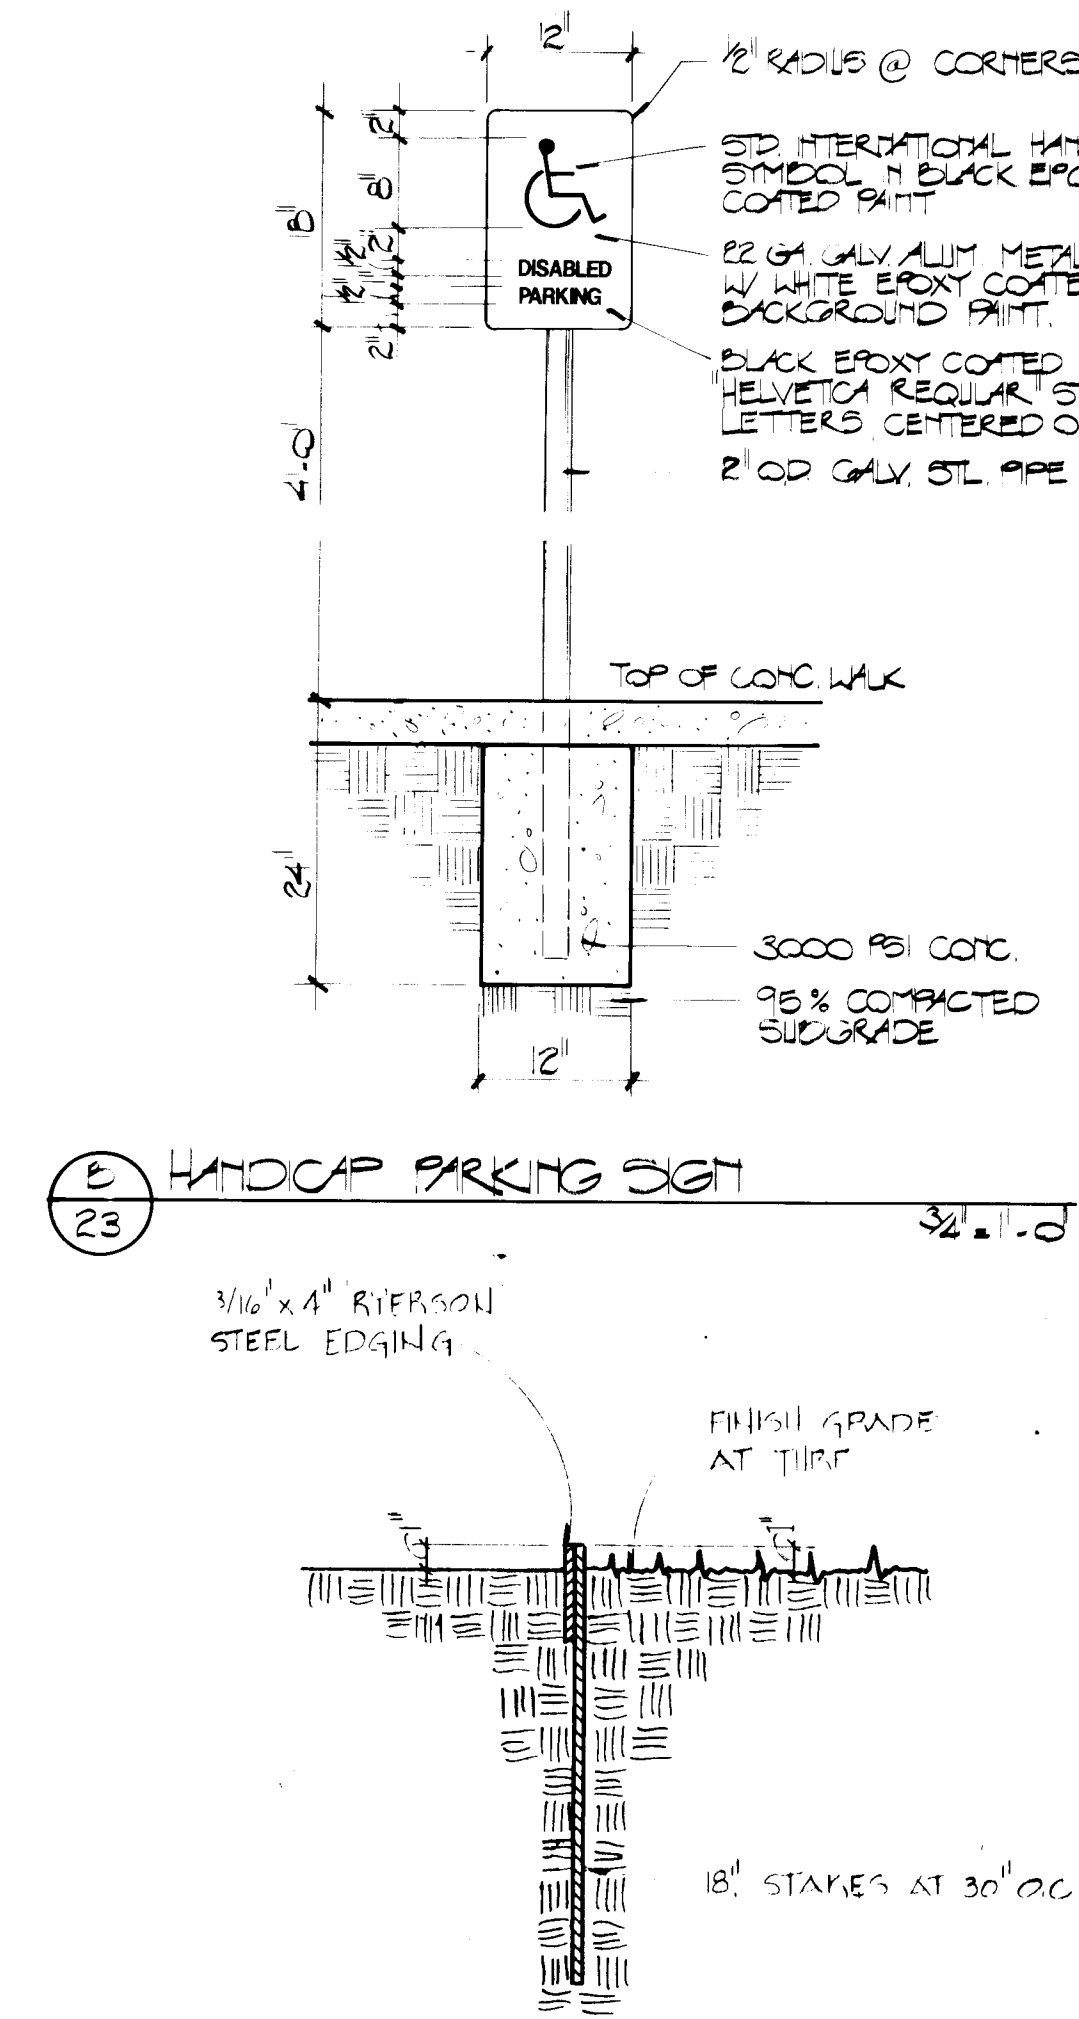


NOTE: SEE E/23 & F/23 FOR FRAMING PLANS

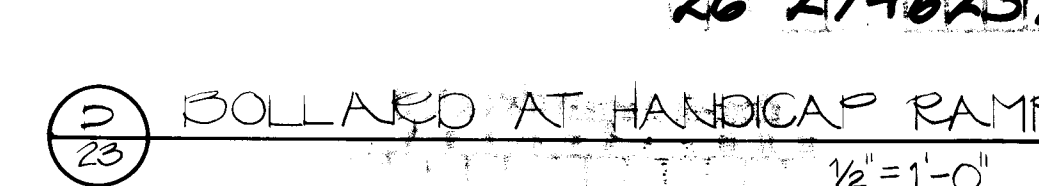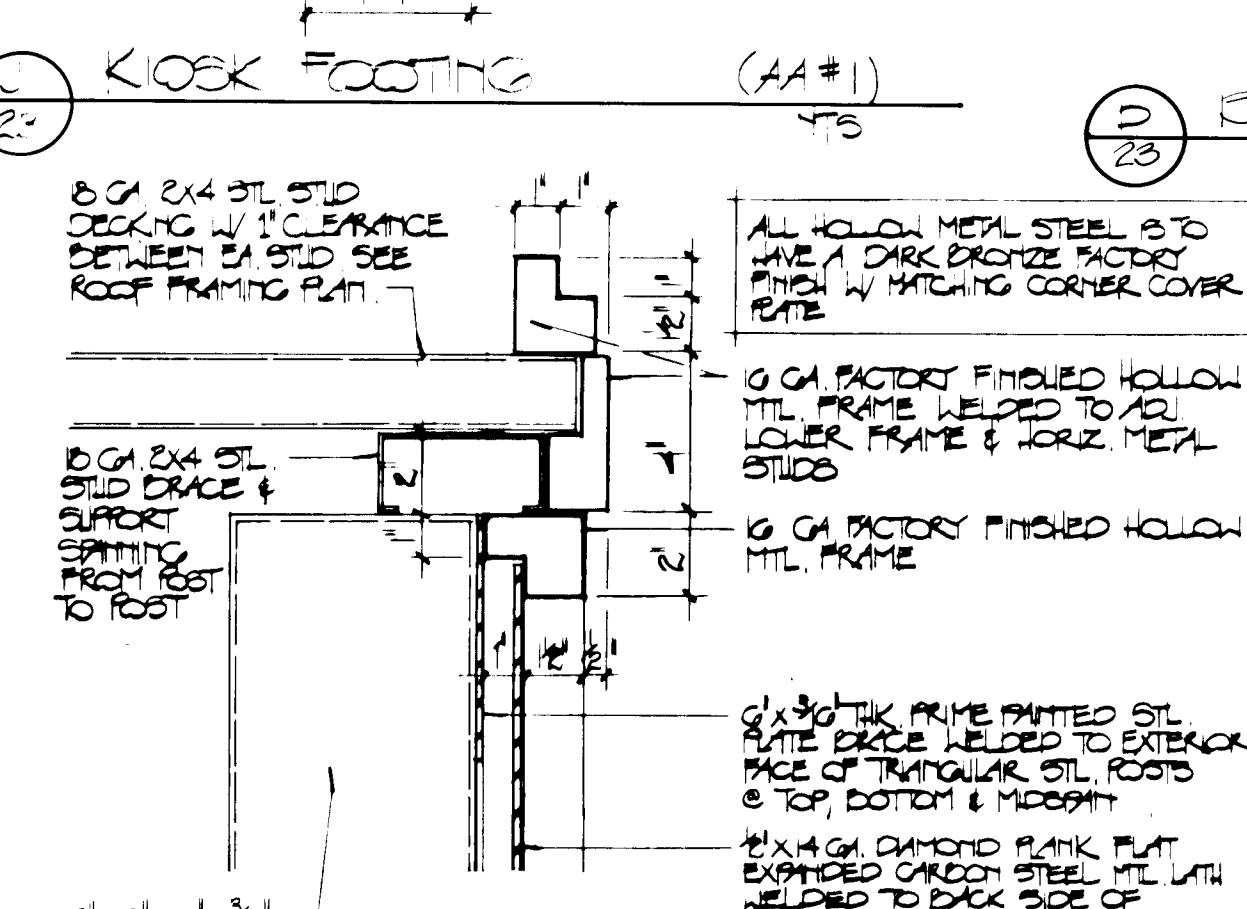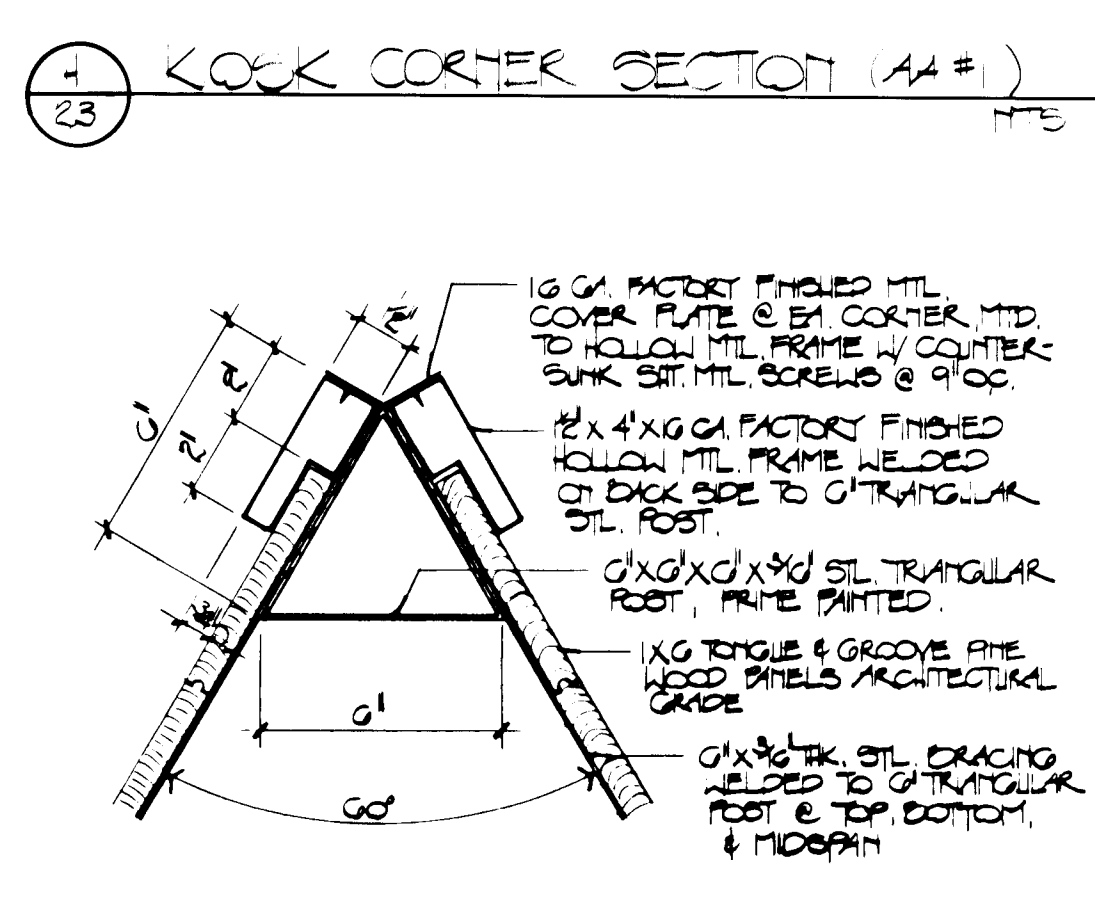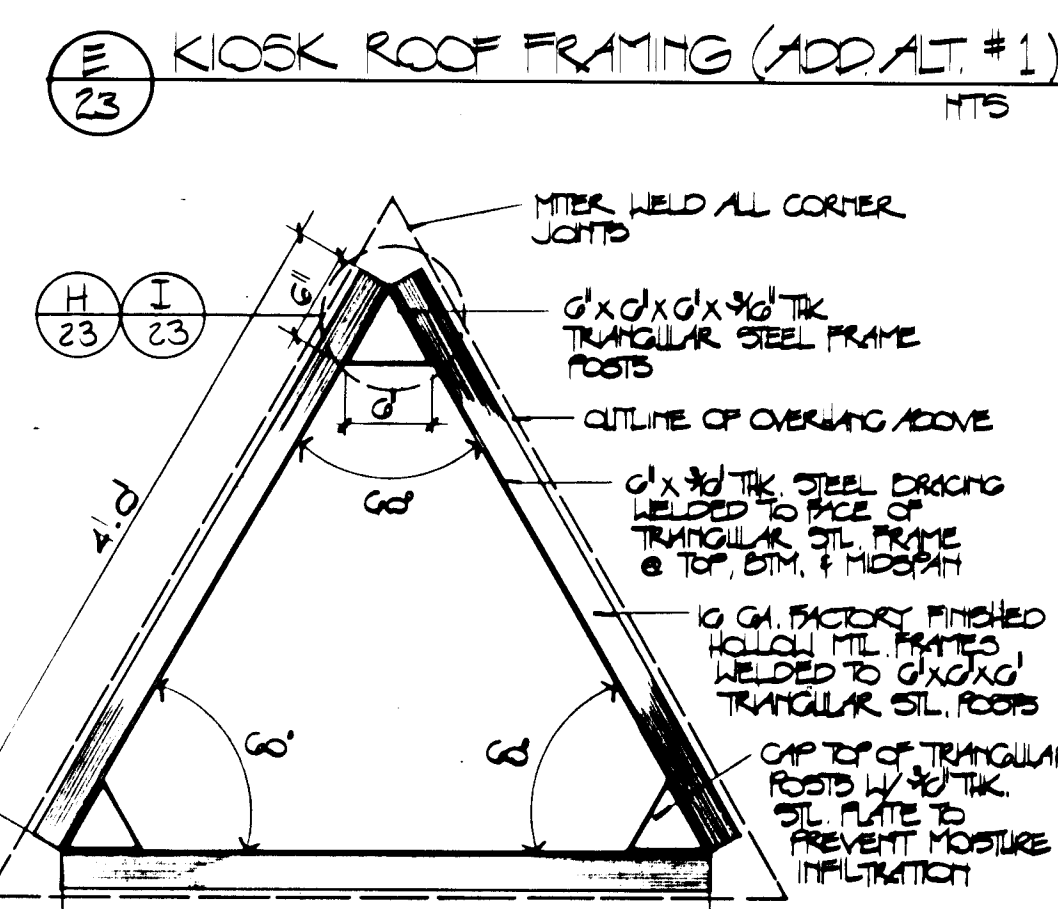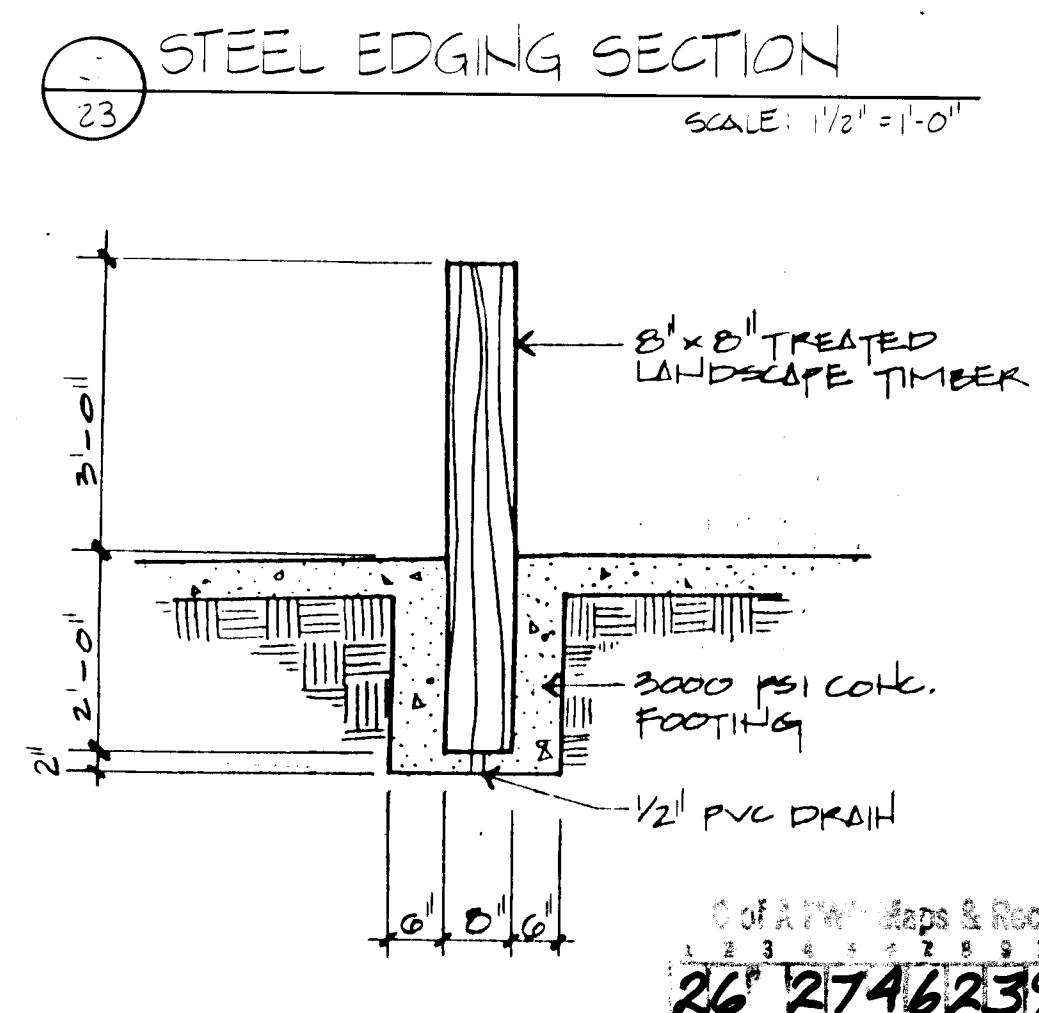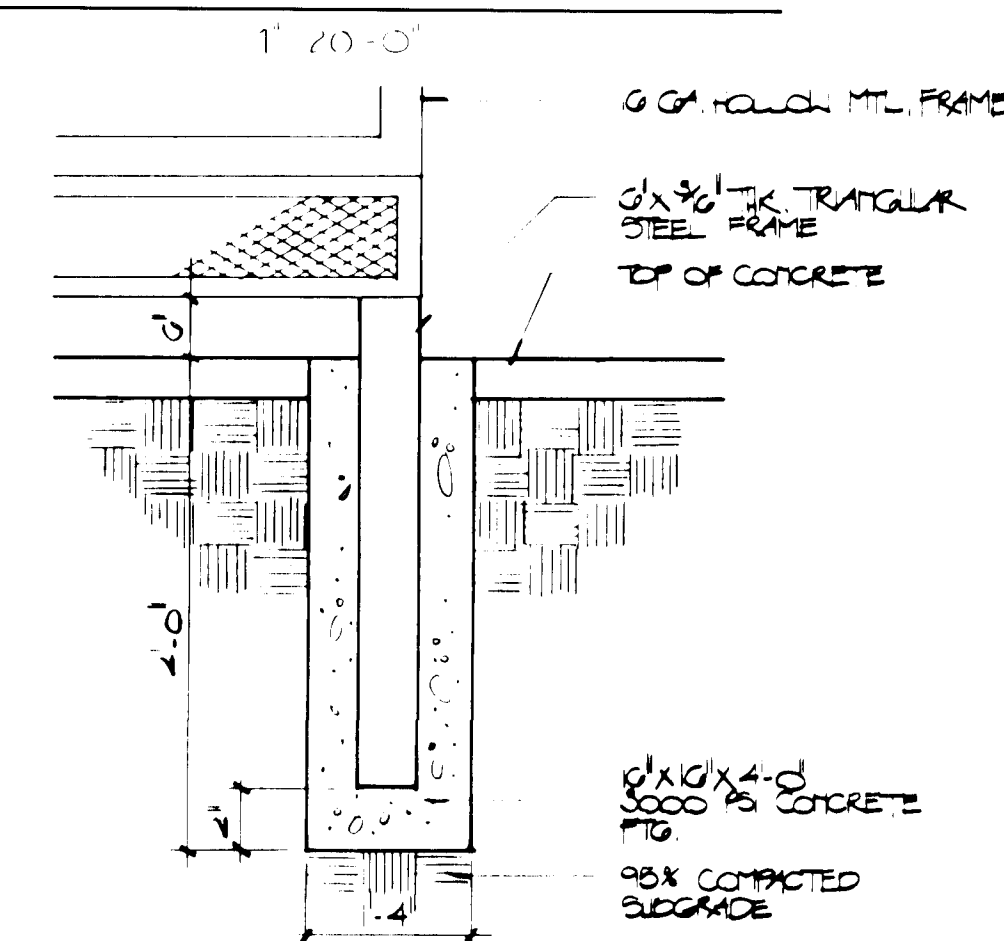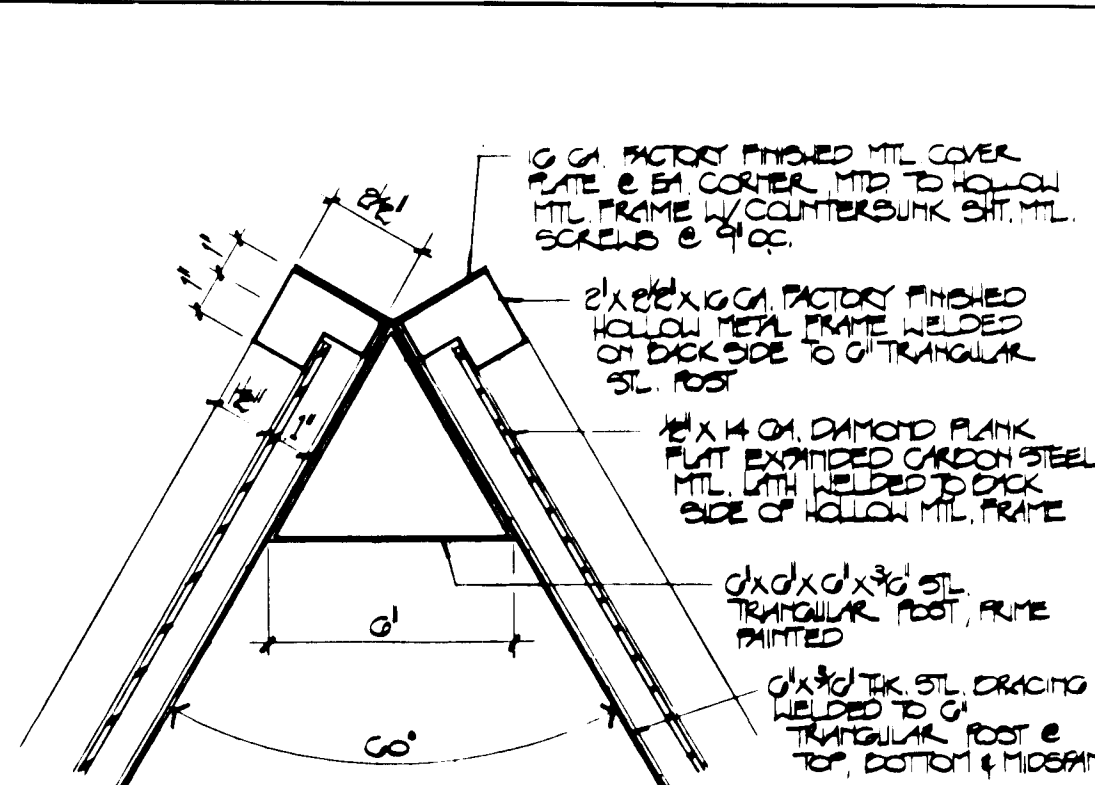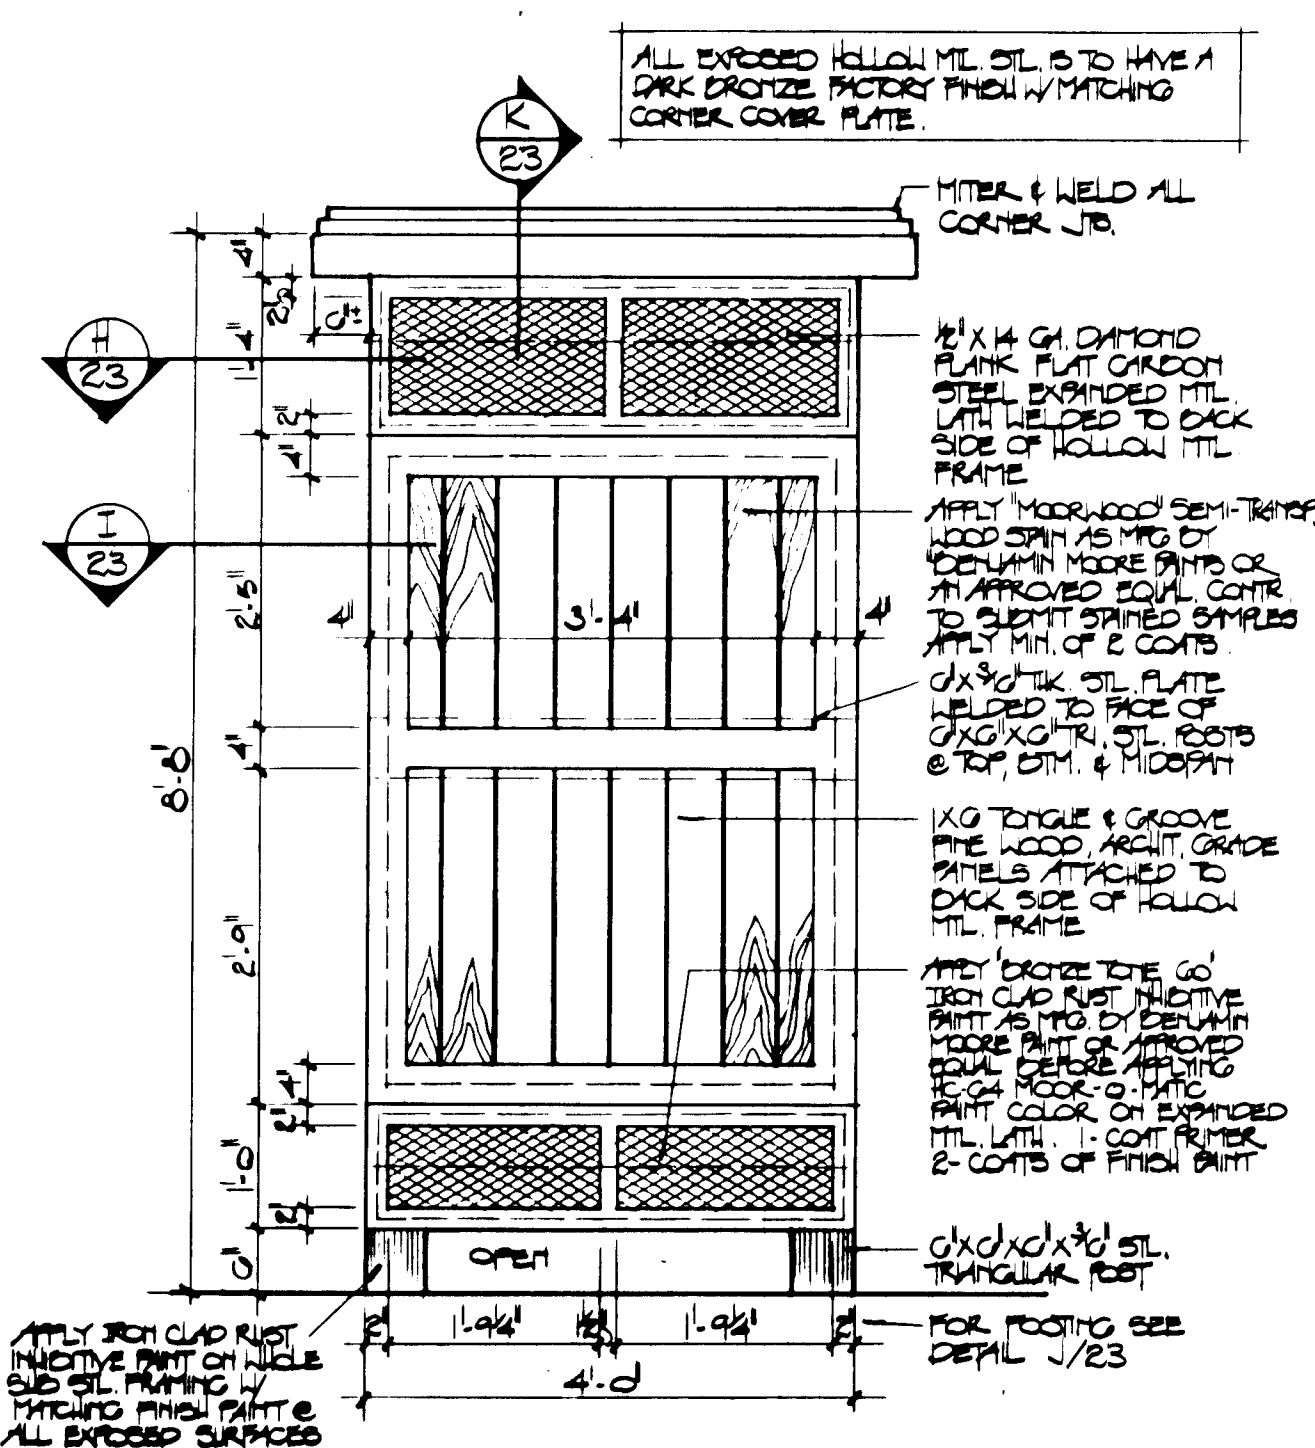


MORROW & COMPANY
LANDSCAPE ARCHITECTS
210 La Veta Drive NE
Albuquerque, New Mexico 87108
505 268-2266

CITY OF ALBUQUERQUE PUBLIC WORKS DEPARTMENT ENGINEERING GROUP					
TITLE: PHIL CHACON PARK PHASE I & II CONSTRUCTION DETAILS					
APPROVALS	ENGINEER	DATE	APPROVALS	ENGINEER	DATE
D.R.C. Chair					
Trans. Dev	<i>D. Seana</i>	<i>4-12-90</i>			
Utility Dev	<i>12/14 RWF</i>	<i>5/17/90</i>			
<i>Drawings</i>	<i>D. Seana</i>	<i>9-5-90</i>			
DRAWING NO. 2746		MAP NO. L-19		SHEET 23 OF 24	

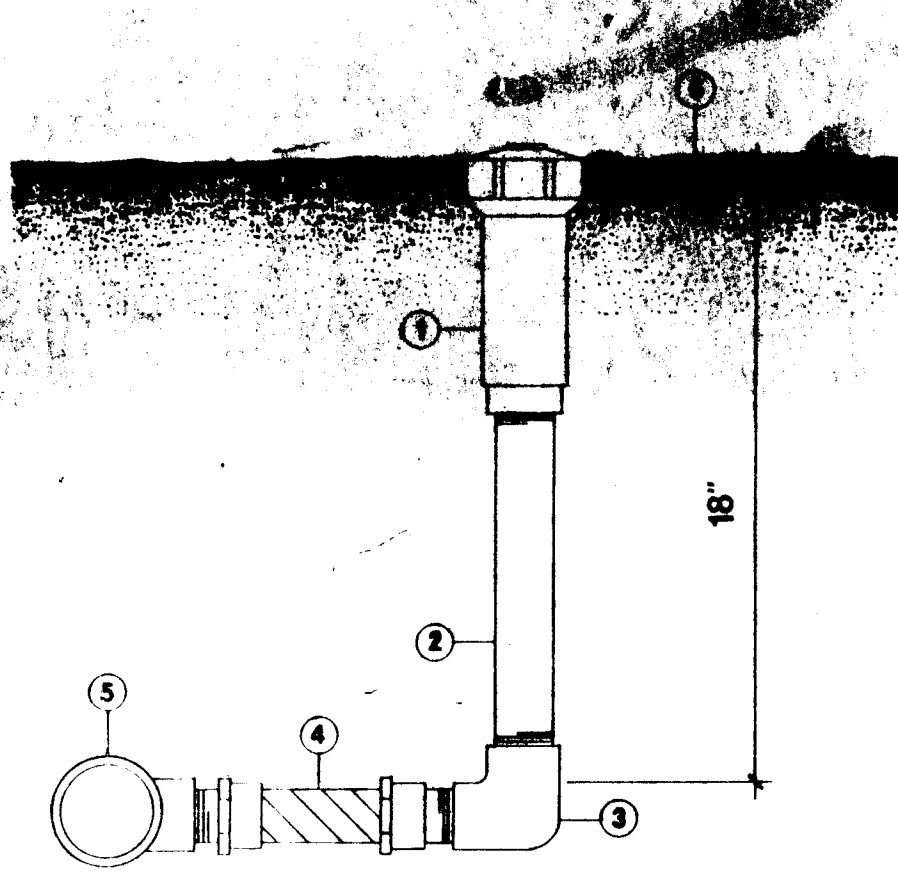


- 1 POP UP SPRINKLER (SEE PLAN)
- 2 1/2" x 12" SCH 80 PVC NIPPLE
- 3 1/2" SCH 40 PVC THREADED ELBOW
- 4 EXCALIBUR 506 MM 1/2"x6" FLEX NIPPLE OR EQUAL
- 5 PVC LATERAL PIPE FITTING
- 6 FINISH GRADE

A
24 POP UP SPRINKLER ASSEMBLY NTS

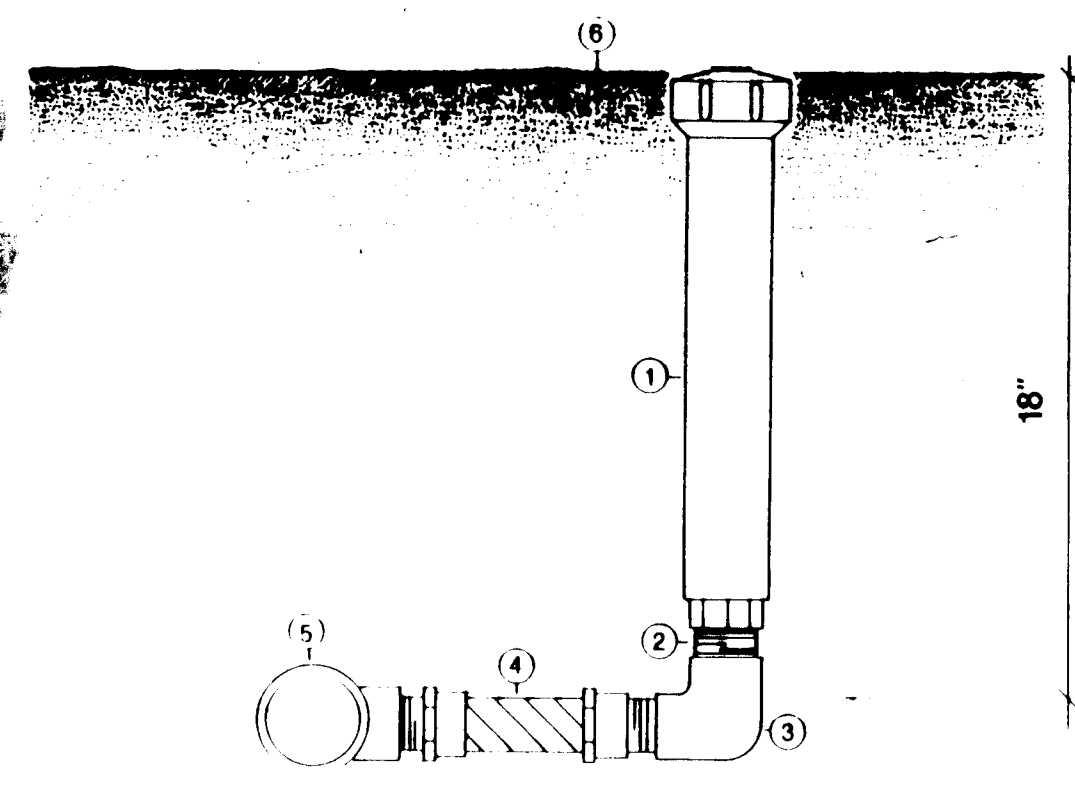


- 1 HIGH POP SPRINKLER (SEE PLAN)
- 2 1/2" x 2" SCH 80 PVC NIPPLE
- 3 1/2" SCH 40 PVC ELBOW T X T
- 4 EXCALIBUR 506 MM 1/2"x6" FLEX NIPPLE OR EQUAL
- 5 PVC LATERAL PIPE FITTING
- 6 FINISH GRADE

B
24 HIGH POP SPRINKLER ASSEMBLY NTS

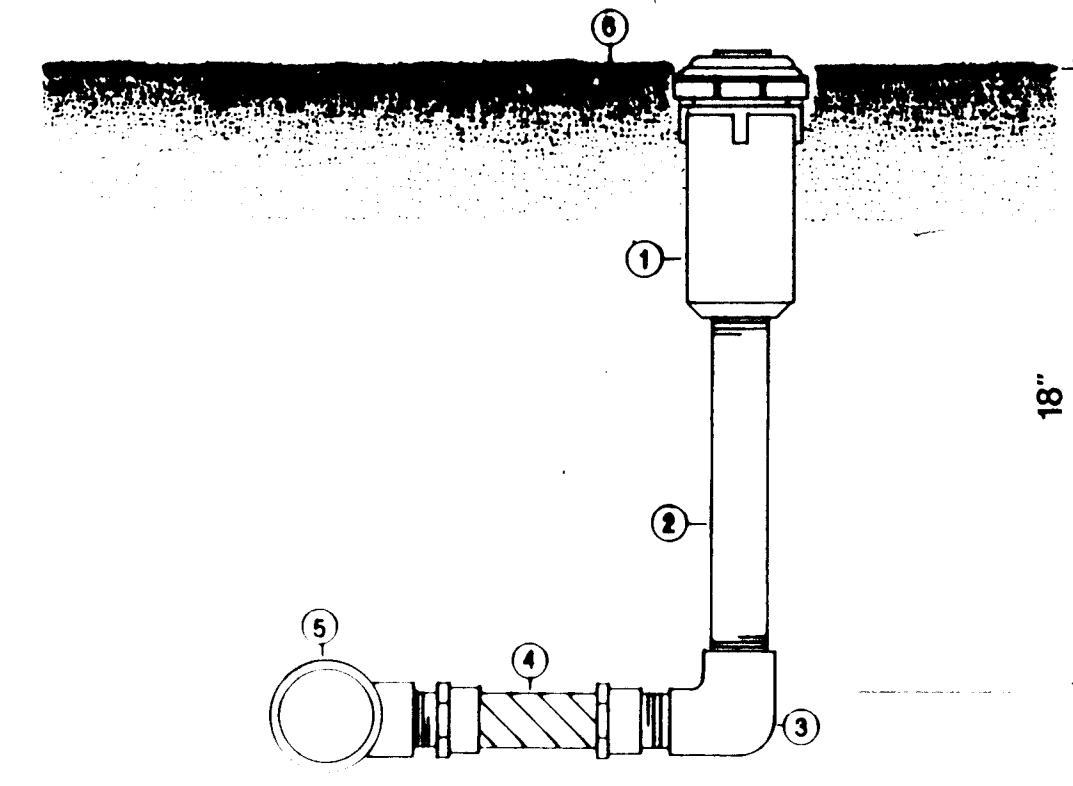


- 1 GEAR DRIVEN ROTARY SPRINKLER (SEE PLAN)
- 2 3/4" x 12" SCH 80 PVC NIPPLE
- 3 3/4" SCH 40 PVC THREADED ELBOW
- 4 EXCALIBUR 756 MM 3/4"x6" FLEX NIPPLE OR EQUAL
- 5 PVC LATERAL PIPE FITTING
- 6 FINISH GRADE

C
24 GEAR DRIVEN ROTARY SPRINKLER NTS

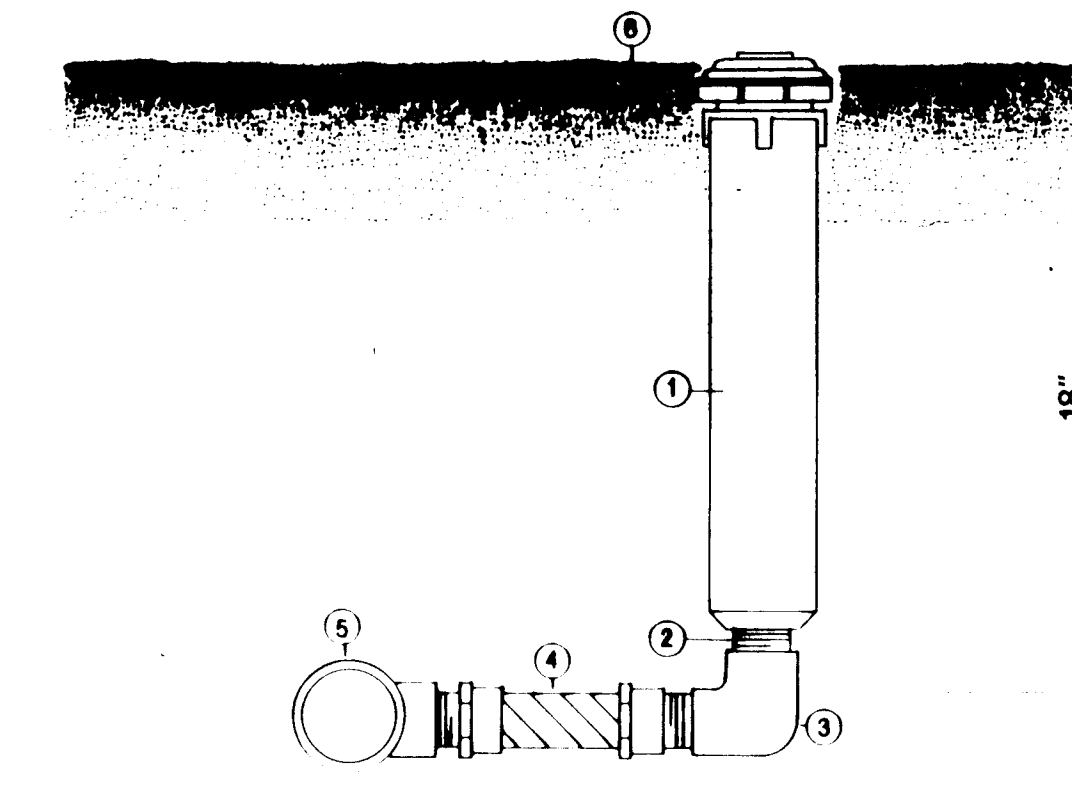


- 1 GEAR DRIVEN ROTARY SPRINKLER (SEE PLAN)
- 2 3/4" x 2" SCH 80 PVC NIPPLE
- 3 3/4" SCH 40 PVC THREADED ELBOW
- 4 EXCALIBUR 756 MM 3/4"x6" FLEX NIPPLE OR EQUAL
- 5 PVC LATERAL PIPE FITTING
- 6 FINISH GRADE

D
24 GEAR DRIVEN ROTARY HIGH POP SPRINKLER NTS

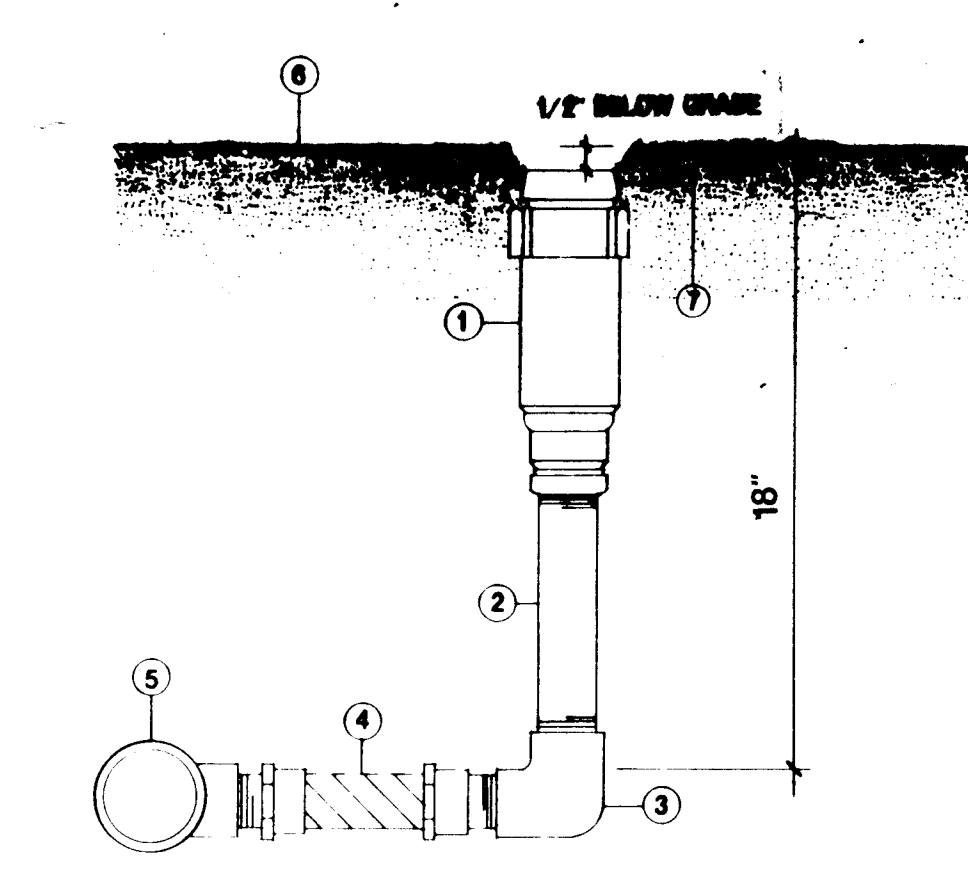

- 1 GEAR DRIVE SPRINKLER (SEE PLAN)
- 2 1" x 12" SCH 80 PVC NIPPLE
- 3 1" SCH 40 PVC THREADED ELBOW
- 4 EXCALIBUR 1007 MM 1"x6" FLEX NIPPLE OR EQUAL
- 5 PVC LATERAL PIPE FITTING
- 6 FINISH GRADE
- 7 RUBBER COVER (IF SPECIFIED, SEE PLAN)


E
24 GEAR DRIVEN ROTARY SPRINKLER NTS

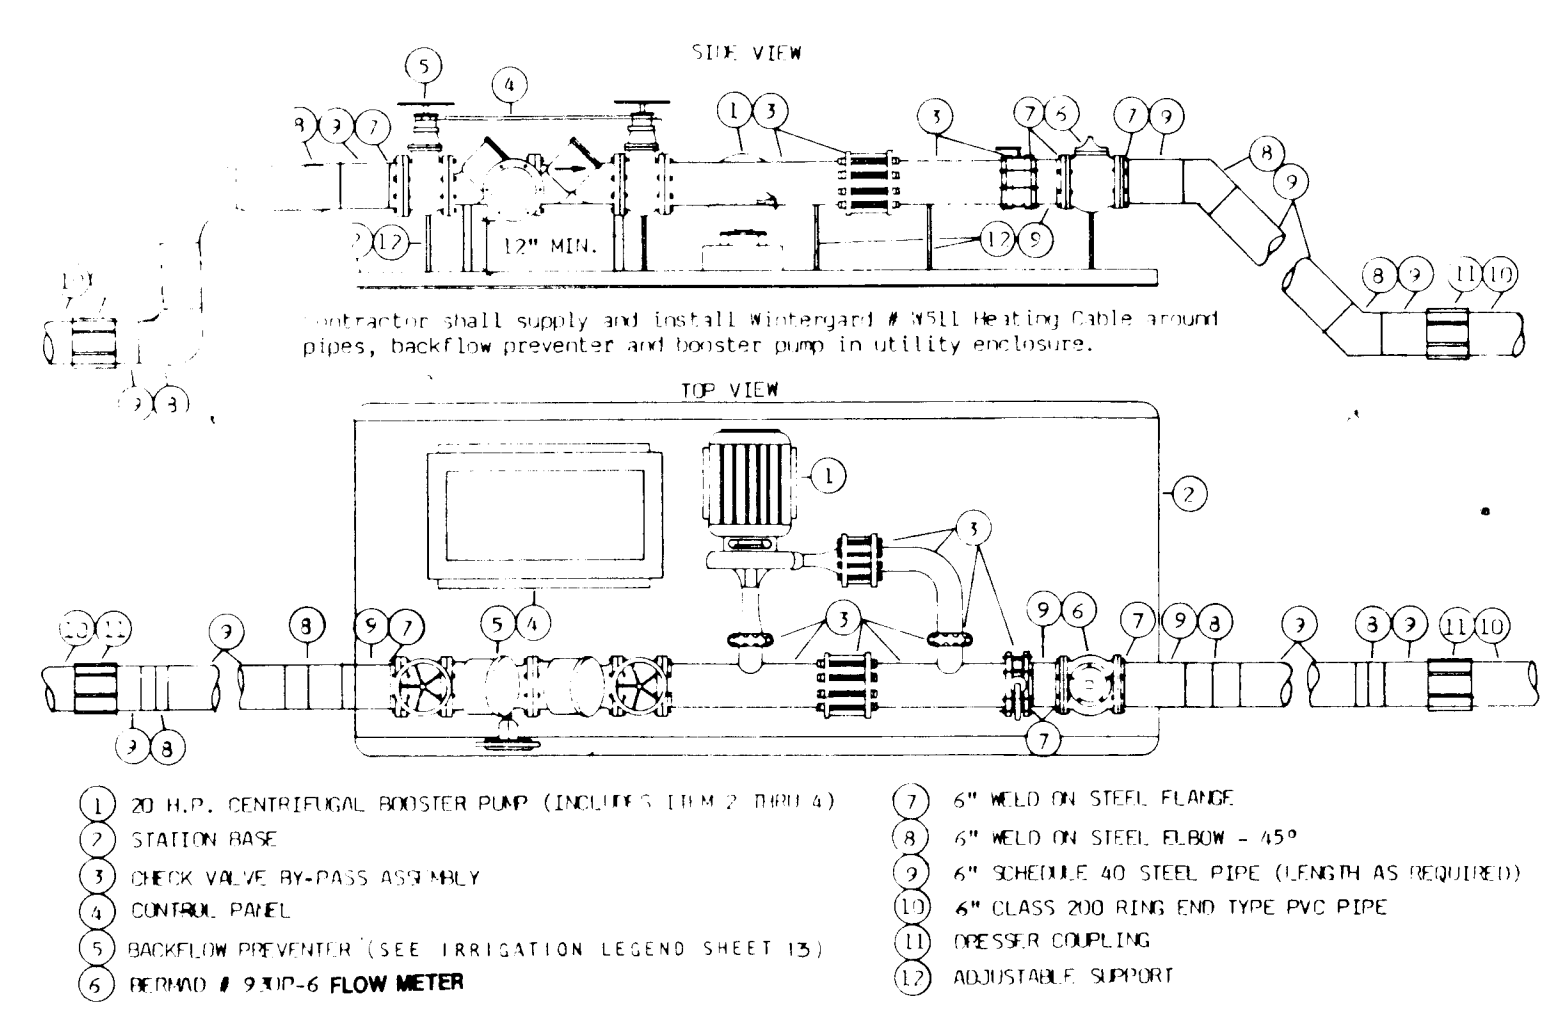

- 1 20 HP, CENTRIFUGAL BOOSTER PUMP (INCLUDES 10' MIN. 2" DIAM. 4")
- 2 STATION RISE
- 3 CHECK VALVE BY-PASS ASSEMBLY
- 4 CONTROL PANEL
- 5 BACKFLOW PREVENTER (SEE IRRIGATION LEGEND SHEET 15)
- 6 FLOW METER 9"x10"x6" FLOW METER
- 7 4" WELD ON STEEL FLANGE
- 8 4" WELD ON STEEL ELBOW - 45°
- 9 4" SCHEDULE 40 STEEL PIPE (LENGTH AS REQUIRED)
- 10 4" CLASS 200 RING END TYPE PVC PIPE
- 11 ORISER COUPLING
- 12 ADJUSTABLE SUPPORT


Booster Pumping Station shall be Model # LPS-125-1-1600-A-20 as built by PSI PUMPING SYSTEMS, DALLAS, TX, 1-800-527-0539.

F
24 BOOSTER PUMP & BACKFLOW PREVENTER ASSEMBLY

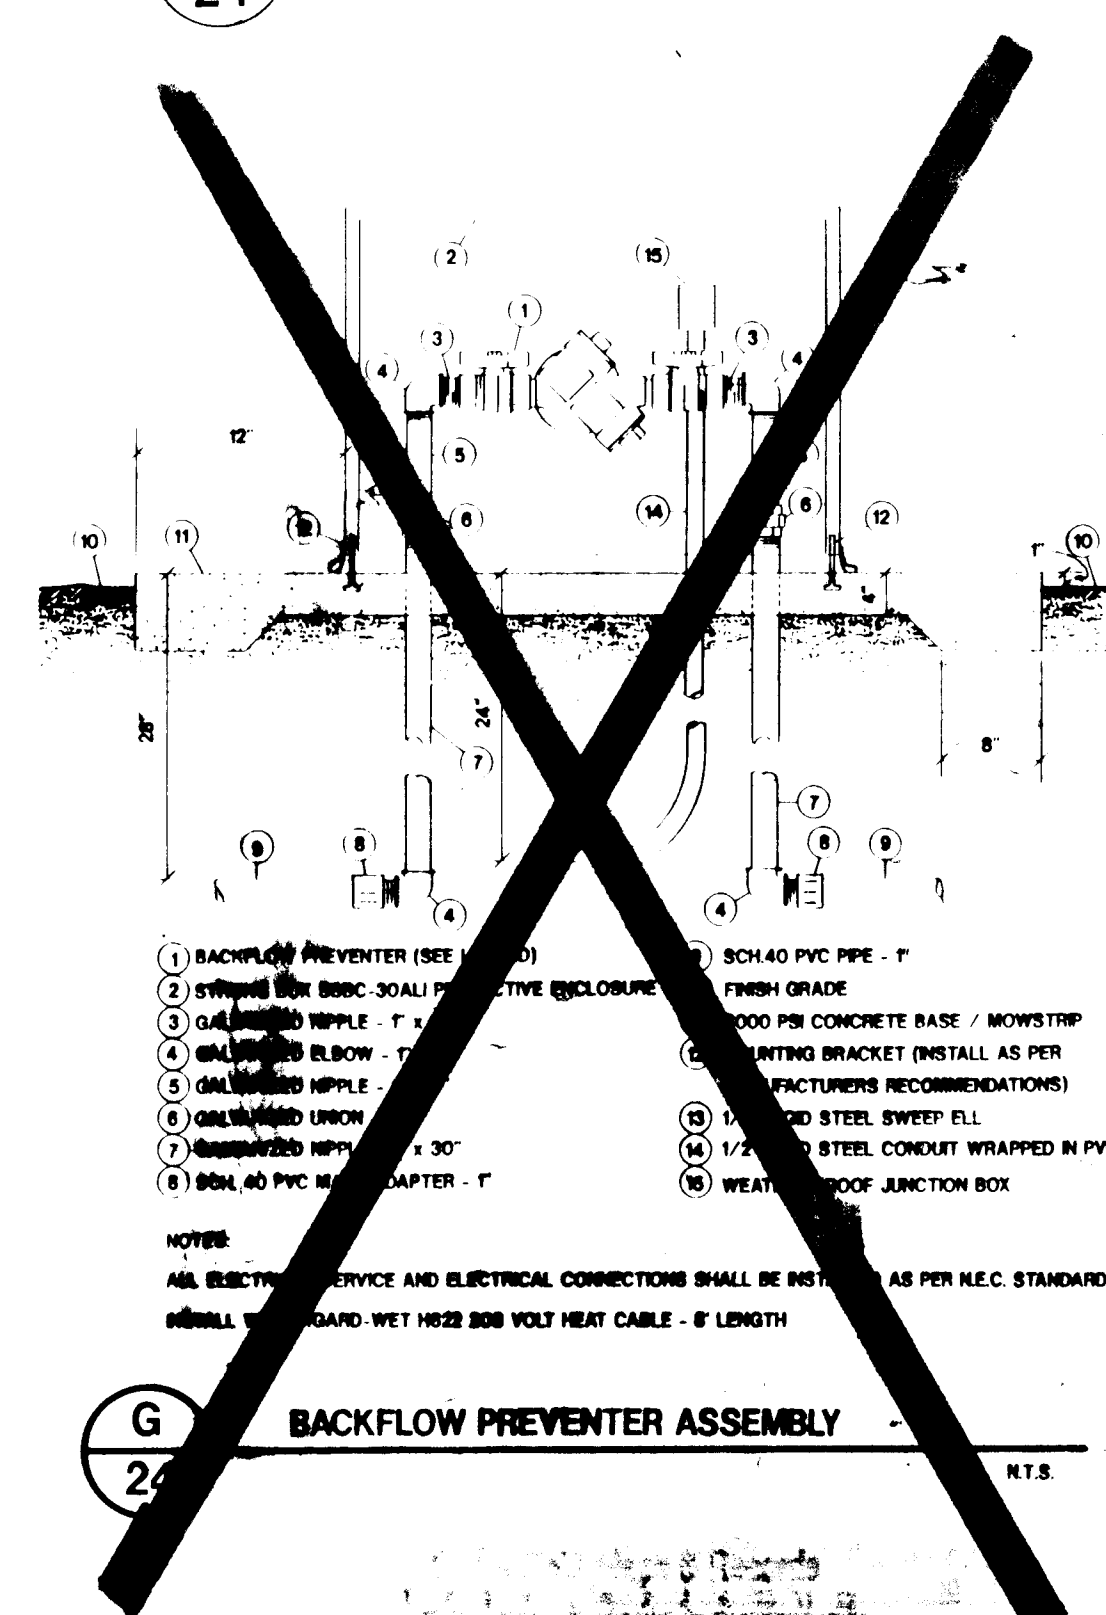


- 1 BACKFLOW PREVENTER (SEE PLAN)
- 2 2" x 12" SCH 80 PVC NIPPLE
- 3 2" SCH 40 PVC THREADED ELBOW
- 4 EXCALIBUR 1007 MM 1"x6" FLEX NIPPLE OR EQUAL
- 5 PVC LATERAL PIPE FITTING
- 6 FINISH GRADE
- 7 4" WELD ON STEEL FLANGE
- 8 4" WELD ON STEEL ELBOW - 45°

G
24 BACKFLOW PREVENTER ASSEMBLY NTS

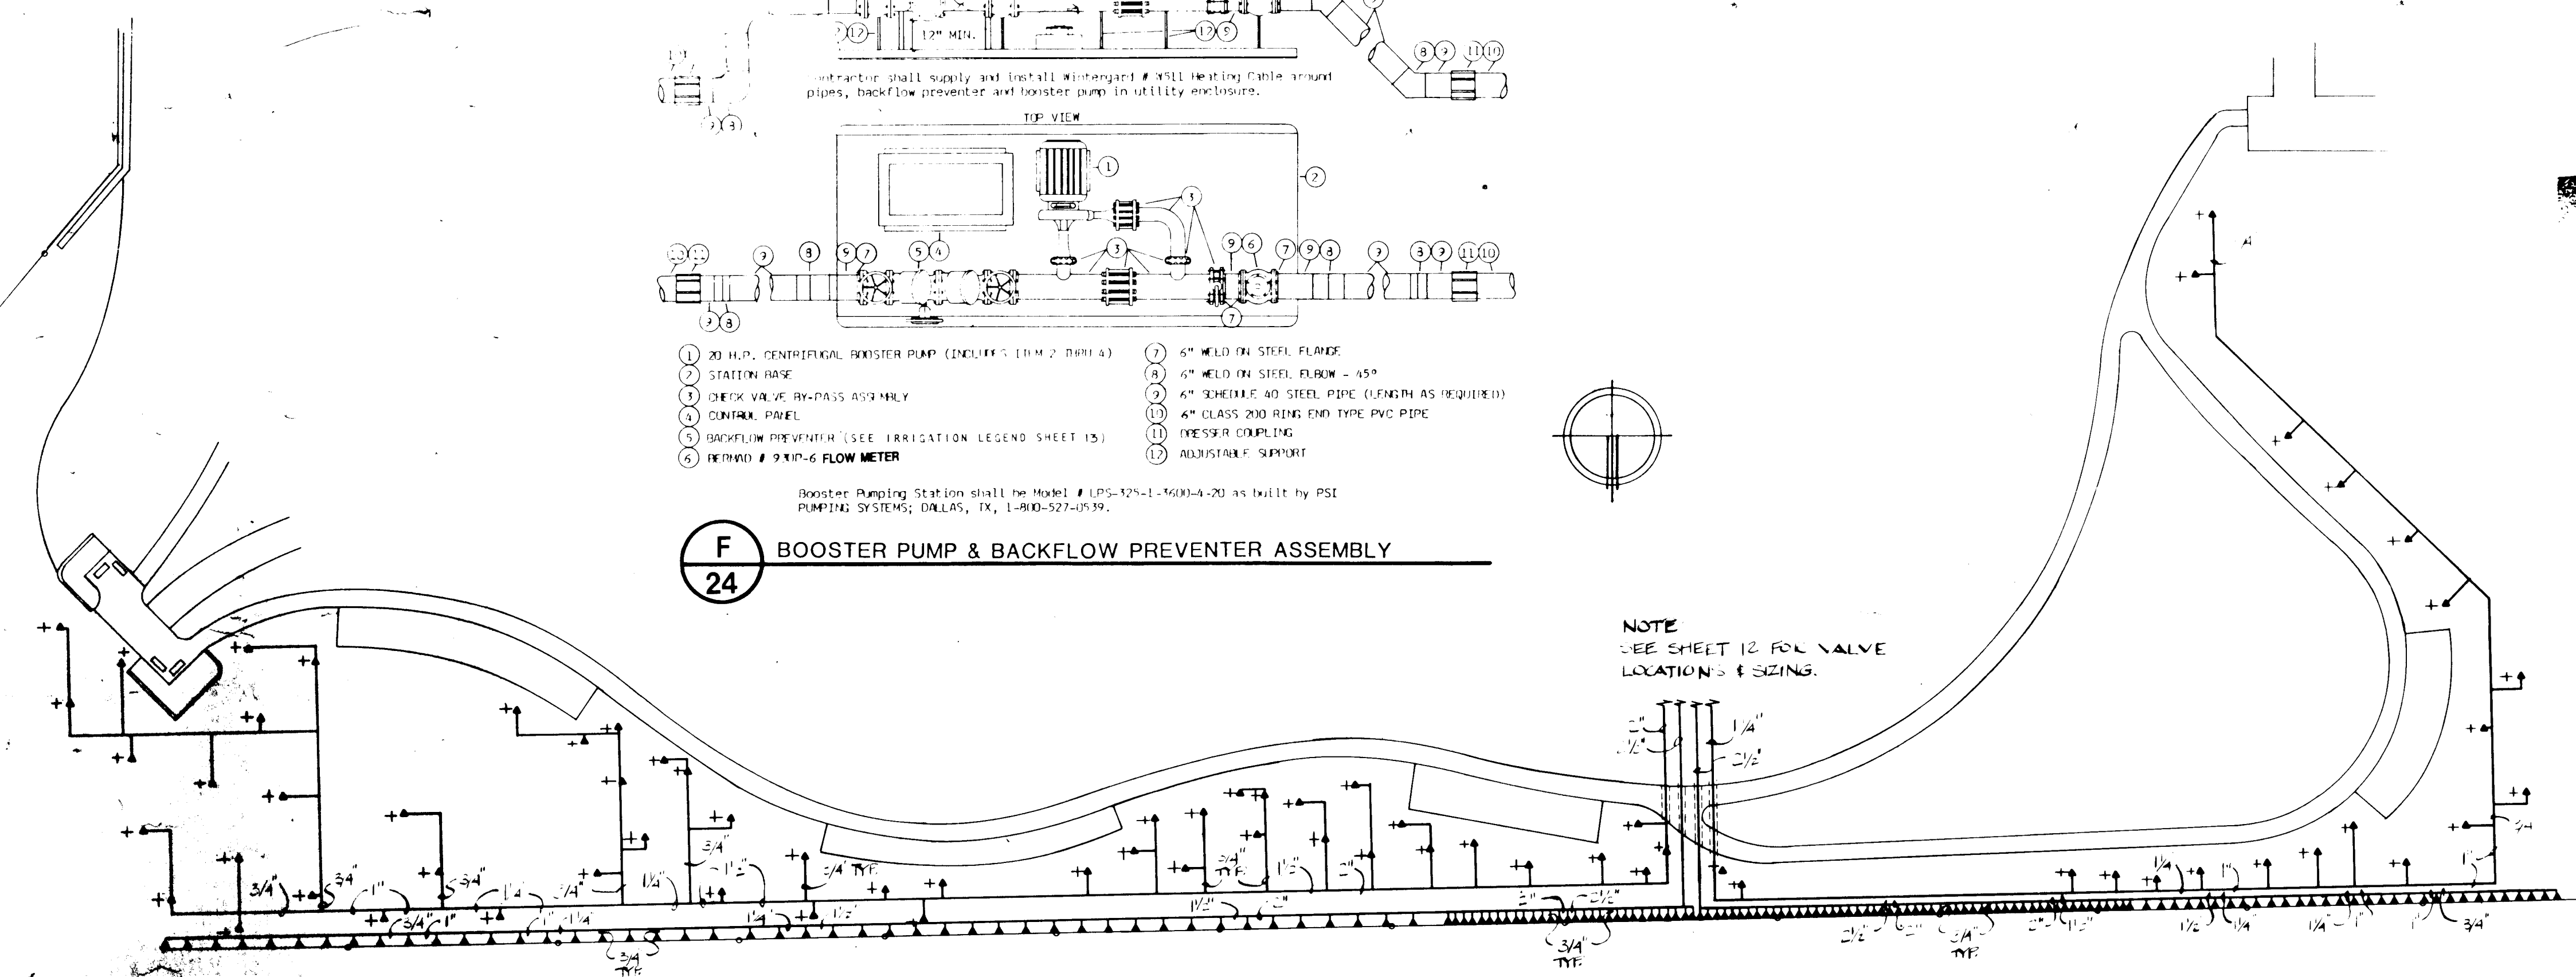

LEGEND	
▲ TORO 570C-4P POP-UP SPRINKLER.....	SEE DETAIL
FB-100-PC PRESSURE COMPENSATING FLOOD BUBBLER - 1 GPM (NO CHECK VALVE)	
— LATERAL PIPE - CLASS 200 SOLVENT WELD PVC; 18" BURY MIN. (SIZES AS INDICATED)	
----- SLEEVE PIPE - CLASS 200 PVC (2 SIZES LARGER THAN PIPE BEING SLEEVED)	

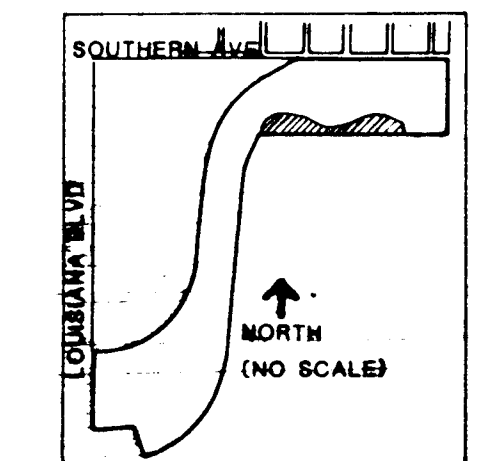

G
24 BUBBLER SYSTEM IN SOUTH NATIVE AREA

MORROW & COMPANY
LANDSCAPE ARCHITECTS
210 La Veta Drive NE
Albuquerque, New Mexico 87108
505 268-2266


CITY OF ALBUQUERQUE PARKS & RECREATION DESIGN & DEVELOPMENT					
TITLE: PHIL CHACON PARK PHASE I & II IRRIGATION DETAILS					
APPROVALS	ENGINEER	DATE	APPROVALS	ENGINEER	DATE
DRC CHAIRMAN			WATER	R.W. Kane	9-17-90
TRANSPORTATION	N/A RHO	6-17-90	WASTE WATER	R.W. Kane	9-17-90
HYDROLOGY	N/A	9/1/90			
Drains	to Sema	9-5-90			
PROJECT NO. 2746		MAP NO. L-19		SHEET 24 OF 29	

NO.		DATE	REVISIONS / REMARKS	BY	DATE	DESIGNED BY	DATE	DRAWN BY	DATE	CHECKED BY	DATE
1		10/91	AS-BUILT	SLM		205	5/90	9/90	5/90	6/90	5/90


NO.		DATE	REVISIONS / REMARKS	BY	DATE	DESIGNED BY	DATE	DRAWN BY	DATE	CHECKED BY	DATE
1		10/91	AS-BUILT	SLM		205	5/90	9/90	5/90	6/90	5/90

NO.		DATE	REVISIONS / REMARKS	BY	DATE	DESIGNED BY	DATE	DRAWN BY	DATE	CHECKED BY	DATE
1		10/91	AS-BUILT	SLM		205	5/90	9/90	5/90	6/90	5/90


NO.		DATE	REVISIONS / REMARKS	BY	DATE	DESIGNED BY	DATE	DRAWN BY	DATE	CHECKED BY	DATE
1		10/91	AS-BUILT	SLM		205	5/90	9/90	5/90	6/90	5/90

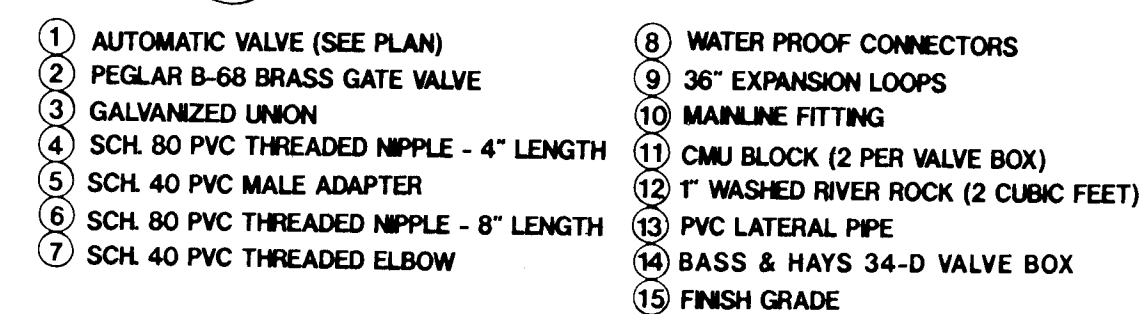


A AUTOMATIC VALVE ASSEMBLY
25

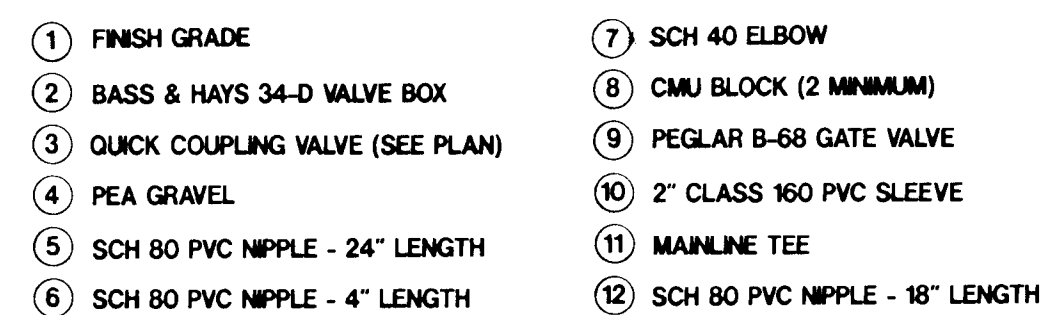


B QUICK COUPLER VALVE ASSEMBLY

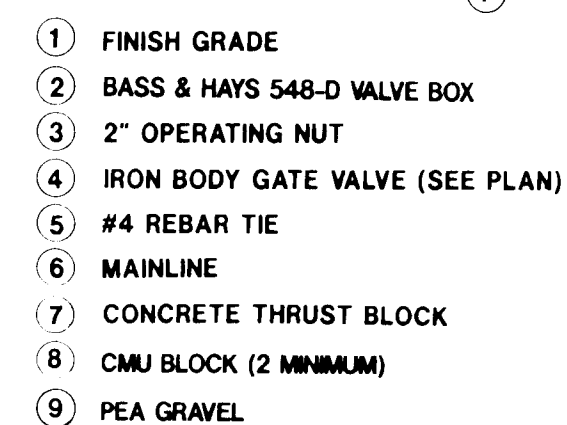


C IRON BODY GATE VALVE ASSEMBLY
25

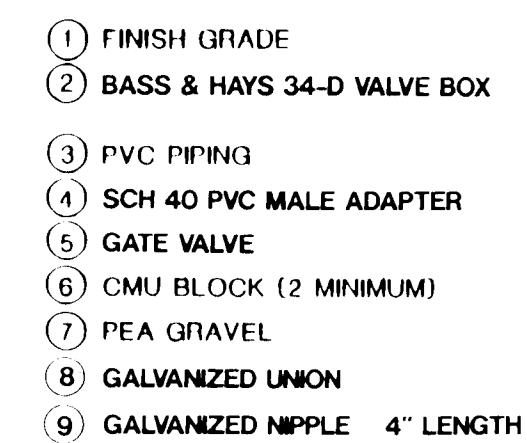


BRASS GATE VALVE ASSEMBLY

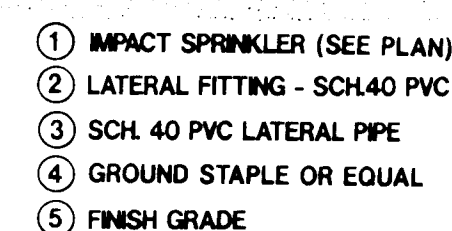


E IMPACT SPRINKLER ASSEMBLY
25 FOR TEMPORARY IRRIGATION

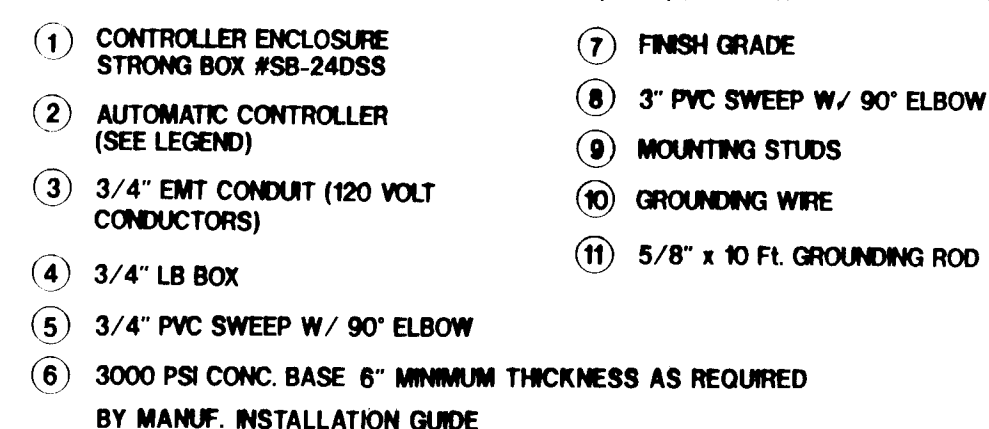

F **AUTOMATIC CONTROLLER & STEEL ENCLOSURE**
25

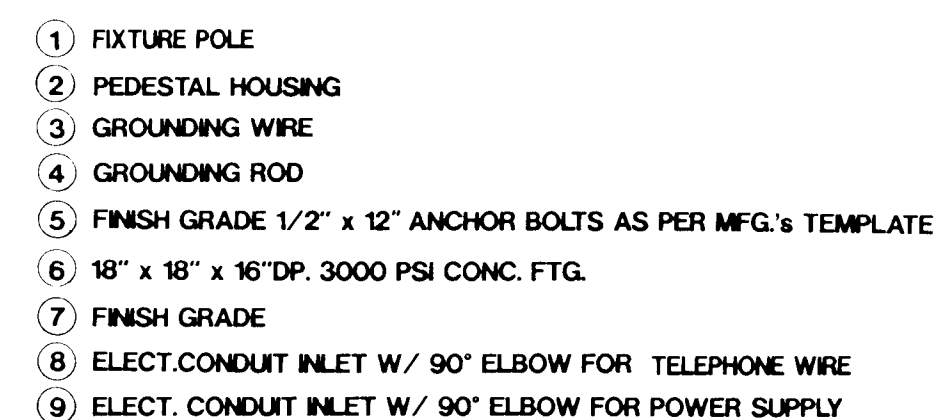

G WEATHER STATION ASSEMBLY
25

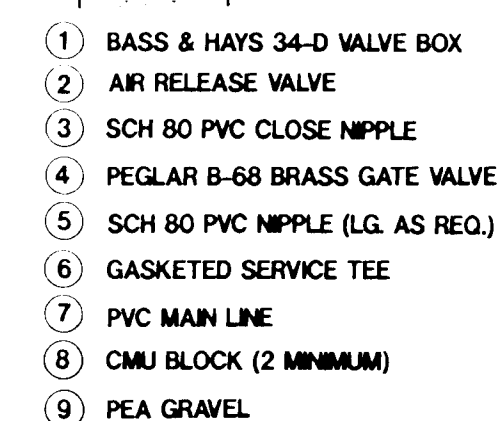

9 PEA GRAVEL

H AIR RELEASE VALVE ASSEMBLY

25

26 27462593

MORROW & COMPANY
LANDSCAPE ARCHITECTS
210 La Veta Drive NE
Albuquerque, New Mexico 87108
505 268-2266

CITY OF ALBUQUERQUE
PUBLIC WORKS DEPARTMENT
ENGINEERING GROUP


TITLE: PHIL CHACON PARK PHASE I & II
IRRIGATION DETAILS

APPROVALS	ENGINEER	DATE	APPROVALS	ENGINEER	DATE
D.R.C. Chair					
Trans. Dev	<i>11-1-90</i>				
Utility Dev	<i>R. K. Kane</i>	<i>8-27-90</i>			
<i>Parts</i>	<i>D. Stena</i>	<i>9-5-90</i>			
DRAWING NO. 2746	MAP NO. L-19	SHEET 25 OF 29			

ITEM	DESCRIPTION	QTY.	MODEL NUMBER
1	NOT USED		
2	1" POOL SLAB PENETRATION	8	2JBS-100
3	3" SIDEWALL OVERFLOW (FLOOR MOUNT)	1	ROVS-900
4	2" SIDEWALL OVERFLOW (FLOOR MOUNT)	2	ROVS-200
5	CUSTOM "J" SHAPED MANIFOLD, 11/2" HOZZLES	1	CUSTOM
6	CUSTOM DRY AERATOR NOZZLE, 1"	8	RFA-D-100
7	1" BRASS BALL VALVE	8	FBB-150
8	2" POOL SLAB PENETRATION	4	RJBS-200
9	12" ANTI-VORTEX PLATE W/SLUMP, 2" INLET	1	RAMS-1200
10	CUSTOM FIBERGLASS WATER TANK	4	RDB-6'0"X6'
11	DIRECT BURIAL PUMP STATION 6'0"X6'	1	RDP-SERIES

NOTES:

1. GRATING SHALL BE SUPPLIED BY CONTRACTOR, NOT BY FTM EQUIP. SUPPLIER

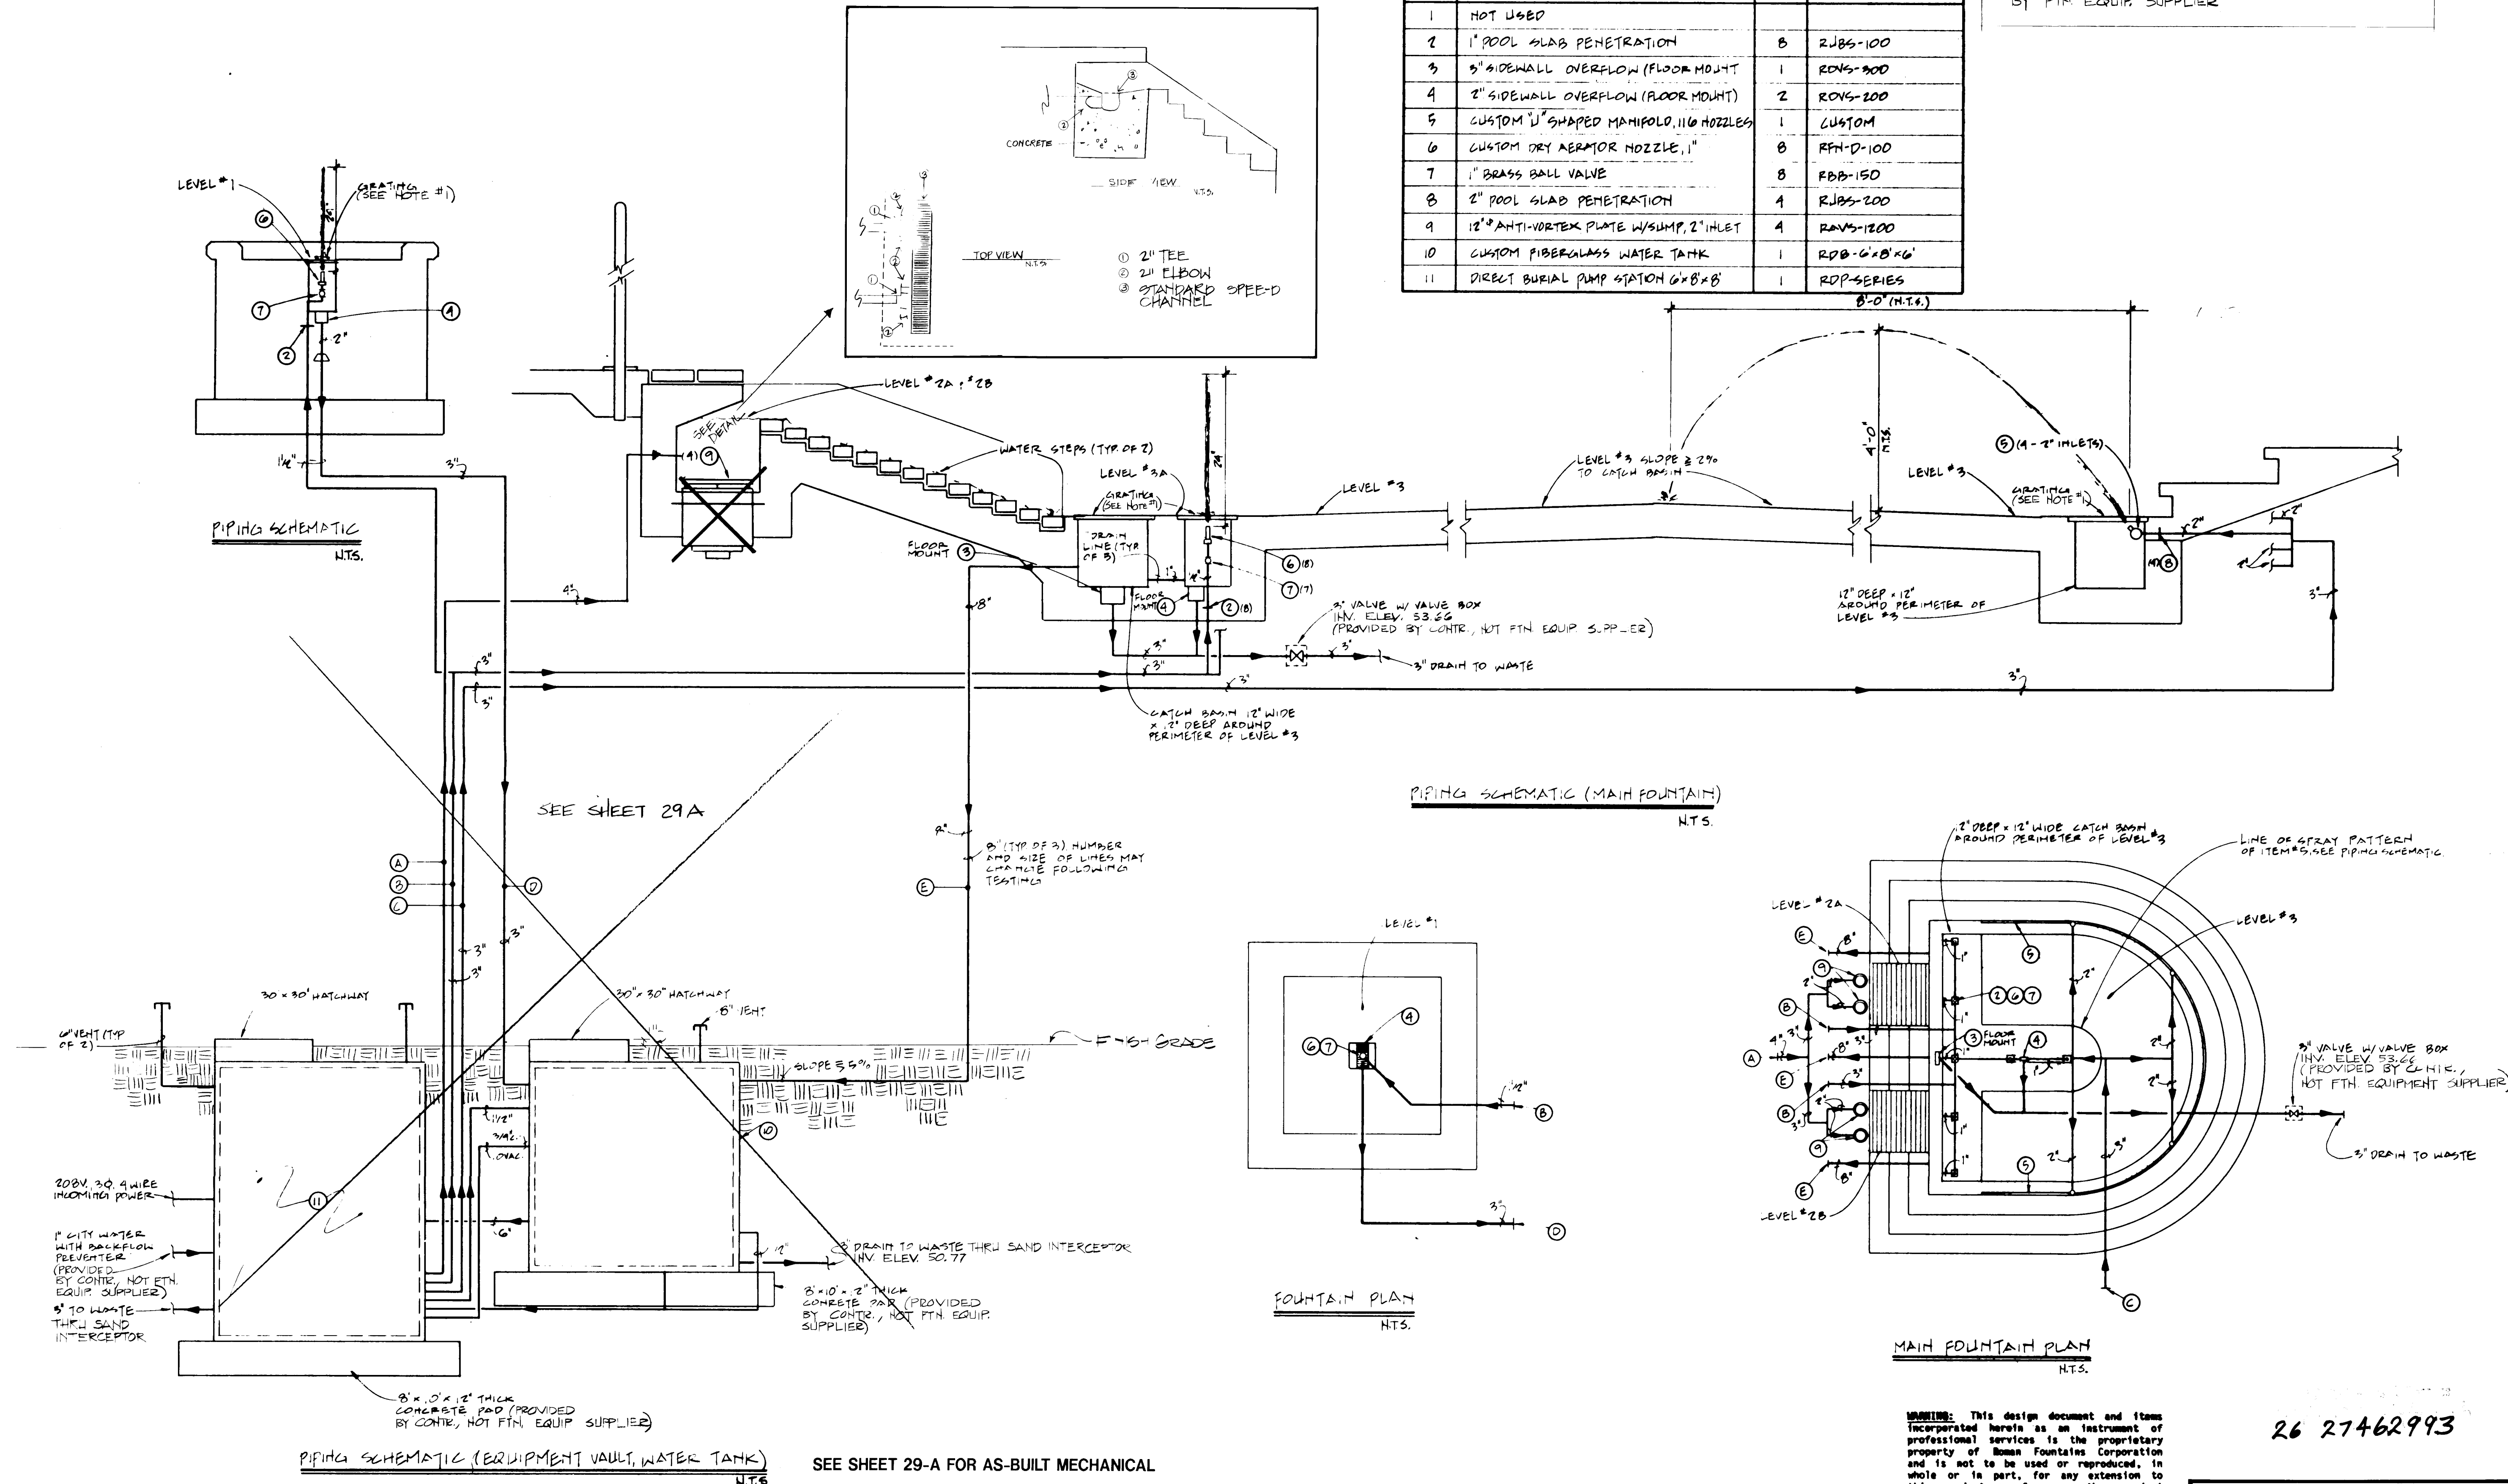

WARNING: This design document and items incorporated herein as an instrument of professional services is the proprietary property of Roman Fountains Corporation and is not to be used or reproduced, in whole or in part, for any extension to this project or for any other project without the express written consent of an officer of Roman Fountains Corporation, Albuquerque, New Mexico. Copyright ©1990.

26 27462993

**CITY OF ALBUQUERQUE
PARKS & RECREATION
DESIGN & DEVELOPMENT**

TITLE: PHIL CHACON PARK PHASES I & II FOUNTAIN MECHANICAL DETAILS					
APPROVALS	ENGINEER	DATE	APPROVALS	ENGINEER	DATE
DRC CHAIRMAN			WATER	R.W. Kane	9-7-99
TRANSPORTATION			WASTE WATER	R.W. Kane	9-7-99
HYDROLOGY	N/A	9/1/99			
<i>Notes</i>	N/A	9/5/99			
PROJECT NO. 2746		MAP NO. L-19		SHEET 29 OF 29	



MORROW & COMPANY
LANDSCAPE ARCHITECTS
 210 La Veta Drive NE
 Albuquerque, New Mexico 87108
 505 268-2266

 roman fountains ALBUQUERQUE, N. M.		
PHIL CHACON PARK ENTRY FOUNTAIN ALBUQUERQUE NEW MEXICO PIPING SCHEMATICS		
PREP BY: RJ CHK BY: CG	SCALE: AS SHOWN	SHEET 101
REV:	DATE: 3/13/90	

