



LAYTON AVE NE

CURVE DATA


CURVE A	CURVE B
$\Delta = 16^\circ 15' 37''$	$\Delta = 180^\circ 00'$
$R = 150.00'$	$R = 13.00'$
$T = 21.43'$	$L = 40.84'$
$L = 42.57'$	

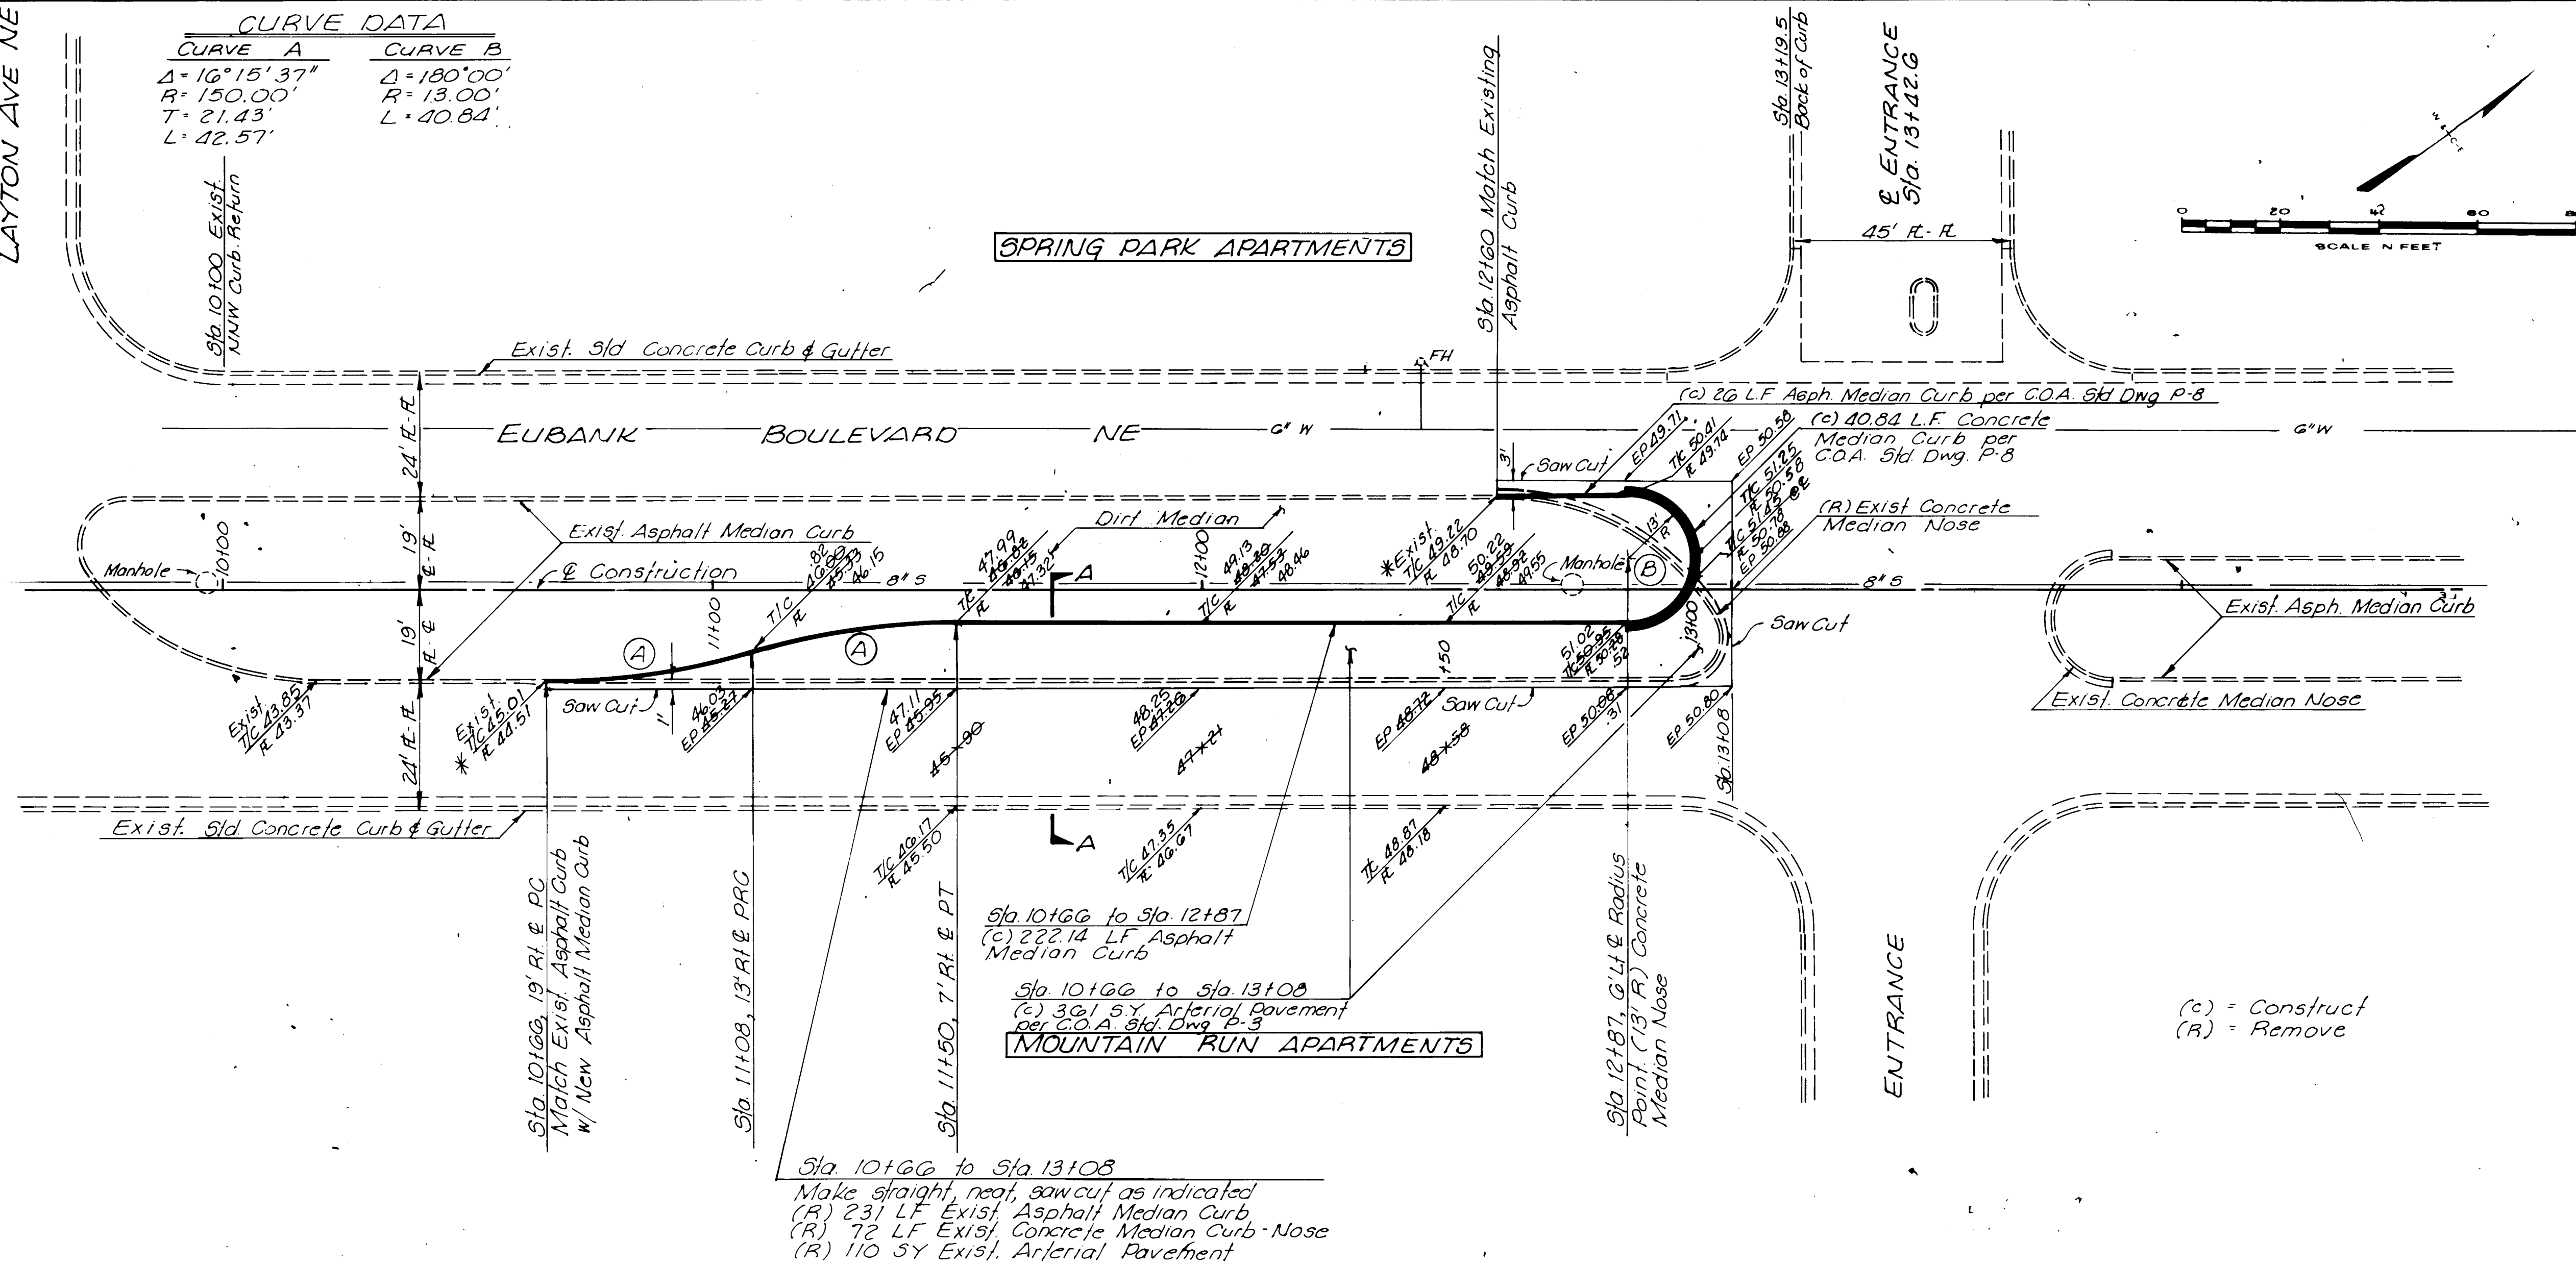


PLAN

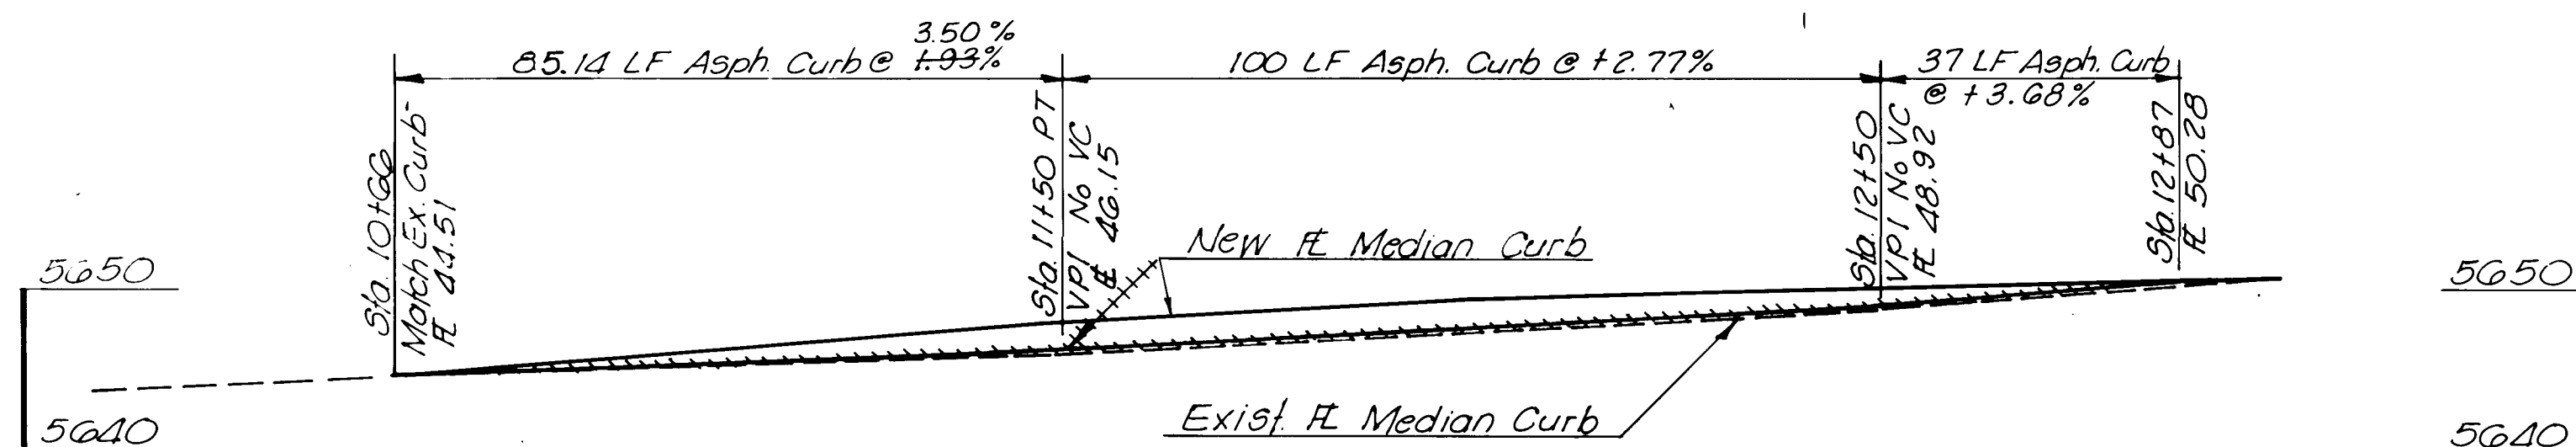

PROFILE

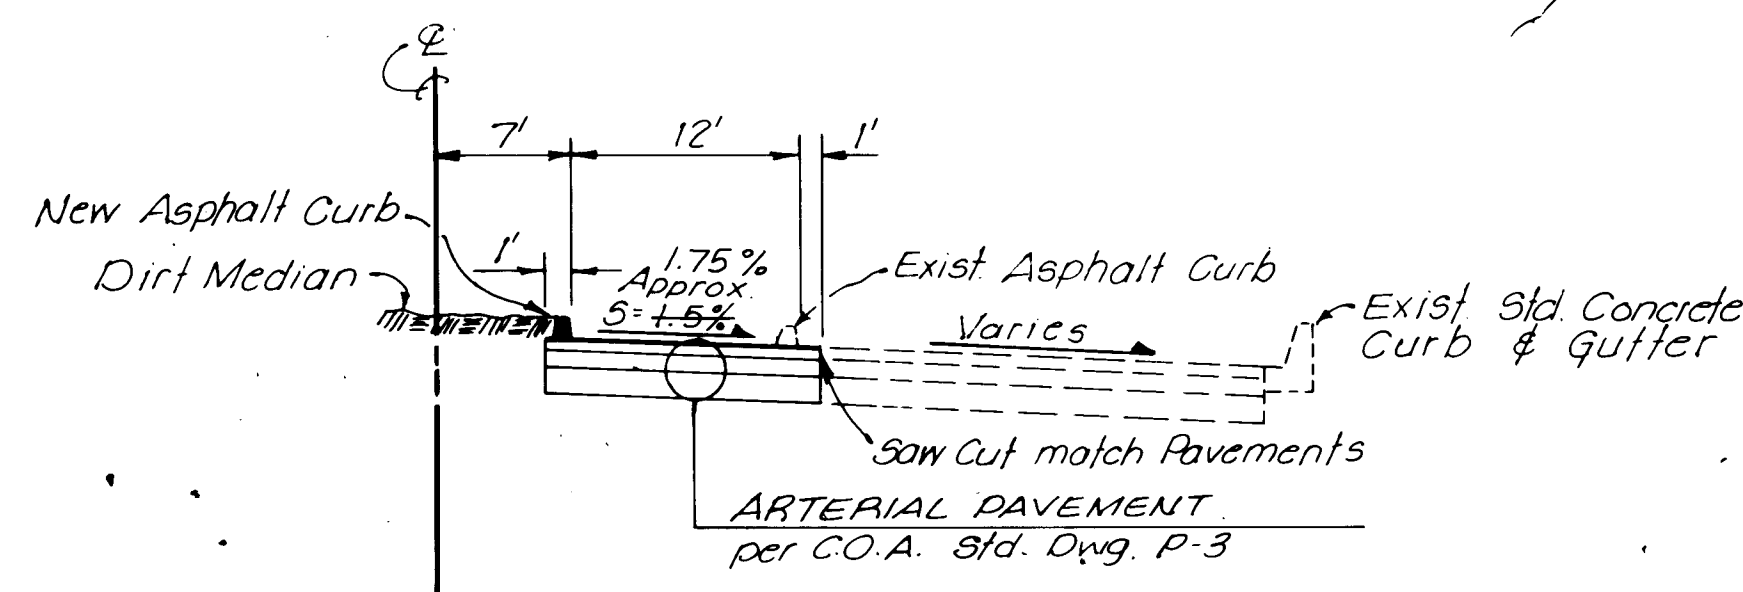

SECTION A-A

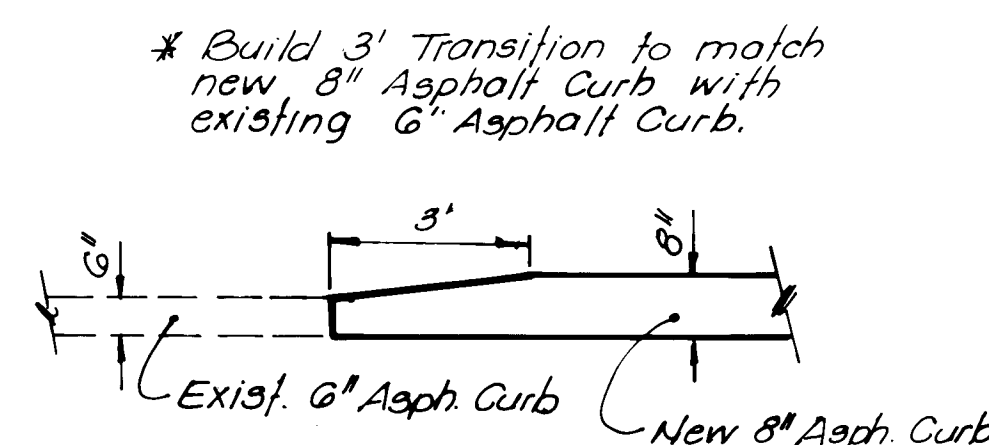

PROFILE

(c) = Construct
(R) = Remove


GENERAL NOTES

- City of Albuquerque Interim Standard Specifications for Public Works Construction, 1985 Edition, will be referred to hereon as "Standard Specifications" for all work done on this project.
- Two working days prior to any excavation, Contractor must contact line locating service, 765-1234 for locating existing utilities.
- Prior to construction, the contractor shall excavate and verify the horizontal and vertical locations of all obstructions. Should a conflict exist, the Contractor shall notify the City Engineer so the conflict can be resolved with a minimum of delay.
- Tack Coat requirements shall be determined by the City Engineer.

AS BUILT INFORMATION	CONTRACTOR	DATE
WORK BY	WCEA	4-86
INSPECTED BY	WCEA	4-86
APPROVED BY	WCEA	4-86
RECORDED BY	WCEA	4-86
DATE		

BENCH MARKS	NO.	DATE
ACS #1-E21-A - Brass Cap in top of West Curb on Eubank Blvd NE, 1380' North of the E of Malaguena Lane NE		
Elevation = 5642.71		

SURVEY INFORMATION	NO.	DATE
FIELD NOTES		

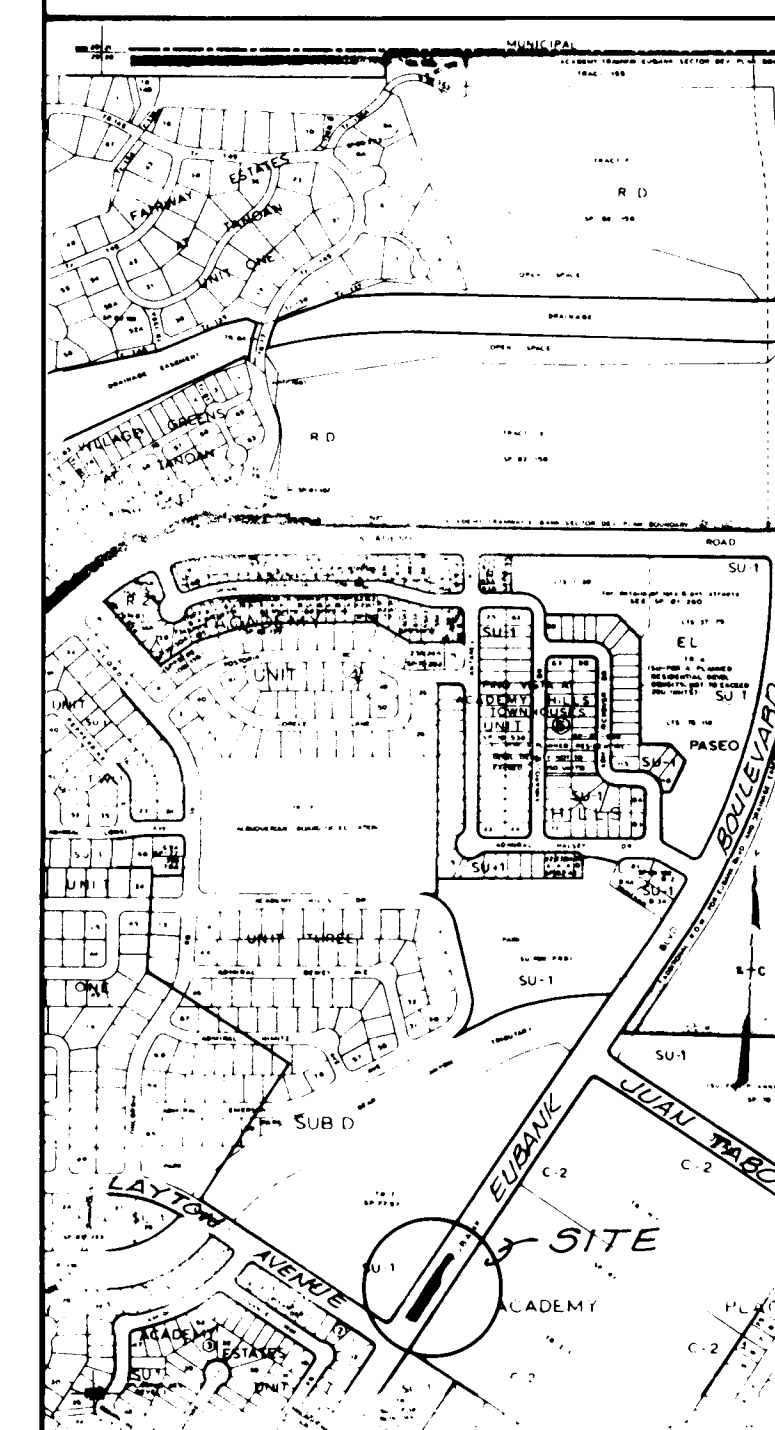

LOCATION MAP

CITY OF ALBUQUERQUE

LEFT TURN LANE - EUBANK BOULEVARD ENTRANCE FOR SPRING PARK APARTMENTS

APPROVALS	ENGINEER	DATE	APPROVALS	ENGINEER	DATE
City Engineer			Liquid Waste		
A.C.E. - Design			Traffic		
A.C.E. - Hydrology			Water		

DRAWING NO.	2747	MAP NO.	E-21-Z	SHEET	1	OF	1
-------------	------	---------	--------	-------	---	----	---

WILSON & COMPANY
ENGINEERS & ARCHITECTS
ALBUQUERQUE, NEW MEXICO

83-518

RECORD DRAWING
DATE 6/86

26 27470186