


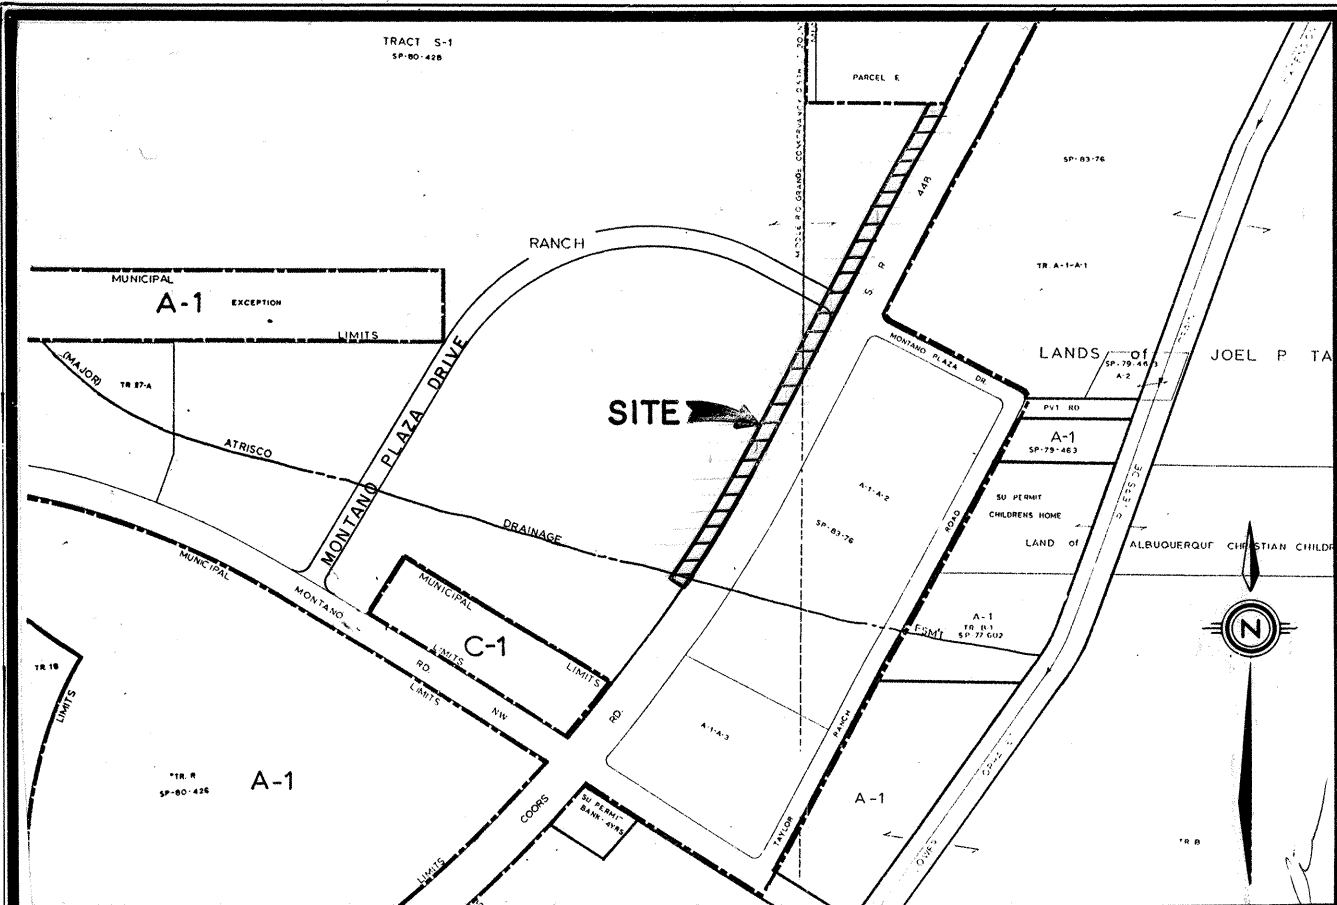

VICINITY MAP
SCALE: 1" = 800'

ZONE ATLAS E-12-Z

COORS / MONTANO DRAINAGE DETENTION FACILITY

INDEX TO SHEETS

SHEET NO.	DESCRIPTION
1	COVER SHEET & INDEX TO DRAWINGS
2-3	PLATS OF GEOMETRY
4	POND GRADING PLAN
5-6	OUTFLOW PLAN & PROFILES
7-8	DIVERSION SWALE GRADING PLANS
9-13	CONSTRUCTION DETAILS
14	REVEGETATION PLAN

GENERAL NOTES:

- ALL WORK DETAILED ON THESE PLANS TO BE PERFORMED UNDER CONTRACT SHALL, EXCEPT AS OTHERWISE STATED OR PROVIDED FOR HEREON, BE CONSTRUCTED IN ACCORDANCE WITH THE CITY OF ALBUQUERQUE INTERIM STANDARD SPECIFICATIONS FOR PUBLIC WORKS CONSTRUCTION, 1985 (REFERRED TO HEREIN AS THE STANDARD SPECIFICATIONS).
- TWO (2) WORKING DAYS PRIOR TO ANY EXCAVATION, CONTRACTOR MUST CONTACT LINE LOCATING SERVICE, 765-1234, FOR LOCATION OF EXISTING UTILITIES.
- PRIOR TO CONSTRUCTION, THE CONTRACTOR SHALL EXCAVATE AND VERIFY THE HORIZONTAL AND VERTICAL LOCATION OF ALL OBSTRUCTIONS. SHOULD A CONFLICT EXIST, THE CONTRACTOR SHALL NOTIFY THE ENGINEER OR SURVEYOR SO THAT THE CONFLICT CAN BE RESOLVED WITH MINIMUM AMOUNT OF DELAY.
- ALL BACKFILL COMPACTION SHALL BE 90% (ASTM 1557) UNLESS OTHERWISE NOTED.
- ALL CORRUGATED METAL PIPE SHALL BE 16 GAUGE WITH 2 2/3" X 1/2" CORRUGATIONS UNLESS OTHERWISE NOTED.
- ALL STEEL CONSTRUCTION SHALL BE STRUCTURAL GRADE STEEL, CLASS A36.
- AFTER CLEANING SURFACE OF SCALE, RUST, OILS, ETC., PAINT STEEL WITH ONE SHOP COAT RED OXIDE, TWO FINISH COATS ALUMINUM PAINT (AASHTO M69).
- ANY CORRUGATED METAL PIPE BURNED BY WELDING OR OTHERWISE DAMAGED BY FABRICATION OR INSTALLATION SHALL BE RECOATED WITH ZINC OXIDE PAINT PER AASHTO M36.
- ALL CORRUGATED METAL PIPE BENDS AND FITTINGS SHALL BE FACTORY FABRICATED AND FACTORY GALVANIZED.

Coors/Montano
Drainage Detention Facility
2759

APPROVAL OF AS BUILT DRAWINGS
CHIEF CONSTRUCTION ENGINEER
Russell B. Smith
DATE 12-22-87

1 2 3 4 5 6 7 8 9 10 11 12
26 27 59 01 87

REV.	SHEETS	CITY ENGINEER	DATE	USER	DEPARTMENT	DATE	USER	DEPARTMENT	DATE
APPROVAL OF REVISIONS									

ENGINEER'S SEAL <i>Russell B. Smith</i> 3/4/86	DATE: DEC., 1985 SCALE: AS NOTED DESIGNED: M.J.Y. DRAWN: C.S.S. JOB NO: 73-36-PRE PROJECT NO. 2759	community sciences corporation LAND PLANNING ENGINEERING SURVEYING P.O. Box 1324 Corrales, New Mexico 87108	APPROVED FOR CONSTRUCTION <i>Russell B. Smith</i> CITY ENGINEER DATE 6/12/86 SHEET 1 OF 14
--	---	---	--

*CORRECTED
SUMMARY PLAT FOR
TRACTS 22A, 24, 27A3, 27B,
30A, 30B, 32, 33, 34, AND 35
TAYLOR RANCH

WITHIN SECTIONS 23, 25, AND 26, T11N, R2E, N.M.P.M.
ALBUQUERQUE, NEW MEXICO

A REPLAT OF
TRACTS S-1-C, S-2, AND S-3, TAYLOR RANCH
WITHIN SECTIONS 23, 25, AND 26, T11N, R2E, N.M.P.M.
BERNALILLO COUNTY, NEW MEXICO
APRIL, 1983

* THE PURPOSE FOR RECORDING
THIS PLAT IS TO CORRECT THE
DIMENSION SHOWN ON THE NORTH
LINE OF TRACT 32 TO 730.46
FEET FROM INCORRECT DIMENSION
OF 728.37 FEET.

TRACT NO.	ZONING	PERMITTED DWELLING UNITS PER GROSS ACRE
22A	SU-1	60
27-A3	SU-4	200
27-B	SU-1	200
30B	CHURCH	200
32	SU-1	120
33	SU-1	30
34	R-1	30
35	R-2	200

THE PURPOSE OF THIS PLAT IS TO LOCATE
THE ZONINGS RELATED THERETO.

PURSUANT TO SECTION 7 OF THE CITY OF ALBUQUERQUE, NEW MEXICO
SUBDIVISION ORDINANCE, A VARIANCE OR WAIVER FROM CERTAIN
SUBDIVISION REQUIREMENTS HAS BEEN GRANTED BY THE CITY AND THE
ALBUQUERQUE METROPOLITAN FLOOD CONTROL AUTHORITY IN CONNECTION
WITH THIS PLAT.

FUTURE SUBDIVISION OF LANDS WITHIN THIS PLAT, SITE DEVELOPMENT
PLAN APPROVALS AND DEVELOPMENT PERMITS MAY BE CONDITIONED UPON
DEDICATION OF RIGHTS-OF-WAY AND EASEMENTS, AND/OR UPON
INFRASTRUCTURE IMPROVEMENTS BY THE OWNER FOR WATER, SANITARY
SEWER, STREETS, DRAINAGE, GRADING AND PARKS IN ACCORDANCE WITH
CURRENT RESOLUTIONS, ORDINANCES AND POLICIES IN EFFECT AT THE
TIME FOR ANY SPECIFIC PROPOSAL.


CERTAIN EASEMENTS FOR ACCESS, UTILITIES AND DRAINAGE CONTROL,
WHICH MAY BE SHOWN HEREON, MAY BE MODIFIED, REPLACED OR REMOVED,
AT THE OPTION OF THE CITY OF ALBUQUERQUE, PENDING FUTURE PLATTING
AND SUBMITTALS WHICH CONFORM TO A MORE COMPLETE OR IMPROVED
ROUTING OF THOSE FACILITIES. THE RIGHTS HEREBY GRANTED, HOWEVER,
ARE TO REMAIN UNTIL SUCH SUBSEQUENT MODIFICATION OF LOCATION
AND PURPOSE, IF ANY.

BY ITS APPROVAL, THE CITY MAKES NO REPRESENTATION OR WARRANTIES
AS TO THE AVAILABILITY OF UTILITIES OR FINAL APPROVAL OF ALL
REQUIREMENTS INCLUDING, (BUT NOT LIMITED TO) THE FOLLOWING ITEMS:

WATER AND SANITARY SEWER AVAILABILITY.
FUTURE STREET DEDICATIONS AND/OR IMPROVEMENTS.
PARK AND OPEN SPACE REQUIREMENTS.
DRAINAGE REQUIREMENTS AND/OR IMPROVEMENTS.
EXCAVATION, FILLING OR GRADING REQUIREMENTS.

ANY PERSON INTENDING DEVELOPMENT OF LANDS WITHIN THESE
SUBDIVISION IS CAUTIONED TO INVESTIGATE THE STATUS OF THESE
ITEMS.

IT IS UNDERSTOOD THAT A SEPARATE NOTICE OF THESE CONDITIONS
IS TO BE RECORDED WITH THE COUNTY CLERK AT THE TIME OF FINAL
PLAT RECORDING.

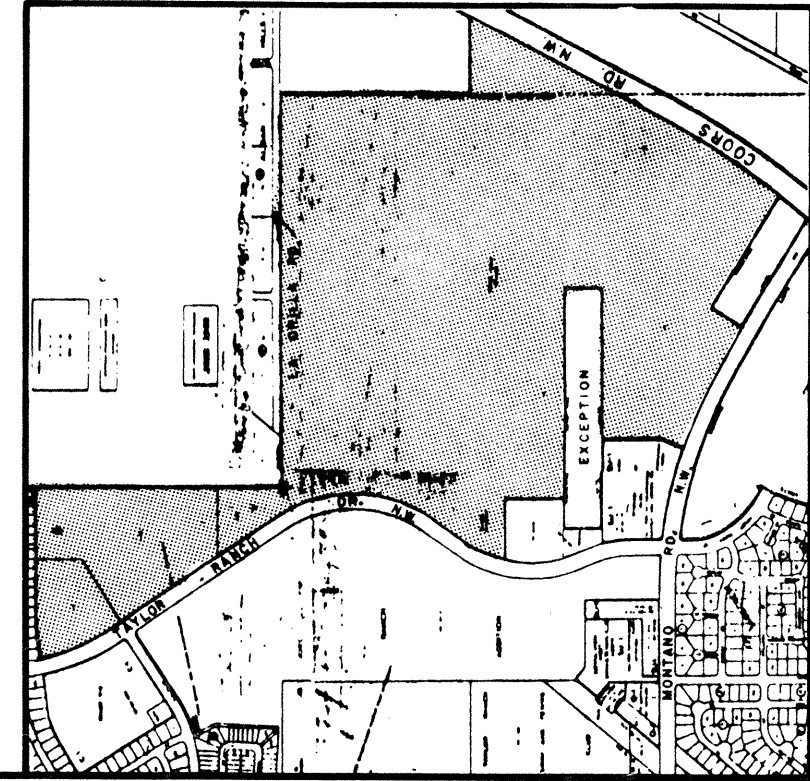

VICINITY
MAP

ZONE
ATLAS

0-11-Z
E-12-Z

LEGEND

- SET PERMANENT MONUMENT
- 1/4 CORNER MONUMENT

CURVE	Δ	RADIUS	LENGTH	TANGENT
1	20°41'28"	953.00	38.84	19.64
2	04°22'44"	593.00	72.85	36.43
3	04°22'44"	593.00	73.54	36.79
4	26°21'52"	953.00	439.43	223.16
5	89°52'11"	25.00	36.63	22.49
6	12°07'16"	735.87	195.68	78.13
7	87°29'02"	25.00	36.24	24.00
8	24°20'33"	638.87	270.22	137.18
9	26°25'14"	688.87	316.27	161.00


CURVE	Δ	RADIUS	LENGTH	TANGENT
10	20°41'28"	953.00	38.84	19.64
11	04°22'44"	593.00	72.85	36.43
12	04°22'44"	593.00	73.54	36.79
13	26°21'52"	953.00	439.43	223.16
14	89°52'11"	25.00	36.63	22.49
15	12°07'16"	735.87	195.68	78.13
16	87°29'02"	25.00	36.24	24.00
17	24°20'33"	638.87	270.22	137.18
18	26°25'14"	688.87	316.27	161.00

NOTE: RECORDING OF THIS PLAT DOES NOT ASSURE AVAILABILITY
OF WATER AND SEWER SERVICES, WATER AND SEWER SERVICE
EASEMENTS WILL BE CONSIDERED ON A TRACT BY TRACT
BASIS.

NOTE: APPROVAL AND RECORDING OF THIS PLAT WITH THE COUNTY
CLERK OF BERNALILLO COUNTY DOES NOT VACATE OR IN
ANY WAY AFFECT PUBLIC OR PRIVATE EASEMENTS.

PLAT & SURVEY BY:
ALBUQUERQUE SURVEYING CO. INC., 2119 MENAUL BLVD. N.E., ALBUQUERQUE, NEW MEXICO 87107

SHEET 1 OF 4

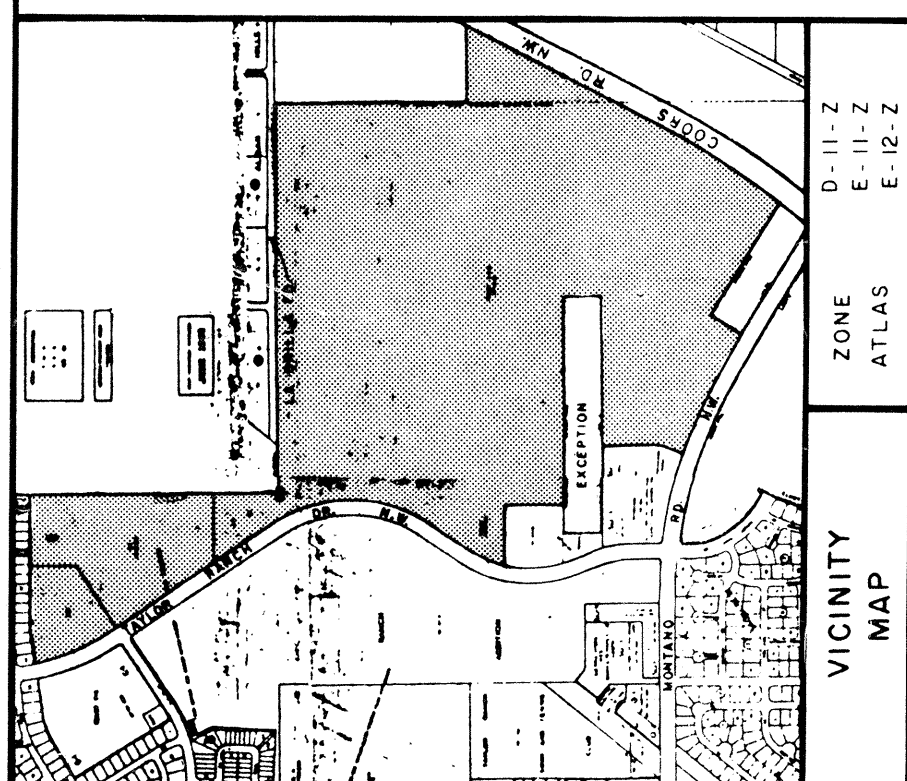

VICINITY
MAP


ZONE
ATLAS

0-11-Z
E-12-Z

*CORRECTED
SUMMARY PLAT FOR
TRACTS 22A, 24, 27A3, 27B,
30A, 30B, 32, 33, 34, AND 35
TAYLOR RANCH


WITHIN SECTIONS 23, 25, AND 26, T11N, R2E, N.M.P.M.
ALBUQUERQUE, NEW MEXICO
A REPLAT OF
TRACTS S-1-C, S-2, AND S-3, TAYLOR RANCH
WITHIN SECTIONS 23, 25, AND 26, T11N, R2E, N.M.P.M.
BERNALILLO COUNTY, NEW MEXICO
APRIL, 1983

* THE PURPOSE FOR RECORDING
THIS PLAT IS TO CORRECT THE
DIMENSION SHOWN ON THE NORTH
LINE OF TRACT 32 TO 730.46
FEET FROM INCORRECT DIMENSION
OF 728.37 FEET.

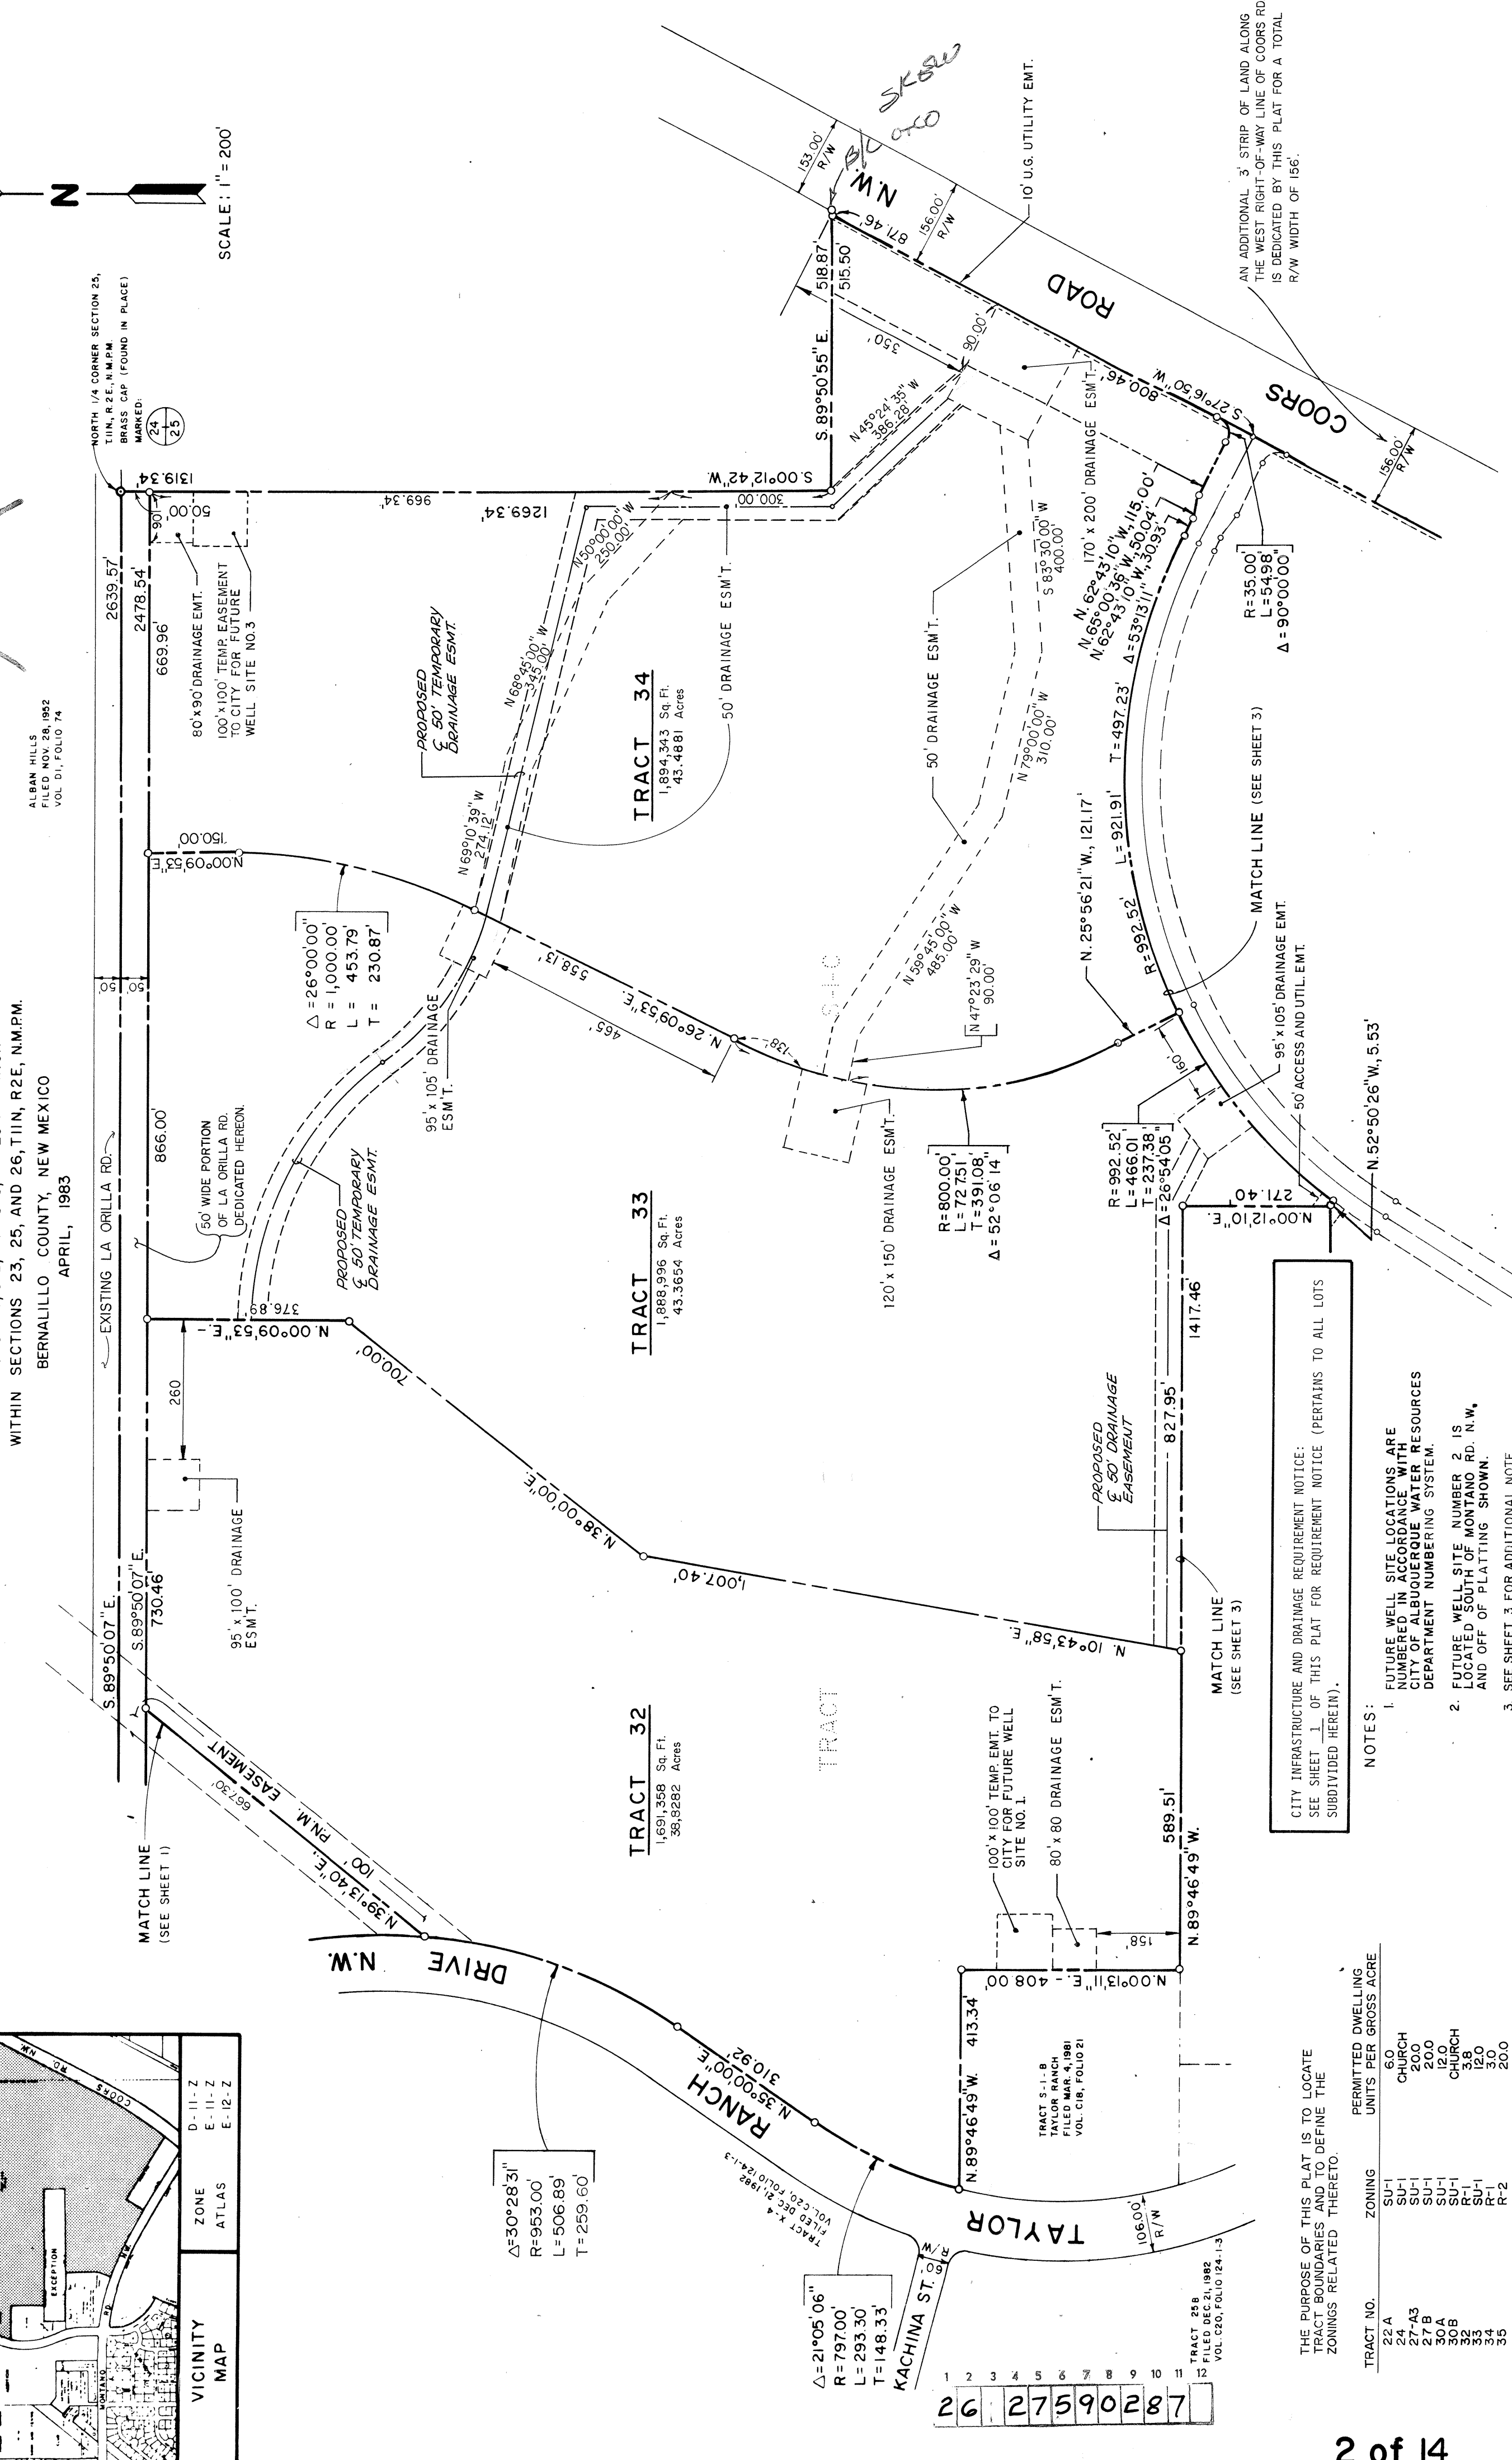


RECORD DRAWING

This drawing as modified shows public improvements as constructed. These modifications have been made using information and measurements obtained by EHA's field survey crew, the Contractor and City Inspector. The modifications conform to the minimum requirements for record drawing criteria as required by the City of Albuquerque per Development Process Manual, Section 27.4 to the best of my knowledge and belief.

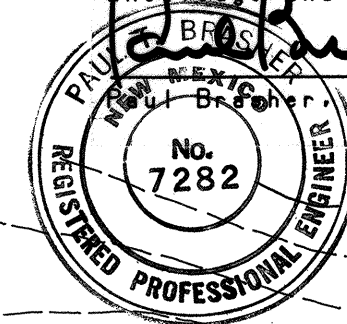

12-16-87
Date


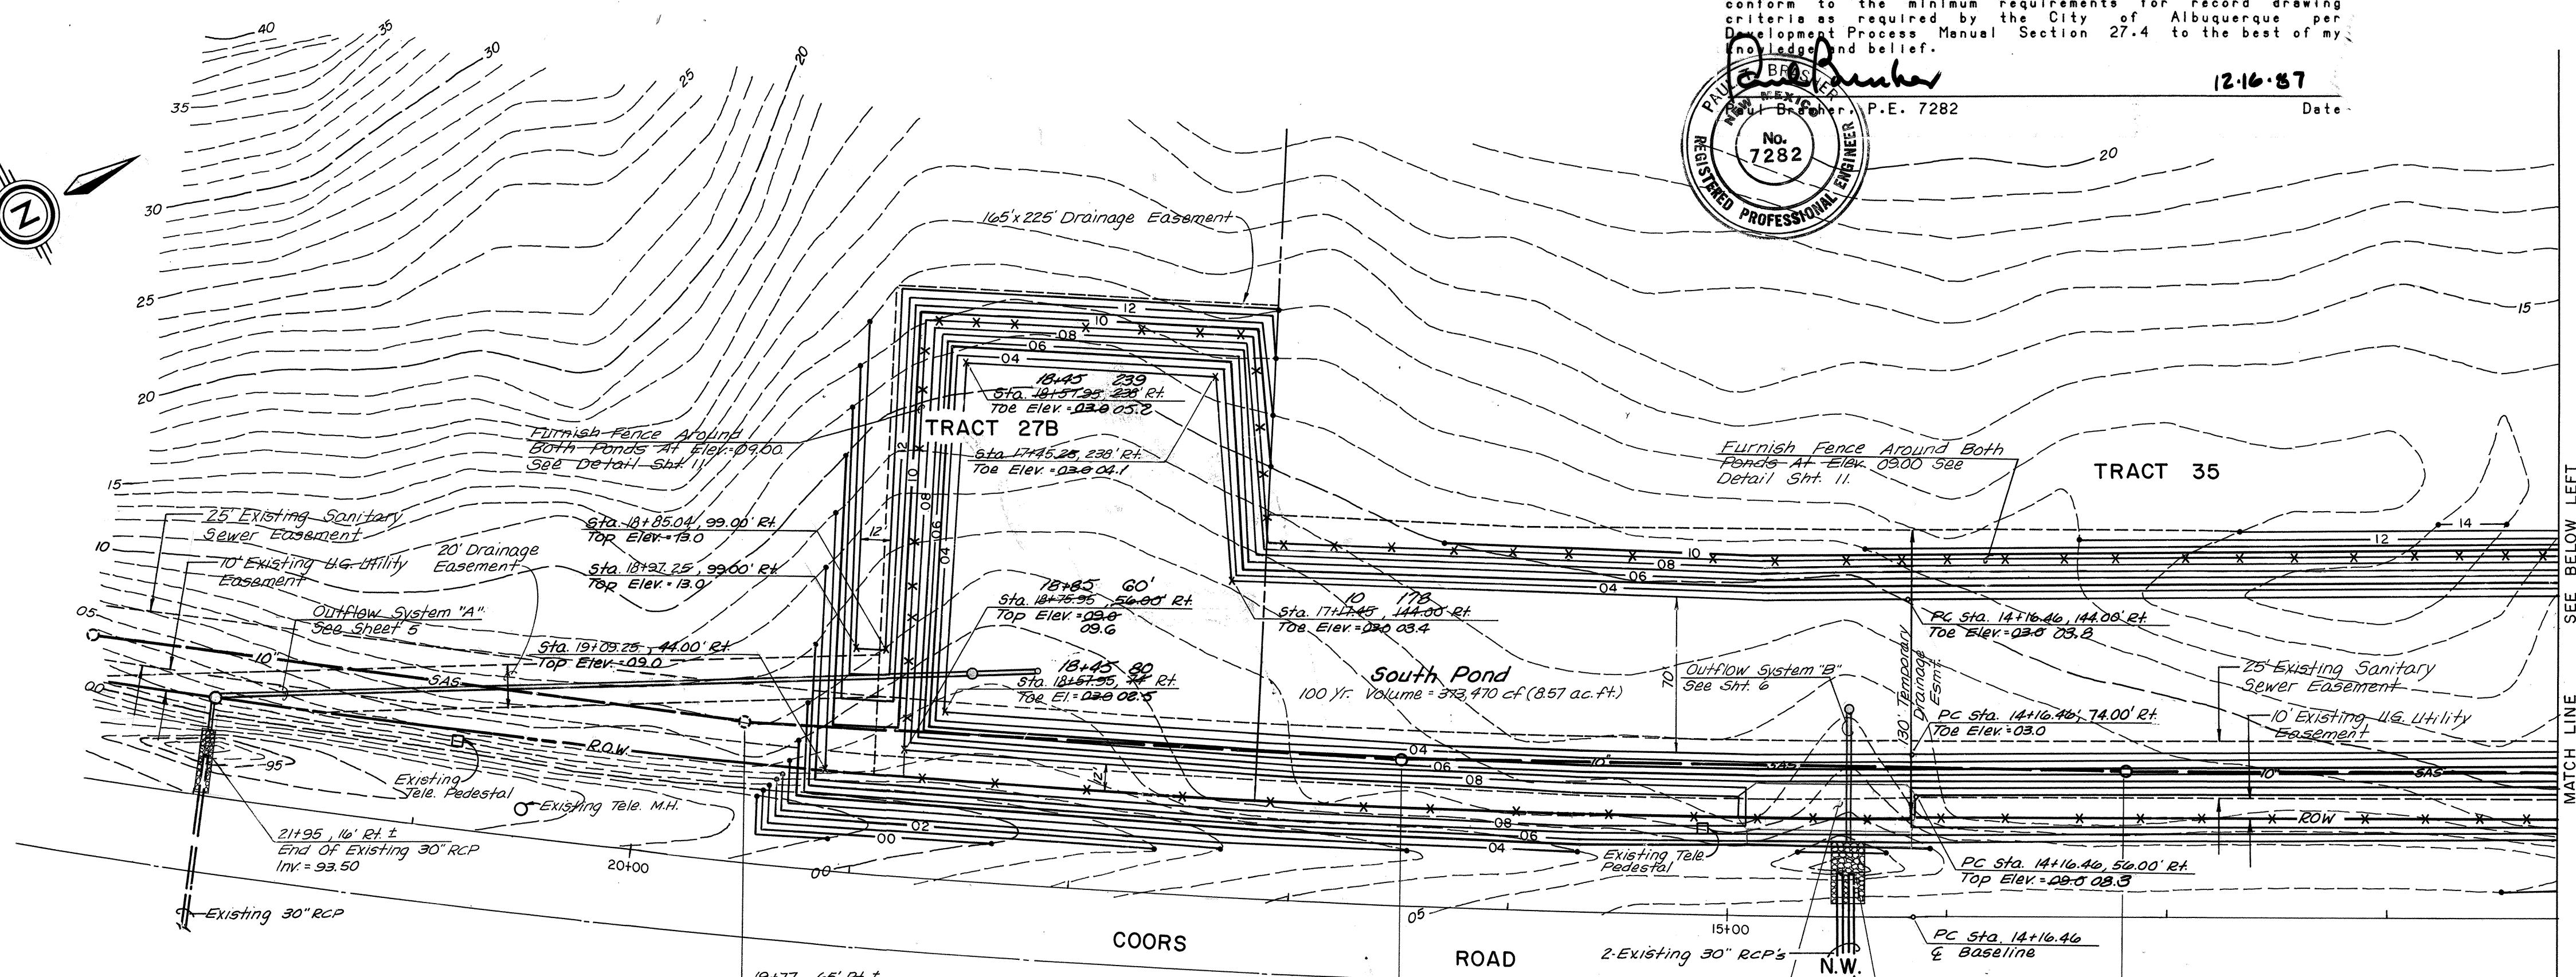


BASILINE CURVE DATA
B=6295.63
L=1046.69
A=10°48'51"

16+73.65' Rt ±
Existing S.A.S. Manhole #2
See Note 3, This Sheet
Existing Rim Elev. = 06.44
Existing Inv. Elev. = 94.22
New Rim Elev. = 07.10
14+25.6 14+75.3
Sta. 14+25.6 To Sta. 14+75.3
Construct Emergency
Spillway Per Detail Sht. 10

Sta. 14+50.18' Rt ±
End of 2-Existing
30" RCP's. Inv. = 02.12

13+19.4
Sta. 13+19.4 65' Rt ±
Existing S.A.S. Manhole #3
See Note 3, This Sht.
Existing Rim Elev. = 03.08.5
Existing Inv. Elev. = 96.52
New Rim Elev. = 07.10

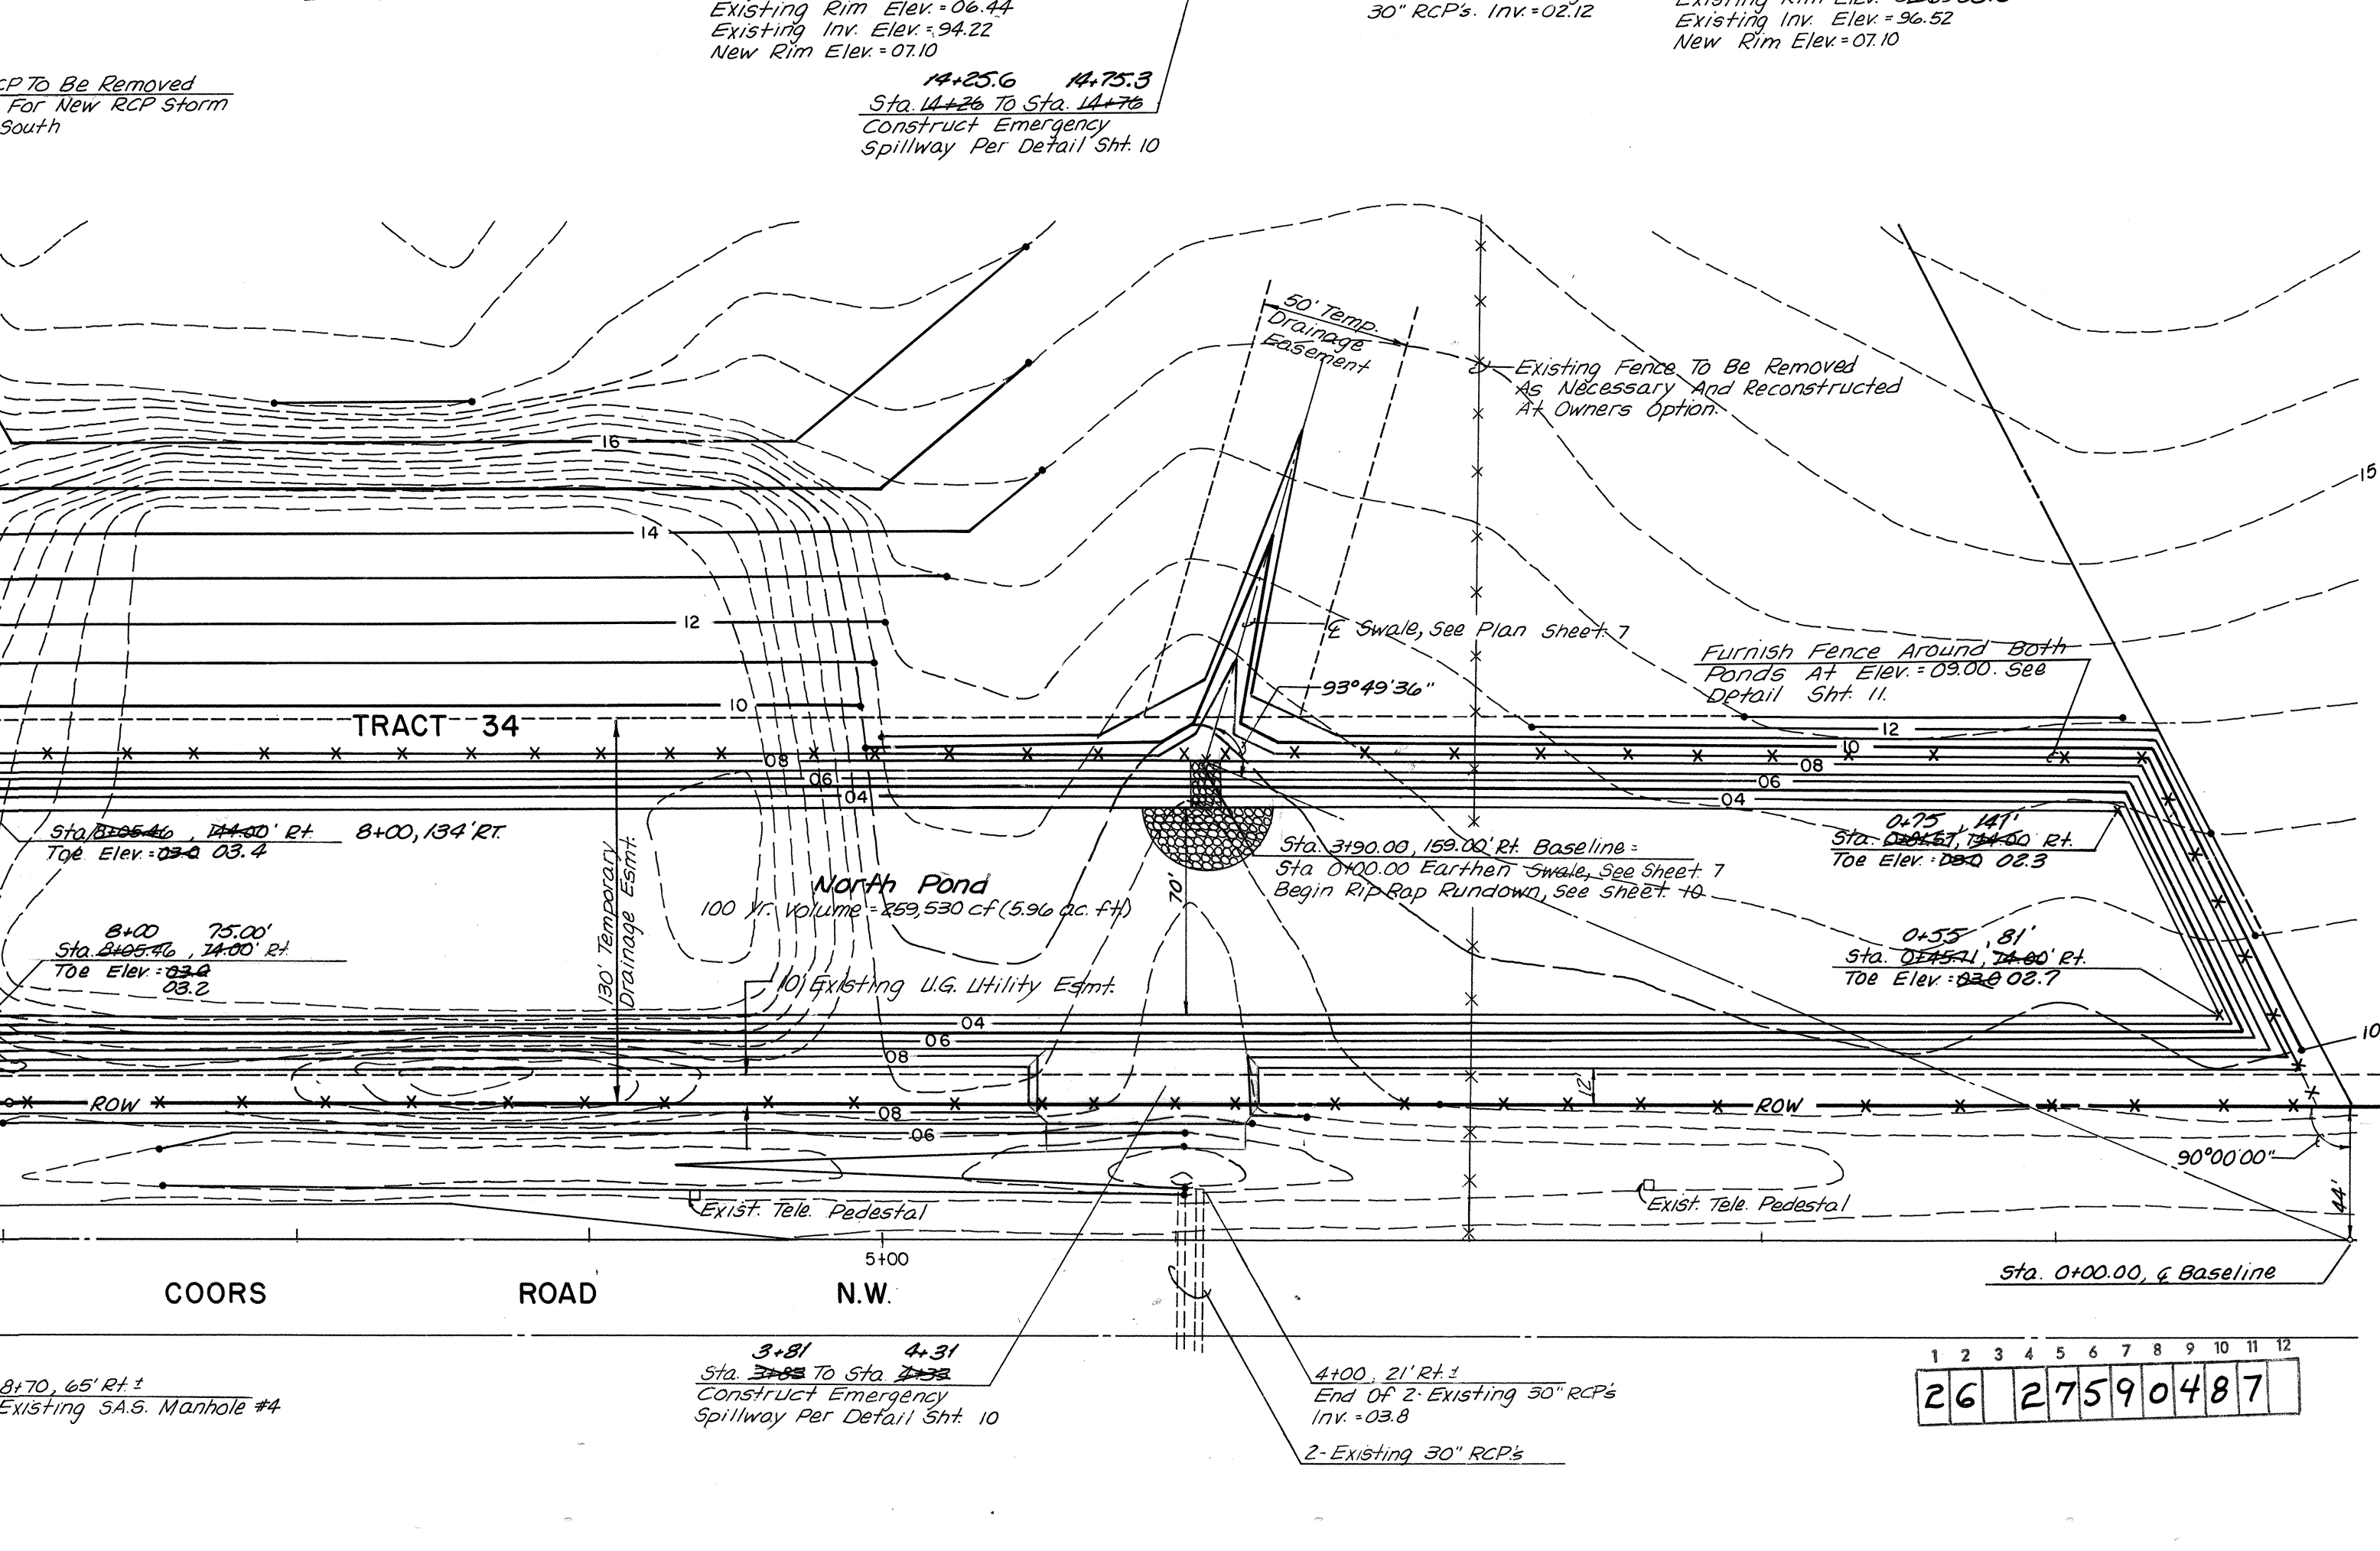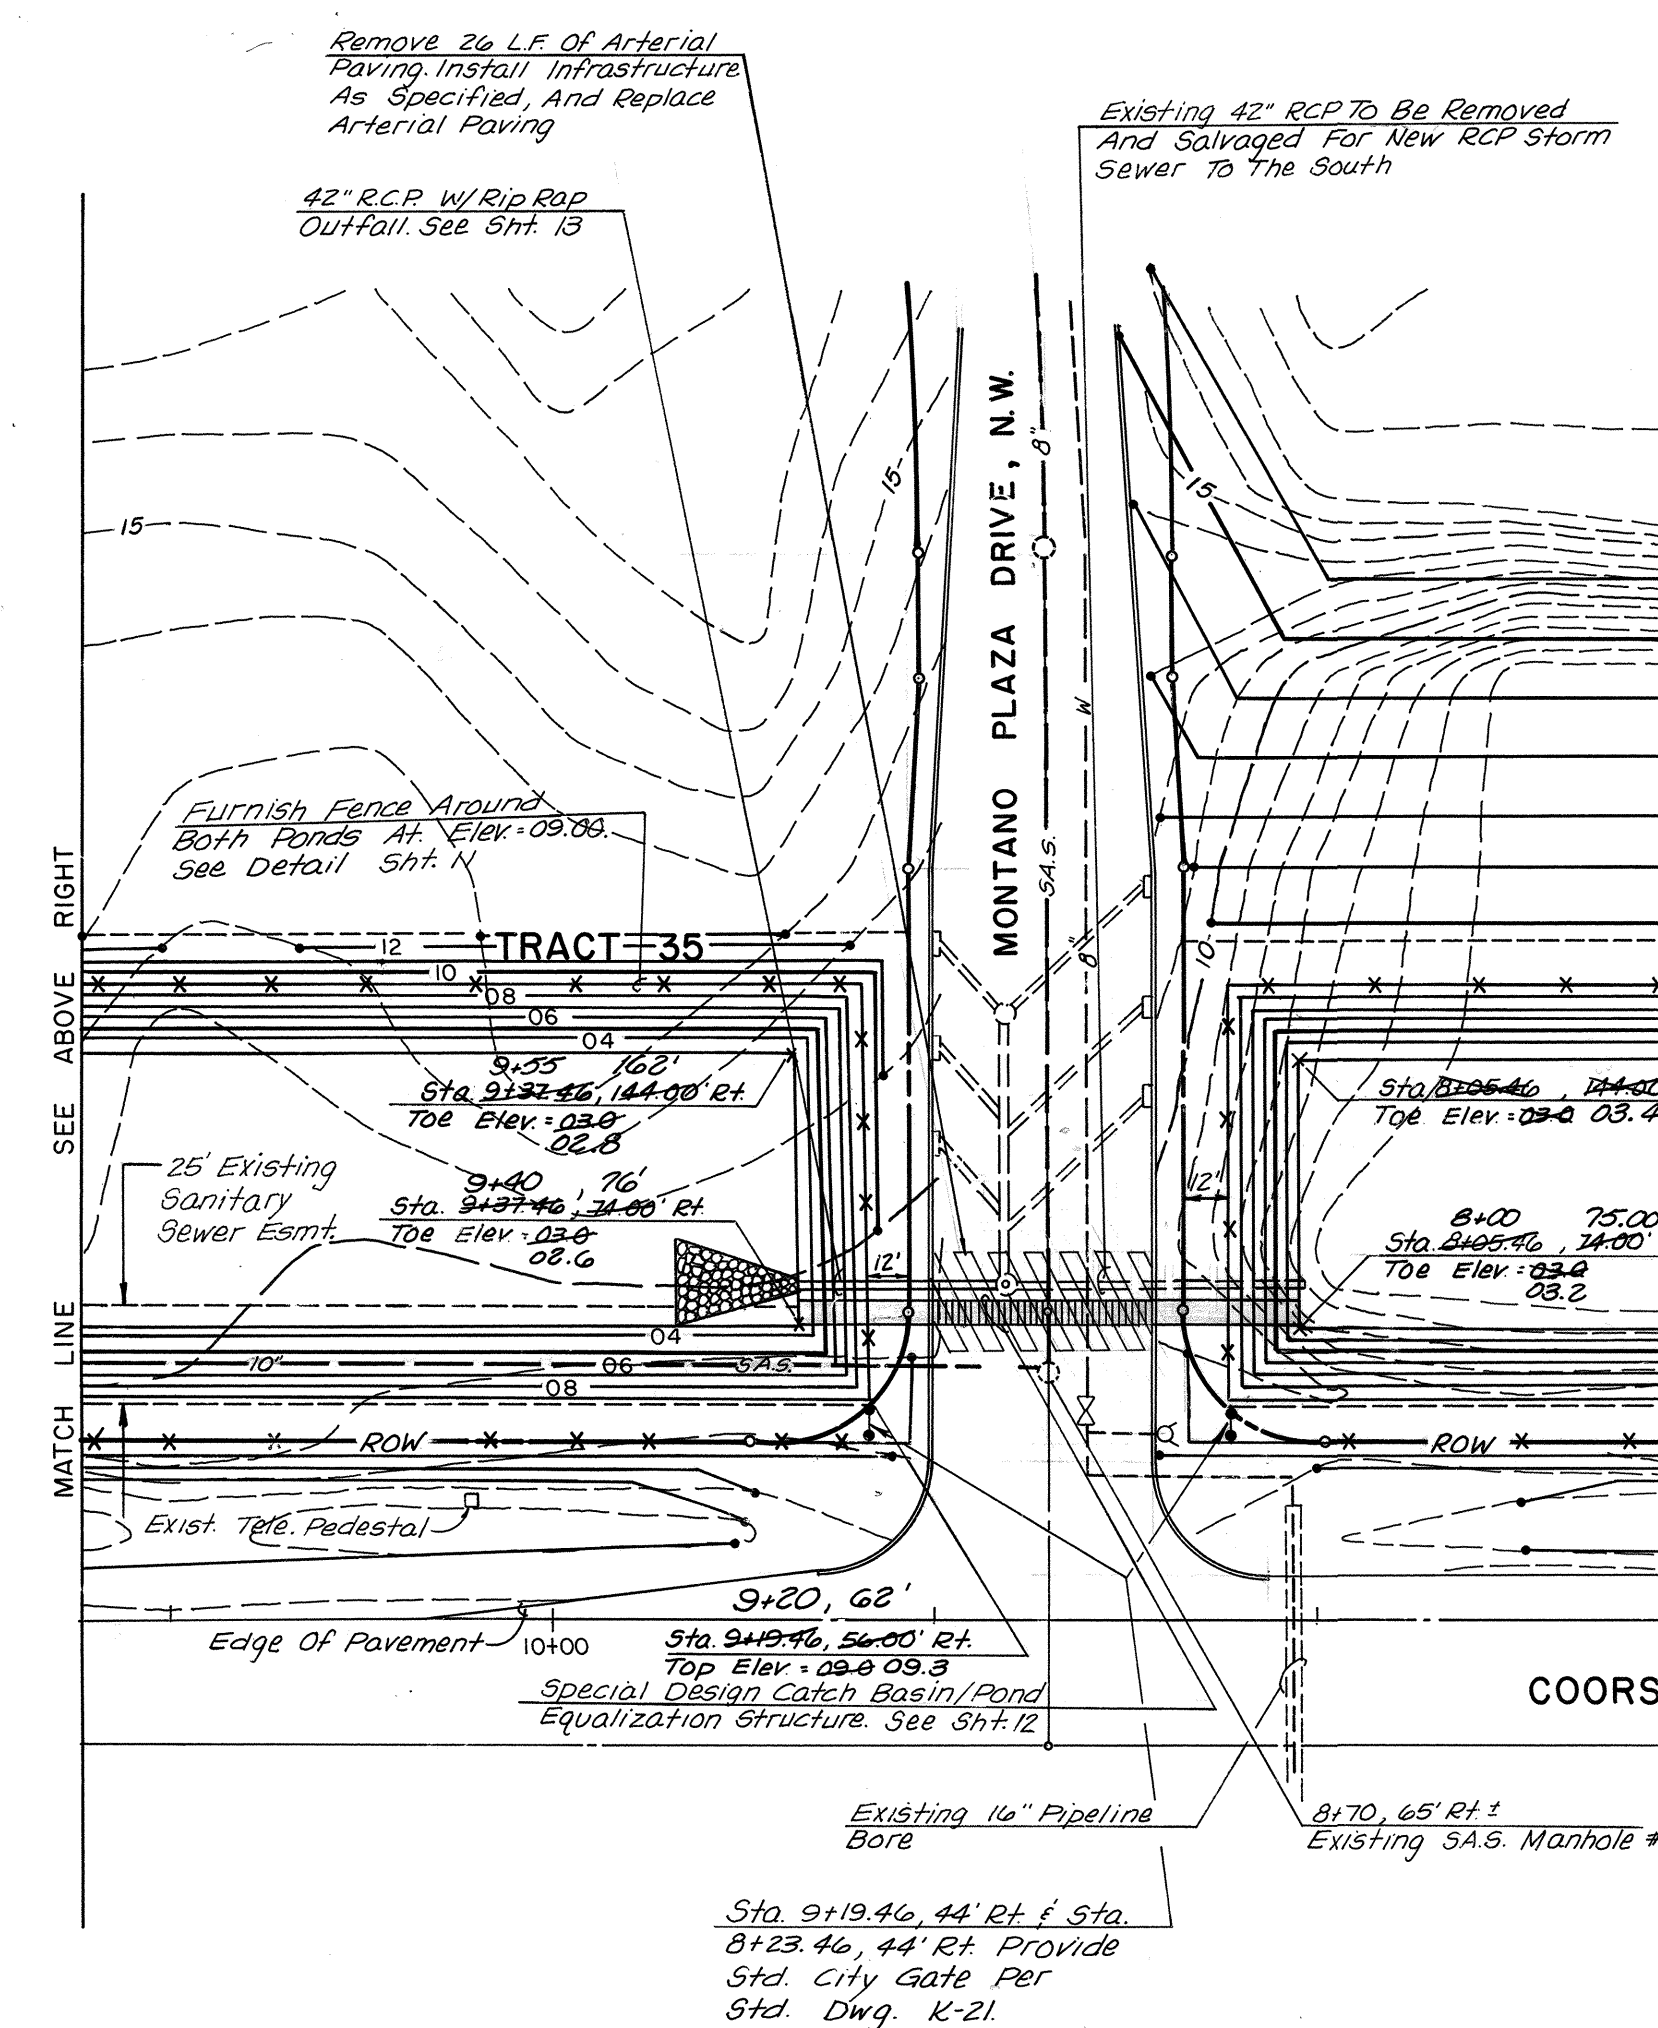

- NOTES:
- BASILINE FOR CONSTRUCTION STAKING IS A LINE PARALLEL TO, AND 44' EAST OF THE WESTERLY COORS ROAD R.O.W. LINE.
 - THERE IS AN EXISTING UNDERGROUND TELEPHONE BETWEEN THE WESTERLY COORS ROAD R.O.W. LINE AND THE WESTERLY EDGE OF PAVEMENT. EXACT LOCATION SHALL BE FIELD VERIFIED PRIOR TO CONSTRUCTION.
 - EXISTING SAS MANHOLES #2 AND #3 SHALL BE RECONSTRUCTED AS NECESSARY TO ACHIEVE A 4' DIA. TYPE "E" MANHOLE WITH RIM ELEVATION @ 5007.10.
 - CONTRACTOR MUST SUBMIT A TRAFFIC CONTROL PLAN AND RECEIVE A BARRICADE PERMIT PRIOR TO CONSTRUCTION IN MONTANO PLAZA DR.

BENCH MARKS		AS BUILT INFORMATION	
NO.	DATE	CONTRACTOR	DATE
267	10/14/87	CONTRACTOR	DATE
APPROXIMATELY 100 FEET NORTHEAST OF THE INTERSECTION OF COORS ROAD, N.W. (STATE ROAD #448) AND MONTANO ROAD, N.W., ON THE EAST RIGHT-OF-WAY. ELEVATION = 5005.143.		CONTRACTOR	DATE

ADMINISTRATIVE
DEVELOPMENT PLAN AMENDMENT
FILE NO. 780-74

3/14/86
PLANNING DIRECTOR DATE

LEGEND

EXISTING CONTOUR LINES AT 1' INTERVALS

PROPOSED CONTOUR LINES AT 1' INTERVALS

SCALE: 1" = 50'

community sciences corporation


CITY OF ALBUQUERQUE
MUNICIPAL DEVELOPMENT DEPARTMENT
ENGINEERING DIVISION




TITLE: COORS/MONTANO DRAINAGE DETENTION FACILITY

PCND GRADING PLAN

APPROVALS	ENGINEER	DATE	APPROVALS	ENGINEER	DATE
City Engineer	for	4/17/86	Planning		
A.C.E.-Design			Traffic	N/A	2-14-86
A.C.E.-Hydrology			Water Utilities	N/A	3-14-86

DRAWING NO. 2759 MAP NO. E-12 SHEET 4 OF 14

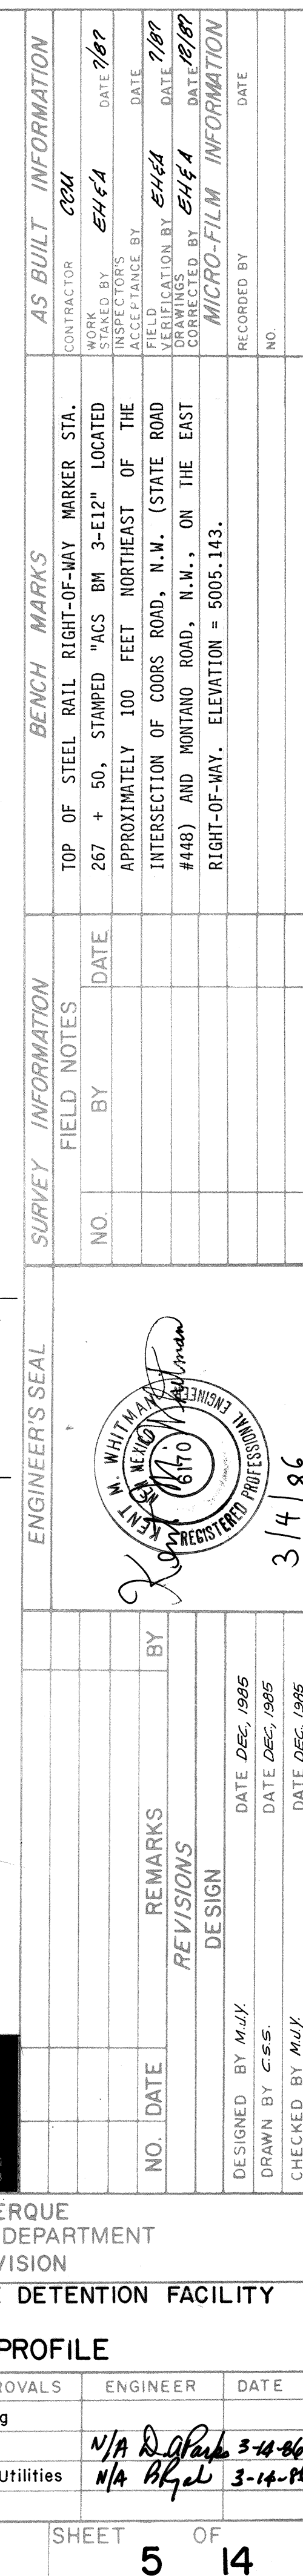

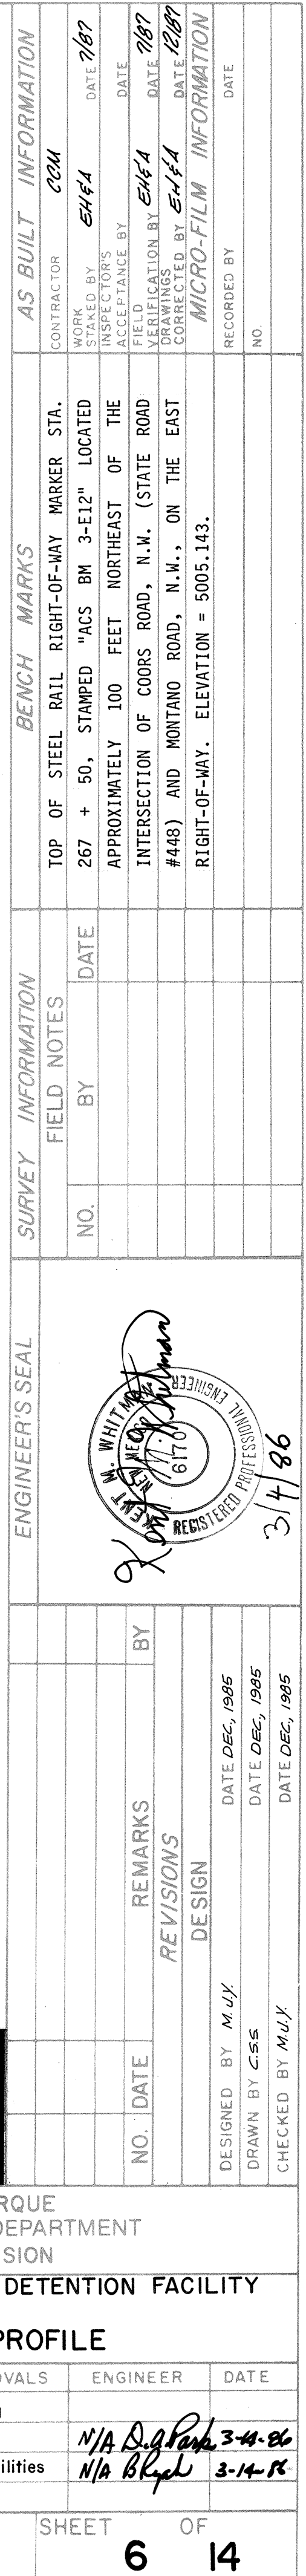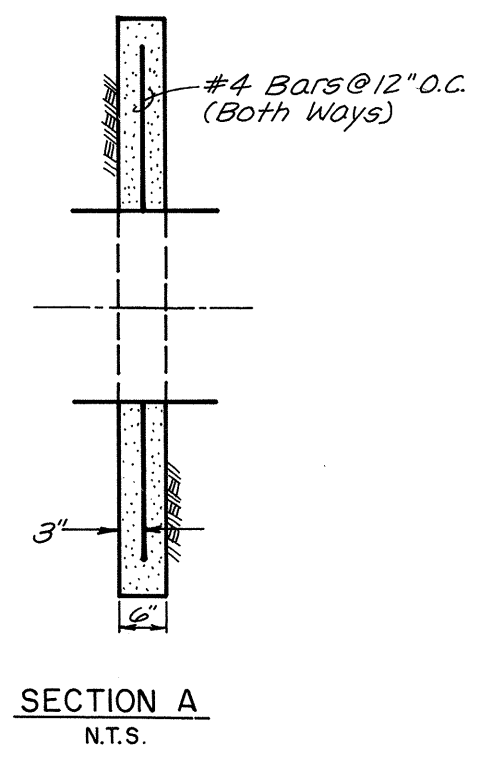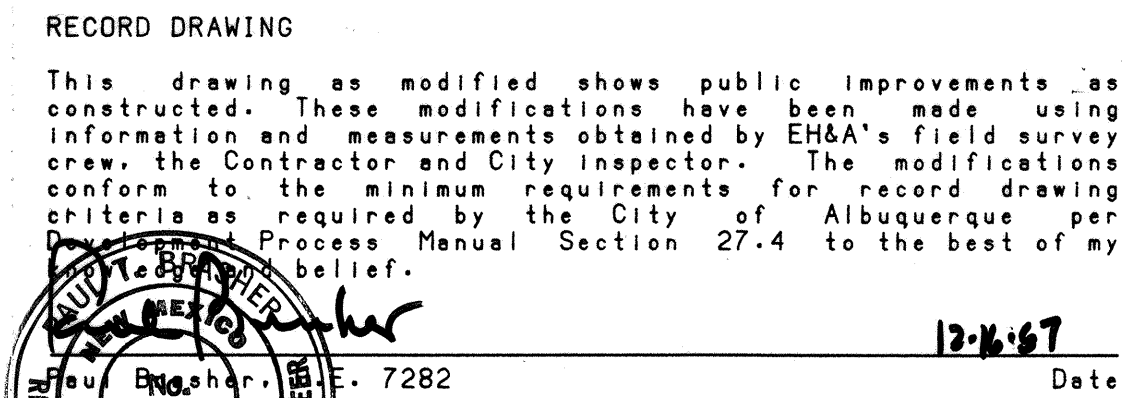

1	2	3	4	5	6	7	8	9	10	11	12
2	6			2	7	5	9	0	6	8	7

SCALE:
1" = 20' HOR.
1" = 5' VER.

community
sciences
corporation

LAND PLANNING ENGINEERING SURVEYING
P.O. Box 1328 Corrales, N.M. 87048


CITY OF ALBUQUERQUE
MUNICIPAL DEVELOPMENT DEPARTMENT
ENGINEERING DIVISION

TITLE: COORS/MONTANO DRAINAGE DETENTION FACILITY

OUTFLOW PLAN & PROFILE

APPROVALS	ENGINEER	DATE	APPROVALS	ENGINEER	DATE
City Engineer	<i>[Signature]</i>	4/13/06	Planning		
A.C.E.-Design	"	"	Traffic	N/A <i>[Signature]</i>	3-4-06
A.C.E.-Hydrology	"	"	Water Utilities	N/A <i>[Signature]</i>	3-14-06






DRAWING NO.	2759	MAP NO.	E-12	SHEET	6	OF	14
-------------	------	---------	------	-------	---	----	----

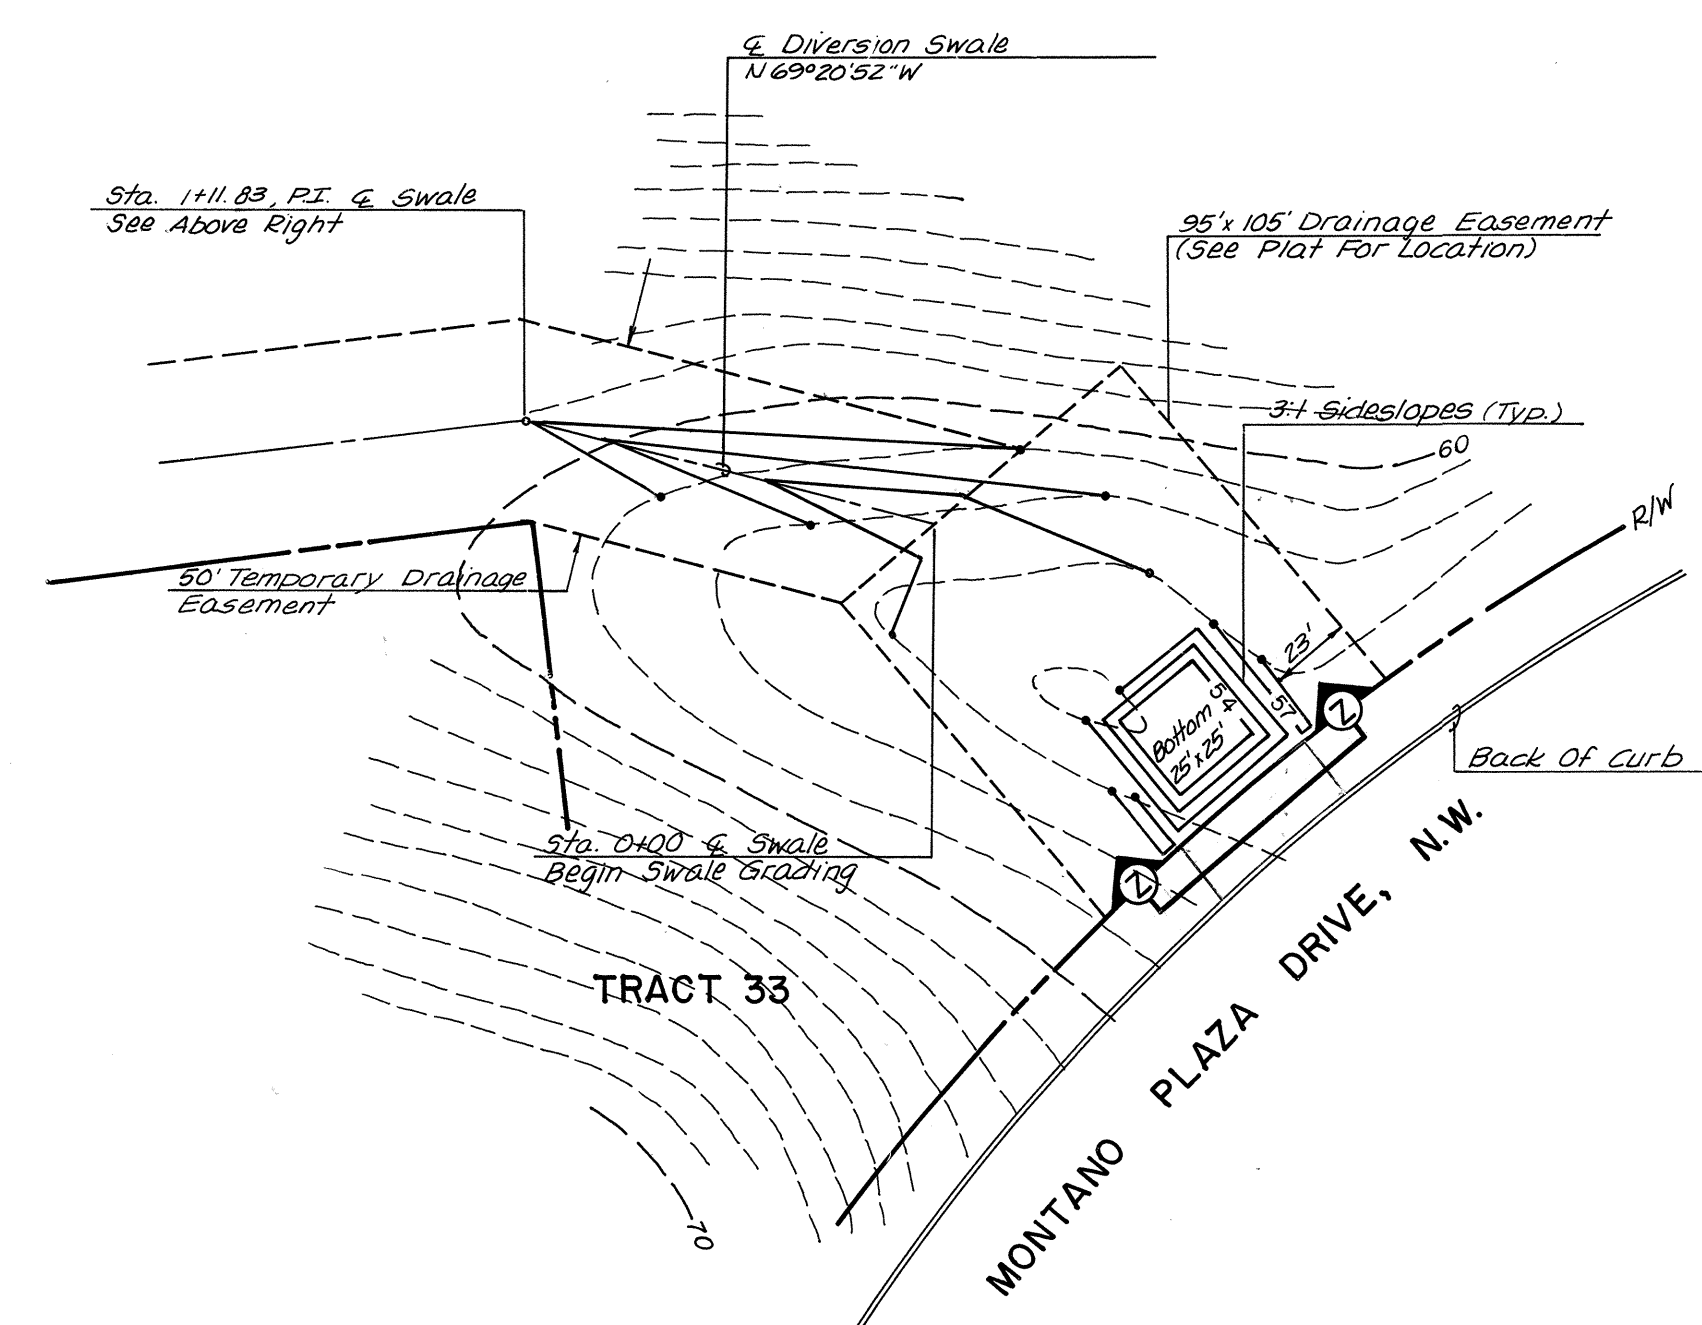

$EI = 56.4$ Match Existing Top Of Curb Elev. On Montano Plaza Dr.
 43'
 4" CTB Per S.D. Spec. 305.

1	2	3	4	5	6	7	8	9	10	11	12
2	6		2	7	5	9	0	8	8	7	

[illegible]

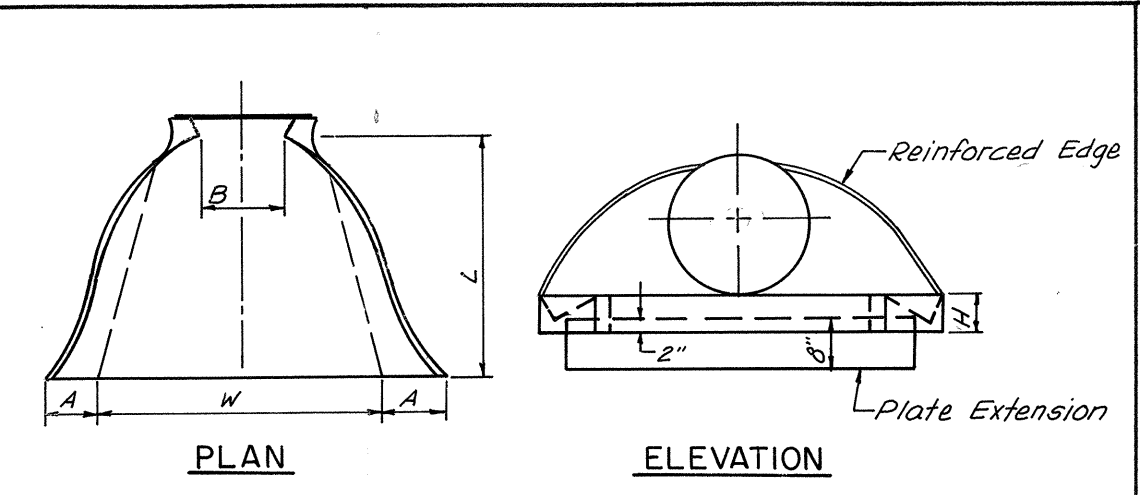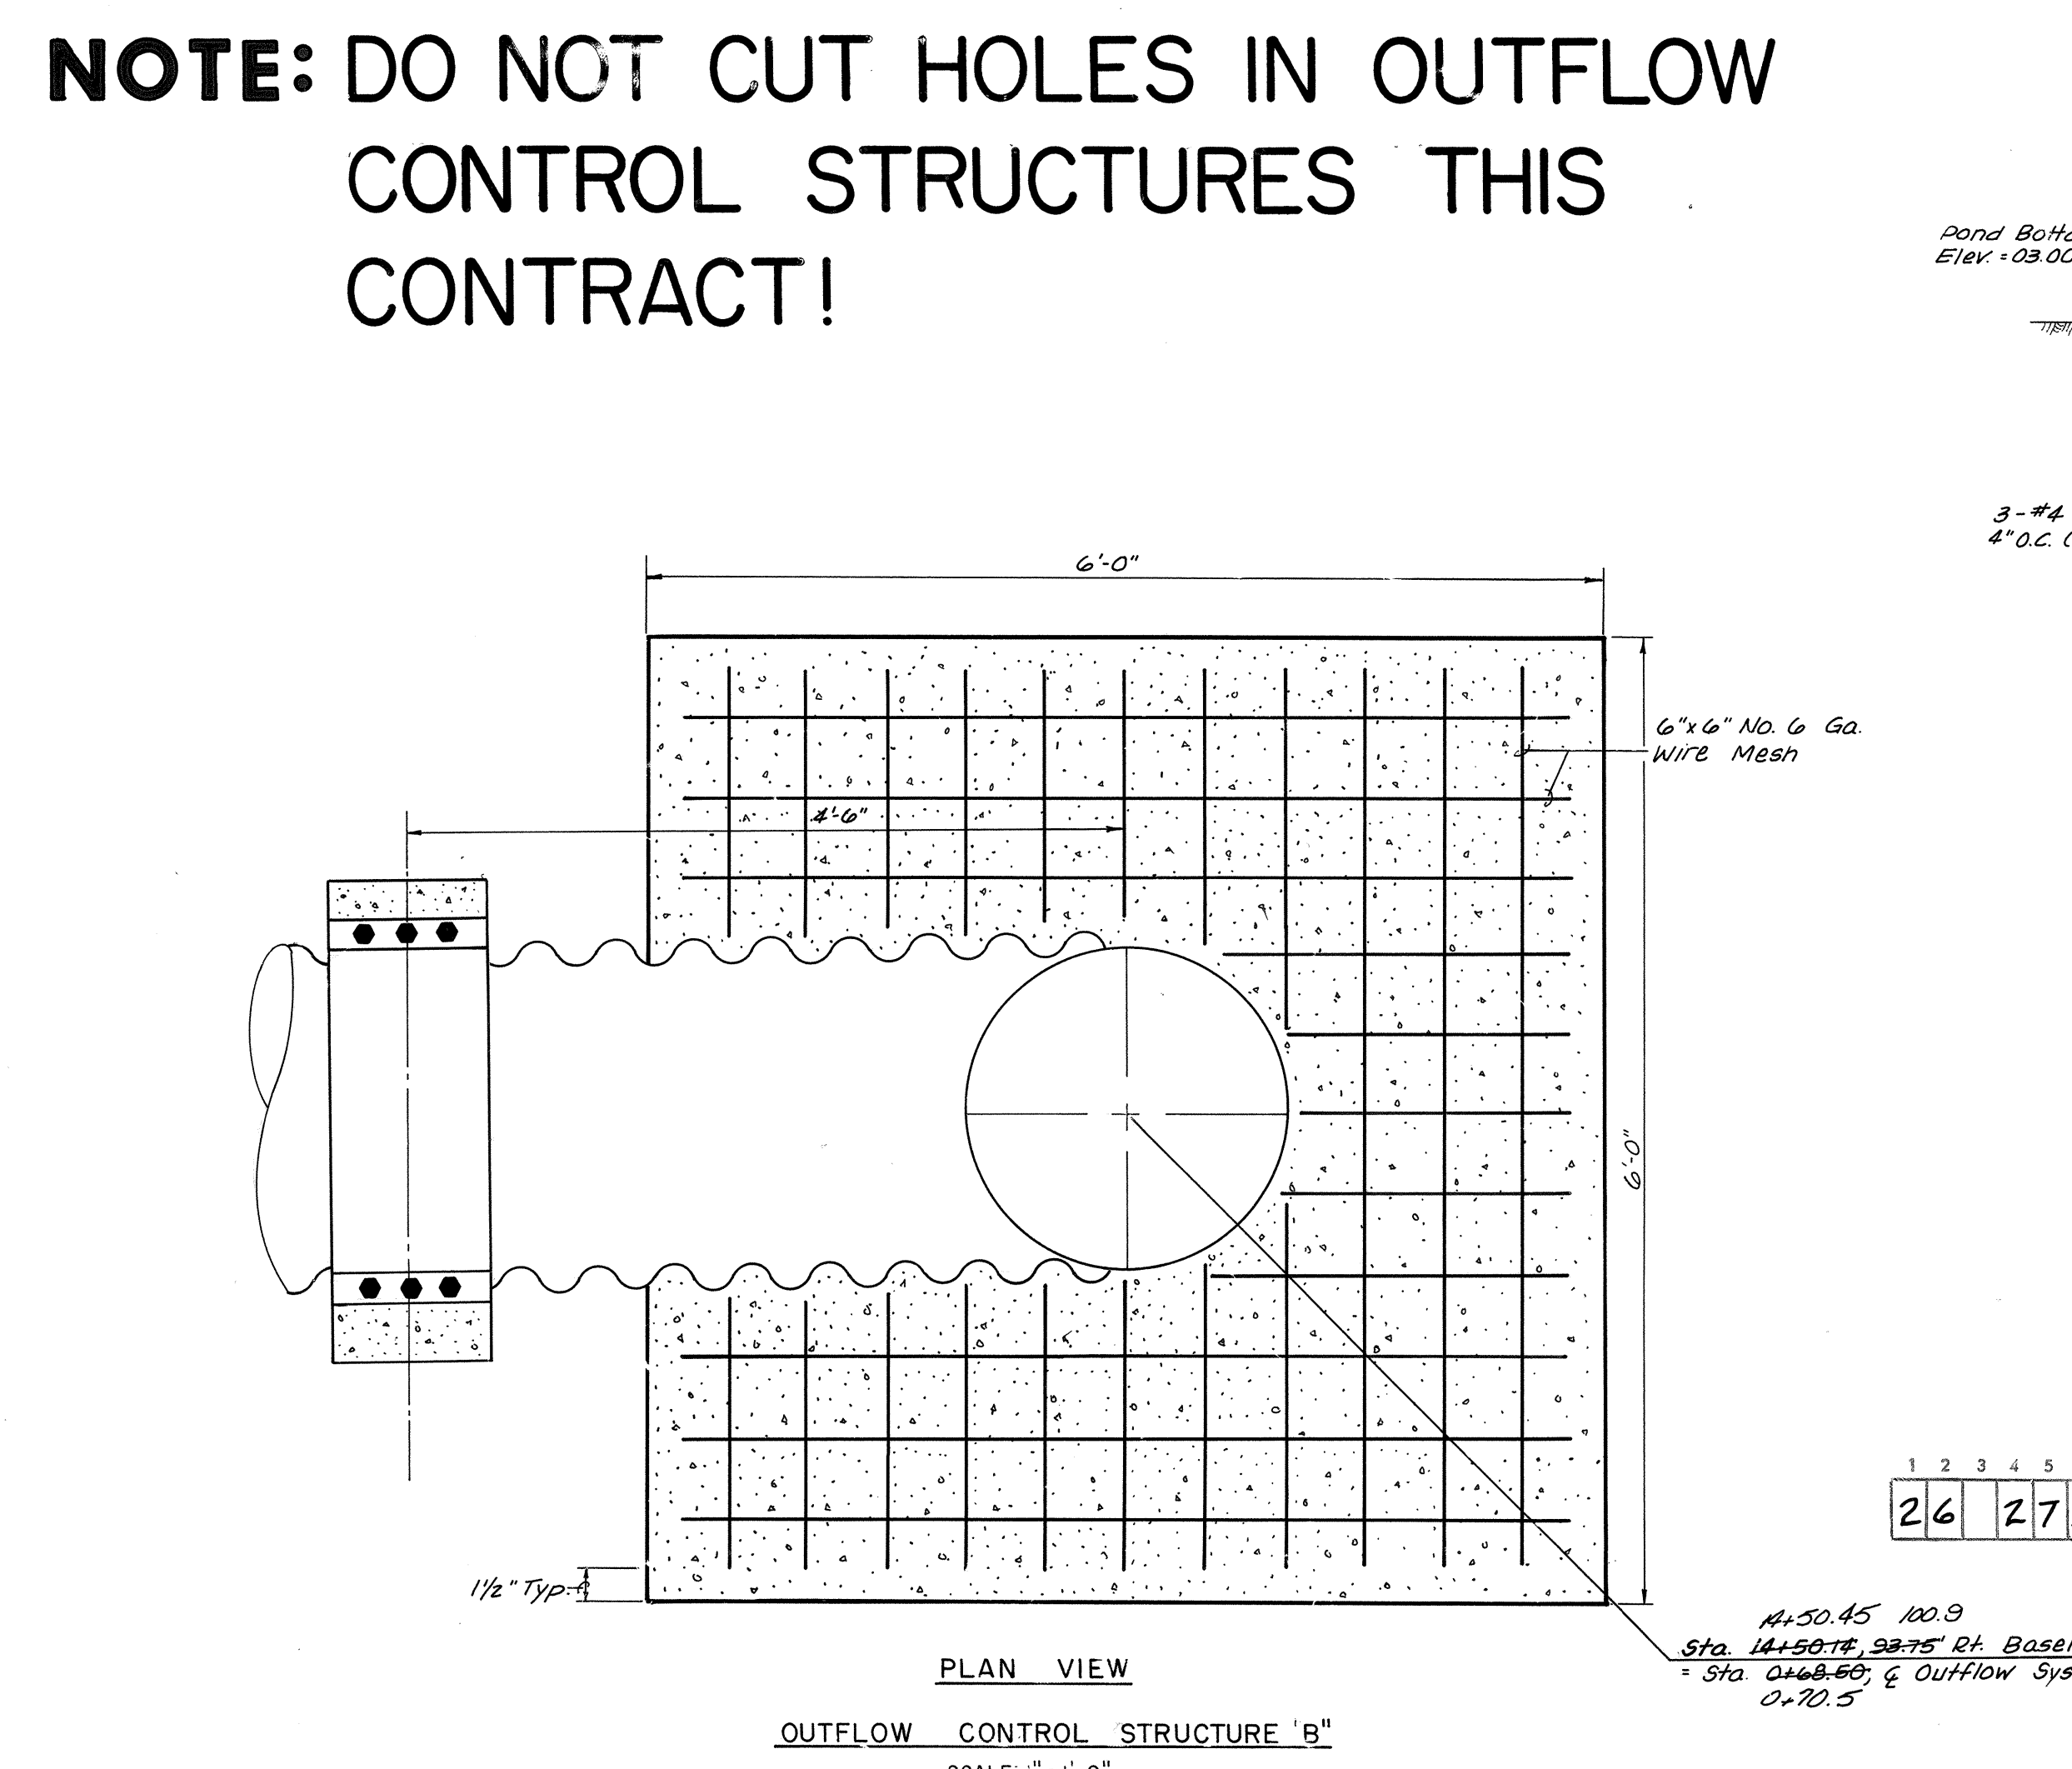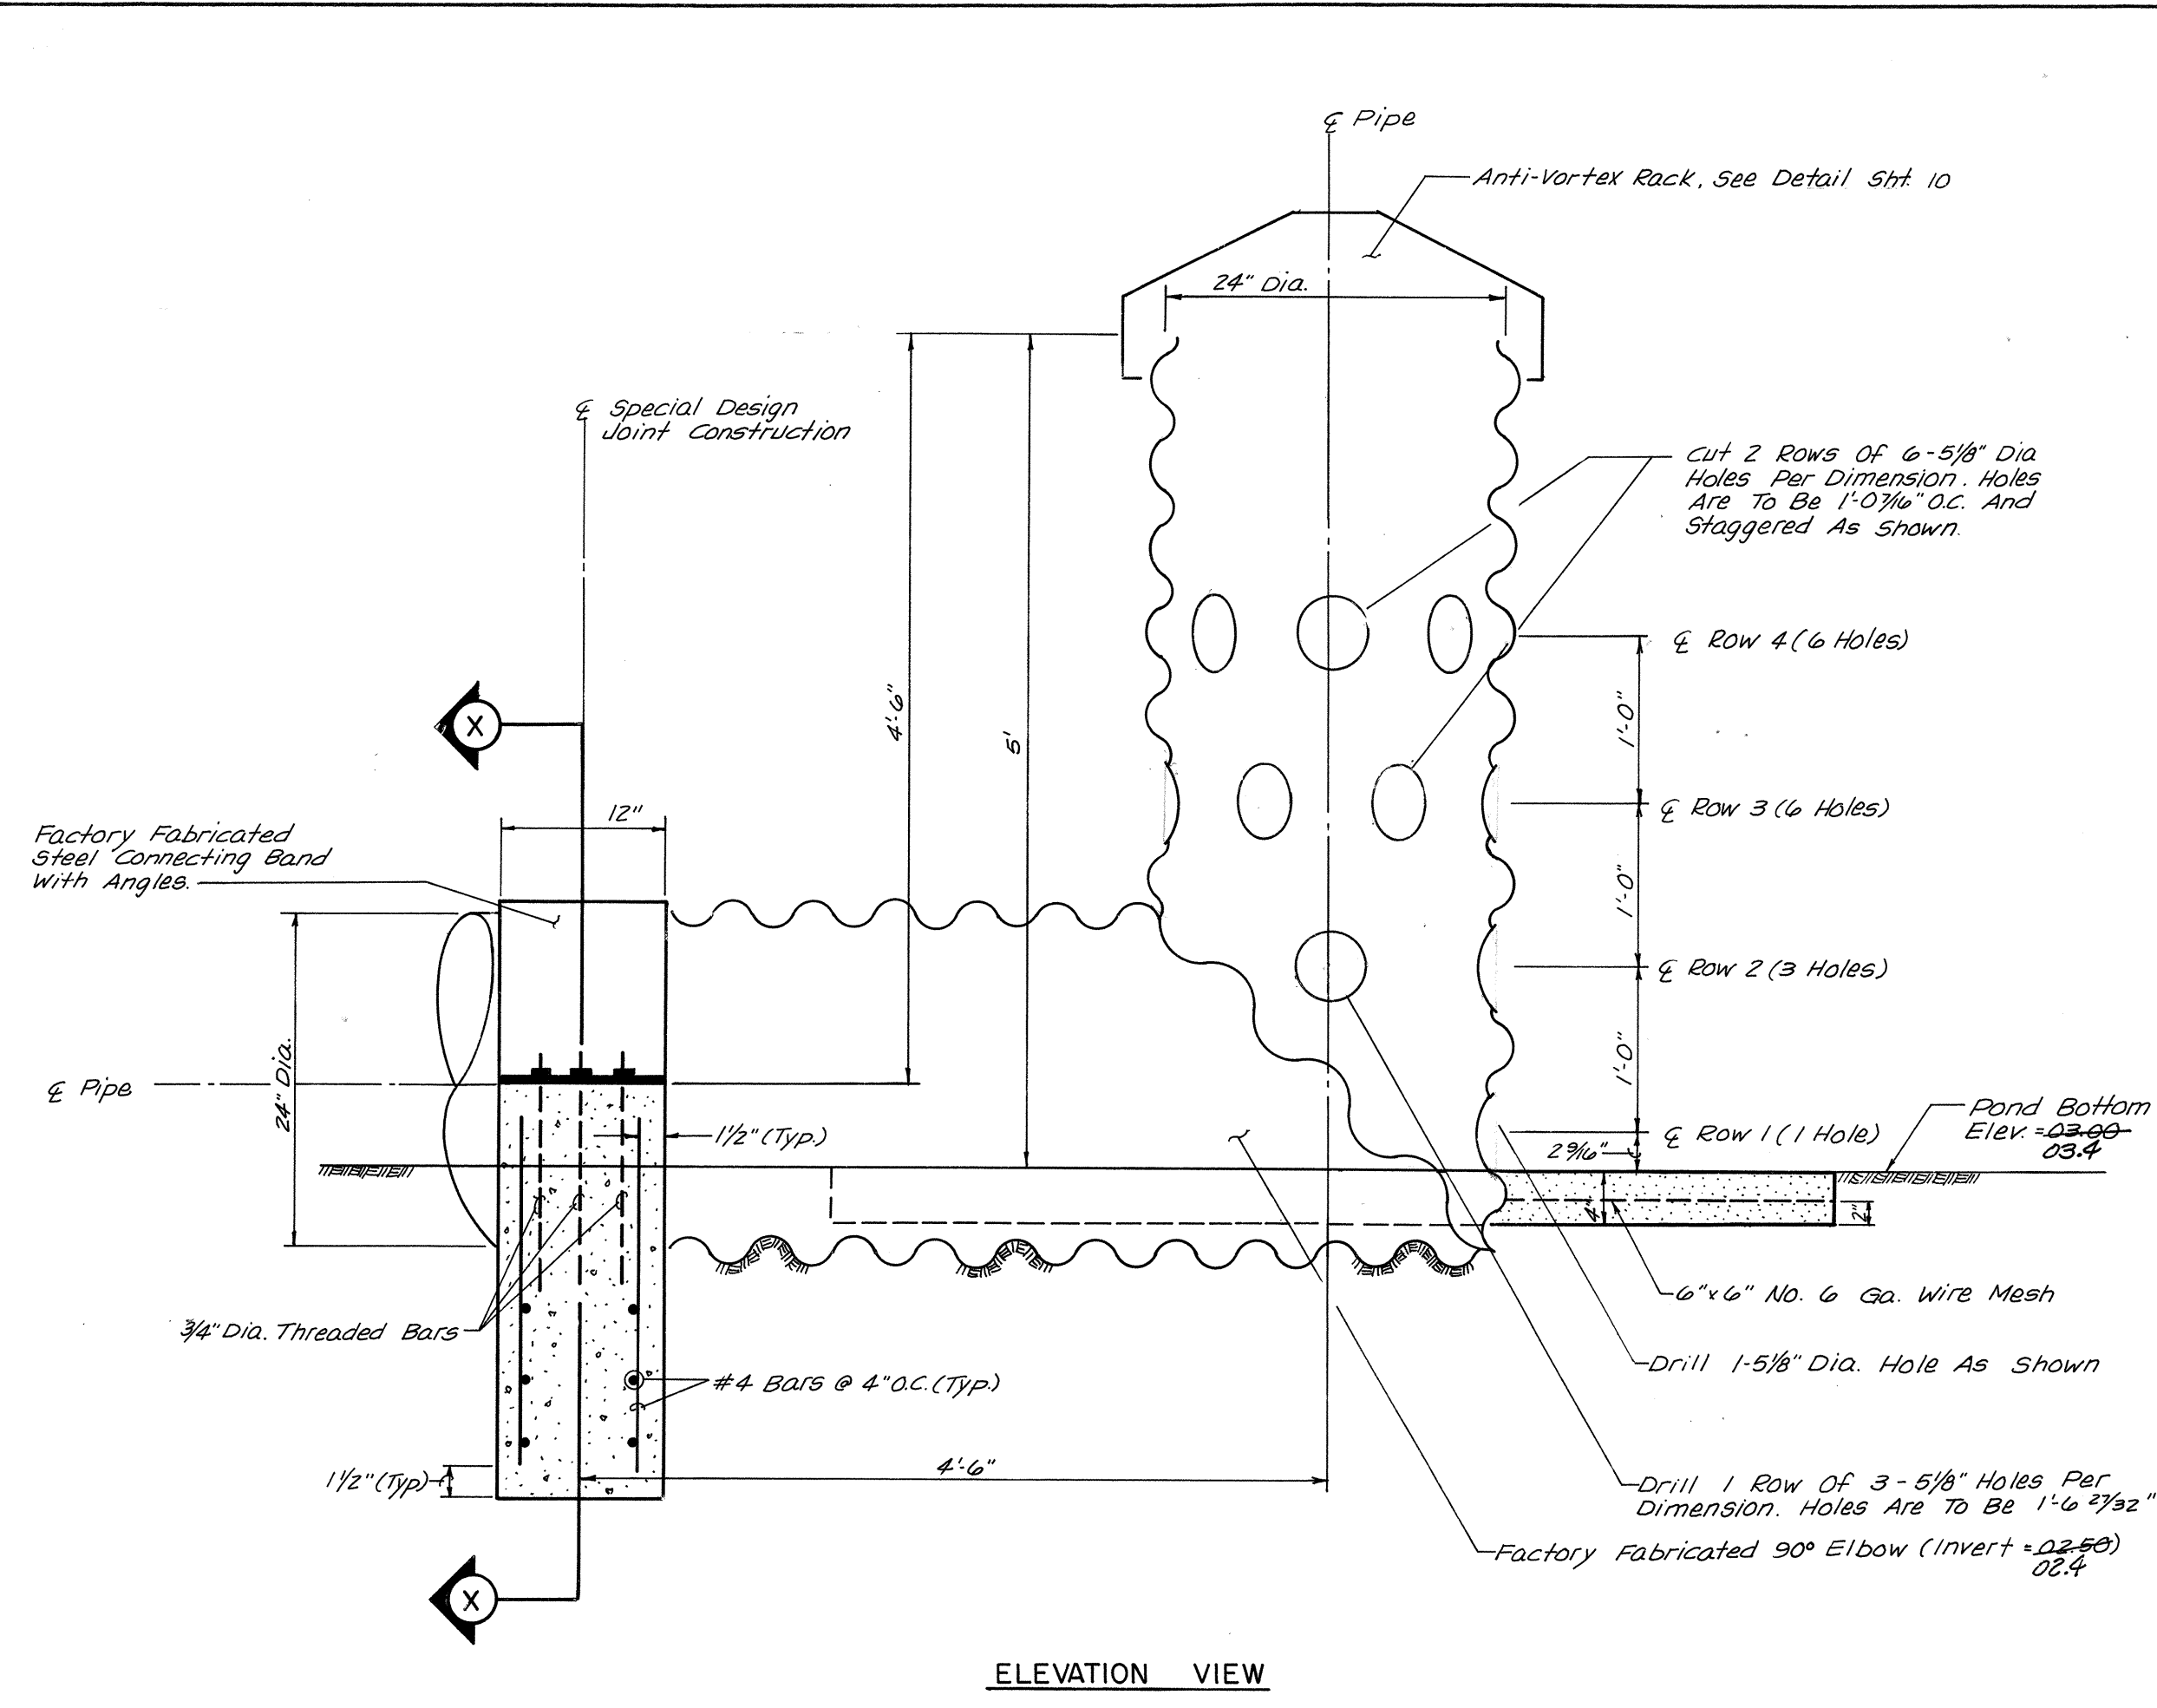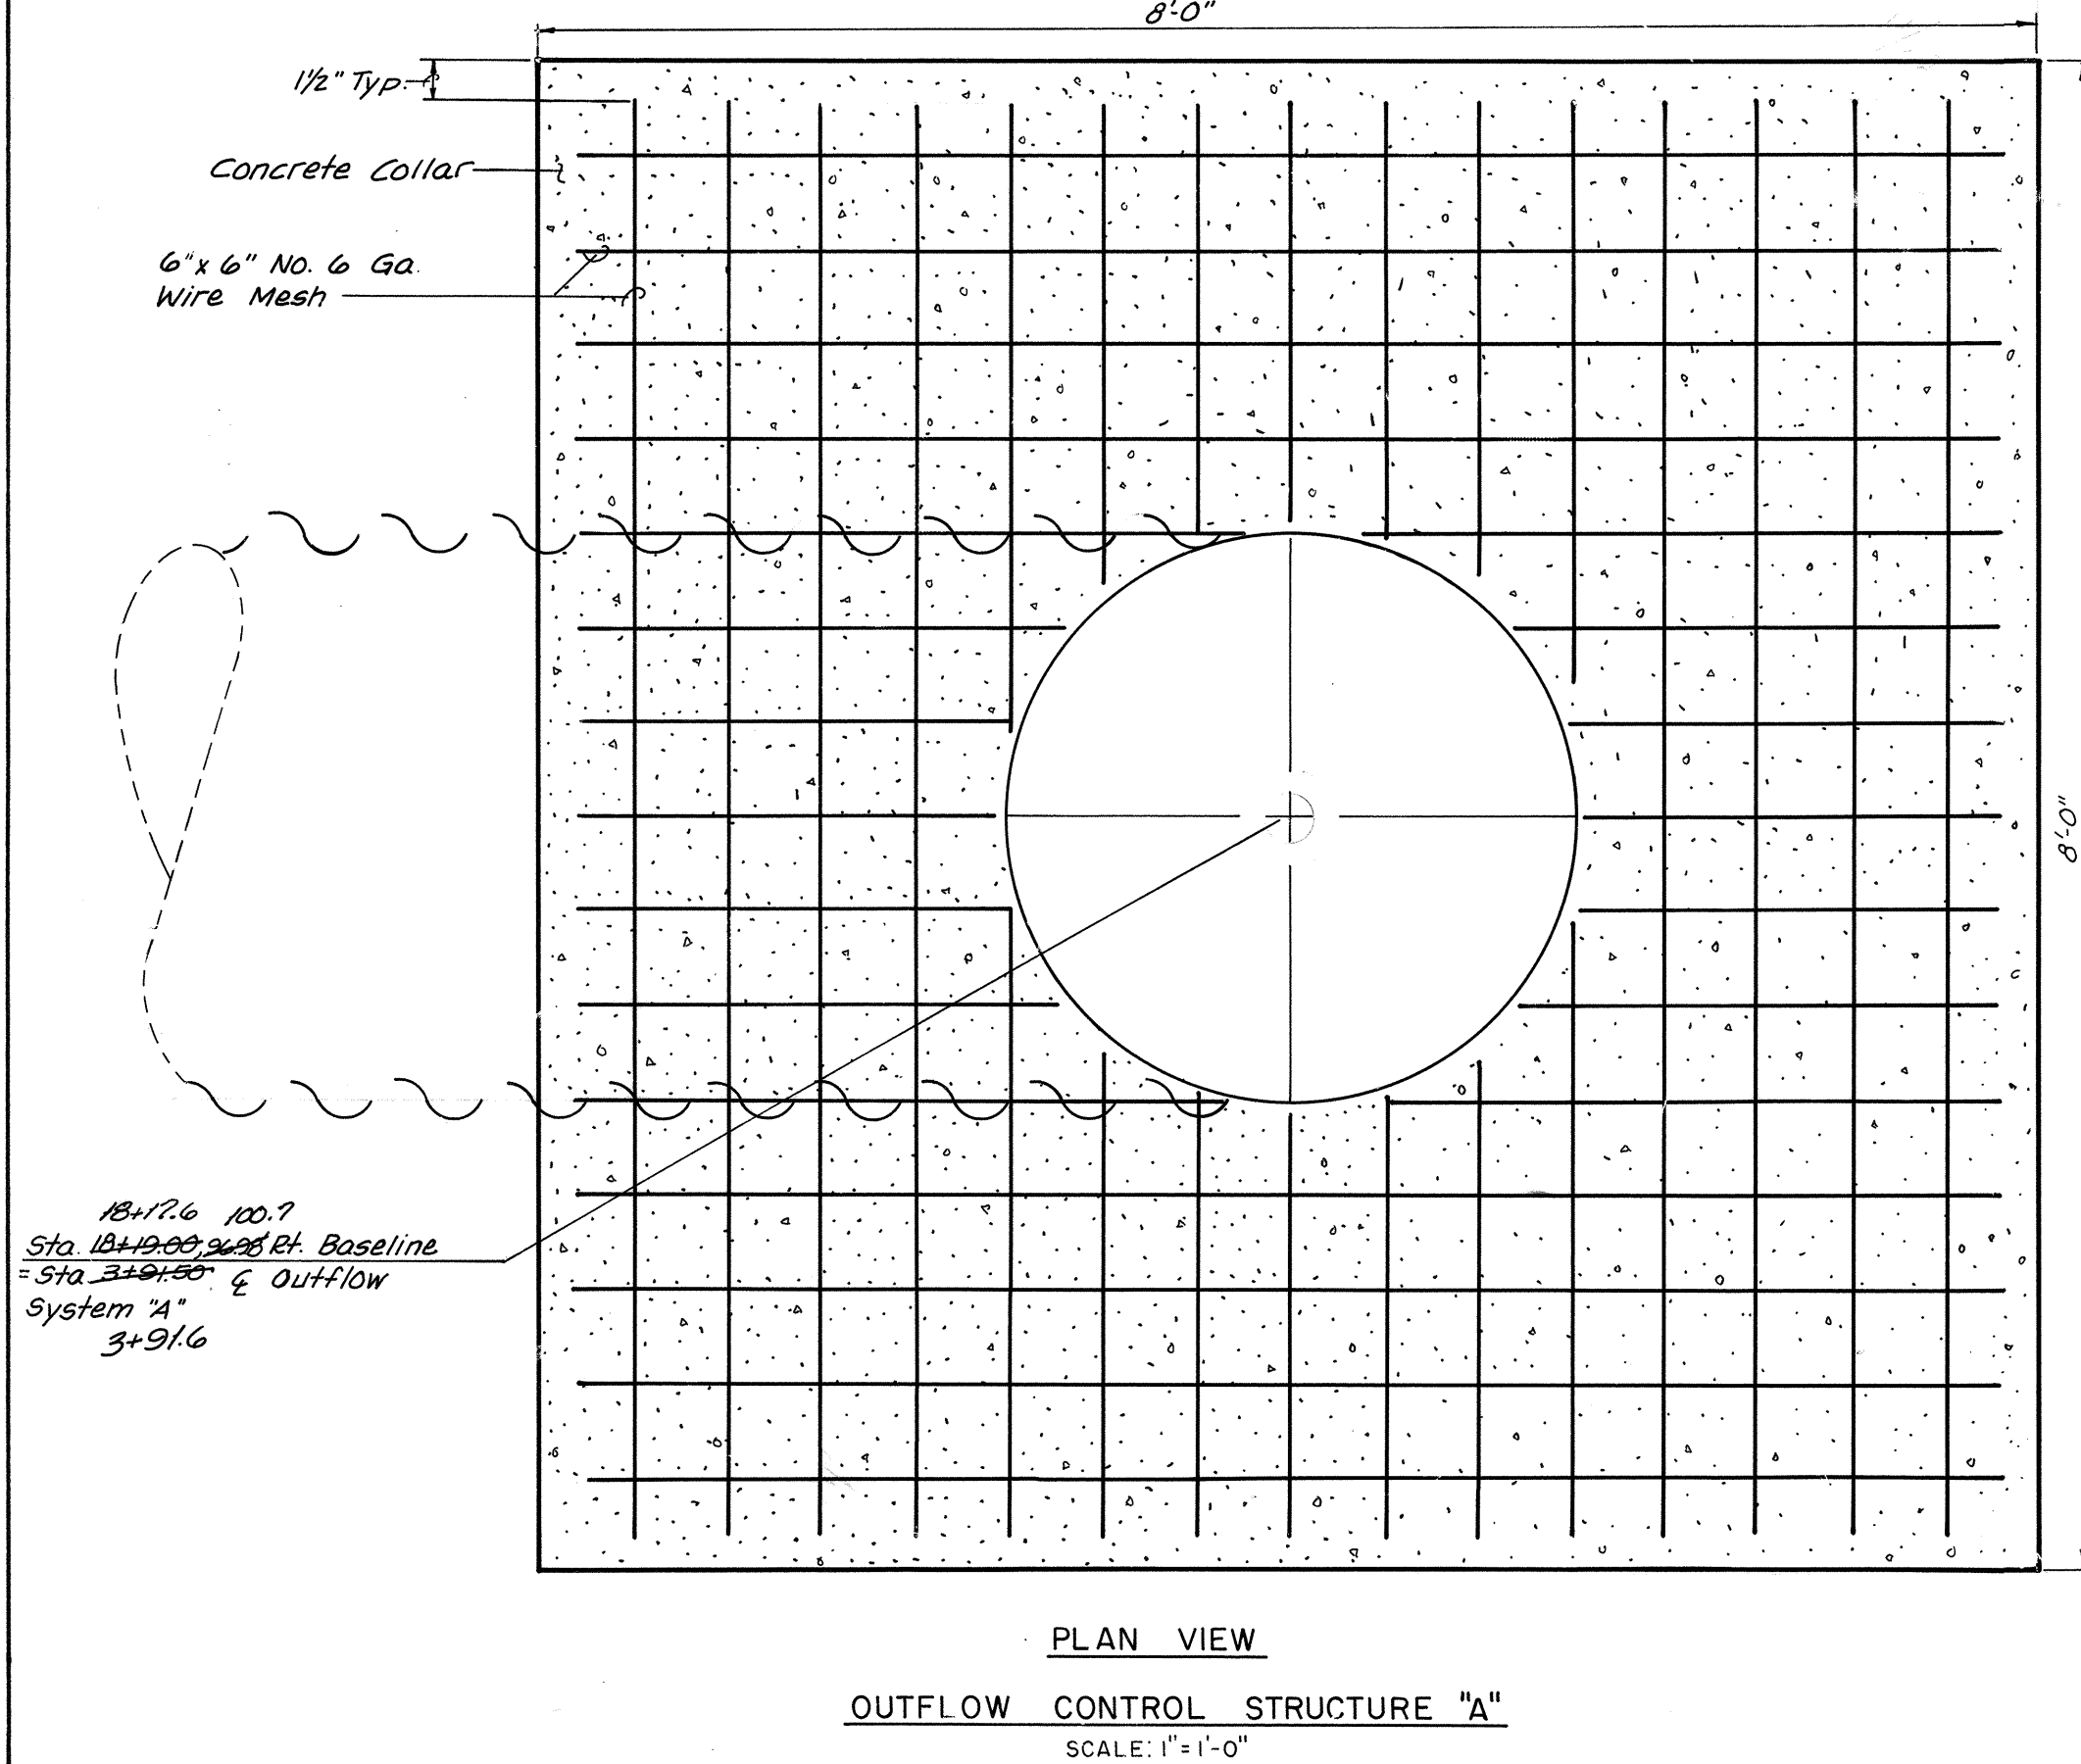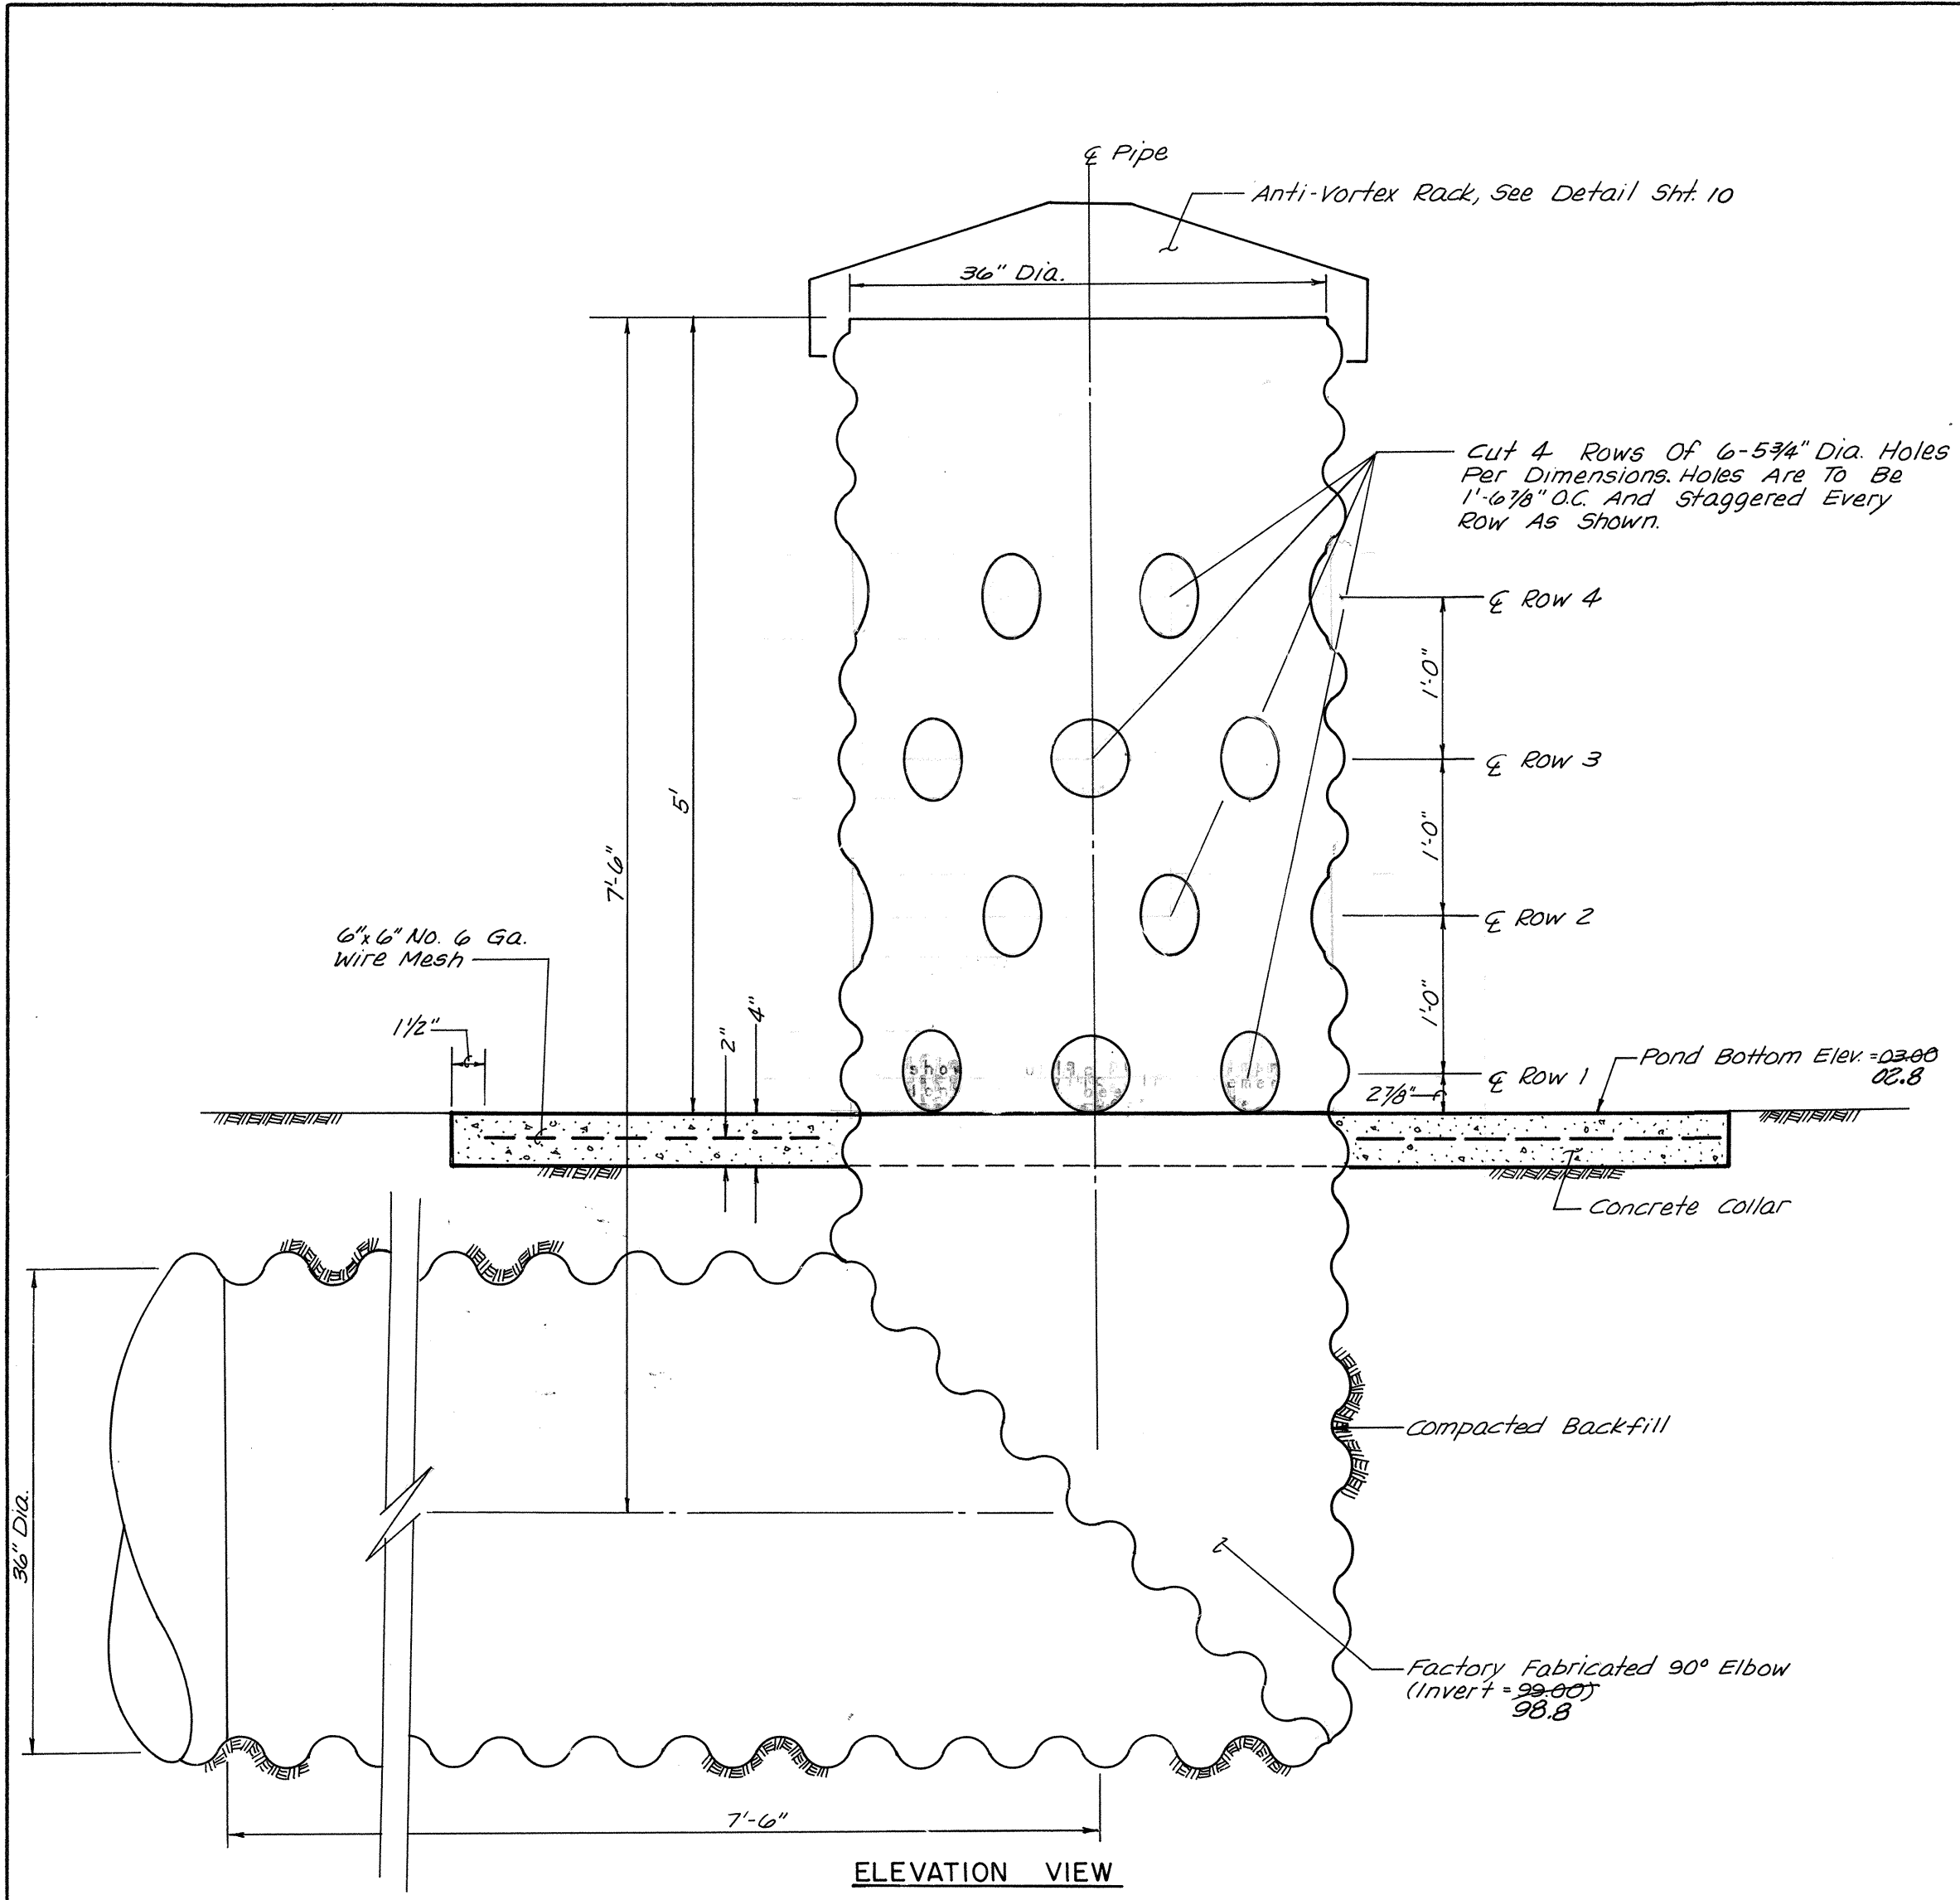

TYPICAL CROSS SECTION


Outlet System	Pipe Dia.	Ga.	Approx. Dimensions					Approx. Slope	Body
			A	B	H	L	W		
B	24	16	10	13	6	41	48	2½	1 ft.

CMP END SECTION DETAIL
N.T.S.

RECORD DRAWING
This drawing as modified shows public improvements as constructed. These modifications have been made using information and measurements obtained by EHA's field survey crew, the Contractor and City Inspector. The modifications conform to the minimum requirements for record drawing criteria required by the City of Albuquerque per Department of Public Works Manual Section 27.4 to the best of my knowledge and belief.

DATE 12-16-87

PROFESSIONAL ENGINEER 7282

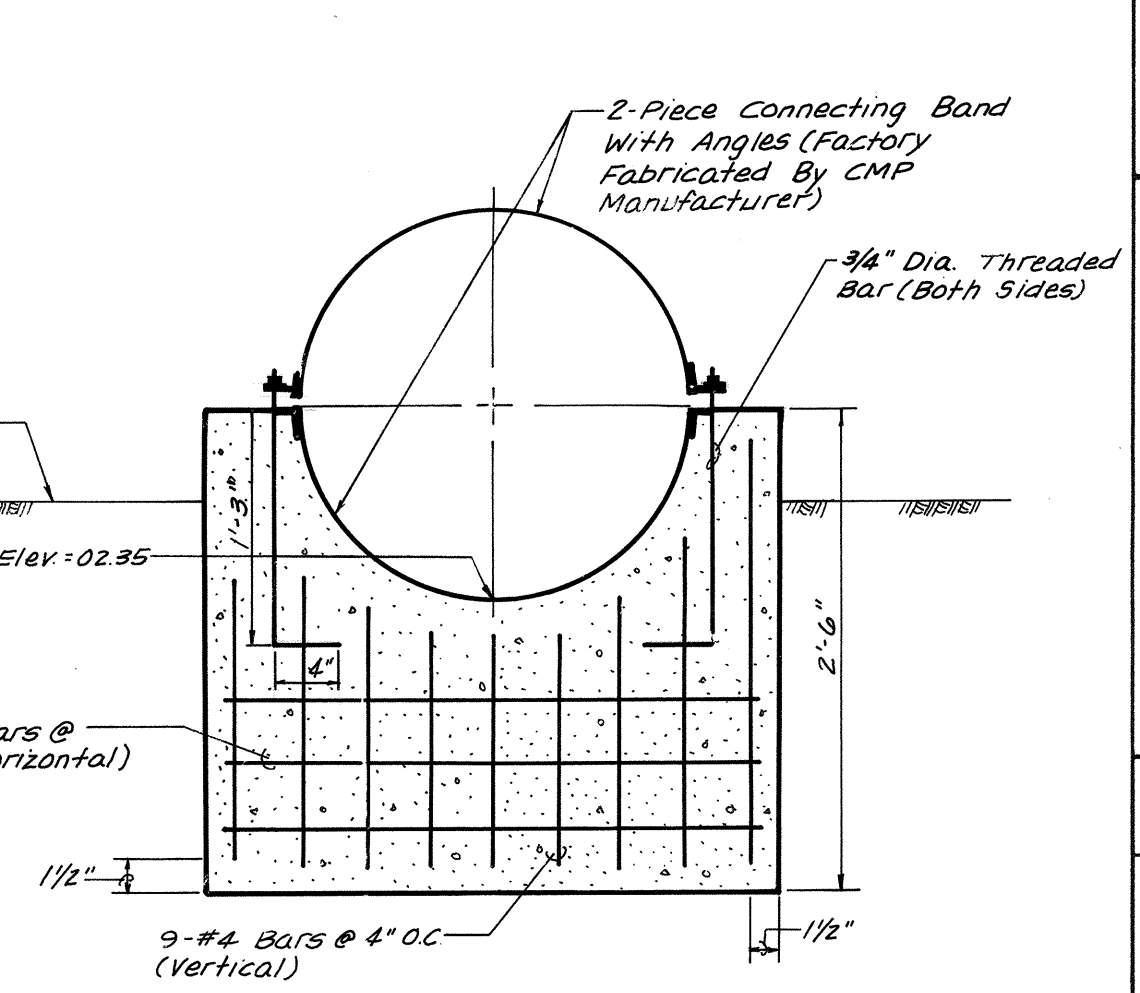

- CONSTRUCTION SEQUENCE:**
- FORM & POUR 3000 PSI CONCRETE STRUCTURE TO CONFORM TO BOTTOM PIECE OF CONNECTING BAND WITH THE THREADED BARS. (NOTE: STRUCTURE CAN BE SHOP FABRICATED AT CONTRACTOR'S OPTION).
 - PLACE BOTTOM PIECE OF CONNECTING BAND ON STRUCTURE WITH THREADED BARS PROJECTING THROUGH ANGLES.
 - SET 24" CMP INTO PLACE.
 - SET TOP PIECE OF CONNECTING BAND IN PLACE AND TIGHTEN TO STRUCTURE WITH HEX NUTS.


SCALE: AS NOTED

community sciences corporation

LAND PLANNING ENGINEERING SURVEYING
P.O. Box 1328 Albuquerque, N.M. 87108

CITY OF ALBUQUERQUE MUNICIPAL DEVELOPMENT DEPARTMENT ENGINEERING DIVISION			
TITLE: COORS/MONTANO DRAINAGE DETENTION FACILITY			
CONSTRUCTION DETAILS			
APPROVALS	ENGINEER	DATE	APPROVALS
City Engineer	Planning	4/17/86	
A.C.E.-Design	Traffic		N/A B. G. 3-14-86
A.C.E.-Hydrology	Water Utilities		N/A B. G. 3-14-86
DRAWING NO. 2759		MAP NO. E-12	SHEET 9 OF 14


NOTE: DO NOT CUT HOLES IN OUTFLOW CONTROL STRUCTURES THIS CONTRACT!

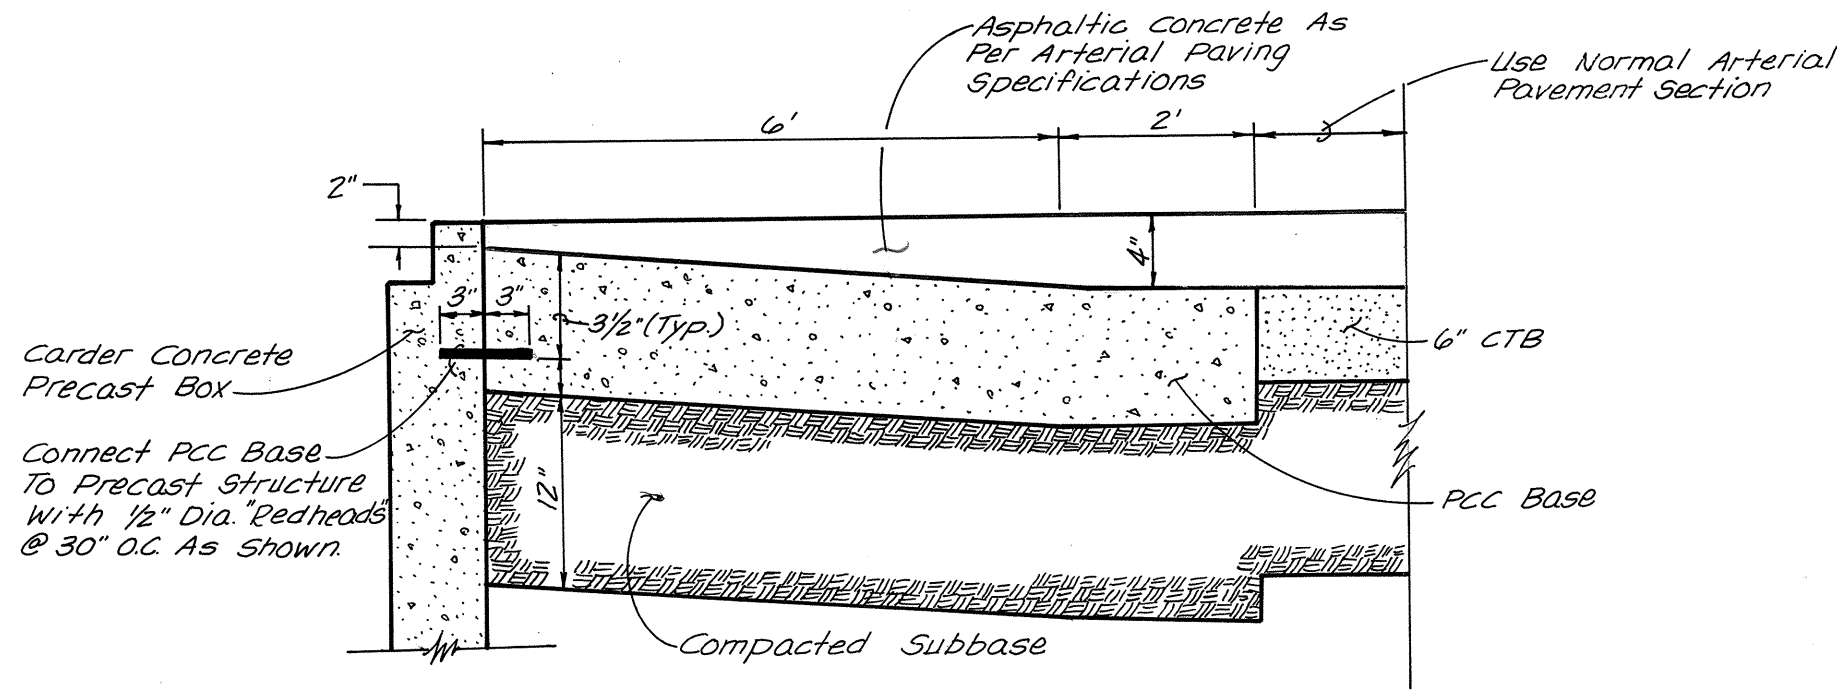

PAVEMENT SECTION TRANSITION DETAIL
N.T.S.


RECORD DRAWING

This drawing as modified shows public improvements as constructed. These modifications have been made using information and measurements obtained by EH&A's field survey crew, the Contractor and City Inspector. The modifications conform to the minimum requirements for record drawing criteria as required by the City of Albuquerque per the Engineering Process Manual Section 27.4 to the best of my belief.

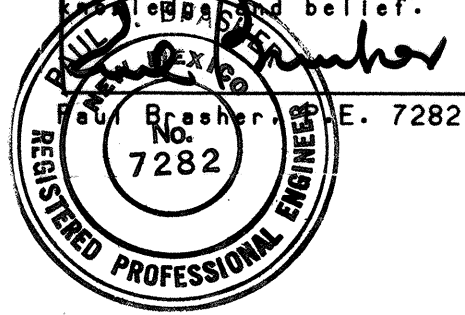


12-16-87


Date

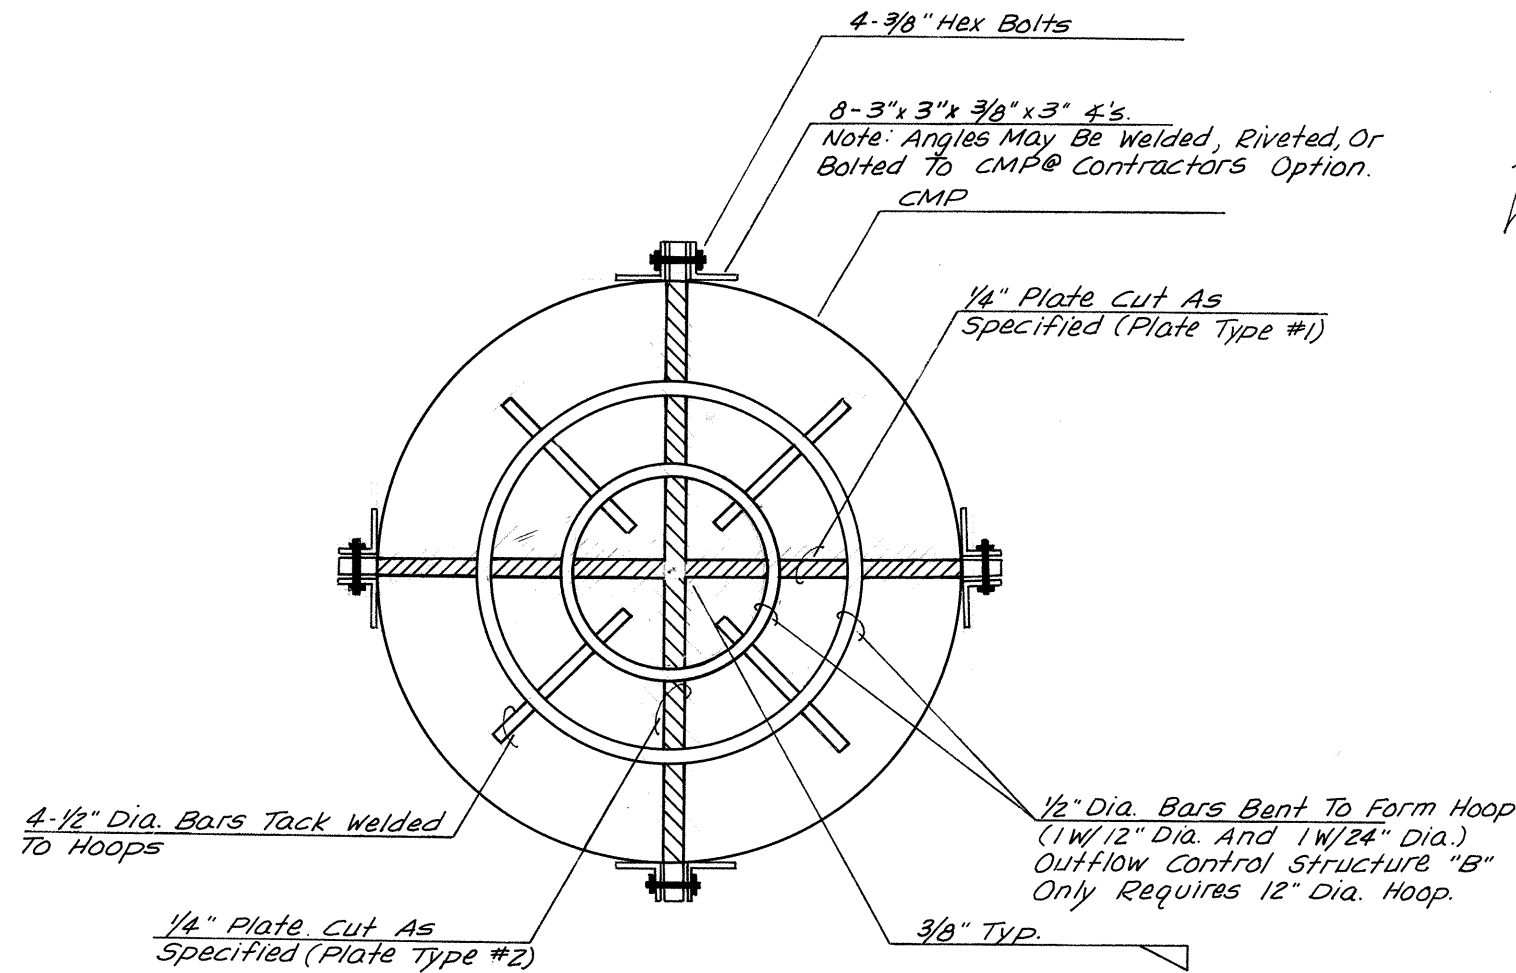


ANTI-VORTEX RACK FOR OUTFLOW CONTROL STRUCTURES
N.T.S.

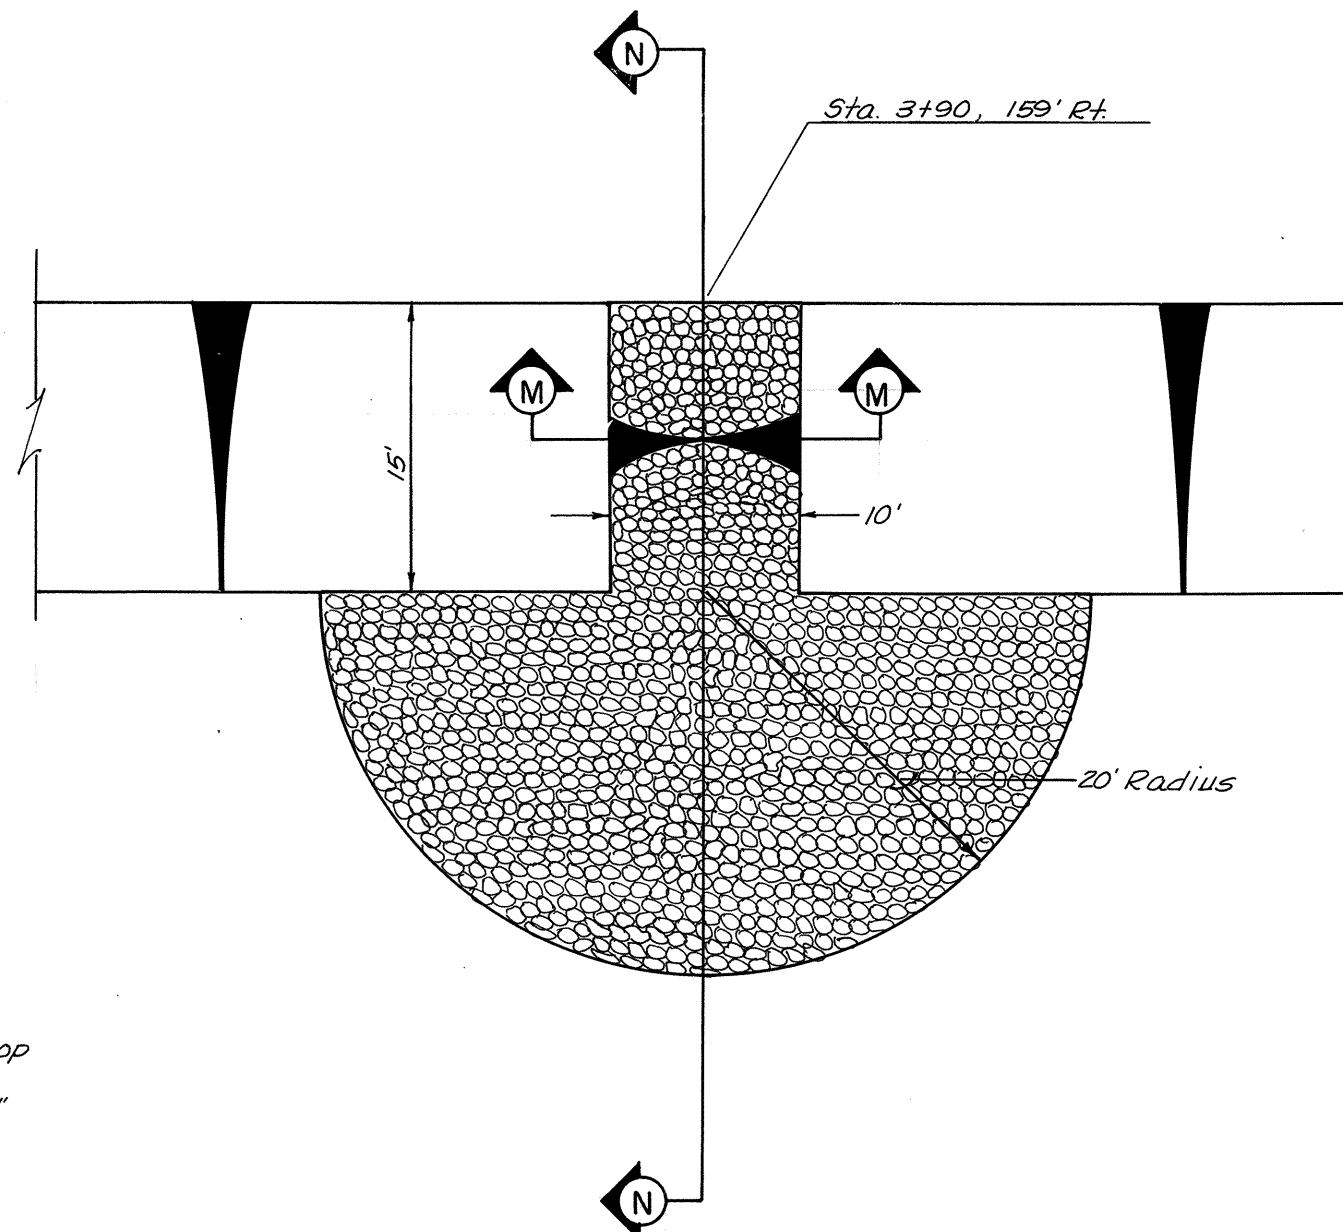


RIP RAP RUNDOWN
SCALE: 1" = 10'

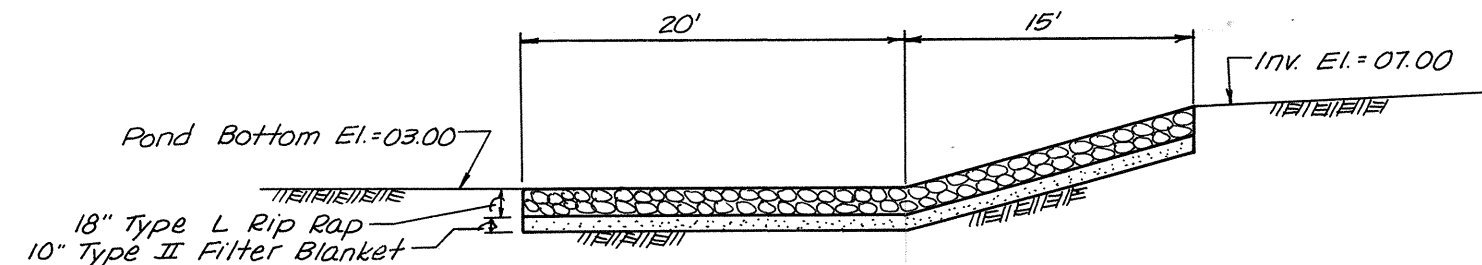


SECTION N-N
SCALE: 1" = 10'

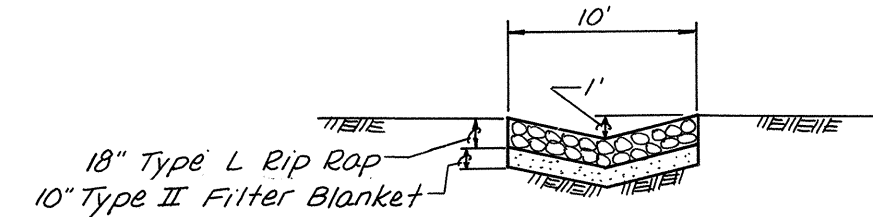


SECTION M-M
SCALE: 1" = 10'

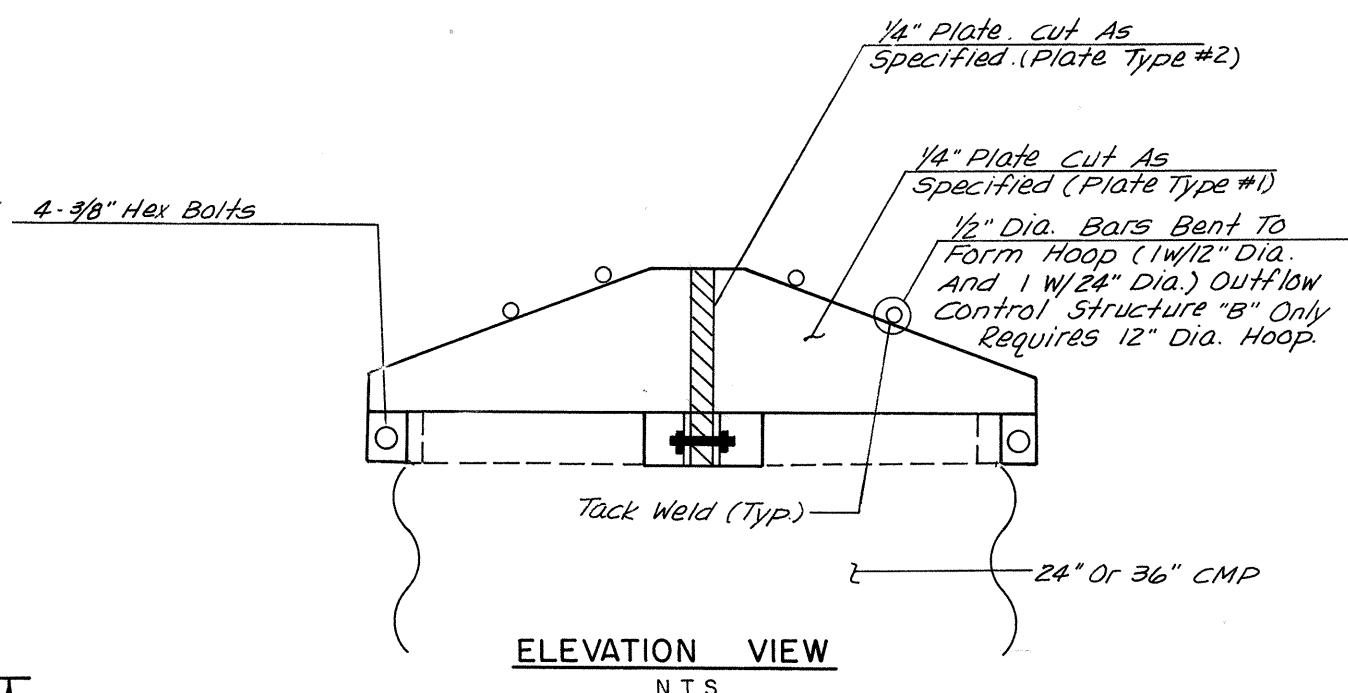


ELEVATION VIEW
N.T.S.

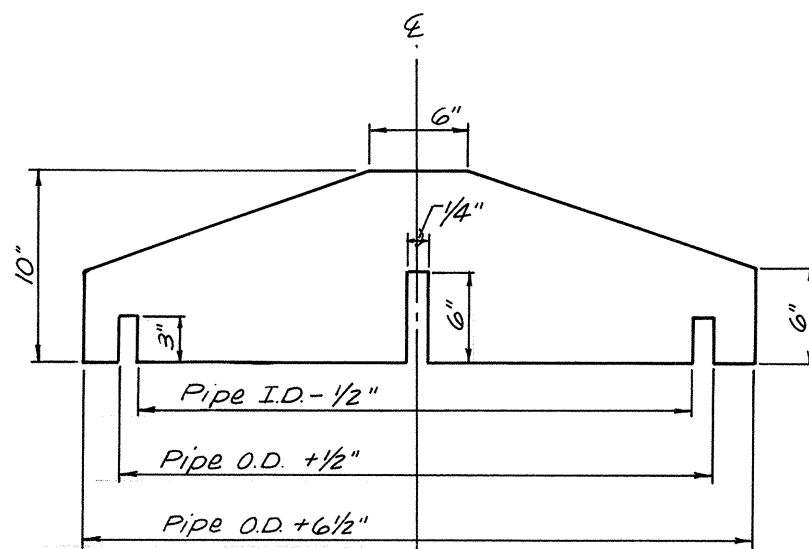

DIMENSIONS - PLATE TYPE #1 (1 PER STRUCTURE)
N.T.S.

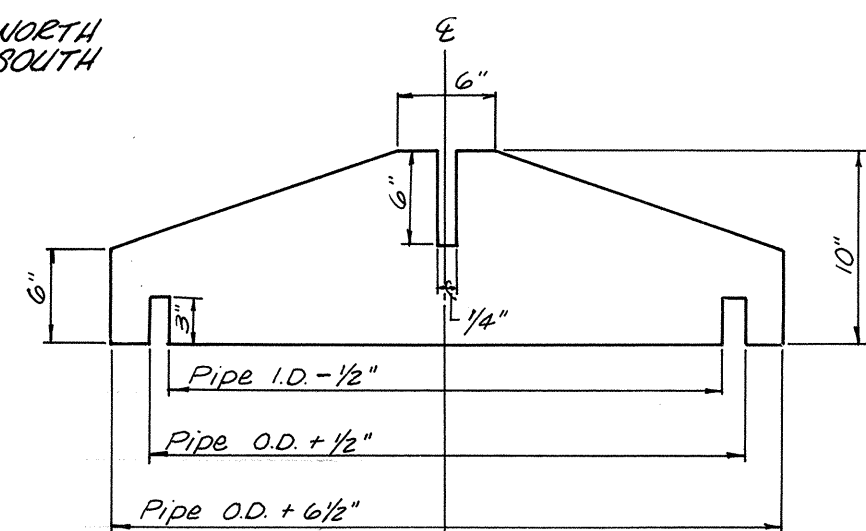

DIMENSIONS - PLATE TYPE #2 (1 PER STRUCTURE)
N.T.S.

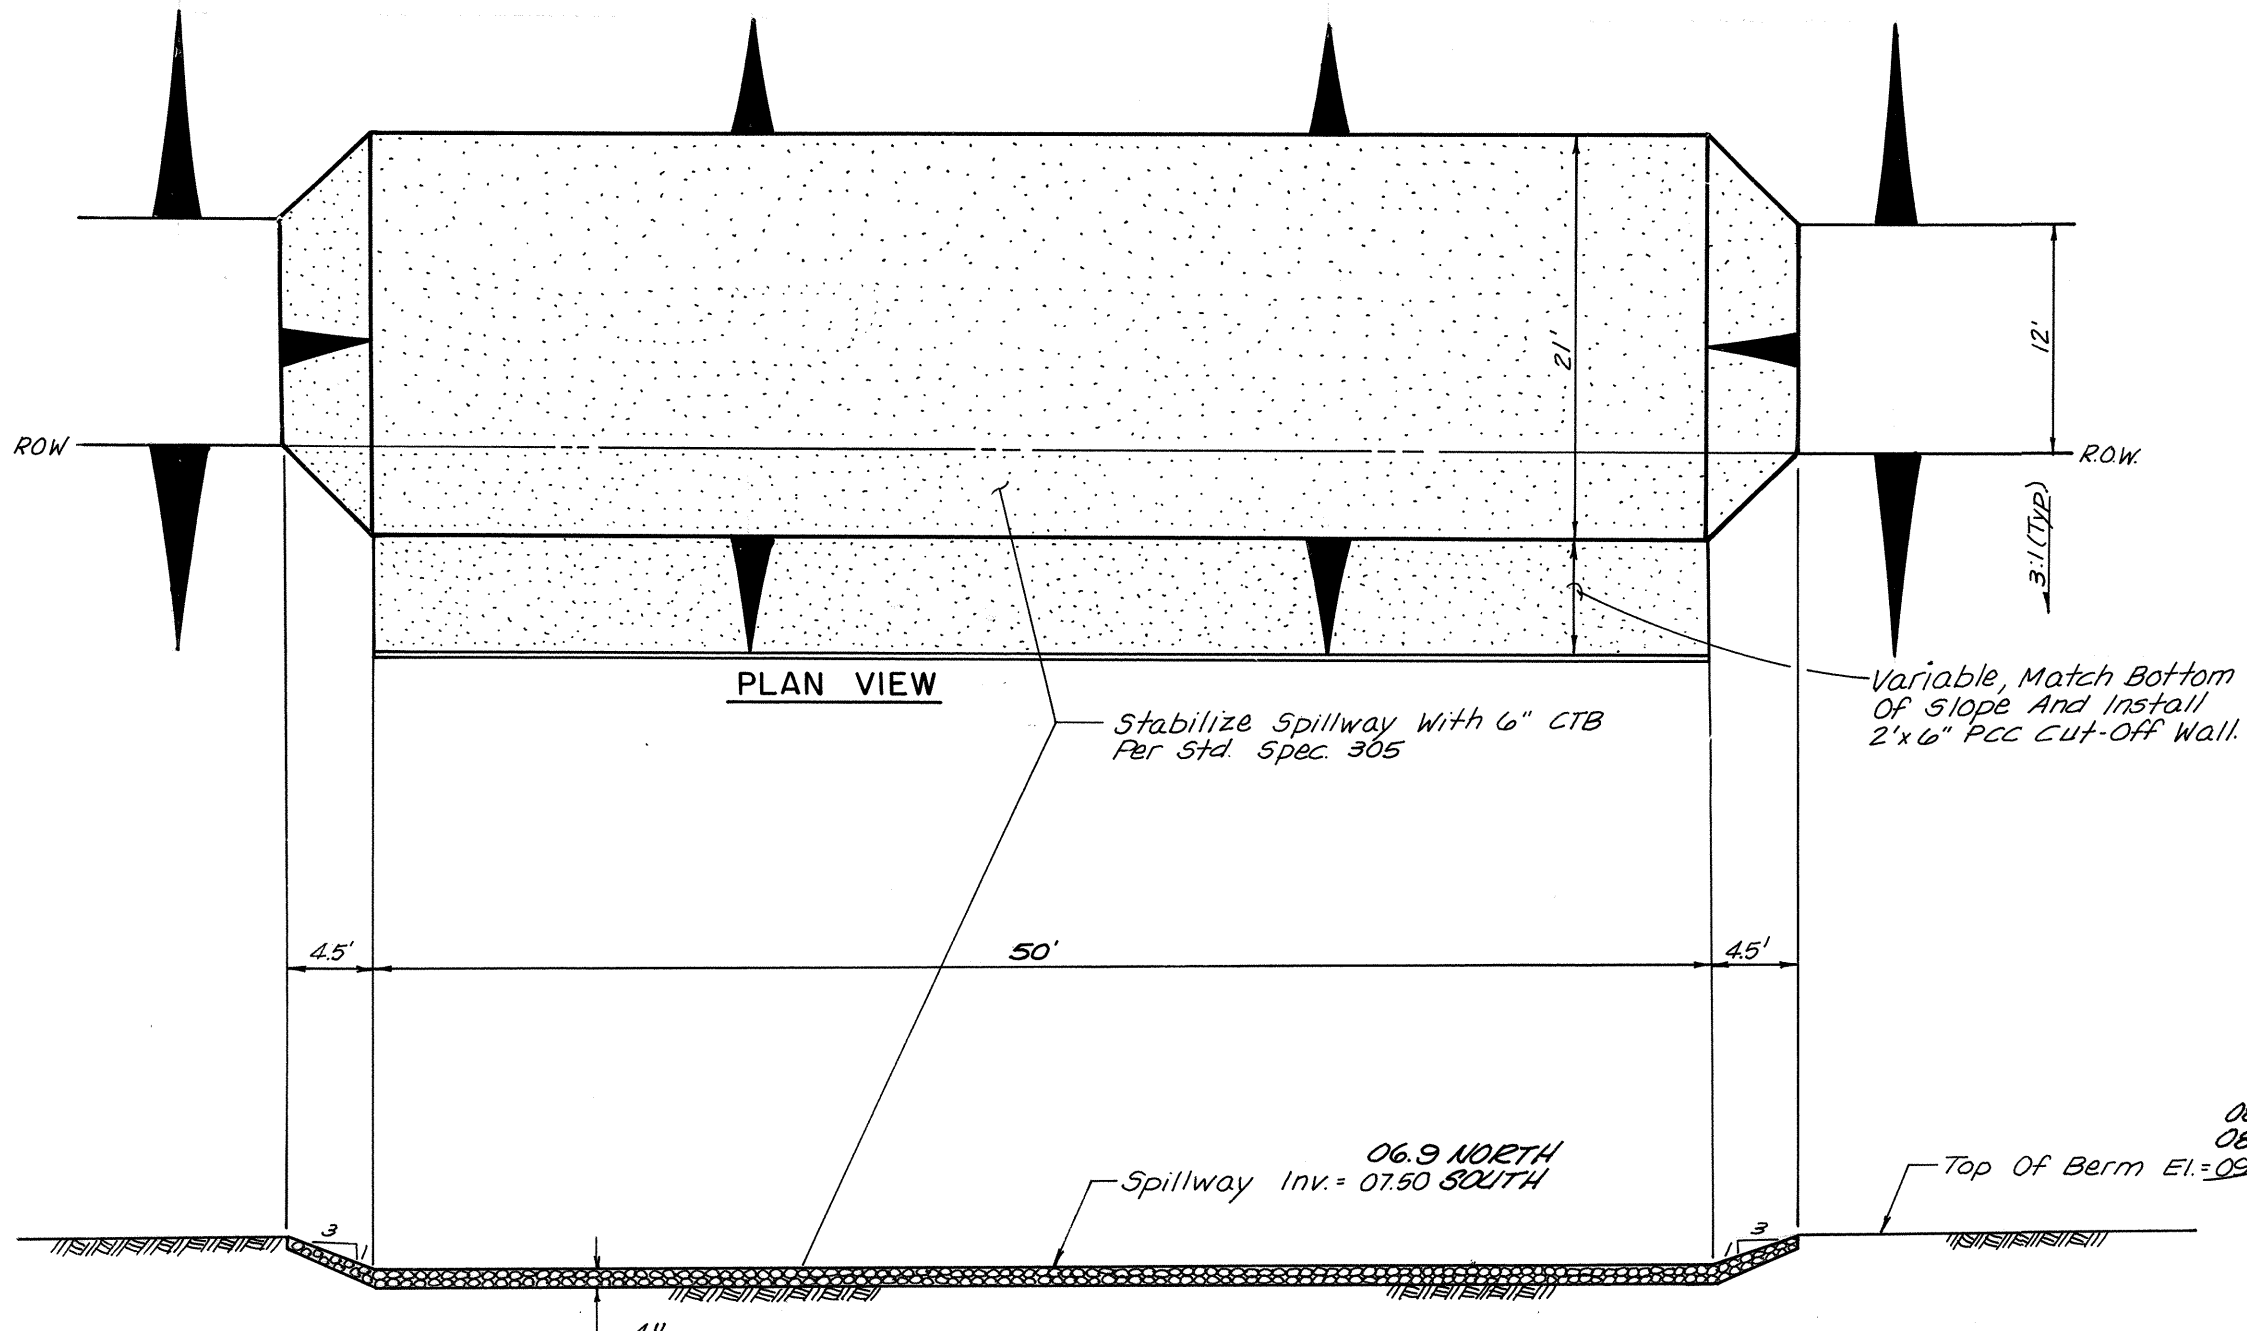

ELEVATION VIEW
EMERGENCY SPILLWAY DETAIL
N.T.S.

Type L Rip Rap Specs		
% Smaller Than Given Size By Weight	Minimum Dimension Inches	*K _u Inches
100	12	-
35-65	9	9
10	2	-

Type II Filter Specs	
Sieve Size	% By Weight Passing Square Mesh Sieves
2"	90-100
3/4"	20-30
#4	10-20
#200	0-3

* K_u = Median Stone Size

Rip Rap Shall Be Hard Durable Angular Stone With A Specific Gravity Of 2.5 Or Greater

26 27591087

SCALE:
AS NOTED

community sciences corporation
LAND PLANNING ENGINEERING SURVEYING
P.O. Box 1326 Corrales, N.M. 87048

CITY OF ALBUQUERQUE
MUNICIPAL DEVELOPMENT DEPARTMENT
ENGINEERING DIVISION


TITLE: COORS/MONTANO DRAINAGE DETENTION FACILITY

CONSTRUCTION DETAILS












APPROVALS	ENGINEER	DATE	APPROVALS	ENGINEER	DATE
City Engineer	<i>[Signature]</i>	12/16/87	Planning	<i>[Signature]</i>	3-14-88
A.C.E.-Design	<i>[Signature]</i>		Traffic	<i>[Signature]</i>	3-14-88
A.C.E.-Hydrology	<i>[Signature]</i>		Water Utilities	<i>[Signature]</i>	3-14-88

DRAWING NO. 2759 MAP NO. E-12 SHEET 10 OF 14

SURVEY INFORMATION		BENCH MARKS		AS BUILT INFORMATION	
NO.	BY	DATE	TOP OF STEEL RAIL RIGHT-OF-WAY MARKER STA. 267 + 50, STAMPED "ACS BM 3-E12" LOCATED APPROXIMATELY 100 FEET NORTHEAST OF THE INTERSECTION OF COORS ROAD, N.W. (STATE ROAD #448) AND MONTANO ROAD, N.W., ON THE EAST RIGHT-OF-WAY. ELEVATION = 5005.143.	CONTRACTOR	DATE
				CCM	12/16/87
				WORK STAKED BY	DATE
				FIELD ACCEPTANCE BY	DATE
				CONTRACTOR BY	DATE
				RECORDED BY	DATE

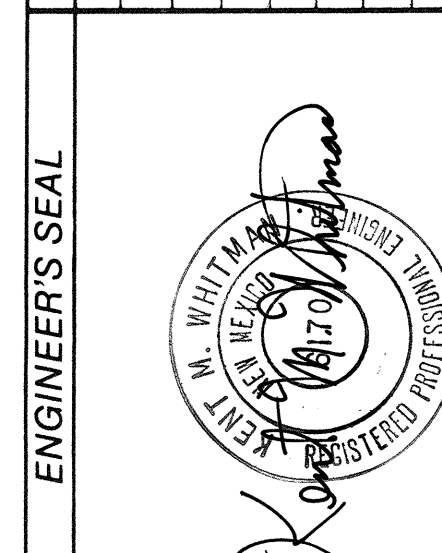

REVISIONS		BY	DATE
DESIGN			DEC, 1985
			DEC, 1985
			DEC, 1985

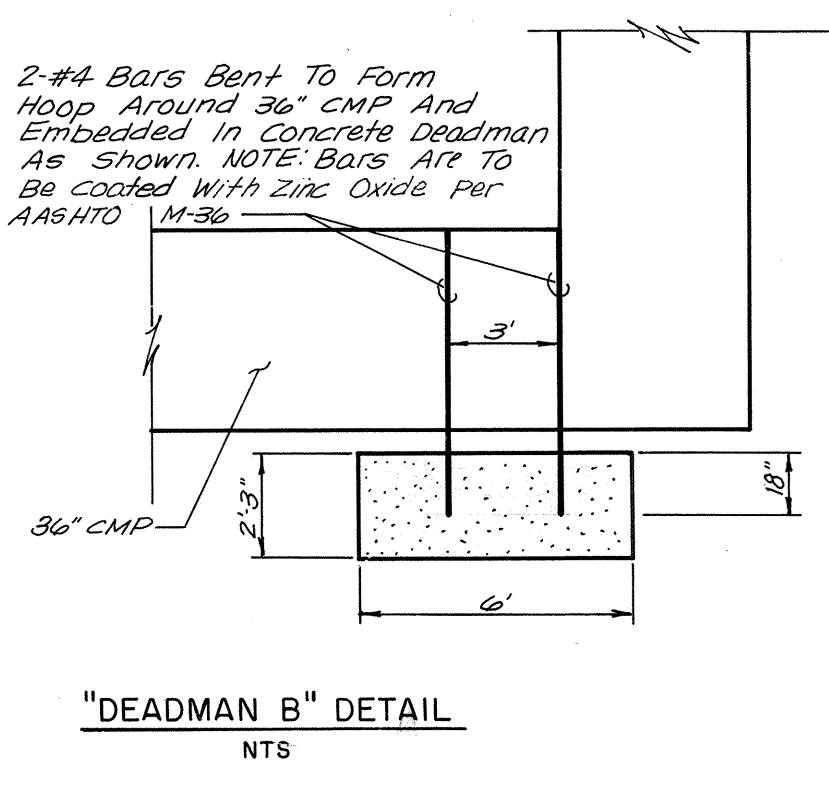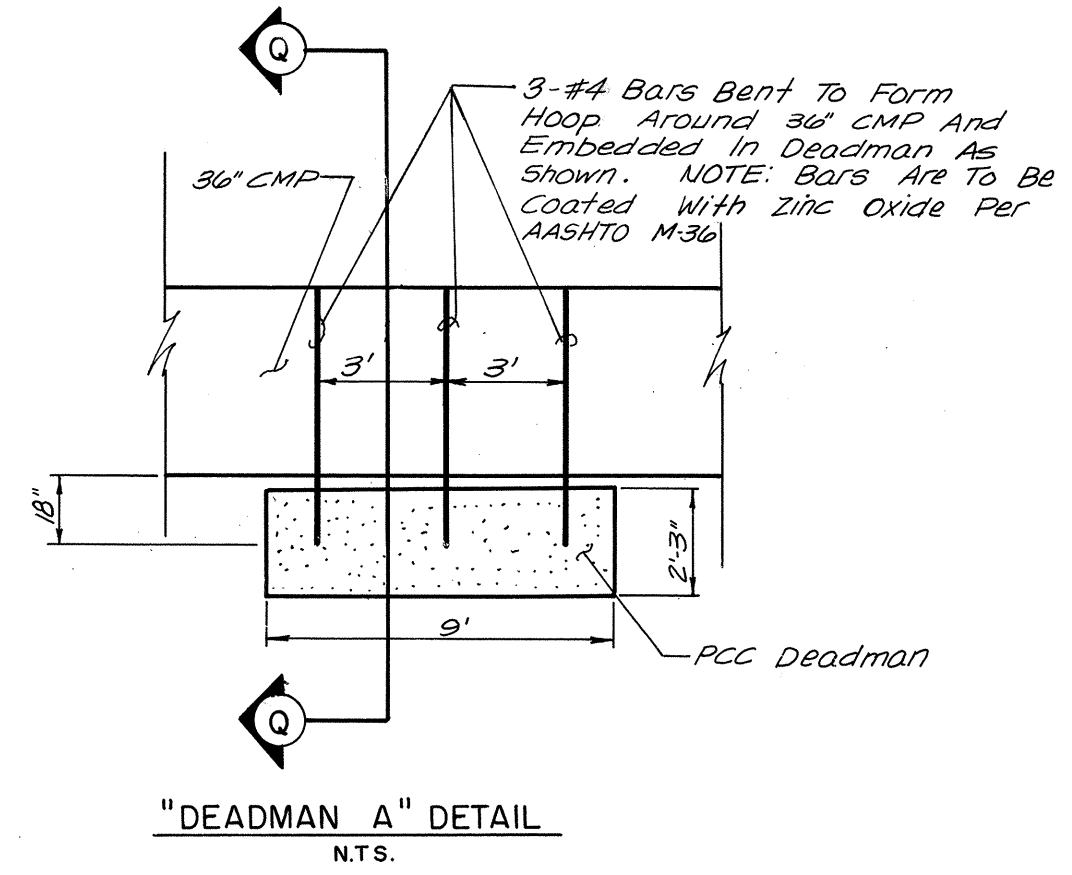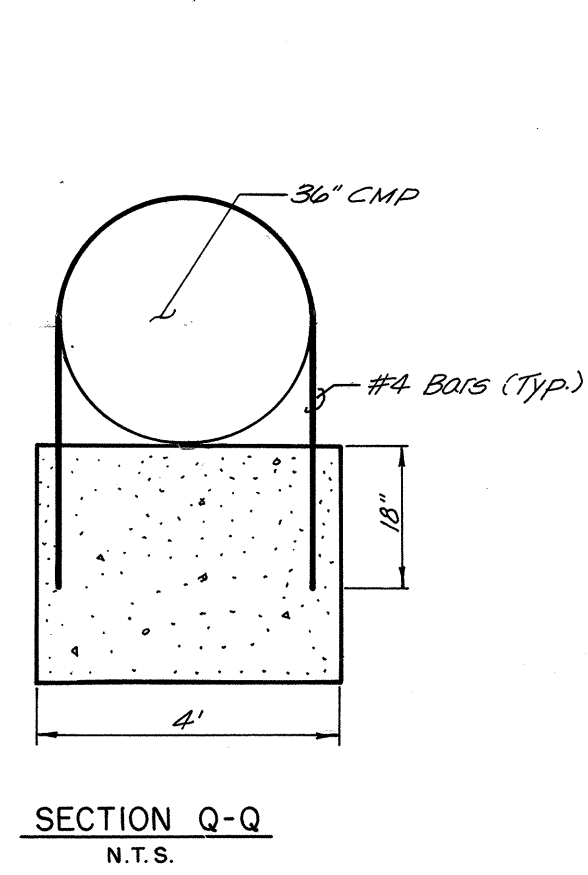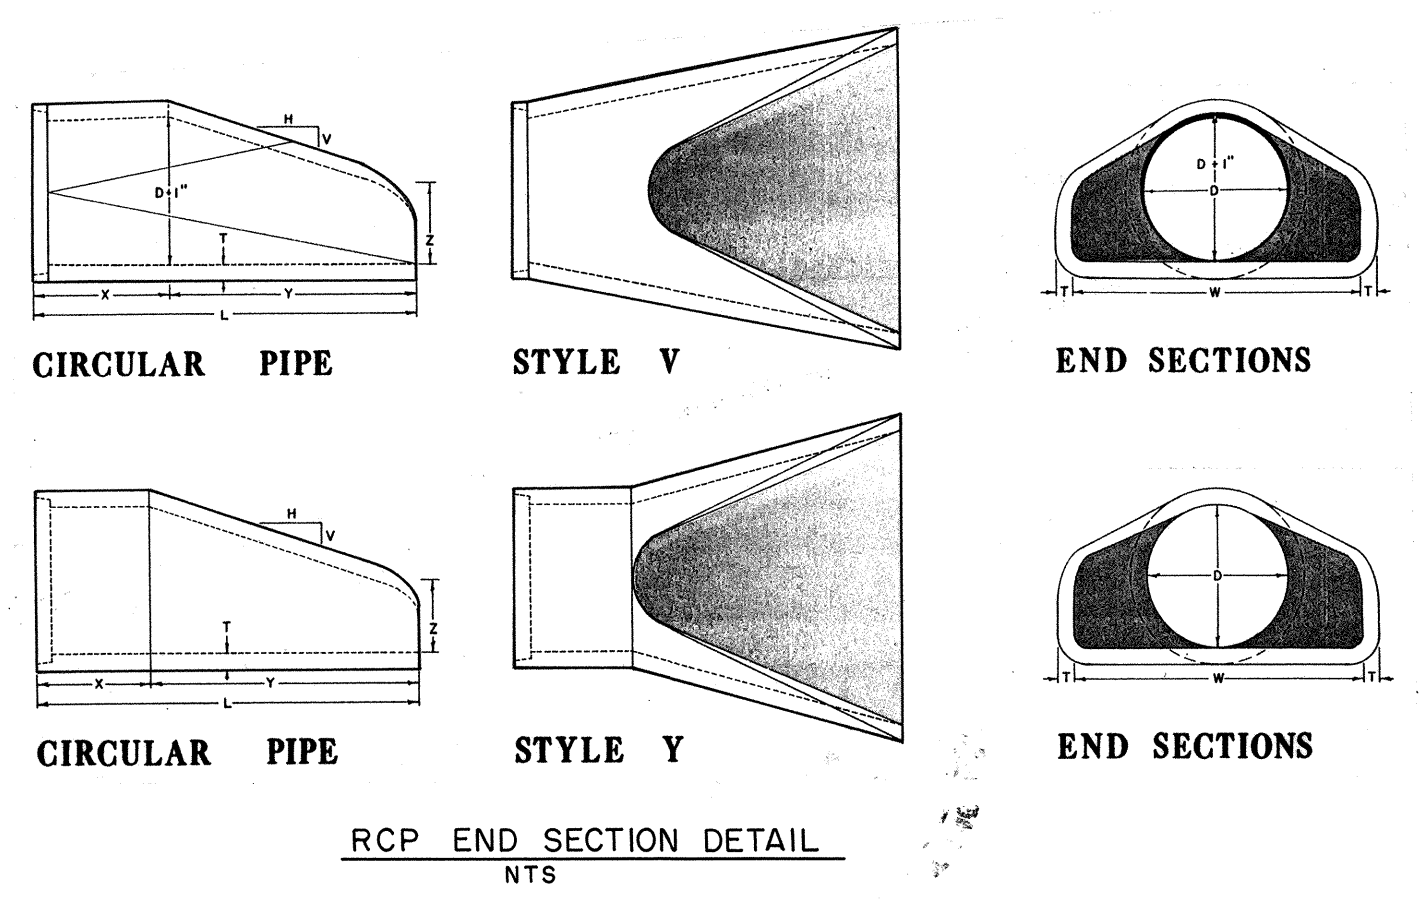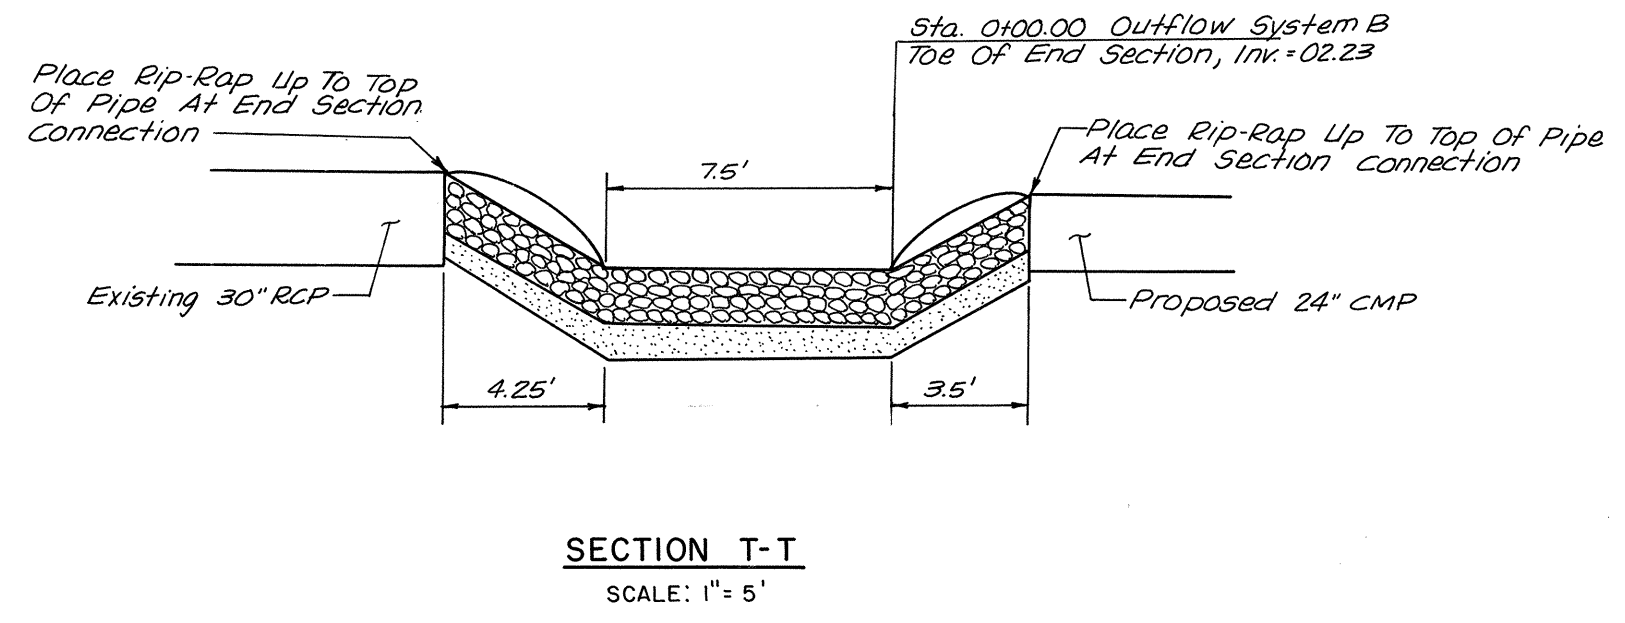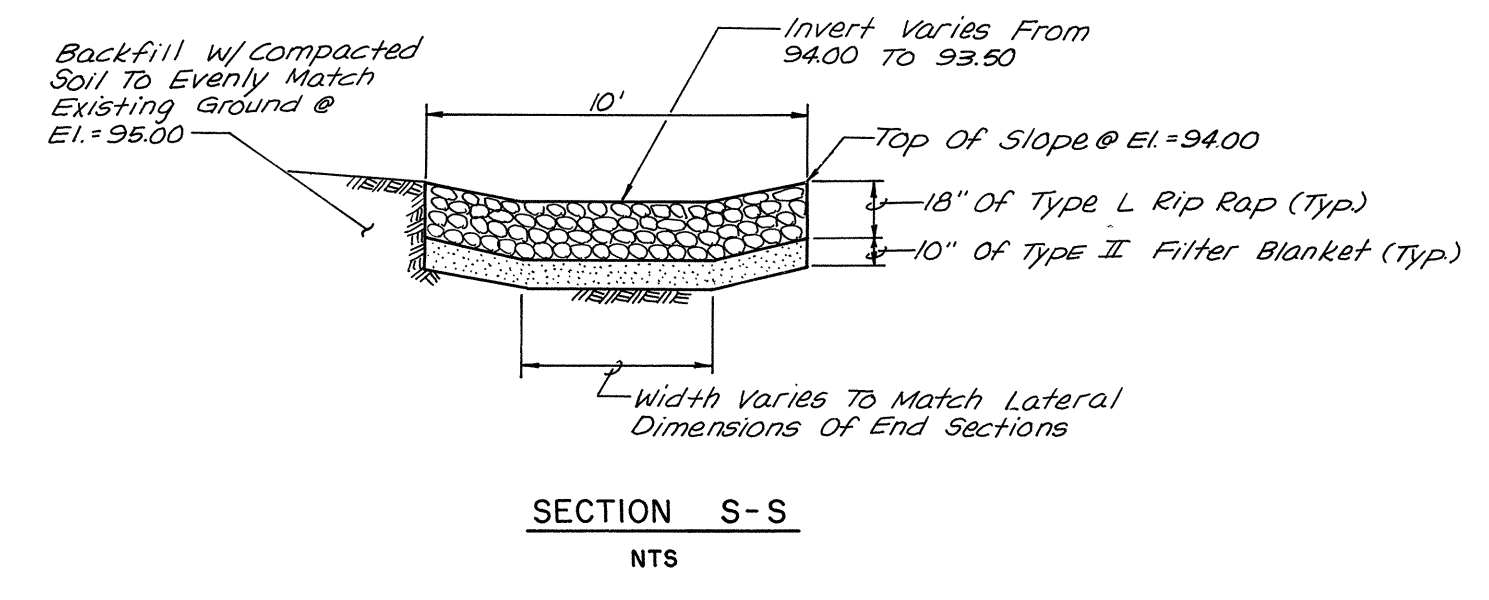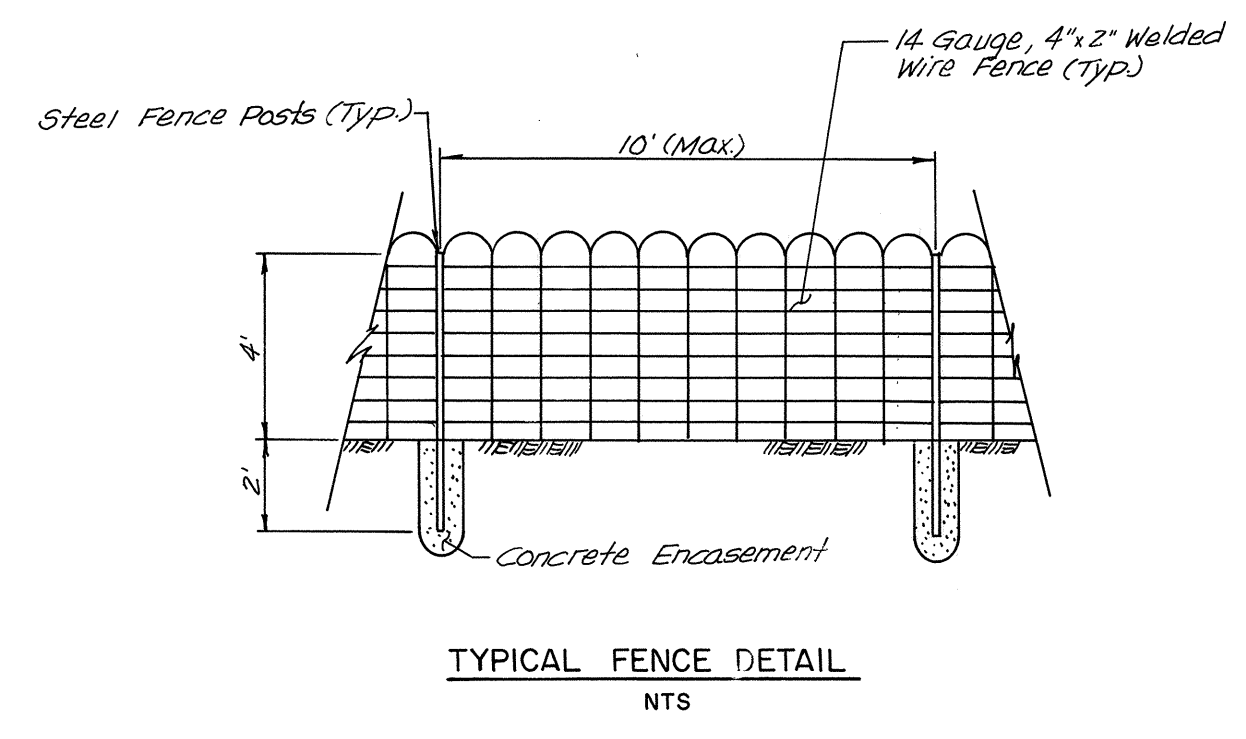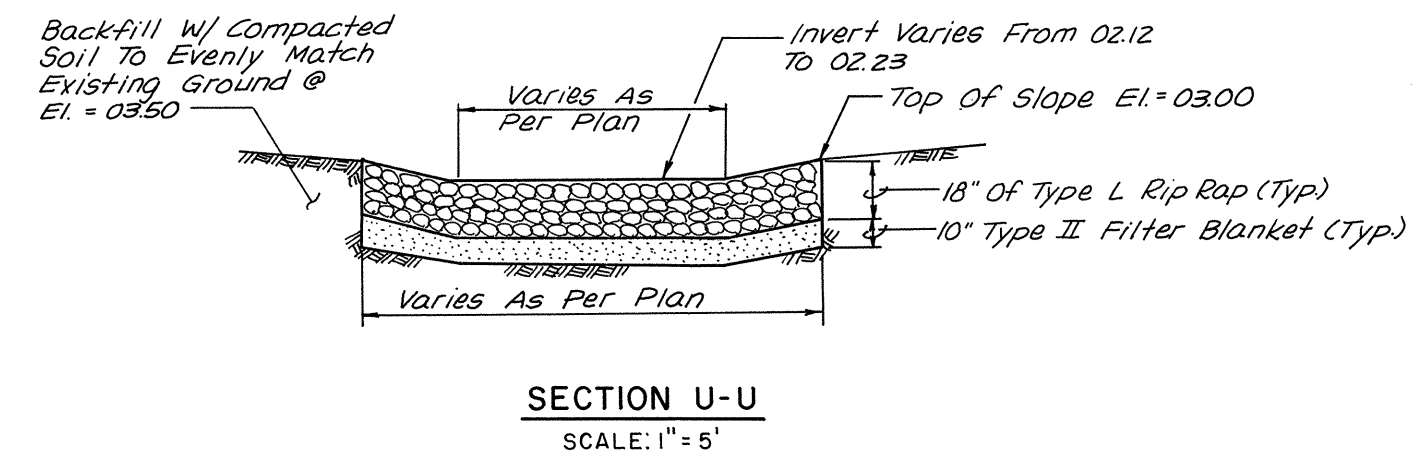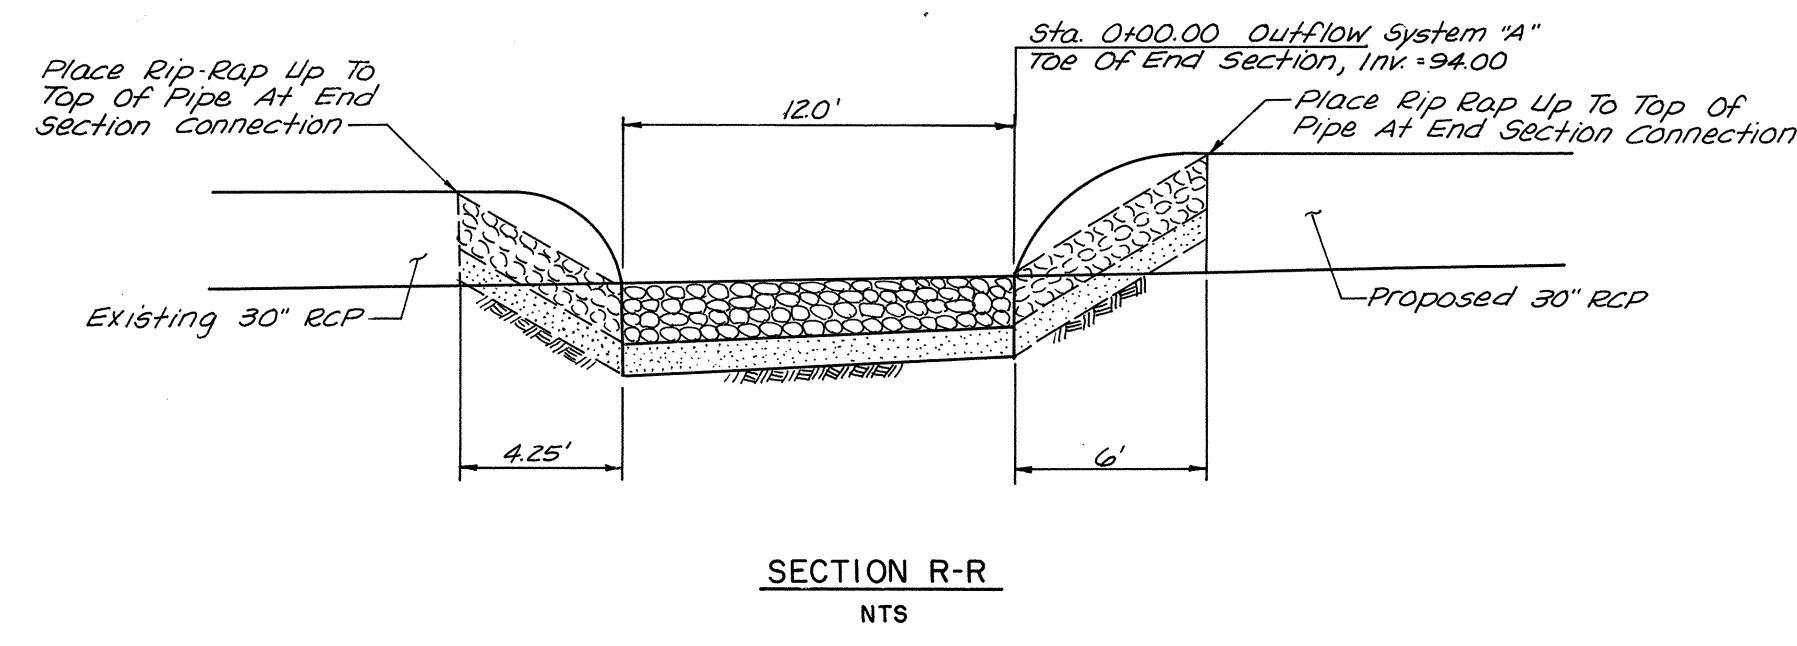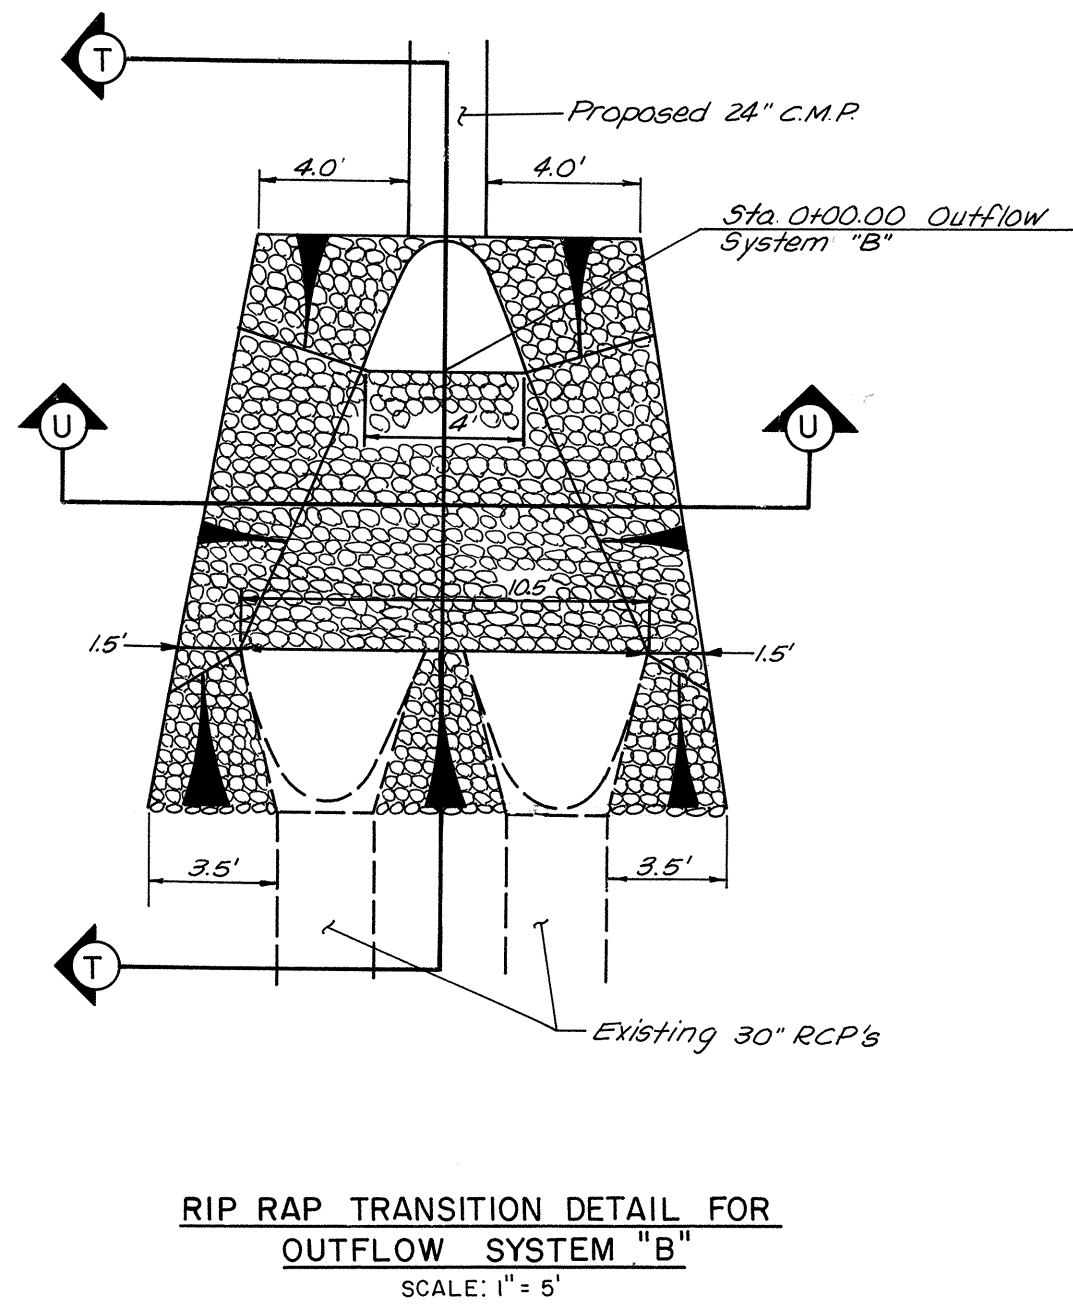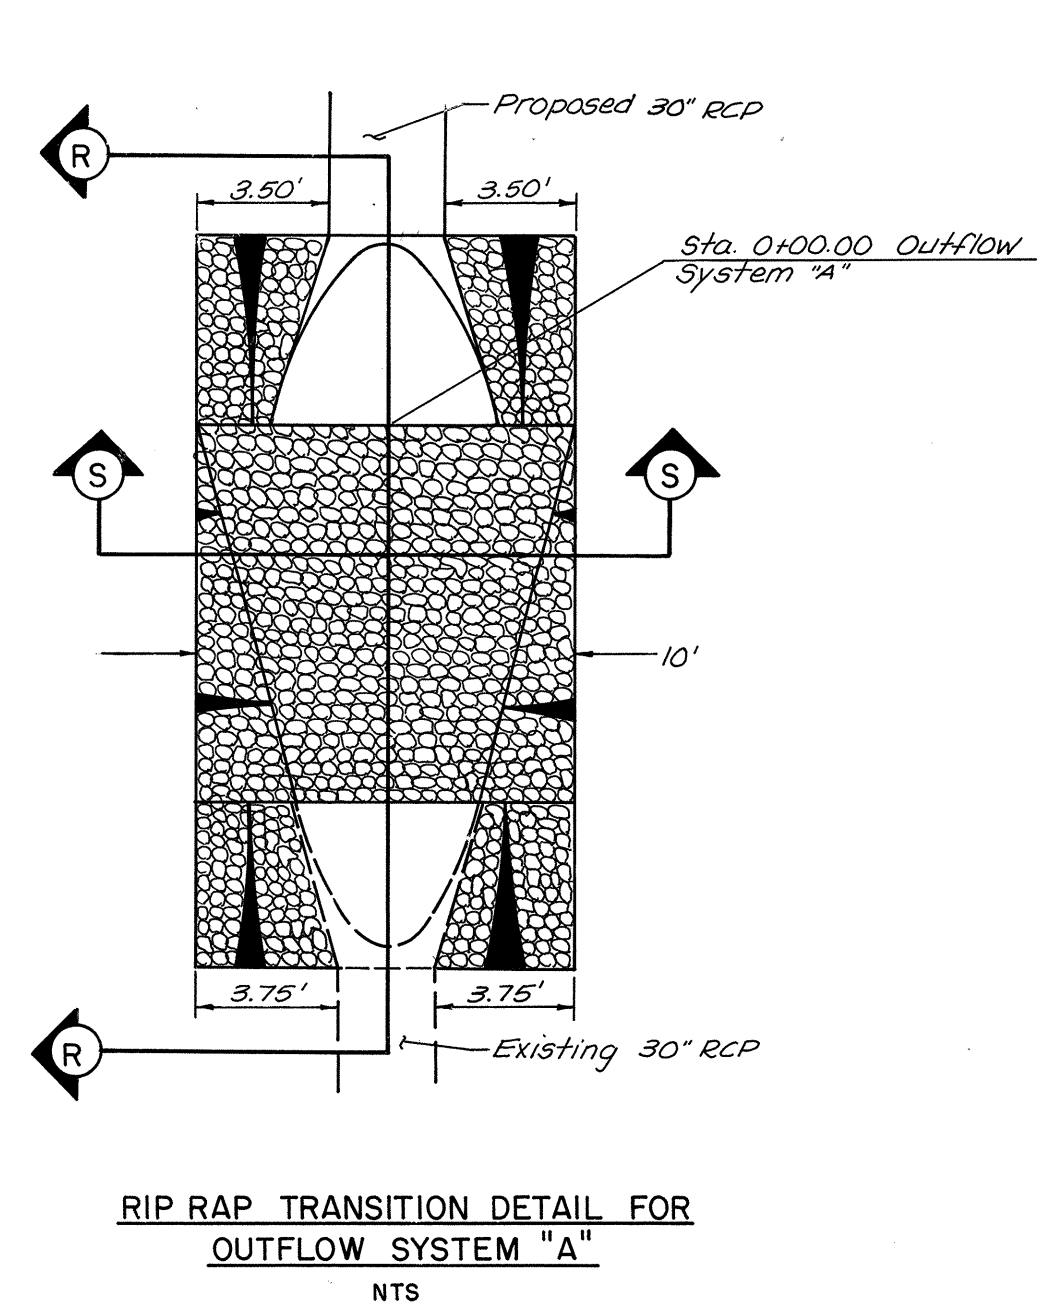


1	2	3	4	5	6	7	8	9	10	11	12
26	27	59	11	87							

SCALE:
AS NOTED


community sciences corporation
LAND PLANNING ENGINEERING SURVEYING
P.O. Box 1328 CORRAL, N.M. 87038

CITY OF ALBUQUERQUE MUNICIPAL DEVELOPMENT DEPARTMENT ENGINEERING DIVISION					
TITLE: COORS/MONTANO DRAINAGE DETENTION FACILITY					
CONSTRUCTION DETAILS					
APPROVALS	ENGINEER	DATE	APPROVALS	ENGINEER	DATE
City Engineer	<i>[Signature]</i>	4/19/96	Planning		
A.C.E.-Design			Traffic	<i>N.A. Dapala</i>	3-14-96
A.C.E.-Hydrology			Water Utilities	<i>N.A. Blythe</i>	3-14-96
DRAWING NO.	2759	MAP NO.	E-12	SHEET	11 OF 14

SURVEY INFORMATION			BENCH MARKS		AS BUILT INFORMATION	
FIELD NOTES			TOP OF STEEL RAIL RIGHT-OF-WAY MARKER STA.	CONTRACTOR		
NO.	BY	DATE	267 + 50, STAMPED "ACS BM 3-E12" LOCATED APPROXIMATELY 100 FEET NORTHEAST OF THE INTERSECTION OF COORS ROAD, N.W., (STATE ROAD #448) AND MONTANO ROAD, N.W., ON THE EAST RIGHT-OF-WAY, ELEVATION = 5005.143.	WORK STARTED BY	DATE	
				INSPECTORS FIELD MEASUREMENT BY	DATE	
				VERIFICATION BY	DATE	
				CONTRACTOR'S CORRECTION BY	DATE	
				MICRO-FILM INFORMATION		
				RECORDED BY	DATE	
				NO		

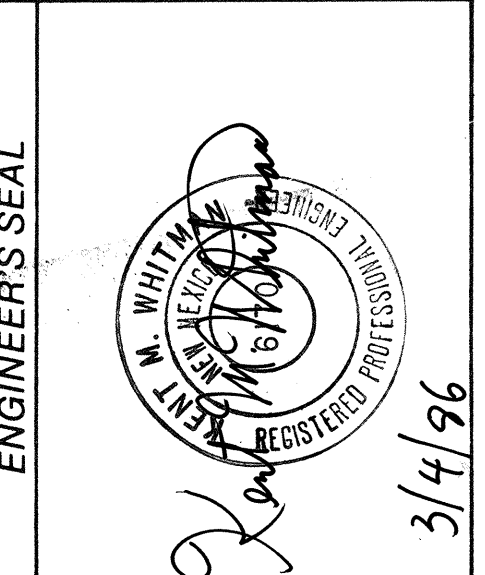

REMARKS	BY	DATE
DESIGN		DATE DEC, 1995
REVISIONS		DATE DEC, 1995
DESIGNED BY M.J.Y.		DATE DEC, 1995
DRAWN BY C.S.S.		DATE DEC, 1995
CHECKED BY M.J.Y.		DATE DEC, 1995

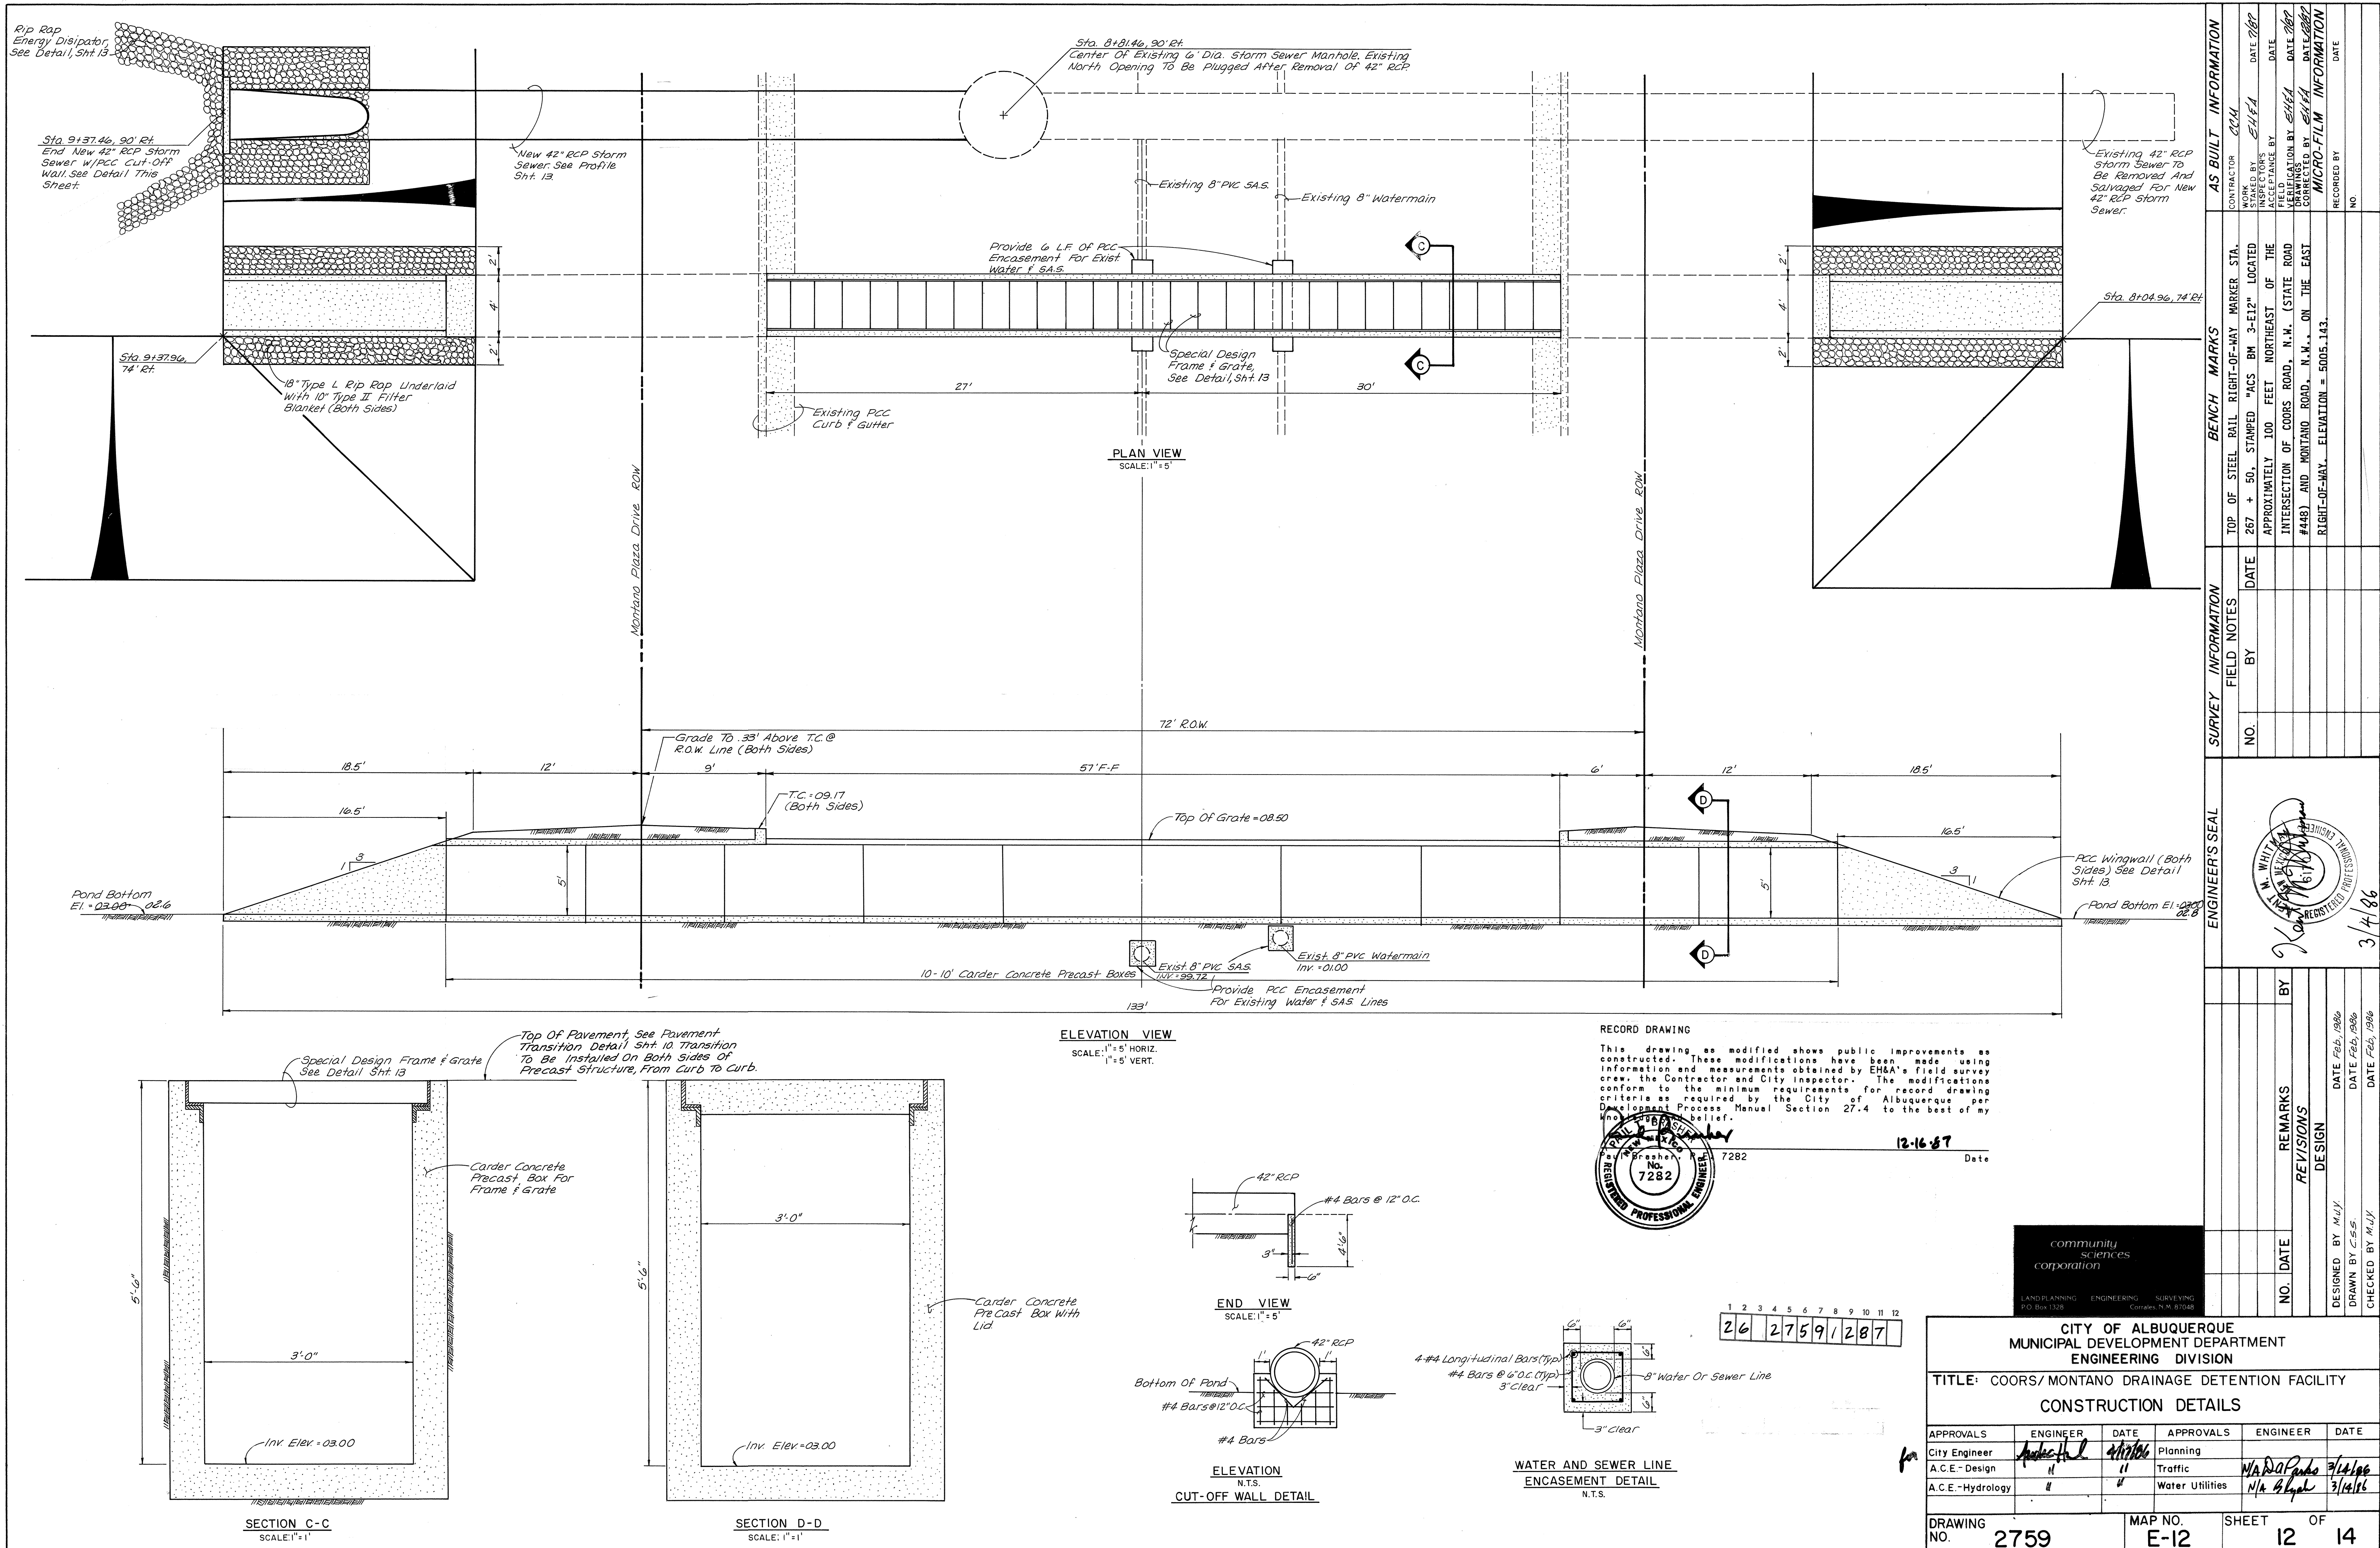

APPROVALS	ENGINEER	DATE	APPROVALS	ENGINEER	DATE
City Engineer	<i>[Signature]</i>	4/17/86	Planning		
A.C.E.- Design	<i>[Signature]</i>		Traffic	<i>N/A D.A. [Signature]</i>	3-14-86
A.C.E.- Hydrology	<i>[Signature]</i>		Water Utilities	<i>N/A B. [Signature]</i>	3-14-86

DRAWING NO. 2759

MAP NO. E-12

SHEET 13 OF 14

