



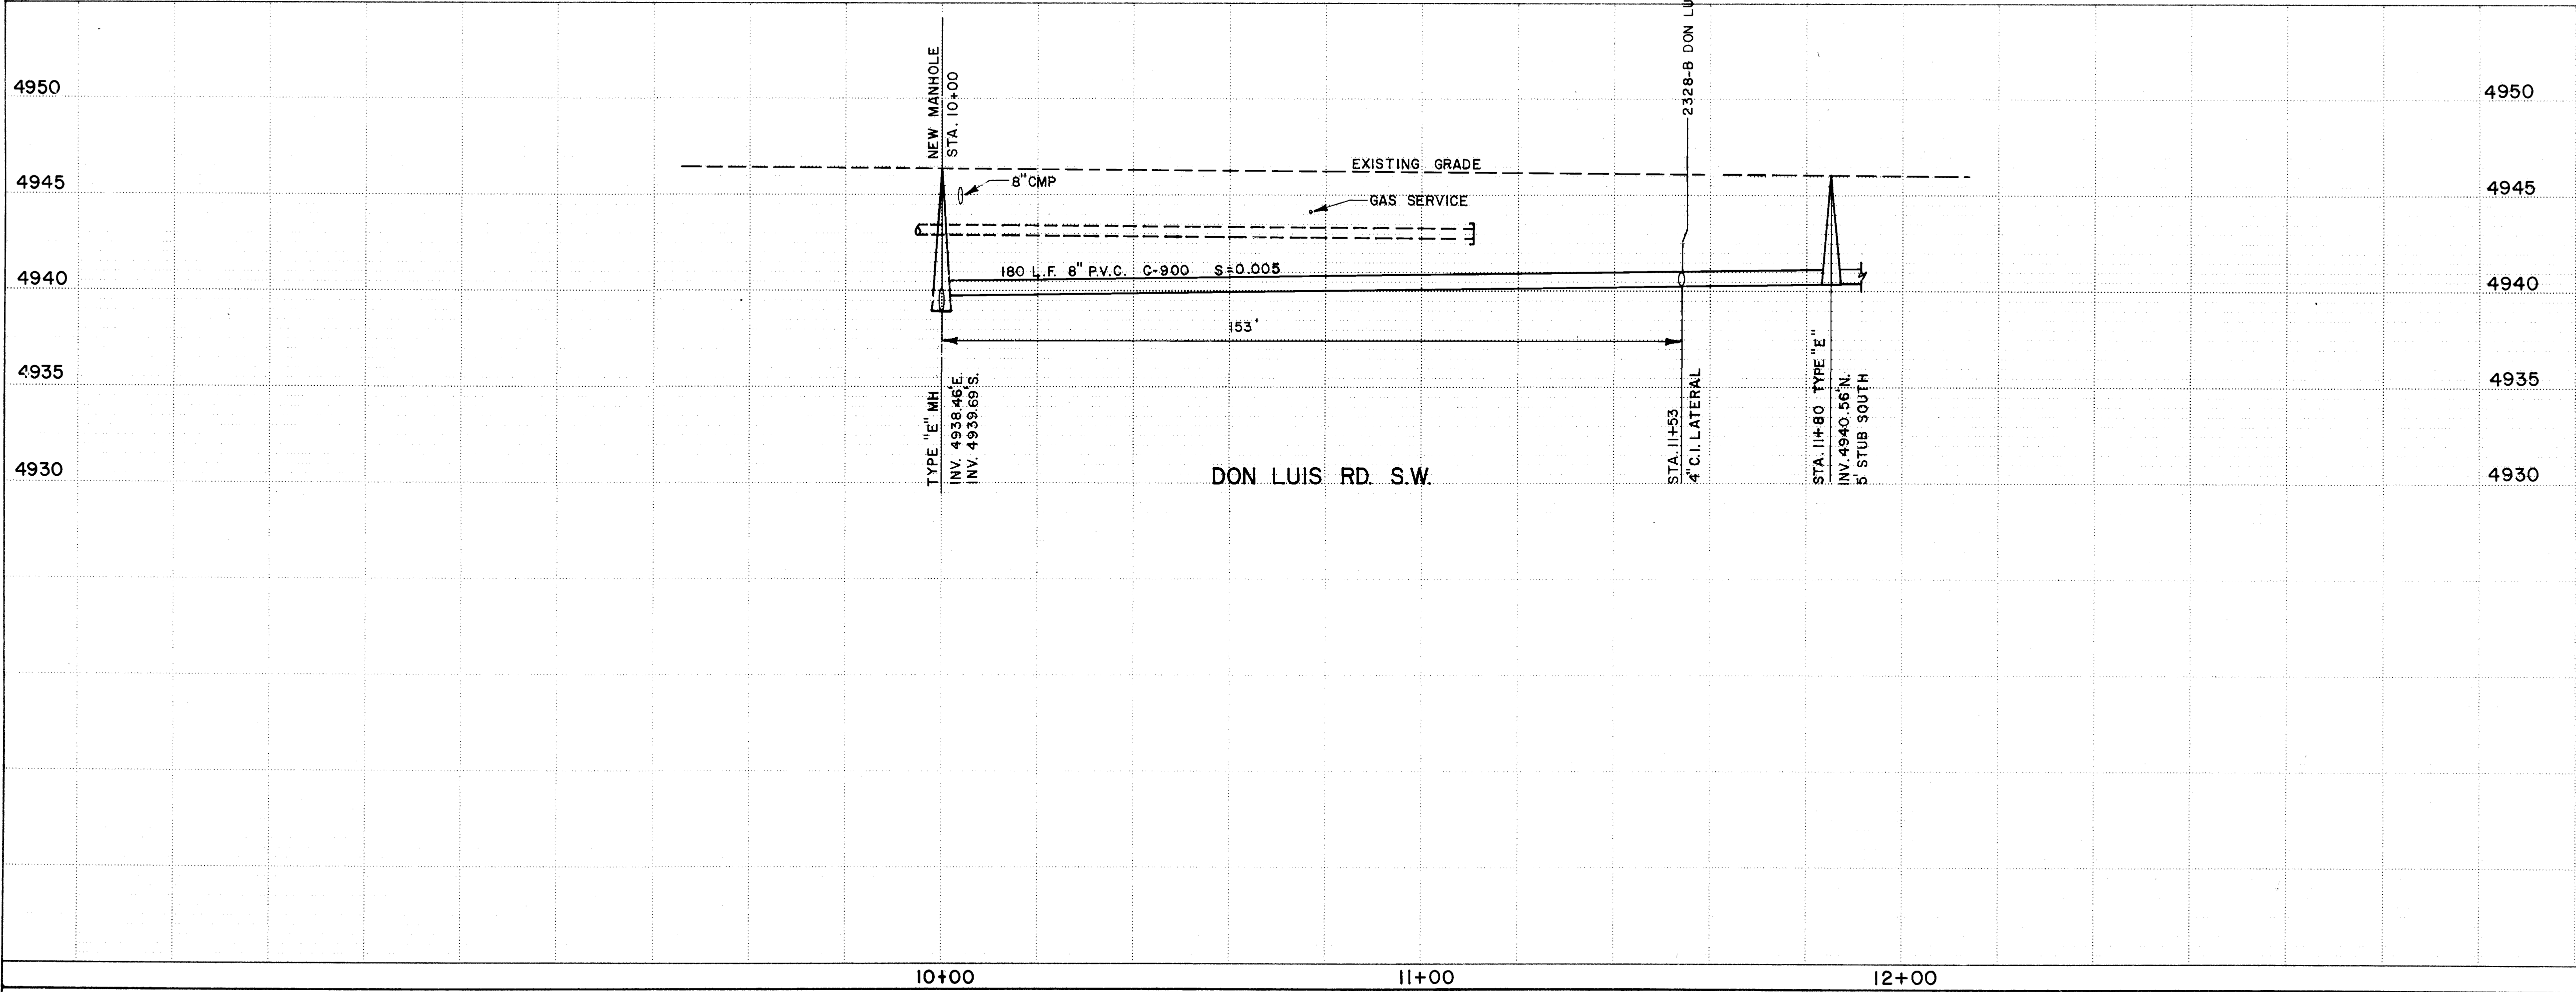

PLAN
SCALE: 1"=20'
PROFILE
SCALE: 1"=20' HORIZ.
1"=5' VERT.

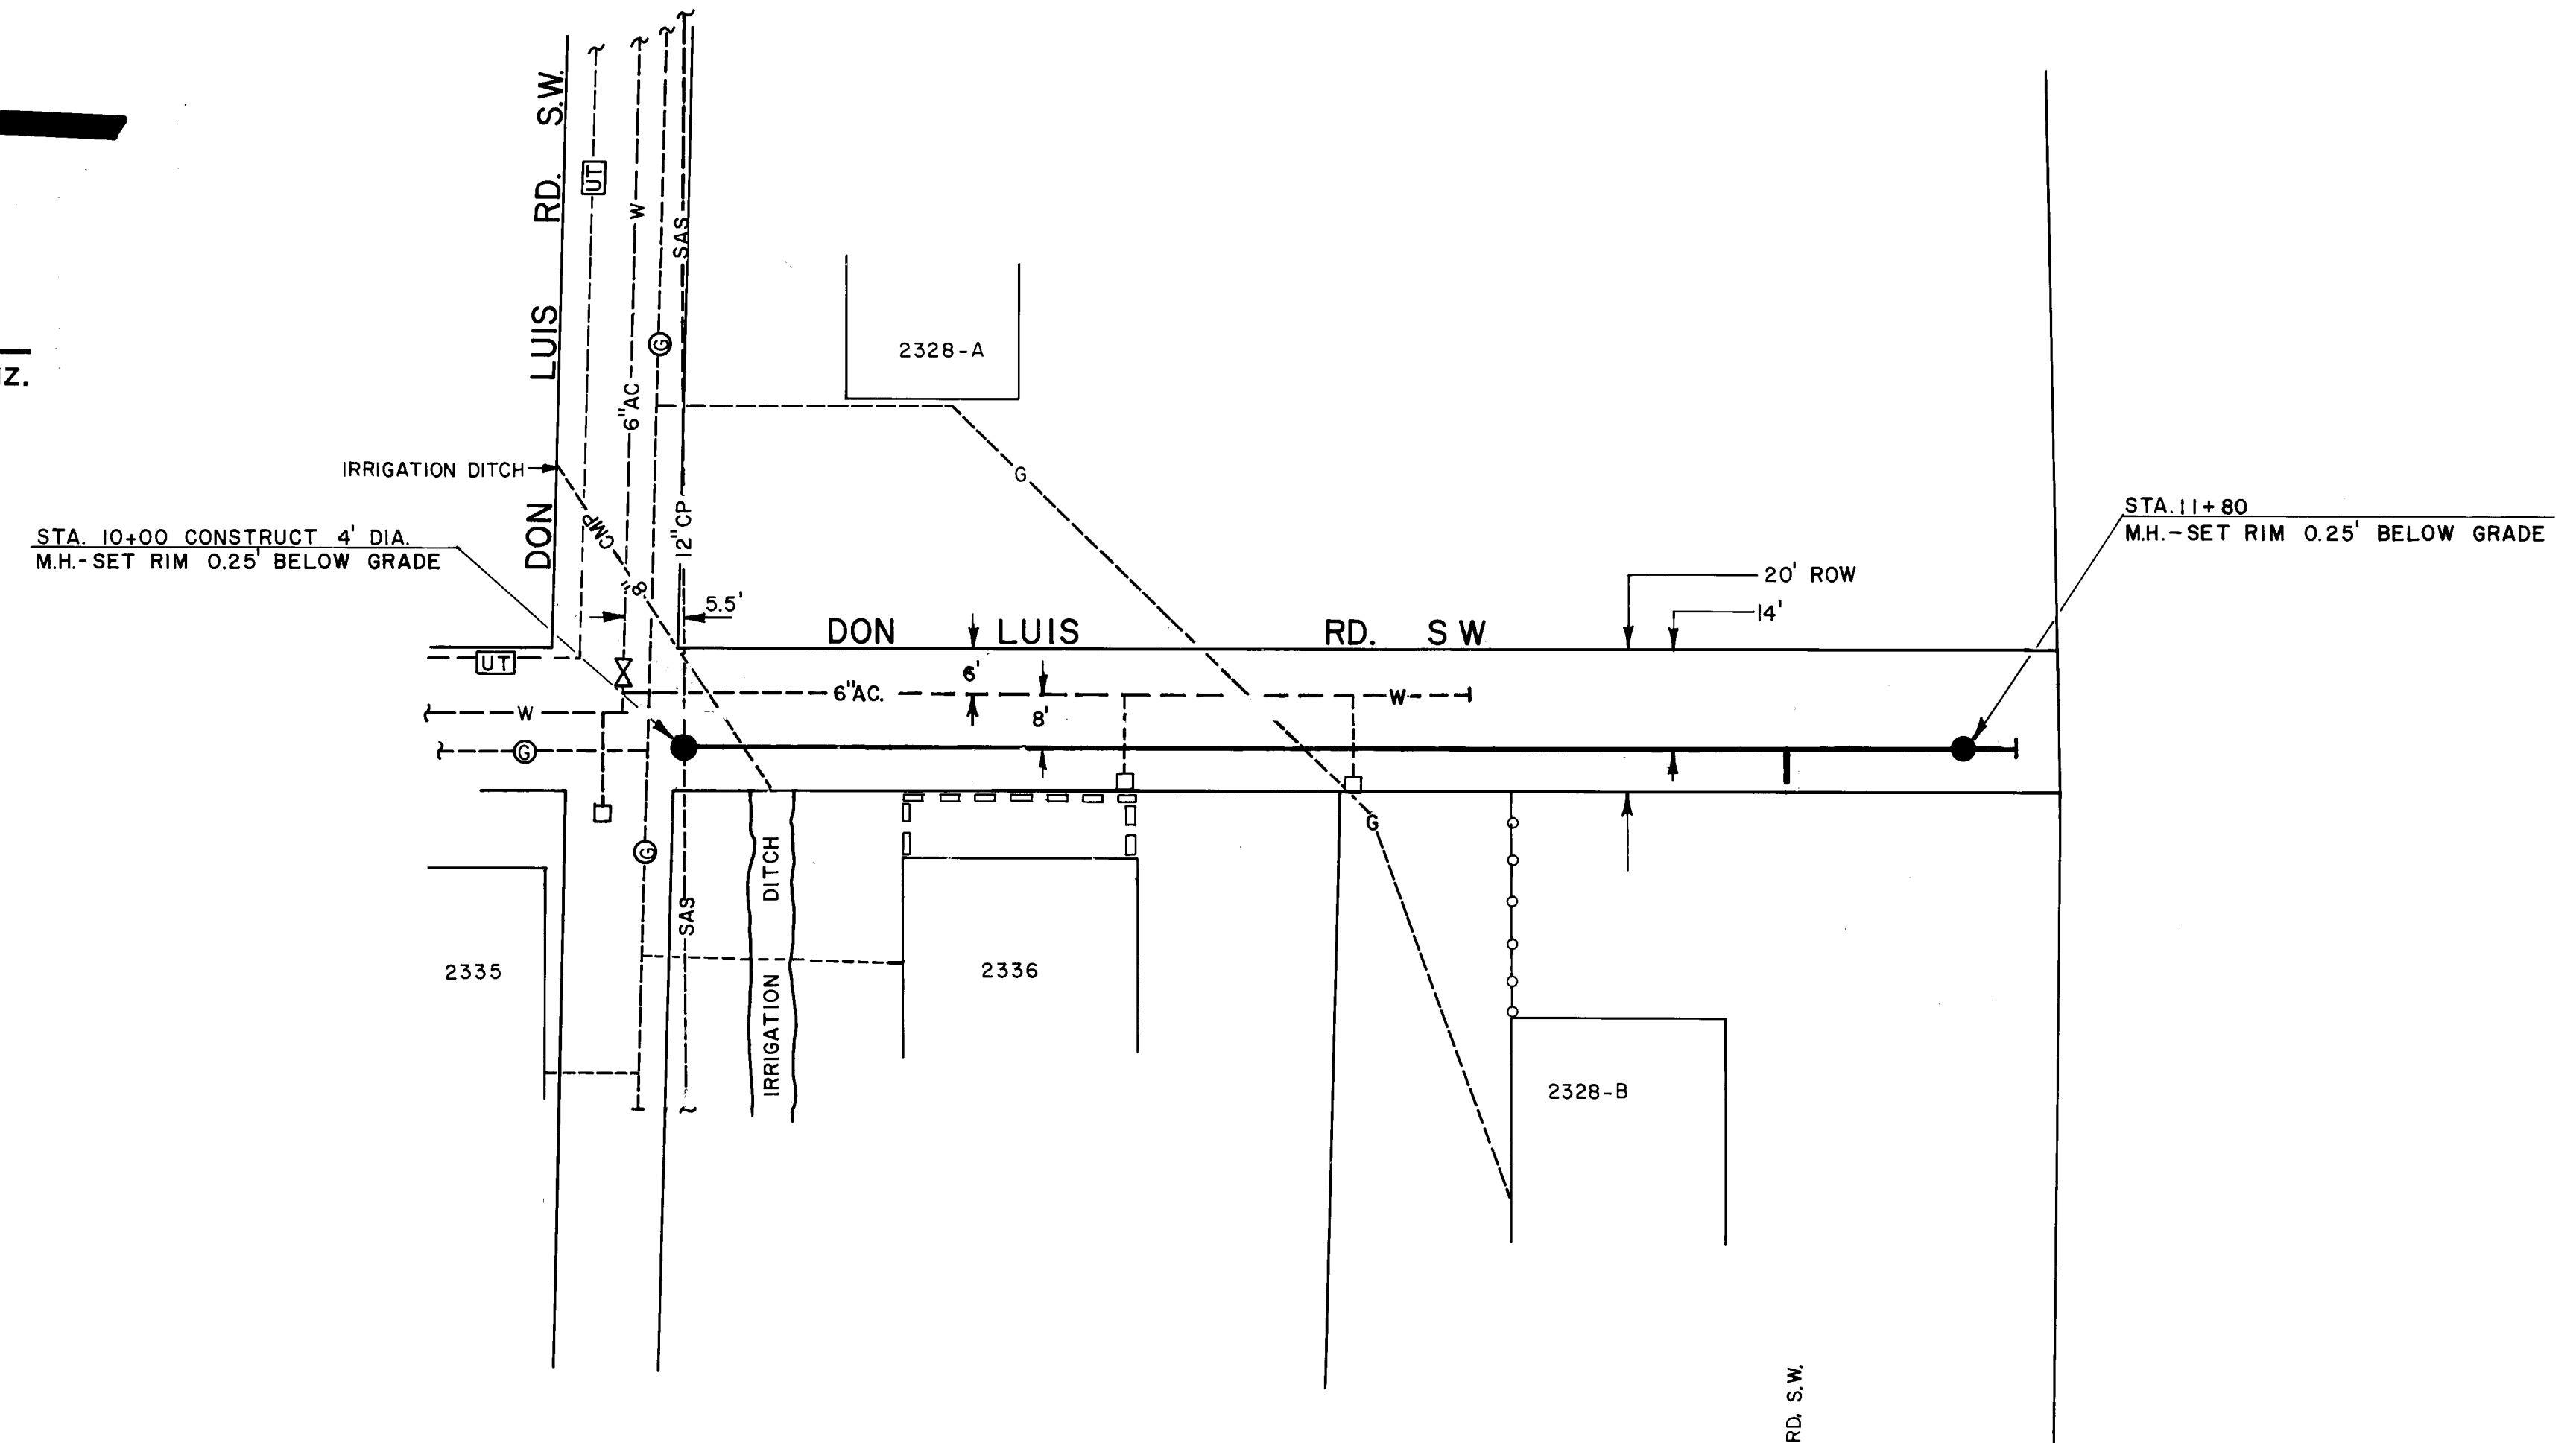

GENERAL NOTES

1. ALL WORK DETAILED ON THESE PLANS TO BE PERFORMED UNDER CONTRACT, EXCEPT AS OTHERWISE STATED OR PROVIDED FOR HEREON, SHALL BE CONSTRUCTED IN ACCORDANCE WITH THE NEW MEXICO STANDARD SPECIFICATIONS FOR PUBLIC WORKS CONSTRUCTION - 1979 EDITION.

2. TWO(2) WORKING DAYS PRIOR TO ANY EXCAVATION, CONTRACTOR MUST CONTACT LINE LOCATING SERVICE, 765-1234, FOR LOCATION OF EXISTING UTILITIES.

3. PRIOR TO CONSTRUCTION, THE CONTRACTOR SHALL EXCAVATE AND VERIFY THE HORIZONTAL AND VERTICAL LOCATION OF ALL OBSTRUCTIONS. SHOULD A CONFLICT EXIST, THE CONTRACTOR SHALL NOTIFY THE PROJECT ENGINEER SO THAT THE CONFLICT CAN BE RESOLVED WITH MINIMUM AMOUNT OF DELAY.

AS BUILT INFORMATION			BENCH MARKS			SURVEY INFORMATION			ENGINEER'S SEAL		
CONTRACTOR	INTER-WEST	DATE 10/85	11-K12	NW corner of the intersection of Gonzales Rd. and Atrisco Rd., S.W.	60-penny nail in east side of power pole no. BN 87. Elev. 4946.738	NO.	BY	DATE			
DESIGNED BY	B.D.	DATE 10/85	DATE								
FIELD CHECKED BY	W.U.D.	DATE 10/85	REVISIONS								
RECORDED BY	DATE		NO.								
MICRO-FILM INFORMATION			REVISIONS			DESIGNED BY J. ROCHA			DATE AUG.		
						DRAWN BY J. ROCHA			DATE AUG.		
						CHECKED BY			DATE		

CITY OF ALBUQUERQUE
MUNICIPAL DEVELOPMENT DEPARTMENT
ENGINEERING DIVISION

TITLE: 8" SANITARY SEWER EXTENSION
DON LUIS RD. S.W.

APPROVALS	ENGINEER	DATE	APPROVALS	ENGINEER	DATE
City Engineer			Liquid Waste		
A.C.E. - Design			Traffic		
A.C.E. - Hydrology			Water		

DRAWING NO. 2779 MAP NO. K-12 SHEET 1 OF 1