



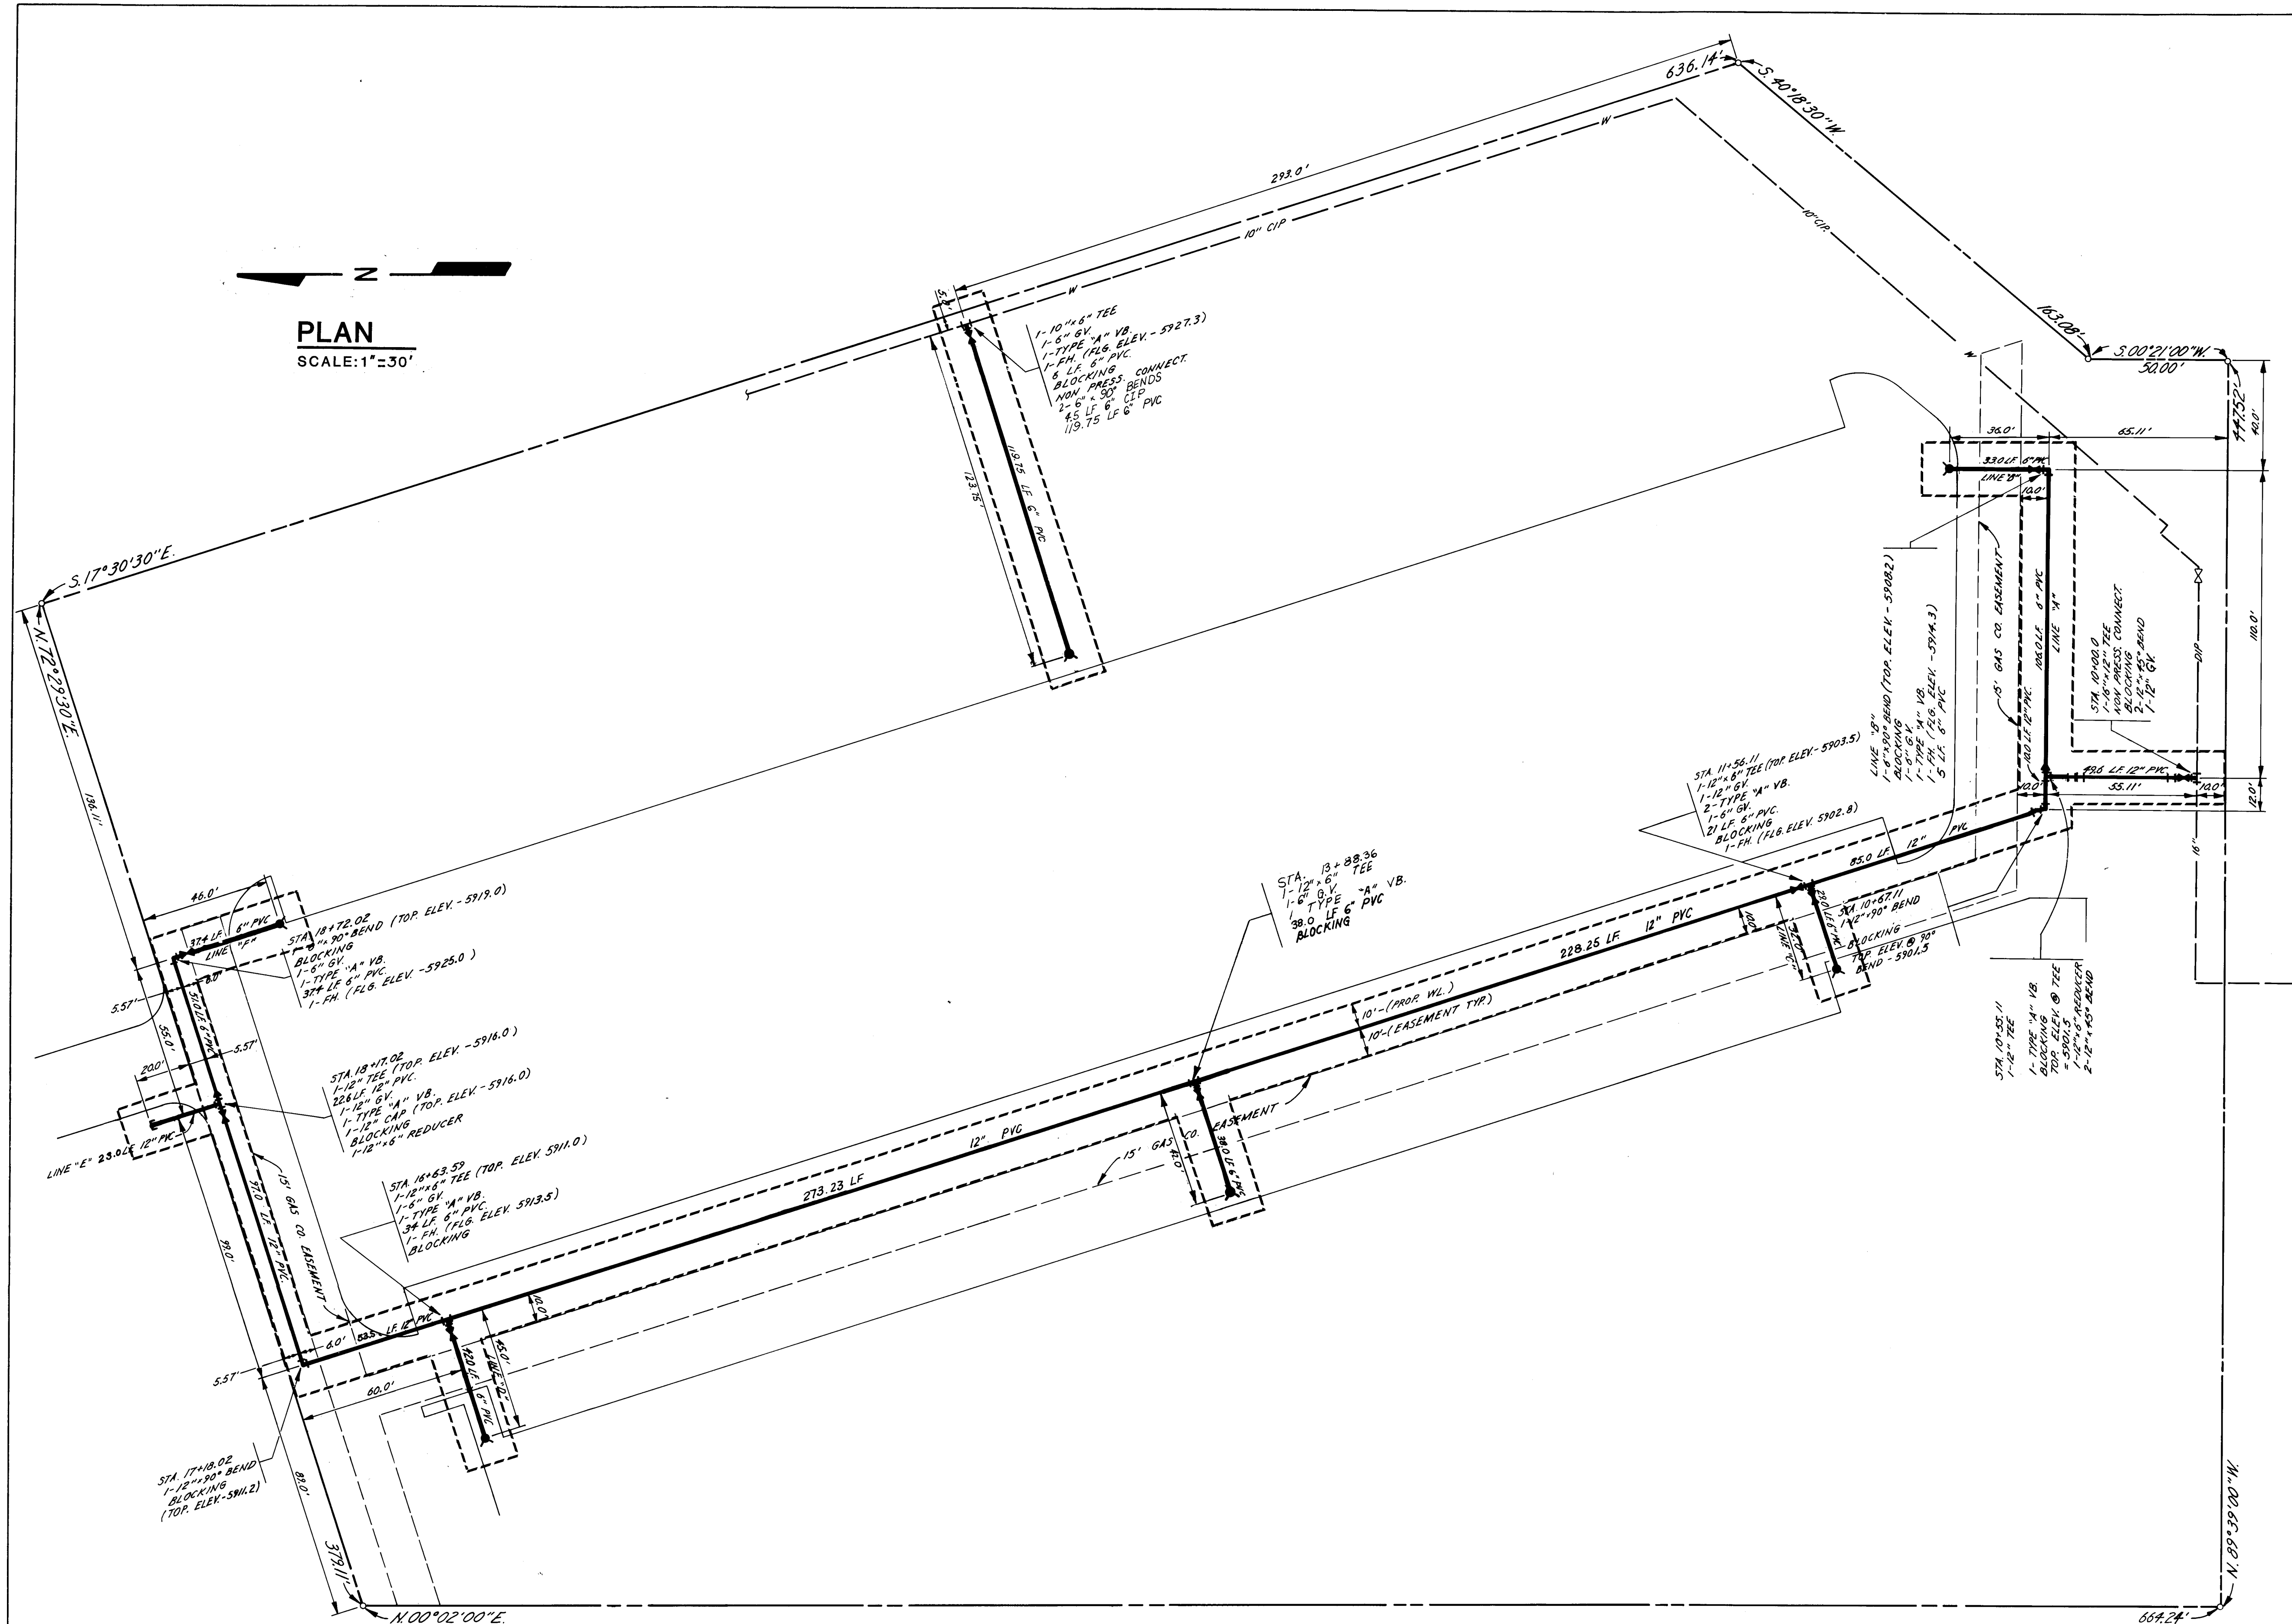

NOTE:

- 1) ALL PROPOSED GRADE ELEV. & FACE OF CURB INFO. OBTAINED FROM CONSULT.; (TERRA SOL INC.) GRADING PLAN FOR TRAMWAY APT. COMPLEX, SHT. 2 OF 2
- 2) ALL BOUNDARY DISTANCES OBTAINED FROM SUM. PLAT SP-09-13-599
- 3) STATIONING ALONG @ WATERLINE.

ENGINEER'S SEAL		SURVEY INFORMATION		BENCH MARKS		AS BUILT INFORMATION	
		FIELD NOTES					
		NO.	BY	DATE			
						CONTRACTOR SUNDANCE MECHANICAL	
						WORK STAKED BY SUNDANCE MECH. DATE 1/84	
						INSPECTOR'S FIELD CHECK BY WED DATE 5/84	
						FIELD PLANCE BY WED DATE 5/84	
						VERIFICATION BY WED DATE 5/84	
						CORRECTED BY FJA DATE 5/84	
						MICRO-FILM INFORMATION	
						RECORDED BY DATE	
						NO	

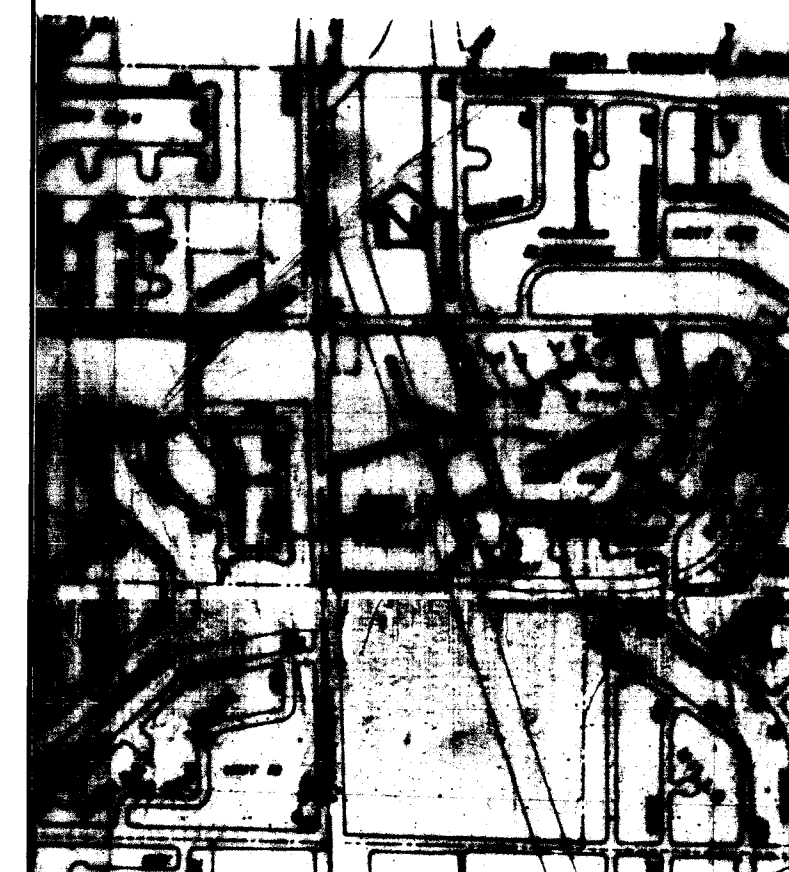

LOCATION MAP
SCALE : 1" = 1000'

WATER RESOURCES DEPARTMENT
APPROVAL: *[Signature]*
Date: 1/2/80

CITY OF ALBUQUERQUE
WATER RESOURCES DEPARTMENT
ENGINEERING DIVISION



TITLE: TRAMWAY APT COMPLEX - FIRELINE

APPROVALS	ENGINEER	DATE	APPROVALS	ENGINEER	DATE
City Engineer			Liquid Waste		
A.C.E - Design			Traffic		
A.C.E -Hydrology			Water		

DRAWING NO. 2781	WRD CHIEF ENG. MAP NO. 6-23	SHEET / OF 2
---------------------	-----------------------------	--------------

TRAMWAY BLVD. NE.

1	2	3	4	5	6	7	8	9	10
26			27	81	01	86			

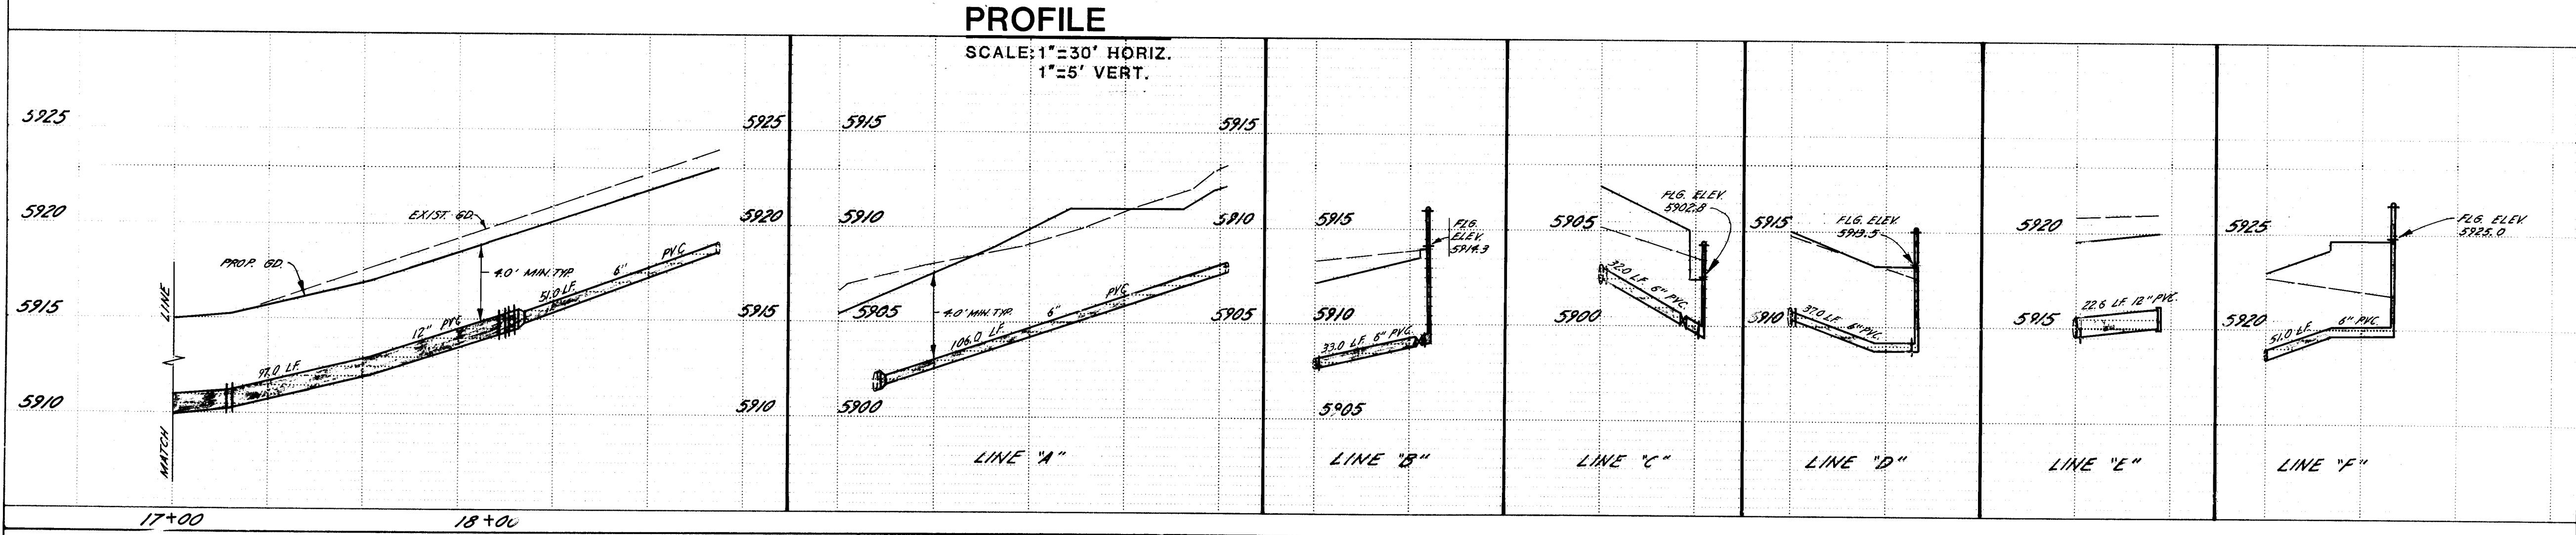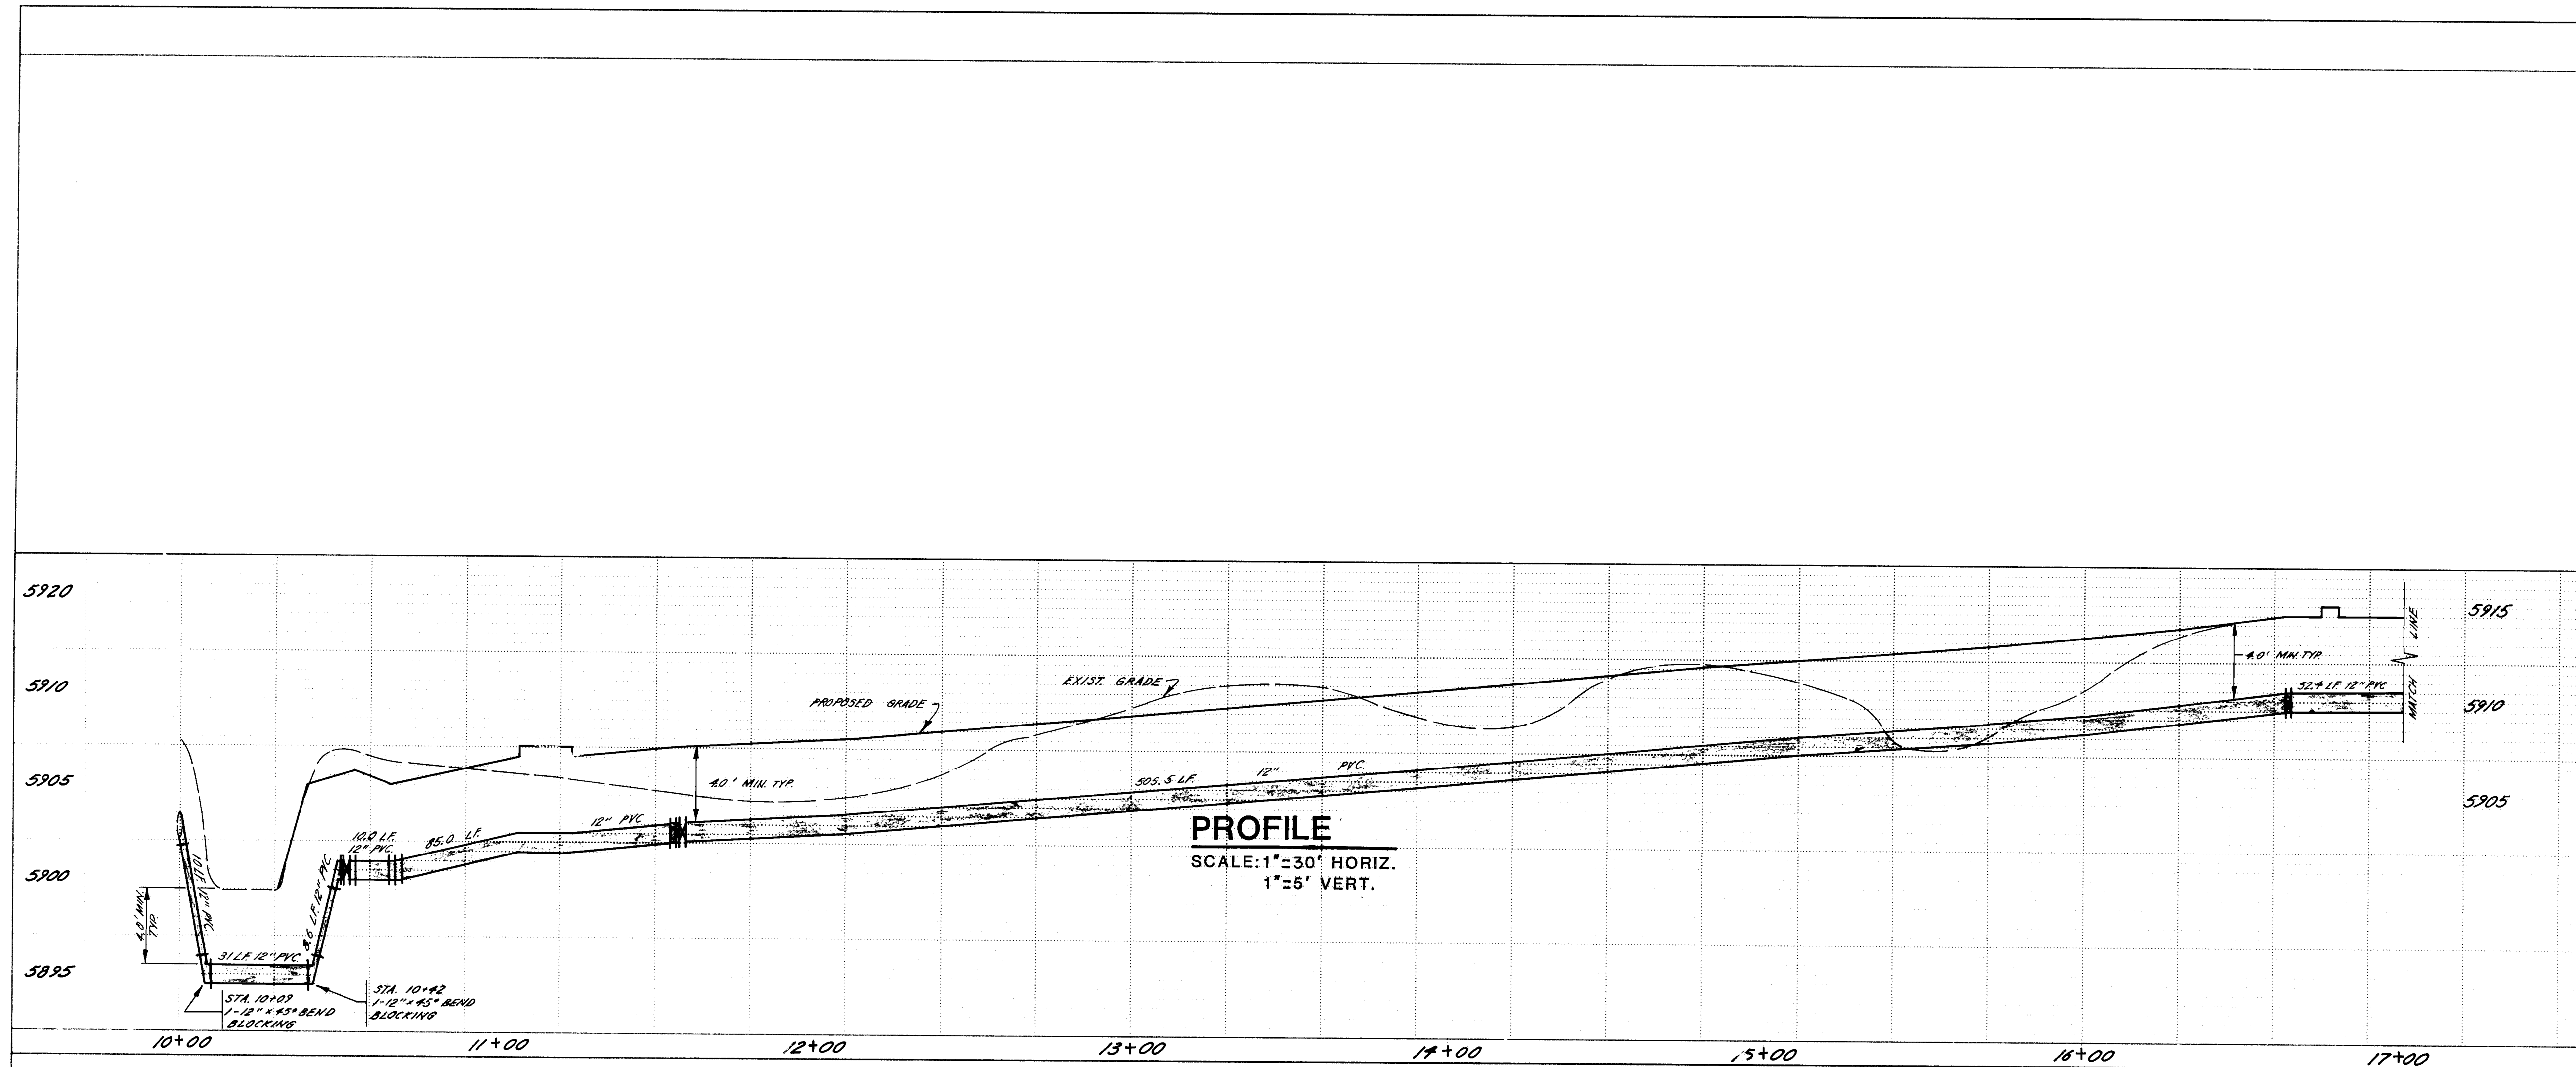

1 2 3 4 5 6 7 8 9 10 11 12
26 27 81 02 86

Ben J. Hall
1/7/86

NOTE: ALL PROP WATERLINES MUST HAVE A 4.0' MIN. COVER FROM PROPOSED GRADE.

CITY OF ALBUQUERQUE WATER RESOURCES DEPARTMENT ENGINEERING DIVISION					
TITLE: TRAMWAY APT. COMPLEX-FIRELINE PROFILE					
APPROVALS	ENGINEER	DATE	APPROVALS	ENGINEER	DATE
City Engineer			Liquid Waste		
ACE - Design			Traffic		
ACE - Hydrology			Water		
DRAWING NO. 2781		WRD CHIEF ENG. MAP NO. 6-23 SHEET 2 OF 2			

SURVEY INFORMATION		BENCH MARKS		AS BUILT INFORMATION	
NO.	BY	DATE	BM - STD. OLD BRASS CAP. LOCATED AT THE INTERSECTION OF MONTGOMERY & TRAMWAY APPROX. 1.0' BELOW PRESENT UNDER A MM LID. ELEV. - 5906.43	CONTRACT NO.	DATE
				INSPECTOR'S FIELD CHECK BY	DATE
				VERIFICATION BY	DATE
				CORRECTED BY	DATE
				RECORDED BY	DATE
					NO.