


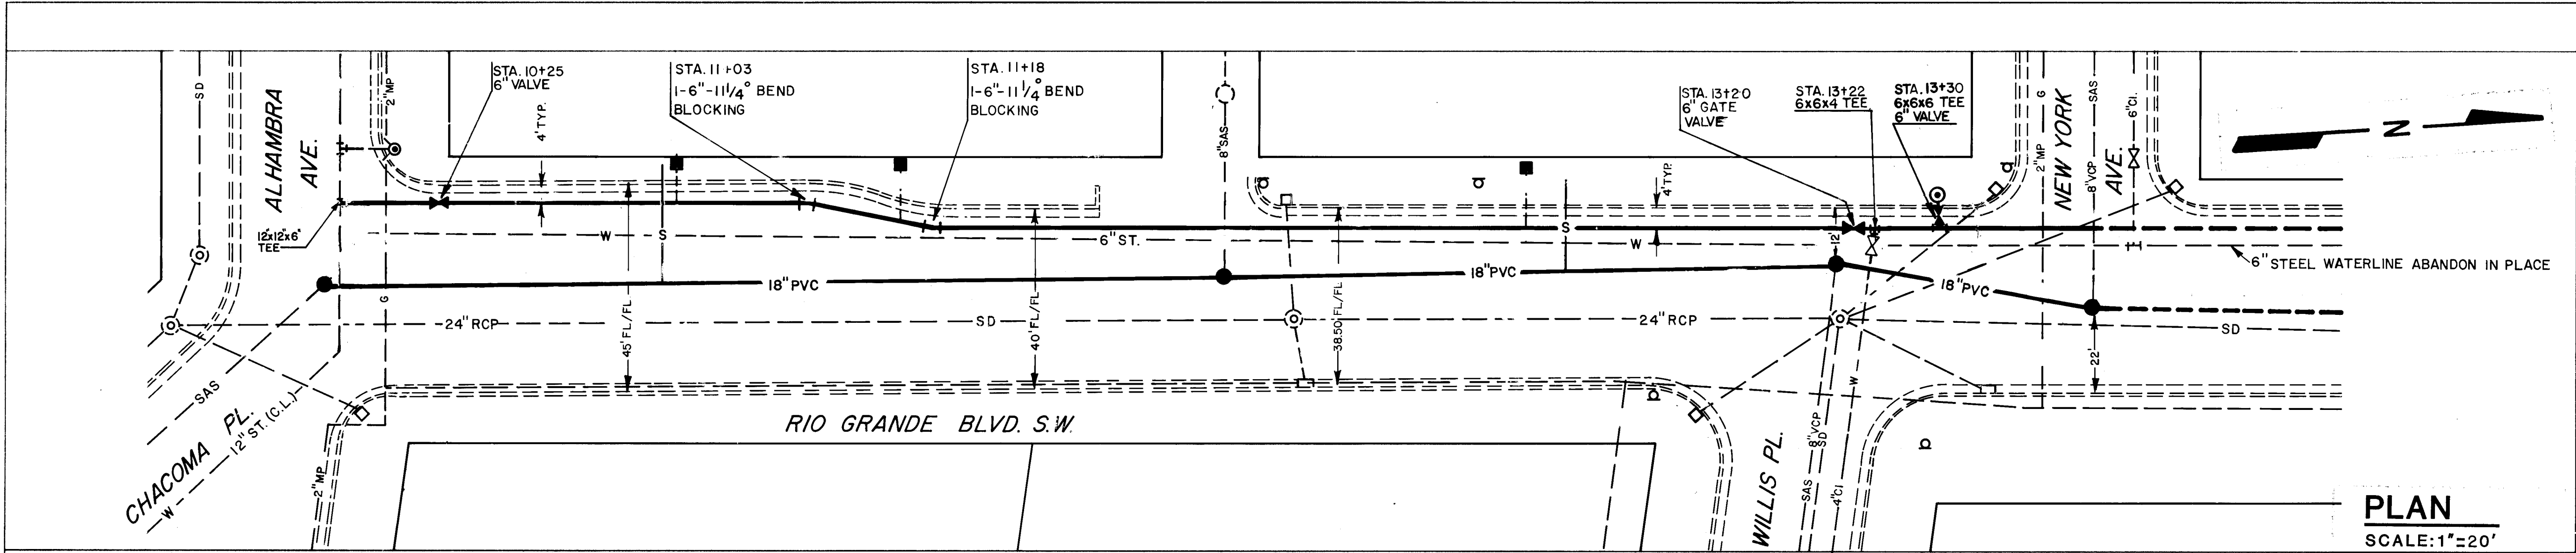


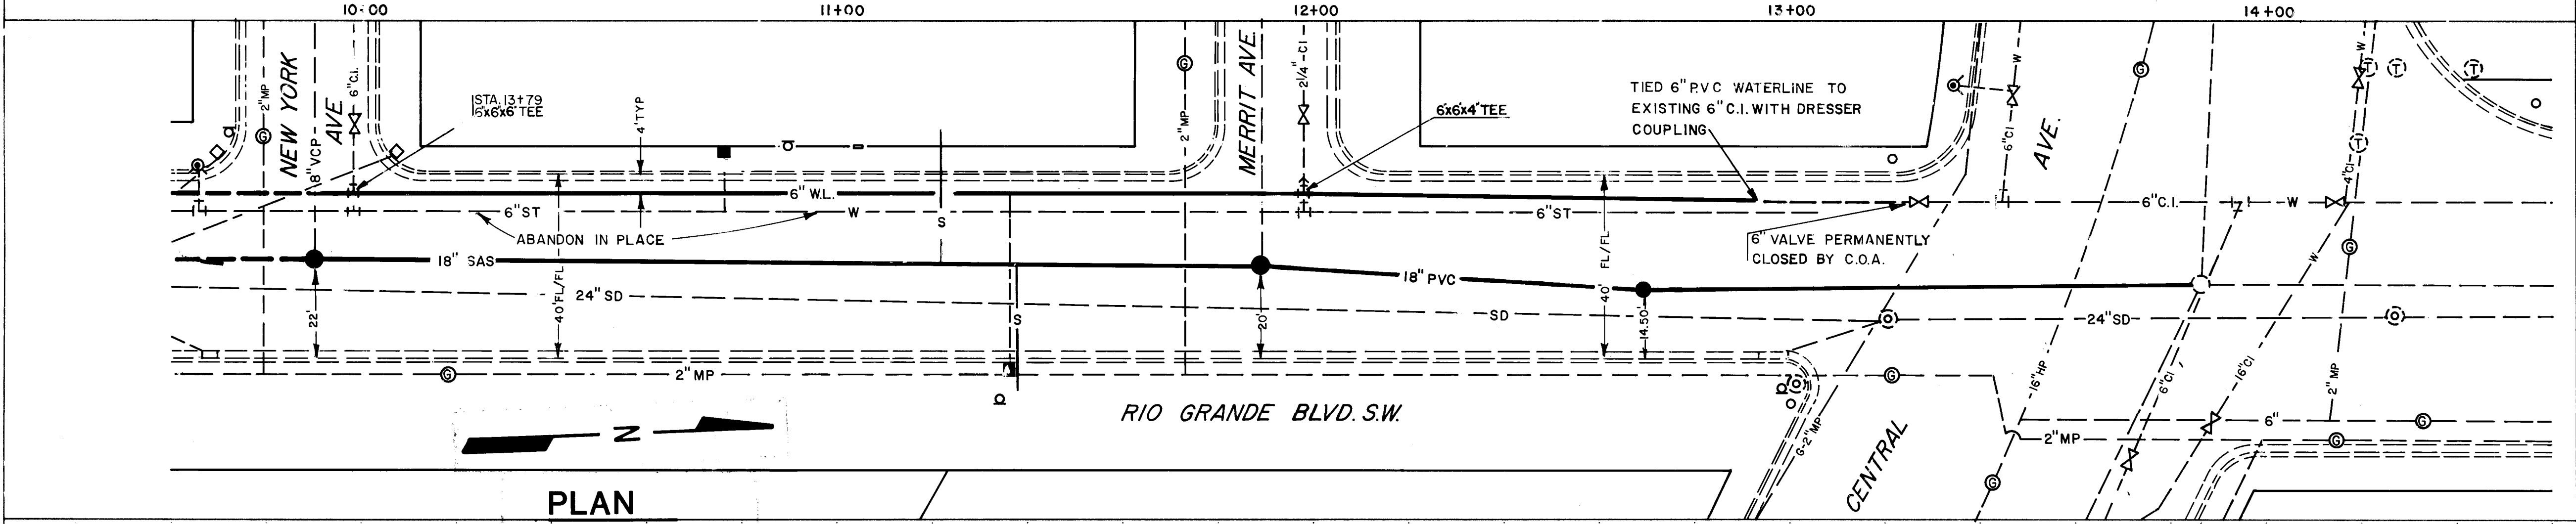

PLAN
SCALE: 1"=20'
PROFILE
SCALE: 1"=20' HORIZ.
1"=5' VERT.

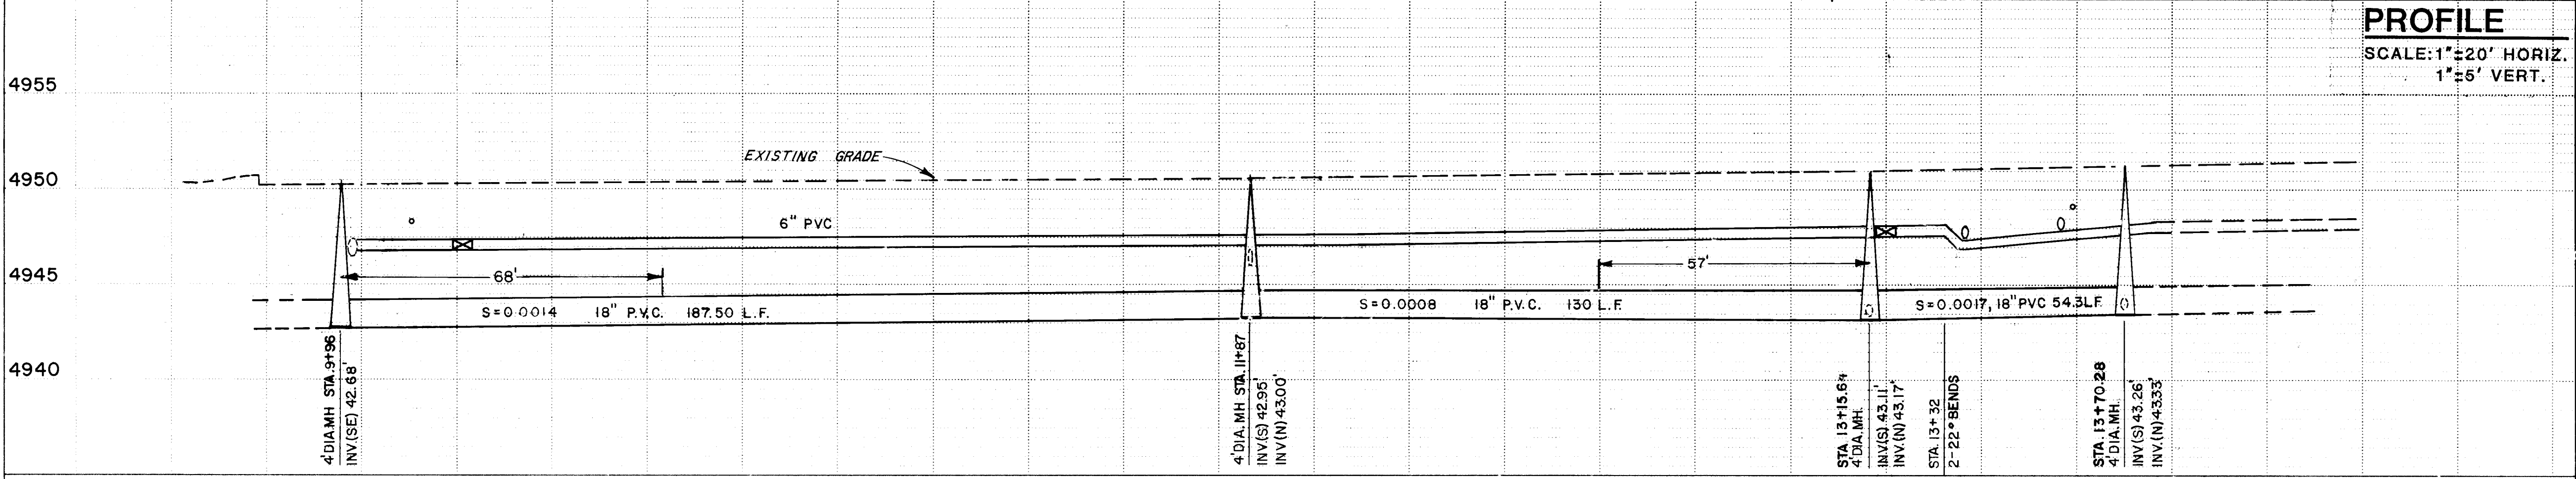

PLAN
SCALE: 1"=20'
PROFILE
SCALE: 1"=20' HORIZ.
1"=5' VERT.

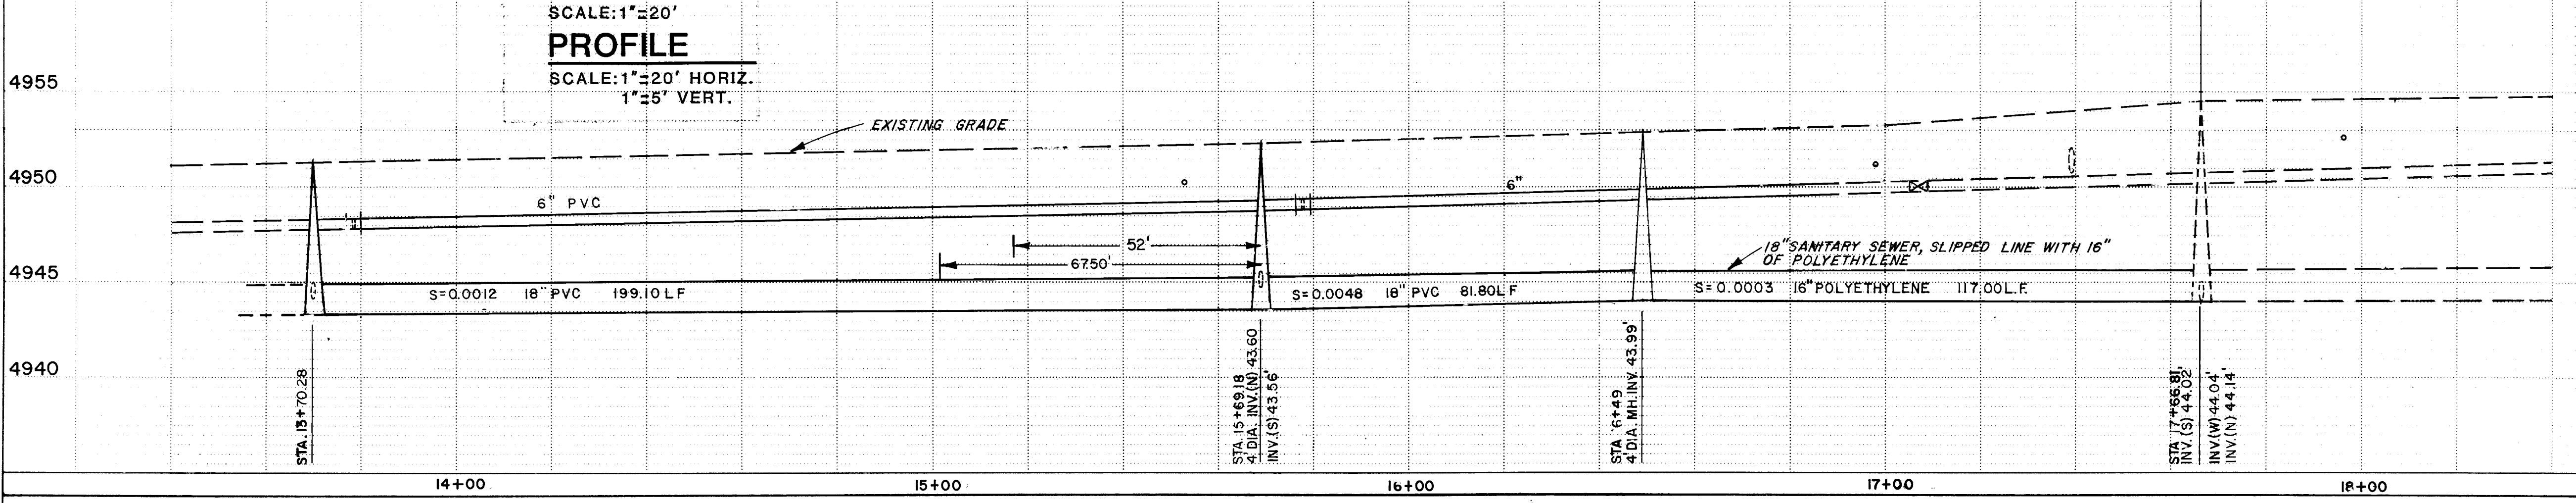

26 27820186

CITY OF ALBUQUERQUE MUNICIPAL DEVELOPMENT DEPARTMENT ENGINEERING DIVISION					
TITLE: RIO GRANDE BLVD. S.W. SOUTH OF CENTRAL AVENUE 18" SANITARY SEWER PVC & 6" WATERLINE PVC, INSTALLED MAY 1985					
APPROVALS	ENGINEER	DATE	APPROVALS	ENGINEER	DATE
City Engineer			Liquid Waste		
ACE - Design			Traffic		
ACE - Hydrology			Water		
DRAWING NO. 2782			MAP NO. J-13		
SHEET 1			OF 1		

AS BUILT INFORMATION		BENCH MARKS		SURVEY INFORMATION		ENGINEER'S SEAL	
CONTRACT	INTER WEST	DATE	4/85	NO.	BY	DATE	
CHECKED BY	E.J. SMITH	DATE	4/85				
APPROVED BY	W.D. SMITH	DATE	4/85				
FIELD	W.D. SMITH	DATE	4/85				
REVISIONS							
NO.	DATE	REMARKS	BY				
DESIGNED BY J. ROCHA				DATE JAN. 85			
DRAWN BY J. ROCHA				DATE JAN. 85			
CHECKED BY J.D.				DATE 1/86			