


CONSTRUCTION PLANS FOR
SANTA FE VILLAGE - UNIT III
PHASE I
SOUTH BRANCH OF SAN ANTONIO ARROYO

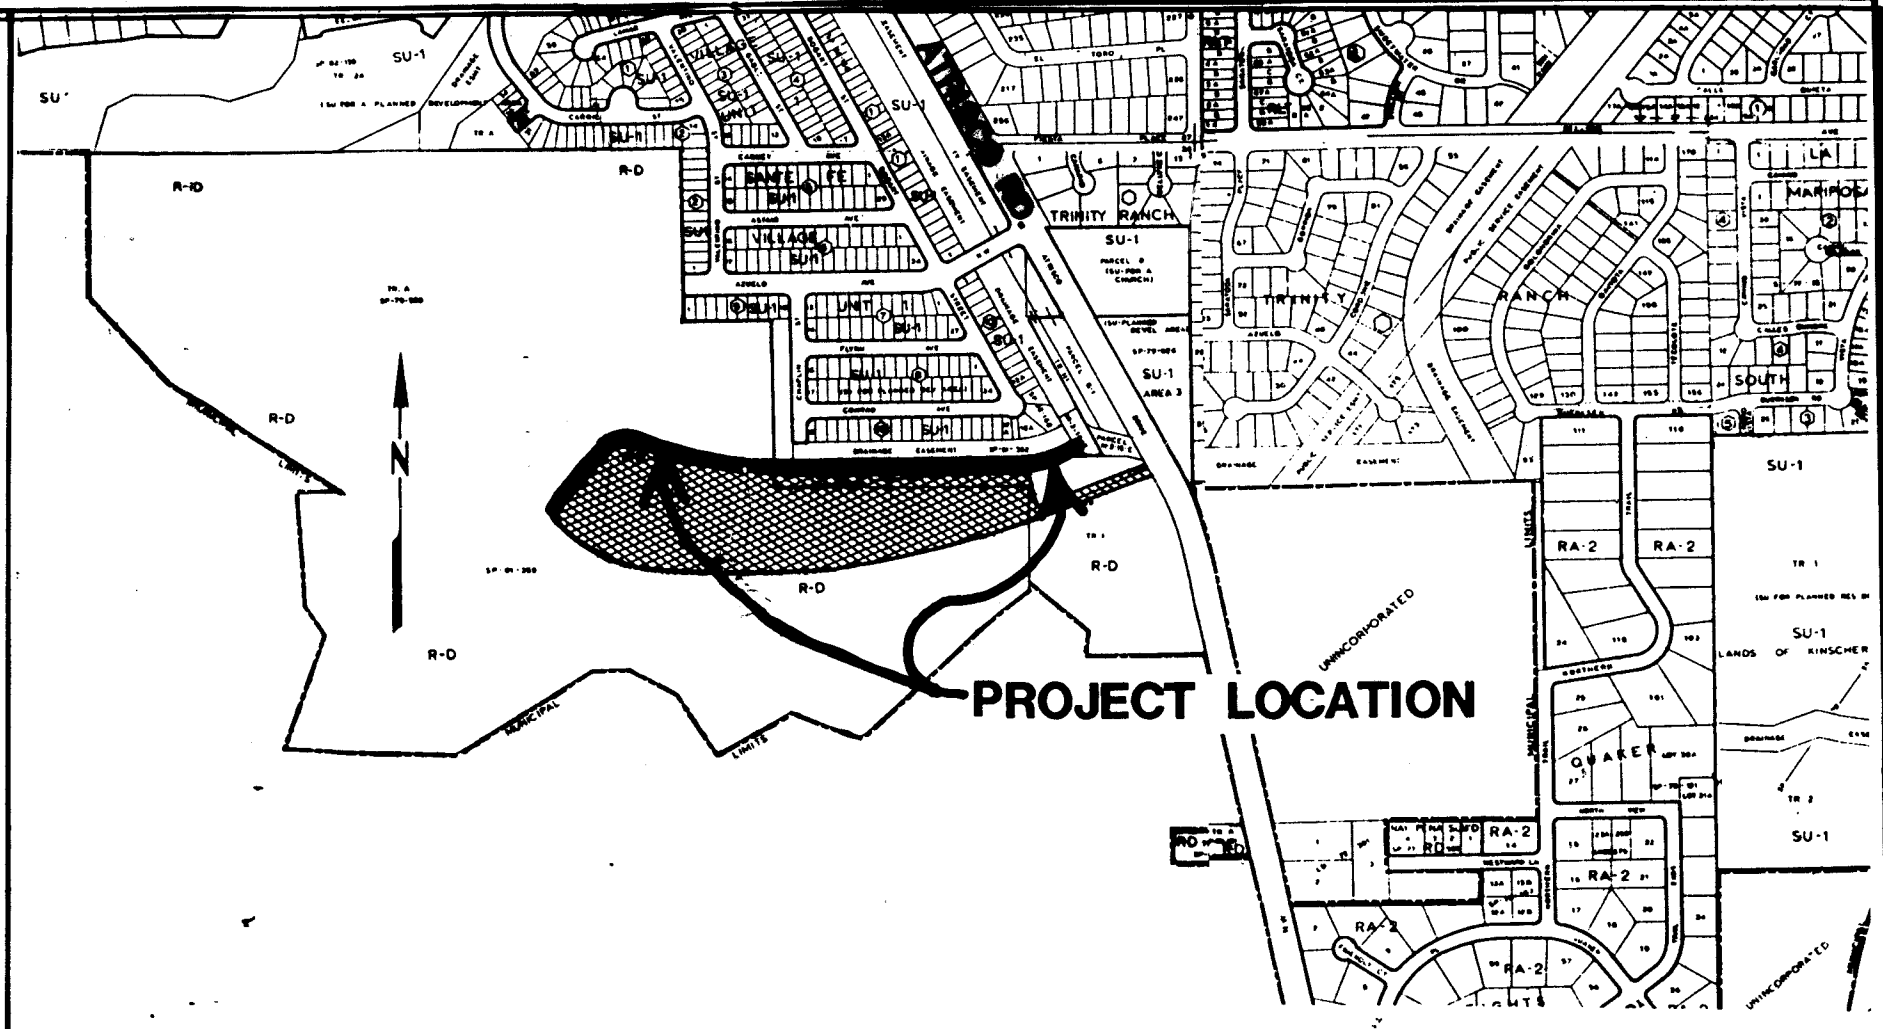

VICINITY MAP
SCALE: 1" = 800 ±

MAP NO. E-10,11
F-10,11

DRAWING INDEX

SHEET TITLE

SHEET NO.

COVER SHEET
PLAT
PLAT
PLAT
CHANNEL PLAN & PROFILE - EAST
CHANNEL PLAN & PROFILE - WEST
BOX CULVERTS
DETAILS
CHANNEL CROSS SECTIONS

1
2
3
4
5
6
7-9
10-14
15

GENERAL NOTES

- ALL WORK DETAILED ON THESE PLANS TO BE PERFORMED UNDER CONTRACT SHALL, EXCEPT AS OTHERWISE STATED OR PROVIDED FOR HEREIN, BE CONSTRUCTED IN ACCORDANCE WITH THE CITY OF ALBUQUERQUE INTERIM STANDARD SPECIFICATIONS PUBLIC WORKS CONSTRUCTION 1985 (REFERRED TO HEREIN AS THE STANDARD SPECIFICATIONS)
- TWO (2) WORKING DAYS PRIOR TO ANY EXCAVATION, CONTRACTOR MUST CONTACT LINE LOCATING SERVICE, 765-1234, FOR LOCATION OF EXISTING UTILITIES.
- PRIOR TO CONSTRUCTION, THE CONTRACTOR SHALL EXCAVATE AND VERIFY THE HORIZONTAL AND VERTICAL LOCATIONS OF ALL OBSTRUCTIONS. SHOULD A CONFLICT EXIST, THE CONTRACTOR SHALL NOTIFY THE ENGINEER OR SURVEYOR SO THAT THE CONFLICT CAN BE RESOLVED WITH MINIMUM AMOUNT OF DELAY.
- ALL UTILITIES AND UTILITY SERVICE LINES INCLUDED IN THIS CONTRACT SHALL BE INSTALLED PRIOR TO CONSTRUCTION OF BOGART STREET AND VULCAN PARKWAY BOX CULVERTS.
- ALL STATIONING IS AT CENTER LINE OF CHANNEL UNLESS NOTED OTHERWISE.
- ALL WORK SHALL BE DONE BY QUALIFIED PERSONNEL IN AN APPROVED STANDARD OF PRACTICE.
- THE COST OF ADDITIONAL DESIGN WORK DUE TO ERRORS AND OMISSIONS IN CONSTRUCTION SHALL BE BORNE BY THE CONTRACTOR.
- VERIFY ALL DIMENSIONS AND CONDITIONS PRIOR TO STARTING WORK. NOTIFY THE ENGINEER OF ANY DISCREPANCIES OR INCONSISTENCIES.
- VERIFY IN FIELD ALL EXISTING CONDITIONS SHOWN ON DRAWINGS.
- ALL UTILITIES SHOWN AND ANY OTHER UTILITIES THAT ARE NOT SHOWN ON THE PLANS BUT ARE WITHIN THE CONSTRUCTION AREA SHALL BE LOCATED, IDENTIFIED AND PROTECTED AT ALL TIMES DURING CONSTRUCTION BY THE CONTRACTOR.

WATER

- NEW WATER MAINS SHALL BE CITY OF ALBUQUERQUE APPROVED 8-INCH PVC PIPE.



SEWER


- ALL SEWER LINES SHALL BE CERTAINTED FLUID-TITE PVC GRAVITY SEWER PIPE OR EQUAL.
- ALL NEW MANHOLES SHALL BE TYPE "E", 4-FEET IN DIAMETER AS PER CITY STANDARD DRAWING S-2, EXCEPT WHERE NOTED.

26 27140187

REV.	SHEETS	CITY ENGR.	DATE	DATE	DATE
APPROVAL OF REVISIONS					

APPROVAL OF AS BUILT DRAWINGS
THREE MONTHS AFTER
7-28-87

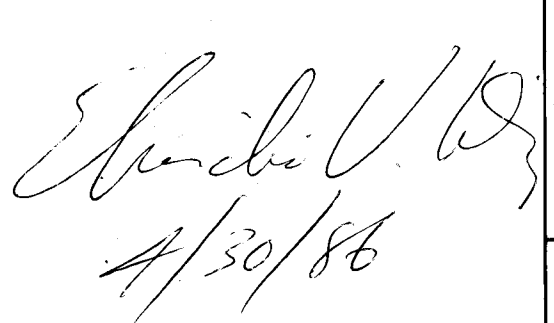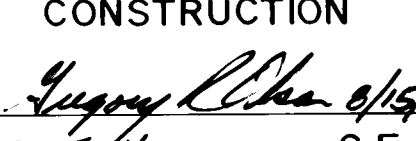 4/30/86	PREPARED BY: RESOURCE TECHNOLOGY INCORPORATED	APPROVED FOR CONSTRUCTION  C.E.
	PROJECT NO. 2794	SHEET OF 1 15

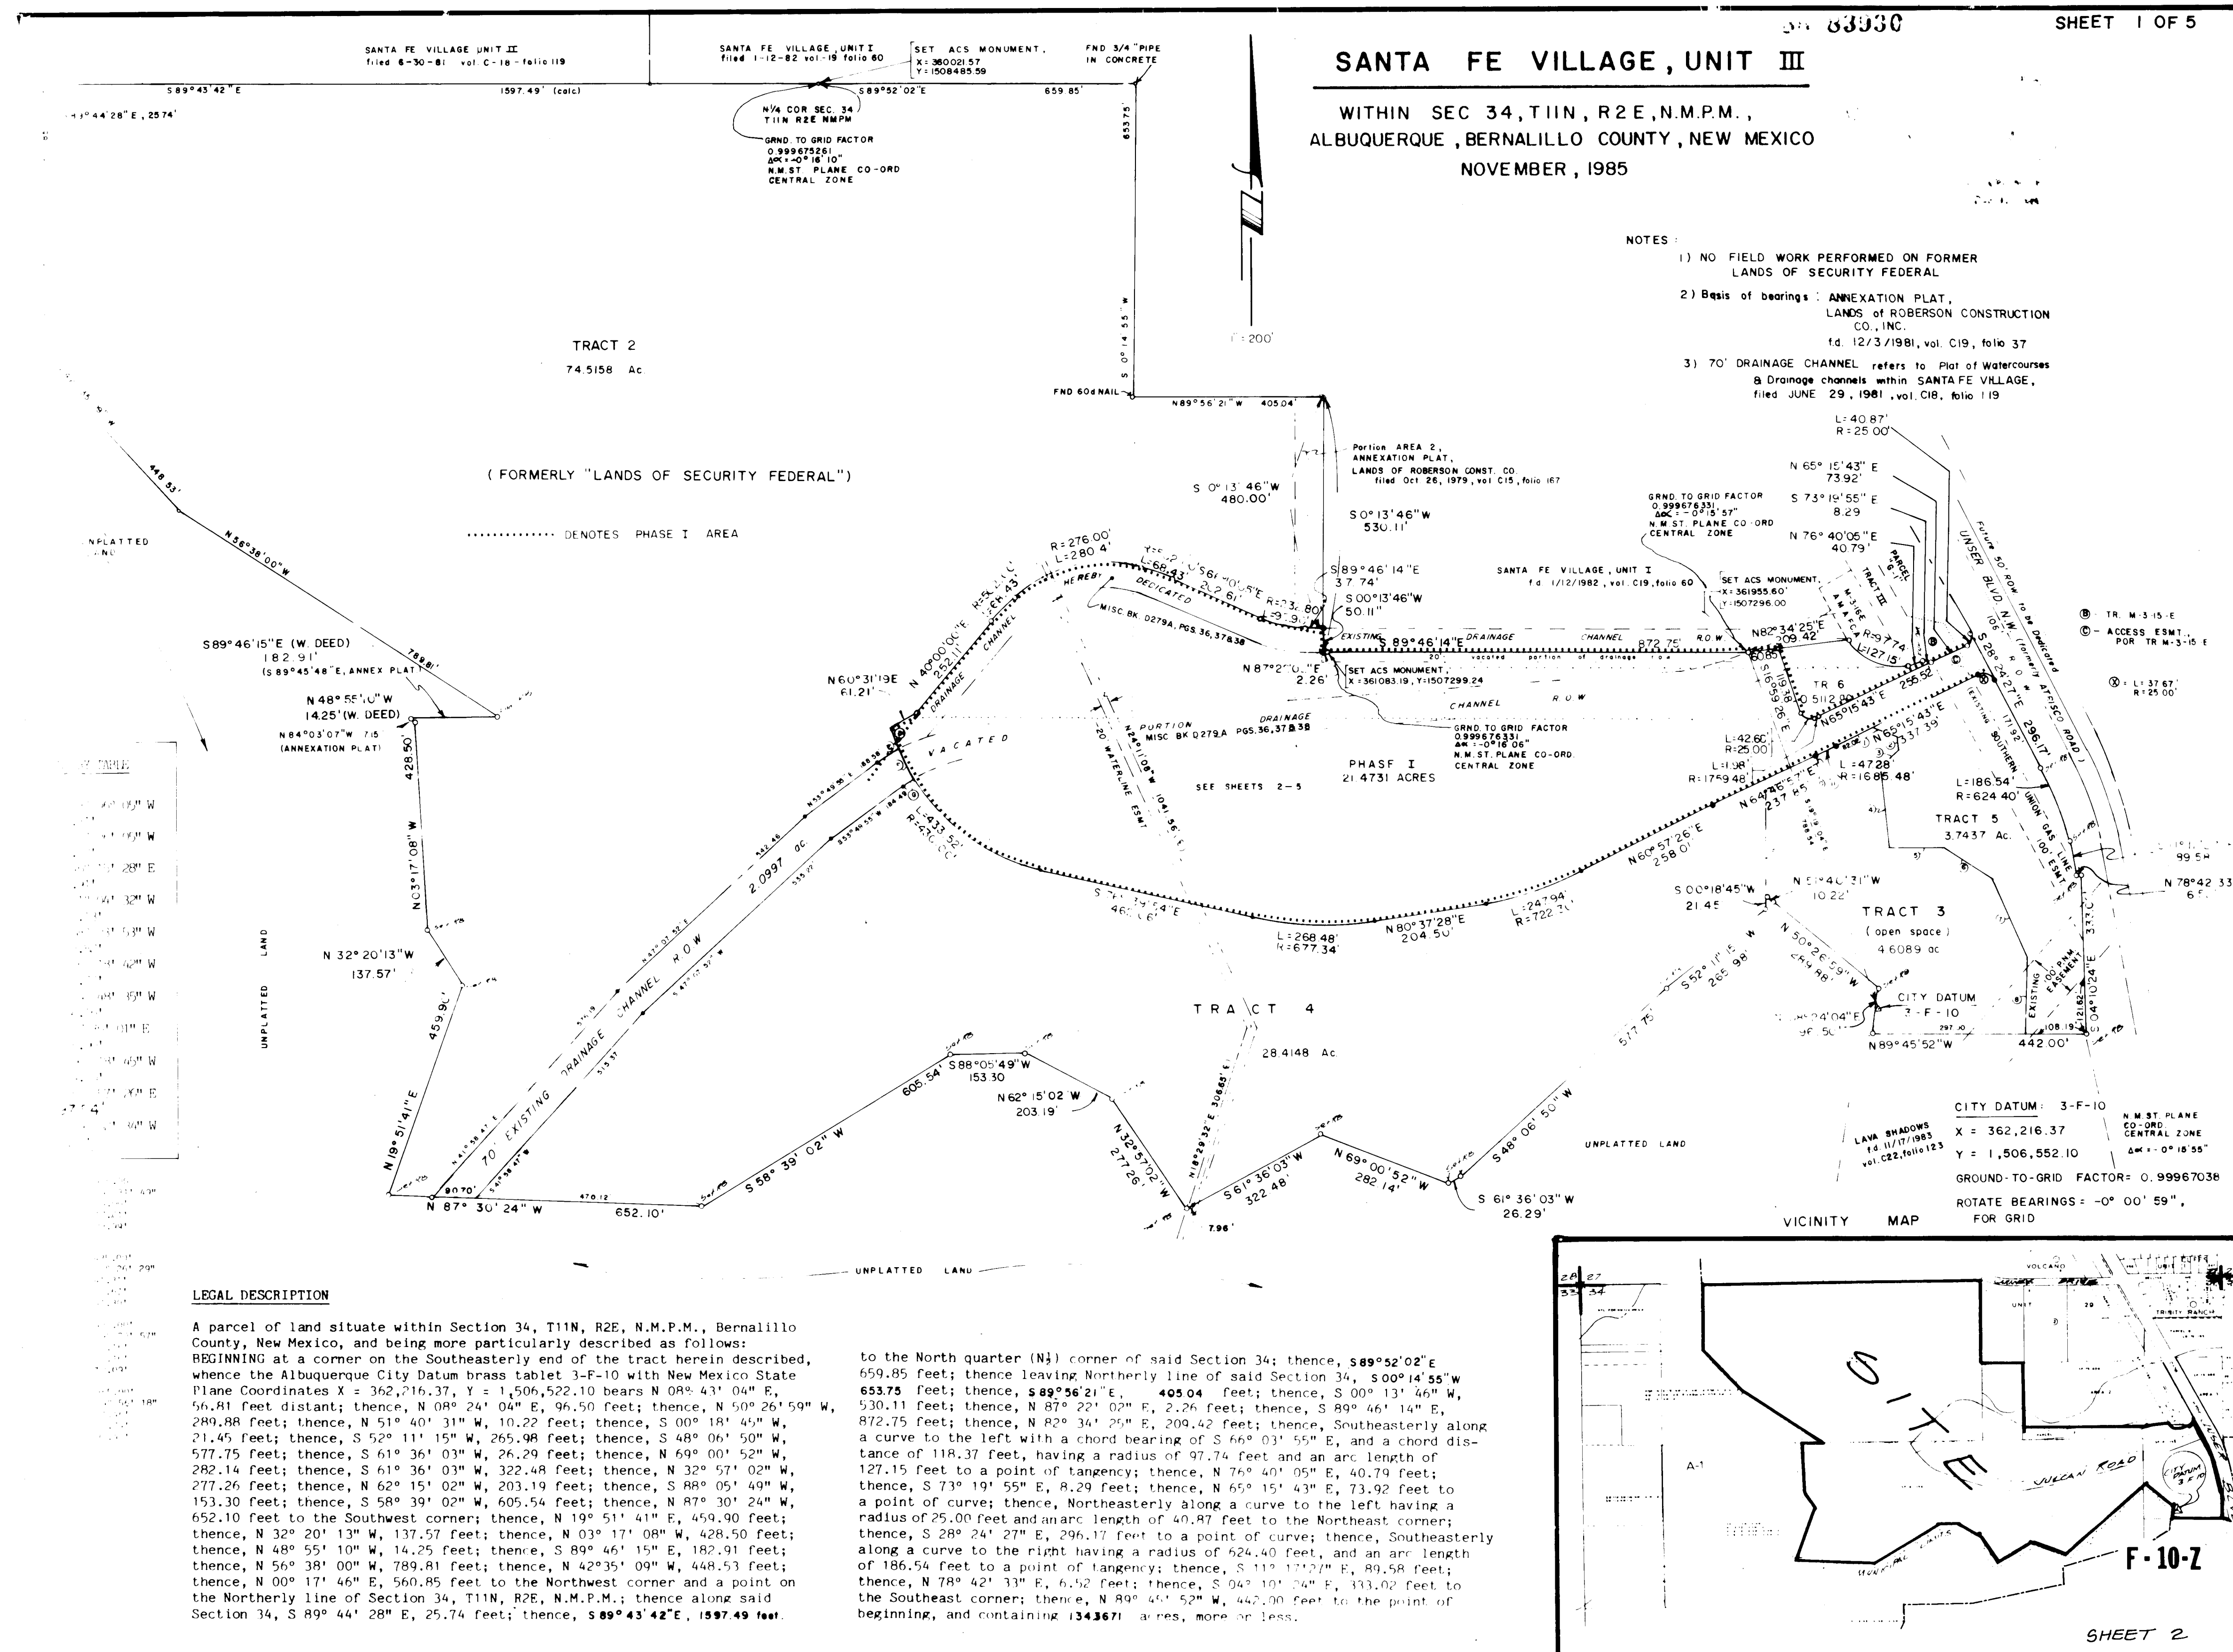

LEGAL DESCRIPTION

A parcel of land situate within Section 34, T11N, R2E, N.M.P.M., Bernalillo County, New Mexico, and being more particularly described as follows: BEGINNING at a corner on the Southeastly end of the tract herein described, whence the Albuquerque City Datum brass tablet 3-F-10 with New Mexico State Plane Coordinates X = 362,716.37, Y = 1,506,552.10 bears N 08° 43' 04" E, 56.81 feet distant; thence, N 08° 24' 04" E, 96.50 feet; thence, N 50° 26' 59" W, 249.88 feet; thence, N 51° 40' 31" W, 10.22 feet; thence, S 00° 18' 14" W, 21.45 feet; thence, S 52° 11' 15" W, 265.98 feet; thence, S 48° 06' 50" W, 577.75 feet; thence, S 61° 36' 03" W, 26.29 feet; thence, N 69° 00' 52" W, 282.14 feet; thence, S 61° 36' 03" W, 322.48 feet; thence, N 32° 57' 02" W, 277.26 feet; thence, N 62° 15' 02" W, 203.19 feet; thence, S 88° 05' 49" W, 153.30 feet; thence, S 58° 39' 02" W, 605.54 feet; thence, N 87° 30' 24" W, 652.10 feet to the Southwest corner; thence, N 19° 51' 41" E, 459.90 feet; thence, N 32° 20' 13" W, 137.57 feet; thence, N 03° 17' 08" W, 428.50 feet; thence, N 48° 55' 10" W, 14.25 feet; thence, S 89° 46' 15" E, 182.91 feet; thence, N 56° 38' 00" W, 789.81 feet; thence, N 42° 35' 09" W, 448.53 feet; thence, N 00° 17' 46" E, 560.85 feet to the Northwest corner and a point on the Northernly line of Section 34, T11N, R2E, N.M.P.M.; thence along said Section 34, S 89° 44' 28" E, 25.74 feet; thence, S 89° 43' 42" E, 1597.49 feet.


to the North quarter (N $\frac{1}{4}$) corner of said Section 34; thence, S 89° 52' 02" E, 659.85 feet; thence leaving Northernly line of said Section 34, S 00° 14' 55" W, 653.75 feet; thence, S 89° 56' 21" E, 405.04 feet; thence, S 00° 13' 46" W, 530.11 feet; thence, N 87° 22' 02" E, 2.26 feet; thence, S 89° 46' 14" E, 872.75 feet; thence, N 82° 34' 25" E, 209.42 feet; thence, Southeastly along a curve to the left with a chord bearing of S 66° 03' 55" E, and a chord distance of 118.37 feet, having a radius of 97.74 feet and an arc length of 127.15 feet to a point of tangency; thence, N 76° 40' 05" E, 40.79 feet; thence, S 73° 19' 55" E, 8.29 feet; thence, N 65° 15' 43" E, 73.92 feet to a point of curve; thence, Northeastly along a curve to the left having a radius of 25.00 feet and an arc length of 40.87 feet to the Northeast corner; thence, S 28° 24' 27" E, 296.17 feet to a point of curve; thence, Southeastly along a curve to the right having a radius of 624.40 feet, and an arc length of 186.54 feet to a point of tangency; thence, S 11° 17' 27" E, 89.58 feet; thence, N 78° 42' 33" E, 6.42 feet; thence, S 04° 10' 24" E, 113.02 feet to the Southeast corner; thence, N 89° 46' 52" W, 442.00 feet to the point of beginning, and containing 134.3671 acres, more or less.

88 83930

SANTA FE VILLAGE, UNIT III

SHEET 2 OF 5

WITHIN SEC 34, T11N, R2E, N.M.P.M.,
ALBUQUERQUE, BERNALILLO COUNTY, NEW MEXICO
NOVEMBER, 1985
PHASE I

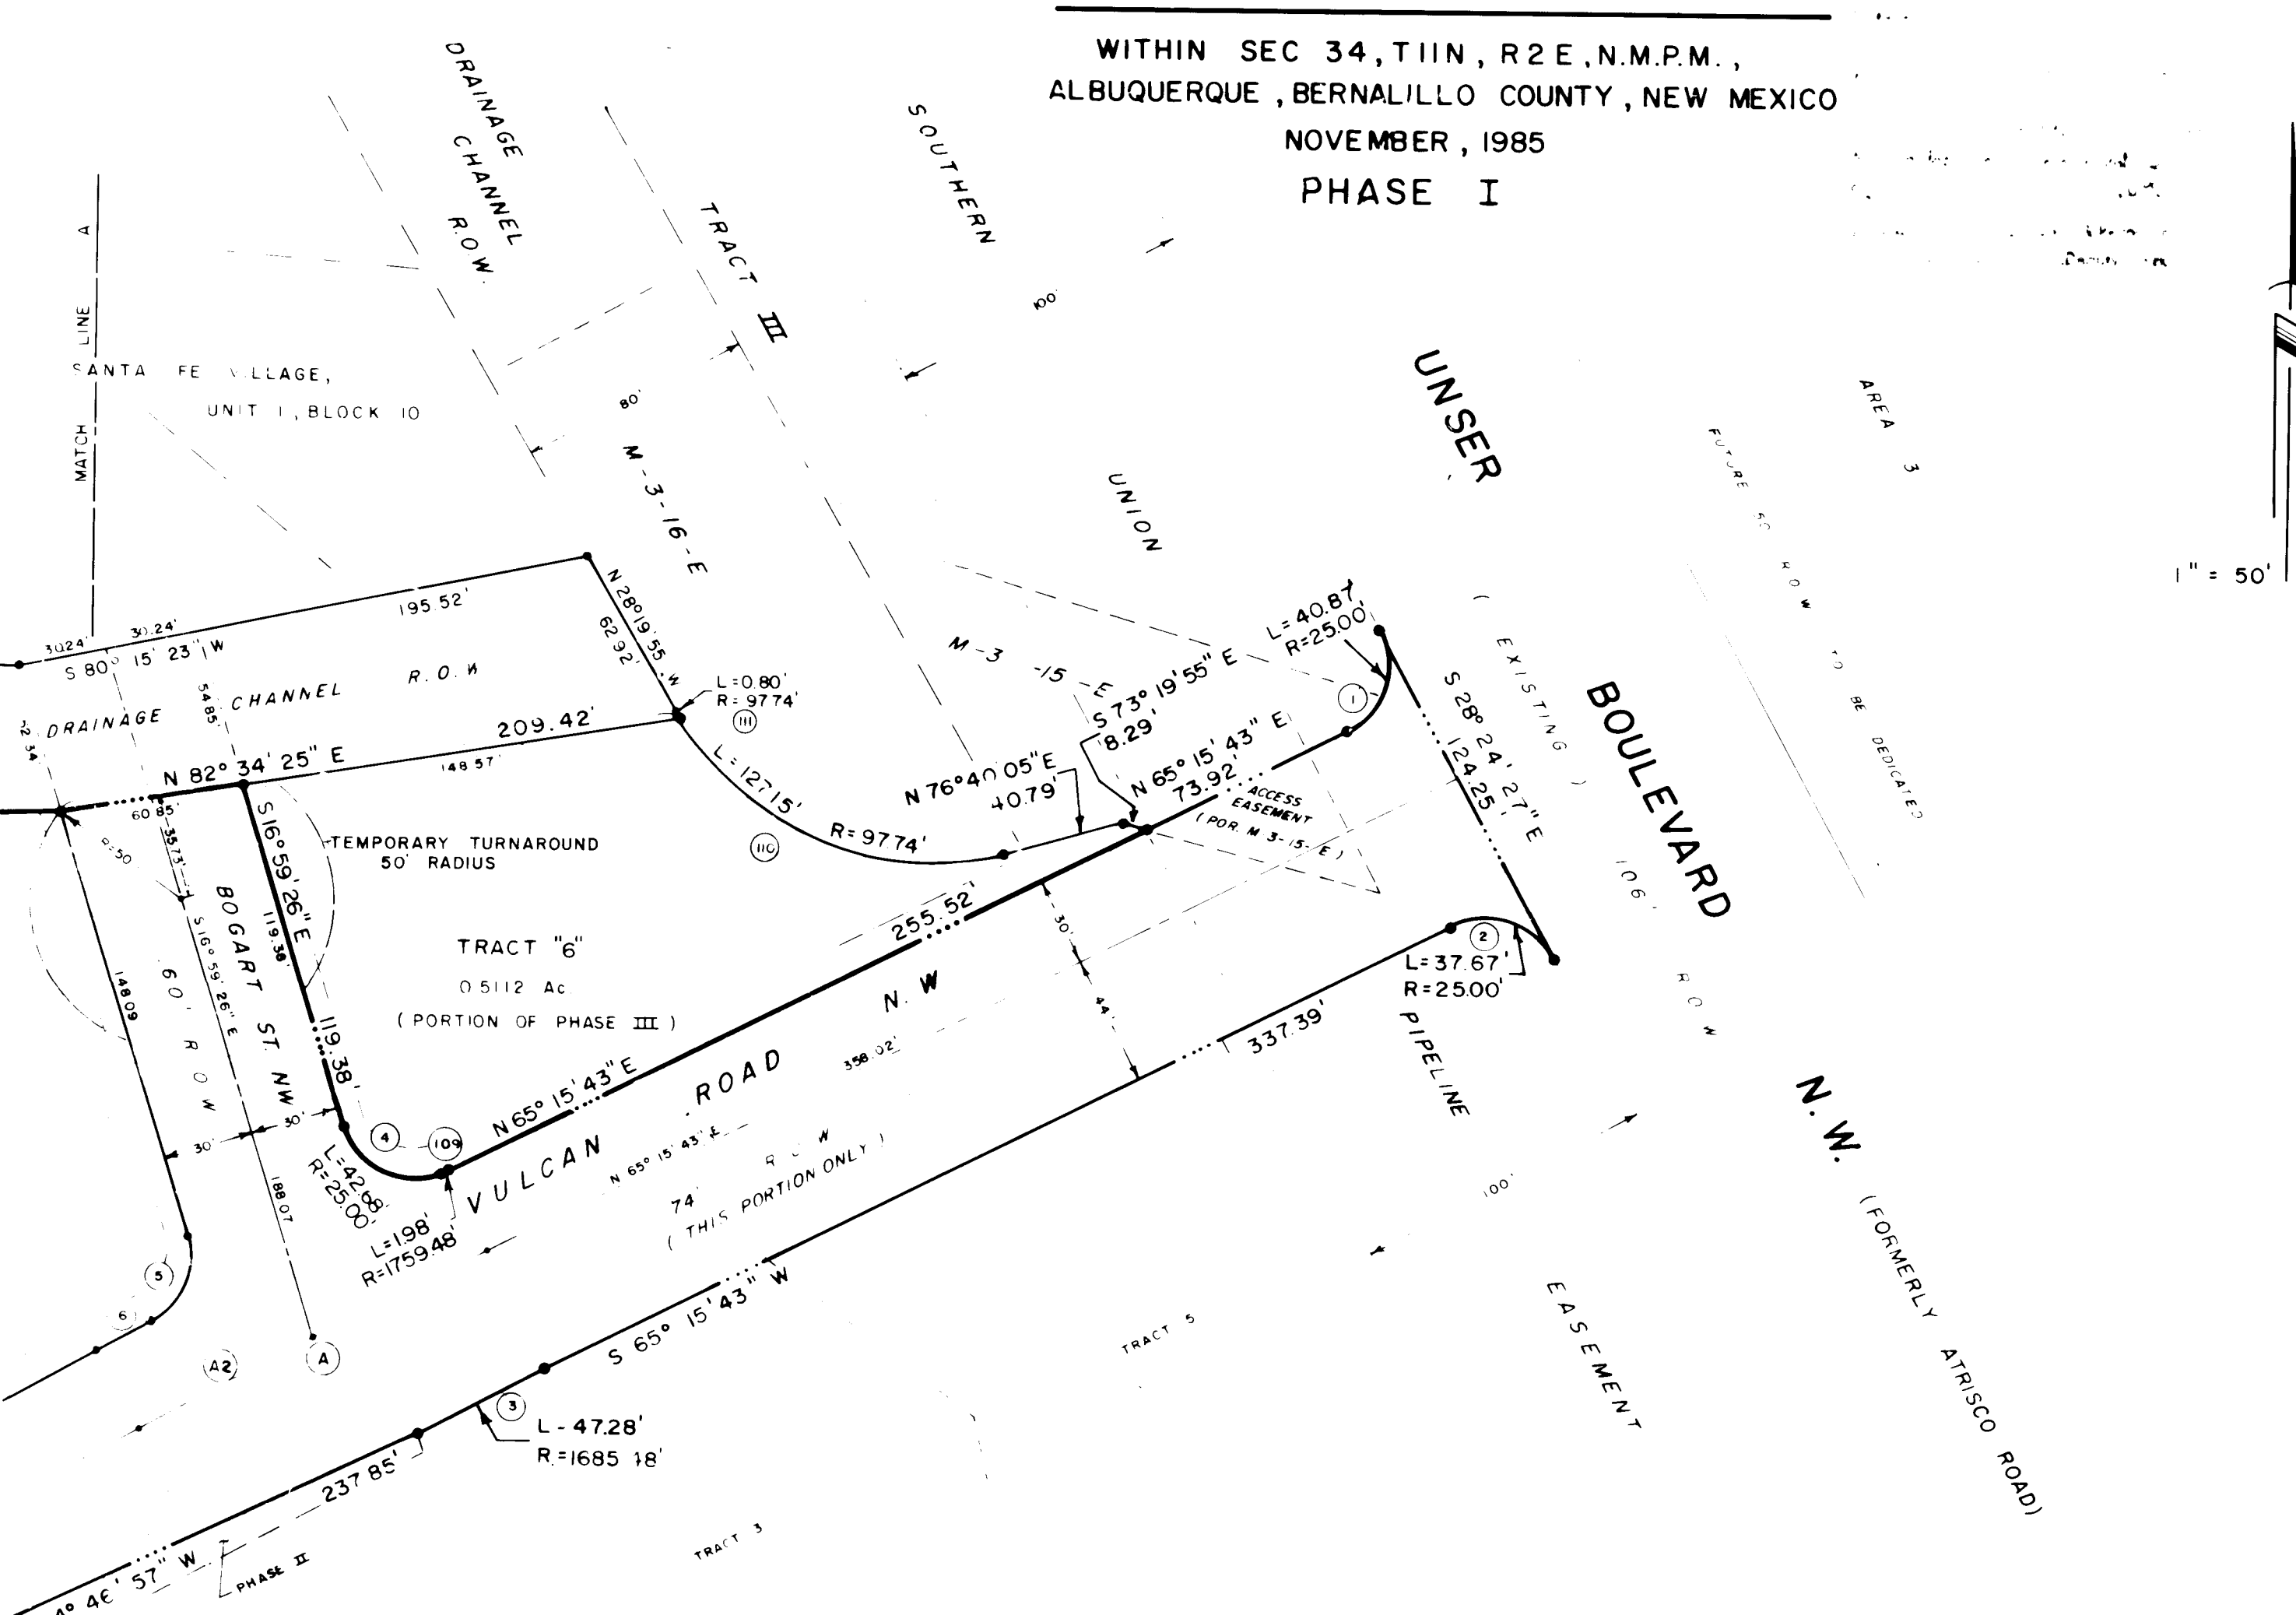

FREE CONSENT & DEDICATION

The subdivision of the land herein shown is with free consent and in accordance with the desires of the undersigned owner and/or proprietor(s) thereof, and said owner(s) and/or proprietor(s) do hereby dedicate the public right-of-way, and drainage right-of-way shown herein, and do hereby grant all easements shown in this plat and including the right of ingress and egress and the right to trim or remove any interfering trees or bushes.

OWNER: *Cody C. Robinson* 1-27-86
DATE: 1-27-86

P.N.M. B.M.S.T. & T.
NOTE: Electrical Power and
Communication easements are
shown on this plat.

NOTE

Electrical Power and Communication easements are reserved for overhead distribution lines for pole type utilities and buried distribution lines, and including the right of ingress and egress for construction and maintenance, and the right to trim interfering trees and shrubs. Also included are easements for the right to install power and communication service lines along side lot lines.

NOTE ON EASEMENTS

These easements shall include minimum working space requirements for single and three-phase transformers. See Public Service Company of New Mexico (PSCN) Distribution Standard Drawing 105-7-16-2 for details.

DATE: 4-1-86
DATE: 3-27-86
DATE: 3-3-86

ACKNOWLEDGMENT
STATE OF NEW MEXICO)
COUNTY OF BERNALILLO) ss.
The foregoing instrument was acknowledged before me this 14th day of January, 1986, by: *Cody C. Robinson*

My Commission Expires: 1-2-87
Notary Public: *David H. Green*

CITY/COUNTY APPROVALS
David H. Green 8-19-86
City Engineer
David H. Green 8-19-86
City Engineer
City Engineer
David H. Green 8-19-86
City Engineer
David H. Green 8-19-86
City Engineer

City Engineer
David H. Green 8-19-86
City Engineer
David H. Green 8-19-86
City Engineer


City Engineer
David H. Green 8-19-86
City Engineer
David H. Green 8-19-86
City Engineer

88 83930

SANTA FE VILLAGE, UNIT III

SHEET 3 OF 5

WITHIN SEC 34, T11N, R2E, N.M.P.M.,
ALBUQUERQUE, BERNALILLO COUNTY, NEW MEXICO
NOVEMBER, 1985
PHASE I

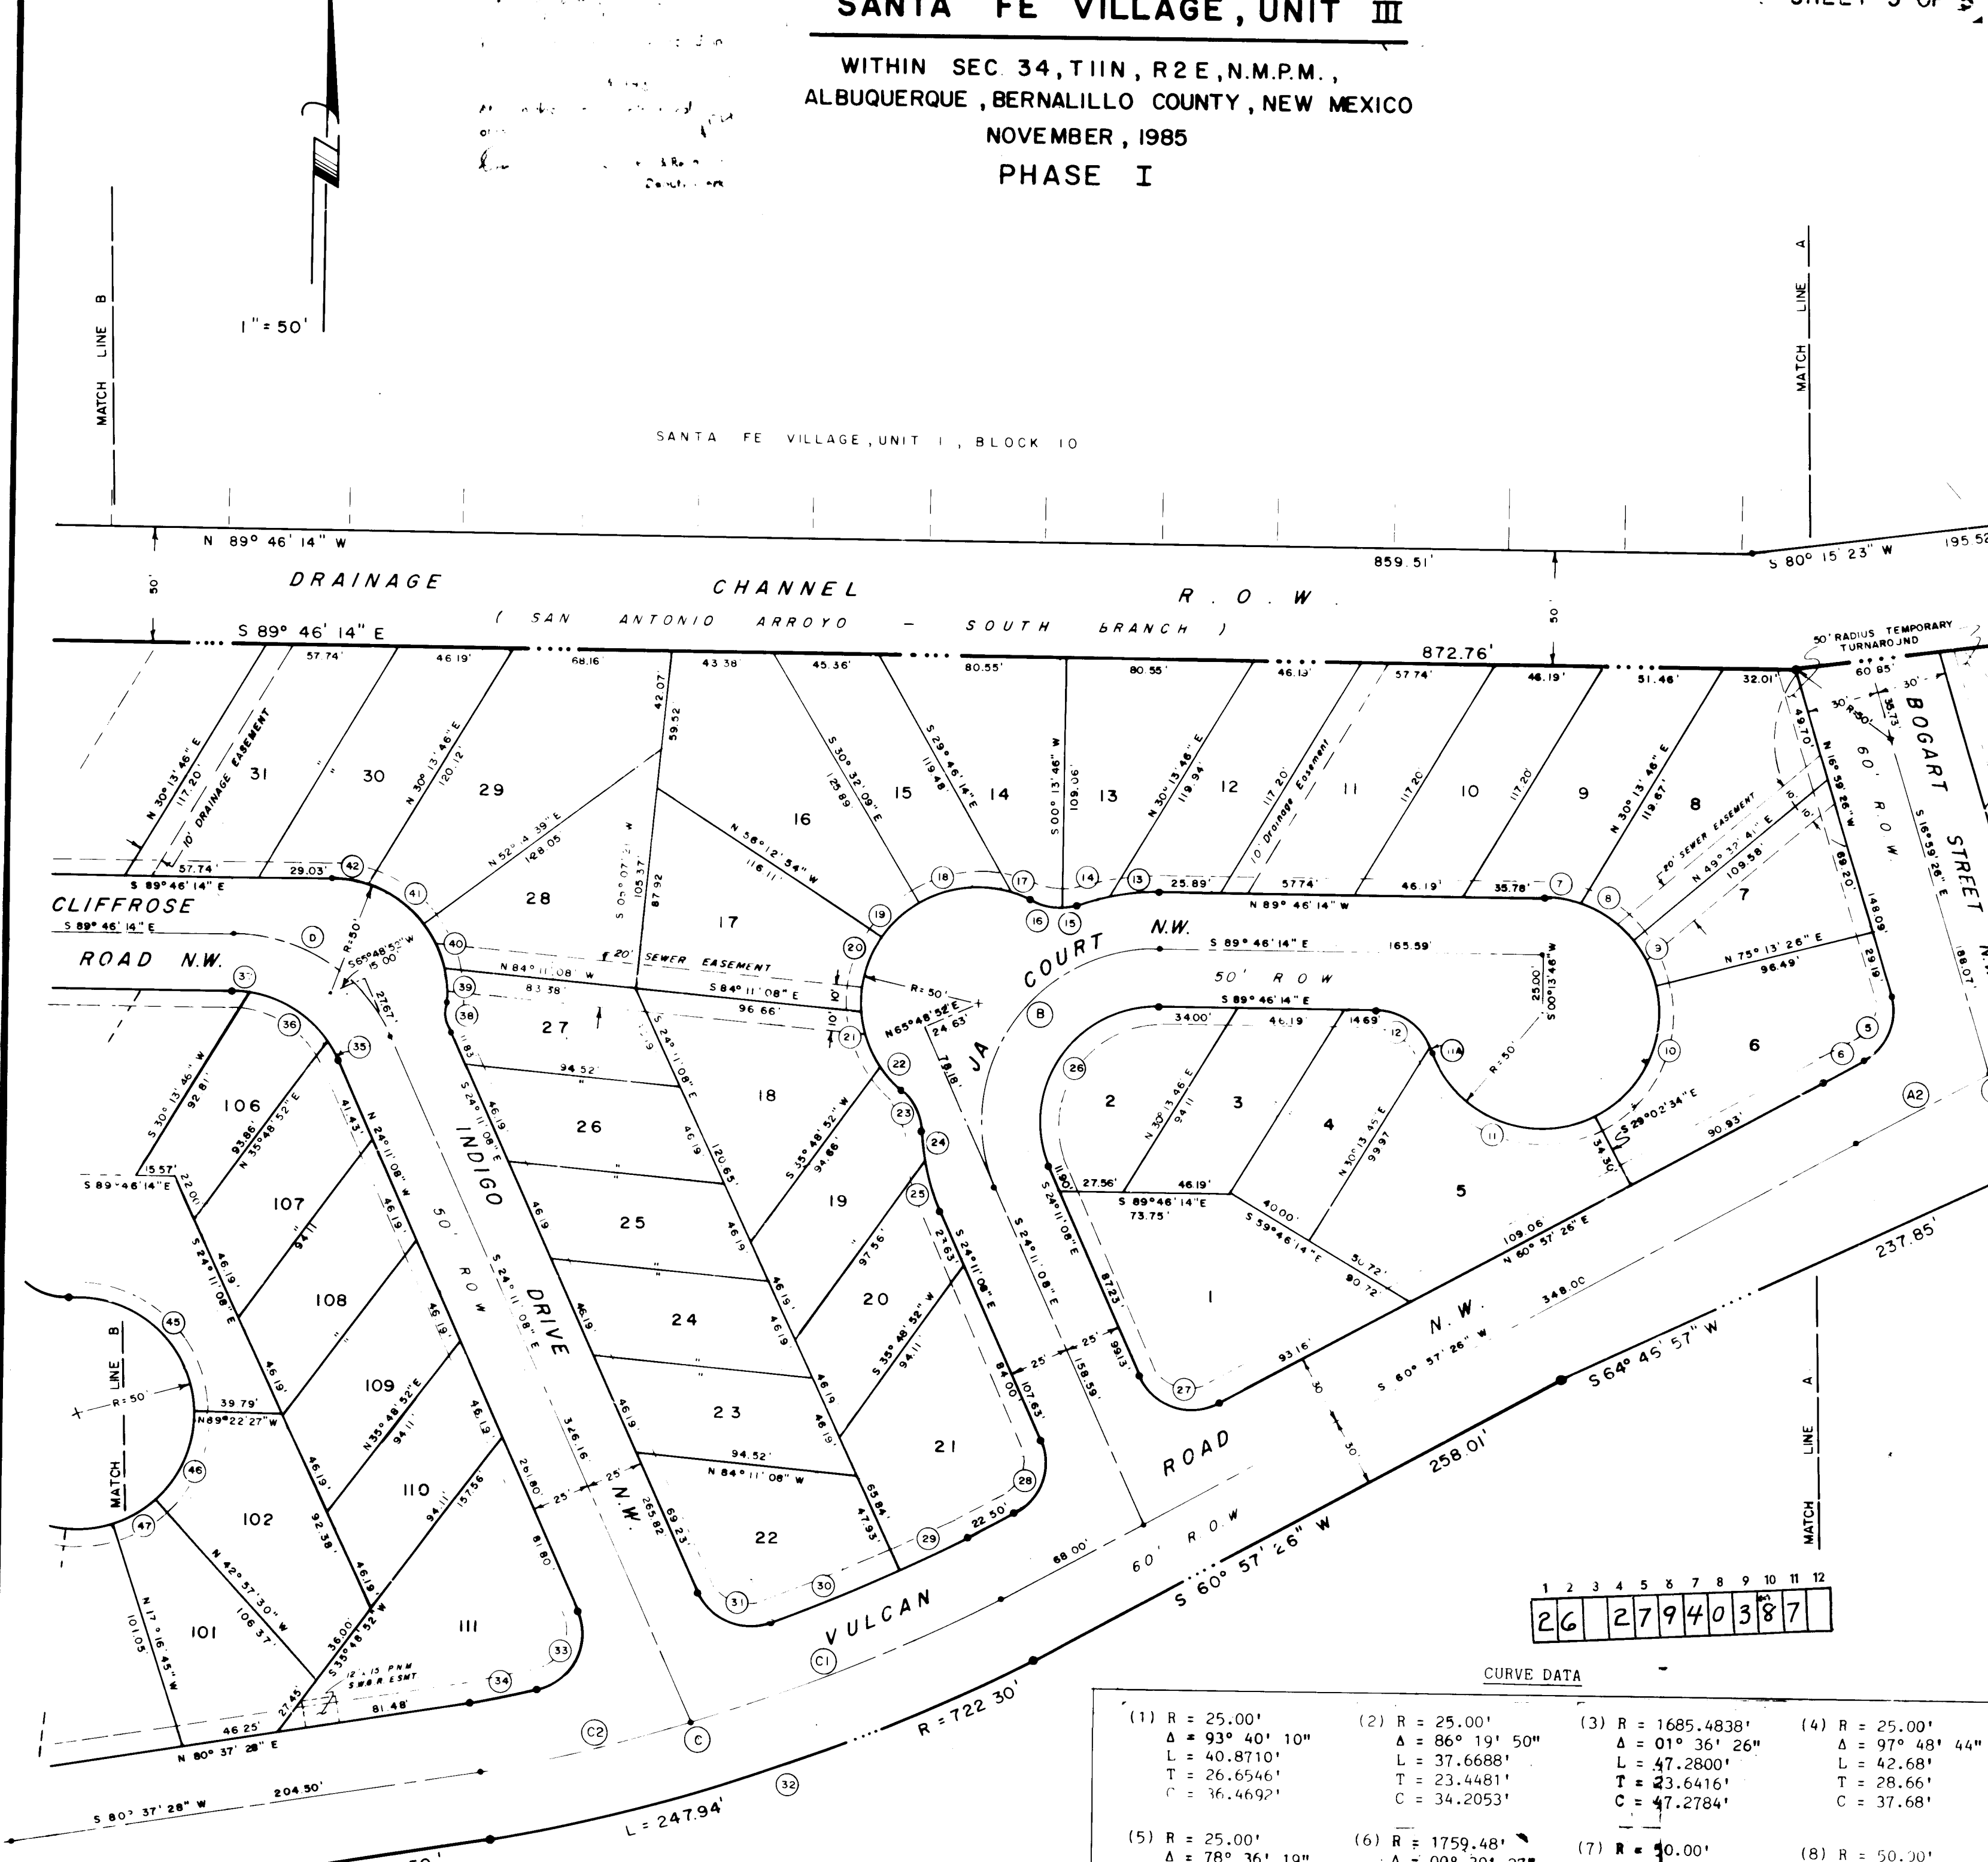

CURVE DATA			
(1) R = 25.00'	(2) R = 25.00'	(3) R = 1685.4838'	(4) R = 25.00'
A = 93° 40' 10"	A = 86° 19' 50"	A = 01° 36' 26"	A = 97° 48' 44"
L = 40.8710'	L = 37.6688'	L = 47.2800'	L = 42.68'
T = 26.6546'	T = 23.4481'	T = 23.4481'	T = 28.66'
C = 16.4450'	C = 34.2053'	C = 47.2784'	C = 37.68'

CURVE DATA			
(5) R = 25.00'	(6) R = 1759.48'	(7) R = 40.00'	(8) R = 50.00'
A = 78° 36' 19"	A = 00° 39' 27"	A = 60° 47' 42"	A = 32° 31' 13"
L = 34.30'	L = 28.19'	L = 16.66'	L = 28.38'
T = 20.46'	T = 10.10'	T = 7.38'	T = 15.58'
C = 31.67'	C = 28.19'	C = 74.60'	C = 28.00'


CURVE DATA			
(9) R = 50.00'	(10) R = 50.00'	(11) R = 50.00'	(12) R = 25.00'
A = 25° 40' 45"	A = 75° 44' 00"	A = 99° 48' 04"	A = 04° 17' 37"
L = 22.41'	L = 66.09'	L = 87.09'	L = 1.87'
T = 11.39'	T = 38.88'	T = 59.38'	T = 0.94'
C = 22.22'	C = 61.38'	C = 76.49'	C = 1.87'

CURVE DATA			
(13) R = 100.00'	(14) R = 100.00'	(15) R = 25.00'	(16) R = 25.00'
A = 12° 30' 50"	A = 12° 30' 50"	A = 16° 50' 12"	A = 16° 50' 12"
L = 21.84'	L = 21.84'	L = 7.35'	L = 7.35'
T = 10.92'	T = 10.92'	T = 3.70'	T = 3.70'
C = 14.00'	C = 14.00'	C = 7.32'	C = 7.32'

CURVE DATA			
(17) R = 50.00'	(18) R = 50.00'	(19) R = 50.00'	(20) R = 50.00'
A = 09° 37' 06"	A = 48° 22' 55"	A = 25° 40' 45"	A = 25° 40' 45"
L = 8.39'	L = 22.41'	L = 22.41'	L = 22.41'
T = 4.21'	T = 22.46'	T = 22.46'	T = 22.46'
C = 8.38'	C = 40.98'	C = 40.98'	C = 40.98'

CURVE DATA			
(21) R = 50.00'	(22) R = 50.00'	(23) R = 25.00'	(24) R = 25.00'
A = 29° 01' 15"	A = 16° 40' 49"	A = 16° 40' 49"	A = 16° 40' 49"
L = 25.33'	L = 14.56'	L = 14.56'	L = 14.56'
T = 12.66'	T = 7.33'	T = 7.33'	T = 7.33'
C = 25.06'	C = 14.50'	C = 14.50'	C = 14.50'

CURVE DATA			
(25) R = 50.00'	(26) R = 50.00'	(27) R = 25.00'	(28) R = 25.00'
A = 14° 03' 18"	A = 14° 03' 18"	A = 14° 03' 18"	A = 14° 03' 18"
L = 24.53'	L = 24.53'	L = 24.53'	L = 24.53'
T = 12.26'	T = 12.26'	T = 12.26'	T = 12.26'
C = 24.47'	C = 24.47'	C = 24.47'	C = 24.47'

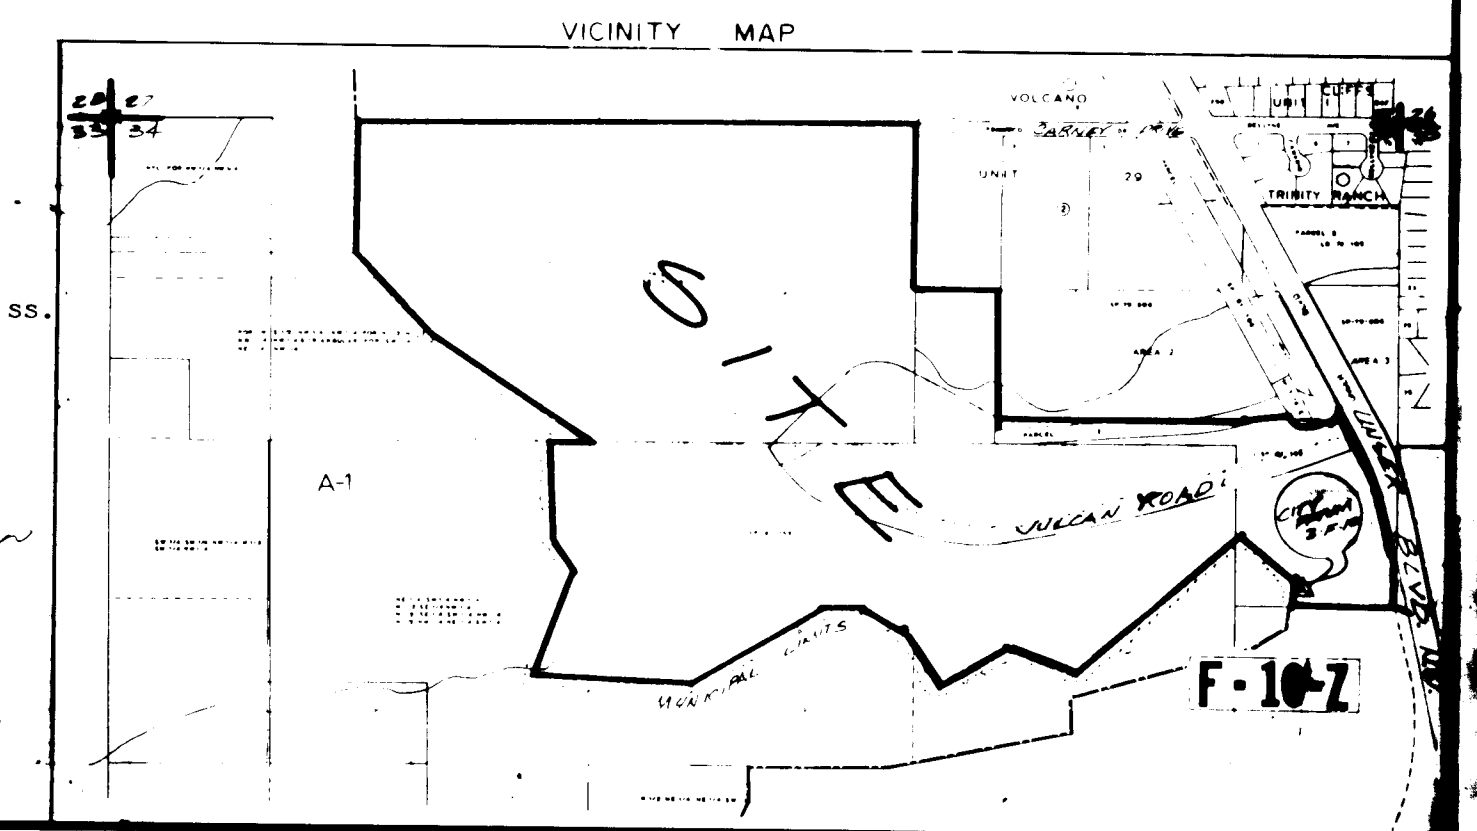

Surveyor's Certification
I, *Franklin E. Wilson*, do hereby certify that I am a registered Land Surveyor under the laws of the State of New Mexico, and that this plat was prepared by me or under my supervision, shows all easements of record, meets the minimum requirements for monumentation and surveys of the Albuquerque Subdivision Ordinance and is true and correct to the best of my knowledge and belief.

Signature: *Franklin E. Wilson* 11/10/85
Date: 11/10/85

Signature: *Richard D. Green* 11/10/85
Date: 11/10/85

Signature: *Richard D. Green* 11/10/85
Date: 11/10/85

Signature: *Richard D. Green* 11/10/85
Date: 11/10/85

Signature: *Richard D. Green* 11/10/85
Date: 11/10/85


Signature: *Richard D. Green* 11/10/85
Date: 11/10/85


Signature: *Richard D. Green* 11/10/85
Date: 11/10/85

Signature: *Richard D. Green* 11/10/85
Date: 11/10/85


Signature: *Richard D. Green* 11/10/85
Date: 11/10/85

Signature: *Richard D. Green* 11/10/85
Date: 11/10/85

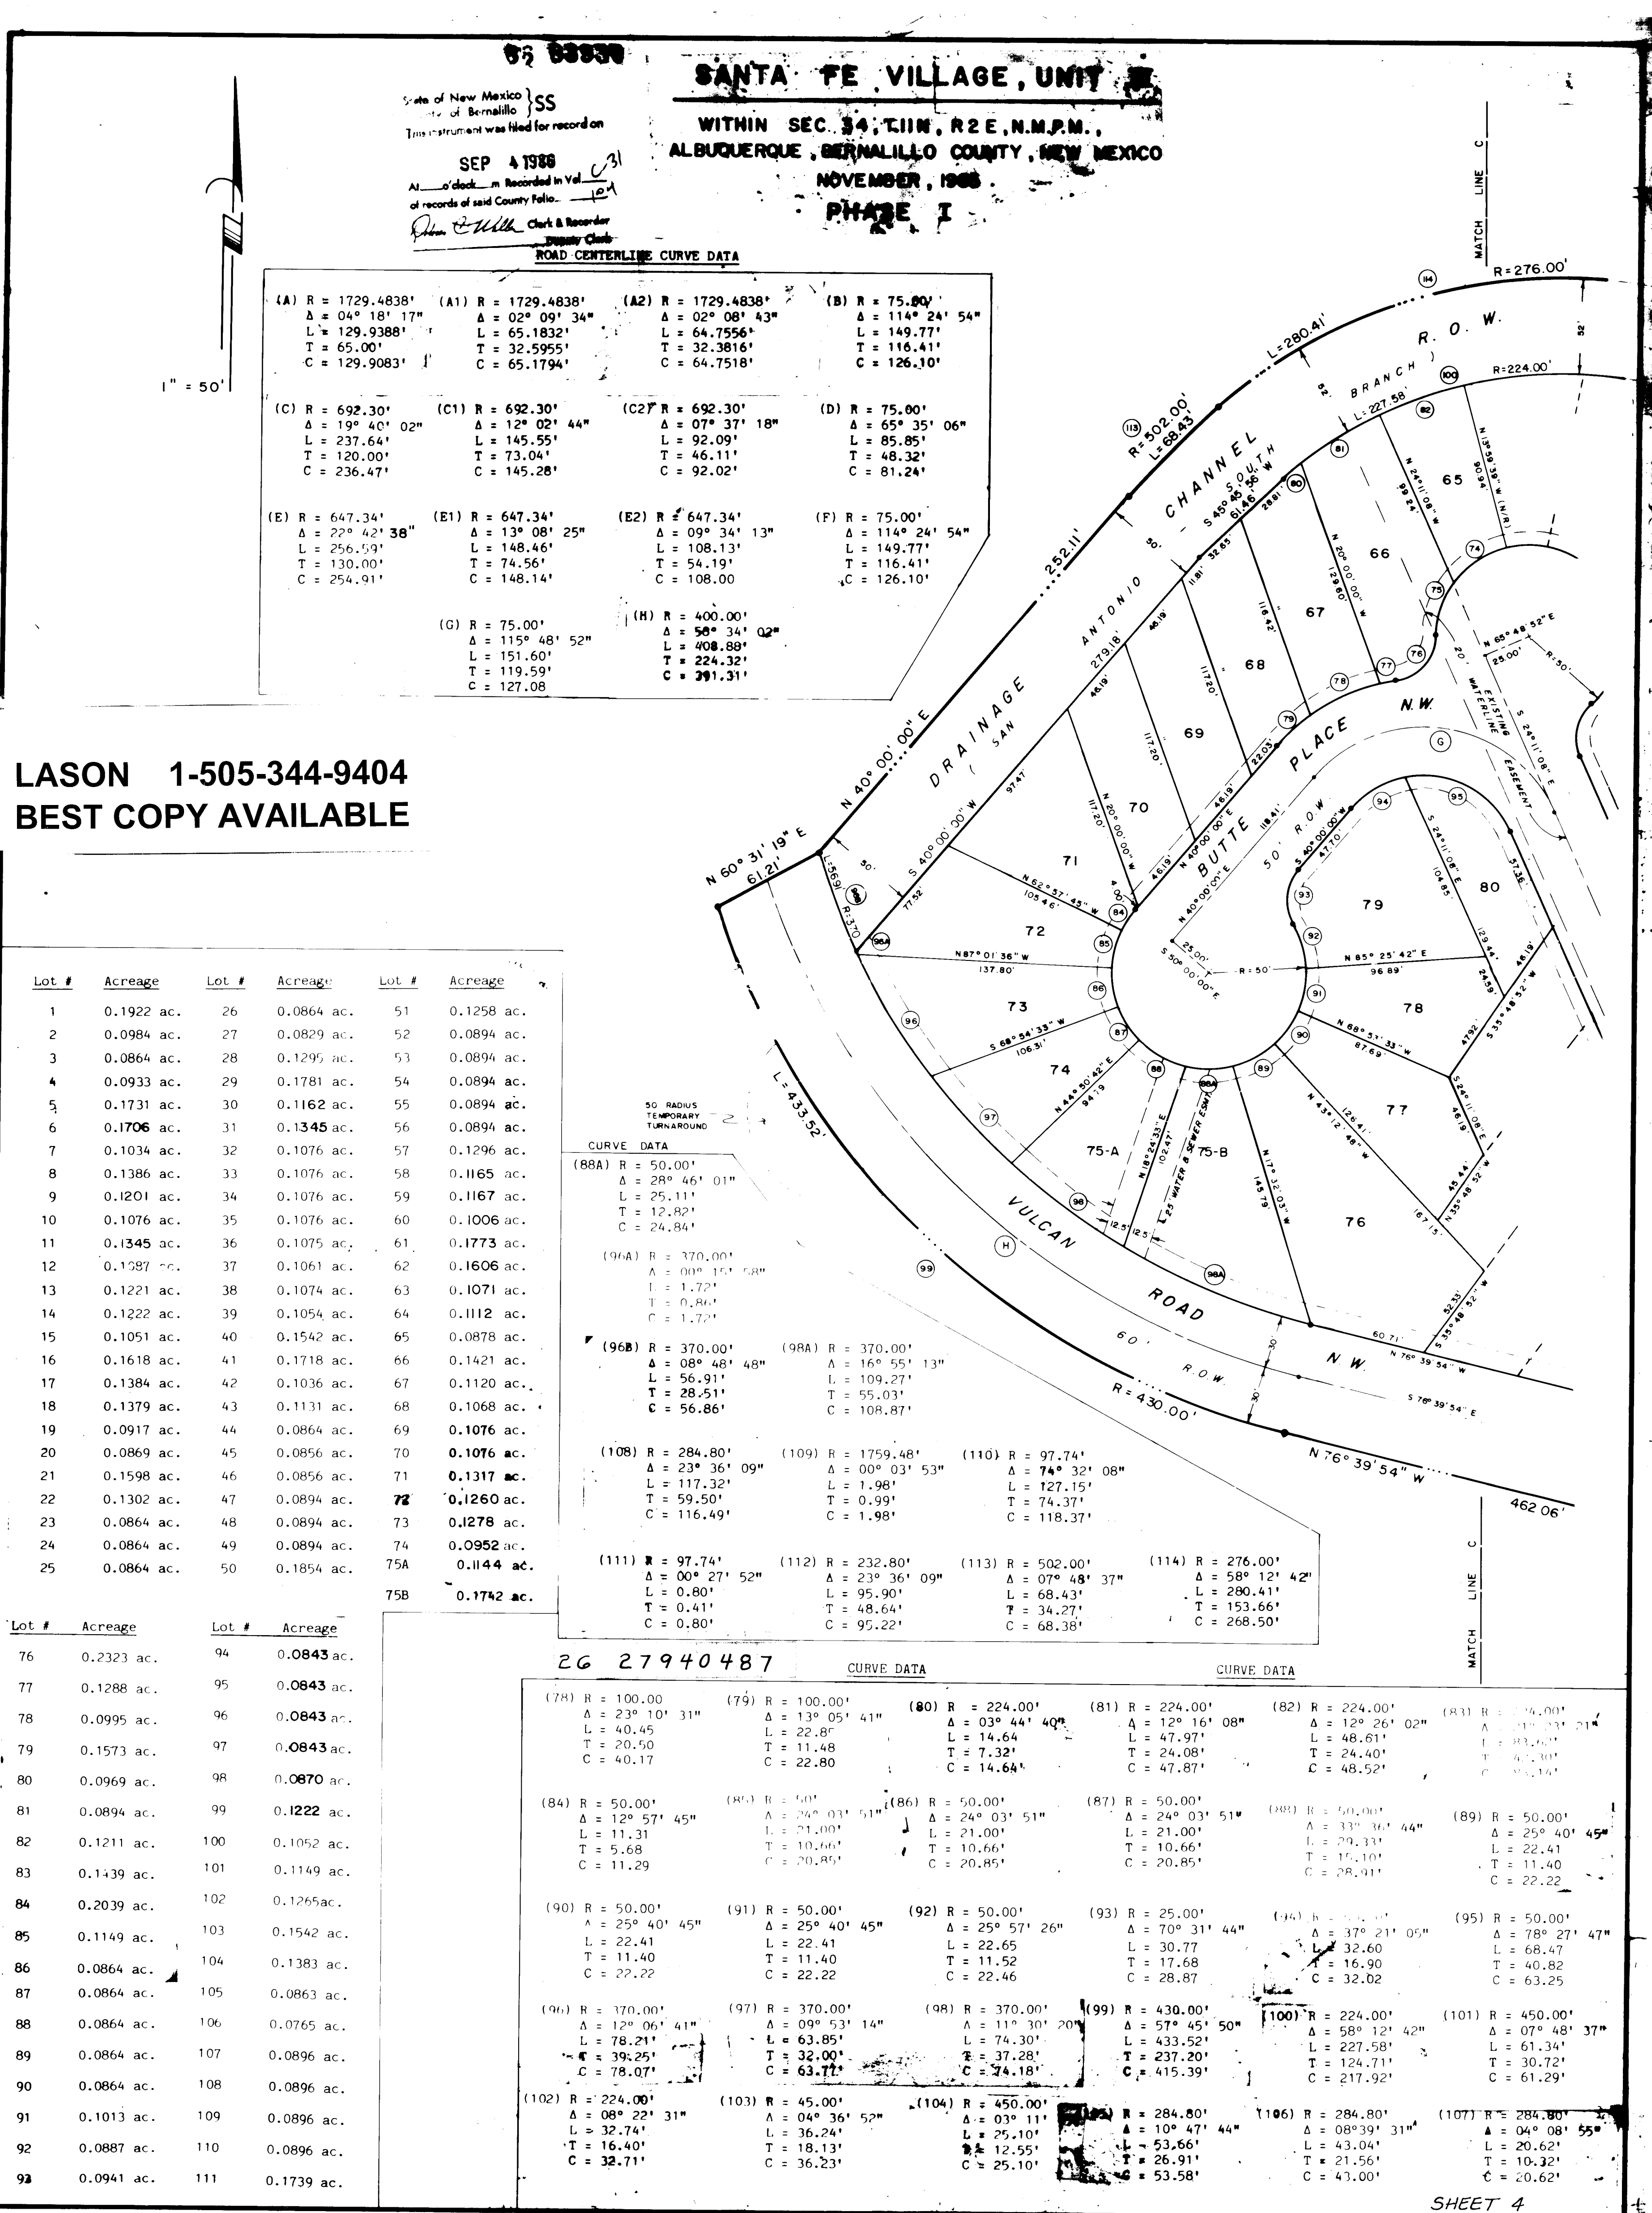


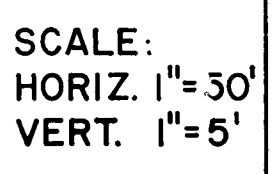

ENGINEER'S SEAL		SURVEY INFORMATION		BENCH MARKS		AS BUILT INFORMATION	
		NO		DATE		CONTRACT: BENCH MARK 7-FIL, WHICH BEARS N 26° 09' 08" E., 756.55' FROM THE S.E. CORNER OF SANTA FE VILLAGE III, A 3/4" PIPE. BENCH MARK IS A STANDARD A.C.S. BRASS CAP STAMPED 7-FIL.	
		BY		DATE		CONTROL: BENCH MARK 7-FIL, WHICH BEARS N 26° 09' 08" E., 756.55' FROM THE S.E. CORNER OF SANTA FE VILLAGE III, A 3/4" PIPE. BENCH MARK IS A STANDARD A.C.S. BRASS CAP STAMPED 7-FIL.	
NO. DATE		REMARKS		DESIGN		MICROFILM INFORMATION	
DESIGNED BY B.S.		DATE 2-86		RECORDED BY		DATE	
DRAWN BY A.P.		DATE 2-86		NO		M.S.L. ELEVATION 518.97'	
CHECKED BY E.D.		DATE 2-86					
PHASE I AND PROFILE							
ENGINEER		DATE					
R. H. HARRIS		5/16/66					
R. H. HARRIS		5/16/66					
SHEET		5		OF		15	

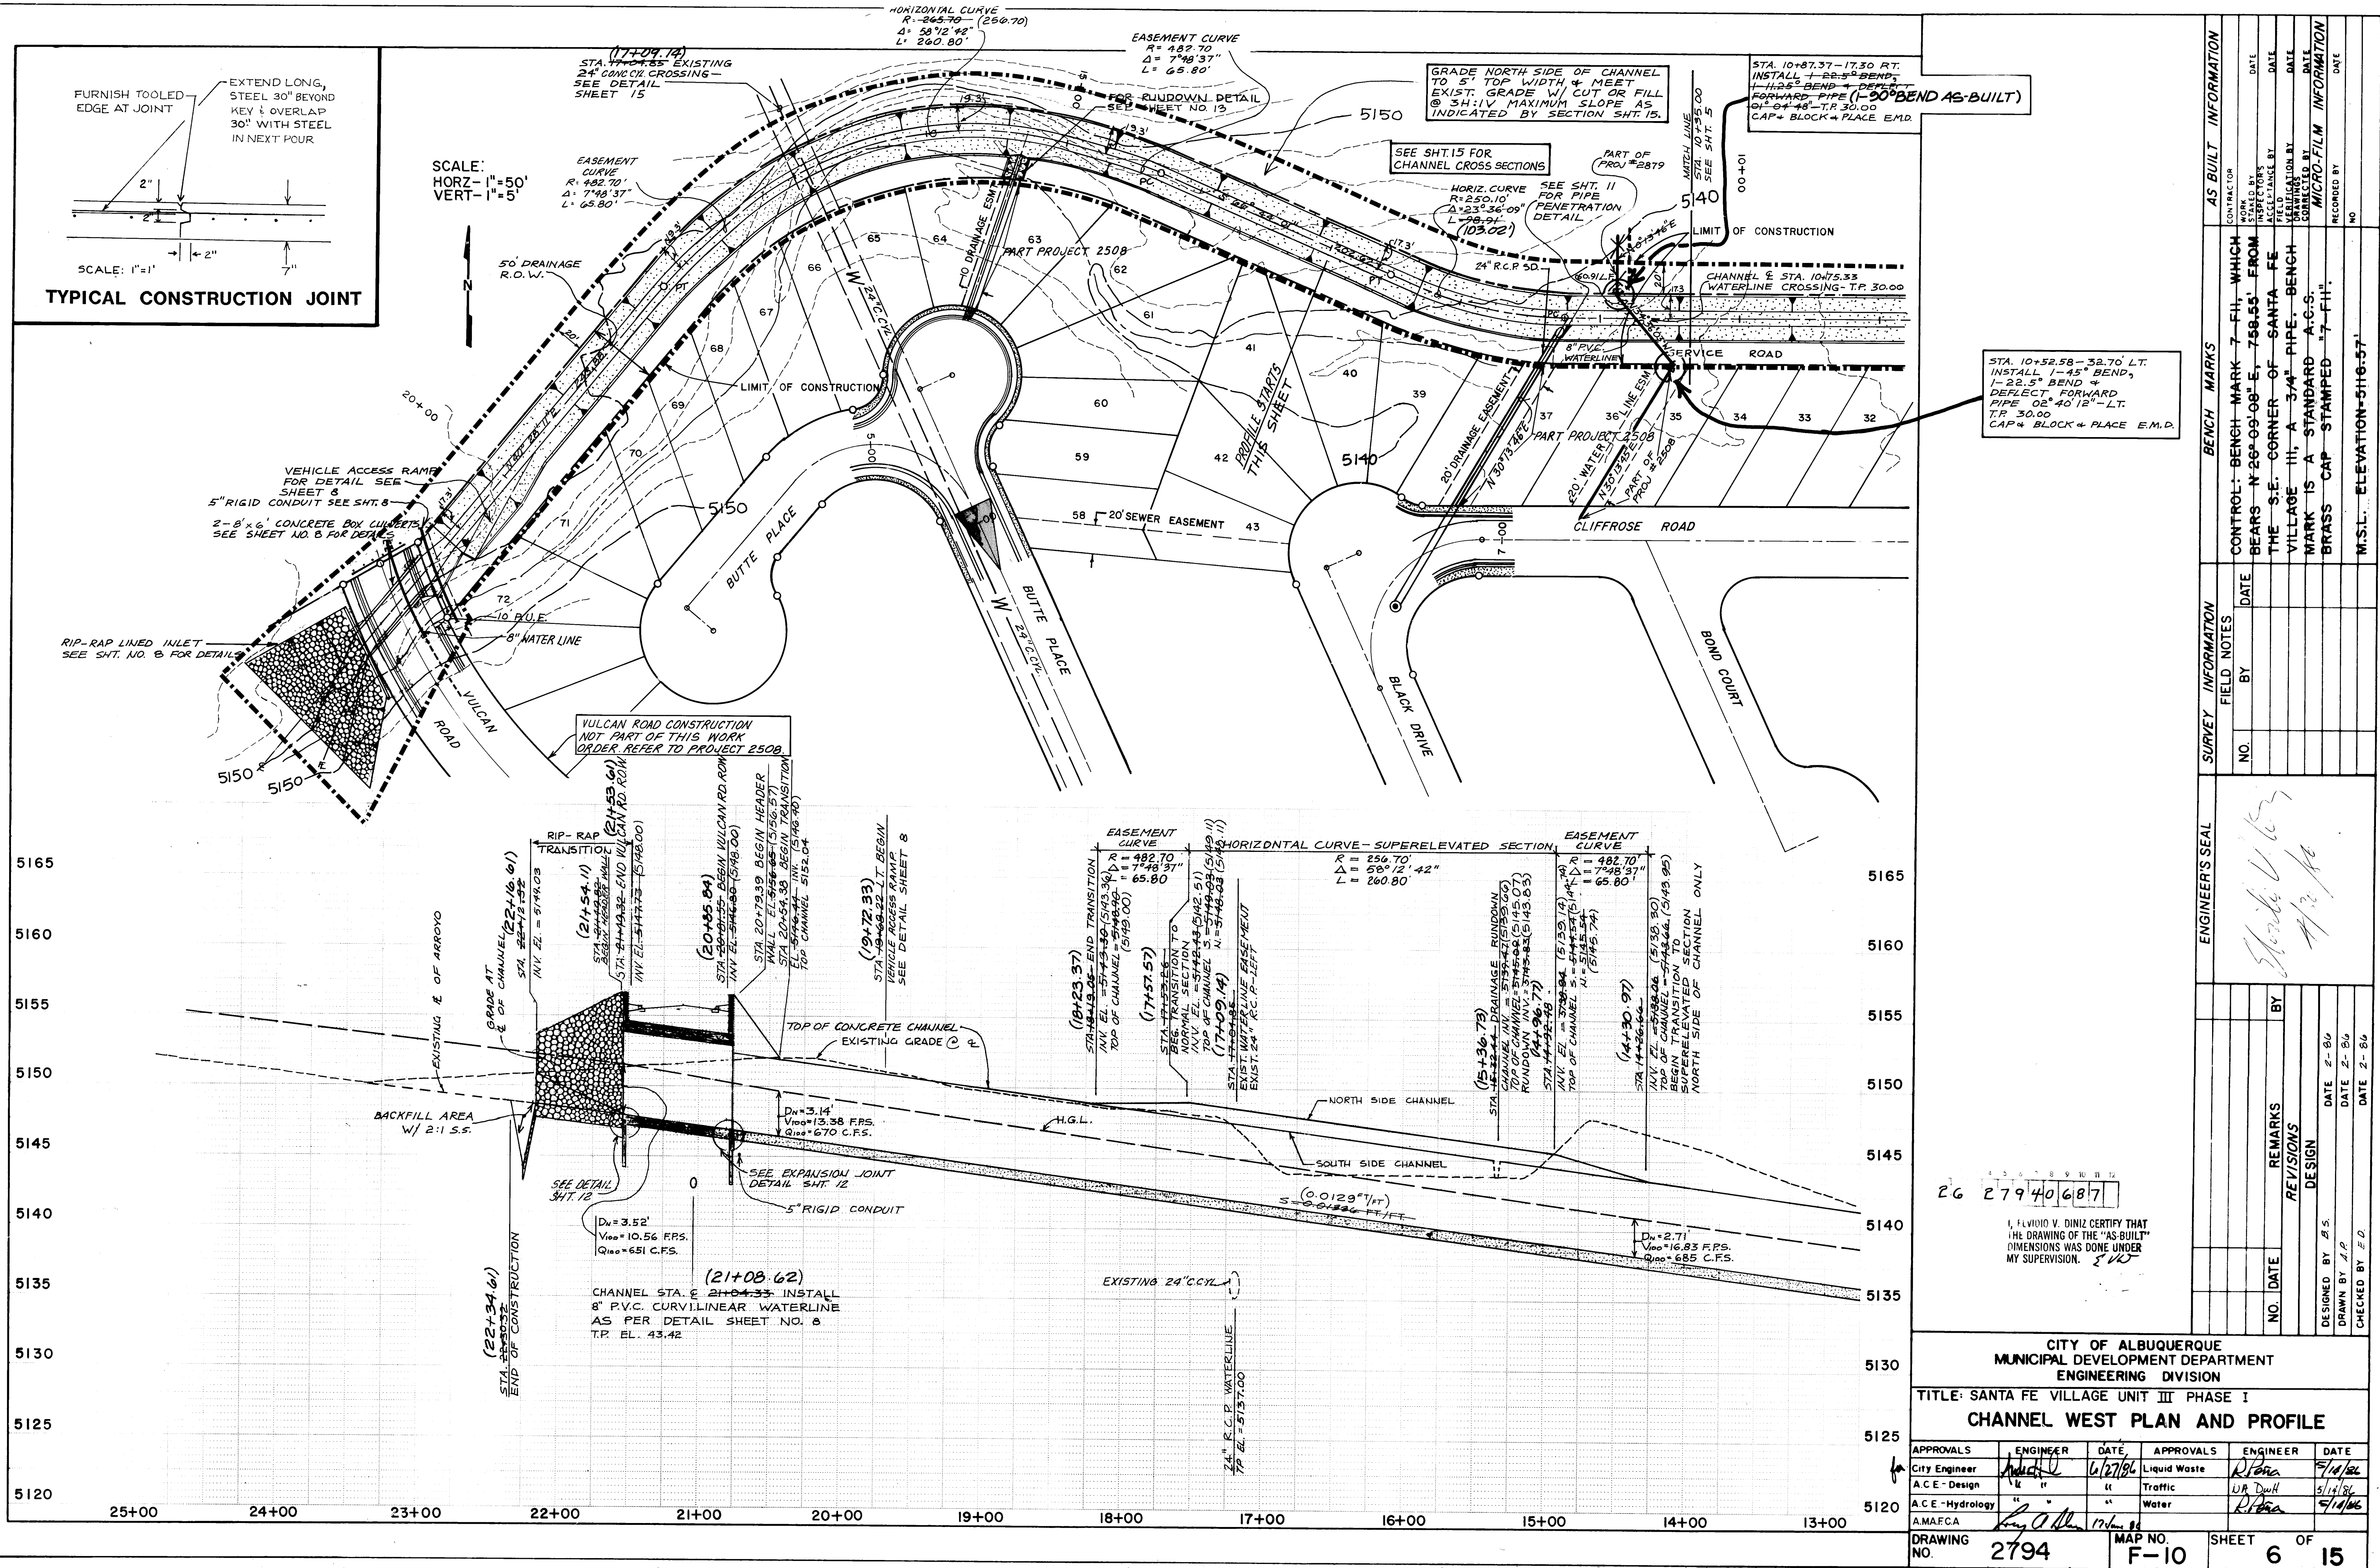


CITY OF ALBUQUERQUE MUNICIPAL DEVELOPMENT DEPARTMENT ENGINEERING DIVISION					
TITLE: SANTA FE VILLAGE UNIT III PHASE I					
CHANNEL WEST PLAN AND PROFILE					
APPROVALS	ENGINEER	DATE	APPROVALS	ENGINEER	DATE
City Engineer	<i>[Signature]</i>	6/27/86	Liquid Waste	<i>[Signature]</i>	7/1/86
A.C.E. - Design	<i>[Signature]</i>	6/27/86	Traffic	<i>[Signature]</i>	7/1/86
A.C.E. - Hydrology	<i>[Signature]</i>	6/27/86	Water	<i>[Signature]</i>	7/1/86
AMAFCA	<i>[Signature]</i>	6/27/86			
DRAWING NO.	2794	MAP NO.	F-10	SHEET	6 OF 15

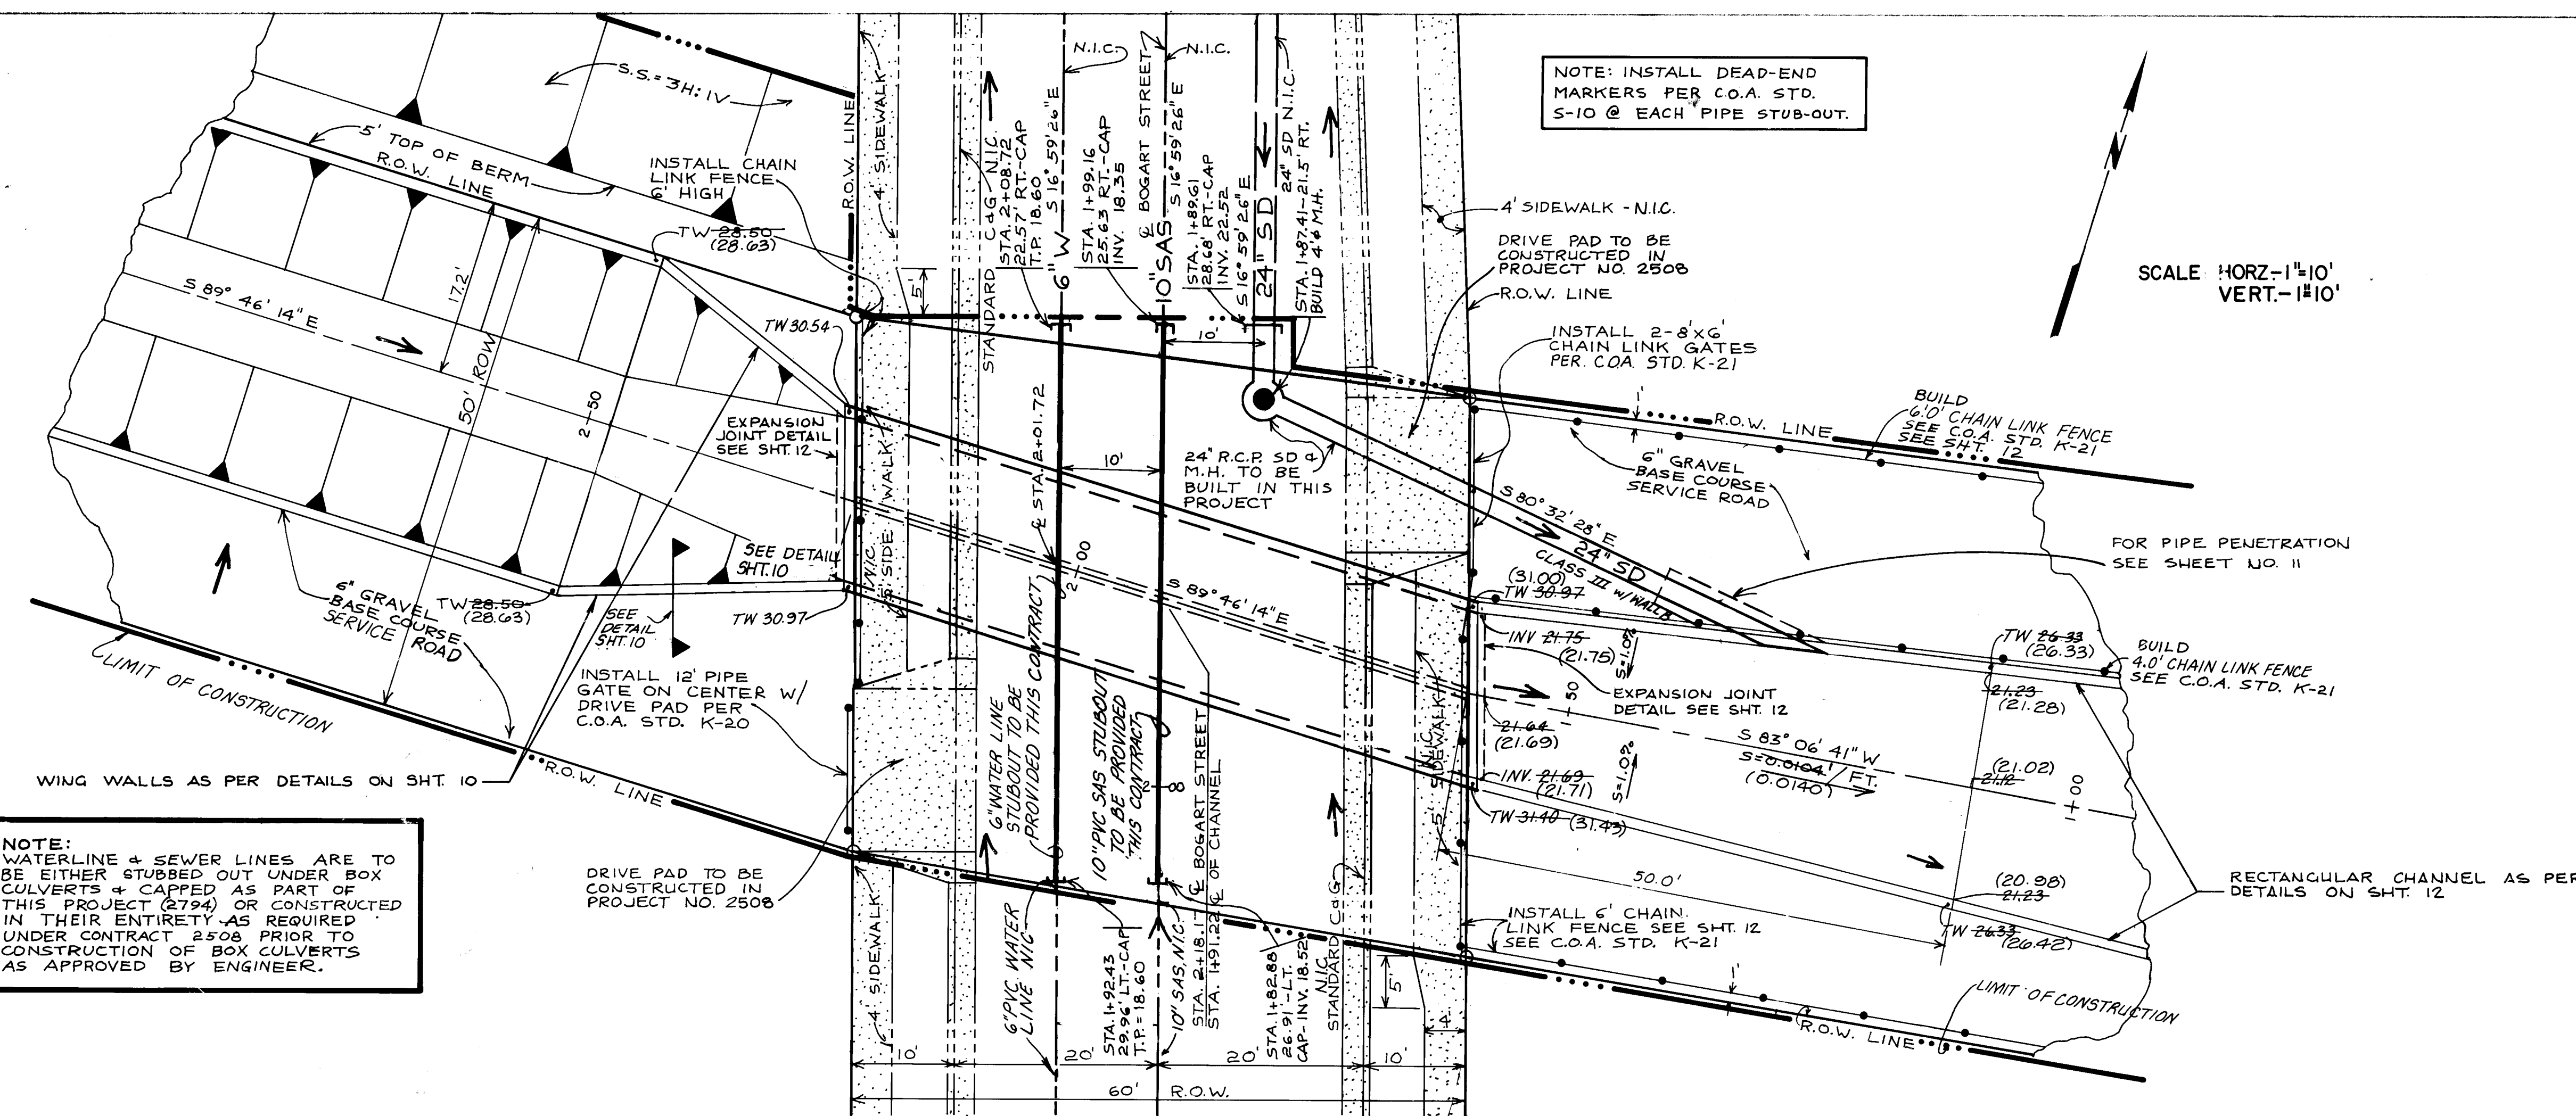


NOTE:
WATERLINE & SEWER LINES ARE TO BE EITHER STUBBED OUT UNDER BOX CULVERTS & CAPPED AS PART OF THIS PROJECT (2794) OR CONSTRUCTED IN THEIR ENTIRETY AS REQUIRED UNDER CONTRACT 2508 PRIOR TO CONSTRUCTION OF BOX CULVERTS AS APPROVED BY ENGINEER.

NOTE: INSTALL DEAD-END MARKERS PER C.O.A. STD. S-10 @ EACH PIPE STUB-OUT.

SCALE: HORIZ.-1"=10'
VERT.-1"=10'

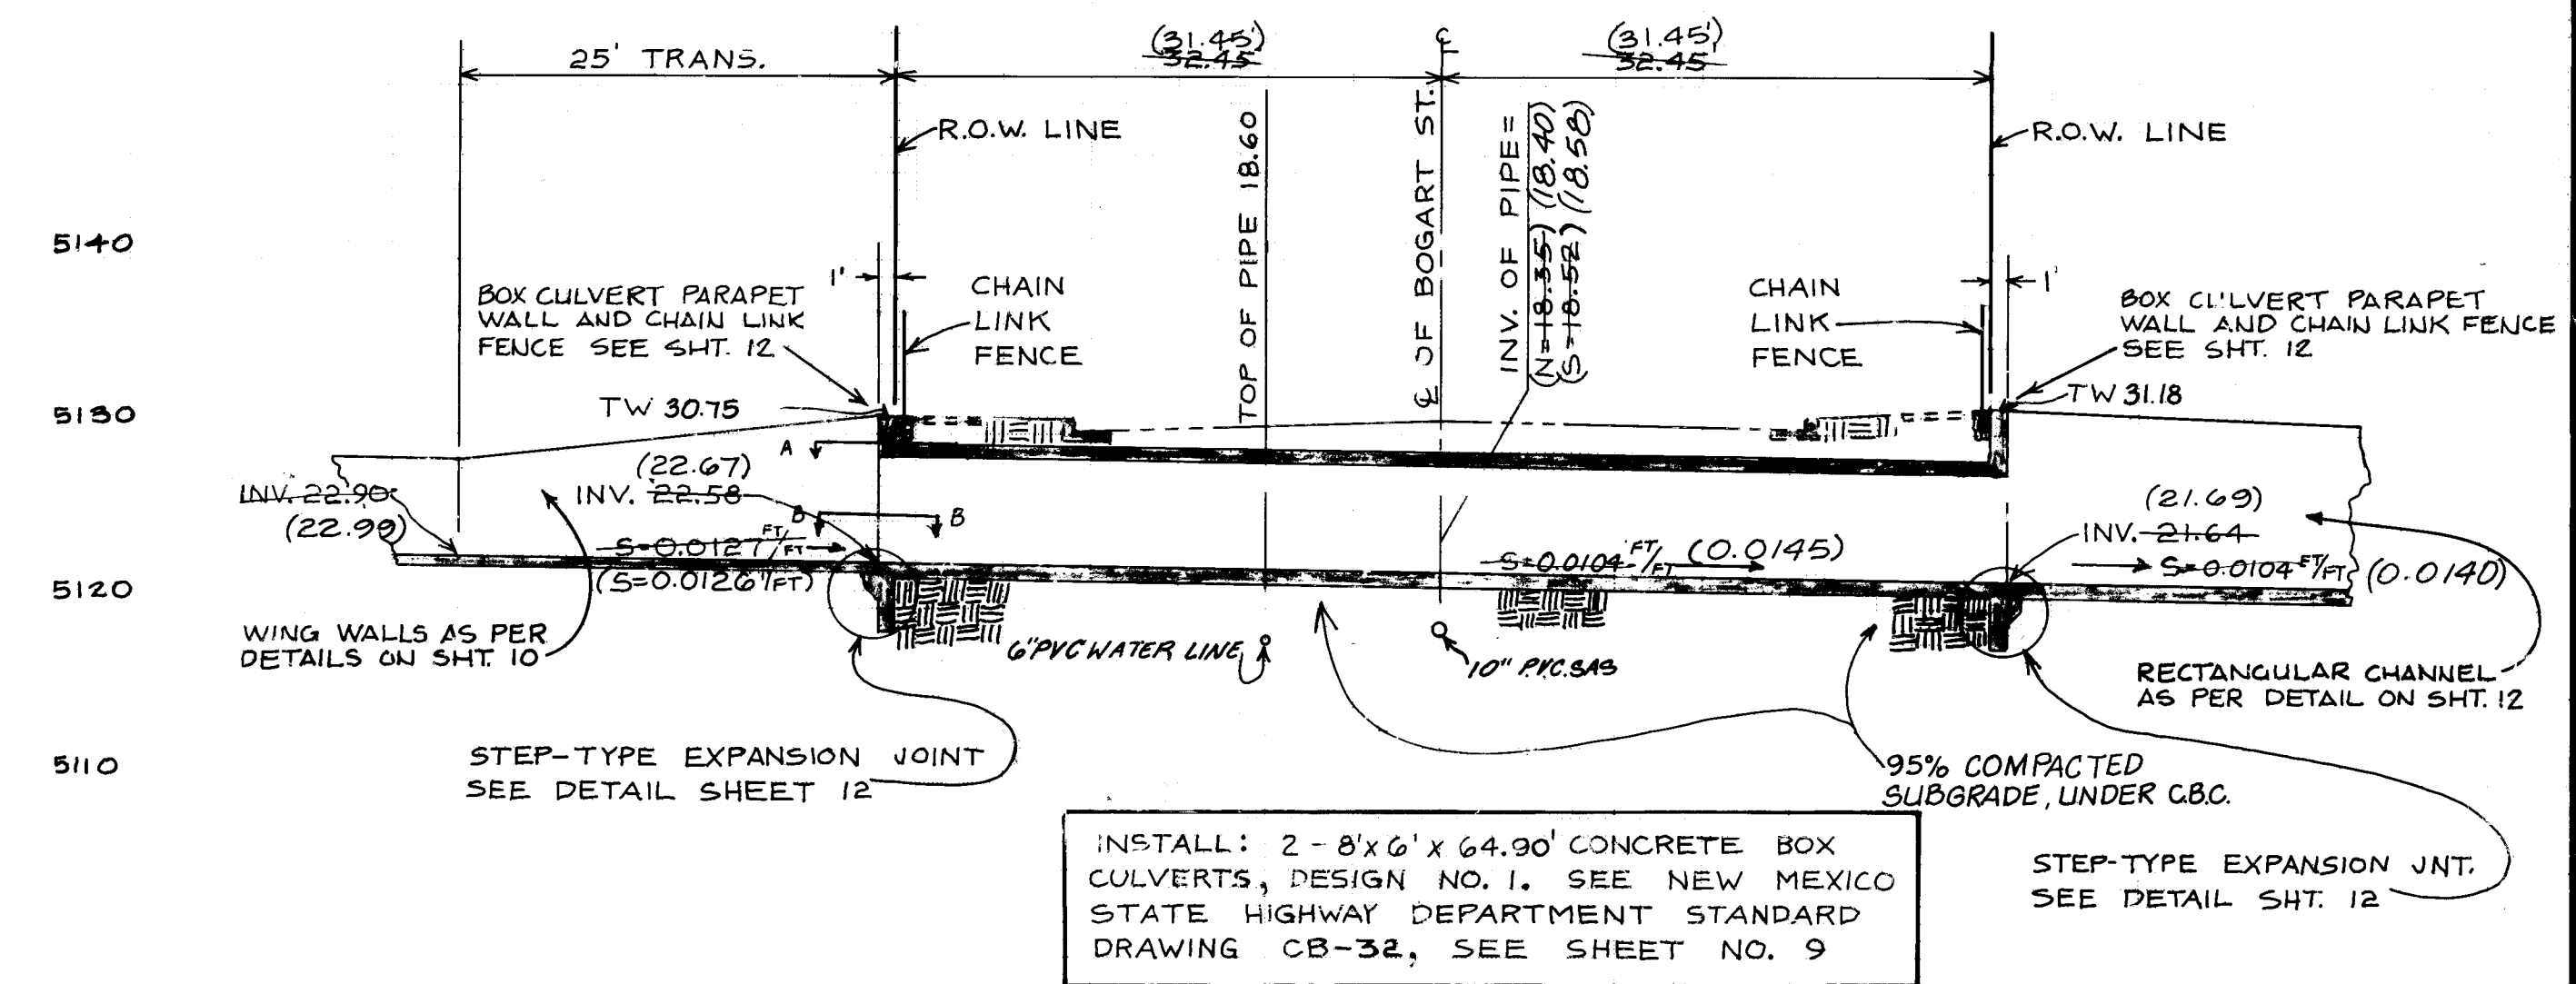

INSTALL: 2 - 8'x6'x64.90' CONCRETE BOX CULVERTS, DESIGN NO. 1. SEE NEW MEXICO STATE HIGHWAY DEPARTMENT STANDARD DRAWING CB-32, SEE SHEET NO. 9

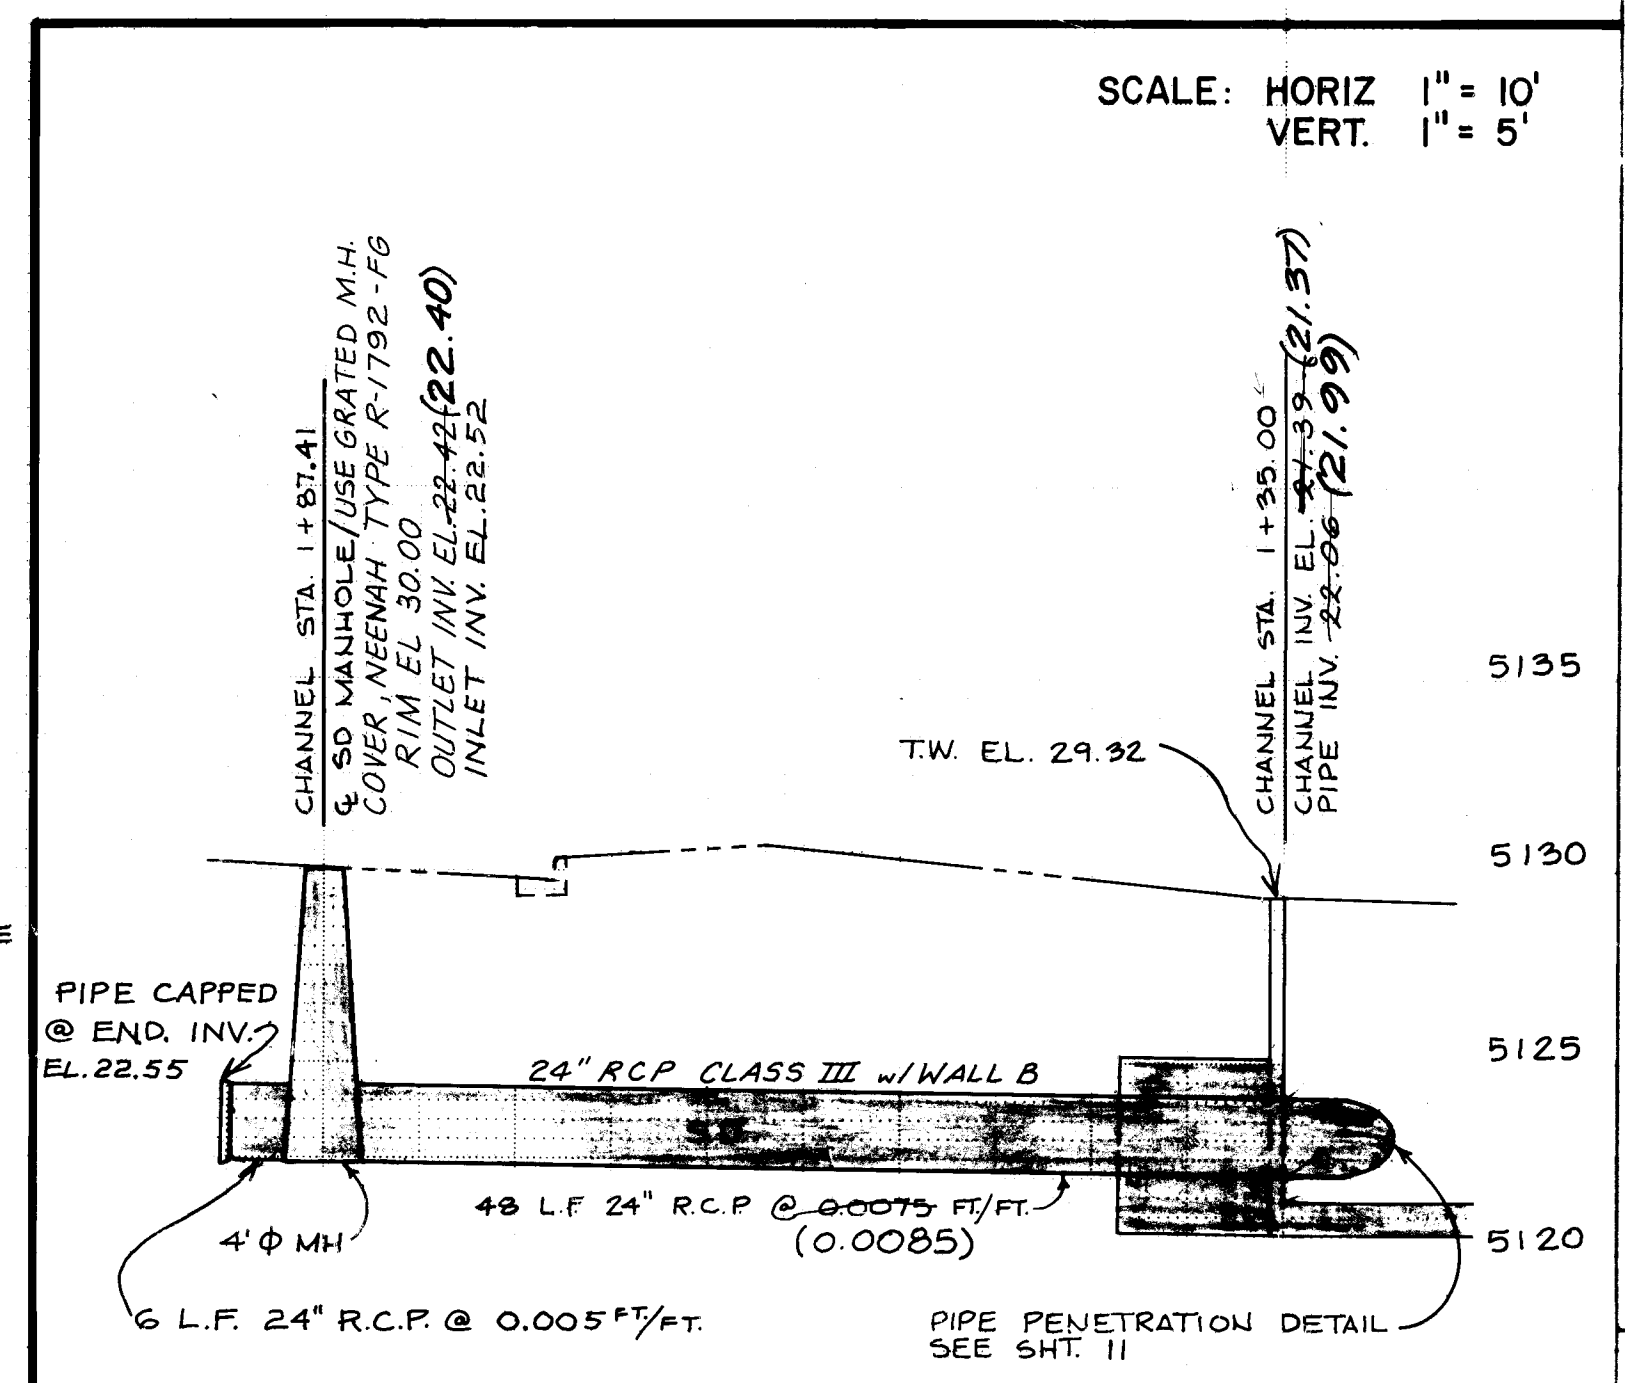


SCALE: HORIZ. 1"=10'
VERT. 1"=5'

NOTE: ALL STREET IMPROVEMENTS, EXCEPT CHAIN LINK FENCE AND PIPE GATE TO BE CONSTRUCTED IN PROJECT 2508.

AS BUILT INFORMATION				BENCH MARKS				SURVEY INFORMATION				ENGINEER'S SEAL			
DATE	BY	NO.	REMARKS	DATE	BY	NO.	REMARKS	DATE	BY	NO.	REMARKS	DATE	BY	NO.	REMARKS
				CONTROL: BENCH MARK 7-FIL WHICH BEARS N 26° 09' 08" E, 758.55' FROM THE S.E. CORNER OF SANTA FE VILLAGE III, A 3/4" PIPE. BENCH MARK IS A STANDARD A.C.S. BRASS CAP STAMPED "7-FIL".											
				M.S.L. ELEVATION=5116.57'											

BOGART STREET BOX CULVERT - PLAN AND PROFILE

STORM DRAIN PROFILE

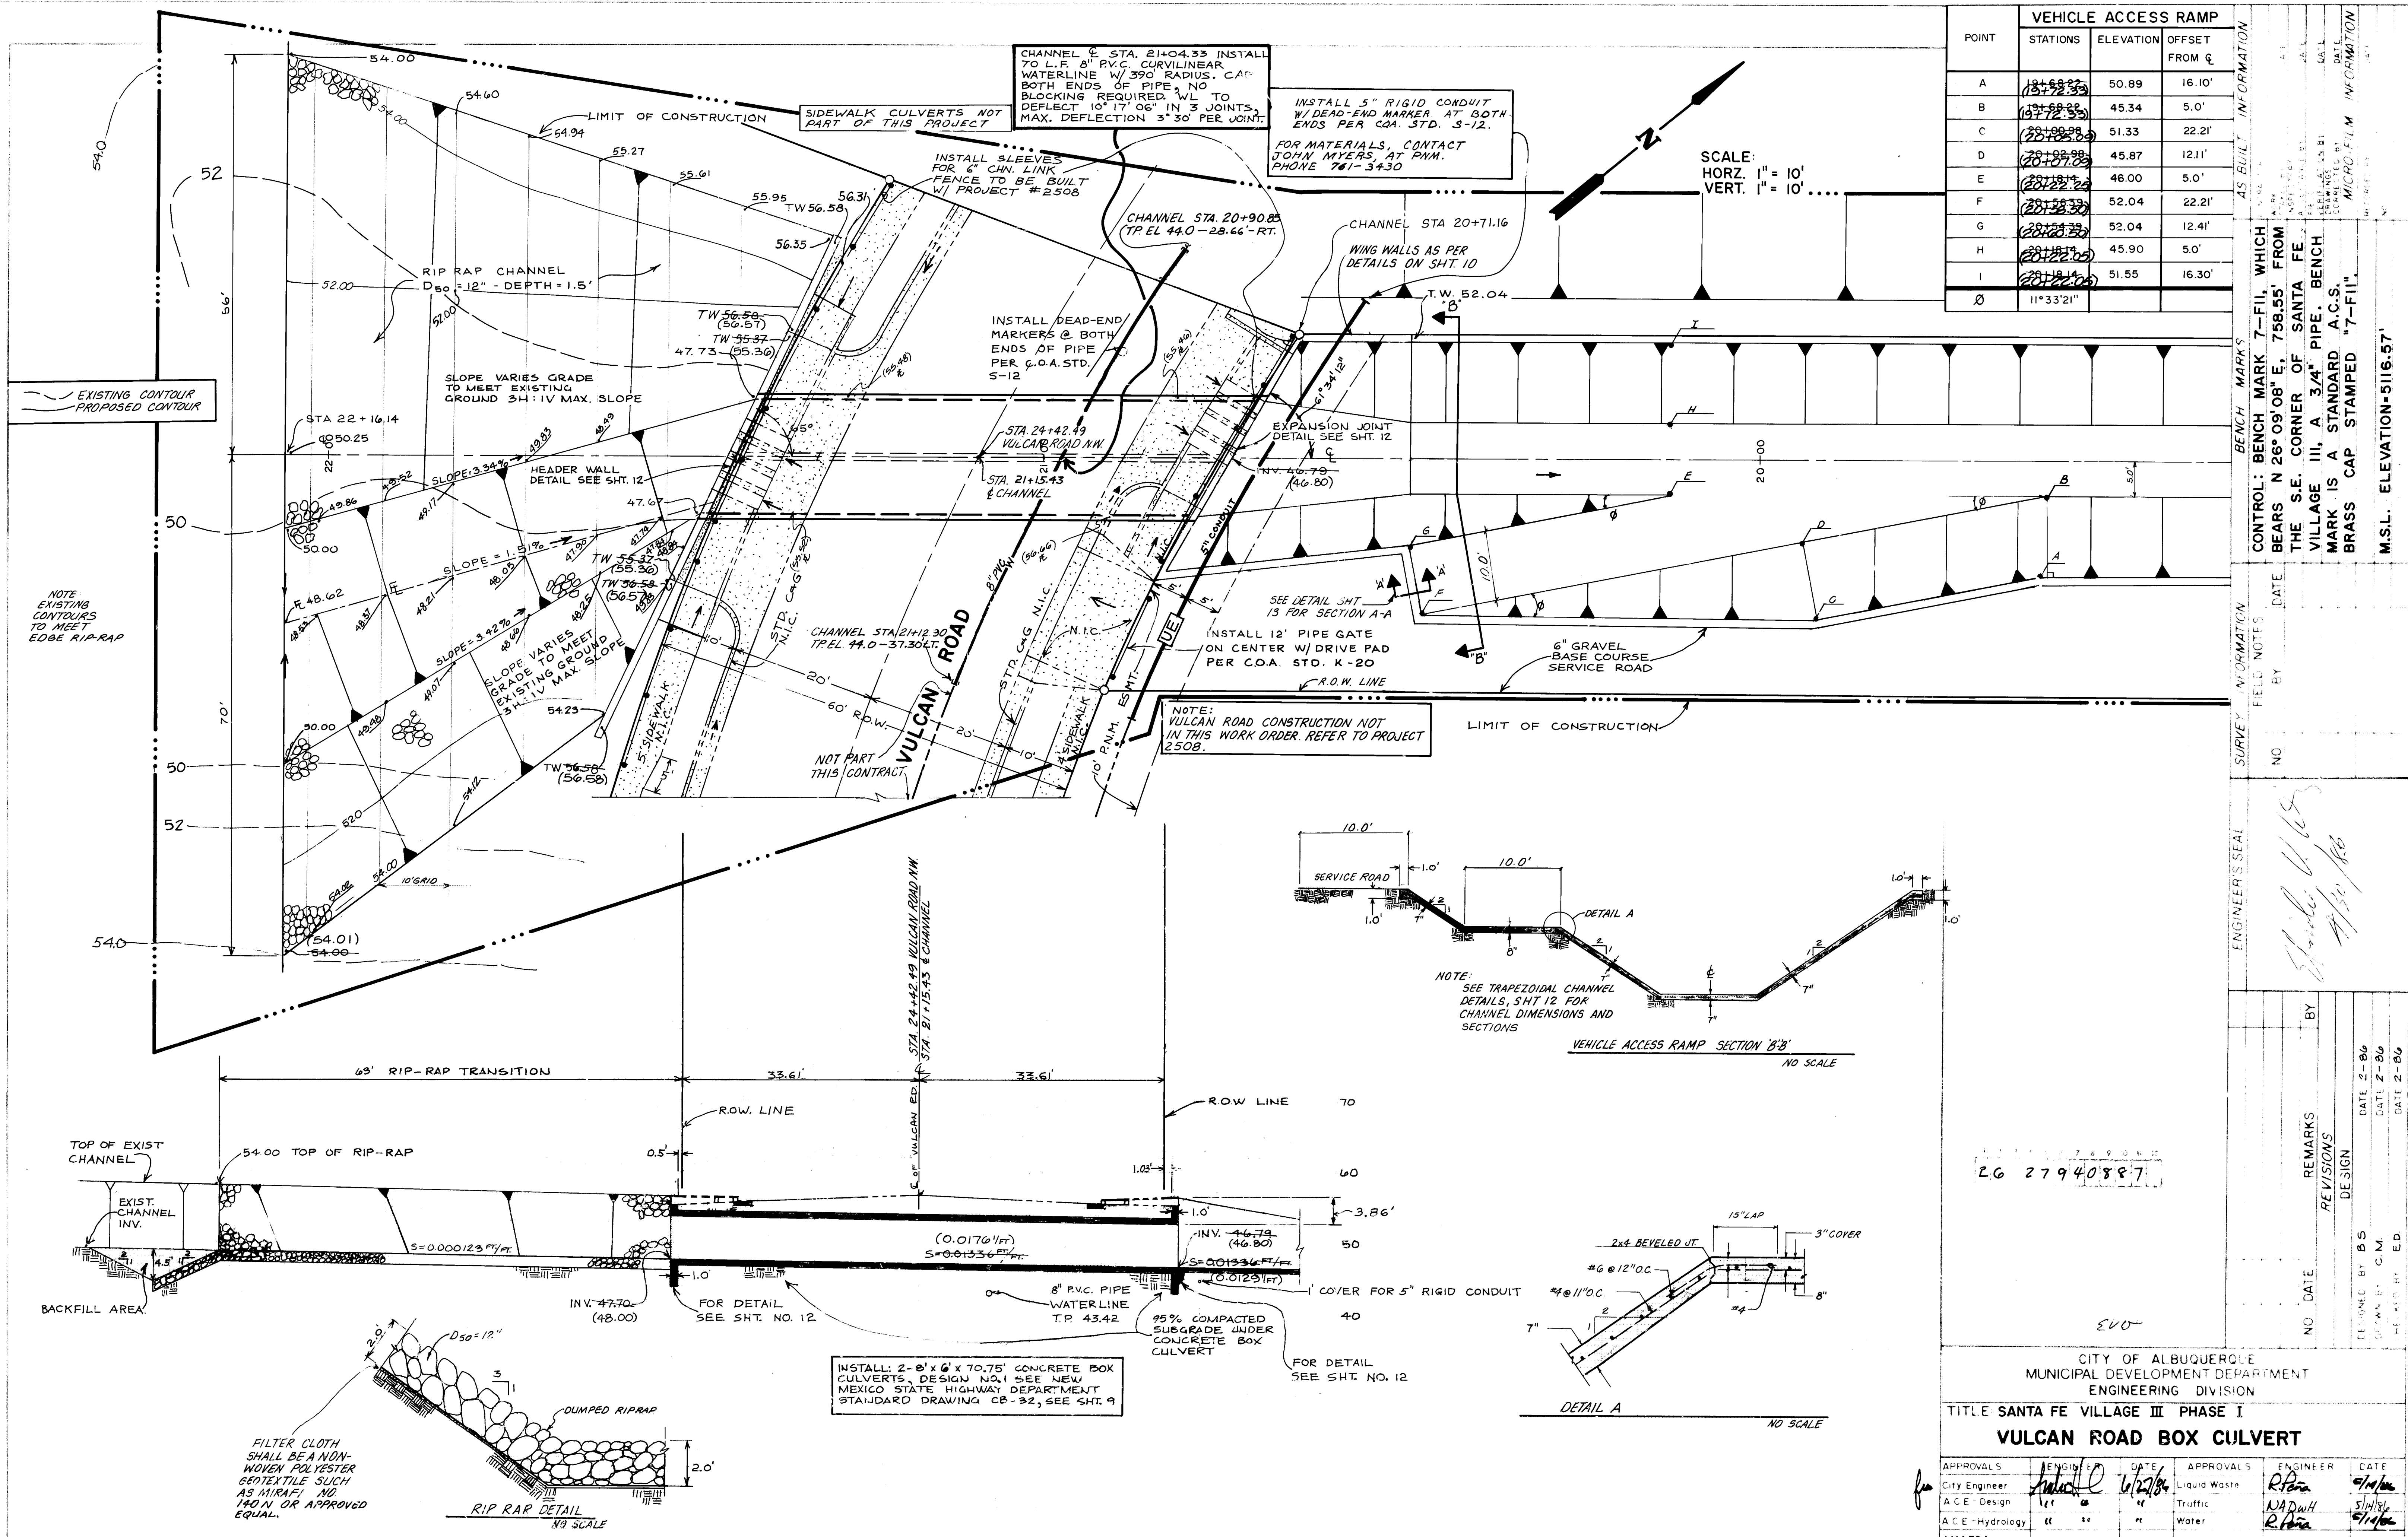

POINT	VEHICLE ACCESS RAMP		
	STATIONS	ELEVATION	OFFSET FROM C
A	18+58.33	50.89	16.10'
B	19+58.33	45.34	5.0'
C	20+00.00	51.33	22.21'
D	20+07.00	45.87	12.11'
E	20+13.15	46.00	5.0'
F	20+18.33	52.04	22.21'
G	20+25.00	52.04	12.41'
H	20+31.15	45.90	5.0'
I	20+37.00	51.55	16.30'
J	11+33'21"		

AS BUILT INFORMATION

CONTROL: BENCH MARK 7-FII, WHICH BEARS N 26° 09' 08" E, 758.55' FROM THE S.E. CORNER OF SANTA FE VILLAGE III, A 3/4" PIPE. BENCH MARK IS A STANDARD A.C.S. BRASS CAP STAMPED "7-FII".

M.S.L. ELEVATION=5116.57'

SURVEY INFORMATION

DATE: 1/27/84

BY: [Signature]

NO. 26 27 940 887

ENGINEER'S SEAL

[Signature]

DATE: 2-86

DATE: 2-86

DATE: 2-86

REMARKS

DESIGN

NO. DATE

REVISIONS

DESIGN

NO. DATE

CITY OF ALBUQUERQUE

MUNICIPAL DEVELOPMENT DEPARTMENT

ENGINEERING DIVISION

TITLE SANTA FE VILLAGE III PHASE I

VULCAN ROAD BOX CULVERT

APPROVALS

City Engineer

ACE - Design

ACE - Hydrology

AMAFCA

DATE

1/27/84

"

"

APPROVALS

Engineer

Liquid Waste

Truffic

Water

DATE

5/14/86

5/14/86

5/14/86

DRAWING NO.

2794

MAP NO.

F-10


SHEET

8


OF

15


VULCAN ROAD BOX CULVERT—PLAN AND PROFILE

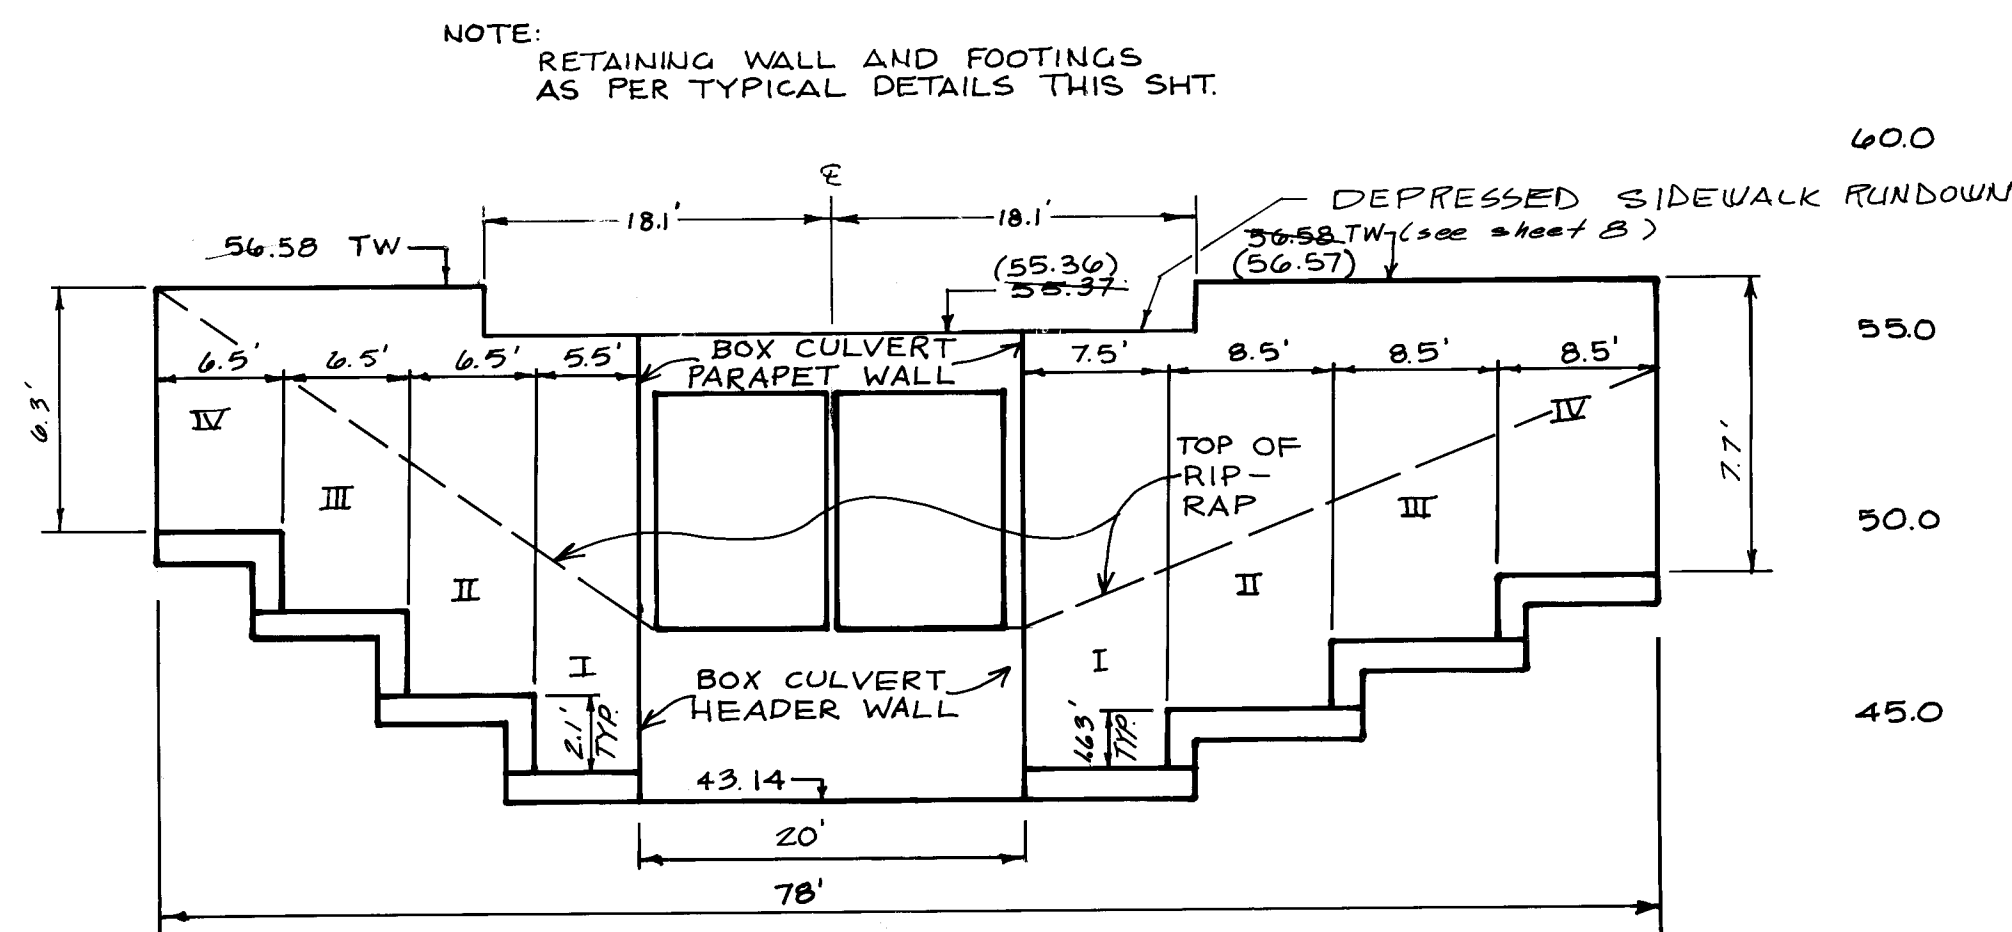


HEADER WALL—VULCAN WEST

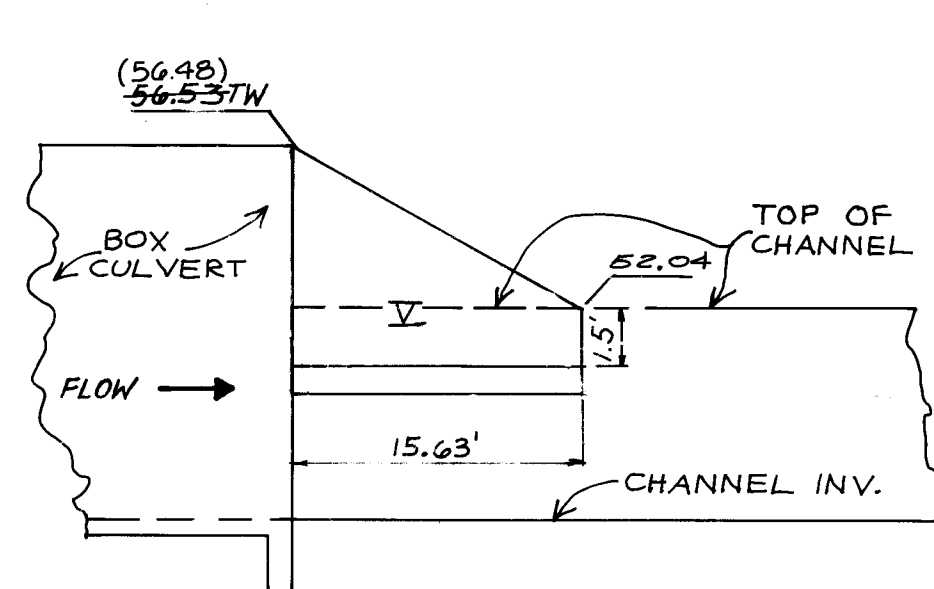


NORTHSIDE

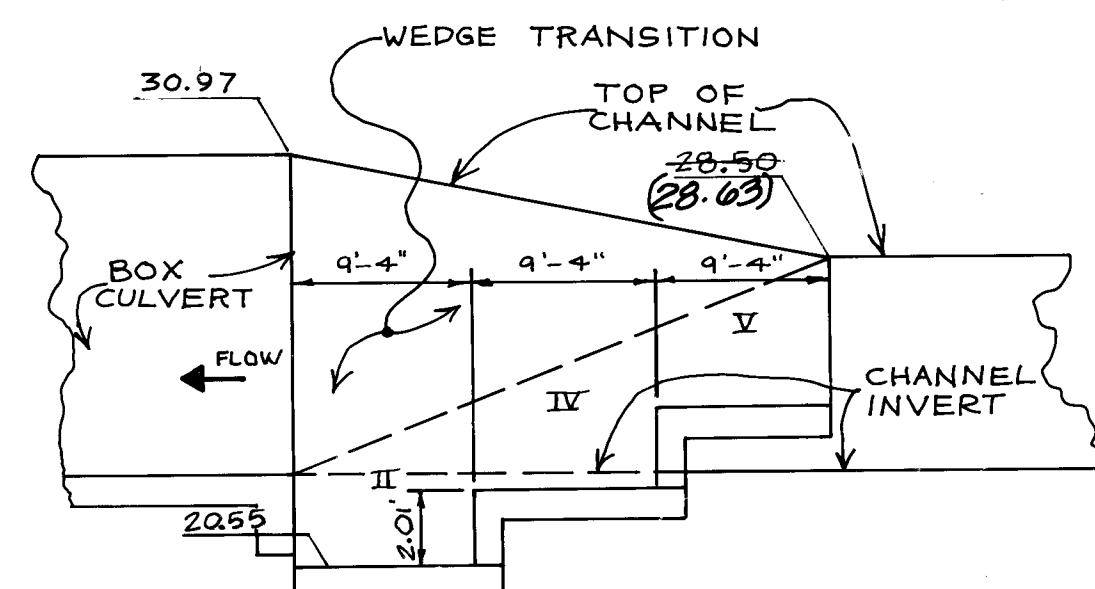

SOUTHSIDE

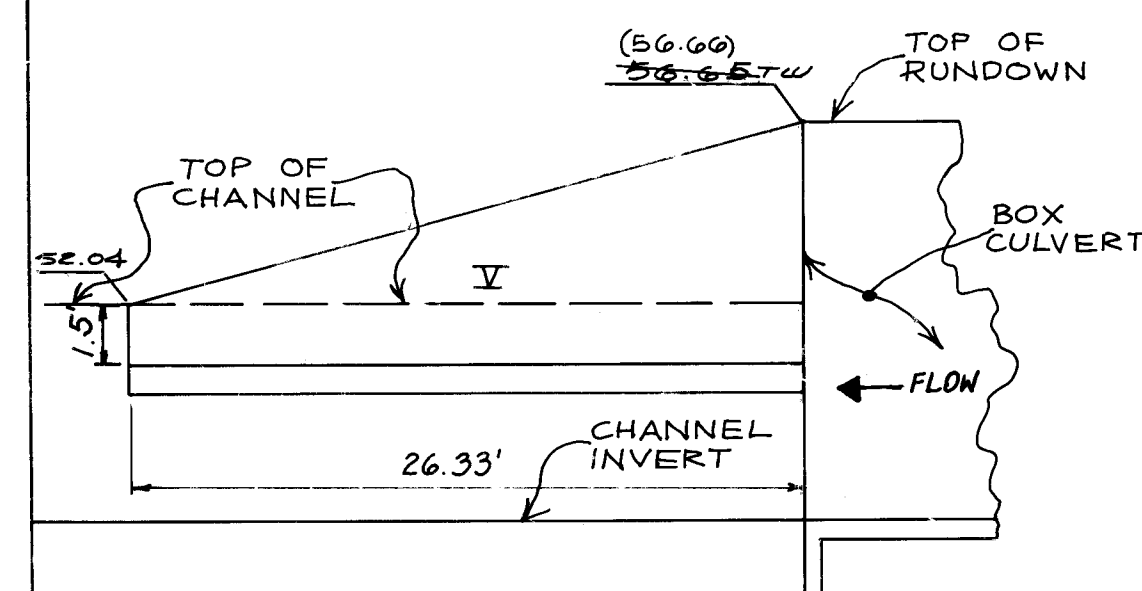


SOUTHSIDE

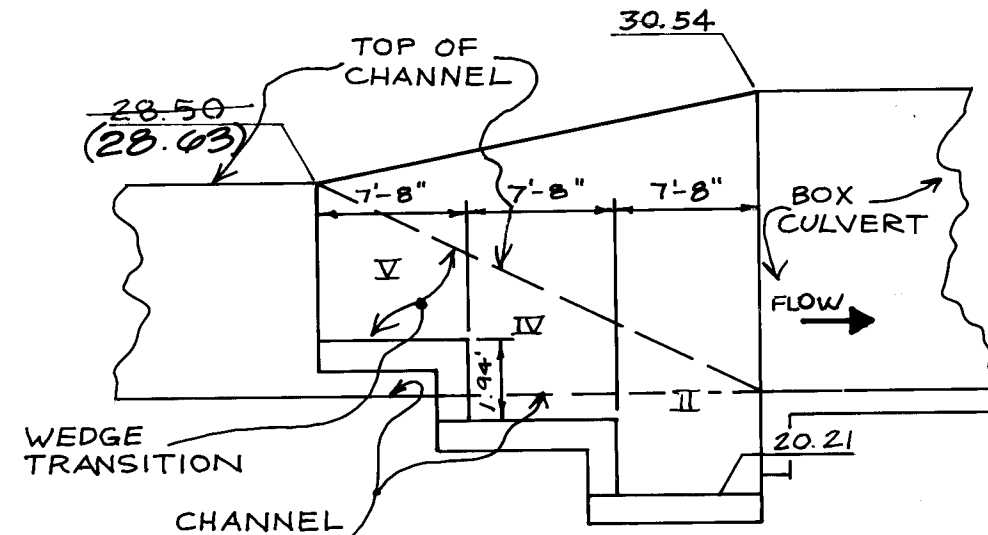


NORTHSIDE

VULCAN STREET WING WALLS

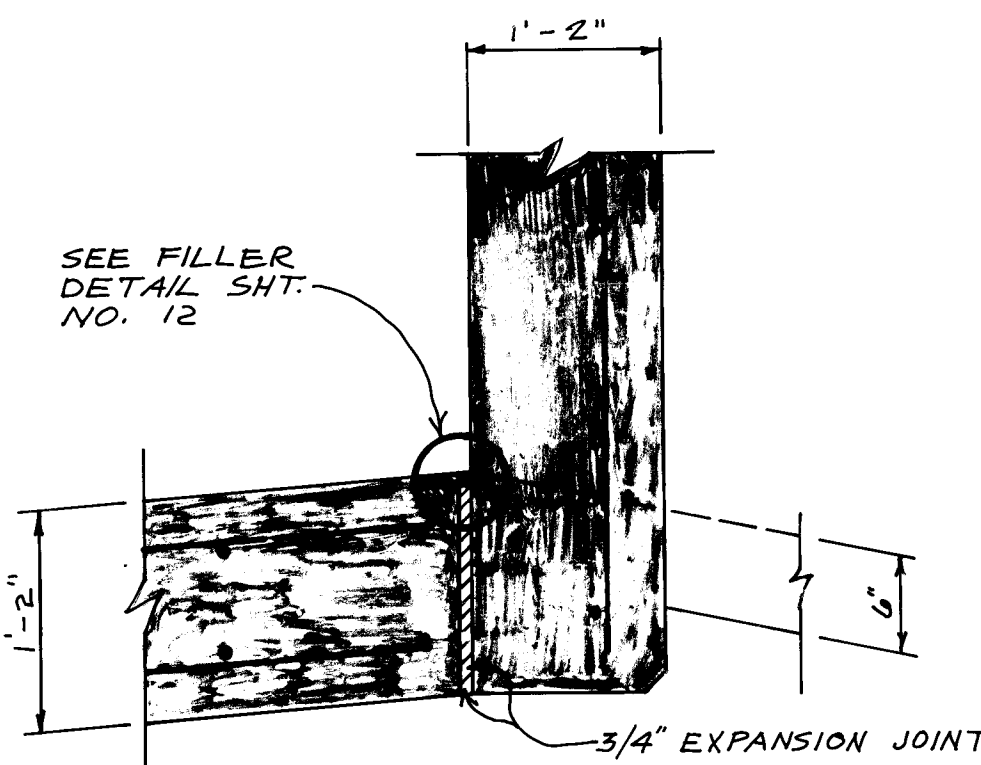

SCALE: 1" = 1'


**SECTION A-A TYP. EXPANSION JOINT
AT BOX CULVERT PARAPET**

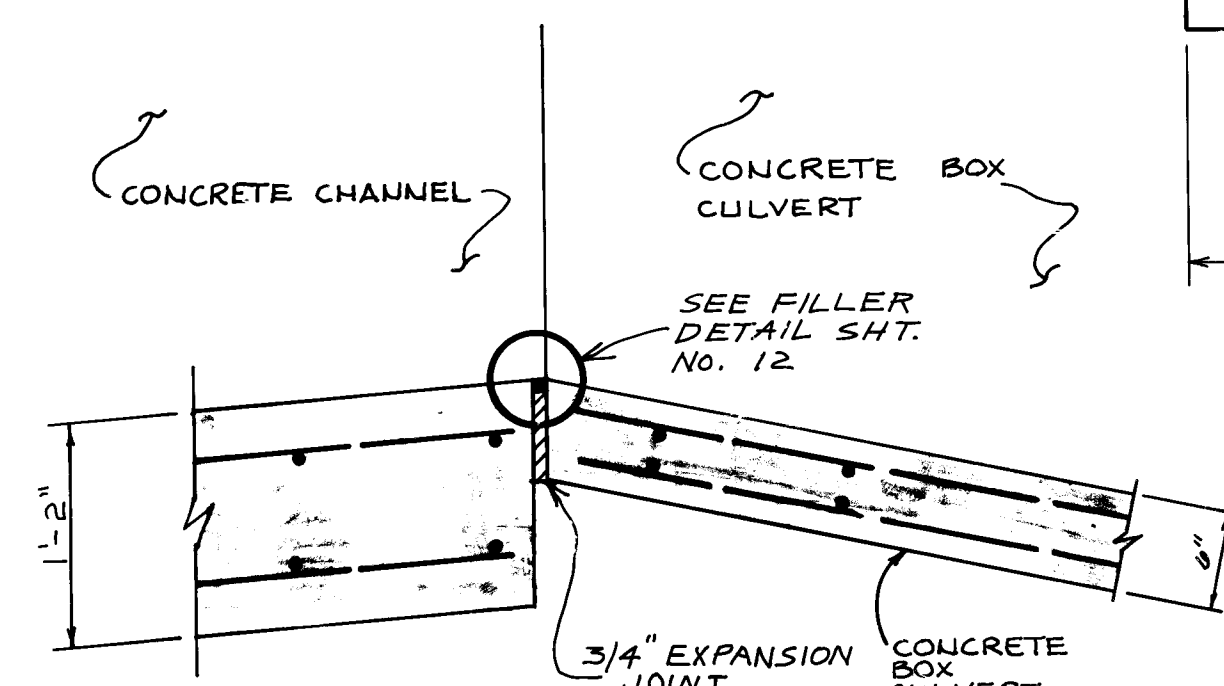


**SECTION B-B TYP. EXPANSION JOINT DETAIL
AT BOX CULVERT BARREL WALL**

TYPE	A	B	C	D	V - BARS	H - BARS
I	1'-8"	6'-6"	1'-3"	1'-2"	#7 @ 6" O.C.	#6 @ 6" O.C.
II	1'-4"	5'-4"	1'-2"	1'-2"	#7 @ 6" O.C.	#6 @ 6" O.C.
III	1'-0"	4'-9"	1'-0"	1'-0"	#6 @ 6" O.C.	#5 @ 6" O.C.
IV	1'-0"	4'-0"	1'-0"	1'-0"	#4 @ 6" O.C.	#4 @ 12" O.C.
V	6"	3'-0"	11"	10"	#4 @ 12" O.C.	#4 @ 18" O.C.


RETAINING WALL SCHEDULE

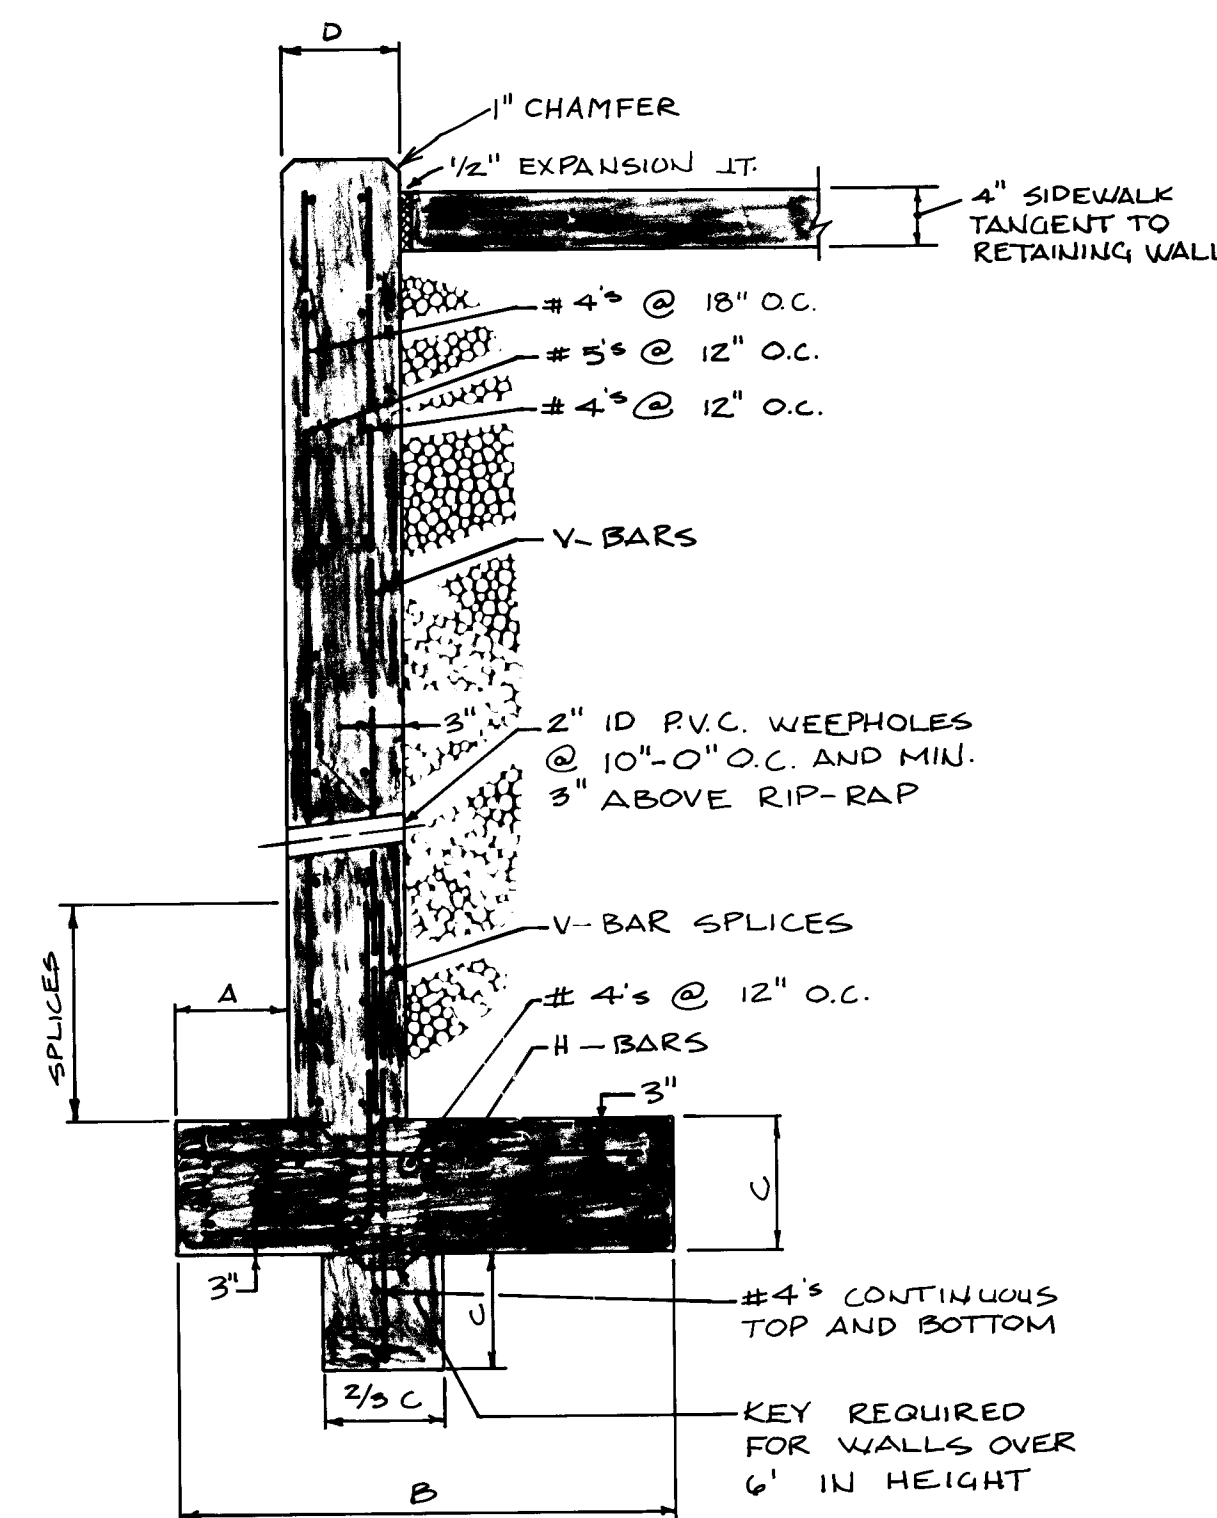


NO SCALE
TYPICAL RETAINING WALL

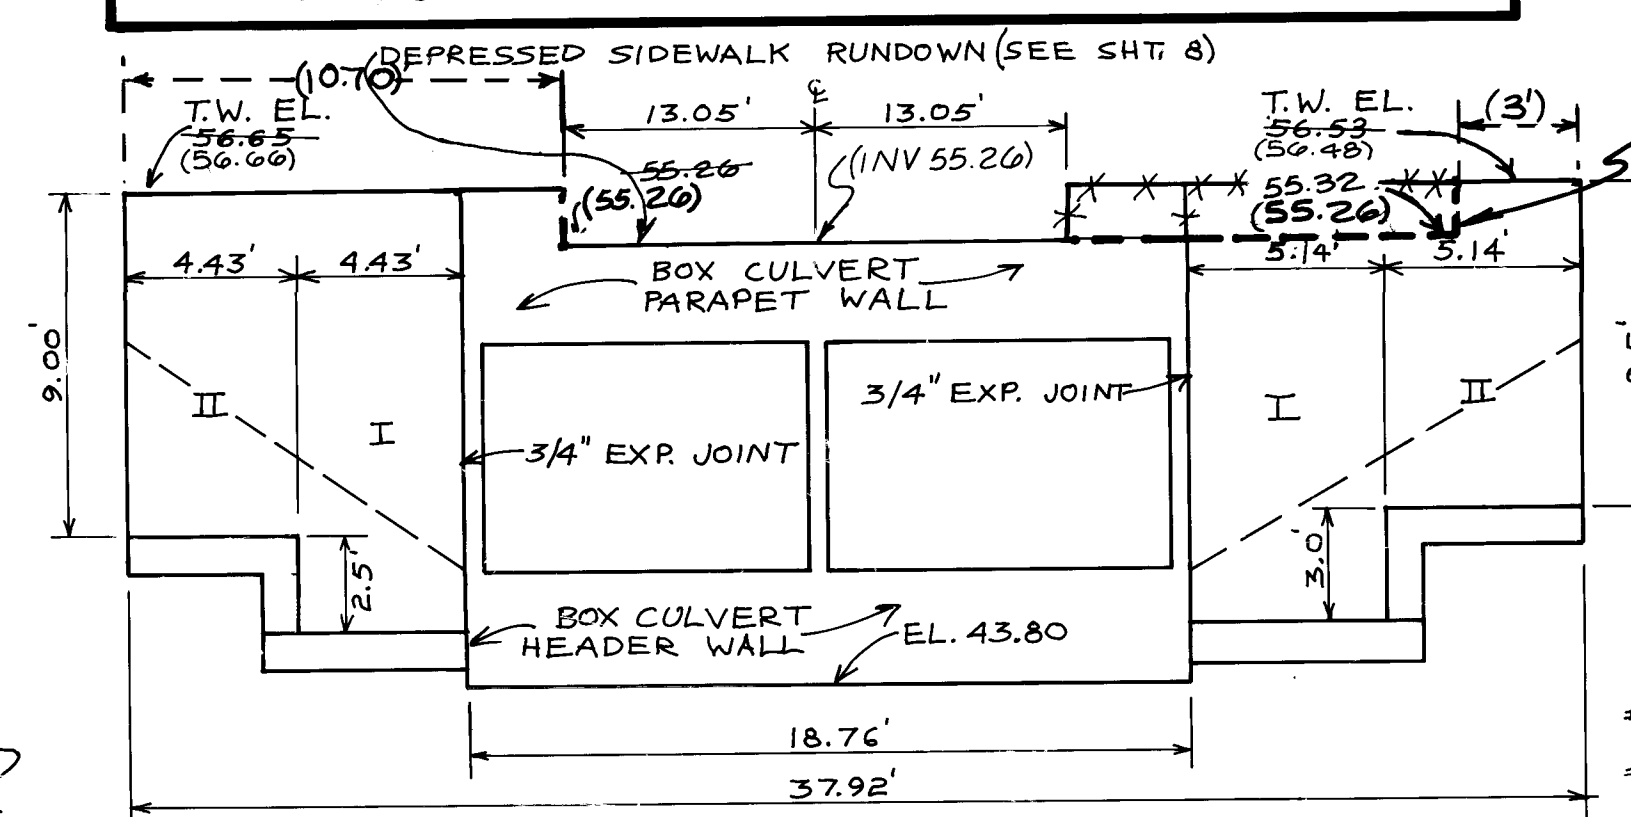


HEADER WALL-VULCAN EAST

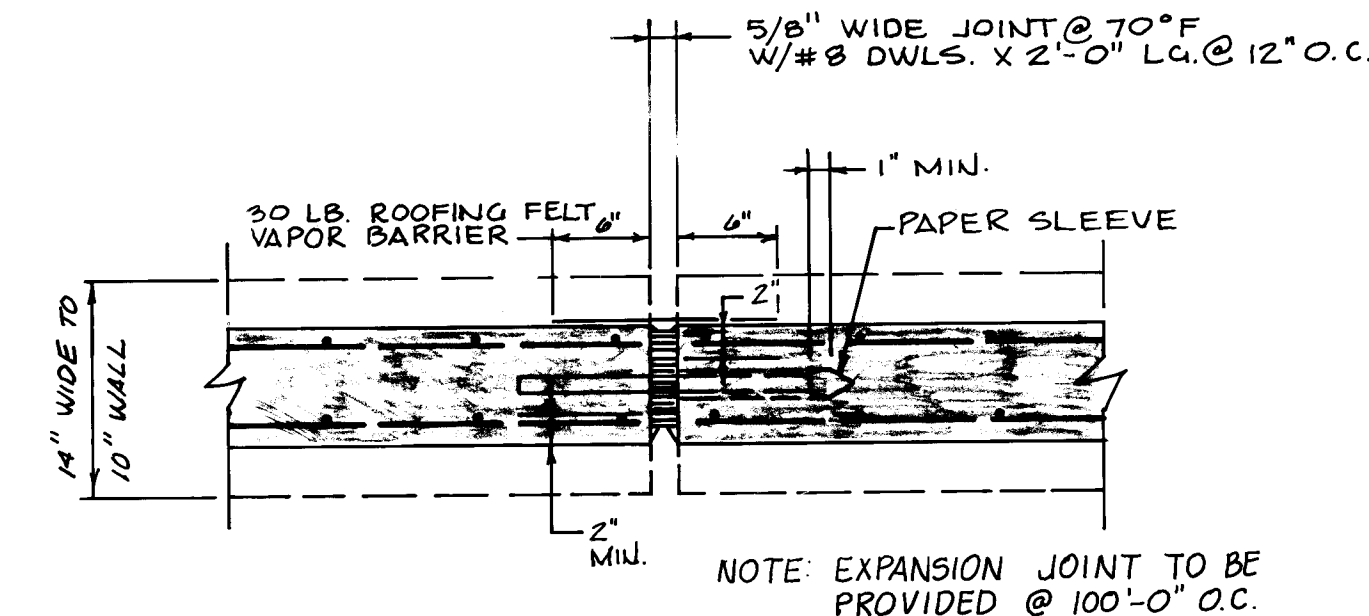


NO SCALE
RETAINING WALL EXPANSION JOINT.

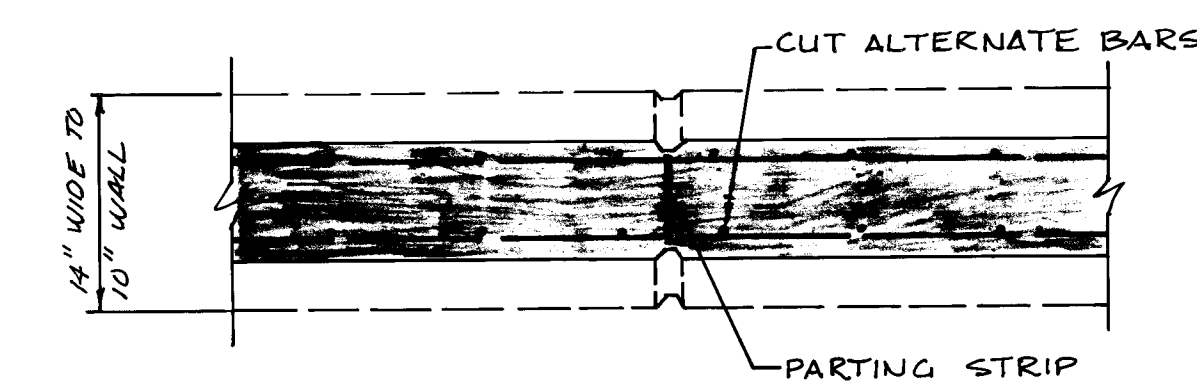

NO SCALE
NOTE: CONTROL JOINT TO BE PROVIDED @25'-0" O.C.
RETAINING WALL CONTROL JOINT

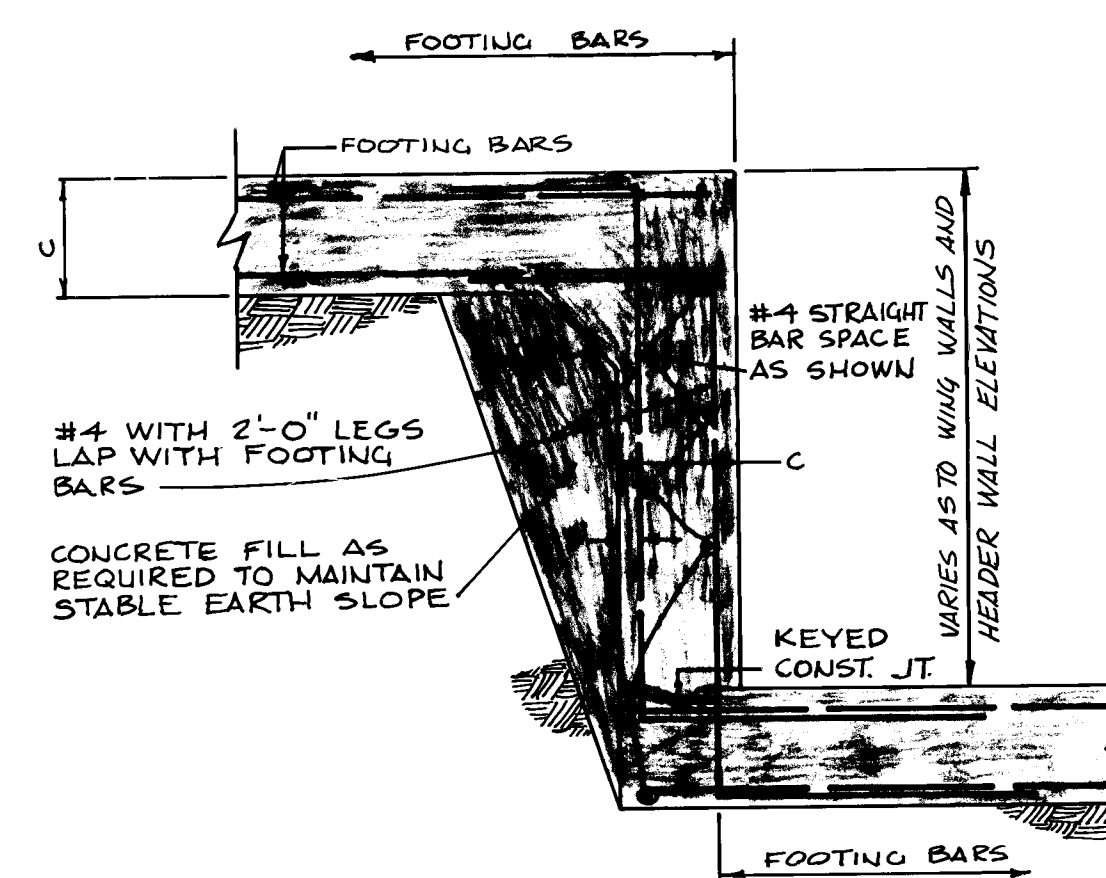

NO SCALE
TYPICAL STEP FOOTING

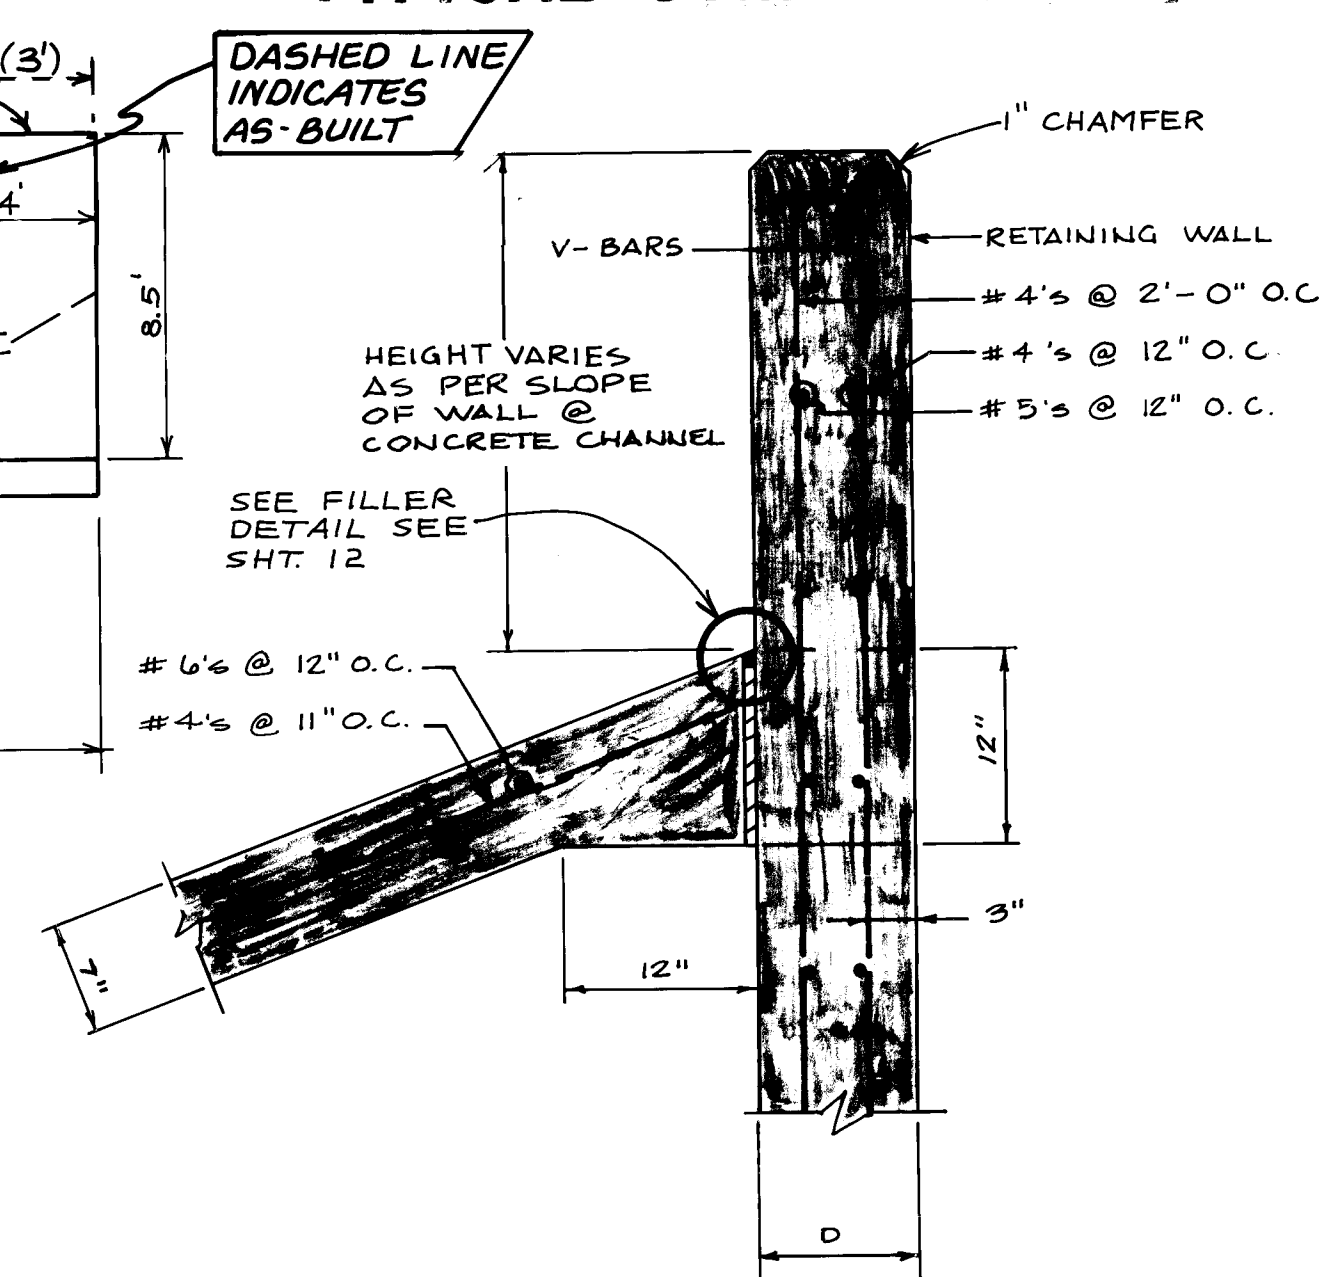

**TYP. EXPANSION JOINT DETAIL BETWEEN
CONCRETE CHANNEL AND WINGWALL**


ENGINEER'S SEAL		SURVEY INFORMATION		BENCH MARKS		AS BUILT INFORMATION	
		FIELD NOTES					
NO	DATE	REMARKS	BY	NO	DATE	WORK BY	DATE
						INSPECTED BY	DATE
						ACCEPTED BY	DATE
						VERIFICATION BY	DATE
						DRAWN BY	DATE
						CHECKED BY	DATE
						MICRO-FILM INFORMATION	
						RECORDED BY	DATE
						NO	

CITY OF ALBUQUERQUE
MUNICIPAL DEVELOPMENT DEPARTMENT
ENGINEERING DIVISION


TITLE: SANTA FE VILLAGE UNIT III PHASE I
WING WALL DETAILS

APPROVALS	ENGINEER	DATE	APPROVALS	ENGINEER	DATE
City Engineer	<i>[Signature]</i>	6/27/04	Liquid Waste	<i>[Signature]</i>	7/14/04
A C E - Design	" "	" "	Traffic	NA DWH	5/14/08
A C E - Hydrology	" "	" "	Water	<i>[Signature]</i>	4/14/08


A.M.A.F.C.A.		MAP NO.		SHEET OF	
DRAWING NO. 2794		F-10		10 15	

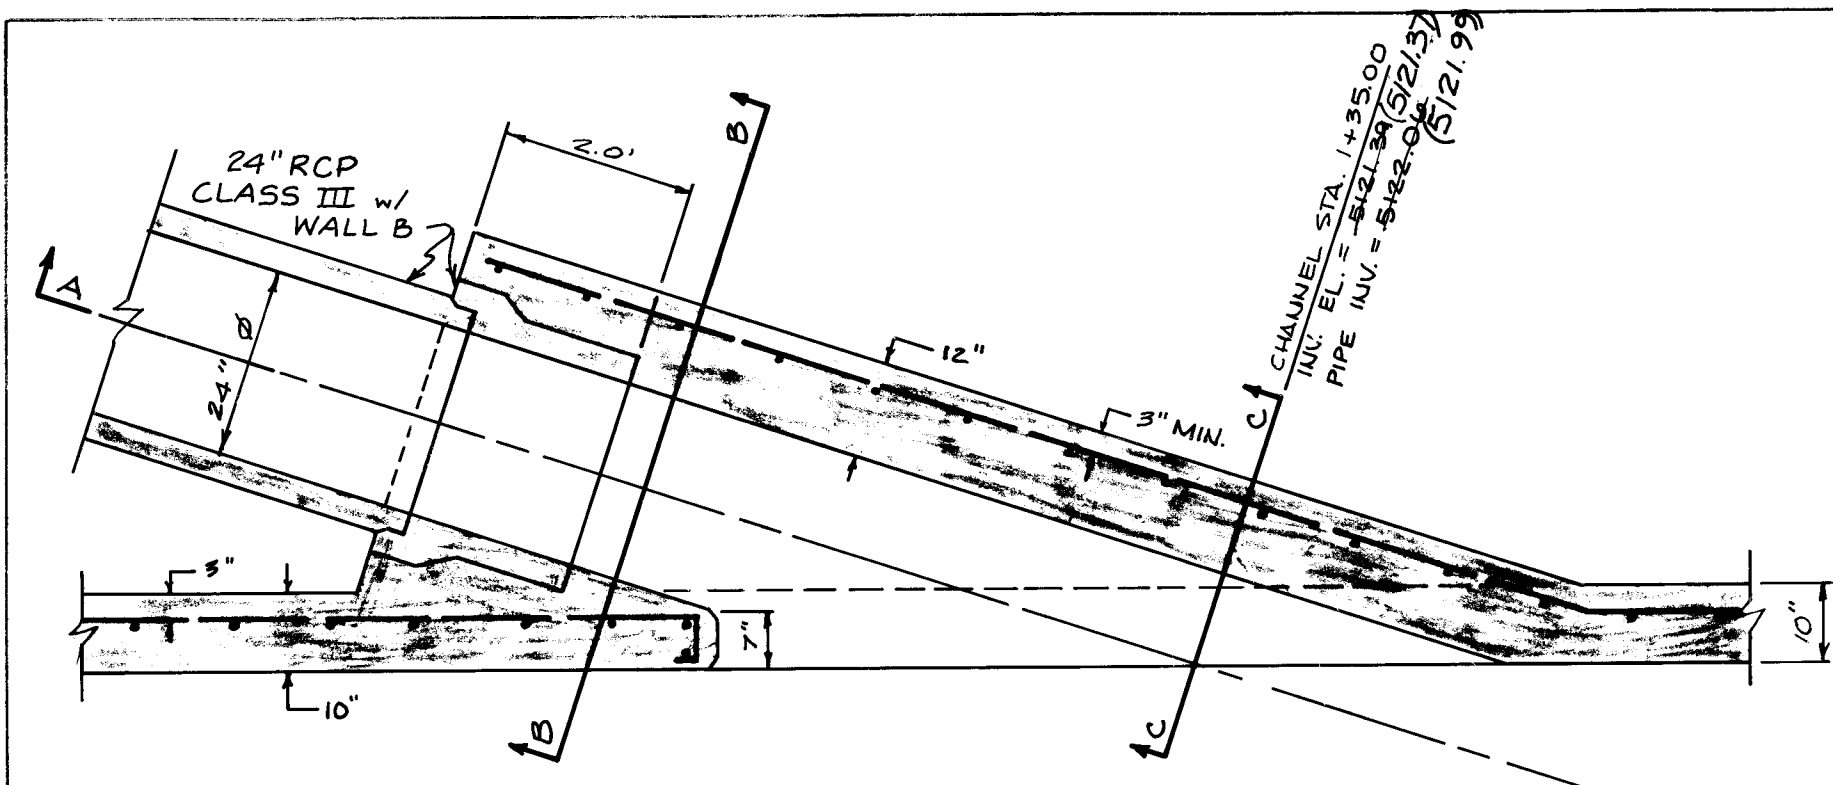


SCALE: 1" = 2'
PIPE PENETRATION PLAN SECTION

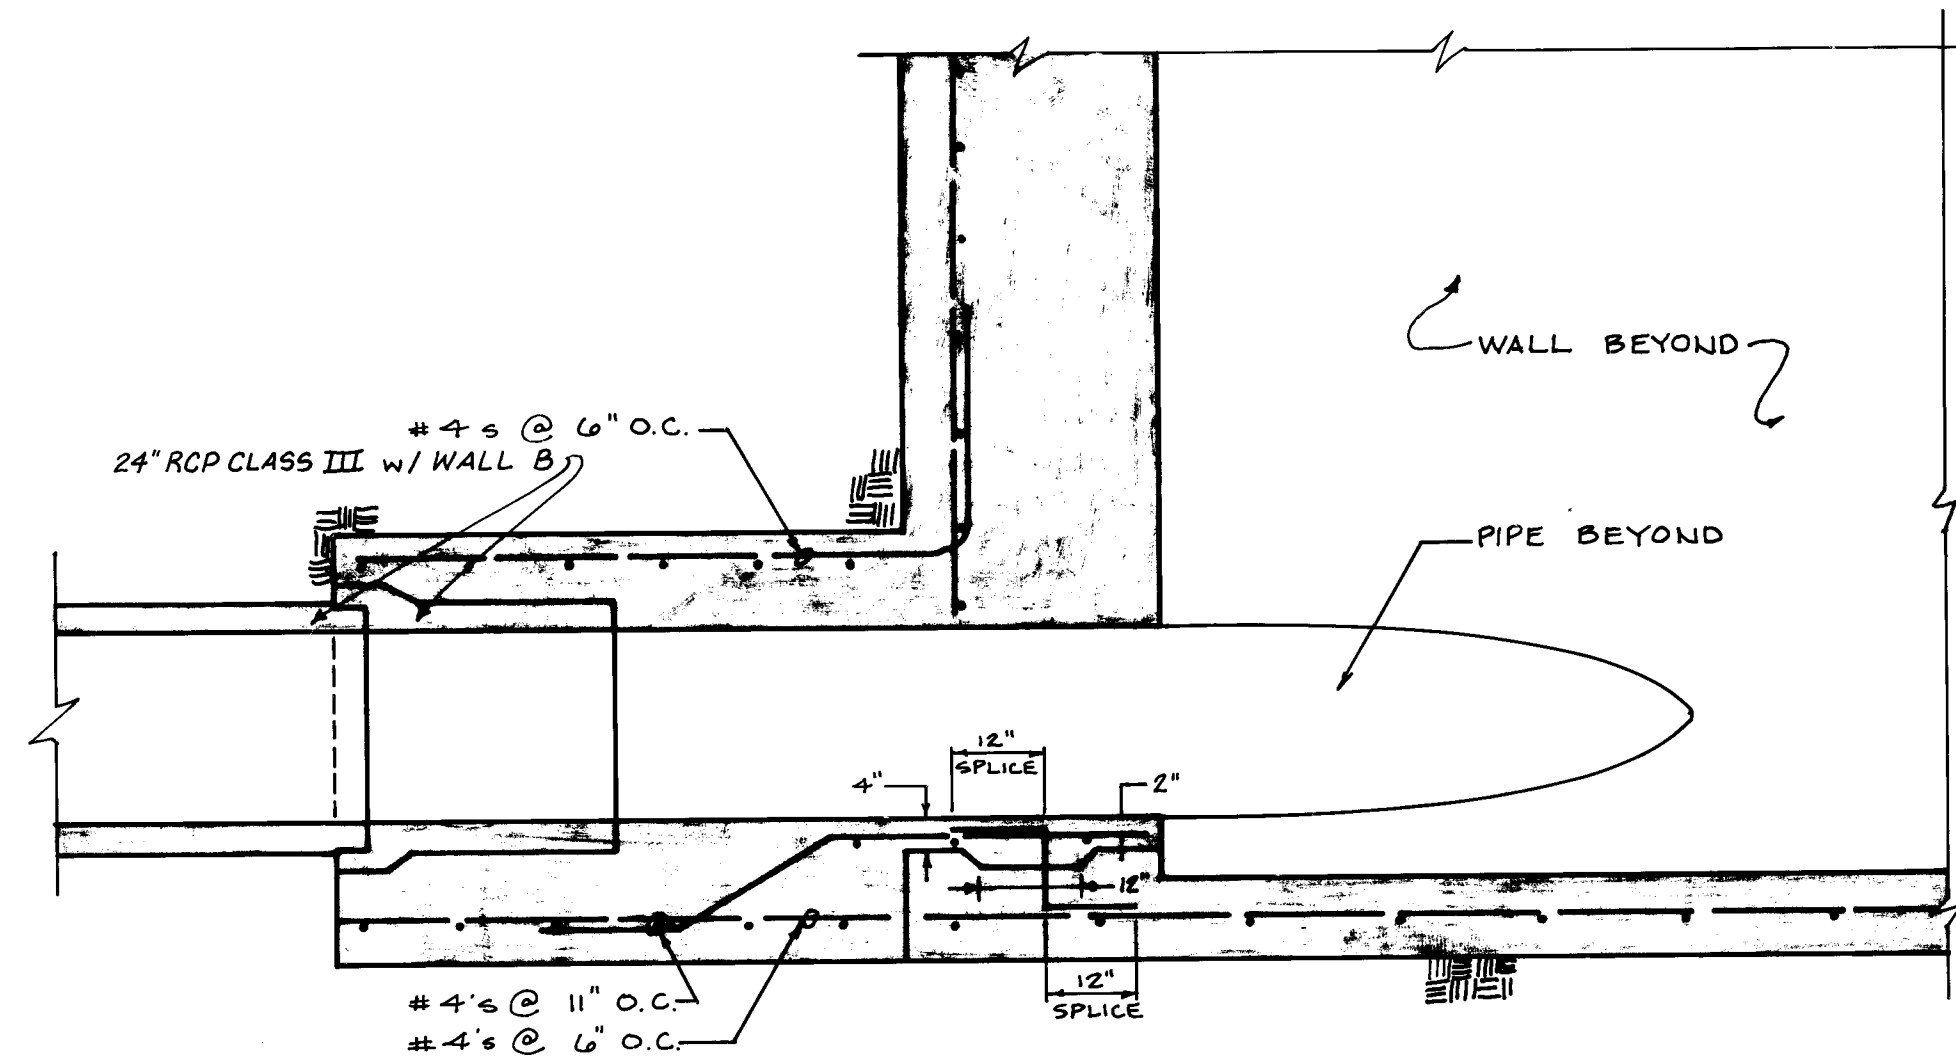


SCALE: 1" = 2'
SECTION A-A

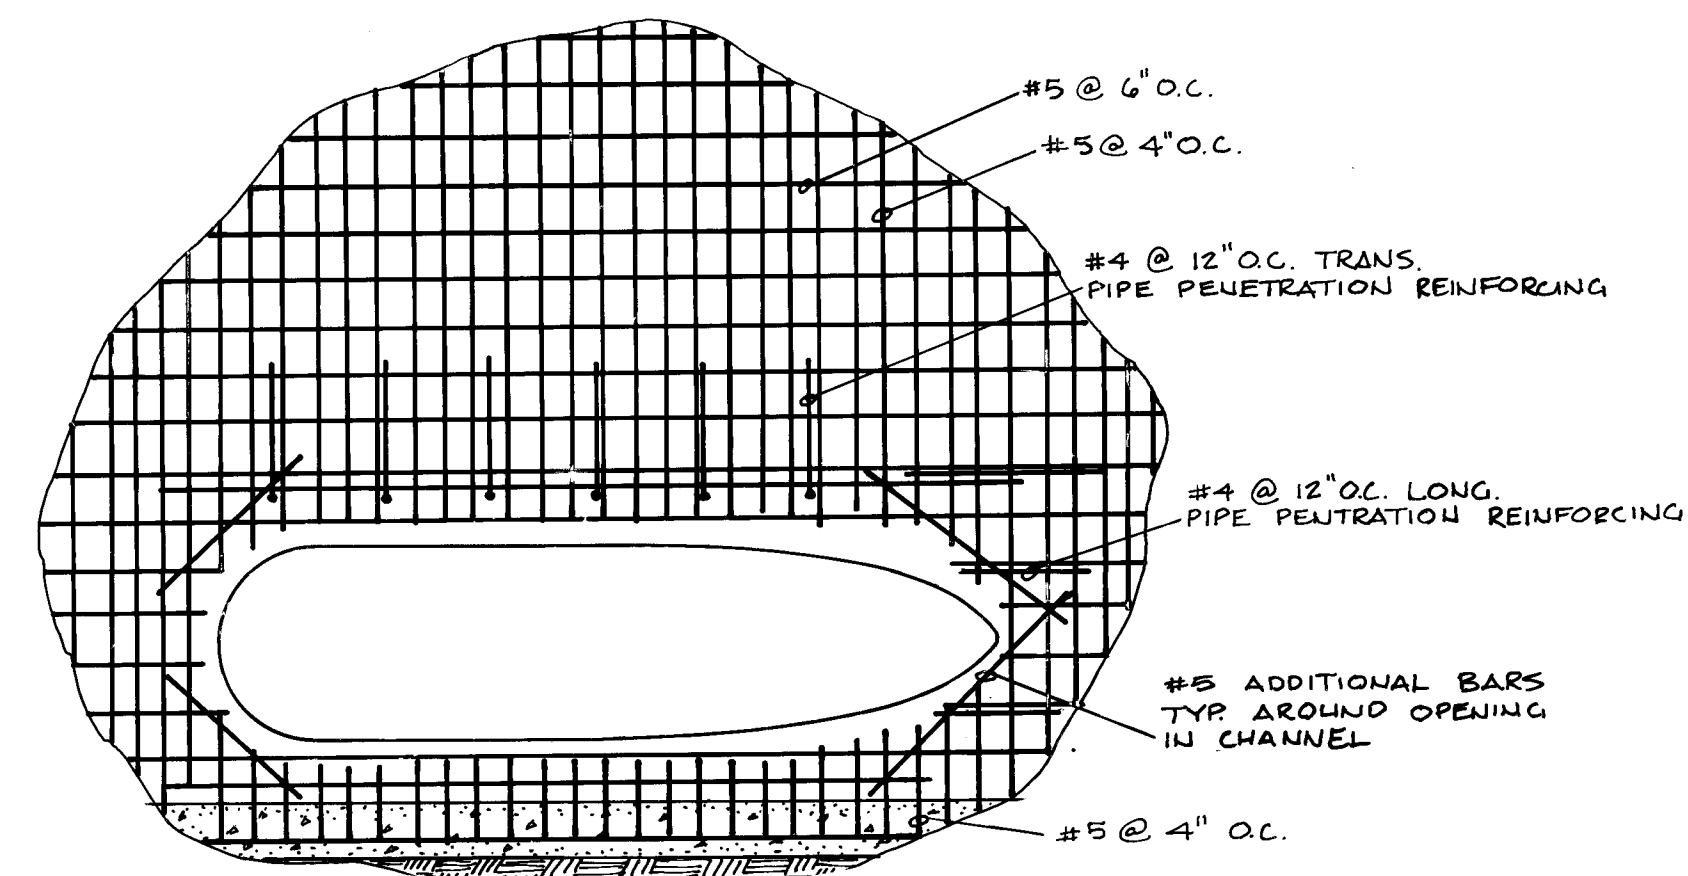


SCALE: 1" = 2'
PIPE PENETRATION REINFORCEMENT ELEVATION

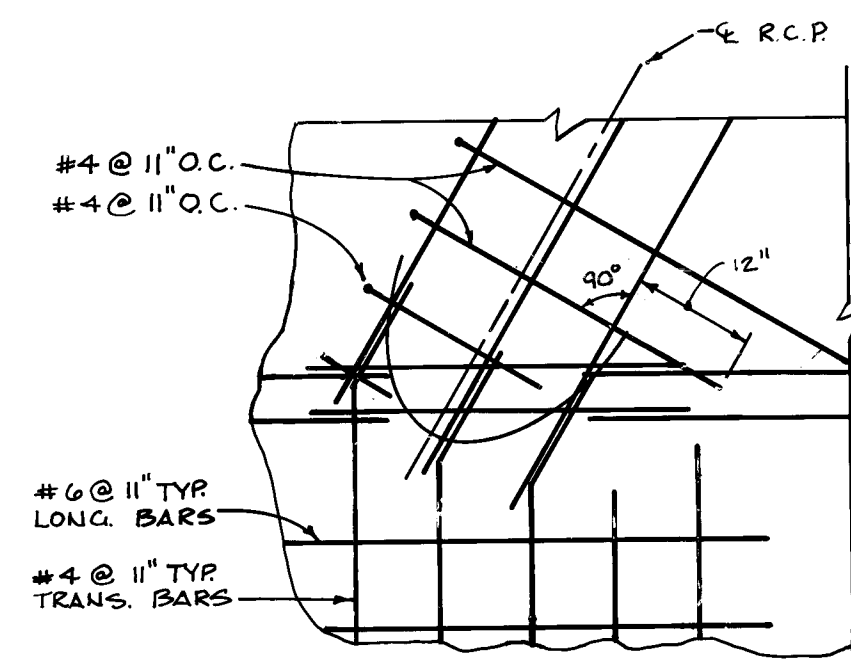


NO SCALE
SECTION I-I

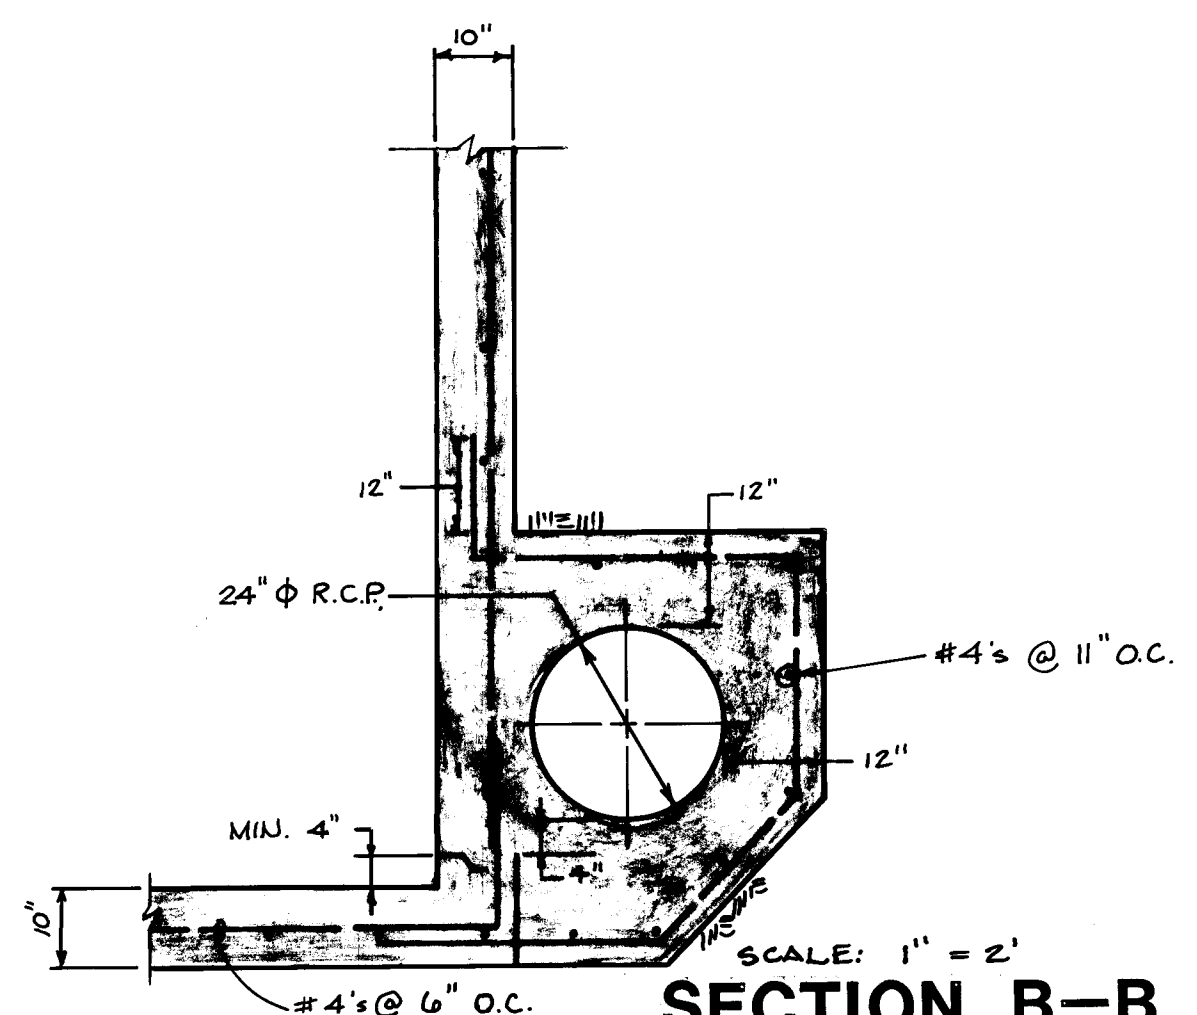


SCALE: 1" = 2'
SECTION B-B

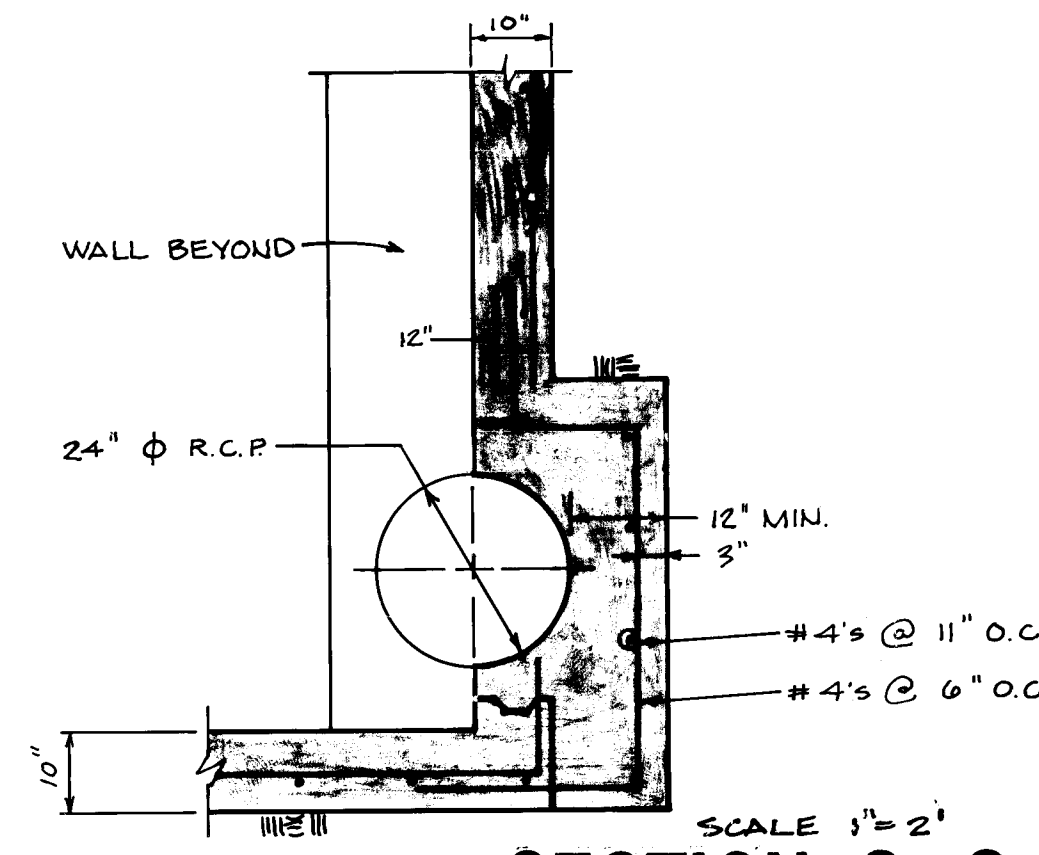


SCALE: 1" = 2'
SECTION C-C

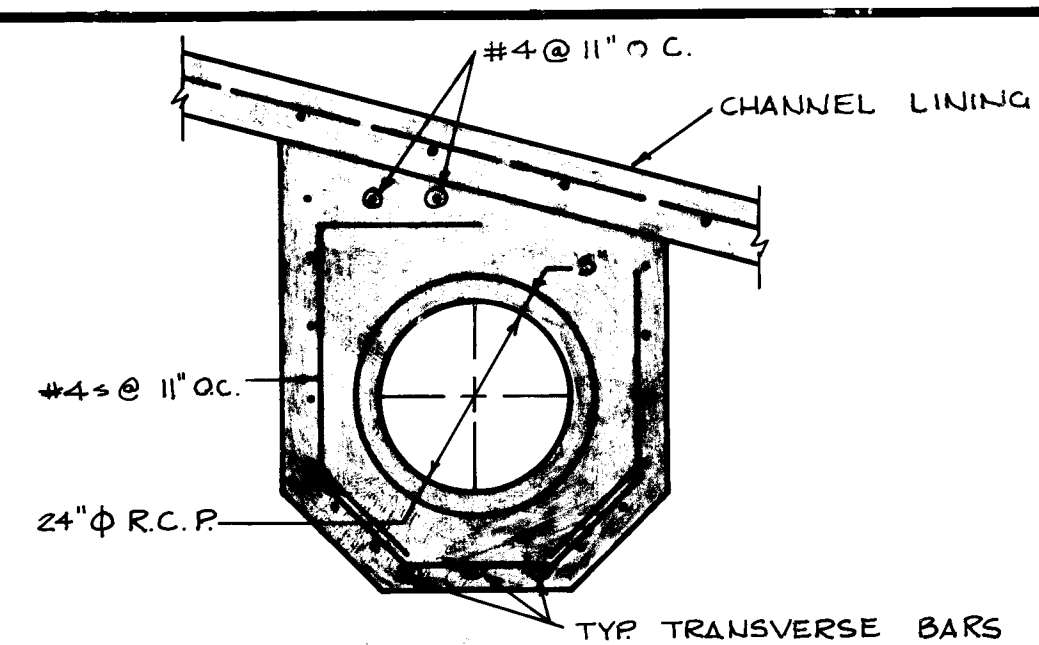


NO SCALE
SECTION F-F

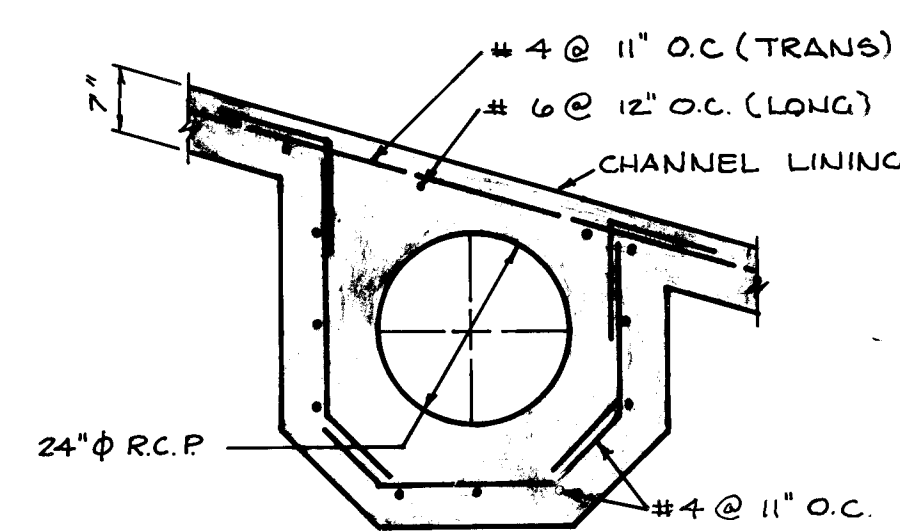


NO SCALE
SECTION G-G

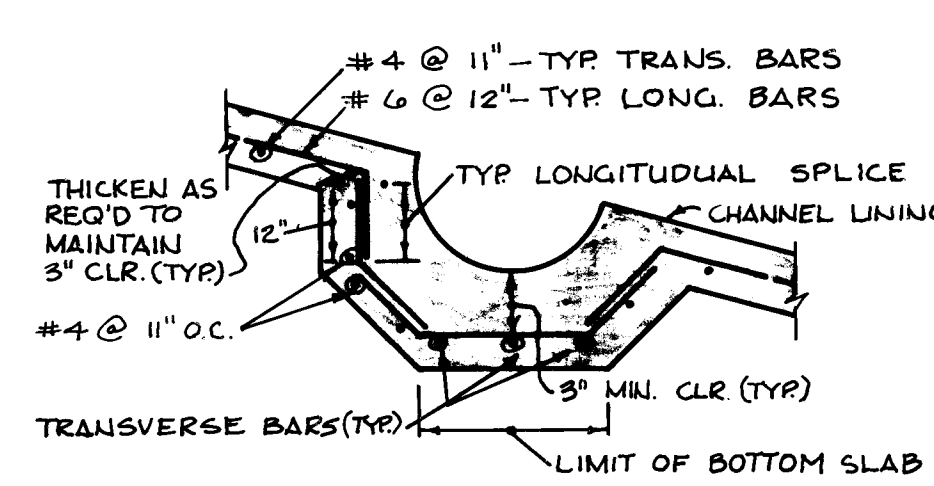


NO SCALE
SECTION H-H

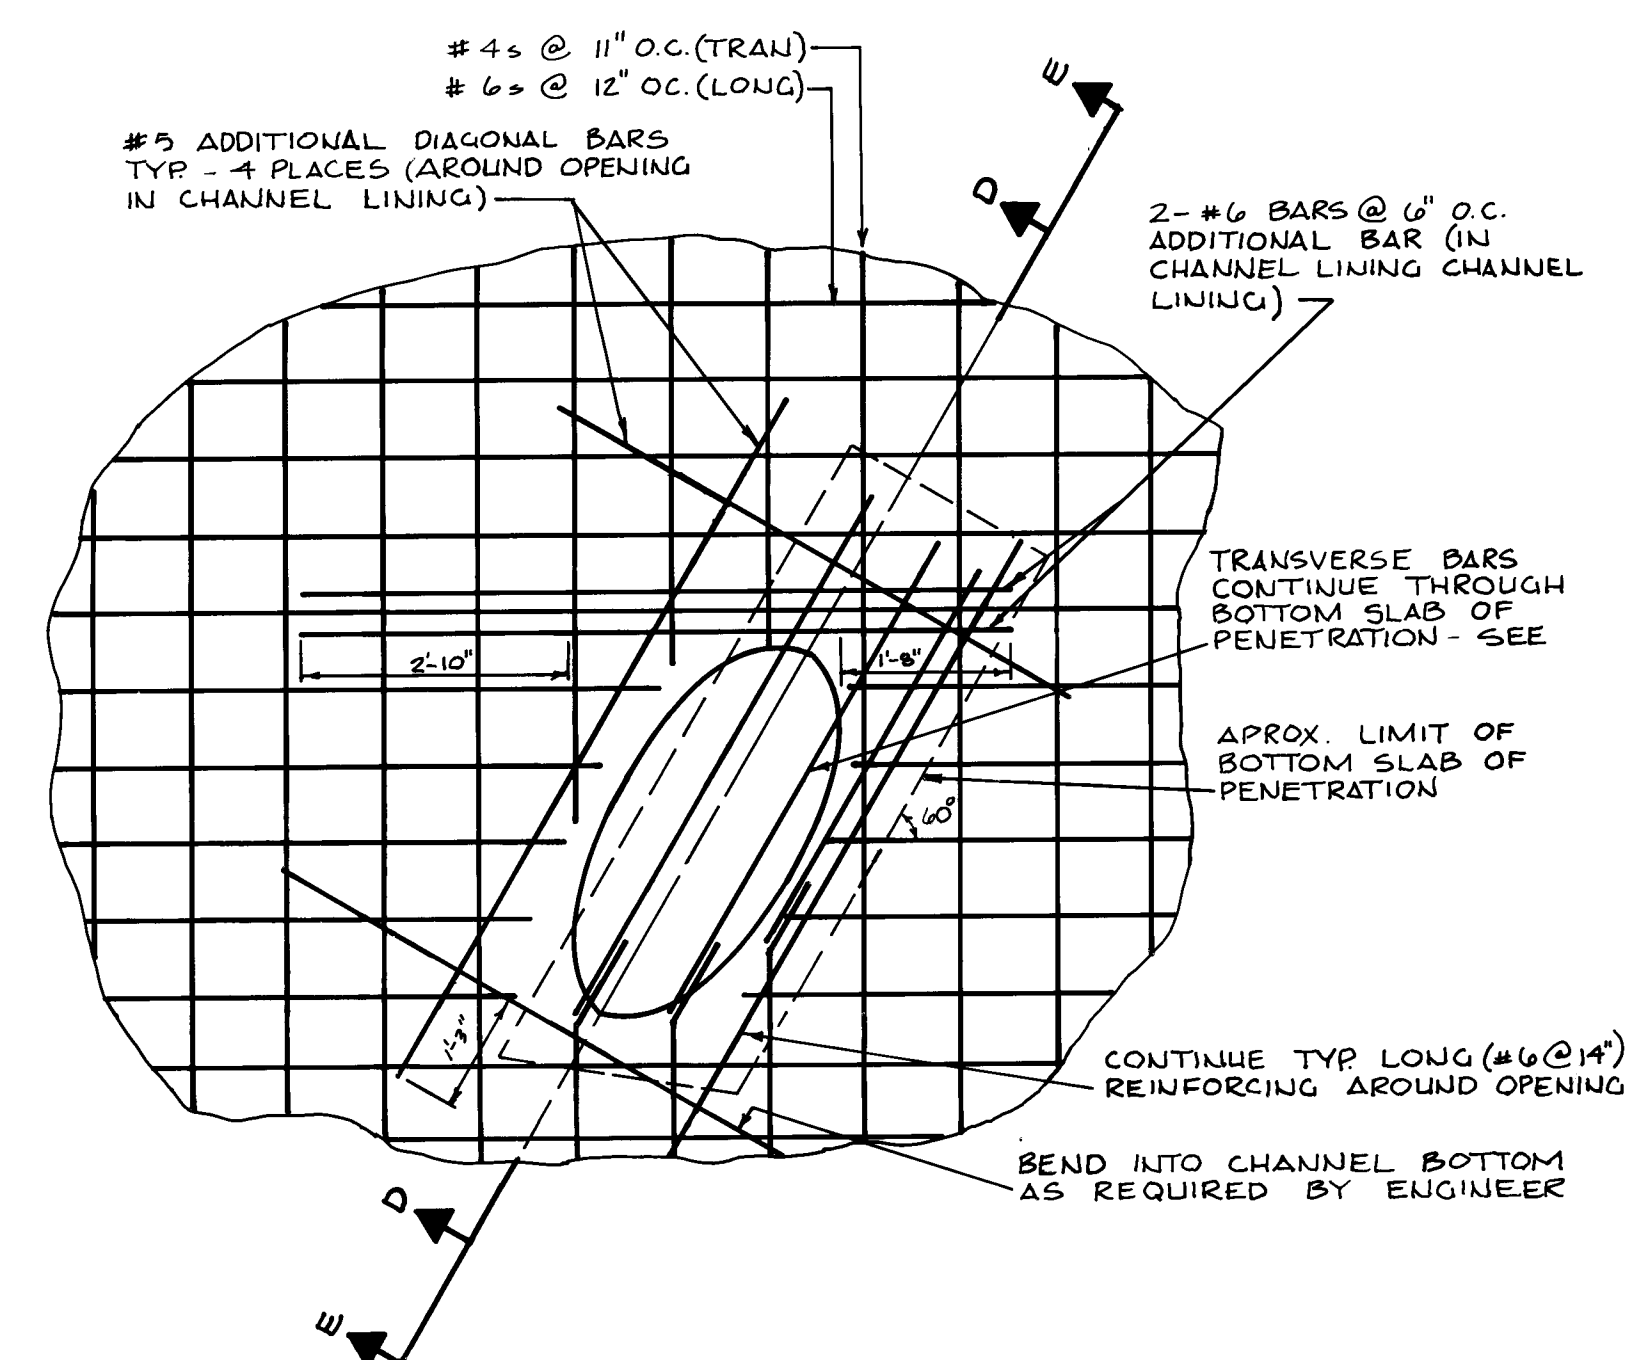

PIPE PENETRATION REINFORCEMENT PLAN






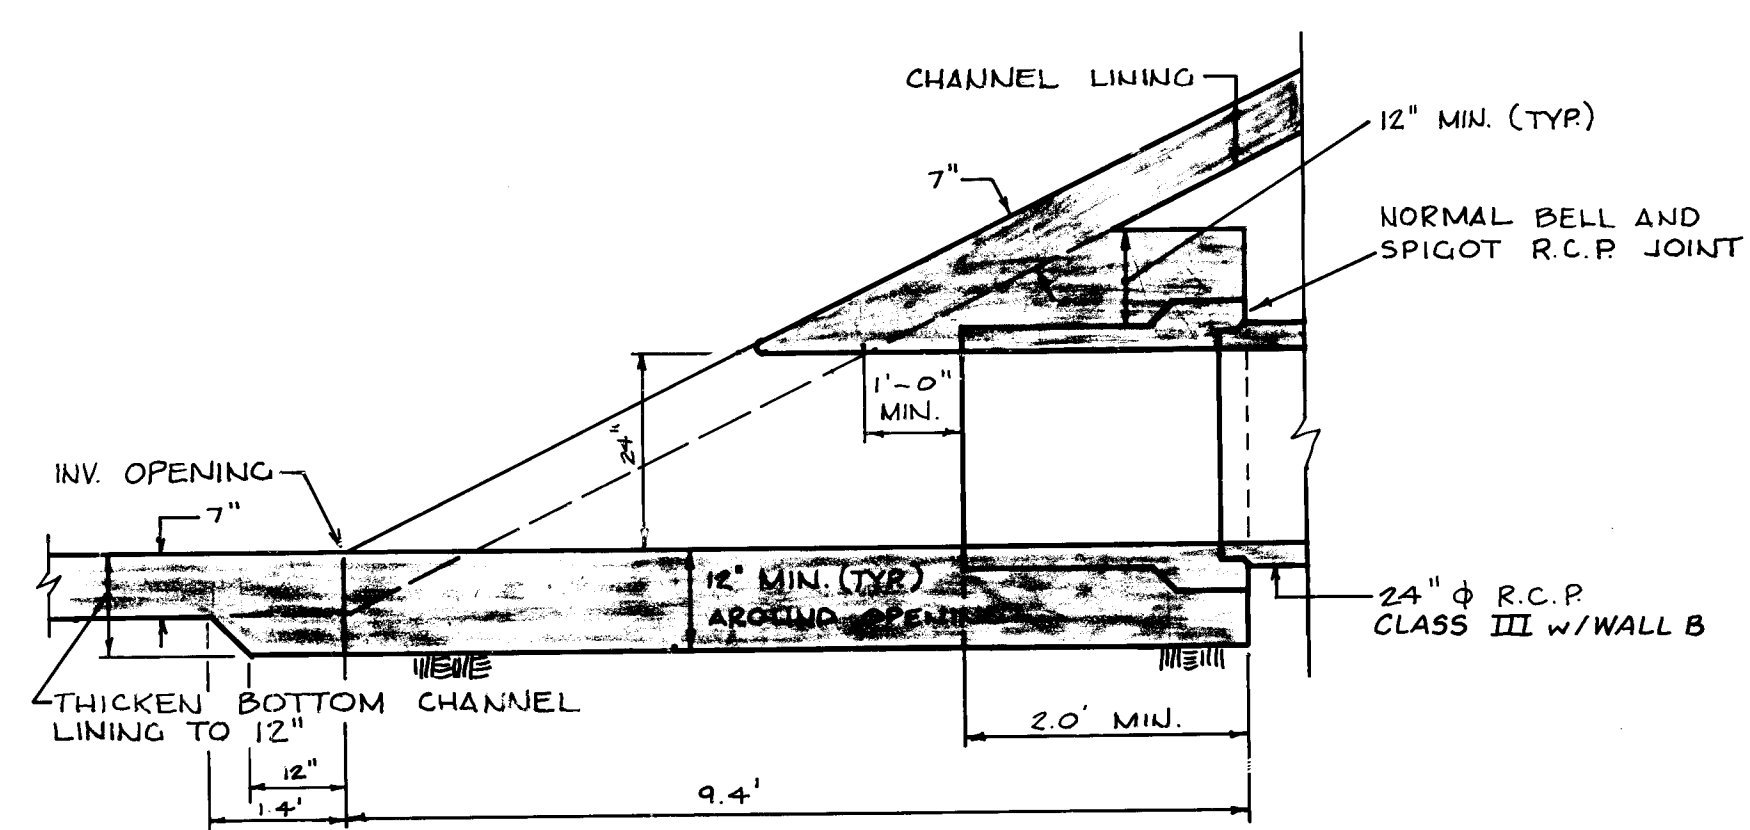


NO SCALE
SECTION D-D

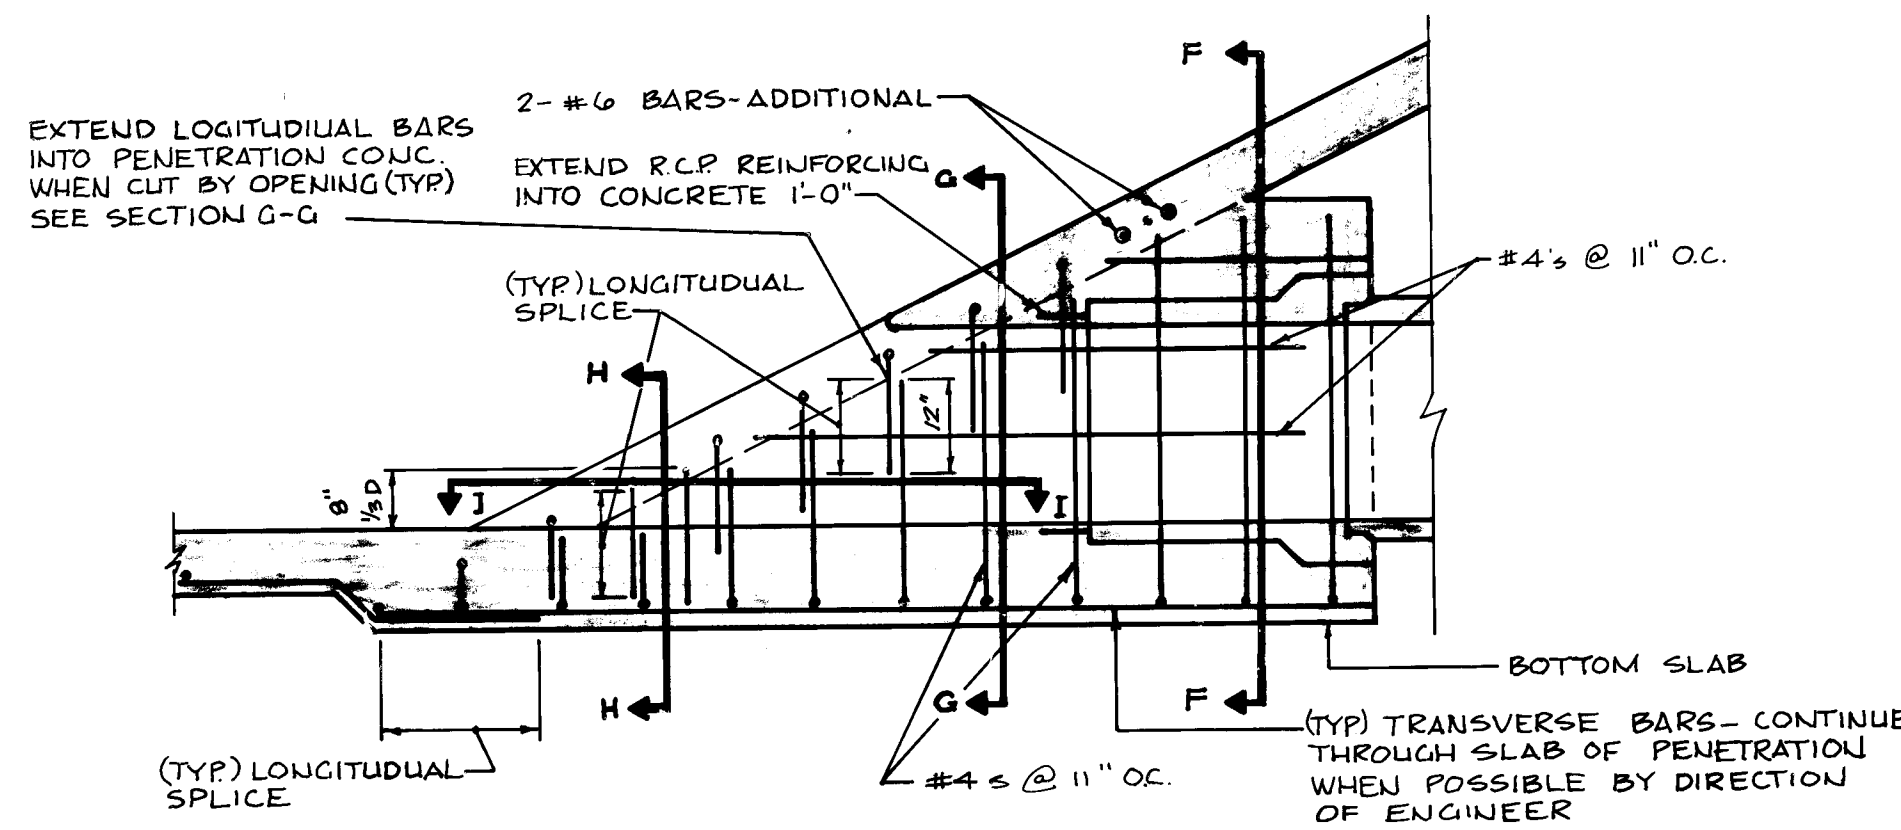

NO SCALE
SECTION E-E


AS BUILT INFORMATION		BENCH MARKS		SURVEY INFORMATION		ENGINEER'S SEAL		REVISIONS		CITY OF ALBUQUERQUE	
CONTRACT NO.	DATE	CONTRACT NO.	DATE	NO.	BY	NO.	DATE	NO.	DATE	MUNICIPAL DEVELOPMENT DEPARTMENT ENGINEERING DIVISION	
CONTROL: BENCH MARK 7-F-II, WHICH BEARS N 26° 09' 08" E, 758.55' FROM THE S.E. CORNER OF SANTA FE VILLAGE III, A 3/4" PIPE. BENCH MARK IS A STANDARD A.C.S. BRASS CAP STAMPED "7-F-II".		M.S.L. ELEVATION-5116.57'								TITLE: SANTA FE VILLAGE III PHASE I PIPE PENETRATION DETAILS	
APPROVALS	ENGINEER	DATE	APPROVALS	ENGINEER	DATE						
City Engineer		6/27/84	Liquid Waste		9/14/84						
A.C.E - Design			Traffic		5/14/86						
A.C.E - Hydrology			Water		9/14/86						
DRAWING NO. 2794		MAP NO. F-10		SHEET 11 OF 15							

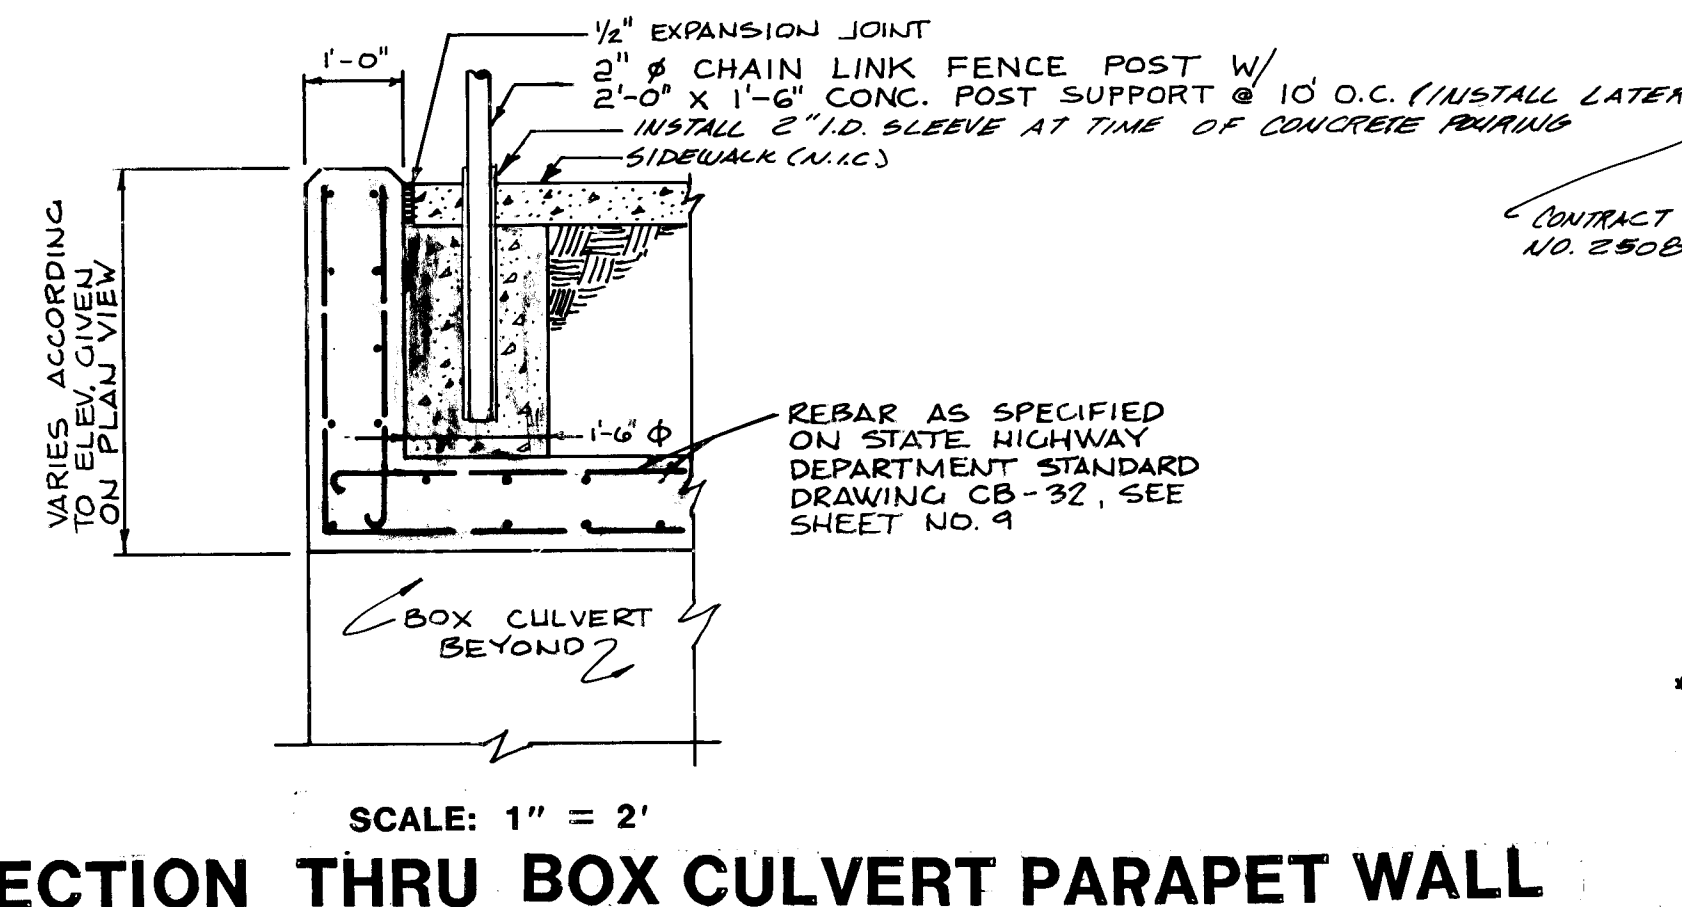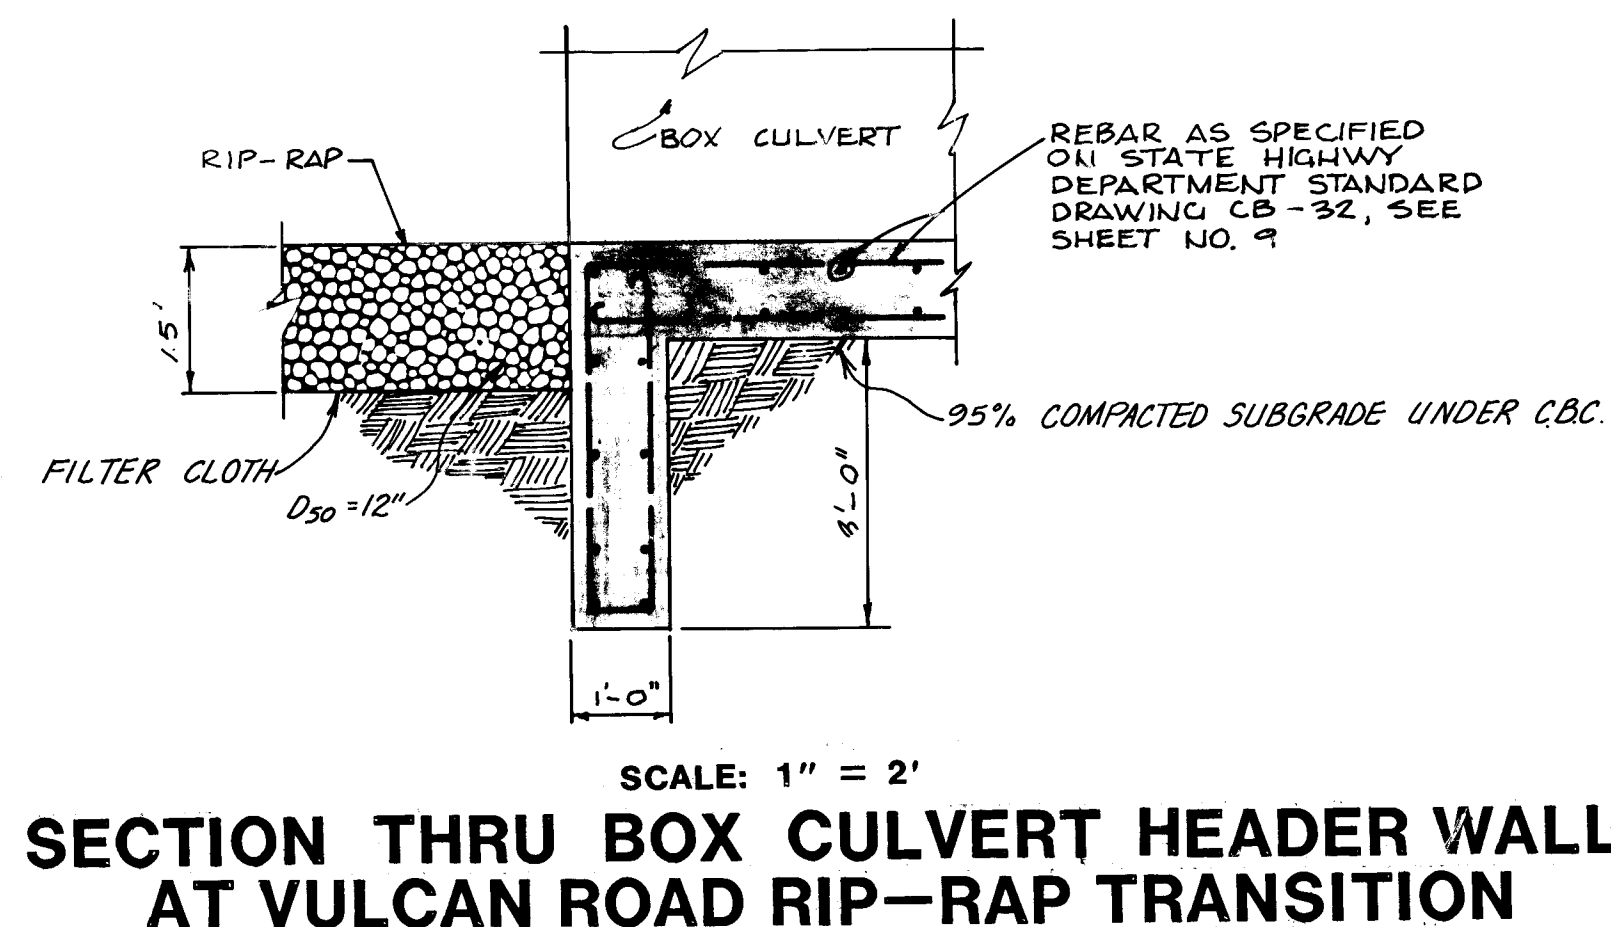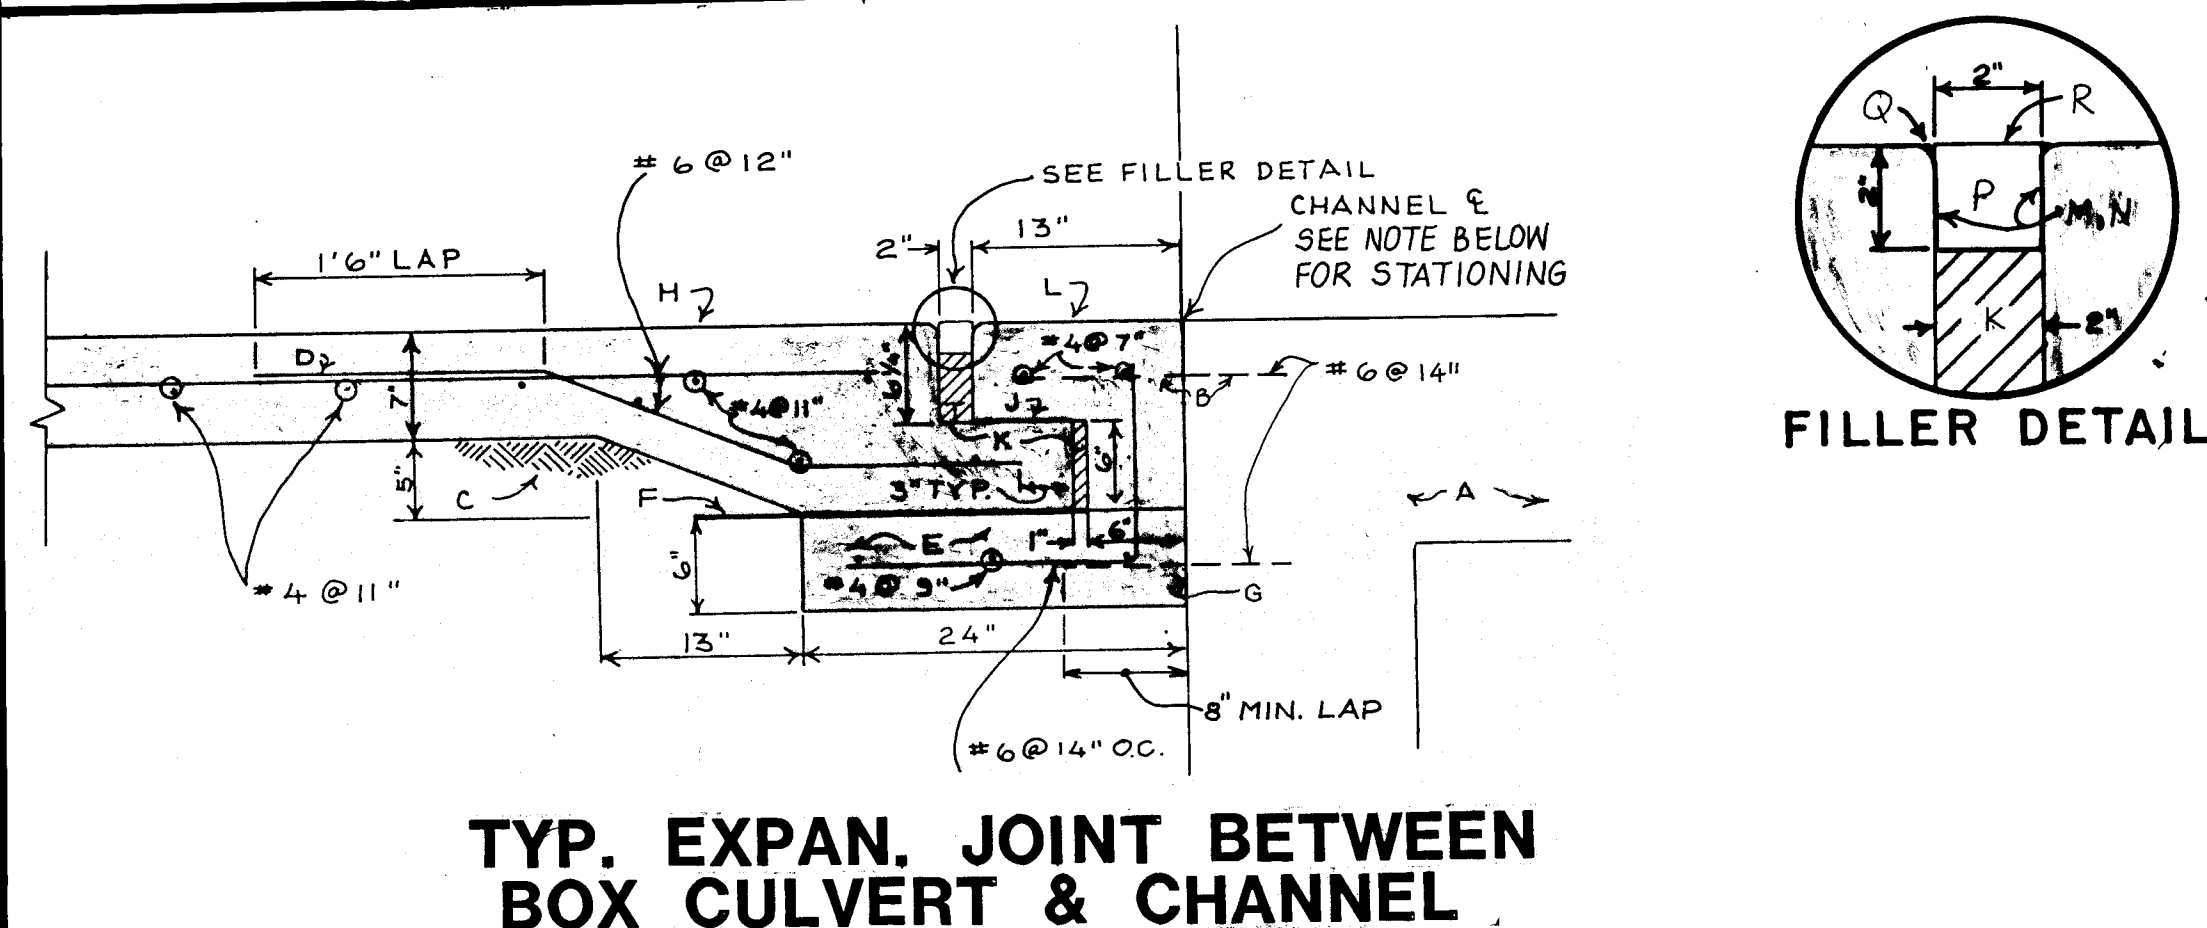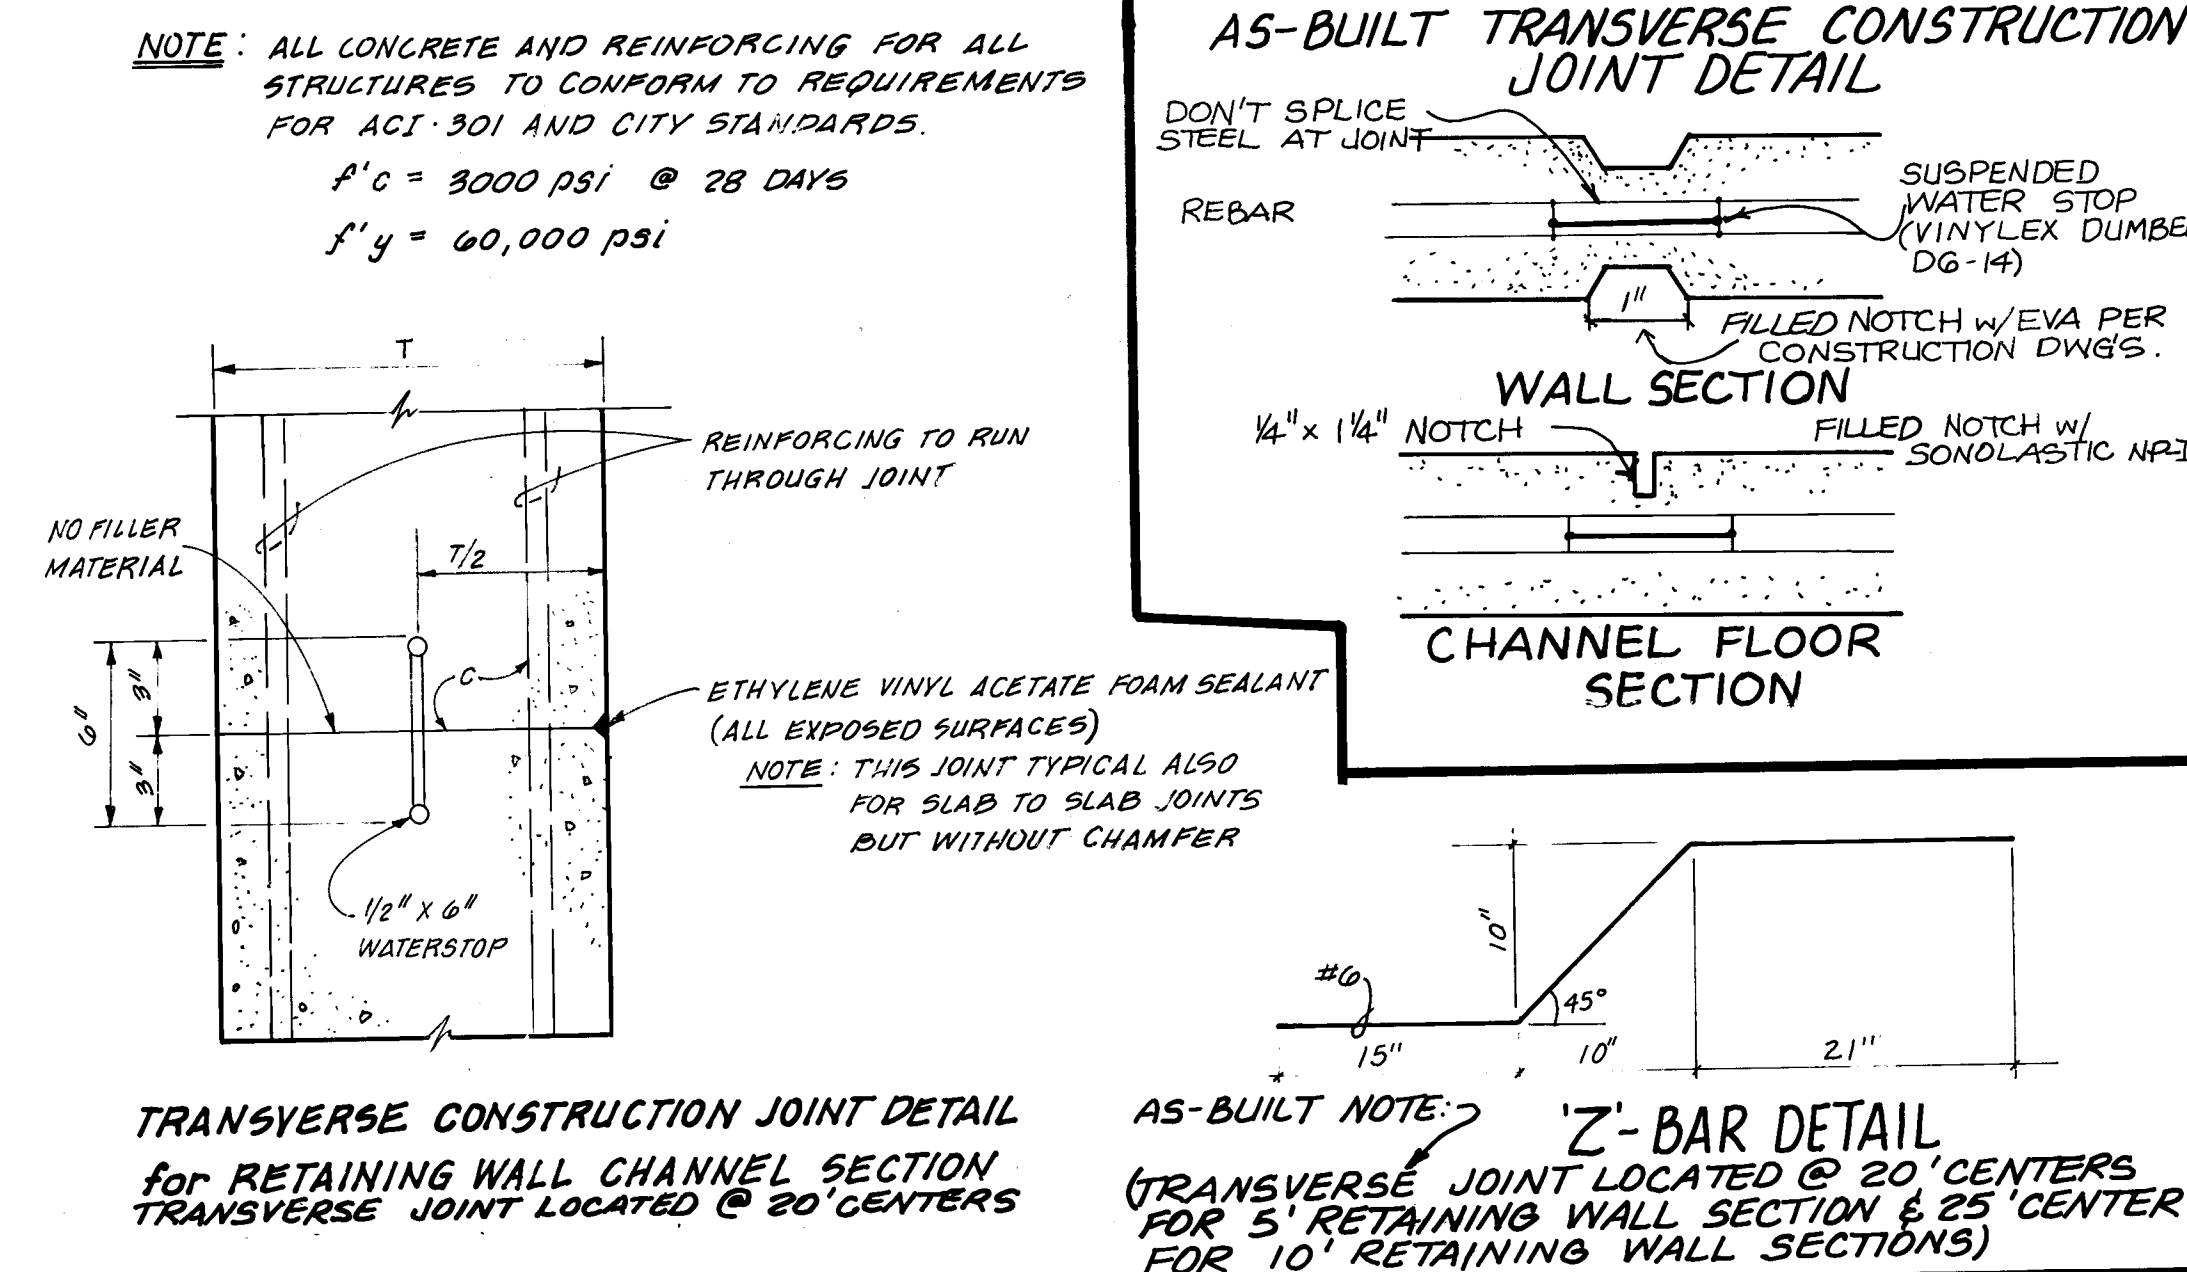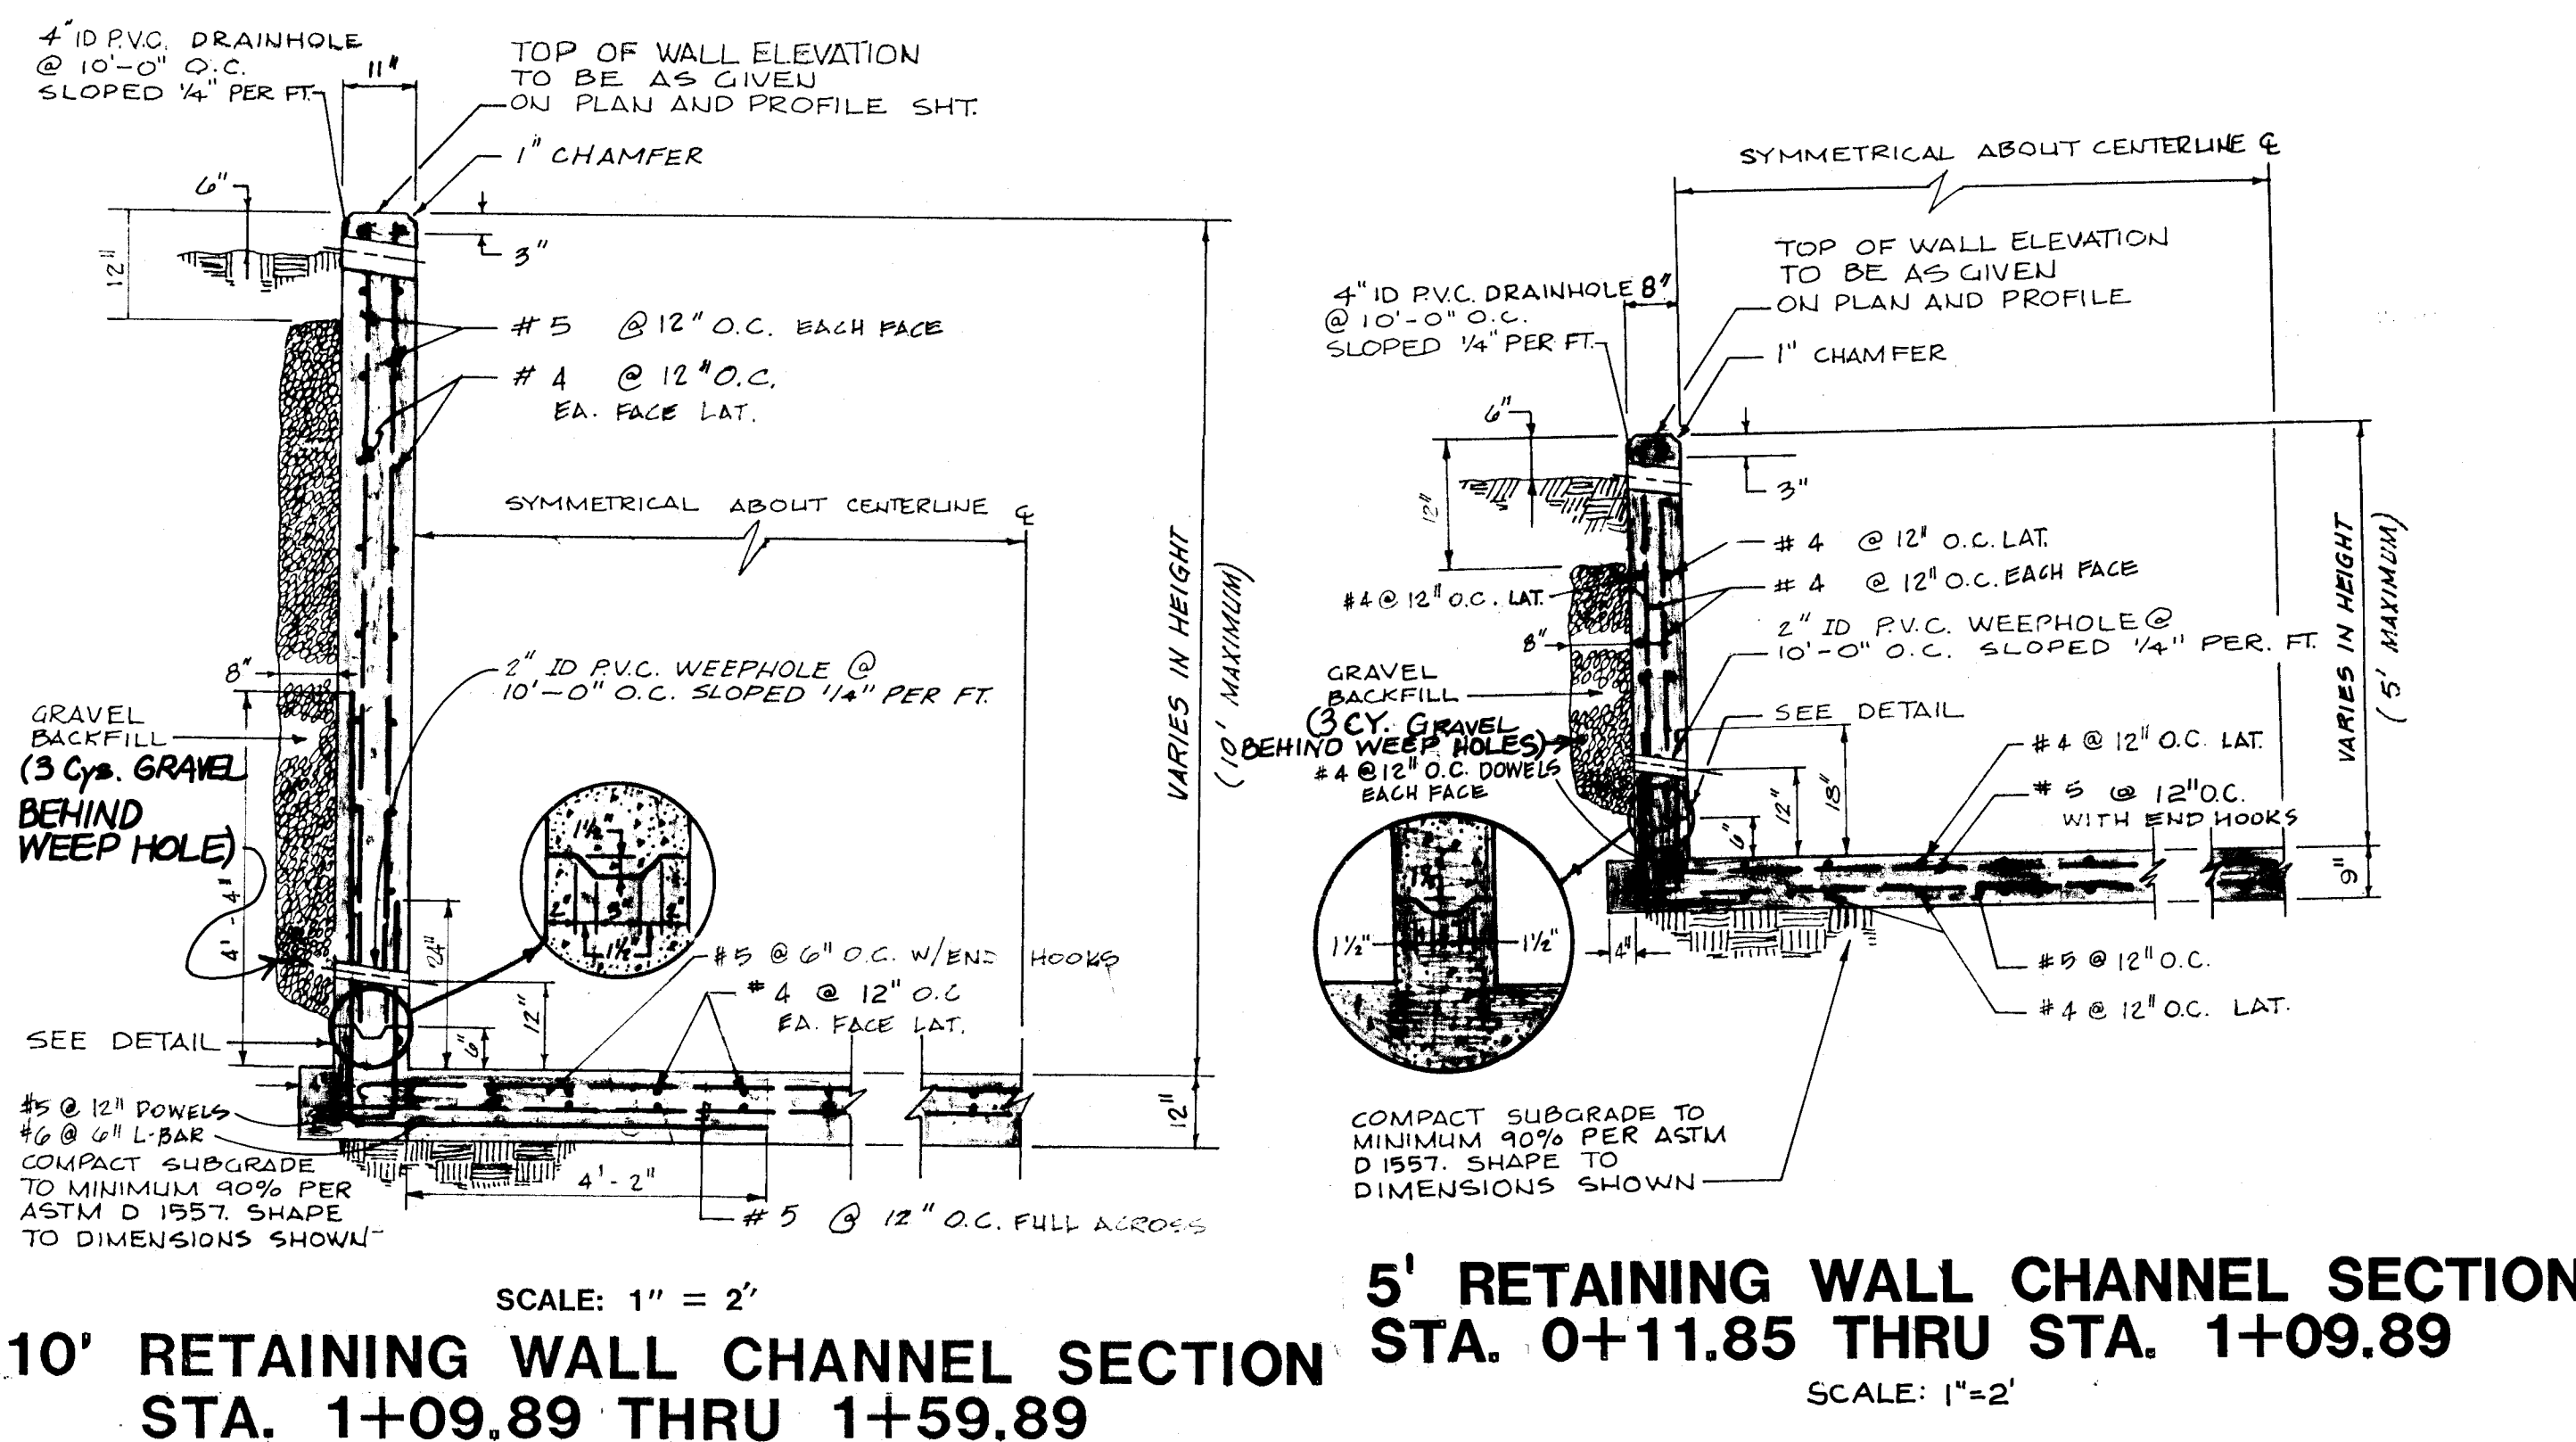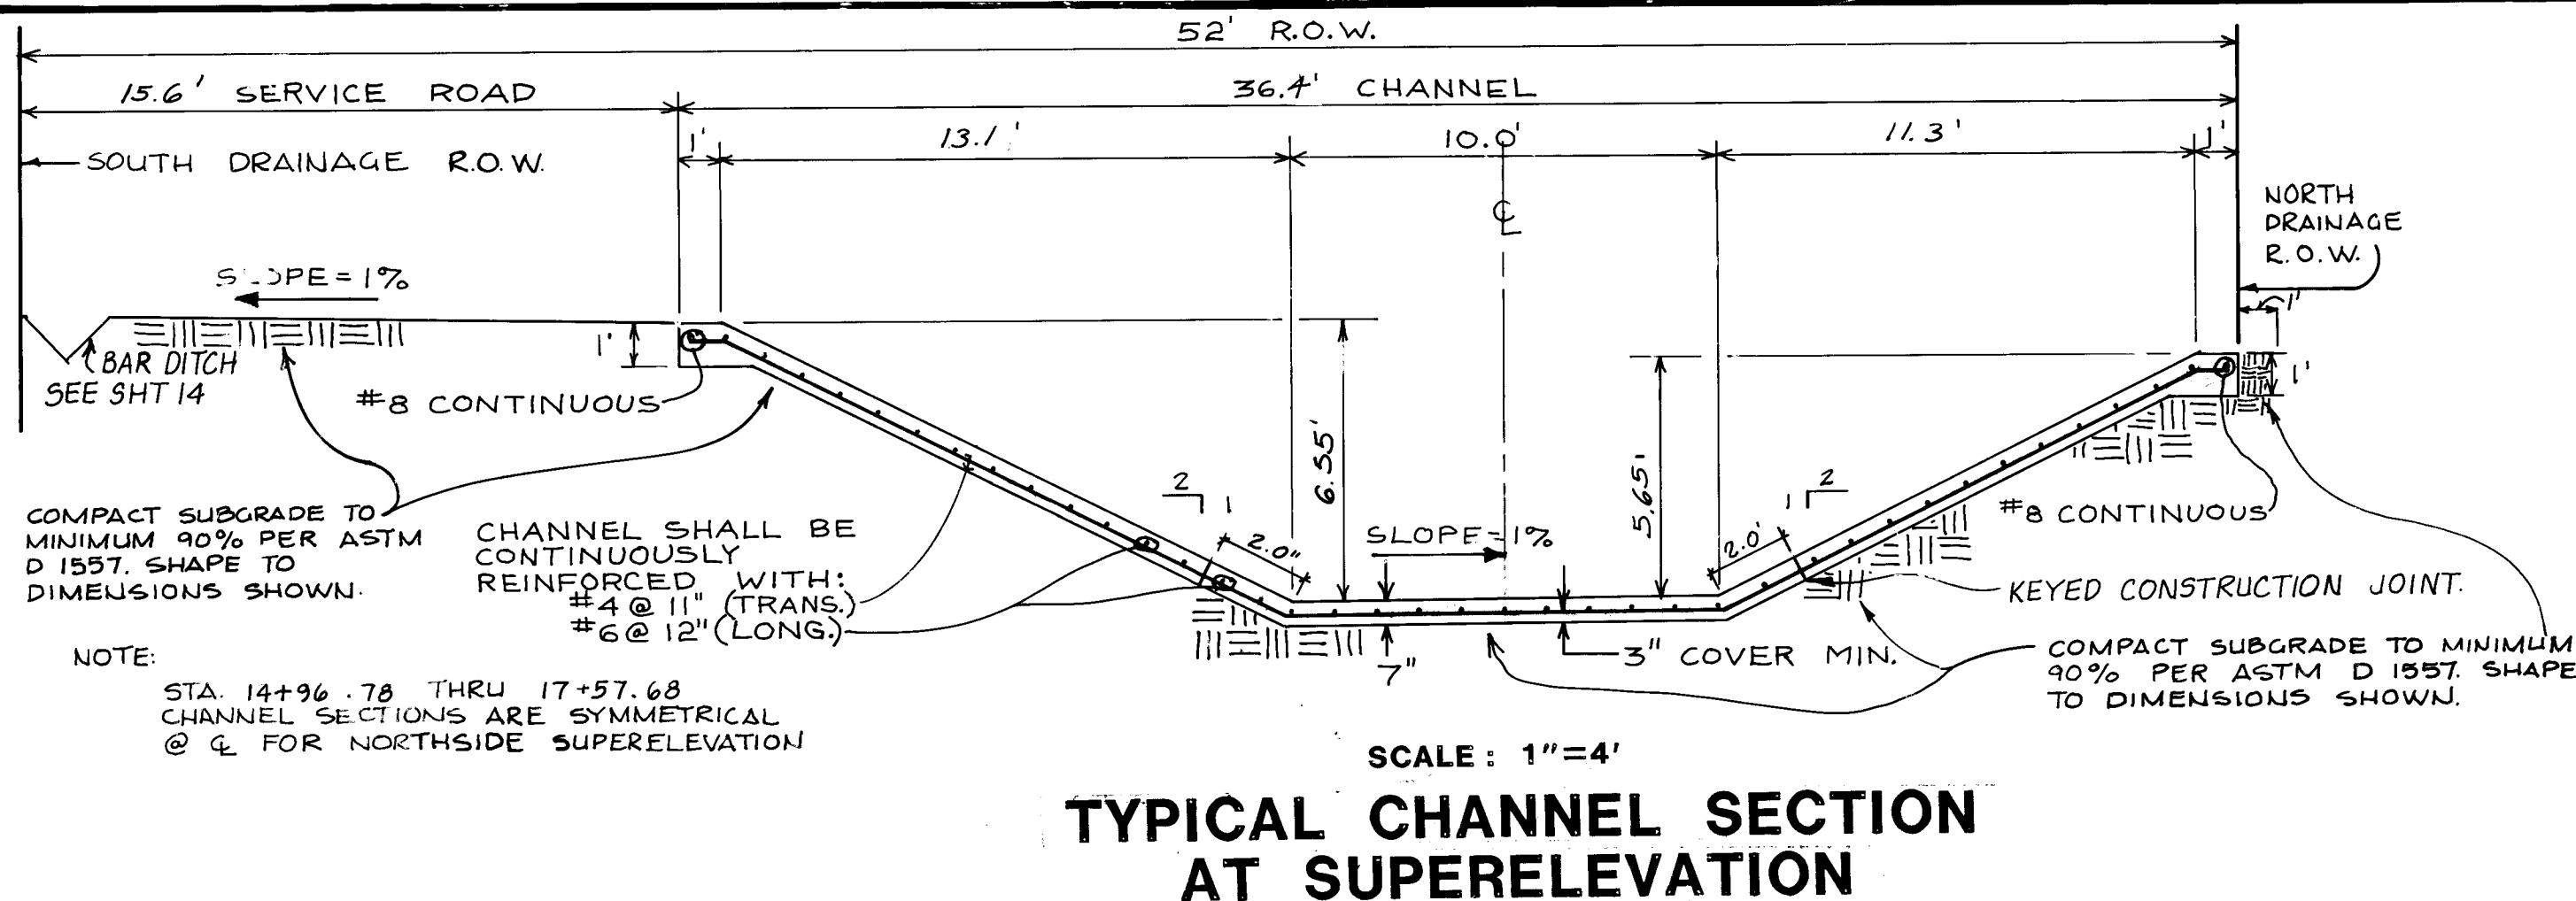


- GENERAL NOTES
1. STEP JOINT WITH SLEEPER SHALL BE USED IN ALL NEW AND REHABILITATION CONSTRUCTION AS SPECIFIED BY ENGINEER. JOINT MATERIALS SHALL BE INSTALLED ACCORDING TO MANUFACTURER'S RECOMMENDATIONS.
 2. AS SOON AS THE STEP JOINT IS COMPLETE, THE EXPOSED ENDS OF THE STEP JOINT SHALL BE COVERED WITH A PROTECTIVE SHEET OF 16 GA. GALVANIZED STEEL WITH 1/2" CRIMPED EDGES, ANCHORED AT TWO CORNERS ON ONE SIDE OF THE JOINT, FLUSH TO THE TOP OF THE JOINT, AND EXTENDING AT LEAST 3' PAST THE SEALANT, FILLERS, AND LOWER BEARING PLATE.
- CONSTRUCTION NOTES
- A. ~~EXISTING CONCRETE STRUCTURE TO REMAIN.~~
 - B. ~~EXISTING REINFORCING STEEL TO REMAIN.~~
 - C. COMPACT SUBGRADE TO MINIMUM 90% PER ASTM D 1557. SHAPE TO DIMENSIONS SHOWN.
 - D. STEEL AS SHOWN: ~~10" SPACING PARALLEL TO CHANNEL.~~ OTHER STEEL SIZE AND SPACING PER D.P.M. LONGITUDINAL CONC. AREA: GREATER THAN .0025 CONC. AREA; TRANSVERSE STEEL AREA GREATER THAN .0025 TIMES CONC. AREA. SPLICED AT 10' ON EACH END. SHEET SECURELY TIE ALL CONNECTIONS. SUPPORT SLEEPER MAT WITH PREFORMED CONCRETE CHAIRS. STEEL SHALL BE FREE OF FERRIC OXIDE (BLACK RUST SCALE).
 - E. FORM AND POUR FLY ASH CONCRETE SLEEPER, STEEL TROWEL BEARING SURFACE SIDE ONLY. RECOMPACT ADJACENT SOIL.
 - F. POLYETHYLENE BEARING PLATE, 1/4" X 2', LOW DENSITY, PLACED FLAT ON SAME GRADE AS CHANNEL. CARE SHALL BE TAKEN NOT TO LOCK EDGE OF PLATE WITH CONCRETE FILLER HOLES OR FLASHING. COMPACT SOIL TO TOP PLANE OF PLATE.
 - G. SANDBLAST EDGE OF ~~EXISTING~~ CONCRETE STRUCTURE AND APPLY CEMENTITIOUS GROUT, JUST PRIOR TO PLACING NEW CONCRETE.
 - H. FORM AND POUR DOWNSTREAM CONCRETE STRUCTURE AS SHOWN. FLY ASH CONCRETE WITH ALUMINUM FLOAT AND DRY BROOM FINISH. STEEL TROWEL BEARING PLATE SURFACE ONLY. BEARING PLATE SURFACE MUST BE PARALLEL TO BEARING PLATE SURFACE ON SLEEPER. FORMS TO REMAIN IN PLACE UNTIL NEXT DAY FOLLOWING POUR.
 - J. PLACE 1/4" X 6" LOW DENSITY POLYETHYLENE BEARING PLATE AS SHOWN BETWEEN THE TWO FILLER SECTIONS.
 - K. PLACE POLYETHYLENE FOAM FILLERS AS SHOWN, PLASTAZOTE OR APPROVED EQUAL. DO NOT ANCHOR WITH NAILS OR BONDING AGENTS. KEEP FILLERS FLOWING. CONCRETE DO WHEN POURING UPSTREAM SECTION. DO NOT ALLOW FRESH CONCRETE BETWEEN PLASTAZOTE AND POURED CONCRETE SECTION.
 - L. POUR UPSTREAM SECTION WITH FLY ASH CONCRETE. INVERTICE, SIDET OF FORM USED TO BLOCK OUT SPACE OR SEALANT SHALL BE SMOOTH. CLEAN MATERIAL TO AVOID NOSING CONTAMINATION AND FOR EASY REMOVAL. CONCRETE SHALL BE CURED TO MINIMUM 80% OF DESIGN STRENGTH BEFORE INSTALLING SEALANT.
 - M. PREPARE VERTICAL NOSING FOR BONDER BY SANDBLASTING. BLOW ALL SAND OUT OF THE JOINT BEFORE APPLYING BONDER.
 - N. APPLY 2 COMPONENT EPOXY EVA-POX, FRESH CONCRETE BONDER, OR APPROVED EQUAL TO VERTICAL CONCRETE FACES AND VERTICAL SEALANT FACES.
 - P. IMMEDIATELY INSTALL ETHYLENE VINYL ACETATE FOAM SEALANT, EVA-SEAL OR APPROVED EQUAL. FLOWING. COMPRESSION OF FOAM SEALANT BEFORE INSTALLATION SHALL BE AS SHOWN. FOAM SEALANT MUST BE COMPRESSED INTO JOINT. IMMEDIATELY REMOVE ALL BONDER FROM TOP SURFACE OF SEALANT.
 - Q. BONDER BEAD IN GROOVE BETWEEN TOOL-ED RADIUS AND SEALANT IS TO REMAIN.
 - R. SAND SURFACE OF SEALANT FLUSH TO TOP OF CONCRETE. APPLY ULTRA VIOLET PROTECTANT: 2 COATS, FLEXCOAT 19 OR APPROVED EQUAL.

[illegible]


CITY OF ALBUQUERQUE MUNICIPAL DEVELOPMENT DEPARTMENT ENGINEERING DIVISION					
TITLE: SANTA FE VILLAGE UNIT III PHASE I CHANNEL DETAILS					
APPROVALS	ENGINEER	DATE	APPROVALS	ENGINEER	DATE
City Engineer	<i>[Signature]</i>	6/29/80	Liquid Waste	<i>[Signature]</i>	5/14/80
A.C.E. - Design	" "	"	Traffic	MA Dwy H	5/14/80
A.C.E. - Hydrology	" "	"	Water	<i>[Signature]</i>	5/14/80
A.M.A.F.C.A.					
DRAWING NO.		MAP NO.		SHEET OF	
2794		E-10		12 15	

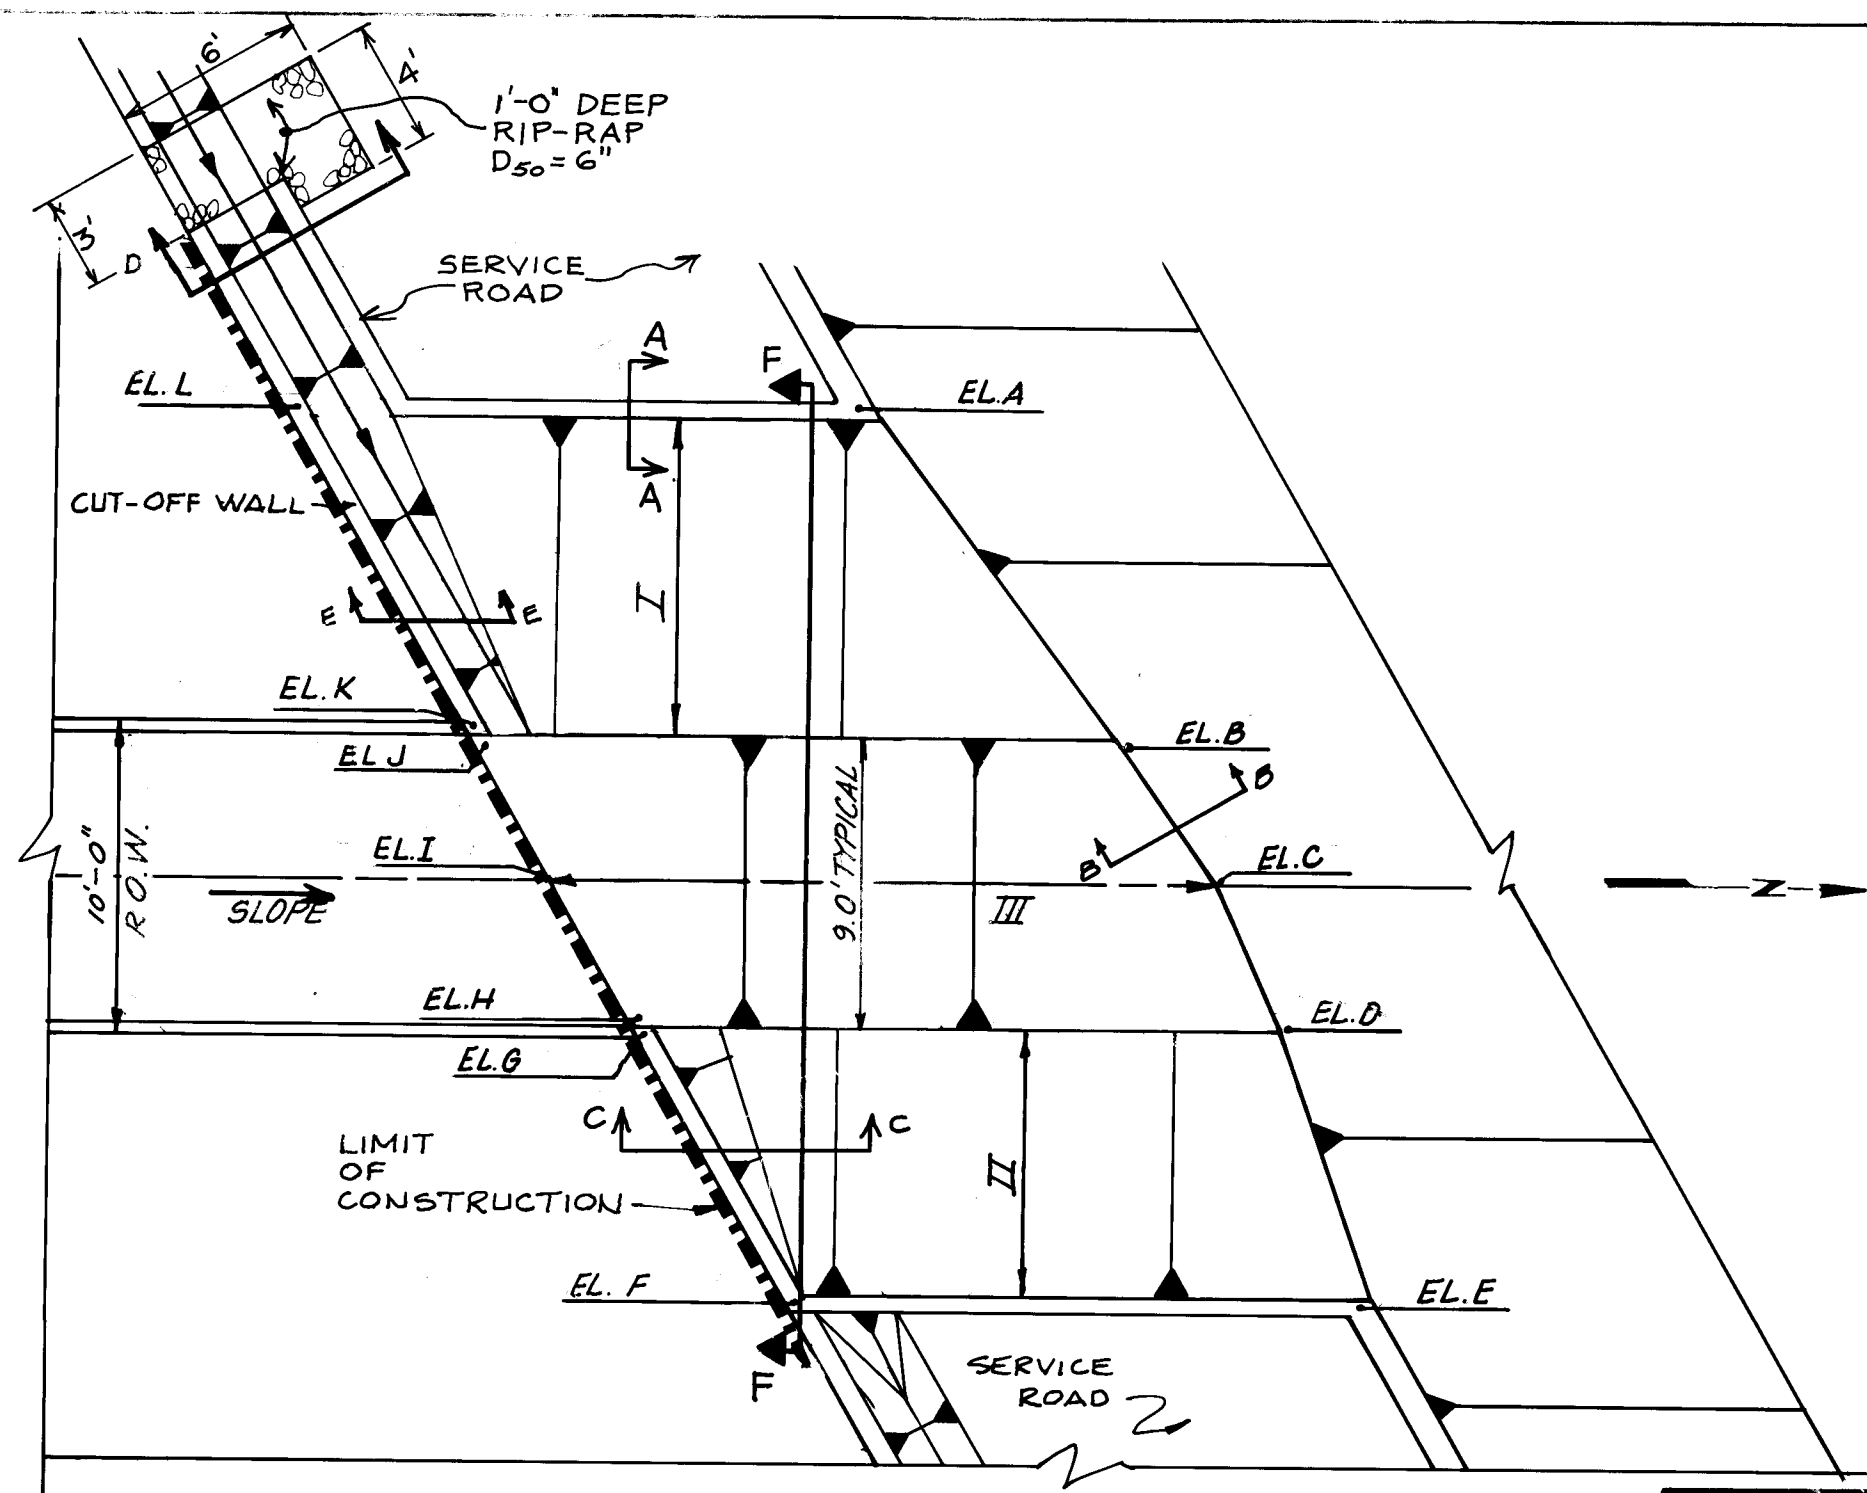

SCALE: 1" = 6'
TYP. RUNDOWN AT CHANNEL

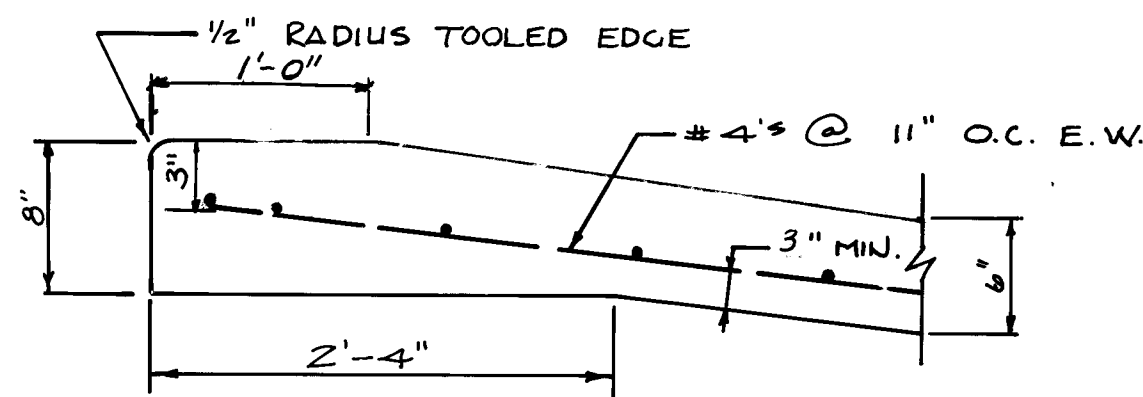


A-A THICKENED EDGE DETAIL
NO SCALE

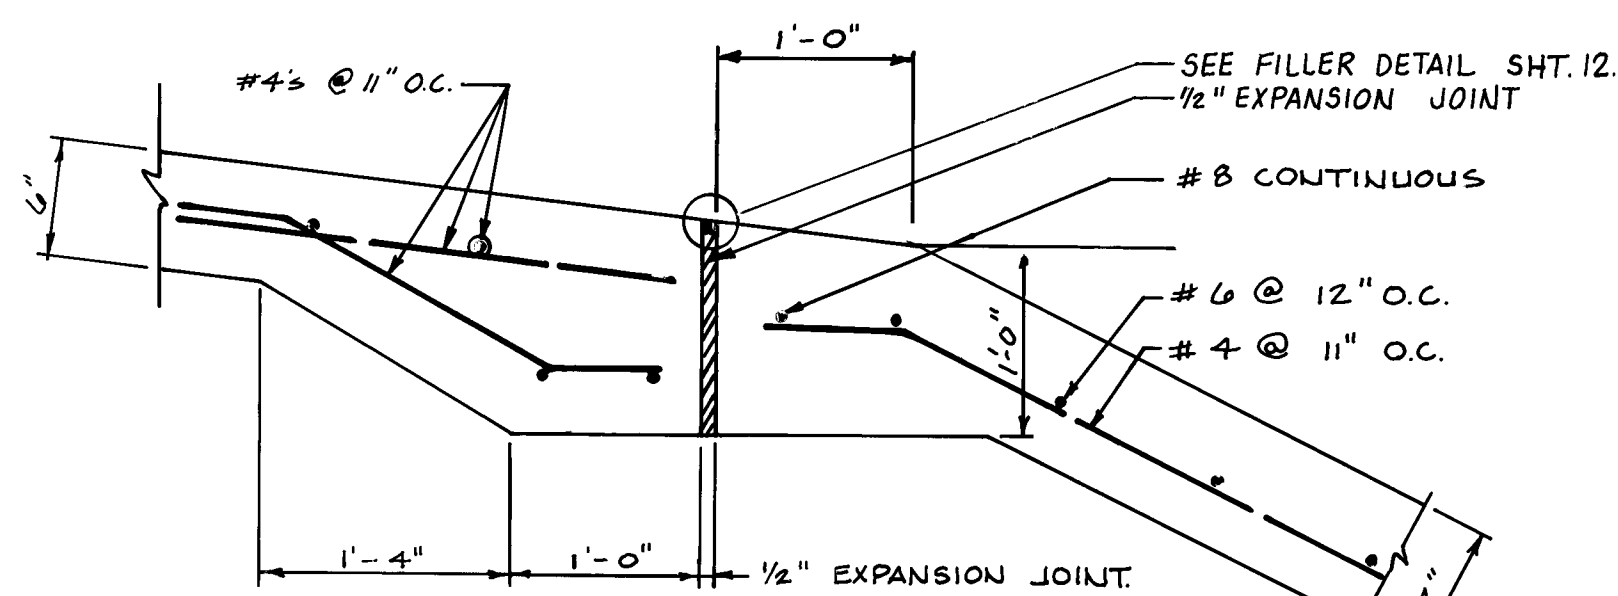

(BUTTE PLACE RUNDOWN WAS BUILT ACCORDING TO PLAN)

SCALE: 1" = 1'
B-B EXPANSION JOINT BETWEEN RUNDOWN & CHANNEL


AS-BUILT EXPANSION JOINT BETWEEN RUNDOWN & CHANNEL FOR JA COURT RUNDOWN & CLIFFROSE ROAD RUNDOWN

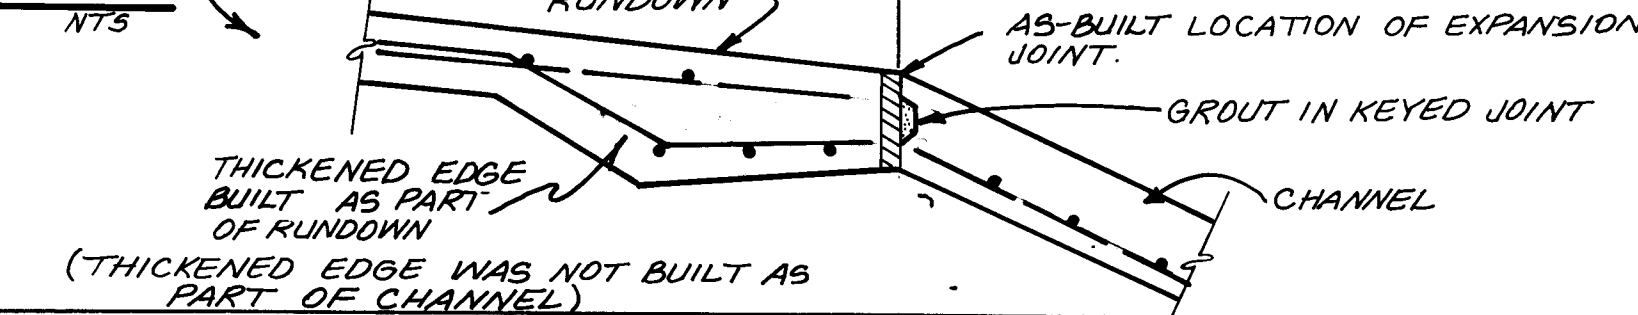


C-C SECTION AT CUTOFF WALL
NO SCALE

DESCRIPTION	RUNDOWNS		
	CLIFFROSE	JA COURT	BUTTE COURT
EL.A	(36.5)	(30.46)	(45.4)
EL.B	(34.85)	(28.99)	(44.17)
EL.C	(34.36)	(28.84)	(43.82)
EL.D	(34.57)	(28.95)	(44.12)
EL.E	(35.94)	(30.11)	(44.95)
EL.F	35.80	30.04	45.17
EL.G	(35.92)	(30.13)	(45.25)
EL.H	(35.21)	(29.7)	(44.25)
EL.I	(34.52)	(28.92)	(44.28)
EL.J	(34.86)	(29.36)	(44.34)
EL.K	(36.08)	(30.38)	(45.48)
EL.L	36.30	30.34	45.54
DIST. I	14.68	12.50	11.08
DIST. II	11.14	9.60	7.27
DIST. III	22.6"	22.05	23.31
Q BRGS	N30°13'46"E	N30°13'46"E	N18°36'57"E
SLOPE	(0.700%)	(0.303%)	(0.787%)
	+0%	+3.00%	+3.1%


DESCRIPTION	RUNDOWNS		
	CLIFFROSE	JA COURT	BUTTE COURT
EL.M	36.42	30.46	45.67
EL.N	35.42	29.46	44.67
EL.O	36.42	30.46	45.67
EL.P	36.34	30.38	45.48
EL.Q	34.88	29.25	44.42
EL.R	34.81	29.13	44.29

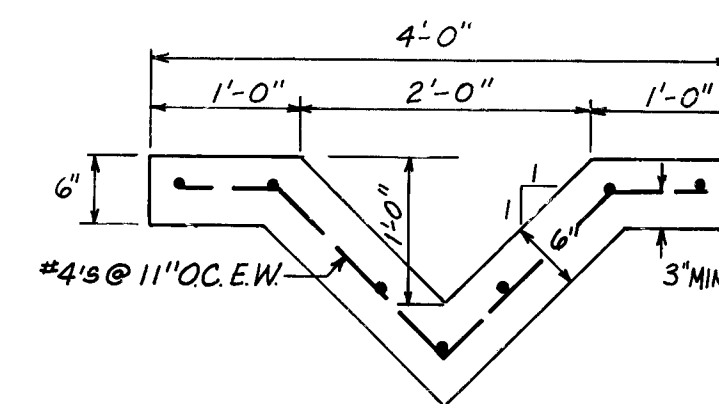


D-D SECTION AT RUNDOWN
NO SCALE

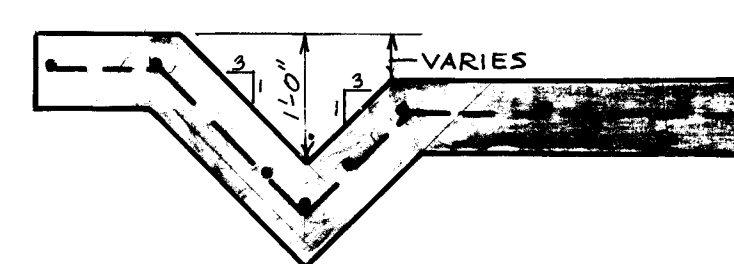

E-E SECTION AT RUNDOWN
NO SCALE

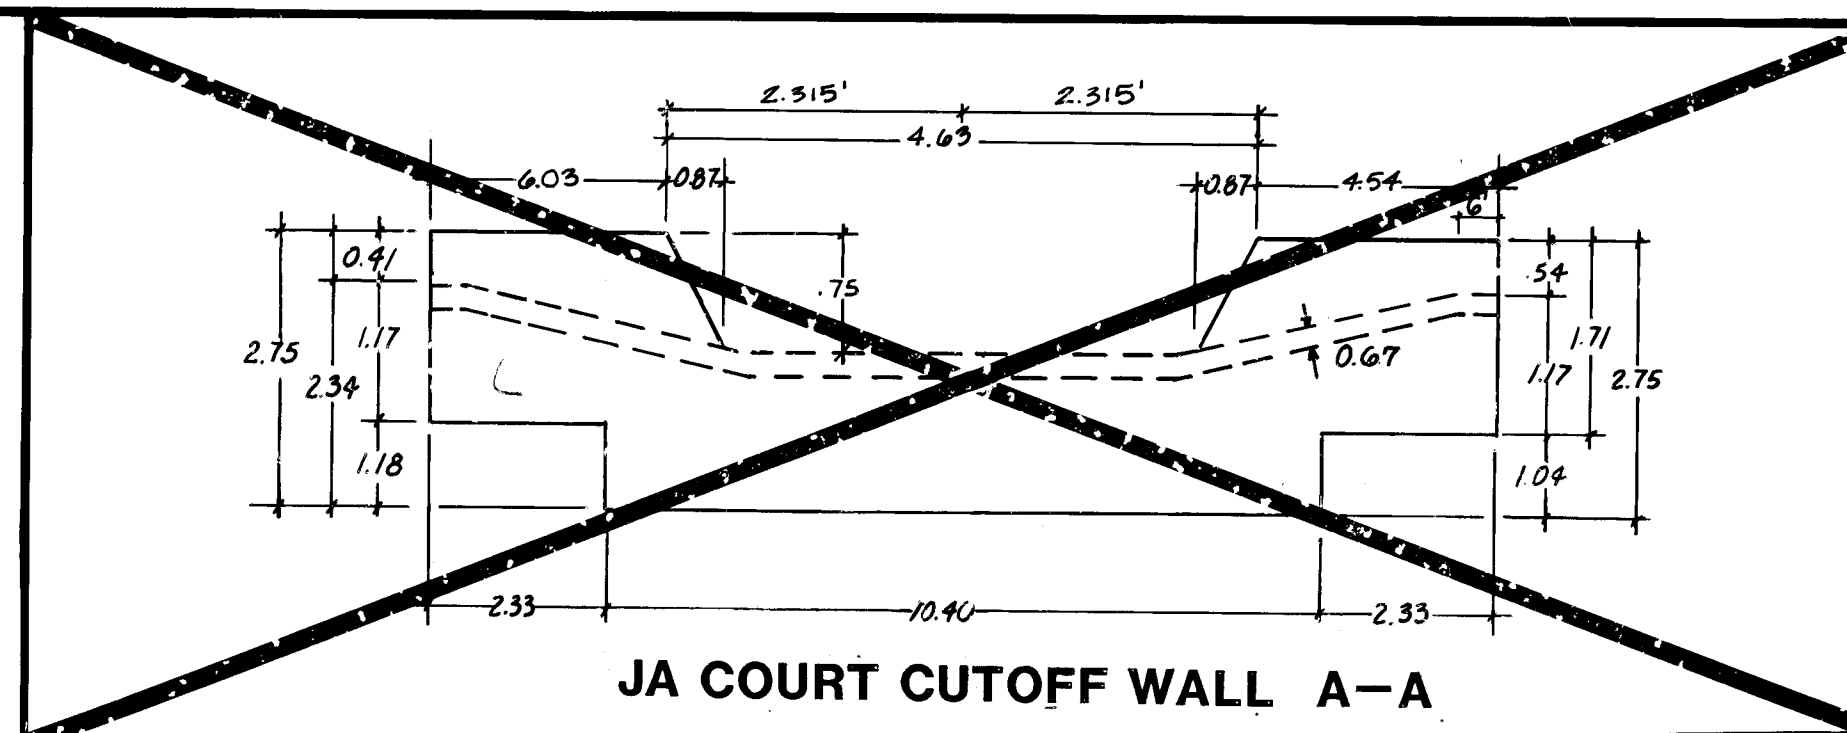

SECTION F-F TYP. RUNDOWN SECTION
NO SCALE

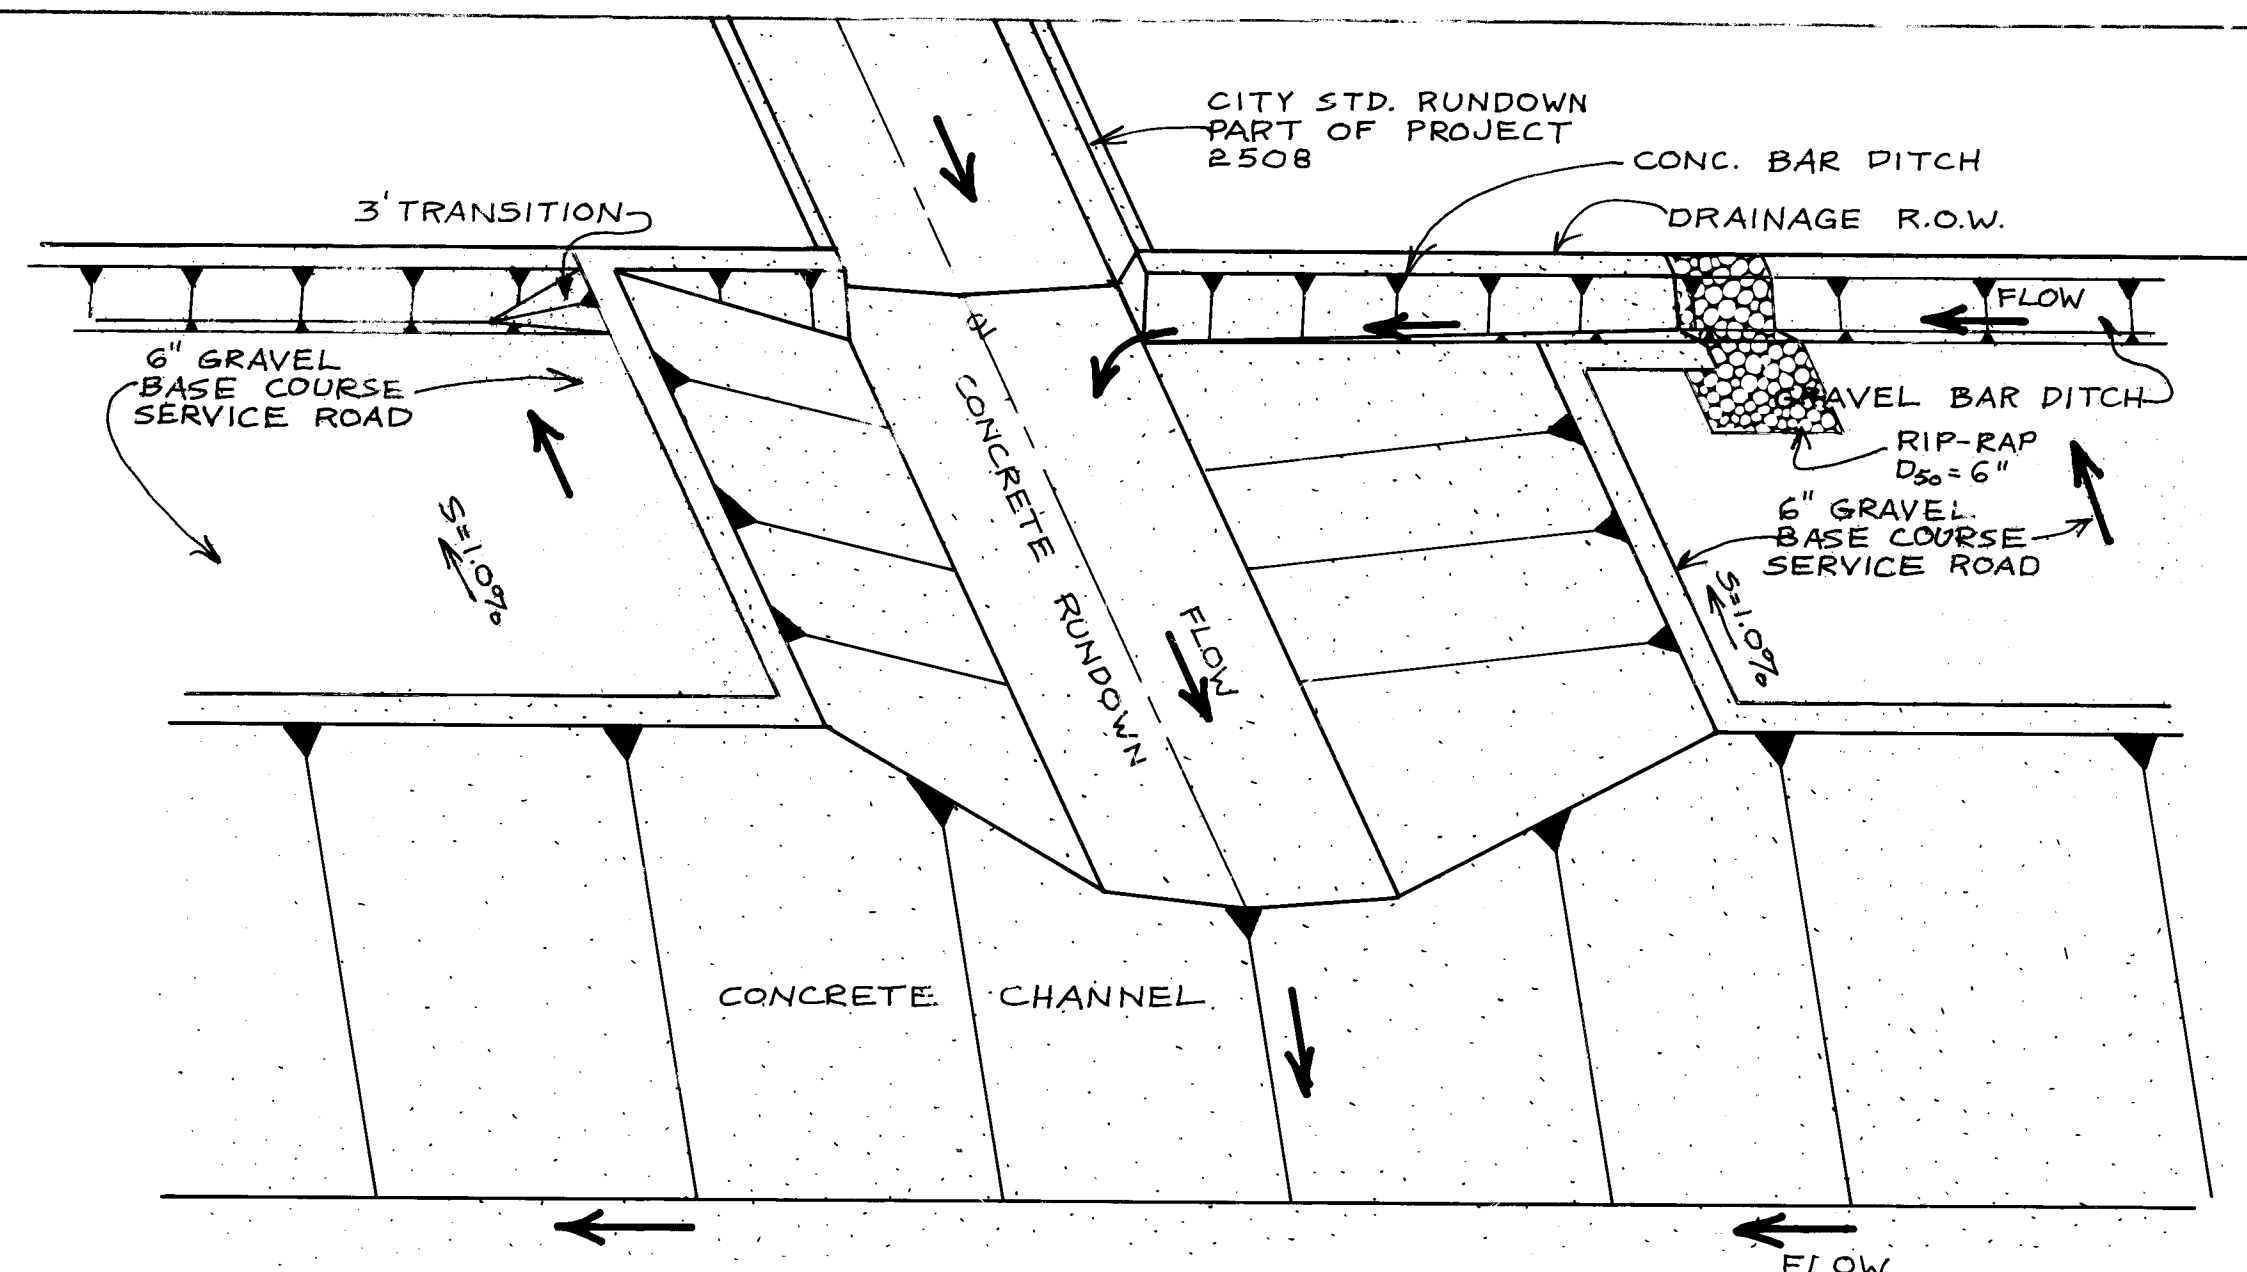

ISOMETRIC VIEW-TYP. RUNDOWN
NO SCALE






AS BUILT INFORMATION		BENCH MARKS		SURVEY INFORMATION		ENGINEER'S SEAL	
CONTRACT NO.	DATE	CONTROL: BENCH MARK 7-FII, WHICH BEARS N 26°09'08" E, 758.55' FROM THE S.E. CORNER OF SANTA FE VILLAGE III, A 3/4" PIPE, BENCH MARK IS A STANDARD A.C.S. BRASS CAP STAMPED "7-FII".	DATE	NO.	BY	DATE	REMARKS
WORK ORDER NO.	DATE						
INSPECTED BY	DATE						
FIELD ENGINEER	DATE						
APPROVED BY	DATE						
RECORDED BY	DATE						
INDEXED BY	DATE						

26 27941387

CITY OF ALBUQUERQUE
MUNICIPAL DEVELOPMENT DEPARTMENT
ENGINEERING DIVISION

TITLE: SANTA FE VILLAGE UNIT III PHASE I
CHANNEL DETAILS
RUNDOWNS & MISC.

APPROVALS	ENGINEER	DATE	APPROVALS	ENGINEER	DATE
City Engineer	<i>[Signature]</i>	6/27/85	Liquid Waste	<i>[Signature]</i>	5/14/86
A.C.E. Design	" "	" "	Traffic	<i>[Signature]</i>	5/14/86
A.C.E. Hydrology	" "	" "	Water	<i>[Signature]</i>	5/14/86
AMAFCA					
DRAWING NO.	2794	MAP NO.	F-10	SHEET	13 OF 15

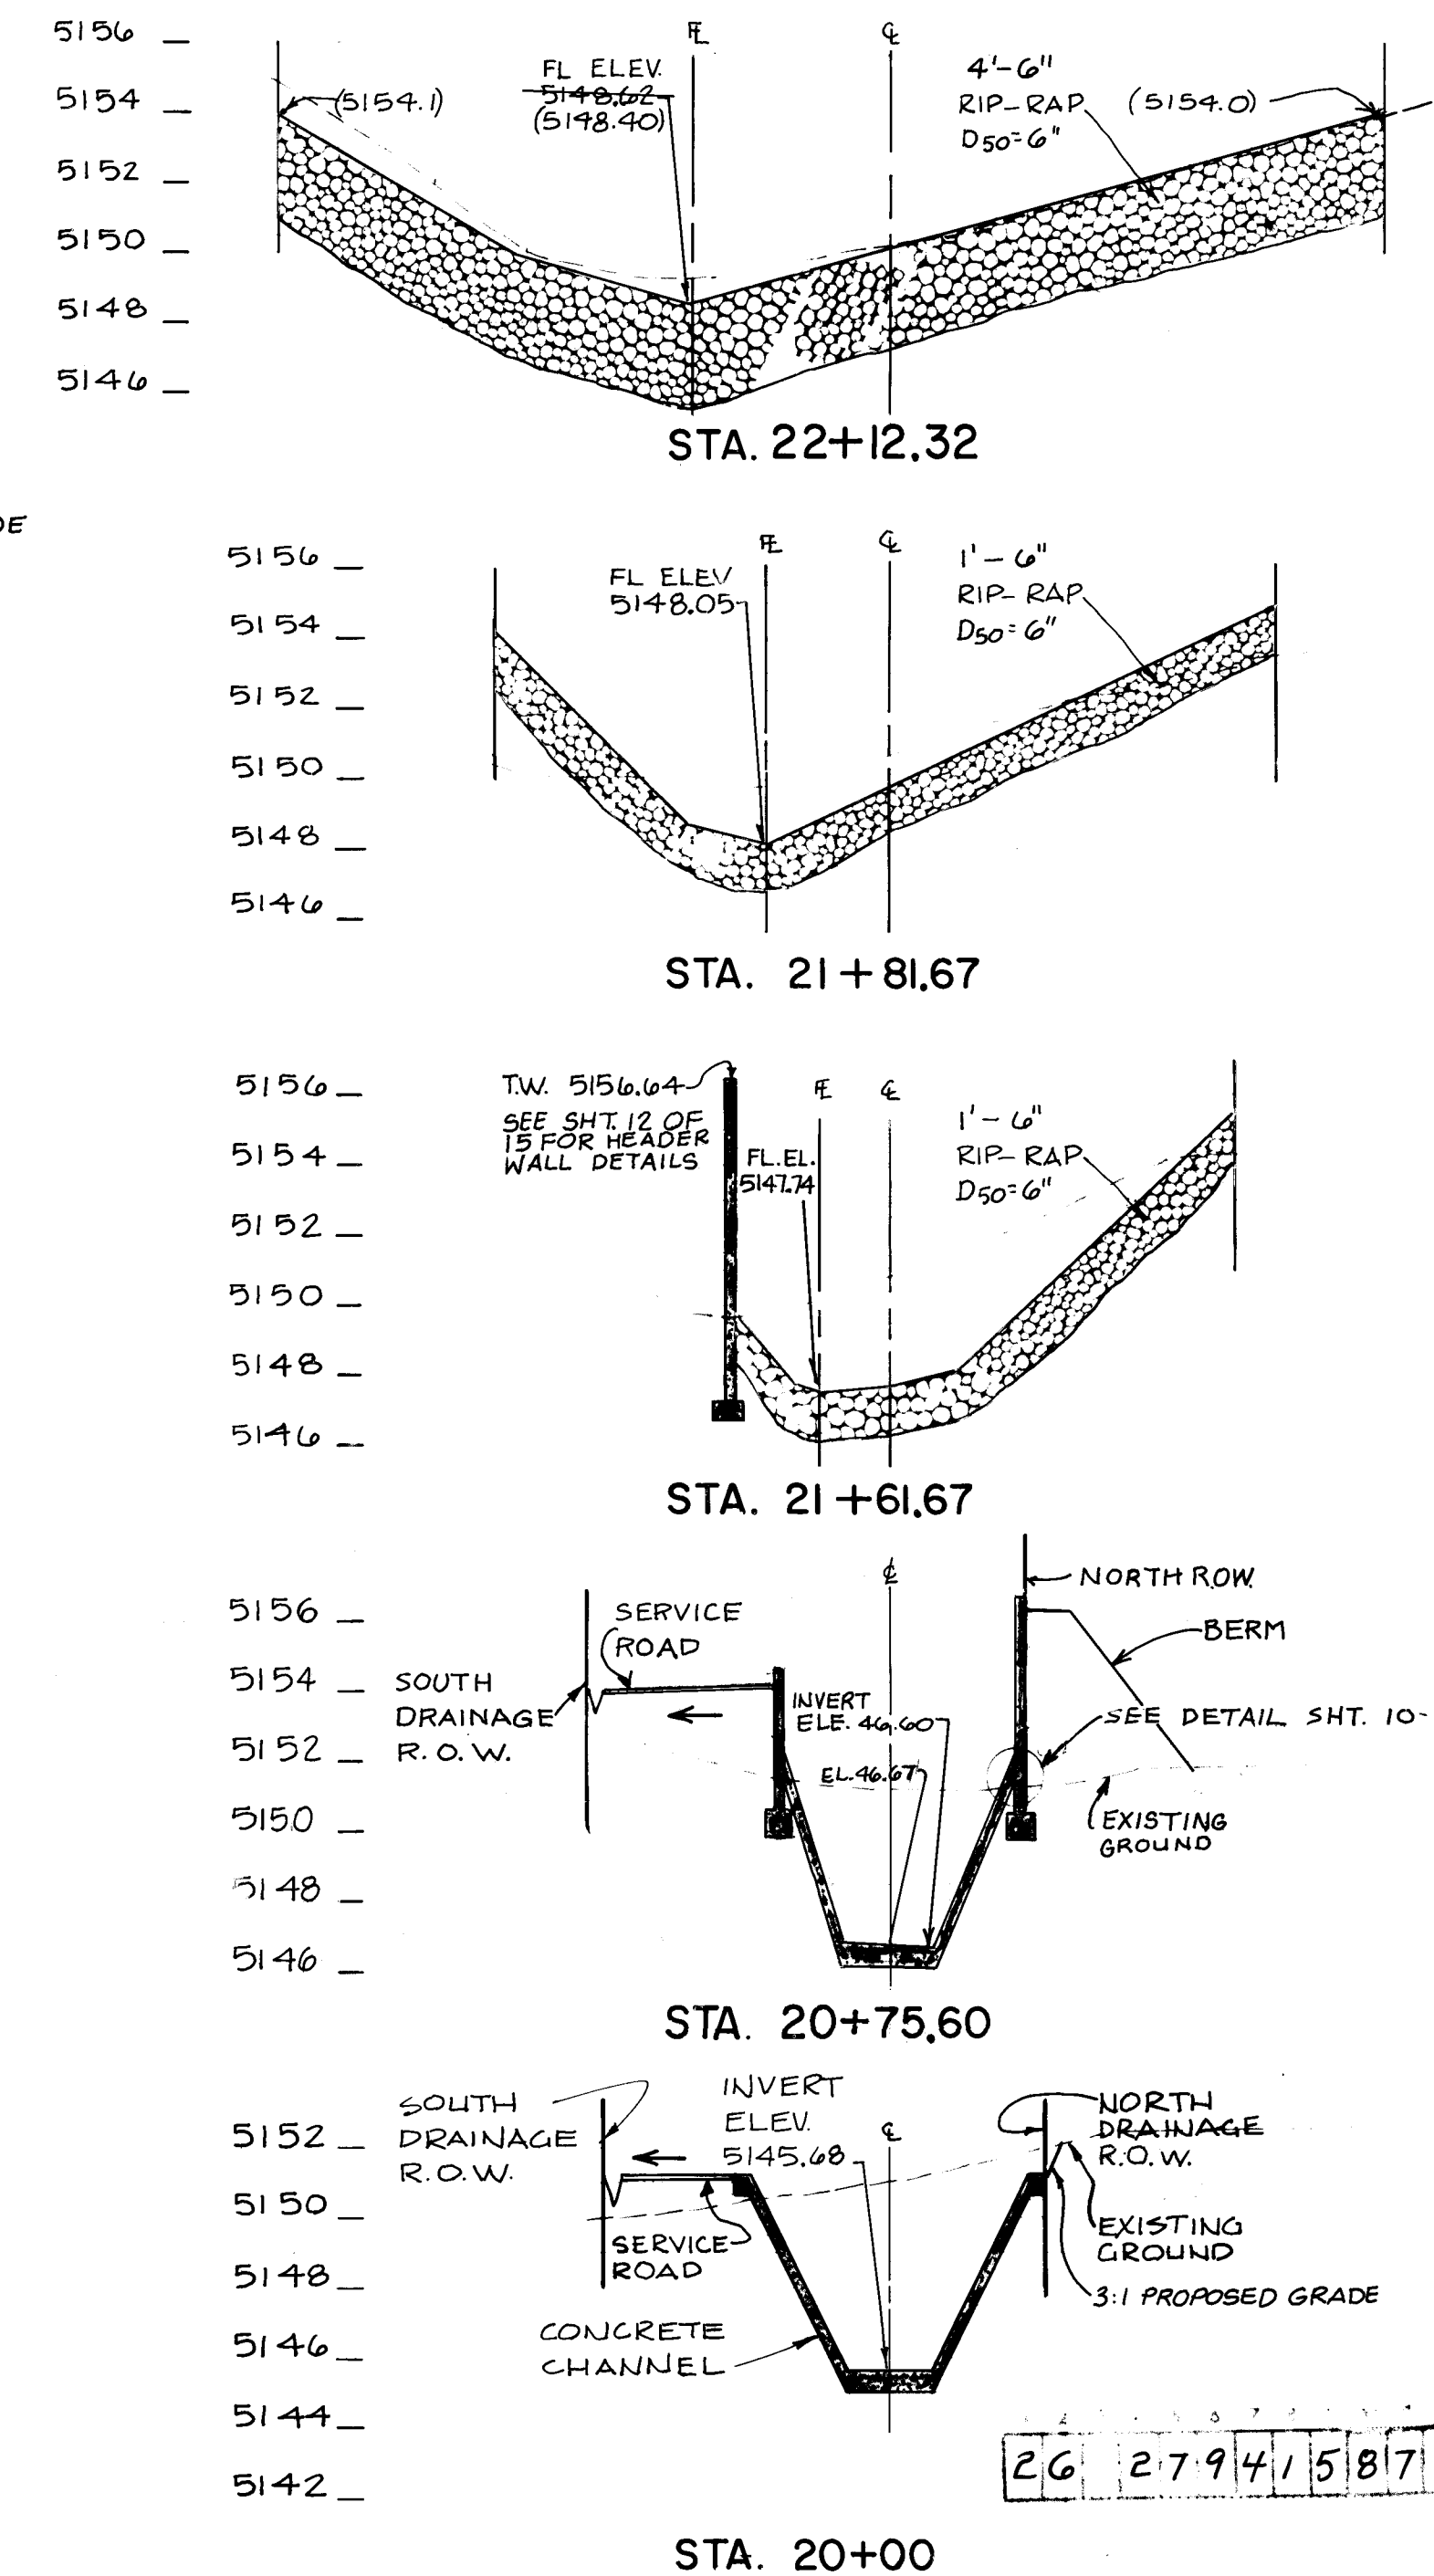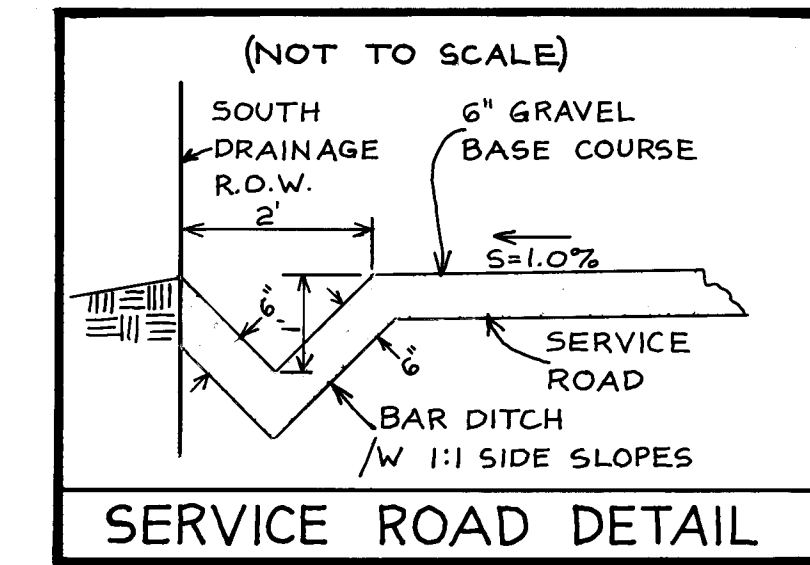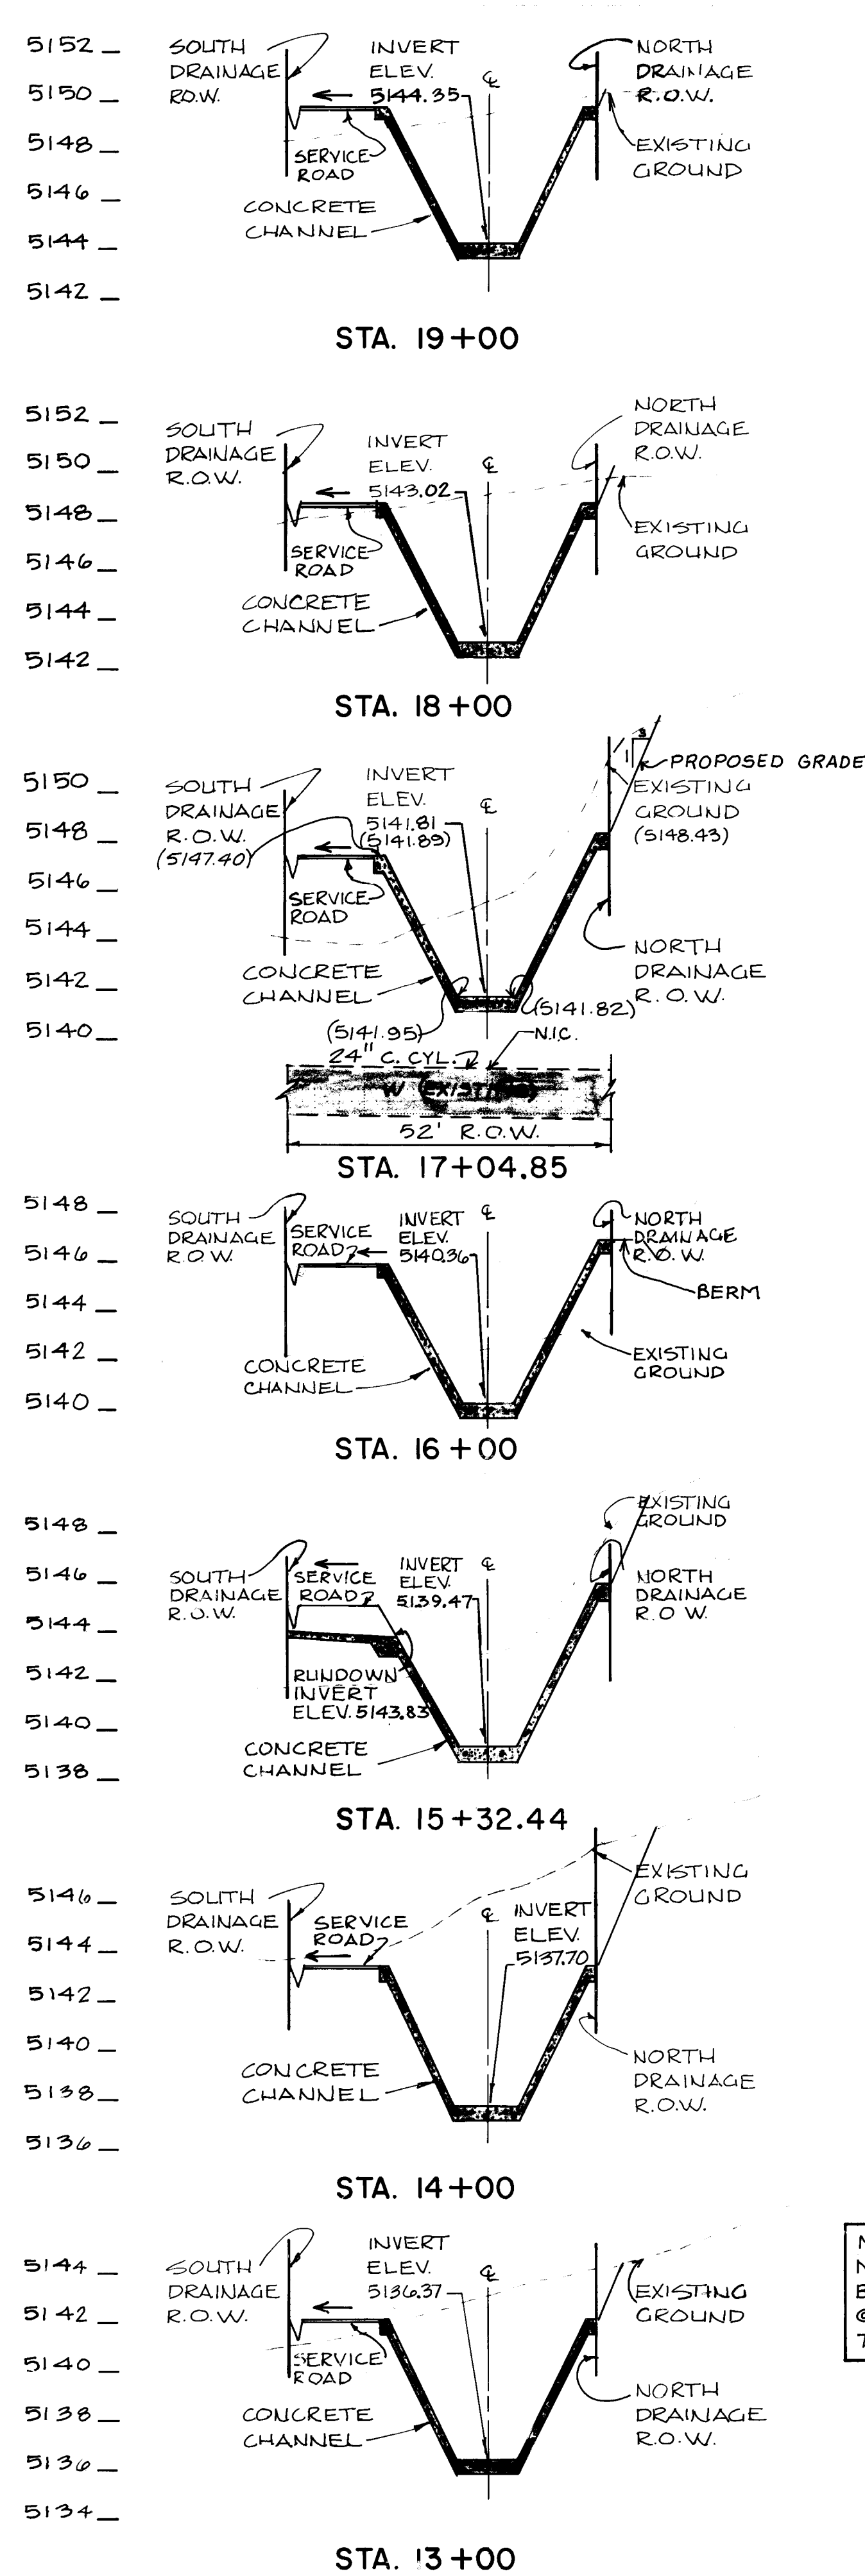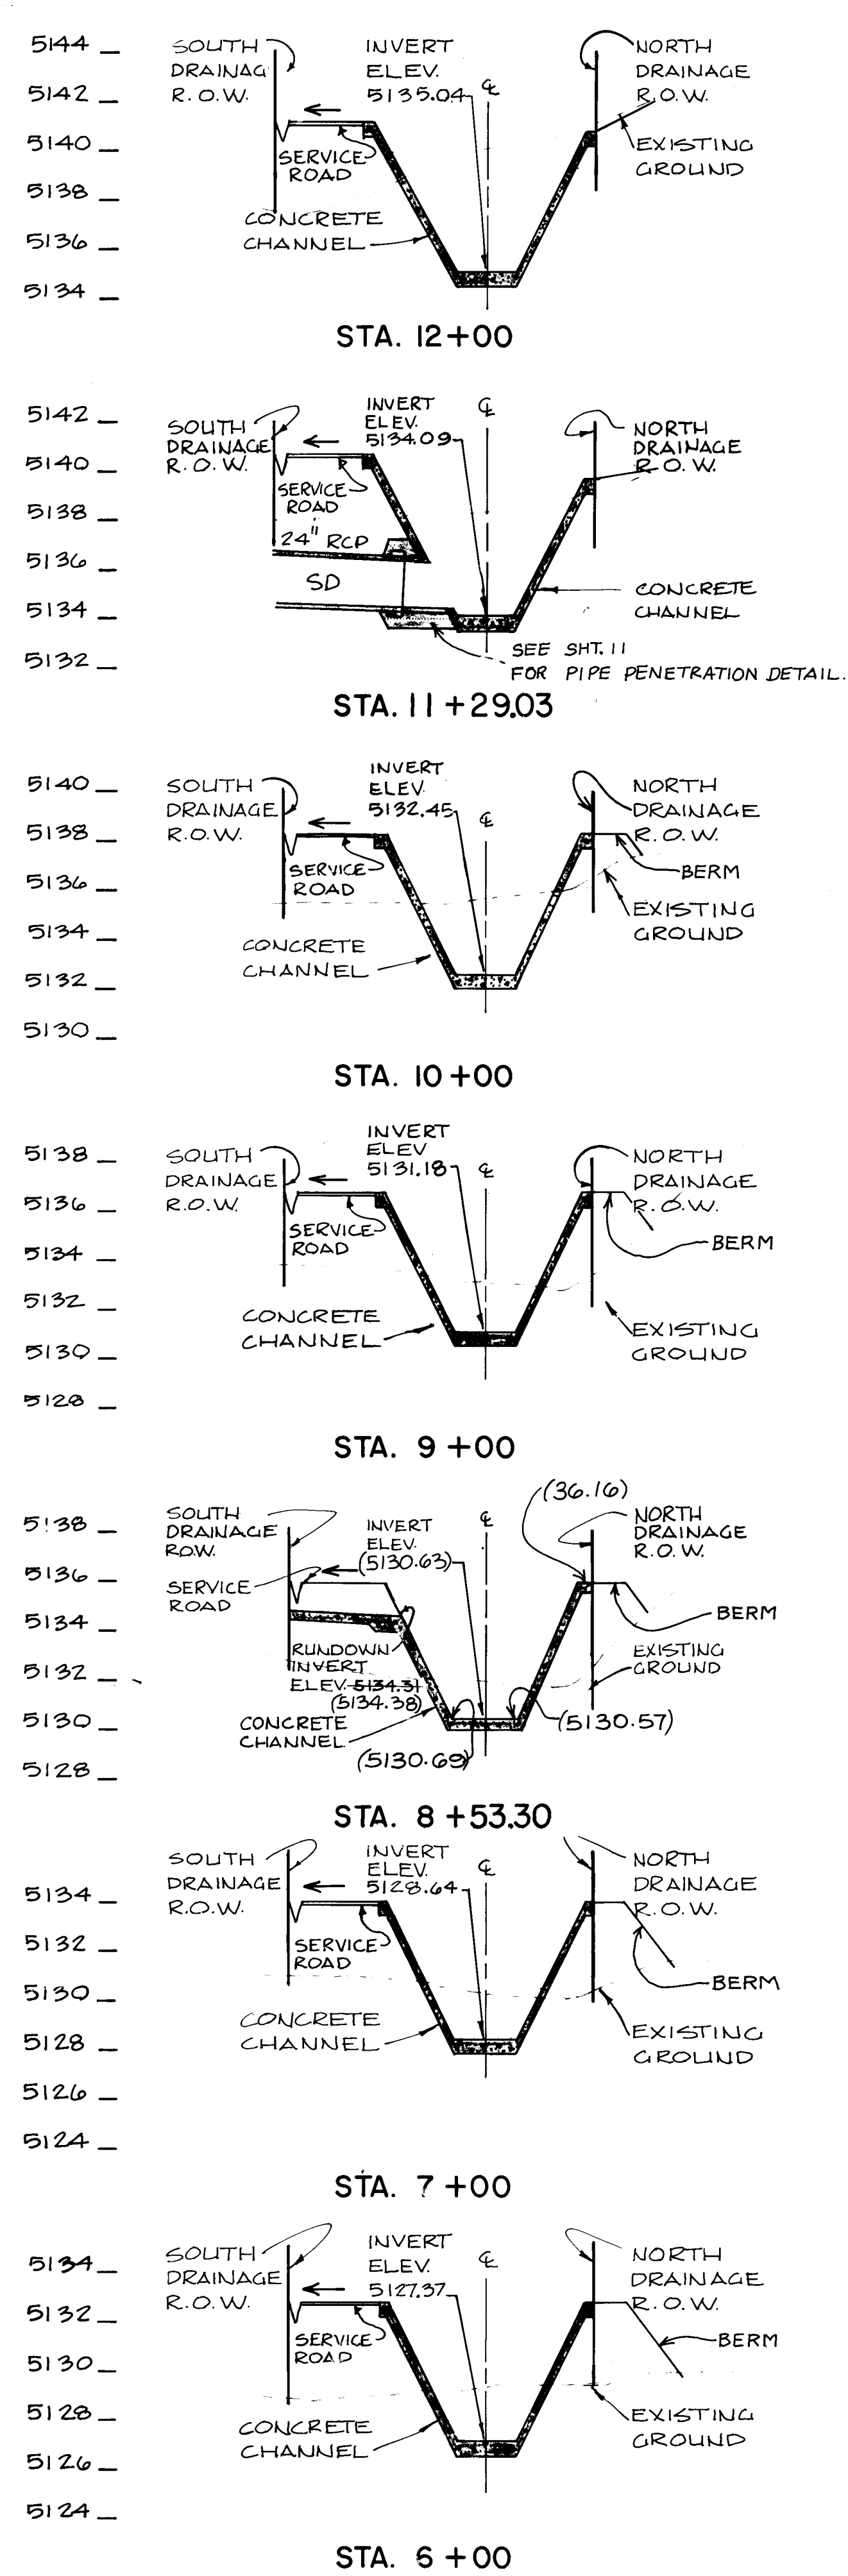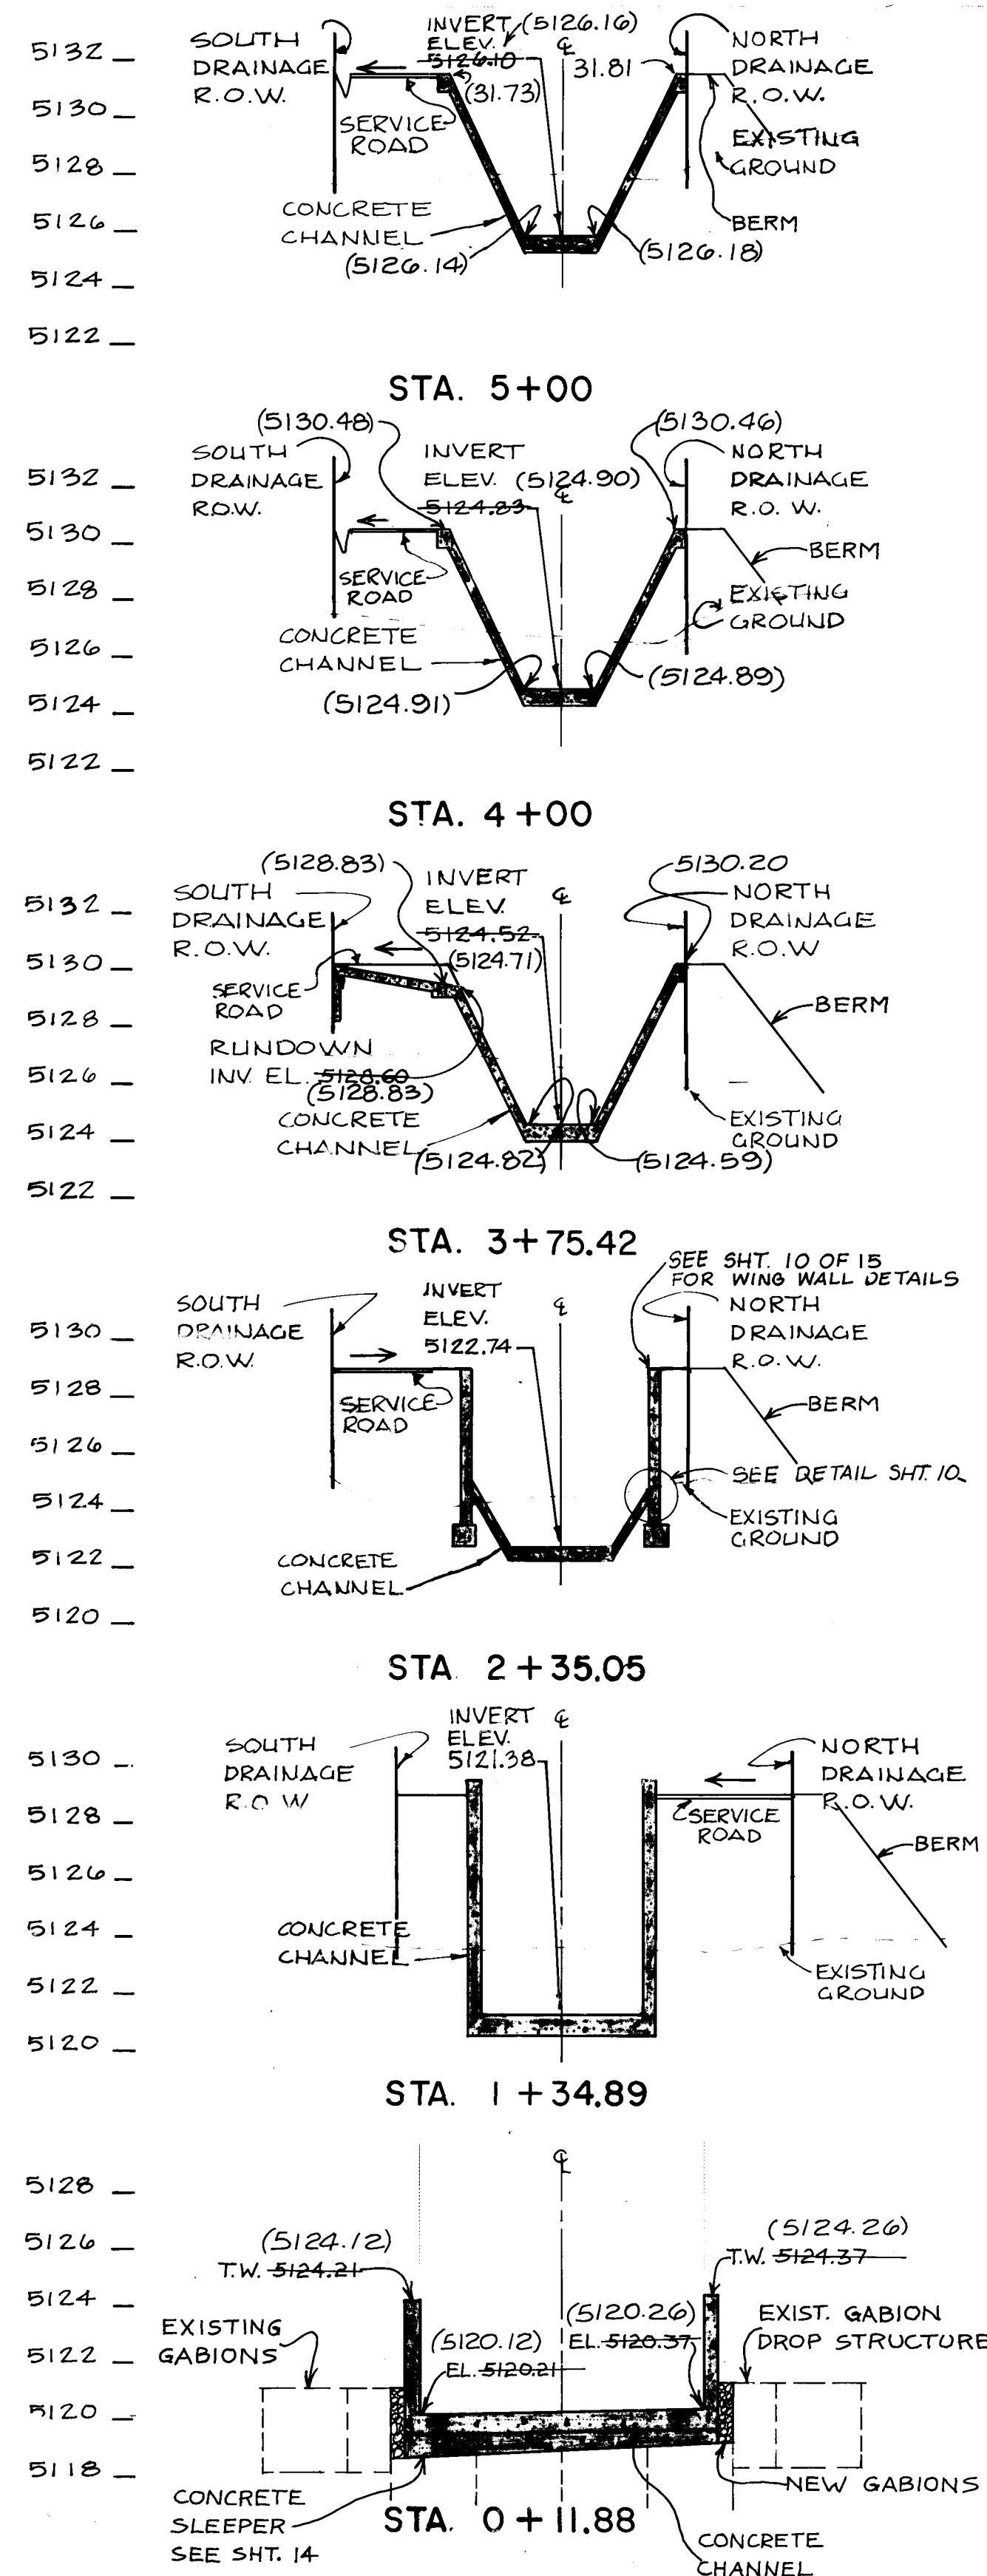

NOTE: NORTH SIDE OF CHANNEL-BUILD EARTH BERM TO MEET EXIST. GRADE W/FILL @ 3H:1V SIDESLOPES MAXIMUM & TOP WIDTH OF 5'-0" FROM R.O.W. LINE

CITY OF ALBUQUERQUE MUNICIPAL DEVELOPMENT DEPARTMENT ENGINEERING DIVISION			
TITLE: SANTA FE VILLAGE UNIT III PHASE I CHANNEL CROSS-SECTIONS			
APPROVED	ENGINEER	DATE	APPROVAL
By Engineer	<i>[Signature]</i>	6/27/86	By <i>[Signature]</i>
A. E. Design			By <i>[Signature]</i>
A. I. Hydrology			By <i>[Signature]</i>
AMAFCA			
DRAWING NO.	2794	MAP NO.	F-10
SHEET	15	OF	15

CONTROL: BENCH MARK 7-FII, WHICH BEARS N 26° 09' 08" E, 758.55' FROM THE S.E. CORNER OF SANTA FE VILLAGE III, A 3/4" PIPE. BENCH MARK IS A STANDARD A.C.S. BRASS CAP STAMPED "7-FII".

M.S.L. ELEVATION=5116.57'