

1"=20'

GLENWOOD

UNIT HILLS THREE  
BLOCK 7

SOUTH

LOT 9

EXISTING GARDEN WALL

NOTE: SEE DETAIL 1

EXISTING RETAINING WALL

DIRT

115'

66'

ASPHALT

PROPOSED CURB

133'

EXISTING CHANNEL

40' R.O.W.

DIRT

EXISTING RETAINING WALL





EXISTING GARDEN WALL

123'

132.9'

50' R.O.W.

EMBURY DRIVE

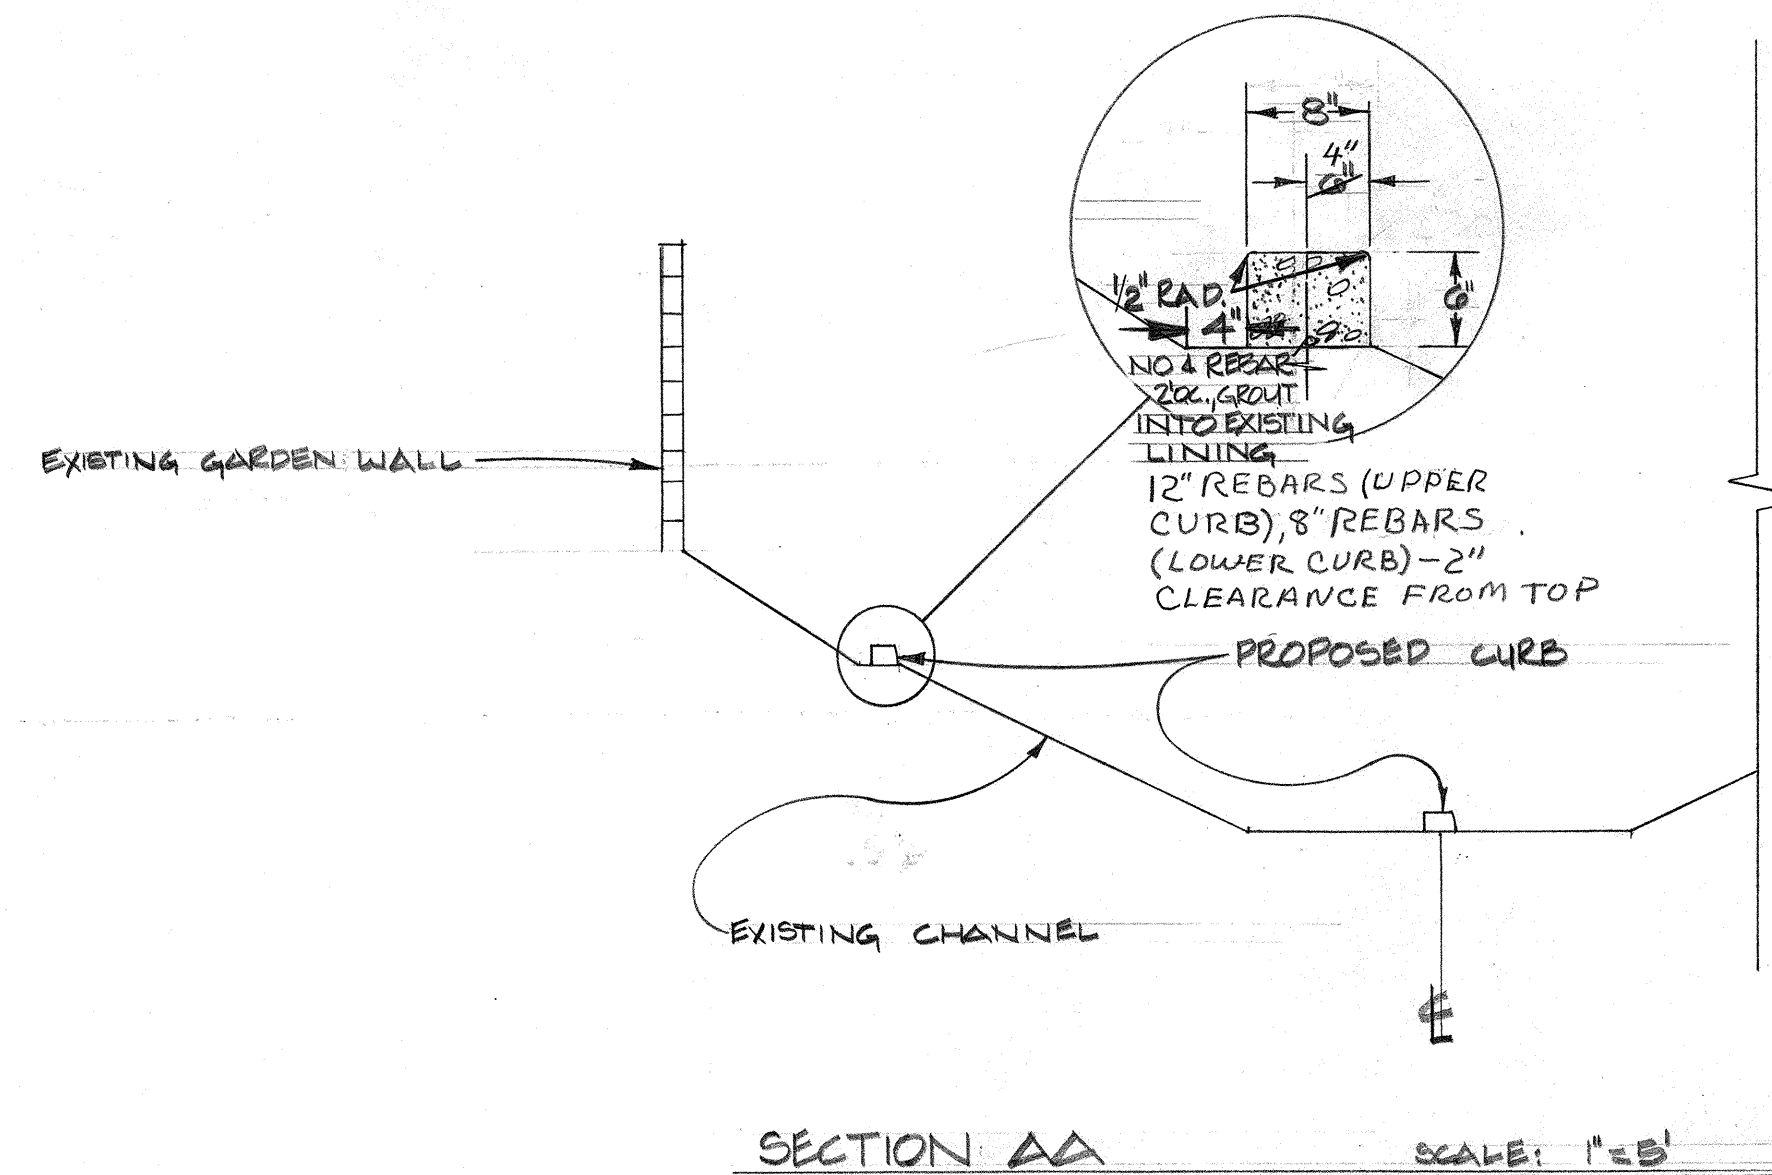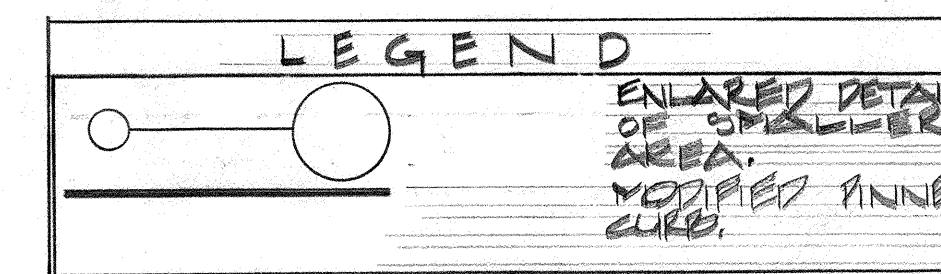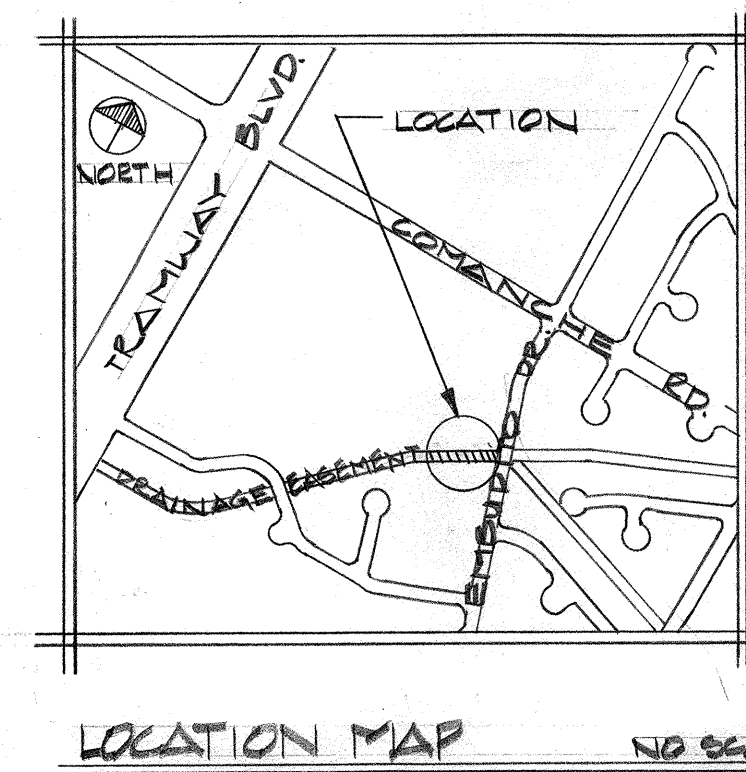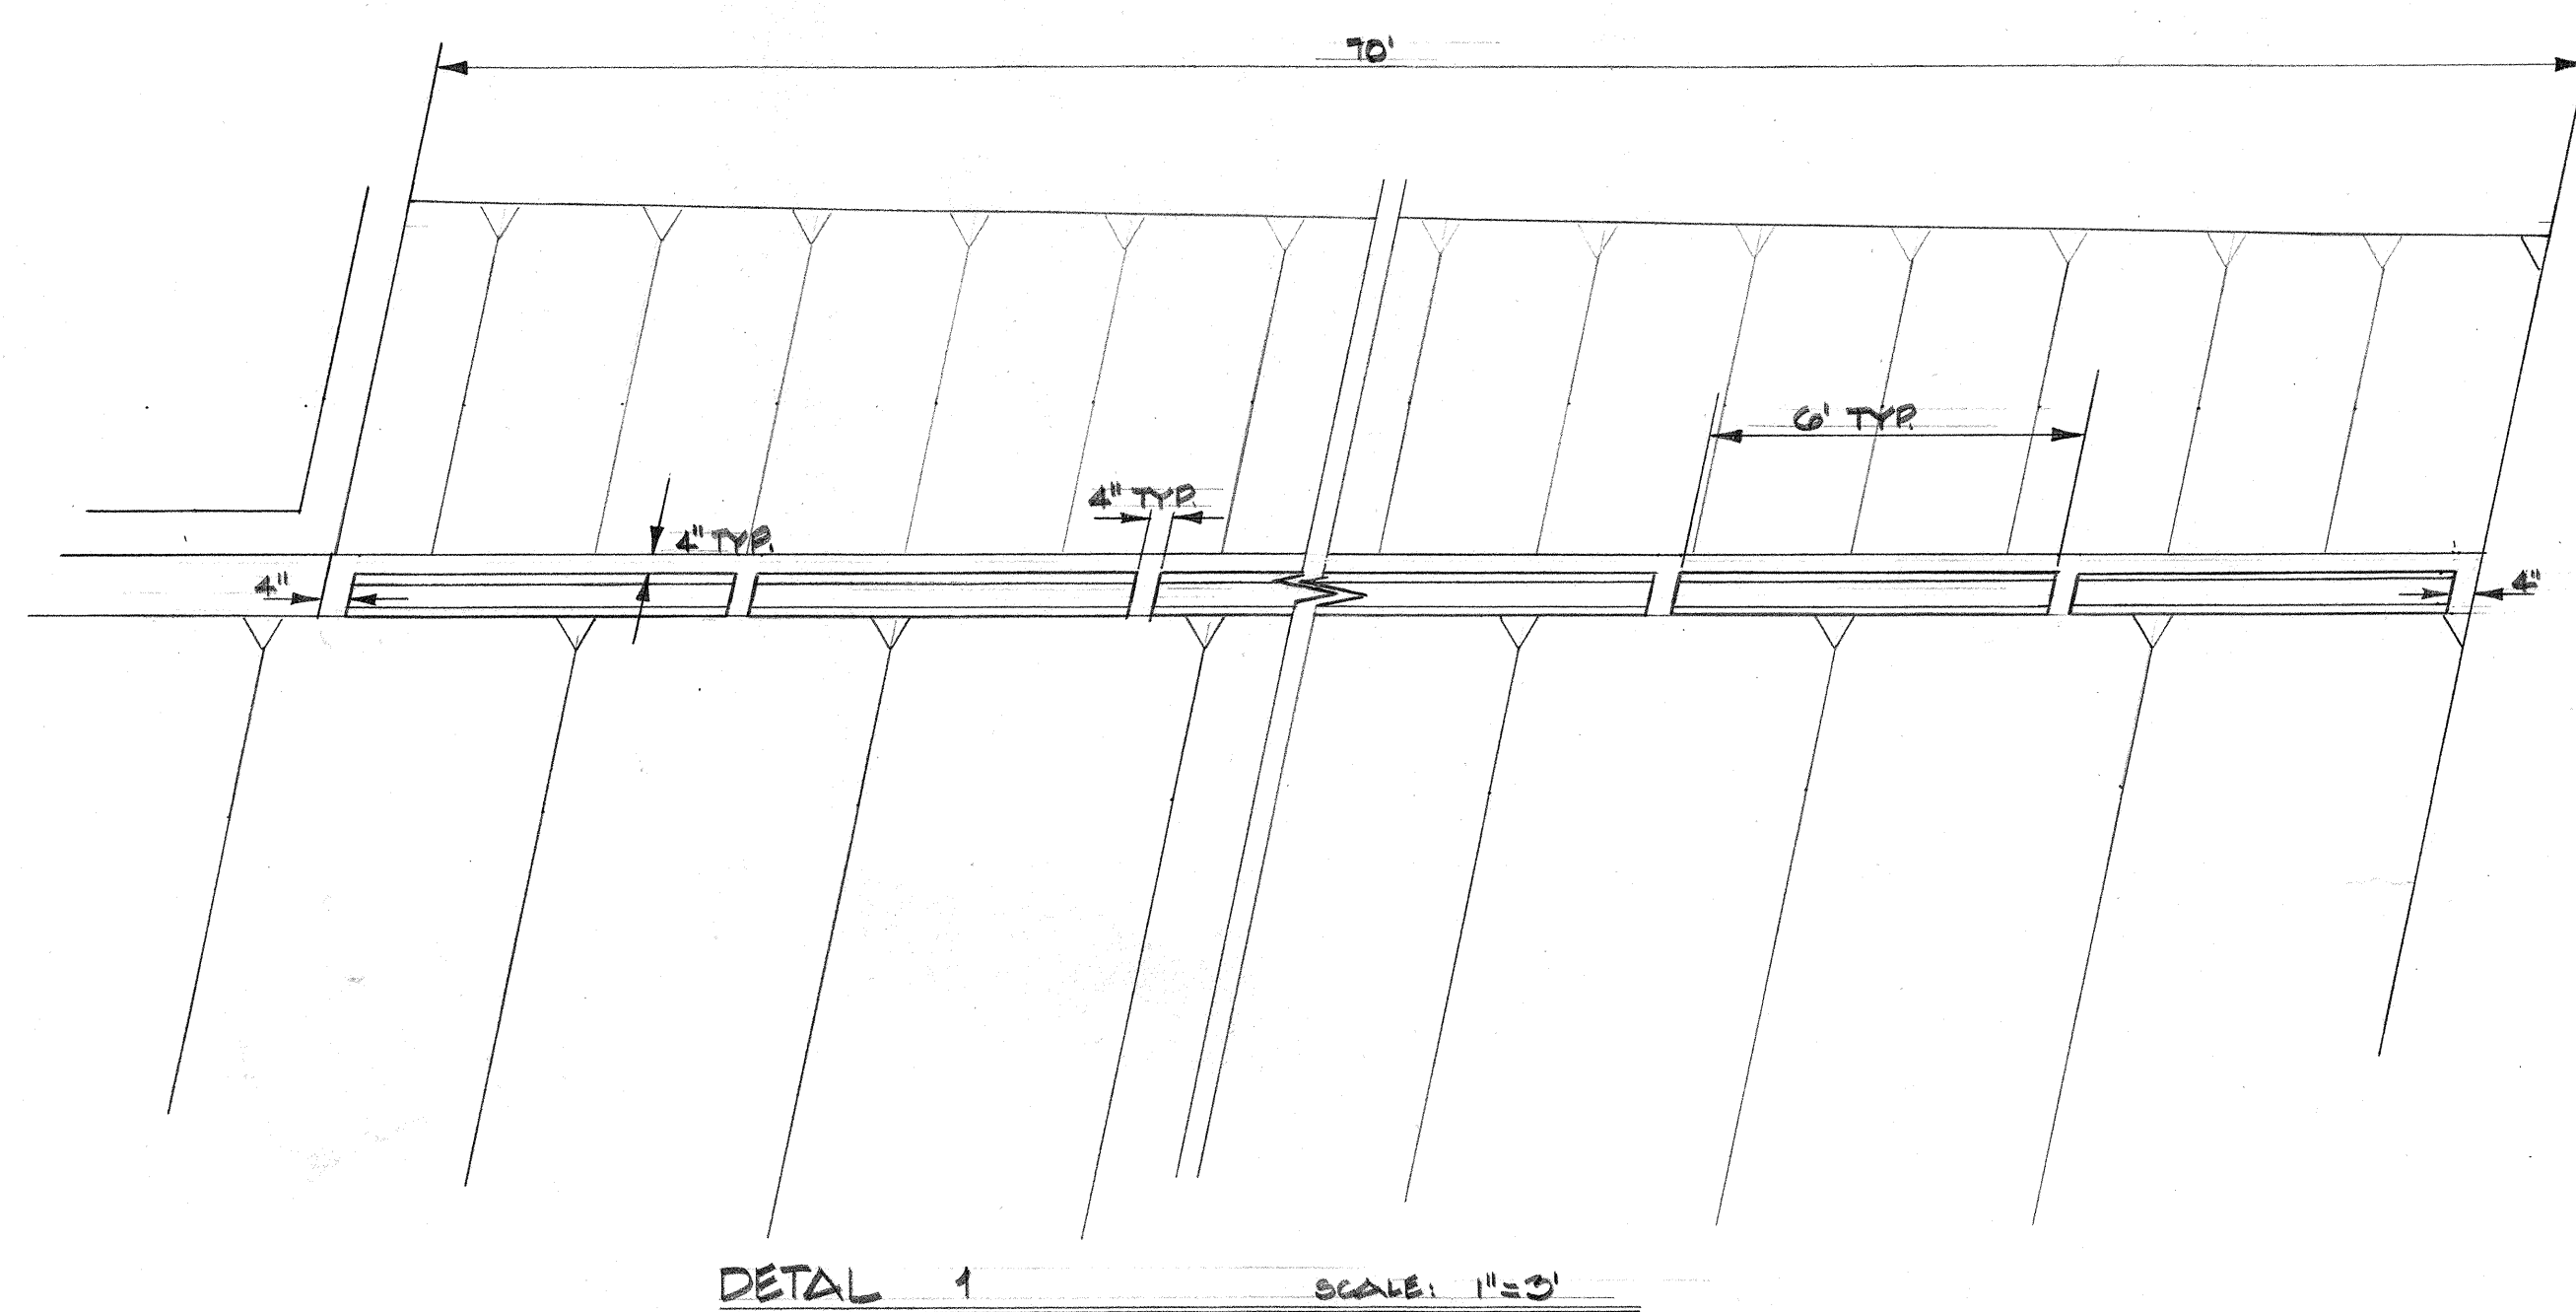

1	2	3	4	5	6	7	8	9	10	11	12
20			281					0129			

APPROVAL OF AS BUILT DRAWINGS  
ASST. CITY ENGINEER - FIELD  
*[Signature]*  
DATE *5-29-82*

APPROVED FOR  
CONSTRUCTION

CITY OF ALBUQUERQUE					
PUBLIC WORKS DEPARTMENT					
ENGINEERING DIVISION					
TITLE: SKATEBOARD PROTECTION					
GLENWOOD HILLS SOUTH CHANNEL					
APPROVALS	ENGINEER	DATE	APPROVALS	ENGINEER	DATE
City Engineer	<i>R. Swall</i>	9/23/80	Liquid Waste		
A.C.E. - Design	<i>C. Bellch</i>	7/16/80	Traffic		
A.C.E. - Hydrology			Water		
DRAWING NO. SD-29-281			SHEET 1 OF 1		