


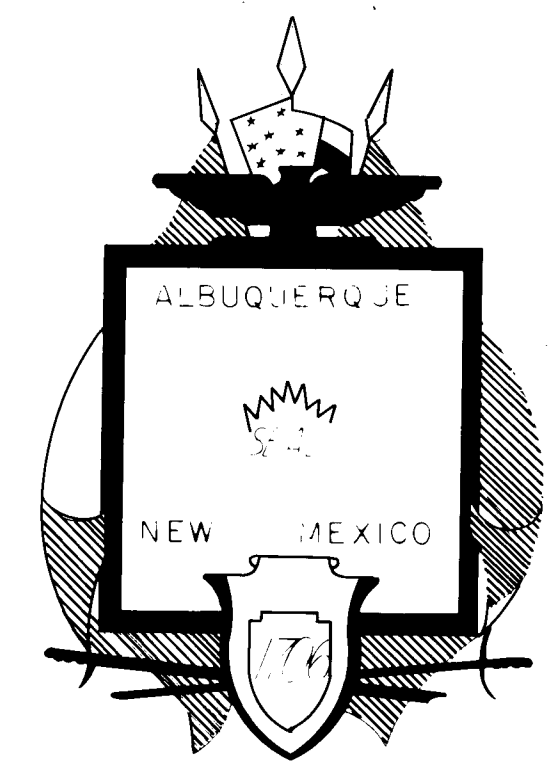


CITY OF ALBUQUERQUE, NEW MEXICO

SUNPUEBLO APARTMENTS

ALBUQUERQUE, NEW MEXICO

SITE AND GRADING PLAN, PUBLIC AND PRIVATE INFRASTRUCTURE IMPROVEMENTS

EMPIRE WEST COMPANIES,
DEVELOPER

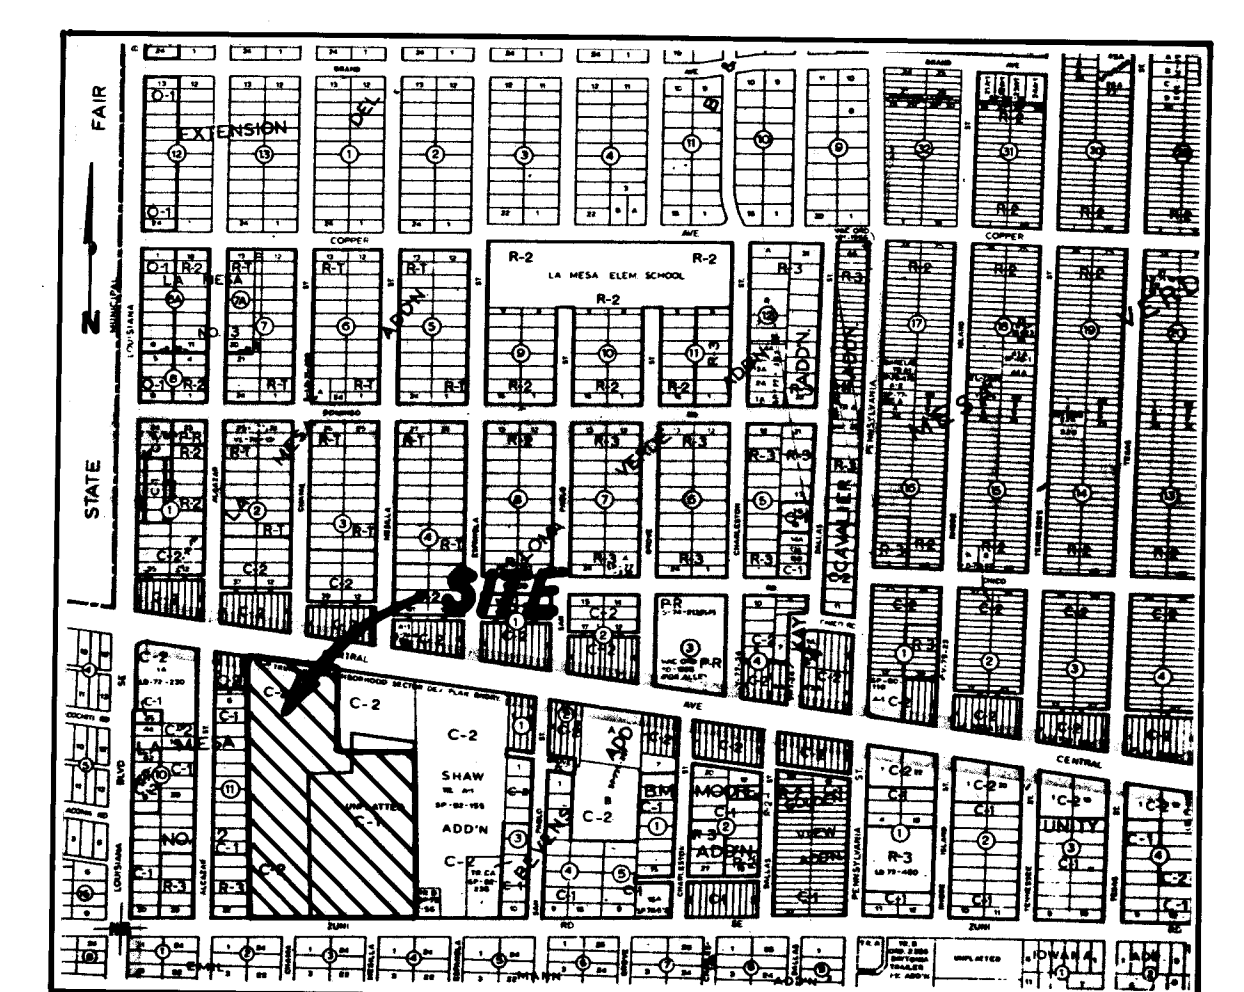

VICINITY MAP
Zone Atlas K-19
Scale 1"=800'

GENERAL NOTES

- All work detailed on these plans to be performed under contract shall, except otherwise stated or provided for hereon, be constructed in accordance with the "City Of Albuquerque Interim Standard Specifications For Public Works Construction 1985."
- Two working days prior to any excavation, Contractor must contact Line Locating Service, 765-1234, for the location of existing utilities.
- Prior to construction, the Contractor shall excavate and verify the horizontal and vertical locations of all existing utilities and potential obstructions. Should a conflict exist, the Contractor shall notify the Engineer so that the conflict can be resolved with a minimum amount of delay.
- The Contractor shall maintain access to adjacent properties at all times.
- All work on this project shall be performed in accordance with applicable Federal, State and Local laws, rules and regulations concerning construction safety and health.
- The Contractor must submit a construction signing and barricading plan to Traffic Engineering to receive a barricading permit prior to construction.
- All dimensions and radii of curb and curb returns are shown to face of curb unless otherwise noted.
- Where removal of existing curb and gutter, sidewalk or pavement is required the Contractor shall sawcut and/or remove to the nearest joint. Curb and gutter shown as existing and not to be removed under this contract which is damaged or displaced by the Contractor shall be removed and replaced by the Contractor at the Contractor's expense.
- Restriping of roadway shall be the responsibility of the City of Albuquerque and shall not be included in this contract.
- Backfill compaction shall be according to specified street use.
- Tack coat requirements shall be determined by the City Engineer.
- Sidewalks and wheelchair ramps within the curb returns shall be constructed wherever a new curb return is constructed.
- If curb is depressed for a driveway or a handicap ramp, the driveway or ramp shall be constructed prior to acceptance of the curb and gutter.
- All storm drainage facilities shall be completed prior to final acceptance.

INDEX

SHEET NO.	DESCRIPTION	SHEET NO.	DESCRIPTION
1	TITLE & VICINITY MAP	6	CURB PLAN & GEOMETRY
2	PLAT	7	OVERALL SEWER LAYOUT
3	DEMOLITION PLAN	8	OVERALL WATER LAYOUT
4	GRADING & DRAINAGE PLAN	9-12	PLAN & PROFILES (PUBLIC WATERLINE)
5	SITE PLAN	13	DETAILS

dtm & associates, inc.

Denney-Tibljias-McLean & Associates, Inc.
Consulting Engineers ■ Planners ■ Surveyors
2400 COMANCHE ROAD, NE ■ ALBUQUERQUE, NM 87107
TELEPHONE (505) 884-0696

NOTE: Work order includes public waterline only.

Russell D. Smith
DATE 12-12-86

RECORD DRAWING
Date 11/19/86

Δ	4,5,6,7,8	<i>[Signature]</i>	7/10/86	<i>[Signature]</i>	7/10/86		
Δ	4	" "	" "	" "	" "		
Δ	4,8,12	" "	" "	" "	" "		
Δ	4,8,9,12	" "	" "	" "	" "		
REV.	SHEETS	FOR CITY ENGR.	DATE	USER DEPT.	DATE	USER DEPT.	DATE

APPROVAL OF REVISIONS


DENNEY-TIBLJAS-McLEAN & ASSOC., INC.
CONSULTING ENGINEERS ■ PLANNERS ■ SURVEYORS
2400 COMANCHE RD. N.E., ALBUQ. N.M. 87107
(505) 884-0696


APPROVED FOR CONSTRUCTION
[Signature]
7/16/86
C.E.

DRWG. NO. 2814

SHEET 1 OF 13

26 28 140 186

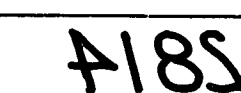

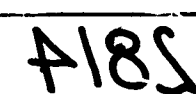

MESILLA ST. N.E.


AVE.

CHAMA ST. N.E.

CENTRAL



SCALE: 1" = 40'

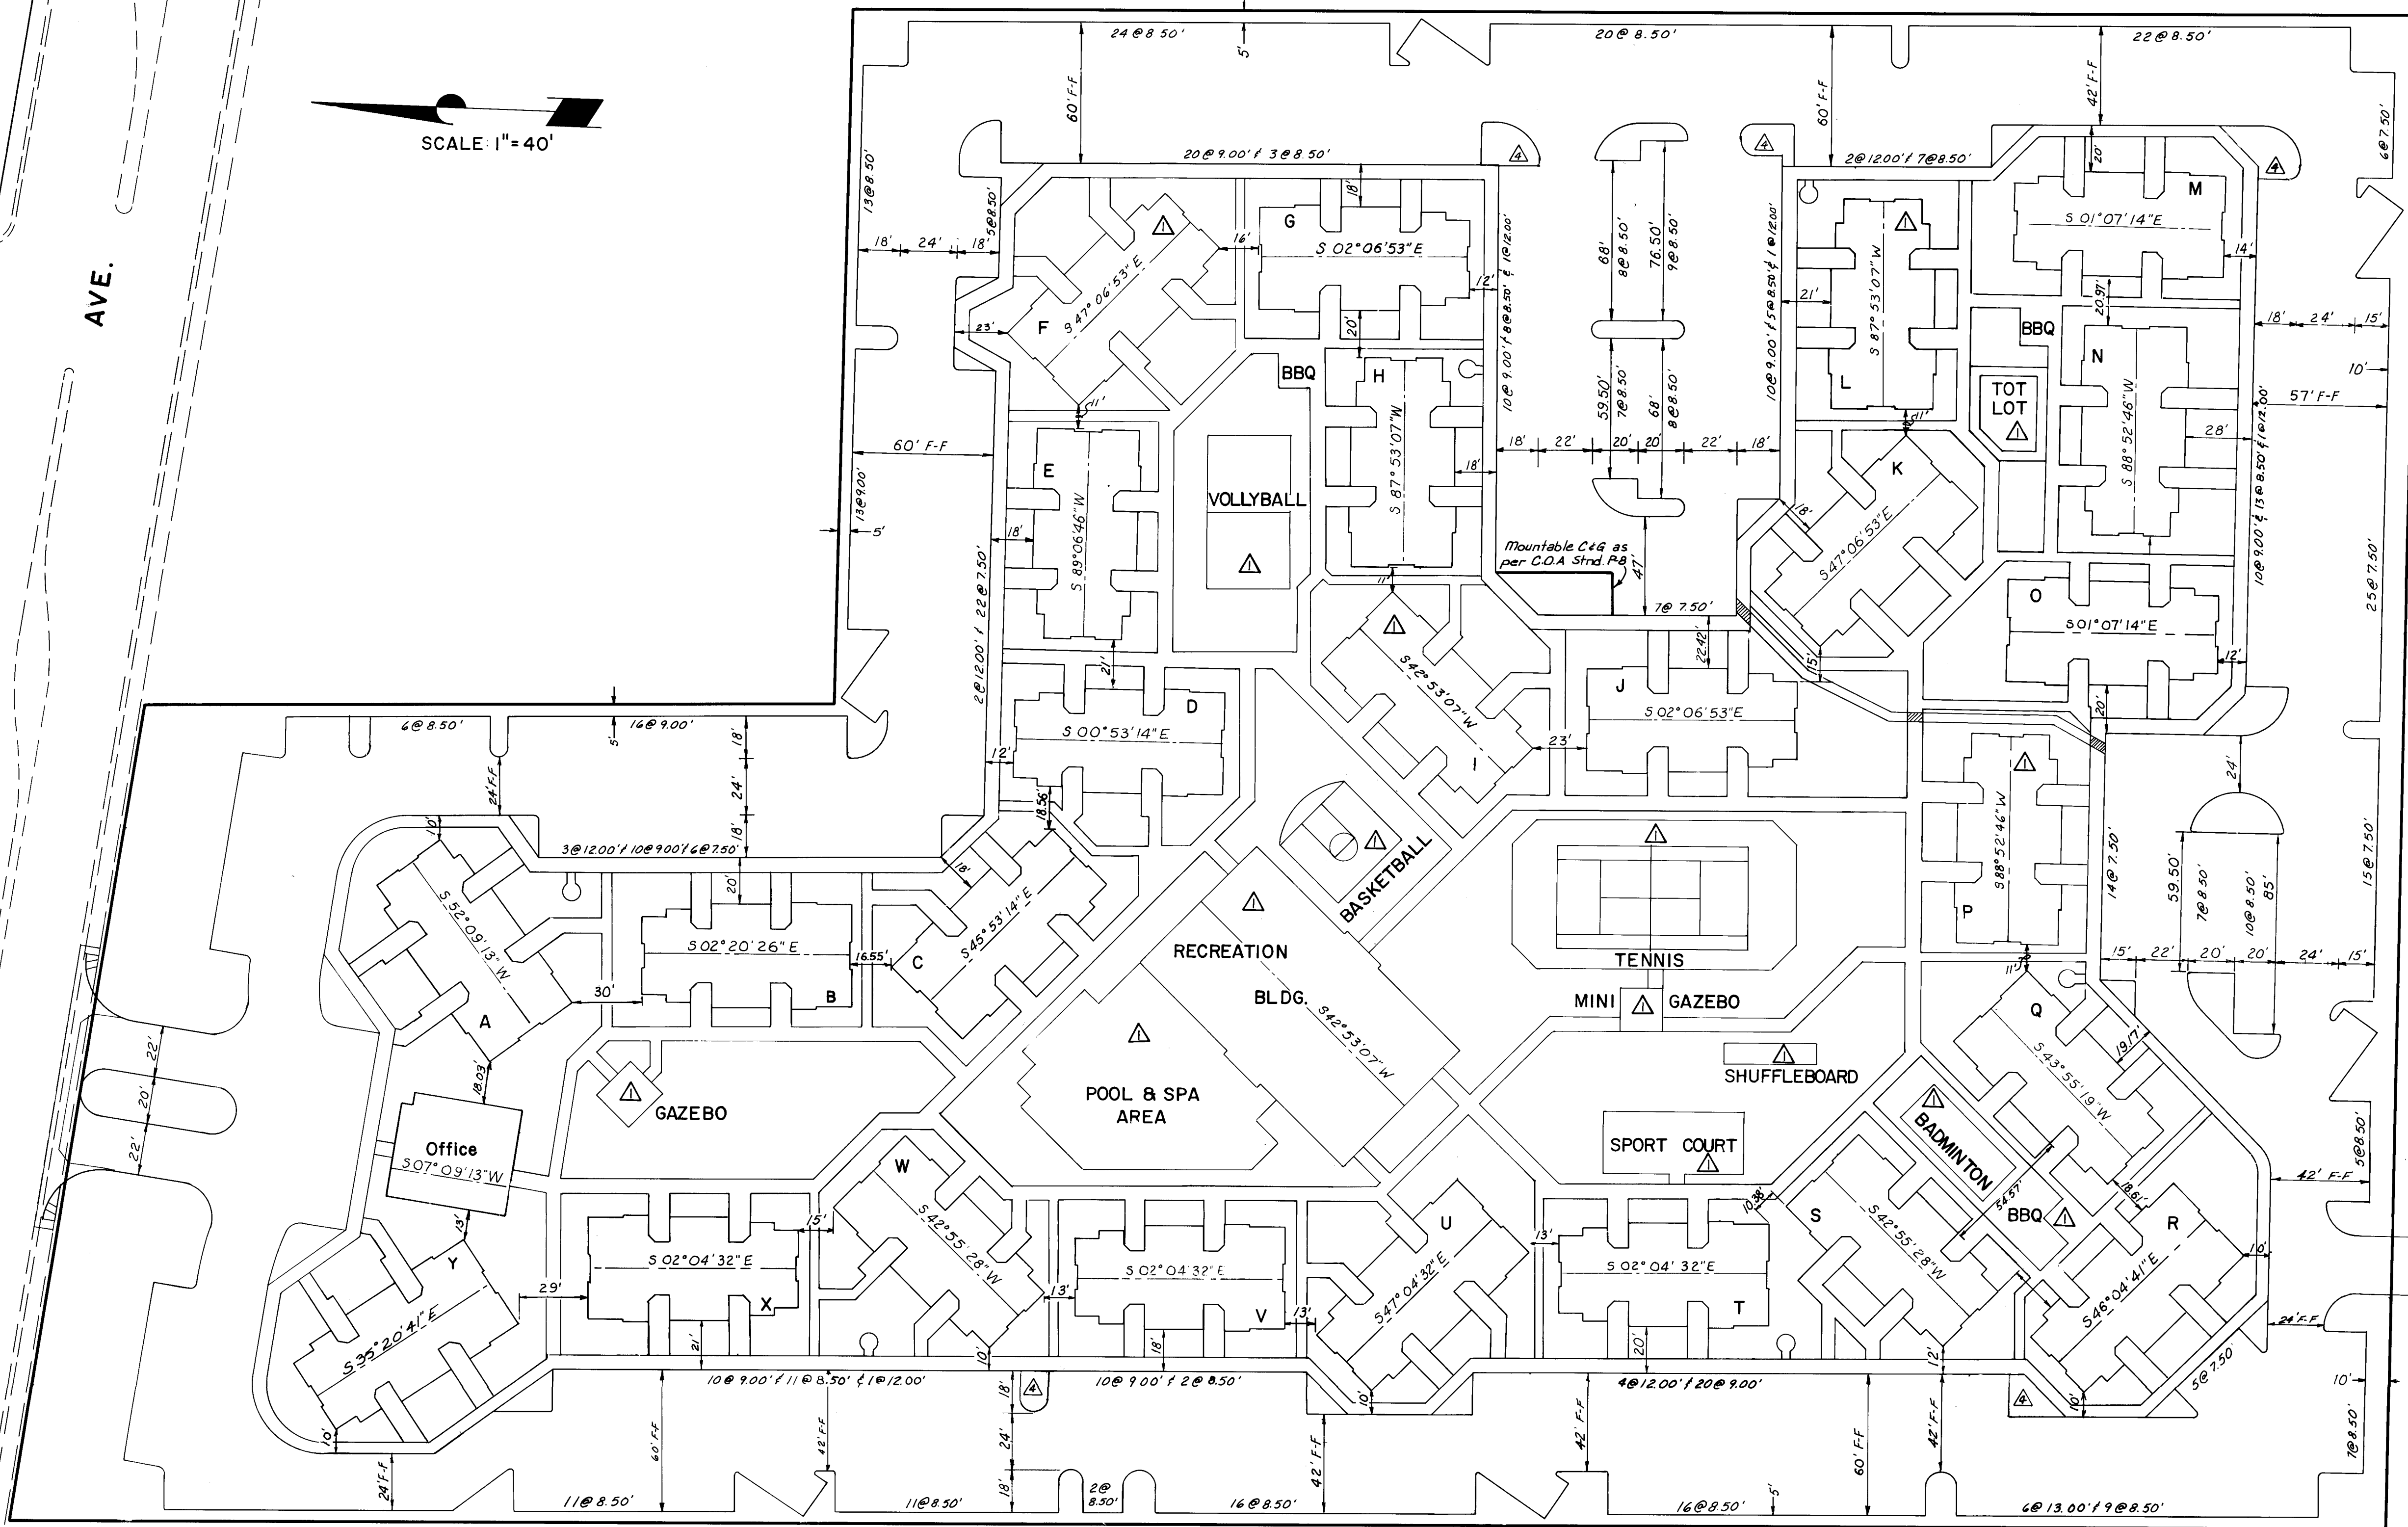

Note All curb dimensions
are from face of curb.

S.E.

ROAD

ZUNI

MESILLA ST. S.E.

CHAMA ST. S.E.

ENGINEER'S SEAL			SURVEY INFORMATION			BENCH MARKS			AS BUILT INFORMATION			
			FIELD NOTES				The station is a standard A.C.S. brass tablet stamped "7+K/9" located at the intersection of Central Ave. & Louisiana Blvd. The station is 65.5' east of the centerline of Louisiana & 25.7' south of the centerline of the west bound lanes of Central, located on the nose of the median. Elevation = 5323.308 ft.					
			BY		DATE							
			DTM									
			DESIGN			REVISIONS			MICRO-FILM INFORMATION			
			DESIGNED BY GWT/JAJ			DATE JAN '86			RECORDED BY			
			DRAWN BY ELO/JCR			DATE JAN '86			NO.			
			CHECKED BY LCG/TJM			DATE JAN '86						

CITY OF ALBUQUERQUE MUNICIPAL DEVELOPMENT DEPARTMENT ENGINEERING DIVISION	
TITLE: SUNPUEBLO APARTMENTS SITE PLAN	
NOT IN WORK ORDER FOR INFORMATION ONLY	
DRAWING NO. 2814	SHEET 5 OF 13
MAP NO. K19	D.T.M. JOB No. 812.22

P.C. 28140586


LINE TABLE

LINE	BEARING	DISTANCE	LINE	BEARING	DISTANCE
L1	N 7°09'13" E	11.50	L81	N 89°08'46" E	6.50
L2	N 1°07'14" W	11.45	L82	S 87°53'07" E	17.00
L3	S 1°07'14" E	11.25	L83	N 87°53'07" E	17.00
L4	S 1°04'41" E	28.76	L84	N 2°06'53" E	17.00
L5	N 1°04'41" W	25.76	L85	S 2°06'53" E	47.50
L6	N 32°25'28" E	39.68	L86	S 87°53'07" W	16.00
L7	N 87°39'34" E	14.21	L87	S 2°06'53" E	52.50
L8	S 87°39'34" W	17.00	L88	N 87°53'07" E	5.11
L9	S 87°55'28" W	14.50	L89	S 2°06'53" E	17.00
L10	N 89°08'46" E	3.72	L90	N 2°06'53" W	17.50
L11	N 55°53'14" W	6.38	L91	S 2°06'53" E	15.15
L12	N 34°06'46" E	18.00	L92	S 87°53'07" W	17.00
L13	S 55°53'14" E	33.68	L93	N 87°53'07" E	17.00
L14	N 0°53'14" E	18.50	L94	N 1°07'14" W	12.00
L15	S 0°53'14" E	12.00	L95	S 1°07'14" E	17.00
L16	N 0°53'14" W	12.00	L96	N 1°07'14" W	55.25
L17	S 0°53'14" E	17.00	L97	S 1°07'14" E	14.00
L18	N 87°53'07" E	17.00	L98	N 88°52'46" W	14.02
L19	S 87°53'07" W	17.00	L99	N 43°55'19" E	13.58
L20	S 2°06'53" E	6.35	L100	N 48°04'41" W	37.50
L21	N 32°53'07" E	5.99	L101	S 43°55'19" W	13.59
L22	S 57°06'53" E	18.00	L102	N 87°55'28" E	17.00
L23	S 32°53'07" W	33.68	L103	S 87°55'28" W	17.00
L24	N 87°53'07" E	16.50	L104	N 87°55'28" E	17.00
L25	S 87°53'06" W	14.39	L105	S 87°55'28" W	17.72
L26	N 87°53'07" E	14.39	L106	N 87°55'28" E	17.72
L27	S 87°53'07" W	17.00	L107	S 87°55'28" W	17.00
L28	S 1°07'14" E	17.00	L108	N 2°04'32" W	25.48
L29	S 88°52'46" W	45.00	L109	N 37°50'47" W	30.78
L30	N 1°07'14" W	14.50	L110		
L31	S 88°52'46" W	6.35	L111		
L32	S 56°07'14" E	5.99	L112		
L33	S 33°52'46" W	18.50	L113		
L34	N 56°07'14" W	33.68	L114		
L35	S 1°07'14" E	13.50	L115		
L36	N 87°55'28" E	15.68	L116		
L37	N 37°50'47" W	30.04	L117		
L38	S 1°04'41" E	16.00	L118		
L39	S 56°07'14" E	6.00	L119		
L40	S 33°55'19" W	18.00	L120	S 7°09'13" W	47.00
L41	N 56°04'41" W	33.68	L121	N 2°06'53" E	19.00
L42	S 1°04'41" E	18.50	L122	S 87°53'07" W	32.50
L43	S 87°55'28" W	17.00	L123	N 2°06'53" W	18.35
L44	N 87°55'28" E	16.00	L124	S 2°06'53" E	13.50
L45	N 87°55'28" W	17.00	L125	N 2°06'53" W	32.50
L46	N 2°04'32" W	19.97	L126	S 2°06'53" E	32.50
L47	S 32°55'28" W	5.99	L127	S 2°06'53" E	18.33
L48	N 57°04'32" W	18.00	L128	S 87°53'07" W	9.50
L49	N 32°55'28" W	33.68	L129	S 2°06'53" E	16.25
L50	S 87°55'28" W	16.50	L130	N 2°06'53" W	16.25
L51	N 87°55'28" E	11.25	L131	N 1°07'14" W	87.38
L52	S 87°55'28" W	11.25	L132	S 1°07'14" E	19.00
L53	N 2°04'32" W	6.72	L133	S 88°52'46" W	25.50
L54	S 32°55'28" W	5.99	L134	N 87°55'28" E	19.00
L55	N 57°04'32" W	18.00	L135	N 43°55'19" E	23.95
L56	N 7°09'13" E	16.00	L136	S 2°06'53" E	2.34
L57	S 7°09'13" W	16.00	L137	S 2°20'26" E	51.00
L58	N 7°09'13" W	16.00	L138	S 88°55'19" W	42.50
L59	N 87°39'34" W	16.00	L139	N 1°04'41" W	15.00
L60	S 87°39'34" E	25.50	L140	S 88°55'19" W	59.00
L61	S 2°20'26" E	53.76	L141	S 87°55'28" W	17.00
L62	S 2°20'26" E	53.76	L142	S 87°39'34" W	14.21
L63	N 7°09'13" E	31.58	L143	N 87°55'28" E	13.00
L64	N 7°09'13" W	15.24	L144	S 87°55'28" W	13.00
L65	S 7°09'13" W	15.91	L145	S 87°55'28" W	13.00
L66	S 88°50'47" E	31.93	L146	N 2°04'32" W	17.00
L67	N 56°04'32" W	46.72	L147	N 87°55'28" E	13.00
L68			L148	S 87°55'28" W	13.00
L69			L149		
L70			L150	N 87°55'28" E	17.00
L71			L151		
L72			L152	N 1°07'14" W	10.68
L73	S 87°39'34" W	16.00			
L74	N 87°39'34" E	16.00			
L75	S 0°53'14" E	16.00			
L76	N 0°53'14" W	16.00			
L77	N 89°08'46" E	35.13			
L78	S 0°53'14" E	16.00			
L79	N 89°08'46" E	42.50			
L80	N 0°53'14" W	16.00			

SCALE: 1" = 40'


CURVE TABLE

CURVE	ARC	DELTA	RADIUS	FAIR LENGTH
C1	39.27	90°00'00"	39.27	39.27
C2	11.77	180°00'00"	11.77	11.77
C3	2.78	173°50'00"	2.78	2.78
C4	11.90	180°00'00"	11.90	11.90
C5	1.57	90°00'00"	1.57	1.57
C6	22.59	88°52'46"	22.59	22.59
C7	1.57	90°00'00"	1.57	1.57
C8	18.31	180°00'00"	18.31	18.31
C9	3.18	81°13'39"	3.18	3.18
C10	1.57	90°00'00"	1.57	1.57
C11	2.53	125°00'00"	2.53	2.53
C12	1.57	90°00'00"	1.57	1.57
C13	11.34	180°00'00"	11.34	11.34
C14	1.57	90°00'00"	1.57	1.57
C15	3.87	80°00'00"	3.87	3.87
C16	2.18	125°00'00"	2.18	2.18
C17	1.57	90°00'00"	1.57	1.57
C18	2.18	125°00'00"	2.18	2.18
C19	2.18	125°00'00"	2.18	2.18
C235	2.18	125°00'00"	2.18	

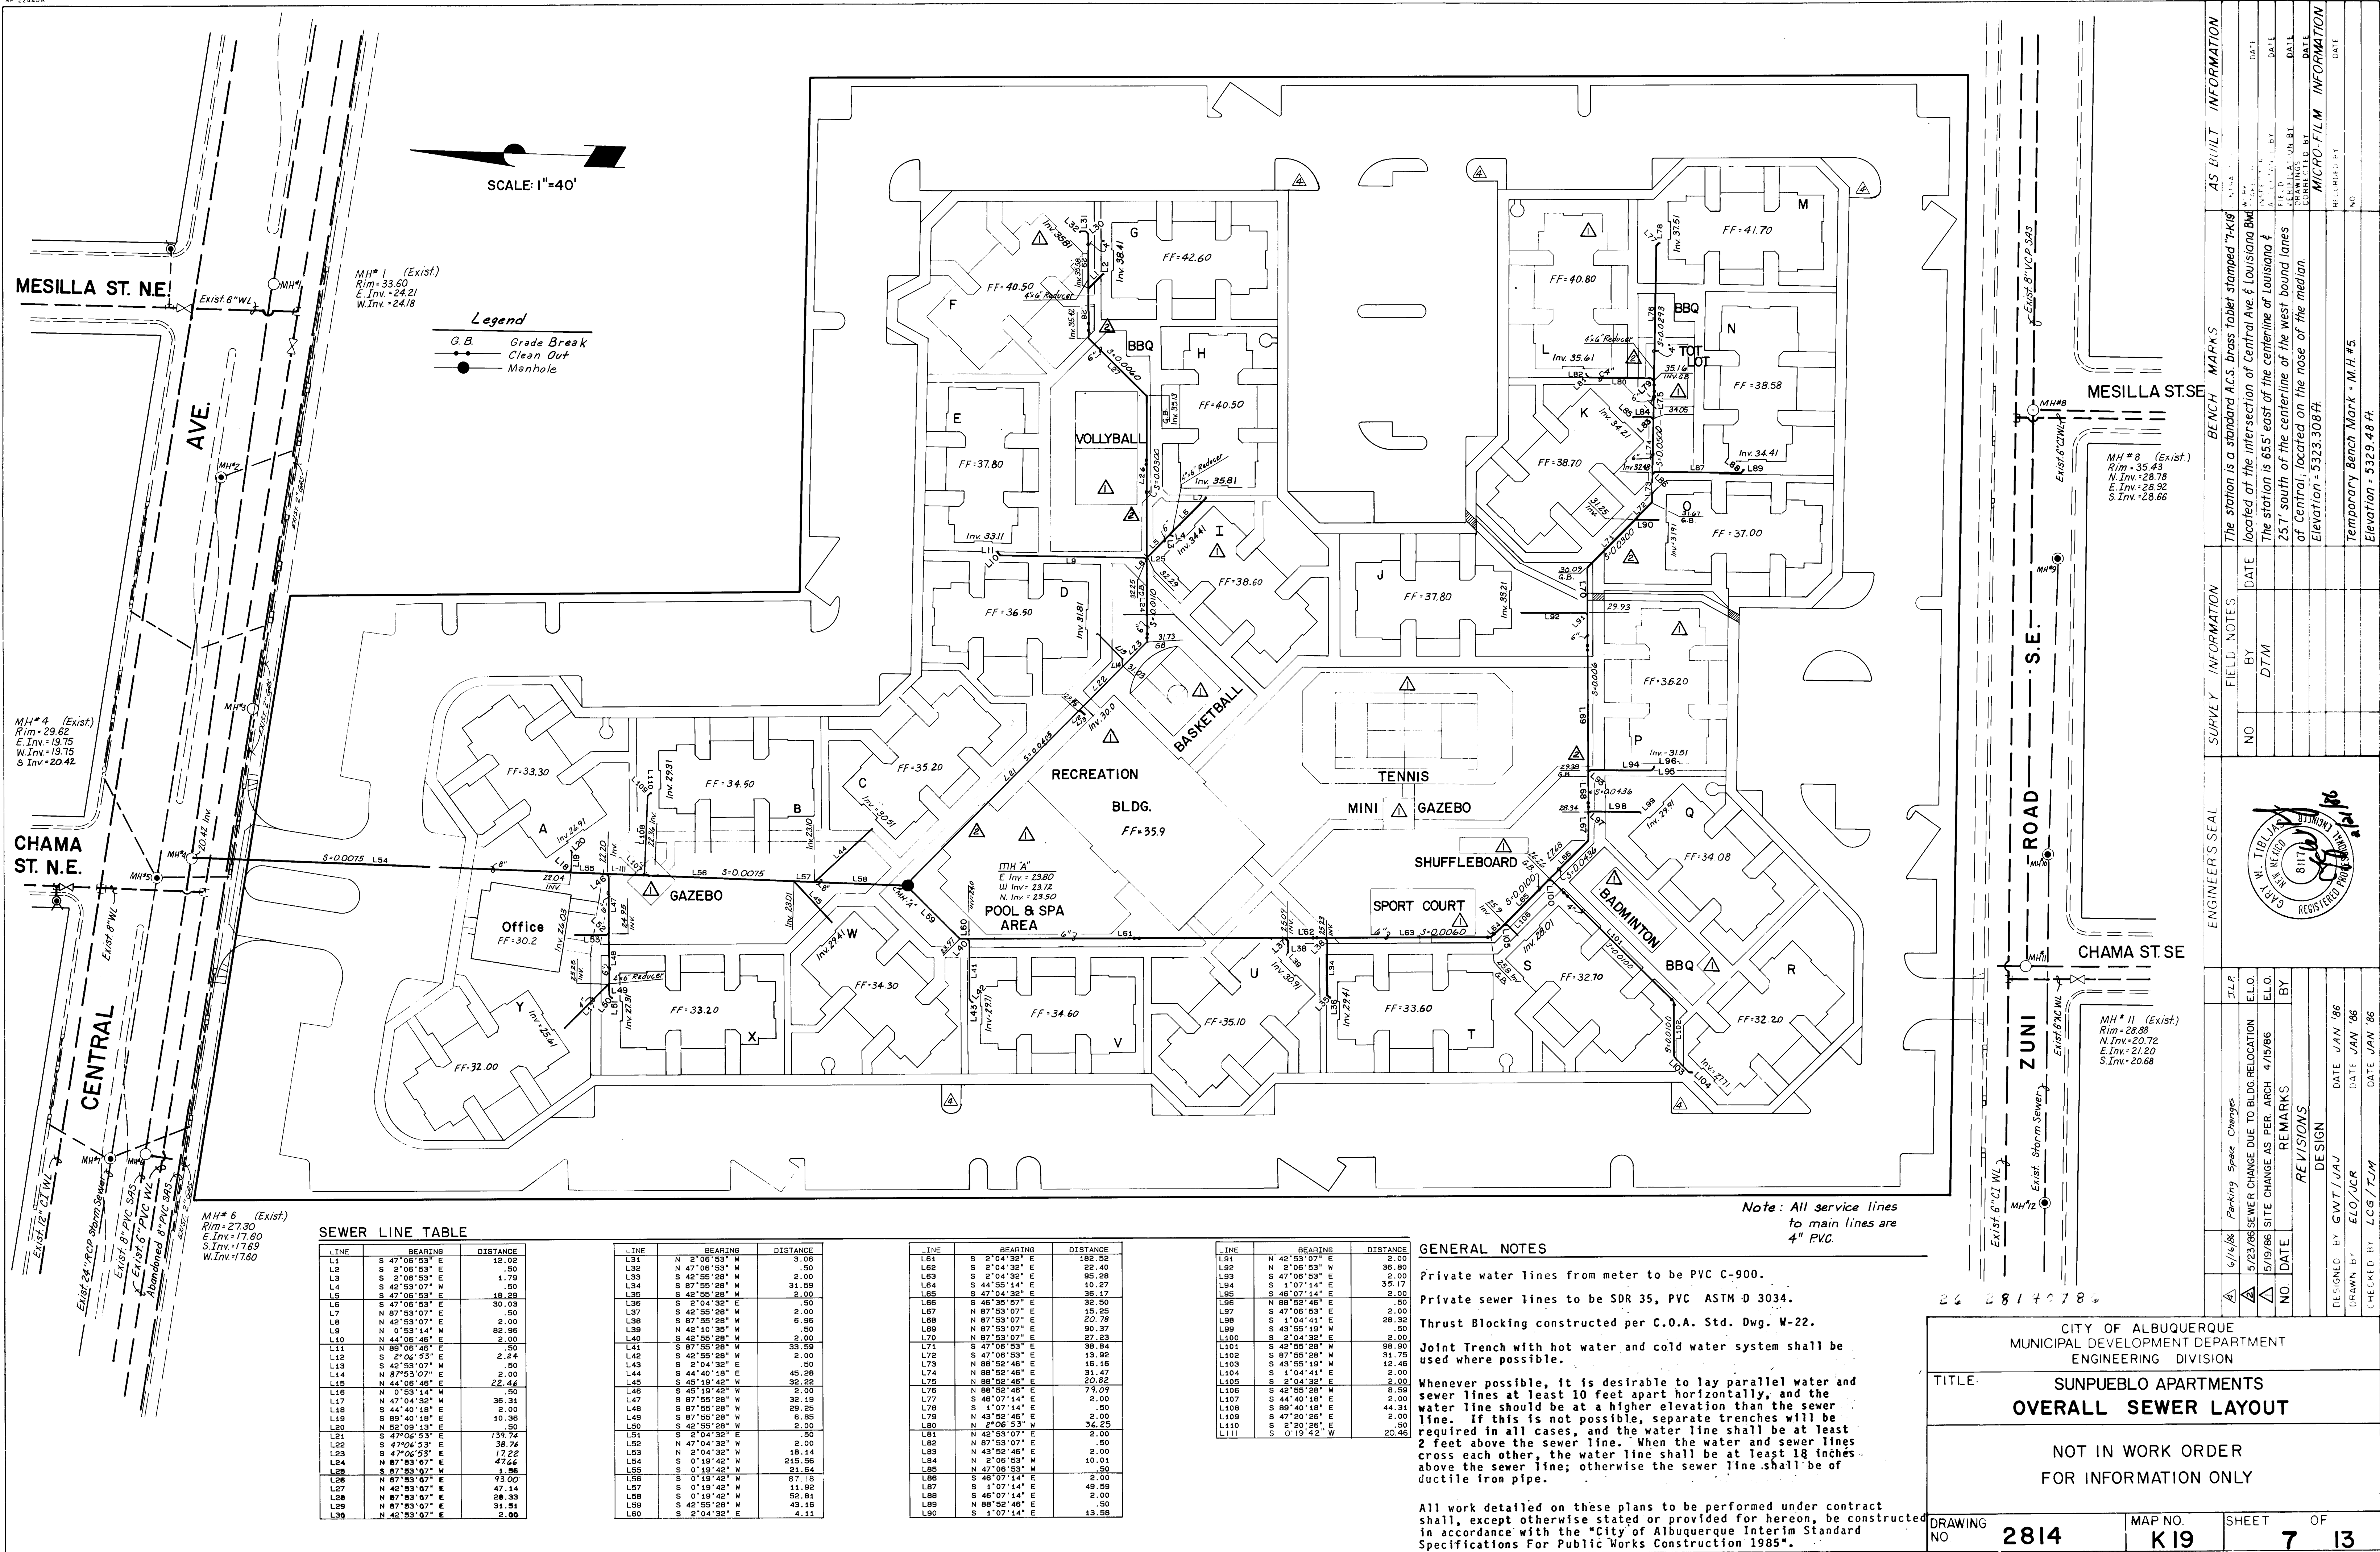

ENGINEER'S SEAL		SURVEY INFORMATION		BENCH MARKS		AS BUILT INFORMATION	
DATE	BY	NO.	DTM	DATE	BY	DATE	BY
		The station is a standard A.C.S. brass tablet stamped "K-18" located at the intersection of Central Ave. & Louisiana Blvd. The station is 65' east of the centerline of Louisiana & 25' south of the centerline of the west bound lanes of Central, located on the nose of the median. Elevation = 5323.308 ft.		The station is a standard A.C.S. brass tablet stamped "K-18" located at the intersection of Central Ave. & Louisiana Blvd. The station is 65' east of the centerline of Louisiana & 25' south of the centerline of the west bound lanes of Central, located on the nose of the median. Elevation = 5323.308 ft.		The station is a standard A.C.S. brass tablet stamped "K-18" located at the intersection of Central Ave. & Louisiana Blvd. The station is 65' east of the centerline of Louisiana & 25' south of the centerline of the west bound lanes of Central, located on the nose of the median. Elevation = 5323.308 ft.	
DESIGNED BY GWT/JAJ		DATE JAN '86		DRAWN BY ELO/JCR		DATE JAN '86	
CHECKED BY LCG/TJM		DATE JAN '86					

CITY OF ALBUQUERQUE MUNICIPAL DEVELOPMENT DEPARTMENT ENGINEERING DIVISION			
TITLE: SUNPUEBLO APARTMENTS OVERALL SEWER LAYOUT			
NOT IN WORK ORDER FOR INFORMATION ONLY			
DRAWING NO.	2814	MAP NO.	K19
SHEET	7	OF	13
D.T.M. JOB NO. 812.22			

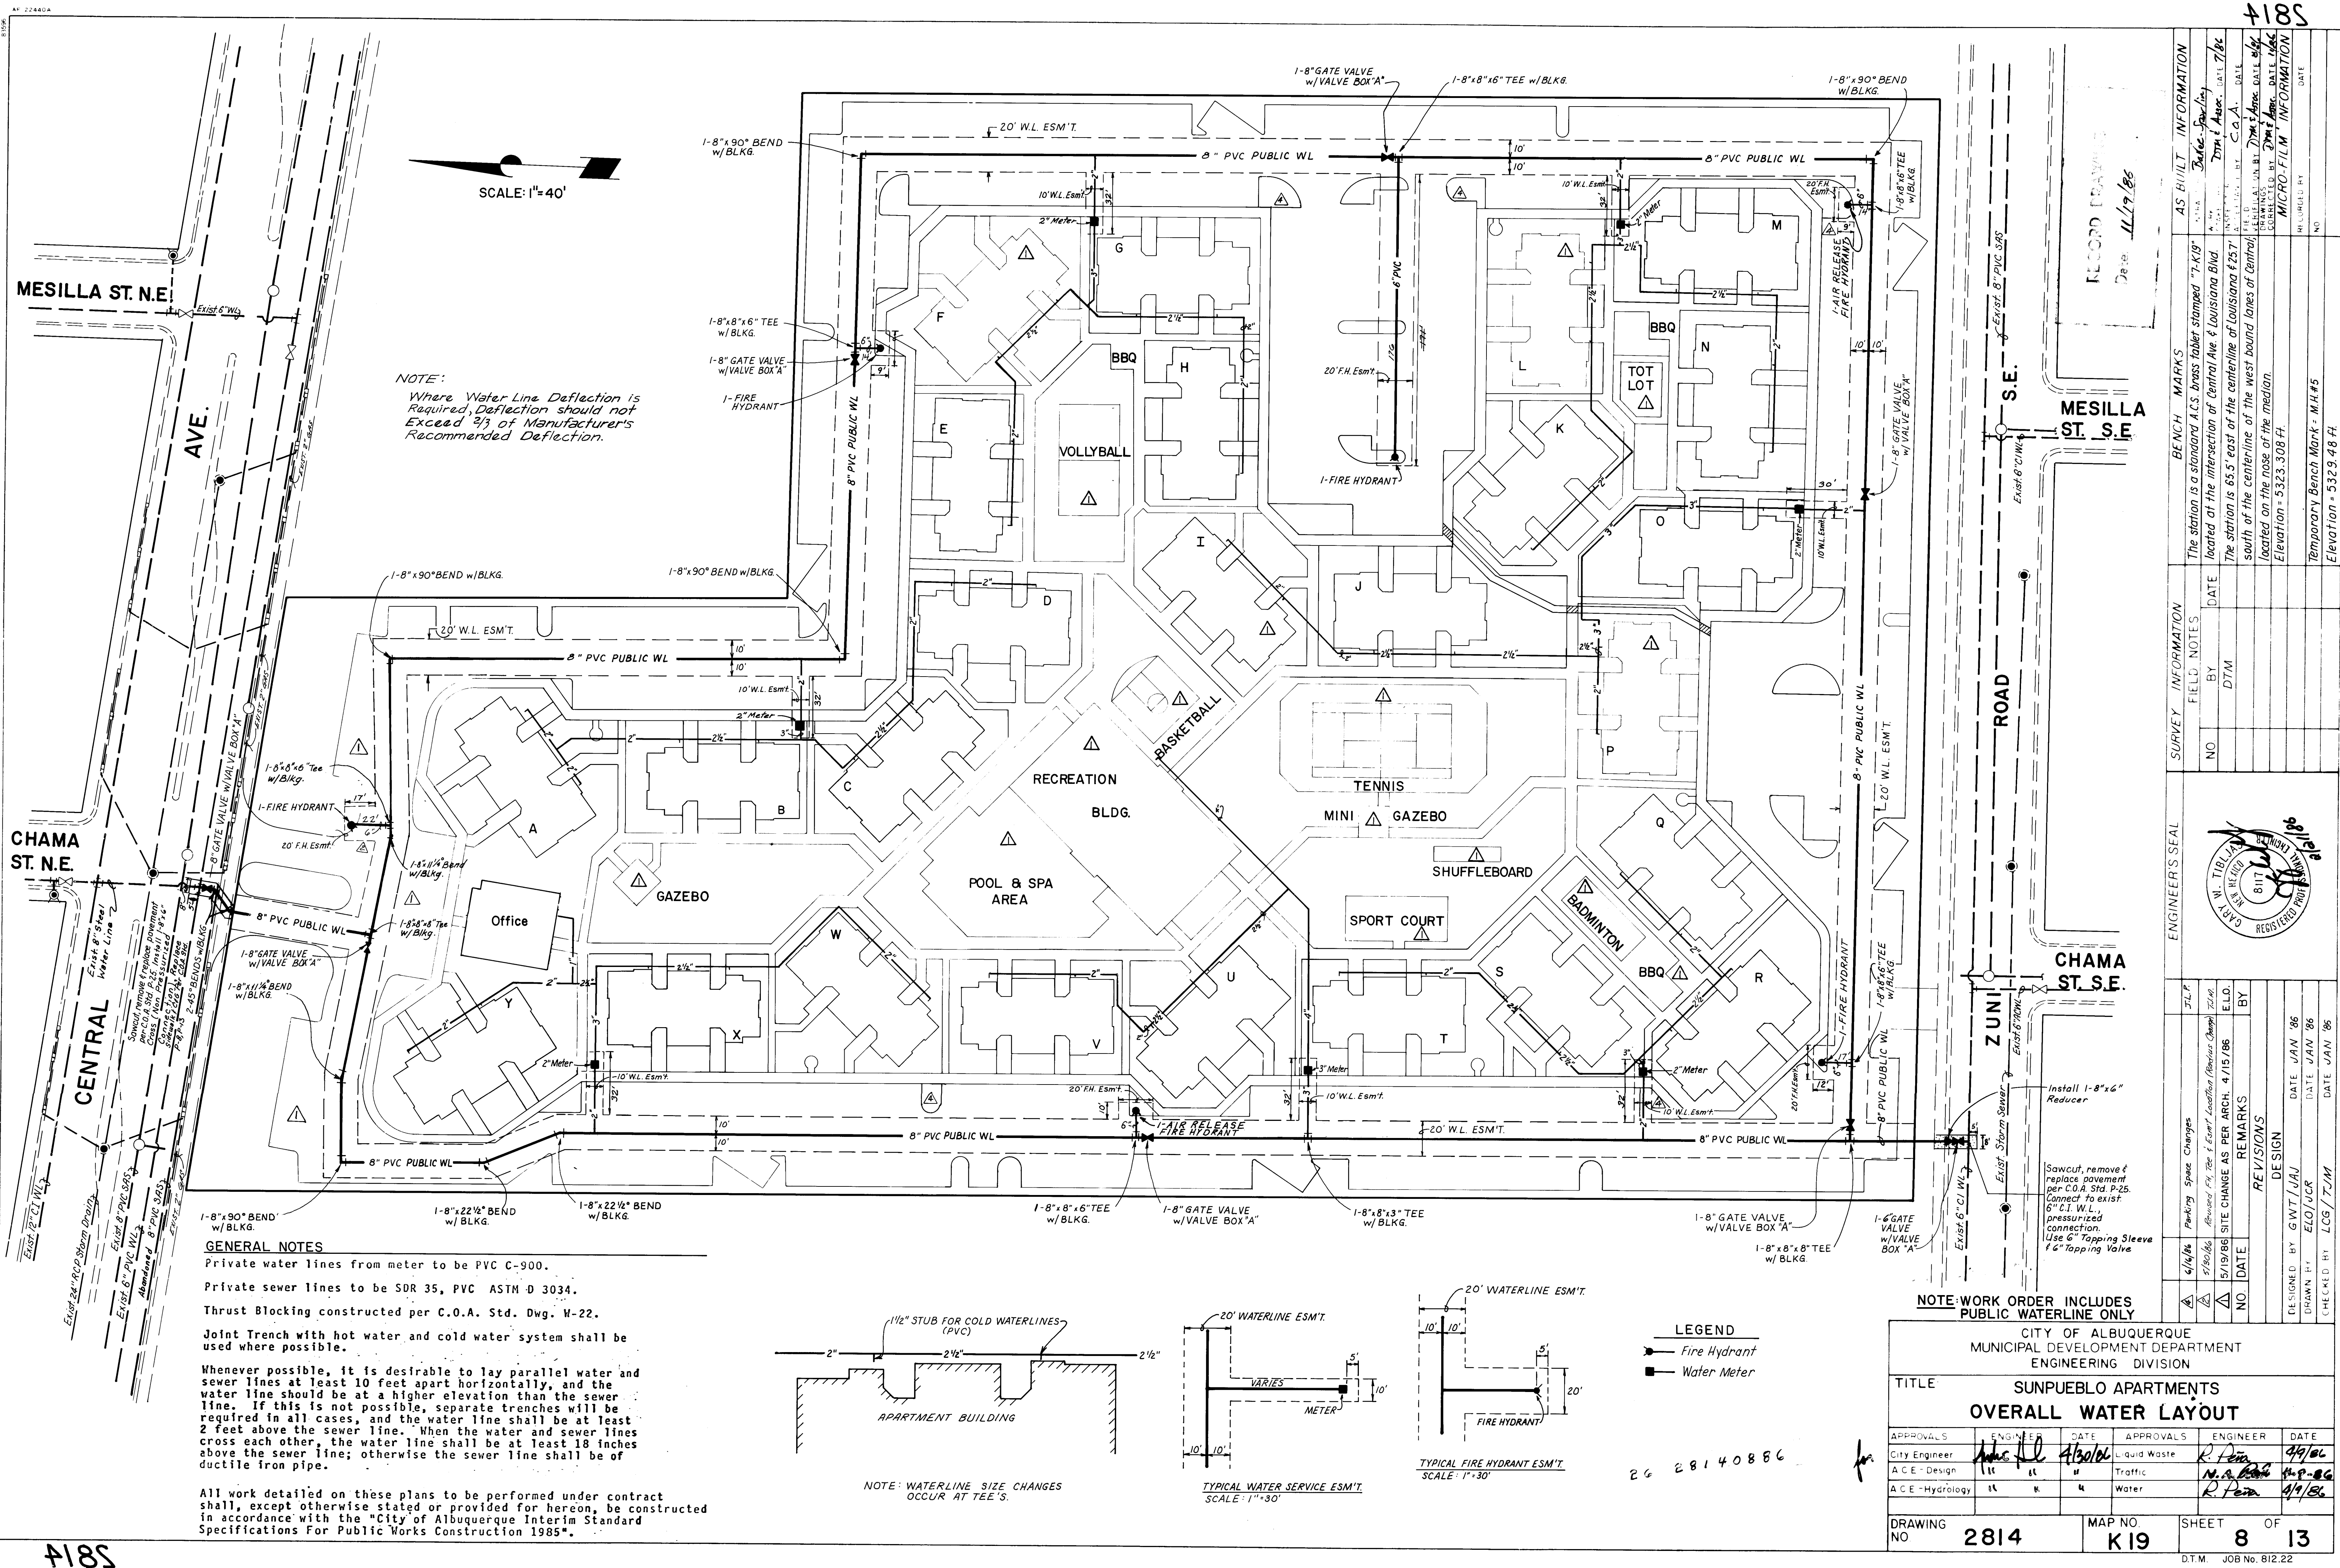

GENERAL NOTES

Private water lines from meter to be PVC C-900.


Private sewer lines to be SDR 35, PVC ASTM D 3034.

Thrust Blocking constructed per C.O.A. Std. Dwg. W-22.

Joint Trench with hot water and cold water system shall be used where possible.

Whenever possible, it is desirable to lay parallel water and sewer lines at least 10 feet apart horizontally, and the water line should be at a higher elevation than the sewer line. If this is not possible, separate trenches will be required in all cases, and the water line shall be at least 2 feet above the sewer line. When the water and sewer lines cross each other, the water line shall be at least 18 inches above the sewer line; otherwise the sewer line shall be of ductile iron pipe.



All work detailed on these plans to be performed under contract shall, except otherwise stated or provided for hereon, be constructed in accordance with the "City of Albuquerque Interim Standard Specifications For Public Works Construction 1985".

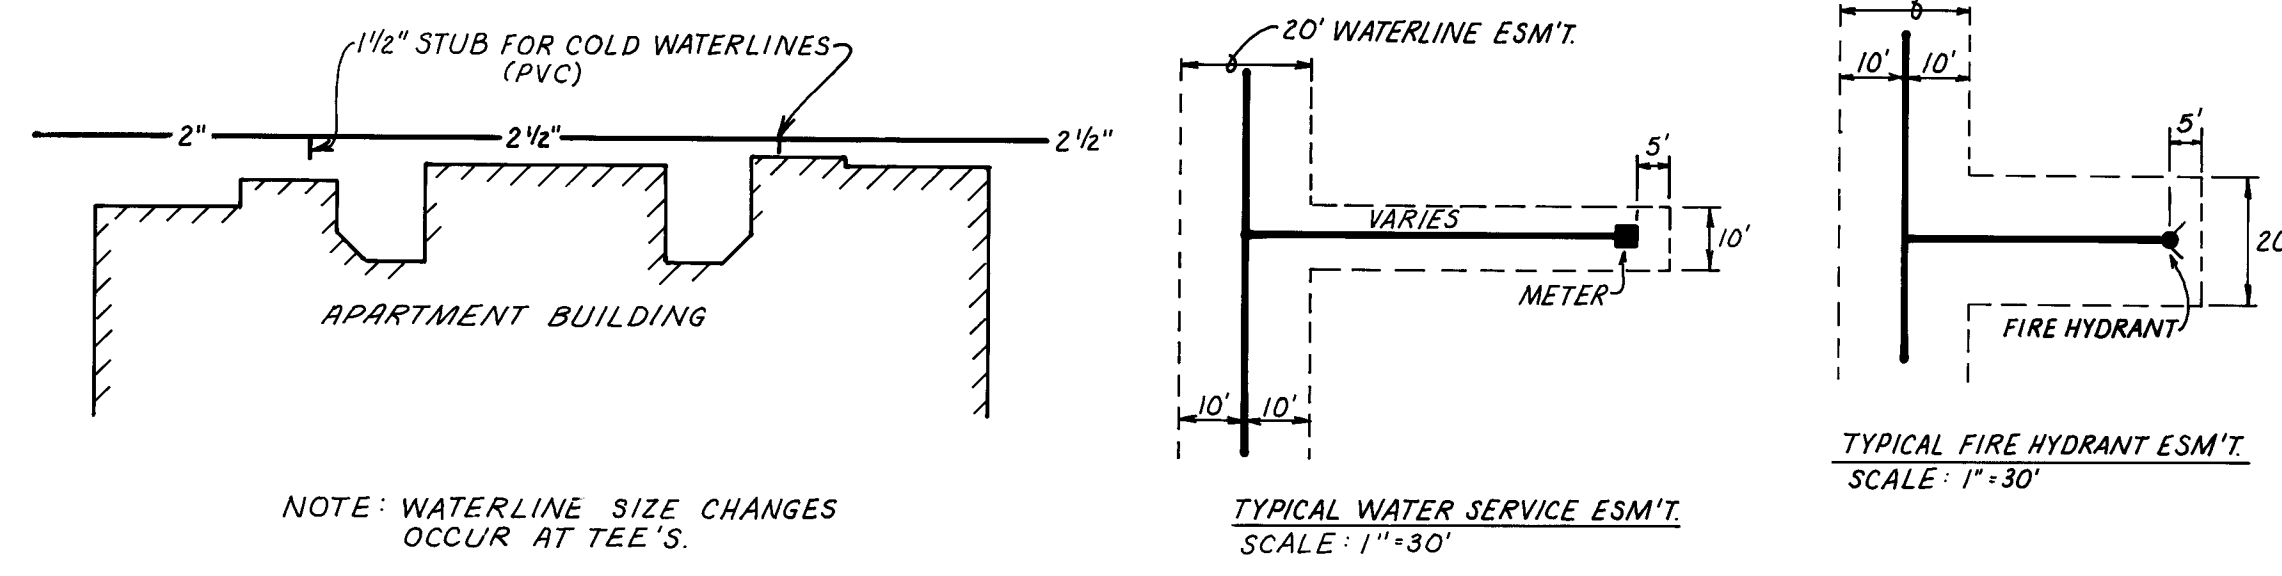

- LEGEND**
- Fire Hydrant
 - Water Meter

NOTE: WORK ORDER INCLUDES PUBLIC WATERLINE ONLY

CITY OF ALBUQUERQUE MUNICIPAL DEVELOPMENT DEPARTMENT ENGINEERING DIVISION					
TITLE: SUNPUEBLO APARTMENTS OVERALL WATER LAYOUT					
APPROVALS	ENGINEER	DATE	APPROVALS	ENGINEER	DATE
City Engineer	<i>[Signature]</i>	4/1/86	Liquid Waste	<i>[Signature]</i>	4/1/86
A.C.E. - Design	"	"	Traffic	<i>[Signature]</i>	4/1/86
A.C.E. - Hydrology	"	"	Water	<i>[Signature]</i>	4/1/86
DESIGNED BY: GWT/JAJ			DATE: JAN '86		
DRAWN BY: ELO/JCR			DATE: JAN '86		
CHECKED BY: LCB/TJM			DATE: JAN '86		
DRAWING NO.	2814	MAP NO.	K19	SHEET	8 OF 13
D.T.M. JOB No. 612.22					

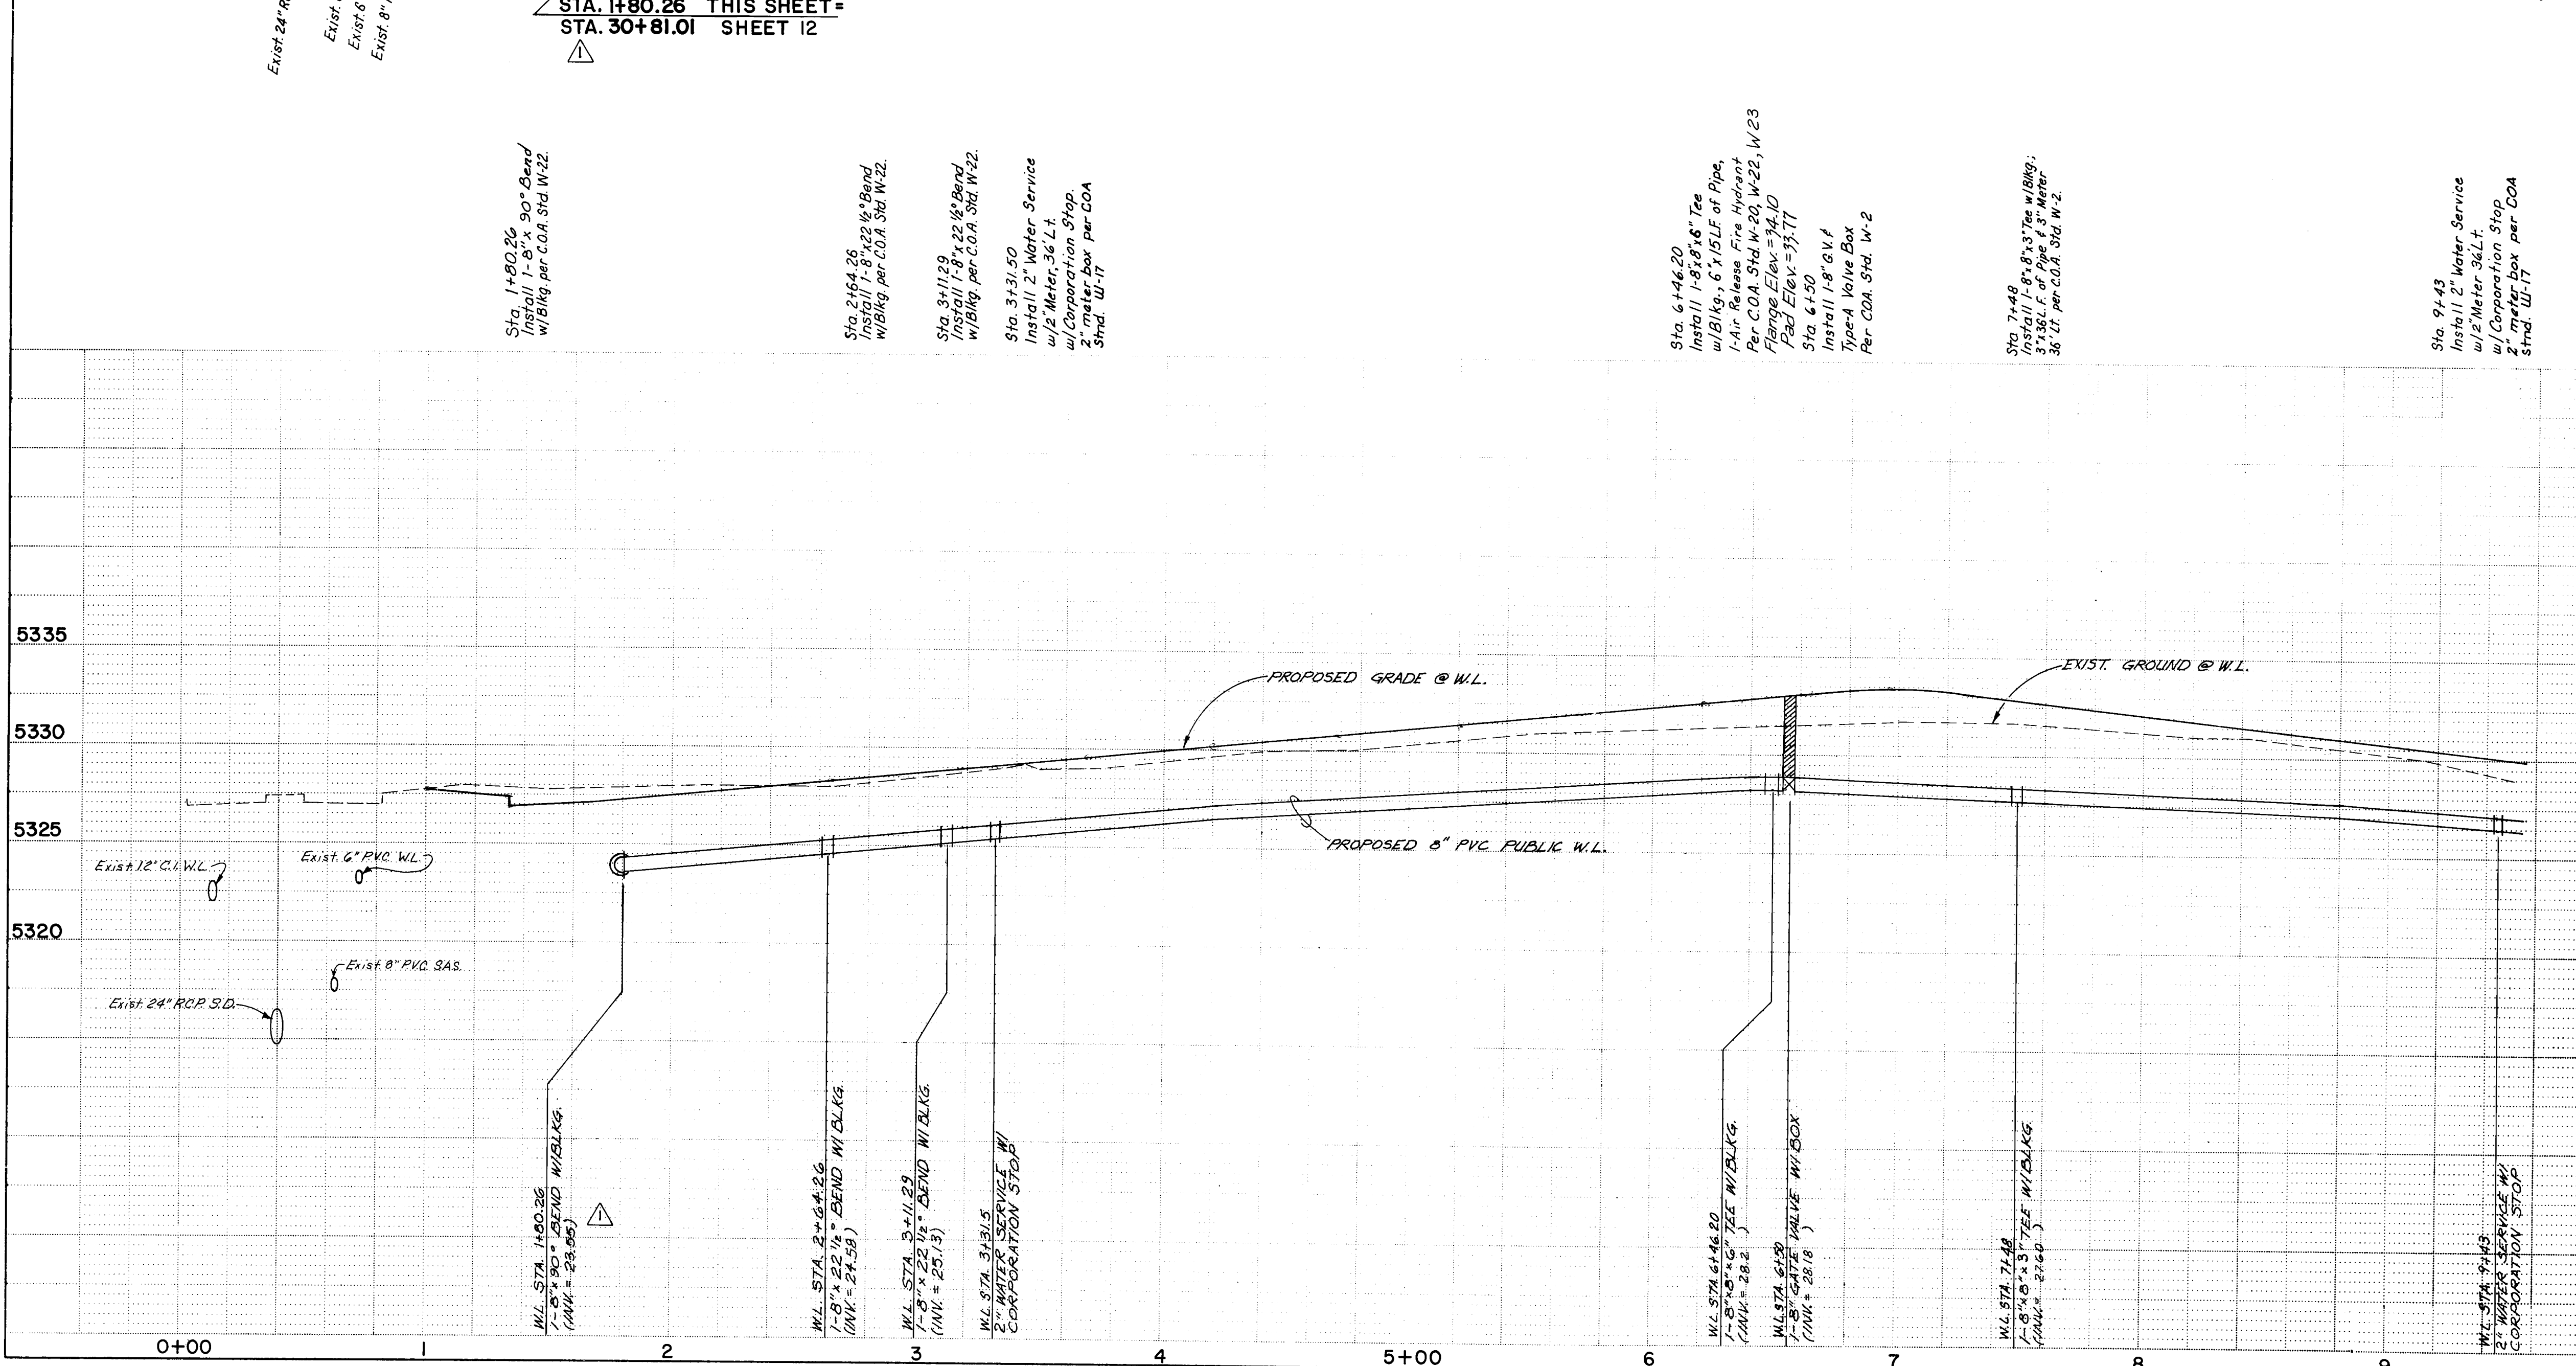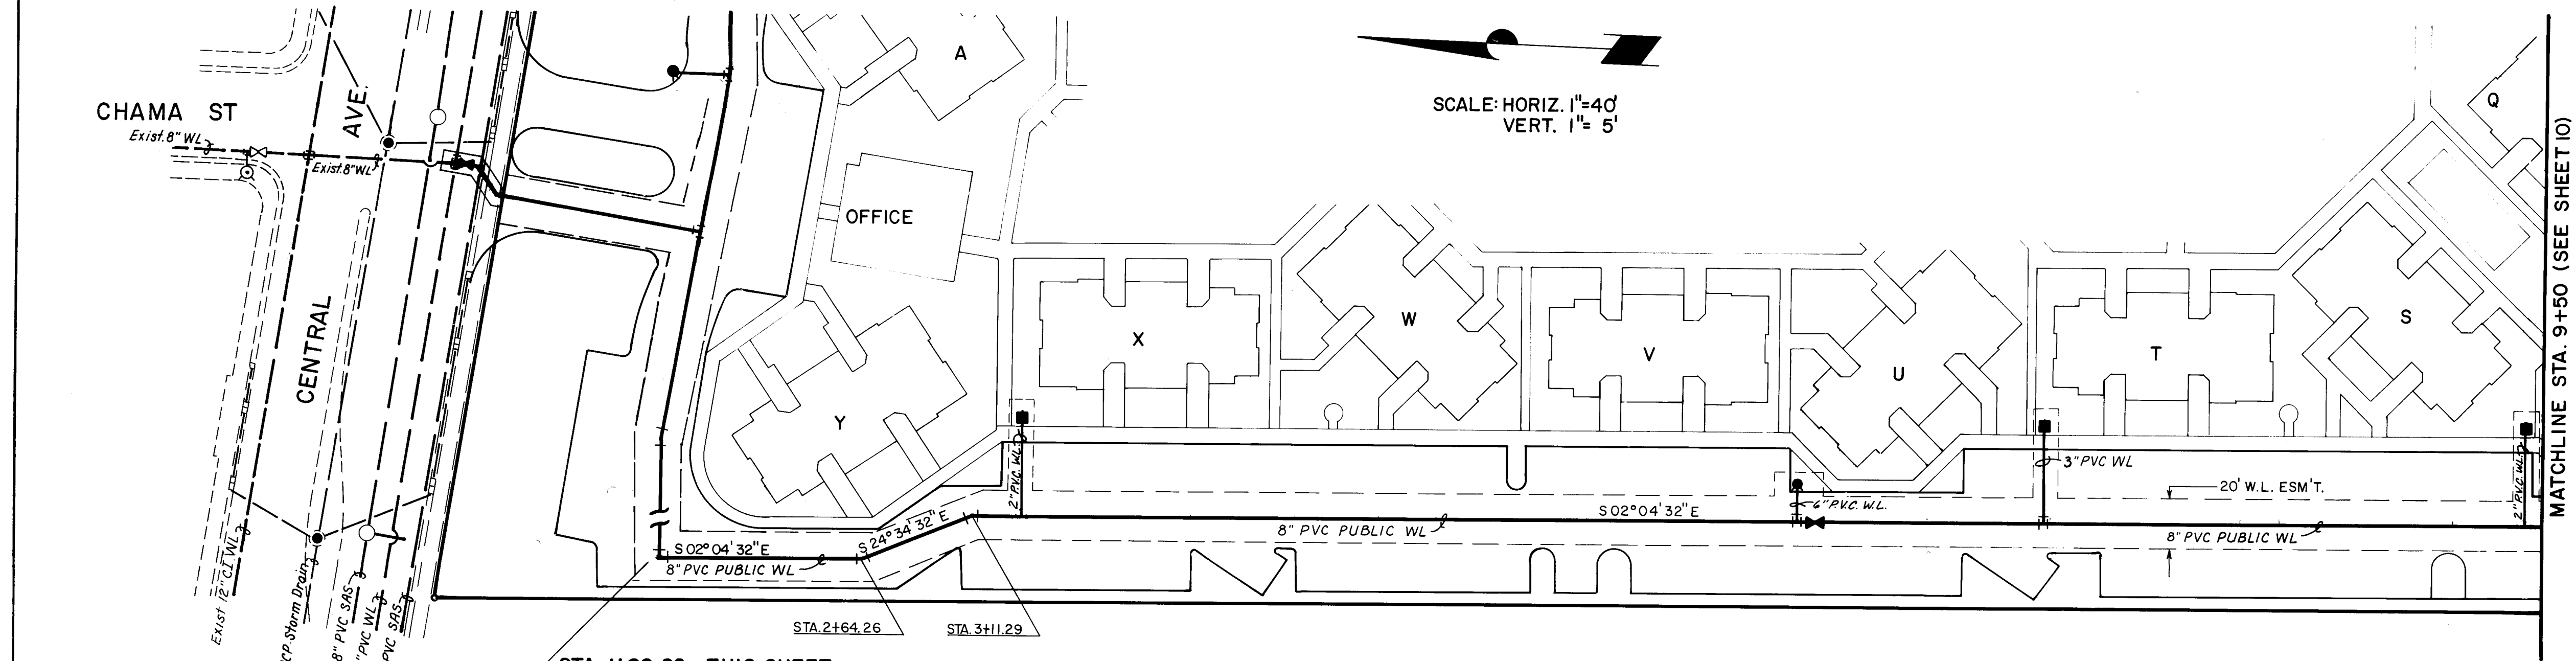


RECORD DRAWING
Date: 11/19/86

AS BUILT INFORMATION			BENCH MARKS			SURVEY INFORMATION			ENGINEER'S SEAL			REVISIONS			DESIGN		
The station is a standard ADS brass tablet stamped "7-K19" located at the intersection of Central Ave & Louisiana Blvd. The station is 255' east of the centerline of Louisiana & 257' south of the centerline of the west bound lanes of Central; located on the nose of the median. Elevation = 5323.308 ft.			Temporary Bench Mark = MH #5 Elevation = 5329.48 ft.			NO. BY DATE			W.L. Change @ Entry			NO. DATE			DESIGNED BY GMT, J.A.J.		
CONTRACTOR: Baker-Burley			WORKED BY: D.M. J. Agre			INSPECTED BY: C.O.A.			JDM BY			DATE JAN. 1986			DRAWN BY E.L.O.		
DATE: 7/86			DATE: 7/86			DATE: 7/86			CHECKED BY L.C.G., T.J.M.			DATE: 11/19/86			DATE: 11/19/86		
VERIFICATION BY: D.M. J. Agre			VERIFICATION BY: D.M. J. Agre			VERIFICATION BY: D.M. J. Agre			REMARKS			REMARKS			REMARKS		
MICRO-FILM INFORMATION			MICRO-FILM INFORMATION			MICRO-FILM INFORMATION			MICRO-FILM INFORMATION			MICRO-FILM INFORMATION			MICRO-FILM INFORMATION		

NOTE: WORK ORDER INCLUDES
PUBLIC WATERLINE ONLY.

CITY OF ALBUQUERQUE MUNICIPAL DEVELOPMENT DEPARTMENT ENGINEERING DIVISION					
TITLE: SUNPUEBLO APARTMENTS PUBLIC WATERLINE					
APPROVALS	ENGINEER	DATE	APPROVALS	ENGINEER	DATE
City Engineer	11/19/86	11/19/86	Liquid Waste	11/19/86	11/19/86
A.C.E. - Design	11/19/86	11/19/86	Traffic	11/19/86	11/19/86
A.C.E. - Hydrology	11/19/86	11/19/86	Water	11/19/86	11/19/86

DRAWING NO. 2814	MAP NO. K 19	SHEET 9 OF 13
------------------	--------------	---------------

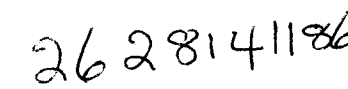



CITY OF ALBUQUERQUE
MUNICIPAL DEVELOPMENT DEPARTMENT
ENGINEERING DIVISION

APPROVALS	ENGINEER	DATE	APPROVALS	ENGINEER	DATE
City Engineer	<i>[Signature]</i>	<i>4/30/86</i>	Liquid Waste	<i>R. P. [Signature]</i>	<i>4/9/86</i>
A C E - Design	" "	"	Traffic	<i>M. A. [Signature]</i>	<i>4-9-86</i>
A C E - Hydrology	" "	"	Water	<i>R. P. [Signature]</i>	<i>4/9/86</i>


D.T.M. JOB NO. 812.22

[illegible]

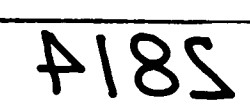


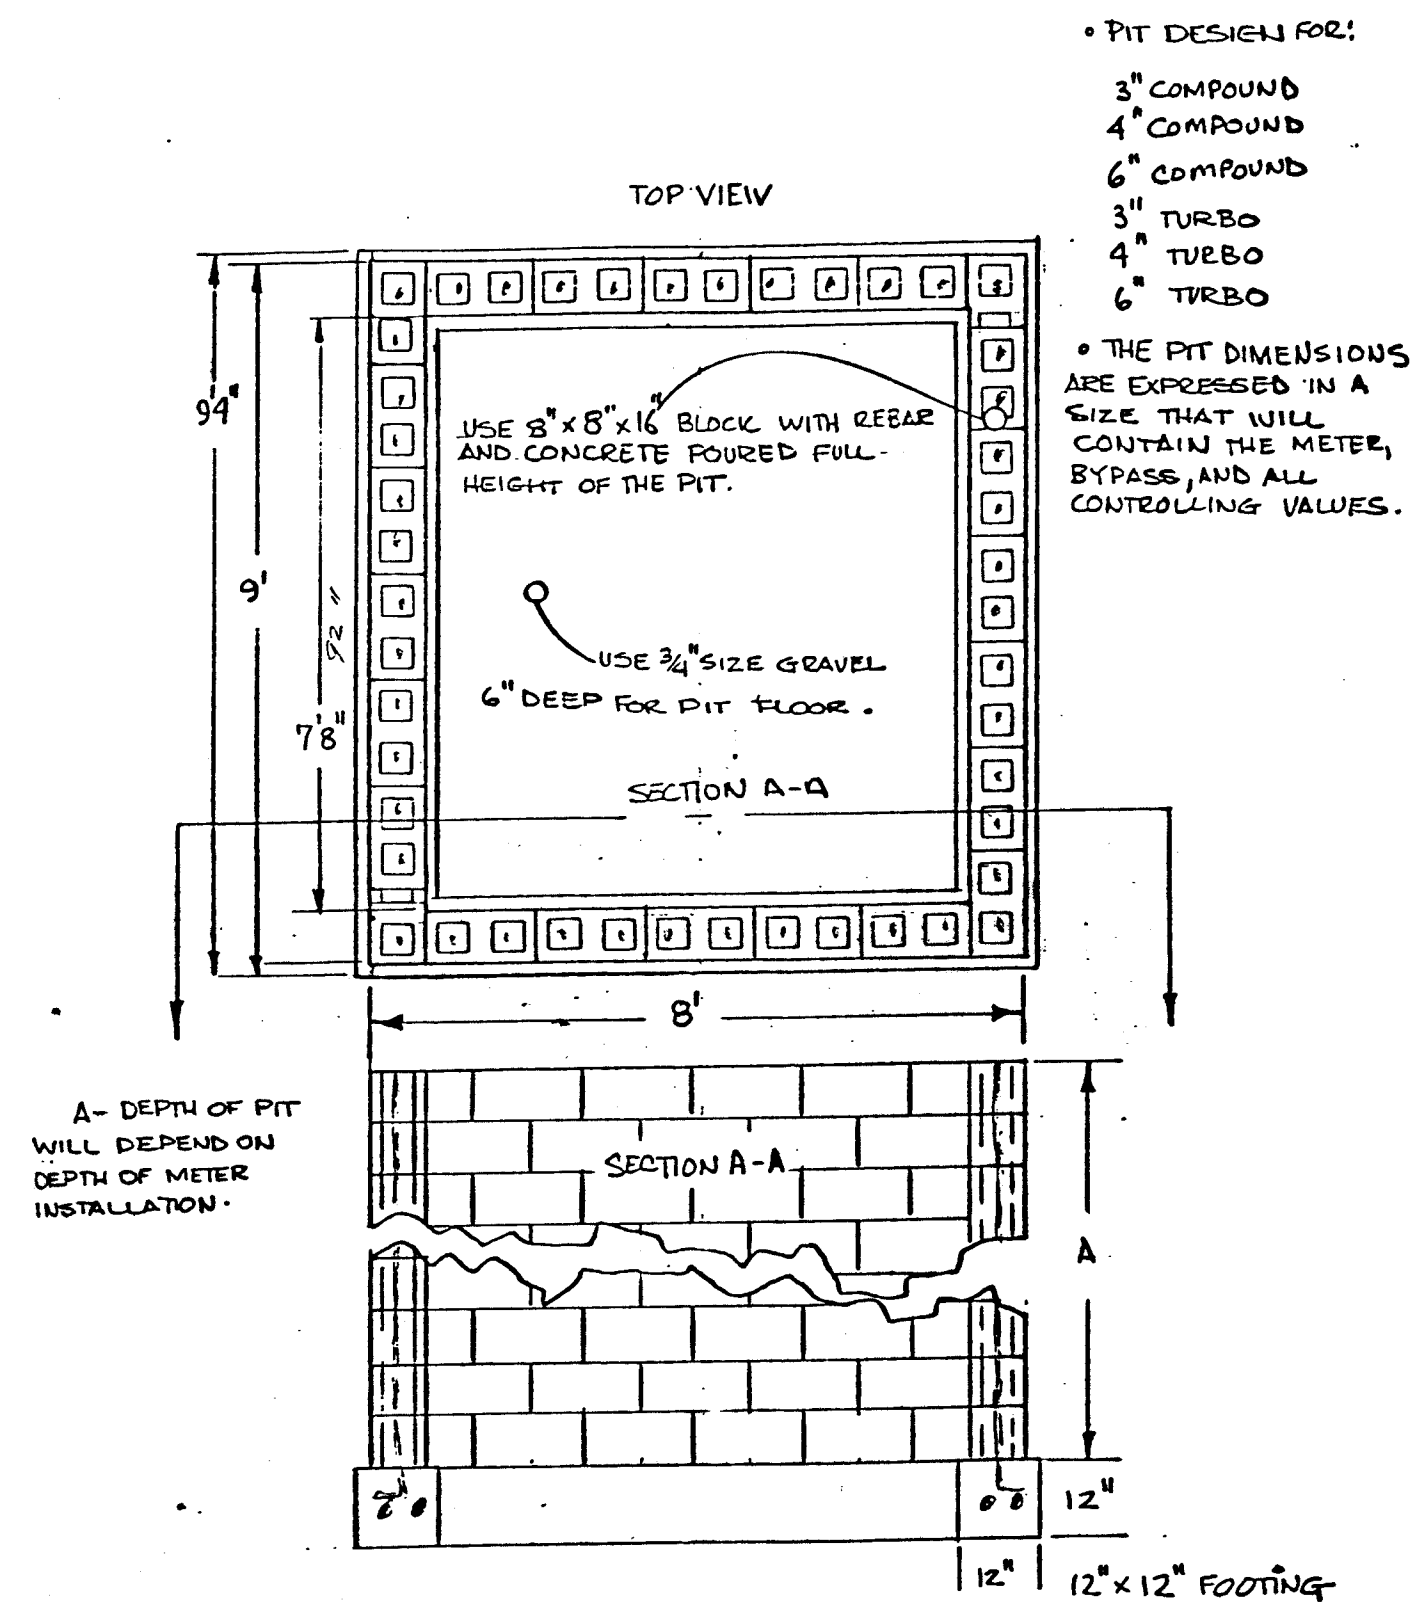


3" METER PIT DETAIL
N.T.S.

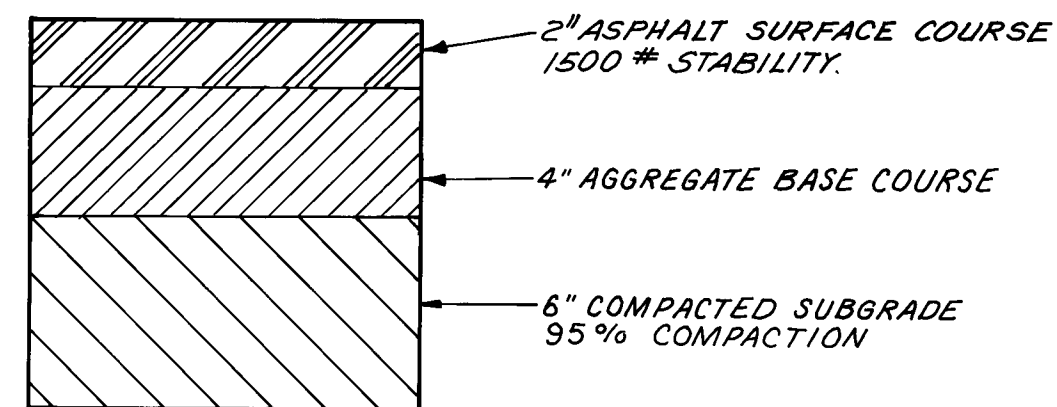


PARKING PAVING SECTION
N.T.S.

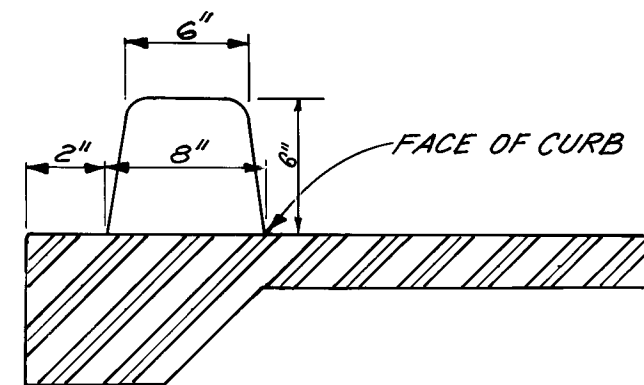


EXTRUDED CONCRETE CURB
N.T.S.

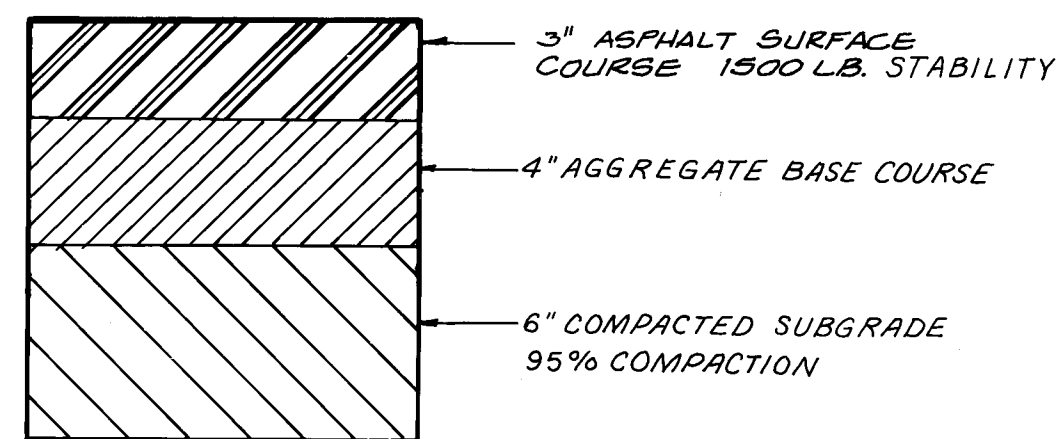

DRIVE PAVING SECTION
N.T.S.

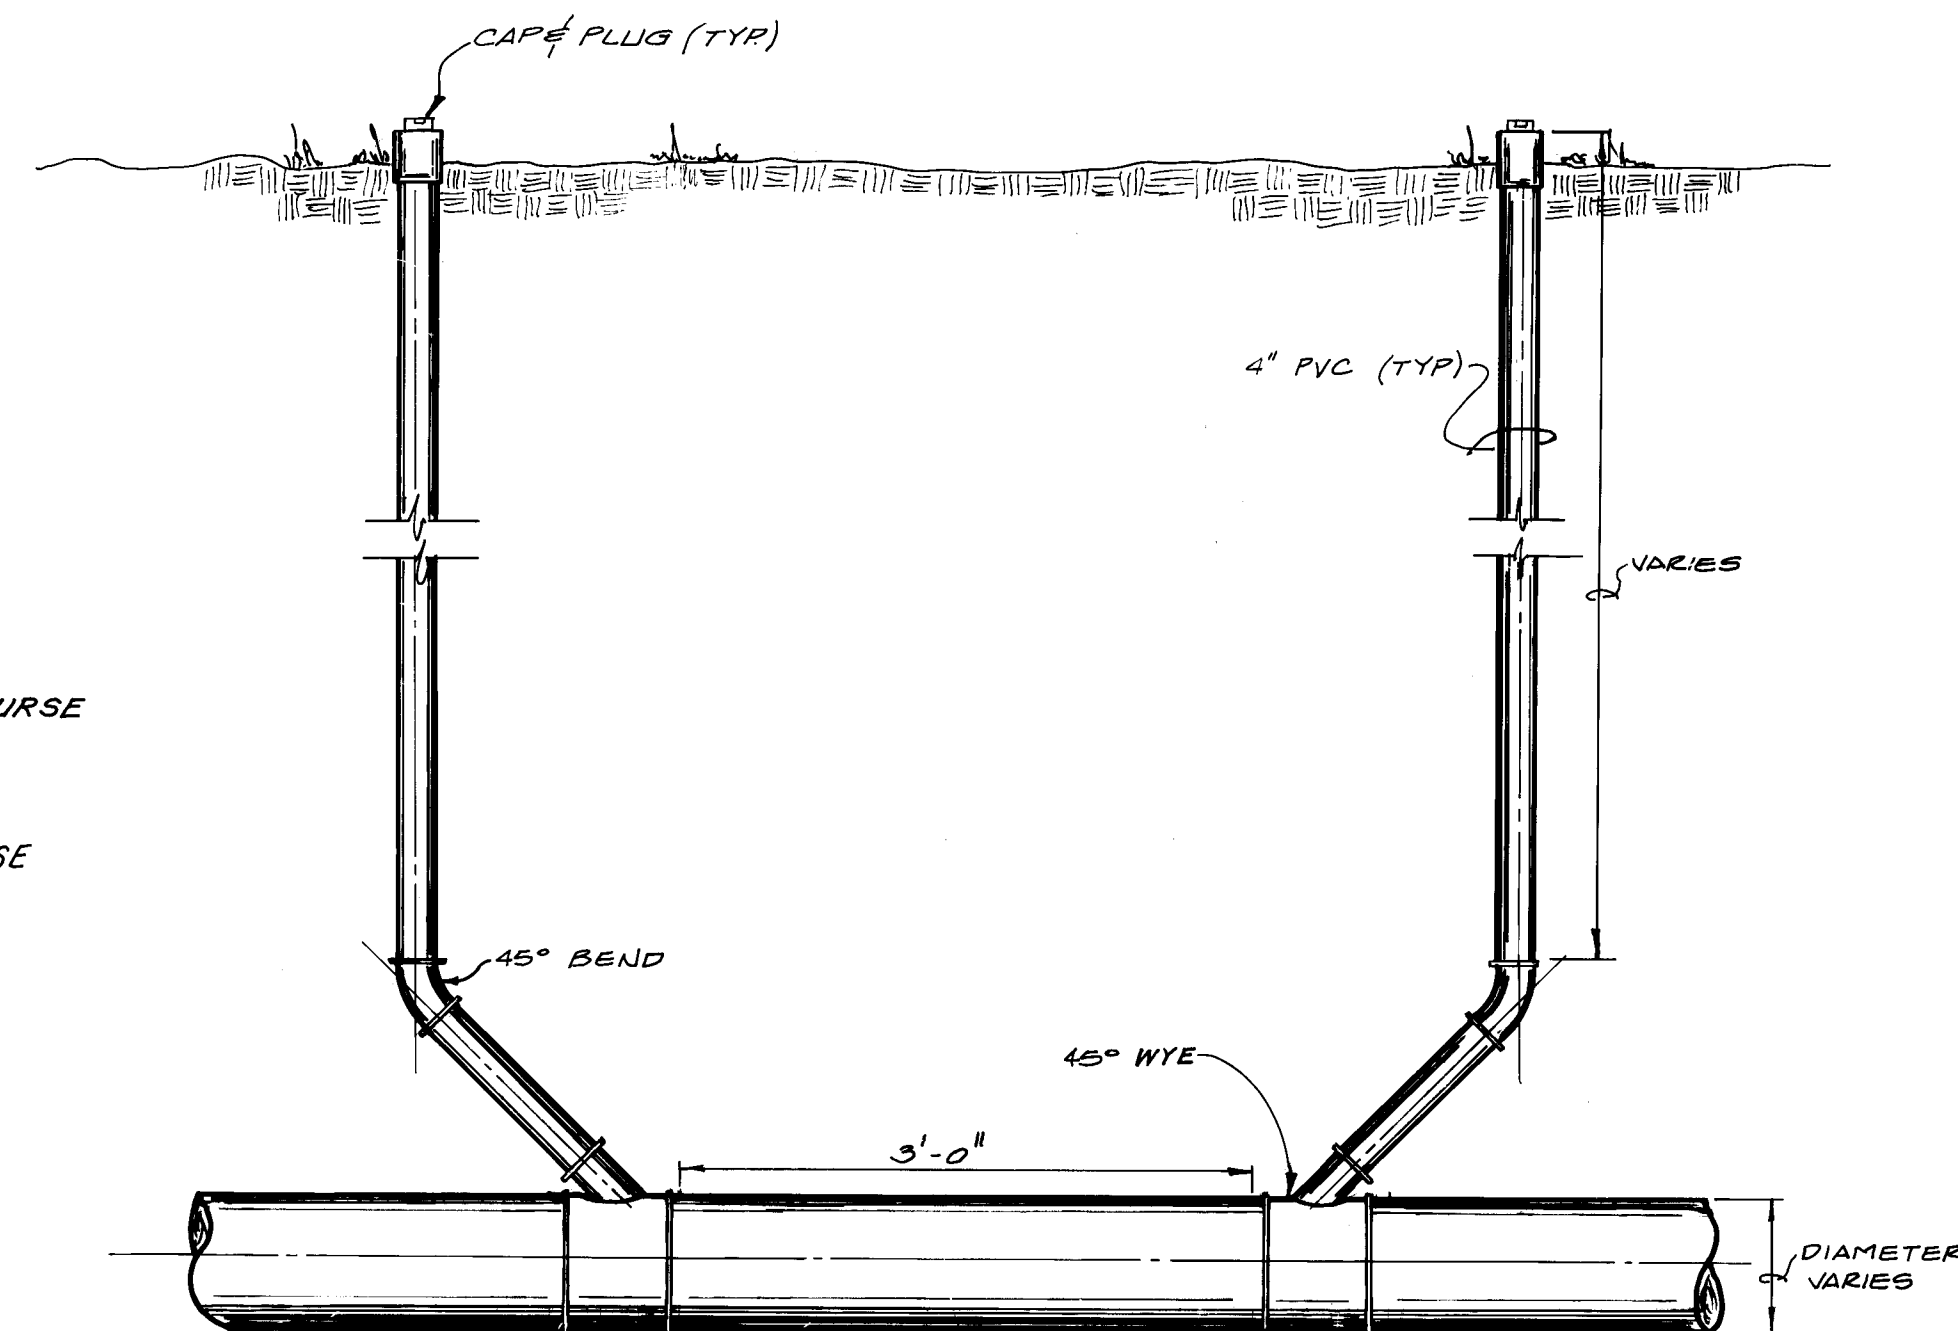


DOUBLE CLEANOUT DETAIL
N.T.S. JCS

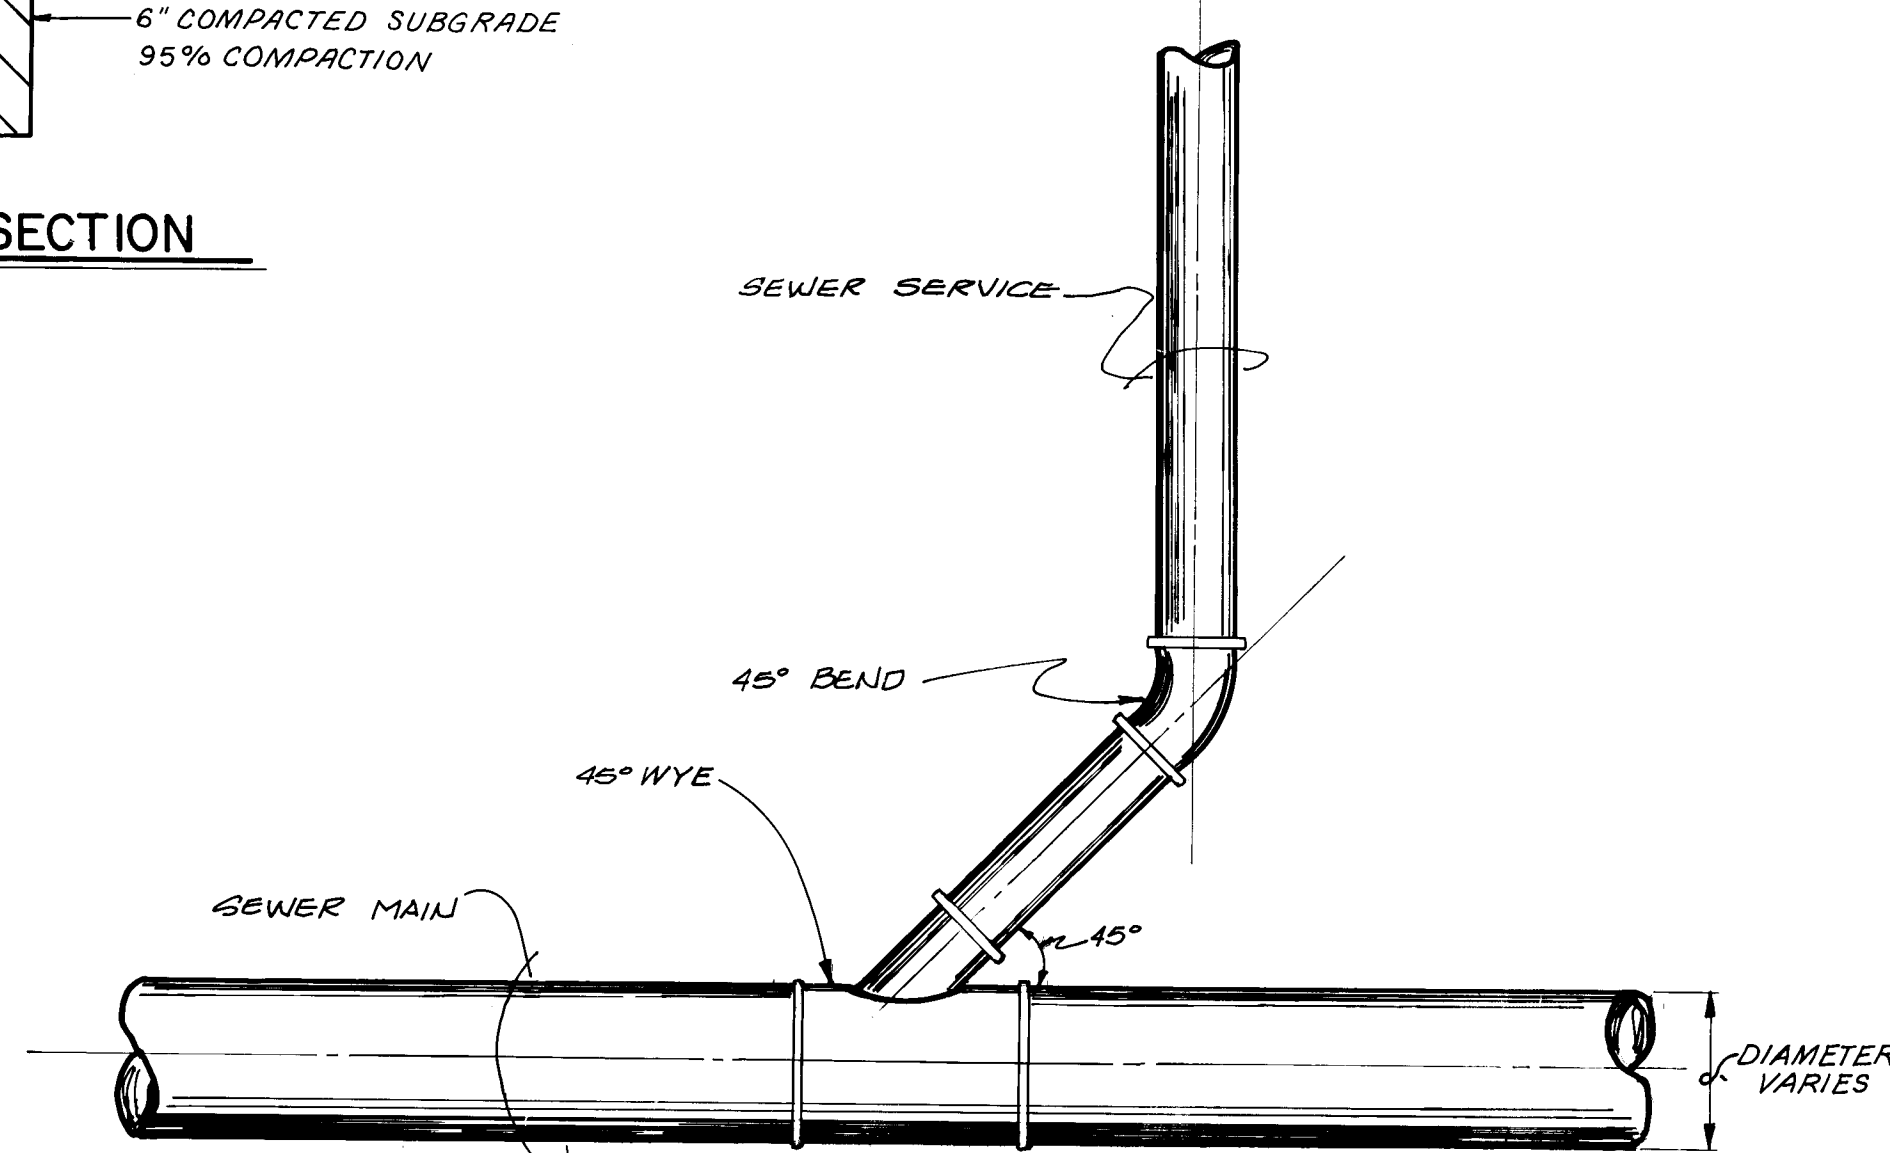

TYPICAL SEWER MAIN CONNECTION
SCALE 1" = 10' JCS

AS BUILT INFORMATION		BENCH MARKS		SURVEY INFORMATION		ENGINEER'S SEAL		REVISIONS		DESIGN		REVISIONS		DESIGN		REVISIONS		DESIGN	
CONTRACTOR	STATION IS A STANDARD "A.C.S." BRASS	STATION IS A STANDARD "A.C.S." BRASS	STATION IS A STANDARD "A.C.S." BRASS	NO.	BY	DATE	DATE	NO.	DATE	BY	DATE	NO.	DATE	BY	DATE	NO.	DATE	BY	DATE
WORK BY	TABLET, STAMPED "7-K19", STATION IS	TABLET, STAMPED "7-K19", STATION IS	TABLET, STAMPED "7-K19", STATION IS		DTM														
INSPECTOR'S	LOCATED AT THE INTERSECTION OF CENTRAL AVE.	LOCATED AT THE INTERSECTION OF CENTRAL AVE.	LOCATED AT THE INTERSECTION OF CENTRAL AVE.																
DATE	AND LOUISIANA BLVD. STATION IS 45' 5" EAST OF	AND LOUISIANA BLVD. STATION IS 45' 5" EAST OF	AND LOUISIANA BLVD. STATION IS 45' 5" EAST OF																
DATE	CENTERLINE ON LOUISIANA BLVD AND 25' SOUTH	CENTERLINE ON LOUISIANA BLVD AND 25' SOUTH	CENTERLINE ON LOUISIANA BLVD AND 25' SOUTH																
DATE	OF CENTERLINE ON THE WEST BOUND LANES OF	OF CENTERLINE ON THE WEST BOUND LANES OF	OF CENTERLINE ON THE WEST BOUND LANES OF																
DATE	CENTRAL AVE. STATION IS LOCATED ON THE NOSE	CENTRAL AVE. STATION IS LOCATED ON THE NOSE	CENTRAL AVE. STATION IS LOCATED ON THE NOSE																
DATE	OF THE MEDIAN. ELEVATION = 5323.308	OF THE MEDIAN. ELEVATION = 5323.308	OF THE MEDIAN. ELEVATION = 5323.308																
NO	(T.B.M. = M.H.#5, Elev. = 5329.48 ft.)	(T.B.M. = M.H.#5, Elev. = 5329.48 ft.)	(T.B.M. = M.H.#5, Elev. = 5329.48 ft.)																

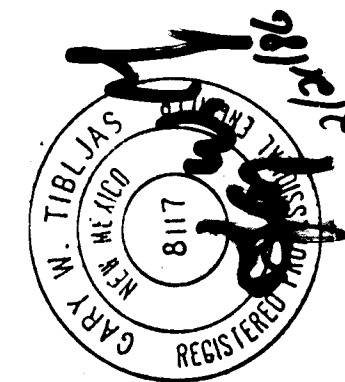

26 2814/386

CITY OF ALBUQUERQUE MUNICIPAL DEVELOPMENT DEPARTMENT ENGINEERING DIVISION	
TITLE: SUNPUEBLO APARTMENTS DETAILS	
NOT IN WORK ORDER FOR INFORMATION ONLY	
DRAWING NO. 2814	MAP NO. K-19
SHEET 13	OF 13