


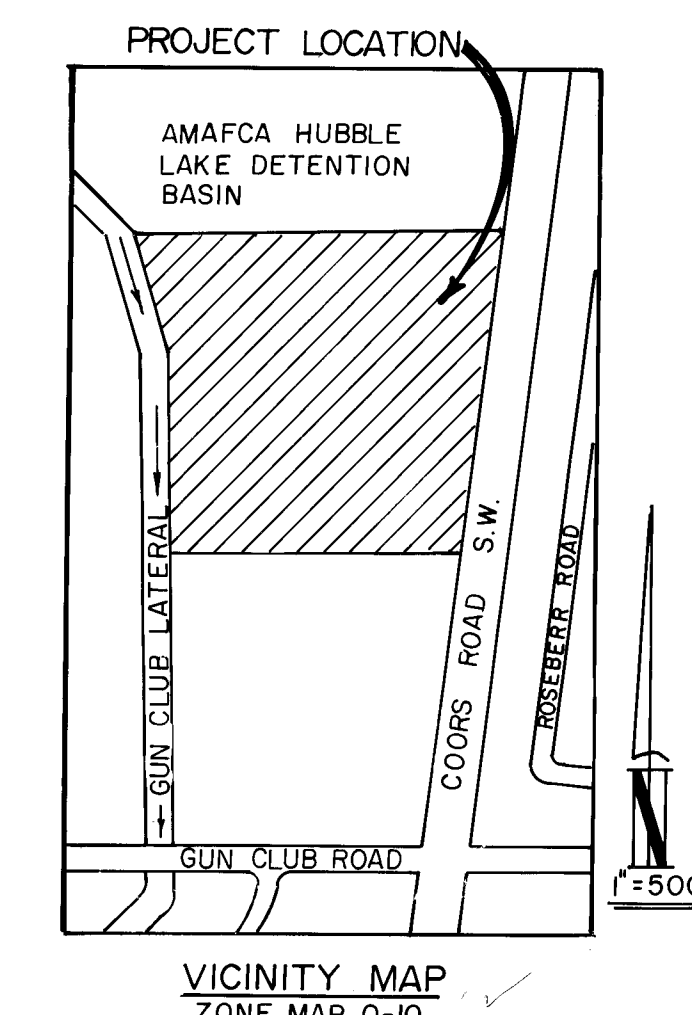

LEGAL DESCRIPTION
COUNTRYSIDE MOBILE HOME PARK
.4201 COORS S.W. BERNALILLO COUNTY, NM
TRACTS 3A2, 2A1A1, & 2A1A2
MBGCD MAP #52

LEGEND

PROPOSED PROFILE	----
EXISTING SPOT ELEVATION	⊕
PROPOSED SPOT ELEVATION	⊗
EXISTING CURB	=====
PROPOSED CURB	=====
EXISTING SANITARY SEWER	----- SAS -----
PROPOSED SANITARY SEWER	----- SAS -----
PROPERTY LINE	----- PL -----

NOTES

1. TWO (2) WORKING DAYS PRIOR TO ANY EXCAVATION, CONTRACTOR MUST CONTACT LINE LOCATING SERVICE AT 765-1234.
2. ALL ITEMS SHALL BE CONSTRUCTED IN ACCORDANCE WITH CITY OF ALBUQUERQUE 1985 INTERIM STANDARD SPECIFICATIONS FOR PUBLIC WORKS CONSTRUCTION.
3. CONTRACTOR SHALL OBTAIN BARRICADING PERMIT FROM THE CITY OF ALBUQUERQUE AND SUBMIT A TRAFFIC CONTROL PLAN 3 DAYS IN ADVANCE OF LANE CLOSURES.
4. CONTRACTOR SHALL CONFORM TO THE CITY OF ALBUQUERQUE STANDARD DWGS:
S-1
S-2
S-3

APPROVAL OF AS BUILT DRAWINGS
CHIEF CONSTRUCTION ENGINEER
[Signature]
DATE 1/20/86

Amos N. Hicks
455136

CITY OF ALBUQUERQUE
MUNICIPAL DEVELOPMENT
ENGINEERING DIV.

TITLE: COUNTRYSIDE MOBILE
SANITARY SEWER F

APPROVALS	ENGINEER	DATE	APPR
City Engineer	<i>[Signature]</i>	3/31/86	Liquid W
A C E - Design	<i>[Signature]</i>	3/26/84	Traffic
A C E - Hydrology	<i>[Signature]</i>	3/26/84	Water

PROJECT NO.	2816	MAP NO.	P/Q - 1
-------------	------	---------	---------