


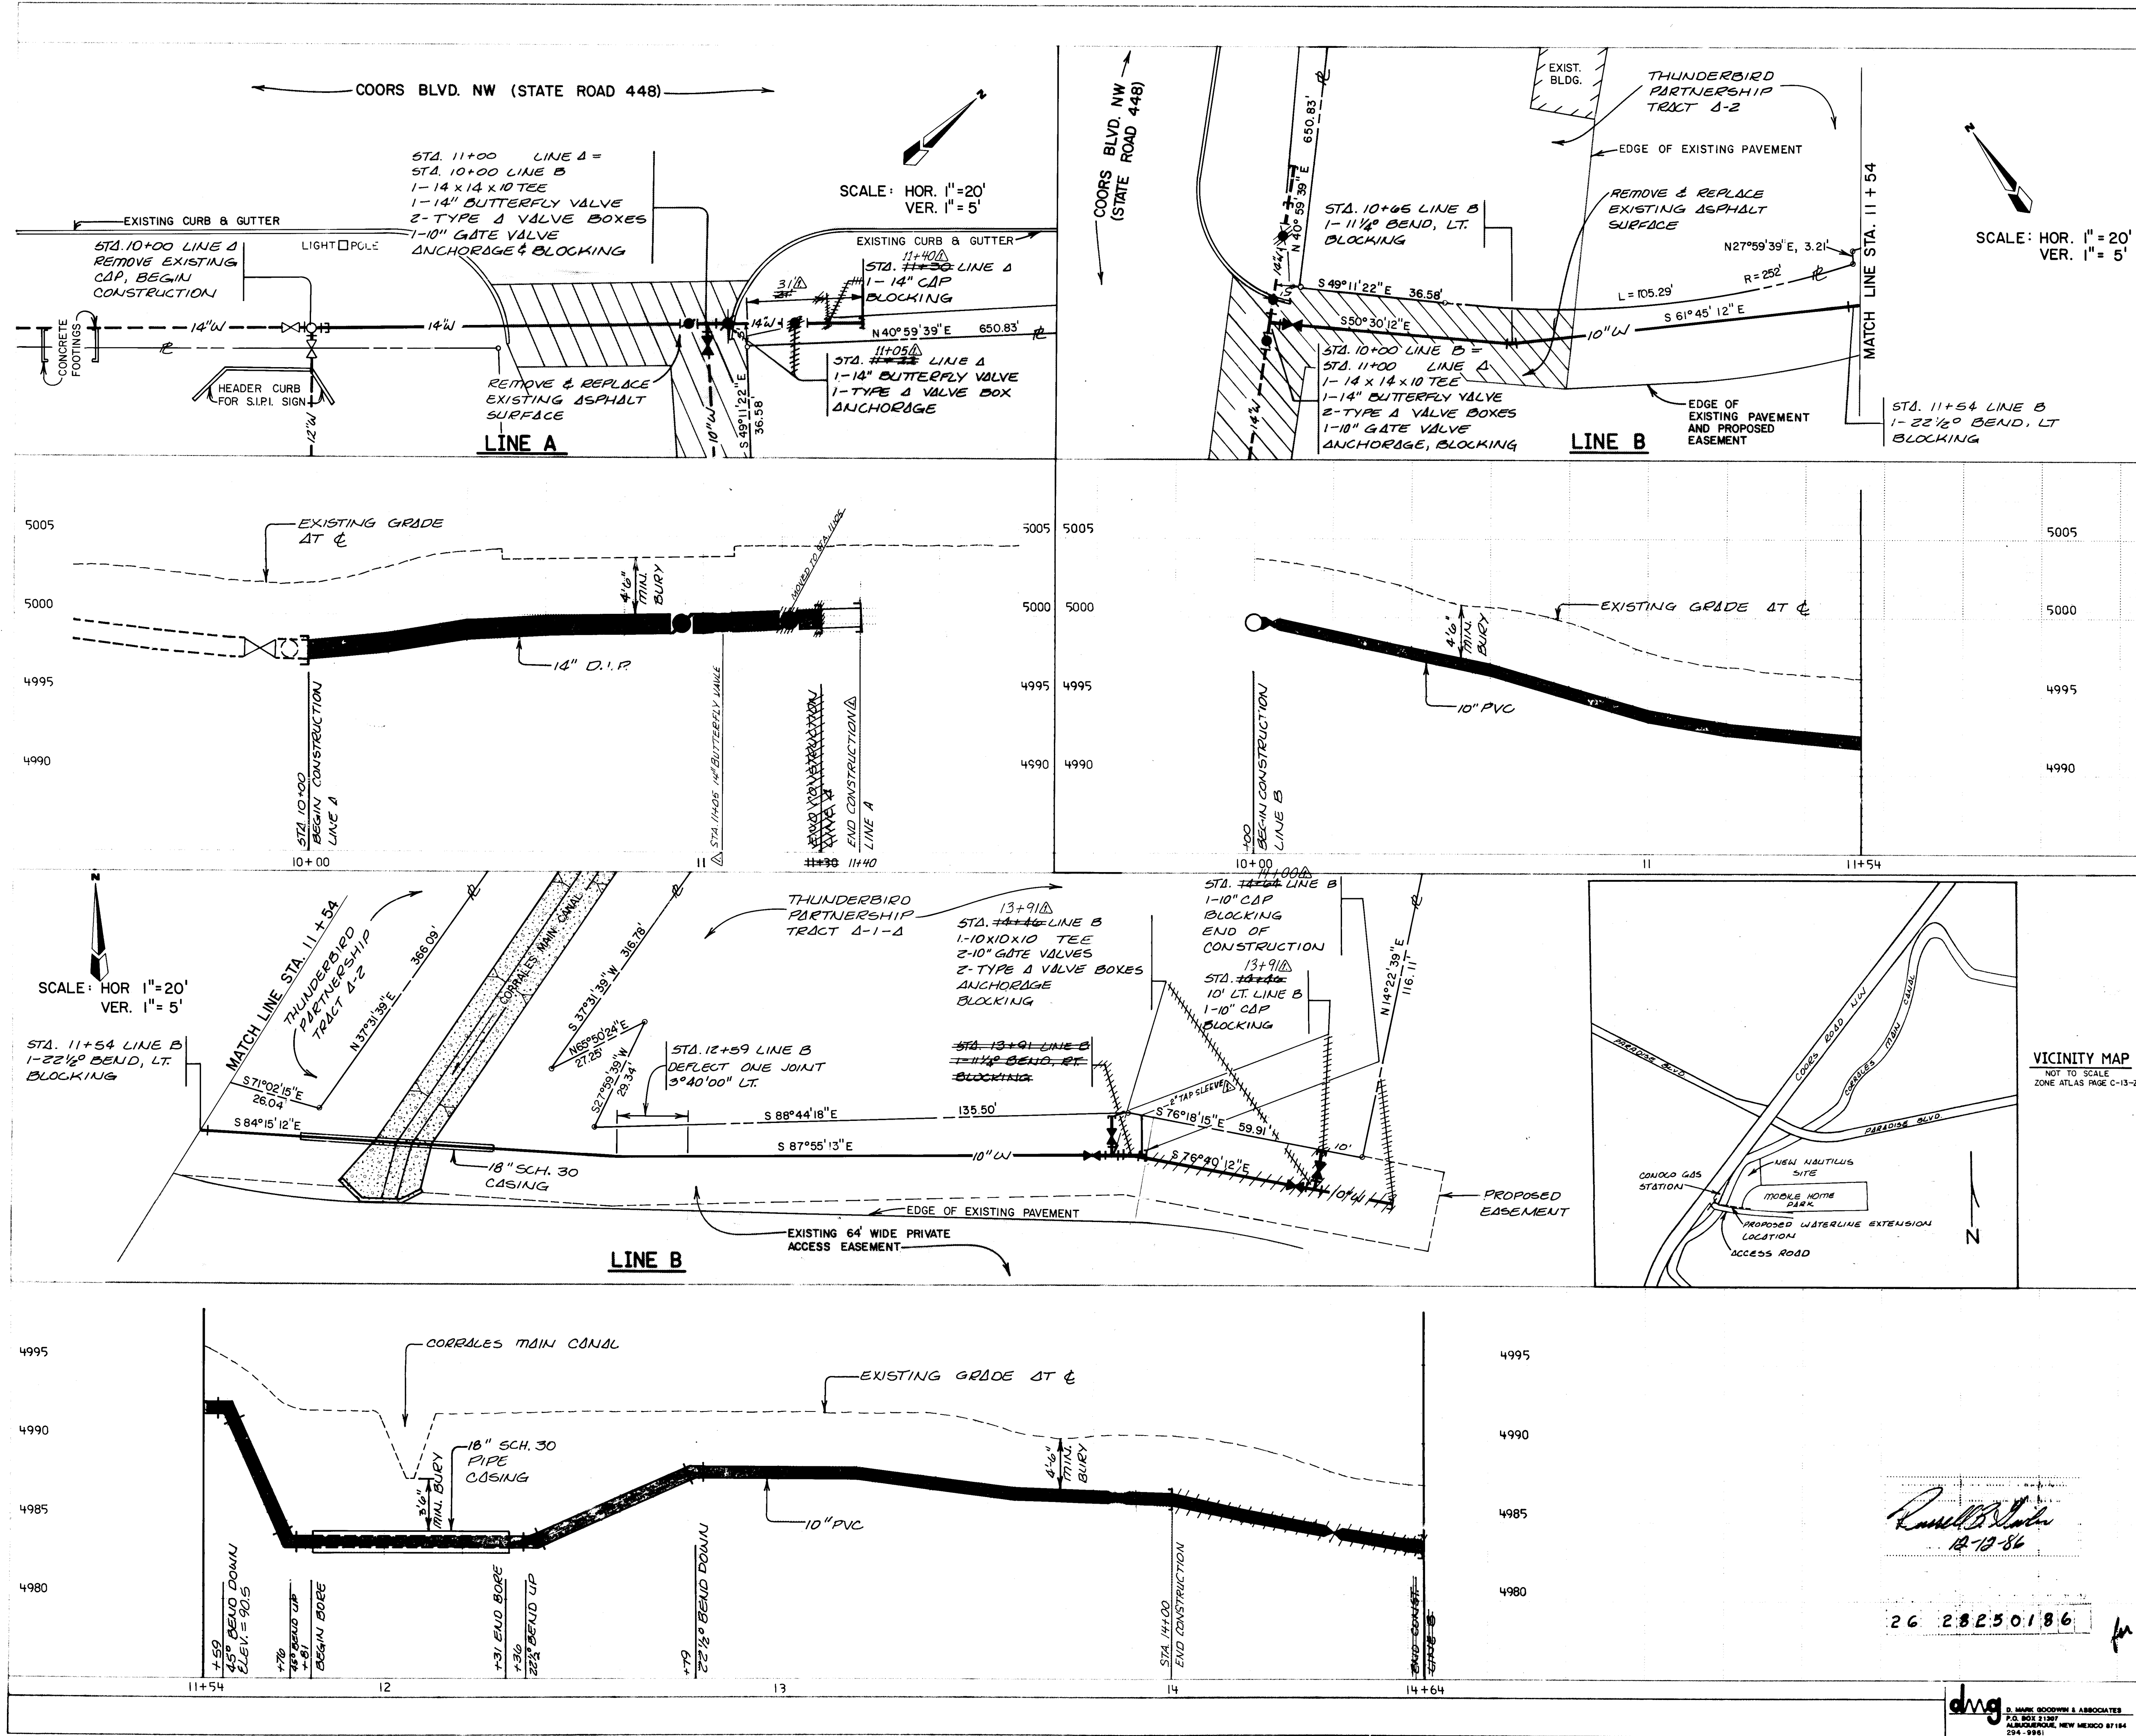

LEGEND

- EXISTING ASPHALT
- EXISTING CONCRETE
- EXISTING PROPERTY LINE
- EXISTING 14" WATER LINE
- PROPOSED 14" WATER LINE
- PROPOSED 10" WATER LINE
- WATER LINE CAP
- WATER LINE TEE
- WATER LINE BEND
- DUCTILE IRON PIPE
- EXISTING GATE VALVE
- PROPOSED GATE VALVE
- PROPOSED BUTTERFLY VALVE

GENERAL NOTES

- ALL CONSTRUCTION IS TO BE IN ACCORDANCE WITH THE CITY OF ALBUQUERQUE INTERIM STANDARD SPECIFICATIONS FOR PUBLIC WORKS CONSTRUCTION, 1985 EDITION.
- THE FOLLOWING CITY STANDARD DRAWINGS ARE TO BE USED:
 - W-1 WATERLINE CONNECTION
 - W-2 TYPE A VALVE BOX
 - W-4 VALVE BOX RING & COVER
 - W-6 BORING INSTALLATION
 - W-8 VALVE ANCHORAGE
 - W-22 CONCRETE BLOCKING
 - P-2 RESIDENTIAL STREET SECTION, ASPHALT
- ALL PIPE TO BE DUCTILE IRON PIPE OR PVC.
- TRAFFIC CONTROL TO BE PROVIDED BY THE CONTRACTOR PER MUTCD STANDARDS.
- TWO (2) WORKING DAYS PRIOR TO ANY EXCAVATION, CONTRACTOR MUST CONTACT LINE LOCATING SERVICE, 765-1234, FOR LOCATION OF EXISTING UTILITIES.
- PRIOR TO CONSTRUCTION, THE CONTRACTOR SHALL EXCAVATE AND VERIFY THE HORIZONTAL & VERTICAL LOCATIONS OF ALL OBSTRUCTIONS. SHOULD A CONFLICT EXIST, THE CONTRACTOR SHALL NOTIFY THE ENGINEER OR SURVEYOR SO THAT THE CONFLICT CAN BE RESOLVED WITH A MINIMUM AMOUNT OF DELAY.
- BACKFILL COMPACTION SHALL BE ACCORDING TO SPECIFIED STREET USE.
- TACK COAT REQUIREMENTS SHALL BE DETERMINED BY THE CITY ENGINEER.
- LINE A = CITY MASTERPLAN LINE
LINE B = DISTRIBUTION LINE

AS BUILT INFORMATION

NO.	DATE	BY
1	12/8/86	REVISOR
2	12/8/86	REVISOR
AS BUILT INFORMATION

NO.	DATE	BY
1	12/8/86	REVISOR
2	12/8/86	REVISOR
3	12/8/86	REVISOR
AS BUILT INFORMATION

NO.	DATE	BY
1	12/8/86	REVISOR
2	12/8/86	REVISOR
3	12/8/86	REVISOR
AS BUILT INFORMATION

NO.	DATE	BY
1	12/8/86	REVISOR
2	12/8/86	REVISOR
3	12/8/86	REVISOR
72	12/8/86	