




STORM DRAINAGE INLET REPAIR AT VARIOUS LOCATIONS











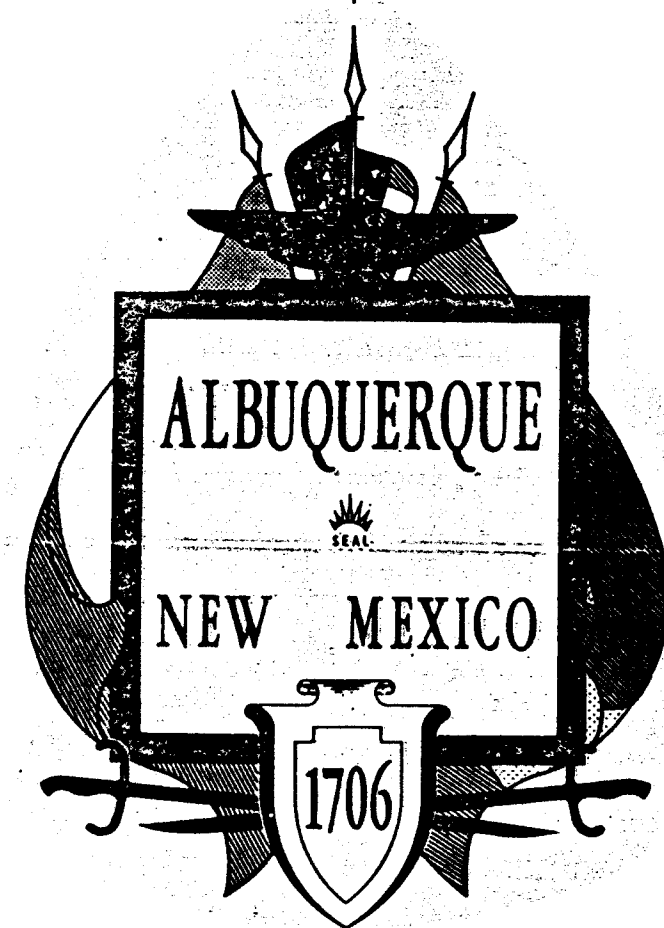


NOTICE TO CONTRACTORS

1. All work detailed on these plans to be performed under contract shall, except as otherwise stated or provided for hereon, be constructed in accordance with the City of Albuquerque Interim Standard Specifications For Public Works Construction 1985.
2. Two (2) working days prior to any excavation, the contractor must contact Line Locating Service, 765-1234 for location of existing utilities.
3. Prior to construction, the contractor shall excavate and verify the horizontal and vertical locations of all obstructions. Should a conflict exist, the contractor shall notify the engineer or surveyor so that the conflict can be resolved with minimum amount of delay.

THE FOLLOWING NOTES ALSO APPLY WHEN CHECKED

- ☐ All utilities and utility service lines shall be installed prior to paving.
- ☒ Backfill compaction shall be according to specified street use.
- ☐ Tack coat requirements shall be determined by the City Engineer.
- ☒ Sidewalks and wheelchair ramps within the curb returns shall be constructed wherever a new curb return is constructed.
- ☐ If curb is depressed for a driveway or a handicap ramp, the driveway or ramp shall be constructed prior to acceptance of the curb and gutter.
- ☐ All storm drainage facilities shall be completed prior to final acceptance.

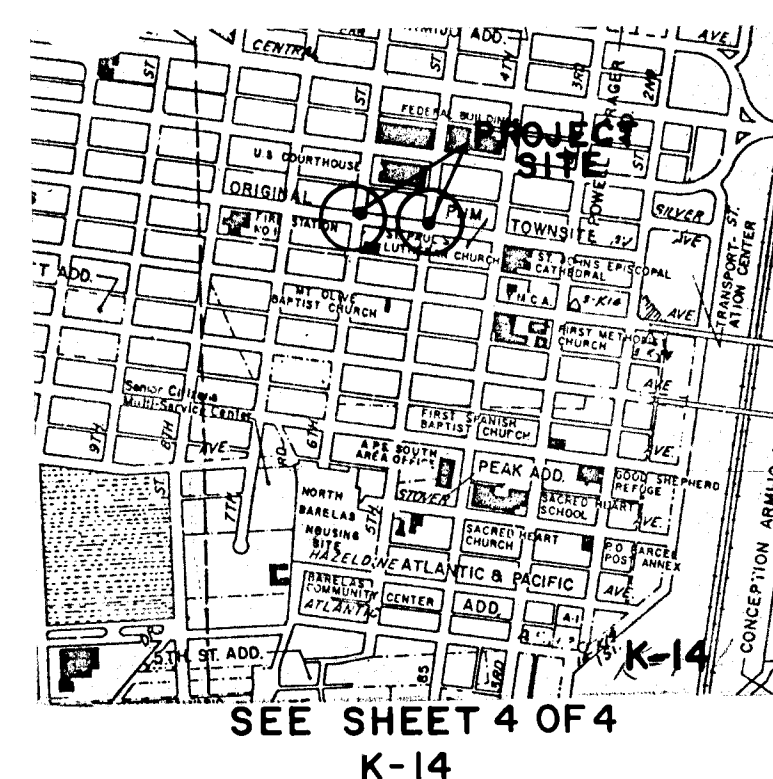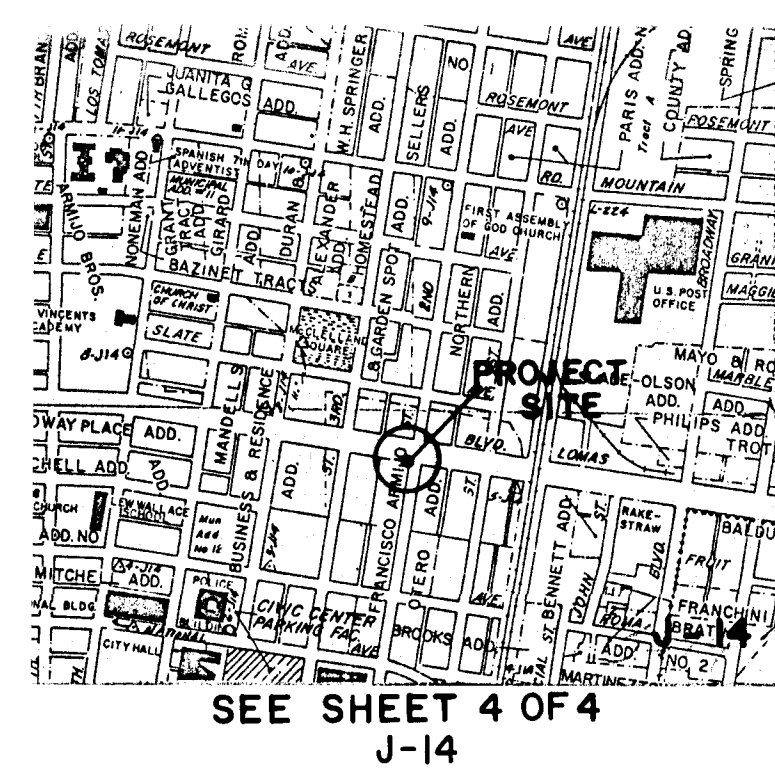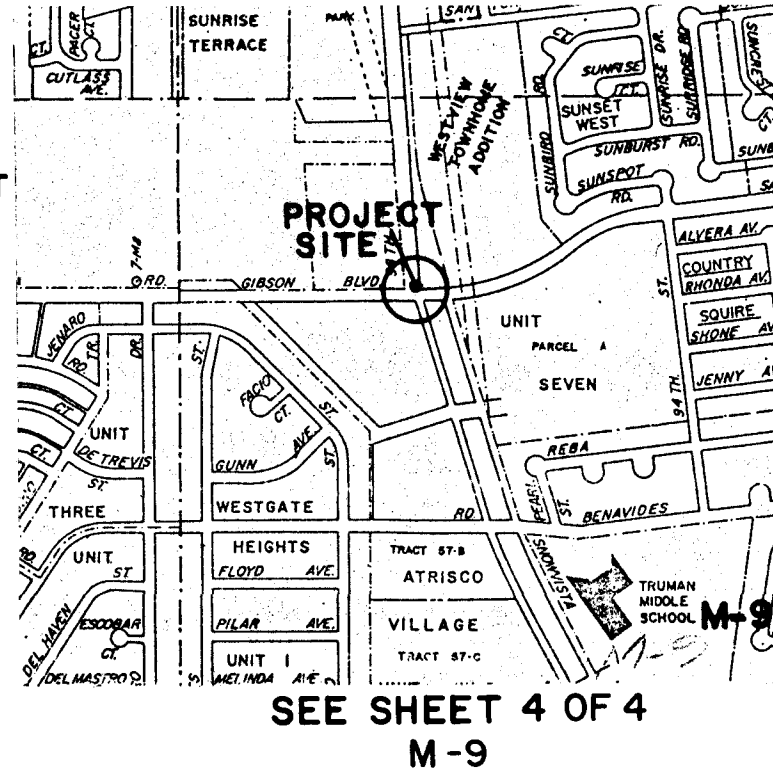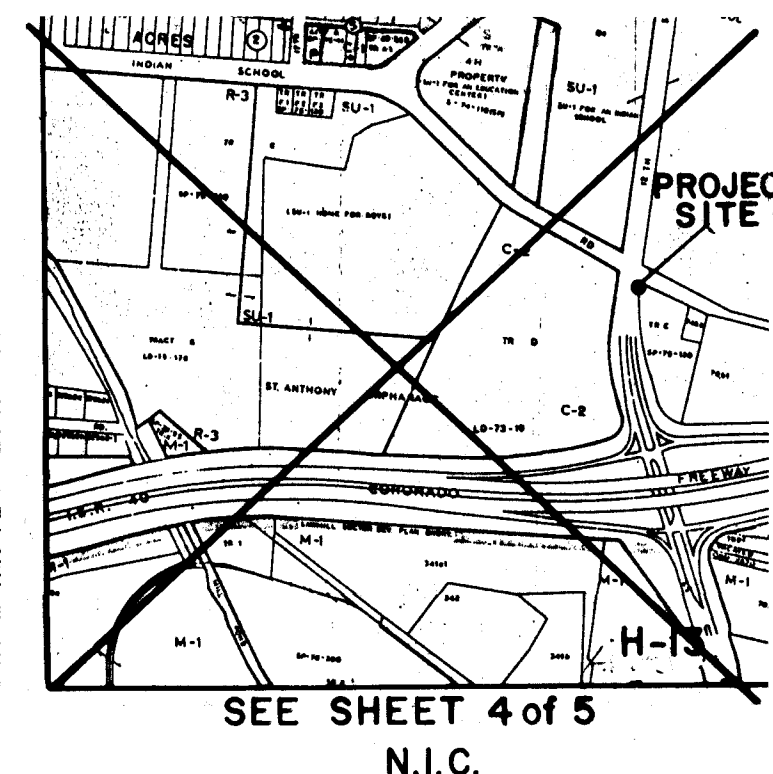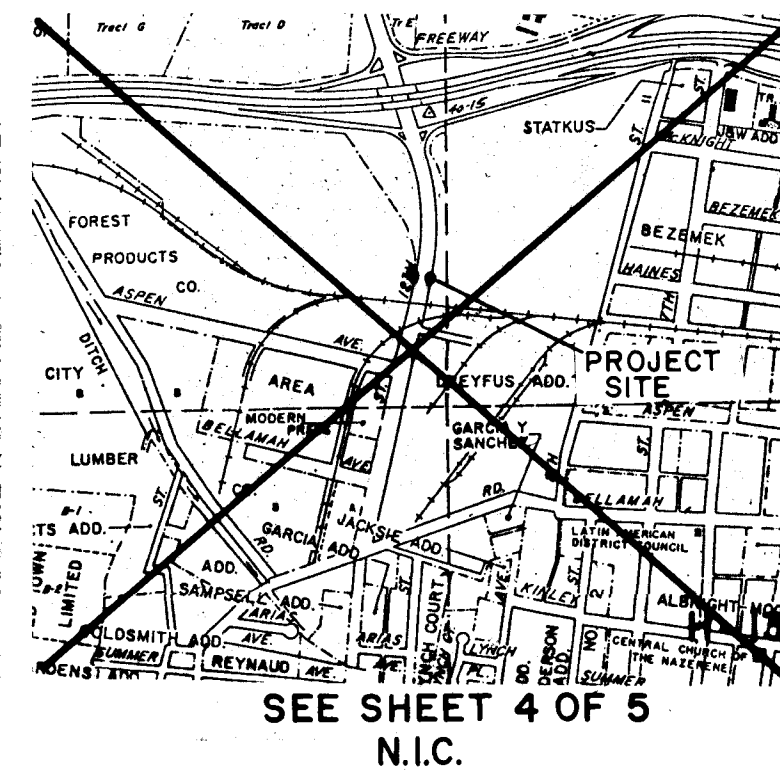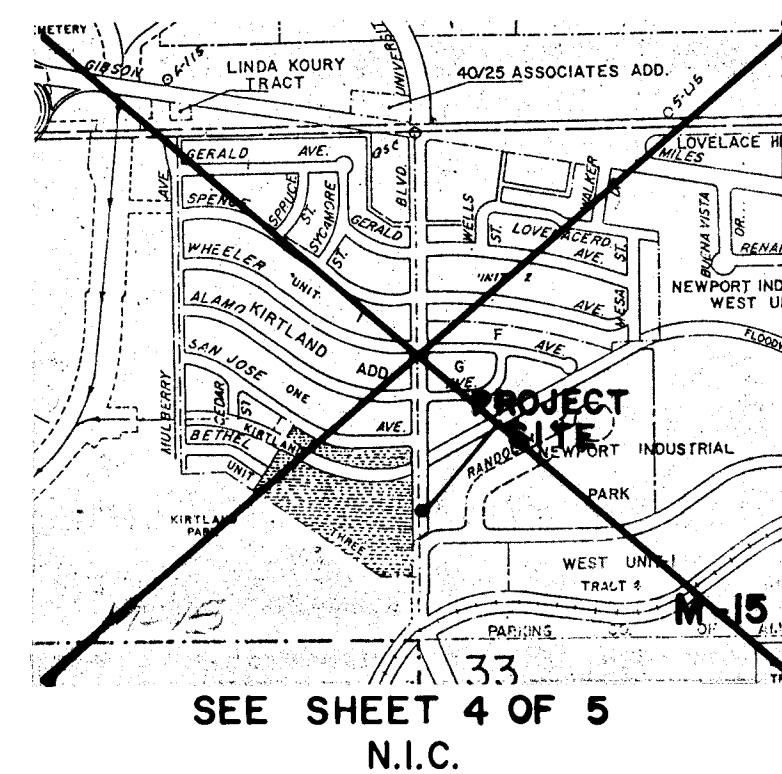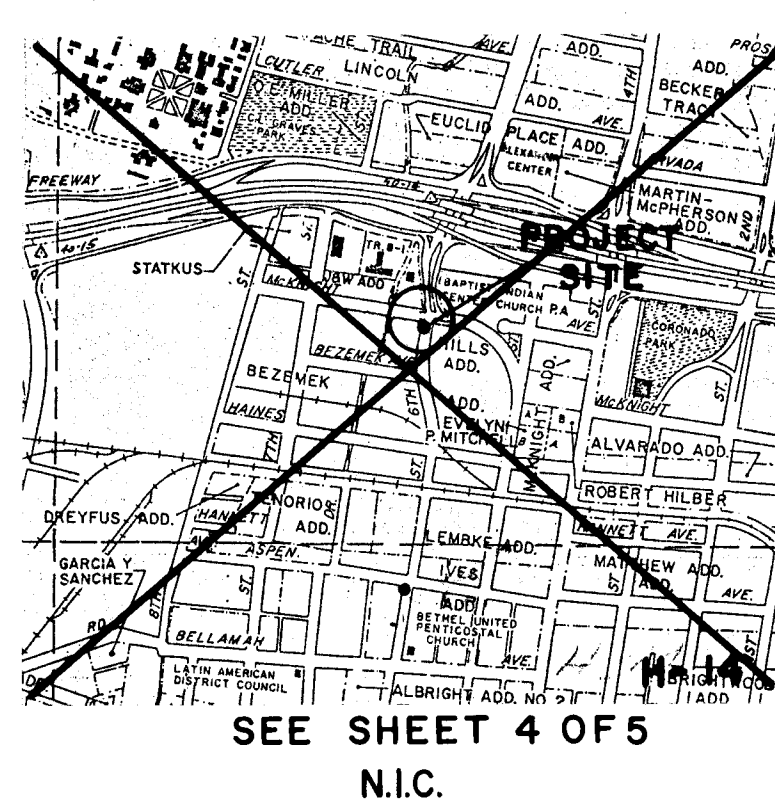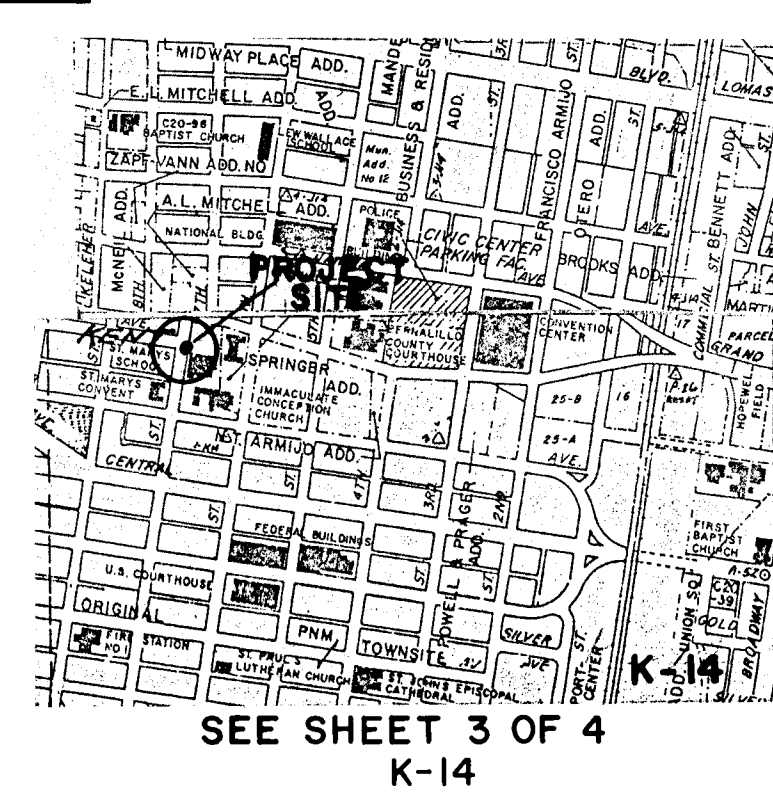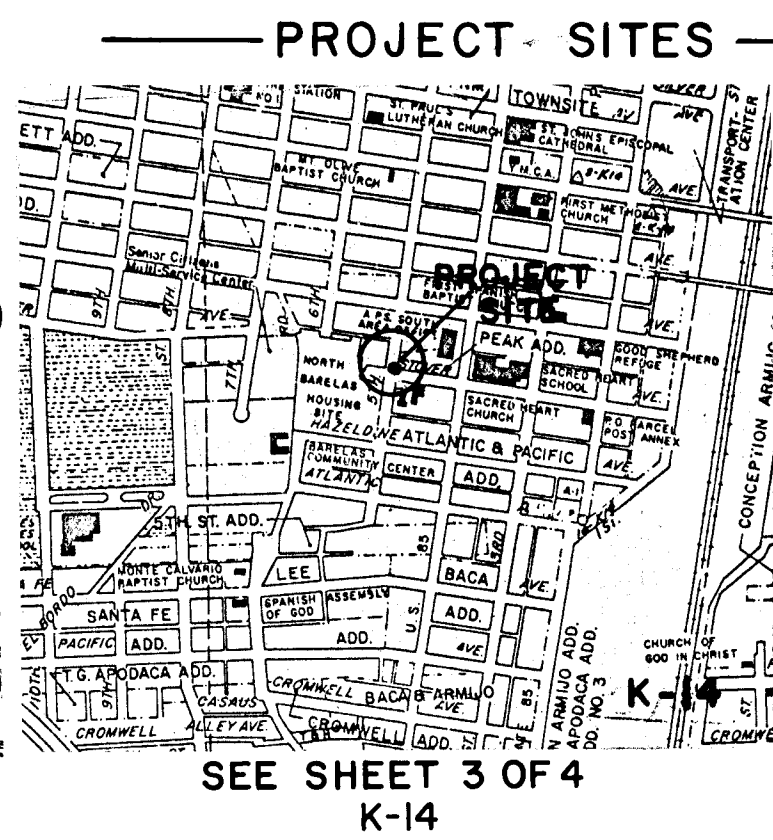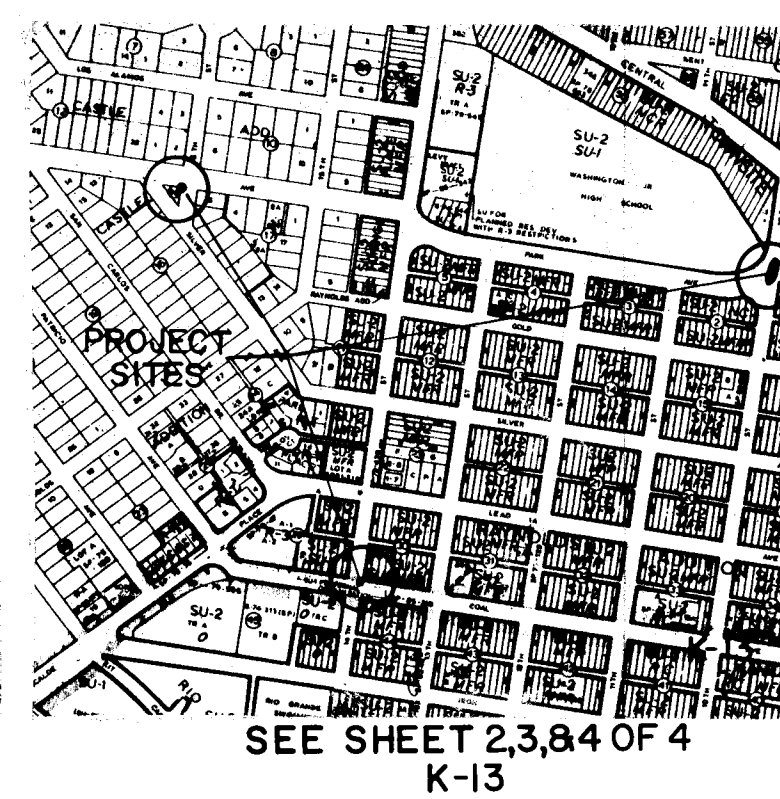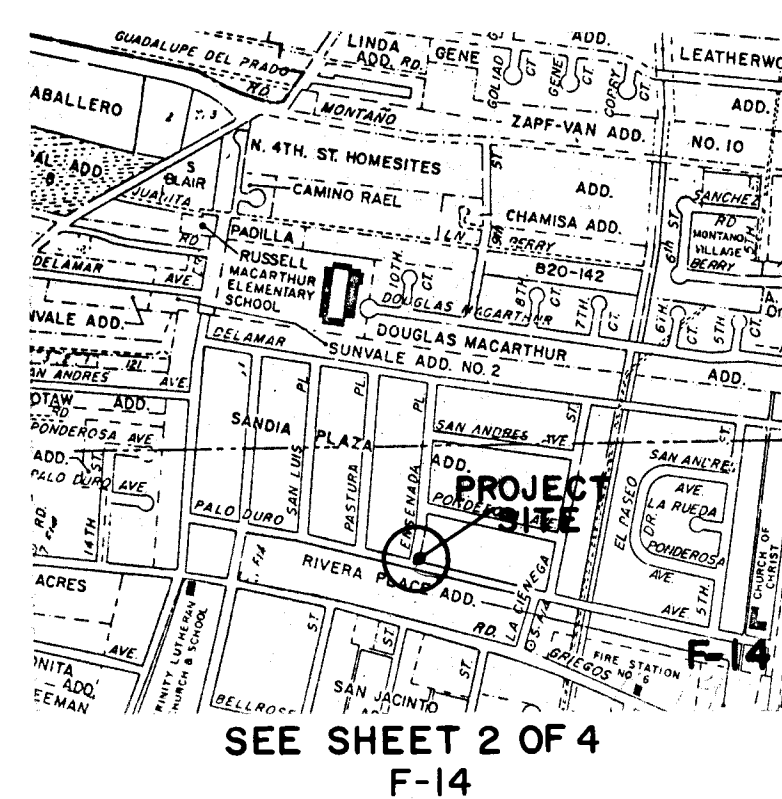


1 2 3 4 5 6 7 8 9 10 11 12
26 28300187

APPROVED AS BUILT DRAWINGS
CHIEF CONSTRUCTION ENGINEER
Russell B. Linder
DATE 12-15-87

REV.	SHEETS	CITY ENGR.	DATE	USER DEPT.	DATE	USER DEPT.	DATE
APPROVAL OF REVISIONS							

DRAWING NO.	2830	CITY OF ALBUQUERQUE	APPROVED FOR CONSTRUCTION <i>Russell B. Linder</i> DATE 12-31-87

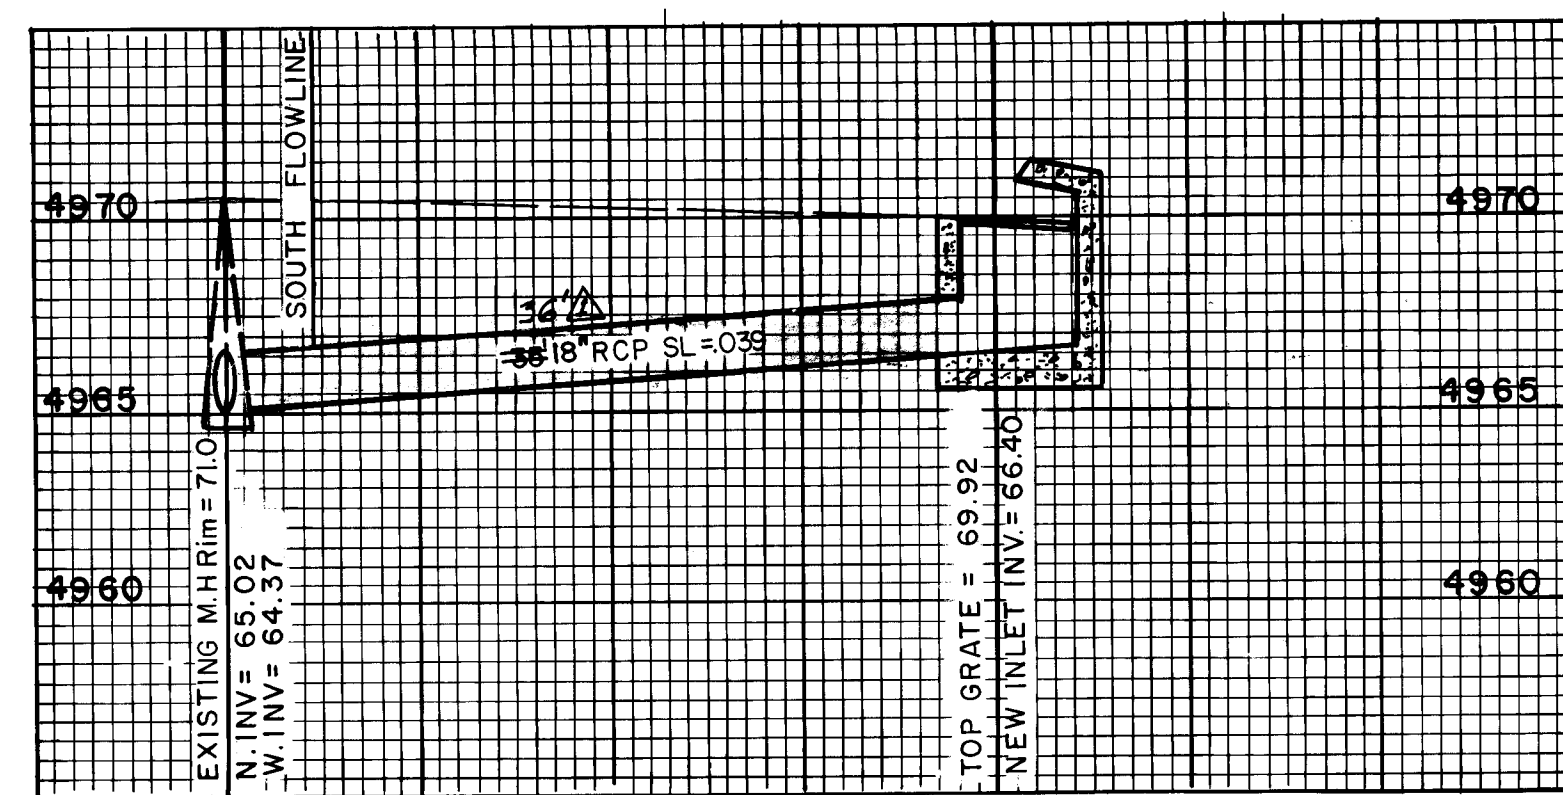

PROFILE


HORIZONTAL SCALE: 1" = 10'
VERTICAL SCALE: 1" = 5'

ALLOWED CONST. TIME = 19 DAYS

PALO DURO DR & ENSENADA PL.


Applies to the following project:

1. Fifth St. & Stover Ave, Sheet 3
2. Kent Ave & Seventh St., Sheet 3

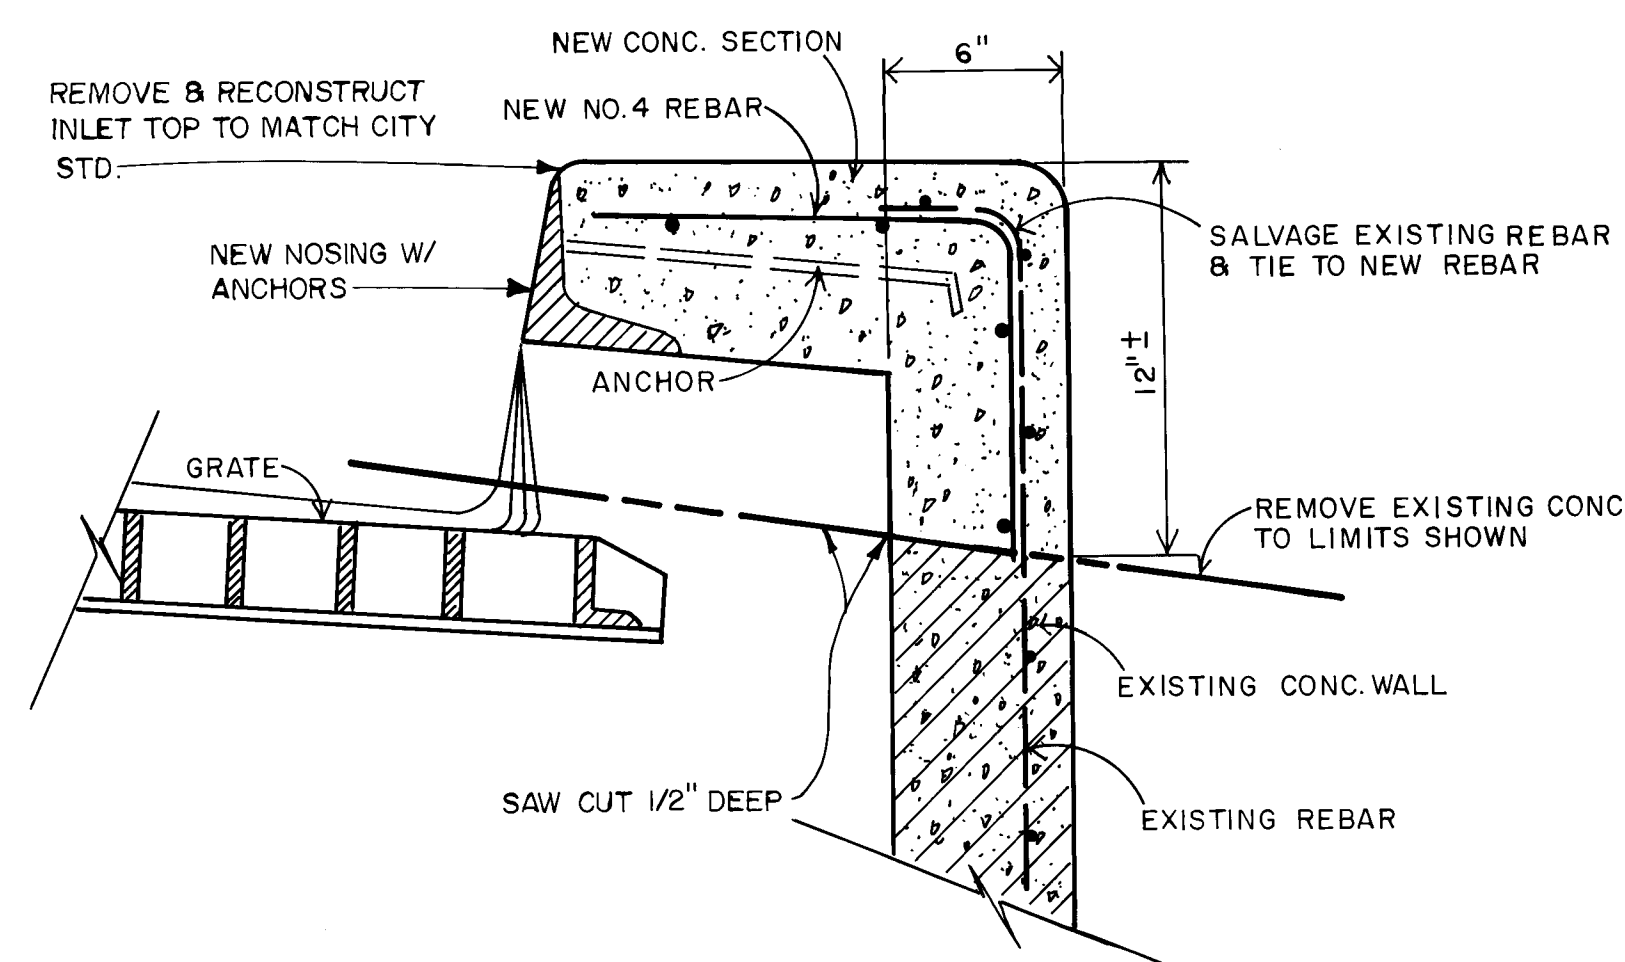


DETAIL "A"

AS PER STD. DWG K-2 & K-4

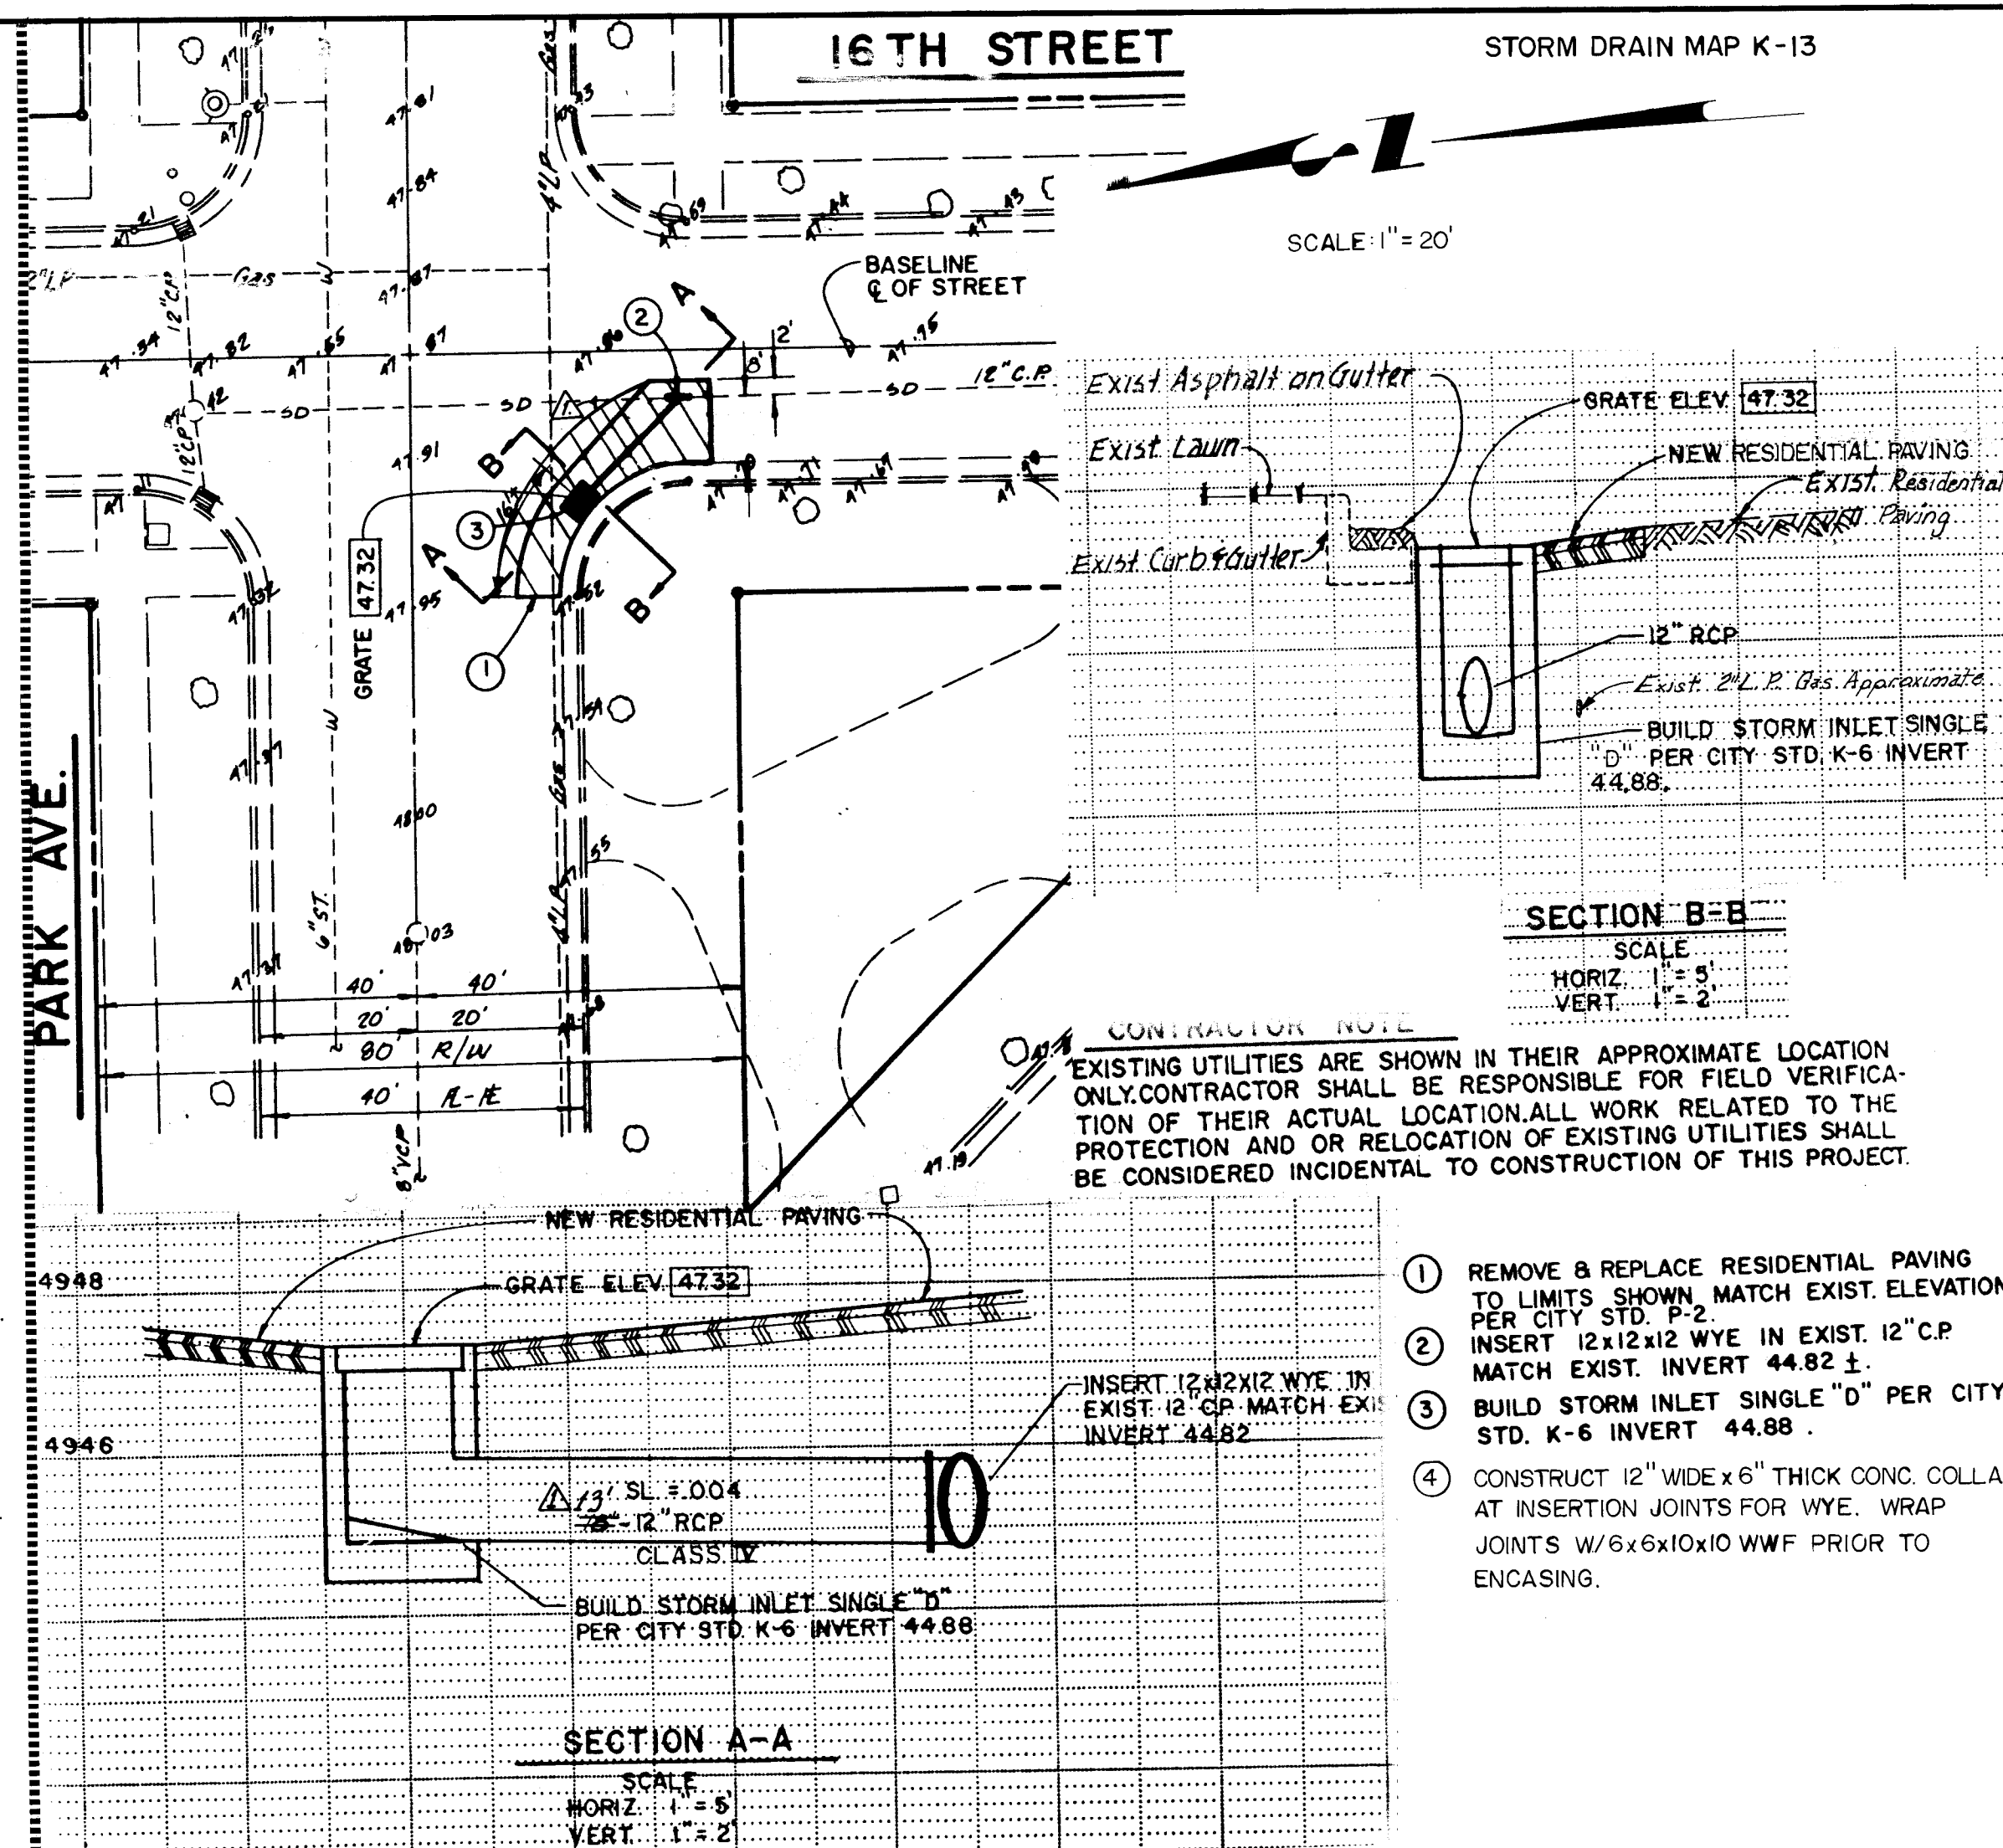

ALLOWED CONST. TIME = 19 DAYS

PARK AVE. & 16TH STREET

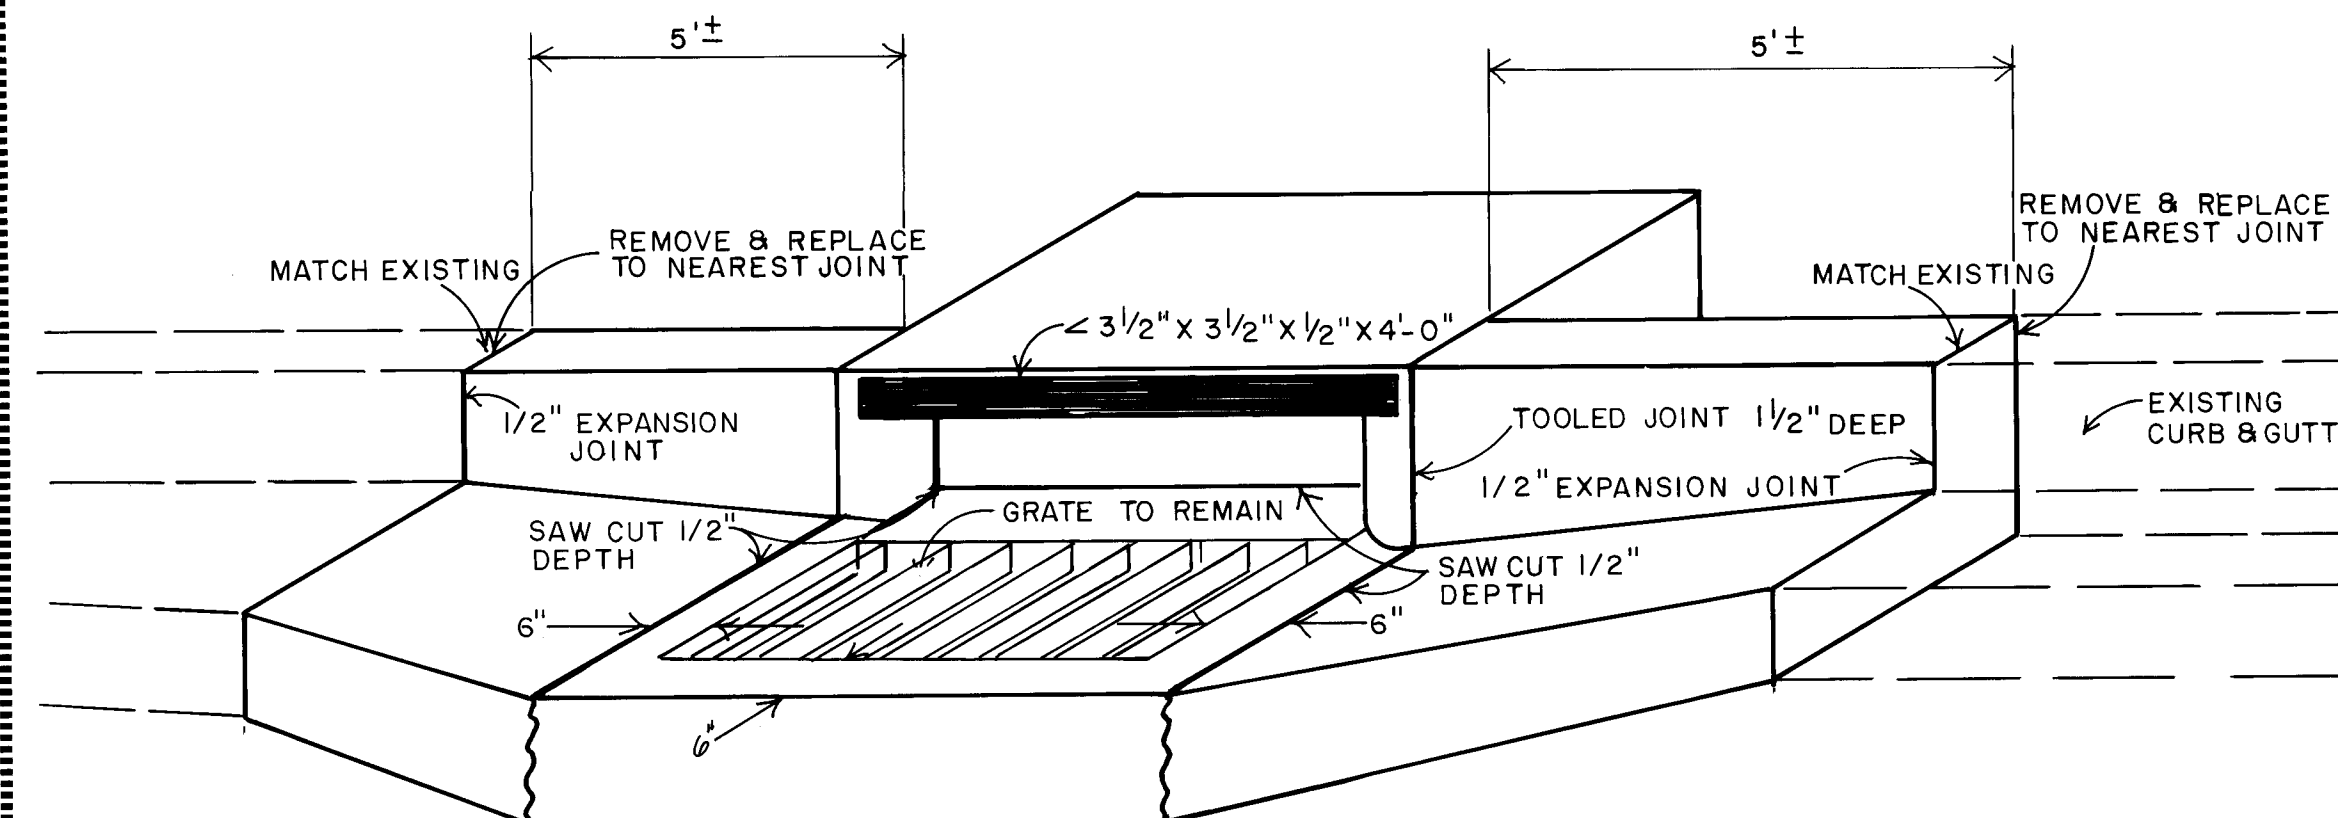

DETAIL "B"

NOT TO SCALE
AS PER STD DWG K-7

GENERAL NOTES

1. CONTRACTOR MUST OBTAIN A BARRICA-
DING PERMIT FOR EACH LOCATION 3 DAYS
PRIOR TO THE START OF CONSTRUCTION
2. CONTRACTOR MUST COMPLY WITH SECTION
19 OF THE INTERIM STANDARD SPECIFICA-
TIONS FOR PUBLIC WORKS CONSTRUC-
TION FOR THE CITY OF ALBUQUERQUE.


ENGINEER'S SEAL		SURVEY INFORMATION		BENCH MARKS		AS BUILT INFORMATION	
		FIELD NOTES					
		NO.	BY	DATE			
			KRAEMER	8/2/86	BM FOR ENSENADA AND PALO DURO DR. REF. 6-F-14 LOCATED AT THE N.E. QUADRANT OF 12TH STREET & GRIEGOS RD. ELEVATION 4970.16		CONTRACTOR <i>PRIDE CONSTE.</i> WORKMAN STARTED BY <i>CIT</i> INSPECTORS DATE <i>11/87</i> FIELD CHANGED BY <i>R. BACA</i> VERIFICATION BY <i>FIELD</i> DATE CORRECTED BY <i>EN.</i> DATE <i>12/87</i>
<i>Δ</i>	<i>12/10/87</i>				<i>BM for Park Ave. & 16th St. 6'-K/3</i> <i>Station is Located 34' NE From Centerline of</i> <i>Traylor Dr., 30.6 NW From Centerline of Alameda Ave.</i> <i>55' SW From Centerline of Riverside Drive</i> <i>Elevation 4956.35</i>		
NO.	DATE	REMARKS	BY				
DESIGN							
DESIGNED BY R. SALAZAR & F. A. U. S. & J. O. DATE 7/86							
DRAWN BY R. SALAZAR & F. A. U. S. & J. O. DATE 8/86							
CHECKED BY C. L. CON. DATE 9/86							

CITY OF ALBUQUERQUE
MUNICIPAL DEVELOPMENT DEPARTMENT
ENGINEERING DIVISION

TITLE: INLET REPAIRS VARIOUS LOCATIONS

APPROVALS	ENGINEER	DATE	APPROVALS	ENGINEER	DATE
City Engineer	<i>[Signature]</i>	11/13/86	Liquid Waste	<i>[Signature]</i>	11/7/86
A.C.E. Design	<i>[Signature]</i>	11/13/86	Traffic	<i>[Signature]</i>	11/7/86
A.C.E.-Hydrology	<i>[Signature]</i>	11/13/86	Water	<i>[Signature]</i>	11/7/86

DRAWING NO.	2830	MAP NO.	F-148 G-14	SHEET	2	OF	4
-------------	------	---------	------------	-------	---	----	---

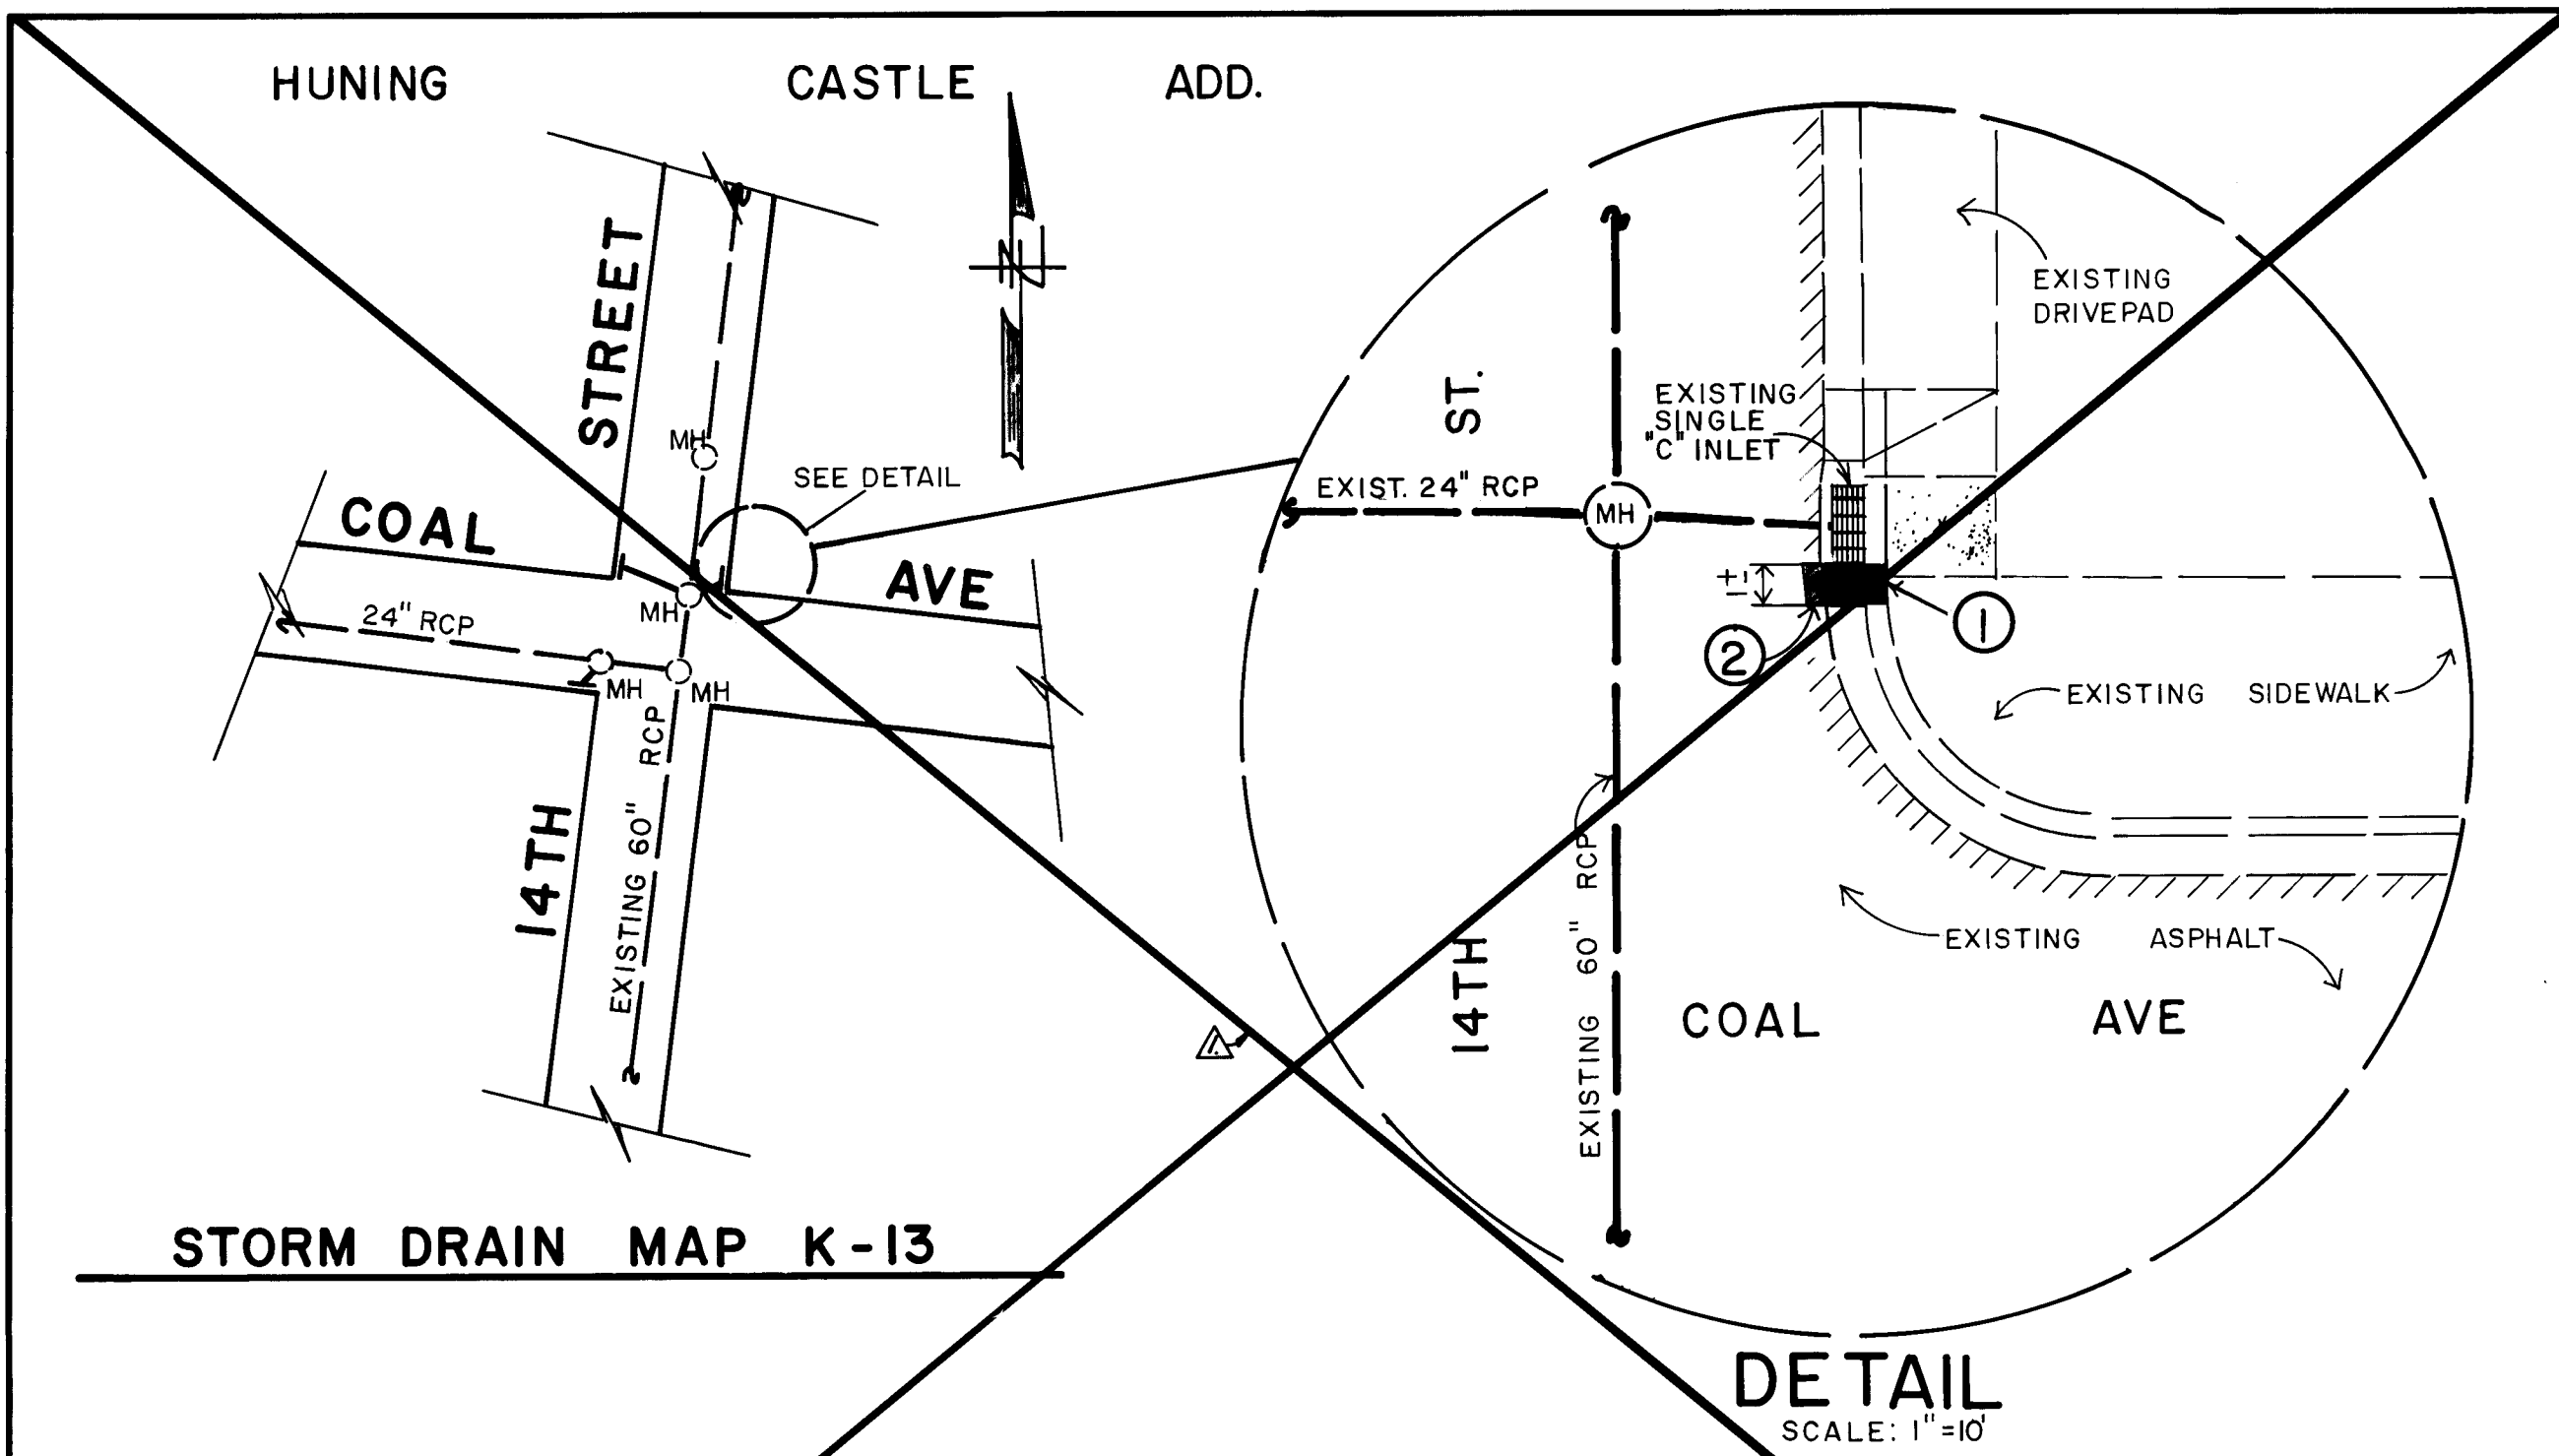

STORM DRAIN MAP K-13


CONSTRUCTION NOTES:

① REMOVE & REPLACE EXIST. CURB ONLY, SIM. TO DETAIL "B" SHEET 2

② REMOVE & REPLACE 1" ASPHALT PAVEMENT.

ALLOWED CONSTRUCTION TIME = 5 DAYS

COAL AVE & FOURTEENTH ST.

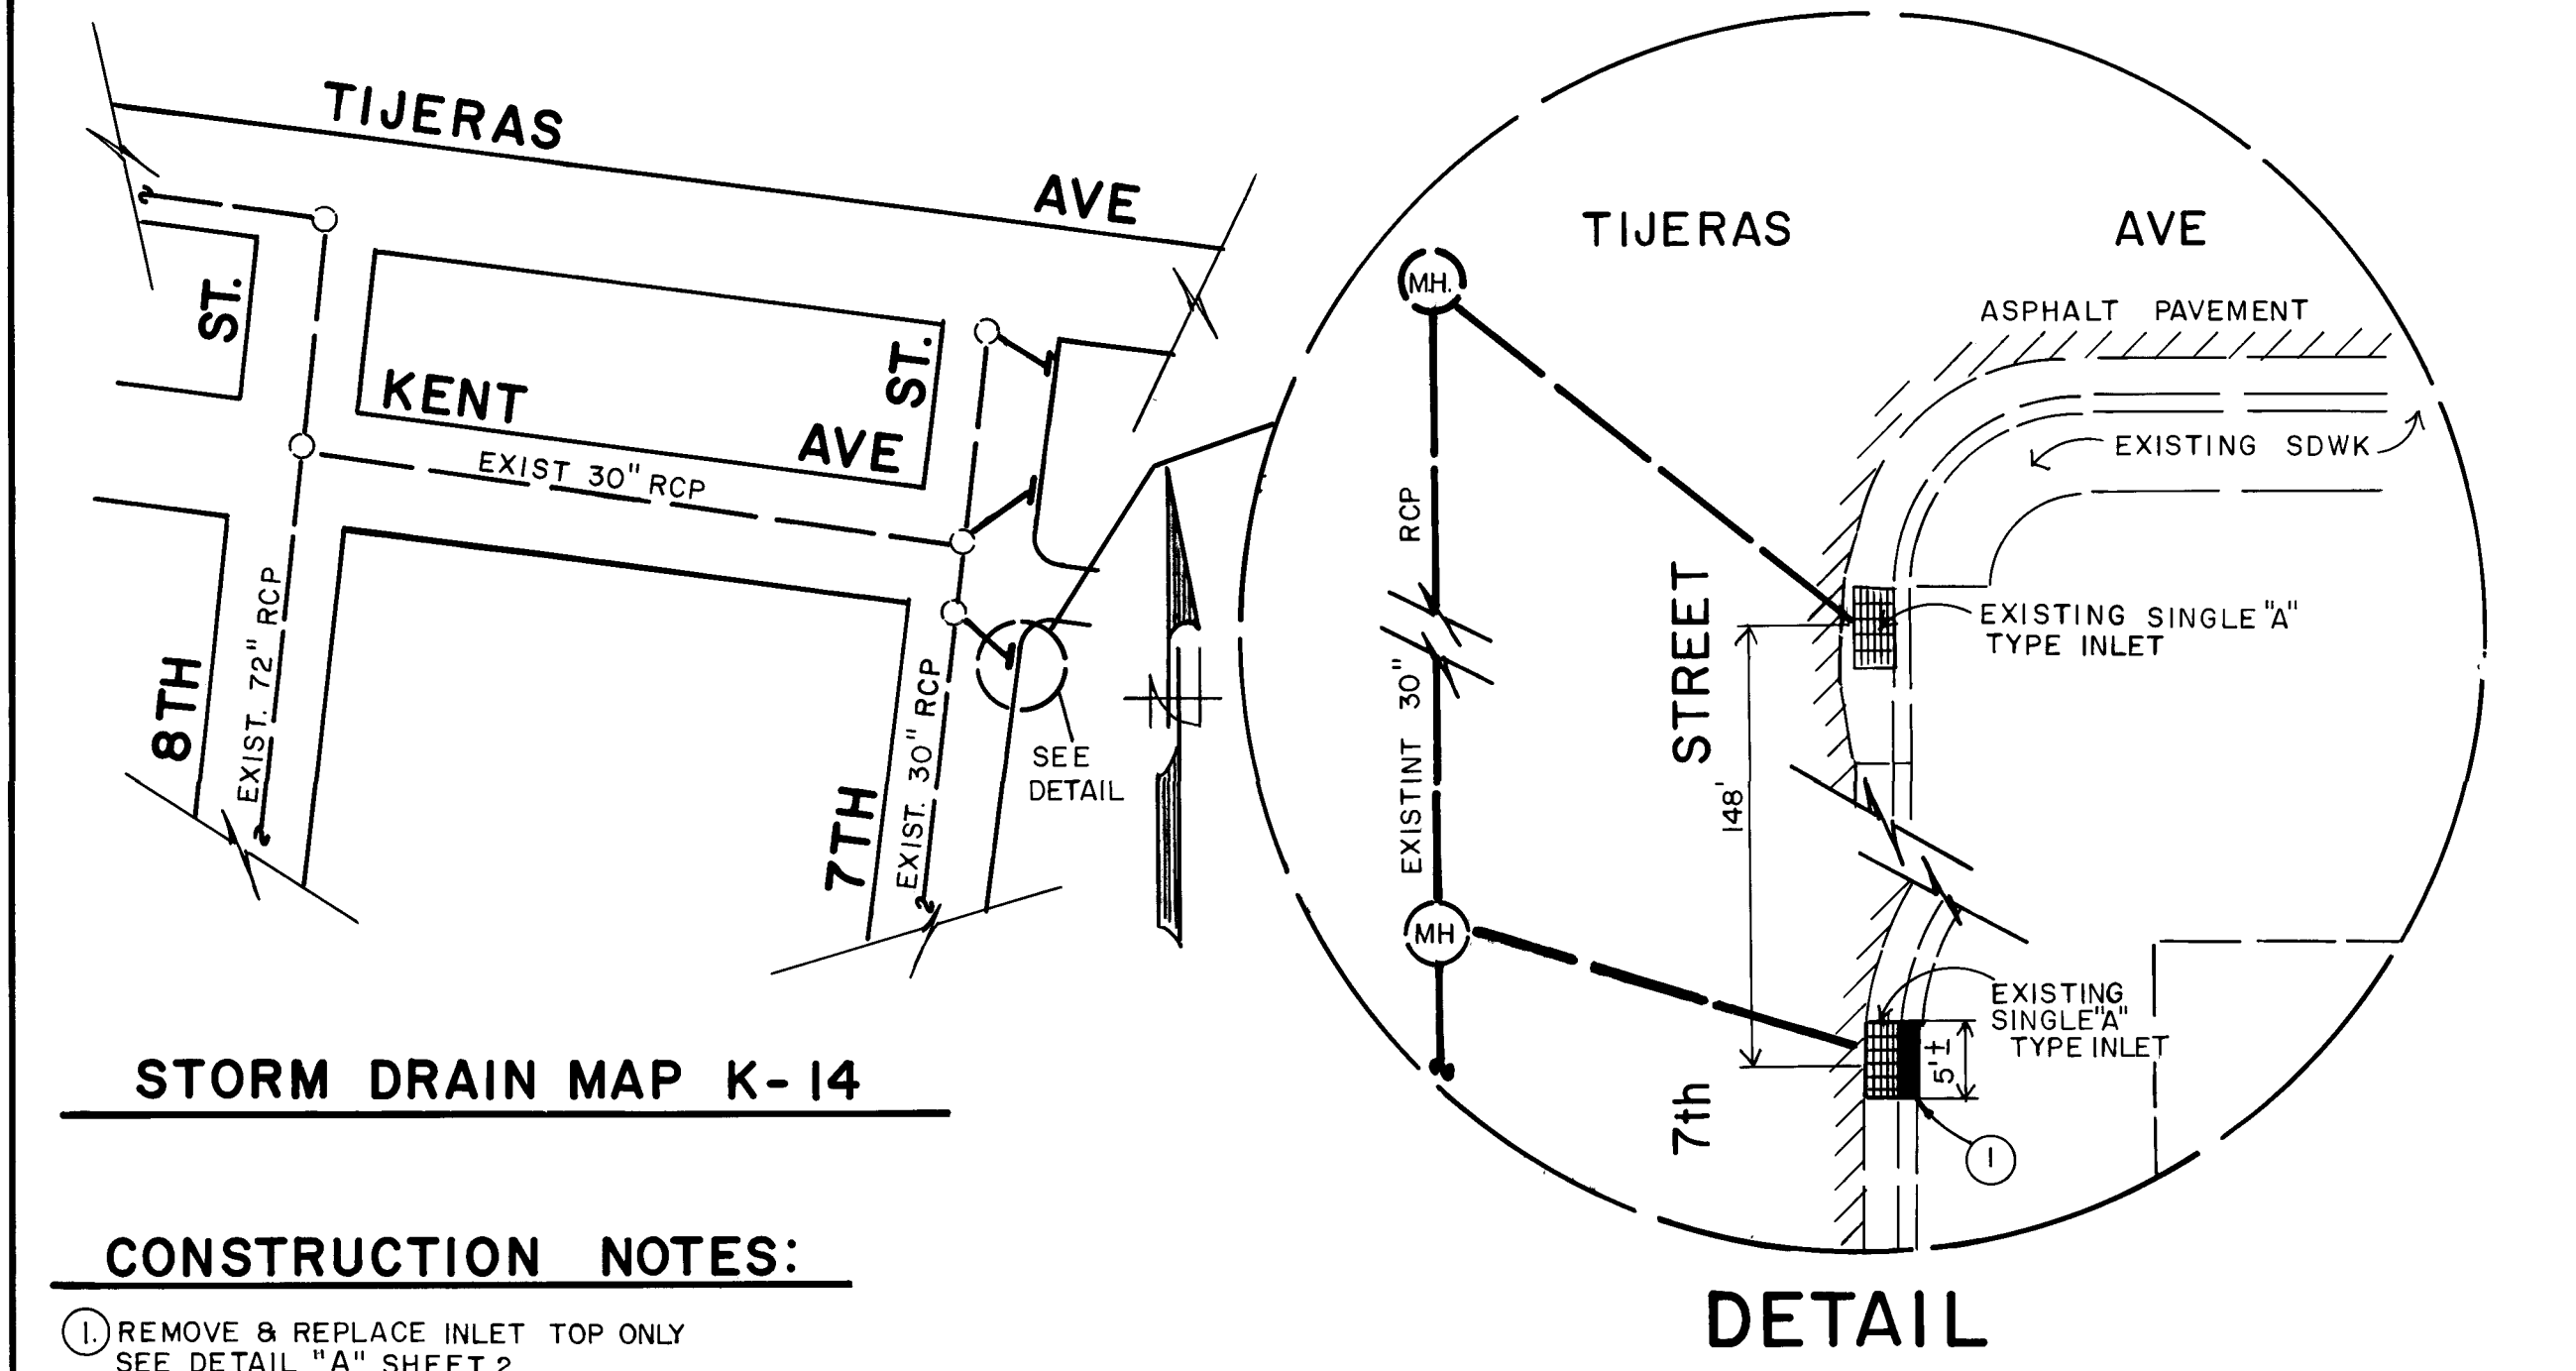


STORM DRAIN MAP K-14

CONSTRUCTION NOTES:

① REMOVE & REPLACE INLET TOP ONLY SEE DETAIL "A" SHEET 2

ALLOWED CONSTRUCTION TIME = 5 DAYS

7TH STREET & KENT AVE

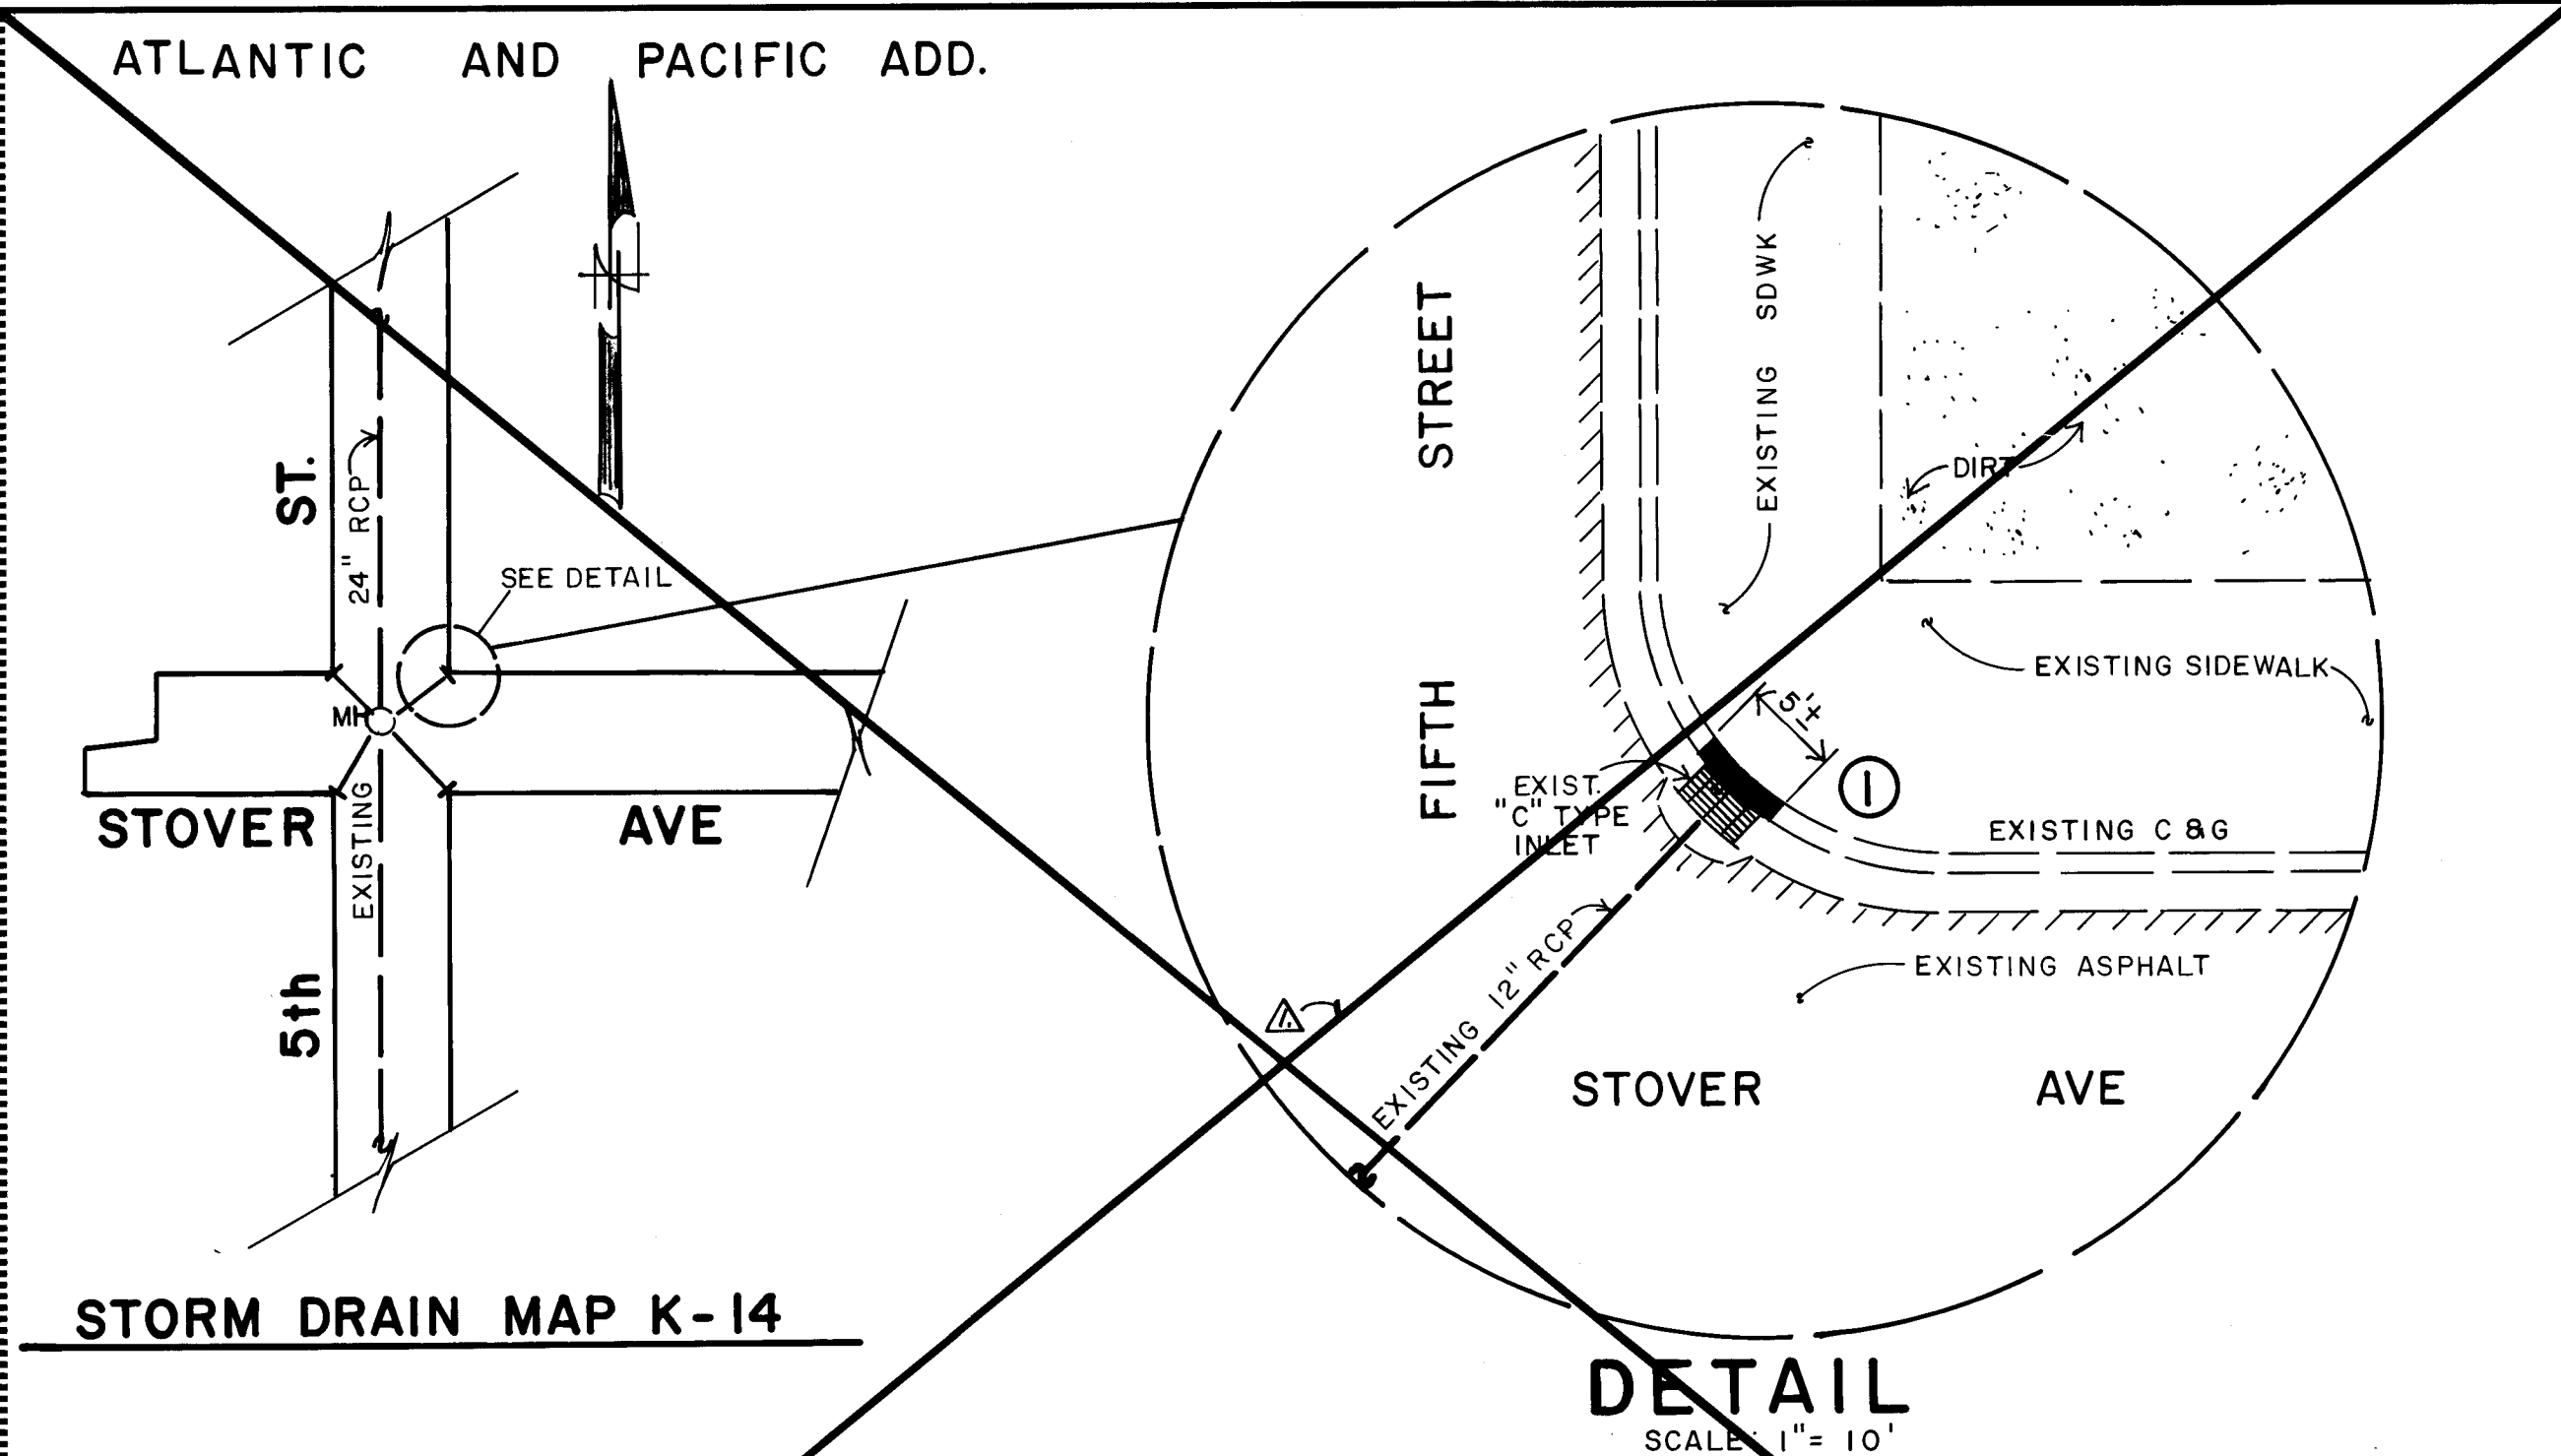


STORM DRAIN MAP K-14

CONSTRUCTION NOTES:

① REMOVE & REPLACE INLET TOP ONLY, SEE DETAIL "A" SHEET 2

ALLOWED CONSTRUCTION TIME = 5 DAYS

FIFTH ST. & STOVER

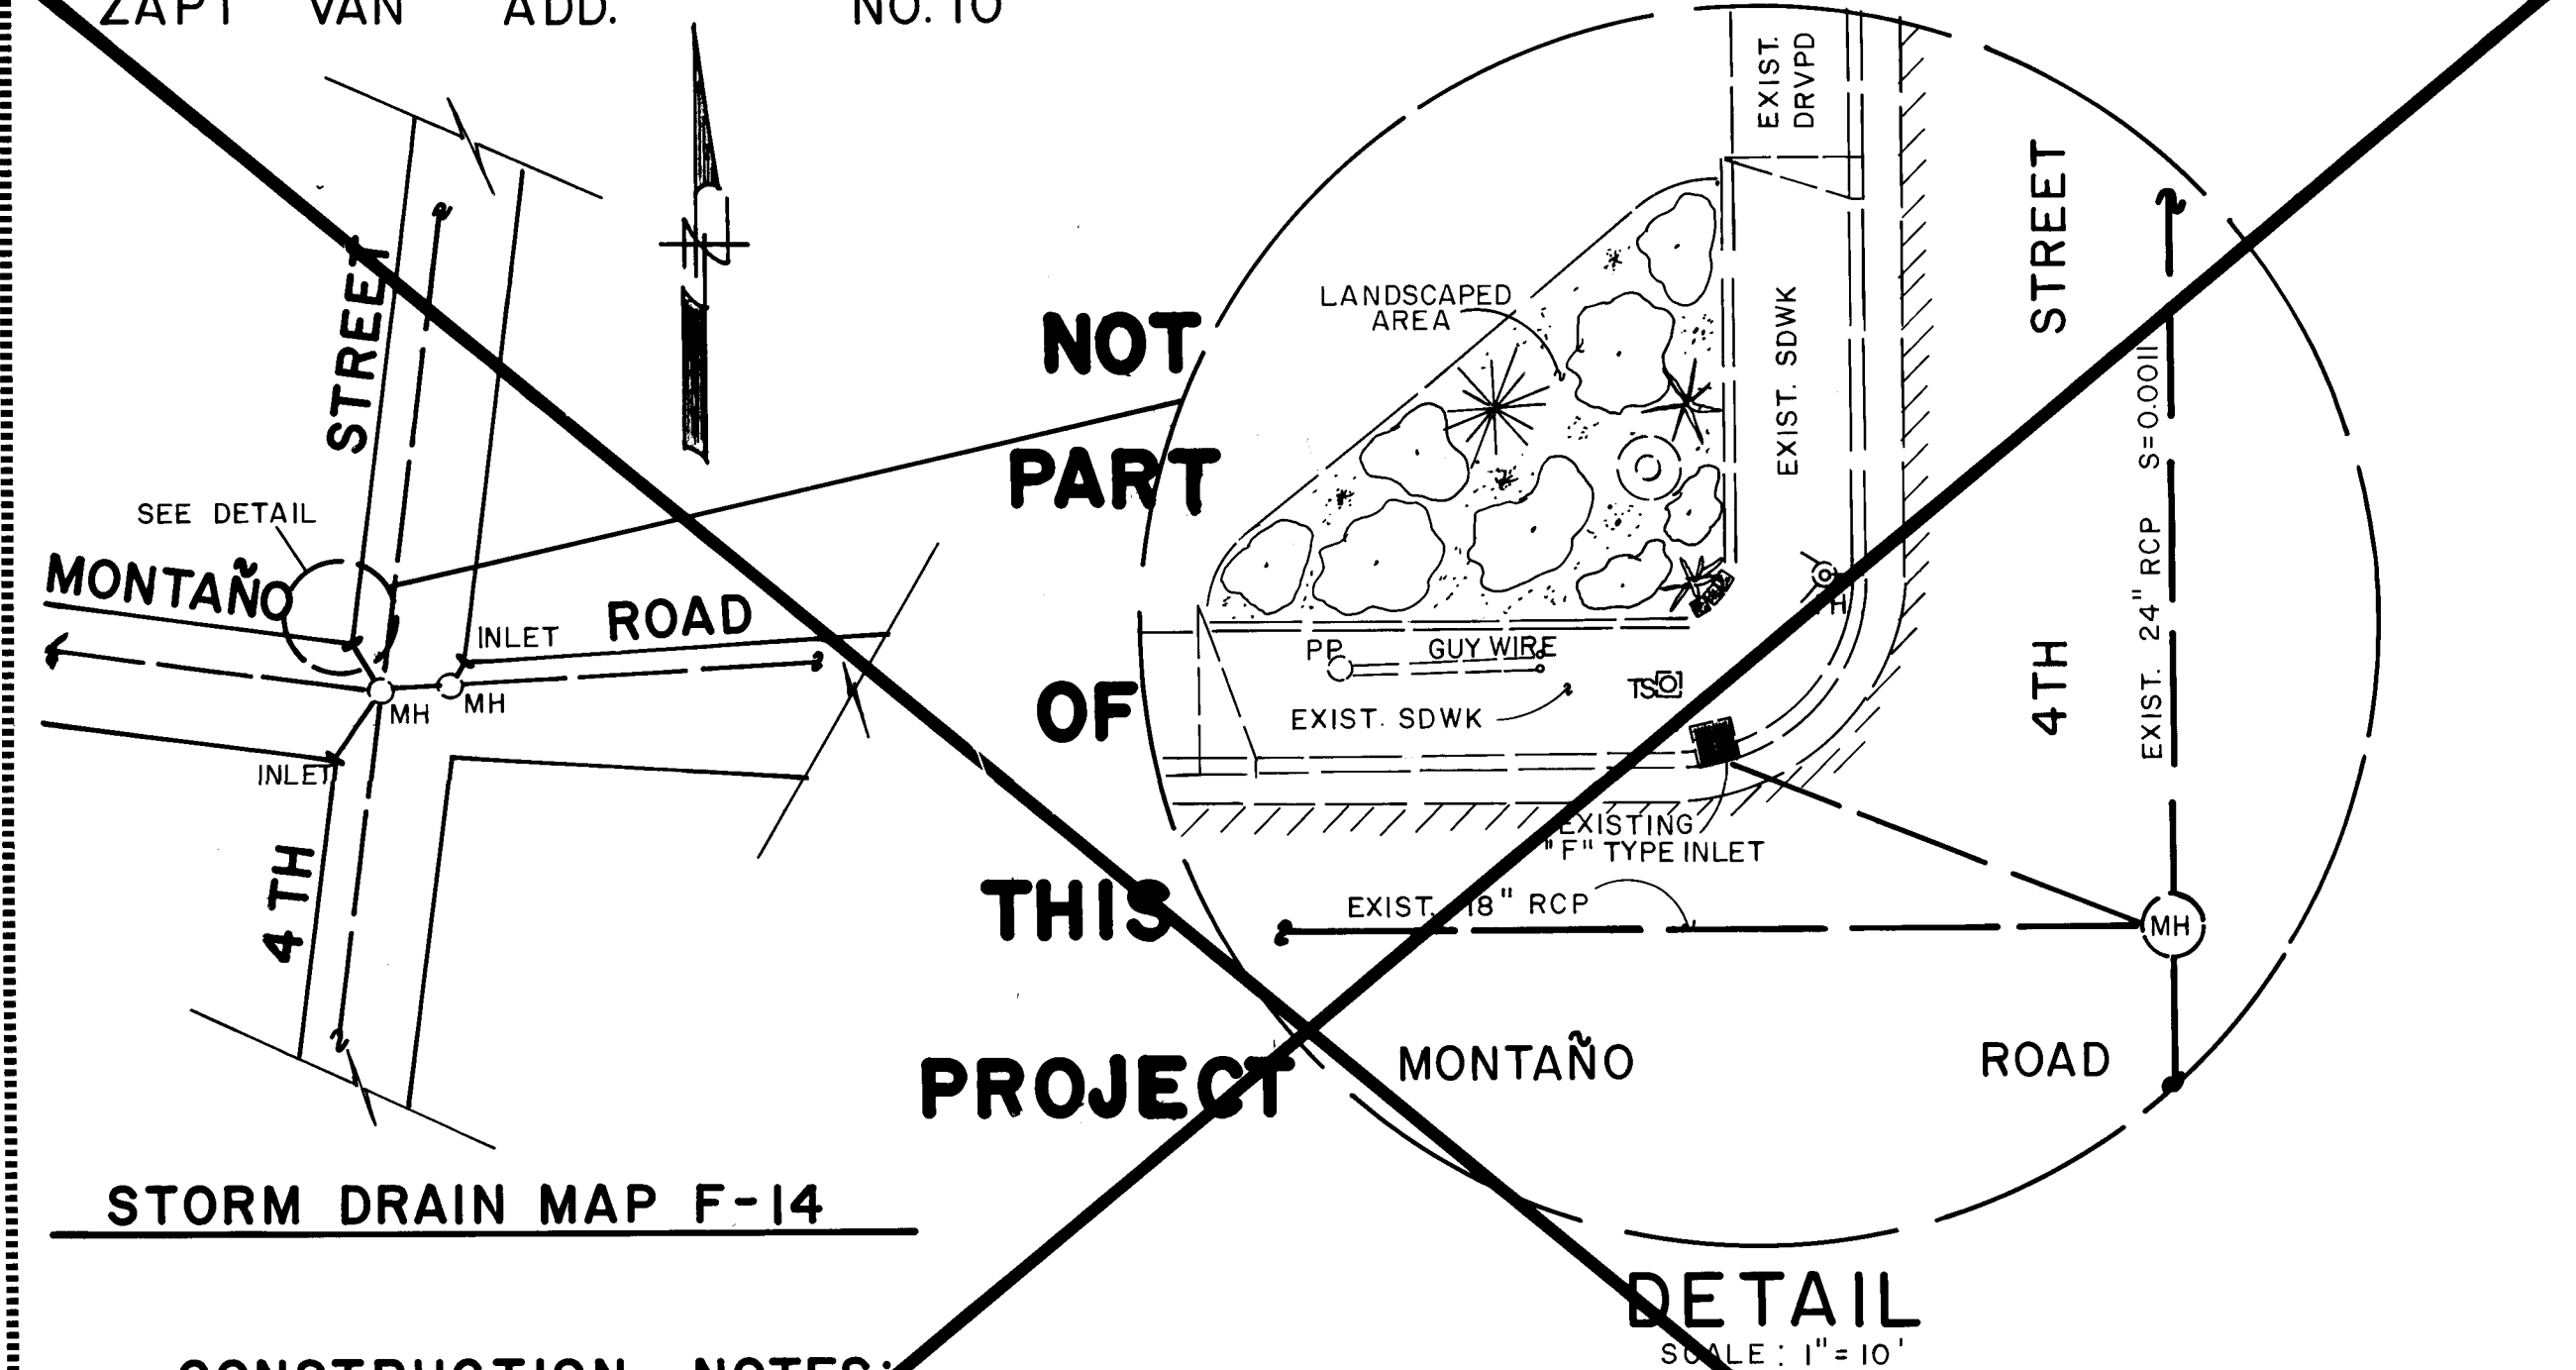

STORM DRAIN MAP F-14

CONSTRUCTION NOTES:

① REMOVE & REPLACE INLET TOP ONLY SEE DETAIL "A" SHEET 2

ALLOWED CONSTRUCTION TIME = 5 DAYS

MONTAÑO RD. & FOURTH ST.

GENERAL NOTES

1. CONTRACTOR MUST OBTAIN A BARRICADING PERMIT FOR EACH LOCATION 3 DAYS PRIOR TO START OF CONSTRUCTION.

2. CONTRACTOR MUST COMPLY WITH SECTION 19 OF THE INTERIM STANDARD SPECIFICATIONS FOR PUBLIC WORKS CONSTRUCTION FOR THE CITY OF ALBUQUERQUE.

AS BUILT INFORMATION		BENCH MARKS		SURVEY INFORMATION		ENGINEER'S SEAL	
CONTRACTOR	DATE	NO.	BY	NO.	BY	NO.	BY
CONTRACTOR	DATE	NO.	BY	NO.	BY	NO.	BY
WORK	DATE	NO.	BY	NO.	BY	NO.	BY
INSPECTION	DATE	NO.	BY	NO.	BY	NO.	BY
ACCEPTANCE BY	DATE	NO.	BY	NO.	BY	NO.	BY
VERIFICATION BY	DATE	NO.	BY	NO.	BY	NO.	BY
DRAWINGS	DATE	NO.	BY	NO.	BY	NO.	BY
MICRO-FILM INFORMATION	DATE	NO.	BY	NO.	BY	NO.	BY

DESIGNED BY R. SALAZAR DATE 7/86

DRAWN BY R. SALAZAR DATE 8/86

CHECKED BY G. OLSON DATE 9/86


26 283 00387

CITY OF ALBUQUERQUE
MUNICIPAL DEVELOPMENT DEPARTMENT
ENGINEERING DIVISION

TITLE: **INLET REPAIRS VARIOUS LOCATIONS**

APPROVALS	ENGINEER	DATE	APPROVALS	ENGINEER	DATE
City Engineer	W	11/13/84	Liquid Waste	W	11/7/86
A.C.E. Design	W	11/13/84	Traffic	W	11/7/86
A.C.E. Hydrology	W	11/13/84	Water	W	11/7/86

DRAWING NO. **2830** MAP NO. **K-13,14 F-14** SHEET **3** OF **4**

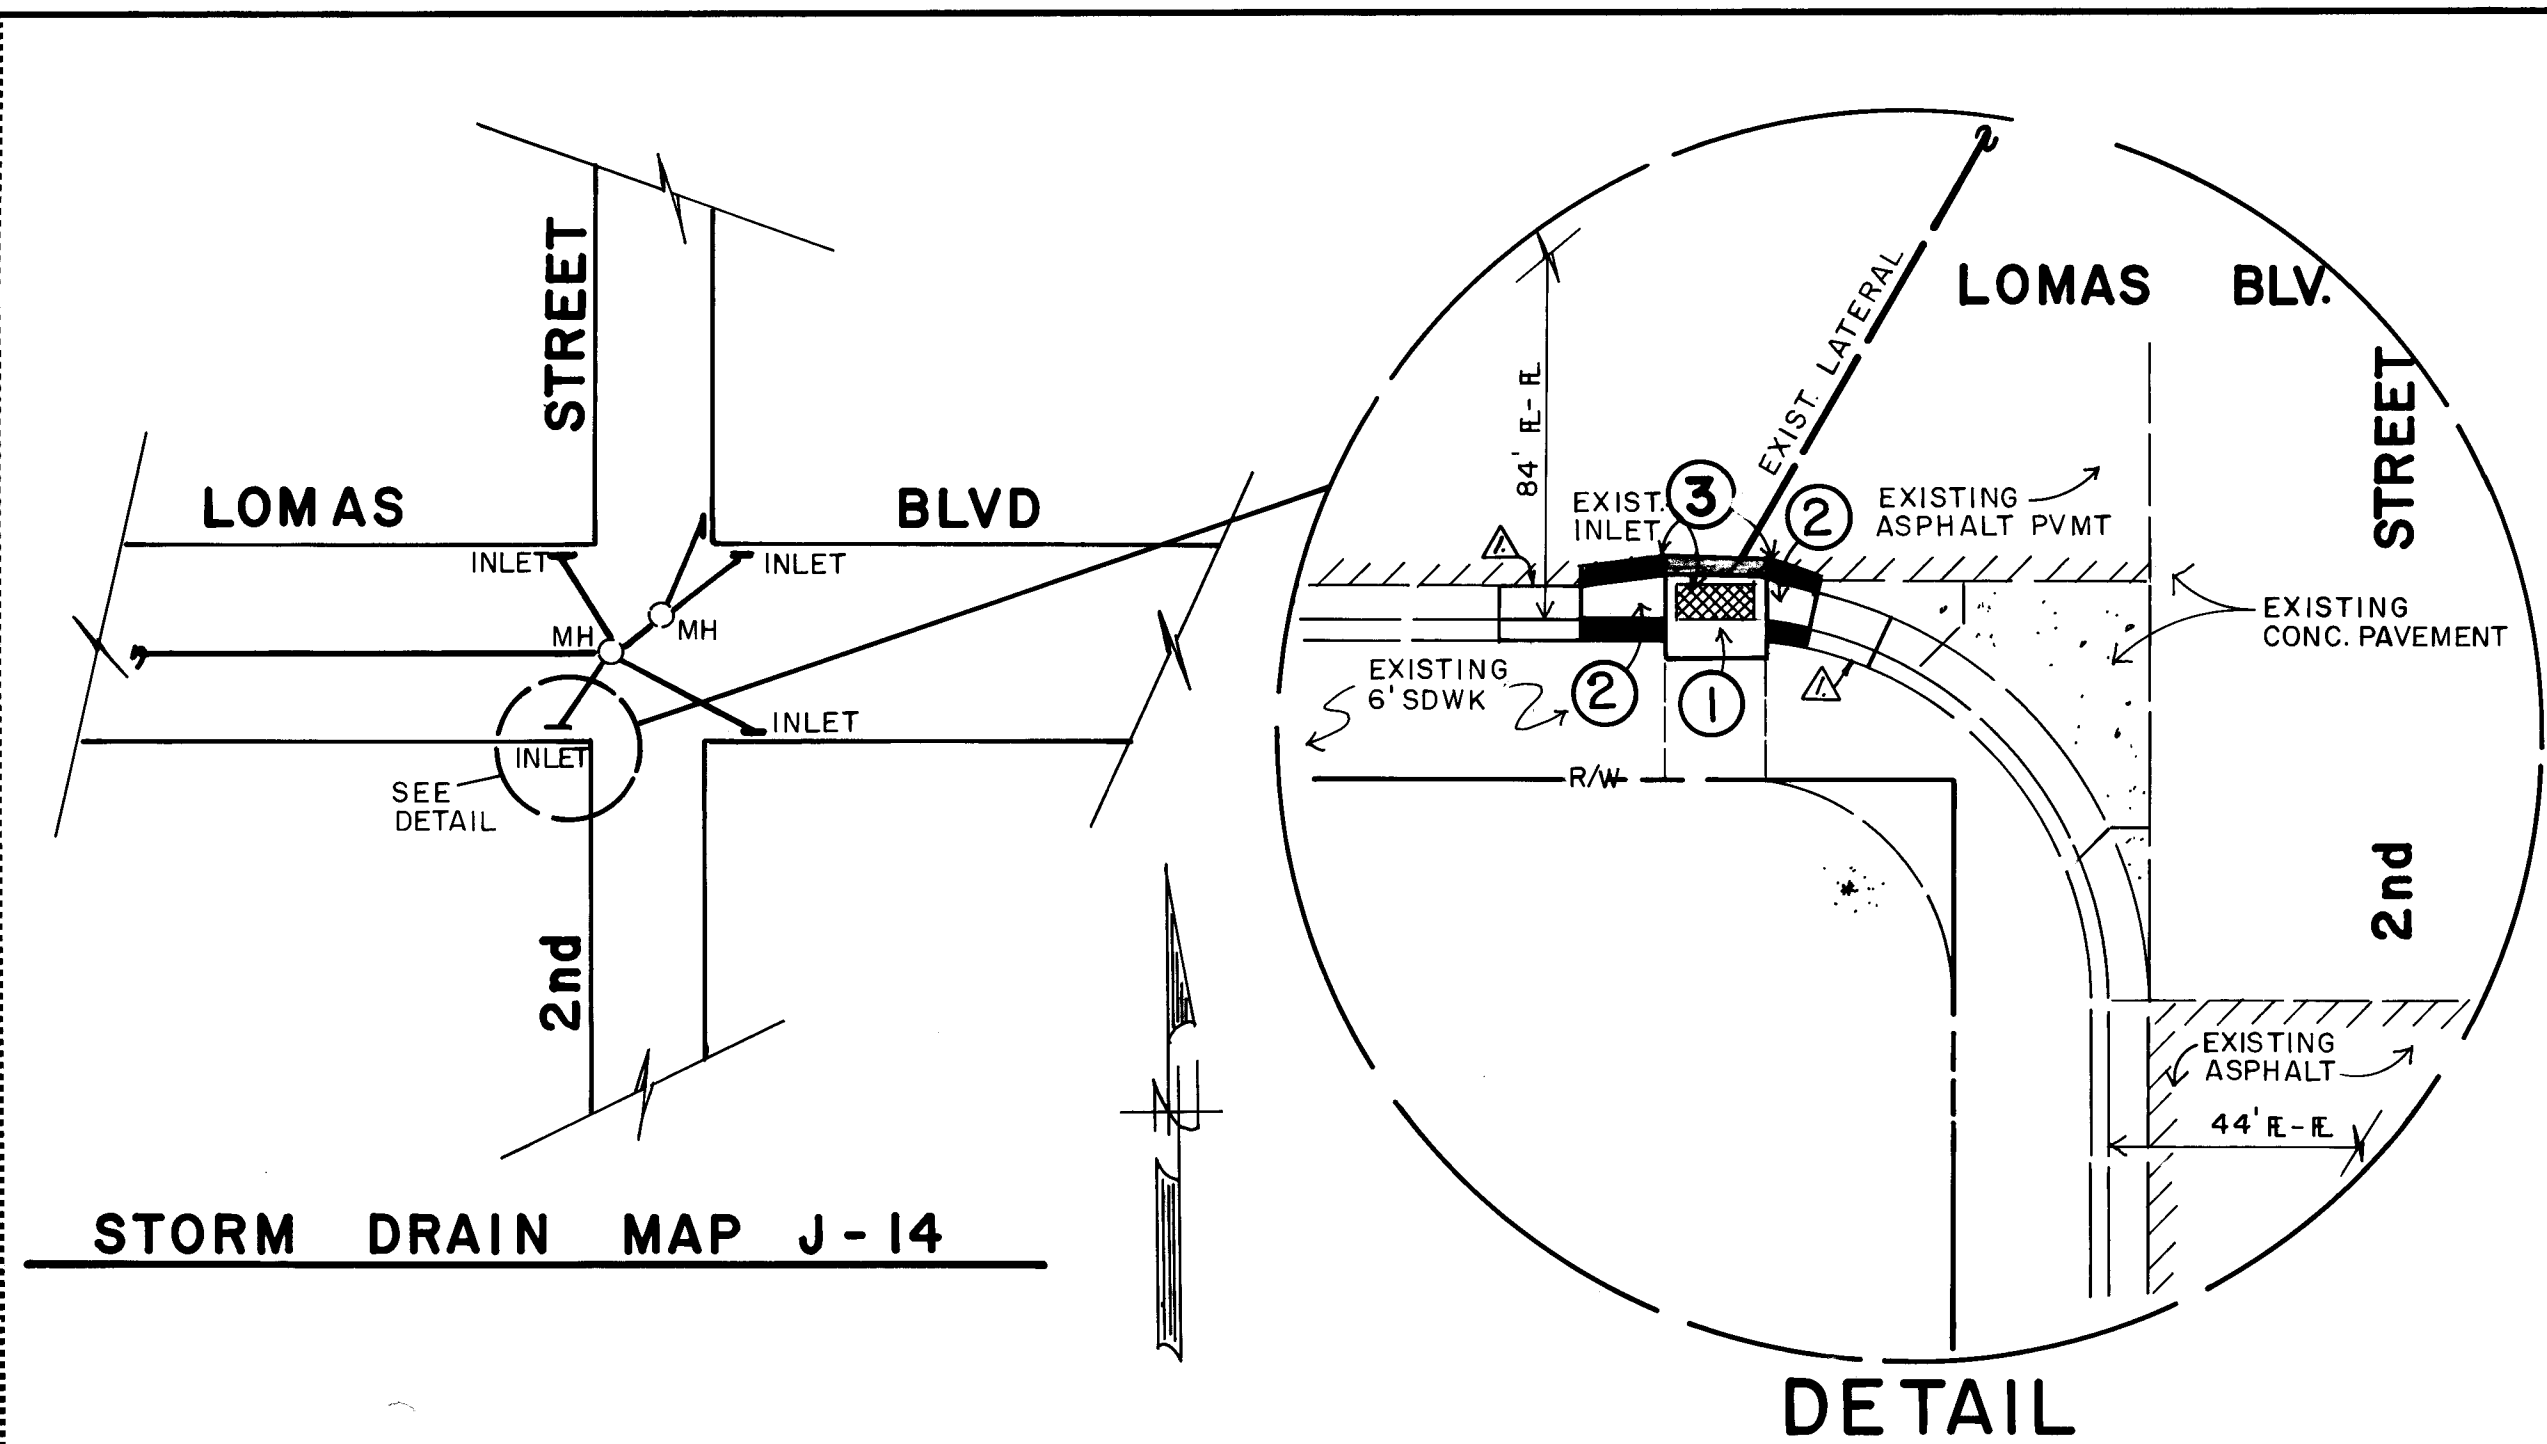

STORM DRAIN MAP M - 9

STORM DRAIN MAP J-14

DETAIL
SCALE: 1" = 10'

CONSTRUCTION NOTES:

- ① REMOVE TOP OF INLET BOX TO $\pm 12"$ BELOW E.L. RECONSTRUCT WITH NEW FRAME & GRATE SIMILAR AS PER STD. DWG. K-4.
- ② REMOVE & RECONSTRUCT CURB & GUTTER EACH SIDE OF INLET, SIMILAR TO DETAIL "B" SHEET 2
- ③ REMOVE & REPLACE 1' WIDE ARTERIAL ASPHALT PAVEMENT.
- ⚠ ④ FUSH CULVERT PIPE AS PART OF REHABILITATION (ENTIRE LENGTH)


CONSTRUCTION NOTES:

- ① REMOVE EXIST. INLET TO 4" BELOW E. AND RECONST. TO MATCH EXISTING. REFURBISH AND REINSTALL EXIST FRAME GRATE & NOSING.
- ② REMOVE & REPLACE TO NEAREST JOINT. SIMILAR TO DETAIL "B" SHEET 2.
- ③ REMOVE & REPLACE 1' WIDE ARTERIAL ASPHALT PAVEMENT.

ALLOWED CONST. TIME = 12 DAYS 98TH STREET & SAGE RD.

ALLOWED CONSTRUCTION TIME = 5 DAYS

LOMAS BLVD. & 2ND STREET

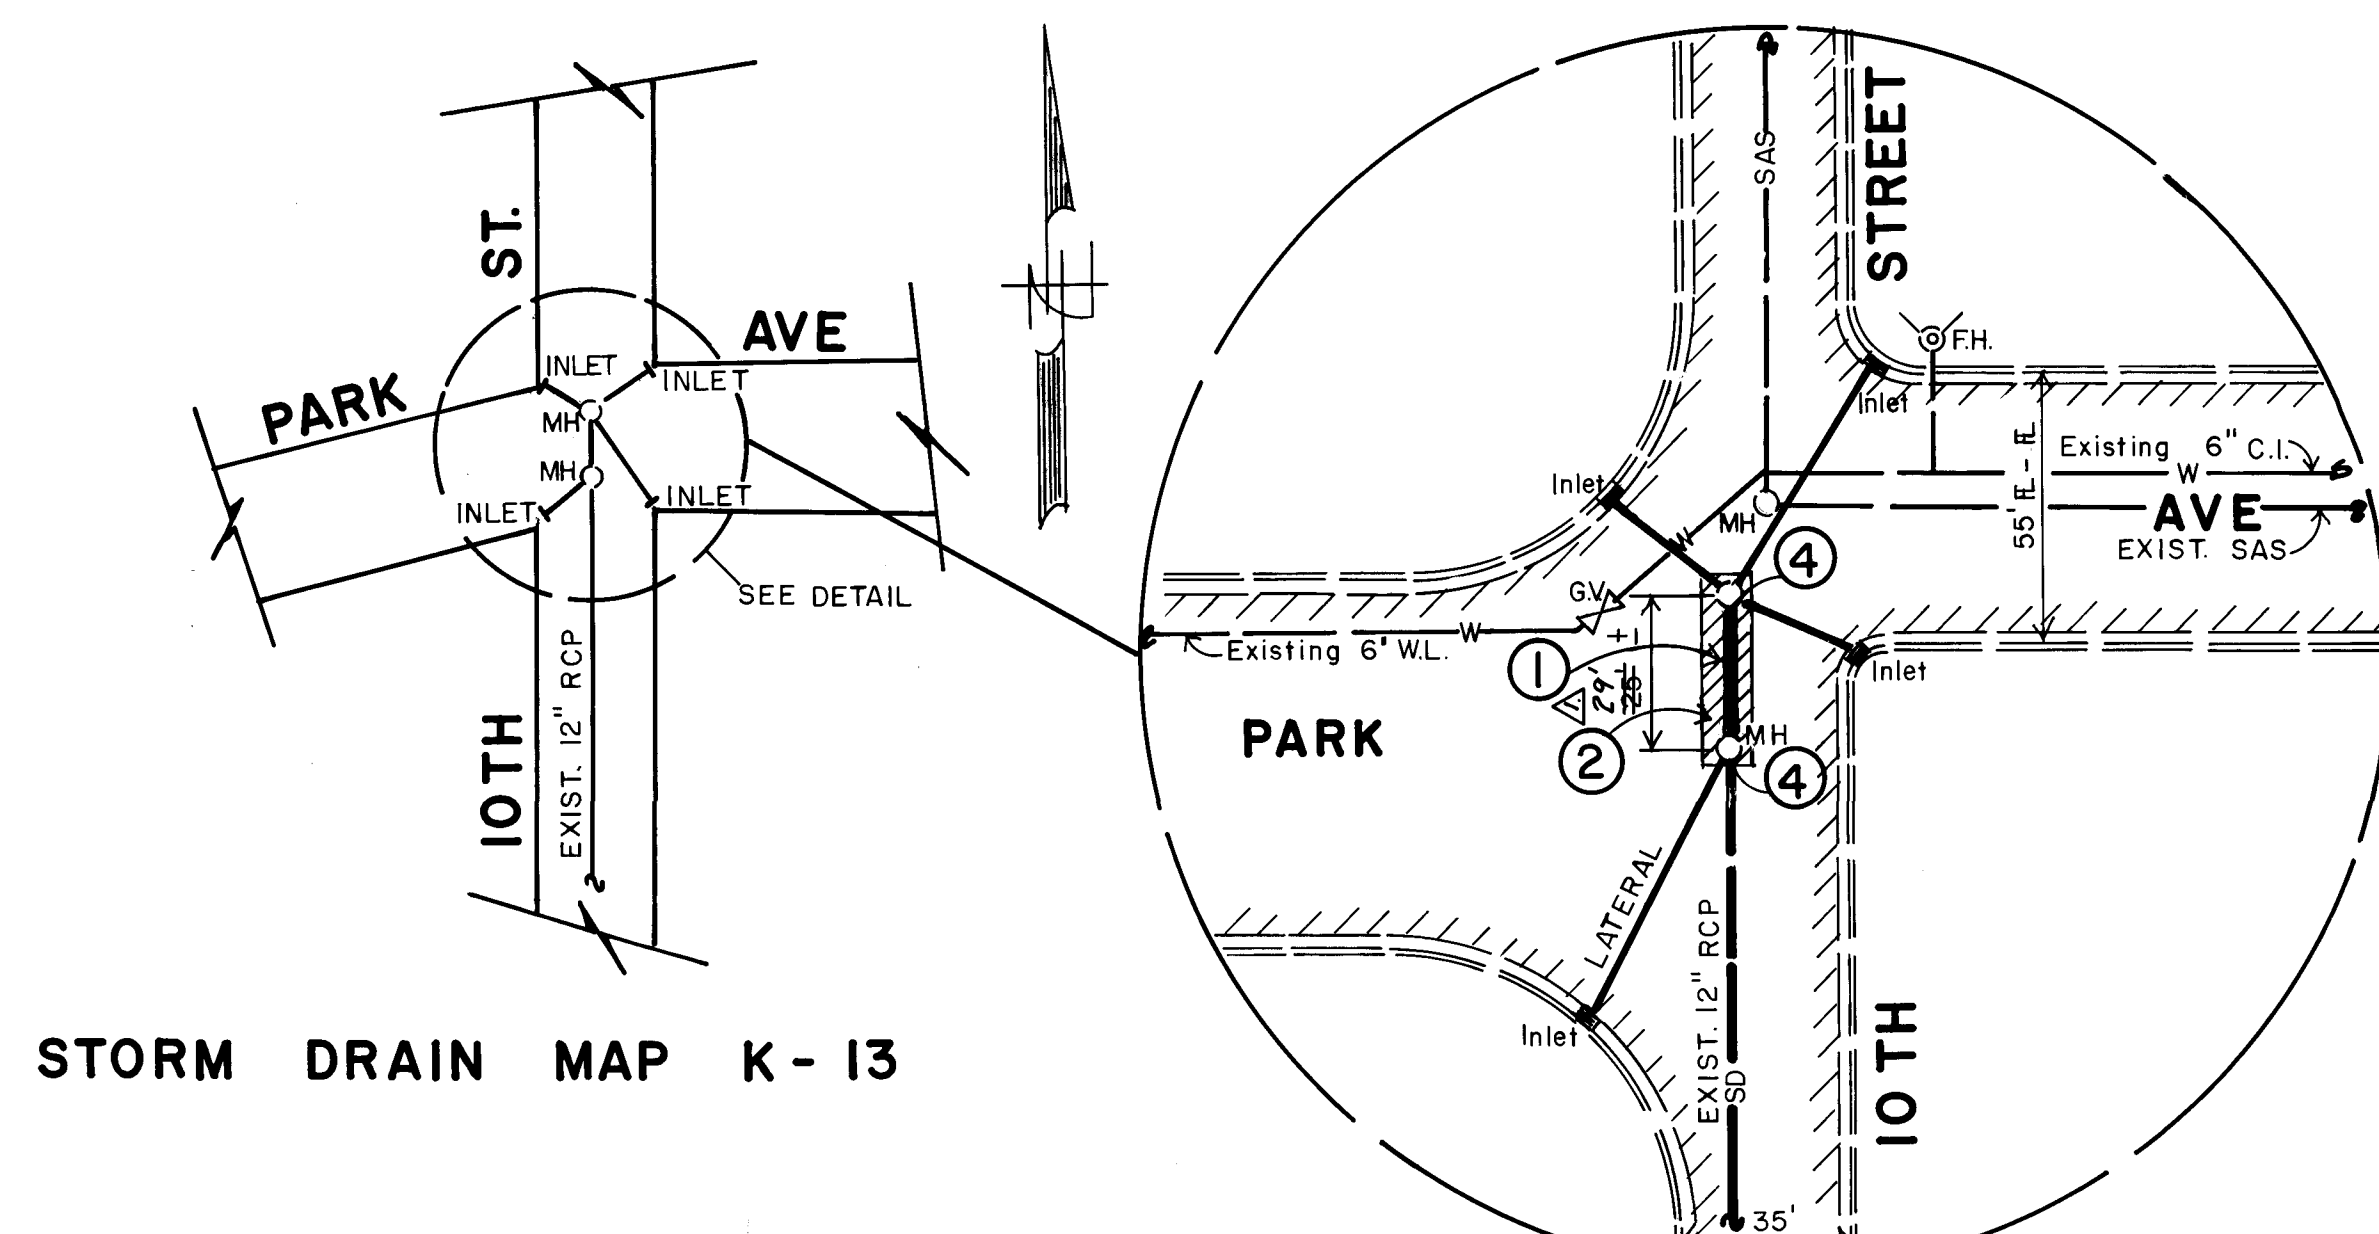


STORM DRAIN MAP K - 13

DETAIL

CONSTRUCTION NOTES:

- ① ~~REMOVE EXISTING BROKEN 12" RCP FROM MH#S192 & (RECORDS)~~
~~MH#S193 AND REPLACE WITH CLASS III 12" RCP.~~
- ② REMOVE & REPLACE ARTERIAL ASPHALT PAVEMENT. PER STD. P-25
- ③ RECONSTRUCT MAN HOLE COLLARS.
- ④ MATCH EXISTING INVERT ELEVATIONS AT EACH END OF PIPE. APPROXIMATE RIM TO INVERT IS $\pm 6'$.

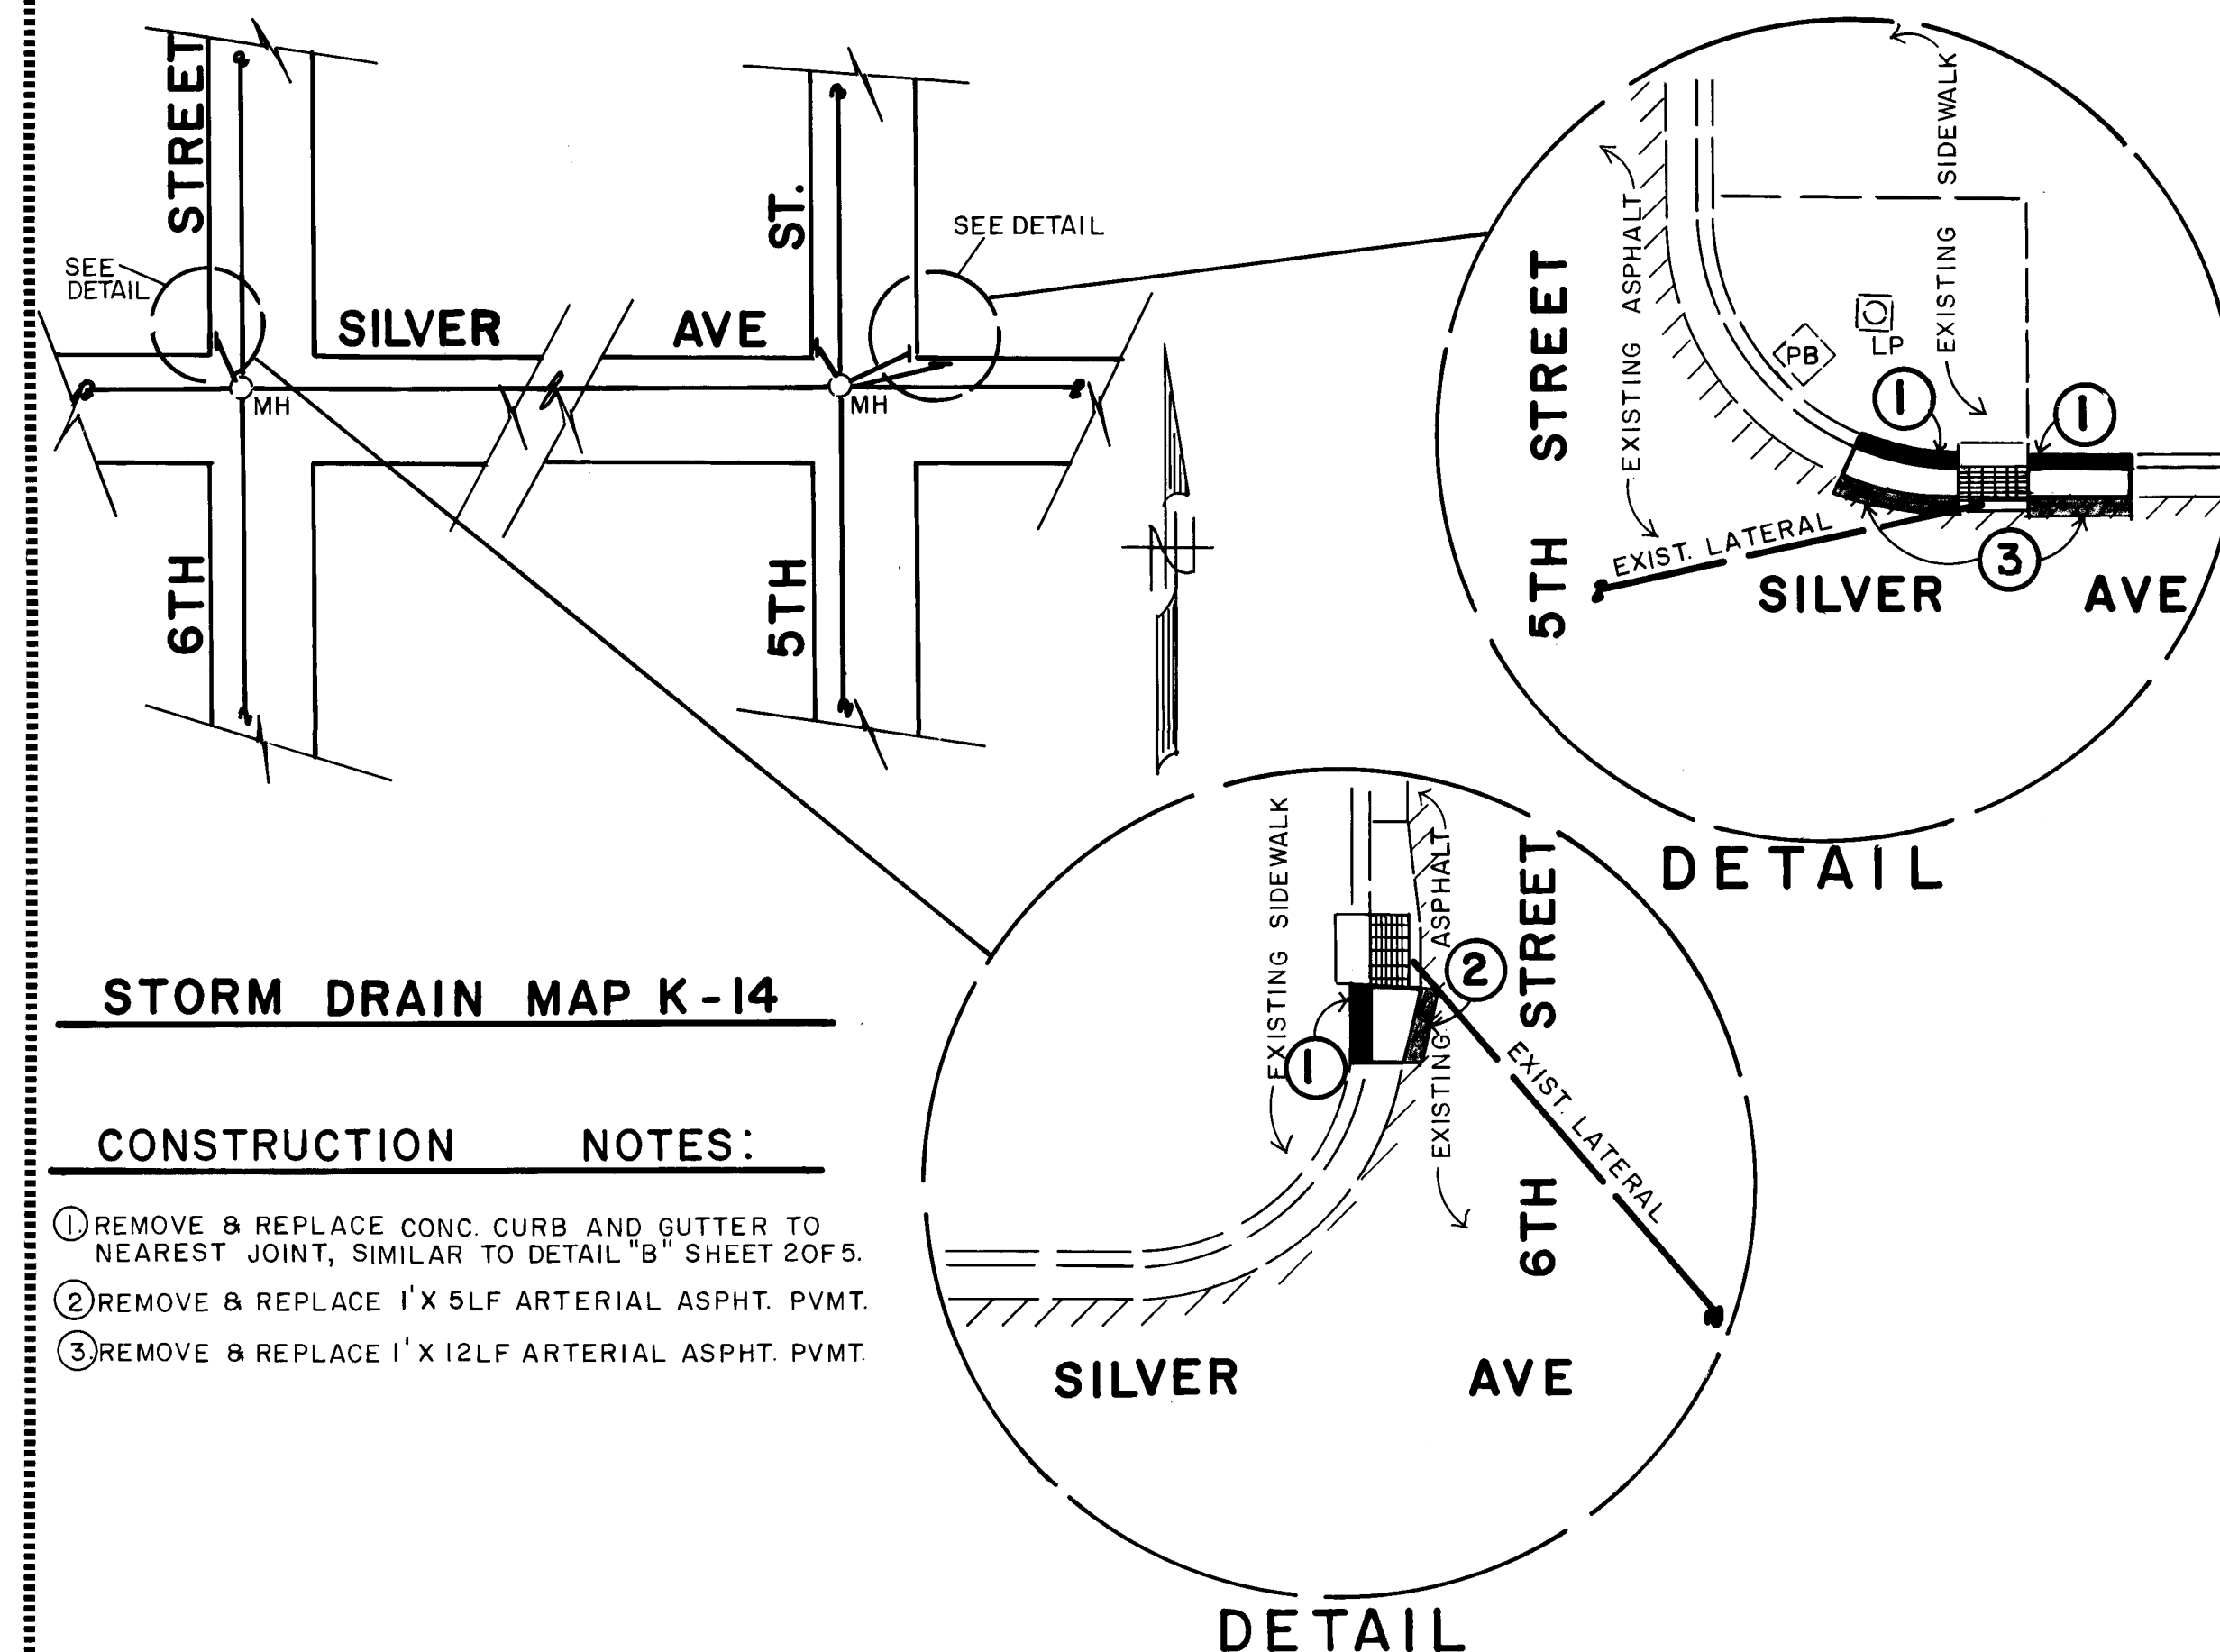


STORM DRAIN MAP K-14

CONSTRUCTION NOTES:

- ① REMOVE & REPLACE CONC. CURB AND GUTTER TO NEAREST JOINT, SIMILAR TO DETAIL "B" SHEET 20F5.
- ② REMOVE & REPLACE 1'X 5LF ARTERIAL ASPHT. PVMT.
- ③ REMOVE & REPLACE 1'X 12LF ARTERIAL ASPHT. PVMT.

ALLOWED CONSTRUCTION TIME = 5 DAYS

SILVER AVE @ 5TH & 6TH STREETS

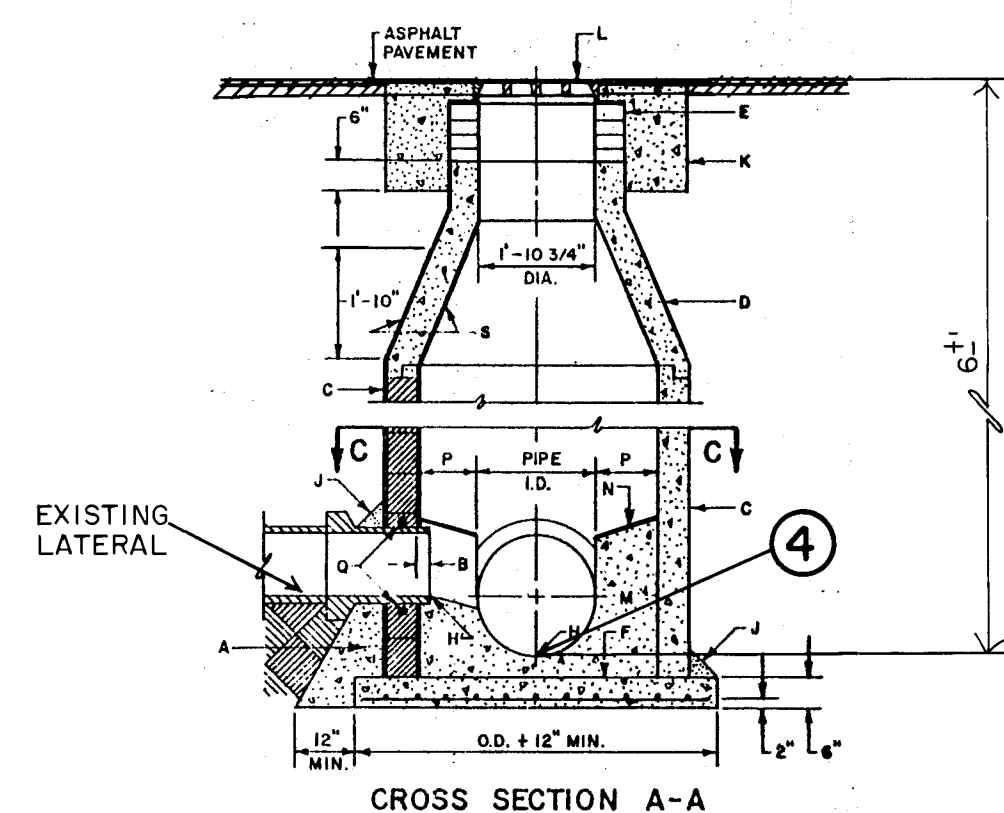

CROSS SECTION A-A

ALLOWED CONST. TIME = 12 DAYS

10TH STREET & PARK AVE

GENERAL NOTES

1. CONTRACTOR MUST OBTAIN A BARRICADING PERMIT FOR EACH LOCATION 3 DAYS PRIOR TO THE START OF CONSTRUCTION.
2. CONTRACTOR MUST COMPLY WITH SECTION 19 OF THE INTERIM STANDARD SPECIFICATIONS FOR PUBLIC WORKS CONSTRUCTION FOR CITY OF ALBUQUERQUE.

[illegible]

2	6	2	8	3	0	0	4	8	7
---	---	---	---	---	---	---	---	---	---

CITY OF ALBUQUERQUE
MUNICIPAL DEVELOPMENT DEPARTMENT
ENGINEERING DIVISION

TITLE: **INLET REPAIRS VARIOUS LOCATIONS**

APPROVALS	ENGINEER	DATE	APPROVALS	ENGINEER	DATE
City Engineer	<i>[Signature]</i>	11/3/84	Liquid Waste	<i>[Signature]</i>	11/7/86
A.C.E. Design	<i>[Signature]</i>	11/3/86	Traffic	<i>[Signature]</i>	11/7/86
A.C. E.-Hydrology	<i>[Signature]</i>	11/3/86	Water	<i>[Signature]</i>	11/7/86

DRAWING NO.	2830	MAP NO. M-9, J-14, K13,15	SHEET 4 OF 4
-------------	------	------------------------------	--------------