

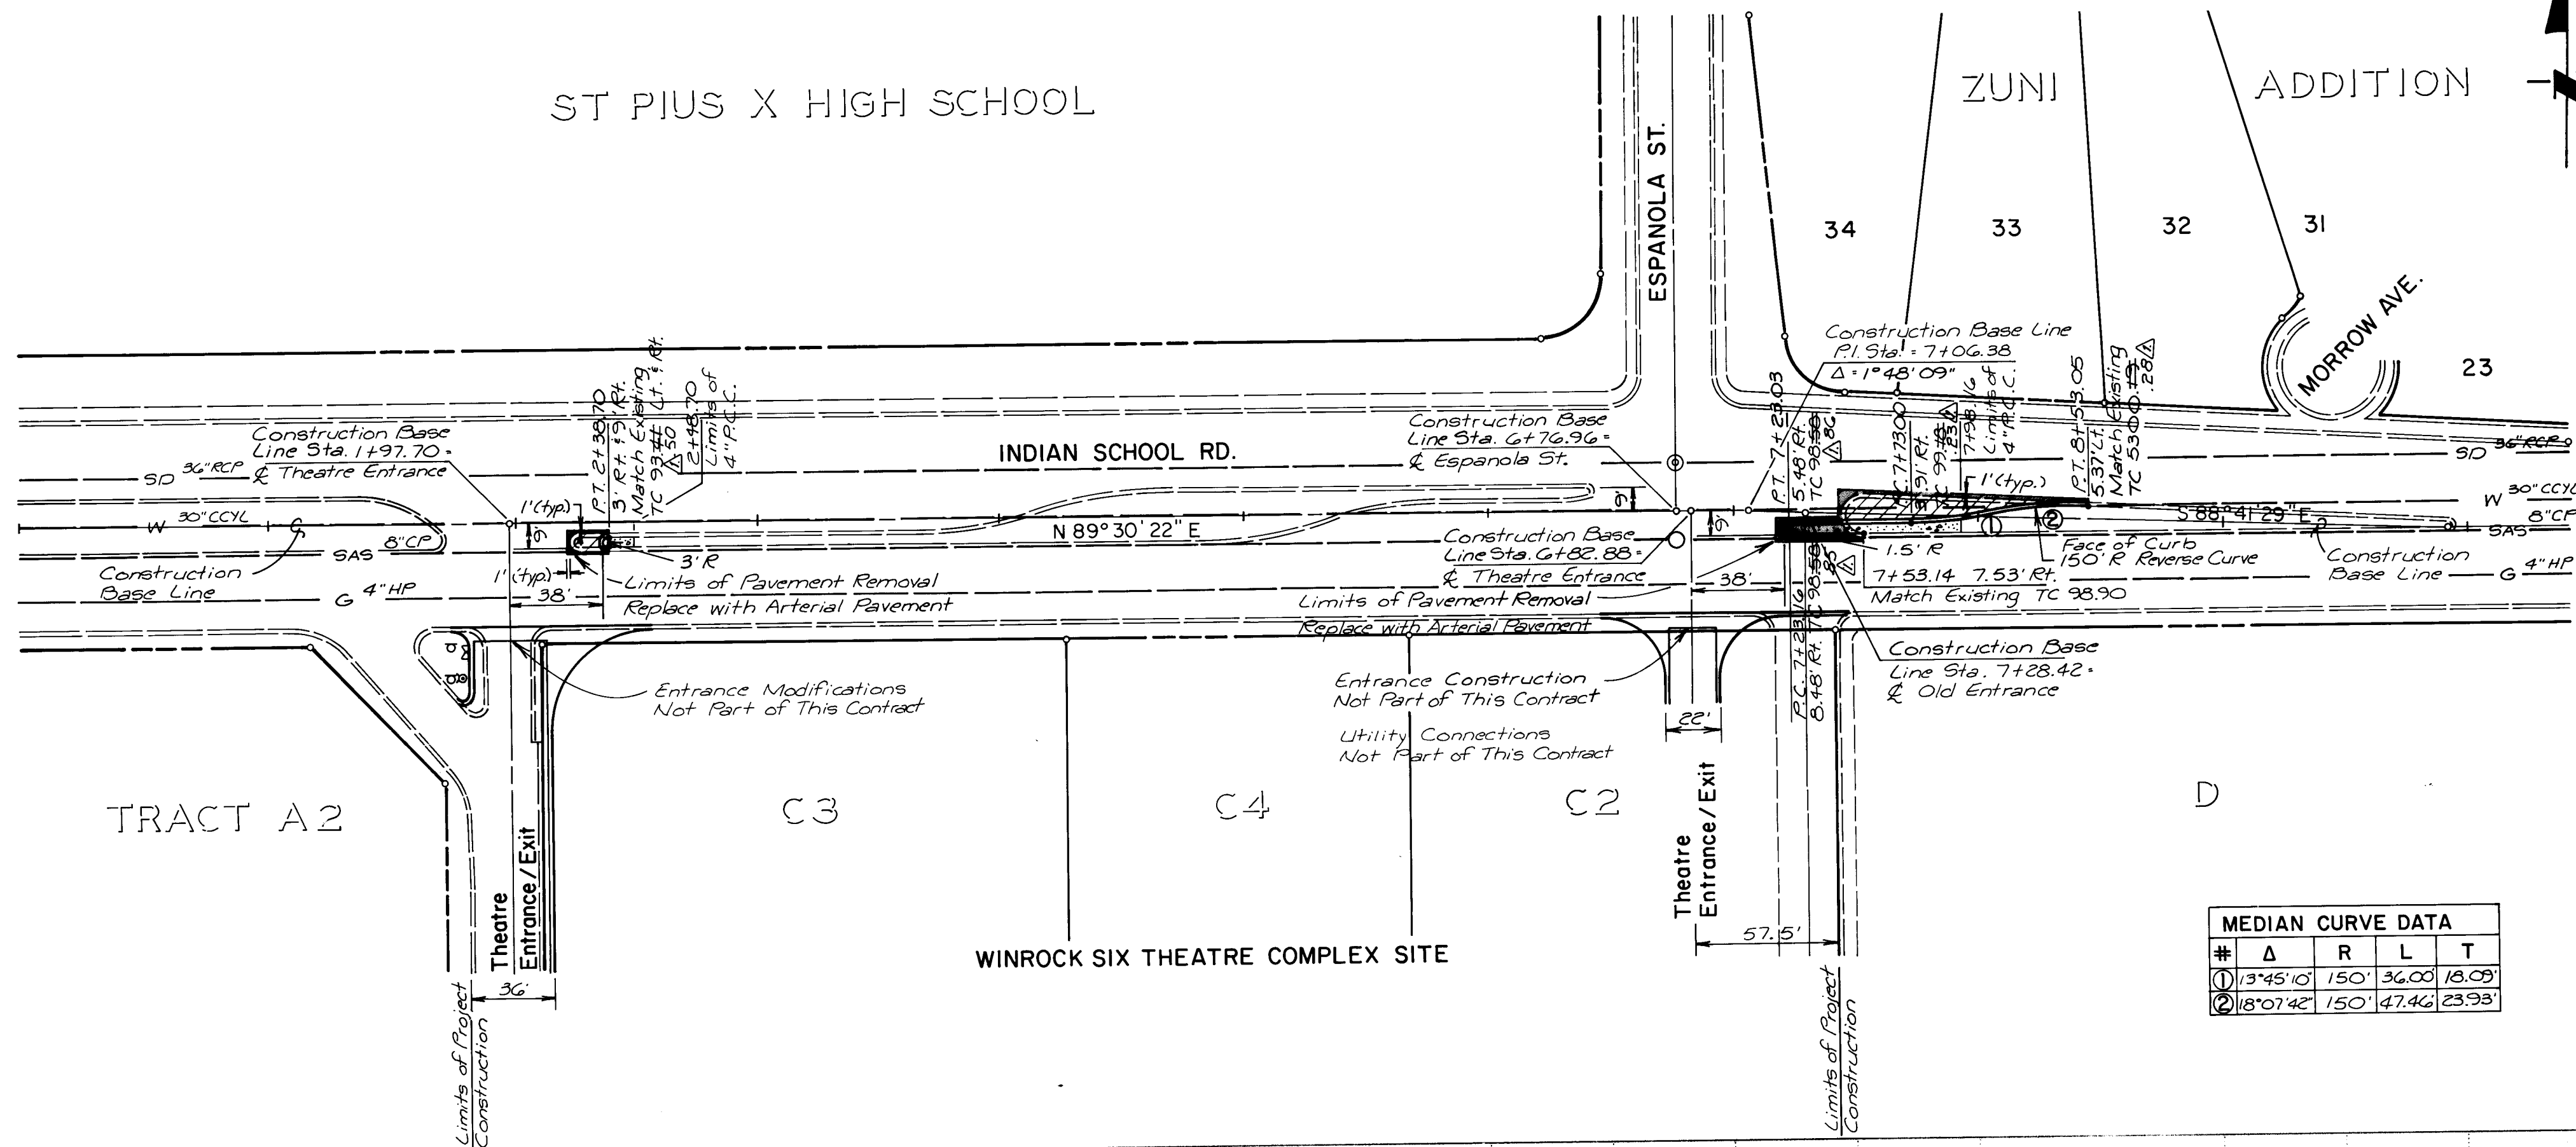


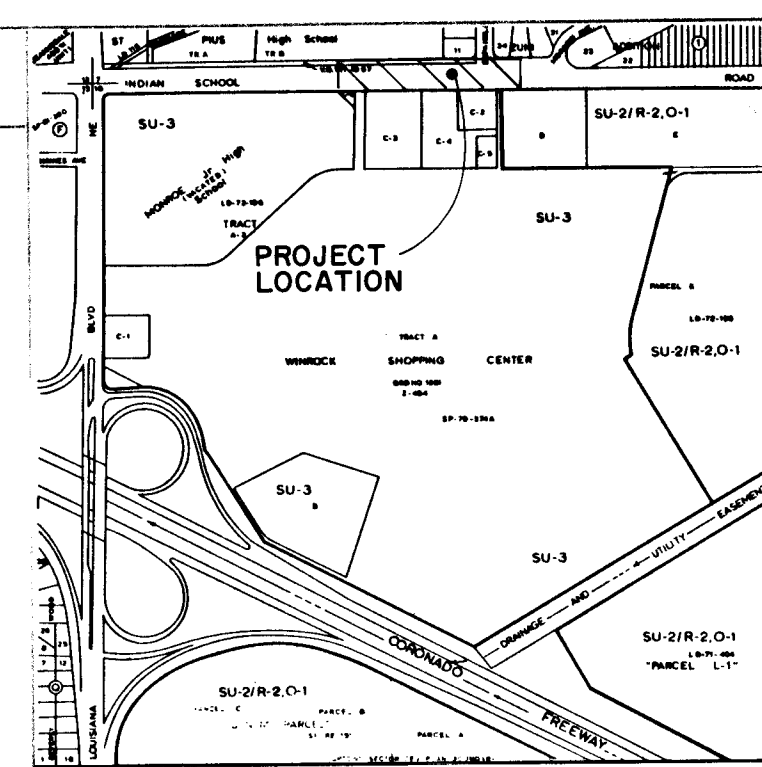

#	Δ	R	L	T
1	1345.10	150	36.00	18.09
2	1187.14	150	47.46	23.93

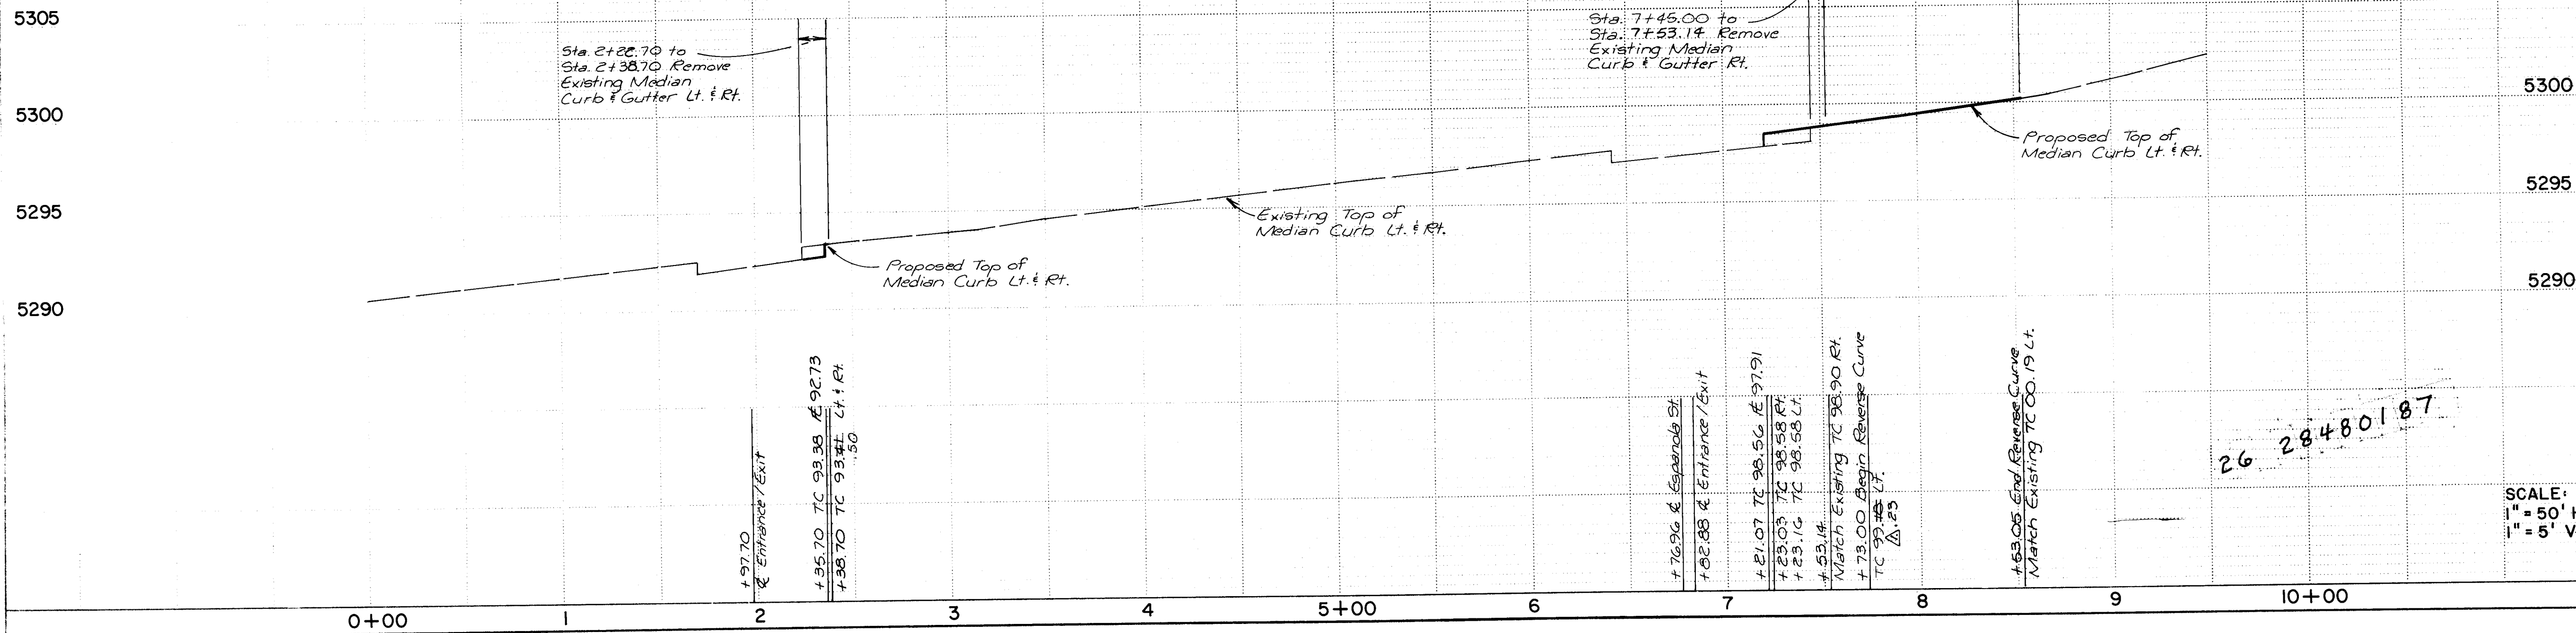

GENERAL NOTES

- ALL WORK DETAILED ON THESE PLANS TO BE PERFORMED UNDER CONTRACT SHALL, EXCEPT AS OTHERWISE STATED OR PROVIDED FOR HEREON, BE CONSTRUCTED IN ACCORDANCE WITH CITY OF ALBUQUERQUE INTERIM STANDARD SPECIFICATIONS FOR PUBLIC WORKS CONSTRUCTION, 1985 EDITION.
- TWO WORKING DAYS PRIOR TO ANY EXCAVATION, CONTRACTOR MUST CONTACT LINE LOCATING SERVICE, 765-1234, FOR LOCATION OF EXISTING UTILITIES.
- PRIOR TO CONSTRUCTION, THE CONTRACTOR SHALL EXCAVATE AND VERIFY THE HORIZONTAL AND VERTICAL LOCATIONS OF ALL CONSTRUCTIONS. SHOULD A CONFLICT EXIST, THE CONTRACTOR SHALL NOTIFY THE ENGINEER OR SURVEYOR SO THAT THE CONFLICT CAN BE RESOLVED WITH A MINIMUM AMOUNT OF DELAY.
- BACKFILL COMPACTION SHALL BE ACCORDING TO SPECIFIED STREET USE.

NOTES

- ALL STATIONS AND OFFSETS ARE BASED ON THE CONSTRUCTION BASE LINE.
- STATIONS AND OFFSETS FOR TIES TO EXISTING CURB MAY REQUIRE FIELD ADJUSTMENT.
- ALL CURB AND GUTTER SHALL BE MEDIAN CURB AND GUTTER PER CITY OF ALBUQUERQUE STD. DWG. P-8.
- ALL PAVEMENT AND MEDIANS SHALL BE ASPHALT PER CITY OF ALBUQUERQUE STD. DWG. P-3.

LEGEND

- R/W
- EXISTING CURB & GUTTER & SW
- EXISTING MEDIAN CURB & GUTTER
- PROPOSED MEDIAN CURB & GUTTER
- LIMITS OF PAVEMENT REMOVAL
- LIMITS OF NEW ARTERIAL PAVEMENT
- EXISTING UTILITY LINES
- EXISTING STORM DRAIN MANHOLE
- EXISTING SANITARY MANHOLE
- EXISTING FIRE HYDRANT
- EXISTING WATER VALVE
- EXISTING POWER POLE

Ramell B. Larkin
1-9-87

James H. Larkin
9/11/86

CITY OF ALBUQUERQUE

TITLE: MEDIAN MODIFICATIONS FOR WINROCK SIX THEATRE COMPLEX

APPROVALS	ENGINEER	DATE	APPROVALS	ENGINEER	DATE
City Engineer	<i>Ramell B. Larkin</i>	5/16/86	W.U.D.	<i>R. Larkin</i>	5/16/86
A C E - Design	"	"	Traffic	<i>David W. Hansen</i>	5/16/86
A C E - Hydrology	"	"			

DRAWING NO.	2848	MAP NO.	J-19	SHEET	1	OF	1
-------------	------	---------	------	-------	---	----	---

AS BUILT INFORMATION		BENCH MARKS		CITY OF ALBUQUERQUE TBM 3-HIS. LOCATED AT THE INTERSECTION OF INDIAN SCHOOL RD. AND ESPANOLA ST. A SQUARE CHISEL ON TOP OF CONCRETE CURB AT THE WNW CURB RETURN. ELEV. = 5297.415	
DATE	DATE	DATE	DATE	DATE	DATE
1-9-87	5/16/86	1-9-87	5/16/86	1-9-87	5/16/86
BY	BY	BY	BY	BY	BY
Ramell B. Larkin	R. Larkin	Ramell B. Larkin	R. Larkin	Ramell B. Larkin	R. Larkin
DATE	DATE	DATE	DATE	DATE	DATE
1-9-87	5/16/86	1-9-87	5/16/86	1-9-87	5/16/86
BY	BY	BY	BY	BY	BY
Ramell B. Larkin	R. Larkin	Ramell B. Larkin	R. Larkin	Ramell B. Larkin	R. Larkin
DATE	DATE	DATE	DATE		