

PLANS FOR CONSTRUCTION OF

ATRISCO BUSINESS PARK

UNIT 3 AND UNIT 4


WATER AND SANITARY SEWER IMPROVEMENTS

ALBUQUERQUE, NEW MEXICO

NOVEMBER, 1999

INDEX TO DRAWINGS


SHEET	TITLE
1.	COVER SHEET
2.	PLAT
3.	PLAT
4.	LINE "A" - WATER PLAN & PROFILE STA. 9+57.50 TO STA. 20+00.00
5.	LINE "A" - WATER PLAN & PROFILE STA. 20+00.00 TO STA. 32+00.00
6.	LINE "A" - WATER PLAN & PROFILE STA. 32+00.00 TO STA. 39+54.00
7.	LINE "B" - WATER AND SANITARY SEWER PLAN & PROFILE STA. 10+00.00 TO STA. 13+83.02
8.	TRAFFIC CONTROL DETAILS
9.	TRAFFIC CONTROL DETAILS

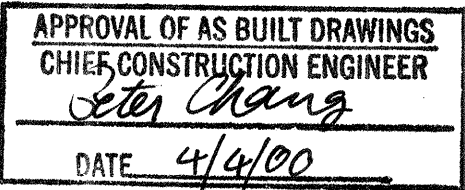

THESE DRAWINGS DO NOT INCLUDE NECESSARY
COMPONENTS FOR THE CONSTRUCTION SAFETY WHICH
SHALL REMAIN THE RESPONSIBILITY OF THE
CONTRACTOR.

DRB 85-657-1

BL BRASHER & LORENZ, INC.
Consulting Engineers
2201 San Pedro NE, Building 1, Suite 210
Albuquerque, New Mexico 87110
Ph: 505-588-5088 Fax: 505-588-6188

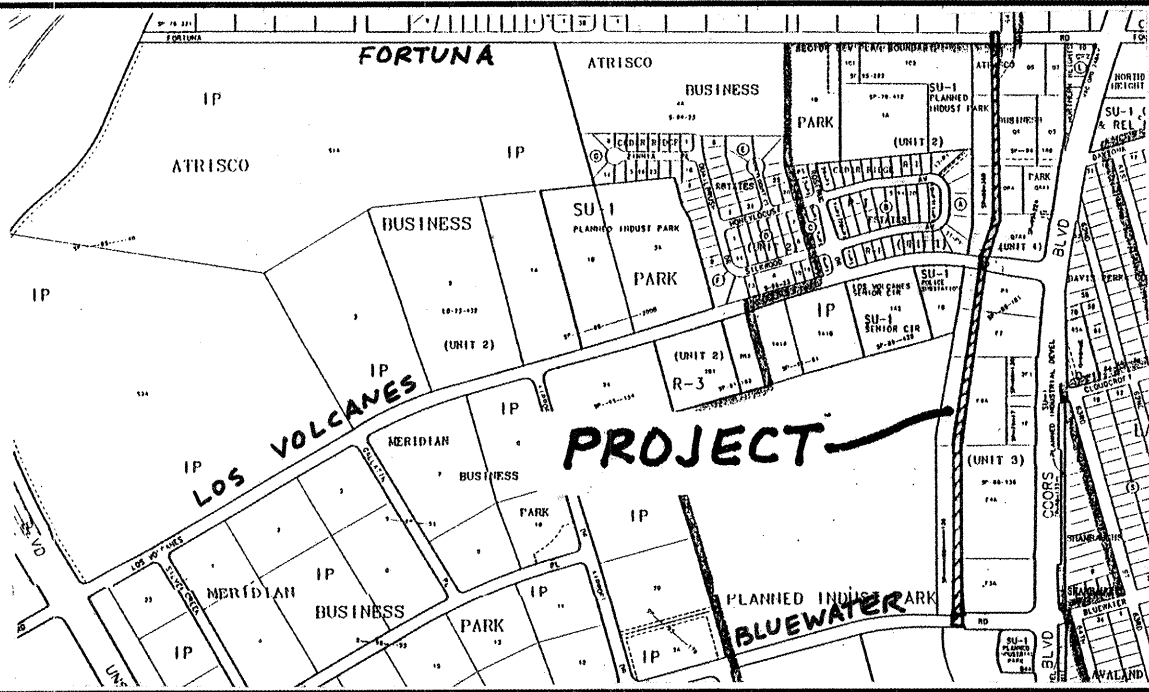


VICINITY MAP: J-10 & K-10


SCALE: 1"=1000'

GENERAL NOTES:

1. CITY OF ALBUQUERQUE SPECIFICATIONS FOR PUBLIC WORKS CONSTRUCTION, 1986 EDITION AS AMENDED THROUGH UPDATE 6, WILL BE REFERRED TO HEREIN AS THE "STANDARD SPECIFICATIONS." ALL WORK DETAILED ON THESE PLANS TO BE PERFORMED UNDER CONTRACT SHALL, EXCEPT AS OTHERWISE STATED OR PROVIDED FOR HEREON BE CONSTRUCTED IN ACCORDANCE WITH THE STANDARD SPECIFICATIONS
2. THREE WORKING DAYS PRIOR TO ANY EXCAVATION, CONTRACTOR MUST CONTACT NEW MEXICO ONE CALL SYSTEM (260-1990) AND DETERMINE LOCATION OF EXISTING UTILITIES.
3. PRIOR TO ANY CONSTRUCTION, THE CONTRACTOR SHALL EXCAVATE AND VERIFY THE HORIZONTAL AND VERTICAL LOCATIONS OF ALL OBSTRUCTIONS. SHOULD A CONFLICT EXIST, THE CONTRACTOR SHALL NOTIFY THE ENGINEER OR THE SURVEYOR SO THAT THE CONFLICT CAN BE RESOLVED WITHOUT DELAY.
4. ALL EXISTING SIGNS, MARKERS, DELINEATORS, ETC., WITHIN THE CONSTRUCTION LIMITS SHALL BE REMOVED, STORED AND RE-SET BY THE CONTRACTOR.
5. THE CONTRACTOR SHALL NOTIFY THE ENGINEER NOT LESS THAN SEVEN (7) WORKING DAYS PRIOR TO STARTING WORK IN ORDER THAT THE ENGINEER MAY TAKE NECESSARY MEASURES TO INSURE THE PRESERVATION OF SURVEY MONUMENTS. THE CONTRACTOR SHALL NOT DISTURB PERMANENT SURVEY MONUMENTS WITHOUT THE CONSENT OF THE ENGINEER AND BEAR THE EXPENSE OF REPLACING ANY THAT MAY BE DISTURBED WITHOUT PERMISSION. REPLACEMENT SHALL BE DONE ONLY BY THE CITY SURVEYOR. WHEN A CHANGE IS MADE IN THE FINISHED ELEVATIONS OF THE PAVEMENT OF ANY ROADWAY IN WHICH A PERMANENT SURVEY MARKER IS LOCATED, CONTRACTOR SHALL, AT HIS OWN EXPENSE, ADJUST THE MONUMENT COVER TO THE NEW GRADE UNLESS OTHERWISE SPECIFIED. REFER TO SECTION 4.4 OF THE GENERAL CONDITIONS OF THE STANDARD SPECIFICATIONS.
6. FIVE (5) WORKING DAYS PRIOR TO BEGINNING CONSTRUCTION THE CONTRACTOR SHALL SUBMIT TO THE CONSTRUCTION COORDINATION DIVISION A DETAILED CONSTRUCTION SCHEDULE. TWO (2) WORKING DAYS PRIOR TO CONSTRUCTION THE CONTRACTOR SHALL OBTAIN A BARRICADING PERMIT FROM THE CONSTRUCTION COORDINATION DIVISION. CONTRACTOR SHALL NOTIFY BARRICADE ENGINEER (768-2551) PRIOR TO OCCUPYING AN INTERSECTION. REFER TO SECTION 19 OF THE STANDARD SPECIFICATIONS.
7. ANY WORK OCCURRING WITHIN AN ARTERIAL ROADWAY REQUIRES 24 HOUR CONSTRUCTION (COORS BLVD).
8. ALL UTILITIES AND UTILITY SERVICE LINES SHALL BE INSTALLED PRIOR TO PAVING.
9. ALL STREET STRIPING ALTERED OR DESTROYED SHALL BE REPLACED BY THE CONTRACTOR WITH HOT THERMOPLASTIC REFLECTORIZED PAVEMENT MARKING. ALL NEW STRIPING SHALL BE HOT THERMOPLASTIC REFLECTORIZED PAVEMENT MARKING.
10. THE CONTRACTOR SHALL ASSUME RESPONSIBILITY FOR ANY DAMAGE TO EXISTING PAVEMENTS, PAVEMENT MARKINGS, CURB AND GUTTER, DRIVEPADS, WHEELCHAIR RAMPS AND SIDEWALKS DURING CONSTRUCTION, APART FROM THOSE SECTIONS INDICATED FOR REMOVAL ON THE PLANS AND SHALL REPAIR OR REPLACE PER THE STANDARD SPECIFICATIONS AT HIS OWN EXPENSE.
11. EXISTING UTILITY LINES AND PIPELINES SHOWN ON THESE DRAWINGS ARE SHOWN IN APPROXIMATE LOCATIONS ONLY. UTILITIES MAY EXIST WHERE NONE ARE SHOWN. THE ENGINEER HAS UNDERTAKEN NO FIELD VERIFICATION OF THE LOCATION, DEPTH, SIZE OR TYPE OF EXISTING UTILITY LINES AND PIPELINES. THE CONTRACTOR IS FULLY RESPONSIBLE FOR DAMAGE CAUSED BY FAILURE TO LOCATE AND PRESERVE EXISTING UTILITY LINES AND PIPELINES.
12. THE CONTRACTOR SHALL SECURE A "TOPSOIL DISTURBANCE PERMIT" PRIOR TO BEGINNING CONSTRUCTION.
13. THE CONTRACTOR SHALL ASSIST THE ENGINEER/INSPECTOR IN THE RECORDING OF DATA ON ALL UTILITY LINES AND ACCESSORIES AS REQUIRED BY THE OWNERS FOR THE PREPARATION OF "RECORD DRAWINGS." THE CONTRACTOR SHALL NOT COVER UTILITY LINES AND ACCESSORIES UNTIL ALL DATA HAS BEEN RECORDED.
14. ALL CONSTRUCTION WITHIN CITY RIGHT-OF-WAY OR EASEMENTS MUST BE DONE FROM APPROVED WORK ORDER DOCUMENTS FROM THE CITY AND PREPARED BY BRASHER AND LORENZ, INC.
15. THE CONTRACTOR SHALL DETERMINE IN ADVANCE OF HIS CONSTRUCTION IF OVERHEAD UTILITY LINES, SUPPORT STRUCTURES, POLES, GUYS, ETC. ARE AN OBSTRUCTION TO CONSTRUCTION OPERATIONS. IF ANY OBSTRUCTION TO CONSTRUCTION OPERATIONS IS EVIDENT, THE CONTRACTOR SHALL BE RESPONSIBLE FOR COORDINATING WITH THE APPROPRIATE UTILITY OWNER TO REMOVE OR SUPPORT THE UTILITY OBSTRUCTION. ANY COST ASSOCIATED WITH THIS EFFORT SHALL BE THE RESPONSIBILITY OF THE CONTRACTOR.
16. THE CONTRACTOR IS TO SUPPORT AND MAINTAIN THE INTEGRITY OF ALL UNDERGROUND TELEPHONE, ELECTRIC CABLES AND CABLE TELEVISION UTILITIES AT NO ADDITIONAL COST THE OWNER. CABLE IS TO BE SUPPORTED EVERY 15 FEET (MINIMUM). CONTRACTOR SHALL COORDINATE WITH AND MAKE NECESSARY PAYMENT (IF ANY) TO UTILITY OWNER FOR DE-ENERGIZATION OF CABLES OR SUPPORT OF CABLES BY THE UTILITY OWNER.
17. THE CONTRACTOR SHALL NOTIFY THE ENGINEER NOT LESS THAN SEVEN (7) DAYS PRIOR TO STARTING WORK IN ORDER THAT THE ENGINEER MAY TAKE NECESSARY MEASURES TO INSURE THE PRESERVATION OF SURVEY MONUMENTS. CONTRACTOR SHALL NOT DISTURB PERMANENT SURVEY MONUMENTS WITHOUT THE CONSENT OF THE ENGINEER AND SHALL NOTIFY THE ENGINEER AND BEAR THE EXPENSE OF REPLACING ANY THAT MAY BE DISTURBED WITHOUT PERMISSION. REPLACEMENT SHALL BE DONE ONLY BY THE CITY SURVEYOR. WHEN A CHANGE IS MADE IN THE FINISHED ELEVATIONS OF THE PAVEMENT OF ANY ROADWAY IN WHICH A PERMANENT SURVEY MONUMENT IS LOCATED, CONTRACTOR SHALL, AT HIS OWN EXPENSE, ADJUST THE MONUMENT COVER TO THE NEW GRADE UNLESS OTHERWISE SPECIFIED. REFER TO SECTION 4.4 OF THE GENERAL CONDITIONS OF THE STANDARD SPECIFICATIONS.

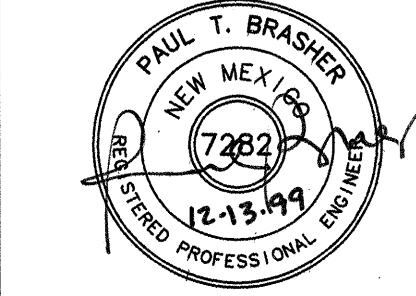

REV.	SHEETS	CITY ENGINEER	DATE	USER DEPARTMENT	DATE	USER DEPARTMENT	DATE
ENGINEERS STAMP & SIGNATURE	APPROVALS	ENGINEER	DATE	*****			
	DRC Chairman	<i>[Signature]</i>	1-17-00	APPROVED FOR CONSTRUCTION			
	Transportation	<i>[Signature]</i>	12-13-99				
	Water/Wastewater	<i>[Signature]</i>	12-13-99				
	Hydrology	<i>[Signature]</i>	12-13-99				
	CIP						
	Constr. Mngmt.						
	Constr. Coord.	<i>[Signature]</i>	12-13-99				
	CITY PROJECT NO.	285380					
	SHEET	1					
	OF	9					

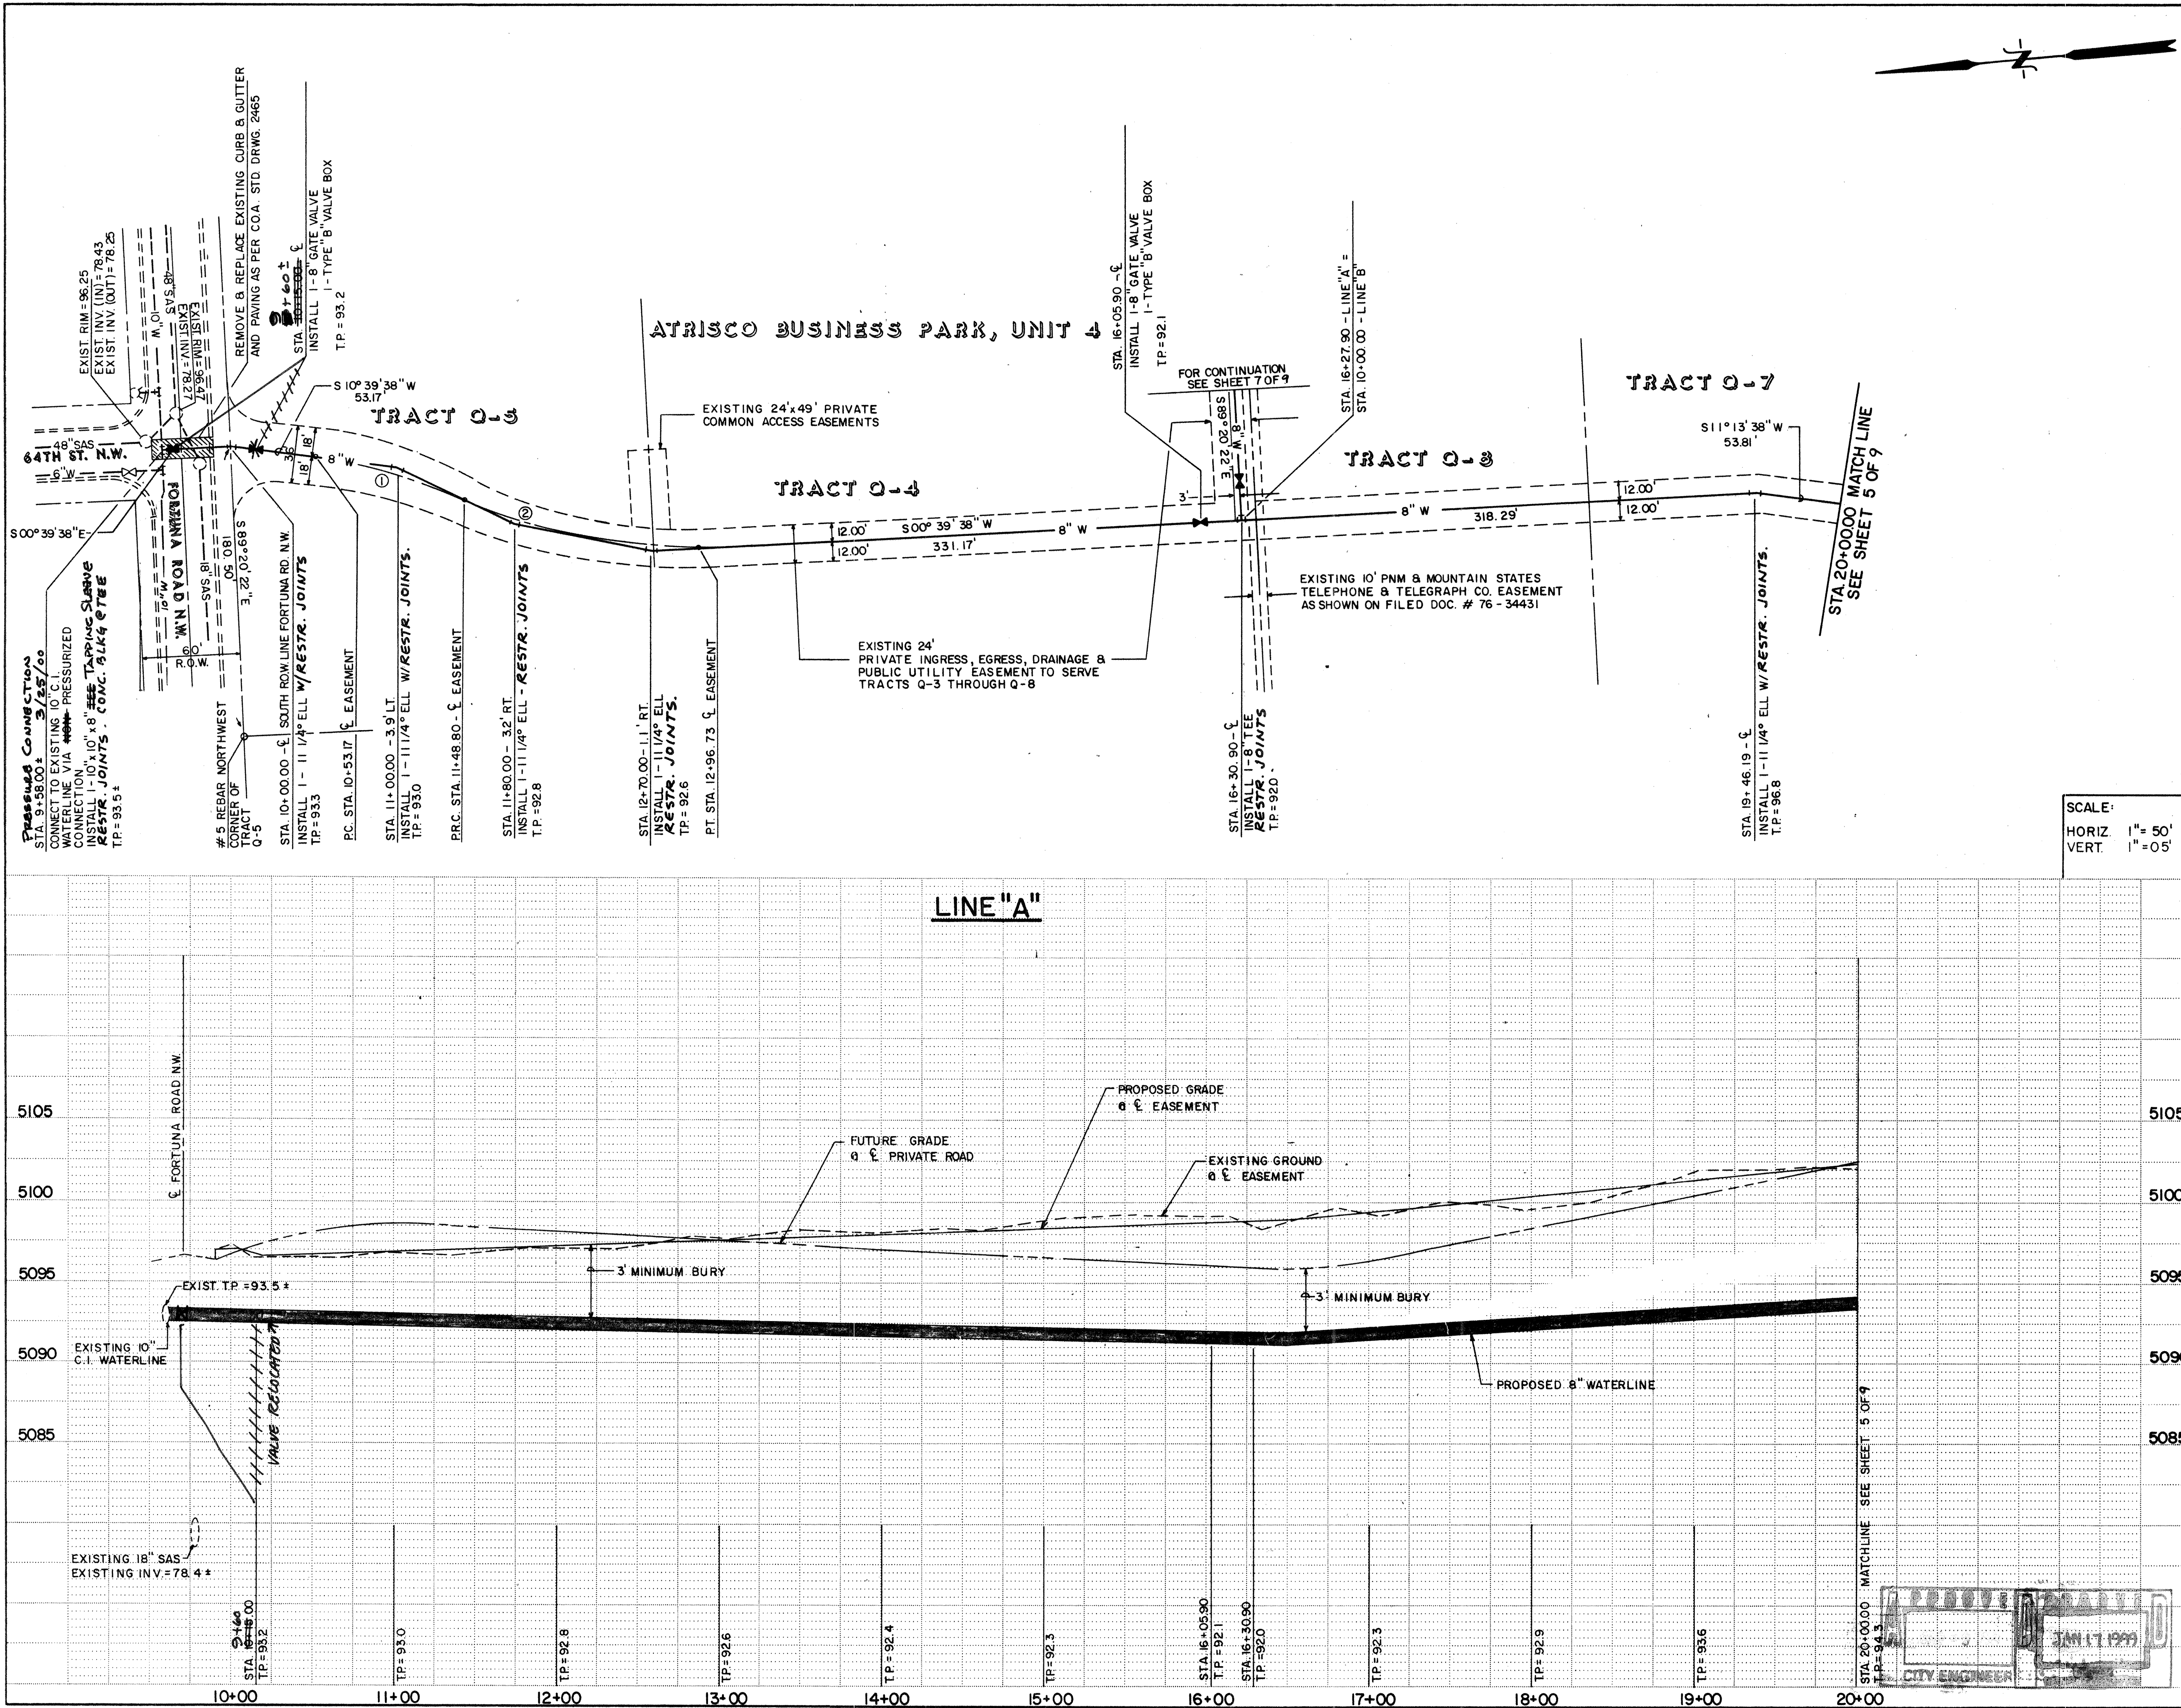

CURVE DATA

CURVE NO.	DELTA	RADIUS	LENGTH
①	19° 25' 45"	282.00'	95.63'
②	29° 25' 45"	288.00'	147.93'

WATER AND SANITARY SEWER

1. All stationing and offset dimensions are based on centerline of easement.

2. The following City of Albuquerque standard drawings are applicable to the water and sanitary sewer construction:

2101	2145
2102	2315
2107	2320
2110	2326
2118	2328
	2325

RESTRAINED JOINT DATA

FITTING	RESTRAINED LENGTH (ft)
8"x6"x6" TEE	73
8"x8"x8" TEE	73
8"x10"x10" TEE	73
8"x16"x16" COLLAR	73
8"x12" CROSS	73
8" - 11 1/4" BEND	3
8" GATE VALVE	3

LEGEND

- EXISTING FIRE HYDRANT
- EXISTING GATE VALVE
- EXISTING MANHOLE
- EXISTING CURB & GUTTER
- W - EXISTING WATERLINE
- SAS - EXISTING SANITARY SEWER LINE
- PROPOSED MANHOLE
- PROPOSED GATE VALVE
- W - PROPOSED WATERLINE
- SAS - PROPOSED SANITARY SEWER LINE
- PROPERTY LINE
- CENTERLINE
- REMOVE & REPLACE EXISTING CURB & GUTTER AND PAVING

ENGINEER'S SEAL

REVISIONS

NO.	DATE	REMARKS	BY
1	7/1/97	DESIGN	JCO.
2	7/1/97	REVISION	AS
3	7/1/97	REVISION	AS



DESIGNED BY JCO. **DATE** 7/1/97
DRAWN BY AS **DATE** 7/1/97
CHECKED BY AS **DATE** 7/1/97

CITY OF ALBUQUERQUE
PUBLIC WORKS DEPARTMENT
ENGINEERING GROUP

TITLE: ATRISCO BUSINESS PARK
UNIT 3 AND UNIT 4
WATER PLAN & PROFILE
LINE "A" STA. 9+57.50 TO STA. 20+00.00

APPROVALS	ENGINEER	DATE	APPROVALS	ENGINEER	DATE
D.R.C. Chair	AS	7/1/97			
Trans. Dev.	AS	7/1/97			
Utility Dev.	AS	7/1/97			

DRAWING NO. 285380 **MAP NO.** J-10 **SHEET** 4 **OF** 9

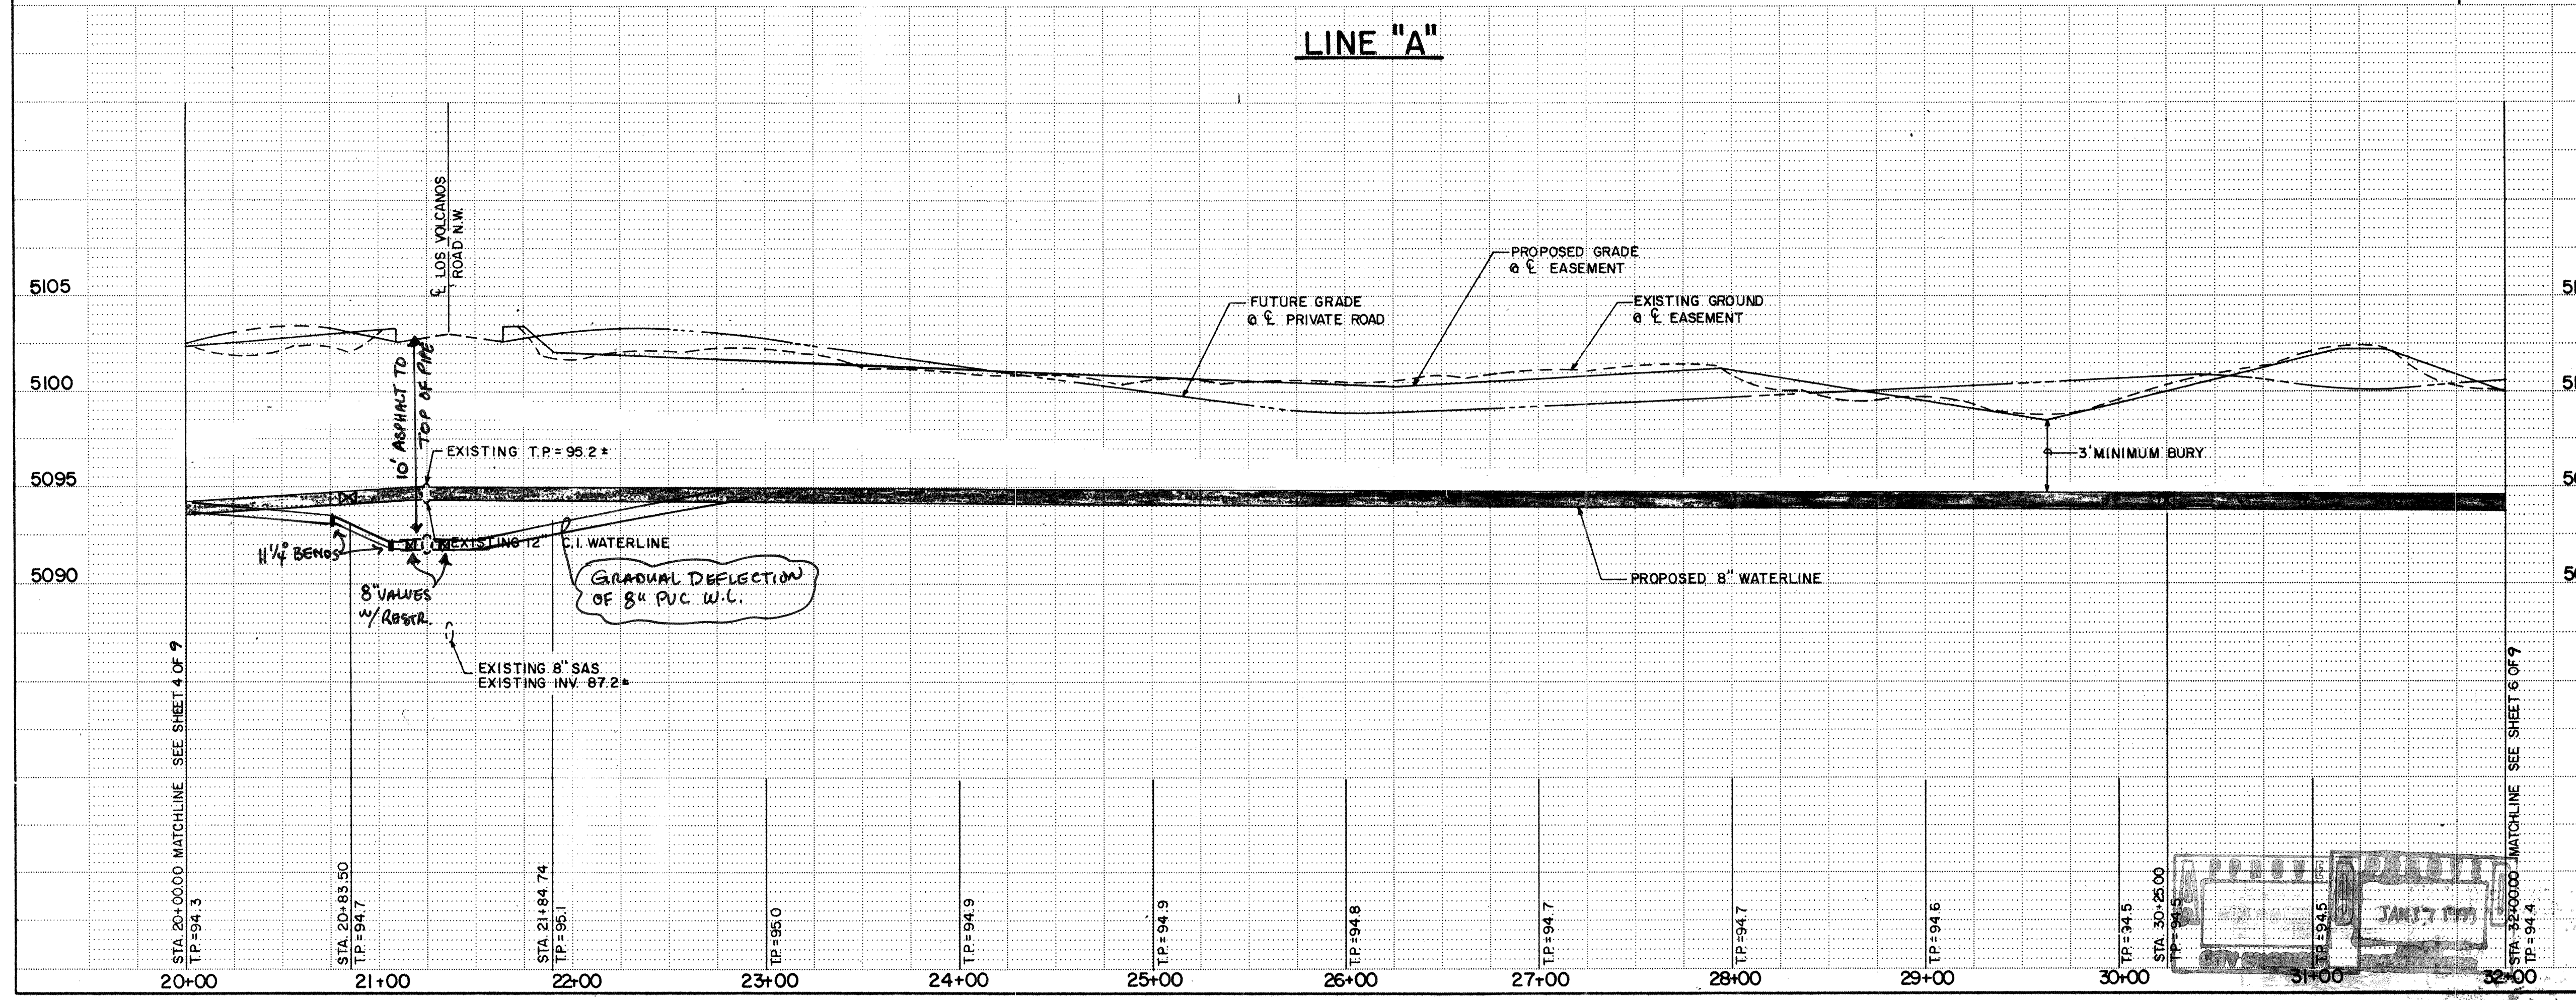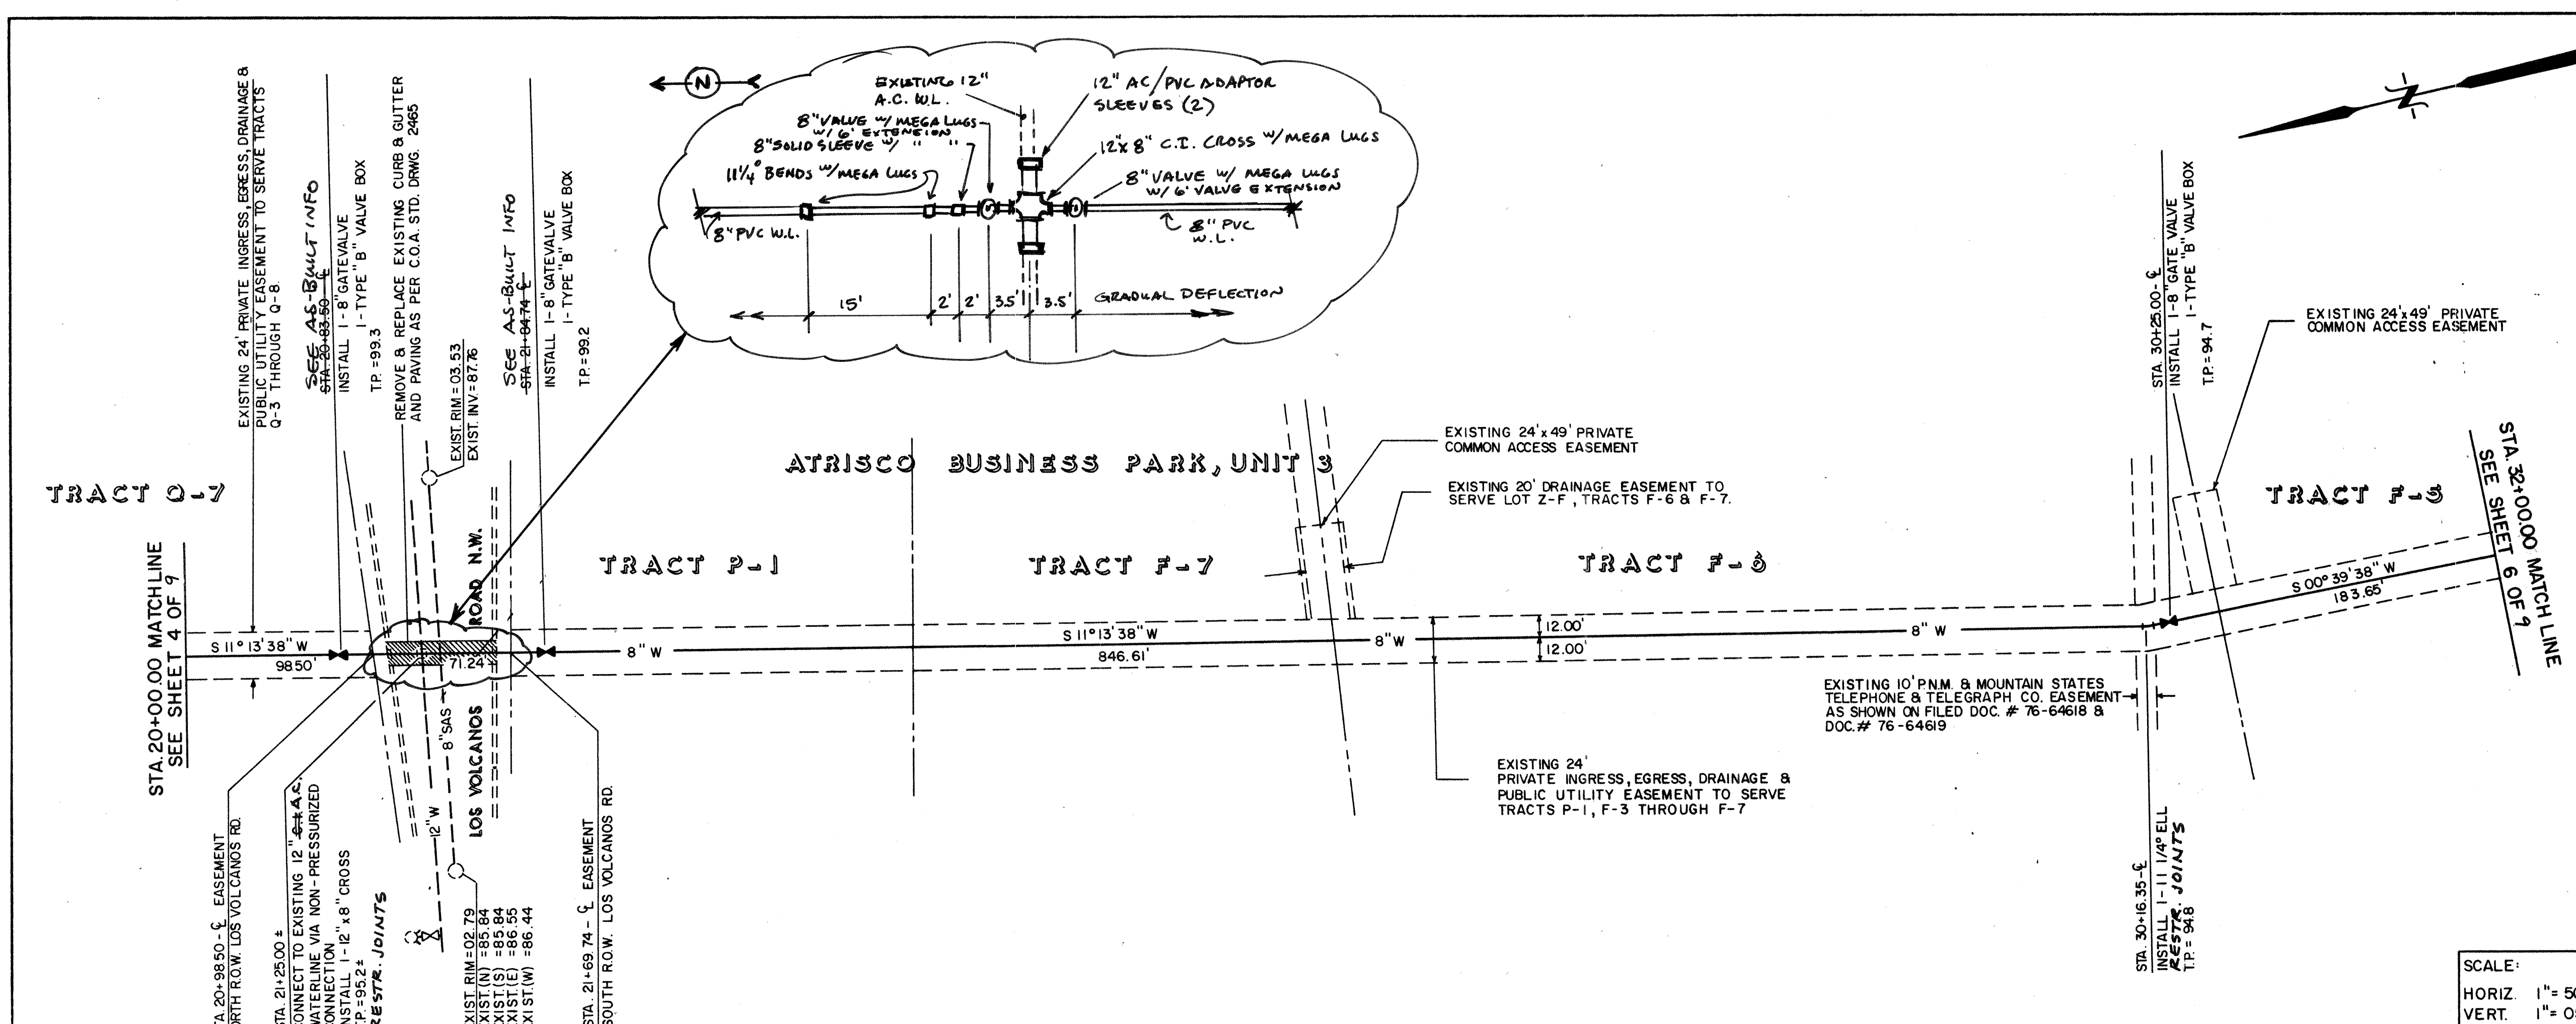

WATER AND SANITARY SEWER

1. All stationing and offset dimensions are based on centerline of easement.

2. The following City of Albuquerque standard drawings are applicable to the water and sanitary sewer construction:

2101	2145
2102	2315
2107	2320
2110	2326
2118	2328
	2325

RESTRAINED JOINT DATA

FITTING	RESTRAINED LENGTH (ft)
8"x6"x6" TEE	73
8"x8"x8" TEE	73
8"x10"x10" TEE	73
8"x16"x16" COLLAR	73
8"x12" CROSS	73
8" - 11 1/4" BEND	3
8" GATE VALVE	3

LEGEND

- EXISTING FIRE HYDRANT
- EXISTING GATE VALVE
- EXISTING MANHOLE
- EXISTING CURB & GUTTER
- EXISTING WATERLINE
- SAS - EXISTING SANITARY SEWER LINE
- PROPOSED MANHOLE
- PROPOSED GATEVALVE
- PROPOSED WATERLINE
- SAS - PROPOSED SANITARY SEWER LINE
- PROPERTY LINE
- CENTERLINE
- REMOVE & REPLACE EXISTING CURB & GUTTER AND PAVING

AS BUILT INFORMATION

CONTRACTOR: NEW CONCEPTS

WORK: 157.0' south of the intersection of Fortuna Road NW and Coors Road NW, Elevation = 5096.67 feet (M.S.L.D.)

DATE: 4/22/87

BY: G. ROMERO

NO. 211

SURVEY INFORMATION

FIELD NOTES

DATE: 4/22/87

BY: G. ROMERO

NO. 211

ENGINEER'S SEAL

PAUL T. BRASHER

REGISTERED PROFESSIONAL ENGINEER

NO. 1579

REVISIONS

NO.	DATE	REMARKS	BY
1	7/69	DESIGN	J.T.O.
2	7/87		J.T.O.
3	7/87		J.T.O.

CITY OF ALBUQUERQUE

PUBLIC WORKS DEPARTMENT

ENGINEERING GROUP

TITLE: ATRISCO BUSINESS PARK UNIT 3 AND UNIT 4 WATER PLAN & PROFILE LINE "A" STA. 20+00.00 TO STA 32+00.00

APPROVALS	ENGINEER	DATE	APPROVALS	ENGINEER	DATE
	J.T.O.	8/5/87			
	N.A. DWH	8/4/87			
	J.E. Eidegaard	8/5/87			

DRAWING NO. 205380 MAP NO. J-10 SHEET 5 OF 9

WATER AND SANITARY SEWER

- All stationing and offset dimensions are based on centerline of easement.
- The following City of Albuquerque standard drawings are applicable to the water and sanitary sewer constructions:

2101	2145
2102	2315
2107	2320
2110	2326
2118	2328
	2325

RESTRAINED JOINT DATA

FITTING	RESTRAINED LENGTH (ft)
8"x6"x6" TEE	73
8"x8"x8" TEE	73
8"x10"x10" TEE	73
8"x16"x16" COLLAR	73
8"x12" CROSS	73
8" - 11 1/4" BEND	3
8" GATE VALVE	3

LEGEND

- EXISTING FIRE HYDRANT
- EXISTING GATE VALVE
- EXISTING MANHOLE
- EXISTING CURB & GUTTER
- EXISTING WATERLINE
- EXISTING SANITARY SEWER
- PROPOSED MANHOLE
- PROPOSED GATE VALVE
- PROPOSED WATERLINE
- PROPOSED SANITARY SEWER
- PROPERTY LINE
- CENTERLINE
- REMOVE & REPLACE EXISTING CURB & GUTTER AND PAVING

ESPEY, HUSTON & ASSOCIATES, INC.
Engineering & Environmental Consultants
317 COMMERCIAL ST. N.E.
ALBUQUERQUE, NEW MEXICO 87102
PHONE: (505) 242-1809

CITY OF ALBUQUERQUE
PUBLIC WORKS DEPARTMENT
ENGINEERING GROUP

TITLE: ATRISCO BUSINESS PARK UNIT 3 AND UNIT 4 WATER PLAN & PROFILE LINE "A" STA. 32+00.00 TO STA. 39+54.00			
APPROVALS	ENGINEER	DATE	APPROVALS
D.R.C. Chair	<i>[Signature]</i>	8/6/97	ENGINEER
Trans. Dev.	<i>[Signature]</i>	8/4/97	DATE
Utility Dev.	<i>[Signature]</i>	8/5/97	DATE
DESIGNED BY	JTC	DATE	7/97
DRAWN BY	DS	DATE	7/97
CHECKED BY	DS	DATE	7/97
DRAWING NO.	285380	MAP NO.	J-10
SHEET	6	OF	9

STA 32+00.00 MATCH LINE
SEE SHEET 5 OF 9

TRACT F-3

TRACT F-4

TRACT F-3

ATRISCO BUSINESS PARK, UNIT 3

24' PRIVATE INGRESS, EGRESS, DRAINAGE & PUBLIC UTILITY EASEMENT TO SERVE TRACTS P-1, F-3 THROUGH F-7

EXISTING 24' x 49' PRIVATE COMMON ACCESS EASEMENT

REMOVE & REPLACE EXISTING CURB & GUTTER AND PAVING AS PER C.O.A. STD. DRWG. 2465

STA 39+54.00+
CONNECT TO EXISTING 16" CONC. CYL. WATERLINE AS PER SECTION 801.4 C.O.A. STANDARD SPECIFICATIONS
INSTALL AS PER C.O.A. STD. DRWG. 2306
1-8" GATE VALVE
1-TYPE 'A' VALVE BOX
1-TYPE 'A' VALVE BOX
1-TYPE 'A' VALVE BOX
CONTRACTOR SHALL COORDINATE CONNECTION TO EXISTING 16" CONC. CYL. WATERLINE WITH WATER SYSTEMS DIVISION PRIOR TO CONSTRUCTION



STA 39+32.18
NORTH ROW BLUEWATER RD. N.W.



5 REBAR
SOUTHWEST CORNER TRACT F-3

STA 39+54.00+
CONNECT TO EXISTING 16" CONC. CYL. WATERLINE AS PER SECTION 801.4 C.O.A. STANDARD SPECIFICATIONS
INSTALL AS PER C.O.A. STD. DRWG. 2306
1-8" GATE VALVE
1-TYPE 'A' VALVE BOX
1-TYPE 'A' VALVE BOX
1-TYPE 'A' VALVE BOX
CONTRACTOR SHALL COORDINATE CONNECTION TO EXISTING 16" CONC. CYL. WATERLINE WITH WATER SYSTEMS DIVISION PRIOR TO CONSTRUCTION

SCALE:
HORIZ. 1" = 50'
VERT. 1" = 05'

LINE "A"

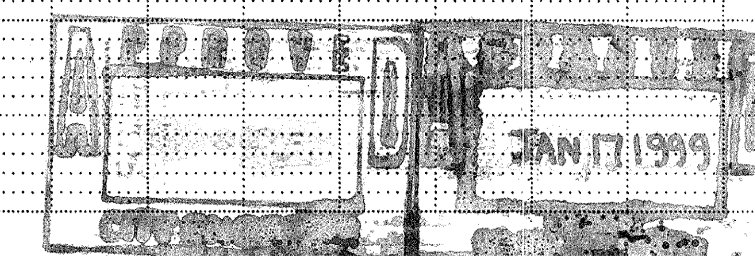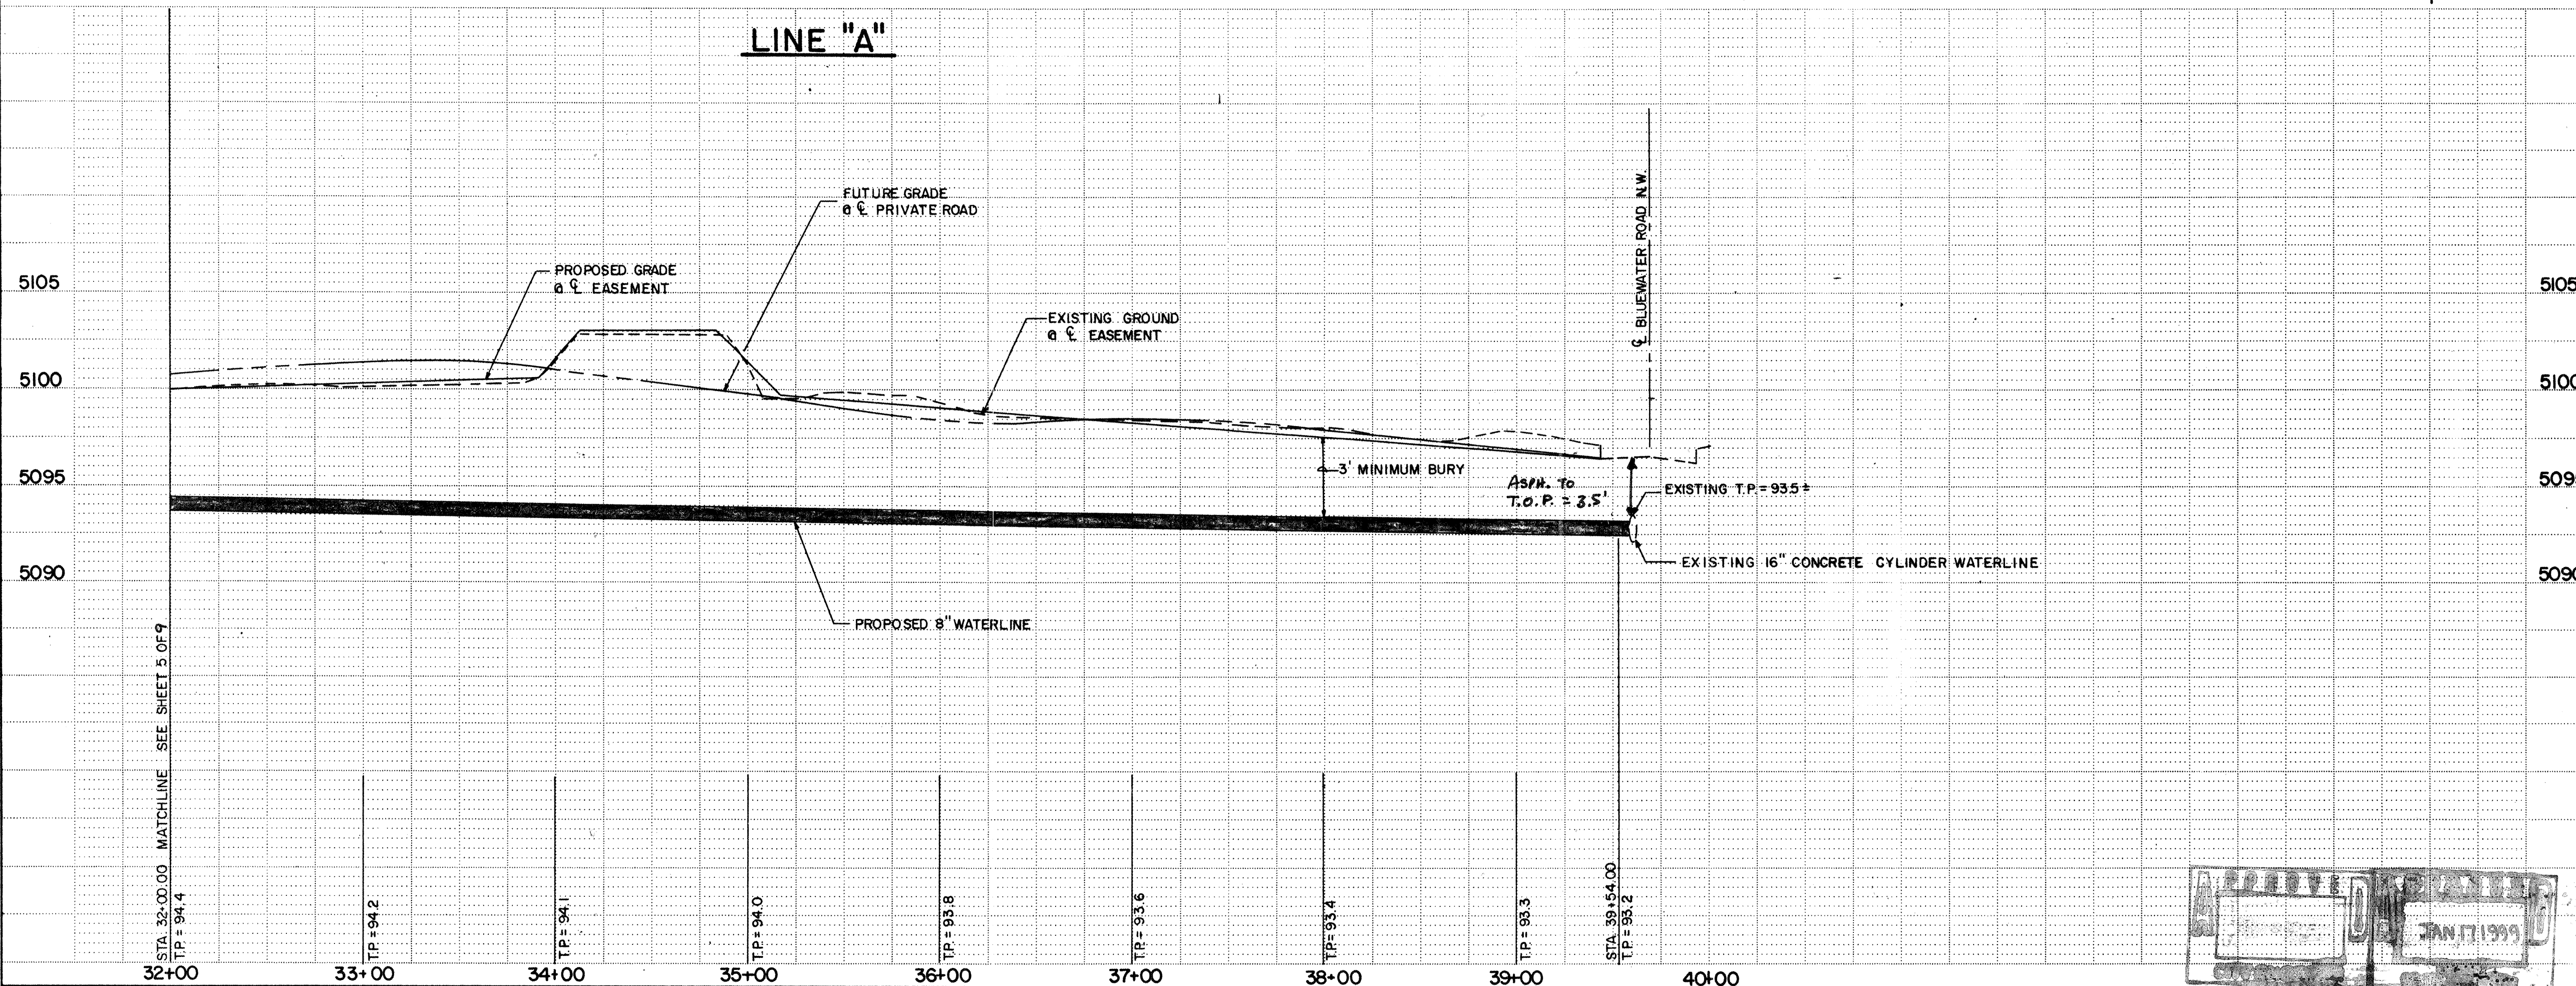

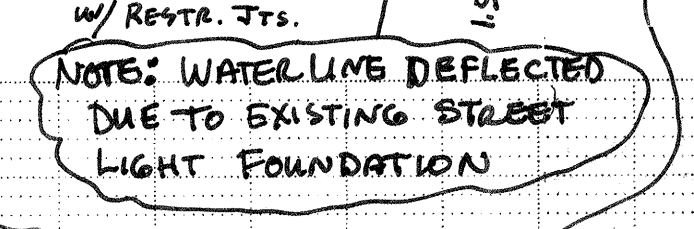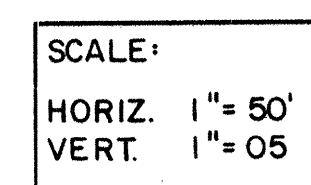


1. ALL VALVES, HYDRANTS, AND APPURTENANCES OF THE CITY WATER SYSTEM SHALL BE OPERATED BY CITY PERSONNEL ONLY.
2. THE CONTRACTOR SHALL PROVIDE THE CITY 5 DAYS ADVANCE NOTICE OF NEED FOR SYSTEM FOR SYSTEM SHUTDOWN. CALL 857-8200.
3. EACH SYSTEM SHUTDOWN IS LIMITED TO 8 HOURS.
4. CONNECTION TO THE EXISTING 10 INCH AT FORTUNA REQUIRES CLOSING THE FOLLOWING VALVES:

#941 @ 64TH ST.
#601, #602 & #607 @ COORS/FORTUNA
VALVE 'A' @ FORTUNA/QUALBRUSH
5. CONNECTION TO THE EXISTING 12 INCH @ LOS VOLCANES REQUIRES CLOSING THE FOLLOWING VALVES:

#1042 & #1044 @ COORS/LOS VALCANES
#341 @ COORS/BLUEWATER
VALVE 'B' @ LOS VOLCANES/ROSEBUD
6. CONNECTION TO THE 16 INCH CONC. CYL @ BLUEWATER WILL BE BY NON-PRESSURIZED CONNECTION. ~~VALVES 341, 343, 345, 352, 353 AND 362 SHALL BE CLOSED UNLESS INSTRUCTED OTHERWISE BY OPERATIONS.~~

LEGEND

	EXISTING FIRE HYDRANT
	EXISTING GATE VALVE
	EXISTING MANHOLE
-----	EXISTING CURB & GUTTER
--- W ---	EXISTING WATERLINE
--- SAS ---	EXISTING SANITARY SEWER LINE
	PROPOSED MANHOLE
-----	PROPOSED GATEVALVE
--- W ---	PROPOSED WATERLINE
--- SAS ---	PROPOSED SANITARY SEWER LINE
-----	PROPERTY LINE
-----	CENTERLINE
	REMOVE & REPLACE EXISTING CURB & GUTTER AND PAVING

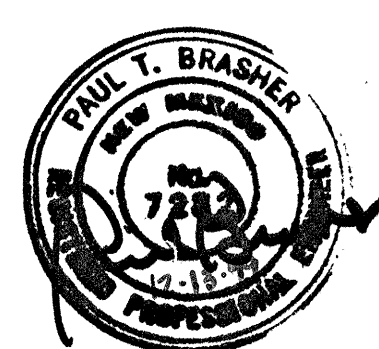

NO.		DATE	REMARKS	BY
<i>REVISED</i>				
<i>DESIGN</i>				
DESIGNED BY			<i>J.T.O.</i>	DATE <i>7/07</i>
DRAWN BY			<i>D.S.</i>	DATE <i>7/07</i>
CHECKED BY			<i>Q.S.</i>	DATE <i>7/11/99</i>

2101	2145
2102	2315
2107	2320
2110	2326
2118	2328
	2325


AS BUILT	INFORMATION
CONTRACTOR: NEW CONCEPTS	
WORK STANDARD BY: CITY OF ALBUQUERQUE DATE: 3/00	
INSPECTOR'S ACCEPTANCE BY: G. SHERIDAN DATE: 3/00	
FIELD CORRECTION BY: G. SHERIDAN DATE: 3/00	
DRAWINGS CORRECTED BY: G. SHERIDAN DATE: 3/00	
MICRO-FILM INFORMATION	
RECORDED BY	DATE
NO	

CITY OF ALBUQUERQUE
PUBLIC WORKS DEPARTMENT
ENGINEERING GROUP

TITLE: ATRISCO BUSINESS PARK
UNIT 3 AND UNIT 4
WATER & SANITARY SEWER PLAN & PROFILE
LINE "B" STA.10+00.00 TO STA.13+83.02

LINE B STA 10+00.00 TO STA 15+85.02					
APPROVALS	ENGINEER	DATE	APPROVALS	ENGINEER	DATE
D.R.C. Chair	<i>[Signature]</i>	8/5/87			
Trans. Dev.	NA DW4	8/4/87			
Utility Dev.	<i>[Signature]</i>	8/5/87			

DRAWING NO. 285300	MAP NO. J-11	SHEET 7	OF 9
------------------------------	------------------------	-------------------	----------------

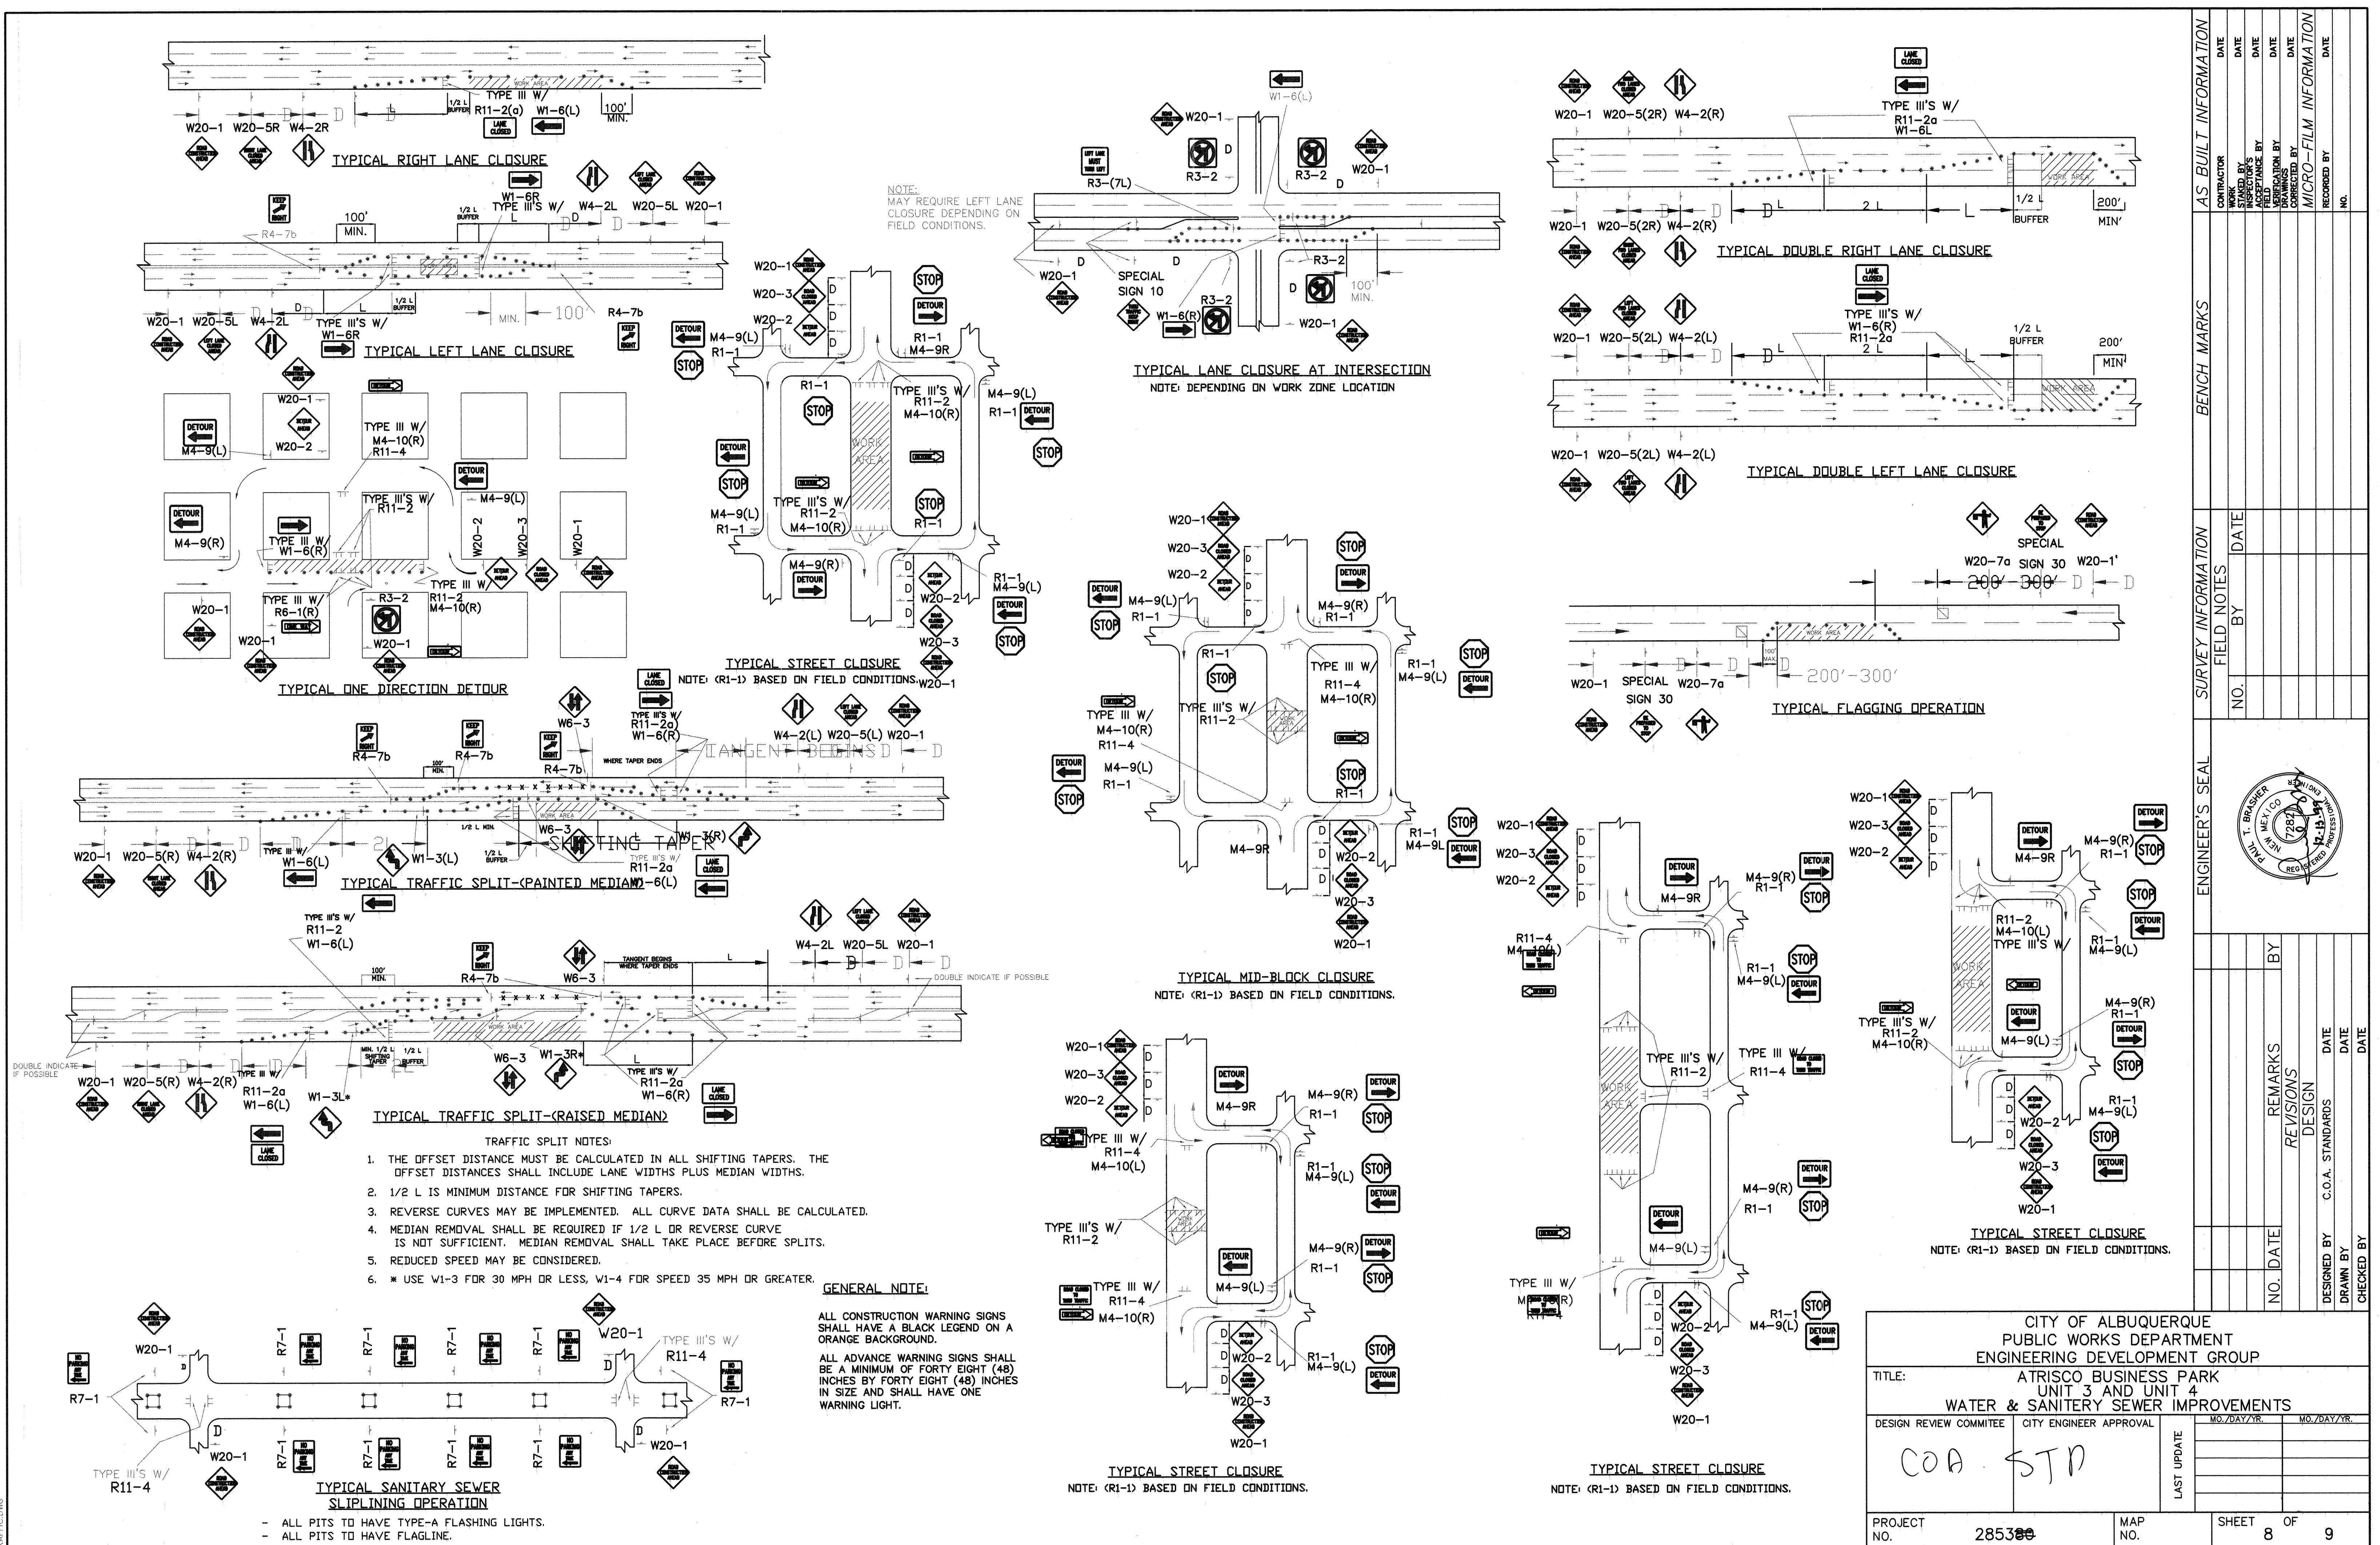

CONSTRUCTION TRAFFIC CONTROL GENERAL NOTES

1. CONTRACTOR MUST OBTAIN FROM CONSTRUCTION COORDINATION AN EXCAVATION/BARRICADING PERMIT BEFORE ENGAGING IN ANY CONSTRUCTION, MAINTENANCE OR REPAIR WORK IN ANY OF THE CITY OF ALBUQUERQUE'S RIGHTS-OF-WAY. EMERGENCY WORK THAT WOULD PRESERVE LIFE OR PROPERTY IS EXCLUDED WITH THE UNDERSTANDING, THAT A PERMIT SHALL BE OBTAINED WITHIN 24 TO 48 HOURS.

2. CONTRACTOR SHALL AT THE TIME OF PERMIT REQUEST, SUBMIT FOR APPROVAL BY CONSTRUCTION COORDINATION, A TRAFFIC CONTROL PLAN DETAILING ALL EXISTING TOPOGRAPHY SUCH AS LANE WIDTHS, DRIVEWAYS, AND BUSINESS/RESIDENTIAL ACCESSES. THE TRAFFIC CONTROL PLAN SHALL INCLUDE ALL PHASES OF WORK AND SCHEDULES INVOLVED IN THE CONSTRUCTION PROJECT. ANY SEPARATE PHASES OF A CONSTRUCTION PROJECT SHALL BE GIVEN AN INDIVIDUAL PERMIT EACH. BLANKET PERMITS WILL NOT BE ISSUED.

3. THESE TYPICAL TRAFFIC CONTROL PLANS DO NOT REFLECT THE EXISTING TOPOGRAPHY SUCH AS DRIVEWAYS, LANE WIDTHS, AND BUSINESS/RESIDENTIAL ACCESSES. EVERY LOCATION THAT REQUIRES CONSTRUCTION TRAFFIC CONTROL SHALL HAVE A DETAILED TRAFFIC CONTROL PLAN SHOWING ALL EXISTING TOPOGRAPHY.

4. CONSTRUCTION SHALL NOT BEGIN UNLESS A TRAFFIC CONTROL PLAN HAS BEEN APPROVED AND VERIFIED BY CONSTRUCTION COORDINATION.

5. CONSTRUCTION COORDINATION SHALL BE NOTIFIED 48 HOURS PRIOR TO ANY TRAFFIC CONTROL CHANGES NEEDED BY CONTRACTOR, THAT WERE NOT PREVIOUSLY APPROVED. THESE TRAFFIC CONTROL CHANGES SHALL BE REQUESTED IN WRITING ACCOMPANIED WITH A TRAFFIC CONTROL PLAN REFLECTING SUCH CHANGES.

6. ALL CONSTRUCTION TRAFFIC CONTROL DEVICES SHALL COMPLY TO THE MANUAL ON UNIFORM TRAFFIC CONTROL DEVICES (MUTCD), LATEST EDITION. IT IS THE RESPONSIBILITY OF THE CONTRACTOR TO INSTALL, SERVICE AND MAINTAIN ALL TRAFFIC CONTROL DEVICES. TRAFFIC CONTROL DEVICES SHALL NOT BE REMOVED OR ALTERED IN ANY WAY WITHOUT THE APPROVAL OF CONSTRUCTION COORDINATION, PER SECTION 6A-4 OF THE MUTCD, LATEST EDITION.

7. THE CONSTRUCTION TRAFFIC CONTROL INITIAL SET-UP SHALL BE BY AN AMERICAN TRAFFIC SAFETY SERVICES ASSOCIATION (ATSSA) CERTIFIED WORKSITE TRAFFIC SUPERVISOR. THE MAINTENANCE AND SERVICING SHALL ALSO BE DONE BY AN ATSSA CERTIFIED WORKSITE TRAFFIC SUPERVISOR OR EQUIVALENT.

8. CONTRACTOR IS RESPONSIBLE TO MAINTAIN AND SERVICE ALL TRAFFIC CONTROL DEVICES 24 HOURS A DAY, 7 DAYS A WEEK THROUGHOUT LENGTH OF PROJECT. CONTRACTOR IS RESPONSIBLE THAT ALL TRAFFIC CONTROL DEVICES COMPLY WITH THE MUTCD, LATEST EDITION.

9. ALL ADVANCE WARNING SIGNS SHALL BE DOUBLE INDICATED WHENEVER THERE ARE MULTI-LANE TRAFFIC IN ANY ONE GIVEN DIRECTION AND THERE IS SUFFICIENT MEDIAN SPACE.

10. ALL BARRICADES IN ALL TAPERS AND TANGENTS SHALL BE PLACED APART, A DISTANCE MEASURED IN FEET, EQUAL TO THAT OF THE POSTED SPEED LIMIT. NO EXCEPTIONS UNLESS APPROVED BY CONSTRUCTION COORDINATION PER MUTCD SECTION 6A-4.

11. CONTRACTOR SHALL NOT BEGIN WORK BEFORE 7:00 A.M. OR END WORK AFTER 7:00 P.M. WITHOUT THE APPROVAL OF CONSTRUCTION COORDINATION.

12. CONTRACTOR IS RESPONSIBLE TO PROVIDE CONSTRUCTION COORDINATION, A WEEKLY LOG OF DAILY INSPECTIONS OF BARRICADE AND MAINTENANCE SCHEDULES ON PROJECTS THAT ARE OVER ONE WEEK DURATION.

13. EQUIPMENT OR MATERIALS SHALL NOT BE STORED WITHIN 15 FEET OF A TRAVELLED TRAFFIC LANE DURING NON-WORKING HOURS WITHOUT THE APPROVAL OF CONSTRUCTION COORDINATION.

14. CONTRACTOR SHALL PROVIDE AND MAINTAIN A SAFE AND ADEQUATE MEANS OF CHANNELIZING PEDESTRIAN TRAFFIC AROUND AND THROUGH THE CONSTRUCTION AREA.

15. CONTRACTOR IS RESPONSIBLE FOR OBLITERATION OF ANY CONFLICTING STRIPING AND RESPONSIBLE FOR ALL TEMPORARY STRIPING.

16. CONTRACTOR SHALL MAINTAIN ACCESS TO ALL FACILITIES, BUSINESSES AND/OR RESIDENTS AT ALL TIMES.

17. CONTRACTOR SHALL PROVIDE ACCESS SIGNS FOR BUSINESSES LOCATED WITHIN THE CONSTRUCTION AREA UNDER THE SUPERVISION OF CONSTRUCTION COORDINATION. EACH ACCESS SIGN SHALL HAVE 5 INCH, WHITE OPAQUE LETTERING ON BLUE REFLECTORIZED BACKGROUND. ACCESS SIGNS SHALL BE CONSIDERED INCIDENTAL TO THE BID AND NOT PART OF THE CONTRACT UNLESS OTHERWISE STATED. NO MORE THAN 3 BUSINESSES SHALL BE LISTED ON A ACCESS SIGN. SHOPPING CENTERS AND MALLS SHALL BE LISTED AS SUCH.

18. ALL ADVANCE WARNING SIGNS SHALL MEET THE MINIMUM REFLECTIVE INTENSITY REQUIREMENTS SET FORTH BY THE CITY OF ALBUQUERQUE. CONSTRUCTION COORDINATION SHALL DETERMINE ALL REQUIREMENTS AND APPROVE OR DISAPPROVE ANY ADVANCE WARNING SIGN PER SECTION 6A-4 OF THE MUTCD, LATEST EDITION.

19. 24 HOURS PRIOR TO OCCUPYING OR CLOSING OF A RIGHT-OF-WAY, CONTRACTOR SHALL NOTIFY: POLICE, FIRE DEPARTMENT, SCHOOLS, HOSPITALS, TRANSIT AUTHORITY, BUSINESSES AND/OR RESIDENTS THAT WILL BE AFFECTED BY THE CONSTRUCTION.

20. ANY FIELD ADJUSTMENTS SHALL BE APPROVED BY CONSTRUCTION COORDINATION.

21. EXCAVATIONS SHALL BE PLATED, TEMPORARILY PATCHED OR RESURFACED PRIOR TO OPENING OF TRAFFIC. A MINIMUM OF 11 FEET SHALL BE PROVIDED FOR TRAFFIC IN ANY GIVEN DIRECTION. CONTRACTOR IS RESPONSIBLE FOR ANY WORK INVOLVED IN SATISFYING THESE REQUIREMENTS.


22. CONTRACTOR SHALL AT ALL TIMES COMPLY WITH THE FOLLOWING:
1. STANDARDS AND REQUIREMENTS SET FORTH IN THE MANUAL ON UNIFORM TRAFFIC CONTROL DEVICES, LATEST EDITION.
2. THE CITY OF ALBUQUERQUE TRAFFIC CODE, LATEST EDITION.
3. SECTION 19 OF THE CITY OF ALBUQUERQUE'S STANDARD SPECIFICATIONS FOR PUBLIC WORK CONSTRUCTION, AS WELL AS OTHER SECTIONS.

23. FAILURE TO COMPLY WITH ANY OF THE ABOVE MENTIONED, WILL BE ADEQUATE CAUSE TO CEASE ALL WORK ON ANY CONSTRUCTION PROJECT. WORK WILL NOT RESUME UNTIL ALL REQUIREMENTS ARE ADDRESSED AND APPROVED BY CONSTRUCTION COORDINATION.

24. ALL TRAFFIC CONTROL DEVICES SHALL BE KEPT IN NEW-CLEAN CONDITION. WASHING OF EQUIPMENT IS INCIDENTAL TO ITS PLACEMENT AND MAINTENANCE.

25. TRAFFIC CONTROL STANDARDS APPLY ONLY WHERE THE CONSTRUCTION TRAFFIC CONTROL PLANS ARE NOT SPECIFIC.

26. ADVANCE WARNING SIGNS SHALL BE 36"x36" WITH SUPER ENGINEERING GRADE SHEETING OR BETTER.

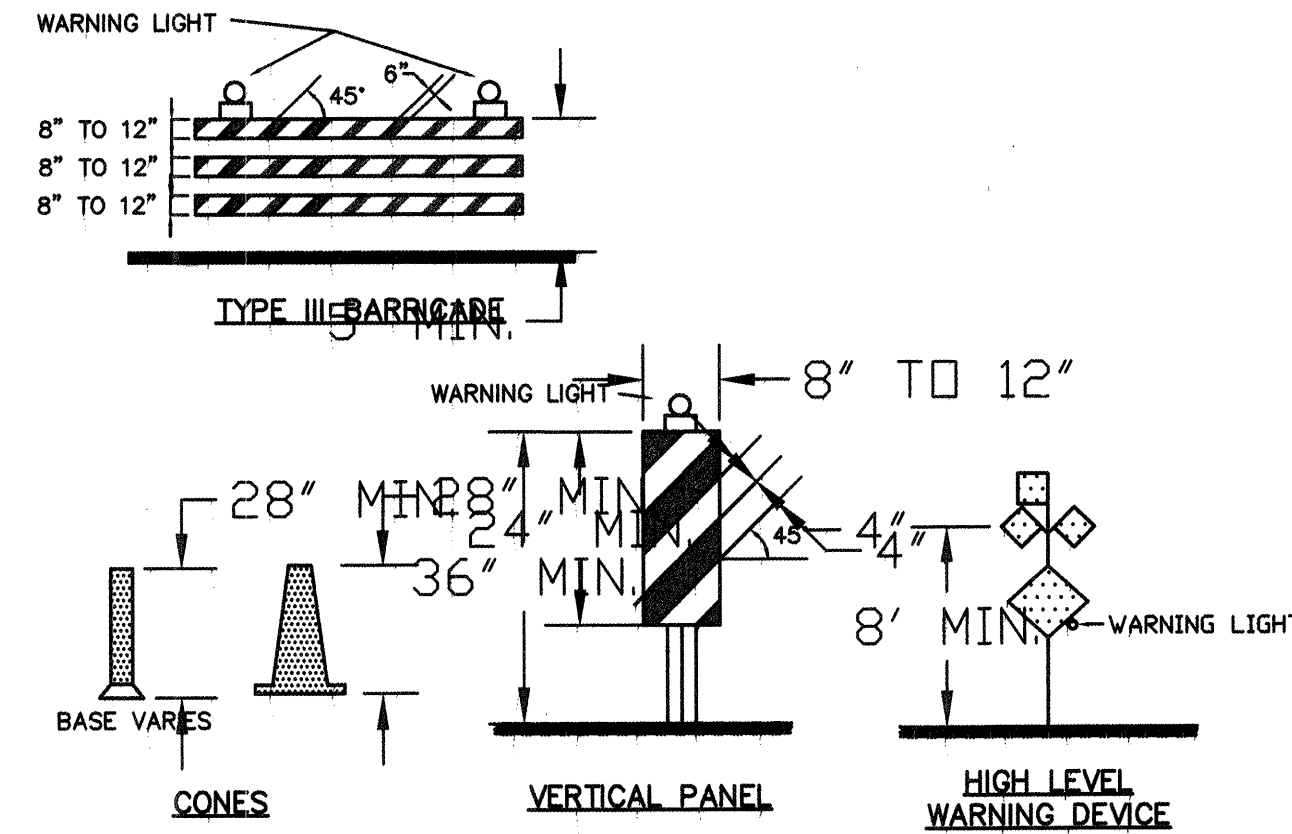

LEGEND

WORK AREA
BARRICADE - TYPE I, TYPE II, OR BARREL
BARRICADE - TYPE III
VERTICAL PANEL
WARNING SIGN
DISTANCE BETWEEN SIGNS - A DISTANCE MEASURED IN FEET EQUAL TO A VALUE OF TEN TIMES THE SPEED LIMIT OF THE STREET FLAGMAN POSITION
SPACING BETWEEN BARRICADES- A DISTANCE MEASURED IN FEET EQUAL TO THE SPEED LIMIT OF THE STREET
TAPER LENGTH - SEE CHART BELOW
THE TANGENT LENGTH IS EQUAL TO THE TAPER LENGTH FOR A GIVEN STREET

TAPER REQUIREMENTS

SPEED LIMIT (MPH)	TAPER LENGTH (L) (FEET)			MINIMUM NUMBER OF DEVICES FOR TAPER	MAXIMUM DEVICE SPACING IN FEET	
	10' LANE	11' LANE	12' LANE		ALONG TAPER	AFTER TAPER
20	70	75	80	5	20	20
25	105	115	125	6	25	25
30	150	165	180	7	30	30
35	205	225	245	8	35	35
40	270	295	320	9	40	40
45	450	495	540	13	45	45
50	500	550	600	13	50	50
55	550	605	660	13	55	55

RECOMMENDED SIGN SPACING(D) FOR ADVANCE WARNING SIGN SERIES

SPEED MILES PER HOUR	MINIMUM DISTANCE BETWEEN SIGNS	MINIMUM DISTANCE FROM LAST SIGN TO TAPER
0-20	10 X SPEED LIMIT	10 X SPEED LIMIT
25-30	10 X SPEED LIMIT	10 X SPEED LIMIT
30-35	10 X SPEED LIMIT	10 X SPEED LIMIT
40-45	10 X SPEED LIMIT	10 X SPEED LIMIT
50-60	10 X SPEED LIMIT	10 X SPEED LIMIT


TAPER CRITERIA

TYPE OF TAPER	TAPER LENGTH
UPSTREAM TAPER:	
MERGING TAPER	L MINIMUM
SHIFTING TAPER	1/2 L MINIMUM
SHOULDER TAPER	1/2 L MINIMUM
TWO-WAY TRAFFIC TAPER	100 FEET MAXIMUM
DOWNSTREAM TAPERS	100 FEET PER LANE


TAPER LENGTH COMPUTATION

SPEED LIMIT	
40 MPH OR LESS	$L = \frac{WS^2}{60}$
45 MPH OR GREATER	$L = W \times S$
L = TAPER LENGTH W = WIDTH OF OFFSET IN FEET S = POSTED SPEED OR OFF-PEAK 85-PERCENTILE SPEED IN MPH	

SIGN FACE DETAILS

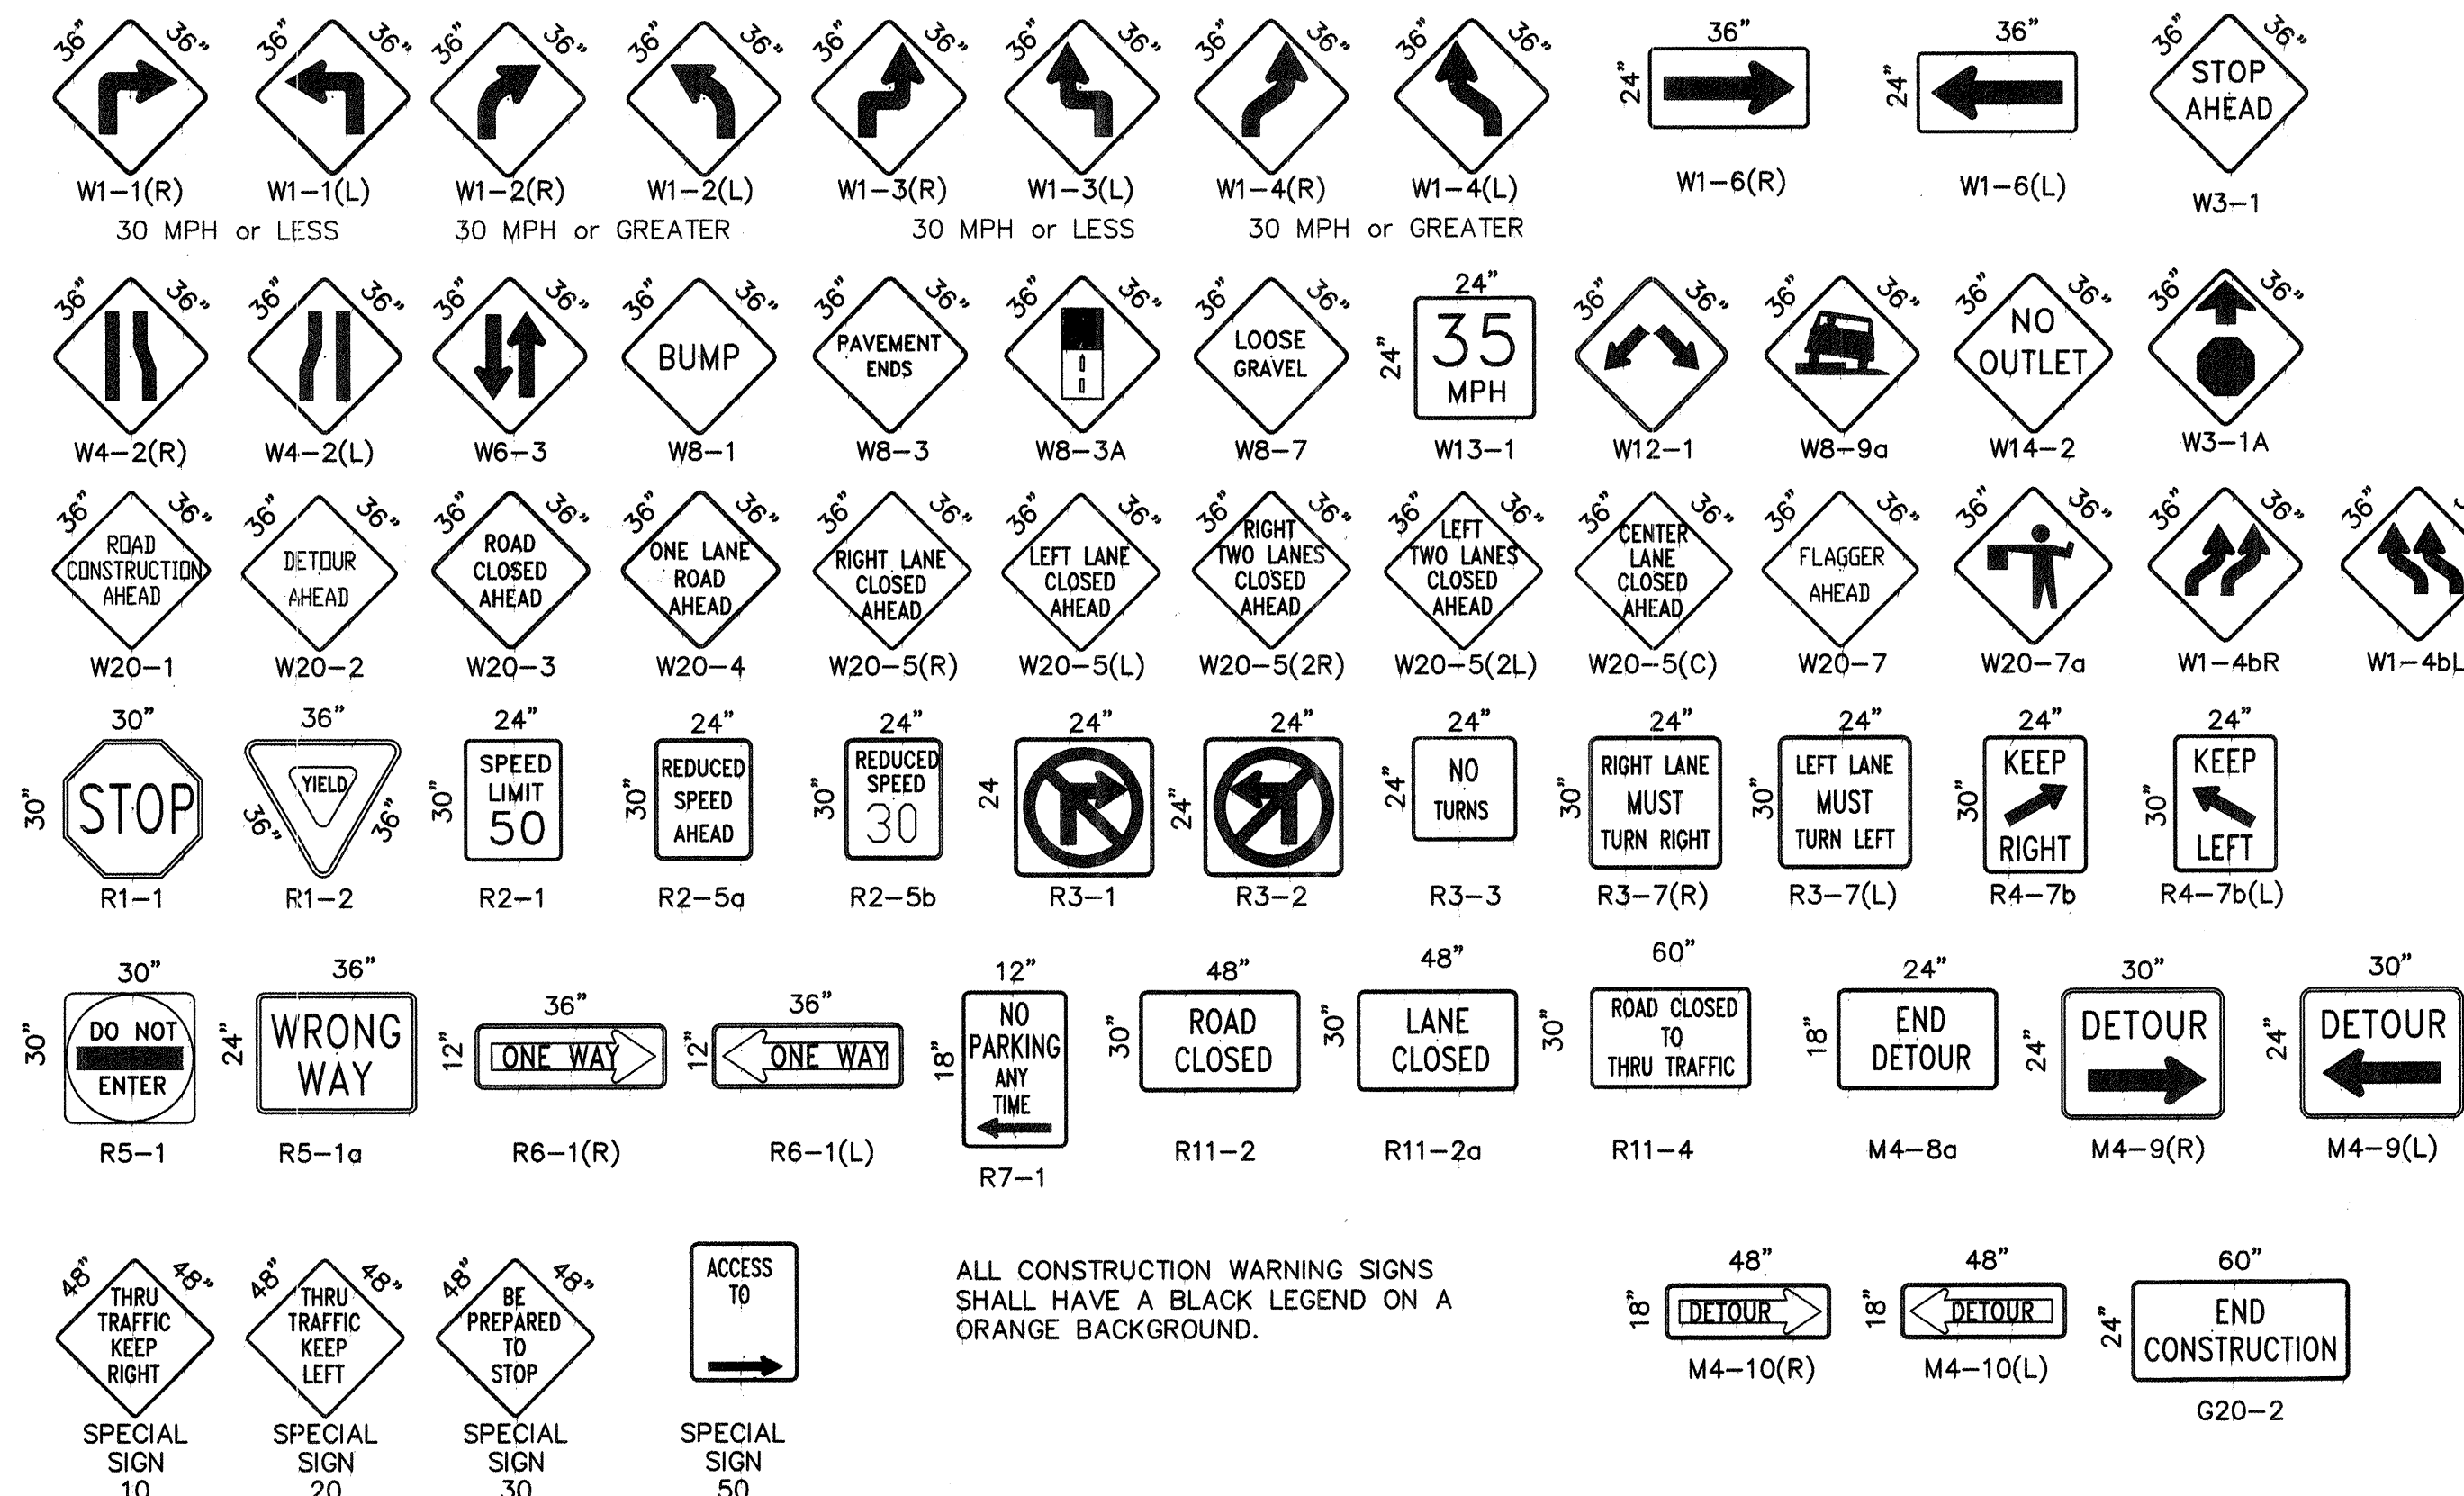

ALL CONSTRUCTION WARNING SIGNS SHALL HAVE A BLACK LEGEND ON A ORANGE BACKGROUND.

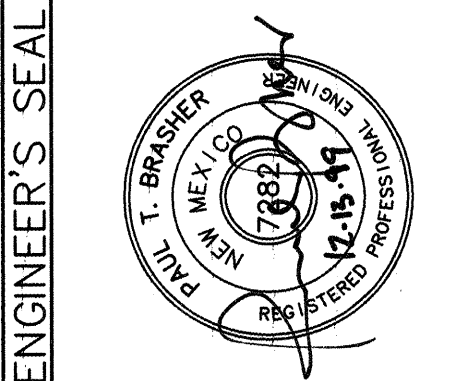

CITY OF ALBUQUERQUE PUBLIC WORKS DEPARTMENT ENGINEERING DEVELOPMENT GROUP	
TITLE: ATRISCO BUSINESS PARK UNIT 3 AND UNIT 4 WATER & SANITARY SEWER IMPROVEMENTS	
DESIGN REVIEW COMMITTEE CITY ENGINEER APPROVAL	MO./DAY/YR. MO./DAY/YR.
LAST UPDATE COP	STO
PROJECT NO. 285300	MAP NO. SHEET 9 OF 9