

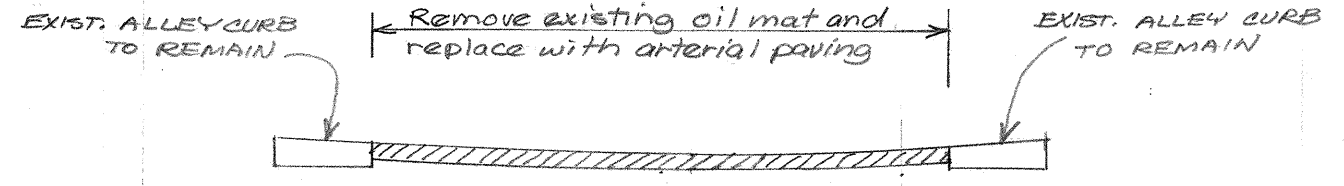


PLAN	SURVEYED	DATE
	NOTE BOOK	ALIGNMENT CHECKED
NO.	BY	NG

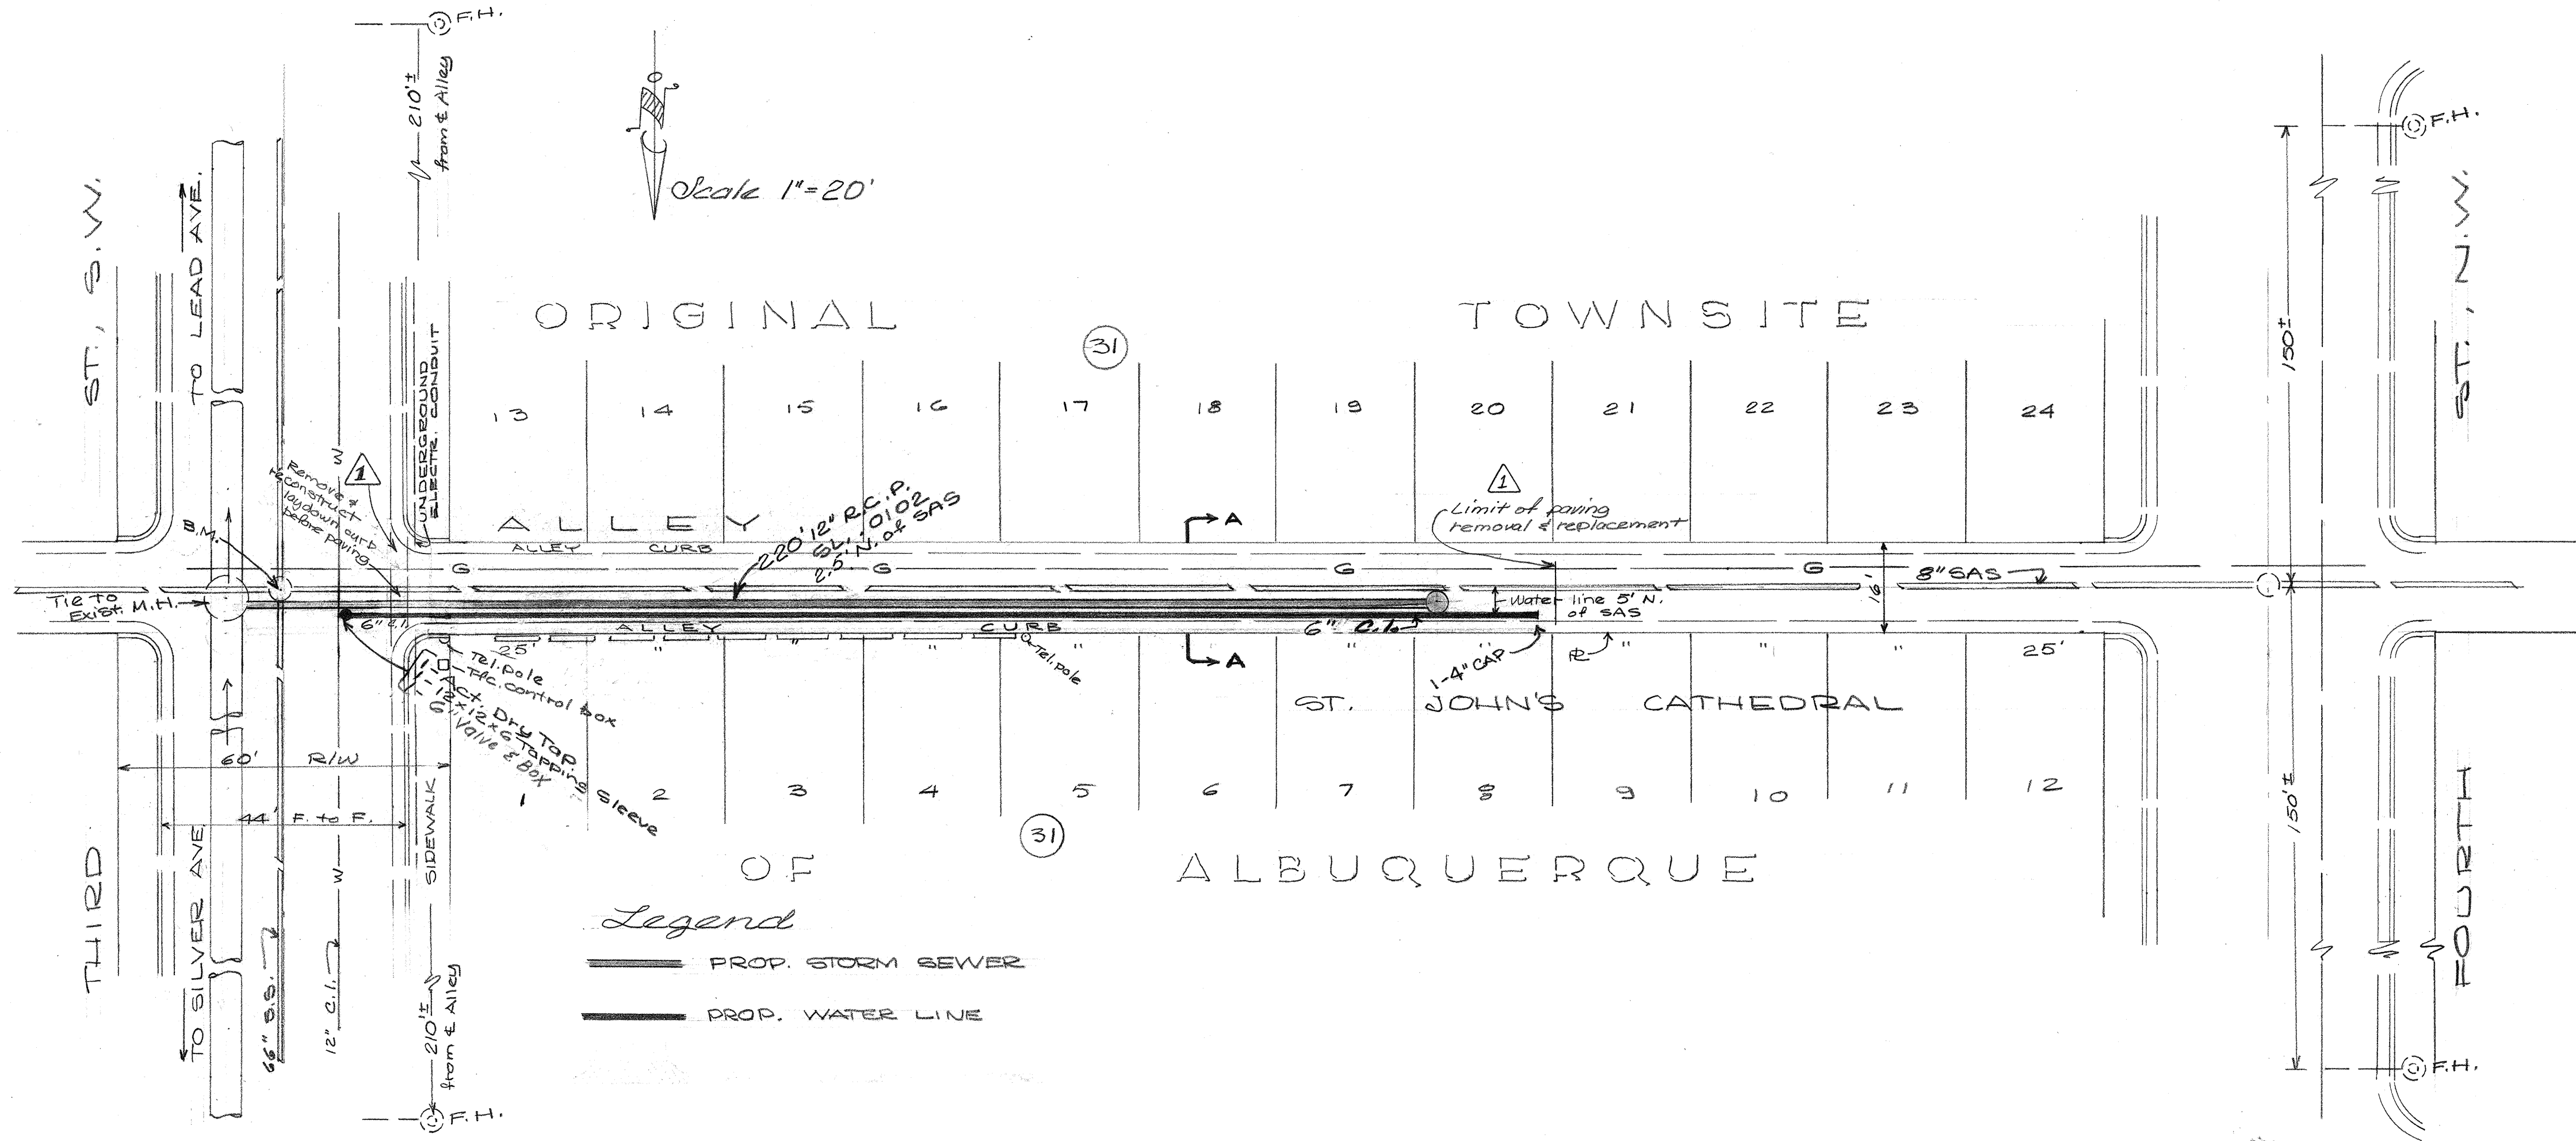

B.M. - Rim of Sanitary
Sewer M.H. at 3rd St.
& Alley S. of Silver
Elev. 89.12 (assumed)

PROFILE	SURVEYED	DATE
	NOTE BOOK	GRADES CHECKED
NO.	BY	NG

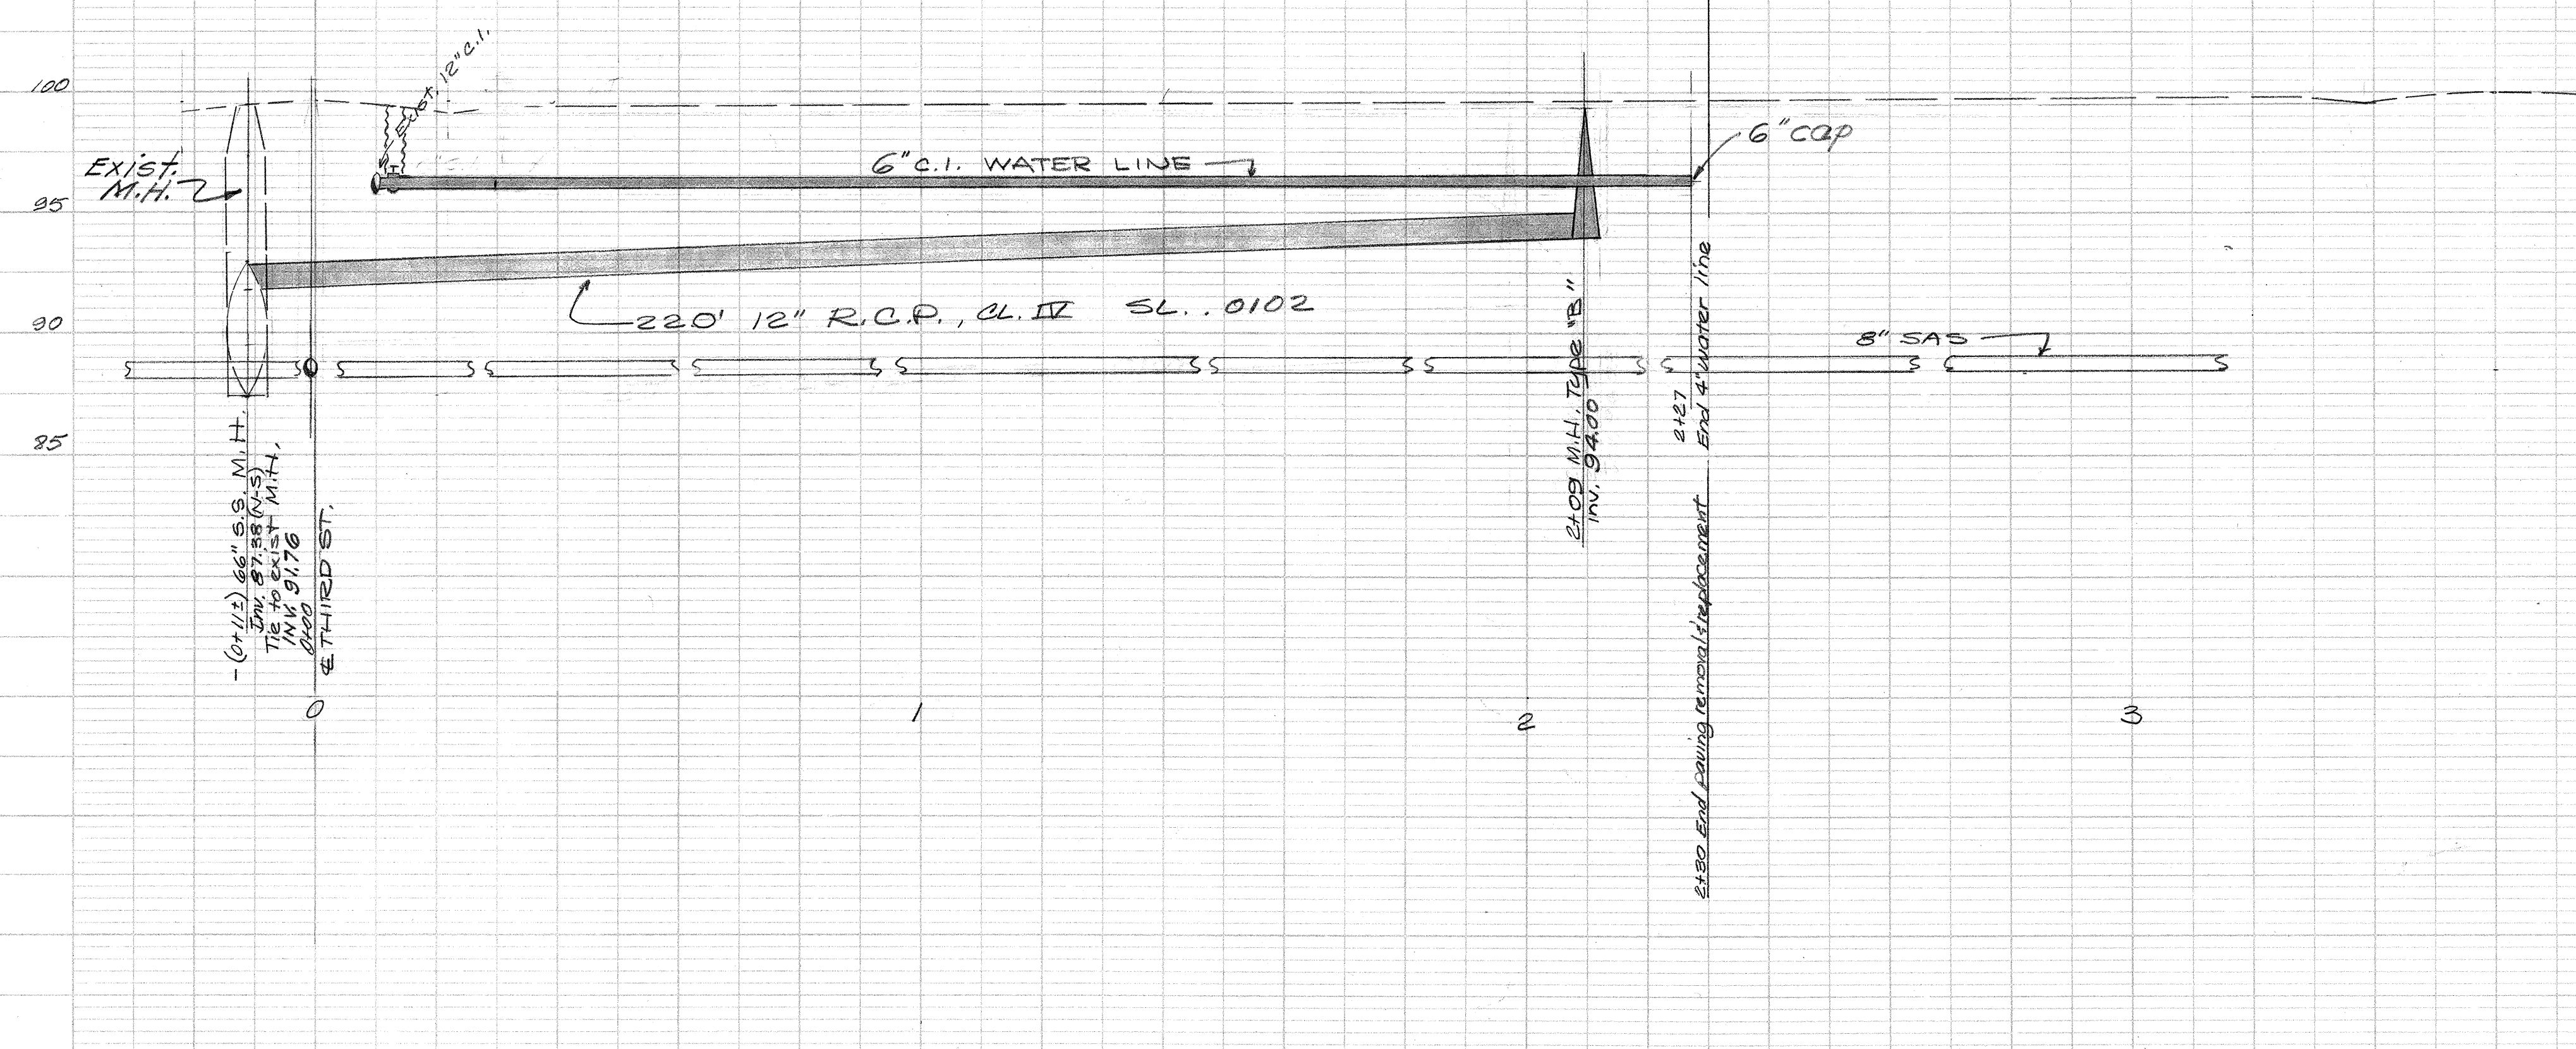

1	2	3	4	5	6	7	8	9	10	11	12	13	14	15	16	17	18	19	20	21	22	23	24	25	26	27	28	29	30	31	
22		028								0174							0201														

Map No. K-14

1 3/3/74 ADDED PAVING LIMITS		RE
NO.	DATE	REVISIONS
CITY OF ALBUQUERQUE PUBLIC WORKS DEPARTMENT ENGINEERING DIVISION		
TITLE STORM SEWER & WATER FOR ST. JOHN'S CATHEDRAL HOUSE Alley between Silver Lead 3rd & 4th		
DESIGNED BY	DRAWN BY	AS BUILT
TITLE	TITLE	SUBMITTED BY
DATE	DATE	DATE
APPROVAL		
ASS'T CITY ENGINEER	CITY ENGINEER	RECORDED BY
DATE	DATE	DATE
WATER ENGINEER	LIQUID WASTE ENGINEER	SHEET NO. 1 OF 1
DATE	DATE	
DRAWING NUMBER	55-28-74 W-10-75	