

CONSTRUCTION PLANS FOR
RINCON SUBDIVISION – PHASE I
GRADING AND DRAINAGE, PAVING,
PUBLIC WATER AND SEWER

DRAWING INDEX

SHEET TITLE

SHEET NO.

COVER SHEET
PLAT
GRADING AND DRAINAGE
OVERALL PAVING PLAN
STREET PAVING PLAN & PROFILES
OVERALL UTILITIES PLAN
UTILITIES PLAN & PROFILES
SUBDIVISION DETAILS
BOX CULVERT

1
2-4
5-7
8
9-19
20
21-31
32
33-36

SEWER


- ALL SEWER LINES SHALL BE CERTAINTIED FLUID-TITE PVC GRAVITY SEWER PIPE OR EQUAL.
- ALL NEW MANHOLES SHALL BE TYPE "E", 4-FEET IN DIAMETER AS PER CITY STANDARD DRAWING S-2, EXCEPT WHERE NOTED.
- SERVICE CONNECTIONS SHALL BE 4-INCH CAST IRON SOIL PIPE AND SHALL BE INSTALLED AS PER CITY STANDARD DRAWING S-8 OR S-9.
- ELECTRONIC MARKER DISKS SHALL BE INSTALLED AS SHOWN IN CITY STANDARD DRAWING S-9 AT ALL SERVICE CONNECTIONS.

WATER

- NEW WATER MAINS SHALL BE CITY OF ALBUQUERQUE APPROVED 8-INCH PVC PIPE.
- WATER MAINS SHALL HAVE 3-FEET MINIMUM COVER.
- ALL BENDS AND TEES IN WATER LINE WILL BE REINFORCED WITH CONCRETE BLOCKING AS SHOWN IN CITY STANDARD DRAWING W-22.
- FIRE HYDRANTS SHALL BE INSTALLED AS SHOWN IN CITY STANDARD DRAWING W-20.
- A 3' X 3' X 6" CONCRETE PAD WILL BE CONSTRUCTED AROUND CENTER LINE OF FIRE HYDRANTS - SEE CITY STANDARD DRAWING W-20, NOTE F.

PAVING

- ALL CURBS AND GUTTERS SHALL BE CONSTRUCTED AS PER CITY STANDARD DRAWING P-8 USING STANDARD OR MOUNTABLE ROLL TYPE CURBS AND GUTTERS EXCEPT WHERE NOTED.
- ALL CURVE DATA IS CALCULATED AT FLOW LINE OF STREET.
- AZUELO AVENUE NW SHALL BE 48 FEET WIDE WITH A 6-INCH CROWN AND SHALL BE CONSTRUCTED AS PER CITY STANDARD DRAWING FOR RESIDENTIAL STREETS, P-2.
- ASTAIR AVENUE SHALL BE 40 FEET WIDE WITH A 5-INCH CROWN AND SHALL BE CONSTRUCTED AS PER CITY STANDARD DRAWING FOR RESIDENTIAL STREETS, P-2.
- ALL OTHER STREETS SHALL BE 32 FEET WIDE WITH A 4-INCH CROWN AND SHALL BE CONSTRUCTED AS PER CITY STANDARD DRAWING FOR RESIDENTIAL STREETS, P-2.

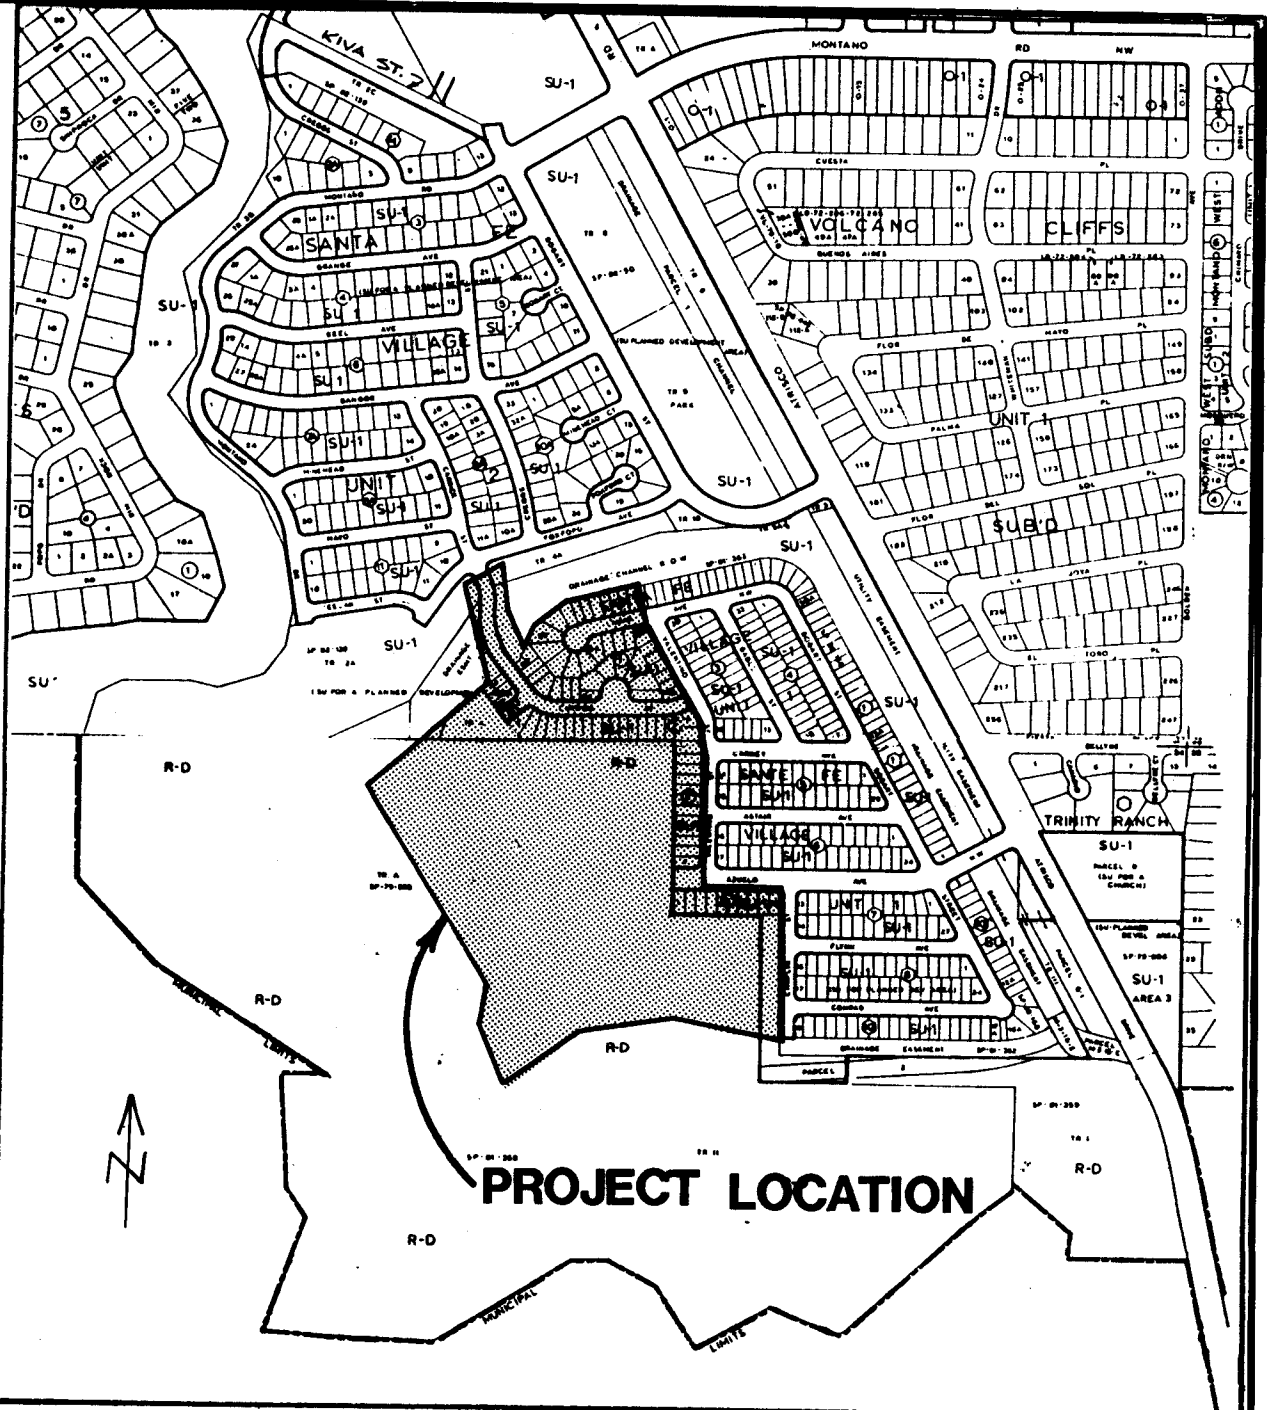

VICINITY MAP
NO SCALE

MAP NO. E-10
F-10

GENERAL NOTES

- ALL WORK DETAILED ON THESE PLANS TO BE PERFORMED UNDER CONTRACT SHALL, EXCEPT AS OTHERWISE STATED OR PROVIDED FOR HEREIN, BE CONSTRUCTED IN ACCORDANCE WITH THE CITY OF ALBUQUERQUE INTERIM STANDARD SPECIFICATIONS PUBLIC WORKS CONSTRUCTION 1985 (REFERRED TO HEREIN AS THE STANDARD SPECIFICATIONS), AND THE NEW MEXICO STANDARD SPECIFICATIONS FOR PUBLIC WORKS CONSTRUCTION - 1979 EDITION.
- TWO (2) WORKING DAYS PRIOR TO ANY EXCAVATION, CONTRACTOR MUST CONTACT LINE LOCATING SERVICE, 765-1234, FOR LOCATION OF EXISTING UTILITIES.
- PRIOR TO CONSTRUCTION, THE CONTRACTOR SHALL EXCAVATE AND VERIFY THE HORIZONTAL AND VERTICAL LOCATIONS OF ALL OBSTRUCTIONS. SHOULD A CONFLICT EXIST, THE CONTRACTOR SHALL NOTIFY THE ENGINEER OR SURVEYOR SO THAT THE CONFLICT CAN BE RESOLVED WITH MINIMUM AMOUNT OF DELAY.
- ALL UTILITIES AND UTILITY SERVICE LINES SHALL BE INSTALLED PRIOR TO PAVING.
- BACKFILL COMPACTION SHALL BE ACCORDING TO SPECIFIED STREET USE.
- TACK COAT REQUIREMENTS SHALL BE DETERMINED BY THE CITY ENGINEER.
- SIDEWALKS AND CHEELCHAIR RAMPS WITHIN THE CURB RETURNS SHALL BE CONSTRUCTED WHEREVER A NEW CURB RETURN IS CONSTRUCTED.
- IF CURB IS DEPRESSED FOR A DRIVEPAD OR A HANDICAP RAMP, THE DRIVEPAD OR RAMP SHALL BE CONSTRUCTED PRIOR TO ACCEPTANCE OF THE CURB AND GUTTER.
- ALL STORM DRAINAGE FACILITIES SHALL BE COMPLETED PRIOR TO FINAL ACCEPTANCE.
- ALL STATIONING IS AT CENTER LINE OF CHANNEL UNLESS NOTED OTHERWISE.
- ALL WORK SHALL BE DONE BY QUALIFIED PERSONNEL IN AN APPROVED STANDARD OF PRACTICE.
- THE COST OF ADDITIONAL DESIGN WORK DUE TO ERRORS AND OMISSIONS IN CONSTRUCTION SHALL BE BORNE BY THE CONTRACTOR.
- VERIFY ALL DIMENSIONS AND CONDITIONS PRIOR TO STARTING WORK. NOTIFY THE ENGINEER OF ANY DISCREPANCIES OR INCONSISTENCIES.
- VERIFY IN FIELD ALL EXISTING CONDITIONS SHOWN ON DRAWINGS.
- ALL UTILITIES SHOWN AND ANY OTHER UTILITIES THAT ARE NOT SHOWN ON THE PLANS BUT ARE WITHIN THE CONSTRUCTION AREA SHALL BE LOCATED, IDENTIFIED AND PROTECTED AT ALL TIMES DURING CONSTRUCTION BY THE CONTRACTOR.

Russell B. B. B.
9-28-87

26 28790187

REV.	SHEETS	CITY ENGR.	DATE	DATE	DATE

APPROVAL OF REVISIONS

	PREPARED BY: RESOURCE TECHNOLOGY INCORPORATED	APPROVED FOR CONSTRUCTION
	PROJECT NO. 2879	SHEET 1 OF 36


RINCON SUBDIVISION ALBUQUERQUE, BERNALILLO COUNTY, NEW MEXICO MARCH 1986

CURVE TABLE

CURVE NUMBER	ARC LENGTH	RADIUS	DELTA
28	68.43'	502.00'	07 deg 48' 37"
30	95.90'	232.80'	23 deg 36' 09"
44	56.32'	346.67'	08 deg 18' 28"
54	39.27'	25.00'	90 deg 00' 00"
57	71.45'	95.40'	42 deg 54' 51"
59	39.27'	25.00'	90 deg 00' 00"
63	40.82'	300.00'	07 deg 48' 56"
65	45.38'	25.00'	103 deg 53' 18"
67	84.10'	211.95'	22 deg 44' 02"
69	31.88'	211.95'	08 deg 16' 45"
73	75.21'	335.00'	12 deg 51' 49"
75	13.01'	300.00'	02 deg 29' 08"
77	42.88'	25.00'	98 deg 16' 23"
78	69.77'	261.95'	15 deg 13' 02"
89	167.39'	350.00'	27 deg 22' 06"
91	14.50'	261.95'	03 deg 06' 28"
92	64.50'	261.95'	14 deg 12' 27"
93	224.78'	300.00'	42 deg 55' 25"
100	149.60'	250.00'	34 deg 08' 52"
102	43.00'	25.00'	98 deg 39' 45"
112	119.20'	200.00'	34 deg 08' 52"
114	32.48'	25.00'	74 deg 28' 21"
116	39.27'	25.00'	90 deg 00' 00"
117	55.40'	204.38'	15 deg 31' 49"
126	39.27'	25.00'	90 deg 00' 00"
129	39.22'	25.00'	89 deg 53' 04"
134	47.11'	93.85'	28 deg 45' 29"
150	22.00'	20.00'	02 deg 55' 53"
152	68.43'	502.00'	07 deg 48' 37"
155	280.41'	276.00'	58 deg 12' 41"
161	39.27'	25.00'	90 deg 00' 00"
166	31.12'	250.00'	07 deg 07' 57"
167	35.76'	25.00'	81 deg 56' 41"
168	65.35'	380.80'	10 deg 41' 51"
170	39.27'	25.00'	90 deg 00' 00"
172	108.91'	145.48'	42 deg 54' 51"
197	259.84'	200.00'	74 deg 26' 21"
194	95.02'	350.00'	15 deg 33' 19"
209	39.27'	25.00'	90 deg 00' 00"
210	4.56'	775.90'	00 deg 20' 15"
216	41.98'	350.00'	06 deg 52' 24"
217	35.99'	300.00'	06 deg 52' 24"
246	3.03'	300.00'	00 deg 34' 43"
256	36.43'	215.00'	16 deg 41' 58"
258	32.48'	25.00'	74 deg 28' 21"
259	69.65'	545.82'	07 deg 54' 09"

LINE TABLE

LINE	DIST	BEARING	LINE	DIST	BEARING	LINE	DIST	BEARING
1	480.00'	N 00°13'46" E	124	70.00'	N 00°13'46" E	214	166.17'	S 50°35'03" W
2	405.26'	N 89°46'14" W	125	368.46'	N 89°46'14" W	219	17.34'	N 00°15'22" E
3	95.00'	N 00°20'42" E	127	68.00'	N 00°20'42" E	218	13.61'	N 89°46'14" W
4	786.12'	N 89°44'38" W	128	56.44'	S 89°46'14" E	219	13.61'	S 89°46'14" E
5	163.74'	N 89°44'38" W	130	529.75'	N 00°20'42" E	220	50.00'	S 48°07'06" E
6	25.11'	N 88°03'07" W	131	489.82'	N 00°20'42" E	221	104.82'	N 26°41'24" W
7	560.85'	S 00°17'46" W	132	154.67'	N 52°55'02" E	222	55.75'	N 17°00'17" E
8	448.53'	S 42°35'09" E	133	74.15'	N 89°44'38" W	223	104.82'	N 26°41'24" W
9	789.21'	S 56°38'00" E	136	255.00'	N 89°44'38" W	224	93.86'	S 80°45'00" W
10	182.91'	N 89°46'15" W	137	66.18'	N 89°46'06" W	225	104.82'	N 26°41'24" W
11	14.25'	S 48°55'30" E	138	108.45'	S 50°35'03" W	226	52.66'	N 09°02'46" E
12	428.50'	S 03°17'08" E	139	181.00'	S 57°30'00" W	227	104.82'	N 26°41'24" W
13	137.57'	S 32°20'13" E	140	438.00'	S 80°45'00" W	228	146.34'	S 80°45'00" W
14	459.90'	S 19°51'41" W	141	228.00'	S 46°35'00" W	229	121.18'	N 26°41'24" W
15	91.28'	S 87°30'24" E	142	295.00'	N 75°00'00" W	230	50.09'	N 34°34'20" W
16	576.19'	N 41°58'47" E	143	184.00'	S 36°00'00" W	231	269.00'	N 52°15'08" W
17	127.63'	N 47°38'24" E	144	150.00'	S 23°45'00" E	232	210.00'	N 16°36'08" W
18	202.61'	S 46°10'05" E	145	59.00'	S 75°20'00" E	233	30.00'	S 74°12'36" W
19	202.61'	S 46°14'14" E	146	39.23'	S 52°15'00" E	234	111.91'	N 17°09'40" W
20	99.31'	N 22°07'00" E	147	20.00'	S 02°55'00" E	235	56.74'	N 01°07'02" W
21	88.22'	N 22°07'00" E	148	70.00'	N 80°00'00" E	236	114.74'	N 28°45'00" W
22	299.15'	N 89°44'38" W	149	00.00'	N 47°50'00" E	237	65.00'	S 47°50'00" W
23	20.85'	N 89°44'38" W	151	61.21'	N 60°31'19" E	238	495.00'	S 47°50'00" W
24	125.68'	N 00°15'22" E	152	252.11'	N 40°00'00" E	239	131.20'	S 77°08'52" W
25	466.02'	N 35°00'00" W	160	52.87'	N 07°54'51" W	240	84.56'	S 12°51'08" E
26	672.15'	N 71°04'41" E	162	50.00'	N 82°05'09" E	241	60.49'	N 69°06'49" E
27	298.06'	N 84°53'42" E	163	460.00'	N 82°05'09" E	242	107.26'	N 88°30'00" E
28	90.26'	N 17°06'46" E	164	146.48'	N 67°45'31" W	243	48.23'	N 63°15'00" E
29	92.00'	N 17°06'46" E	165	17.98'	S 35°00'00" E	244	127.13'	N 71°17'37" E
30	109.66'	N 62°52'06" E	167	304.19'	S 42°05'09" E	245	252.32'	N 37°02'14" E
31	263.94'	S 68°22'42" E	174	132.13'	S 47°54'51" E	246	78.05'	N 89°46'14" W
32	104.12'	N 76°52'22" E	175	50.00'	N 00°03'09" E	247	68.00'	S 00°20'42" E
33	182.24'	N 74°19'46" E	176	113.07'	S 00°15'00" E	248	380.26'	S 89°46'14" E
34	133.51'	N 37°08'46" E	177	38.93'	S 00°15'00" E	249	187.46'	S 80°45'00" E
35	61.15'	N 10°46'49" E	178	362.00'	S 00°15'00" E	250	250.34'	N 80°45'00" E
36	31.99'	N 82°05'09" E	179	142.00'	N 75°20'00" E	251	366.52'	N 28°38'00" W
37	304.19'	N 82°05'09" E	180	94.00'	N 75°20'00" E	252	50.00'	N 13°42'00" E
38	50.00'	S 55°00'00" E	181	196.36'	N 61°00'00" E	253	188.00'	N 89°30'00" E
39	52.177'	N 15°00'00" E	182	216.00'	N 72°00'00" E			
40	67.00'	N 84°53'42" E	183	116.63'	N 53°00'00" E			
41	99.43'	N 29°42'48" W	184	71.37'	N 53°00'00" E			
42	607.91'	S 73°09'00" W	185	107.00'	N 43°00'00" E			
43	91.95'	N 38°00'00" W	186	129.00'	N 41°00'00" E			
44	84.50'	N 52°00'00" E	187	53.13'	N 67°00'00" E			
45	50.00'	N 38°00'00" W	188	159.30'	N 48°00'00" E			
46	111.28'	N 38°00'00" W	189	211.00'	N 63°00'00" E			
47	100.01'	N 52°5'09" E	190	190.00'	N 80°00'00" E			
48	75.00'	N 52°00'00" E	191	204.00'	N 60°00'00" E			
49	23.25'	N 52°55'02" E	195	117.43'	S 42°05'09" E			
50	145.96'	N 24°55'32" E	196	1150.92'	N 28°06'41" E			
51	150.00'	N 52°07'00" E	198	467.25'	S 77°08'52" W			
52	282.14'	N 77°08'52" E	199	1406.71'	S 28°24'47" E			
53	95.00'	S 12°51'08" E	200	91.00'	S 69°00'00" E			
54	140.19'	S 77°08'52" E	201	190.50'	N 75°20'00" E			
55	124.55'	S 43°00'00" E	202	1.88'	N 89°00'00" E			
56	122.86'	N 36°10'00" W	203	110.38'	S 17°00'00" E			
57	54.67'	N 36°10'00" W	205	104.00'	S 36°15'00" E			
58	204.55'	N 43°00'00" E						
59	136.93'	N 77°08'52" E						
60	275.02'	S 28°24'47" E						
61	100.33'	S 00°13'54" W						
62	101.79'	S 00°46'00" E						

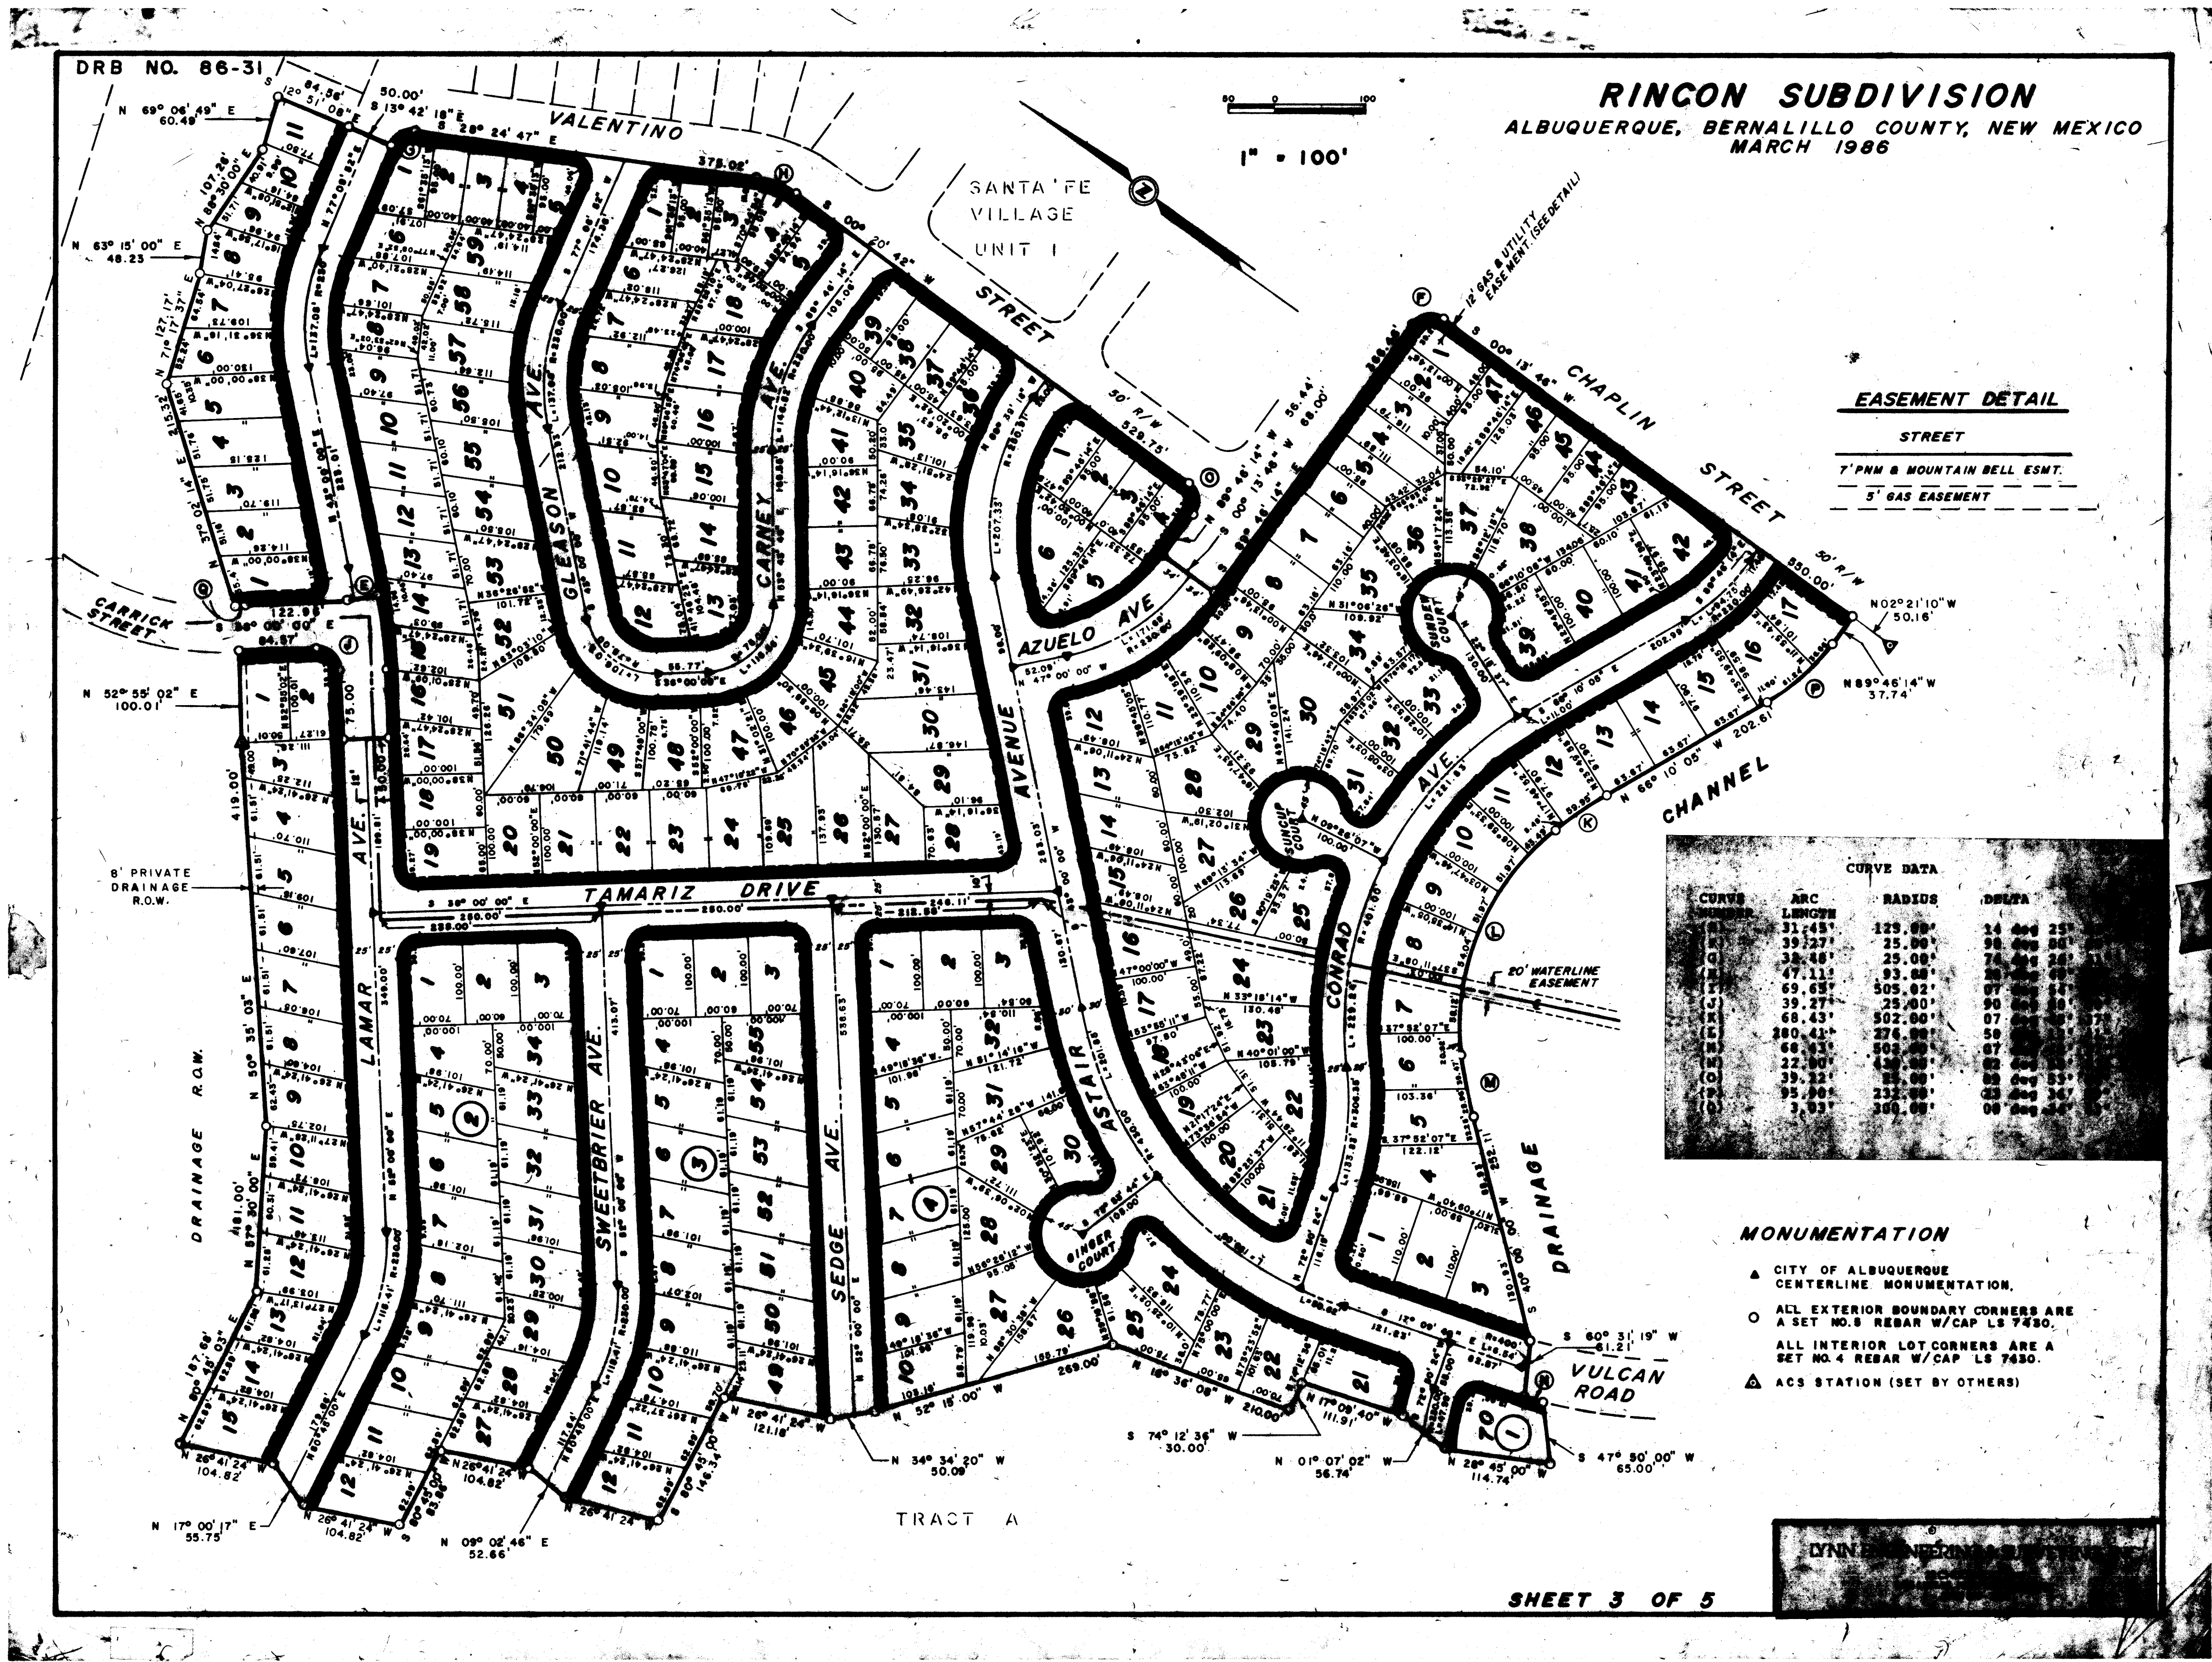

EASEMENT DETAIL

STREET
7' PNM & MOUNTAIN BELL ESMT.
5' GAS EASEMENT

CURVE DATA			
CURVE NUMBER	ARC LENGTH	RADIUS	DEGREE
1	31.45'	129.00'	14.40° 25'
2	39.27'	25.00'	98.40° 00'
3	38.48'	25.00'	74.40° 20'
4	47.11'	93.00'	28.40° 00'
5	59.69'	505.02'	07.40° 00'
6	39.27'	25.00'	98.40° 00'
7	68.43'	502.00'	07.40° 00'
8	280.43'	276.00'	50.40° 00'
9	68.43'	505.02'	07.40° 00'
10	22.00'	420.00'	08.40° 00'
11	39.27'	25.00'	98.40° 00'
12	95.90'	232.00'	33.40° 00'
13	3.03'	300.00'	00.40° 00'

MONUMENTATION


- ▲ CITY OF ALBUQUERQUE CENTERLINE MONUMENTATION.
- ALL EXTERIOR BOUNDARY CORNERS ARE A SET NO. 8 REBAR W/CAP LS 7430.
- ALL INTERIOR LOT CORNERS ARE A SET NO. 4 REBAR W/CAP LS 7430.
- ▲ ACS STATION (SET BY OTHERS)

LASON 1-505-344-9404
BEST COPY AVAILABLE

ENGINEER'S SEAL			SURVEY INFORMATION		BENCH MARKS		AS BUILT INFORMATION						
NO.	DATE	REMARKS	BY	FIELD NOTES	DATE		DATE						
DESIGNED BY			REVISIONS		DATE		DATE						
DRAWN BY			DESIGN		DATE		DATE						
CHECKED BY							MICRO-FILM INFORMATION						
							DATE						

26 28790487

CITY OF ALBUQUERQUE MUNICIPAL DEVELOPMENT DEPARTMENT ENGINEERING DIVISION					
TITLE: RINCON SUBDIVISION - PHASE I PLAT					
APPROVALS	ENGINEER	DATE	APPROVALS	ENGINEER	DATE
City Engineer			Liquid Waste		
A C E - Design			Traffic		
A C E - Hydrology			Water		
DRAWING NO.		MAP NO.		SHEET 4 OF 36	
2879					

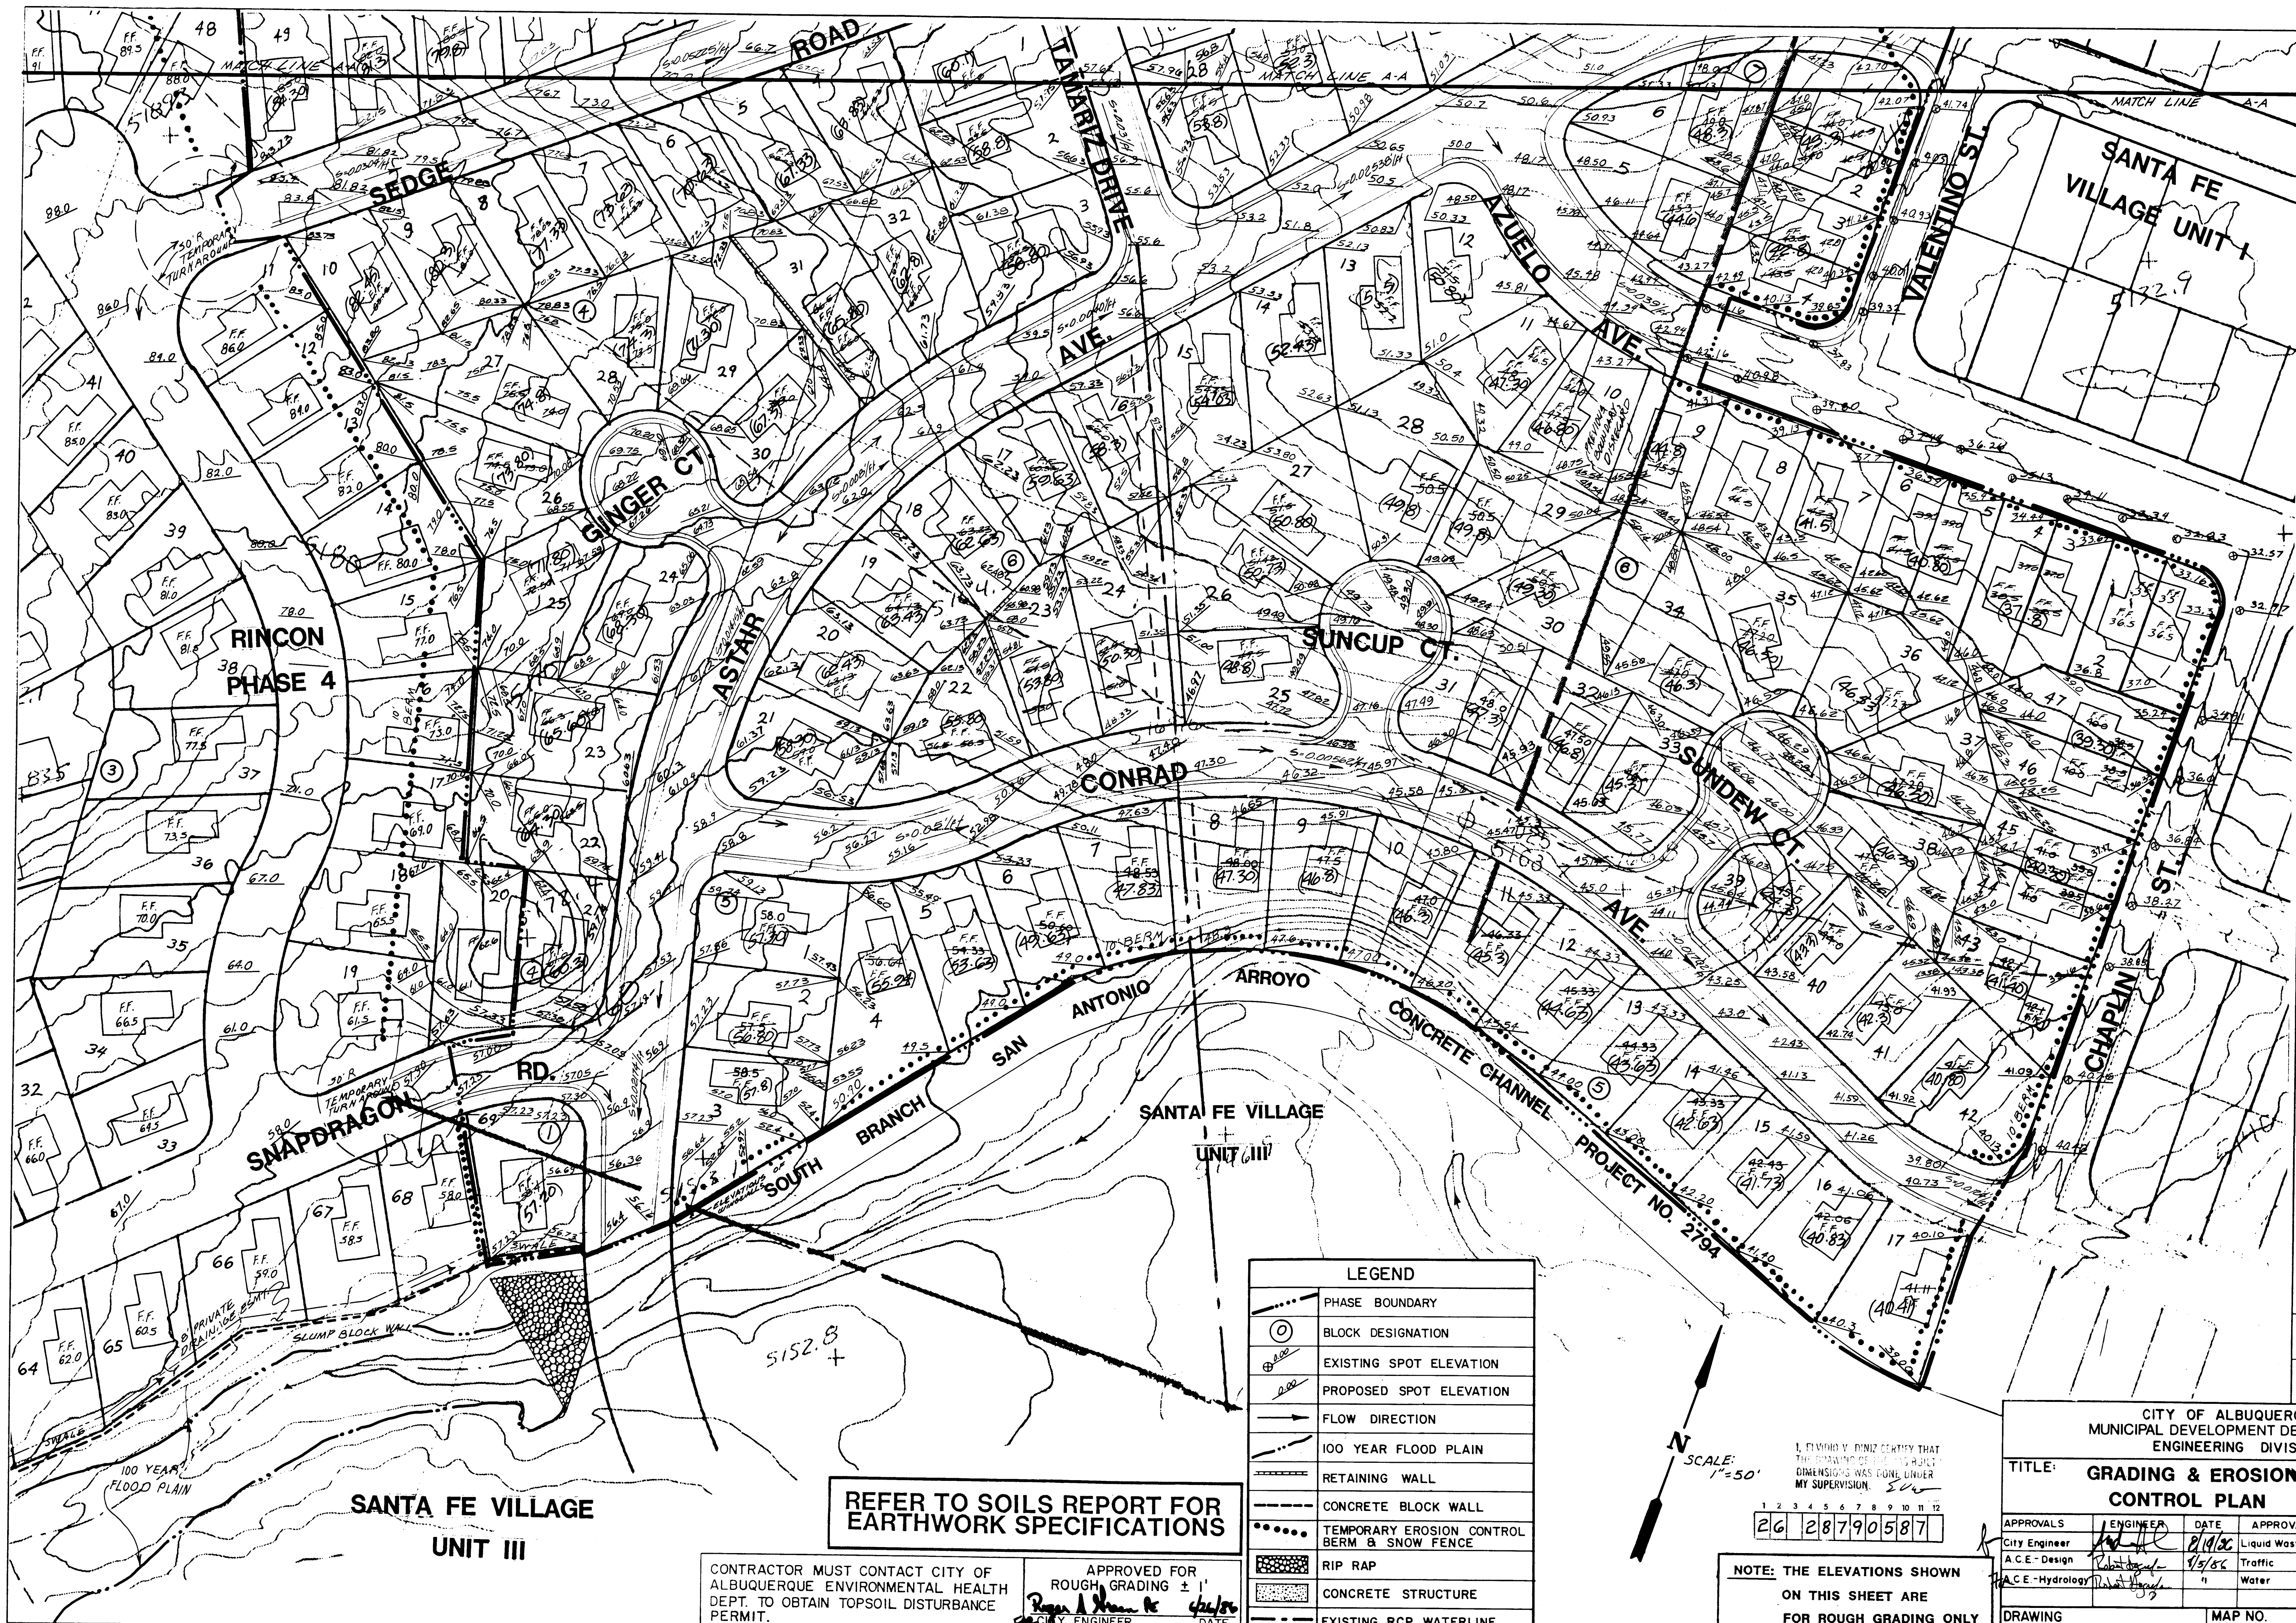


CONTRACTOR MUST CONTACT CITY OF ALBUQUERQUE ENVIRONMENTAL HEALTH DEPT. TO OBTAIN TOPSOIL DISTURBANCE PERMIT.

APPROVED FOR
ROUGH GRADING ± 1'
CITY ENGINEER
DATE 4/2/86

LEGEND	
	PHASE BOUNDARY
	BLOCK DESIGNATION
	EXISTING SPOT ELEVATION
	PROPOSED SPOT ELEVATION
	FLOW DIRECTION
	100 YEAR FLOOD PLAIN
	RETAINING WALL
	CONCRETE BLOCK WALL
	TEMPORARY EROSION CONTROL BERM & SNOW FENCE
	RIP RAP
	CONCRETE STRUCTURE
	EXISTING RCP WATERLINE

NOTE: THE ELEVATIONS SHOWN ON THIS SHEET ARE FOR ROUGH GRADING ONLY

CITY OF ALBUQUERQUE MUNICIPAL DEVELOPMENT DEPARTMENT ENGINEERING DIVISION					
TITLE: GRADING & EROSION CONTROL PLAN					
APPROVALS	ENGINEER	DATE	APPROVALS	ENGINEER	DATE
City Engineer	<i>[Signature]</i>	7/29/86	Liquid Waste	N/A WJW	7/29/86
A.C.E. Design	<i>[Signature]</i>	7/5/86	Traffic	N/A DWH	7/31/86
A.C.E. Hydrology	<i>[Signature]</i>		Water	N/A WJW	7/29/86
DRAWING NO. 2879		MAP NO.		SHEET 5 OF 36	

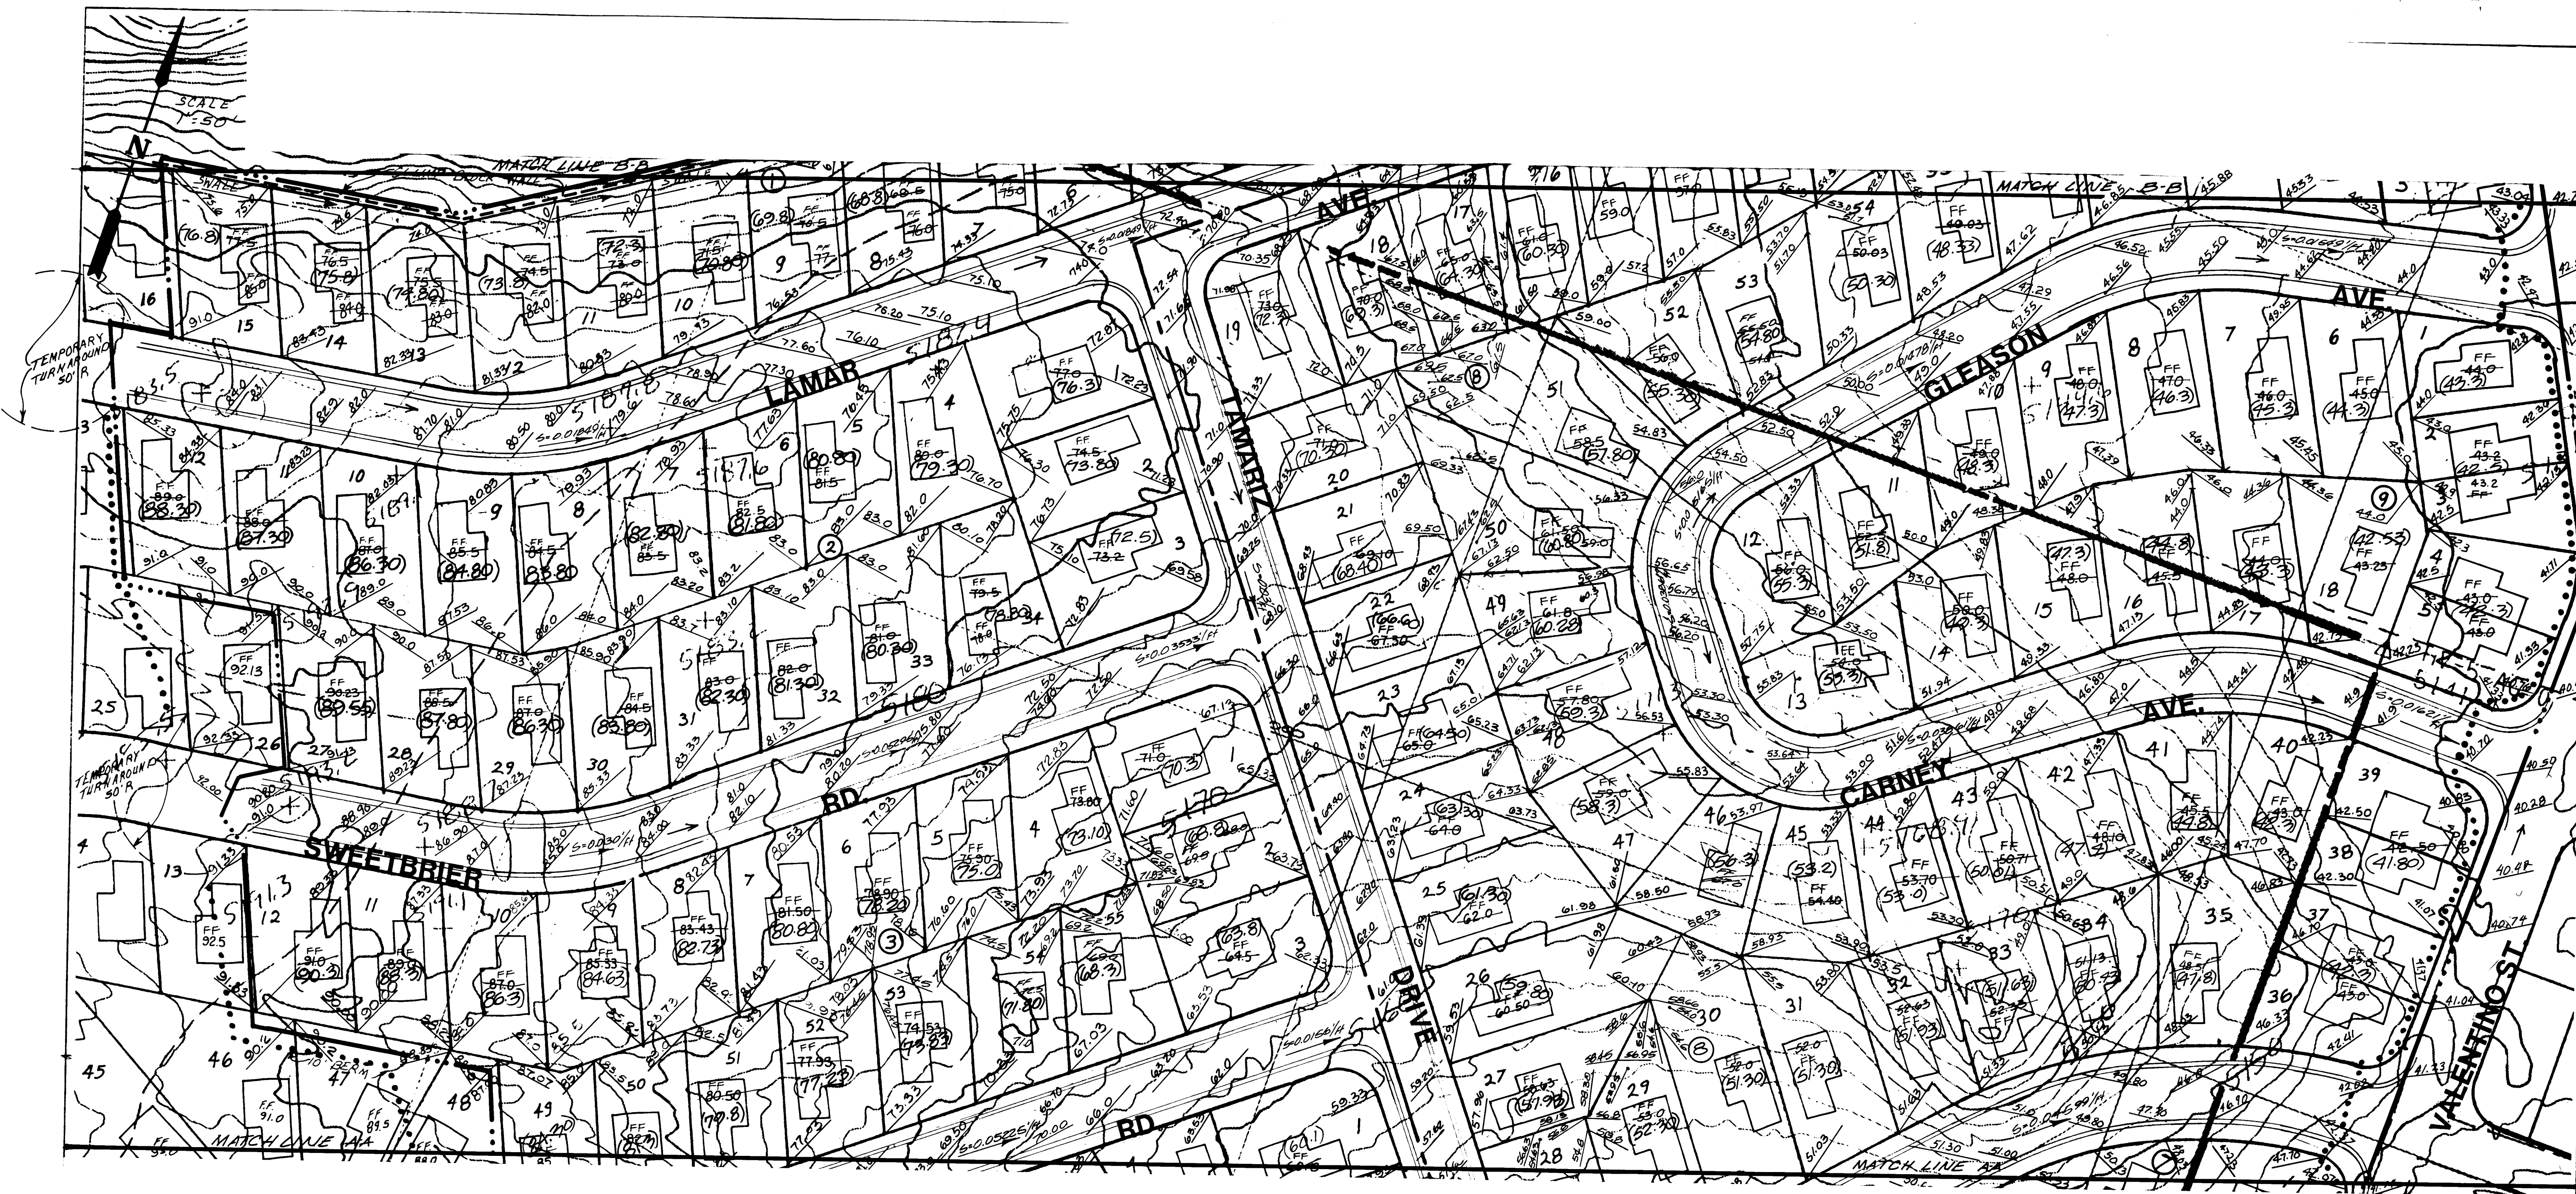

26 28 79 06 87

NOTE: THE ELEVATIONS SHOWN ON THIS SHEET ARE FOR ROUGH GRADING ONLY

REFER TO SOILS REPORT FOR EARTHWORK SPECIFICATIONS



CONTRACTOR MUST CONTACT CITY OF ALBUQUERQUE ENVIRONMENTAL HEALTH DEPT. TO OBTAIN TOPSOIL DISTURBANCE PERMIT.

APPROVED FOR ROUGH GRADING ± 1'
 [Signature]
 CITY ENGINEER

CITY OF ALBUQUERQUE MUNICIPAL DEVELOPMENT DEPARTMENT ENGINEERING DIVISION					
TITLE: GRADING & EROSION CONTROL PLAN					
APPROVALS	ENGINEER	DATE	APPROVALS	ENGINEER	DATE
City Engineer	[Signature]	8/14/86	Liquid Waste	WJH WJW	7/27/86
A.C.E. - Design	[Signature]	8/5/86	Traffic	NA DWB	7/31/86
A.C.E. - Hydrology	[Signature]	"	Water	NA WJW	7/29/86
DRAWING NO. 2879		MAP NO.		SHEET 6 OF 36	

CITY BENCHMARK 16610
EL. 5134.777 A CHISELED
SQUARE IN TOP OF CURB.
LOCATED AT NW CORNER
OF INTERSECTION ATRISCO
RD. AND FLOR DEL SOL.

A hand-drawn sketch map showing the intersection of Atrisco Rd. and Flor del Sol Pl. Atrisco Rd. runs vertically, and Flor del Sol Pl. runs horizontally. Bogert St. is shown as a curved road to the left of Atrisco Rd. A benchmark marker, labeled 'BM 16610', is located at the NW corner of the intersection of Atrisco Rd. and Flor del Sol Pl. A north arrow points upwards, and the text 'NOT TO SCALE' is written at the bottom right.

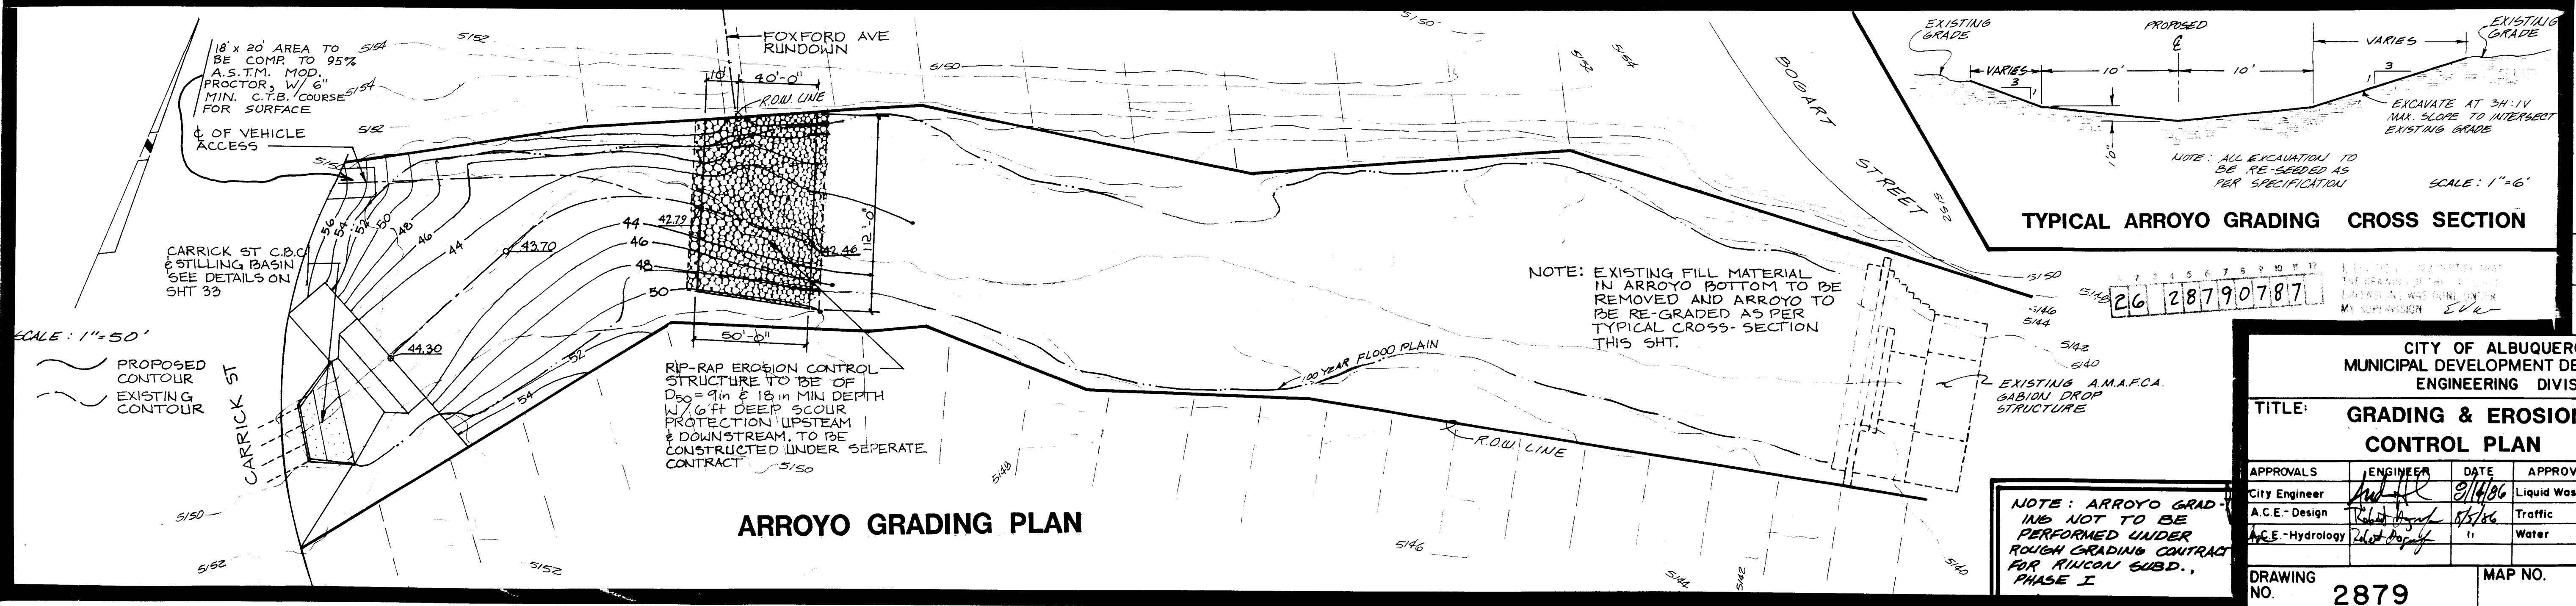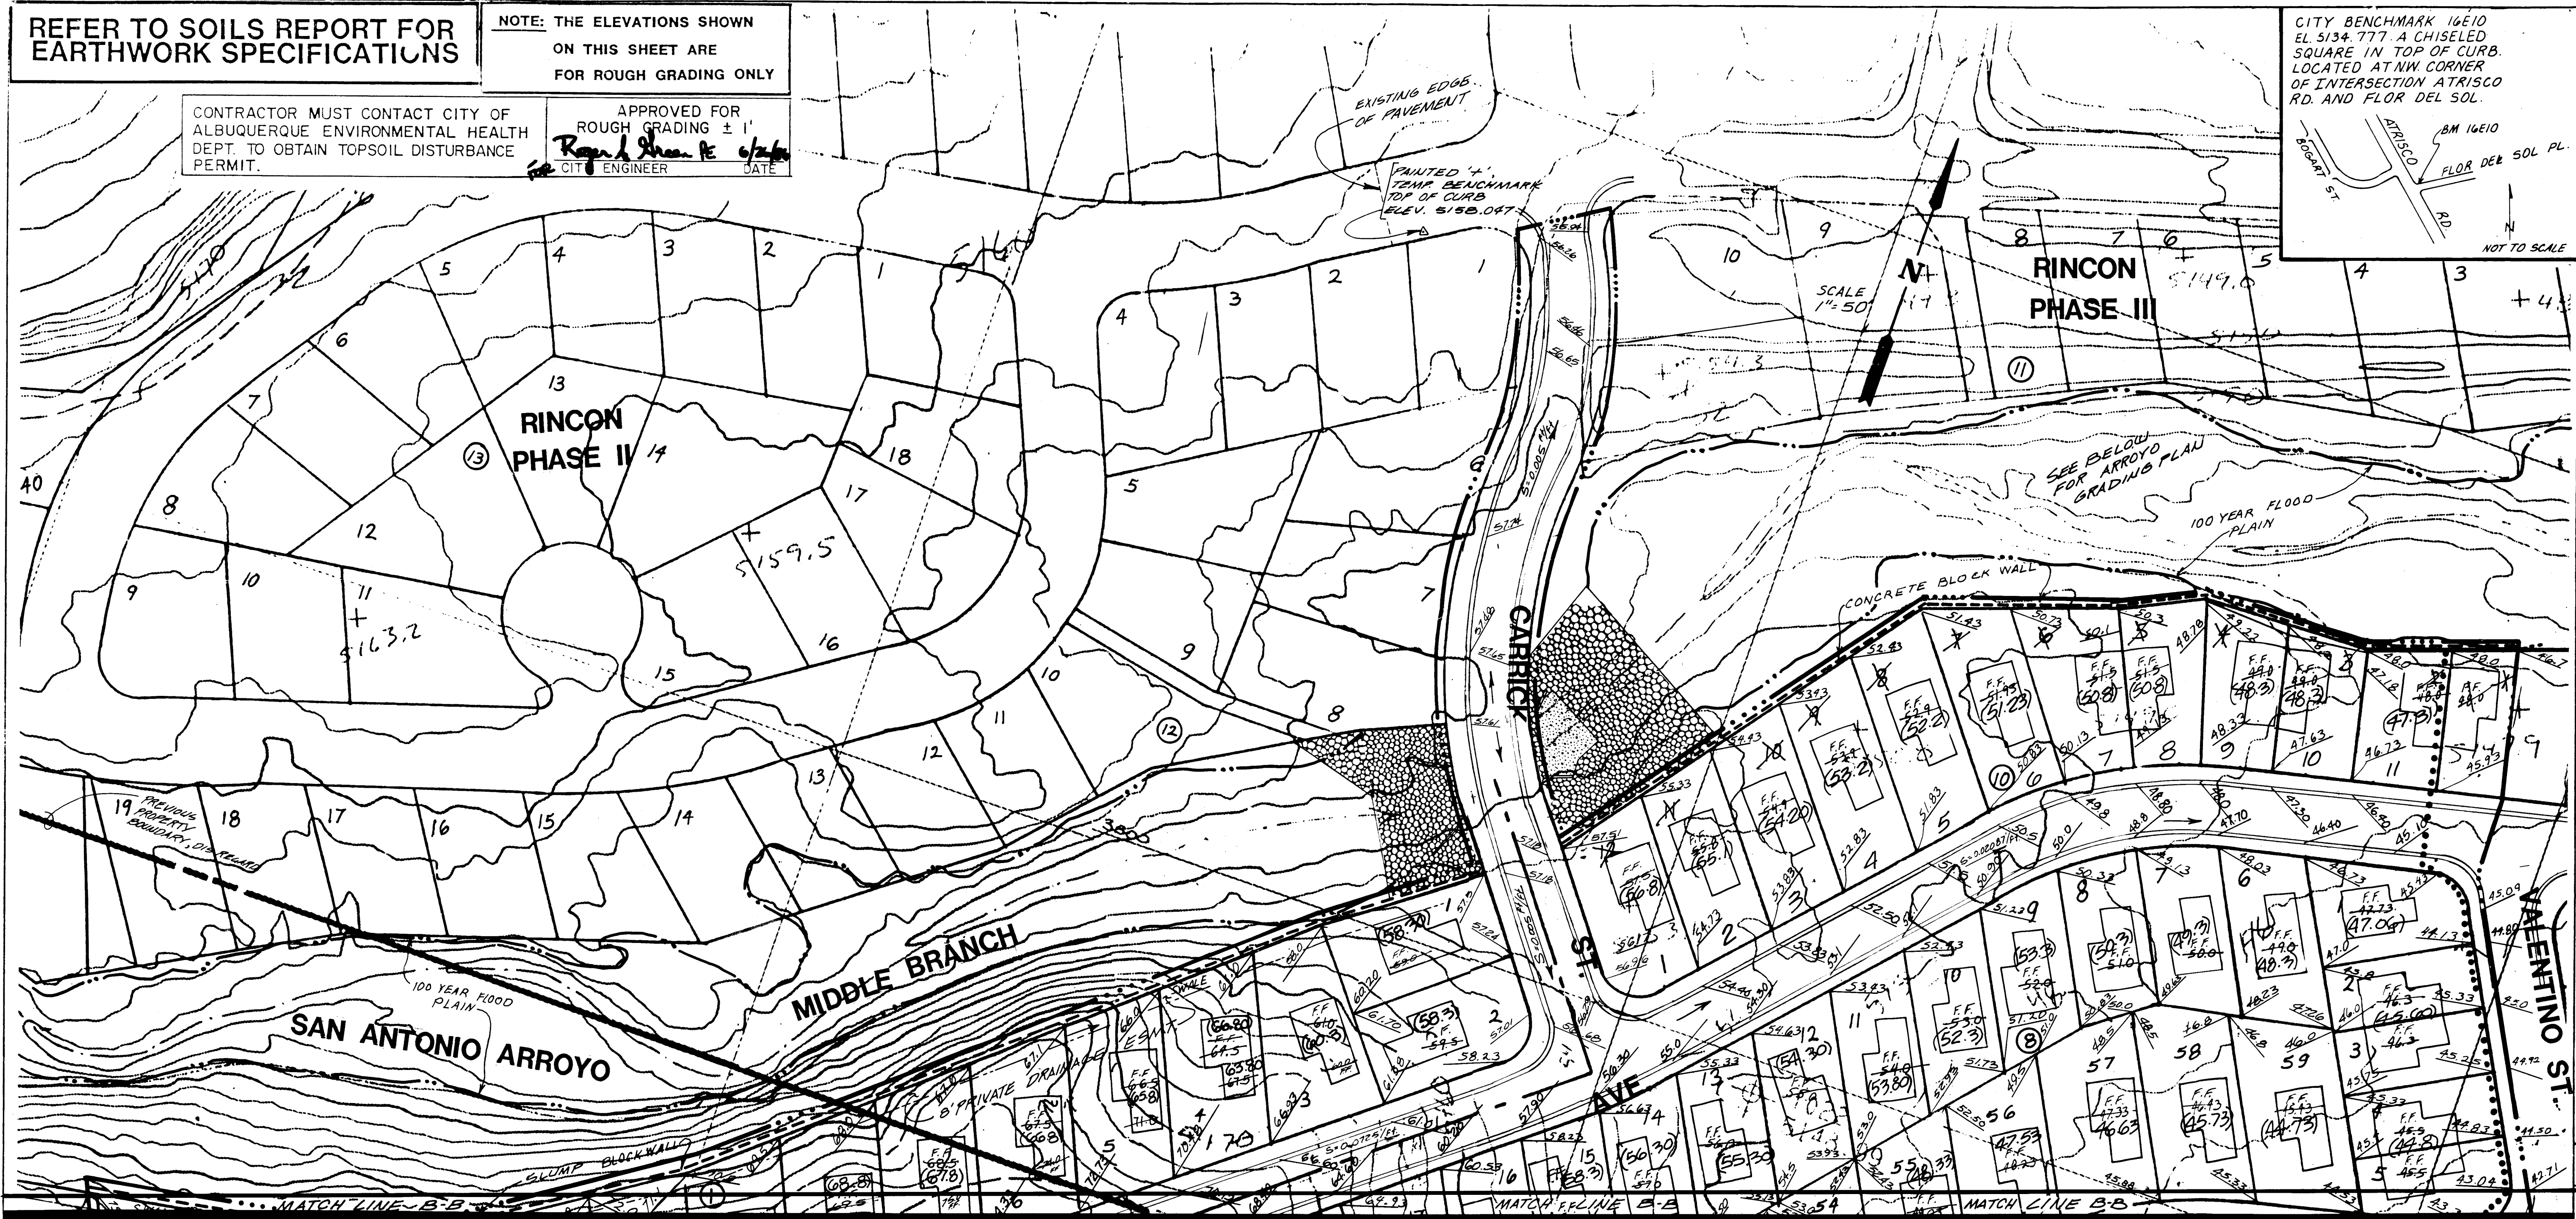[illegible]

NOTE: FOR TYPICAL STREET
PAVING SECTIONS, REFER
TO DETAILS- SHEET NO. 32

PAVING NOTES

1. ALL STATIONING IS BASED ON CENTERLINE OF STREET.
2. THE FOLLOWING CITY OF ALBUQUERQUE STANDARD DETAIL DRAWINGS ARE APPLICABLE:
- | | |
|--------------------|-----------------|
| P- 8 | T- 9 (Case 111) |
| P- 9 | K-16 |
| P-11 | K-20 |
| P-13 (offset type) | K-21 |
| P-17 | |
| P-18 | |

AS BUILT INFORMATION	
CONTRACTOR	
WORK STARTED BY	
DATE	
FIELD ACCEPTANCE BY	
DATE	
REVISIONS	
NO.	DATE
DESIGNED BY	
DATE	
DRAWN BY	
DATE	
CHECKED BY	
DATE	

BENCH MARKS	
CONTROL: BENCH MARK	A.C.S. "16-EIO"
DATE	
BY	
NO.	
REVISIONS	
NO.	DATE
DESIGNED BY	
DATE	
DRAWN BY	
DATE	
CHECKED BY	
DATE	

SURVEY INFORMATION	
FIELD NOTES	
NO.	
DATE	
BY	
REVISIONS	
NO.	DATE
DESIGNED BY	
DATE	
DRAWN BY	
DATE	
CHECKED BY	
DATE	

ENGINEER'S SEAL	
NO.	
DATE	
BY	
REVISIONS	
NO.	DATE
DESIGNED BY	
DATE	
DRAWN BY	
DATE	
CHECKED BY	
DATE	

REMARKS	
NO.	DATE
DESIGNED BY	
DATE	
DRAWN BY	
DATE	
CHECKED BY	
DATE	


CITY OF ALBUQUERQUE
MUNICIPAL DEVELOPMENT DEPARTMENT
ENGINEERING DIVISION


TITLE: RINCON SUBDIVISION - PHASE I
OVERALL PAVING PLAN

APPROVALS	ENGINEER	DATE	APPROVALS	ENGINEER	DATE
City Engineer		7/29/86	Liquid Waste	N/A W/W	7/29/86
A.C.E.-Design		7/29/86	Traffic	N/A W/W	7/29/86
A.C.E.-Hydrology		7/29/86	Water	N/A W/W	7/29/86


DRAWING NO.	2879	MAP NO.	E-10 F-10	SHEET	8 OF 36
-------------	------	---------	-----------	-------	---------

LEGEND	
	TEMPORARY TURN AROUND
	TRAFFIC BARRICADE
	LIMIT OF CONSTRUCTION
	SANITARY SEWER MANHOLE
	WATER LINE GATE VALVE
	STORM RUNOFF FLOW DIRECTION
	WHEEL CHAIR RAMPS
	CROWN TRANSITION SECTION
	CONCRETE VALLEY CUTTER
	4' CONCRETE SIDEWALK
	STANDARD CURB & GUTTER
	MOUNTABLE CURB & GUTTER
	TYPICAL RESIDENTIAL PAVING

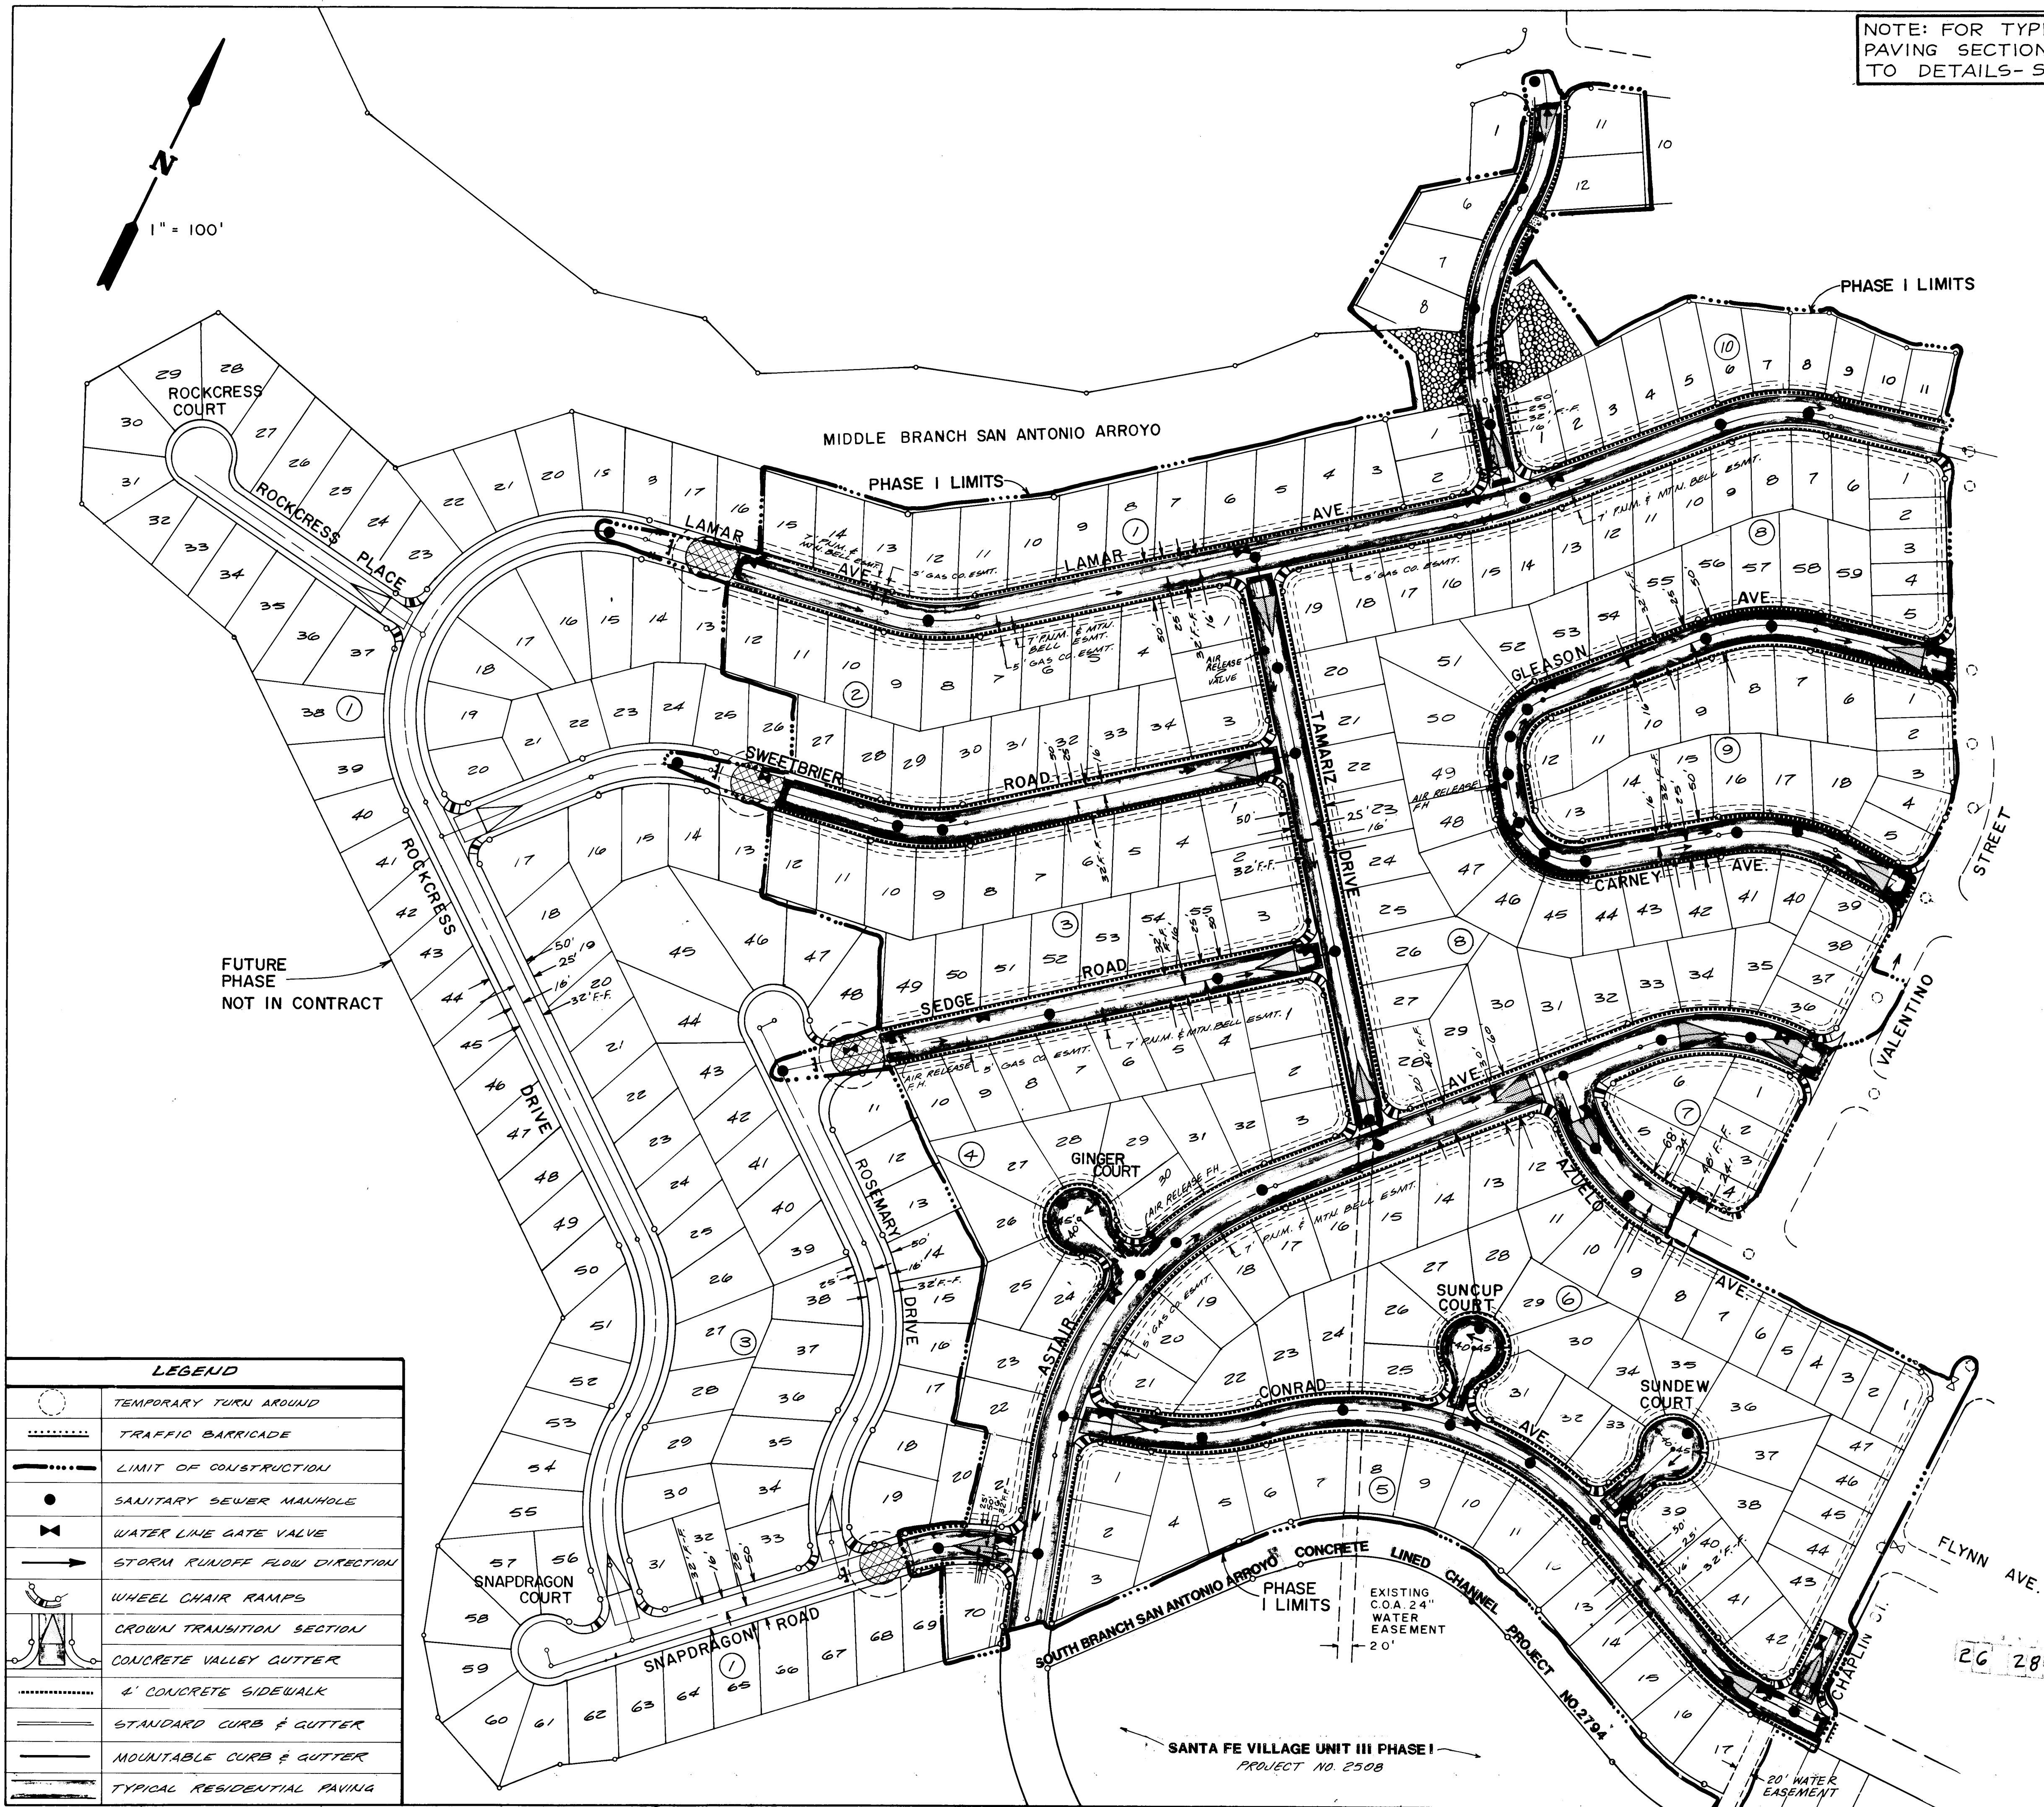

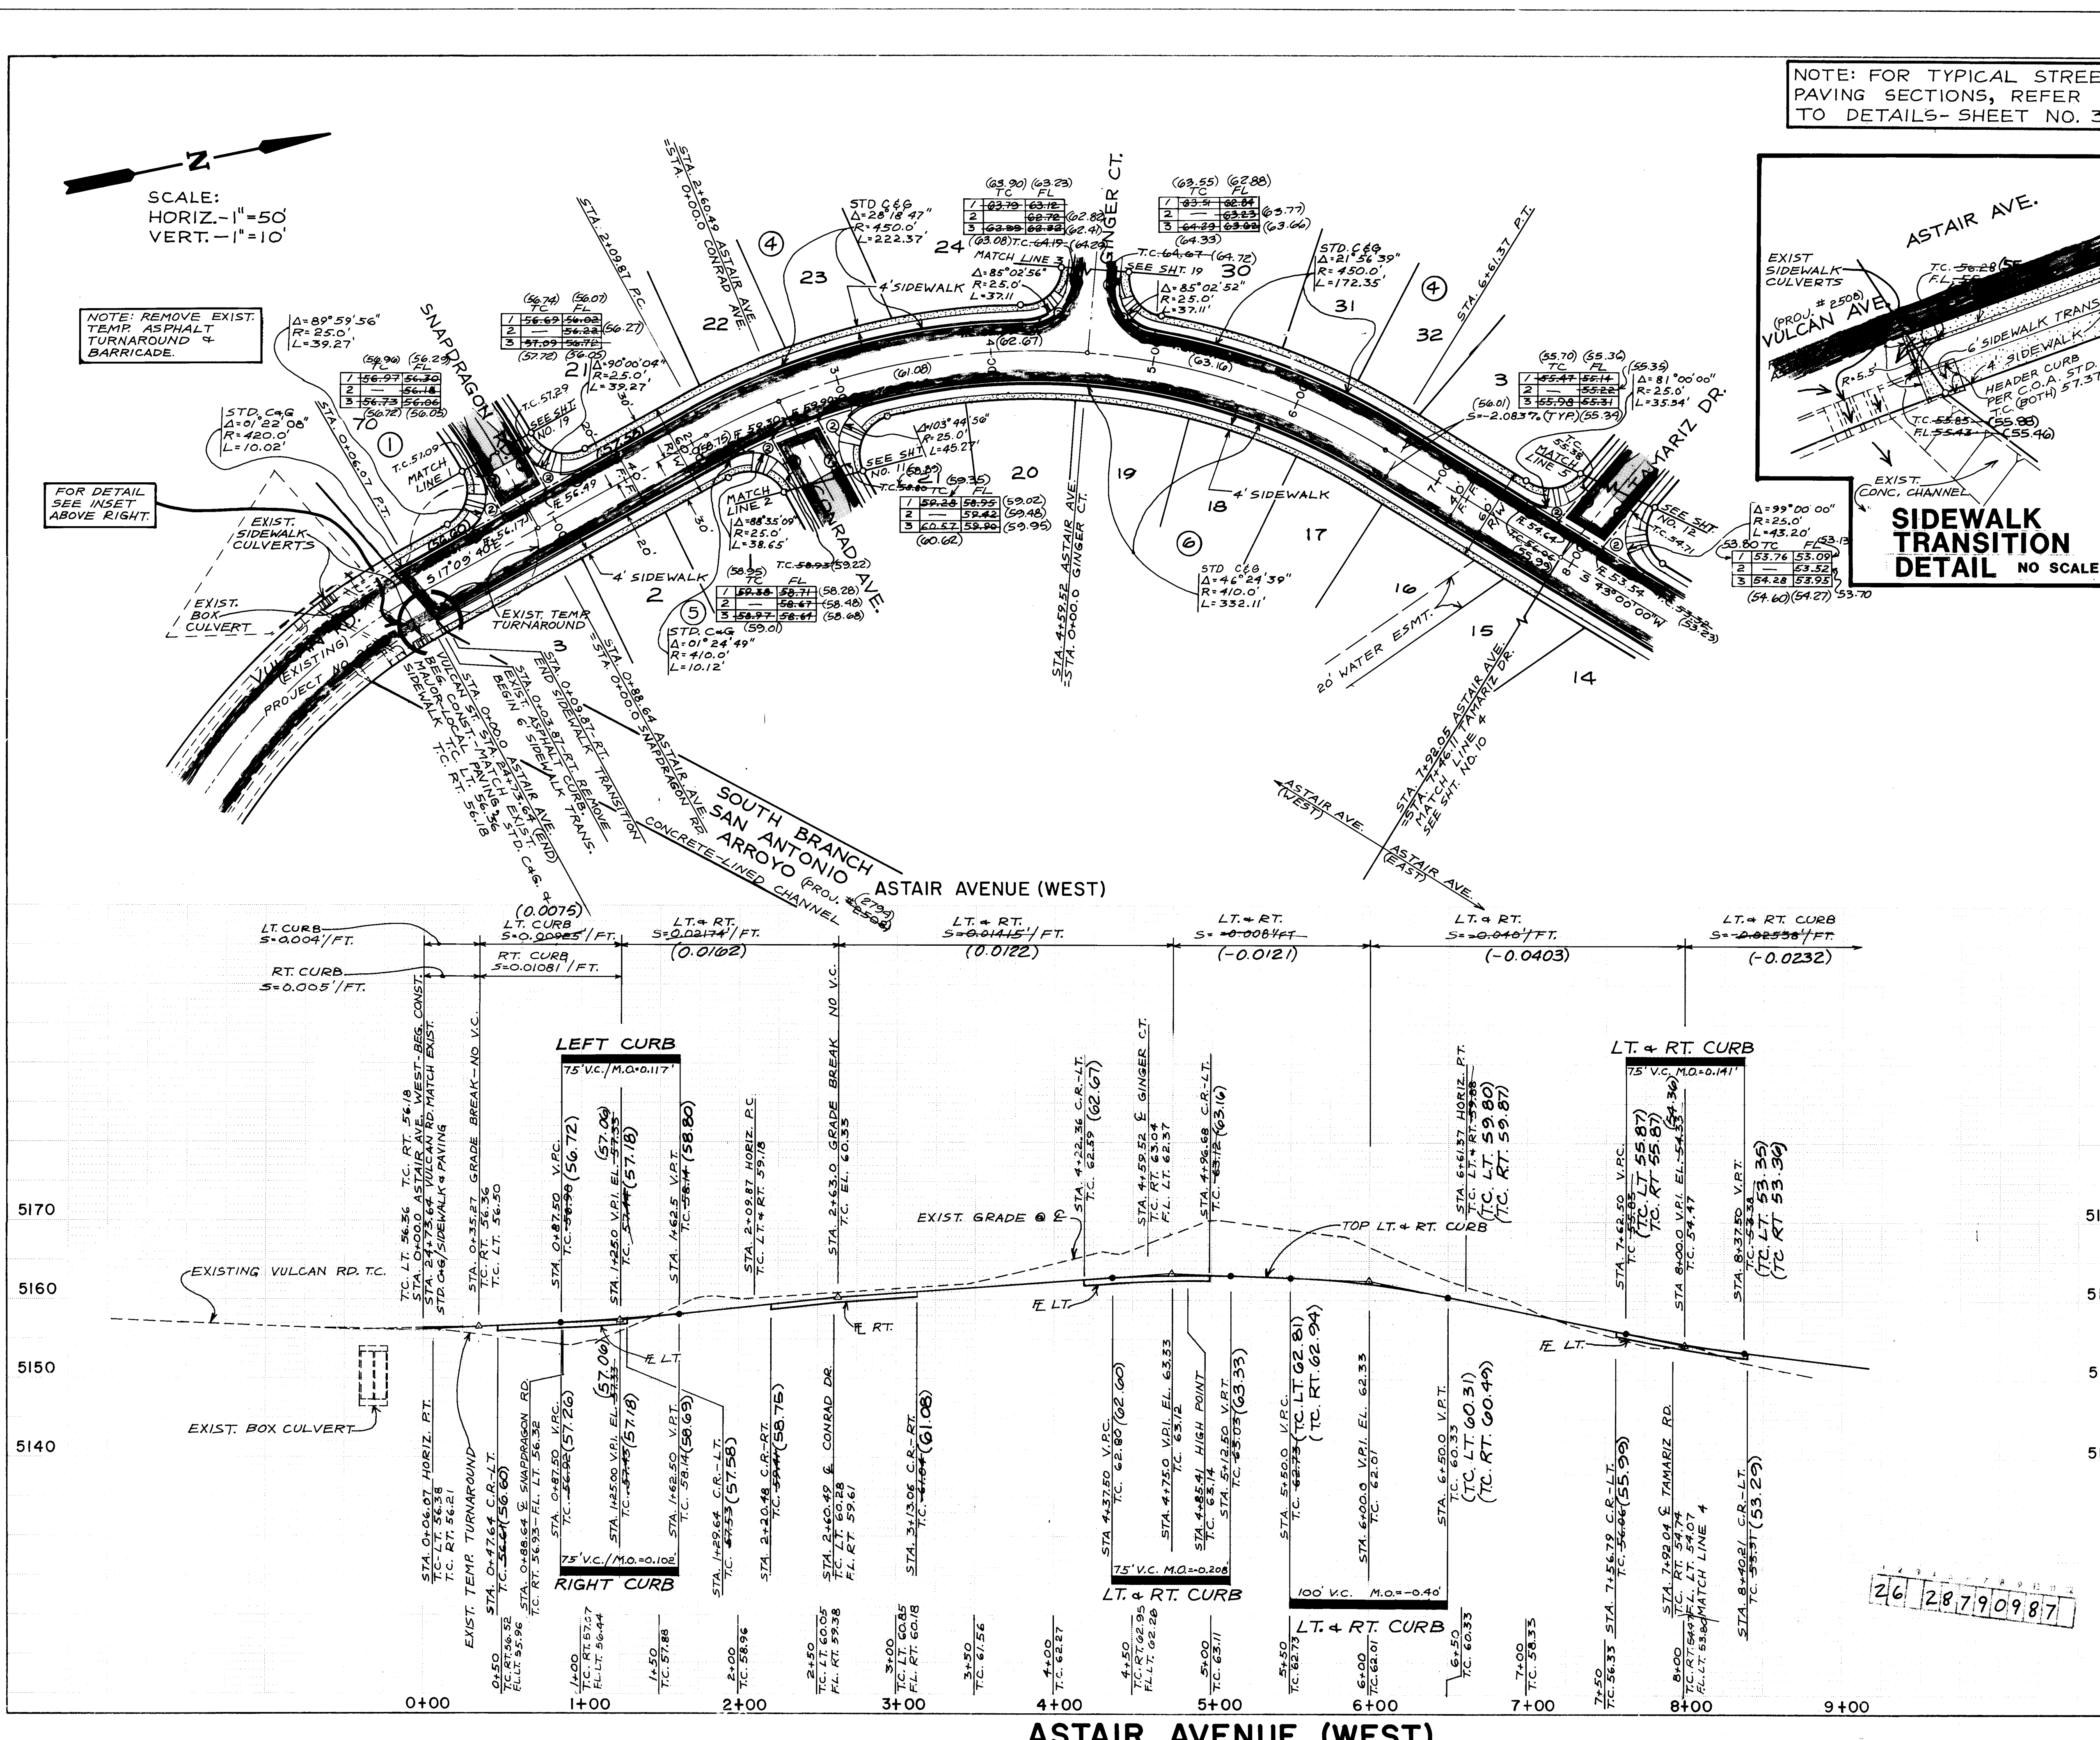

NOTE: FOR TYPICAL STREET PAVING SECTIONS, REFER TO DETAILS- SHEET NO. 32

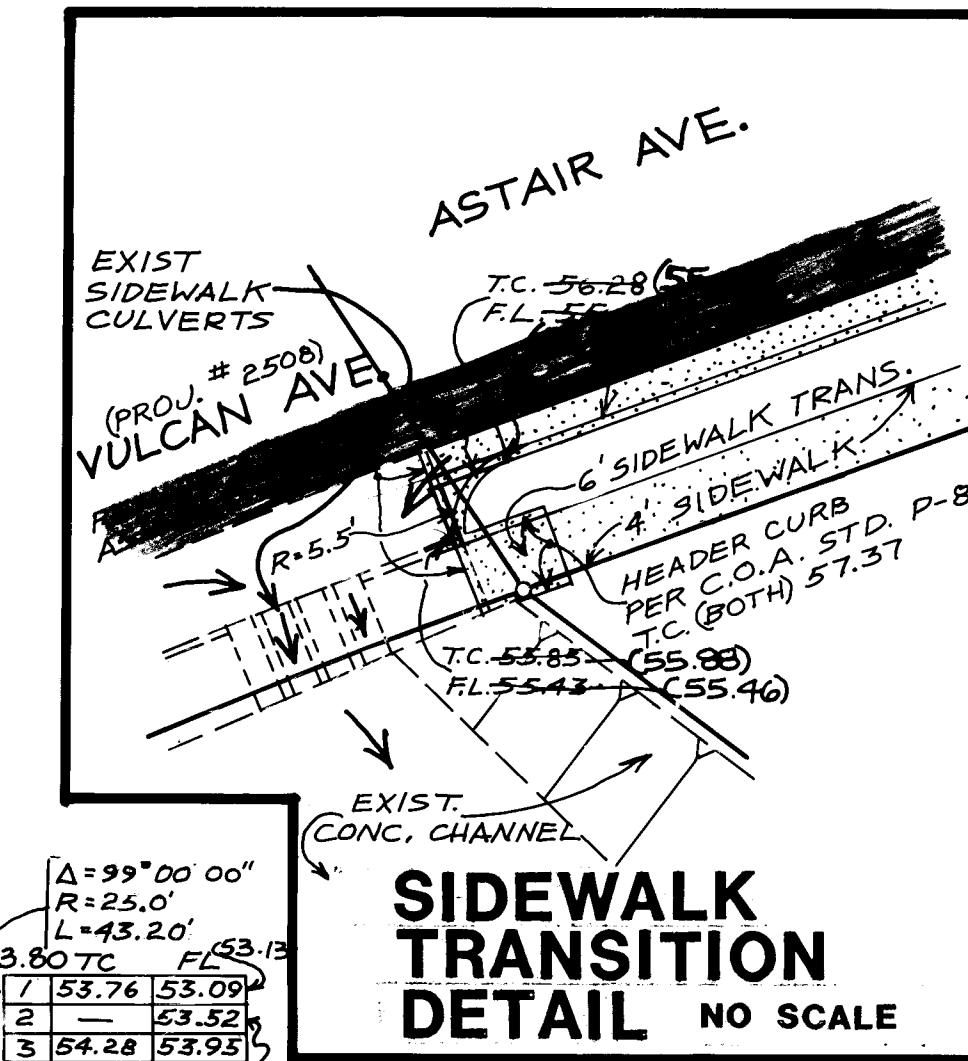

PAVING NOTES

- ALL STATIONING IS BASED ON CENTERLINE OF STREET.
- THE FOLLOWING CITY OF ALBUQUERQUE STANDARD DETAIL DRAWINGS ARE APPLICABLE:

P-8	T-9 (Case 111)
P-9	K-16
P-11	K-20
P-13 (offset type)	K-21
P-17	
P-18	

LEGEND

SANITARY SEWER LINE	—SAS—
SANITARY SEWER MANHOLE	—S—
SAS SERVICE CONNECTION	—SSC—
WATER LINE	—W—
GATE VALVE	—GV—
FIRE HYDRANT	—FH—
REDUCER	—R—
TEE	—T—
BENDS	—B—
WATER SERVICE CONNECTION	—WSC—
CAPS & PLUGS	—CP—
CROSS	—C—
SIDWALK	—S—
STANDARD CURB & GUTTER	—SCG—
MOUNTABLE CURB & GUTTER	—MCG—
RESIDENTIAL PAVING	—RP—
VALLEY GUTTER (CONC.)	—VVG—
CROWN TRANSITION AREA	—CTA—
WHEELCHAIR RAMP (CASE II)	—WCR—
BARRICADE (TYPE III)	—B—

ENGINEER'S SEAL

[Signature]

REVISIONS

NO.	DATE	REMARKS
1	6/86	DESIGNED BY R.G.
2	6/86	DRAWN BY C.C.M.
3	6/86	CHECKED BY E.D.

CITY OF ALBUQUERQUE
MUNICIPAL DEVELOPMENT DEPARTMENT
ENGINEERING DIVISION

TITLE: RINCON SUBDIVISION—PHASE I
ASTAIR AVENUE (WEST)
PAVING PLAN & PROFILE

APPROVALS	ENGINEER	DATE	APPROVALS	ENGINEER	DATE
City Engineer	[Signature]	6/86	Liquid Waste	U.A. W.W.	7/21/86
A.C.E. Design	[Signature]	6/86	Traffic	[Signature]	7/21/86
A.C.E. Hydrology	[Signature]	6/86	Water	N.A. W.W.	7/21/86

DRAWING NO. **2879** MAP NO. **E-10 & F-10** SHEET **9** OF **36**

NOTE: FOR TYPICAL STREET PAVING SECTIONS, REFER TO DETAILS- SHEET NO. 32

SCALE: HORIZ.-1"=50' VERT.-1"=10'

NOTE: FOR TYPICAL STREET PAVING SECTIONS, REFER TO DETAILS- SHEET NO. 32

SCALE: HORIZ.-1"=50' VERT.-1"=10'

PAVING NOTES

- ALL STATIONING IS BASED ON CENTERLINE OF STREET.
- THE FOLLOWING CITY OF ALBUQUERQUE STANDARD DRAWINGS ARE APPLICABLE:

P-8	T-9 (Case III)
P-9	K-16
P-11	K-20
P-13 (offset type)	K-21
P-17	
P-18	

AS BUILT INFORMATION	
CONTRACTOR	NO.
DATE	DATE
INSPECTOR	DATE
ACCURACY BY	DATE
FIELD CALCULATION BY	DATE
DRAWINGS BY	DATE
CONDUCTED BY	DATE
MICRO-FILM INFORMATION	DATE
RECORDED BY	NO.

SURVEY INFORMATION	
CONTROL: BENCH MARK A.C.S. "16-E10"	DATE
A CHISLED ON TOP OF CONCRETE CURB AT THE N.E. CURB RETURN AT THE INTERSECTION OF ATRISCO ROAD N.W. AND FLOR DEL SOL PLACE N.W.	DATE
FIELD NOTES	DATE
NO.	BY



ENGINEER'S SEAL	
BY	DATE
REVISIONS	DATE
DESIGN	DATE
DESIGNED BY R.G.	DATE 6/86
DRAWN BY C.C.M.	DATE 6/86
CHECKED BY E.D.	DATE 6/86

CITY OF ALBUQUERQUE
MUNICIPAL DEVELOPMENT DEPARTMENT
ENGINEERING DIVISION

TITLE: RINCON SUBDIVISION-PHASE I
ASTAIR AVENUE(EAST) & AZUELO AVENUE
PAVING PLAN & PROFILE

APPROVALS	ENGINEER	DATE	APPROVALS	ENGINEER	DATE
City Engineer	8/1/86	8/1/86	Liquid Waste	N.A. W.W.	7/29/86
A.C.E.-Design	8/1/86	8/1/86	Traffic	N.A. W.W.	7/29/86
Hydrology	8/1/86	8/1/86	Water	N.A. W.W.	7/29/86

DRAWING NO. 2879 MAP NO. E-10 & F-10 SHEET 10 OF 36

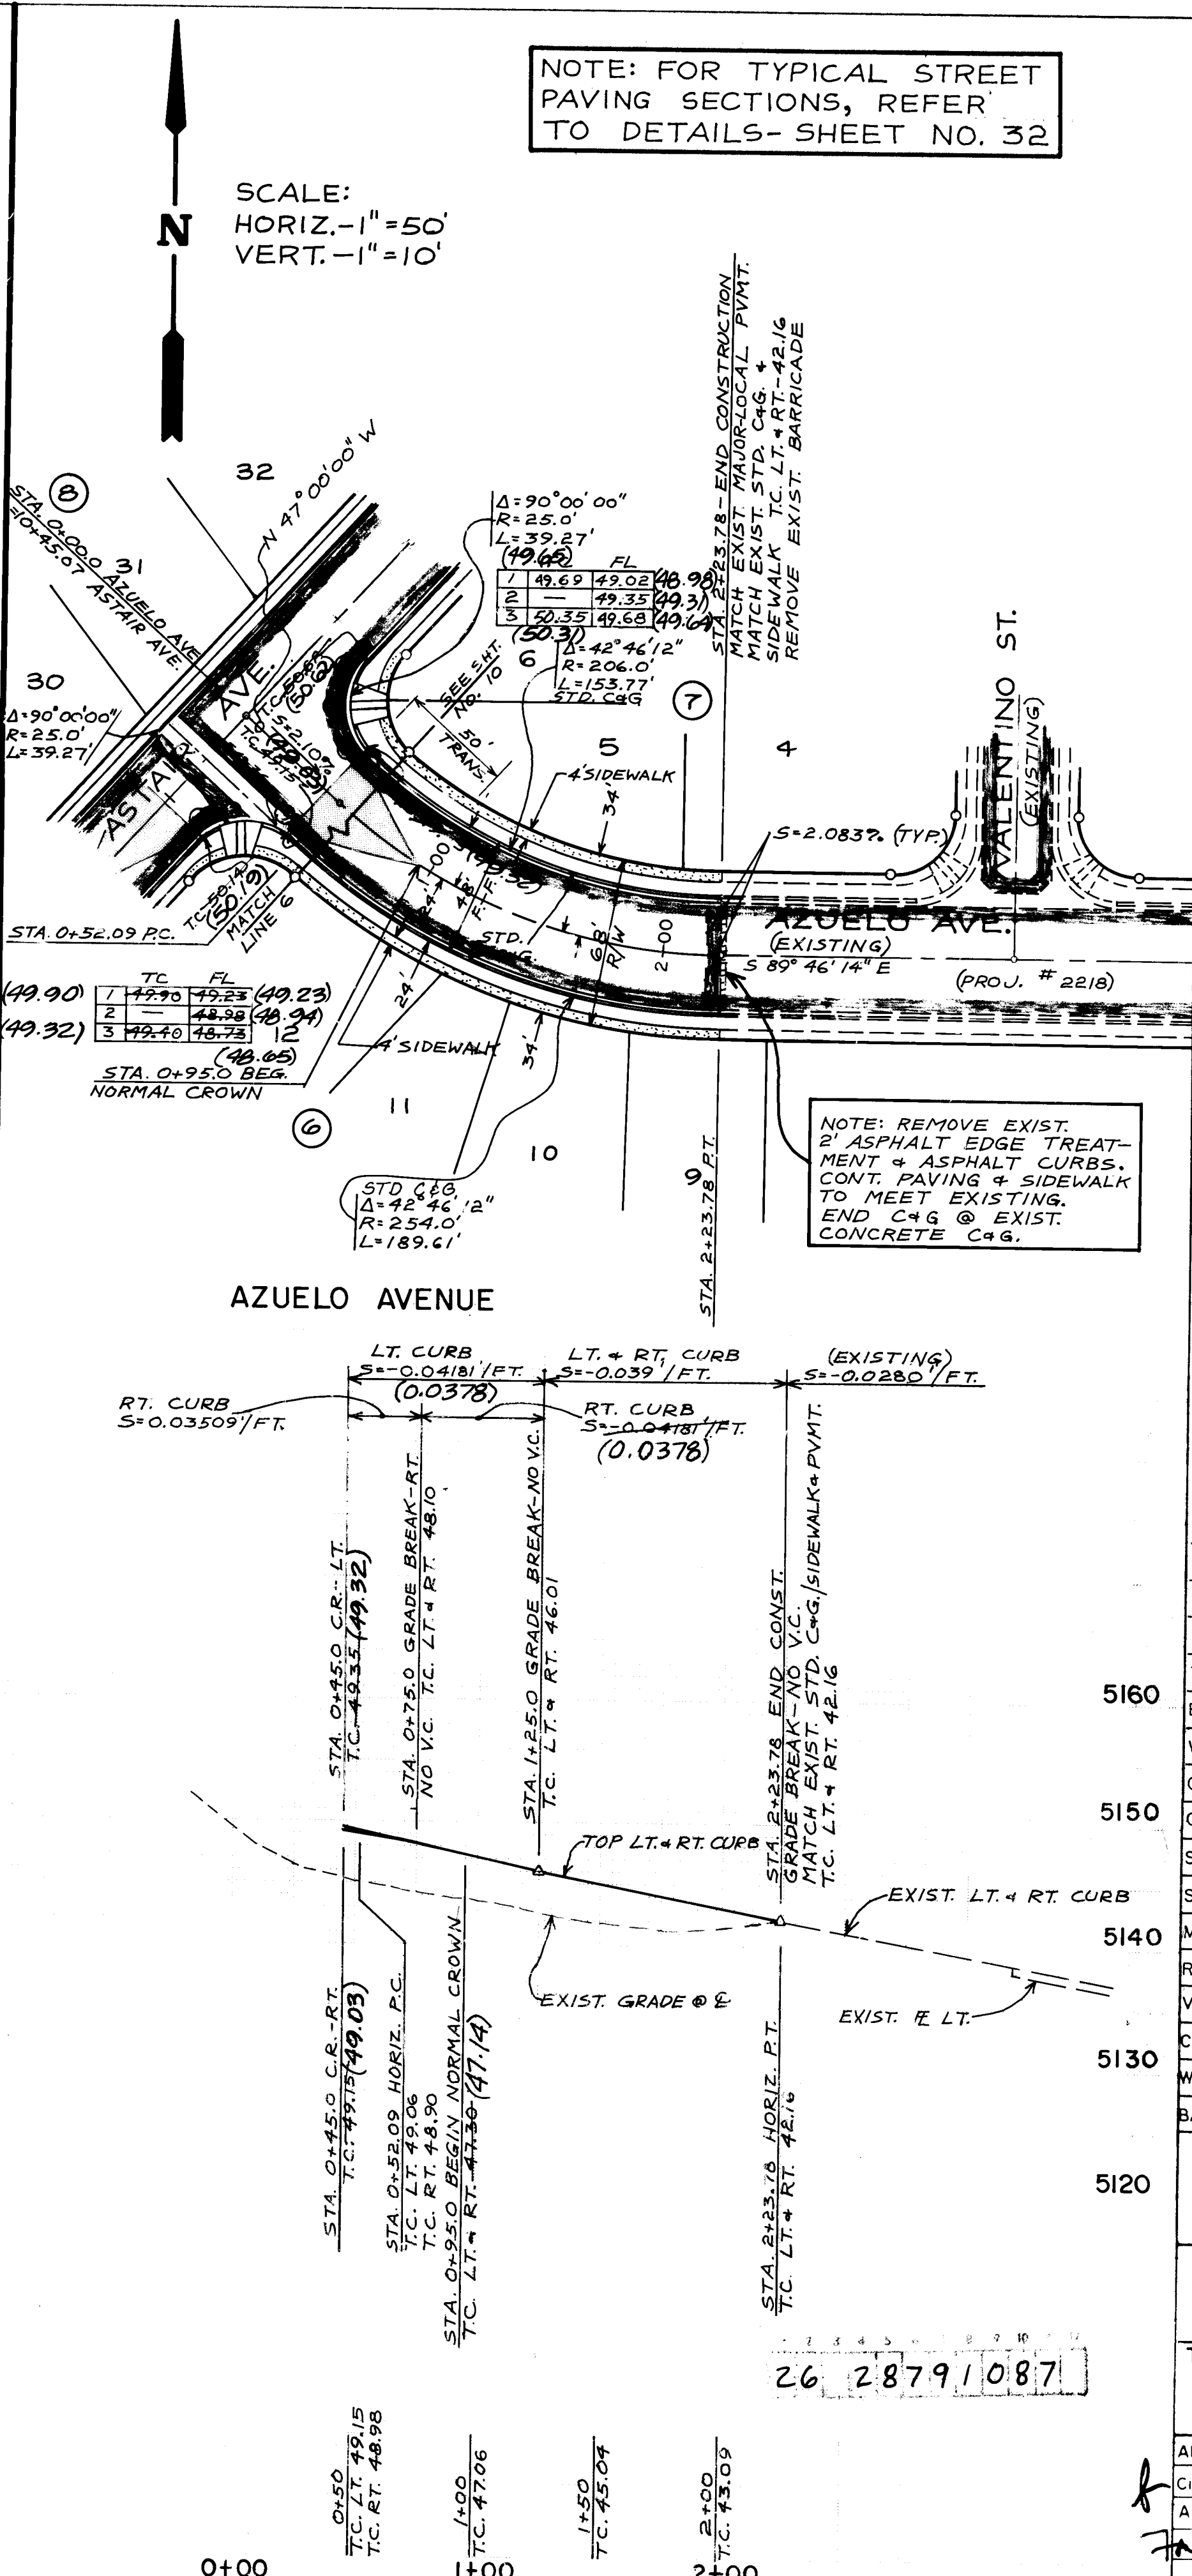
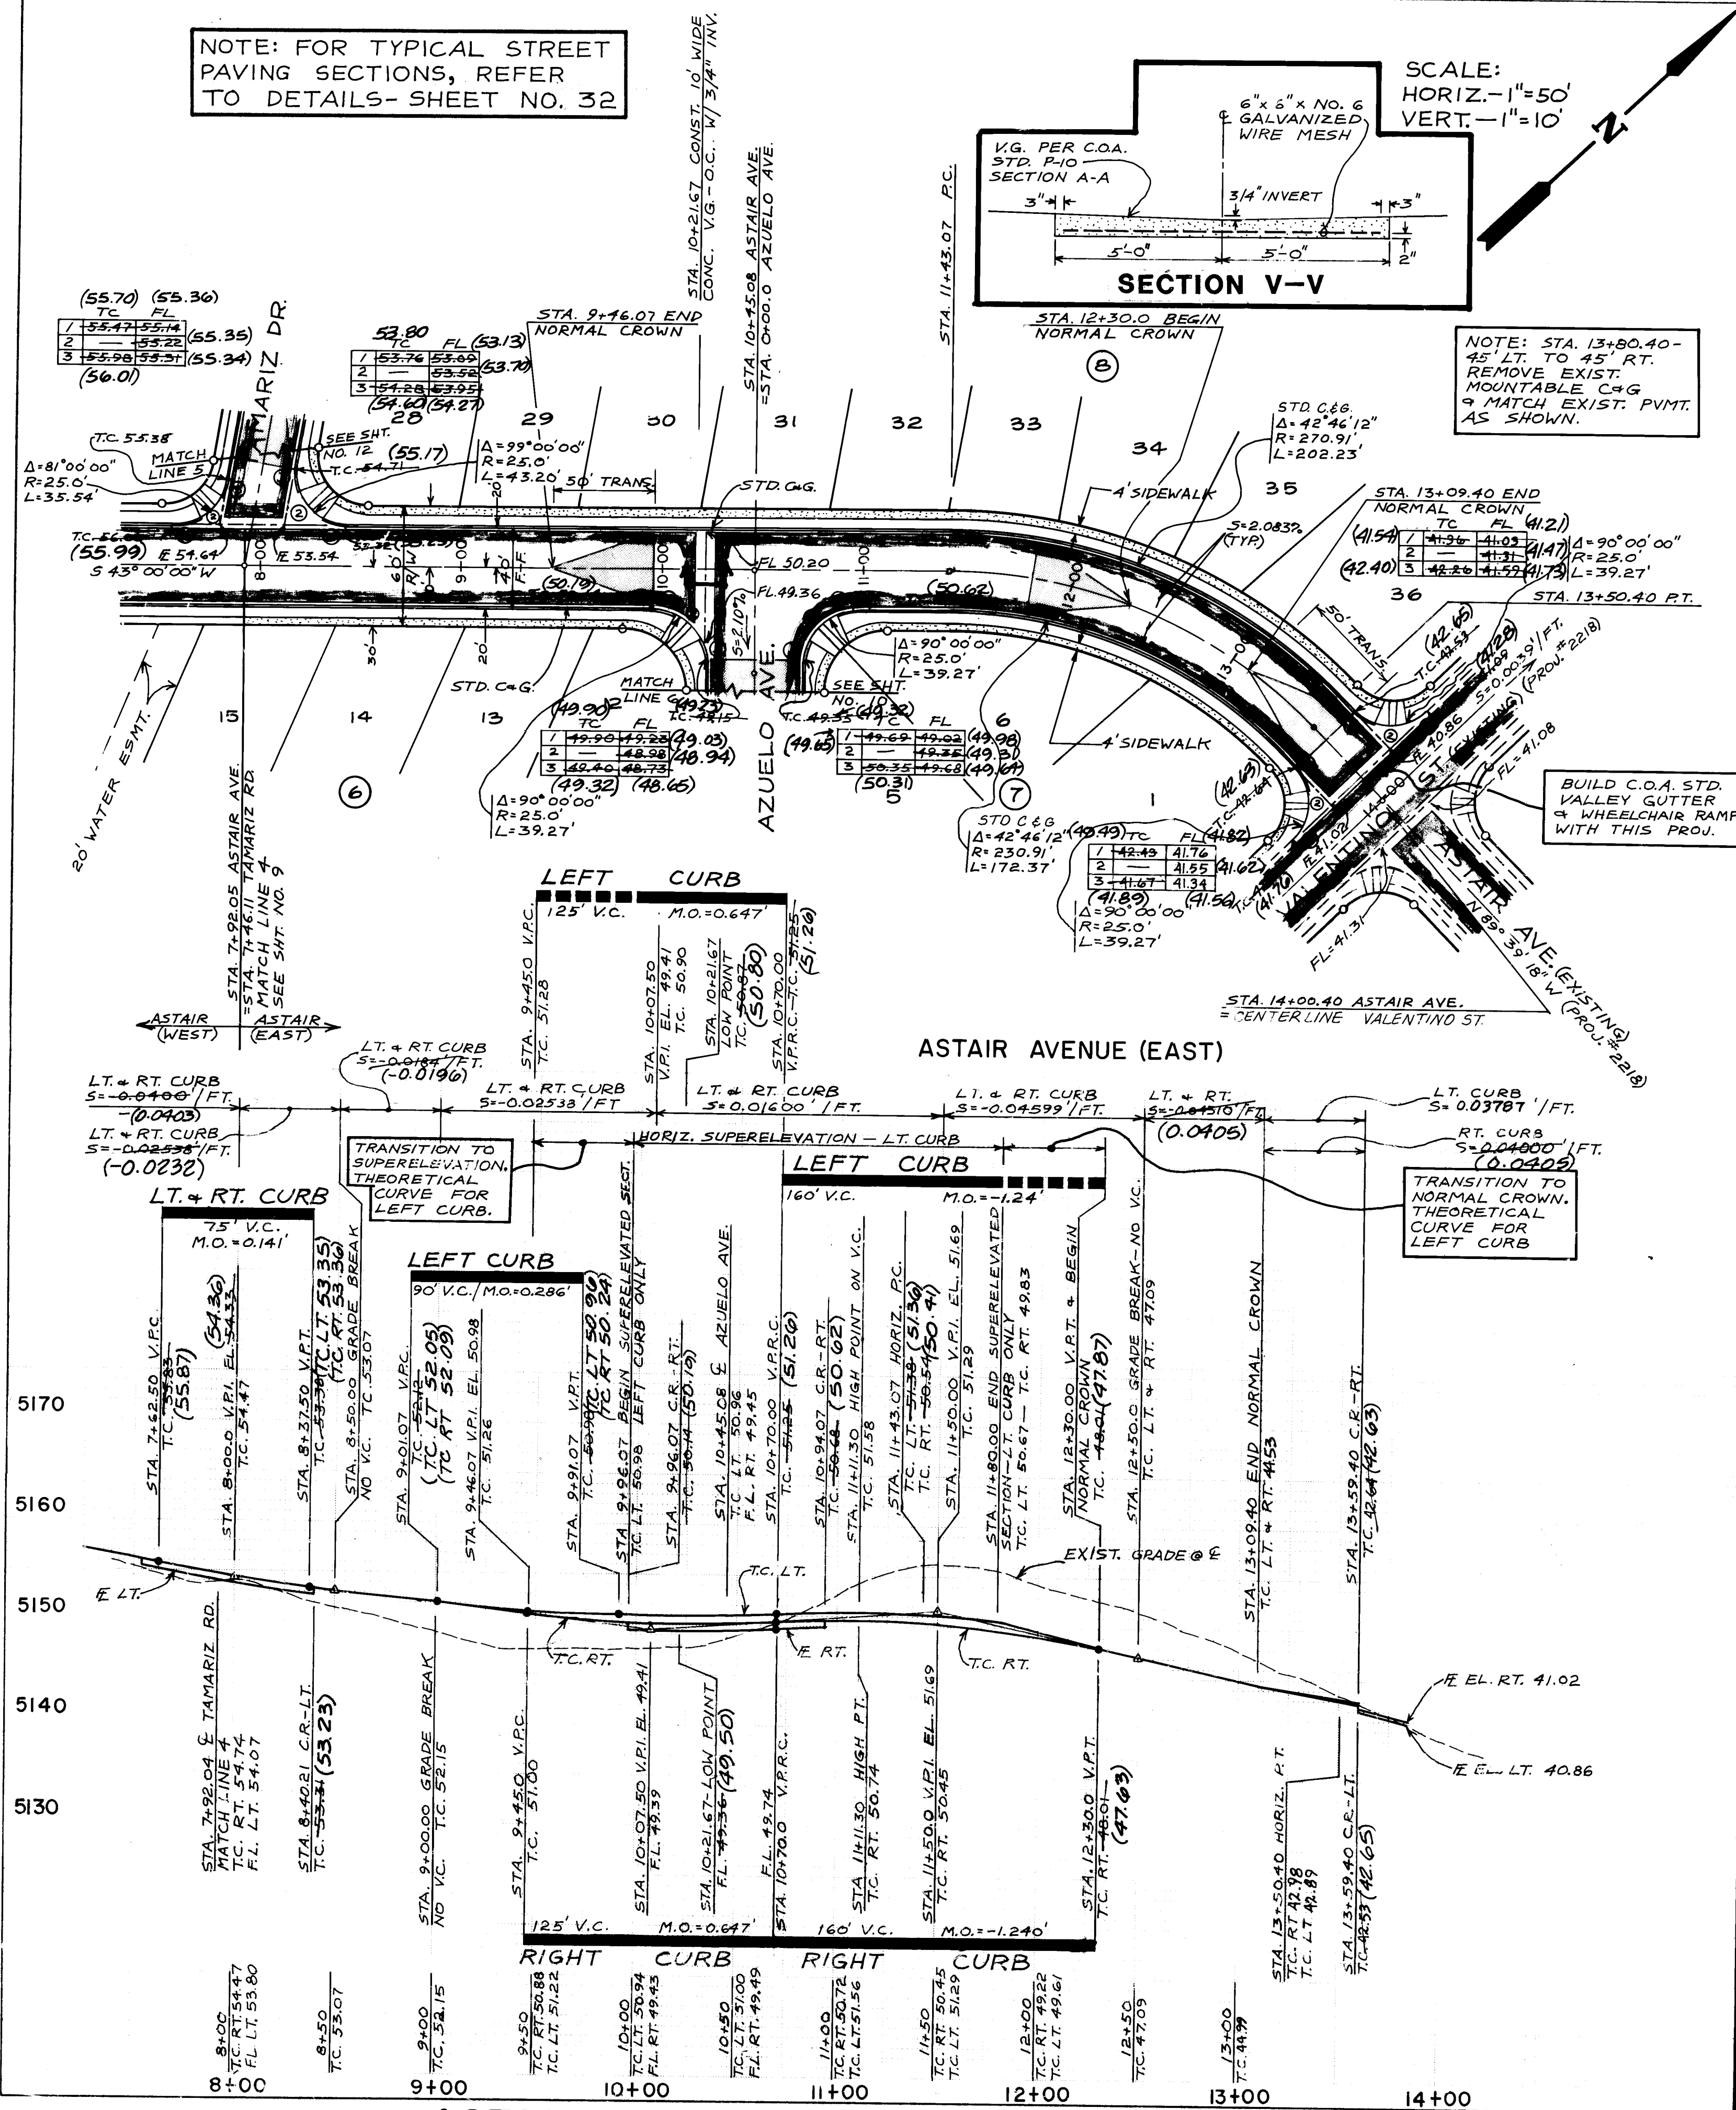


ASTAIR AVENUE (EAST)

AZUELO AVENUE

NOTE: FOR TYPICAL STREET
PAVING SECTIONS, REFER
TO DETAILS- SHEET NO. 32

SCALE:
HORIZ.-1"=50'
VERT.-1"=10'

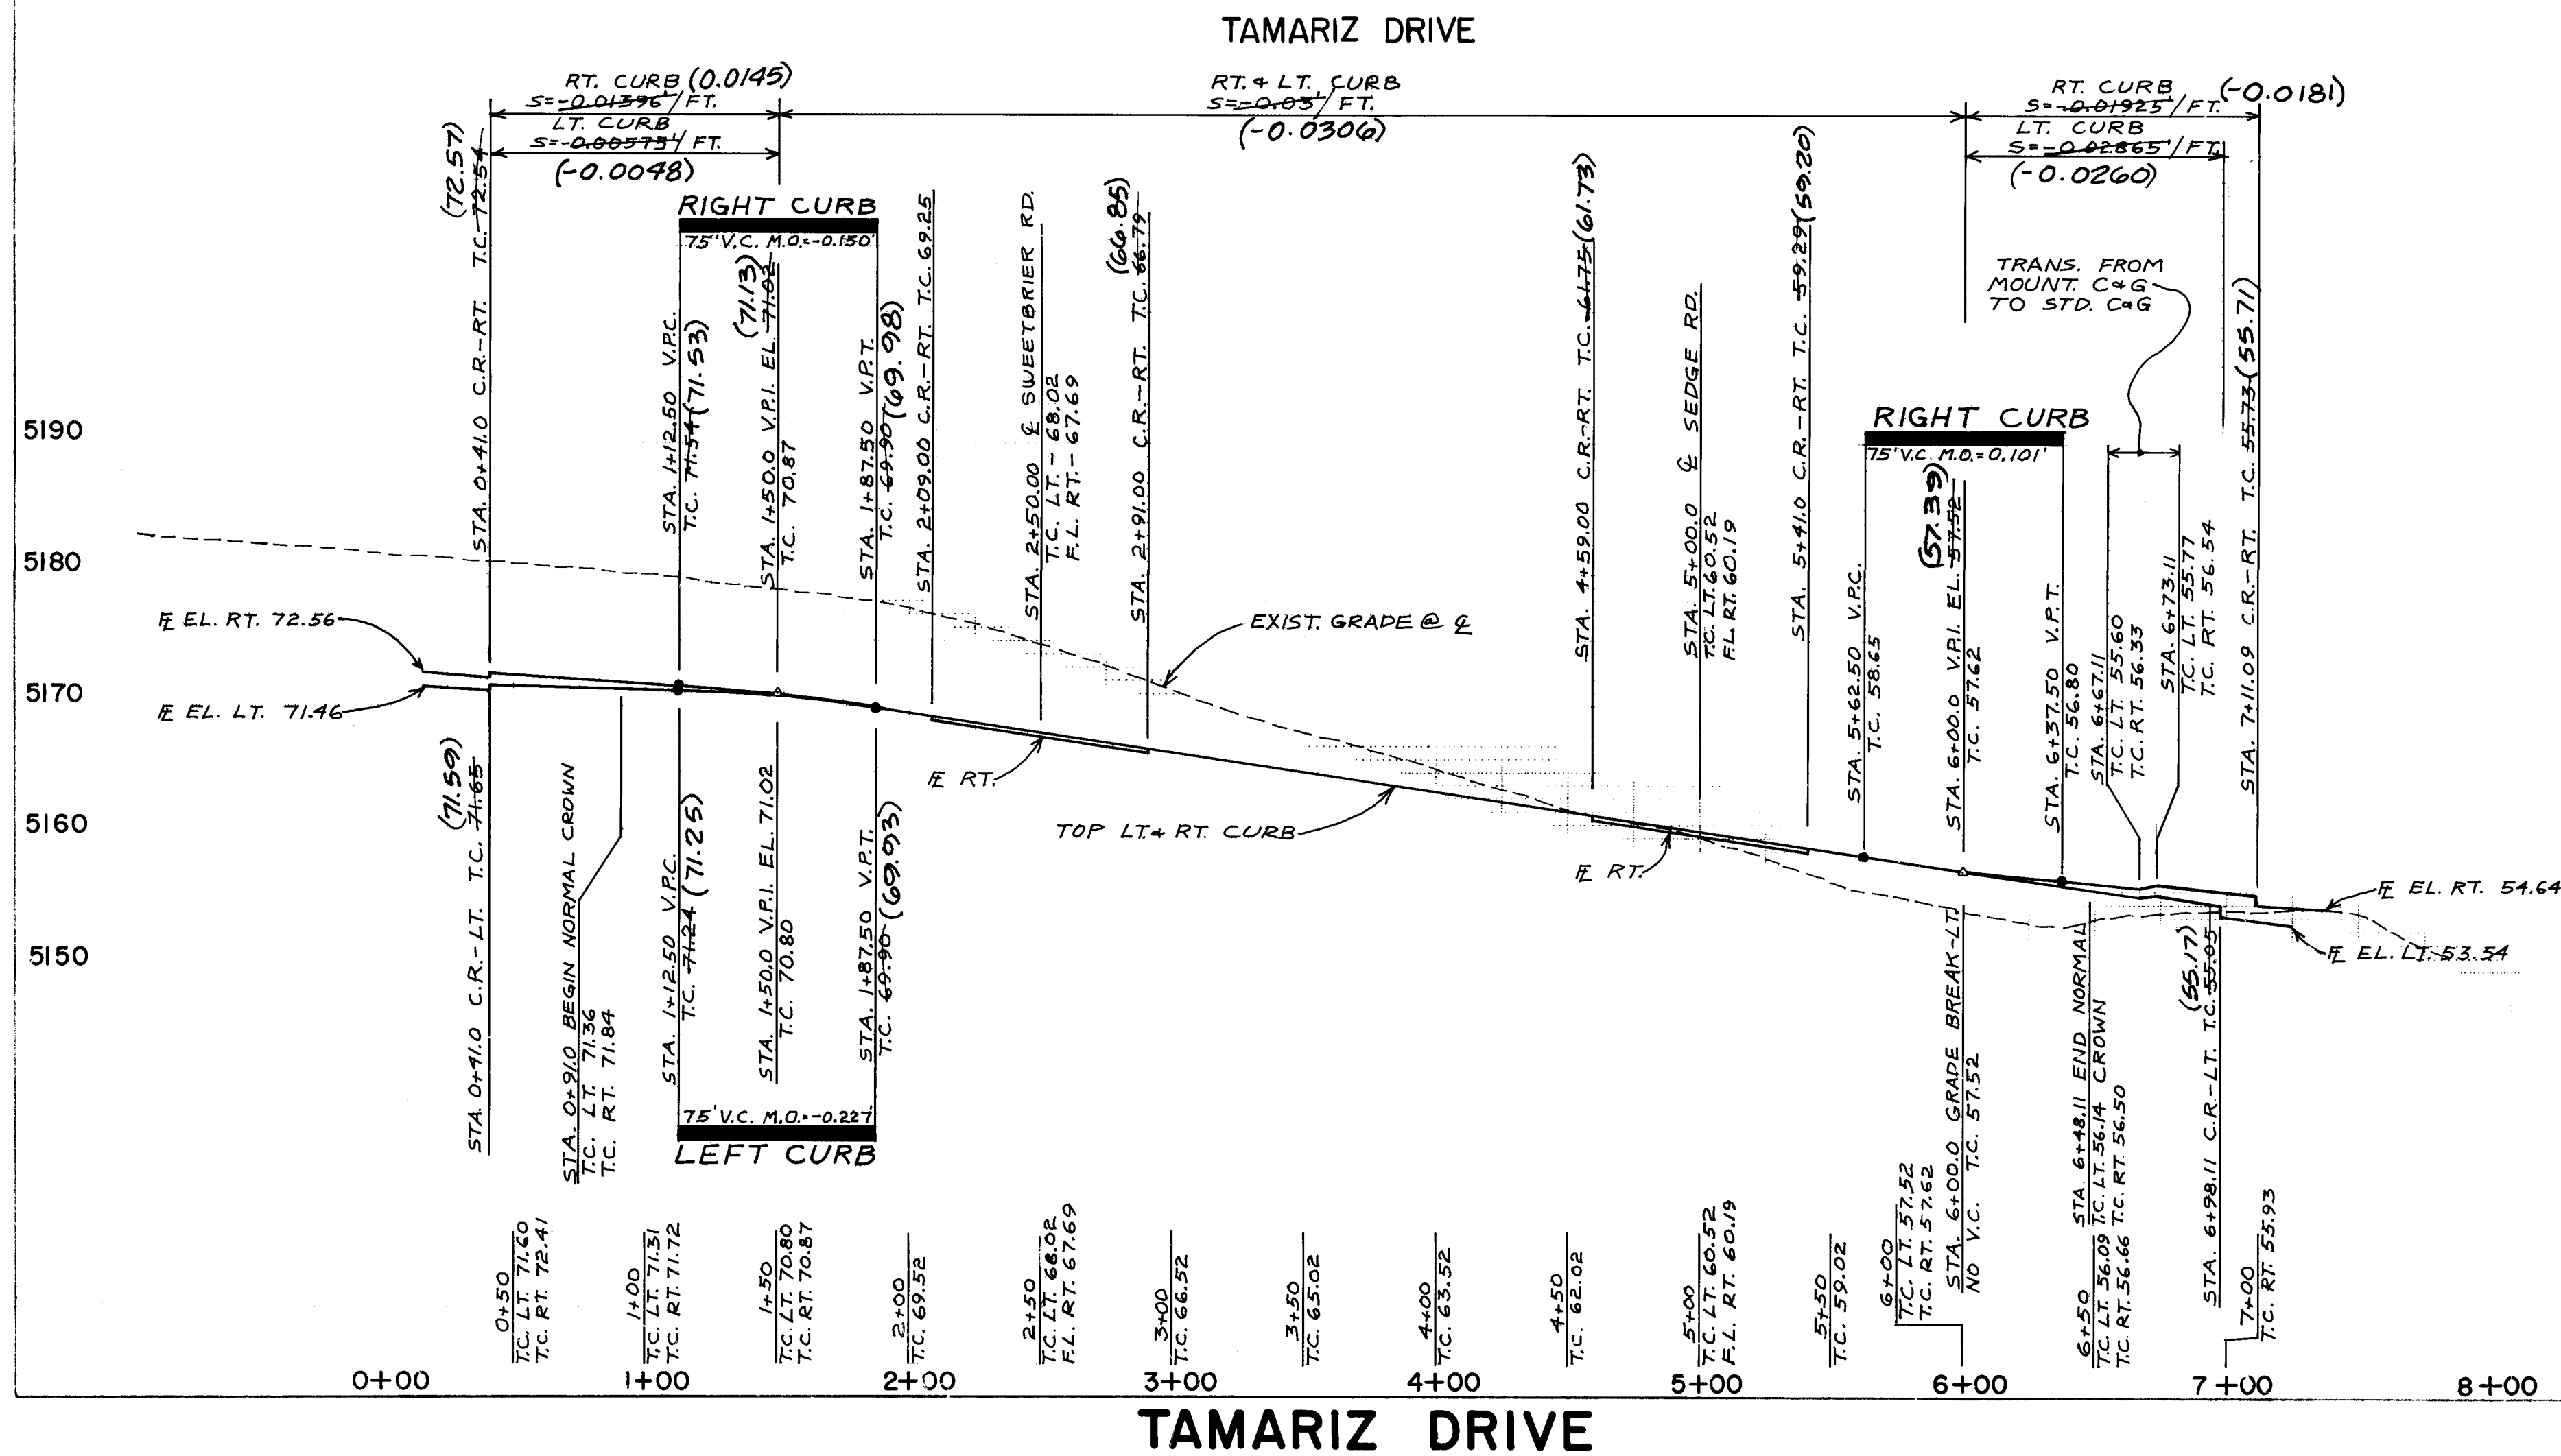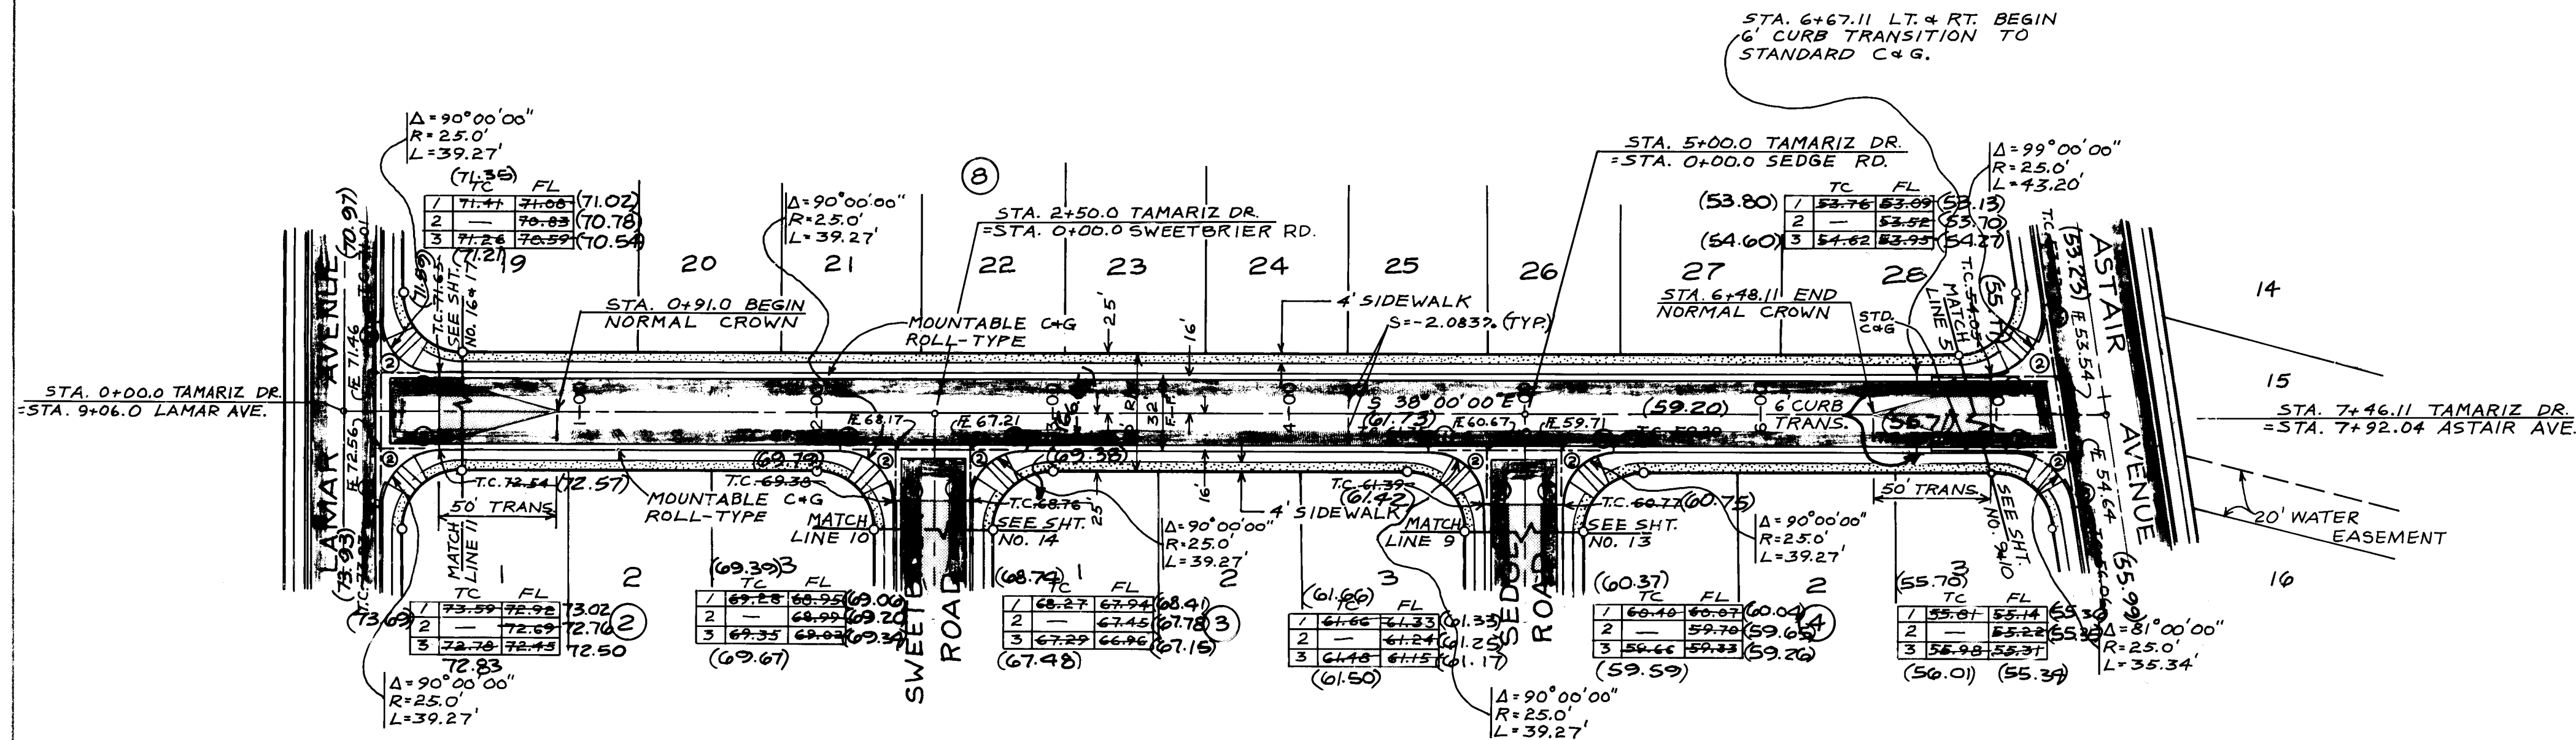

- PAVING NOTES
- ALL STATIONING IS BASED ON CENTERLINE OF STREET.
 - THE FOLLOWING CITY OF ALBUQUERQUE STANDARD DETAIL DRAWINGS ARE APPLICABLE:
- | | |
|-------------------|---------------|
| P-8 | T-9(Case III) |
| P-9 | K-16 |
| P-11 | K-20 |
| P-13(offset type) | K-21 |
| P-17 | |
| P-18 | |

LEGEND

SANITARY SEWER LINE	SAS
SANITARY SEWER MANHOLE	
SAS SERVICE CONNECTION	
WATER LINE	W
GATE VALVE	
FIRE HYDRANT	
REDUCER	
TEE	
BENDS	
WATER SERVICE CONNECTION	
CAPS & PLUGS	
CROSS	
SIDEWALK	
STANDARD CURB & GUTTER	
MOUNTABLE CURB & GUTTER	
RESIDENTIAL PAVING	
VALLEY GUTTER (CONC.)	
CROWN TRANSITION AREA	
WHEELCHAIR RAMP (CASE II)	
BARRICADE (TYPE III)	



26 12 8 7 9 1 2 8 7



CITY OF ALBUQUERQUE
MUNICIPAL DEVELOPMENT DEPARTMENT
ENGINEERING DIVISION

TITLE: RINCON SUBDIVISION-PHASE I
TAMARIZ DRIVE
PAVING PLAN & PROFILE

APPROVALS	ENGINEER	DATE	APPROVALS	ENGINEER	DATE
City Engineer	John R. [Signature]	2/14/86	Liquid Waste	N/A W/L	7/29/86
Atty E-Design	Robert [Signature]	8/5/86	Traffic	David [Signature]	7/31/86
Hydrology	Robert [Signature]		Water	N/A W/L	7/29/86

DRAWING NO. 2879 MAP NO. E-10 & F-10 SHEET 12 OF 36

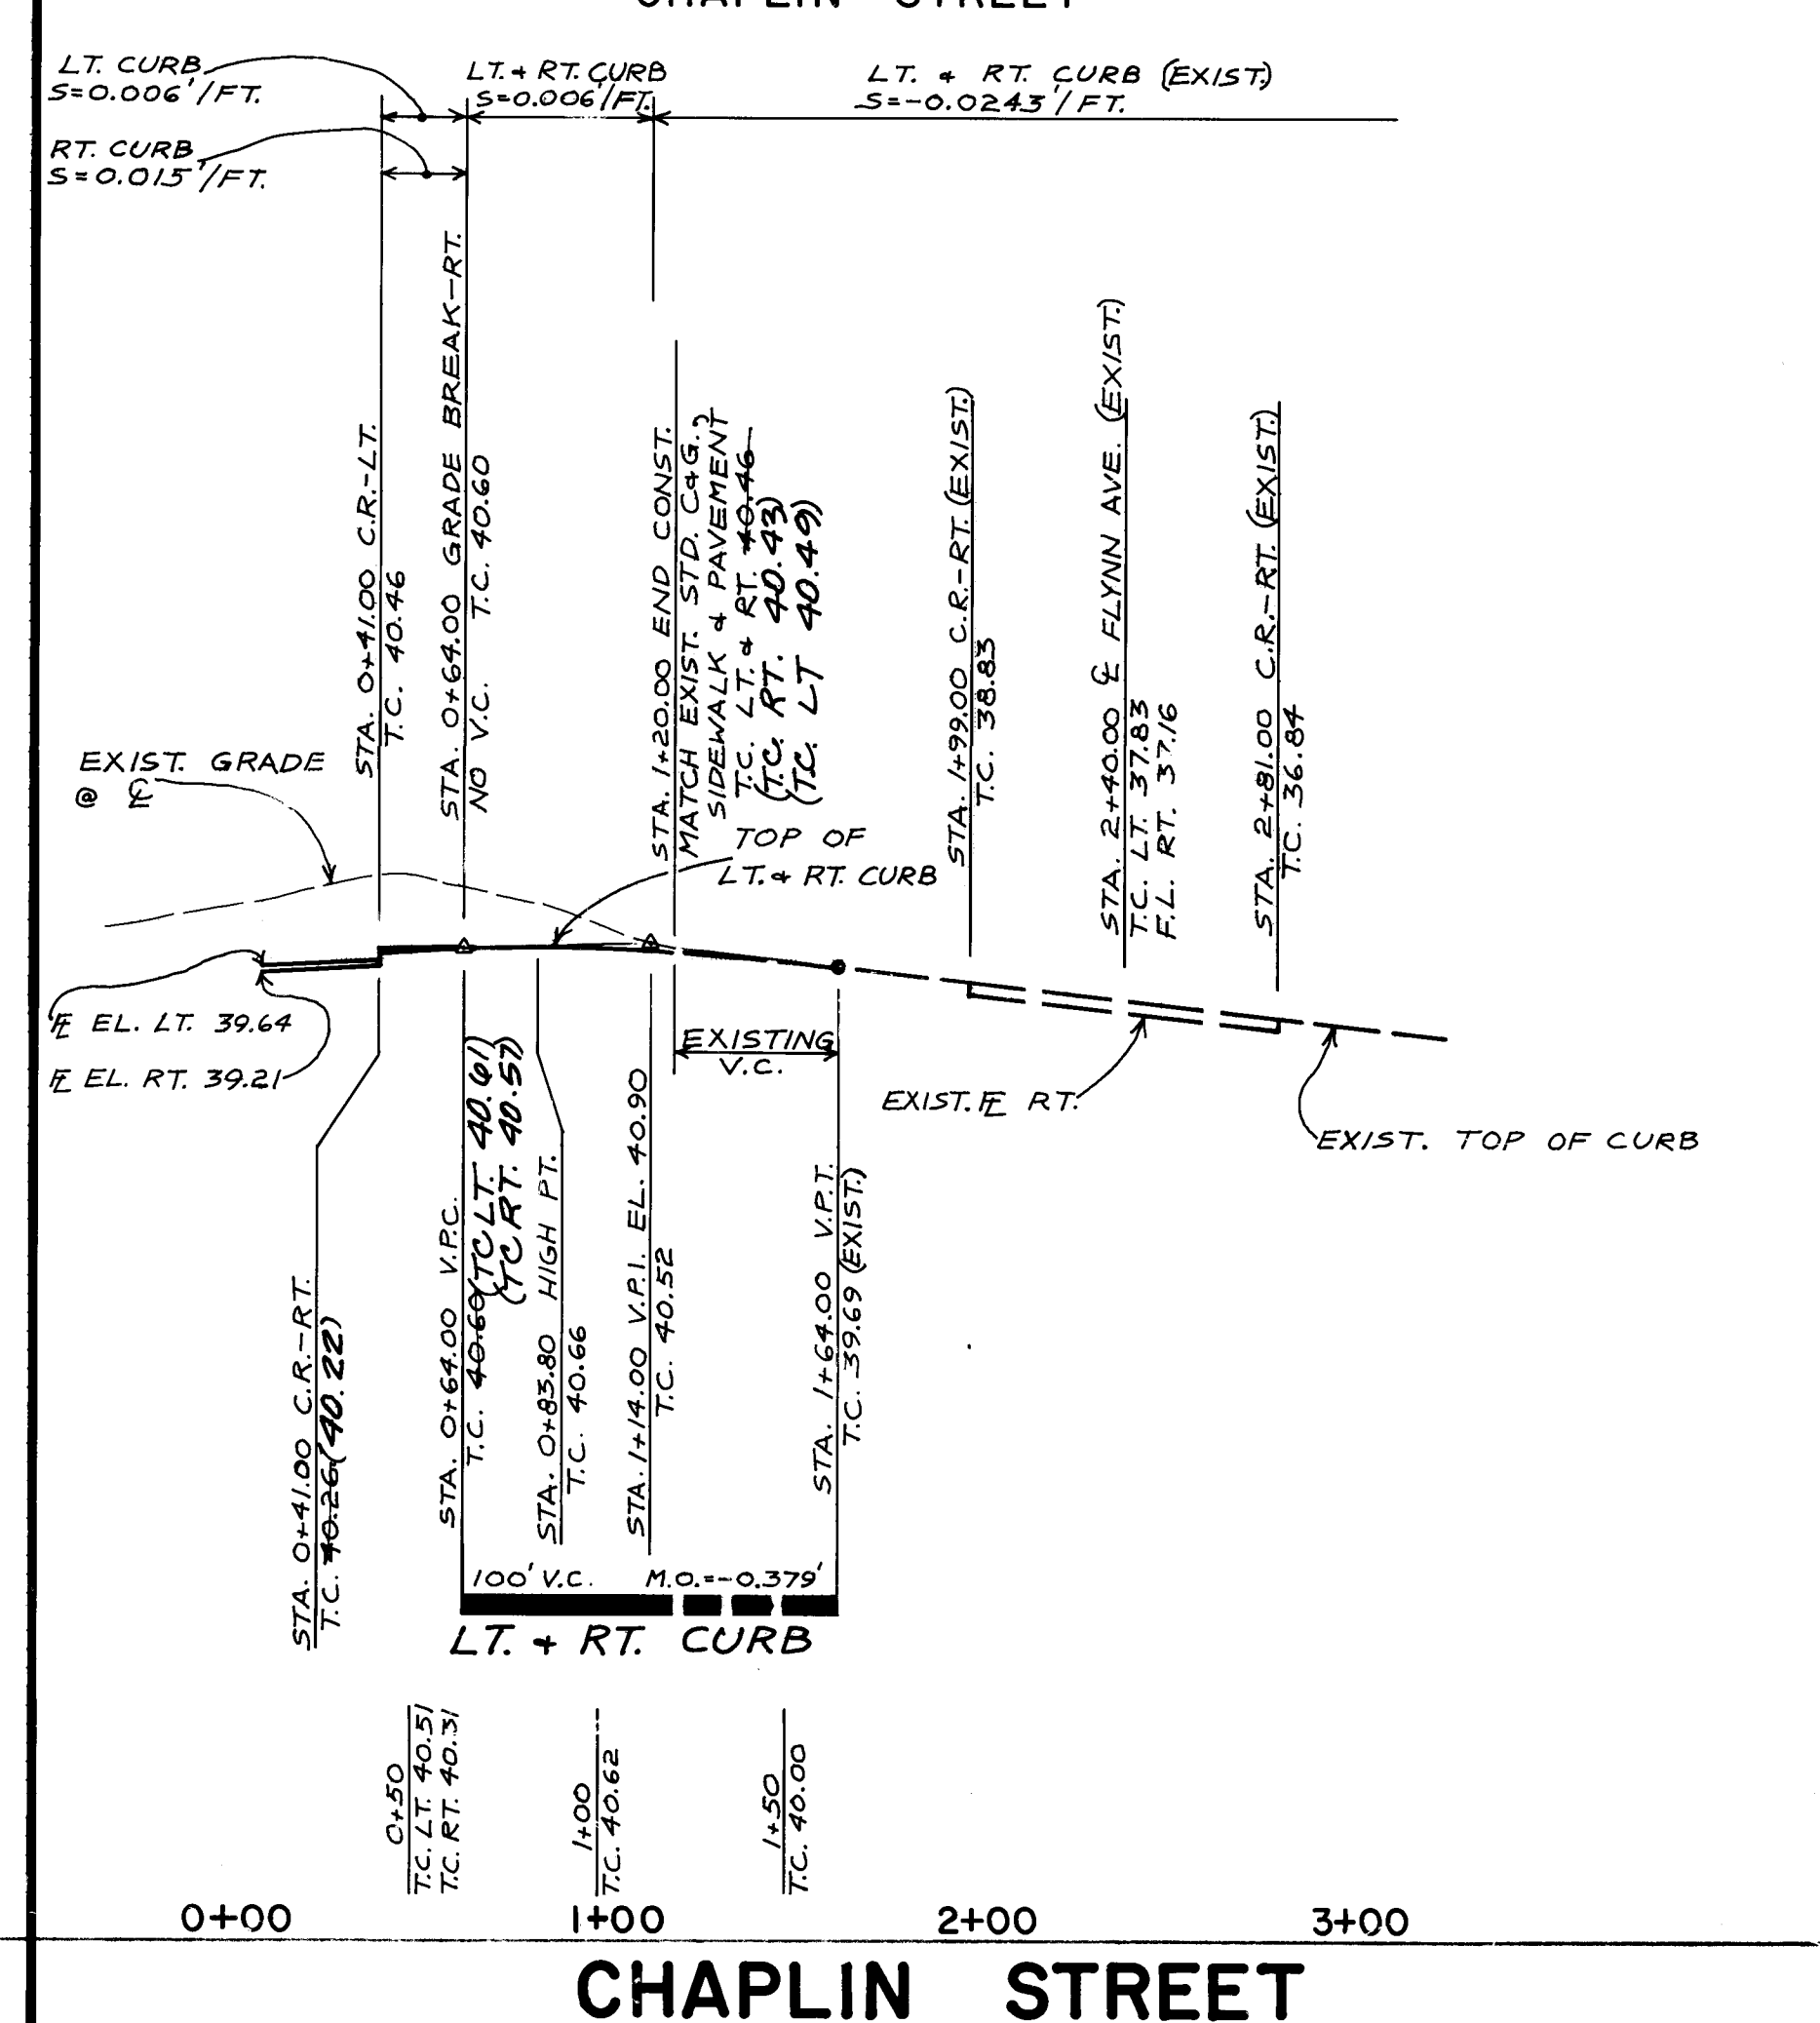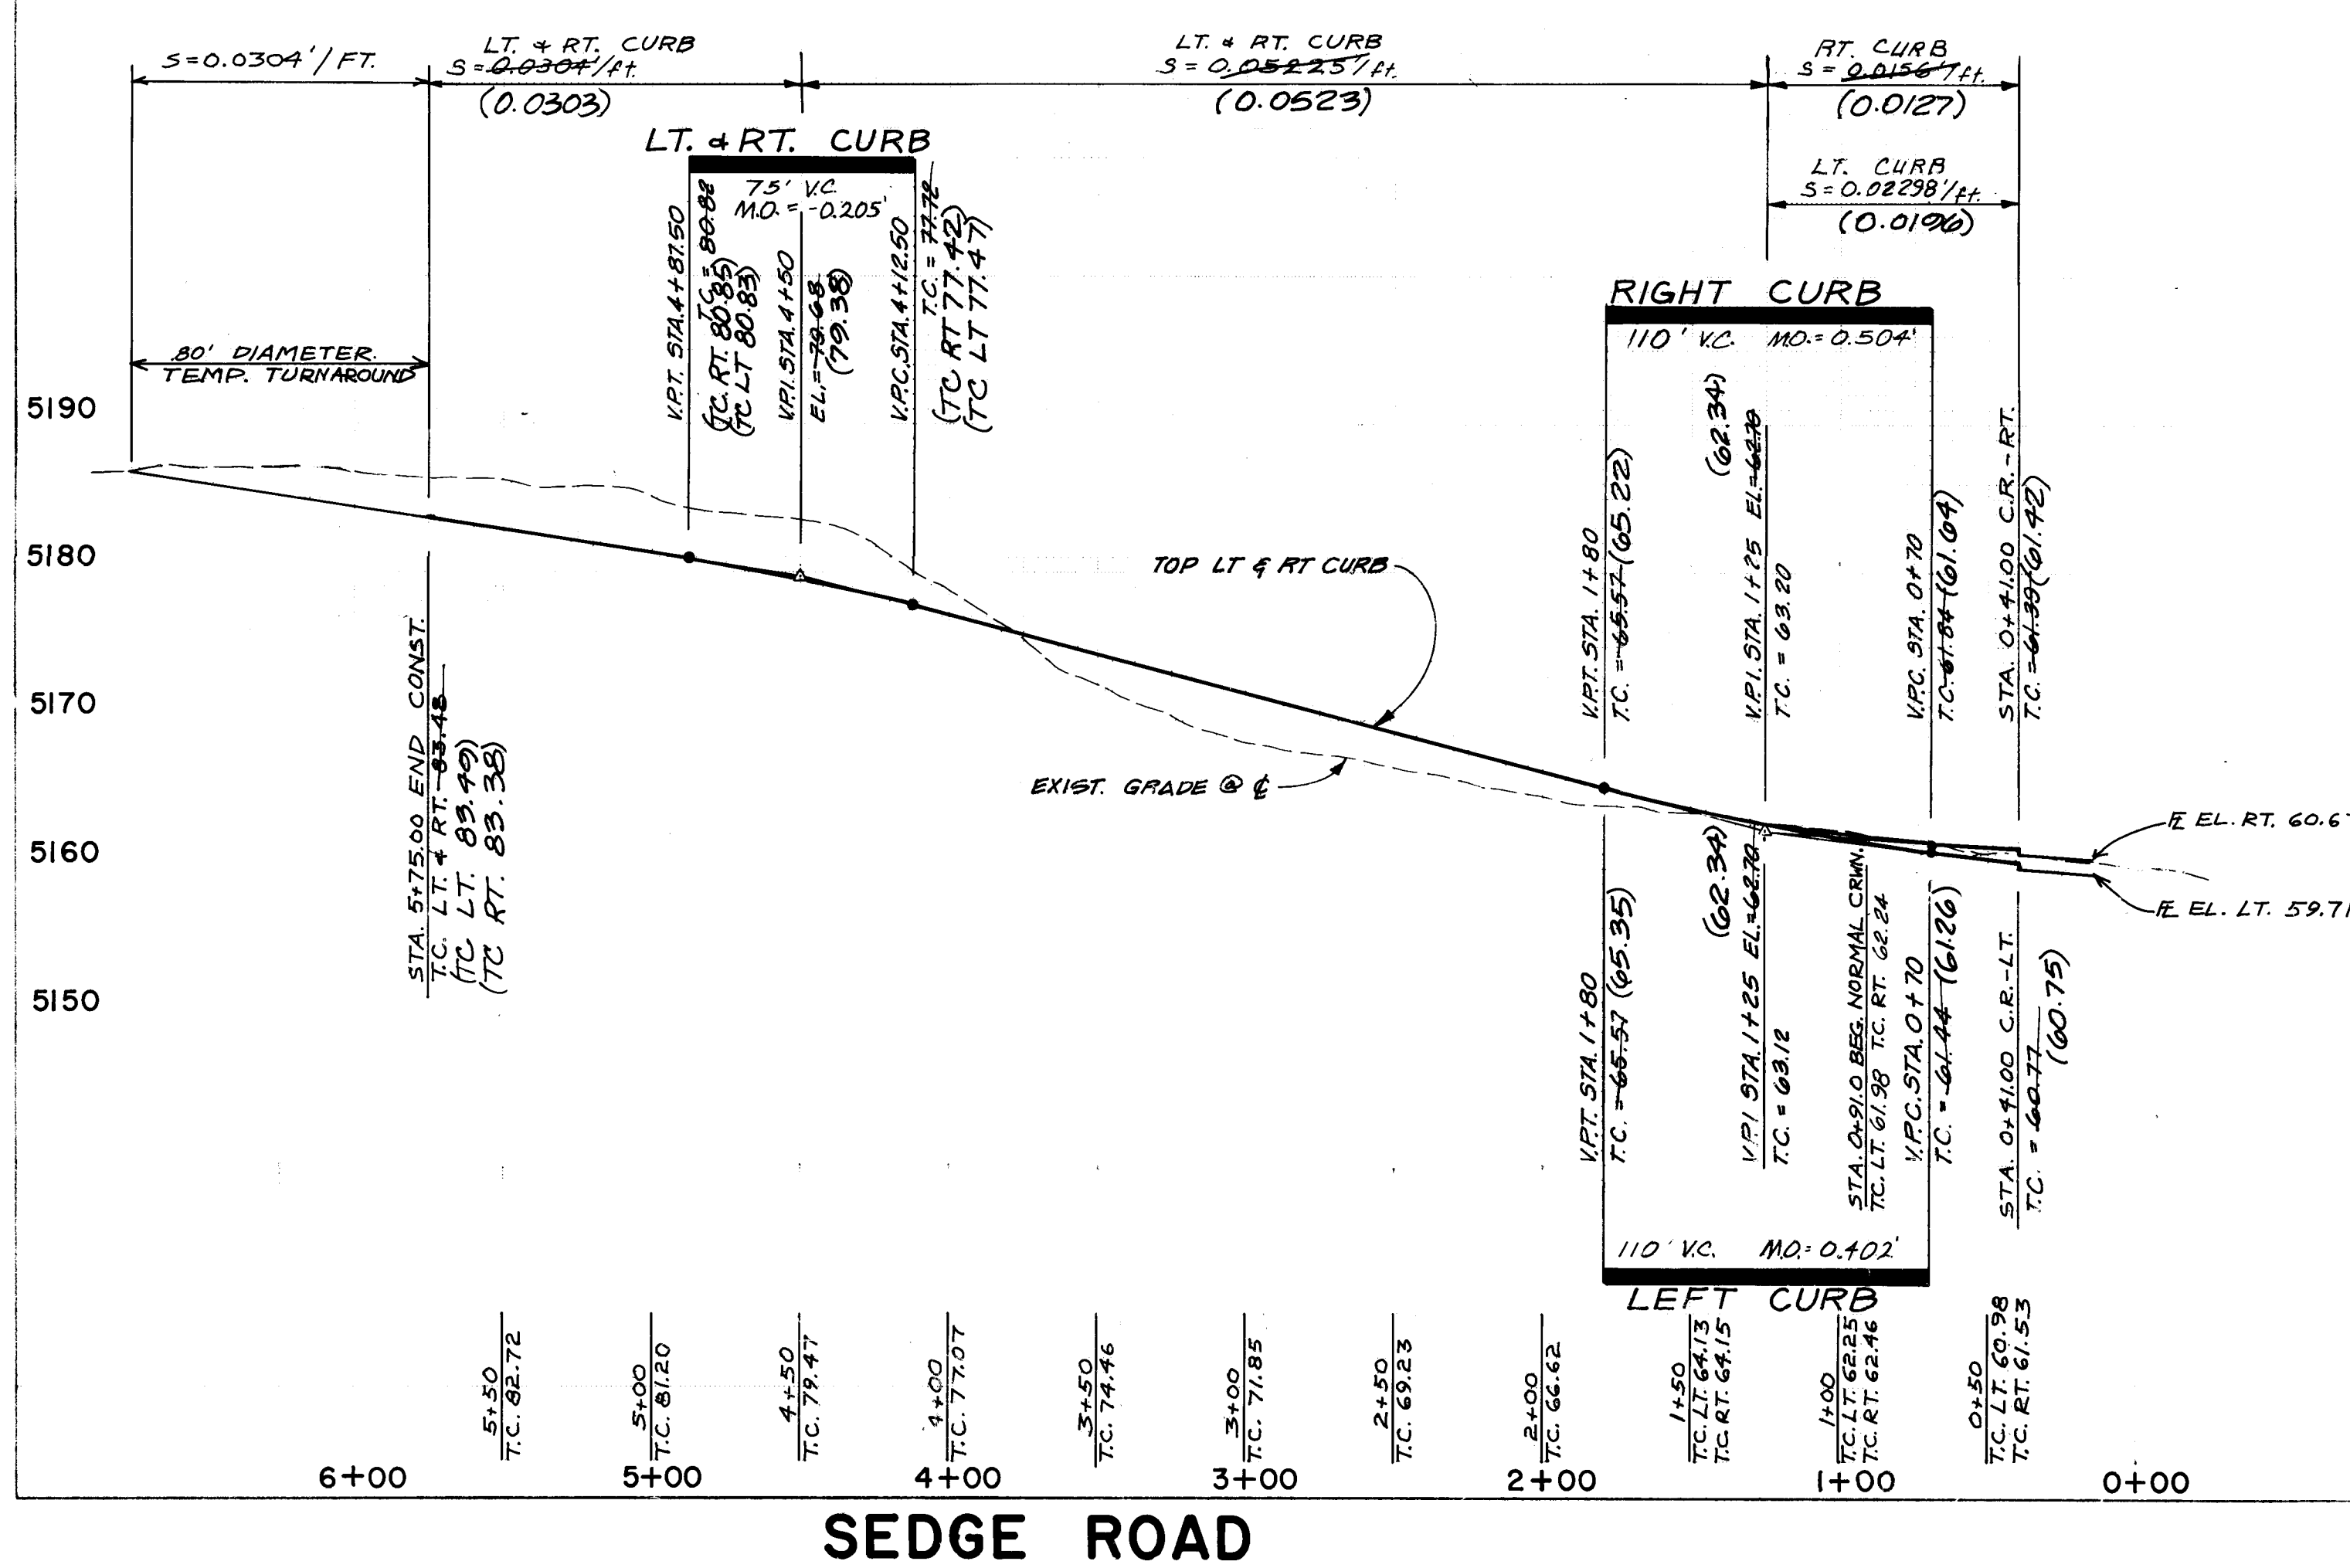[illegible]

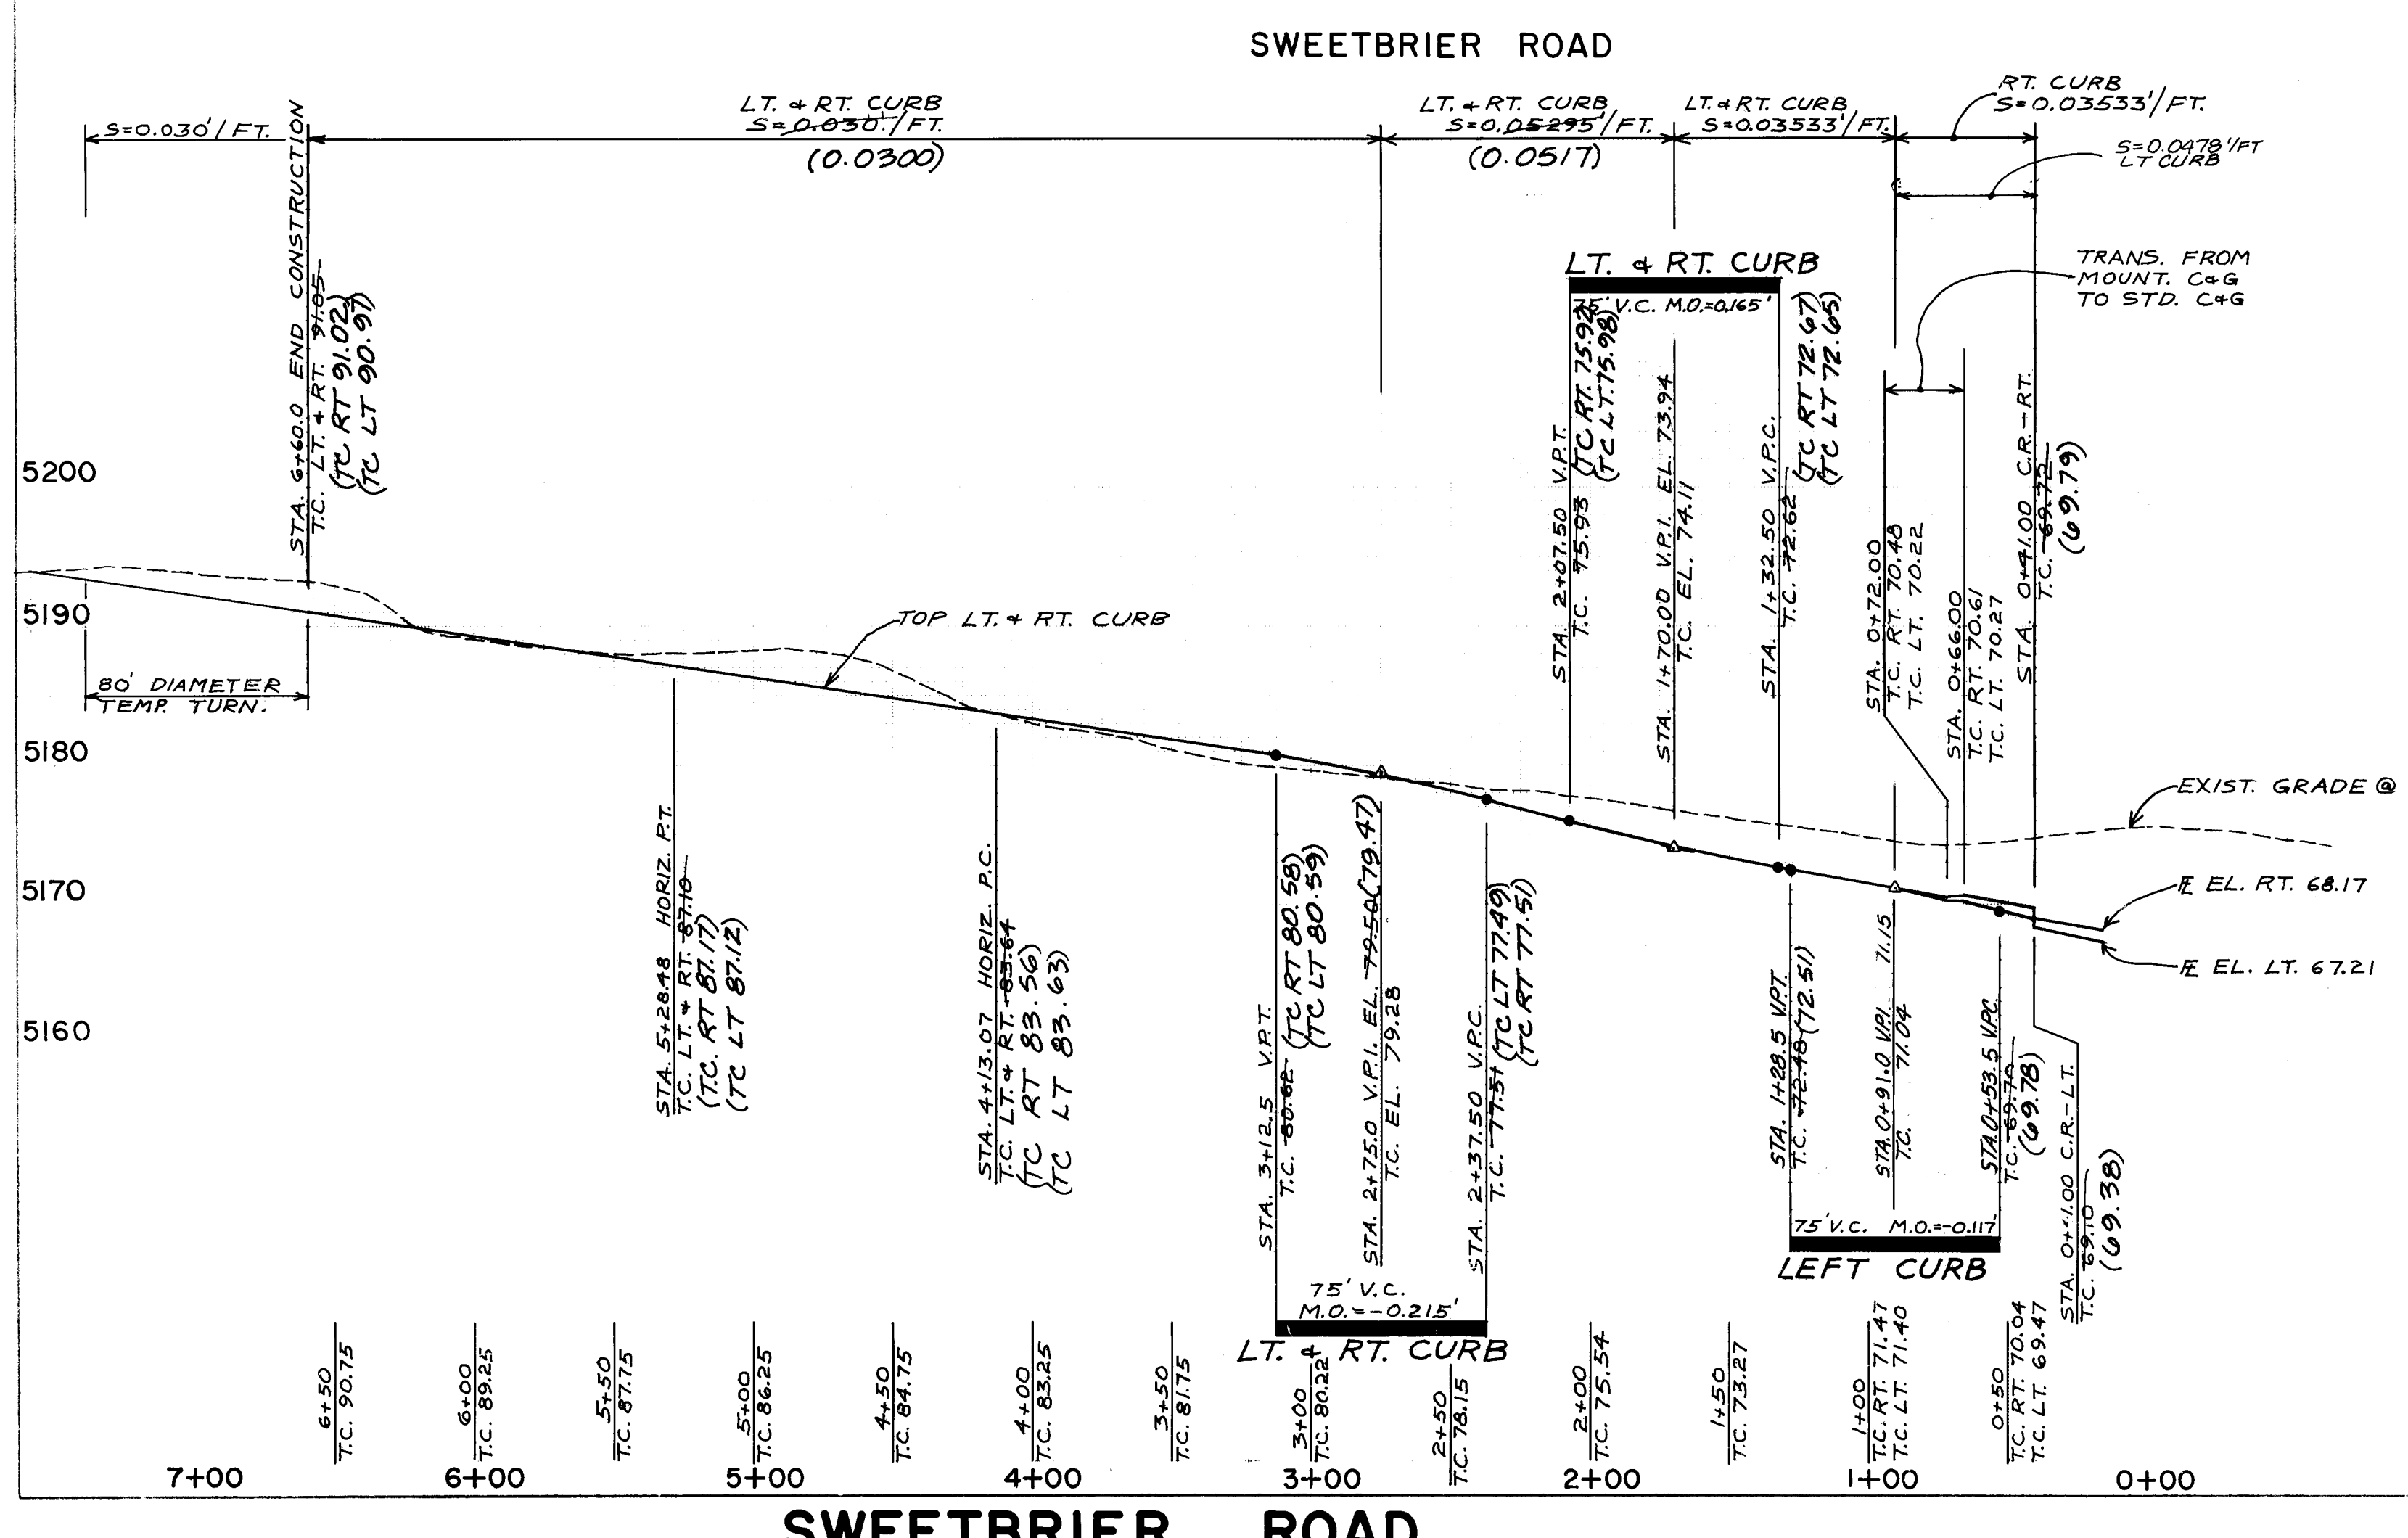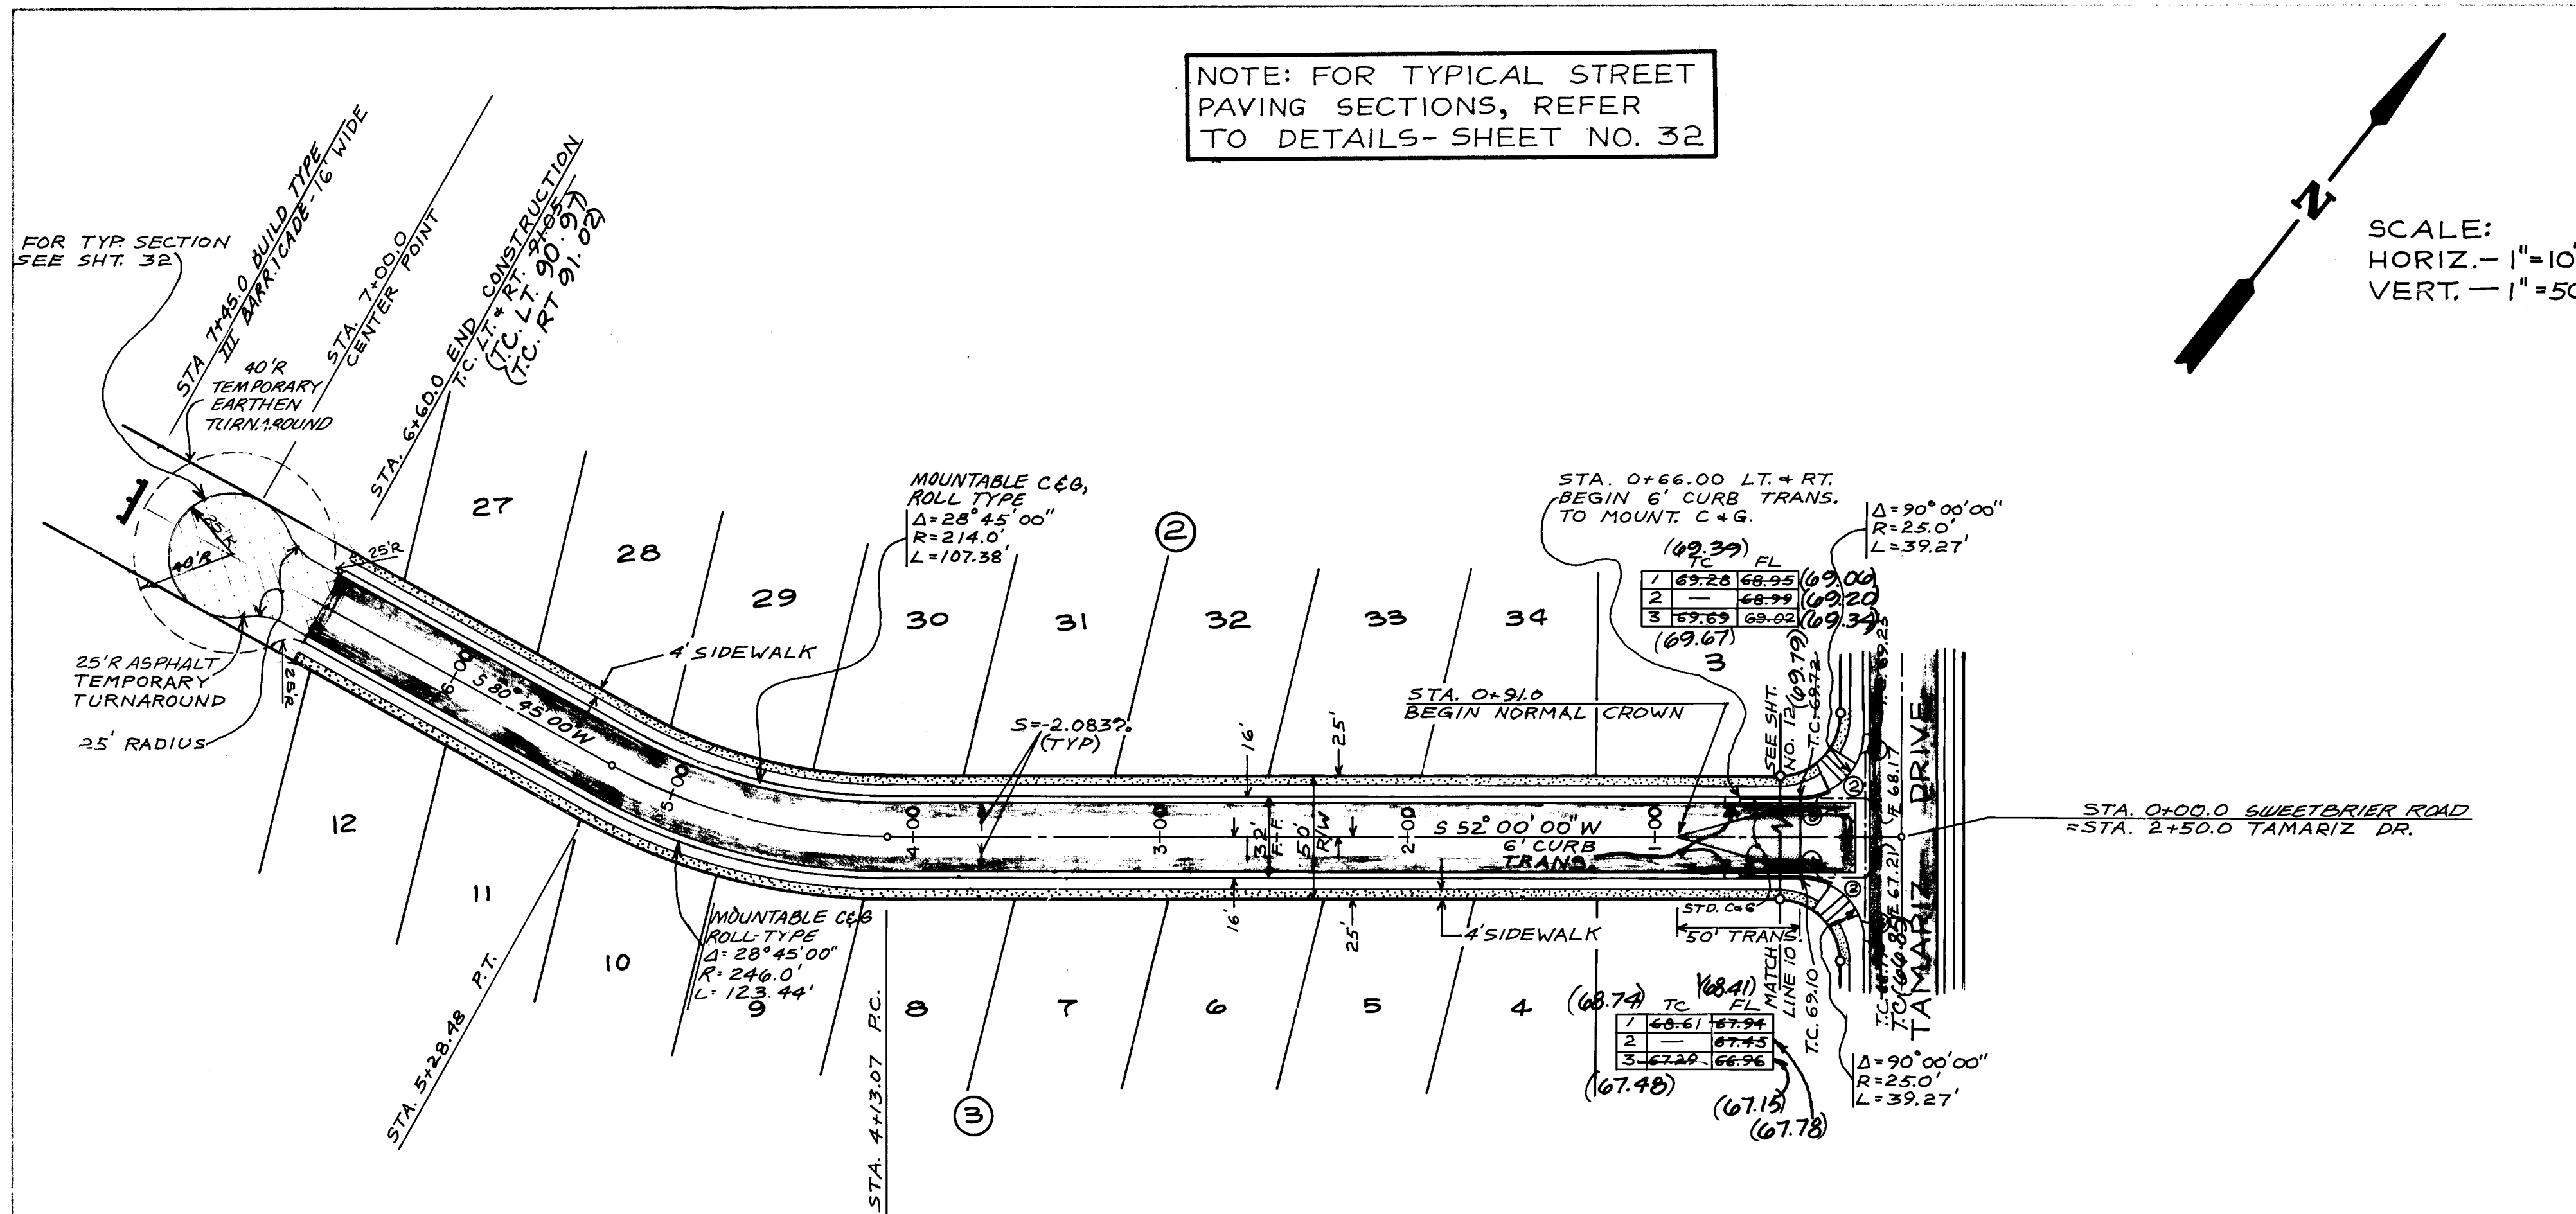

PAVING NOTES

- ALL STATIONING IS BASED ON CENTERLINE OF STREET.
- THE FOLLOWING CITY OF ALBUQUERQUE STANDARD DETAIL DRAWINGS ARE APPLICABLE:

P-8 T-9 (Case III)
P-9 K-16
P-11 K-20
P-13 (offset type) K-21
P-17
P-18

ENGINEER'S SEAL

LEGEND

SANITARY SEWER LINE	— SAS —
SANITARY SEWER MANHOLE	—
SAS SERVICE CONNECTION	—
WATER LINE	— W —
GATE VALVE	—
FIRE HYDRANT	—
REDUCER	—
TEE	—
BENDS	—
WATER SERVICE CONNECTION	—
CAPS & PLUGS	—
CROSS	—
SIDEWALK	—
STANDARD CURB & GUTTER	—
MOUNTABLE CURB & GUTTER	—
RESIDENTIAL PAVING	—
VALLEY GUTTER (CONC.)	—
CROWN TRANSITION AREA	—
WHEELCHAIR RAMP (CASE II)	—
BARRICADE (TYPE III)	—


26 28791487

CITY OF ALBUQUERQUE
MUNICIPAL DEVELOPMENT DEPARTMENT
ENGINEERING DIVISION


TITLE RINCON SUBDIVISION—PHASE I
SWEETBRIER ROAD
PAVING PLAN & PROFILE

APPROVALS	ENGINEER	DATE	APPROVALS	ENGINEER	DATE
City Engineer	John R. [Signature]	8/14/86	Liquid Waste	N/A W/W	7/29/86
A.C.E. Design	Robert [Signature]	8/5/86	Traffic	Robert [Signature]	7/29/86
Hydrology	Robert [Signature]		Water	N/A W/W	7/29/86


DRAWING NO. 2879 MAP NO. E-10 & F-10 SHEET 14 OF 36

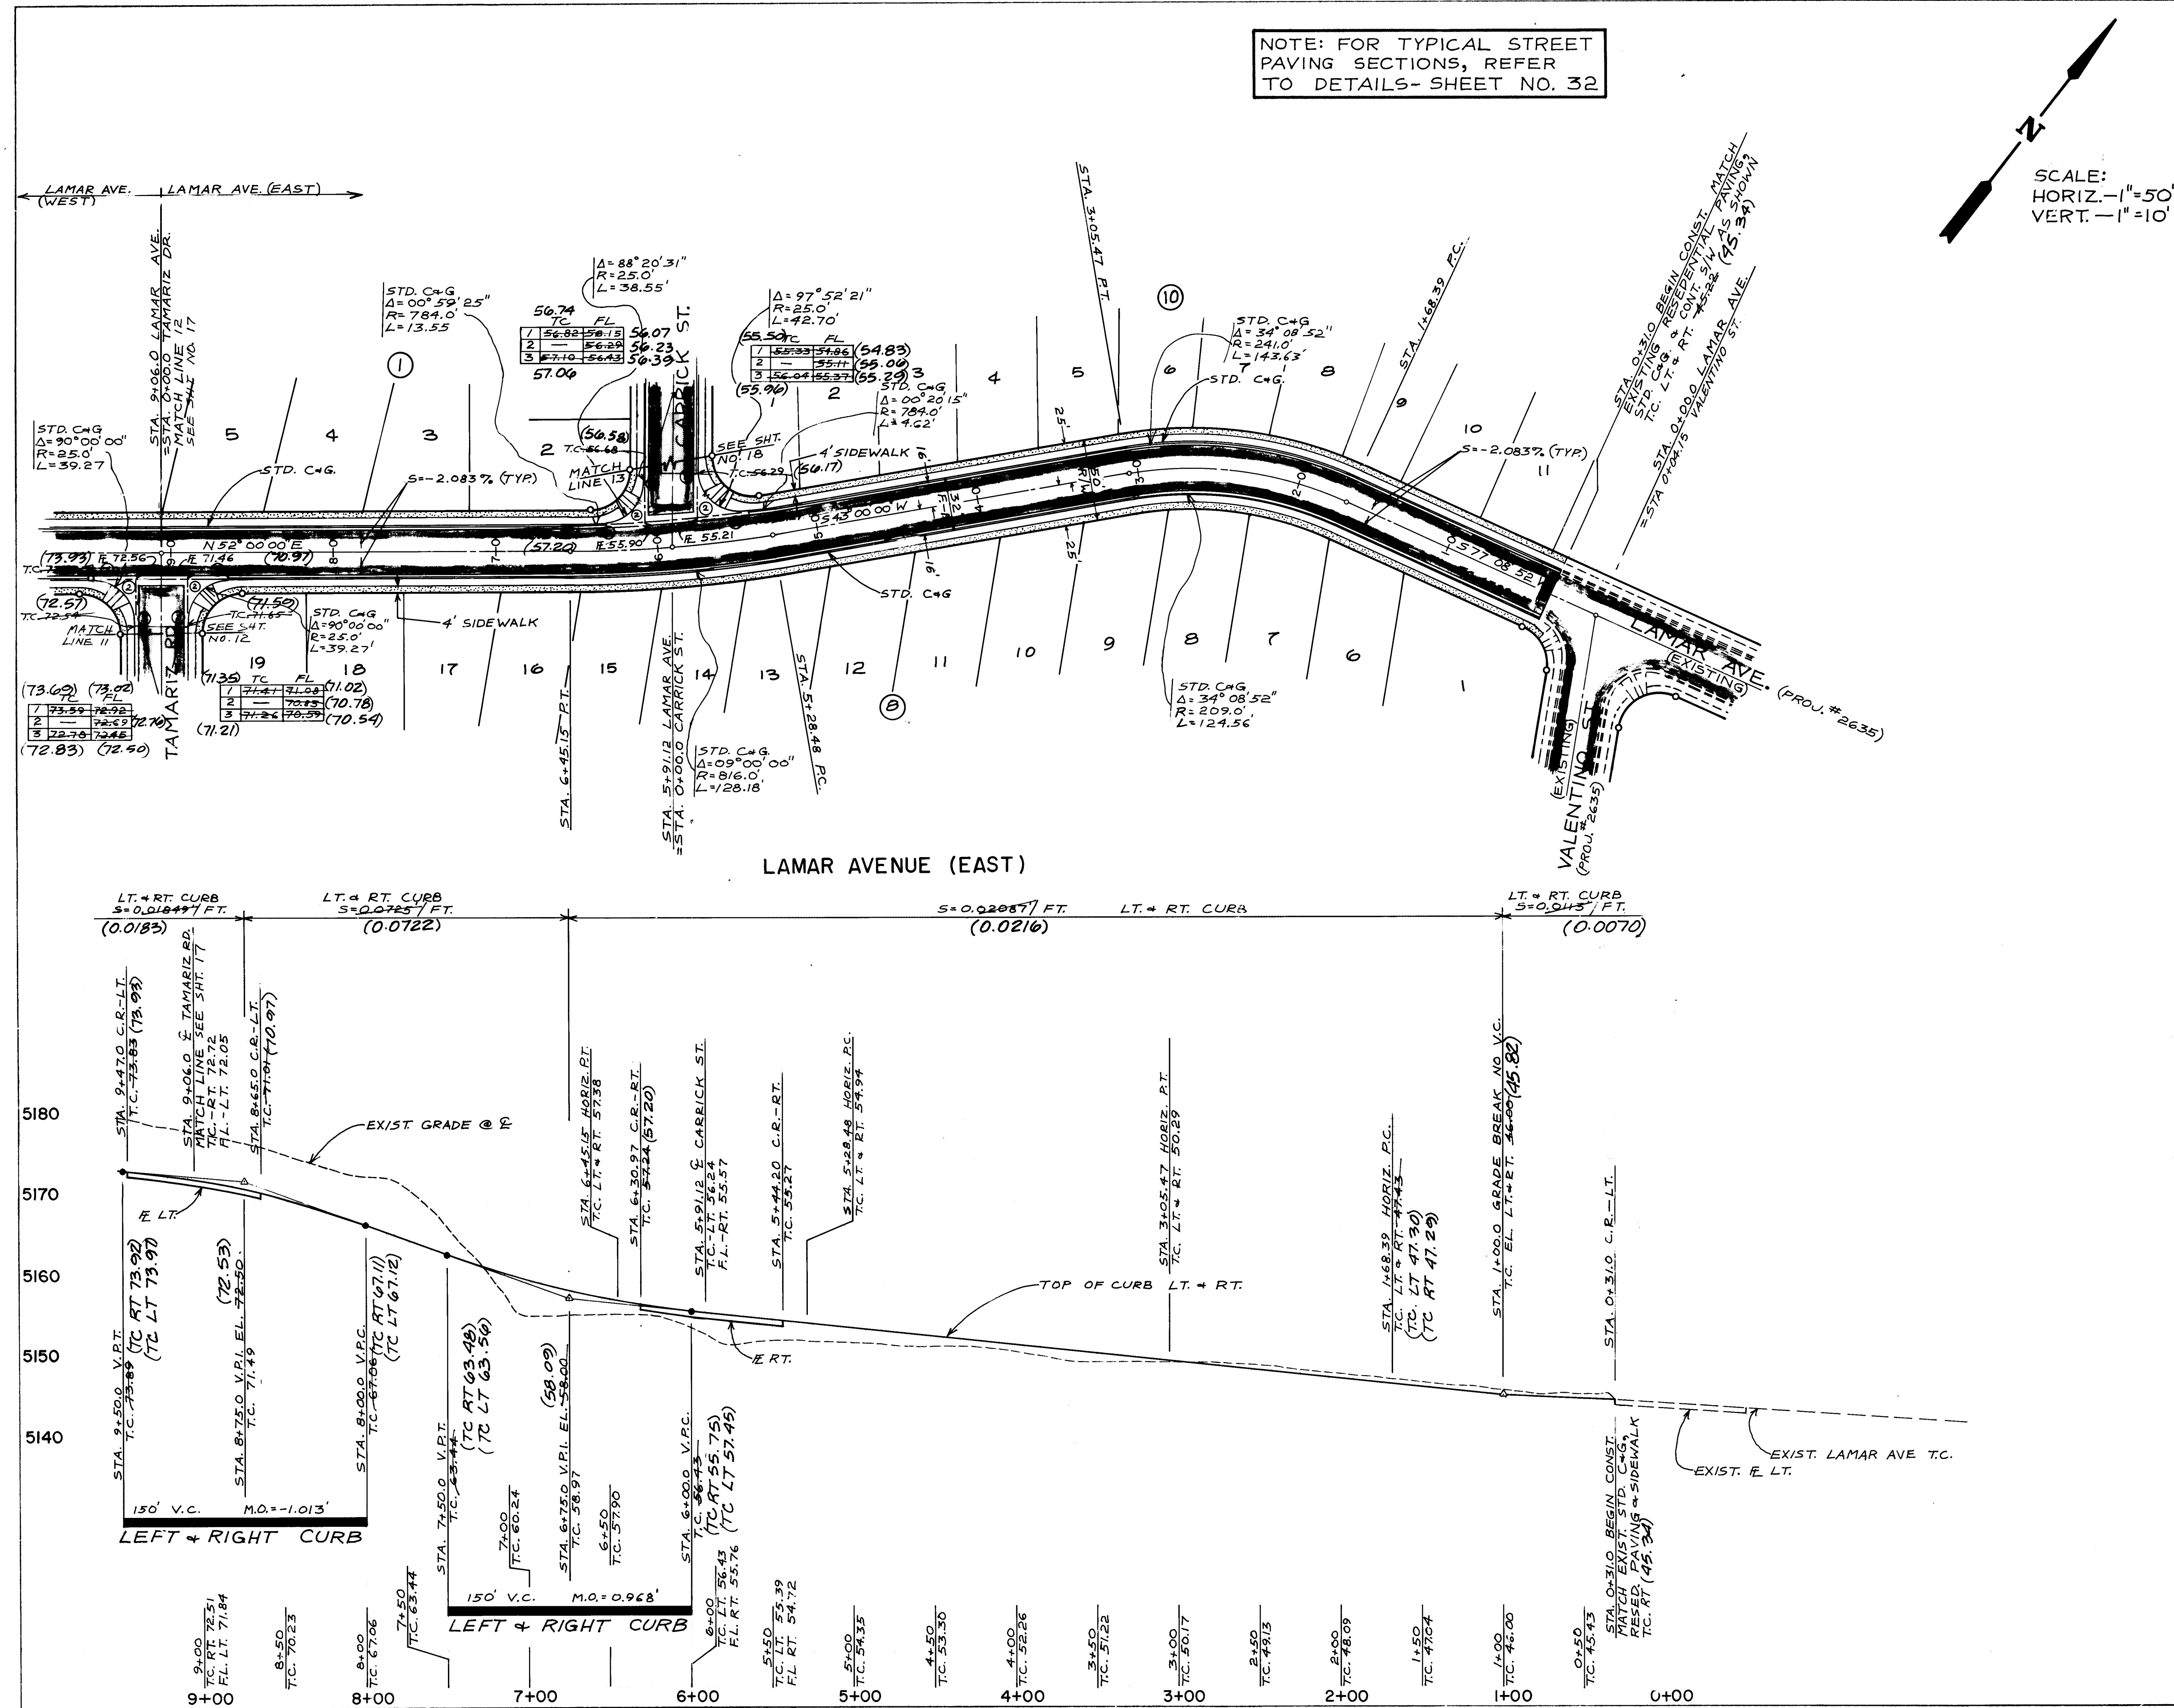

PAVING NOTES		AS BUILT INFORMATION	
1. ALL STATIONING IS BASED ON CENTERLINE OF STREET.		CONTRACT NO.	NO.
2. THE FOLLOWING CITY OF ALBUQUERQUE STANDARD DRAWINGS ARE APPLICABLE:		DATE	DATE
P-8	T-9 (Case III)	INSPECTED BY	DATE
P-9	K-16	FIELD CHECKED BY	DATE
P-11	K-20	VERIFICATION BY	DATE
P-13 (offset type)	K-21	CORRECTED BY	DATE
P-17		MICRO-FILM INFORMATION	
P-18		RECORDED BY	NO.
		CONTROL: BENCH MARK A.C.S. "16-E10"	
		A □ CHISEL ON TOP OF CONCRETE	
		CURB AT THE N.E. CURB RETURN	
		AT THE INTERSECTION OF ATRISCO	
		ROAD N.W. AND FLOR DEL SOL	
		PLACE N.W.	
		M.S.L. ELEVATION = 5134.77'	

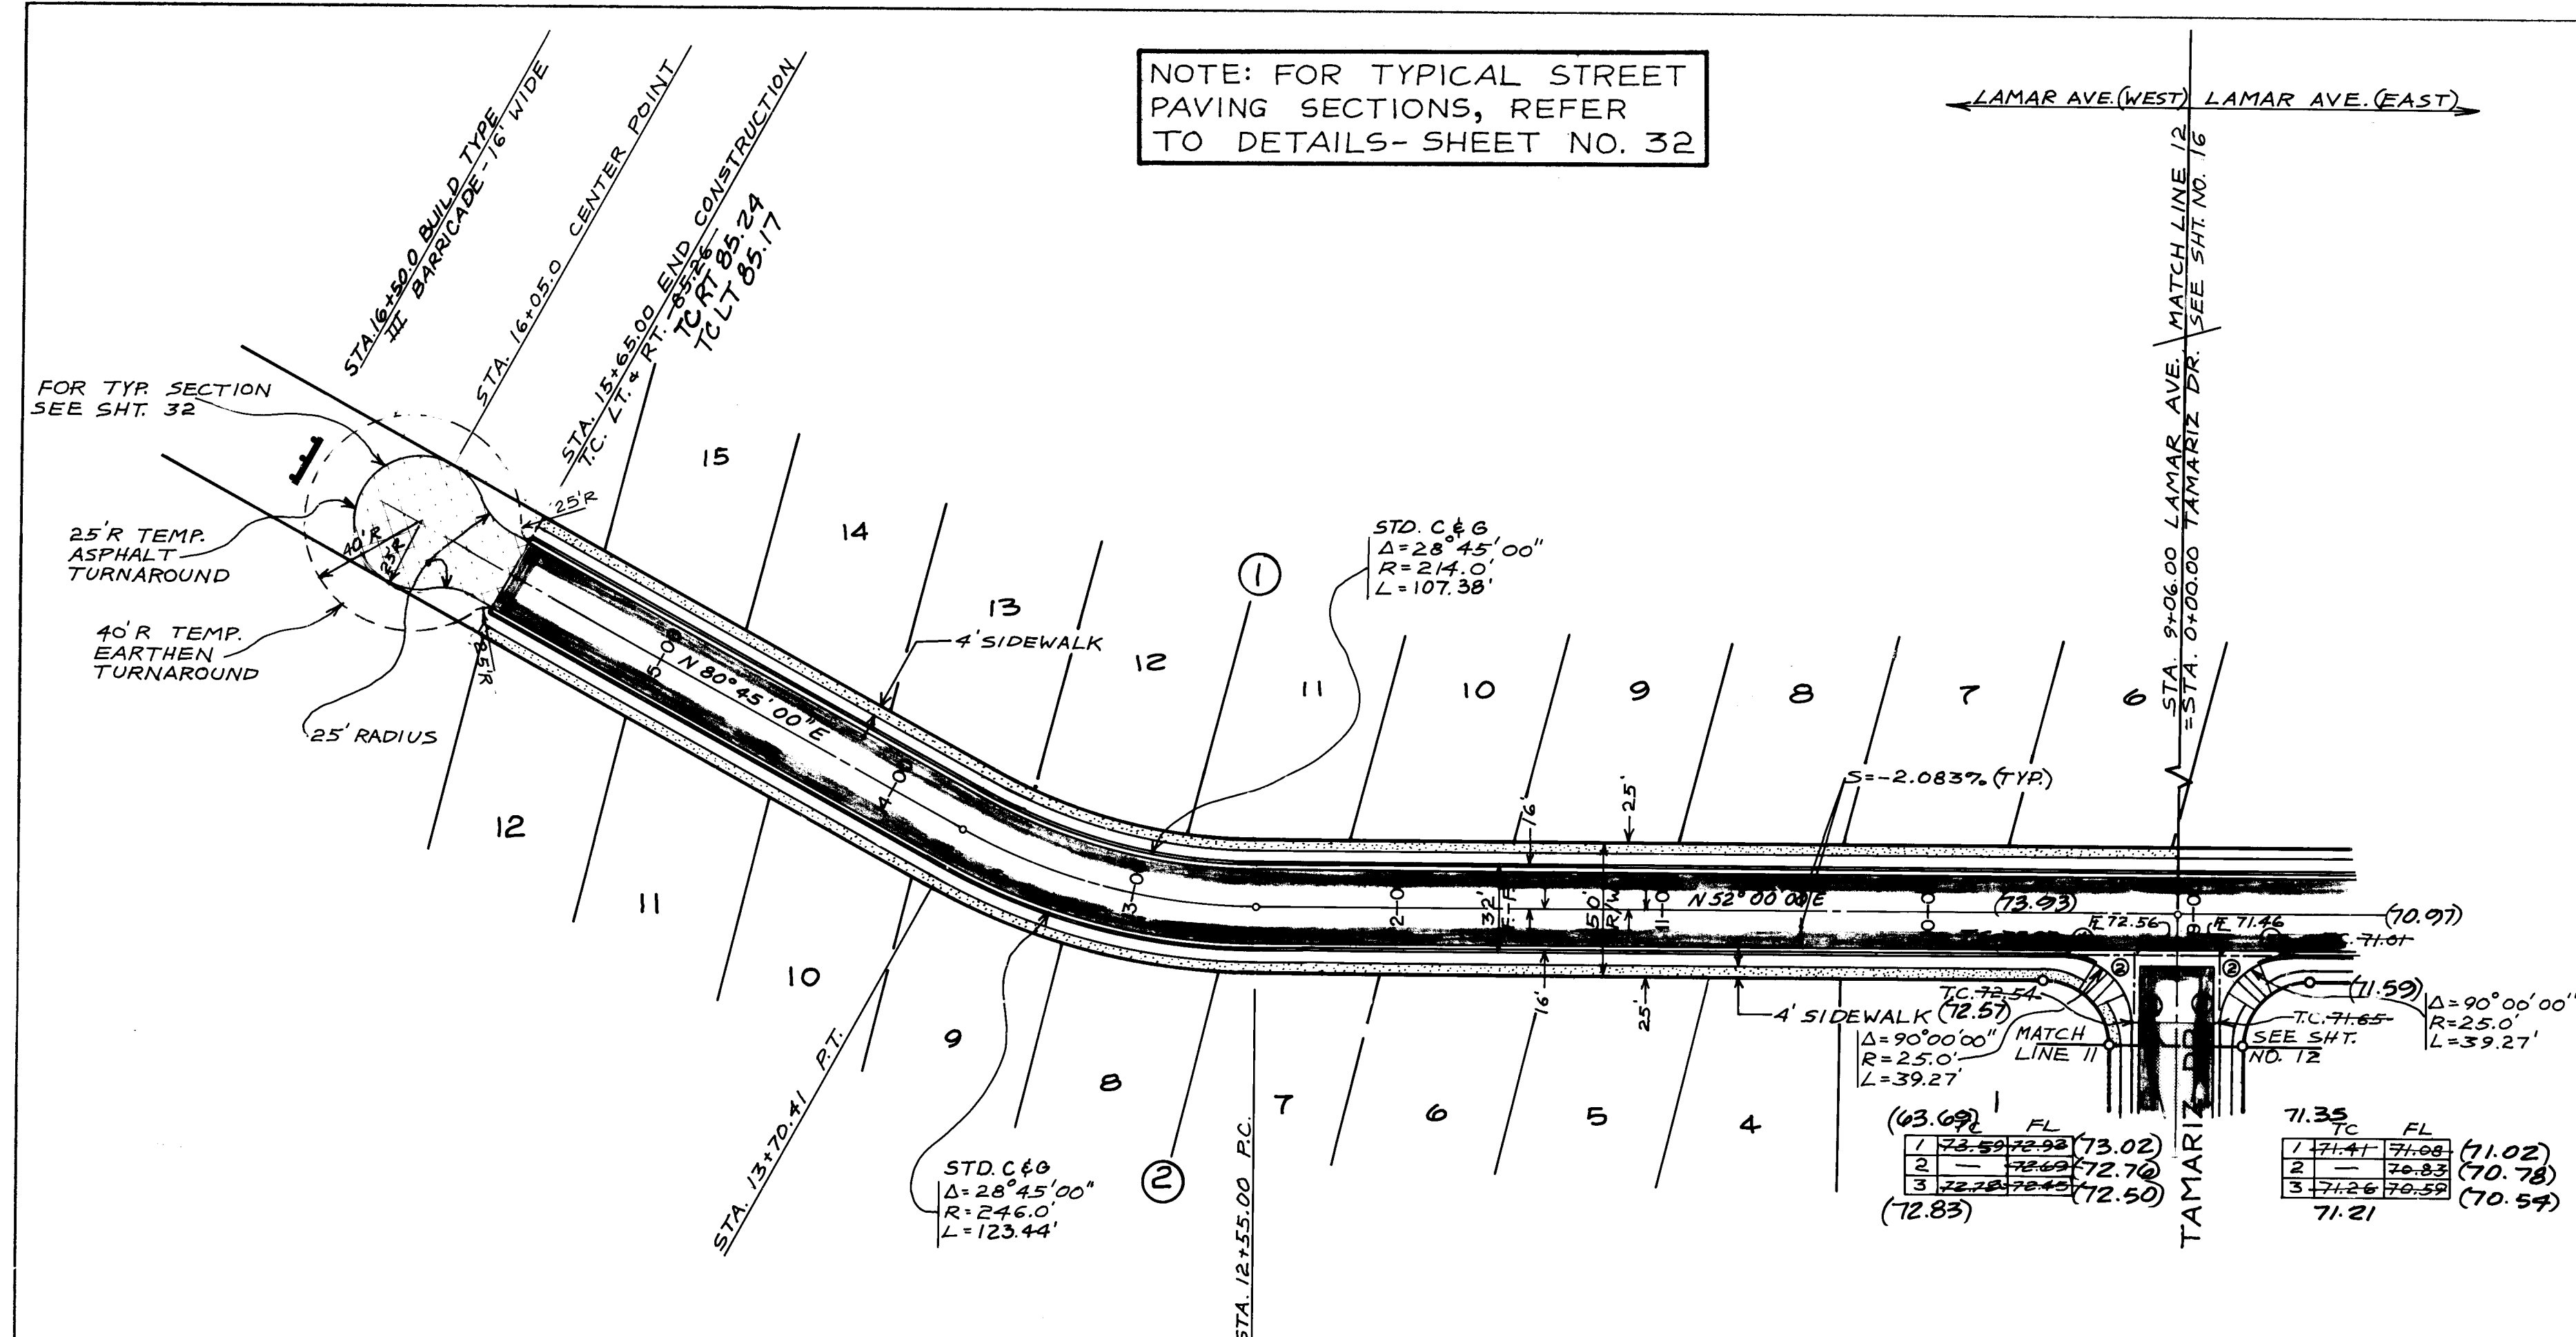

SCALE:
HORIZ.-1"=50'
VERT.-1"=10'

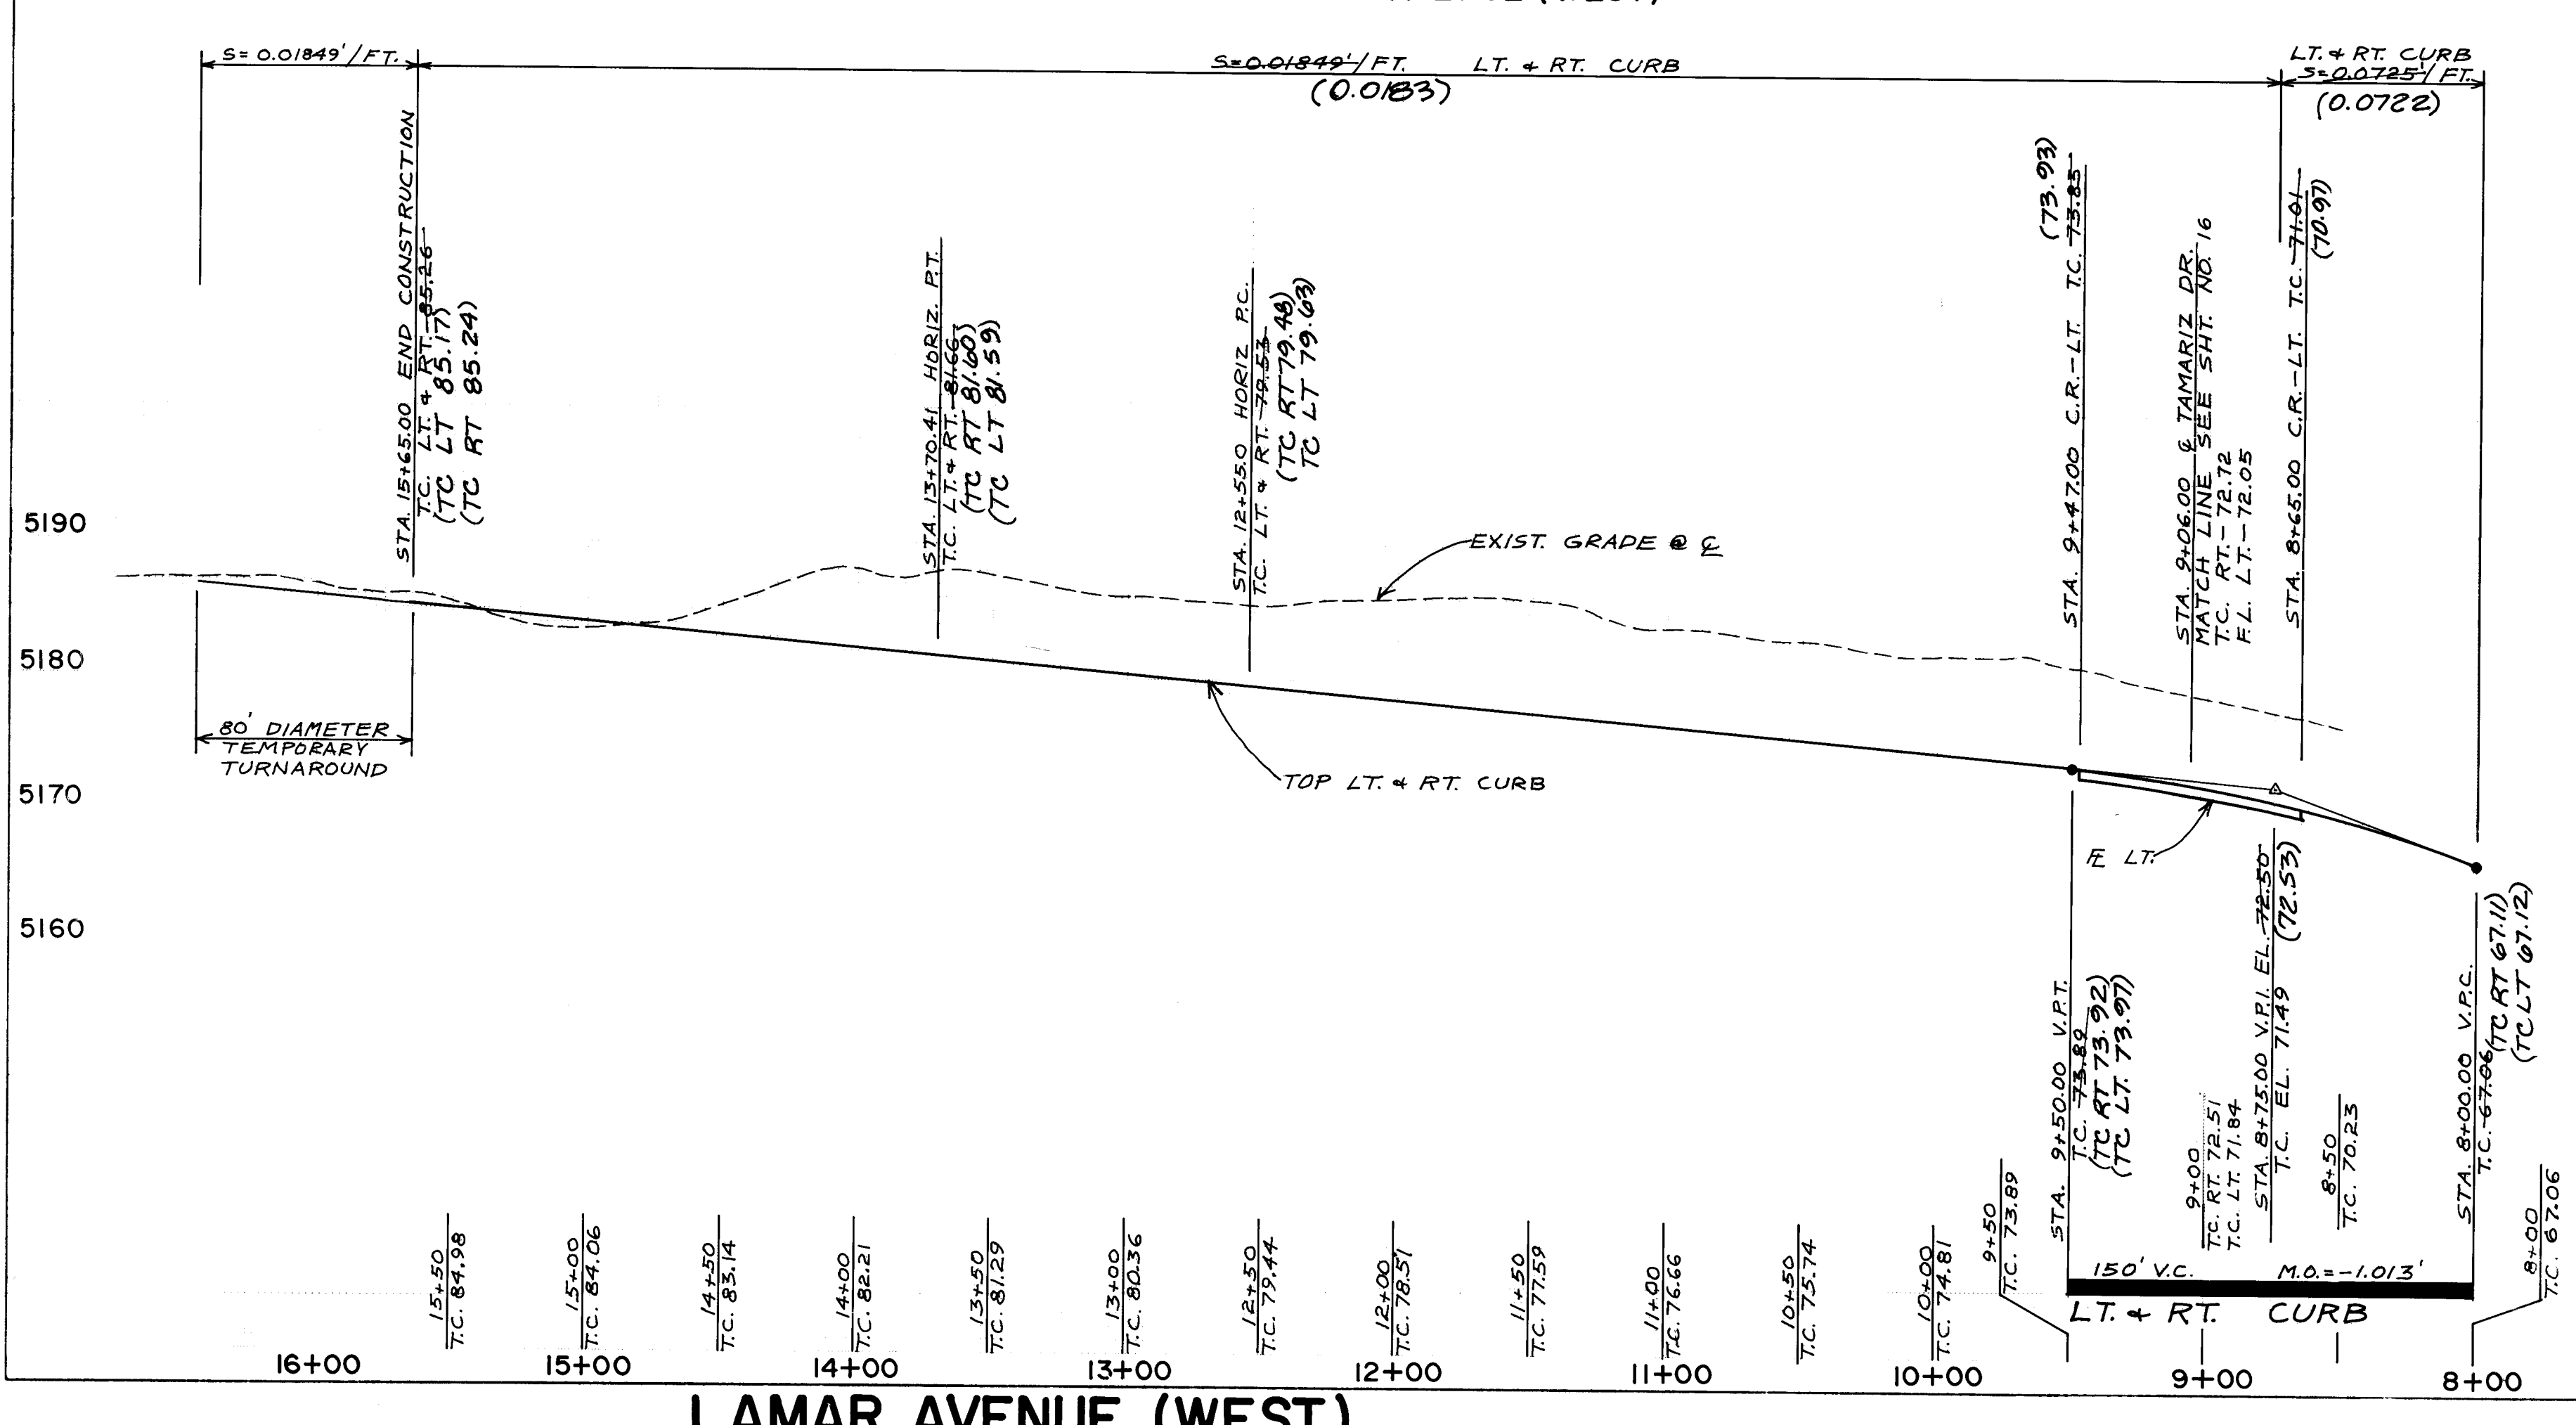

PAVING NOTES

- ALL STATIONING IS BASED ON CENTERLINE OF STREET.
- THE FOLLOWING CITY OF ALBUQUERQUE STANDARD DETAIL DRAWINGS ARE APPLICABLE:

P-8	T-9 (Case III)
P-9	K-16
P-11	K-20
P-13 (offset type)	K-21
P-17	
P-18	

AS BUILT INFORMATION	
CONTRACTOR	DATE
INSPECTOR	DATE
ACCIDENT BY	DATE
VERIFICATION BY	DATE
DRAWING BY	DATE
CHECKED BY	DATE
MICRO-FILM INFORMATION	
NO.	NO.
M.S.L. ELEVATION = 5134.777'	

LEGEND

SANITARY SEWER LINE	SAS
SANITARY SEWER MANHOLE	
SAS SERVICE CONNECTION	
WATER LINE	W
GATE VALVE	
FIRE HYDRANT	
REDUCER	
TEE	
BENDS	
WATER SERVICE CONNECTION	
CAPS & PLUGS	
CROSS	
SIDEWALK	
STANDARD CURB & GUTTER	
MOUNTABLE CURB & GUTTER	
RESIDENTIAL PAVING	
VALLEY GUTTER (CONC.)	
CROWN TRANSITION AREA	
WHEELCHAIR RAMP (CASE II)	
BARRICADE (TYPE III)	


REVISIONS	
NO	DATE
1	2/28/86
2	3/14/86
3	3/15/86
4	3/15/86
5	3/15/86
6	3/15/86
7	3/15/86
8	3/15/86
9	3/15/86
10	3/15/86

CITY OF ALBUQUERQUE
MUNICIPAL DEVELOPMENT DEPARTMENT
ENGINEERING DIVISION

TITLE: RINCON SUBDIVISION—PHASE I
LAMAR AVENUE (WEST)
PAVING PLAN & PROFILE

APPROVALS	ENGINEER	DATE	APPROVALS	ENGINEER	DATE
City Engineer	Robert H. Hays	3/14/86	Liquid Waste	N/A	7/29/86
A.C.E. Design	Robert H. Hays	3/15/86	Traffic	N/A	7/29/86
C.E. Hydrology	Robert H. Hays	3/15/86	Water	N/A	7/29/86


DRAWING NO	MAP NO	SHEET OF
2879	E-10 & F-10	17 36

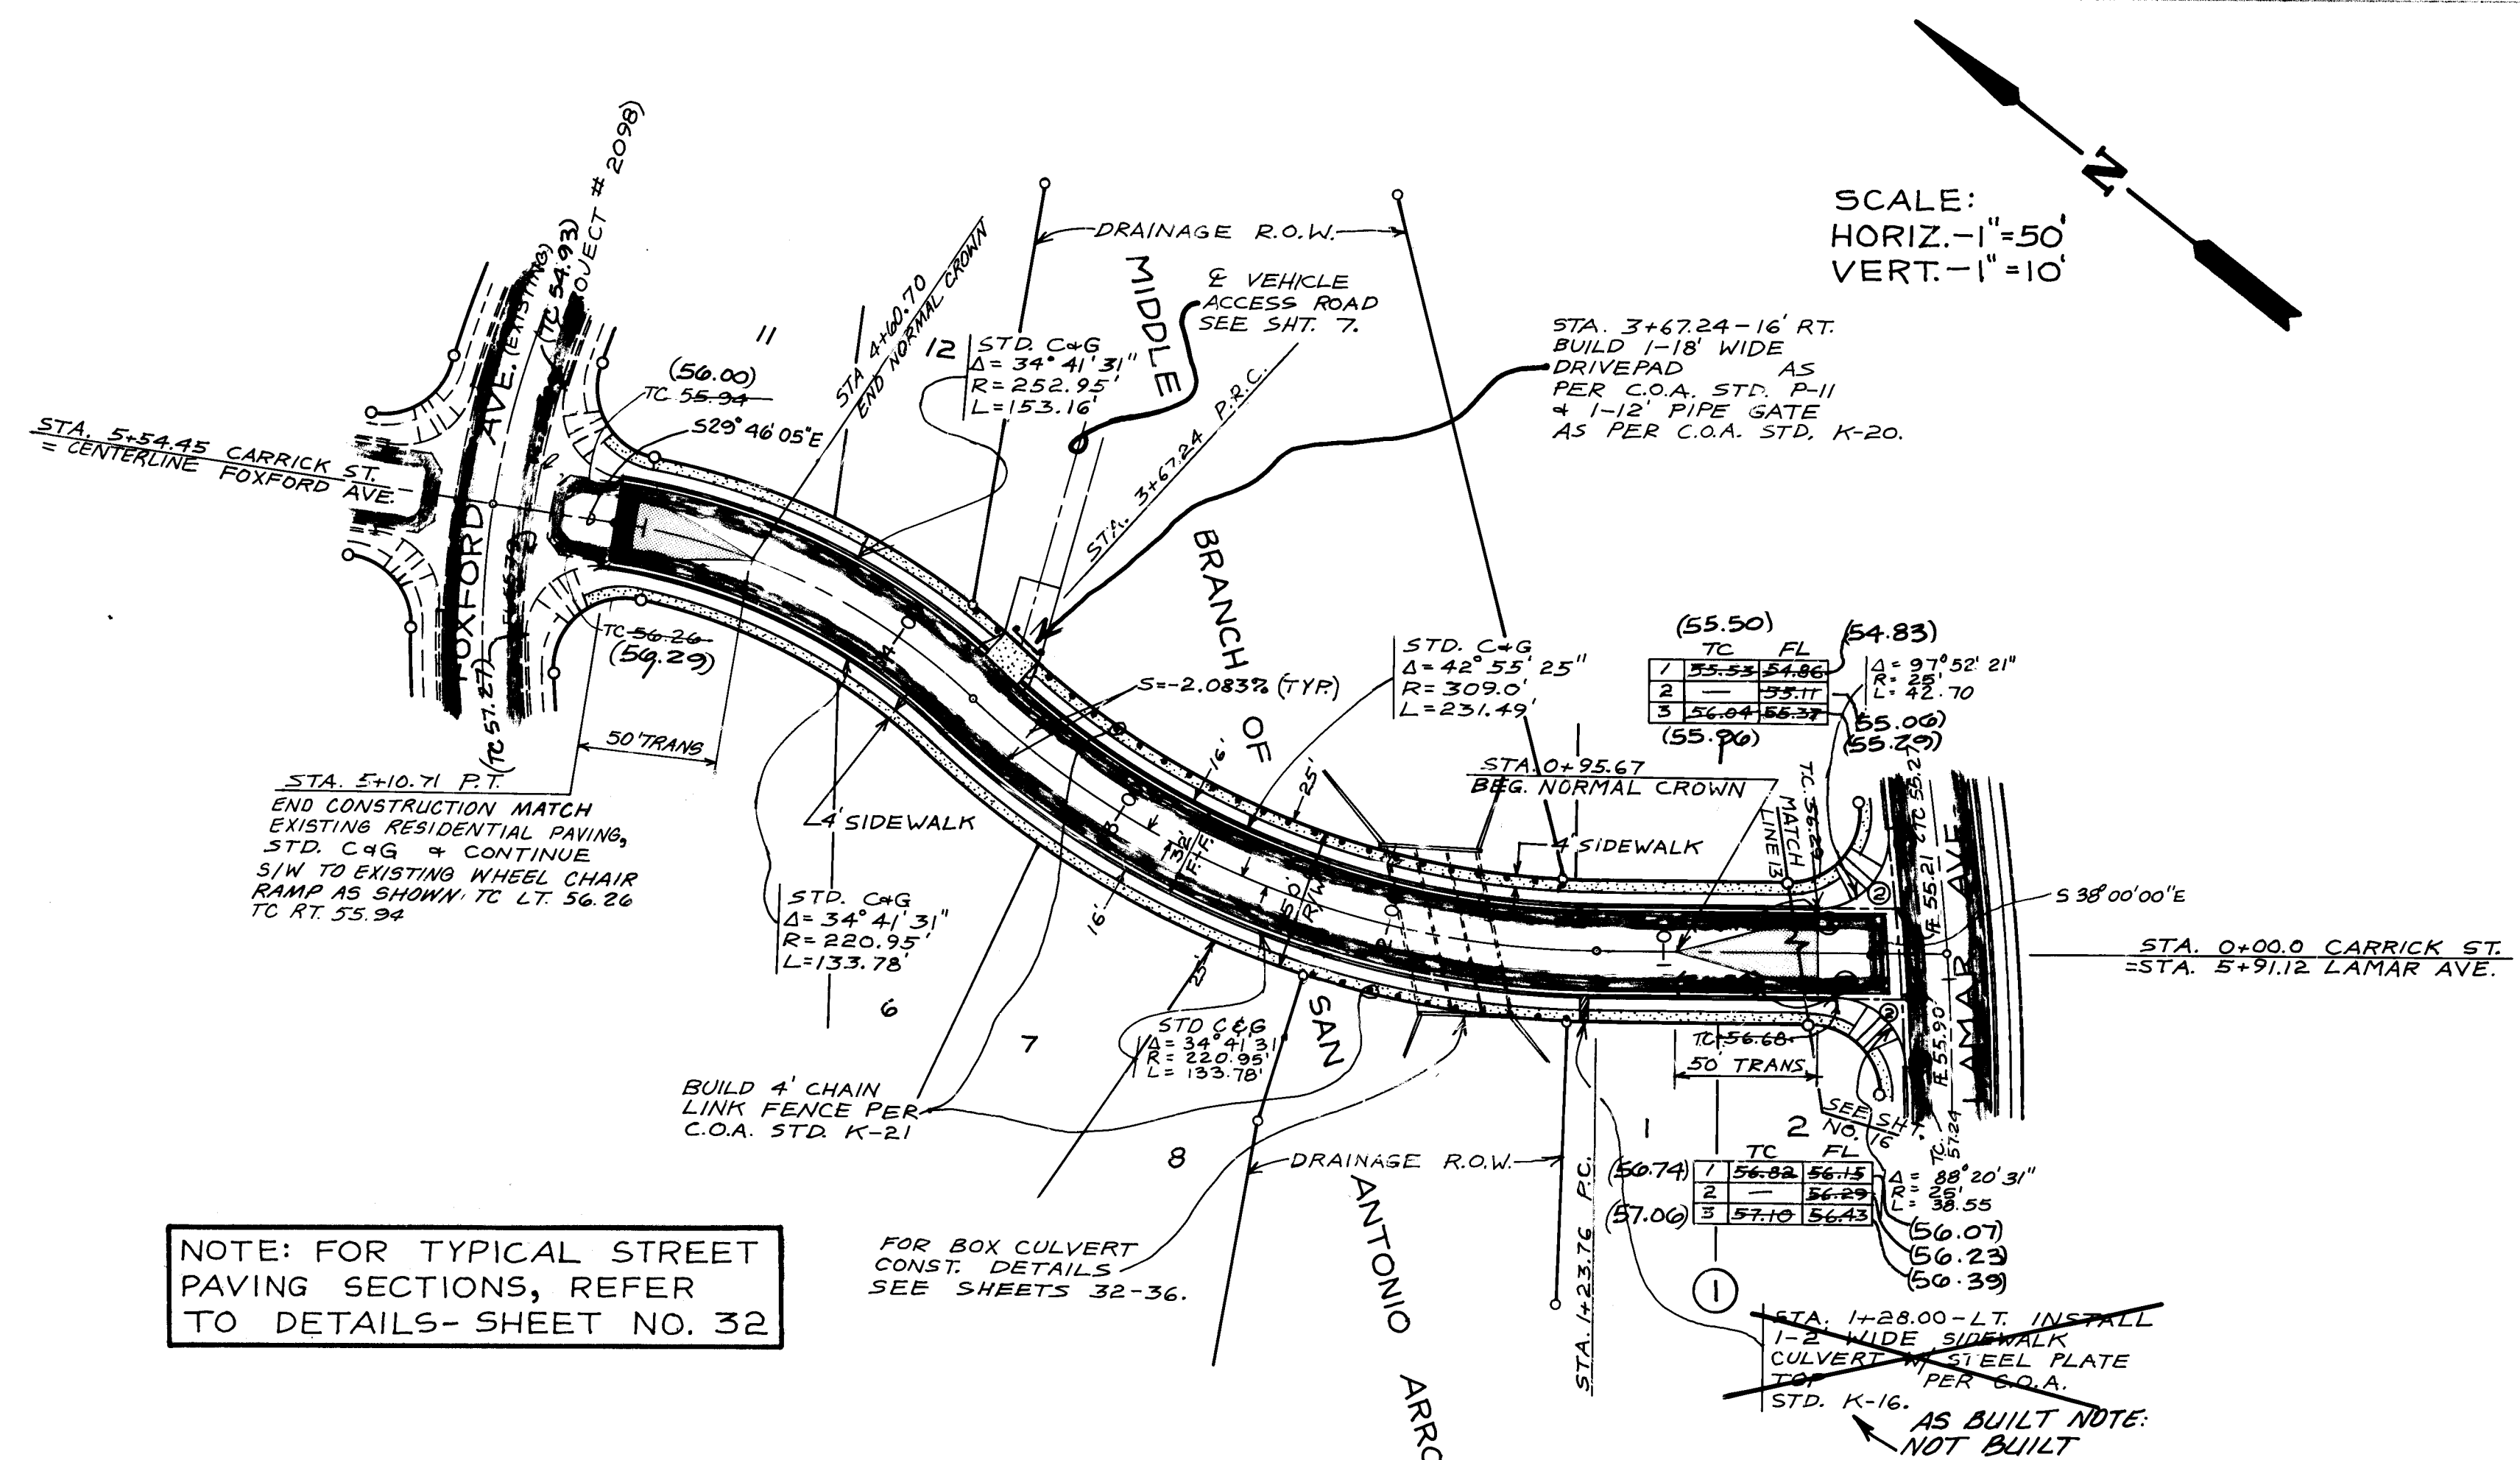

- PAVING NOTES
- ALL STATIONING IS BASED ON CENTERLINE OF STREET.
 - THE FOLLOWING CITY OF ALBUQUERQUE STANDARD DETAIL DRAWINGS ARE APPLICABLE:
- | | |
|--------------------|----------------|
| P-8 | T-9 (Case III) |
| P-9 | K-16 |
| P-11 | K-20 |
| P-13 (offset type) | K-21 |
| P-17 | |
| P-18 | |

CONTROL: BENCH MARK A.C.S. "16-E10", A CHISEL ON TOP OF CONCRETE CURB AT THE N.E. CURB RETURN AT THE INTERSECTION OF ATRISCO ROAD N.W. AND FLOR DEL SOL PLACE N.W.

M.S.L. ELEVATION = 5134.777'

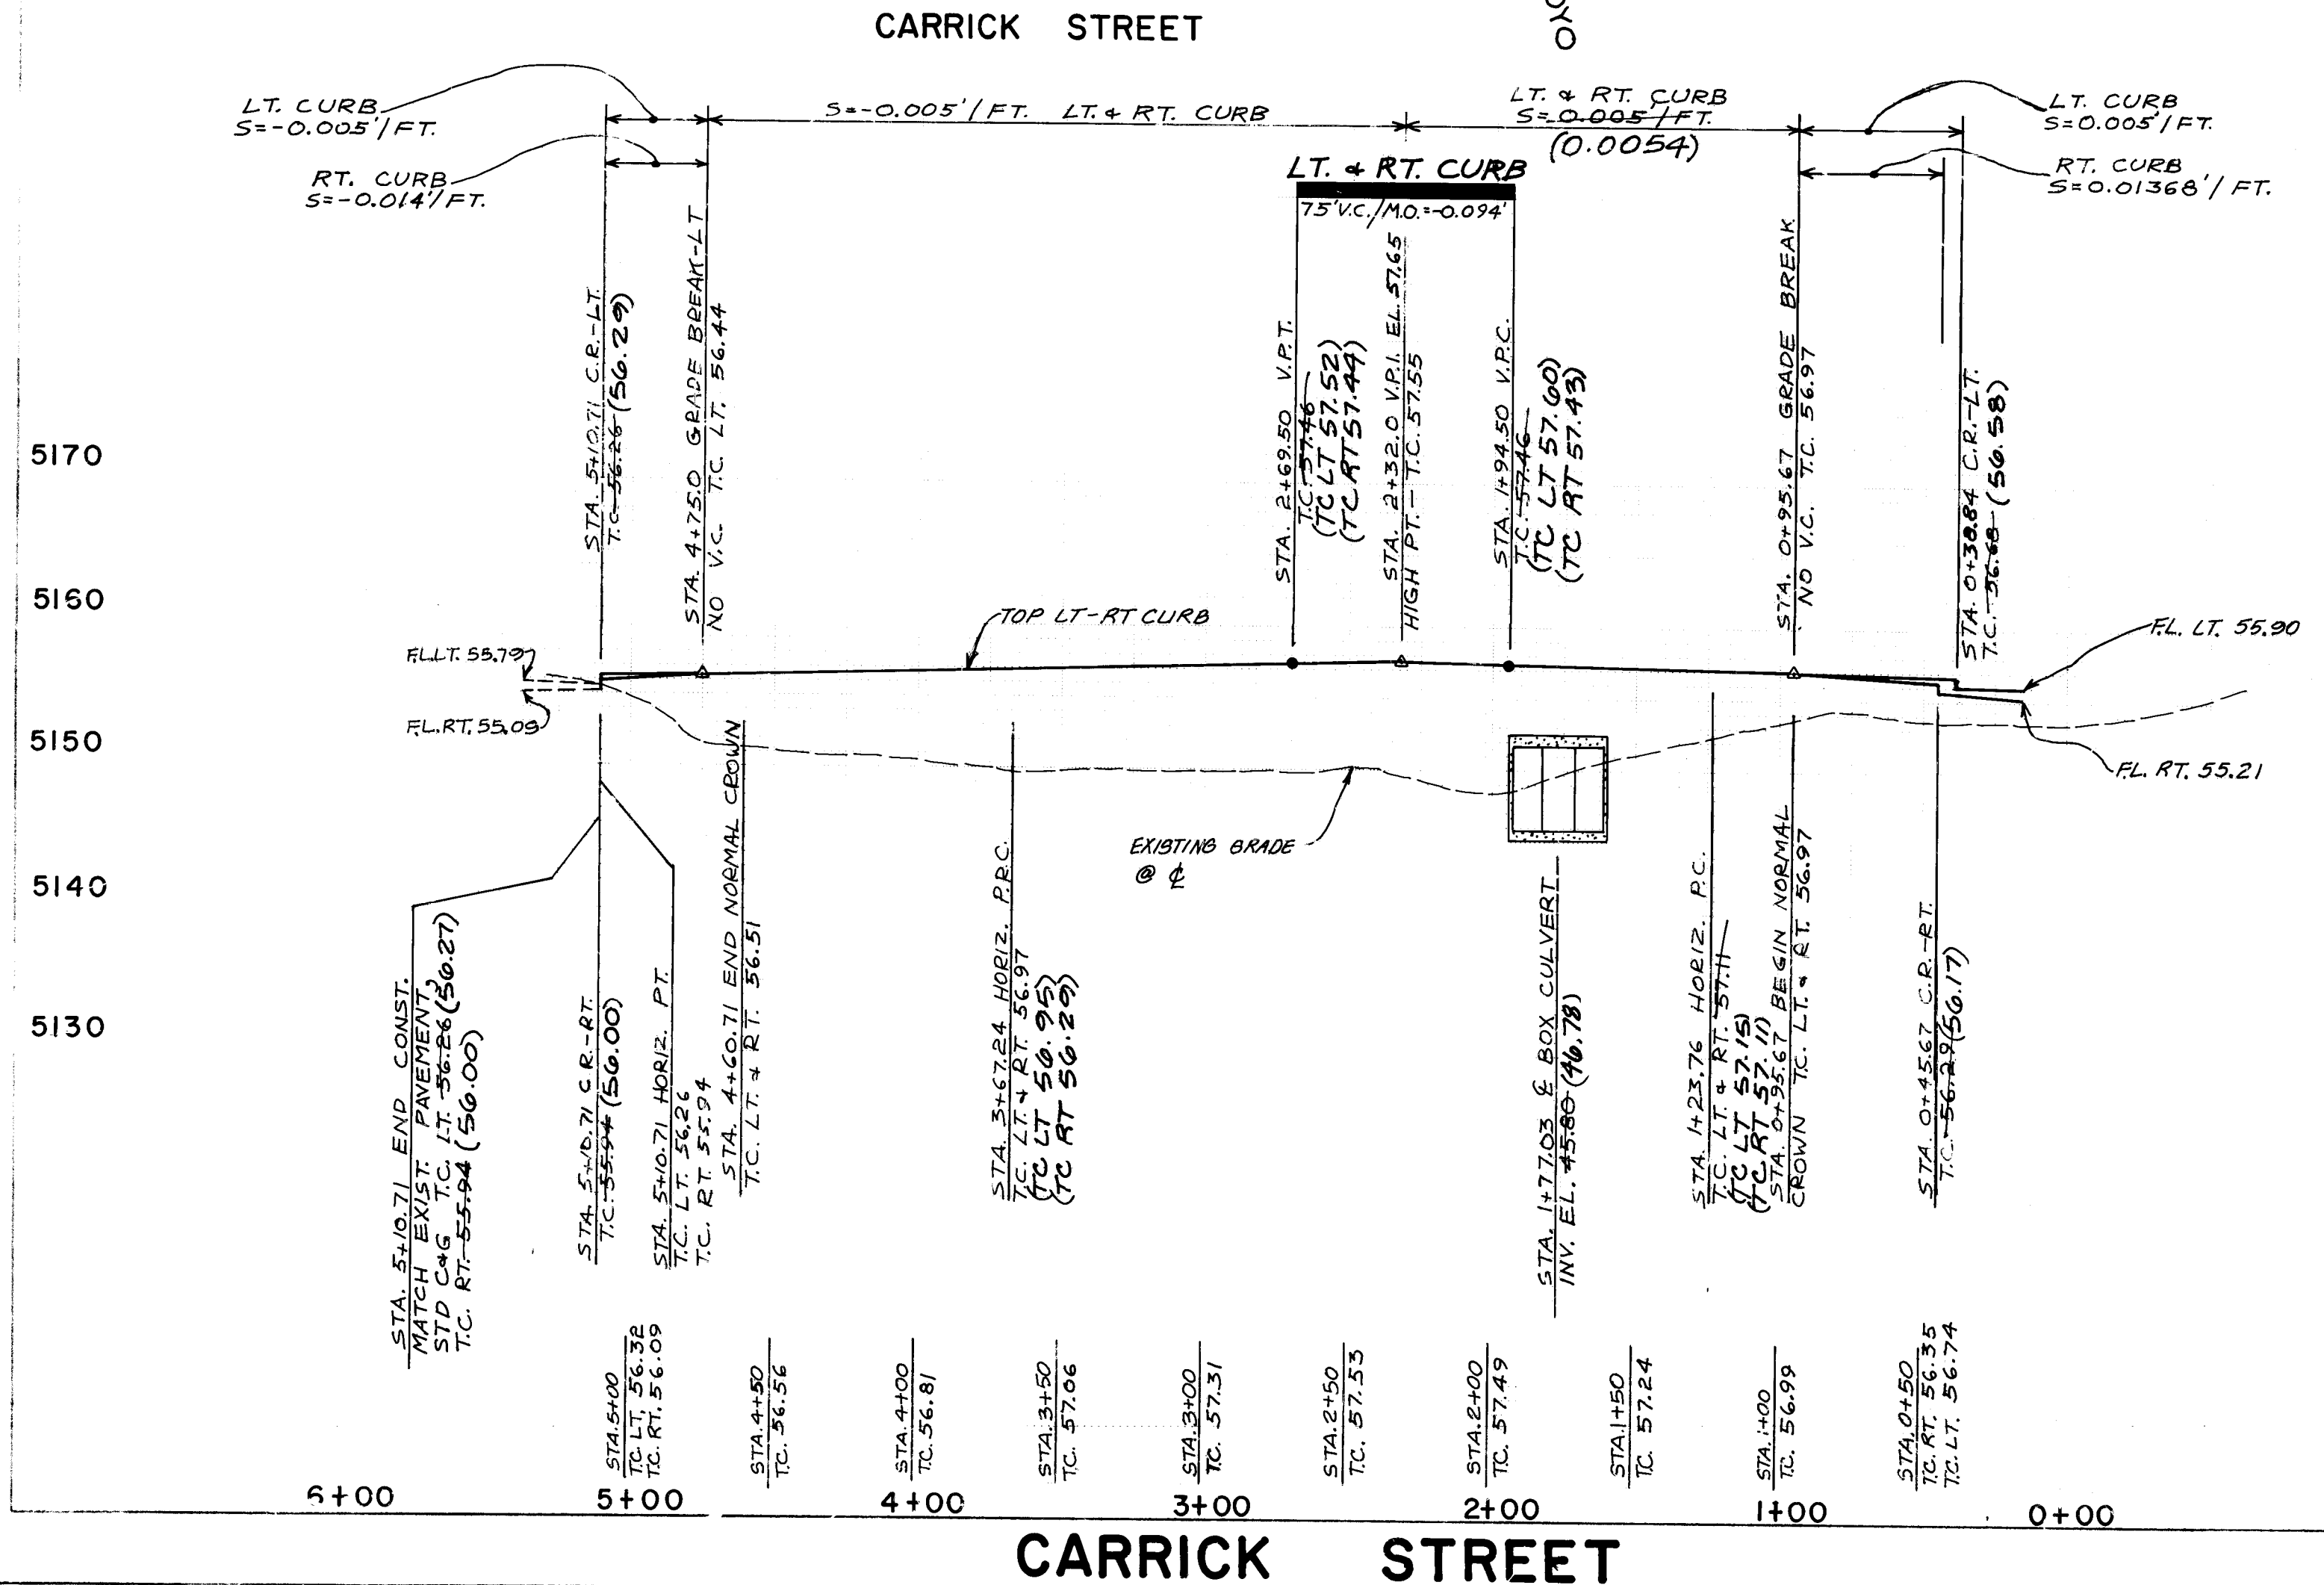

LEGEND	
SANITARY SEWER LINE	SAS
SANITARY SEWER MANHOLE	
SAS SERVICE CONNECTION	
WATER LINE	W
GATE VALVE	
FIRE HYDRANT	
REDUCER	
TEE	
BENDS	
WATER SERVICE CONNECTION	
CAPS & PLUGS	
CROSS	
SIDEWALK	
STANDARD CURB & GUTTER	
MOUNTABLE CURB & GUTTER	
RESIDENTIAL PAVING	
VALLEY GUTTER (CONC.)	
CROWN TRANSITION AREA	
WHEELCHAIR RAMP (CASE II)	
BARRICADE (TYPE III)	





26 2879/887

CITY OF ALBUQUERQUE
MUNICIPAL DEVELOPMENT DEPARTMENT
ENGINEERING DIVISION

TITLE: RINCON SUBDIVISION-PHASE I
CARRICK STREET
PAVING PLAN & PROFILE

APPROVALS	ENGINEER	DATE	APPROVALS	DATE
City Engineer	<i>[Signature]</i>	8/14/86	Liquid Waste	N/A WJW 7/29/86
A.C.E. Design	<i>[Signature]</i>	8/5/86	Traffic	N/A WJW 7/29/86
A.C.E. Hydrology	<i>[Signature]</i>	8/5/86	Water	N/A WJW 7/29/86

DRAWING NO. 2879 MAP NO. E-10 & F-10 SHEET 18 OF 36

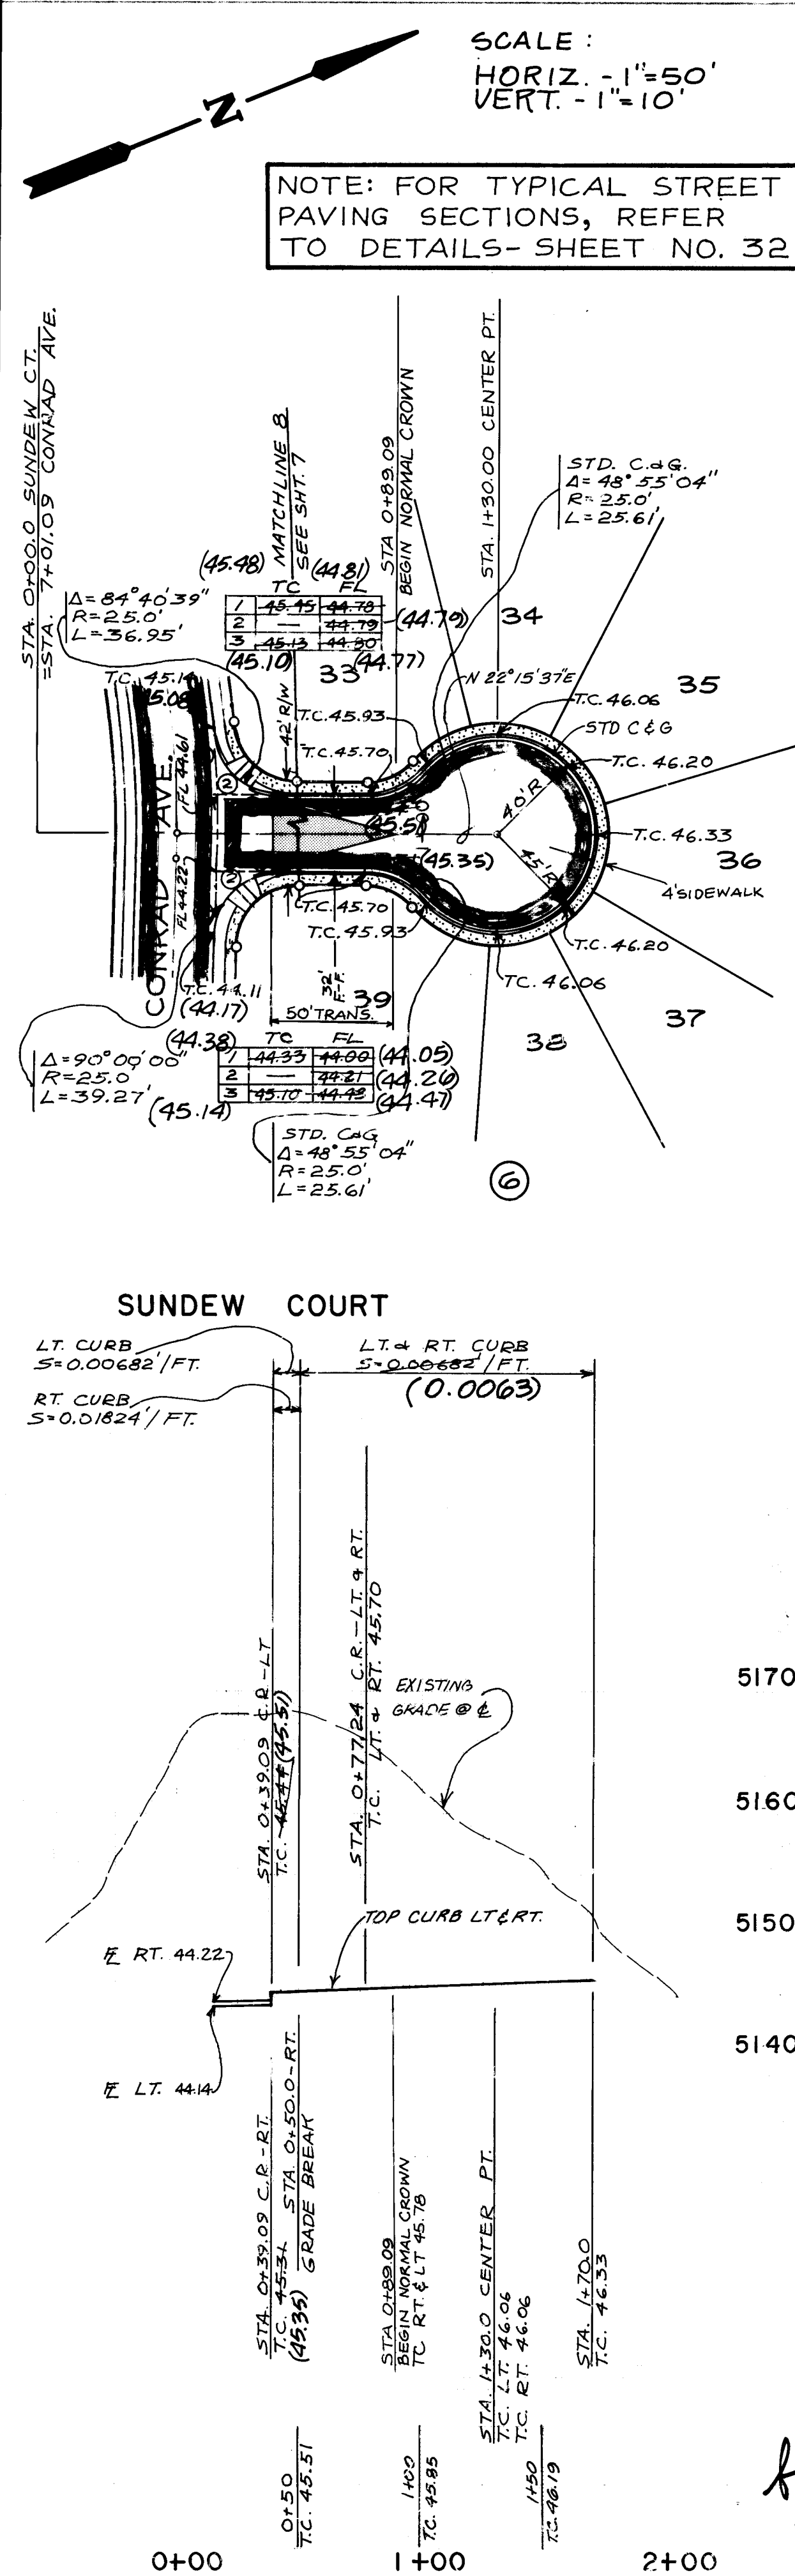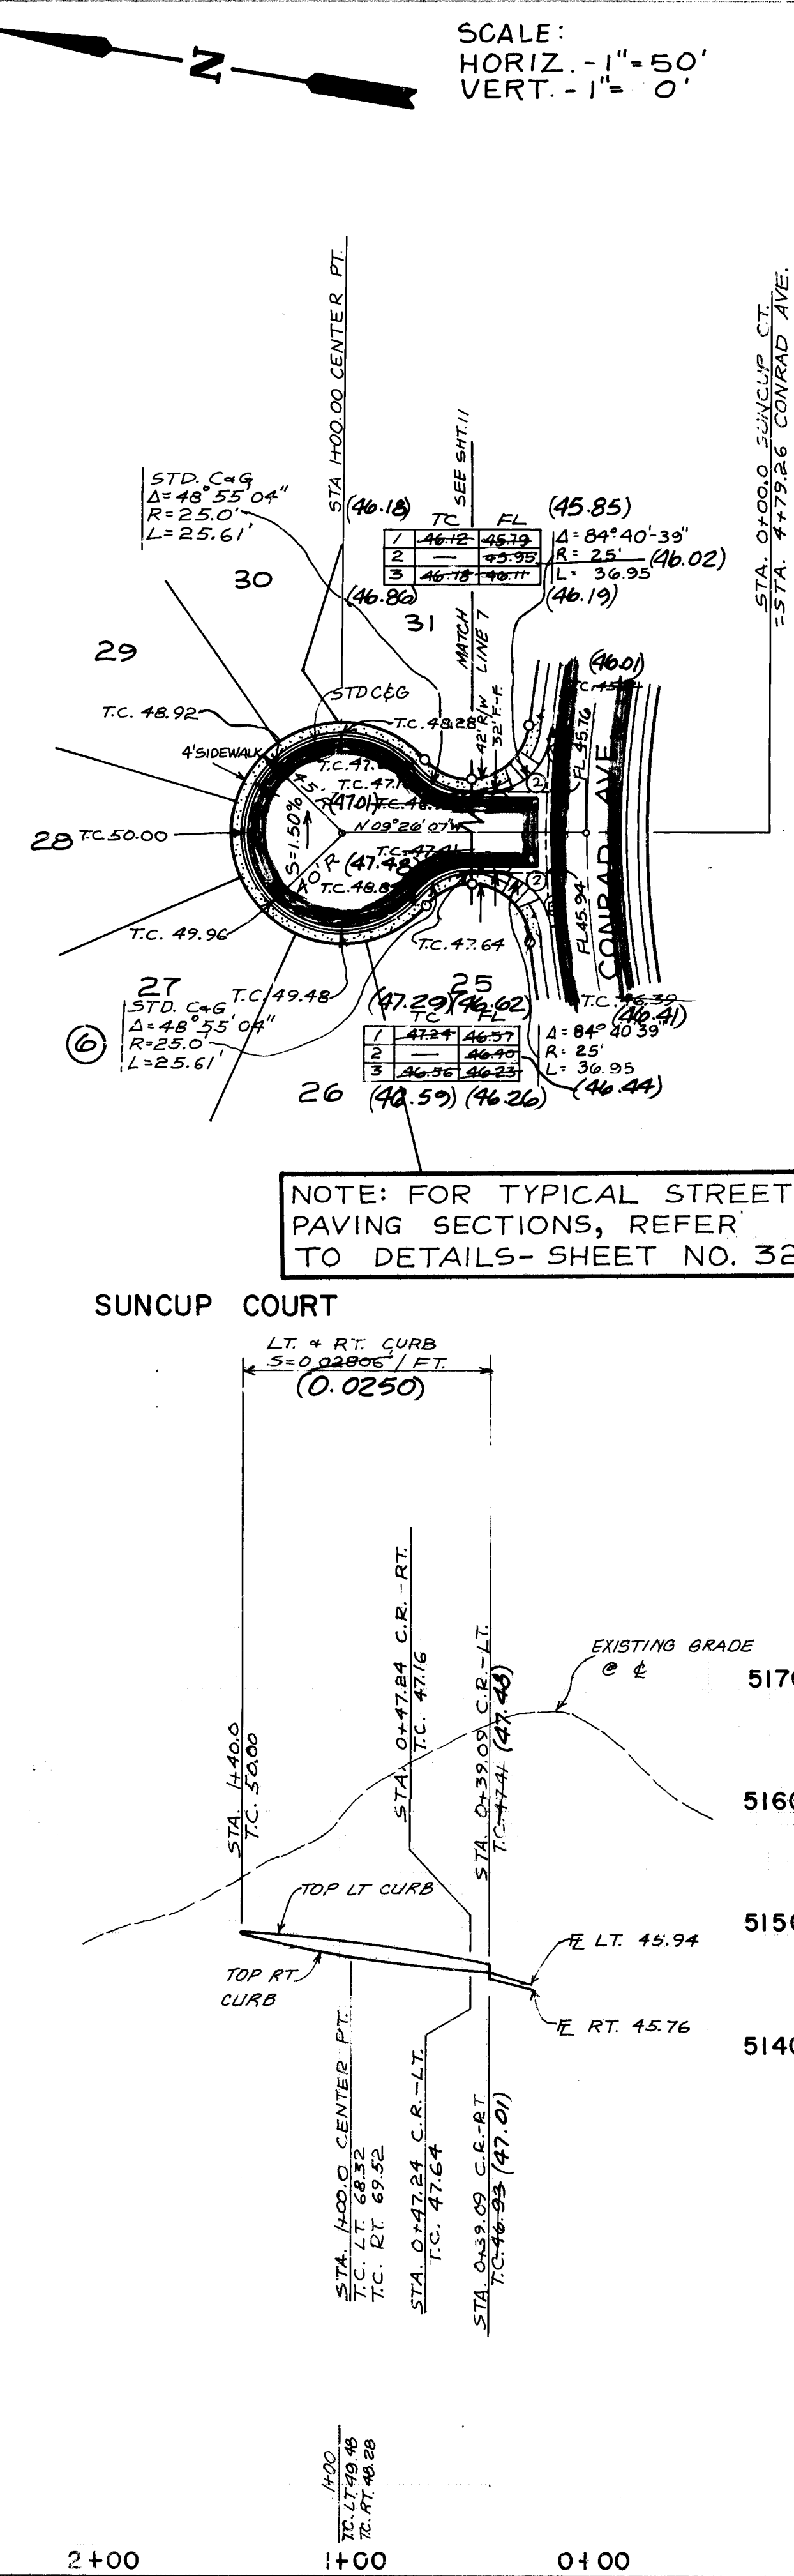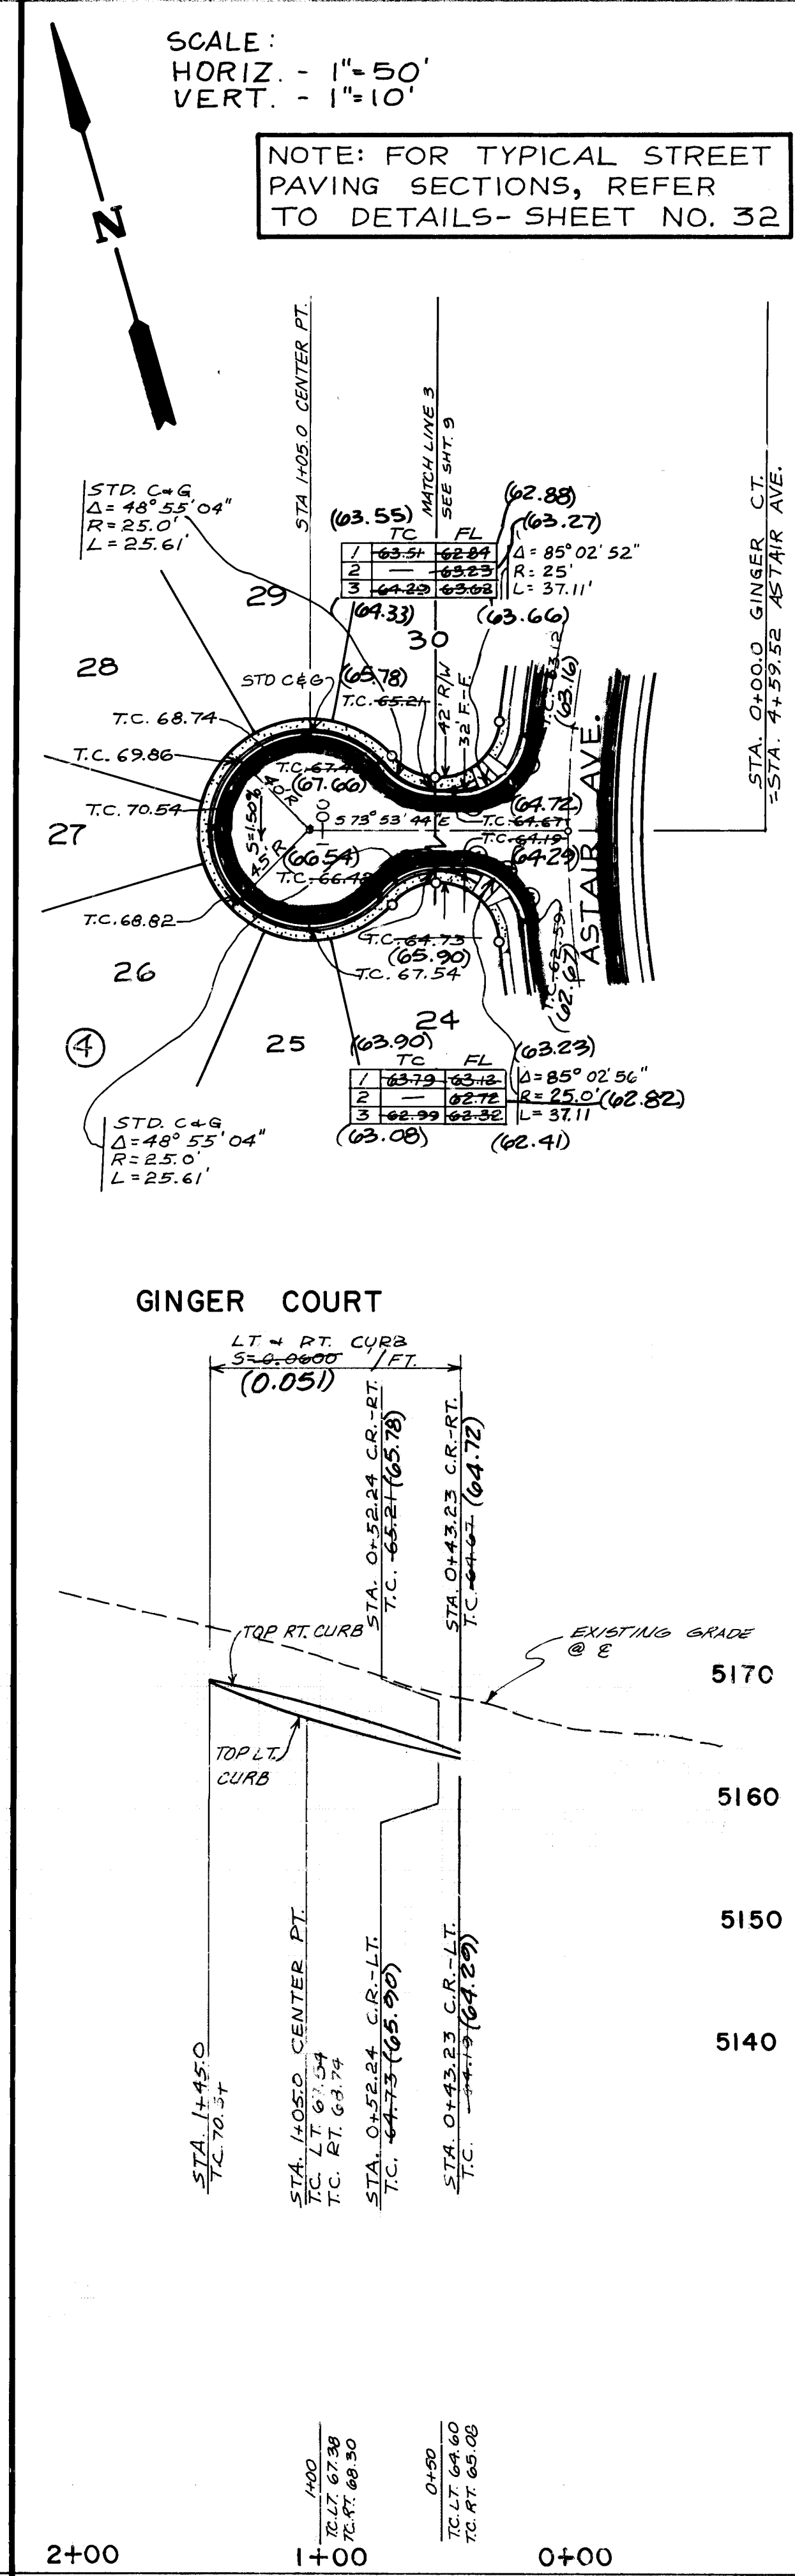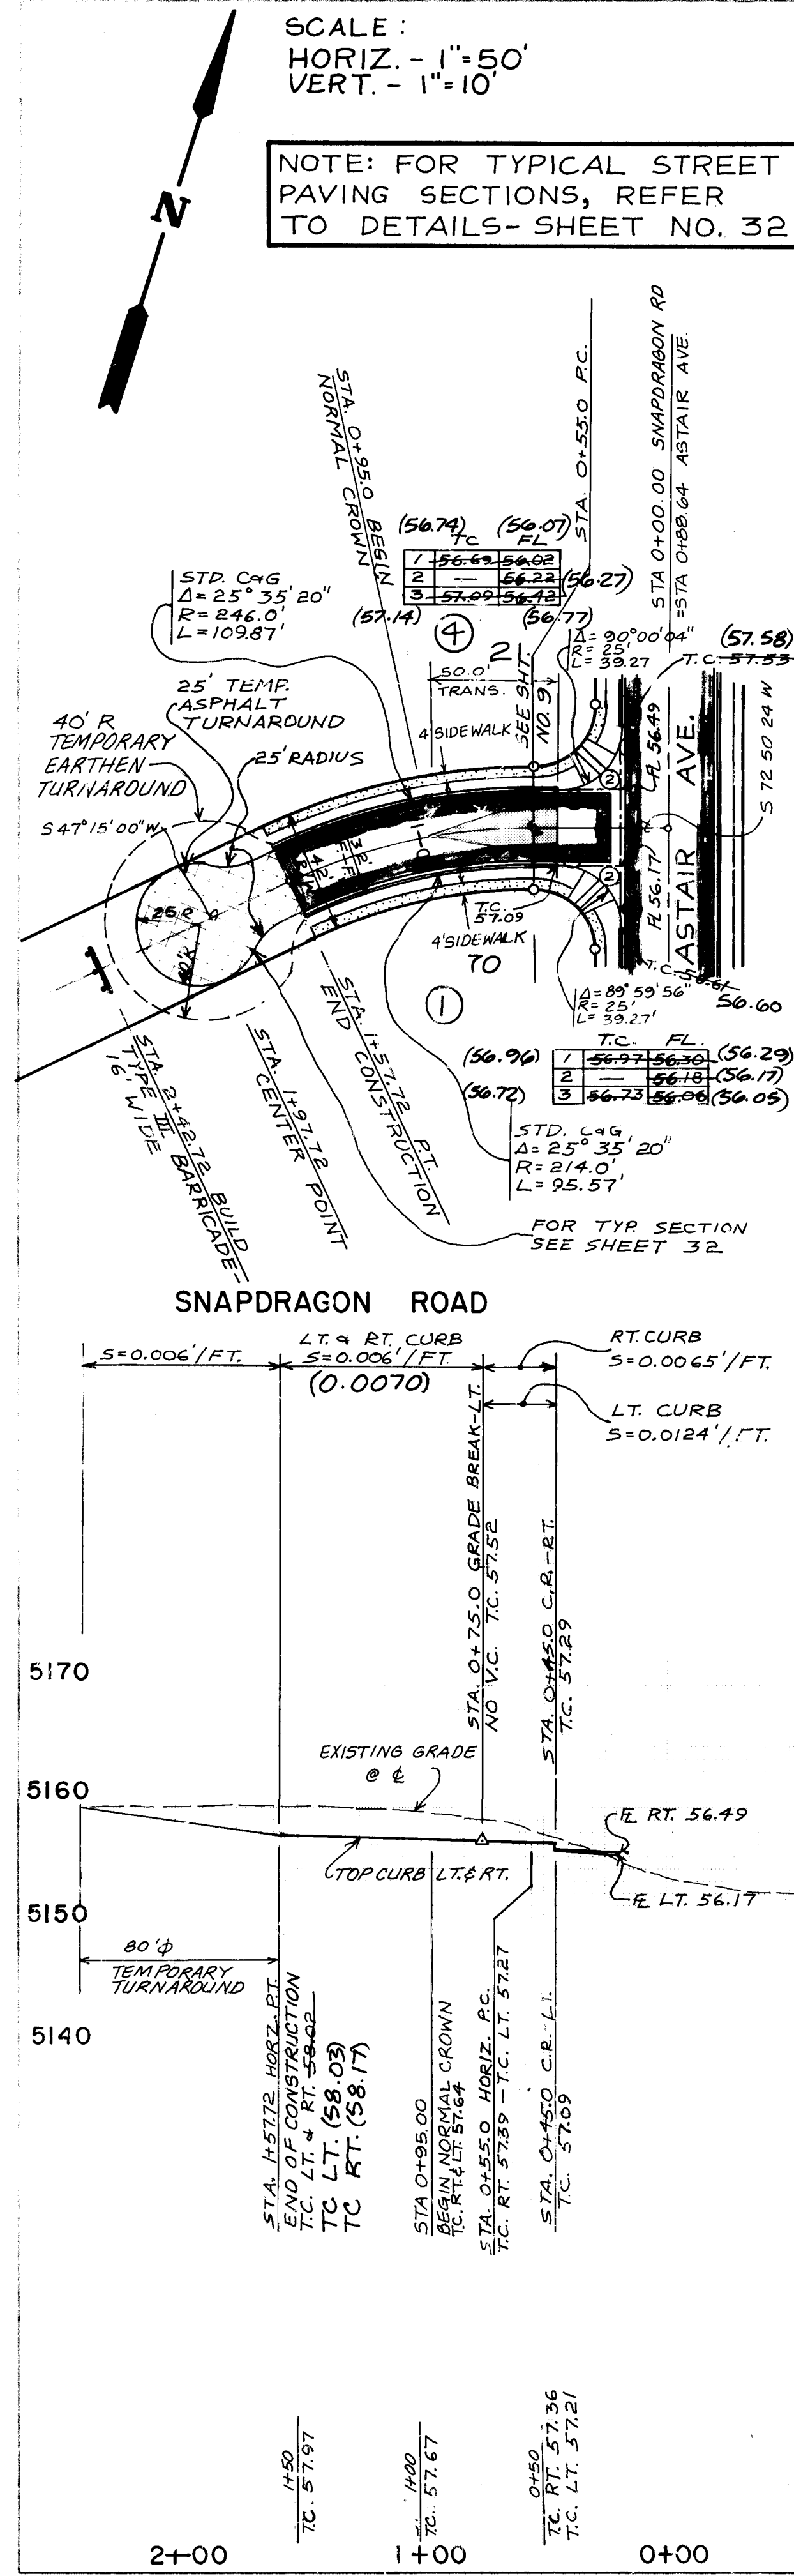

NOTE: FOR TYPICAL R.O.W. FL. TO FL. DIMENSIONS & CONSTRUCTION GEOMETRY SEE C.O.A. STD. DRWG. T-9, CASE III.

PAVING NOTES

- ALL STATIONING IS BASED ON CENTERLINE OF STREET.
- THE FOLLOWING CITY OF ALBUQUERQUE STANDARD DETAIL DRAWINGS ARE APPLICABLE:

P-8	T-9 (Case III)
P-9	K-16
P-11	K-20
P-13 (offset type)	K-21
P-17	
P-18	

CONTROL: BENCH MARK A.C.S. "16-E10", A CHISLED ON TOP OF CONCRETE CURB AT THE N.E. CURB RETURN AT THE INTERSECTION OF ATRISCO ROAD N.W. AND: FLOR DEL SOL PLACE N.W.

M.S.L. ELEVATION = 5134.777'

26 2879 1987



LEGEND	
SANITARY SEWER LINE	SAS
SANITARY SEWER MANHOLE	
SAS SERVICE CONNECTION	
WATER LINE	
GATE VALVE	
FIRE HYDRANT	
REDUCER	
TEE	
BENDS	
WATER SERVICE CONNECTION	
CAPS & PLUGS	
CROSS	
SIDEWALK	
STANDARD CURB & GUTTER	
MOUNTABLE CURB & GUTTER	
RESIDENTIAL PAVING	
VALLEY GUTTER (CONC.)	
CROWN TRANSITION AREA	
WHEELCHAIR RAMP (CASE II)	
BARRICADE (TYPE III)	

CITY OF ALBUQUERQUE
MUNICIPAL DEVELOPMENT DEPARTMENT
ENGINEERING DIVISION

TITLE: RINCON SUBDIVISION - PHASE I
SNAPDRAGON RD., GINGER CT., SUNCUP CT., & SUNDEW CT. PAVING PLAN & PROFILE

APPROVALS	DATE	APPROVALS	DATE
City Engineer	8/14/86	Engineer	7/27/86
A.C.E. Design	8/5/86	Liquid Waste	7/31/86
A.C.E. Hydrology	8/5/86	Water	7/29/86

DRAWING NO. 2879 MAP NO. E-10 & F-10 SHEET 19 OF 36

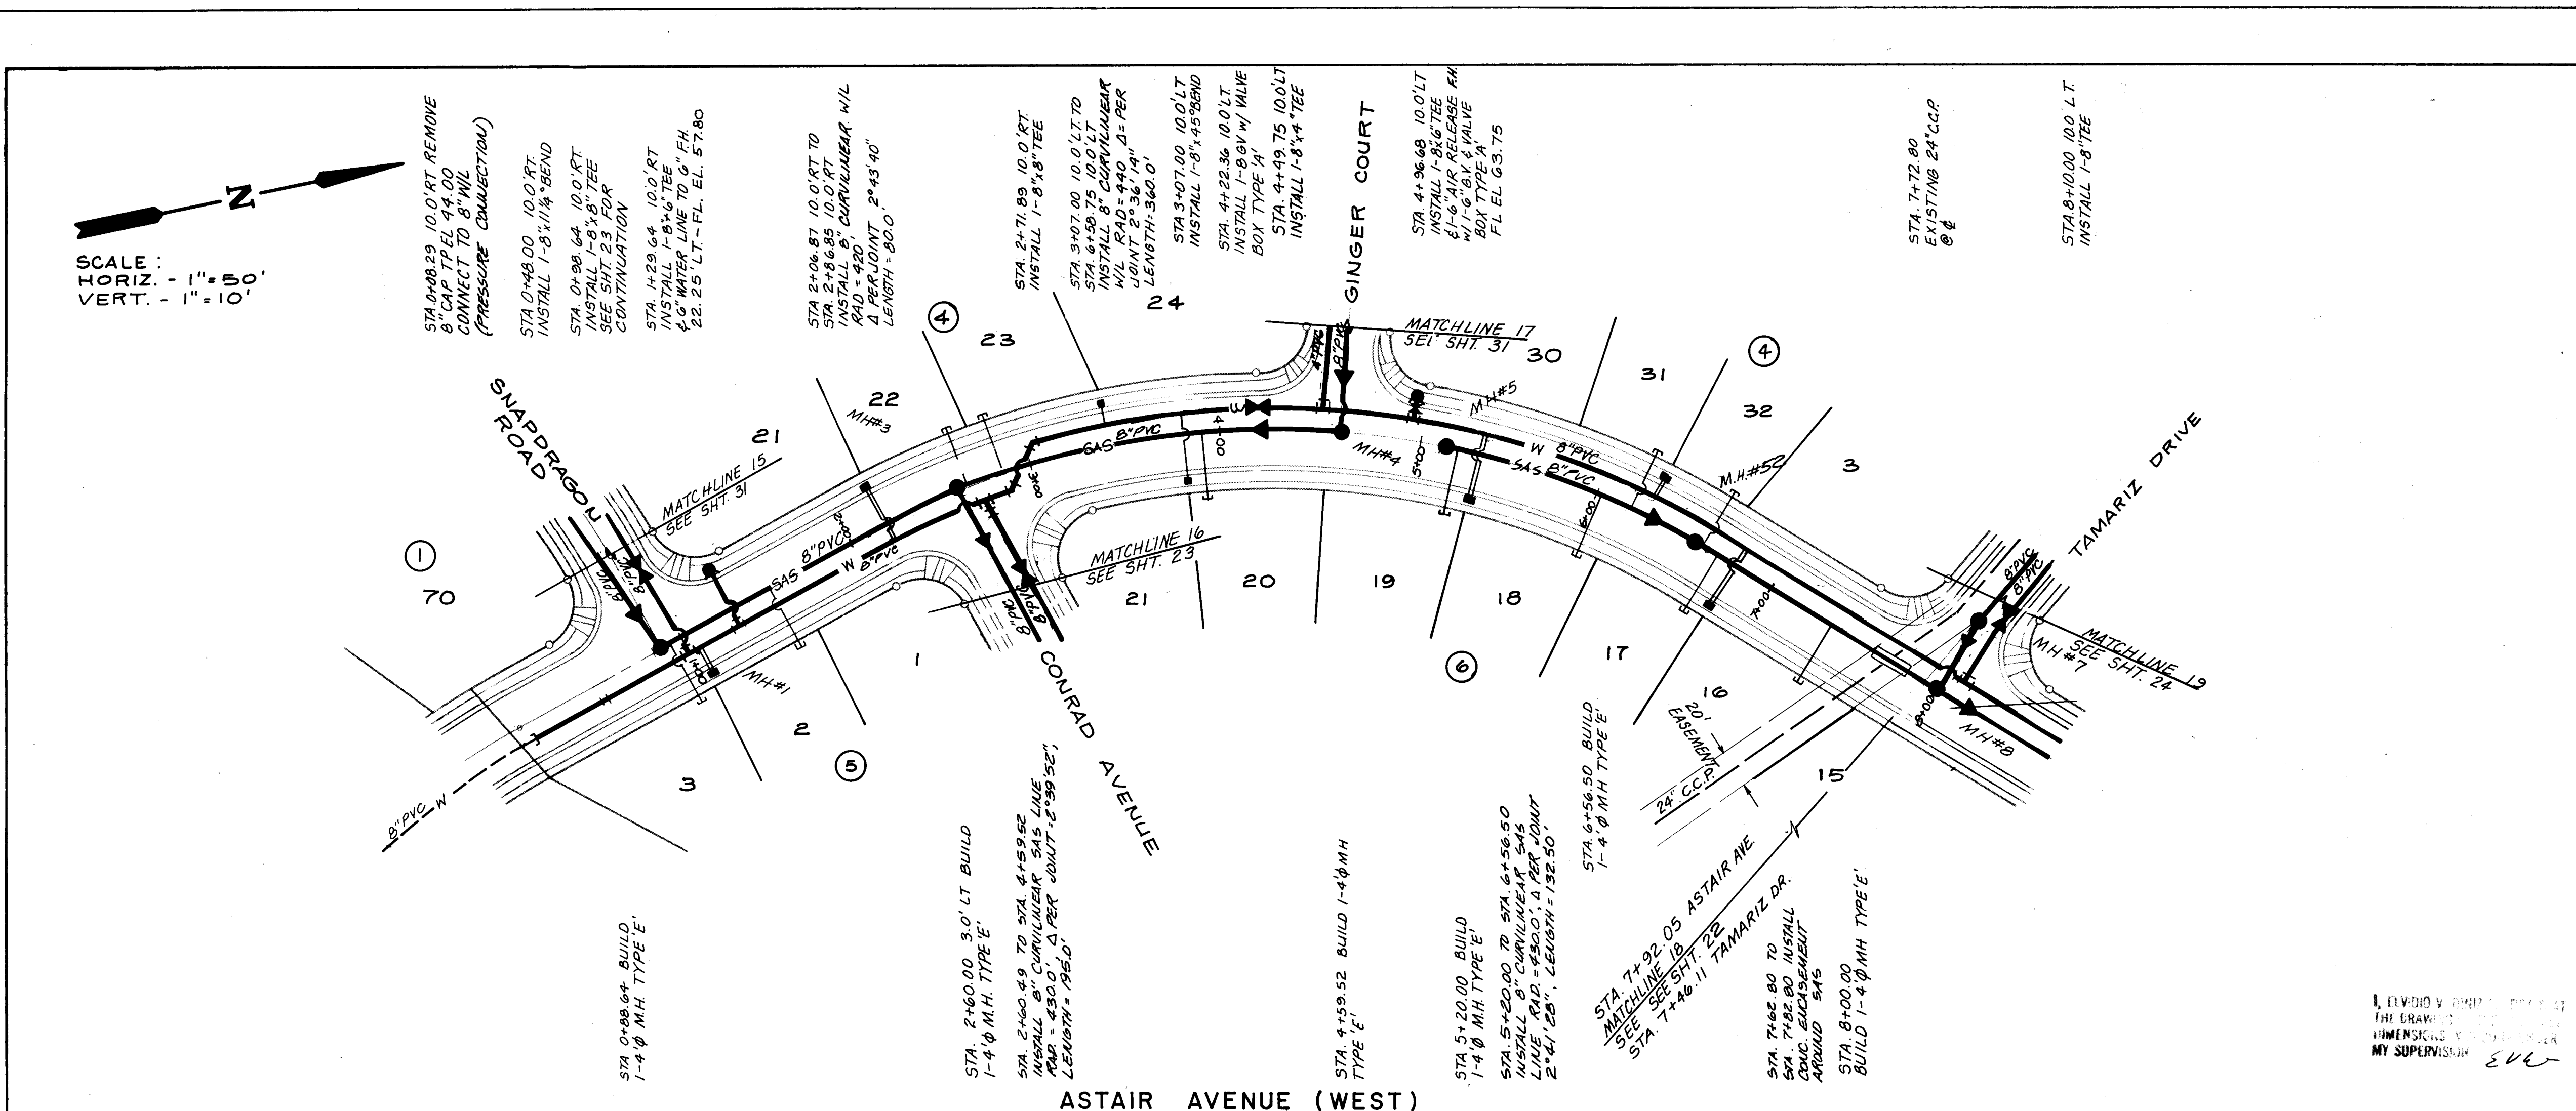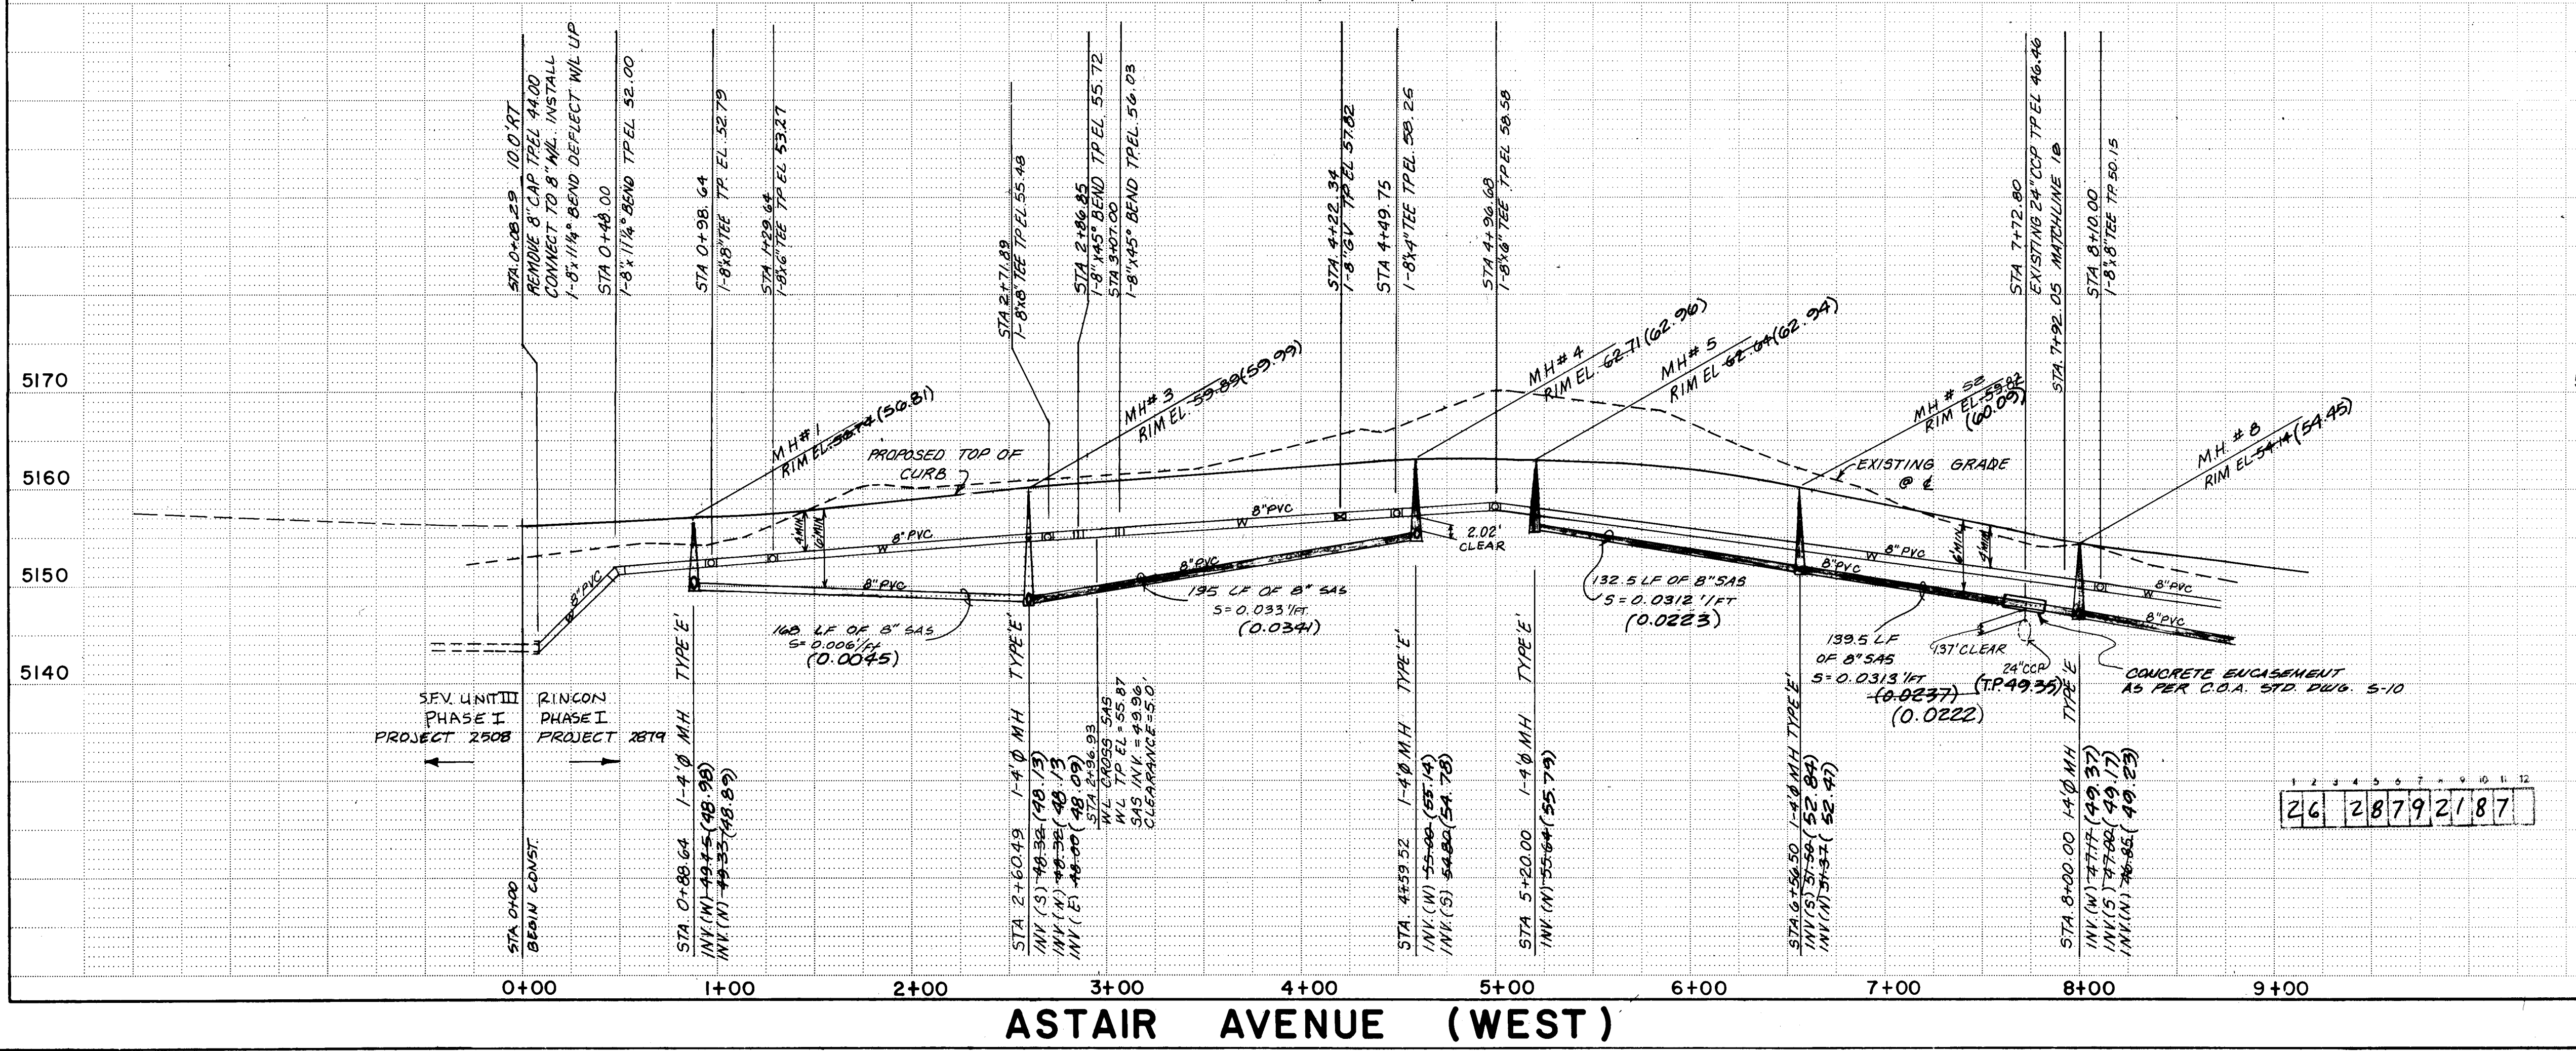

AS BUILT INFORMATION

Lot No.	Center Line Station	Service	Invert Elev. at P.L.
21 & 22	2+50.85	WATER	54.78
21 & 22	2+50.85	SAS	55.75
23	2+97.24	SAS	56.02
23	2+97.24	WATER	57.50
32 & 31	6+17.30	SAS	57.85
6+30.04	6+27.30	WATER	57.42
6+58.18	6+58.18	SAS	56.17

AS BUILT INFORMATION

Lot No.	Center Line Station	Service	Invert Elev. at P.L.
2 & 3	0+99.14	SAS	53.14
1+08.75	1+04.14	WATER	53.25
1+57.84	1+54.14	SAS	54.17

AS BUILT INFORMATION

Lot No.	Center Line Station	Service	Invert Elev. at P.L.
20 & 21	3+88.30	WATER	58.19
3+99.21	3+91.50	SAS	58.23
18 & 19	5+25.00	SAS	59.07
5+36.73	5+36.00	WATER	59.00
6+03.50	6+03.50	SAS	58.05
16 & 17	6+67.50	SAS	55.85
6+77.50	6+77.50	WATER	55.43
7+36.50	7+36.50	SAS	53.00

UTILITY NOTES

- THE STATIONING IS BASED ON CENTERLINE OF STREET.
- THE FOLLOWING CITY OF ALBUQUERQUE STANDARD DETAIL DRAWINGS ARE APPLICABLE:

S-2	W-2
S-5	W-4
S-6	W-7
S-8	W-8
S-9	W-10
S-10	W-14
S-12	W-15 (Case I)
	W-16
	W-18
	W-20
	W-22
	W-23

LEGEND

SANITARY SEWER LINE	SAS
SANITARY SEWER MANHOLE	
SAS SERVICE CONNECTION	
WATER LINE	W
GATE VALVE	
FIRE HYDRANT	
REDUCER	
TEE	
BENDS	
WATER SERVICE CONNECTION	
CAPS & PLUGS	
CROSS	
SIDEWALK	
STANDARD CURB & GUTTER	
MOUNTABLE CURB & GUTTER	
RESIDENTIAL PAVING	
VALLEY GUTTER (CONC.)	
CROWN TRANSITION AREA	
WHEELCHAIR RAMP (CASE II)	
BARRICADE (TYPE III)	

CITY OF ALBUQUERQUE
MUNICIPAL DEVELOPMENT DEPARTMENT
ENGINEERING DIVISION


TITLE: RINCON SUBDIVISION—PHASE I
ASTAIR AVENUE (WEST)
UTILITIES PLAN & PROFILE

APPROVALS	ENGINEER	DATE	APPROVALS	ENGINEER	DATE
City Engineer	John H. [Signature]	2/14/06	Liquid Waste	John H. [Signature]	7/27/06
A.C.E. - Design	John H. [Signature]	2/14/06	Traffic	John H. [Signature]	7/27/06
Hydrology	John H. [Signature]	2/14/06	Water	John H. [Signature]	7/27/06

DRAWING NO. 2879

MAP NO. E-10 & F-10

SHEET 21 OF 36

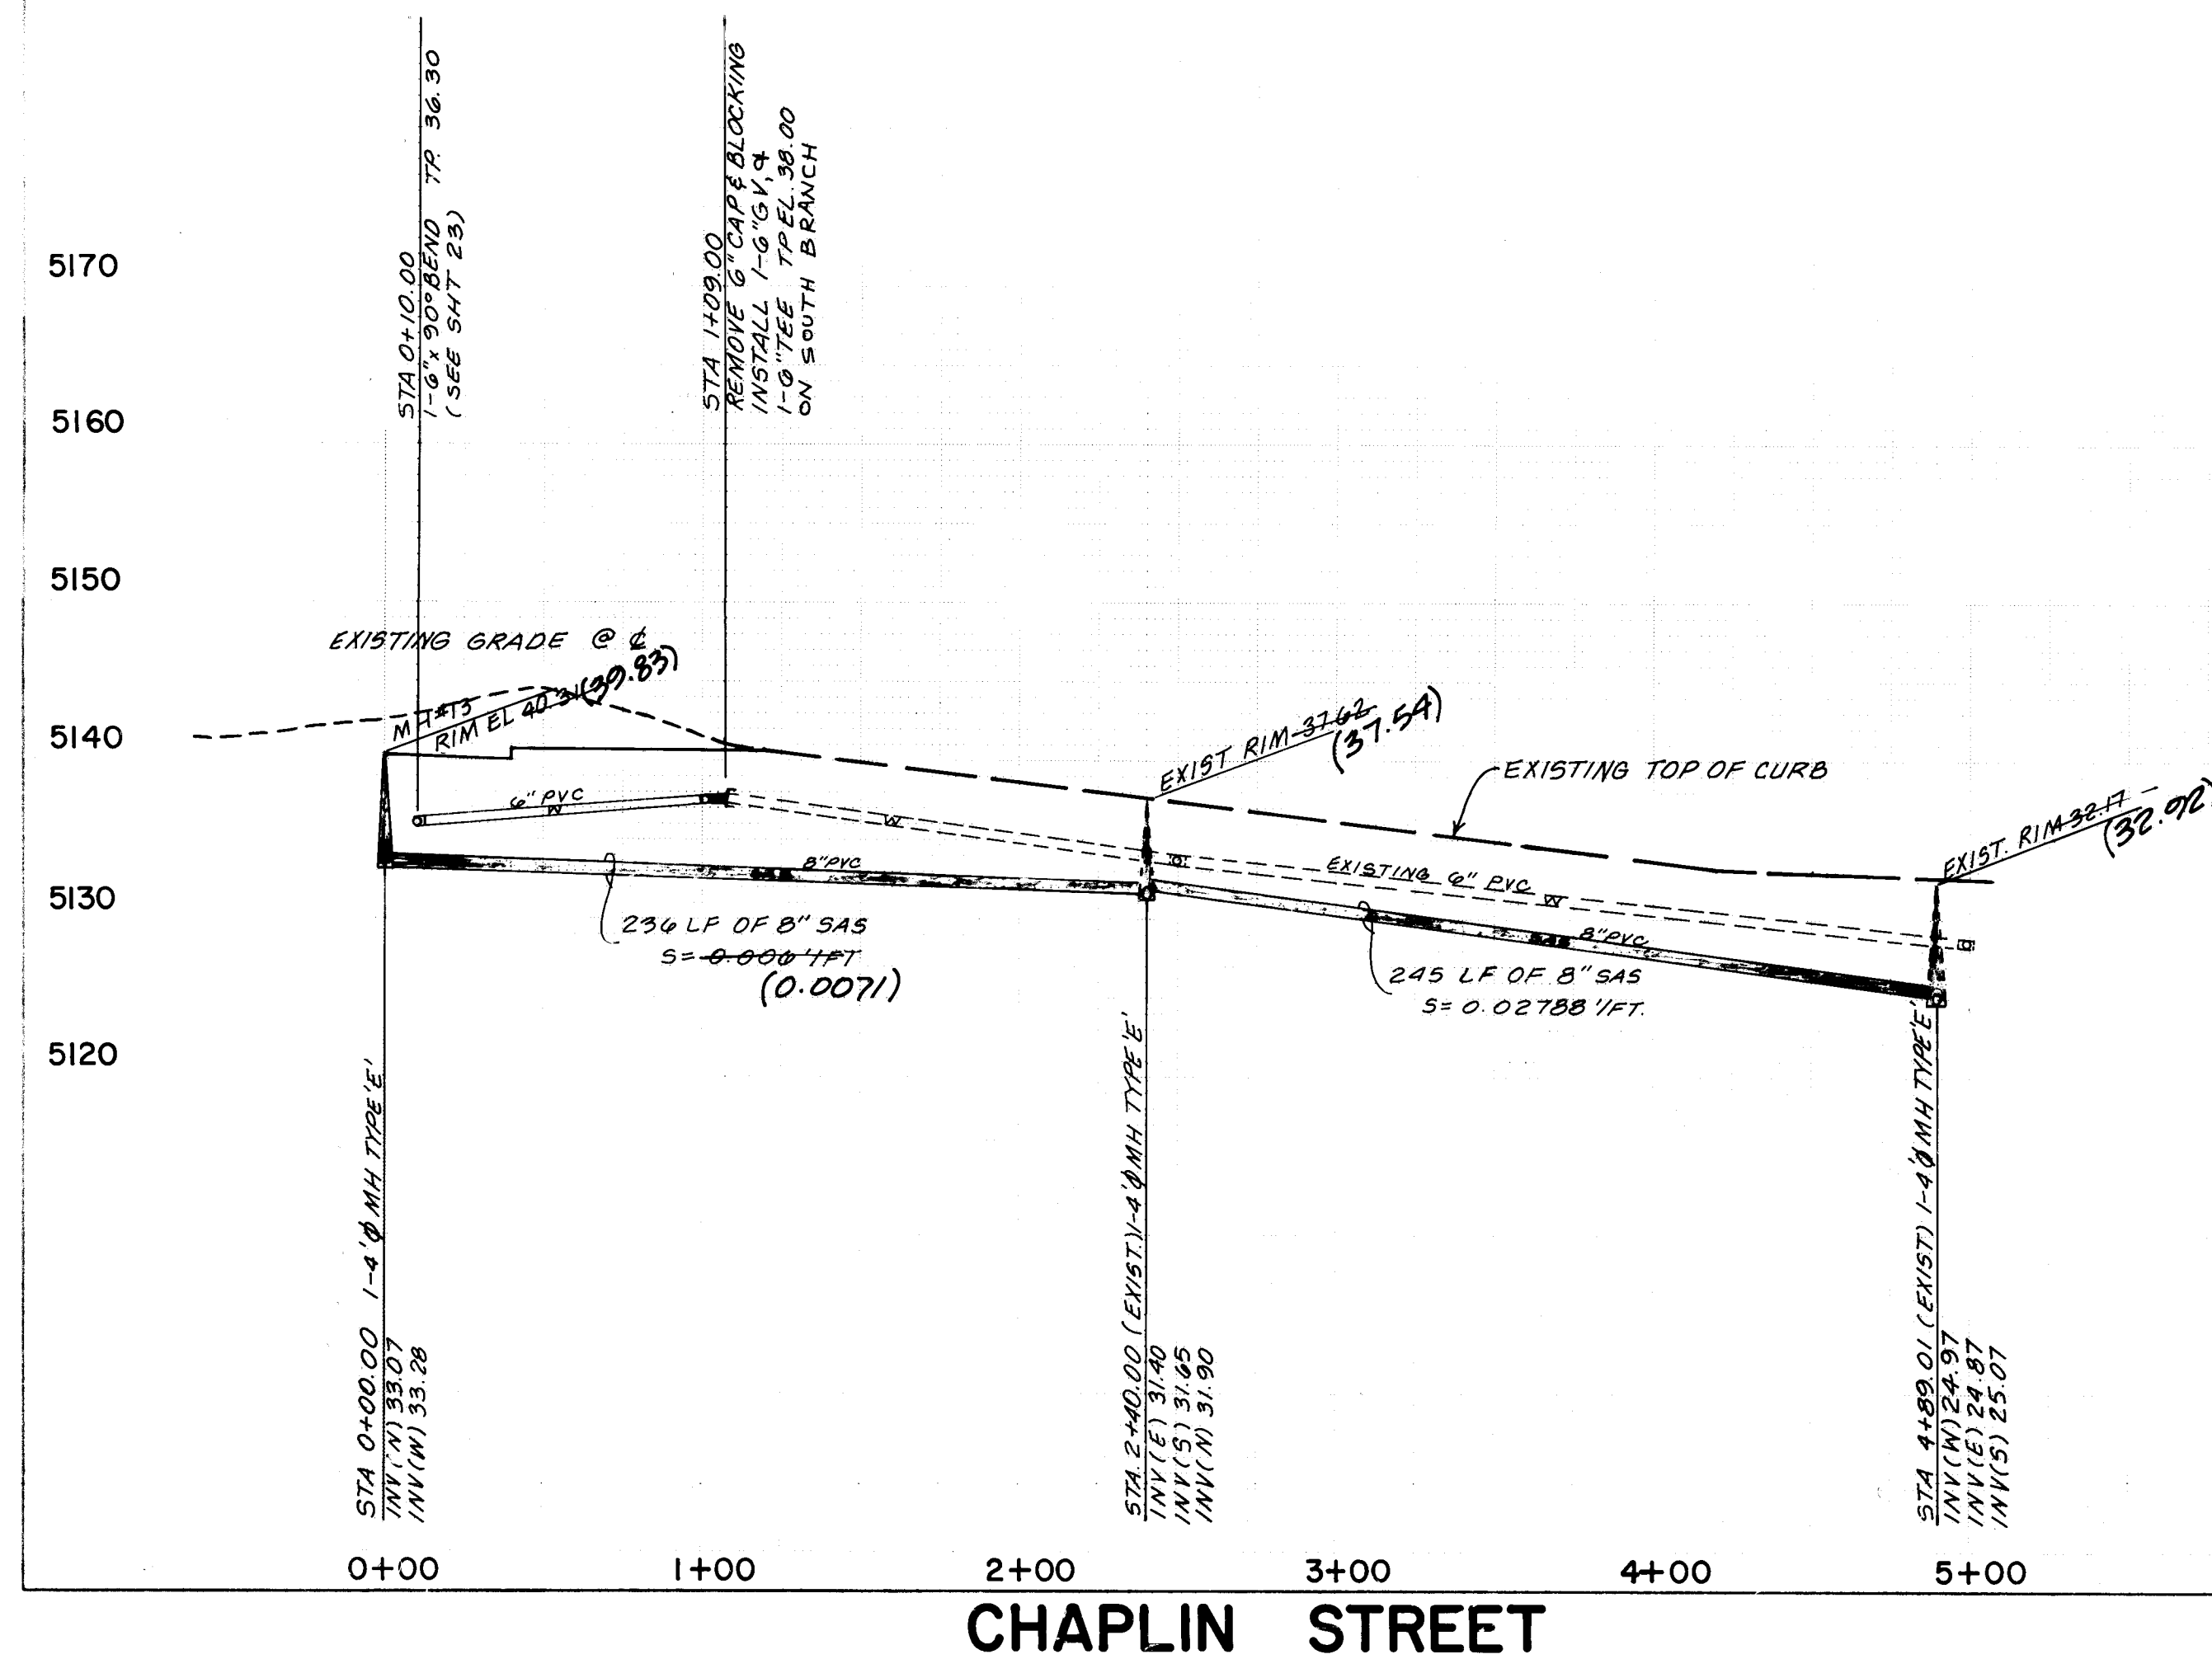

I, ELWOOD V. GONZ CERTIFY THAT
THE DRAWING OF THE "AS BUILT"
DIMENSIONS WAS DONE UNDER
MY SUPERVISION. *EW*

UTILITY NOTES



1. THE STATIONING IS BASED ON CENTERLINE OF STREET.

2. THE FOLLOWING CITY OF ALBUQUERQUE STANDARD DETAIL DRAWINGS ARE APPLICABLE:

S- 2	W- 2
S- 5	W- 4
S- 6	W- 7
S- 8	W- 8
S- 9	W-10
S-10	W-14
S-12	W-15(Case 1)
	W-16
	W-18
	W-20
	W-22
	W-23

1	2	3	4	5	6	7	8	9	10	11	12
26			28	79	23	87	4				

CITY OF ALBUQUERQUE			
MUNICIPAL DEVELOPMENT DEPARTMENT			
ENGINEERING DIVISION			
TITLE: RINCON SUBDIVISION--PHASE I			
CHAPLIN STREET UTILITIES			
PLAN AND PROFILE			
APPROVALS	ENGINEER	DATE	APPROVALS
City Engineer	<i>[Signature]</i>	8/14/86	Liquid Waste
A/C-Design	<i>[Signature]</i>	8/15/86	Traffic
A/C-Hydrology	<i>[Signature]</i>	"	Water
			APPROVALS
			ENGINEER
			DATE
			<i>[Signature]</i>
			7/29/86
			7/21/86
			7/27/86
DRAWING NO.	2879	MAP NO.	E-10 F10
		SHEET	23A
		OF	36

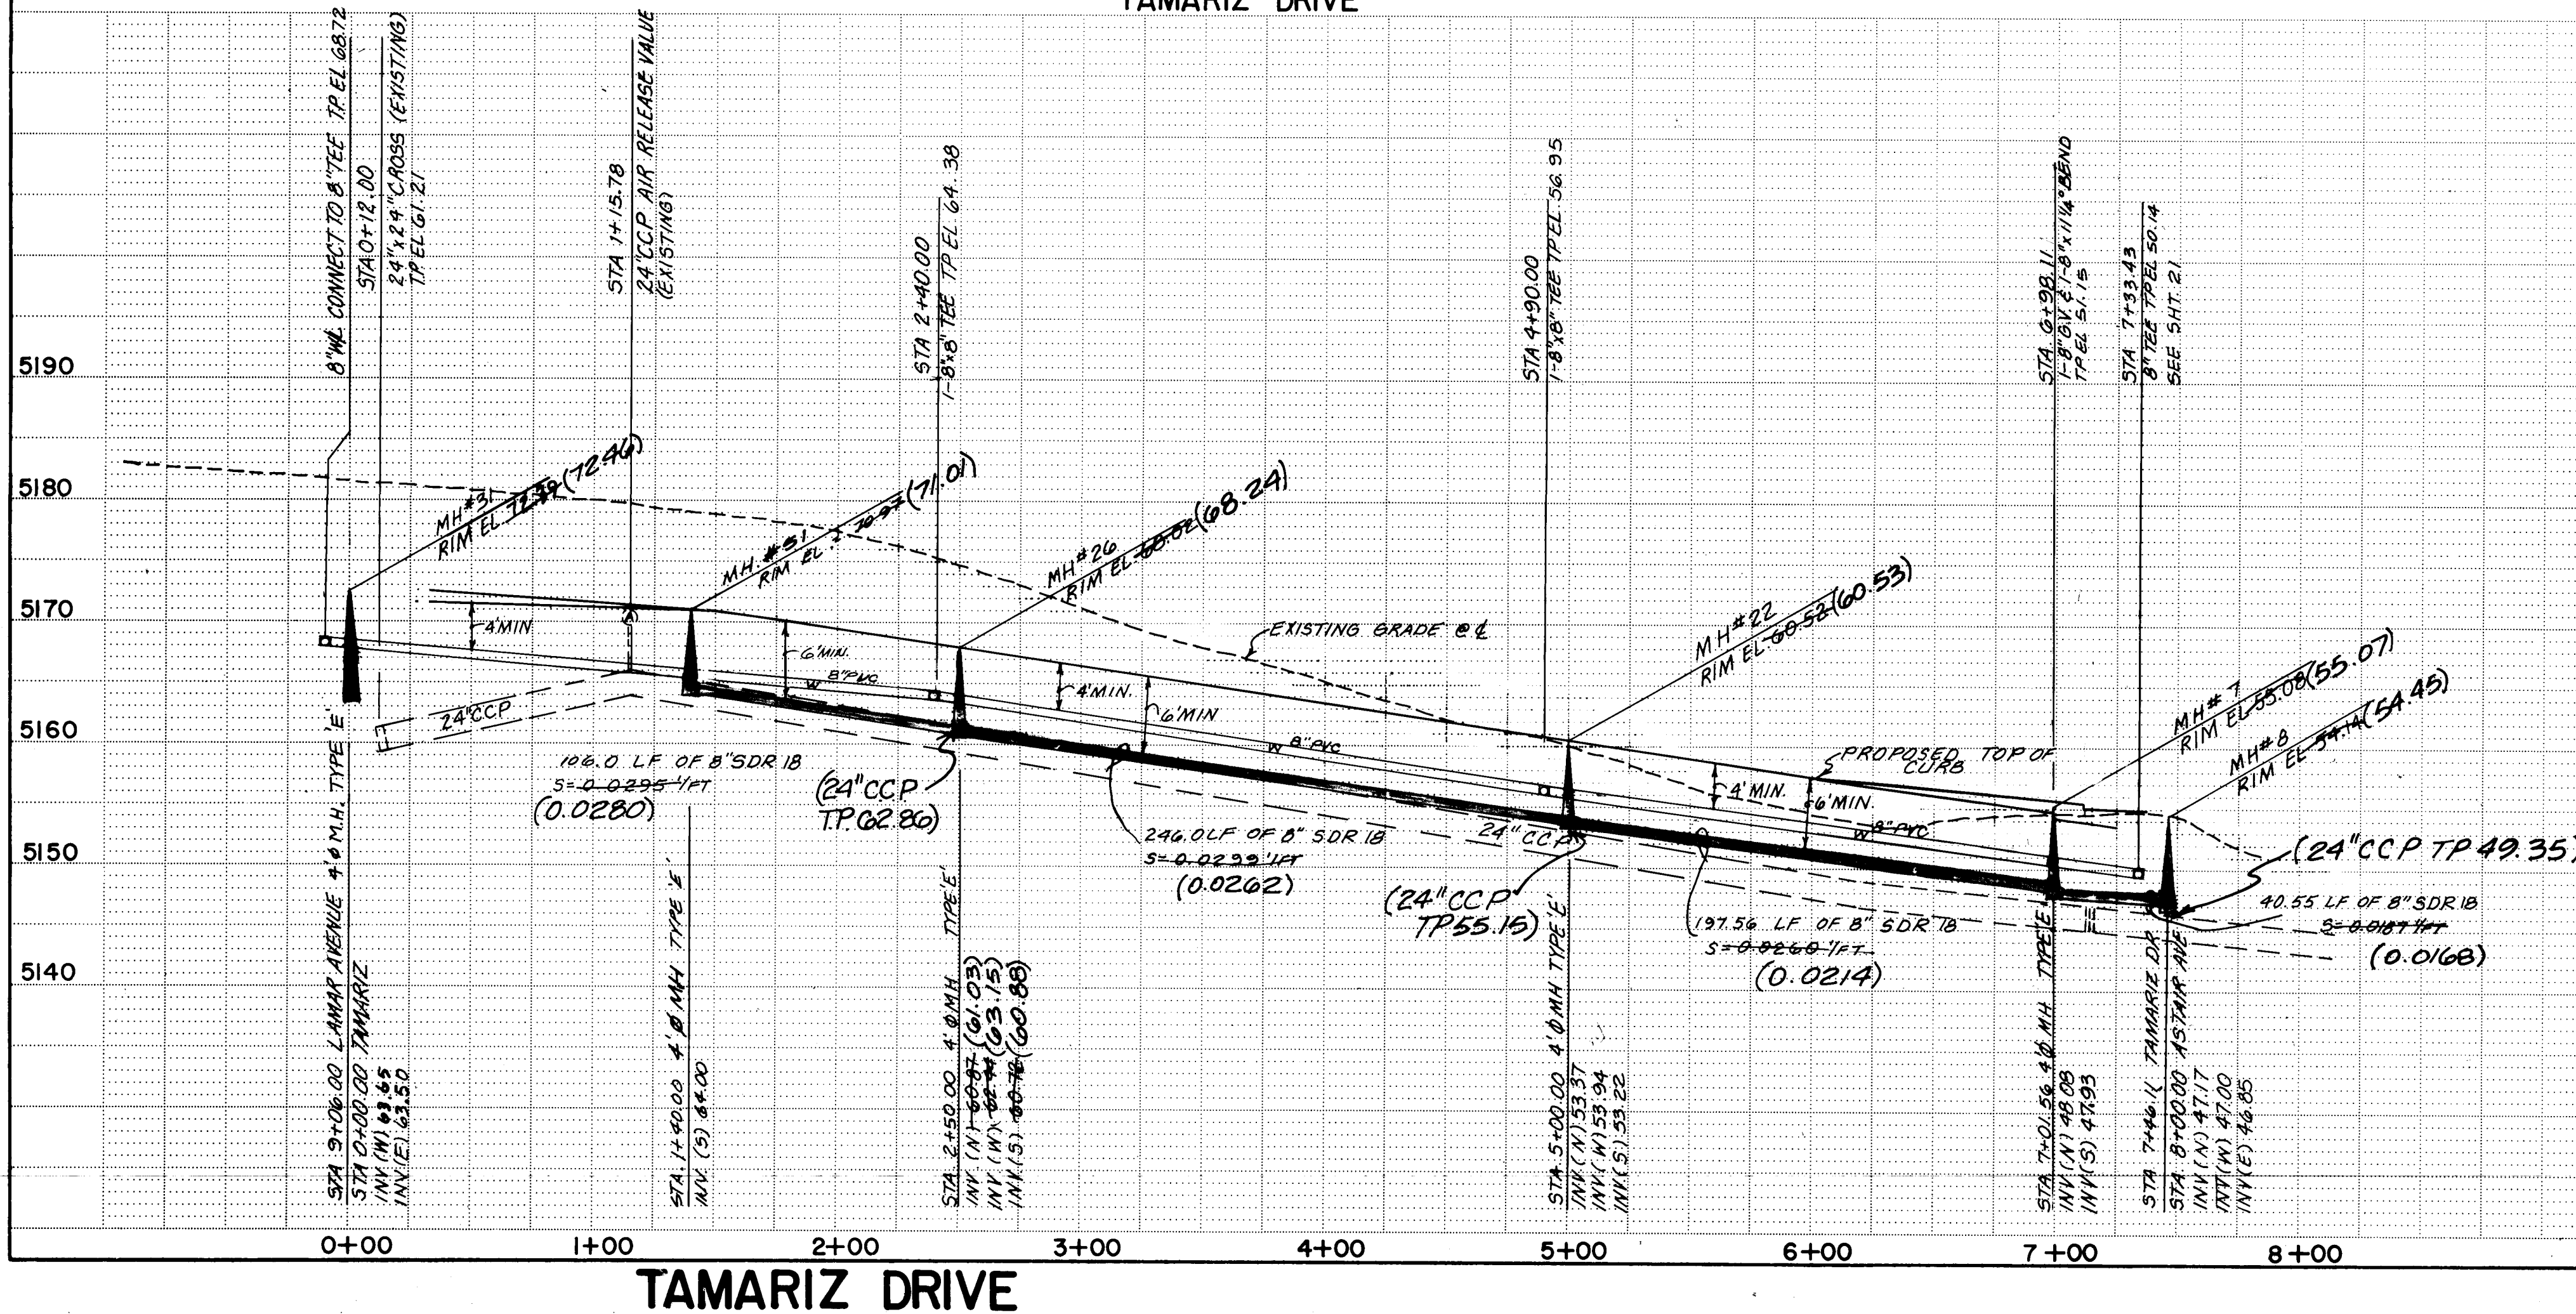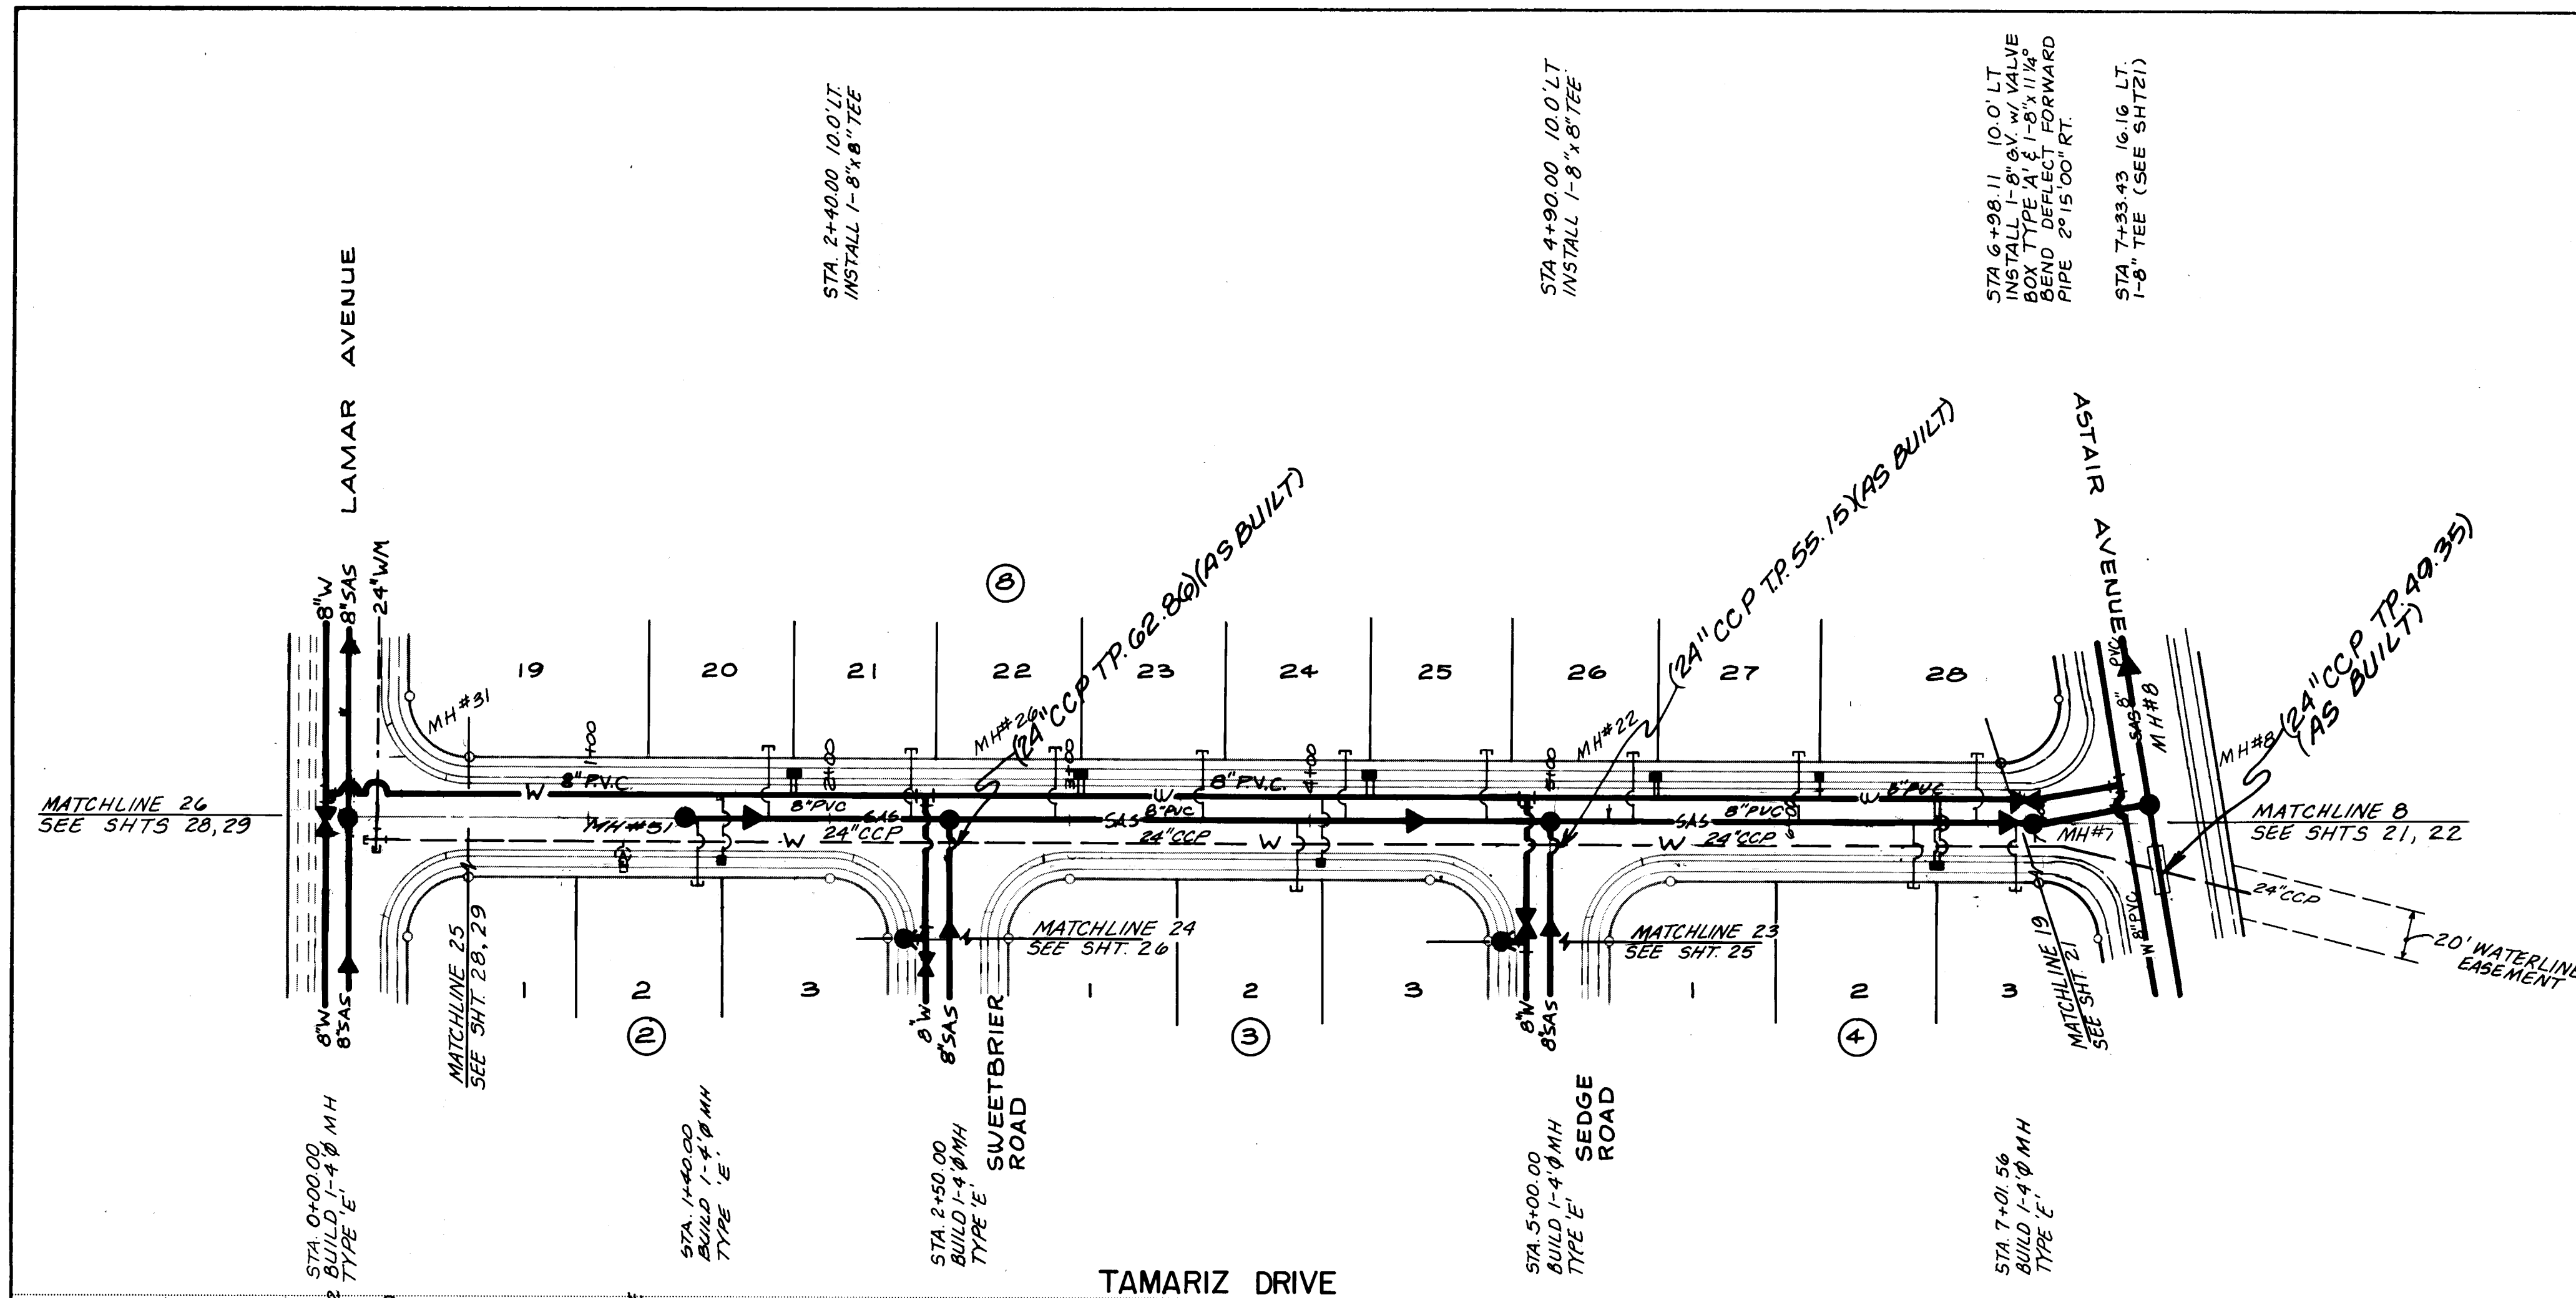

I, ELVIDIO V. DINIZ CERTIFY THAT THE DRAWING OF THE "AS-BUILT" DIMENSIONS WAS DONE UNDER MY SUPERVISION. *EVW*

SCALE:
HORIZ - 1"=50'
VERT. - 1"=10'

SERVICE LINE LOCATIONS				
Lot No.	Center Line Station	Service	Invert Elev. at P.L.	
20 & 21	1+75	SAS	66.25	
	1+85	WATER	---	
	2+35	SAS	64.47	
22 & 23	2+95	SAS	62.67(59.41)	
	3+05	WATER	---	
	3+55	SAS	60.87(58.06)	
24 & 25	4+15	SAS	59.67(56.51)	
	4+25	WATER	---	
	4+75	SAS	57.27(54.96)	
26 & 27	5+35	SAS	55.47(53.53)	
	5+45	WATER	---	
	5+95	SAS	53.67(52.26)	
28	6+05	WATER	---	
	6+72.51	SAS	51.45(50.43)	
2, BLK 2	1+55	WATER	---	
	1+45	SAS	66.97	
2, BLK 3	4+05	WATER	---	
	3+95	SAS	59.67(57.02)	
2 & 3, BLK 4	6+45	SAS	52.66(51.21)	
	6+55	WATER	---	
	6+88.35	SAS	51.76(50.30)	

- UTILITY NOTES
- THE STATIONING IS BASED ON CENTERLINE OF STREET.
 - THE FOLLOWING CITY OF ALBUQUERQUE STANDARD DETAIL DRAWINGS ARE APPLICABLE:
- | | |
|------|---------------|
| S-2 | W-2 |
| S-5 | W-4 |
| S-6 | W-7 |
| S-8 | W-8 |
| S-9 | W-10 |
| S-10 | W-14 |
| S-12 | W-15 (Case 1) |
| | W-16 |
| | W-18 |
| | W-20 |
| | W-22 |
| | W-23 |



LEGEND	
SANITARY SEWER LINE	—SAS—
SANITARY SEWER MANHOLE	—●—
SAS SERVICE CONNECTION	—T—
WATER LINE	—W—
GATE VALVE	—V—
FIRE HYDRANT	—F—
REDUCER	—R—
TEE	—T—
BENDS	—B—
WATER SERVICE CONNECTION	—T—
CAPS & PLUGS	—C—
CROSS	—X—
SIDEWALK	—S—
STANDARD CURB & GUTTER	—C—
MOUNTABLE CURB & GUTTER	—M—
RESIDENTIAL PAVING	—R—
VALLEY GUTTER (CONC.)	—V—
CROWN TRANSITION AREA	—C—
WHEELCHAIR RAMP (CASE II)	—W—
BARRICADE (TYPE III)	—B—

CITY OF ALBUQUERQUE
MUNICIPAL DEVELOPMENT DEPARTMENT
ENGINEERING DIVISION


TITLE: RINCON SUBDIVISION—PHASE I
TAMARIZ DRIVE
UTILITIES PLAN & PROFILE

APPROVALS	ENGINEER	DATE	APPROVALS	ENGINEER	DATE
City Engineer	<i>[Signature]</i>	8/14/06	Liquid Waste	<i>[Signature]</i>	7/27/06
A.C.E. Design	<i>[Signature]</i>	8/15/06	Traffic	<i>[Signature]</i>	7/27/06
A.C.E. Hydrology	<i>[Signature]</i>	8/15/06	Water	<i>[Signature]</i>	7/27/06

DRAWING NO. 2879 MAP NO. E-10 & F-10 SHEET 24 OF 36

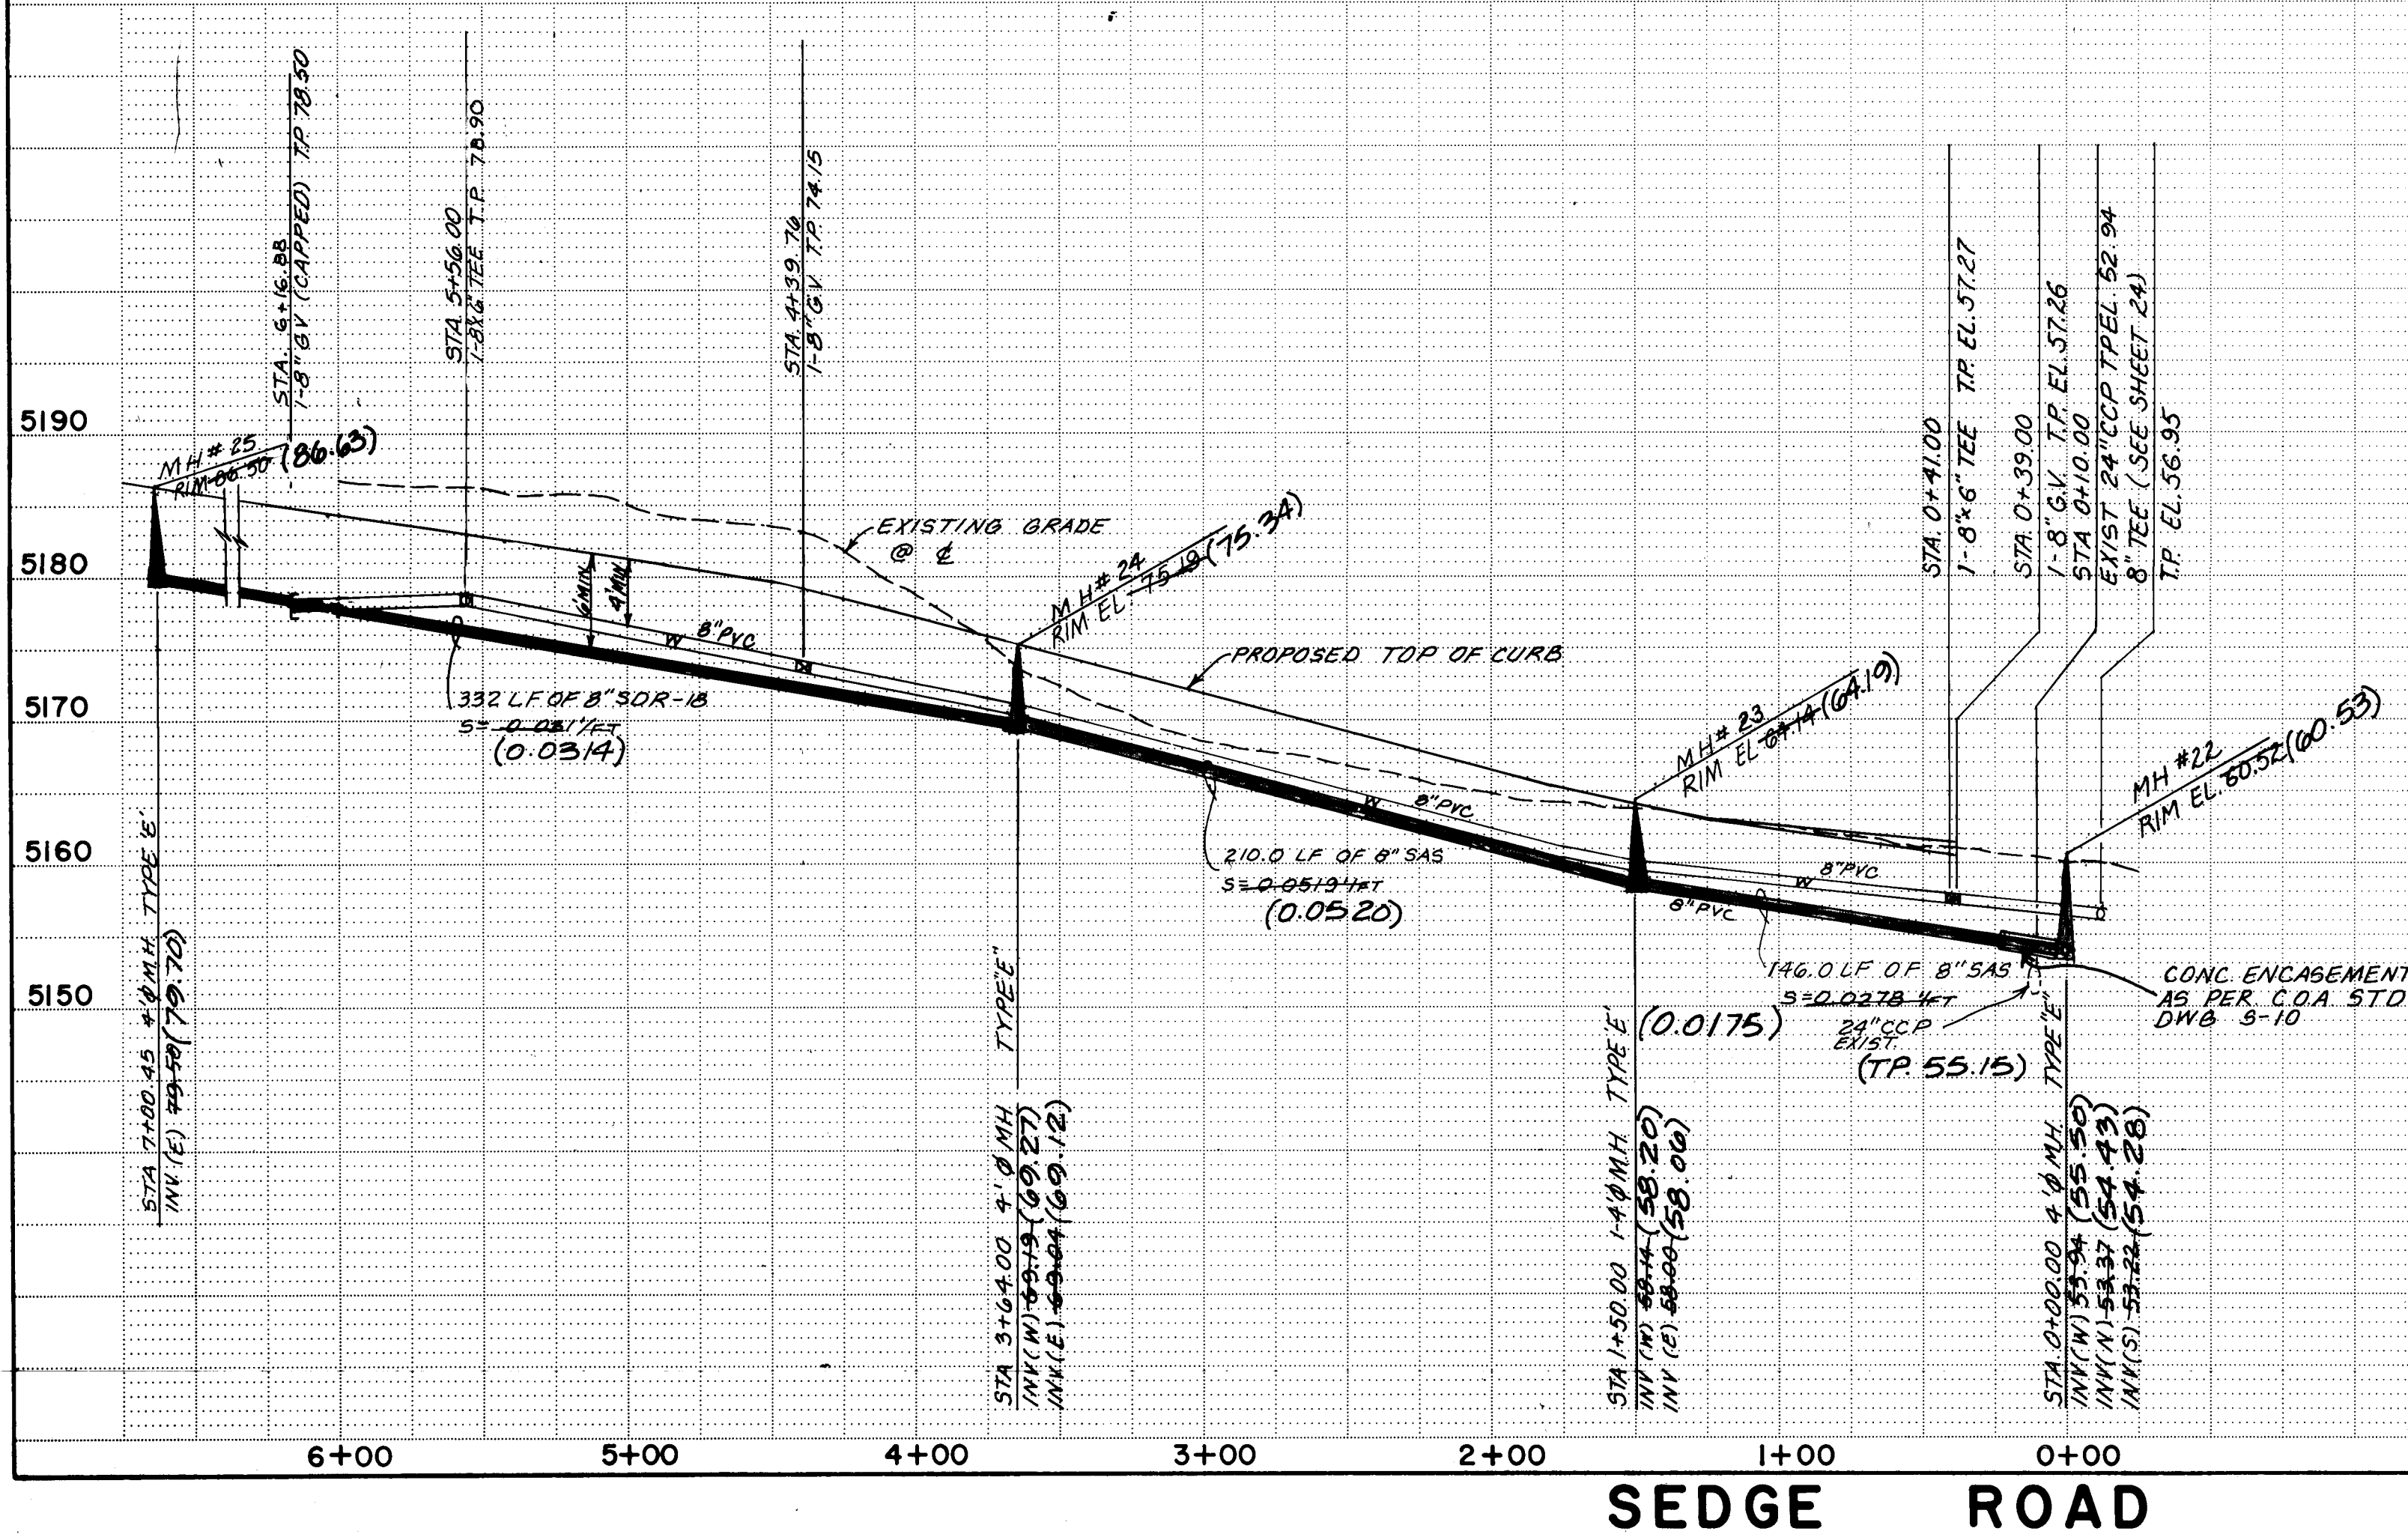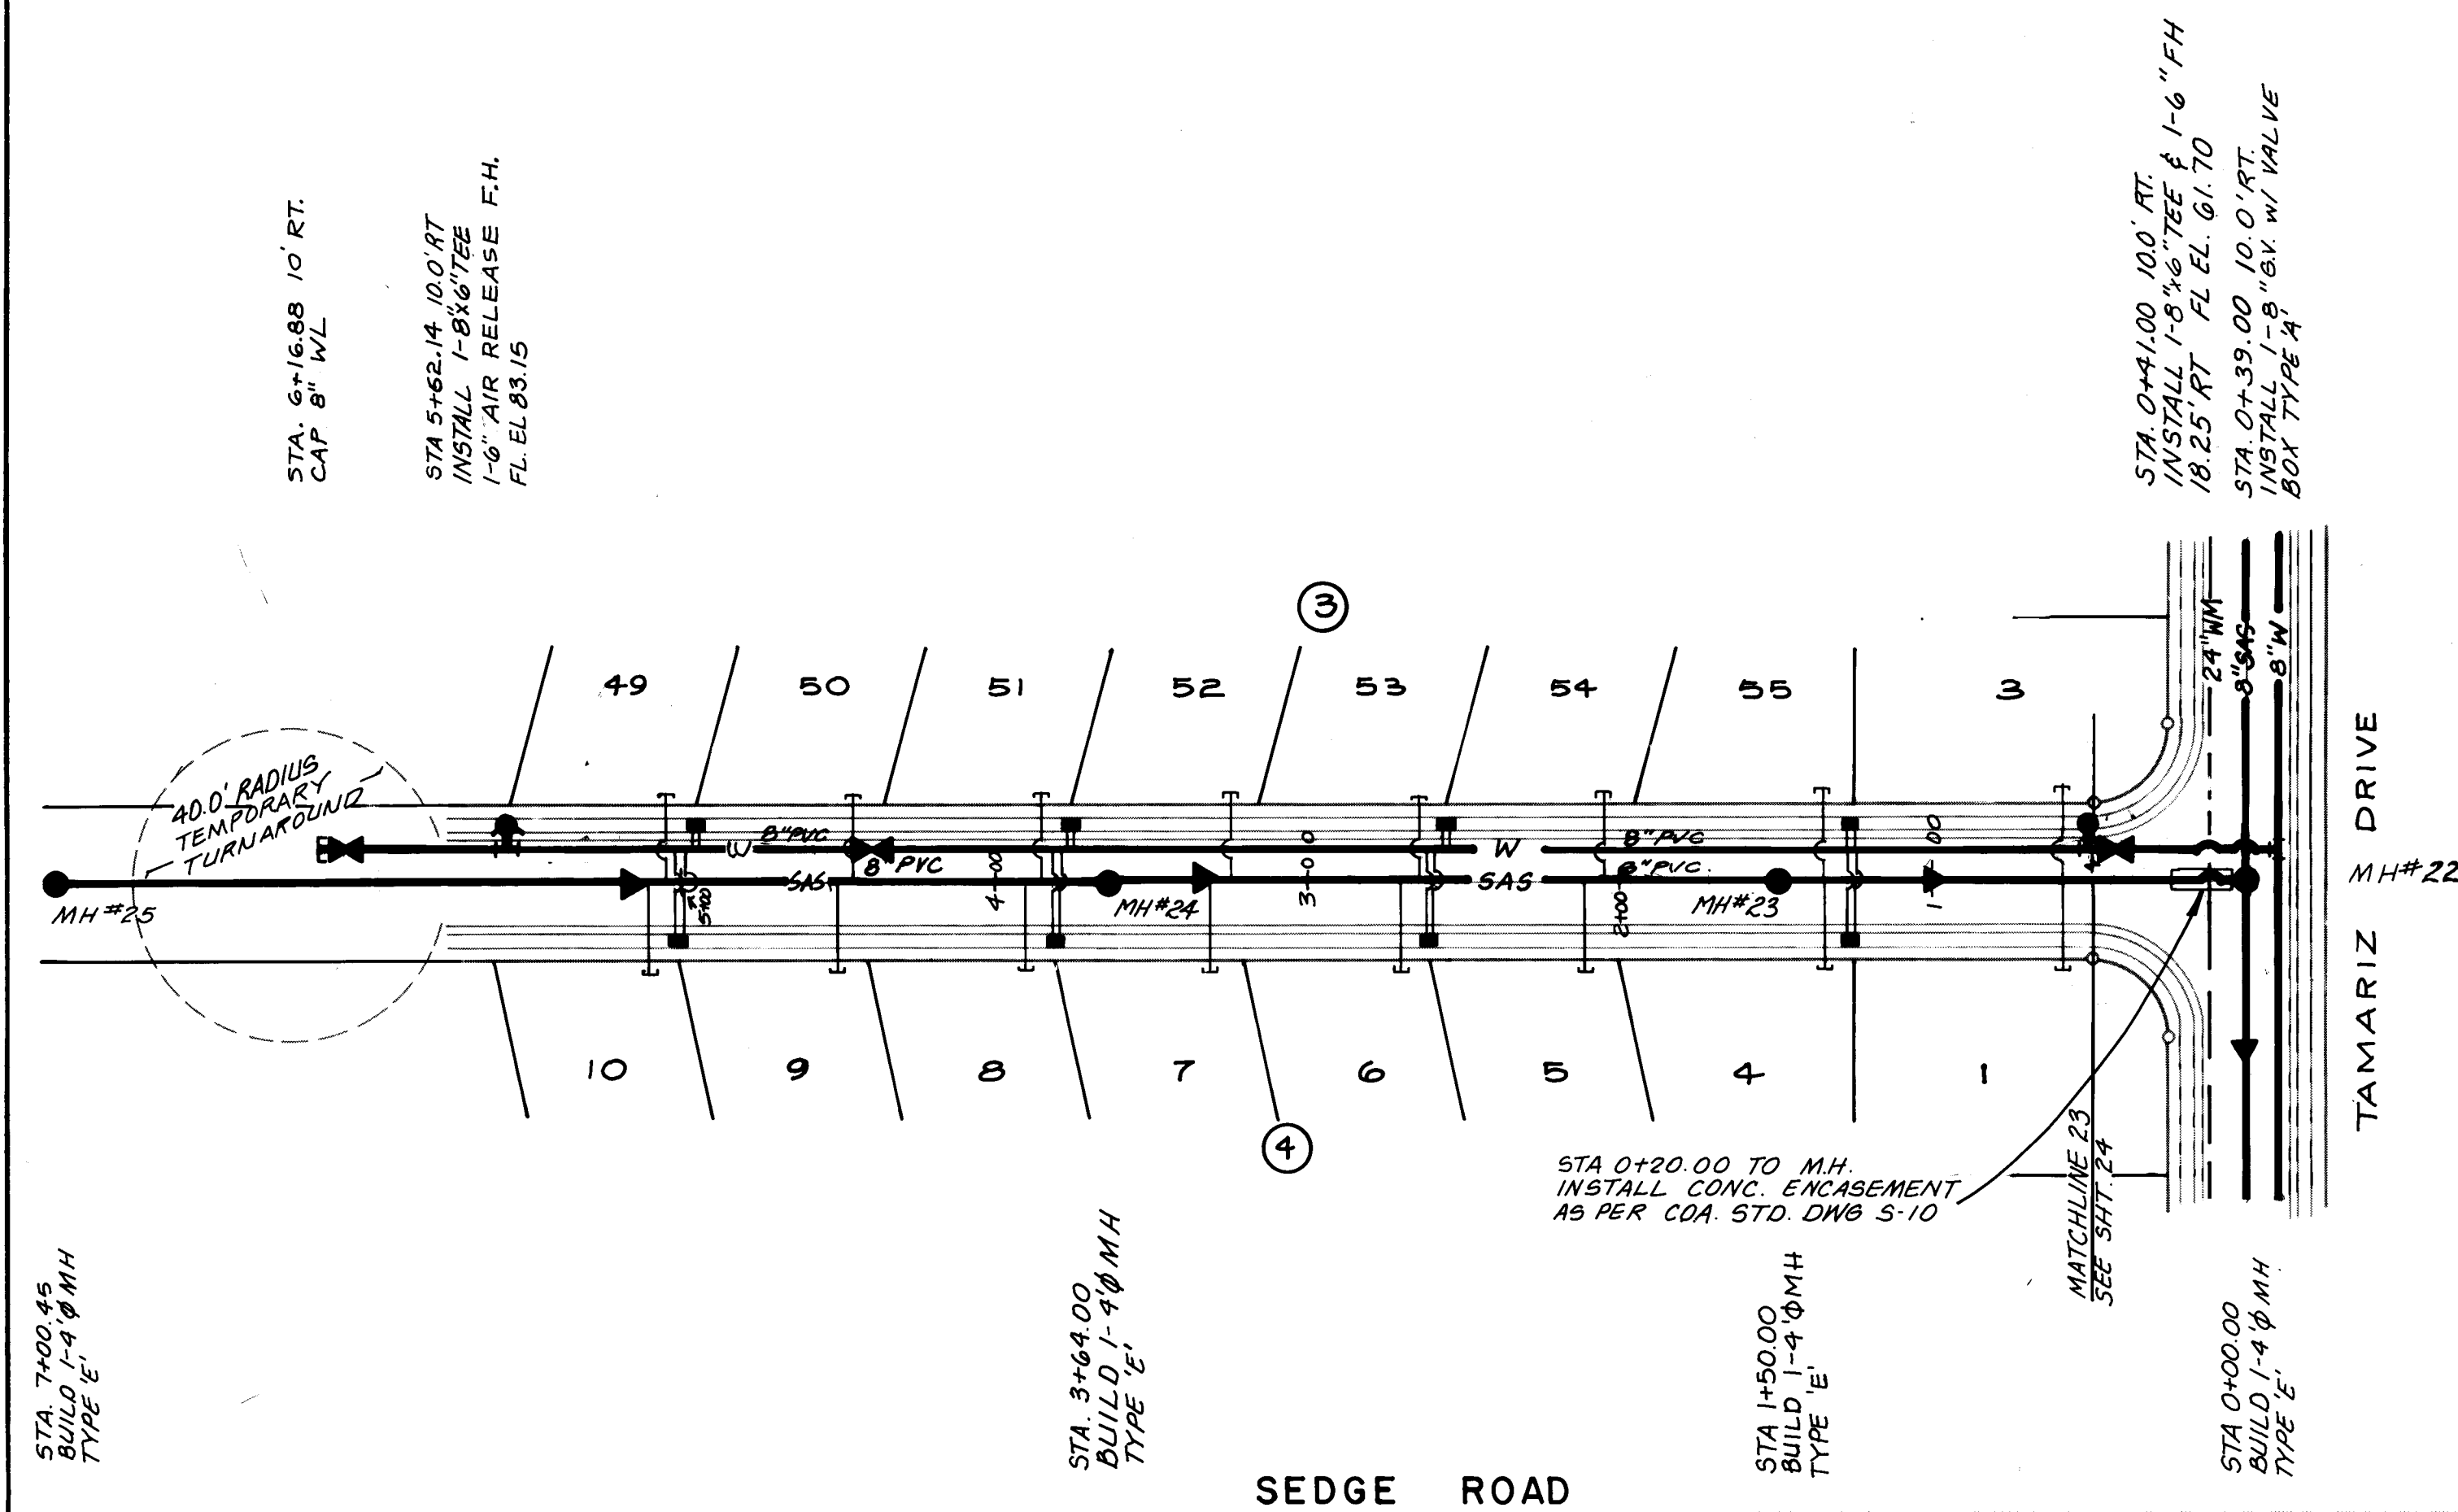

SCALE :
HORIZ. - 1"=50'
VERT. - 1"=10'

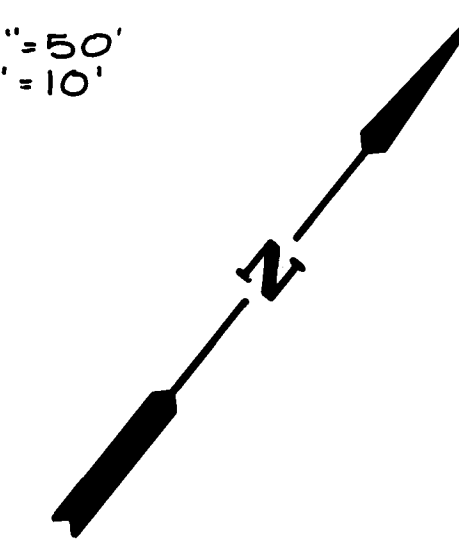

I, ELVIDIO V. DINIZ CERTIFY THAT
THE DRAWING OF THE "AS BUILT"
DIMENSIONS WAS DONE UNDER
MY SUPERVISION. *EDV*

SERVICE LINE LOCATIONS				AS BUILT INFORMATION	
Lot No.	Center Line Station	Service	Invert Elev. at P.L.	CONTRACTOR	DATE
3 & 55	0+60	SAS	-57.60 (56.53)		
	1+25	WATER			
	1+35	SAS	-59.56 (57.87)		
1 & 4	0+61	SAS	-57.15 (56.53)		
	1+25	WATER			
	1+36	SAS	-59.54 (57.87)		
54 & 53	2+05.00	SAS	62.88		
	2+56.19	WATER			
	2+66.19	SAS	66.08		
5 & 6	2+06.00	SAS	62.93		
	2+56.19	WATER			
	2+67.19	SAS	63.13		
52 & 51	3+27.38	SAS	69.29		
	3+78.57	WATER			
	3+88.57	SAS	72.48		
7 & 8	3+28.38	SAS	69.33		
	3+78.57	WATER			
	3+89.57	SAS	72.53		
50 & 49	4+49.56	SAS	75.46		
	5+00.95	WATER			
	5+10.95	SAS	77.23		
9 & 10	4+50.76	SAS	75.51		
	5+00.95	WATER			
	5+11.95	SAS	77.56		

UTILITY NOTES	
1.	THE STATIONING IS BASED ON CENTERLINE OF STREET.
2.	THE FOLLOWING CITY OF ALBUQUERQUE STANDARD DETAIL DRAWINGS ARE APPLICABLE:
S-2	W-2
S-5	W-4
S-6	W-7
S-8	W-8
S-9	W-10
S-10	W-14
S-12	W-15 (Case I)
	W-16
	W-18
	W-20
	W-22
	W-23

LEGEND	
SANITARY SEWER LINE	—SAS—
SANITARY SEWER MANHOLE	—●—
SAS SERVICE CONNECTION	—T—
WATER LINE	—W—
GATE VALVE	—V—
FIRE HYDRANT	—H—
REDUCER	—R—
TEE	—T—
BENDS	—B—
WATER SERVICE CONNECTION	—T—
CAPS & PLUGS	—C—
CROSS	—X—
SIDEWALK	—S—
STANDARD CURB & GUTTER	—C—
MOUNTABLE CURB & GUTTER	—M—
RESIDENTIAL PAVING	—R—
VALLEY GUTTER (CONC.)	—V—
CROWN TRANSITION AREA	—T—
WHEELCHAIR RAMP (CASE II)	—W—
BARRICADE (TYPE III)	—B—

ENGINEER'S SEAL	

REVISIONS	
NO.	DATE
1	6/8/86
2	6/8/86

CITY OF ALBUQUERQUE MUNICIPAL DEVELOPMENT DEPARTMENT ENGINEERING DIVISION	
TITLE: RINCON SUBDIVISION-PHASE I SEGE ROAD UTILITIES PLAN & PROFILE	
APPROVALS	ENGINEER
City Engineer	<i>[Signature]</i> 6/8/86
A.C.E.-Design	<i>[Signature]</i> 6/8/86
A.C.E.-Hydrology	<i>[Signature]</i> 6/8/86
APPROVALS	ENGINEER
Liquid Waste	<i>[Signature]</i> 7/29/86
Traffic	<i>[Signature]</i> 7/29/86
Water	<i>[Signature]</i> 7/29/86

DRAWING NO. 2879	
MAP NO. E-10 & F-10	SHEET 25 OF 36

STA 8+01.40
R.J. 1-4.0' M.H. TYPE 'E'

STA 8+01.40 -
BUILD 1-4.0' M.H. TYPE 'E'

STA 6+90.00 10.0' RT
INSTALL 1-8" 6" VALVE
BOX TYPE 'A' - CAPPED
END

STA 6+37.86 10.0' RT
INSTALL 1-8" 6" TEE &
6" FH 18.25' RT
FL EL 90.64

STA 5+18.50 - 9.78' RT
INSTALL 1-8" 1/2" BEND
DEFLECT FWD PIPE 2' 47.29" LT.

STA 4+49.70 7.05' RT
INSTALL 1-8" 22 1/2" BEND
DEFLECT FWD PIPE 2' 11.33' LT.

STA 0+43.00 10.0' RT
INSTALL 1-8" 6" VALVE
BOX TYPE 'A'

STA 0+41.00 10.0' RT
INSTALL 1-8" 6" TEE TO
6" FH 18.25' RT. FL EL 89.87
STA 0+20.00 TO M.H. BUILD
CONC. ENCASUREMENT AS PER
COA STD. Dwg. S-10

SCALE:
HORIZ. - 1" = 50'
VERT. - 1" = 10'

I, ELVIDO V. DINIZ CERTIFY THAT
THE DRAWING OF THE "AS BUILT"
DIMENSIONS WAS DONE UNDER
MY SUPERVISION. *EDV*

SWEETBRIER ROAD

TAMARIZ DRIVE

SERVICE LINE LOCATIONS			
Lot No.	Center Line Station	Service Invert Elev. at P.L.	
1 & 3	0+65	SAS	-66.23 (65.09)
	1+25	WATER	---
	0+66	SAS	-65.92 (65.09)
4 & 5	1+35	SAS	-68.71 (67.46)
	1+75	WATER	---
	1+85	SAS	-70.80 (69.17)
34 & 33	1+36	SAS	-71.29 (67.49)
	2+00	WATER	---
	2+10	SAS	-72.07 (70.03)
6 & 7	2+46.19	SAS	-73.96 (71.27)
	2+97.38	WATER	---
	3+07.38	SAS	-76.46 (73.37)
32 & 31	2+71.19	SAS	-75.12 (72.13)
	3+17.38	WATER	---
	3+27.38	SAS	-77.07 (74.06)
8 & 9	3+68.57	SAS	-78.31 (75.47)
	4+19.09	WATER	---
	4+28.11	SAS	-80.09 (77.51)
30 & 29	3+88.57	SAS	78.91
	4+42.71	WATER	---
	4+53.80	SAS	80.86
10 & 11	5+19.47	SAS	82.83
	5+28.49	WATER	---
	5+38.49	SAS	83.40
28 & 27	5+21.70	SAS	82.90
	5+74.97	WATER	---
	5+79.97	SAS	84.65
12	5+96.50	SAS	85.15
	5+54.39	WATER	---

UTILITY NOTES

- THE STATIONING IS BASED ON CENTERLINE OF STREET.
- THE FOLLOWING CITY OF ALBUQUERQUE STANDARD DETAIL DRAWINGS ARE APPLICABLE:

S-2	W-2
S-5	W-4
S-6	W-7
S-8	W-8
S-9	W-10
S-10	W-14
S-12	W-15 (Case I)
	W-16
	W-18
	W-20
	W-22
	W-23

LEGEND

SANITARY SEWER LINE	— SAS —
SANITARY SEWER MANHOLE	— (M) —
SAS SERVICE CONNECTION	— T —
WATER LINE	— W —
GATE VALVE	— V —
FIRE HYDRANT	— H —
REDUCER	— R —
TEE	— T —
BENDS	— B —
WATER SERVICE CONNECTION	— T —
CAPS & PLUGS	— C —
CROSS	— X —
SIDEWALK	— S —
STANDARD CURB & GUTTER	— CG —
MOUNTABLE CURB & GUTTER	— MC —
RESIDENTIAL PAVING	— RP —
VALLEY GUTTER (CONC.)	— VG —
CROWN TRANSITION AREA	— CTA —
WHEELCHAIR RAMP (CASE II)	— WR —
BARRICADE (TYPE III)	— B —

1	2	3	4	5	6	7	8	9	10	11	12
26	28	79	26	87							

CITY OF ALBUQUERQUE
MUNICIPAL DEVELOPMENT DEPARTMENT
ENGINEERING DIVISION

TITLE: RINCON SUBDIVISION PHASE I
SWEETBRIER ROAD
UTILITIES PLAN & PROFILE

APPROVALS	ENGINEER	DATE	APPROVALS	ENGINEER	DATE
City Engineer	<i>[Signature]</i>	8/14/86	Liquid Waste	<i>[Signature]</i>	7/29/86
A.C.E. - Design	<i>[Signature]</i>	8/5/86	Traffic	<i>[Signature]</i>	7/21/86
A.C.E. - Hydrology	<i>[Signature]</i>		Water	<i>[Signature]</i>	7/29/86


DESIGNED BY: B.T.
DRAWN BY: M.S.
CHECKED BY: E.D.

NO. DATE REMARKS REVISIONS DESIGN

2879 MAP NO. E-10 & F-10 SHEET 26 OF 36

SWEETBRIER ROAD

GLEASON AVENUE

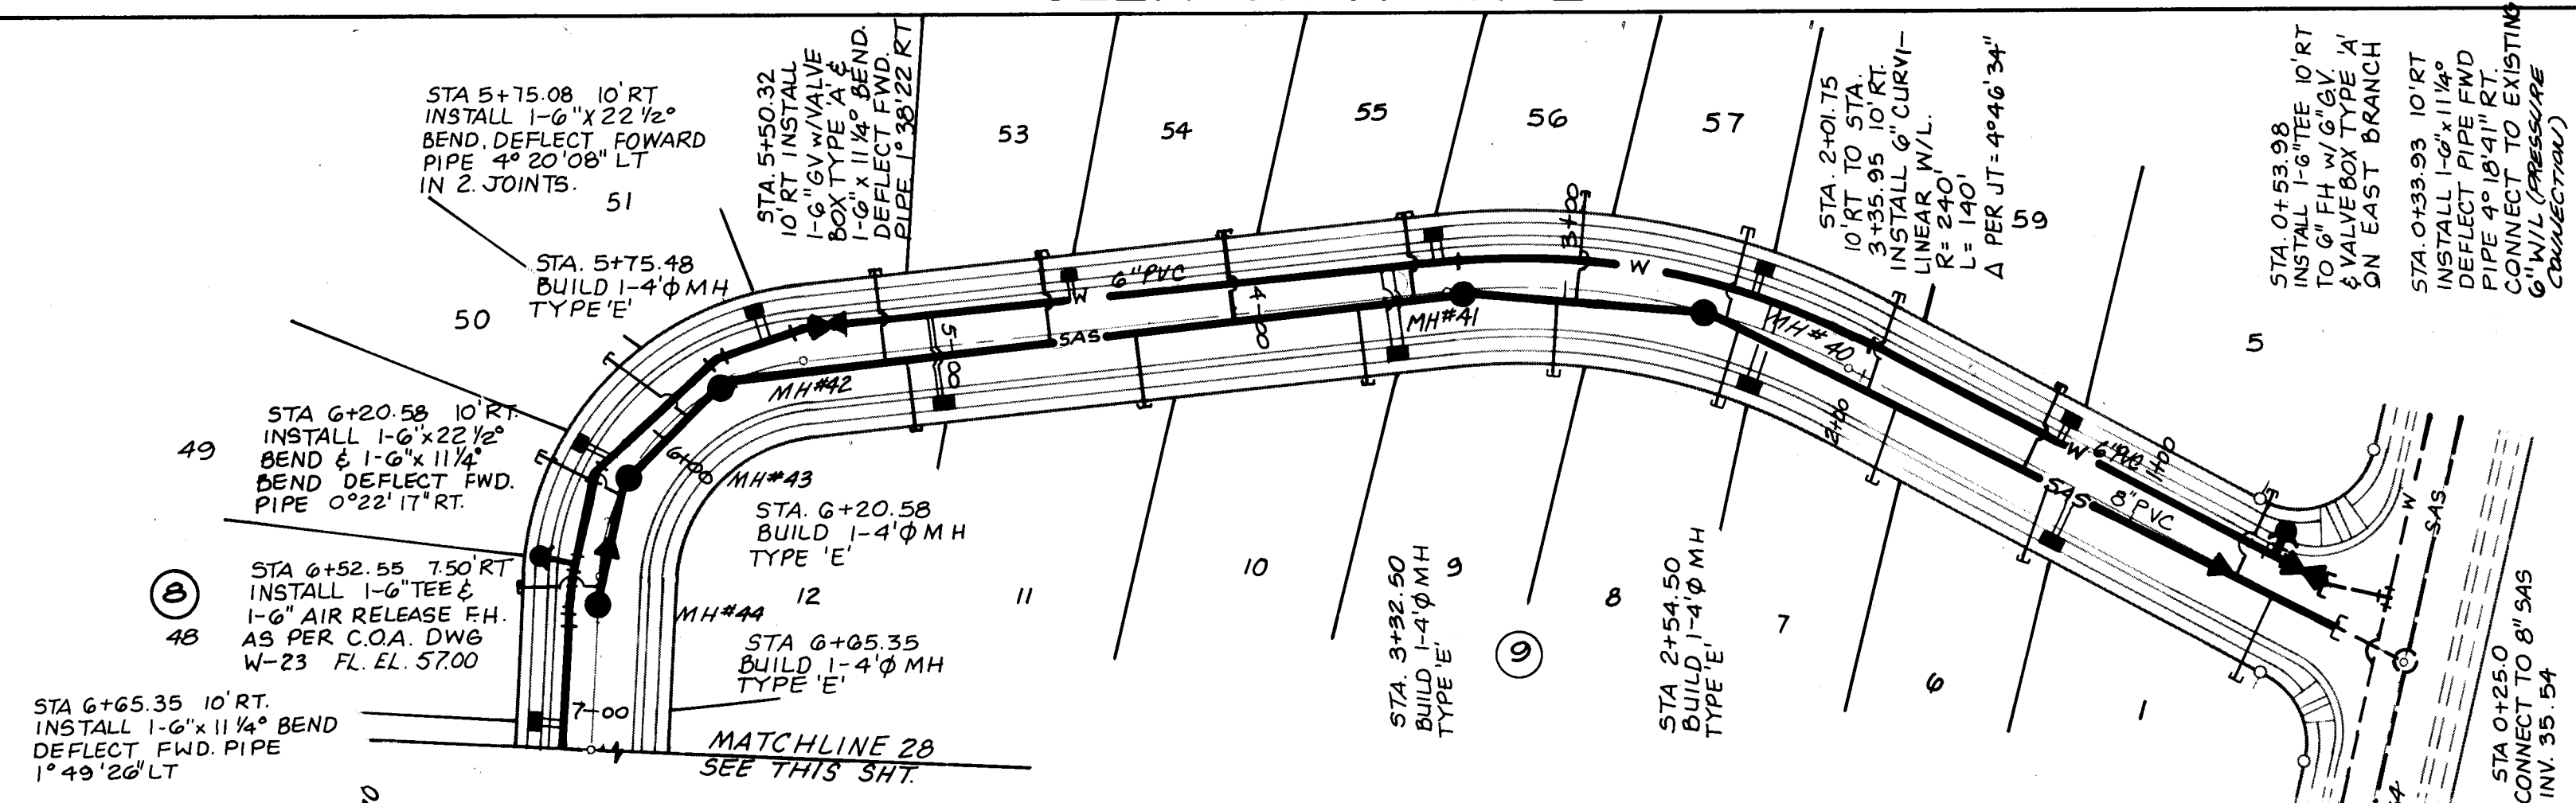SCALE:
HORIZ. - 1"=50'
VERT. - 1"=10'

SERVICE LINE LOCATIONS


Lot No.	Center Line Station	Service	Invert Elev. at P.L.
1 & 6	2+32.20	SAS	39.02
1+18.56	1+32.40	WATER	---
1+28.56	1+42.40	SAS	40.30
5 & 59	2+71.78	SAS	39.36
	2+76.78	WATER	---
	1+32.49	SAS	40.38
	1+42.29	SAS	---
58 & 57	1+97.13	SAS	41.22
	2+36.82	WATER	---
	2+45.84	SAS	41.93
7 & 8	1+80.90	SAS	41.10
	2+28.04	WATER	---
	2+39.26	SAS	41.88
55 & 56	2+93.22	SAS	42.64
	3+37.39	WATER	---
	3+47.39	SAS	43.44
9 & 10	3+01.33	SAS	42.76
3+57.78	3+55.89	WATER	---
3+67.78	3+65.89	SAS	43.80

- UTILITY NOTES
- THE STATIONING IS BASED ON CENTERLINE OF STREET.
 - THE FOLLOWING CITY OF ALBUQUERQUE STANDARD DETAIL DRAWINGS ARE APPLICABLE:

S-2	W-2
S-5	W-4
S-6	W-7
S-8	W-8
S-9	W-10
S-10	W-14
S-12	W-15(Case I)
	W-16
	W-18
	W-20
	W-22
	W-23

I, ELVIDIO V. DIAZ, CERTIFY THAT THE DRAWING OF THIS PROJECT WAS DONE UNDER MY SUPERVISION.

BENCH MARKS		AS BUILT INFORMATION	
CONTROL:	BENCH MARK	A.C.S. "16-10"	CONTRACTOR
		CHISEL ON TOP OF CONCRETE	DATE
		CURB AT THE N.E. CURB RETURN	DATE
		AT THE INTERSECTION OF ATRISCO	DATE
		ROAD N.W. AND FLOR DEL SOL	DATE
		PLACE N.W.	DATE
		M.S.L. ELEVATION = 5134.77'	DATE

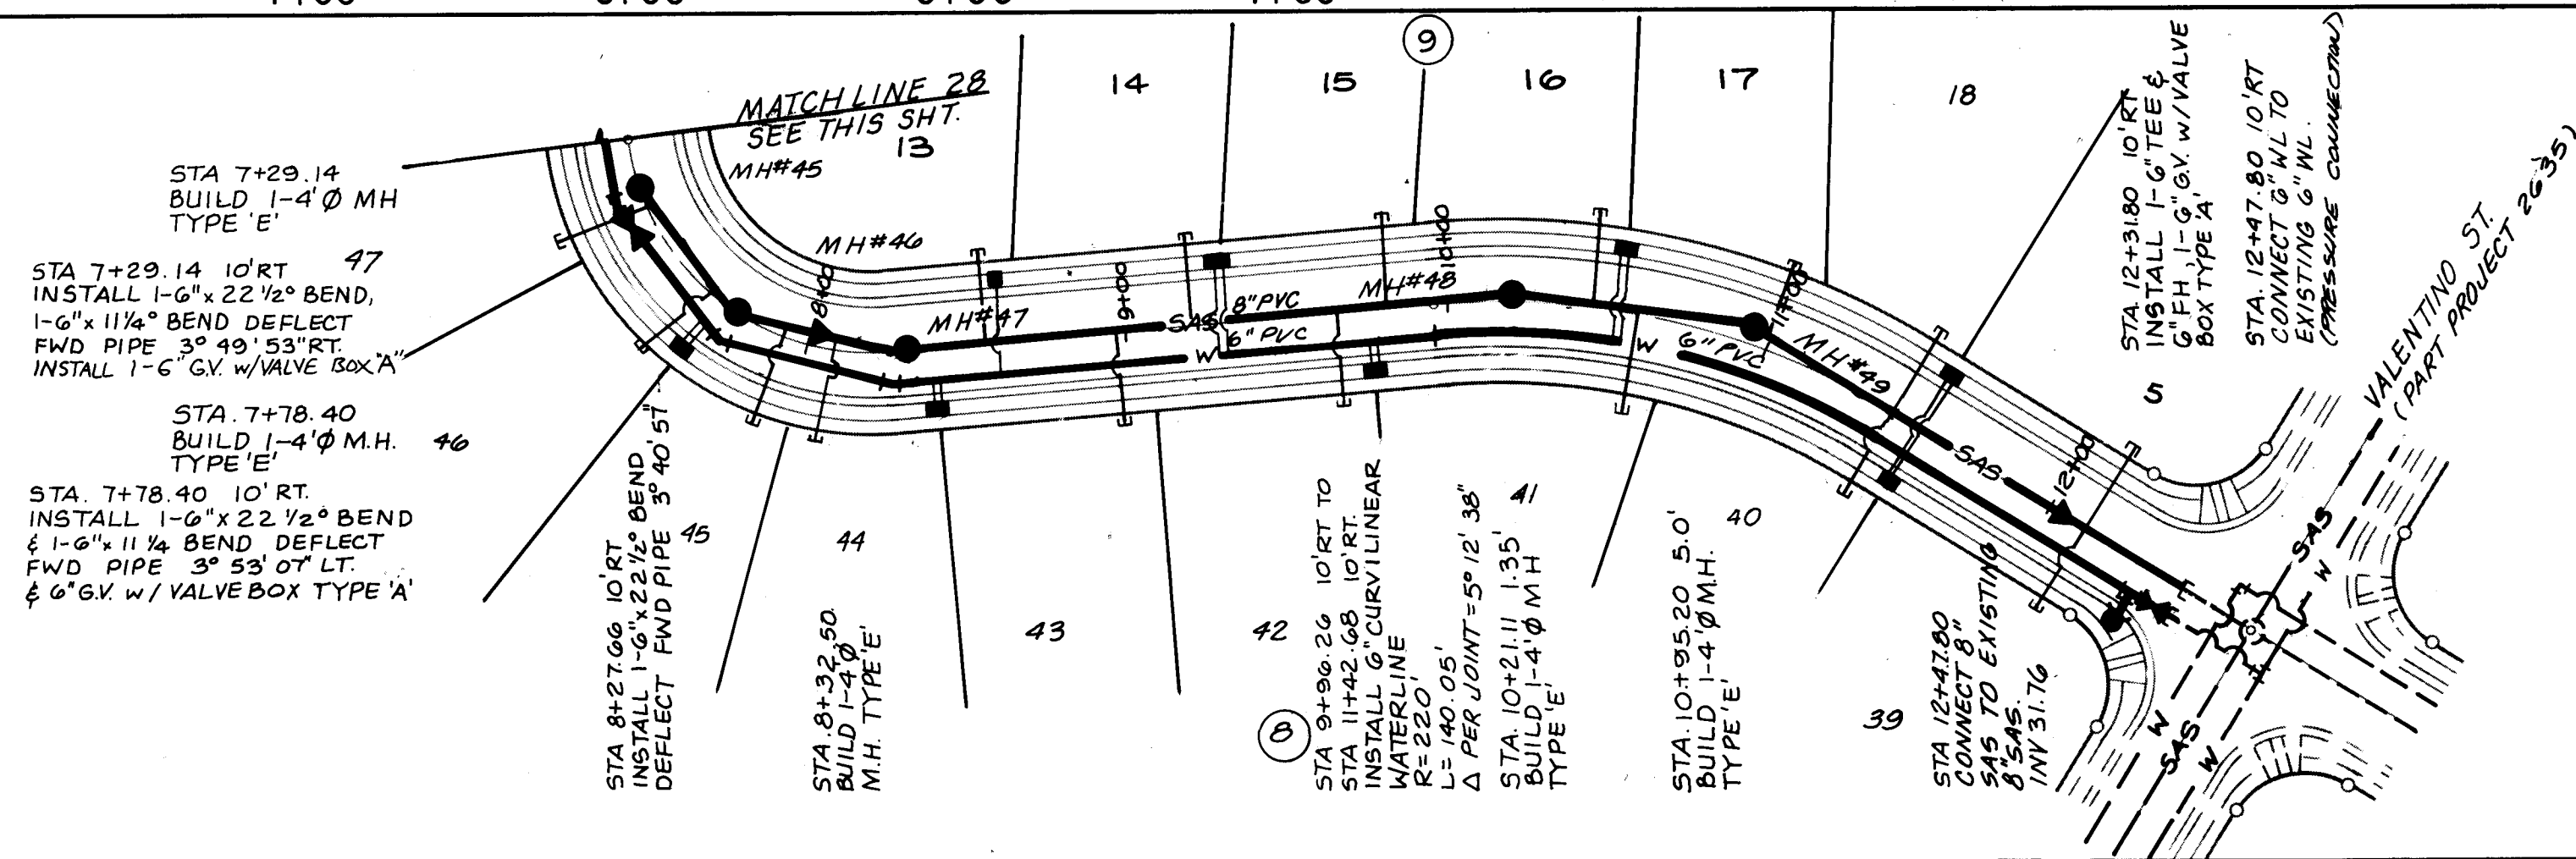SCALE:
HORIZ. - 1"=50'
VERT. - 1"=10'

SERVICE LINE LOCATIONS

Lot No.	Center Line Station	Service	Invert Elev. at P.L.
48 & 47	6+60.09	SAS	52.78
	7+04.60	WATER	---
7+13.98	6+61.79	SAS	52.78
46 & 45	7+63.56	SAS	50.94
	7+71.06	WATER	---
	7+94.50	SAS	49.75
13	8+57.67	SAS	39.02
8+67.67	1+32.40	WATER	---
44 & 43	8+08.23	SAS	49.18
8+41.97	8+37.60	WATER	---
	8+98.03	SAS	46.05
14 & 15	9+22.94	SAS	44.97
9+32.94	9+30.37	WATER	---
9+83.54	9+86.22	SAS	42.35
42 & 41	9+65.43	SAS	43.18
	9+75.43	WATER	---
10+57.50	10+61.36	SAS	39.56

LEGEND	
SANITARY SEWER LINE	SAS
SANITARY SEWER MANHOLE	
SAS SERVICE CONNECTION	
WATER LINE	
GATE VALVE	
FIRE HYDRANT	
REDUCER	
TEE	
BENDS	
WATER SERVICE CONNECTION	
CAPS & PLUGS	
CROSS	
SIDEWALK	
STANDARD CURB & GUTTER	
MOUNTABLE CURB & GUTTER	
RESIDENTIAL PAVING	
VALLEY GUTTER (CONC.)	
CROWN TRANSITION AREA	
WHEELCHAIR RAMP (CASE II)	
BARRICADE (TYPE III)	

26 28 79 27 87


CITY OF ALBUQUERQUE
MUNICIPAL DEVELOPMENT DEPARTMENT
ENGINEERING DIVISIONTITLE: RINCON SUBDIVISION—PHASE I
GLEASON AVE., CARNEY AVE.
UTILITIES PLAN & PROFILE

APPROVALS	ENGINEER	DATE	APPROVALS	ENGINEER	DATE
City Engineer		8/18/86	Liquid Waste		7/21/86
A.C.E. Design		8/18/86	Traffic		8/18/86
A.C.E. Hydrology		8/18/86	Water		7/21/86


DRAWING NO. 2879

MAP NO. E-10 & F-10

SHEET 27 OF 36

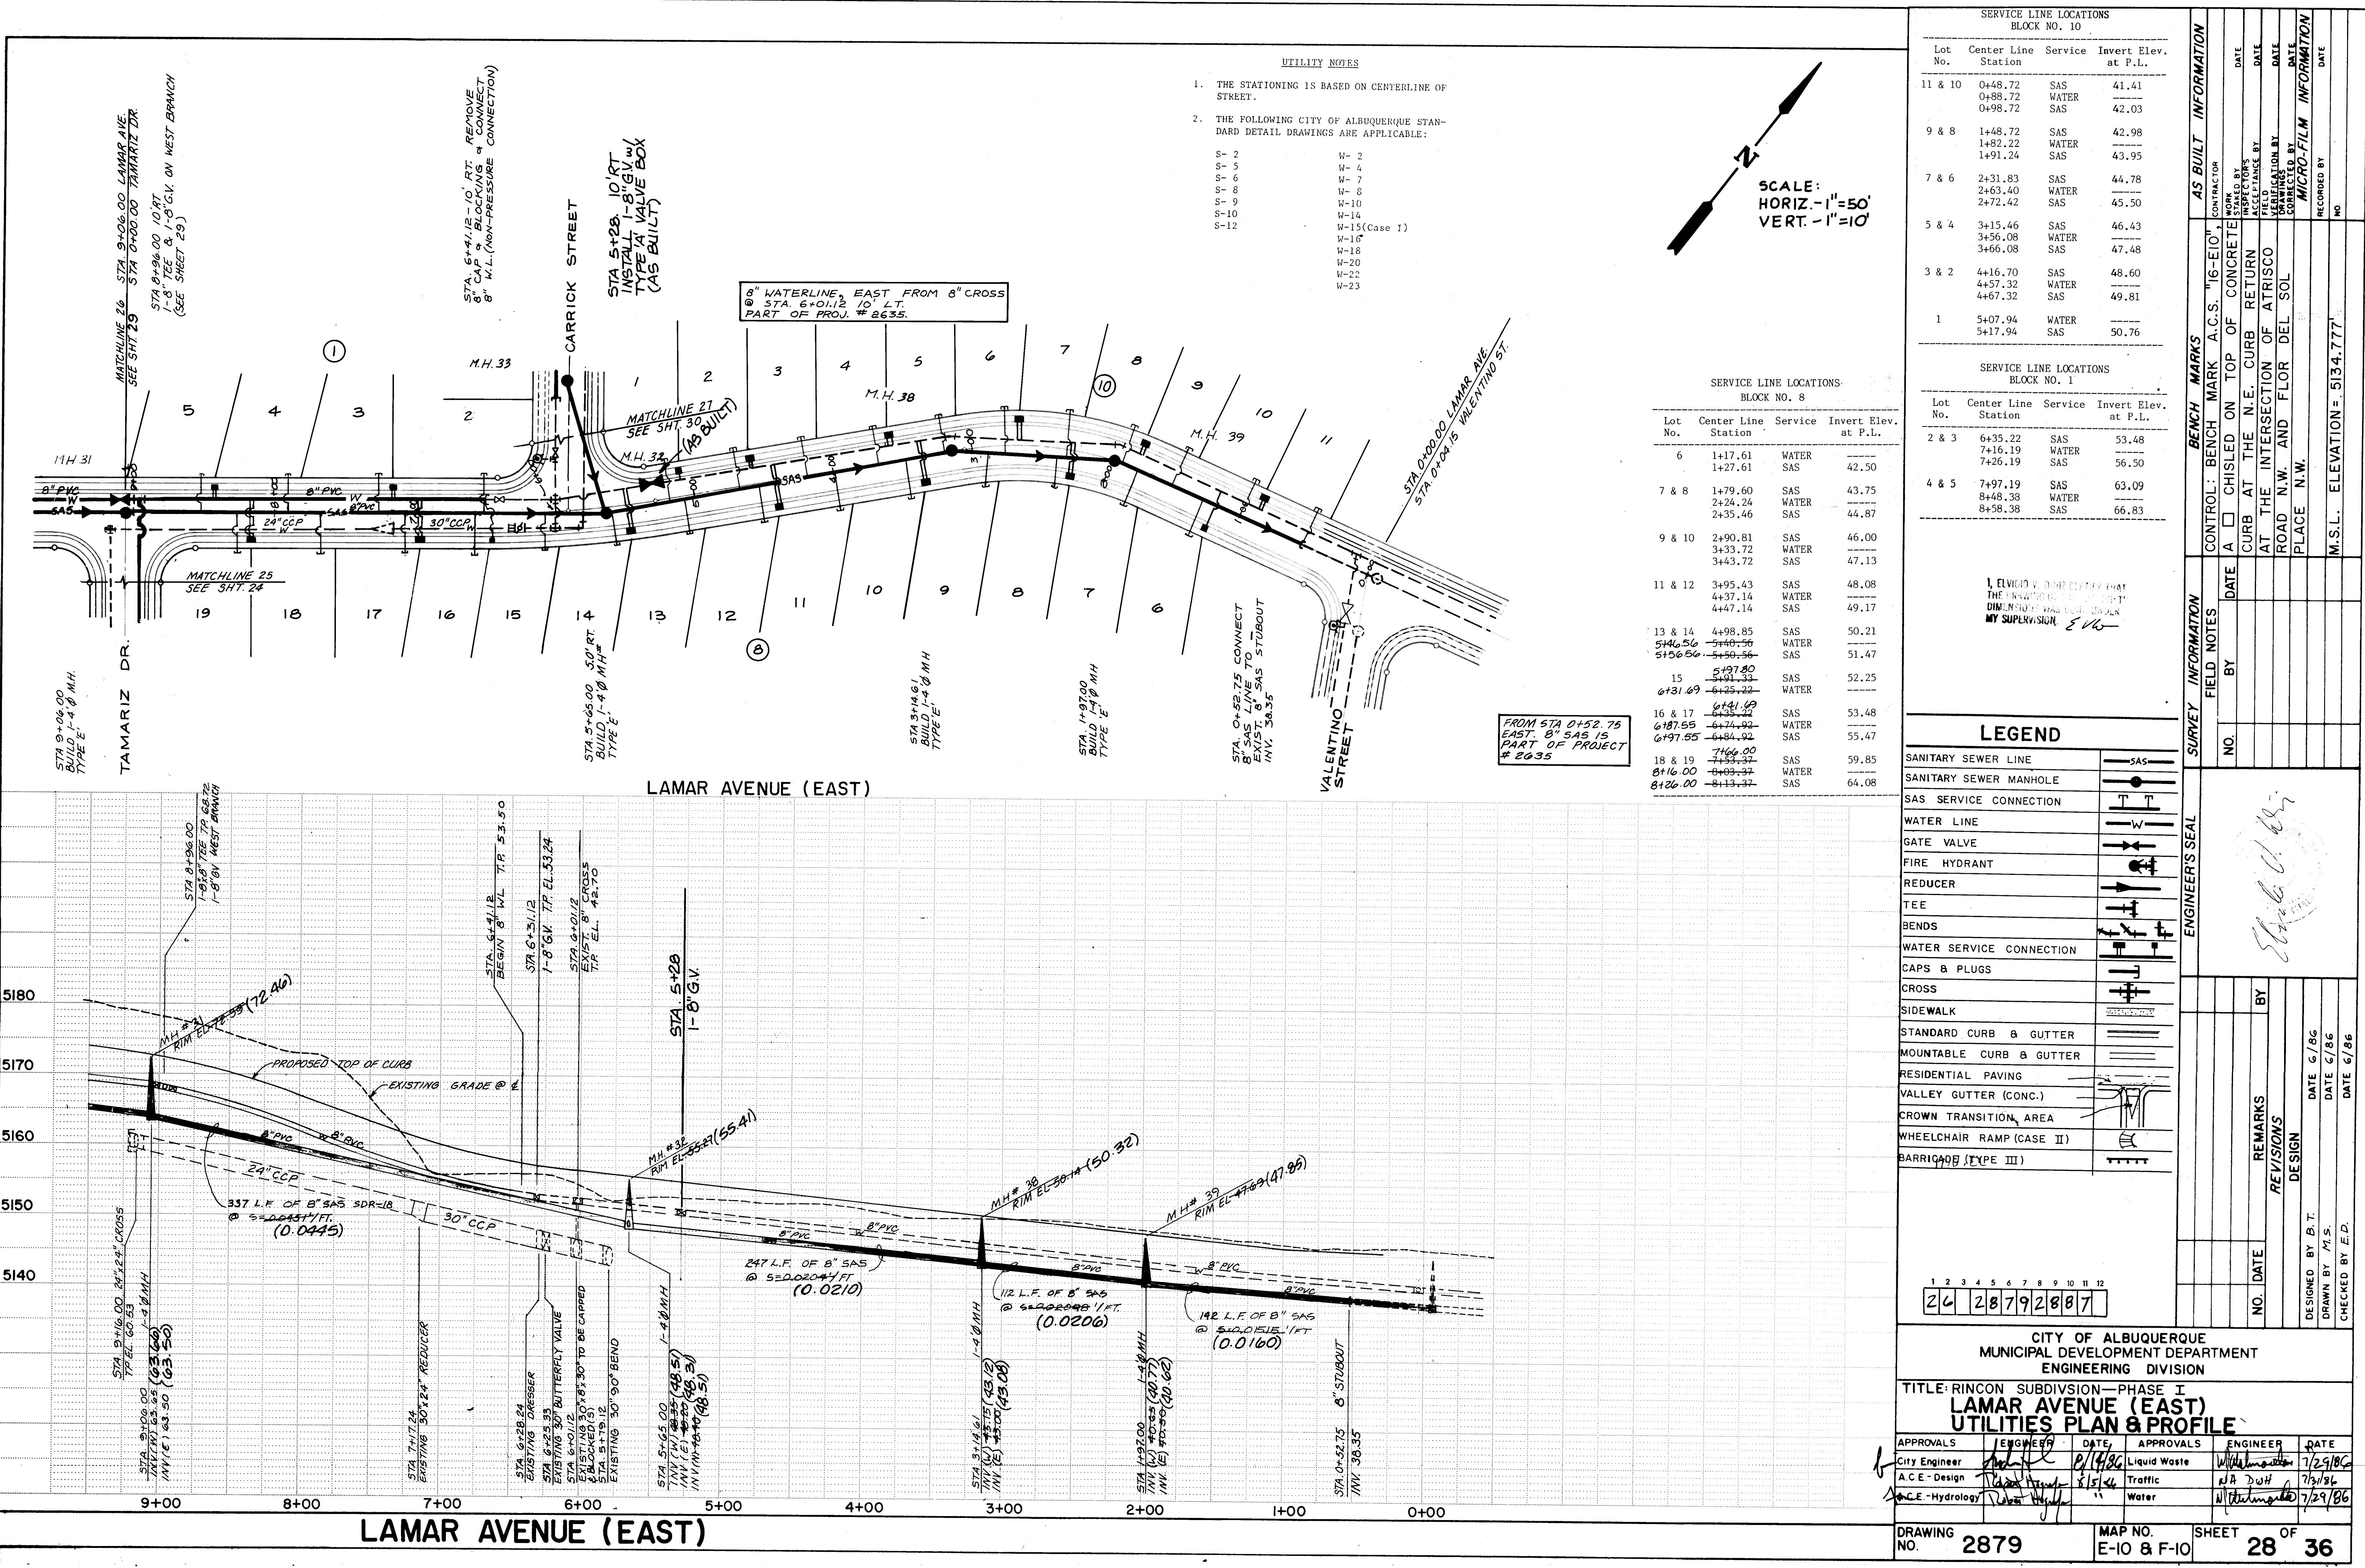

- UTILITY NOTES
1. THE STATIONING IS BASED ON CENTERLINE OF STREET.
 2. THE FOLLOWING CITY OF ALBUQUERQUE STANDARD DETAIL DRAWINGS ARE APPLICABLE:
- | | |
|------|---------------|
| S-2 | W-2 |
| S-5 | W-4 |
| S-6 | W-7 |
| S-8 | W-8 |
| S-9 | W-10 |
| S-10 | W-14 |
| S-12 | W-15 (Case 1) |
| | W-16 |
| | W-18 |
| | W-20 |
| | W-22 |
| | W-23 |

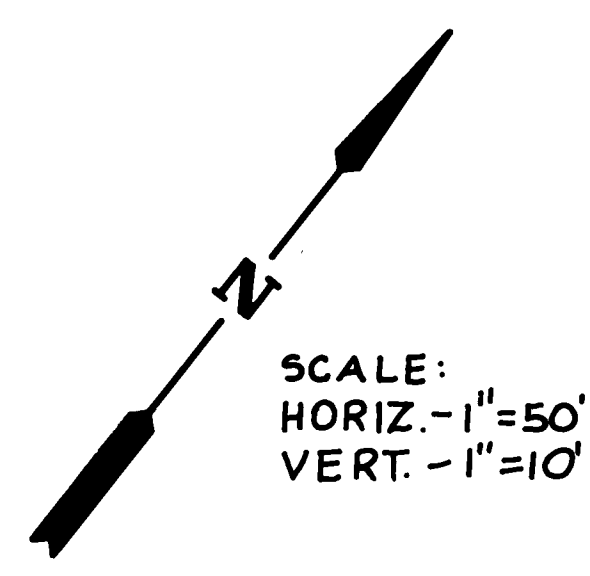

SERVICE LINE LOCATIONS BLOCK NO. 8

Lot No.	Center Line Station	Service	Invert Elev. at P.L.
6	1+17.61	WATER	---
	1+27.61	SAS	42.50
7 & 8	1+79.60	SAS	43.75
	2+24.24	WATER	---
	2+35.46	SAS	44.87
9 & 10	2+90.81	SAS	46.00
	3+33.72	WATER	---
	3+43.72	SAS	47.13
11 & 12	3+95.43	SAS	48.08
	4+37.14	WATER	---
	4+47.14	SAS	49.17
13 & 14	4+98.85	SAS	50.21
	5+46.56	WATER	---
	5+56.56	SAS	51.47
15	5+97.80	SAS	52.25
	6+31.69	WATER	---
	6+41.69	SAS	53.48
16 & 17	6+87.55	WATER	---
	6+97.55	SAS	55.47
18 & 19	7+66.00	SAS	59.85
	8+16.00	WATER	---
	8+26.00	SAS	64.08

FROM STA 0+52.75 EAST 8" SAS IS PART OF PROJECT # 2635

SERVICE LINE LOCATIONS BLOCK NO. 10

Lot No.	Center Line Station	Service	Invert Elev. at P.L.
11 & 10	0+48.72	SAS	41.41
	0+88.72	WATER	---
	0+98.72	SAS	42.03
9 & 8	1+48.72	SAS	42.98
	1+82.22	WATER	---
	1+91.24	SAS	43.95
7 & 6	2+31.83	SAS	44.78
	2+63.40	WATER	---
	2+72.42	SAS	45.50
5 & 4	3+15.46	SAS	46.43
	3+56.08	WATER	---
	3+66.08	SAS	47.48
3 & 2	4+16.70	SAS	48.60
	4+57.32	WATER	---
	4+67.32	SAS	49.81
1	5+07.94	WATER	---
	5+17.94	SAS	50.76

SERVICE LINE LOCATIONS BLOCK NO. 1

Lot No.	Center Line Station	Service	Invert Elev. at P.L.
2 & 3	6+35.22	SAS	53.48
	7+16.19	WATER	---
	7+26.19	SAS	56.50
4 & 5	7+97.19	SAS	63.09
	8+48.38	WATER	---
	8+58.38	SAS	66.83

I, ELVILIO V. DANT, CERTIFY THAT THE DRAWING IS A TRUE AND CORRECT DIMENSIONED AND SCALED COPY OF MY SUPERVISION.

LEGEND

SANITARY SEWER LINE	SAS
SANITARY SEWER MANHOLE	
SAS SERVICE CONNECTION	
WATER LINE	W
GATE VALVE	
FIRE HYDRANT	
REDUCER	
TEE	
BENDS	
WATER SERVICE CONNECTION	
CAPS & PLUGS	
CROSS	
SIDEWALK	
STANDARD CURB & GUTTER	
MOUNTABLE CURB & GUTTER	
RESIDENTIAL PAVING	
VALLEY GUTTER (CONC.)	
CROWN TRANSITION AREA	
WHEELCHAIR RAMP (CASE II)	
BARRICADE (TYPE III)	

26 28 79 28 87



CITY OF ALBUQUERQUE
MUNICIPAL DEVELOPMENT DEPARTMENT
ENGINEERING DIVISION

TITLE: RINCON SUBDIVISION—PHASE I
LAMAR AVENUE (EAST)
UTILITIES PLAN & PROFILE

APPROVALS	ENGINEER	DATE	APPROVALS	ENGINEER	DATE
CITY Engineer		8/14/86	Liquid Waste		7/29/86
A.C.E. Design		8/15/86	Traffic		7/31/86
A.C.E. Hydrology			Water		7/31/86

DESIGNED BY B.T.
DRAWN BY M.S.
CHECKED BY E.D.

DRAWING NO. 2879
MAP NO. E-10 & F-10
SHEET 28 OF 36

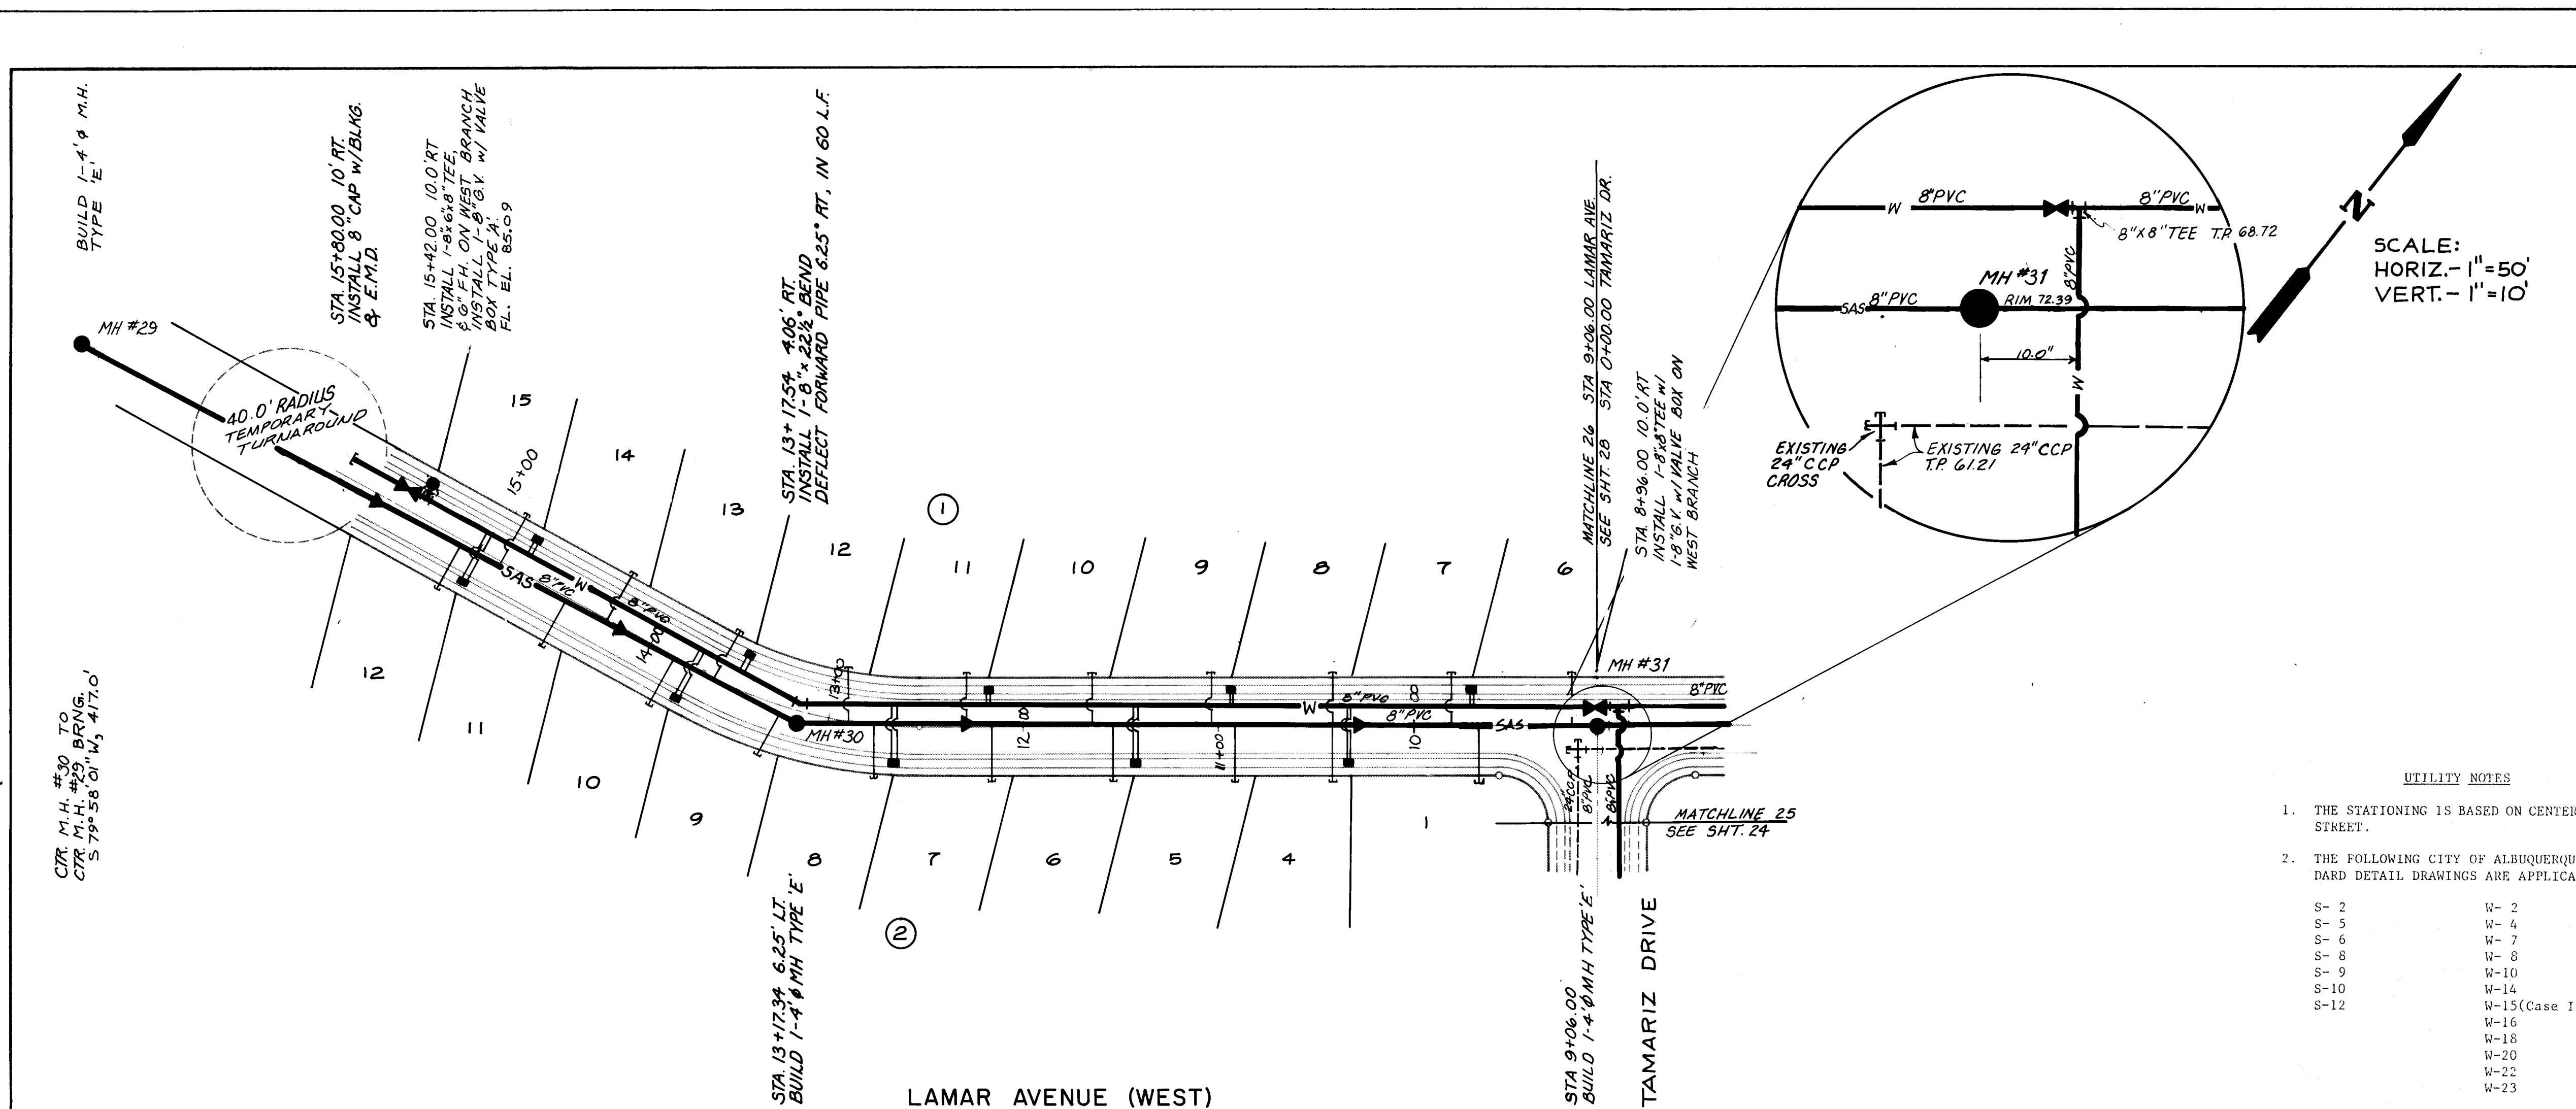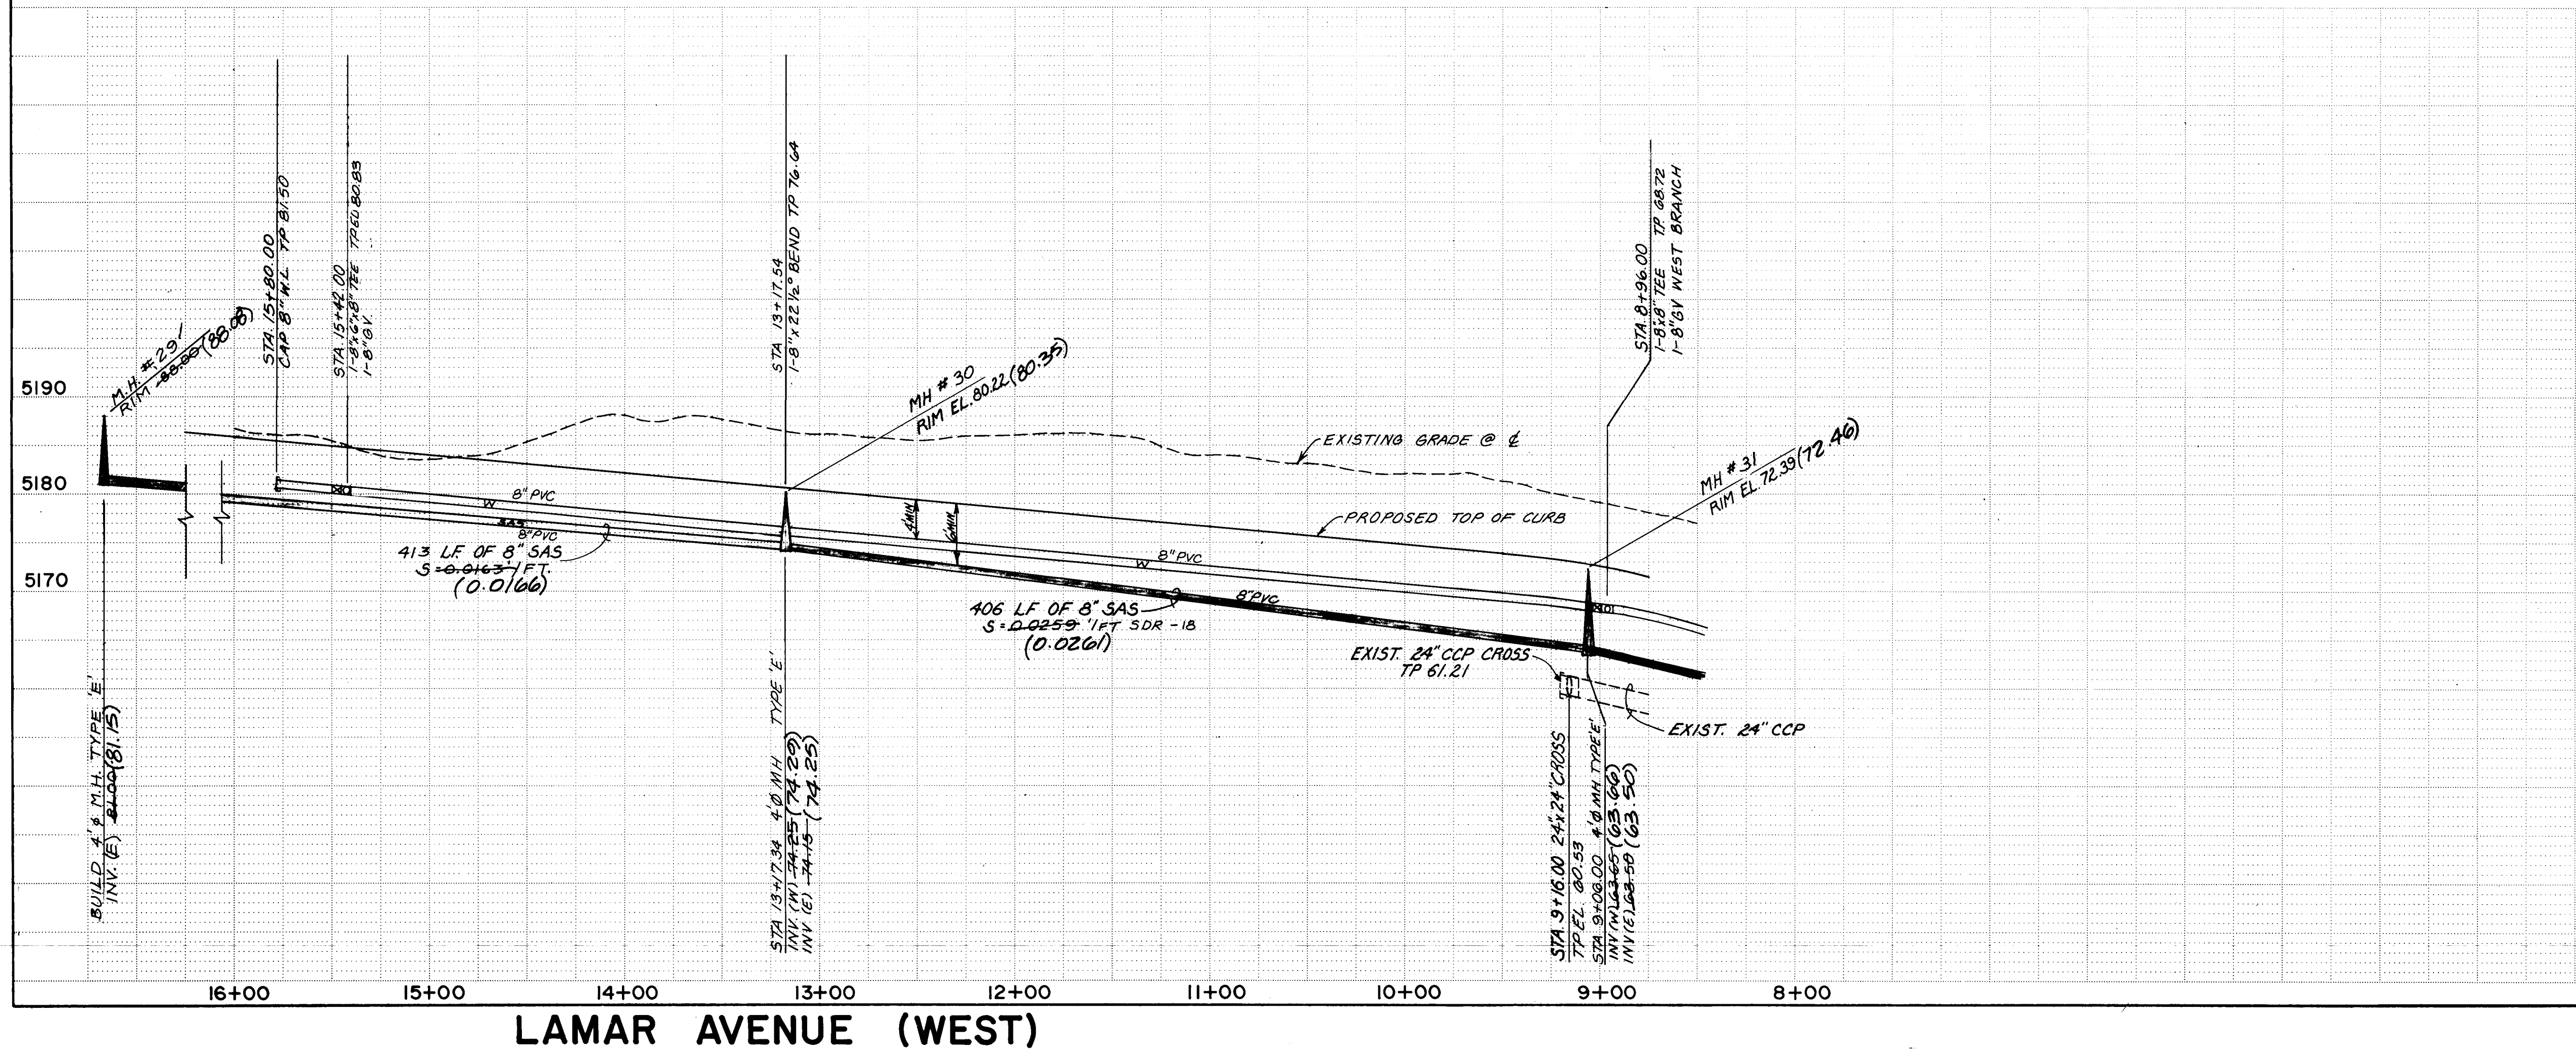

SERVICE LINE LOCATIONS BLOCK NO. 2			
Lot No.	Center Line Station	Service	Invert Elev. at P.L.
1 & 4	9+76.00	SAS	70.24
	10+31.00	WATER	70.13
	10+41.00	SAS	70.13
5 & 6	10+89.13	SAS	72.22
	11+40.13	WATER	73.29
	11+50.13	SAS	73.29
7 & 8	12+15.82	SAS	74.50
	12+65.82	WATER	75.65
	12+75.82	SAS	75.65
9 & 10	13+23.74	SAS	76.51
	13+74.86	WATER	77.60
	13+84.86	SAS	77.60
11 & 12	14+44.86	SAS	78.71
	14+94.86	WATER	79.78
	15+04.86	SAS	79.78

SERVICE LINE LOCATIONS BLOCK NO. 1			
Lot No.	Center Line Station	Service	Invert Elev. at P.L.
6 & 7	9+16.00	SAS	68.53
	9+69.37	WATER	70.18
	9+79.37	SAS	70.18
8 & 9	10+39.37	SAS	71.13
	10+89.37	WATER	72.15
	10+99.37	SAS	72.15
10 & 11	11+59.37	SAS	73.48
	12+09.37	WATER	74.46
	12+19.37	SAS	74.46
12 & 13	13+40.43	SAS	75.58
	13+90.43	WATER	76.81
	13+58.02	SAS	76.81
14 & 15	14+26.30	SAS	78.35
	14+76.82	WATER	79.52
	14+86.82	SAS	79.52

UTILITY NOTES

- THE STATIONING IS BASED ON CENTERLINE OF STREET.
- THE FOLLOWING CITY OF ALBUQUERQUE STANDARD DETAIL DRAWINGS ARE APPLICABLE:

S-	W-
S-2	W-2
S-5	W-4
S-6	W-7
S-8	W-8
S-9	W-10
S-10	W-14
S-12	W-15 (Case 1)
	W-16
	W-18
	W-20
	W-22
	W-23

ELVIDIO V. DINI CERTIFY THAT THE DRAWING IS A TRUE AND CORRECT REPRESENTATION OF THE WORK DONE UNDER MY SUPERVISION



LEGEND

DESCRIPTION	SYMBOL
SANITARY SEWER LINE	—SAS—
SANITARY SEWER MANHOLE	—●—
SAS SERVICE CONNECTION	—T—
WATER LINE	—W—
GATE VALVE	—V—
FIRE HYDRANT	—H—
REDUCER	—R—
TEE	—T—
BENDS	—B—
WATER SERVICE CONNECTION	—T—
CAPS & PLUGS	—C—
CROSS	—X—
SIDEWALK	—S—
STANDARD CURB & GUTTER	—C—
MOUNTABLE CURB & GUTTER	—M—
RESIDENTIAL PAVING	—R—
VALLEY GUTTER (CONC.)	—V—
CROWN TRANSITION AREA	—C—
WHEELCHAIR RAMP (CASE II)	—W—
BARRICADE (TYPE III)	—B—

CITY OF ALBUQUERQUE MUNICIPAL DEVELOPMENT DEPARTMENT ENGINEERING DIVISION			
TITLE: RINCON SUBDIVISION—PHASE I LAMAR AVENUE (WEST) UTILITIES PLAN & PROFILE			
APPROVALS	ENGINEER	DATE	APPROVALS
City Engineer	John H. [Signature]	8/14/86	Liquid Waste
A.C.E. Design	John H. [Signature]	8/15/86	Traffic
Hydrology	John H. [Signature]	8/15/86	Water

DESIGNED BY B.T.		DATE 6/86	
DRAWN BY M.S.		DATE 6/86	
CHECKED BY E.D.		DATE 6/86	

DRAWING NO. 2879		MAP NO. E-10 & F-10		SHEET 29 OF 36	
------------------	--	---------------------	--	----------------	--

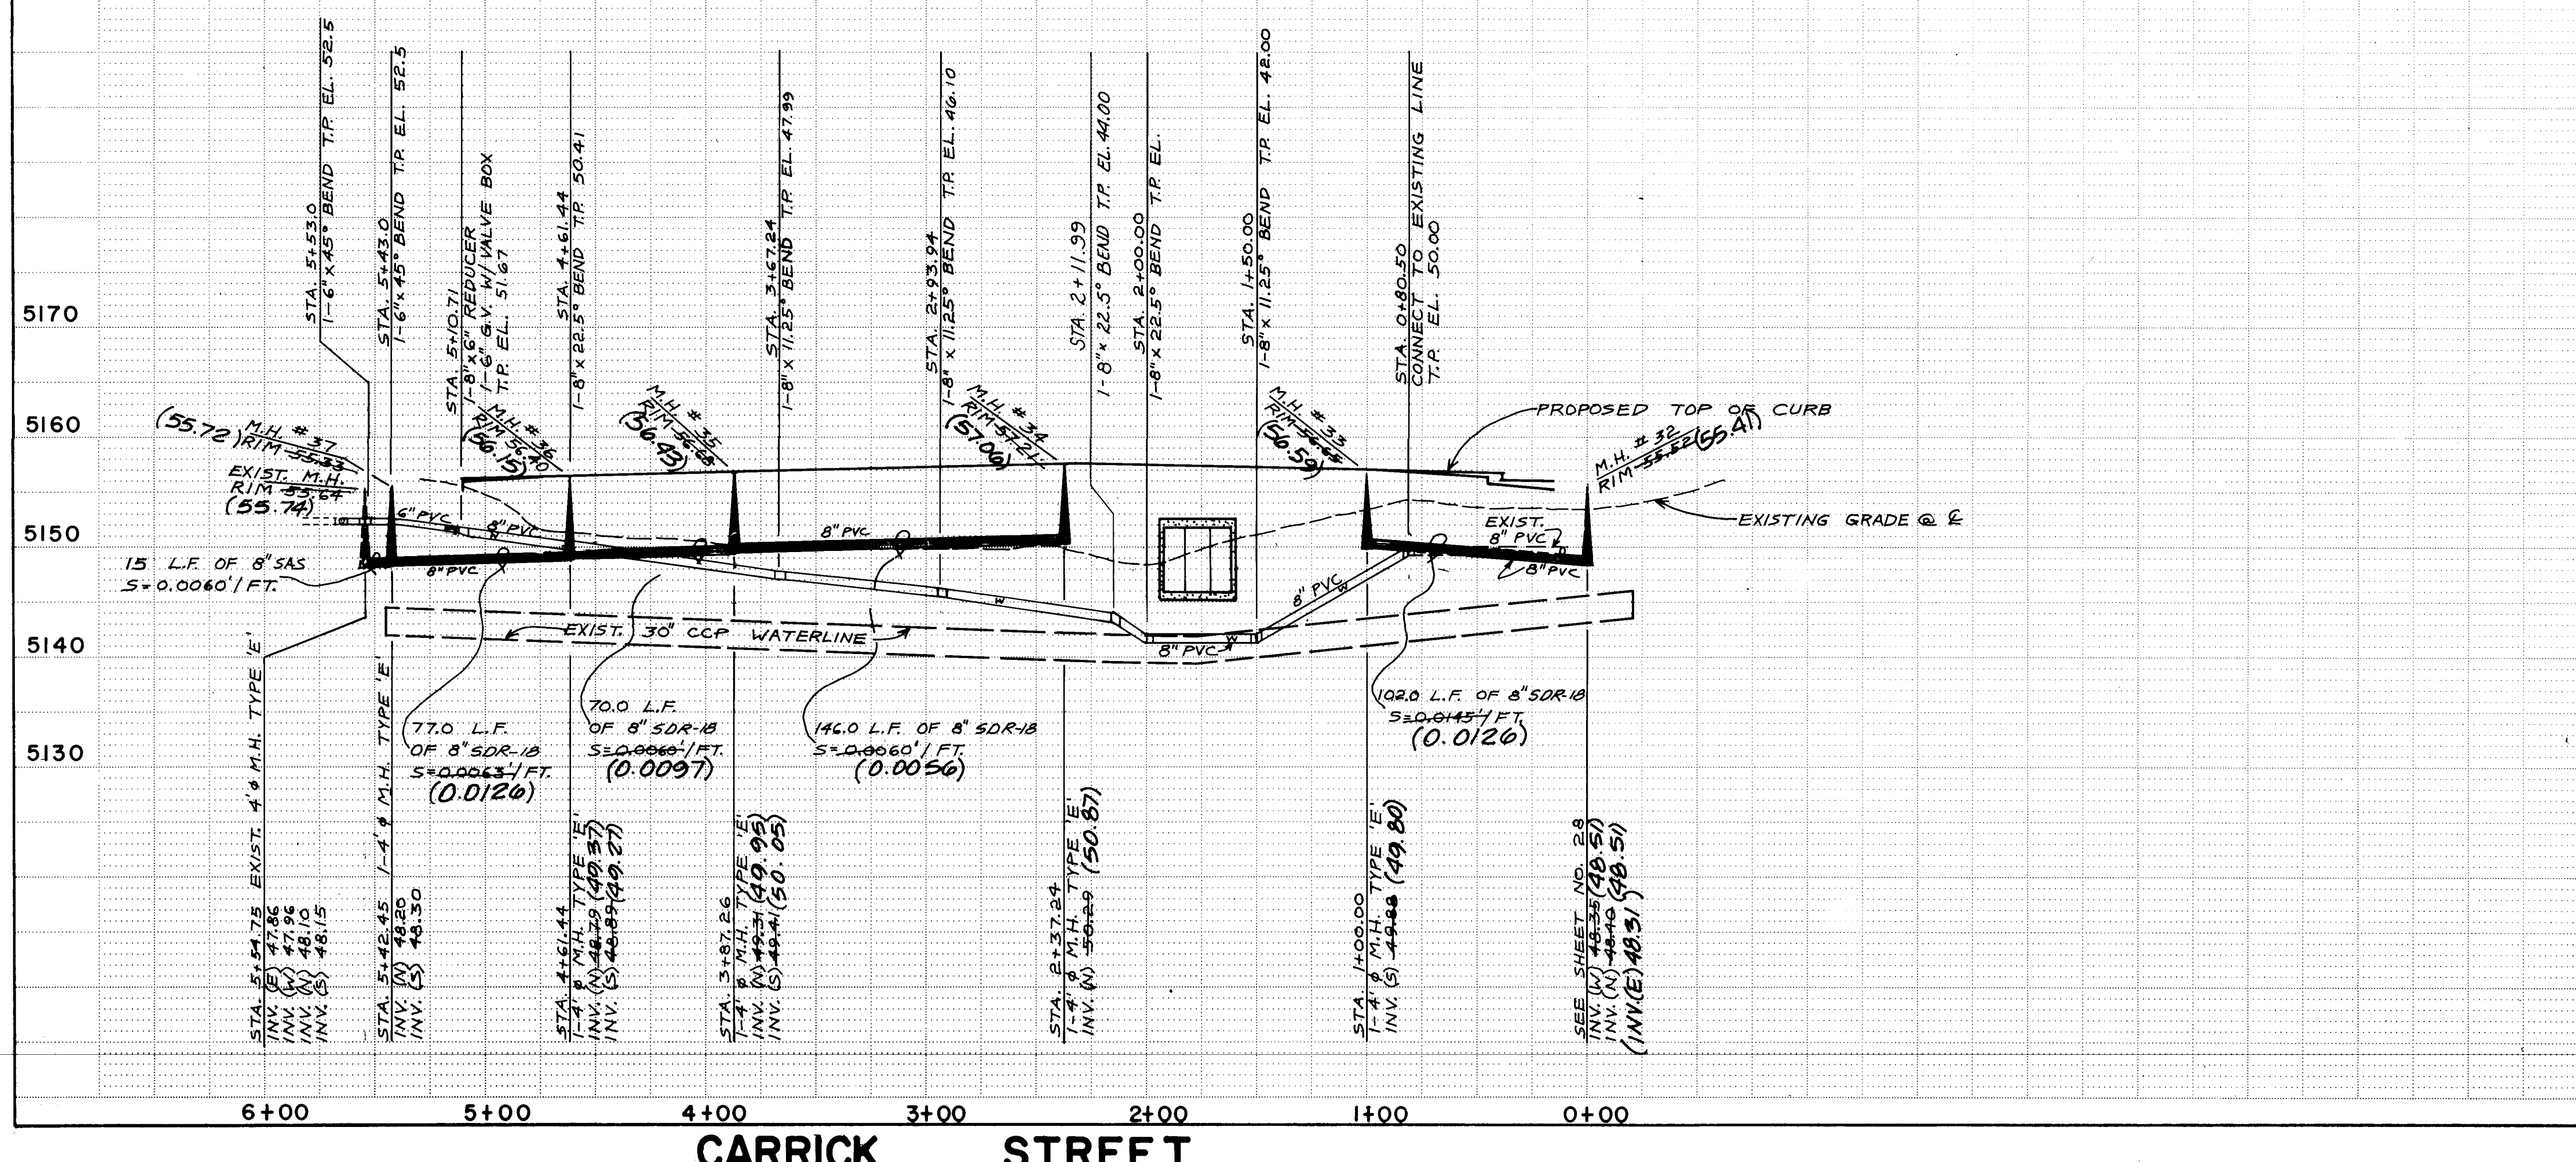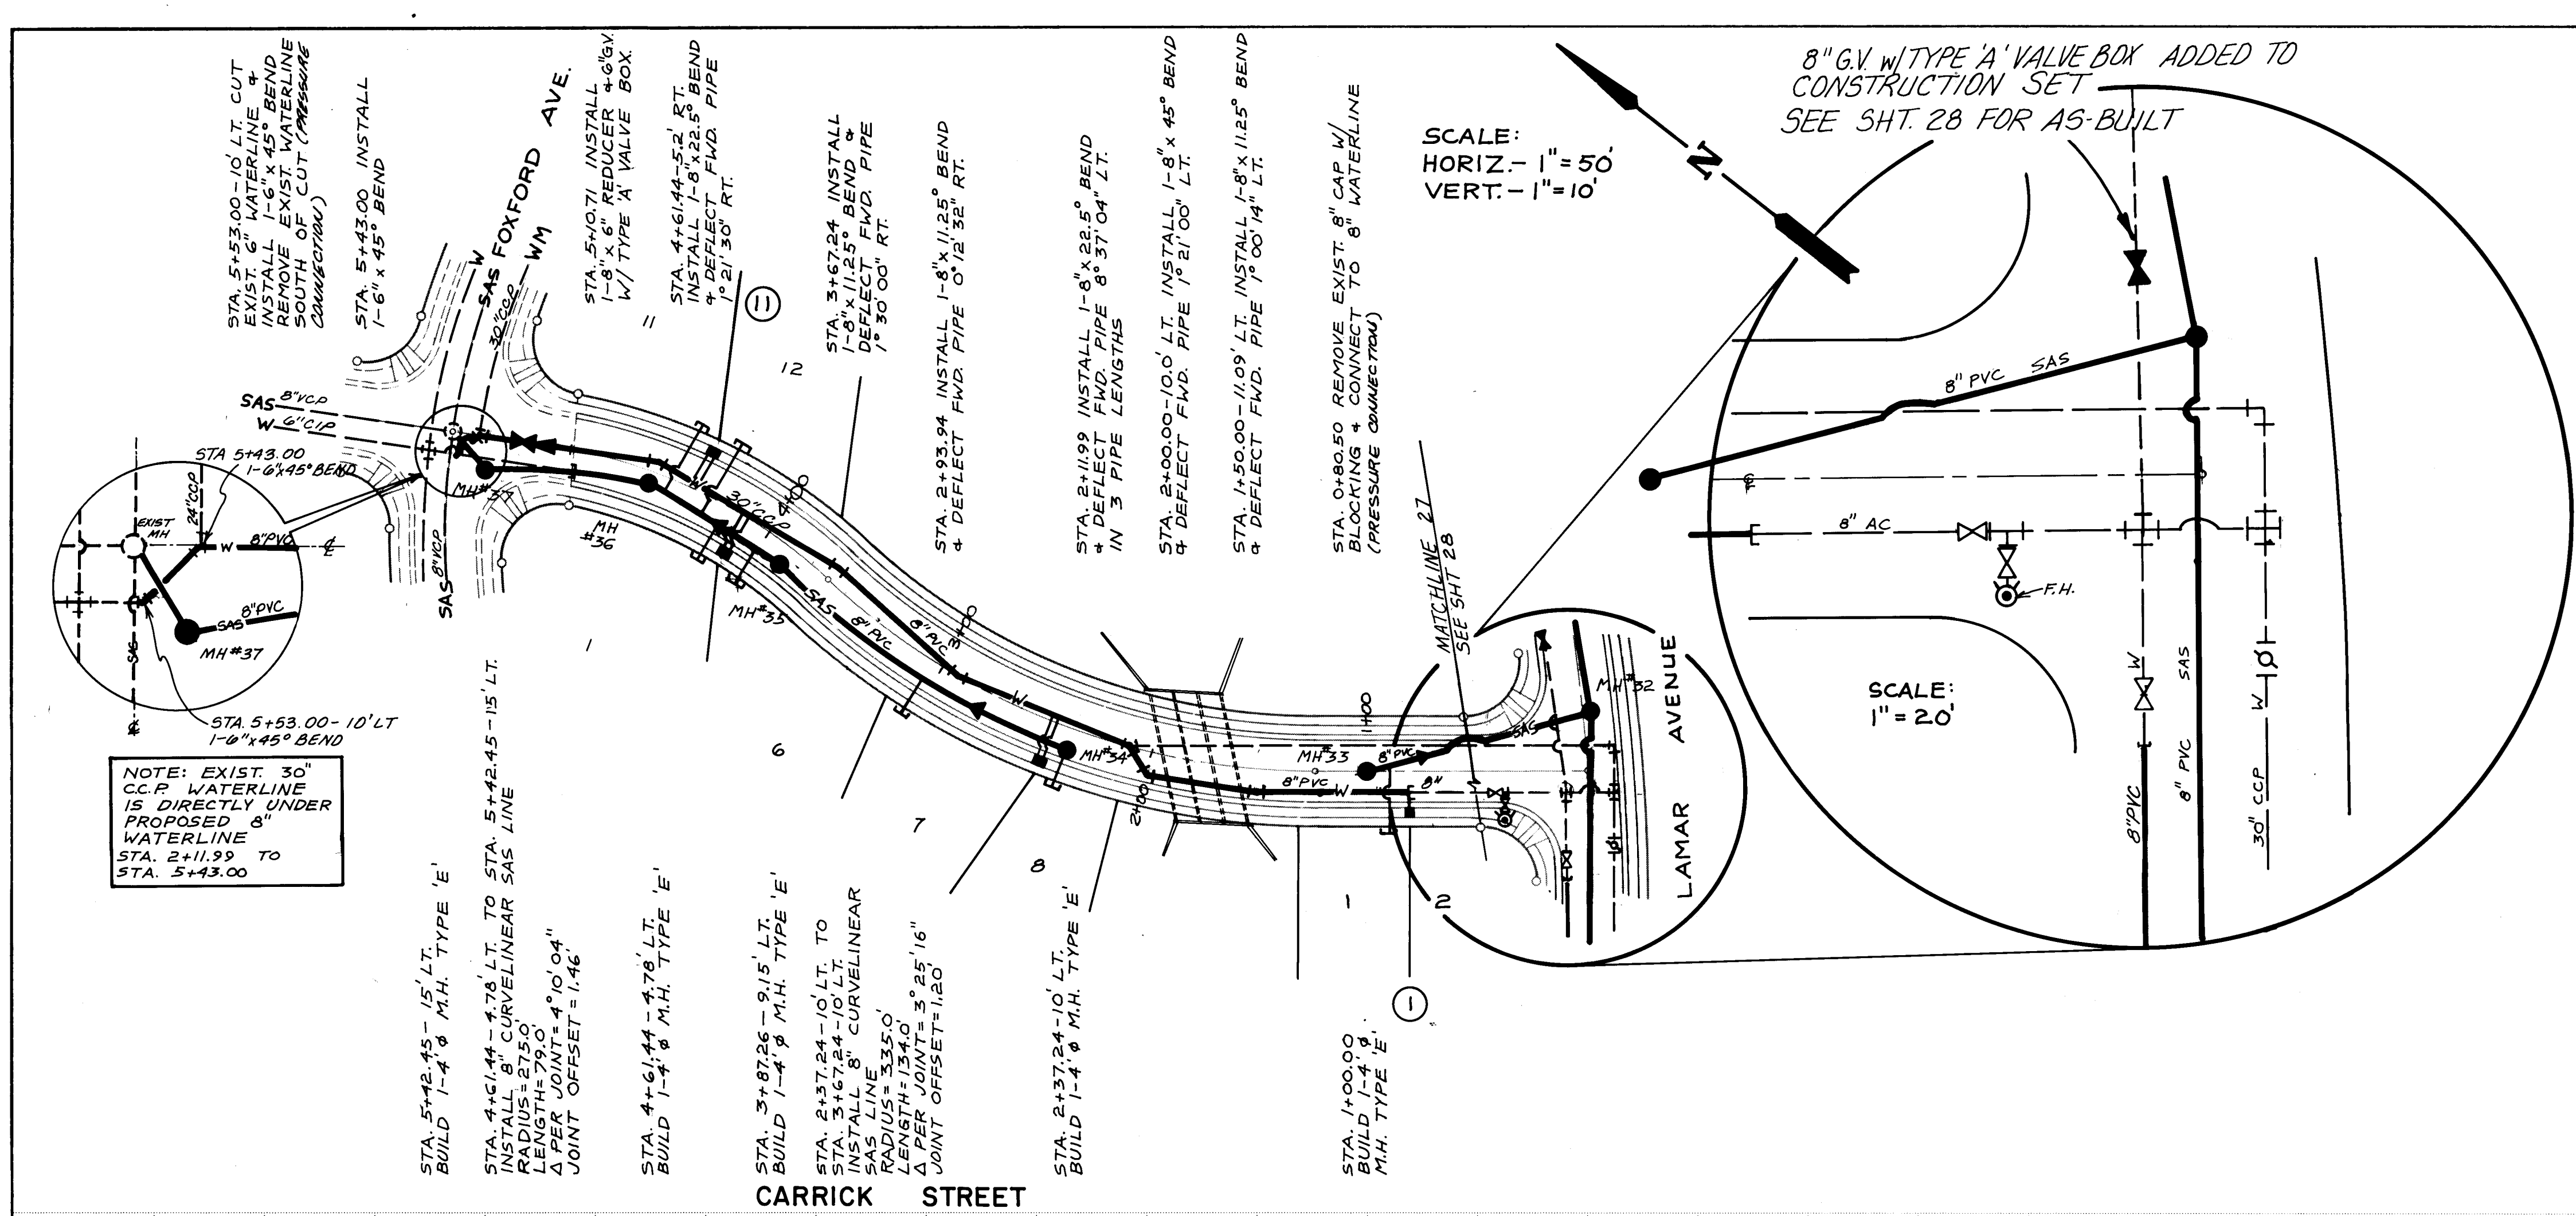

SERVICE LINE LOCATIONS
BLOCK NO. 1

Lot No.	Center Line Station	Service	Invert Elev. at P.L.
1	0+80.76 0+90.76	WATER SAS	53.01
8 & 7	2+36.79 2+46.79 3+04.12	SAS WATER SAS	53.62 53.12
6 & 1	4+01.04 4+11.04 4+21.04	SAS WATER SAS	52.68 52.51

SERVICE LINE LOCATIONS
BLOCK NO. 11

Lot No.	Center Line Station	Service	Invert Elev. at P.L.
12 & 11	4+24.18 4+34.18 4+44.18	SAS WATER SAS	52.61 52.48

UTILITY NOTES

- THE STATIONING IS BASED ON CENTERLINE OF STREET.
- THE FOLLOWING CITY OF ALBUQUERQUE STANDARD DETAIL DRAWINGS ARE APPLICABLE:

S-2	W-2
S-5	W-4
S-6	W-7
S-8	W-8
S-9	W-10
S-10	W-14
S-12	W-15 (Case I)
	W-16
	W-18
	W-20
	W-22
	W-23

LEGEND





SANITARY SEWER LINE	— SAS —
SANITARY SEWER MANHOLE	— T —
SAS SERVICE CONNECTION	— T —
WATER LINE	— W —
GATE VALVE	— V —
FIRE HYDRANT	— F —
REDUCER	— R —
TEE	— T —
BENDS	— B —
WATER SERVICE CONNECTION	— W —
CAPS & PLUGS	— C —
CROSS	— X —
SIDEWALK	— S —
STANDARD CURB & GUTTER	— C —
MOUNTABLE CURB & GUTTER	— M —
RESIDENTIAL PAVING	— R —
VALLEY GUTTER (CONC.)	— V —
CROWN TRANSITION AREA	— T —
WHEELCHAIR RAMP (CASE II)	— W —
BARRICADE (TYPE III)	— B —

CITY OF ALBUQUERQUE
MUNICIPAL DEVELOPMENT DEPARTMENT
ENGINEERING DIVISION

TITLE: RINCON SUBDIVISION—PHASE I
CARRICK STREET
UTILITIES PLAN & PROFILE

APPROVALS	ENGINEER	DATE	APPROVALS	ENGINEER	DATE
City Engineer	[Signature]	8/14/86	Liquid Waste	[Signature]	7/23/86
A.C.E. Design	[Signature]	8/14/86	Traffic	[Signature]	7/23/86
Hydrology	[Signature]	8/14/86	Water	[Signature]	7/23/86

DRAWING NO. 2879 **MAP NO. E-10 & F-10** **SHEET 30 OF 36**

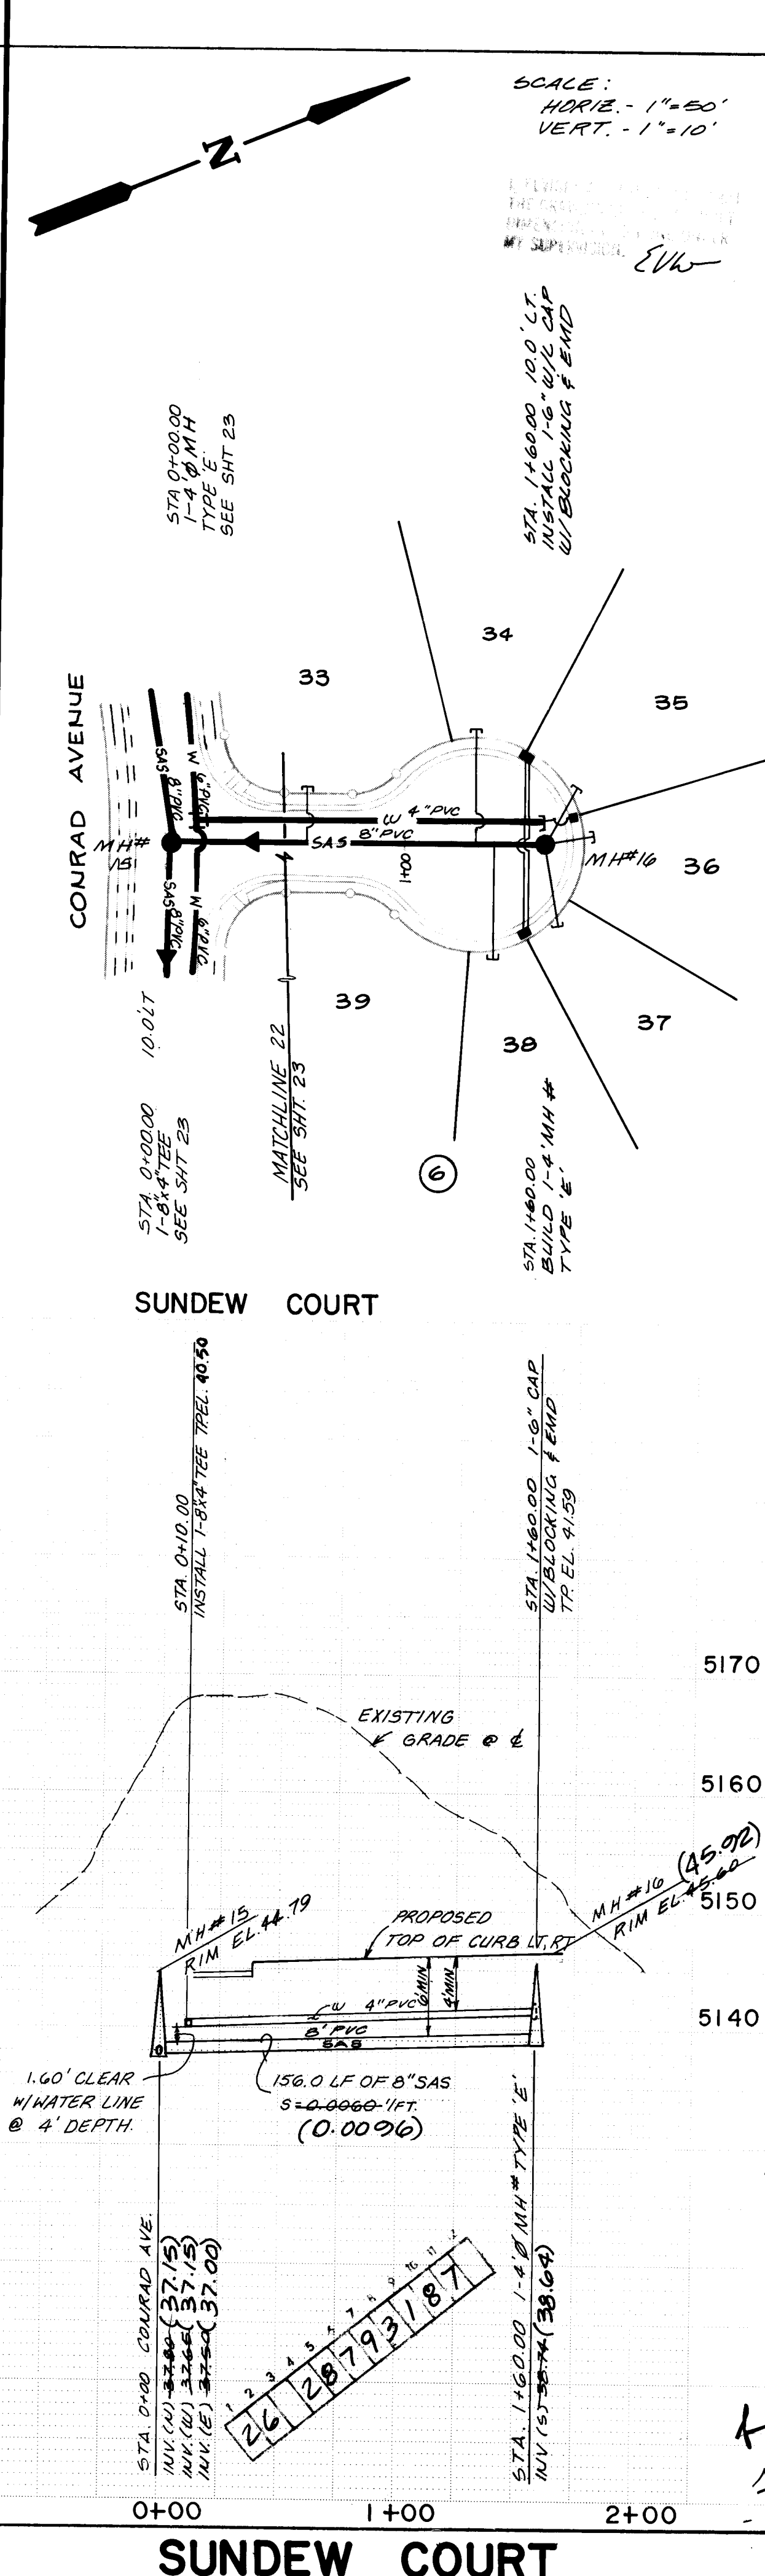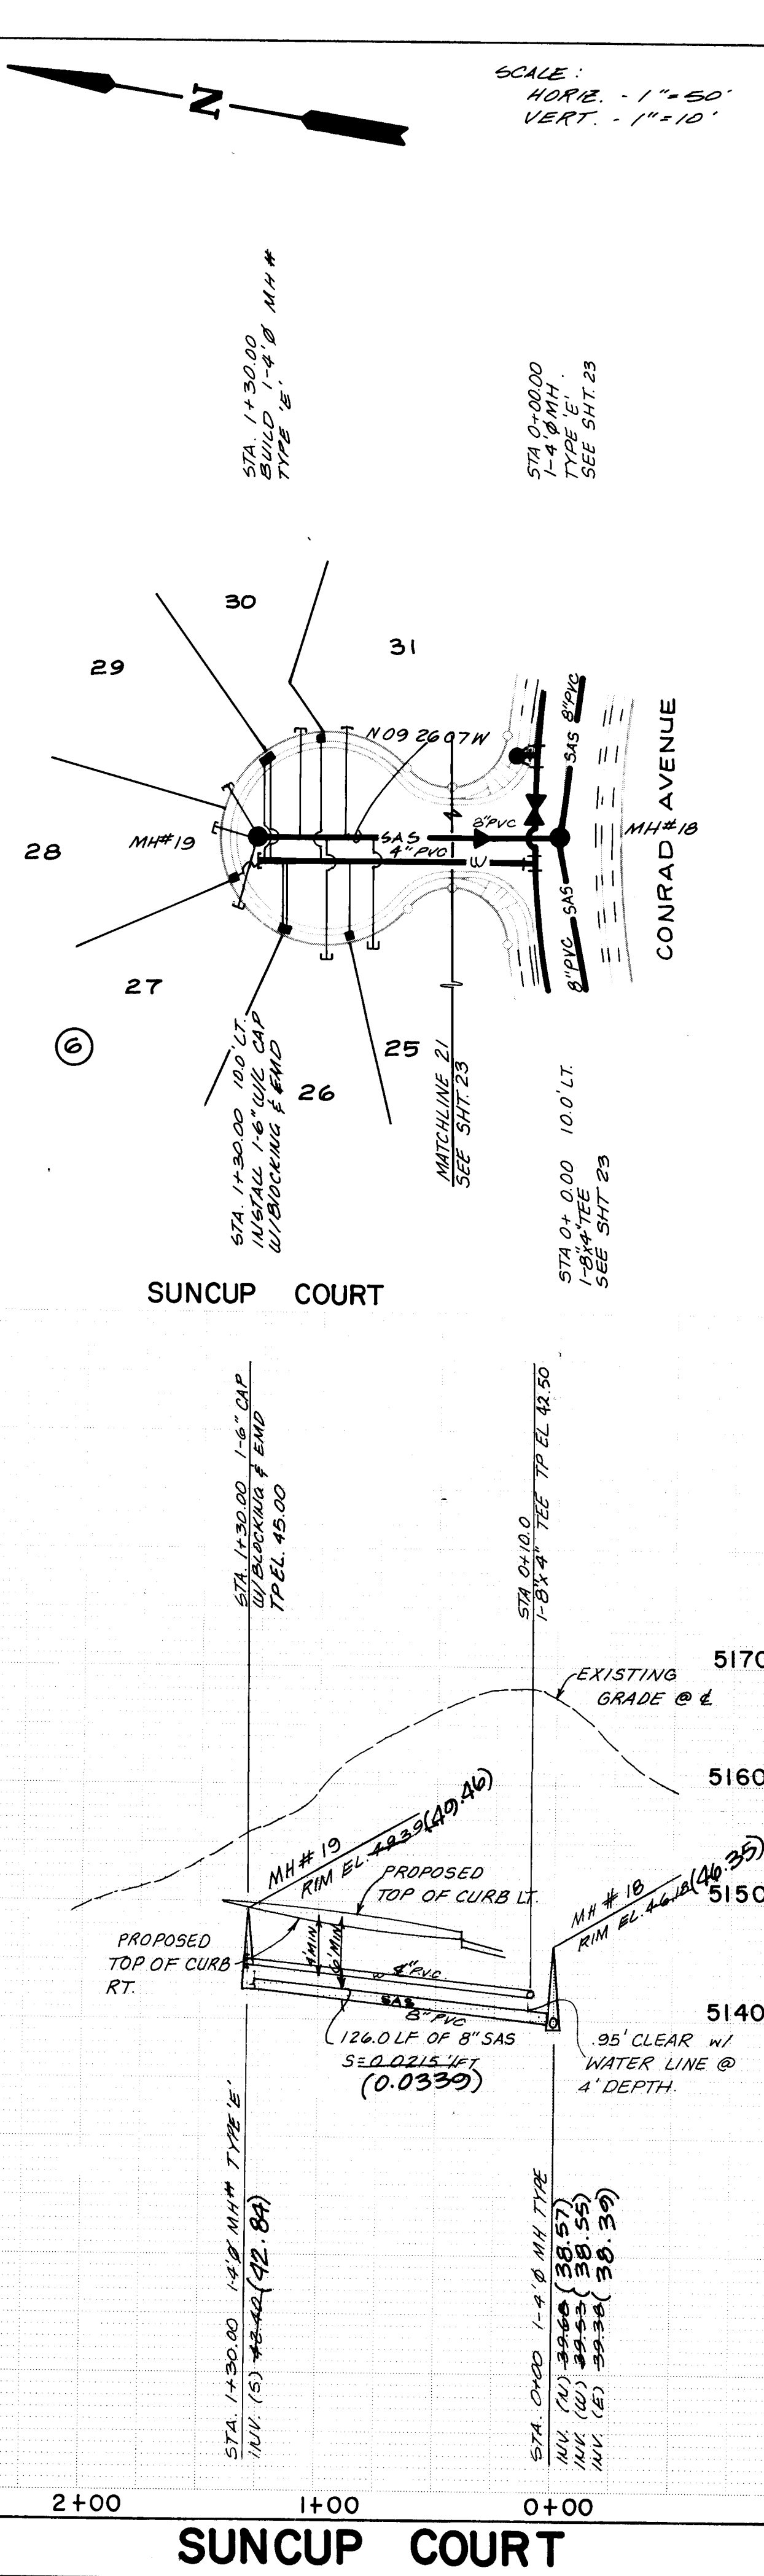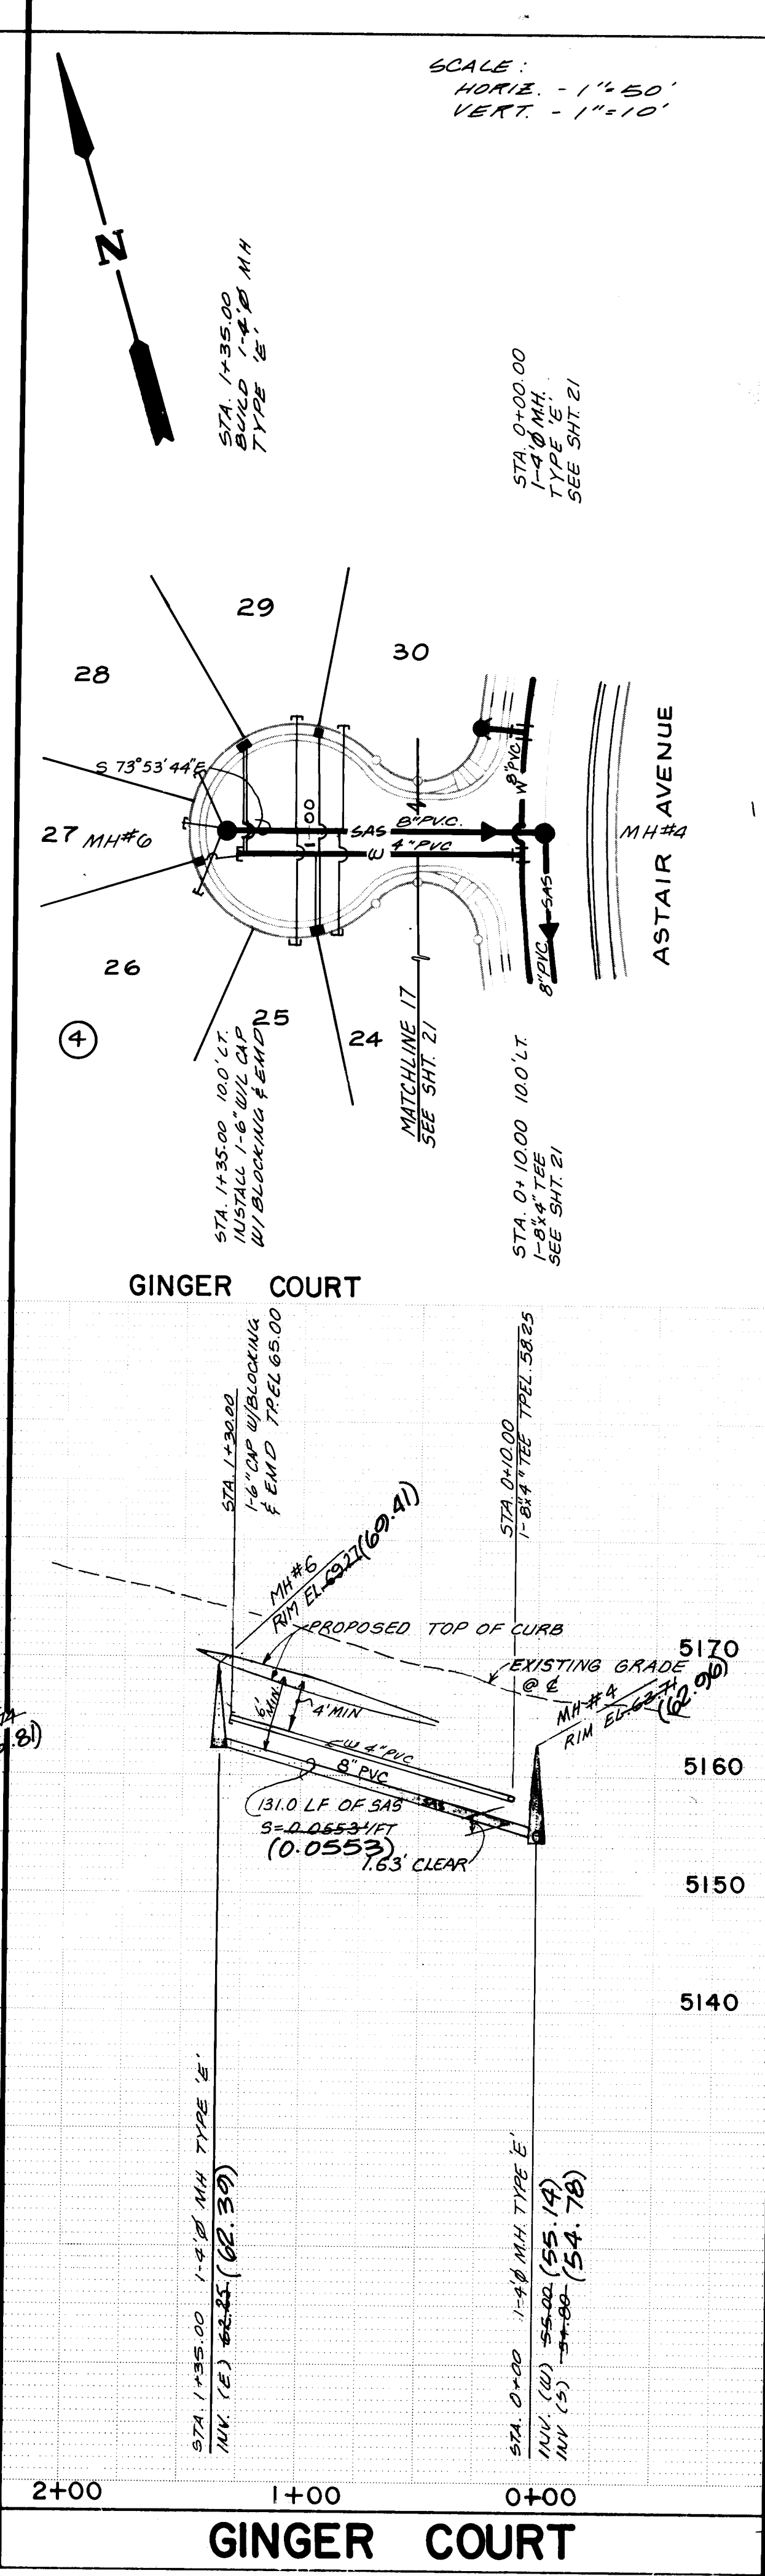
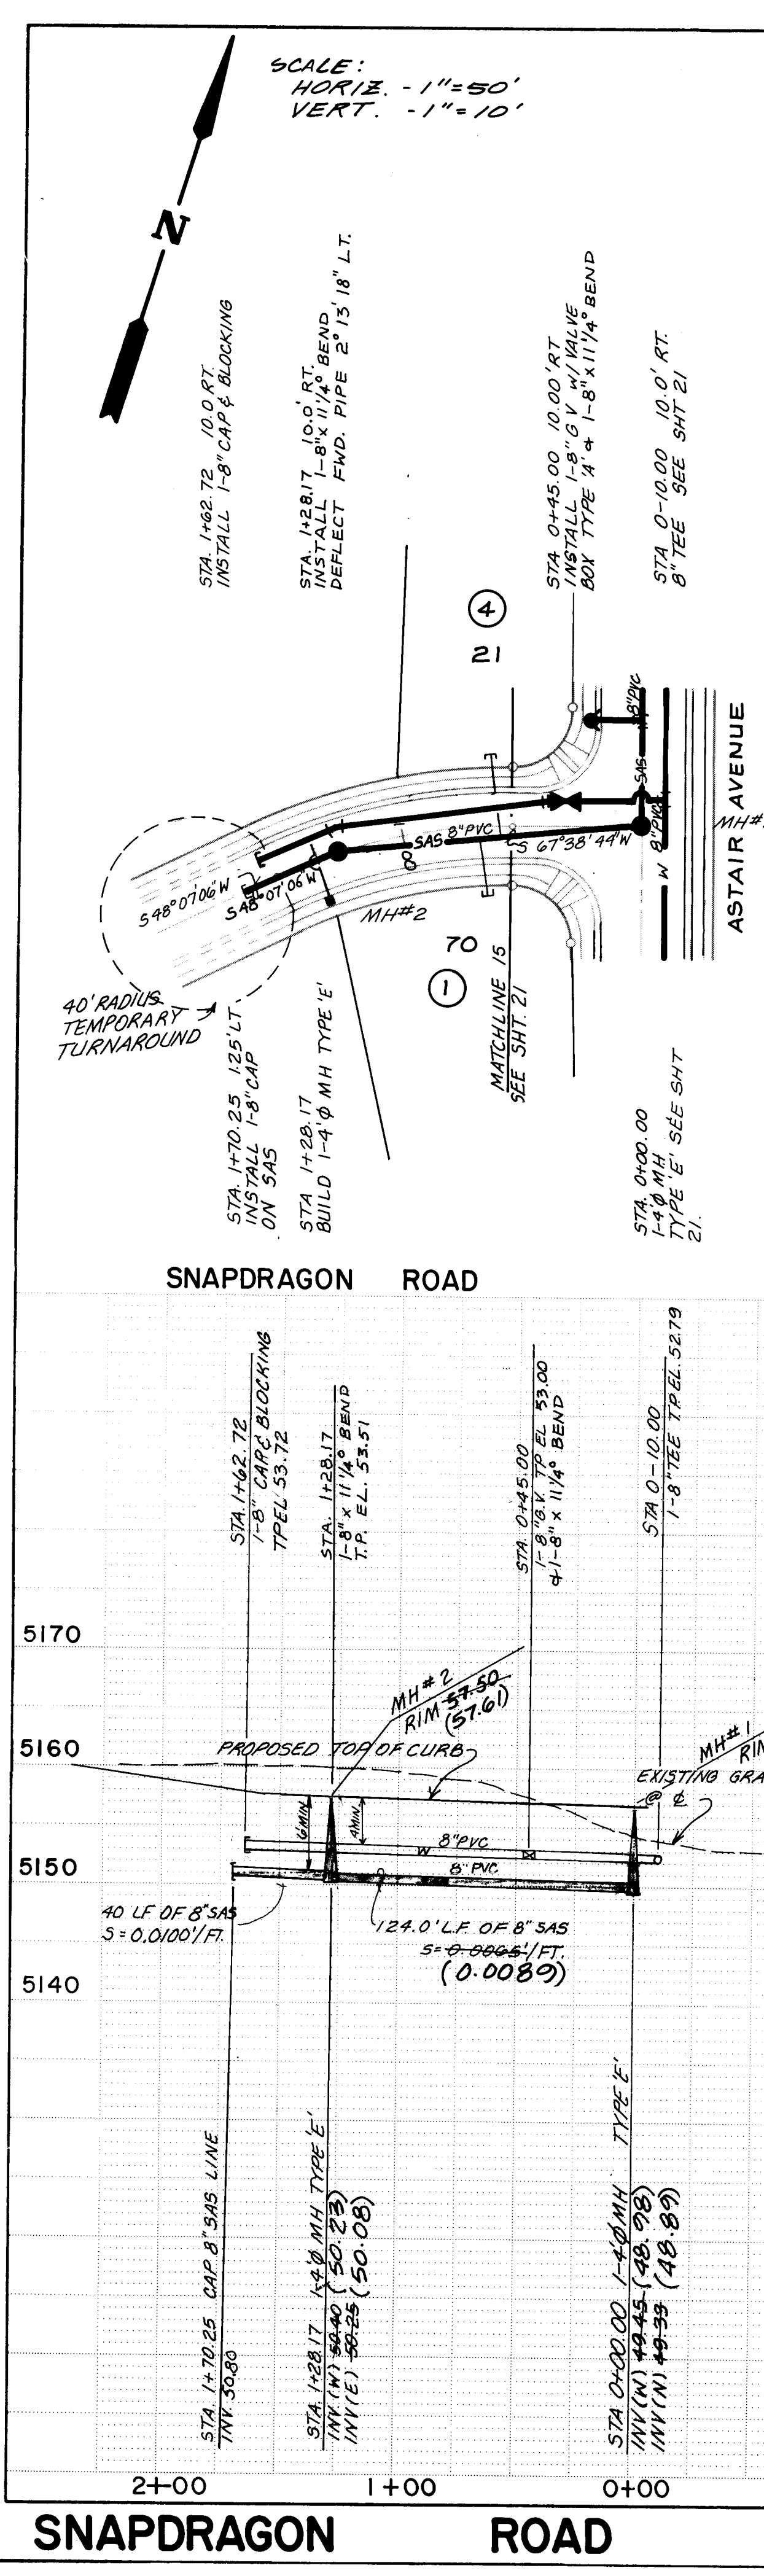


SERVICE LINE LOCATIONS			
Lot No.	Center Line Station	Service Invert Elev. at P.L.	
21	0+60.00	SAS 53.09	
BLOCK NO. 1			
70	0+68.73	SAS 53.13	
BLOCK NO. 4			
30	0+85.94	SAS 63.80	
29 & 28	1+05.94	SAS 64.58	
24 & 25	1+45.63	SAS 70.48	
26 & 27	1+45.26	SAS 70.45	
BLOCK NO. 6			
31 & 30	0+91.06	SAS 44.16	
29 & 28	1+23.11	SAS 46.00	
26 & 27	1+46.13	SAS 46.18	
25	0+79.41	SAS 45.98	
BLOCK NO. 6			
33 & 34	0+58.63	SAS 41.78	
35 & 36	1+50.00	SAS 42.23	
38 & 37	1+37.50	SAS 42.09	





LEGEND			
SANITARY SEWER LINE	SAS		
SANITARY SEWER MANHOLE			
SAS SERVICE CONNECTION			
WATER LINE	W		
GATE VALVE			
FIRE HYDRANT			
REDUCER			
TEE			
BENDS			
WATER SERVICE CONNECTION			
CAPS & PLUGS			
CROSS			
SIDEWALK			
STANDARD CURB & GUTTER			
MOUNTABLE CURB & GUTTER			
RESIDENTIAL PAVING			
VALLEY GUTTER (CONC.)			
CROWN TRANSITION AREA			
WHEELCHAIR RAMP (CASE II)			
BARRICADE (TYPE III)			

CITY OF ALBUQUERQUE			
MUNICIPAL DEVELOPMENT DEPARTMENT			
ENGINEERING DIVISION			
TITLE: RINCON SUBDIVISION - PHASE I			
SNAPDRAGON RD., GINGER CT., SUNCUP CT., & SUNDEW CT., UTILITIES PLAN & PROFILE			
APPROVALS	ENGINEER	DATE	APPROVALS
City Engineer	Robert J. Kelly	9/14/06	Liquid Waste
A.C.E. Design	Robert J. Kelly	6/15/06	Traffic
A.C.E. Hydrology	Robert J. Kelly	6/15/06	Water
DESIGNED BY	DRAWN BY	CHECKED BY	DATE
B.T.	M.S.	E.D.	7/29/06
DRAWING NO. 2879			
MAP NO. E-10 & F-10			
SHEET 31 OF 36			

HORIZ. - $1^{\circ} = 20'$
 VERT. - $1'' = 5'$

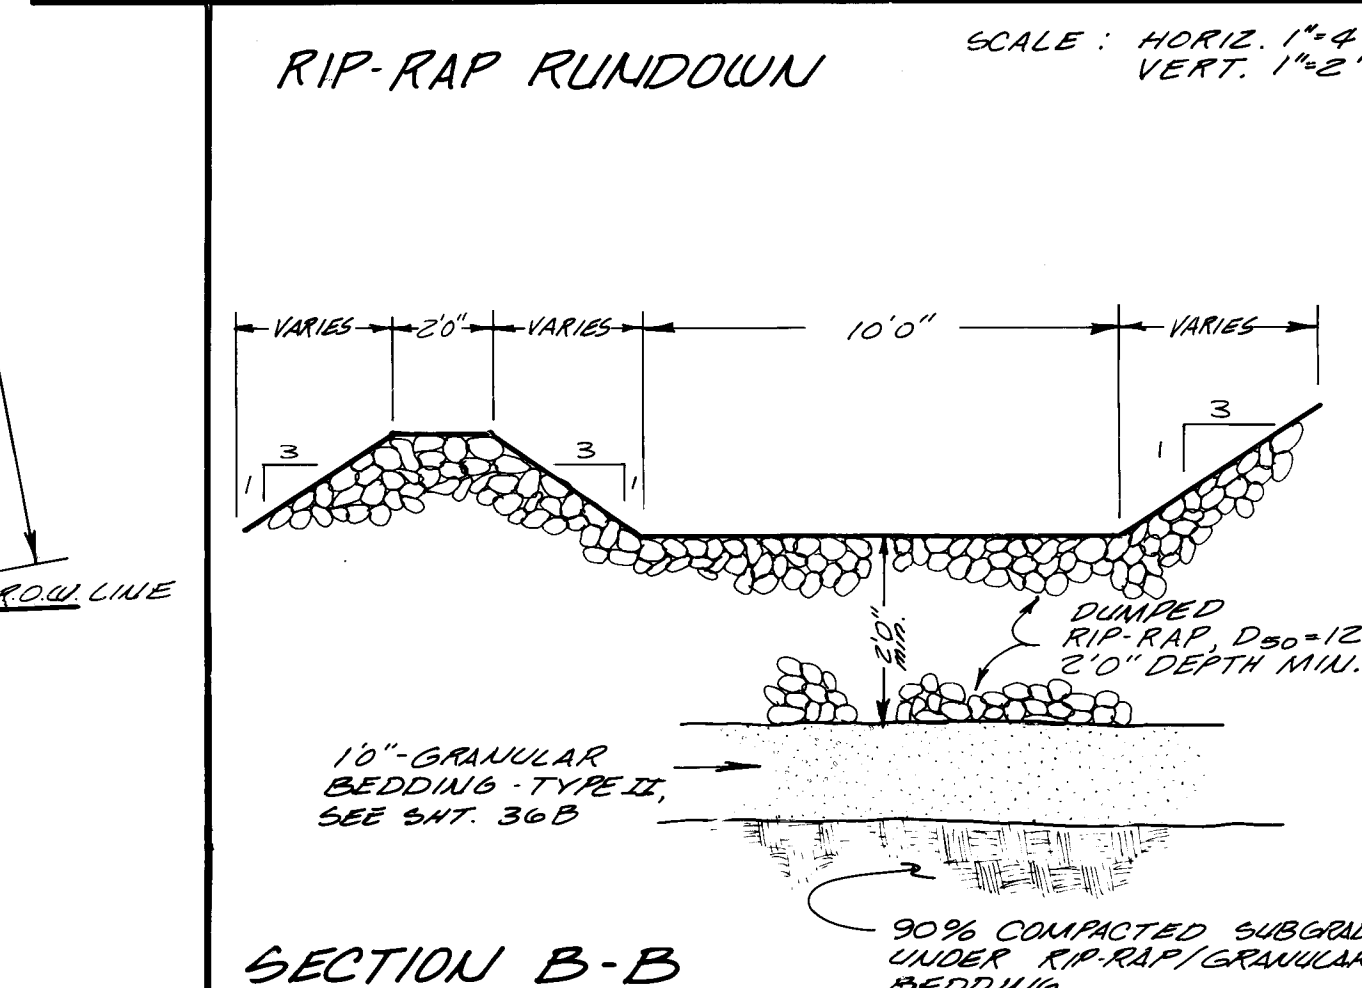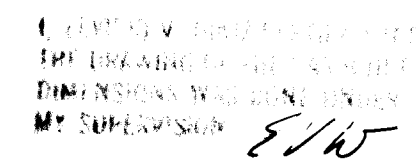

1	420	1	500	1	500
---	-----	---	-----	---	-----

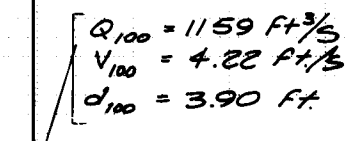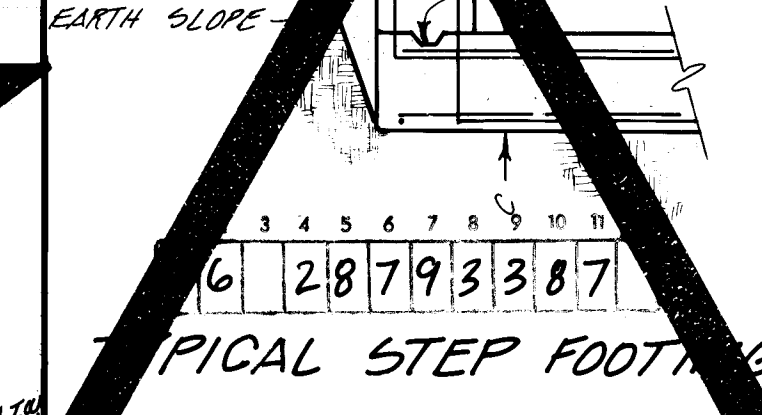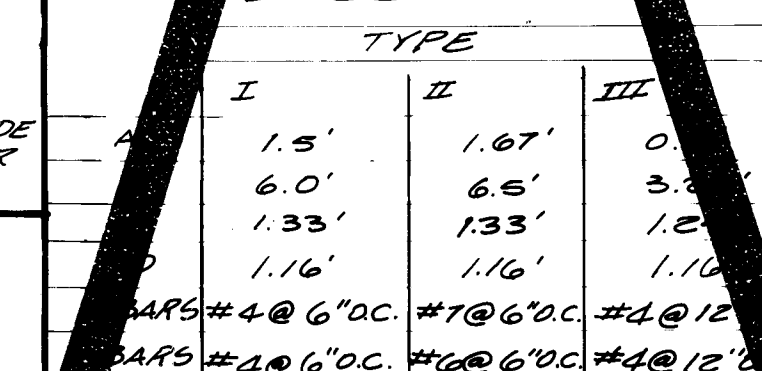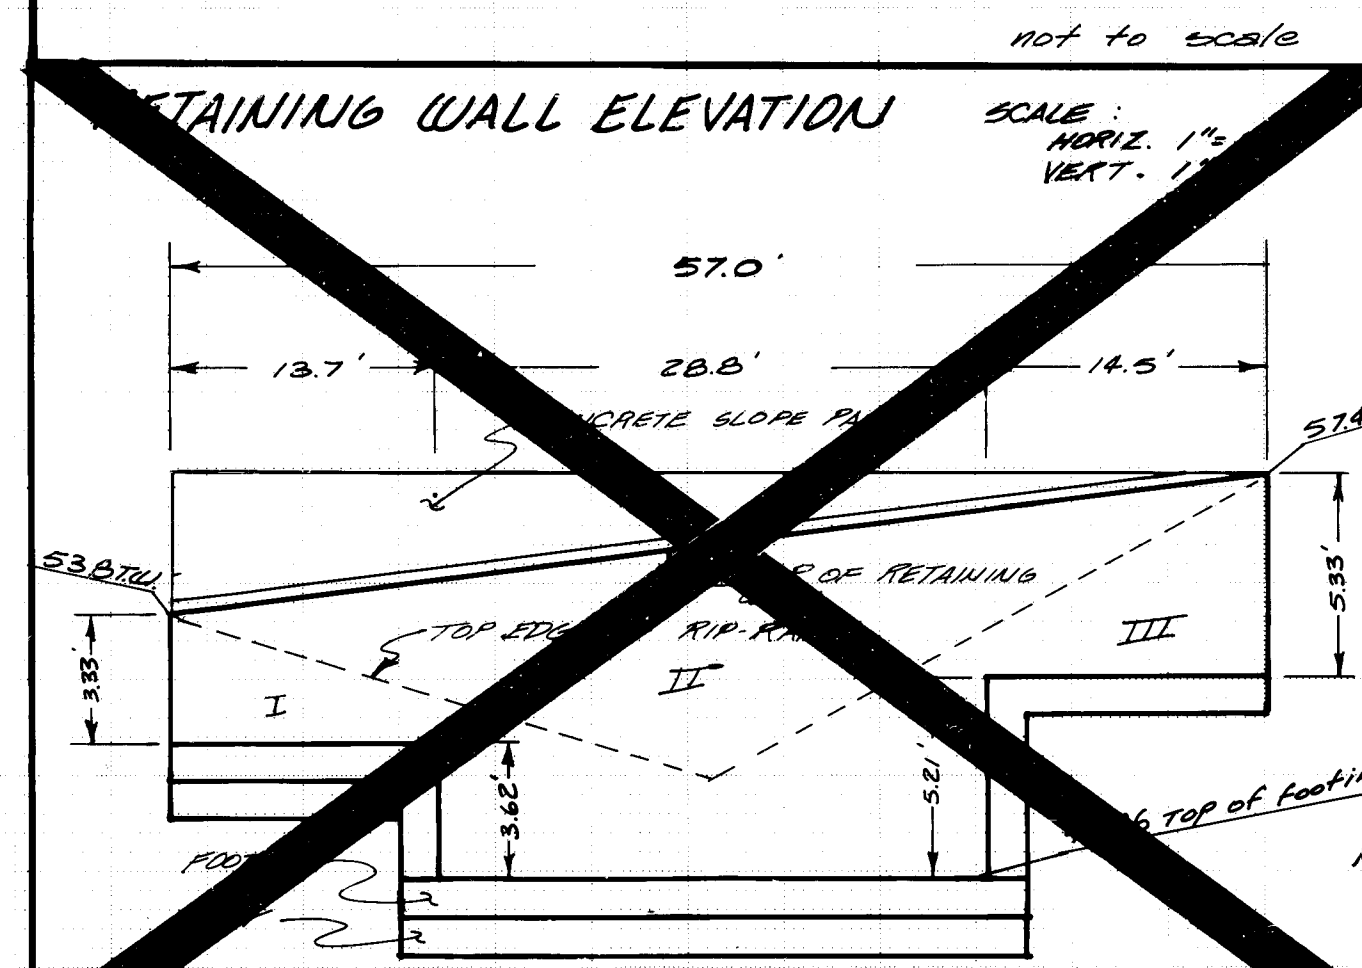


CARRICK STREET BOX CULVERT - PLAN & PROFILE

CITY OF ALBUQUERQUE MUNICIPAL DEVELOPMENT DEPARTMENT ENGINEERING DIVISION					
TITLE: RINCON SUBDIVISION - PHASE I					
CARRICK STREET BOX CULVERT					
APPROVALS	ENGINEER	DATE	APPROVALS	ENGINEER	DATE
City Engineer	<i>[Signature]</i>	8/14/86	Liquid Waste	N/A N/W	7/29/86
A C E - Design	<i>[Signature]</i>	8/5/86	Traffic	N/A D/H	7/31/86
A C E - Hydrology	<i>[Signature]</i>	"	Water	N/A W/W	7/29/86
DRAWING NO.	2879		MAP NO.	SHEET 33 OF 36	


[illegible]

BAR DETAILS	
cl c2	M minus 3"
zbr in	Tubulated Length
p	SO minus 3"
T bars	L + (10" at each end)

SEE GEN. NOTE NO. 4 -



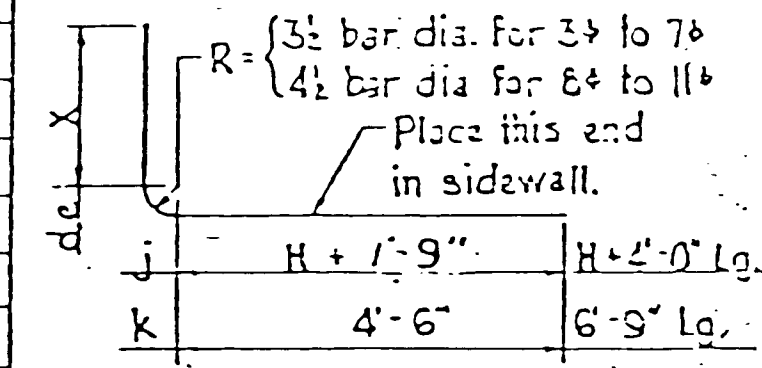


j-bars same size as d-bars
k-bars same size as e-bars

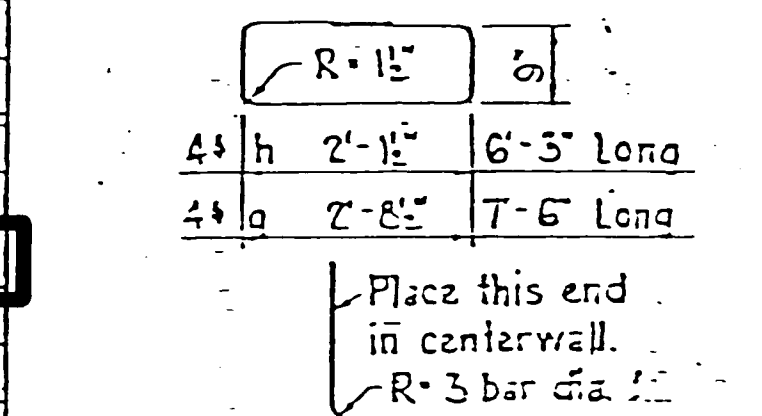



c3 & c4 | 12 bars dia.

NUMBER OF BARS REQUIRED
 $a_1, a_2, b_1, b_2, m_1 \& n_1$: 12L ÷ Spacing;
 $a_2, b_2, c_2, d_2, m_2 \& n_2$: 24L ÷ Spacing;
 c_1 : (24L ÷ Spacing) + 2 at each end;
 $d_3 \& c_4$: (43L ÷ Spacing) + 4 at ea. end;
 j, k : 4 of ea. (for cutoff and parapet)
 at each end;
 p : 12 (for cutoff & parapet) at each end.
 Other bars: see table.
 L = Length of Barrel in feet.

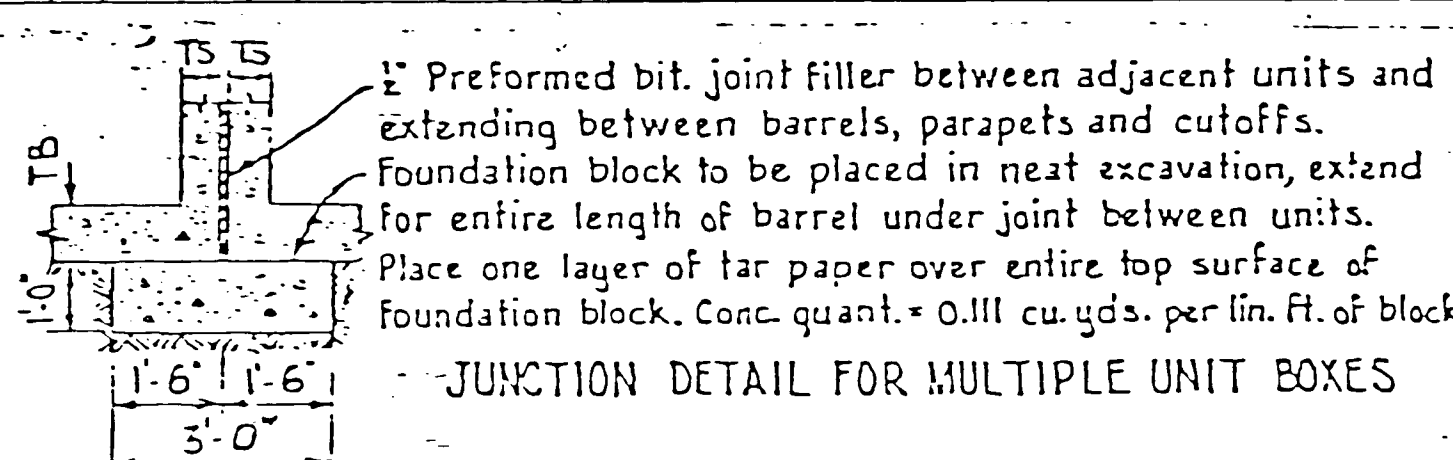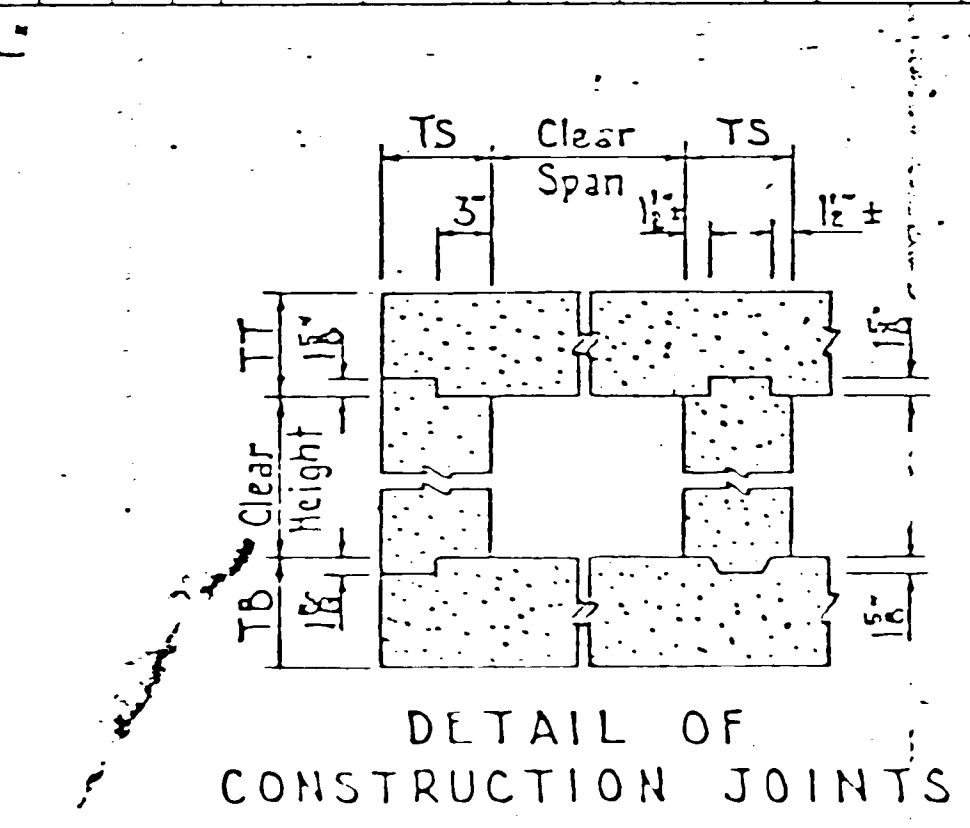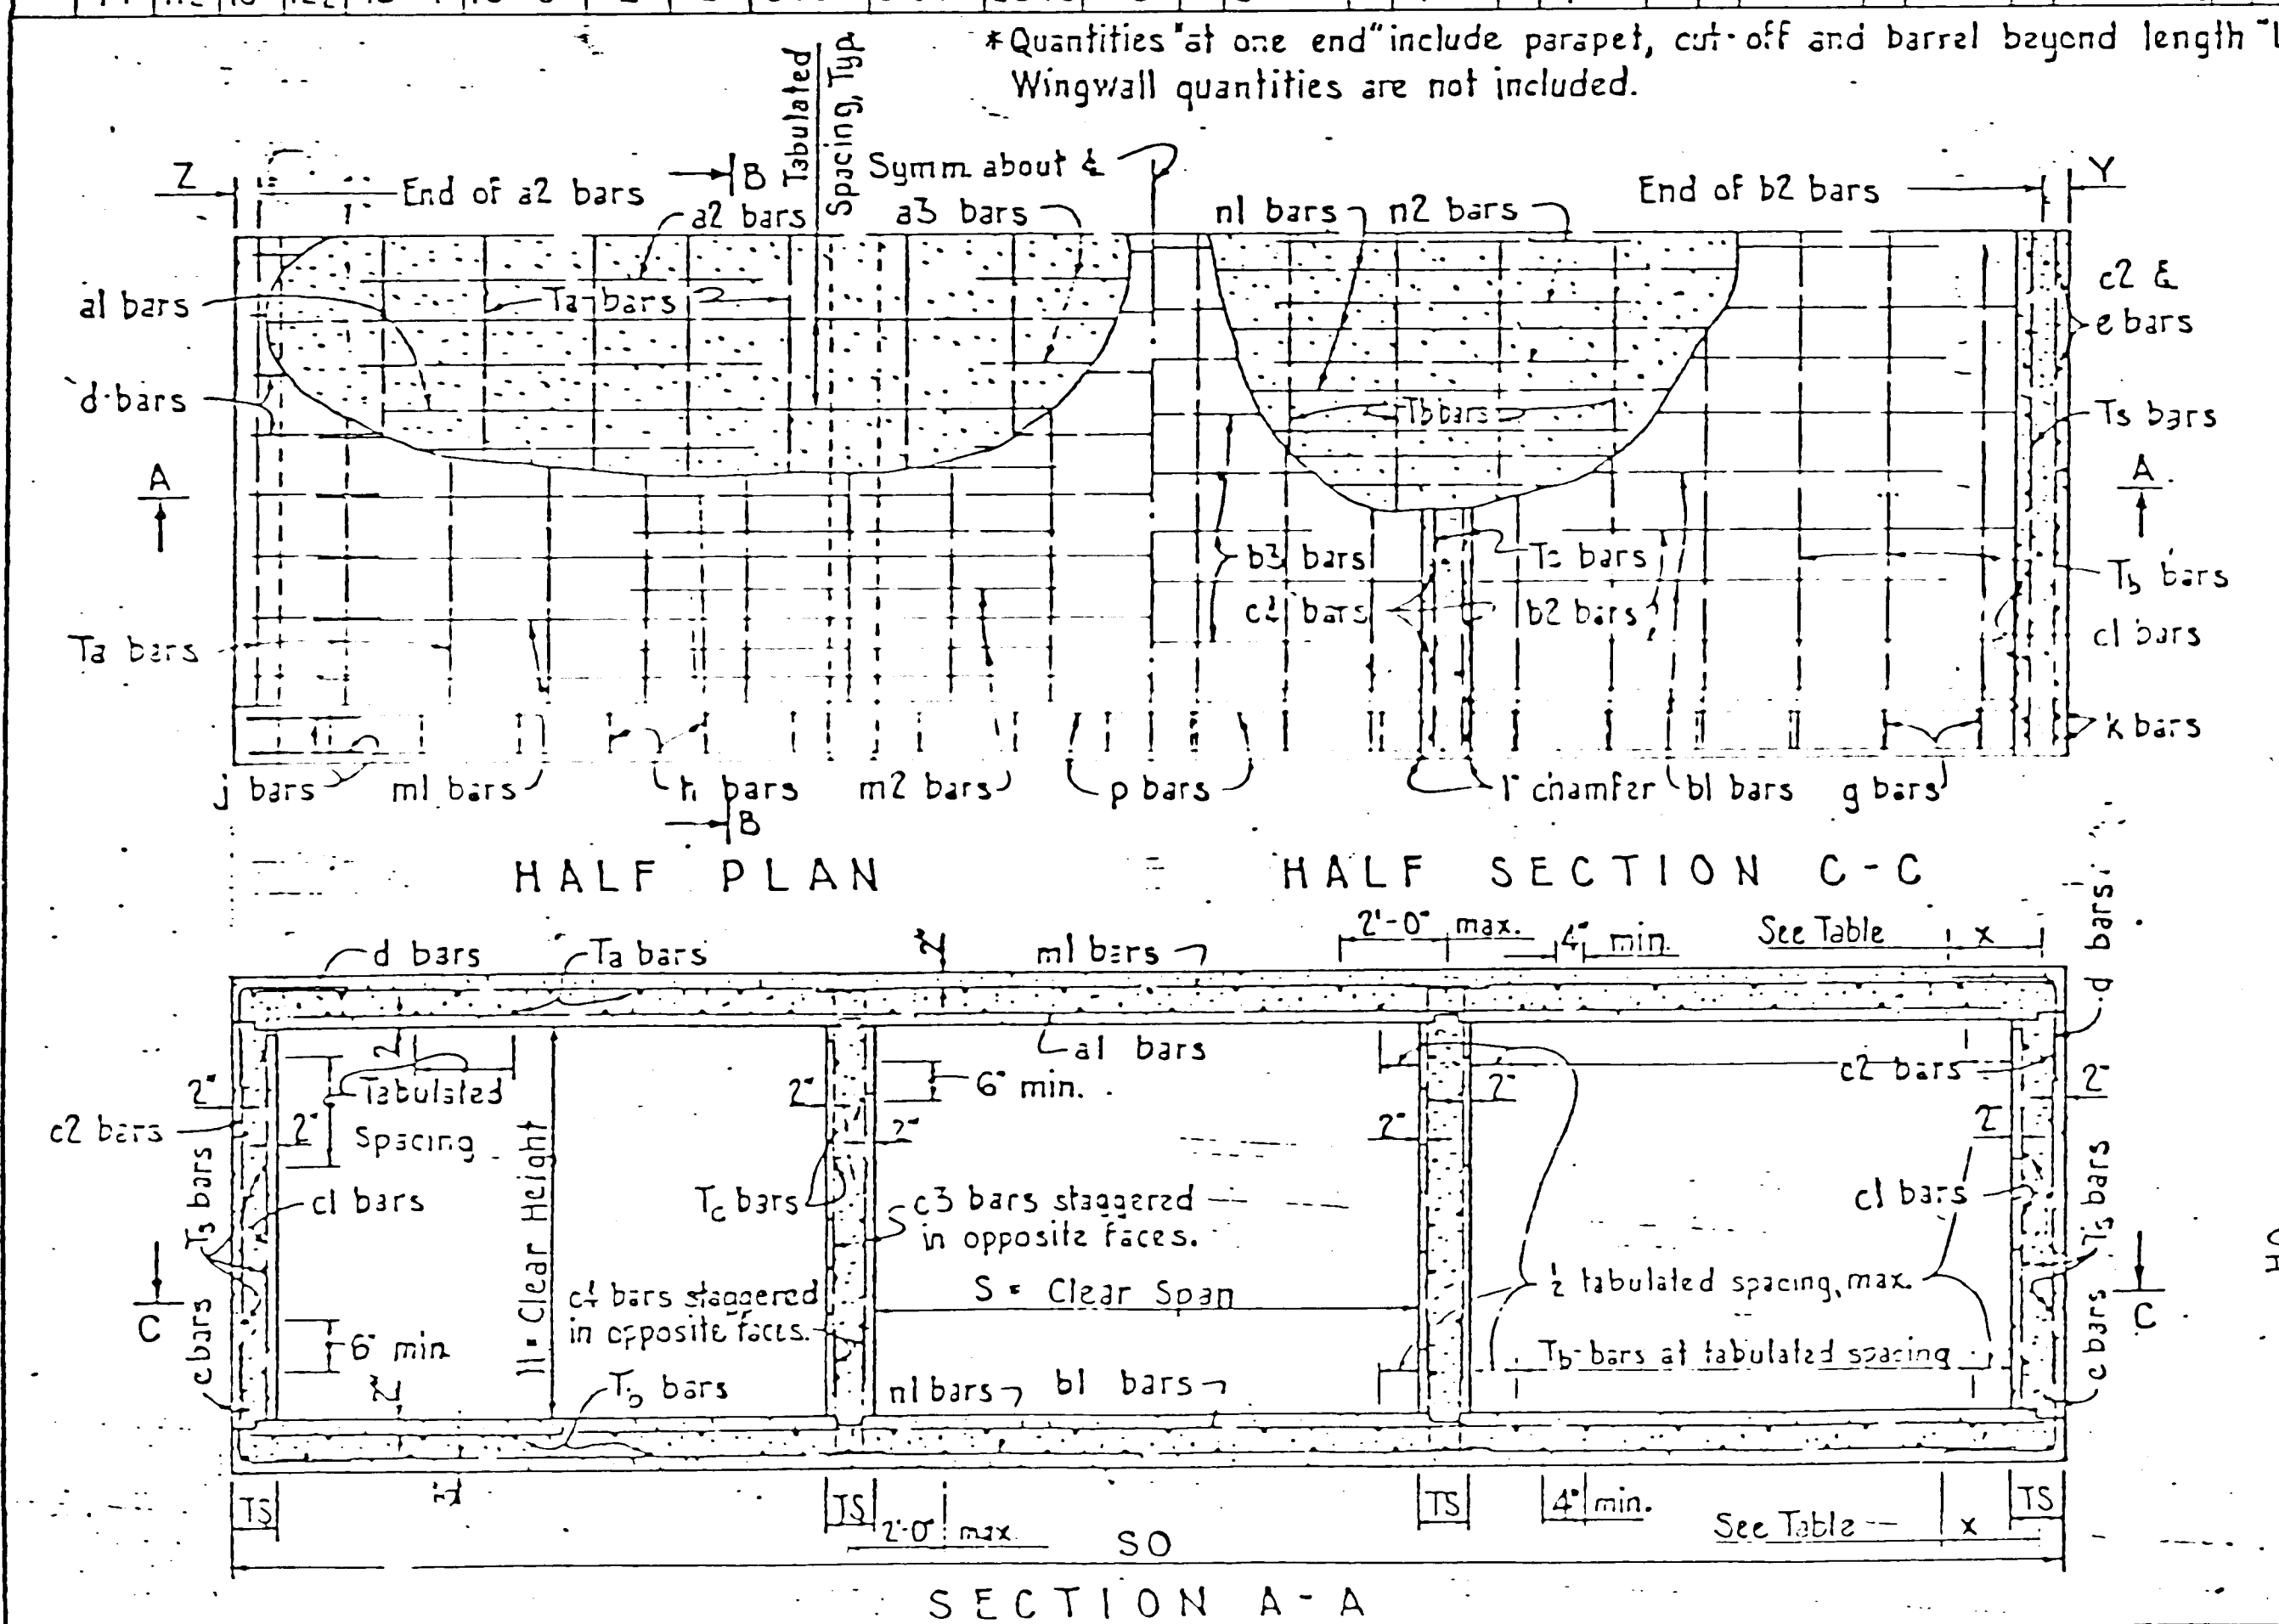

DESIGN DATA

Design according to AASHTO. Specifications, 1957
Live Load: H20-S16-44 & Interstate Alternate Loading.
Weight of Fill on top of box: 64⁷/cu. ft.
Horizontal Earth Pressure = 30⁷/cu. ft., 2 ft. surcharge.
Design Stresses: $f_c = 3000$ p.s.i., $f_t = 1200$ p.s.i.
 $f_s = 20000$ p.s.i., $n = 10$.

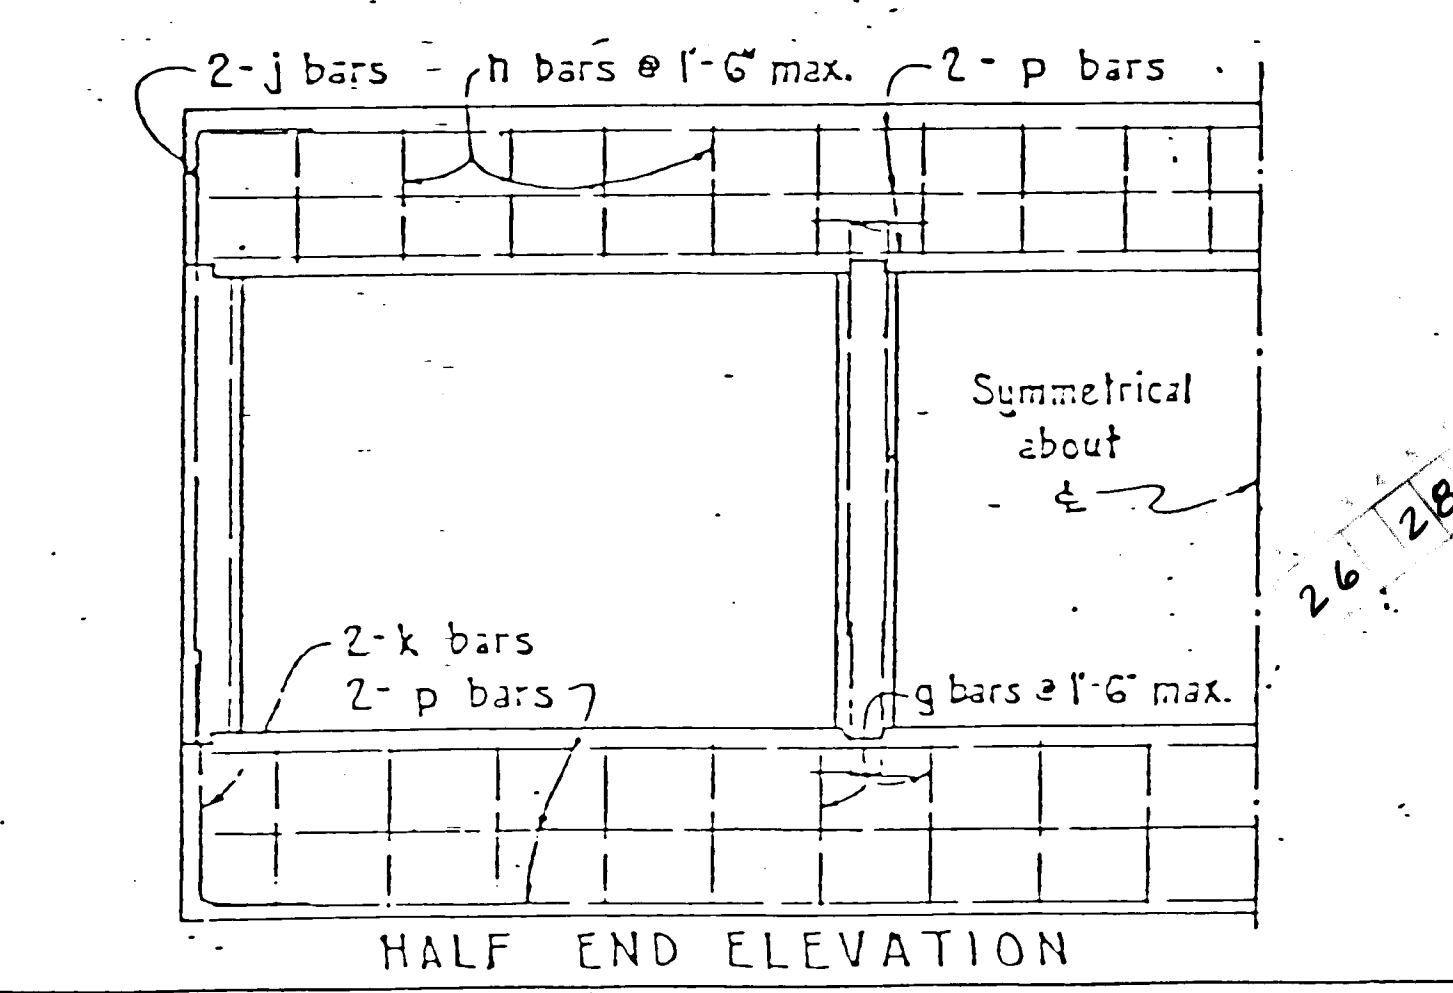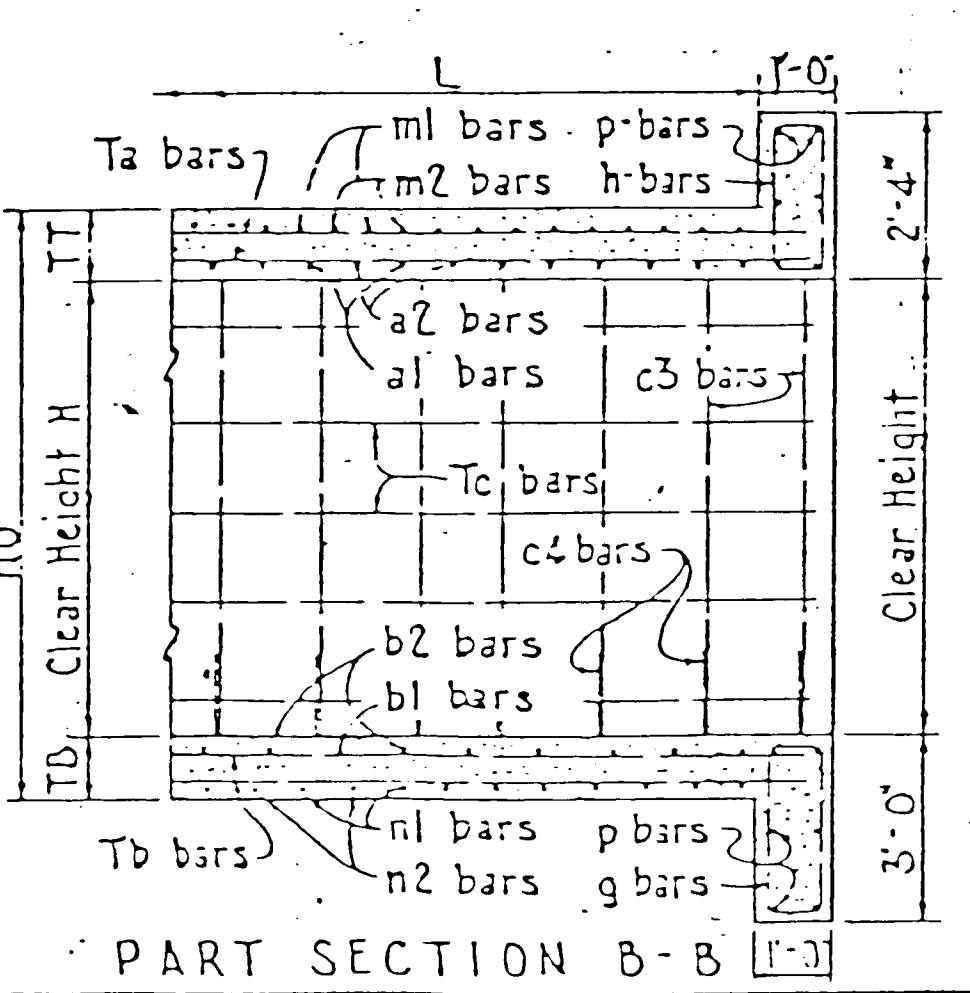

- ## GENERAL NOTES
1. Workmanship and materials shall conform to M.M.S.H. Comm. Specifications.
 2. All concrete to be Class "A". Chasten all exposed edges & except as noted.
 3. All reinforcing steel to be deformed bars, intermediate grade, conforming to A.S.T.M. Specification A-15 & A-305. All dimensions refer to $\frac{1}{4}$ of bar.
 4. T-bars may be spliced, when necessary, by lapping at least 20 bar diameters. Pay weight for reinforcing steel does not include splices. Cost of splice material to be included in unit price bid for reinf. steel.
 5. Volume of concrete = $(L \times W \times H)$ (concrete quantity per ft.) plus concrete ends.
 6. Weight of reinf. steel = $(L \times W \times H)$ (wt. of reinf. steel / LF.) plus weight of ends.
 7. Place T_1 -bars on a-bars and T_2 -bars under b-bars, spaced as shown in the table. The remaining T_1 - and T_2 -bars are to be placed adjacent to d, e, m, and n-bars, as indicated in Section A-A, at 2'-0" max.
 8. Place T_3 -bars next to cl bars, spaced as shown in the table. The remaining T_3 -bars to be placed in sidewall next to cd and e-bars. When cl bars are not required place all T_3 -bars next to cd and e-bars.
 9. Place al, as, ml, nl, bl, bs symm. about & box, place m2, n2 symmetrical about & walls.
 10. "Cover" is height of fill from top of box to finished grade.


THIS SERIAL REVISED 11/15/60

NEW MEXICO
STATE HIGHWAY DEPARTMENT


CONCRETE BOX CULVERT BARRELS
TRIPLE OPENING ~ NORMAL
DESIGN NO. 1
0 TO 5' COVER

Sheet 1 of 4
SERIAL CB-33

APPROVED: Lawrence A. B. B. B.
BRIDGE ENGINEER.

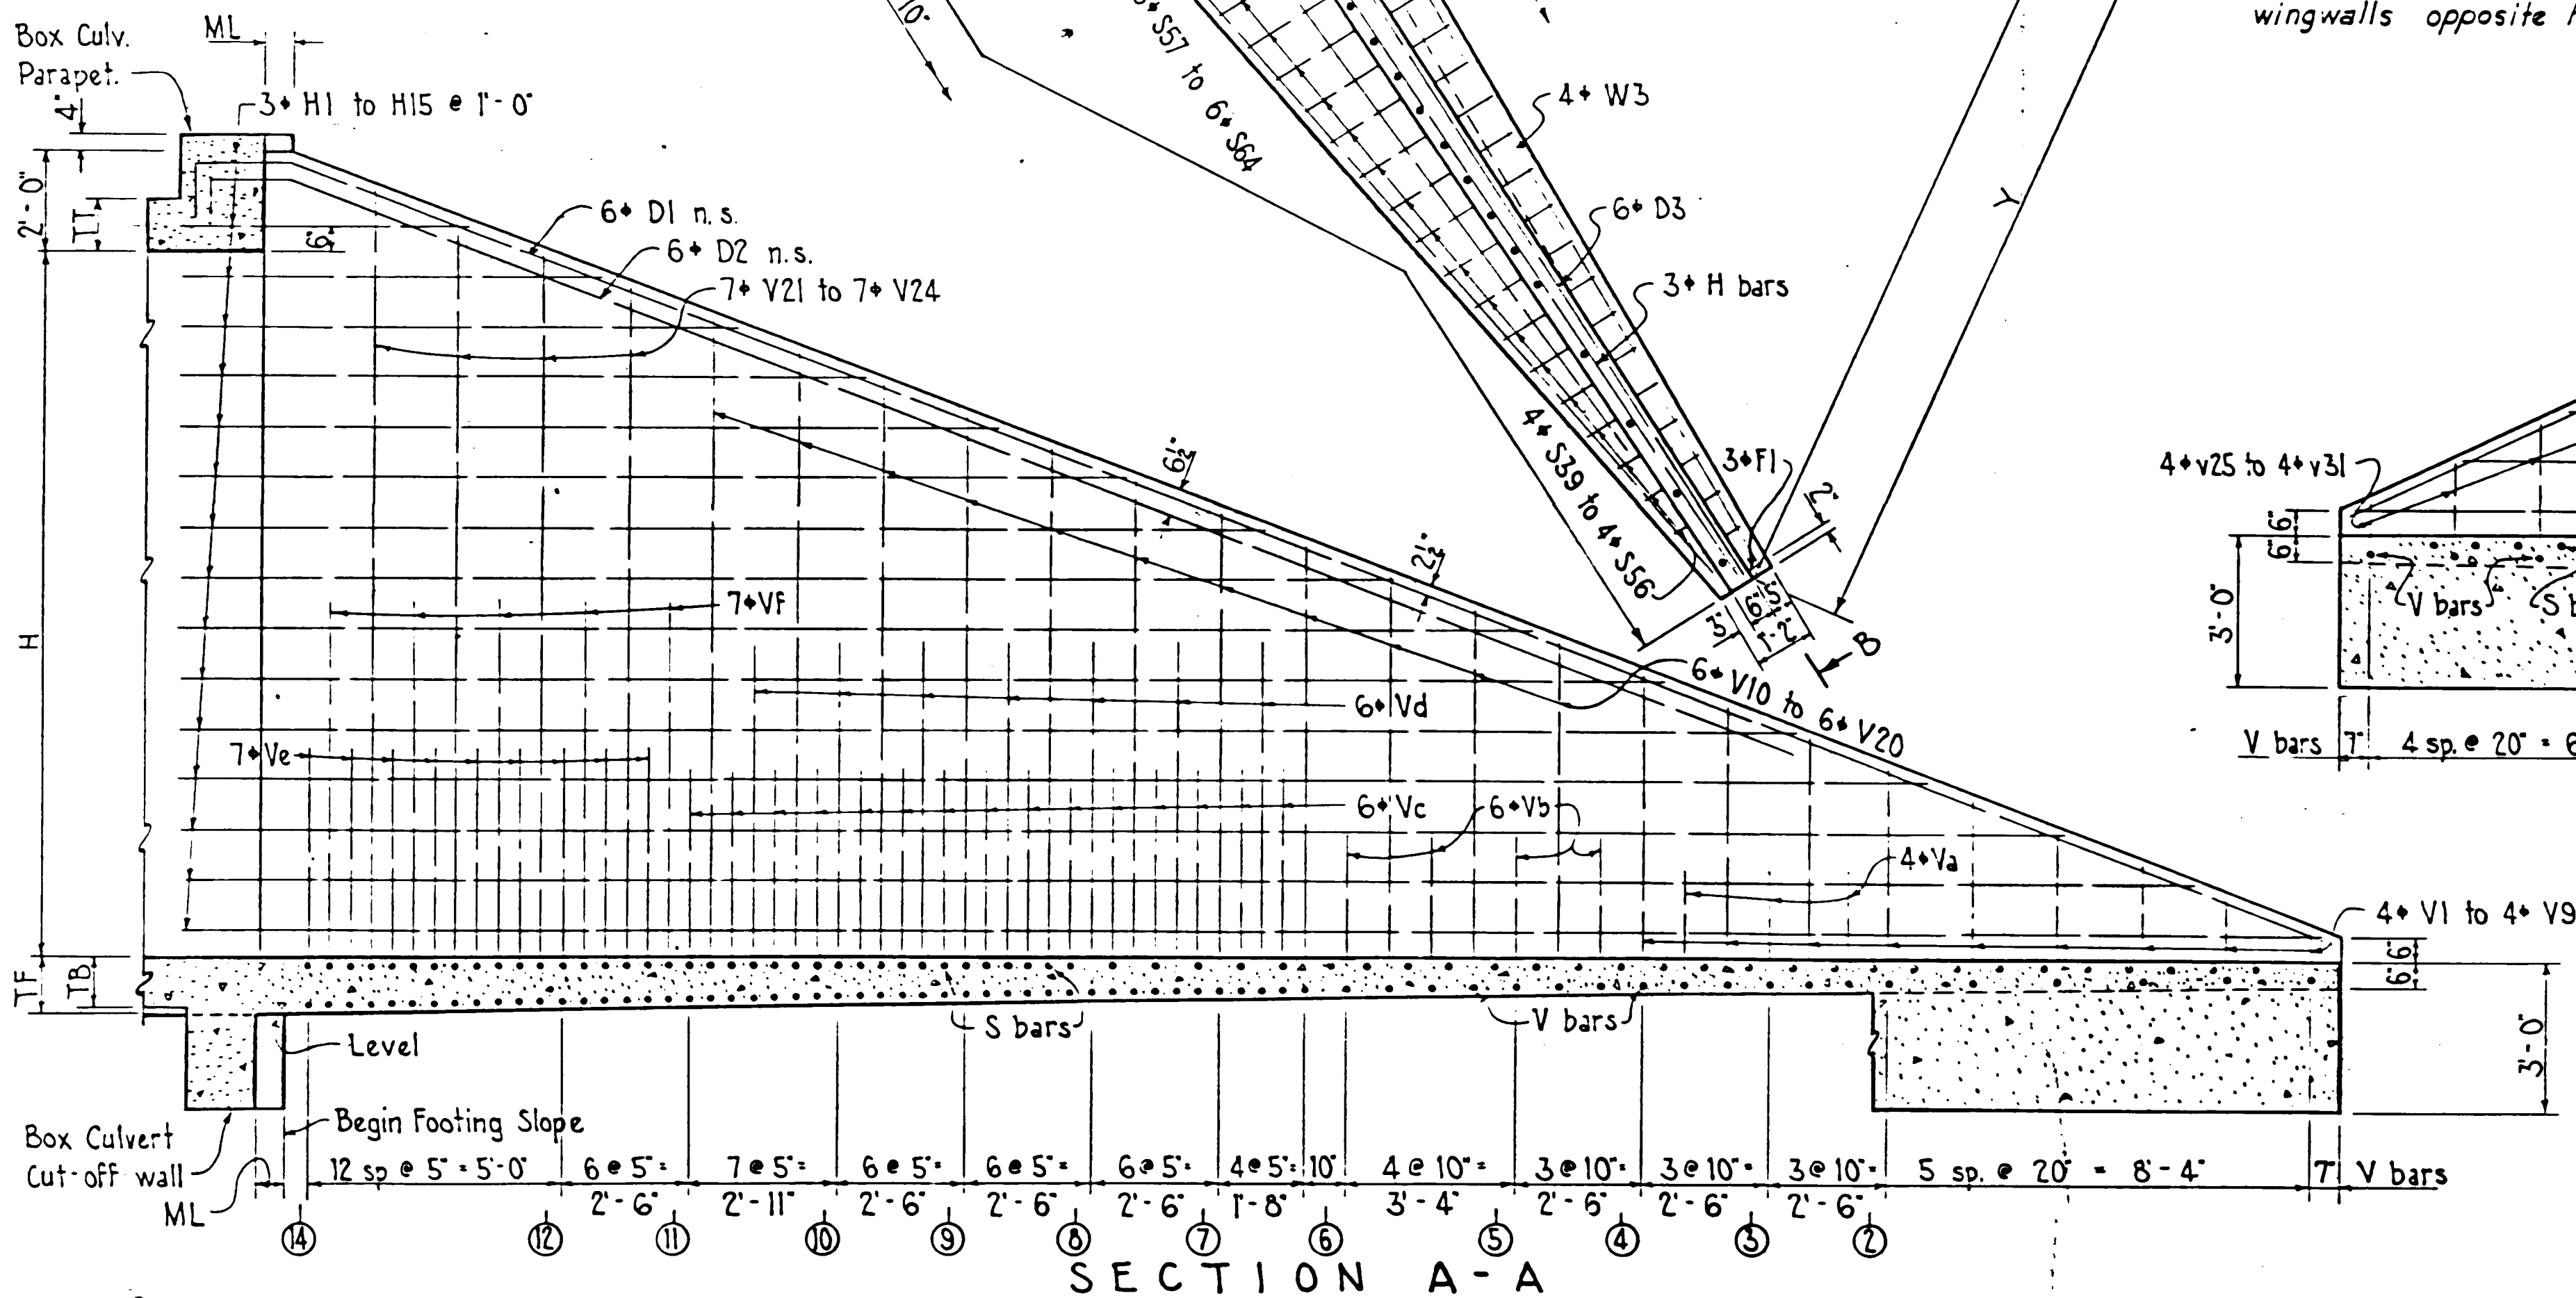

W I N G W A L L D I M E N S I O N S													
H	2'	3'	4'	5'	6'	7'	8'	9'	10'	11'	12'	14'	
WLL	9'-8½"	12'-4"	14'-1½"	17'-7½"	20'-3½"	22'-11"	25'-6¾"	28'-2½"	30'-10½"	33'-6"	36'-1½"	41'-5½"	
XL	8'-8½"	11'-1½"	13'-5¾"	15'-10½"	18'-2½"	20'-7¾"	23'-0"	25'-4½"	27'-9½"	30'-18"	32'-6¾"	37'-3½"	
ML	0'-5½"	0'-5½"	0'-5½"	0'-5½"	0'-5½"	0'-6½"	0'-7½"	0'-7½"	0'-8½"	0'-9½"	0'-10½"	1'-0½"	
TPL	0'-7½"	0'-7½"	0'-7½"	0'-7½"	0'-8½"	0'-9½"	0'-11½"	0'-11½"	1'-1½"	1'-2½"	1'-3½"	1'-6½"	
FPL	1'-0¾"	1'-1½"	1'-3¼"	1'-4¾"	1'-6½"	1'-8½"	1'-9½"	1'-10½"	2'-1"	2'-2½"	2'-3½"	2'-6¾"	
WLS	7'-8½"	9'-9½"	11'-11½"	14'-0"	16'-1½"	18'-2½"	20'-4½"	22'-5½"	24'-6¾"	26'-8½"	28'-9¾"	33'-0"	
XS	6'-5½"	8'-2½"	9'-11½"	11'-8½"	13'-6½"	15'-3"	17'-0"	18'-5½"	20'-6½"	22'-3½"	24'-0"	27'-7½"	
G	0'-2"	0'-2"	0'-2"	0'-2"	0'-2"	0'-2½"	0'-2½"	0'-2½"	0'-3½"	0'-3½"	0'-3½"	0'-4½"	
TPS	0'-6½"	0'-6½"	0'-6½"	0'-6½"	0'-6½"	0'-7½"	0'-8½"	0'-9½"	0'-10½"	0'-11½"	1'-0½"	1'-2½"	
FPS	0'-9½"	0'-10½"	0'-11½"	1'-0½"	1'-2½"	1'-3½"	1'-4½"	1'-5½"	1'-7½"	1'-8½"	1'-9½"	1'-11½"	
Y	4'-2½"	5'-4½"	6'-6½"	7'-8½"	8'-10½"	10'-0"	11'-1½"	12'-3½"	13'-5½"	14'-7½"	15'-9¾"	18'-1½"	
FB	1'-4½"	1'-8½"	2'-0½"	2'-4½"	2'-7½"	2'-10½"	3'-1½"	3'-5"	3'-7½"	3'-10½"	4'-1½"	4'-7½"	
TF	0'-6"	0'-6"	0'-6"	0'-6"	0'-6½"	0'-7½"	0'-8½"	0'-9"	0'-10"	0'-11"	1'-0"	1'-2"	
WW	0'-9"	0'-10"	0'-11"	1'-0"	1'-1½"	1'-2½"	1'-3½"	1'-4½"	1'-6"	1'-7"	1'-8"	1'-10"	
TF	0'-7½"	0'-8"	0'-8½"	0'-9"	0'-9½"	1'-0"	1'-0½"	0'-11"	0'-11½"	1'-0"	1'-0½"	1'-10"	

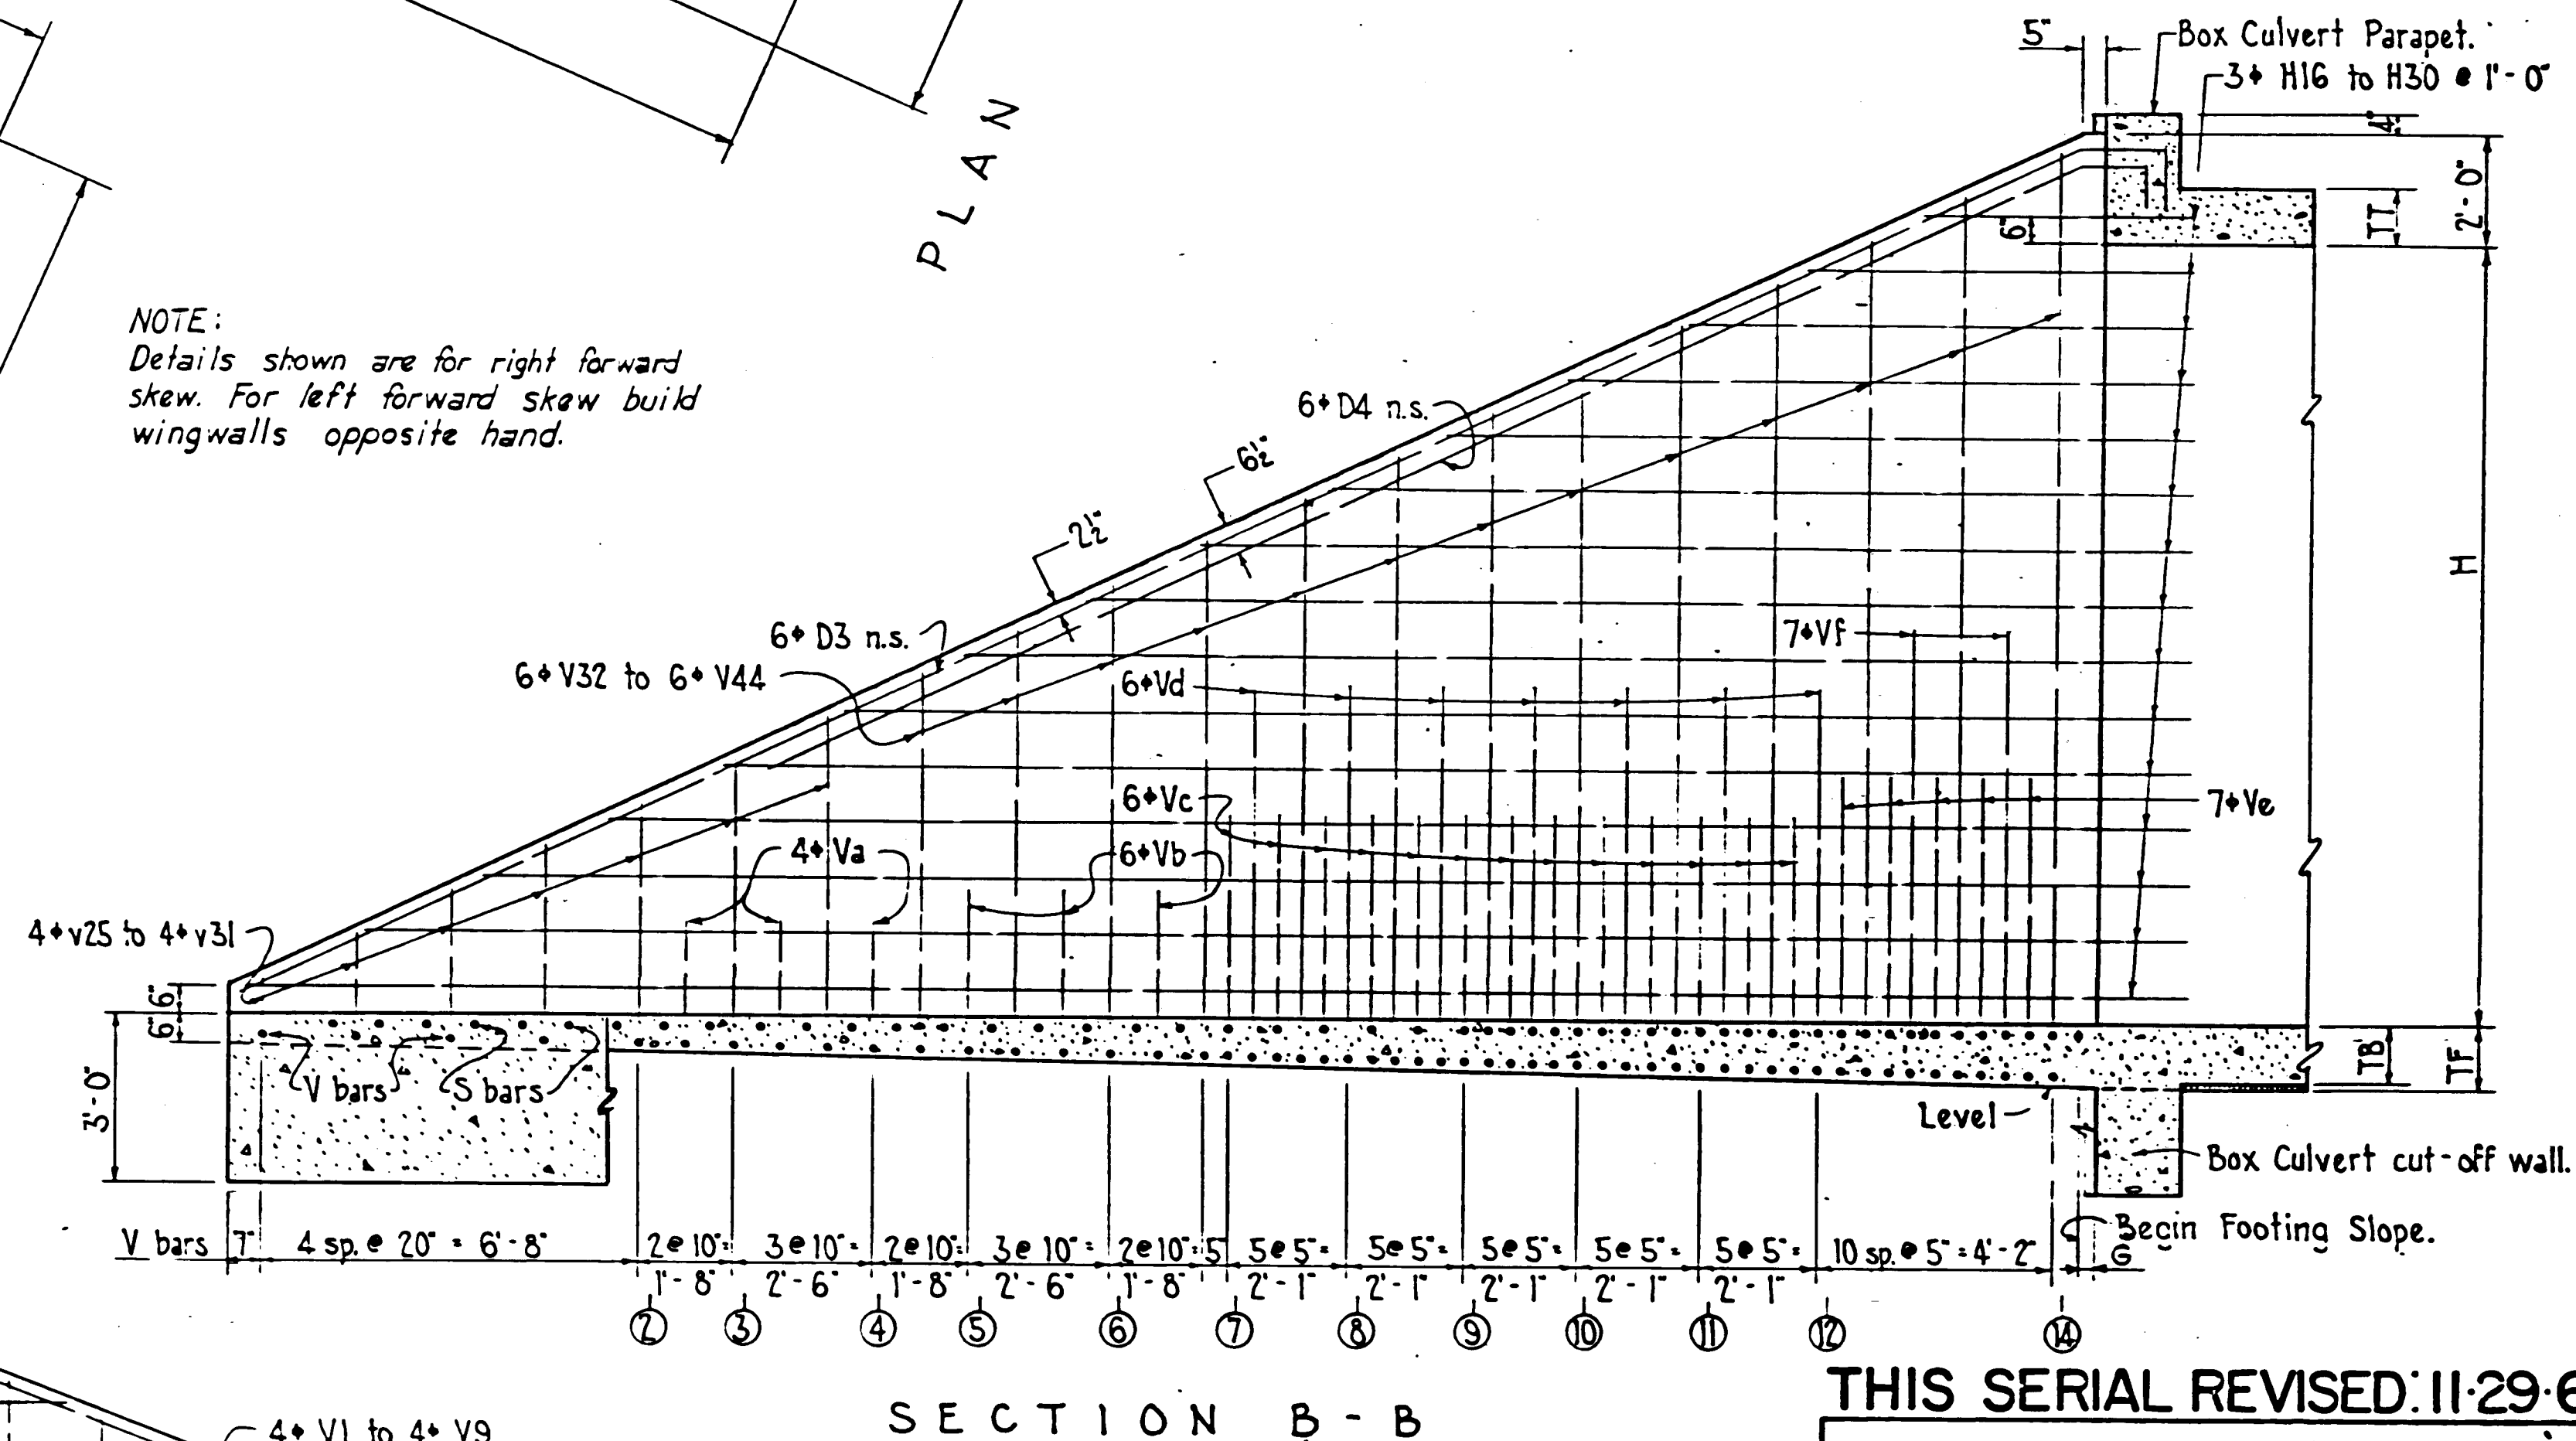


NOTE: Encircled numbers show stopping points of reinforcement for clear heights "H". Vertical and horizontal wing reinforcement shown on Section AA & BB is on far side. F and W bars are not shown.

THIS SERIAL REVISED: 11-29-67

NEW MEXICO
STATE HIGHWAY DEPARTMENT
WINGWALLS
FOR 15° SKEW CONC. BOX CULVERTS

Sheet 1 of 2
SERIAL WCB-15


APPROVED: 
DRAWING NO. 2879 SHEET 35 OF 36

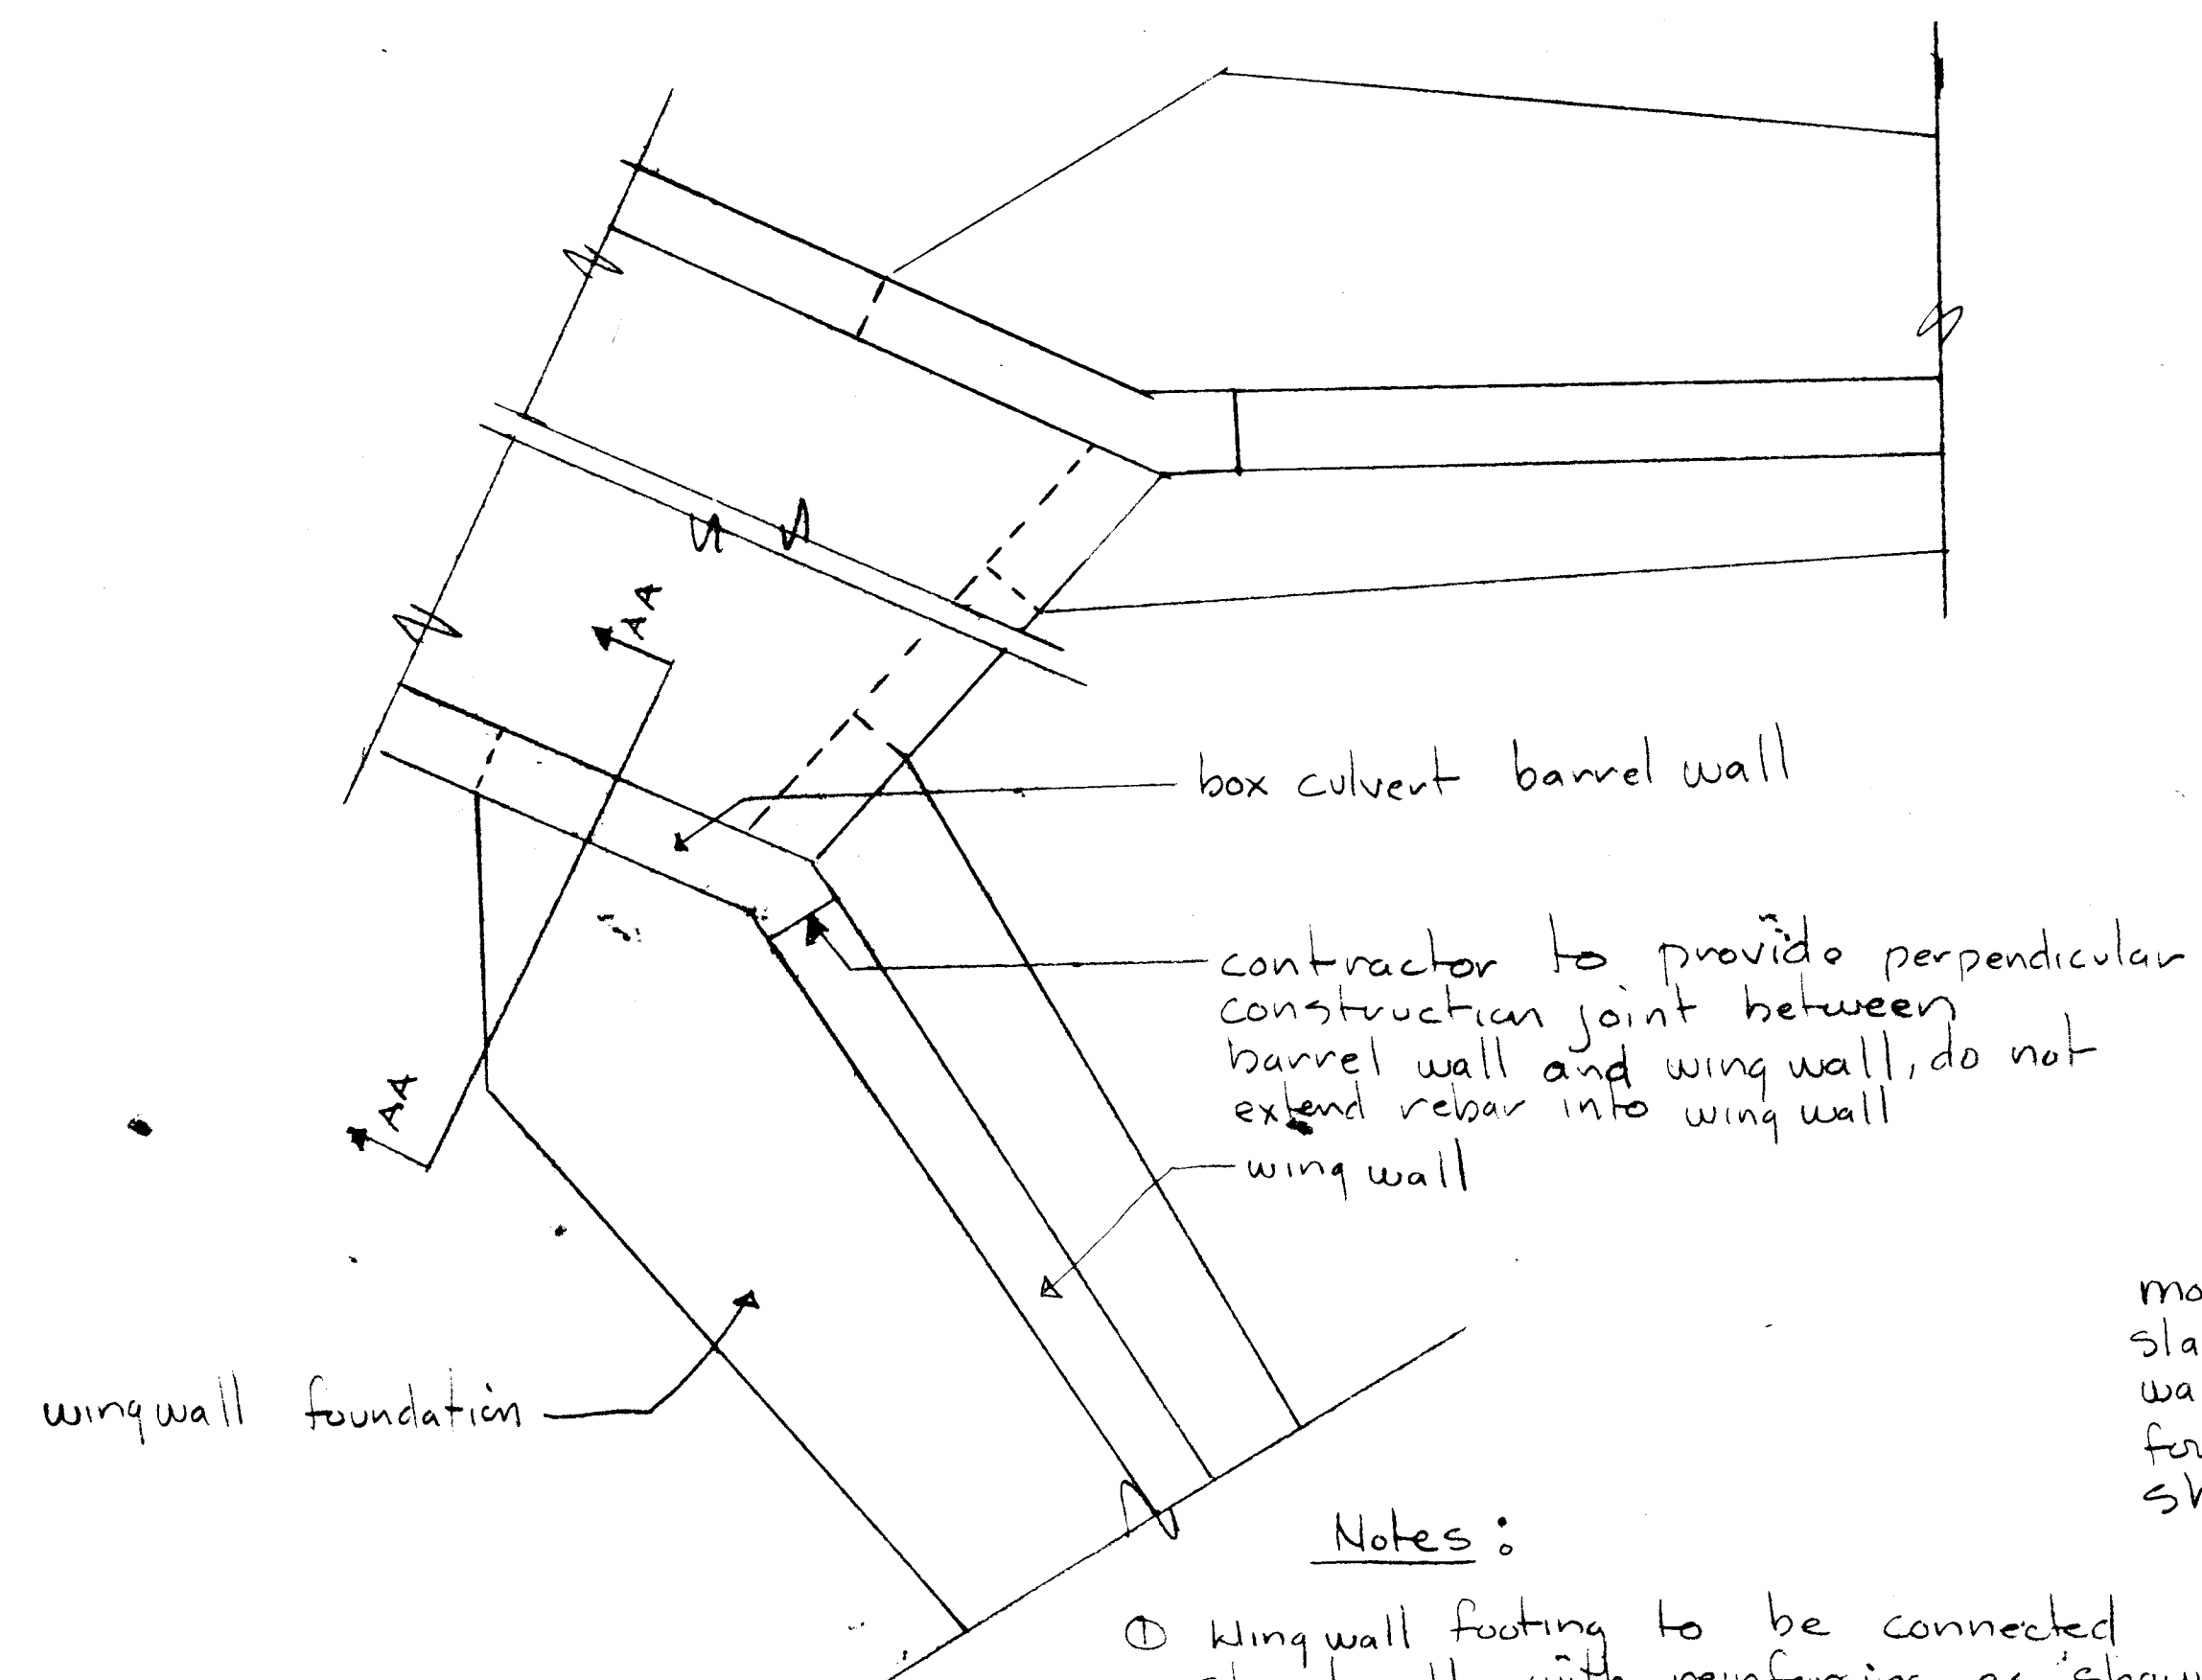


Notes:

- ① Wingwall footing to be connected structurally with reinforcing as shown on these details
- ② Wingwall and box culvert barrel walls are not to be connected structurally, contractor is to provide construction joint between barrel & wing walls
- ③ All reinforcing steel to remain at sizes and spacing as required by the state standards, Contractor shall submit revised shop drawings indicating additional rebar as required to achieve modified details provided this sheet


modify box culvert slab to provide new cut-off wall to bottom of wing-wall foundation at corners as shown

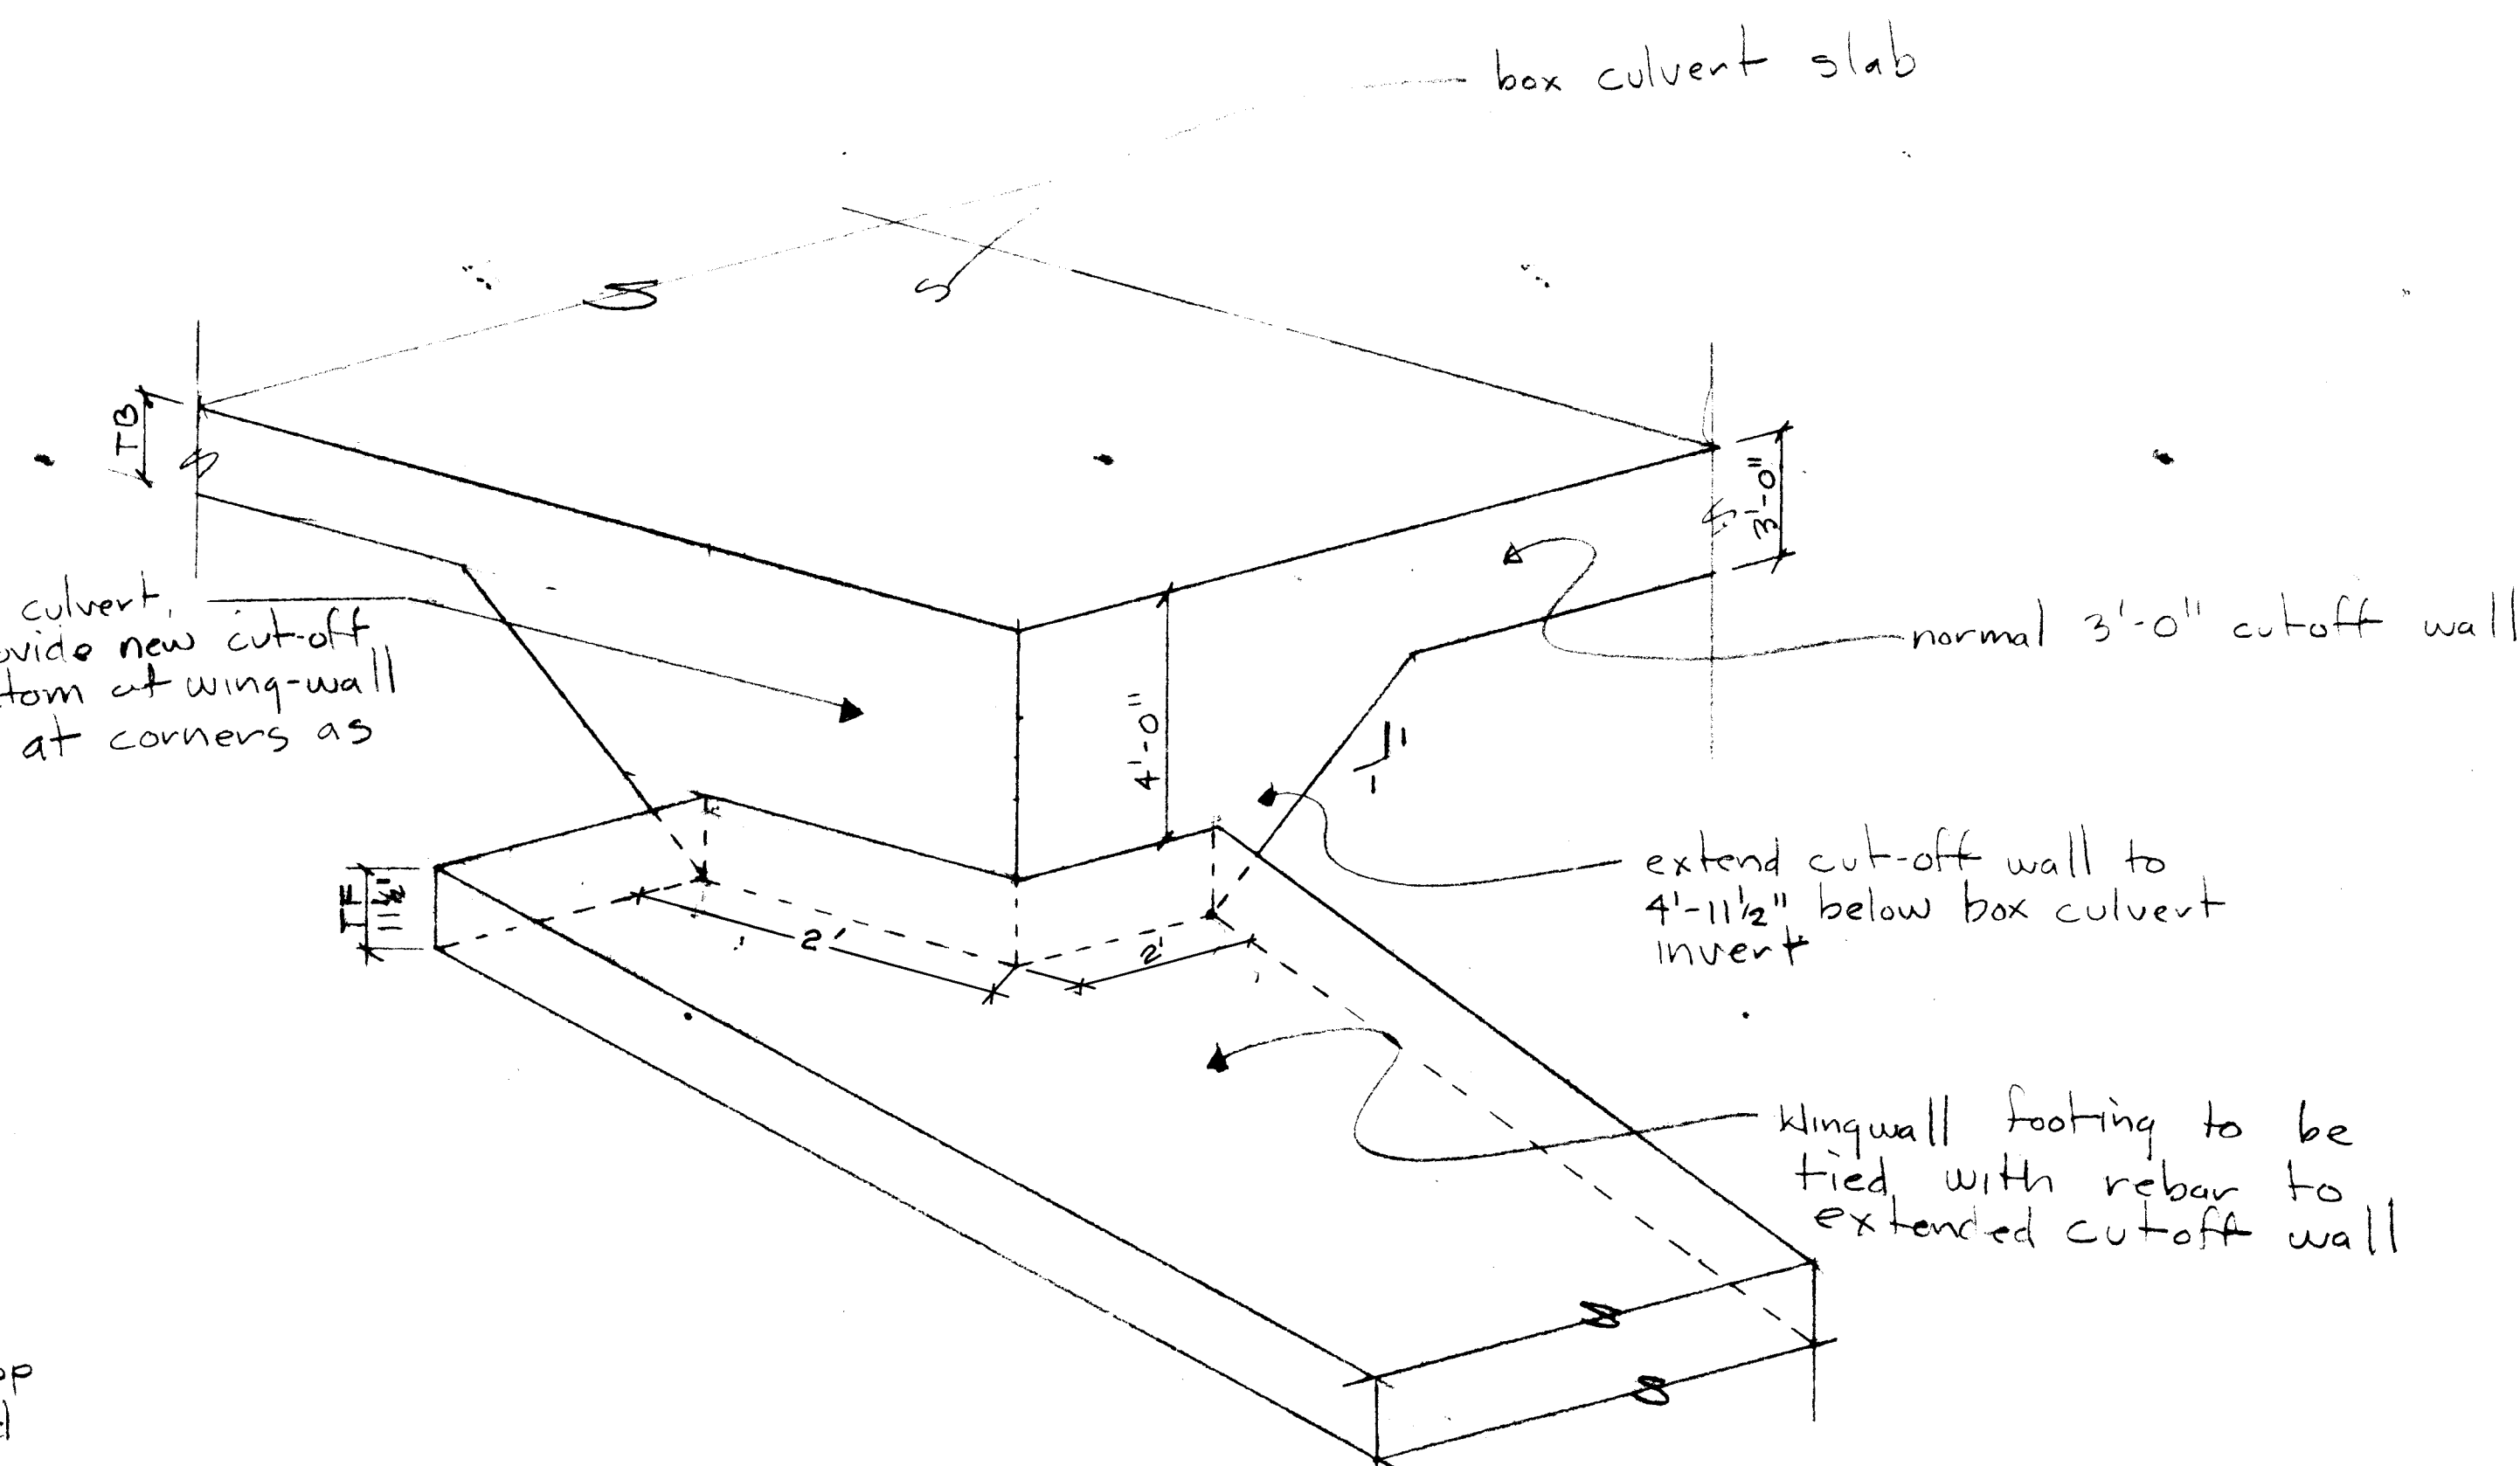

Isometric View of Box Culvert Slab & Wing Wall Footing

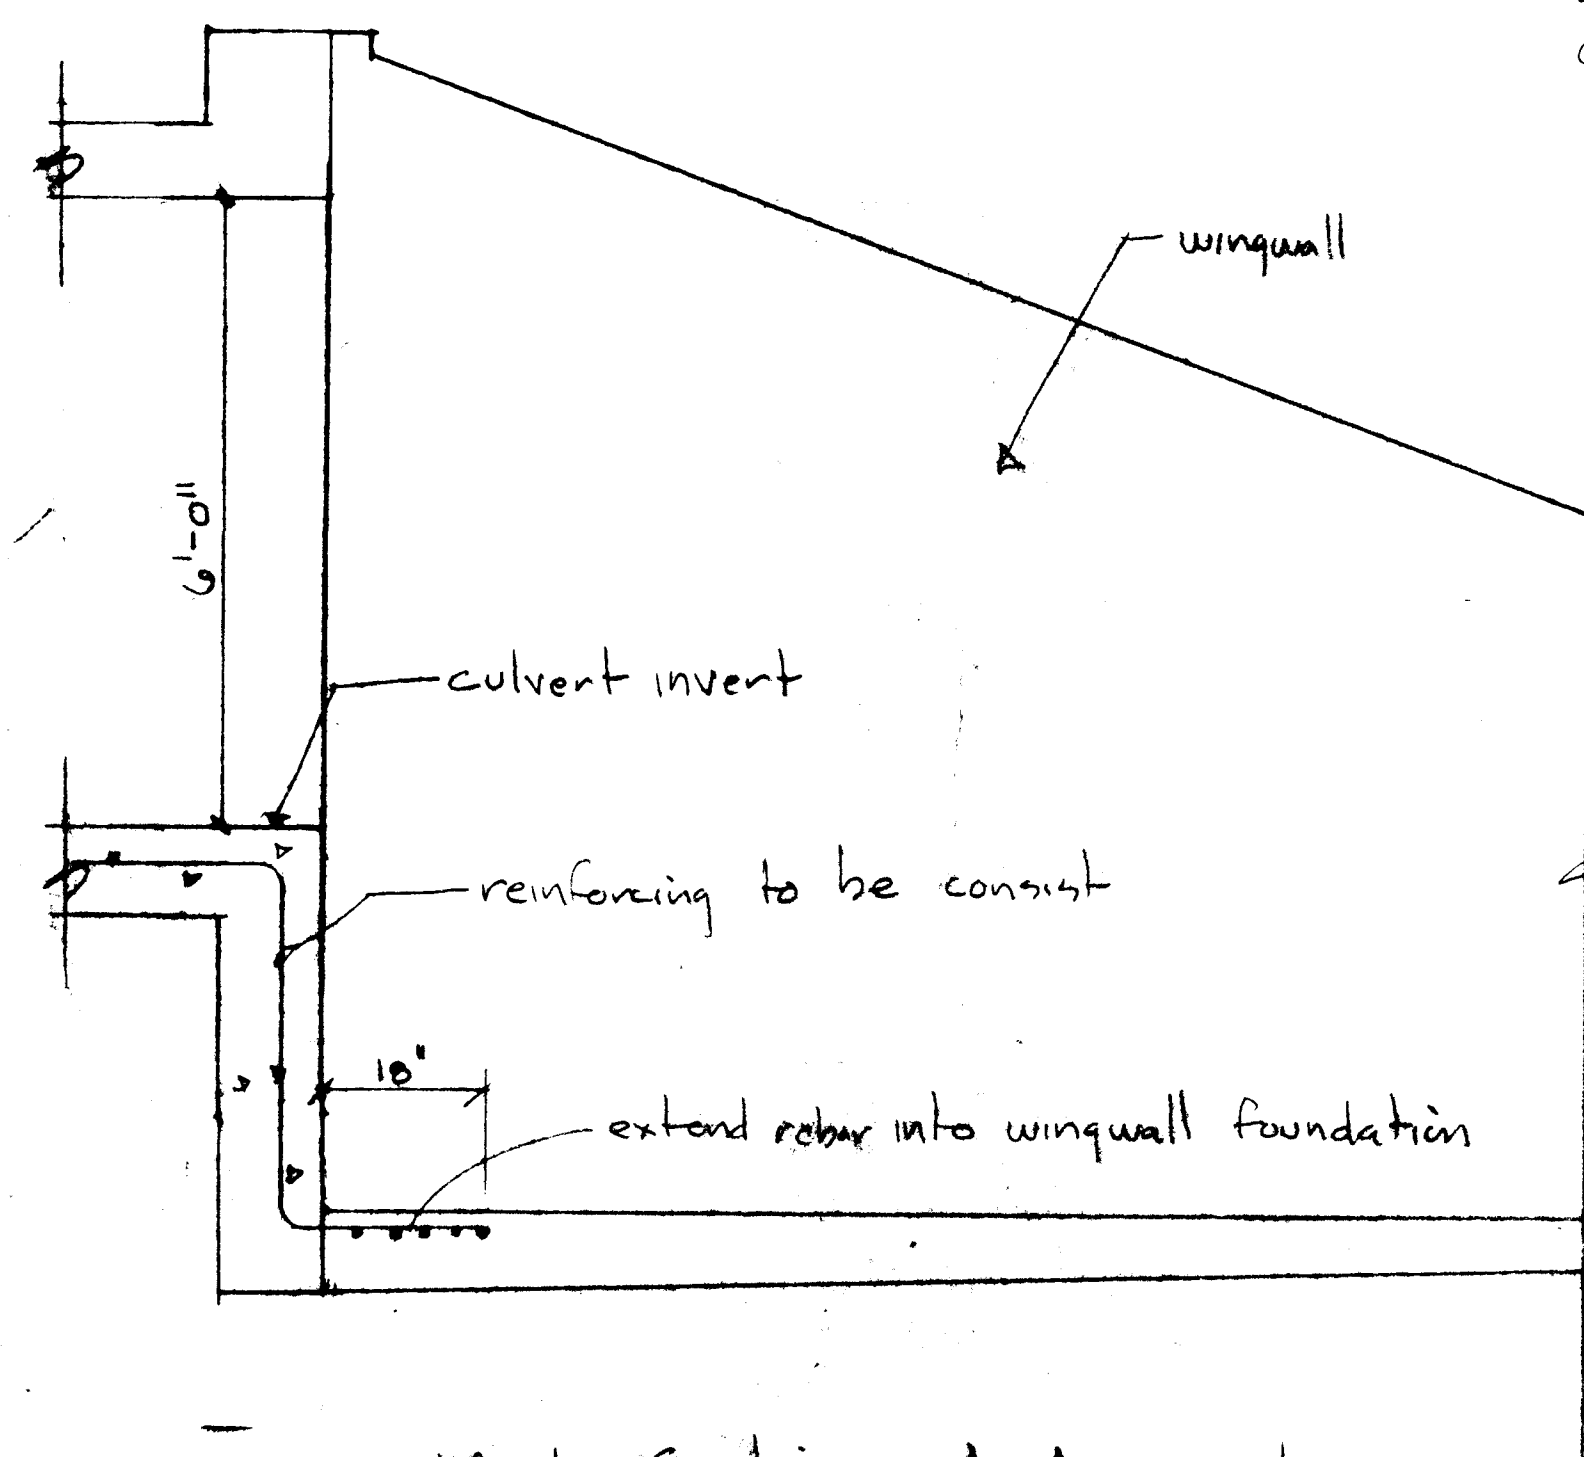

Modified Section A-A

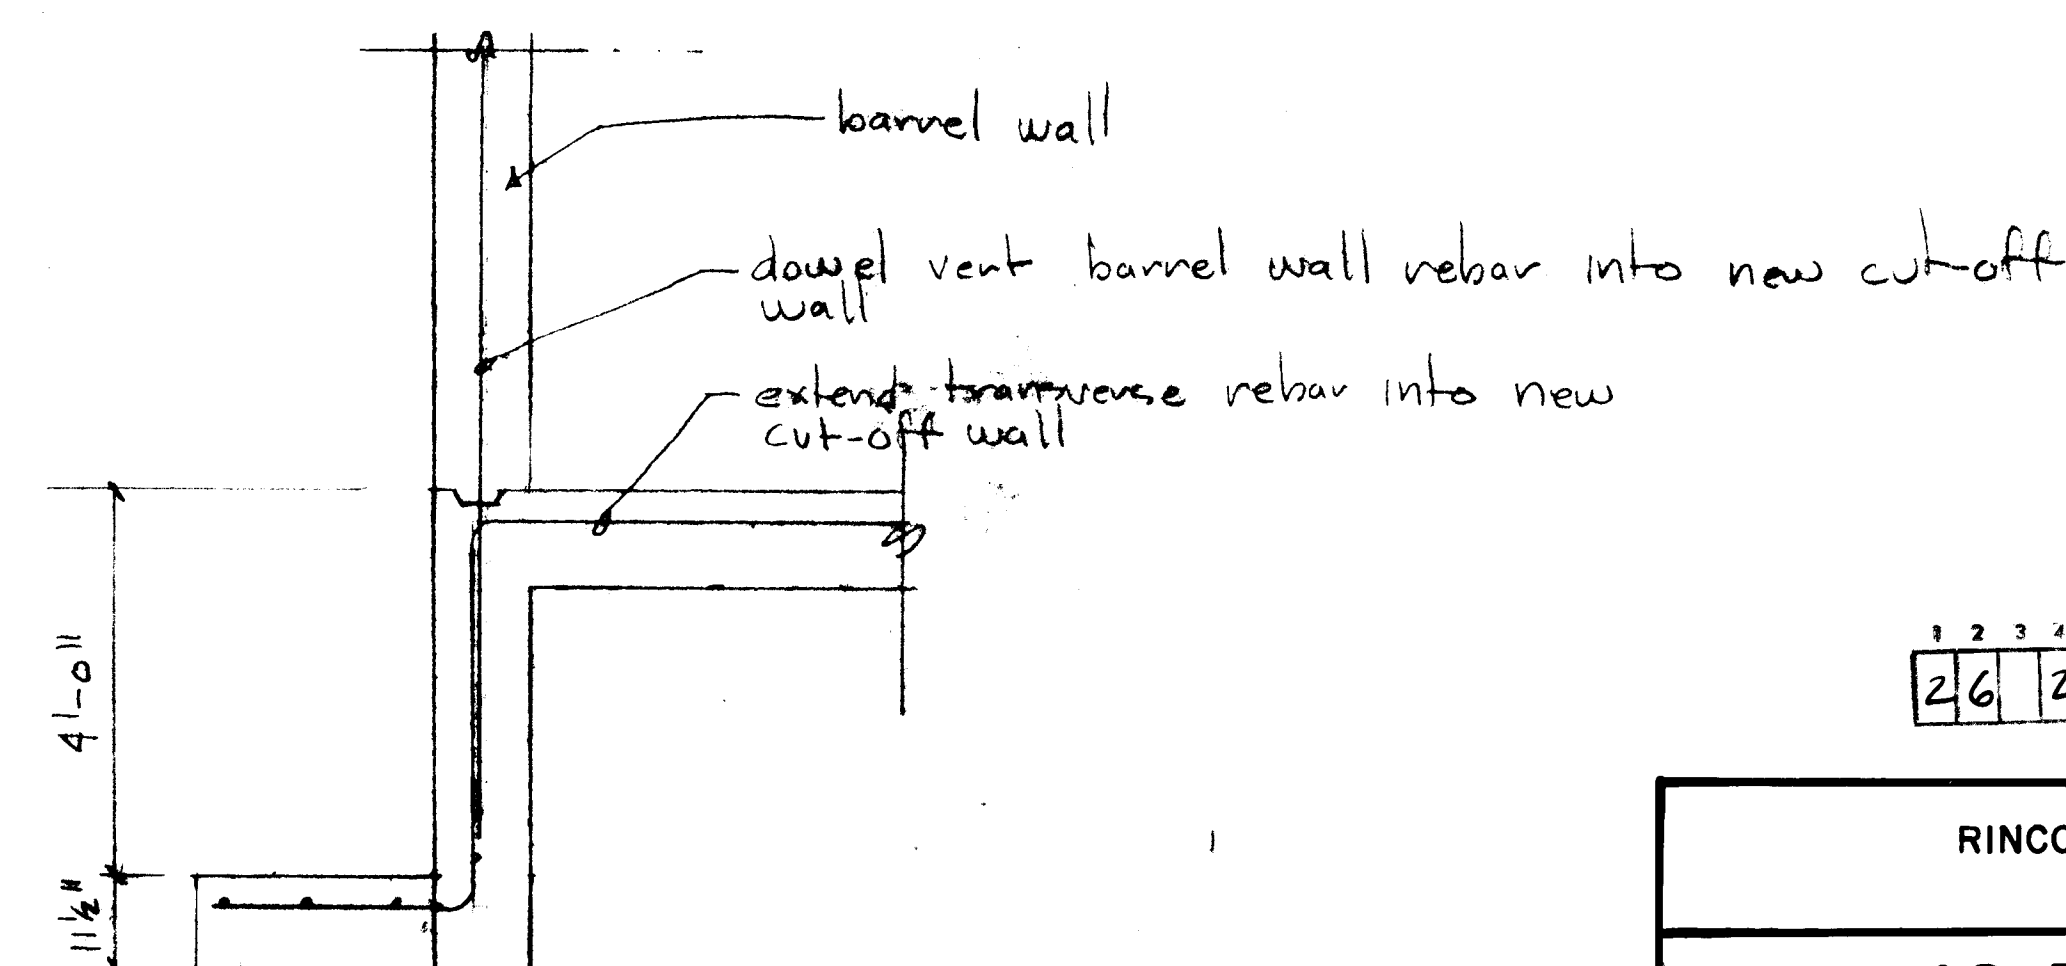

Section AA-AA

1. DRAWING NO. 11-25-87
2. DATE 11-25-87
3. MAP NO. F-10
4. SHEET NO. 36 A
5. TOTAL SHEETS 810

1 2 3 4 5 6 7 8 9 10
26 28 79 36 87 A

RINCON SUBDIVISION PHASE II

AS BUILT SHEET

MODIFICATIONS TO N.M.S.H.D. STANDARD BOX CULVERT USED ON THE EAST SIDE ON THE CARRICK ST. BOX CULVERT.

DATE: 11-25-87

MAP NO. F-10

36 A

Resource Technology, Inc.