




SEWER INVERT ELEVATIONS

1. 80.0 FT. FROM M.H. #1 TO EXIST. CITY M.H. @ MIN. SLOPE OF 1/4" PER FT.
2. 195.0 FT. FROM M.H. #1 TO C.O. #1 @ MIN. SLOPE OF 1/8" PER FT.
3. 4" YARD LINES SLOPE 1/4" PER FT. FROM 6" SEWER LINE 4' FT. TO YARD

DECLARATION: ALL INFRASTRUCTURES GUARANTEED IN SUBDIVISION AGREEMENT HAVE BEEN INSPECTED AND ARE IN ACCORDANCE WITH THE DRAWING.

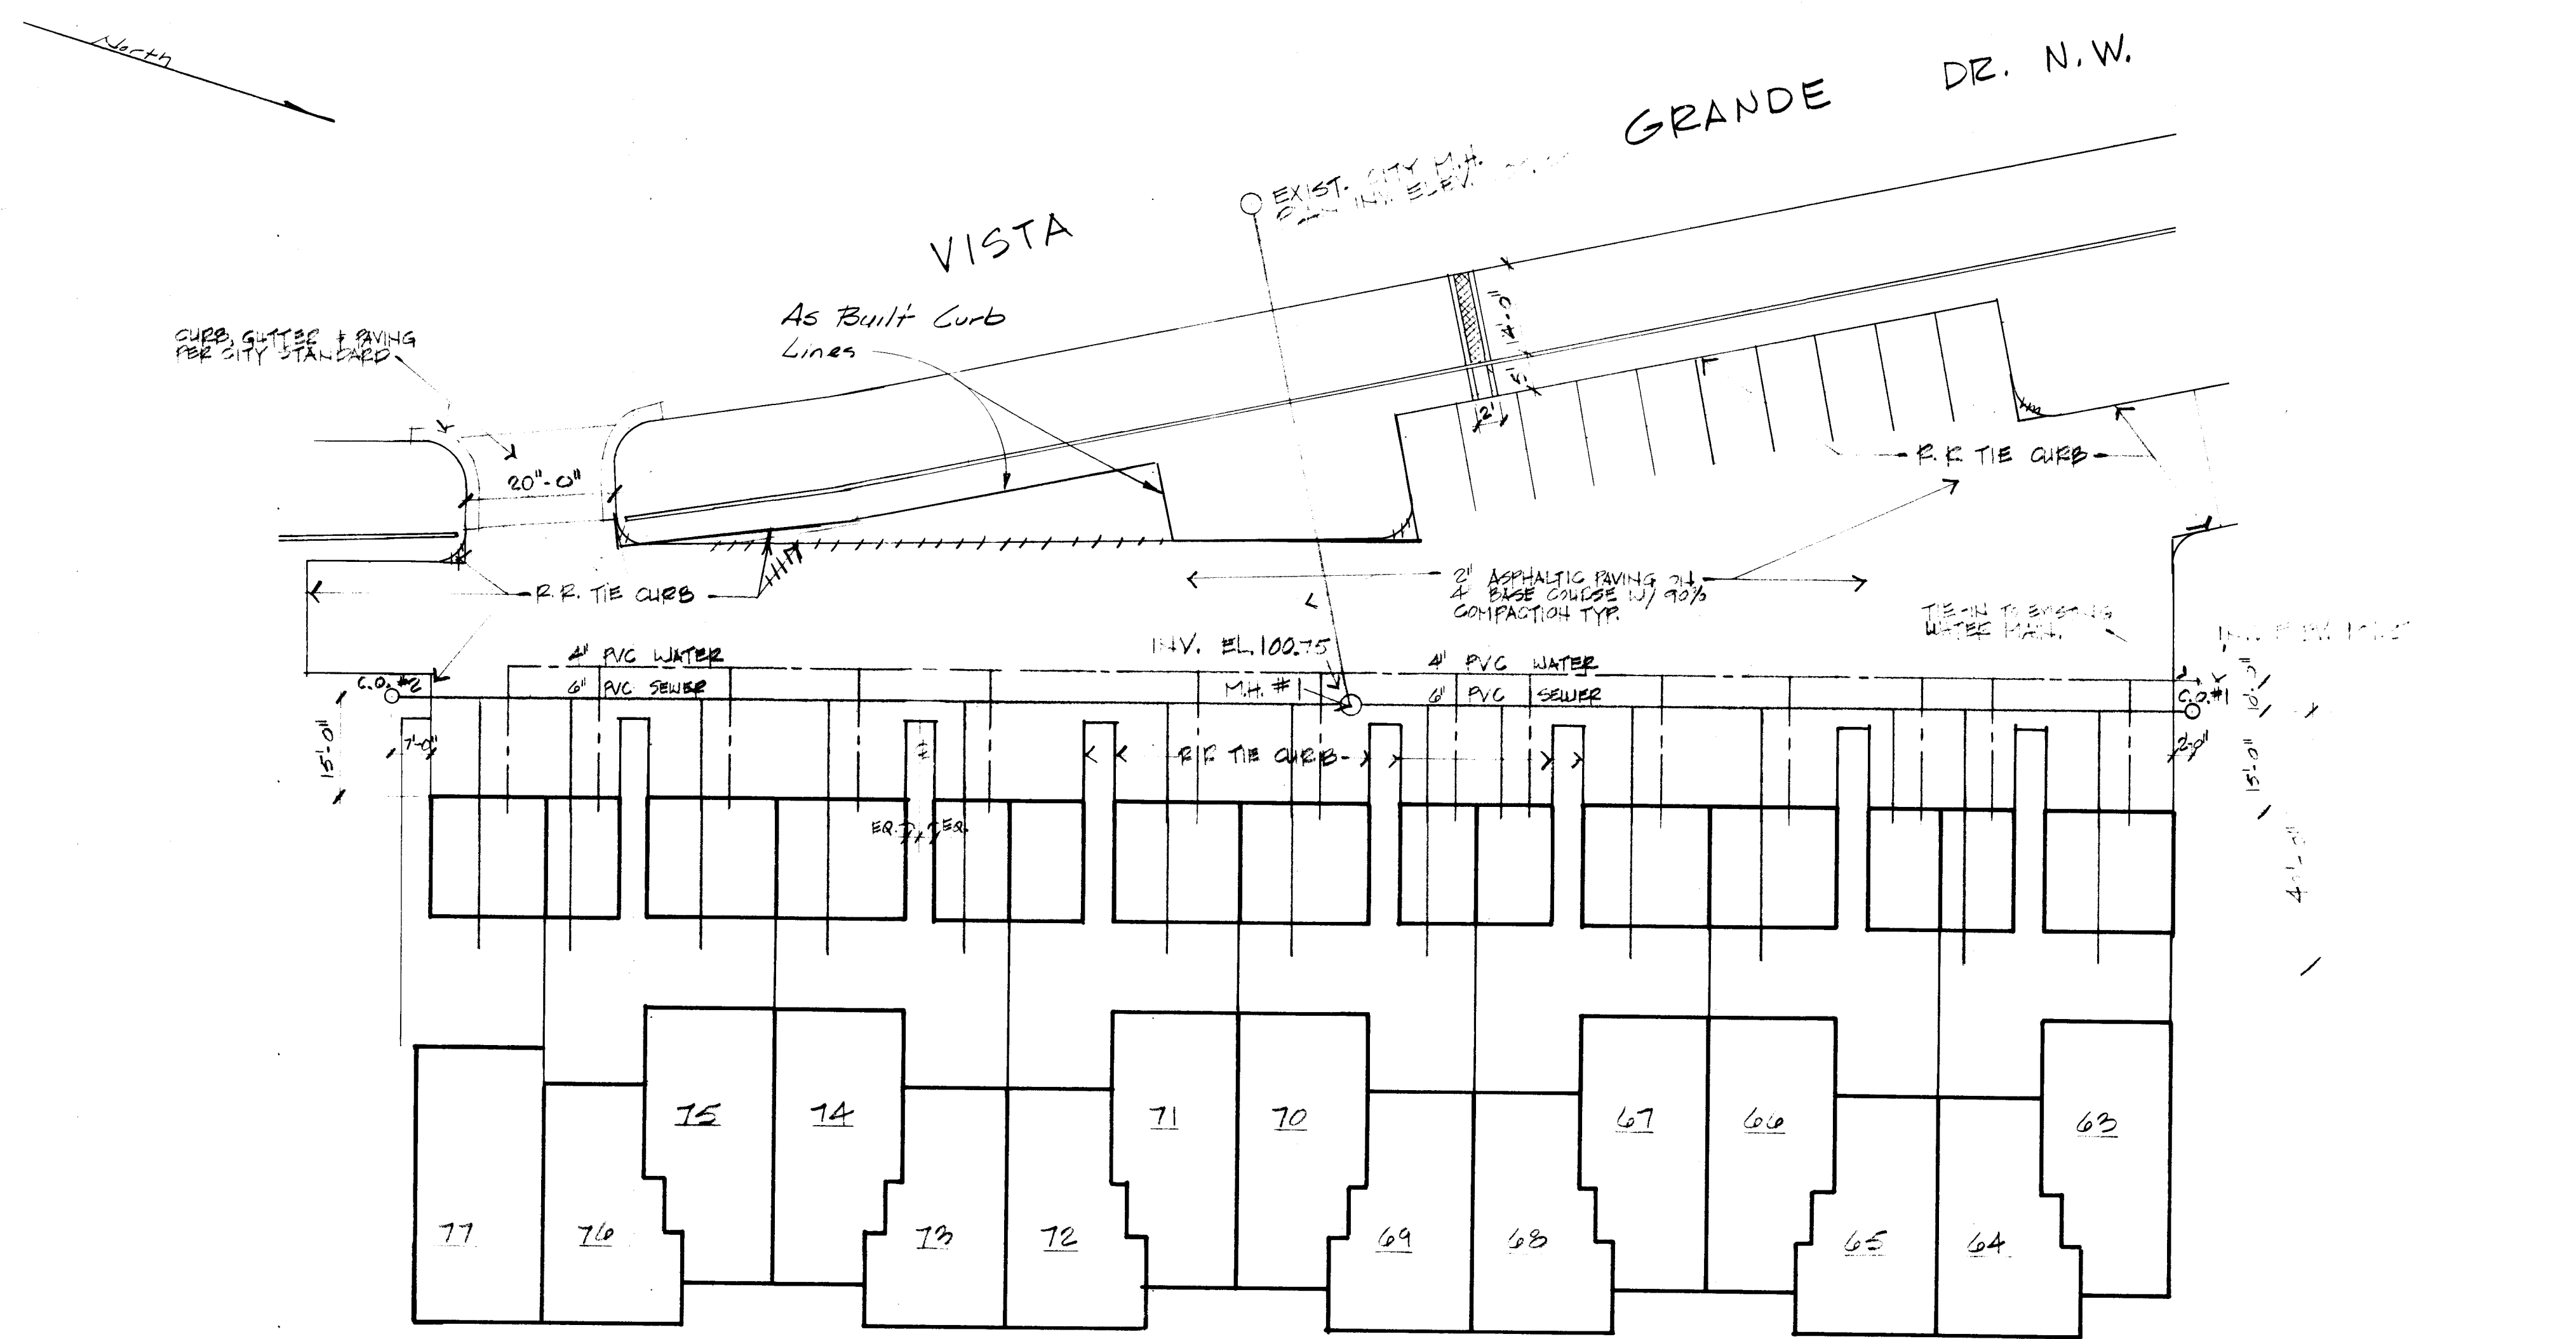

Thomas J. Freeman 4.17.87

WESTCLIFFE PHASE 2B INFRASTRUCTURES

Scale: 1" = 20'

26 28830186

U-1

SHEET 1 OF 1 8-21-86
8-25-86

2883