


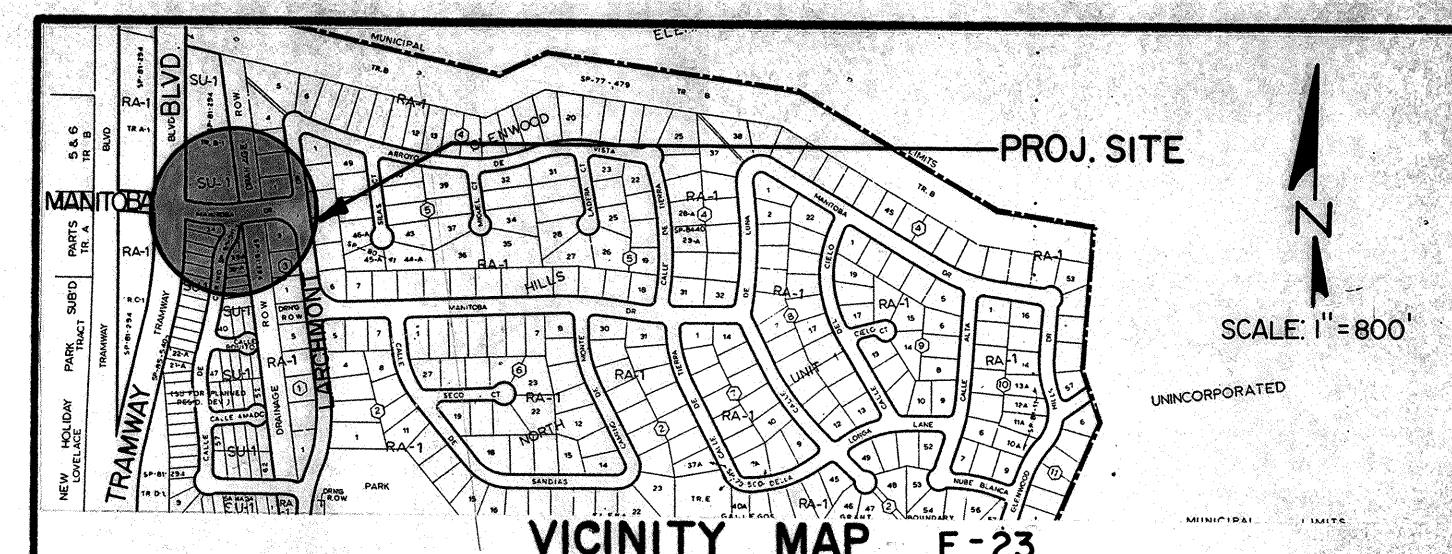

NOTICE TO CONTRACTOR

- All work detailed on these plans to be performed under contract shall, except as otherwise stated or provided for hereon, be constructed in accordance with the City of Albuquerque Interim Standard Specifications for Public Works Construction 1985.
- Two (2) working days prior to any excavation, contractor must contact Line Locating Service, 765-1234, for location of existing utilities.
- Prior to construction, the contractor shall excavate and verify the horizontal and vertical locations of all obstructions. Should a conflict exist, the contractor shall notify the engineer or surveyor so that the conflict can be resolved with minimum amount of delay.
- Two (2) working days prior to construction, contractor shall obtain a Barricading Plan and Permit through Traffic Engineer Division at 768-2780.

THE FOLLOWING NOTES ALSO APPLY WHEN CHECKED


- ☐ All utilities and utility service lines shall be installed prior to paving.
 - ☐ Backfill compaction shall be according to specified street use.
 - ☐ Tack coat requirements shall be determined by the City Engineer.
 - ☐ Sidewalks and wheelchair ramps within the curb returns shall be constructed wherever a new curb return is constructed.
 - ☐ If curb is depressed for a driveway or a handicap ramp, the driveway or ramp shall be constructed prior to acceptance of the curb and gutter.
 - ☐ All storm drainage facilities shall be completed prior to final acceptance.
- The Contractor's Attention is directed to section 107.4.4. of the Standard Specifications relative to the cleaning, drying, backer rod placement & the application of silicone rubber sealant to the existing embankment joint.

DESIGNED BY: Emmett / Pang	DRAWN BY: Hernandez / Zamora	CHECKED BY: Pang	DATE: 1/87
APPROVED FOR RECORD DRAWINGS	10-13-87	APPROVED FOR CONSTRUCTION	11-12-87
ASST. CITY ENGINEER FIELD	DATE	A.C.E. ENGINEER	DATE

CITY OF ALBUQUERQUE

APPROVALS	ENGINEER	DATE	TITLE:
D.R.C. CHAIRPERSON	<i>[Signature]</i>	2/18/87	HANDRAIL INSTALLATION FOR DRAINAGE CROSSING ON MANITOBA DR. E/O TRAMWAY BLVD.
TRANS. DEV.	N.H.	2/11/87	
UTILITY DEV.	W.W.	2-13-87	
PARKS & REC. DEPT.	N/A		
USER DEPT.	<i>[Signature]</i>	2/17/87	


PROJECT NO. 2902
MAP NO. F-23
SHEET 1 OF 3

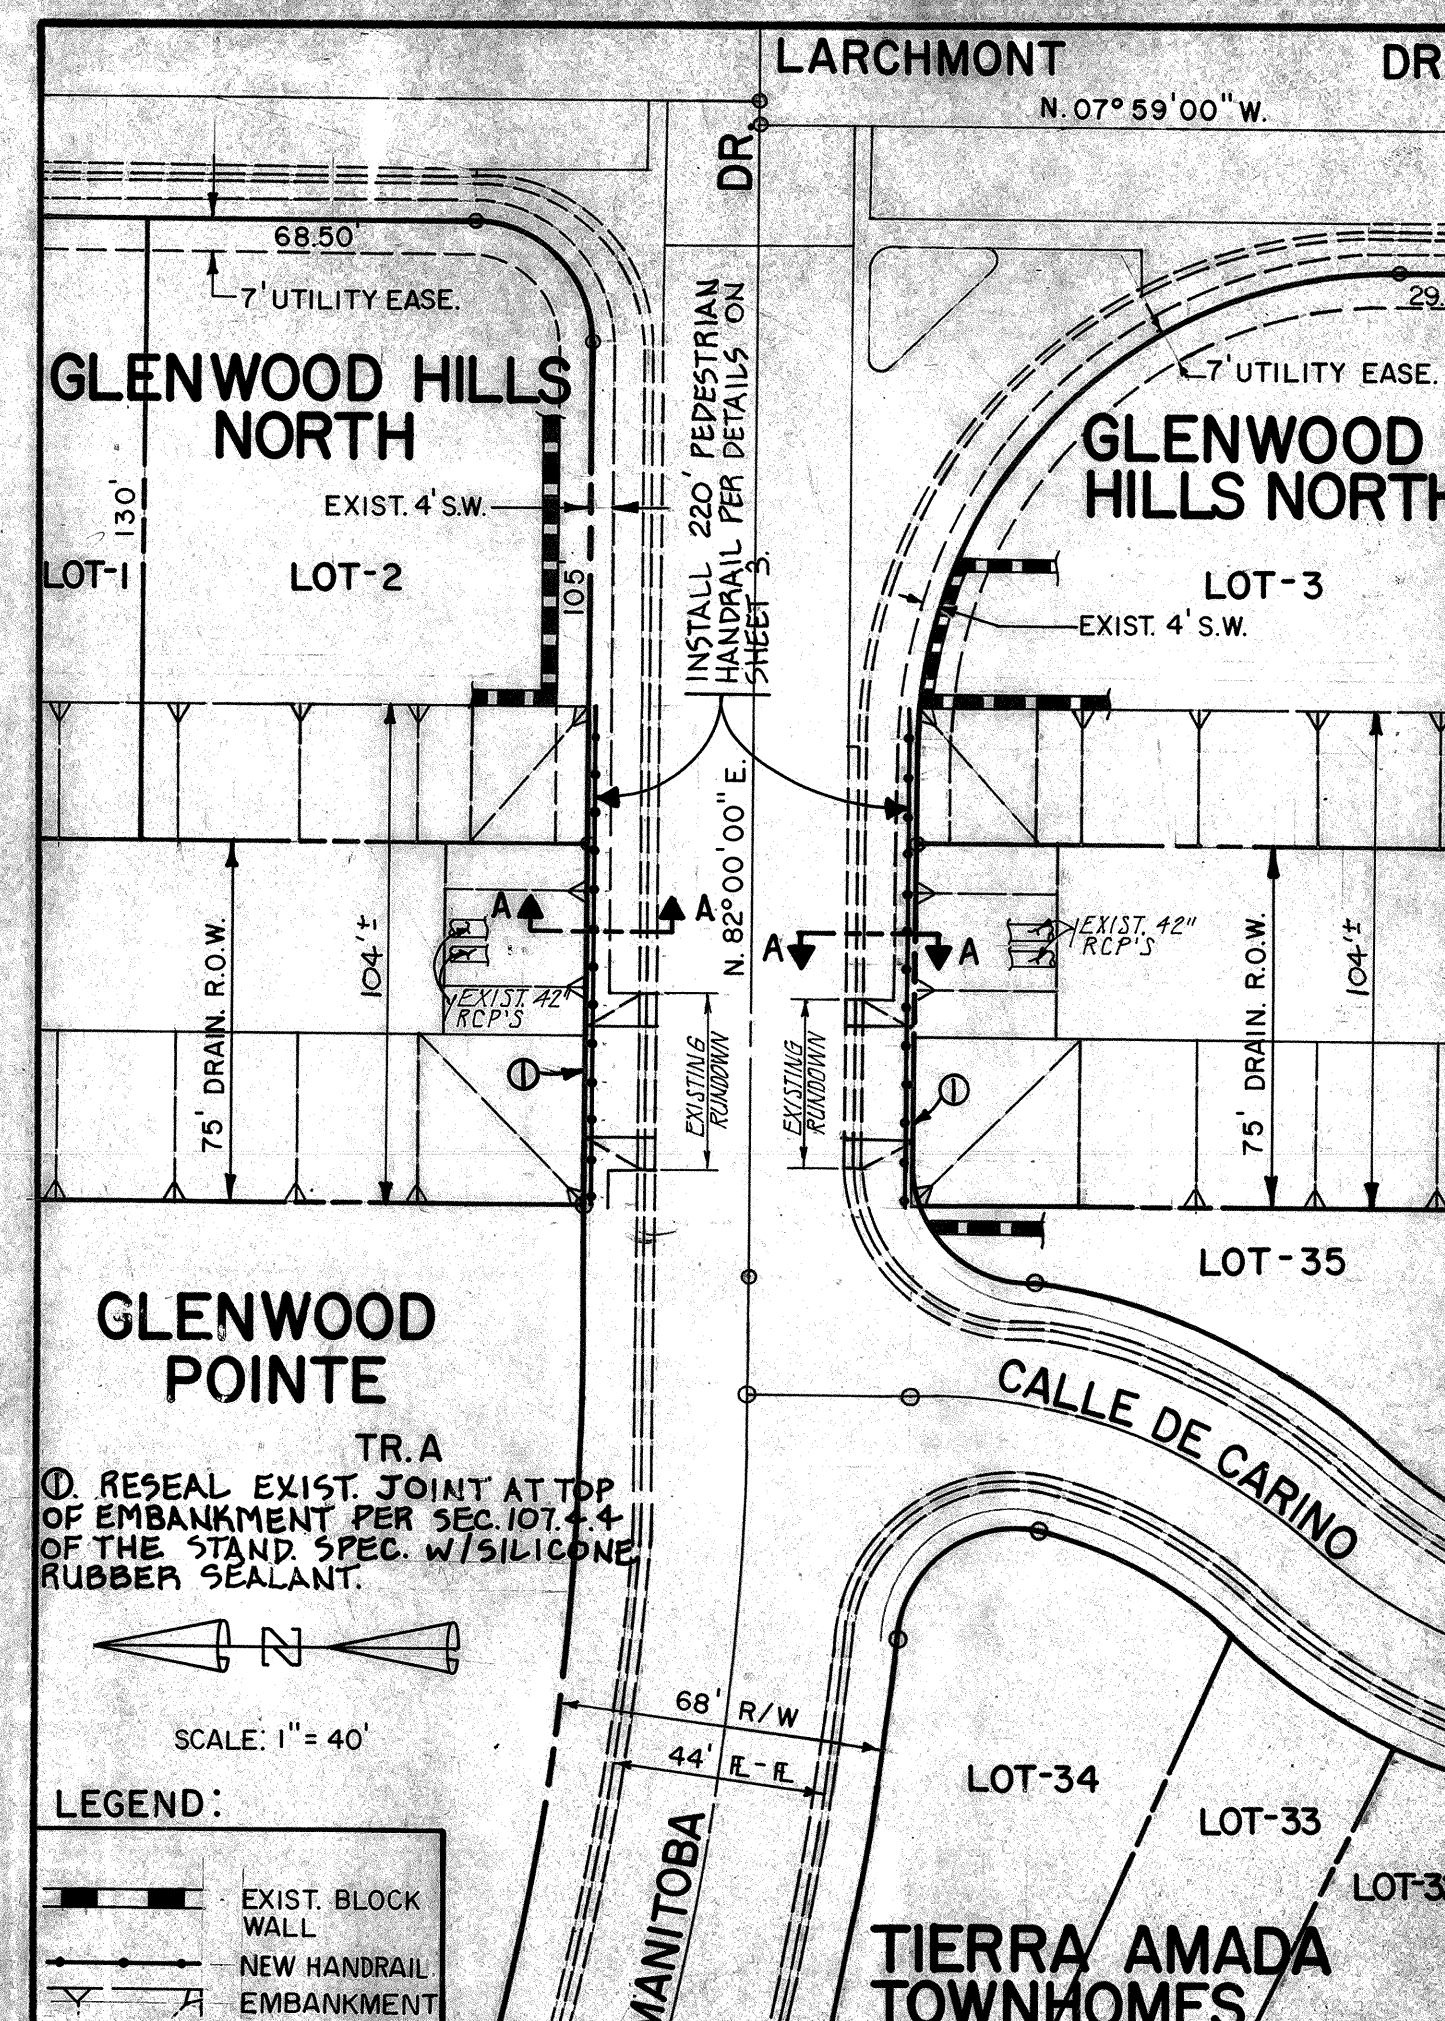

CITY OF ALBUQUERQUE

APPROVALS	ENGINEER	DATE	TITLE:
D.R.C. CHAIRPERSON	<i>[Signature]</i>	2/11/87	HANDRAIL INSTALLATION FOR DRAINAGE CROSSING ON MANITOBA DR. E/O TRAMWAY BLVD.
TRANS. DEV.	<i>[Signature]</i>	2/11/87	
UTILITY DEV.	W.W.	2-13-87	
PARKS & REC. DEPT.	N/A		
USER DEPT.	<i>[Signature]</i>	2/17/87	

PROJECT NO. 2902
MAP NO. F-23
SHEET 2 OF 3

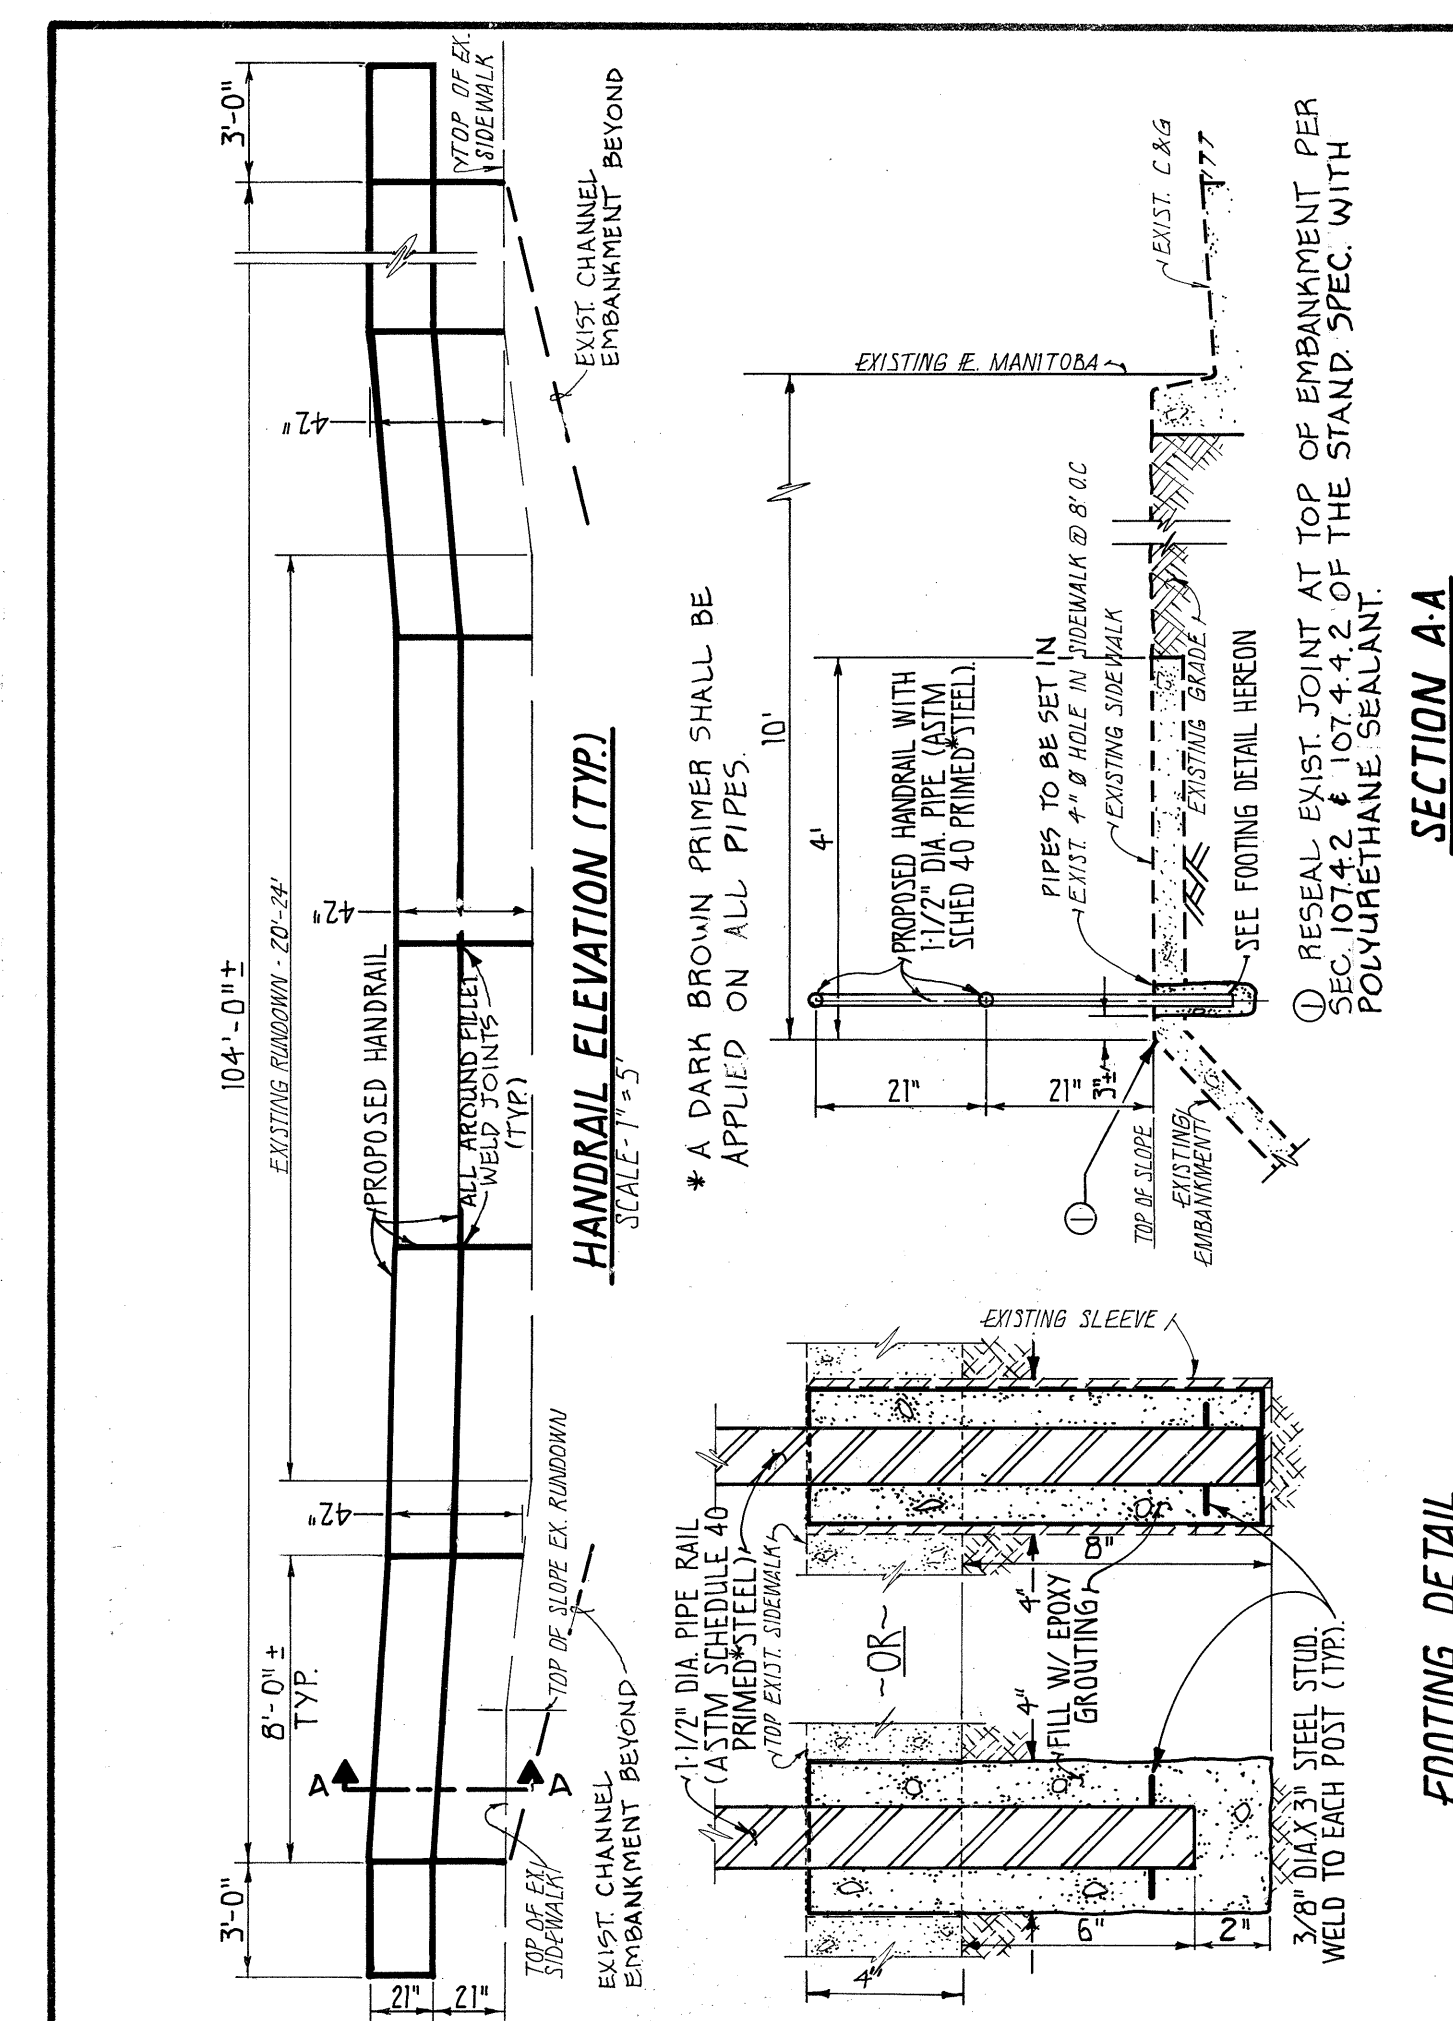

CITY OF ALBUQUERQUE

APPROVALS	ENGINEER	DATE	TITLE:
D.R.C. CHAIRPERSON	<i>[Signature]</i>	2/18/87	HANDRAIL INSTALLATION FOR DRAINAGE CROSSING ON MANITOBA DR. E/O TRAMWAY BLVD.
TRANS. DEV.	<i>[Signature]</i>	2/11/87	
UTILITY DEV.	W.W.	2-13-87	
PARKS & REC. DEPT.	N/A		
USER DEPT.	<i>[Signature]</i>	2/17/87	

PROJECT NO. 2902
MAP NO. F-23
SHEET 3 OF 3

1 2 3 4 5 6 7 8 9 10 11 12
26 29020187