
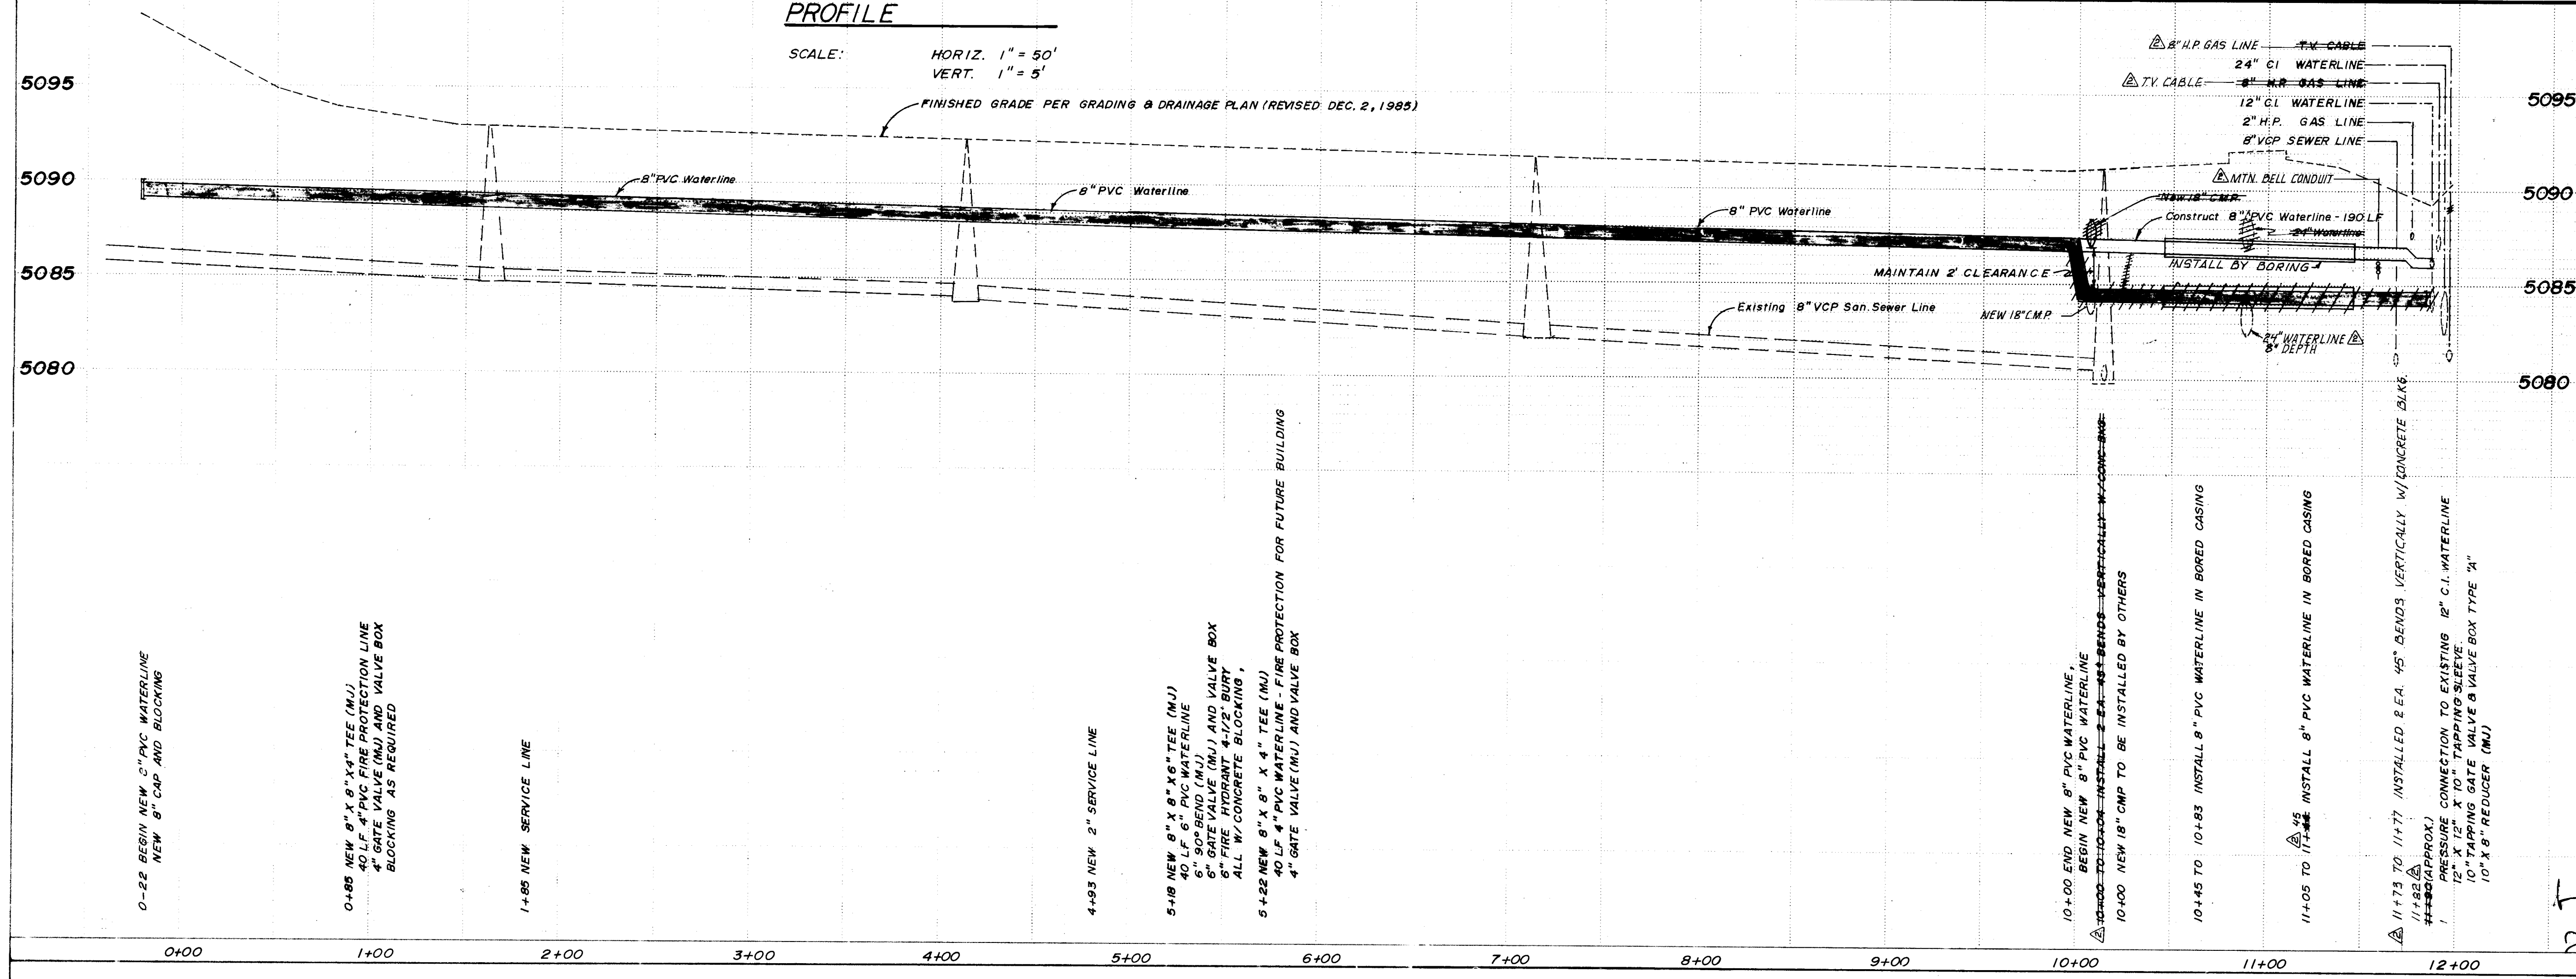


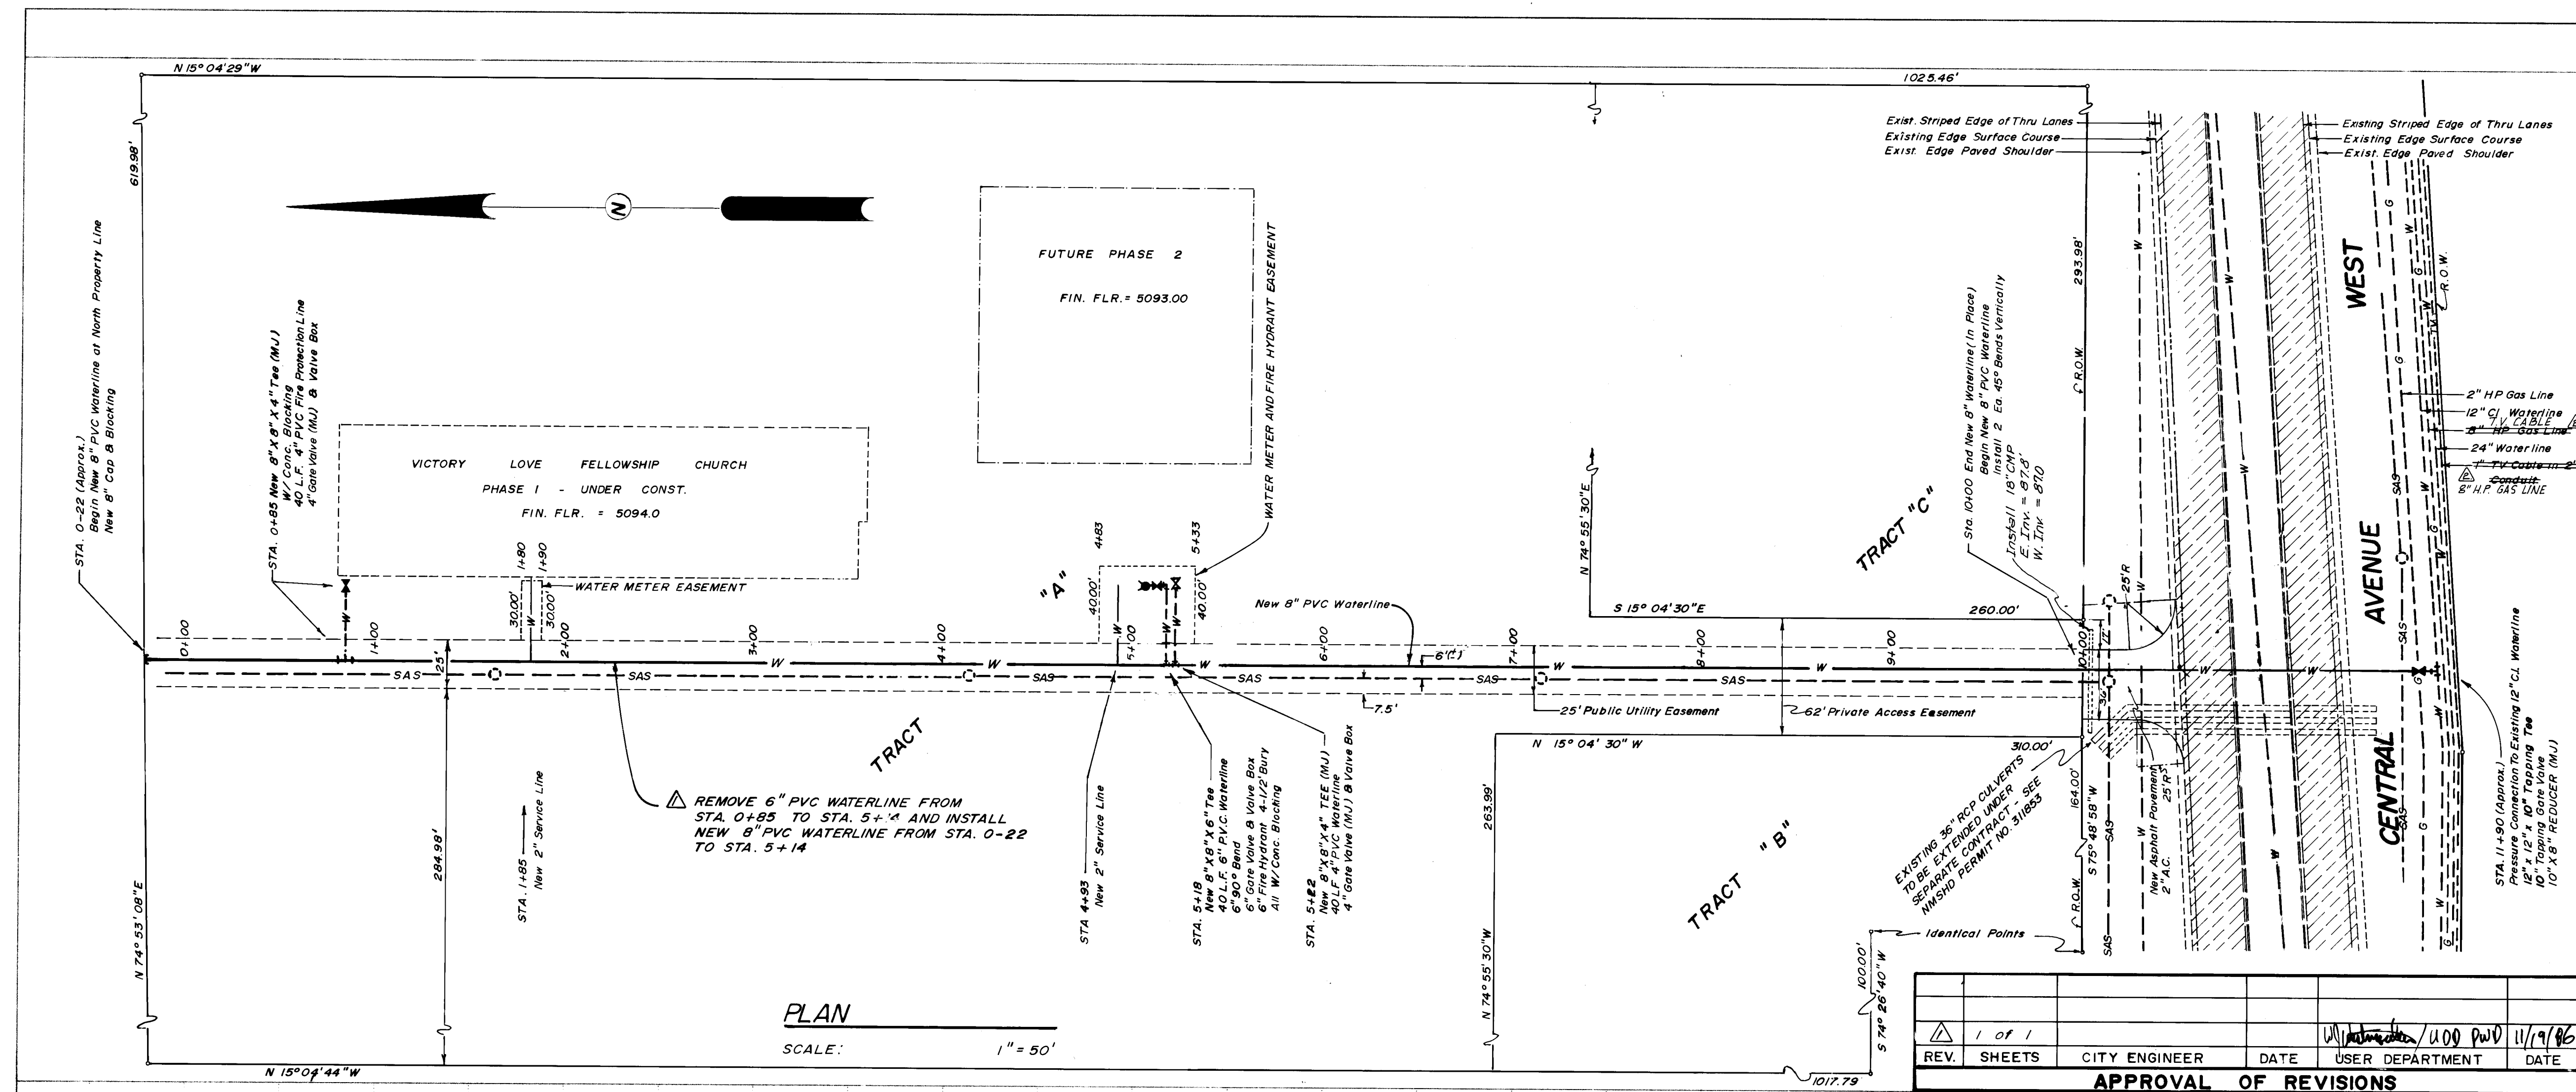

LOCATION MAP

1" = 740'

GENERAL NOTES:

- ALL WORK DETAILED ON THESE PLANS TO BE PERFORMED UNDER CONTRACT SHALL, EXCEPT AS OTHERWISE STATED OR PROVIDED HEREON, BE CONSTRUCTED IN ACCORDANCE WITH THE INTERIM SPECIFICATIONS FOR PUBLIC WORKS CONSTRUCTION, 1985, TOGETHER WITH THE STANDARD DRAWINGS CONTAINED THEREIN.
- TWO WORKING DAYS PRIOR TO ANY EXCAVATION, CONTRACTOR MUST CONTACT LINE LOCATING SERVICE, 765-1234, FOR LOCATION OF EXISTING UTILITIES.
- PRIOR TO CONSTRUCTION, THE CONTRACTOR SHALL EXCAVATE AND VERIFY THE HORIZONTAL AND VERTICAL LOCATIONS OF ALL OBSTRUCTIONS. SHOULD A CONFLICT EXIST, THE CONTRACTOR SHALL NOTIFY THE ENGINEER OR SURVEYOR SO THAT THE CONFLICT CAN BE RESOLVED WITH MINIMUM AMOUNT OF DELAY.
- ALL UTILITIES AND UTILITY SERVICE LINES SHALL BE INSTALLED PRIOR TO PAVING.
- BACKFILL COMPACTION SHALL BE ACCORDING TO ARTERIAL STREET USE WITHIN THE PAVEMENT LIMITS OF CENTRAL AVENUE.
- TACK COAT REQUIREMENTS SHALL BE DETERMINED BY THE CITY ENGINEER.
- PRIOR TO COMMENCING BORING OPERATIONS, THE CONTRACTOR IS TO EXCAVATE ALL UTILITIES IN THE CENTRAL AVENUE RIGHT-OF-WAY TO DETERMINE THE INVERT ELEVATIONS OF ALL UTILITIES AT THE POINTS WHERE THE WATERLINE CROSSES UNDER OR OVER SAID UTILITIES TO AVOID ANY POSSIBLE CONFLICT IN THE BORING ALIGNMENT OR IN CONNECTING TO THE 12" WATERLINE.

AS BUILT INFORMATION

CONTRACT NO. SHAMROCK FIVE CONST.

DATE 12/10/86

FIELD BY E. LOVELADY

DATE 12/10/86

REVISIONS

NO. DATE

1. 12/02/86 REVISION FROM AS BUILT INFORMATION

2. 11/19/86 Replaced 6" PVC Line w/ 12" PVC Waterline

ENGINEER'S SEAL

FRANK D. LOVELADY

REGISTERED PROFESSIONAL ENGINEER

NO. 10101

STATE OF NEW MEXICO

LEGEND

EXISTING	NEW	DESCRIPTION
---	---	Waterline
---	---	Sanitary Sewer Line
---	---	Sanitary Sewer Manhole
---	---	Gas Line
---	---	Cable T.V.
---	---	Telephone
---	---	Existing Pavement

APPROVALS

ENGINEER	DATE	APPROVALS	ENGINEER	DATE
City Engineer	8/4/86	Liquid Waste	W. J. ...	8/6/86
A.C.E. Design	8/6/86	Traffic	W. J. ...	8/6/86
A.C.E. Hydrology	8/6/86	Water	W. J. ...	8/6/86

CITY OF ALBUQUERQUE

MUNICIPAL DEVELOPMENT DEPARTMENT

ENGINEERING DIVISION

TITLE: WATERLINE EXTENSION

VICTORY LOVE FELLOWSHIP CHURCH

DRAWING NO. 2908

MAP NO. K-10

SHEET 1 OF 1

James H. ... 9/9/86