

NEXT SHEET NO. G-12N



NEXT SHEET NO. G-14N

WATER RESOURCES DEPARTMENT
APPROVAL OF AS BUILT DRAWINGS
Brian Dean
Date 4/28/86

CITY OF ALBUQUERQUE
WATER DIVISION

SECTIONAL MAPS


2909

G-13N

SHT 1 OF 2

NEXT SHEET NO. G-13S

LEGEND		REVISIONS	
	GATE VALVE	7-84	W/L REPL. ON ARVILLA AVE. (26-1531-84) G.K.
	CLOSED VALVE	10-84	BAGA SUBDIVISION 26-1532-84 M.G.
	SURGE VALVE		
	LINE REDUCTION SIZE IND.		
	FIRE HYDRANT		
	DISTRIBUTION LINE OR TRANSMISSION LINE THRU TRANSMISSION LINE WELL LINE		
	GATE VALVE W BY PASS		
	PRESSURE REDUC. VALVE		
	AIR RELIEF VALVE		
	CHECK VALVE		
	MOTORIZED GATE VALVE		
(DATE) END OF LINE INSTALLATION			

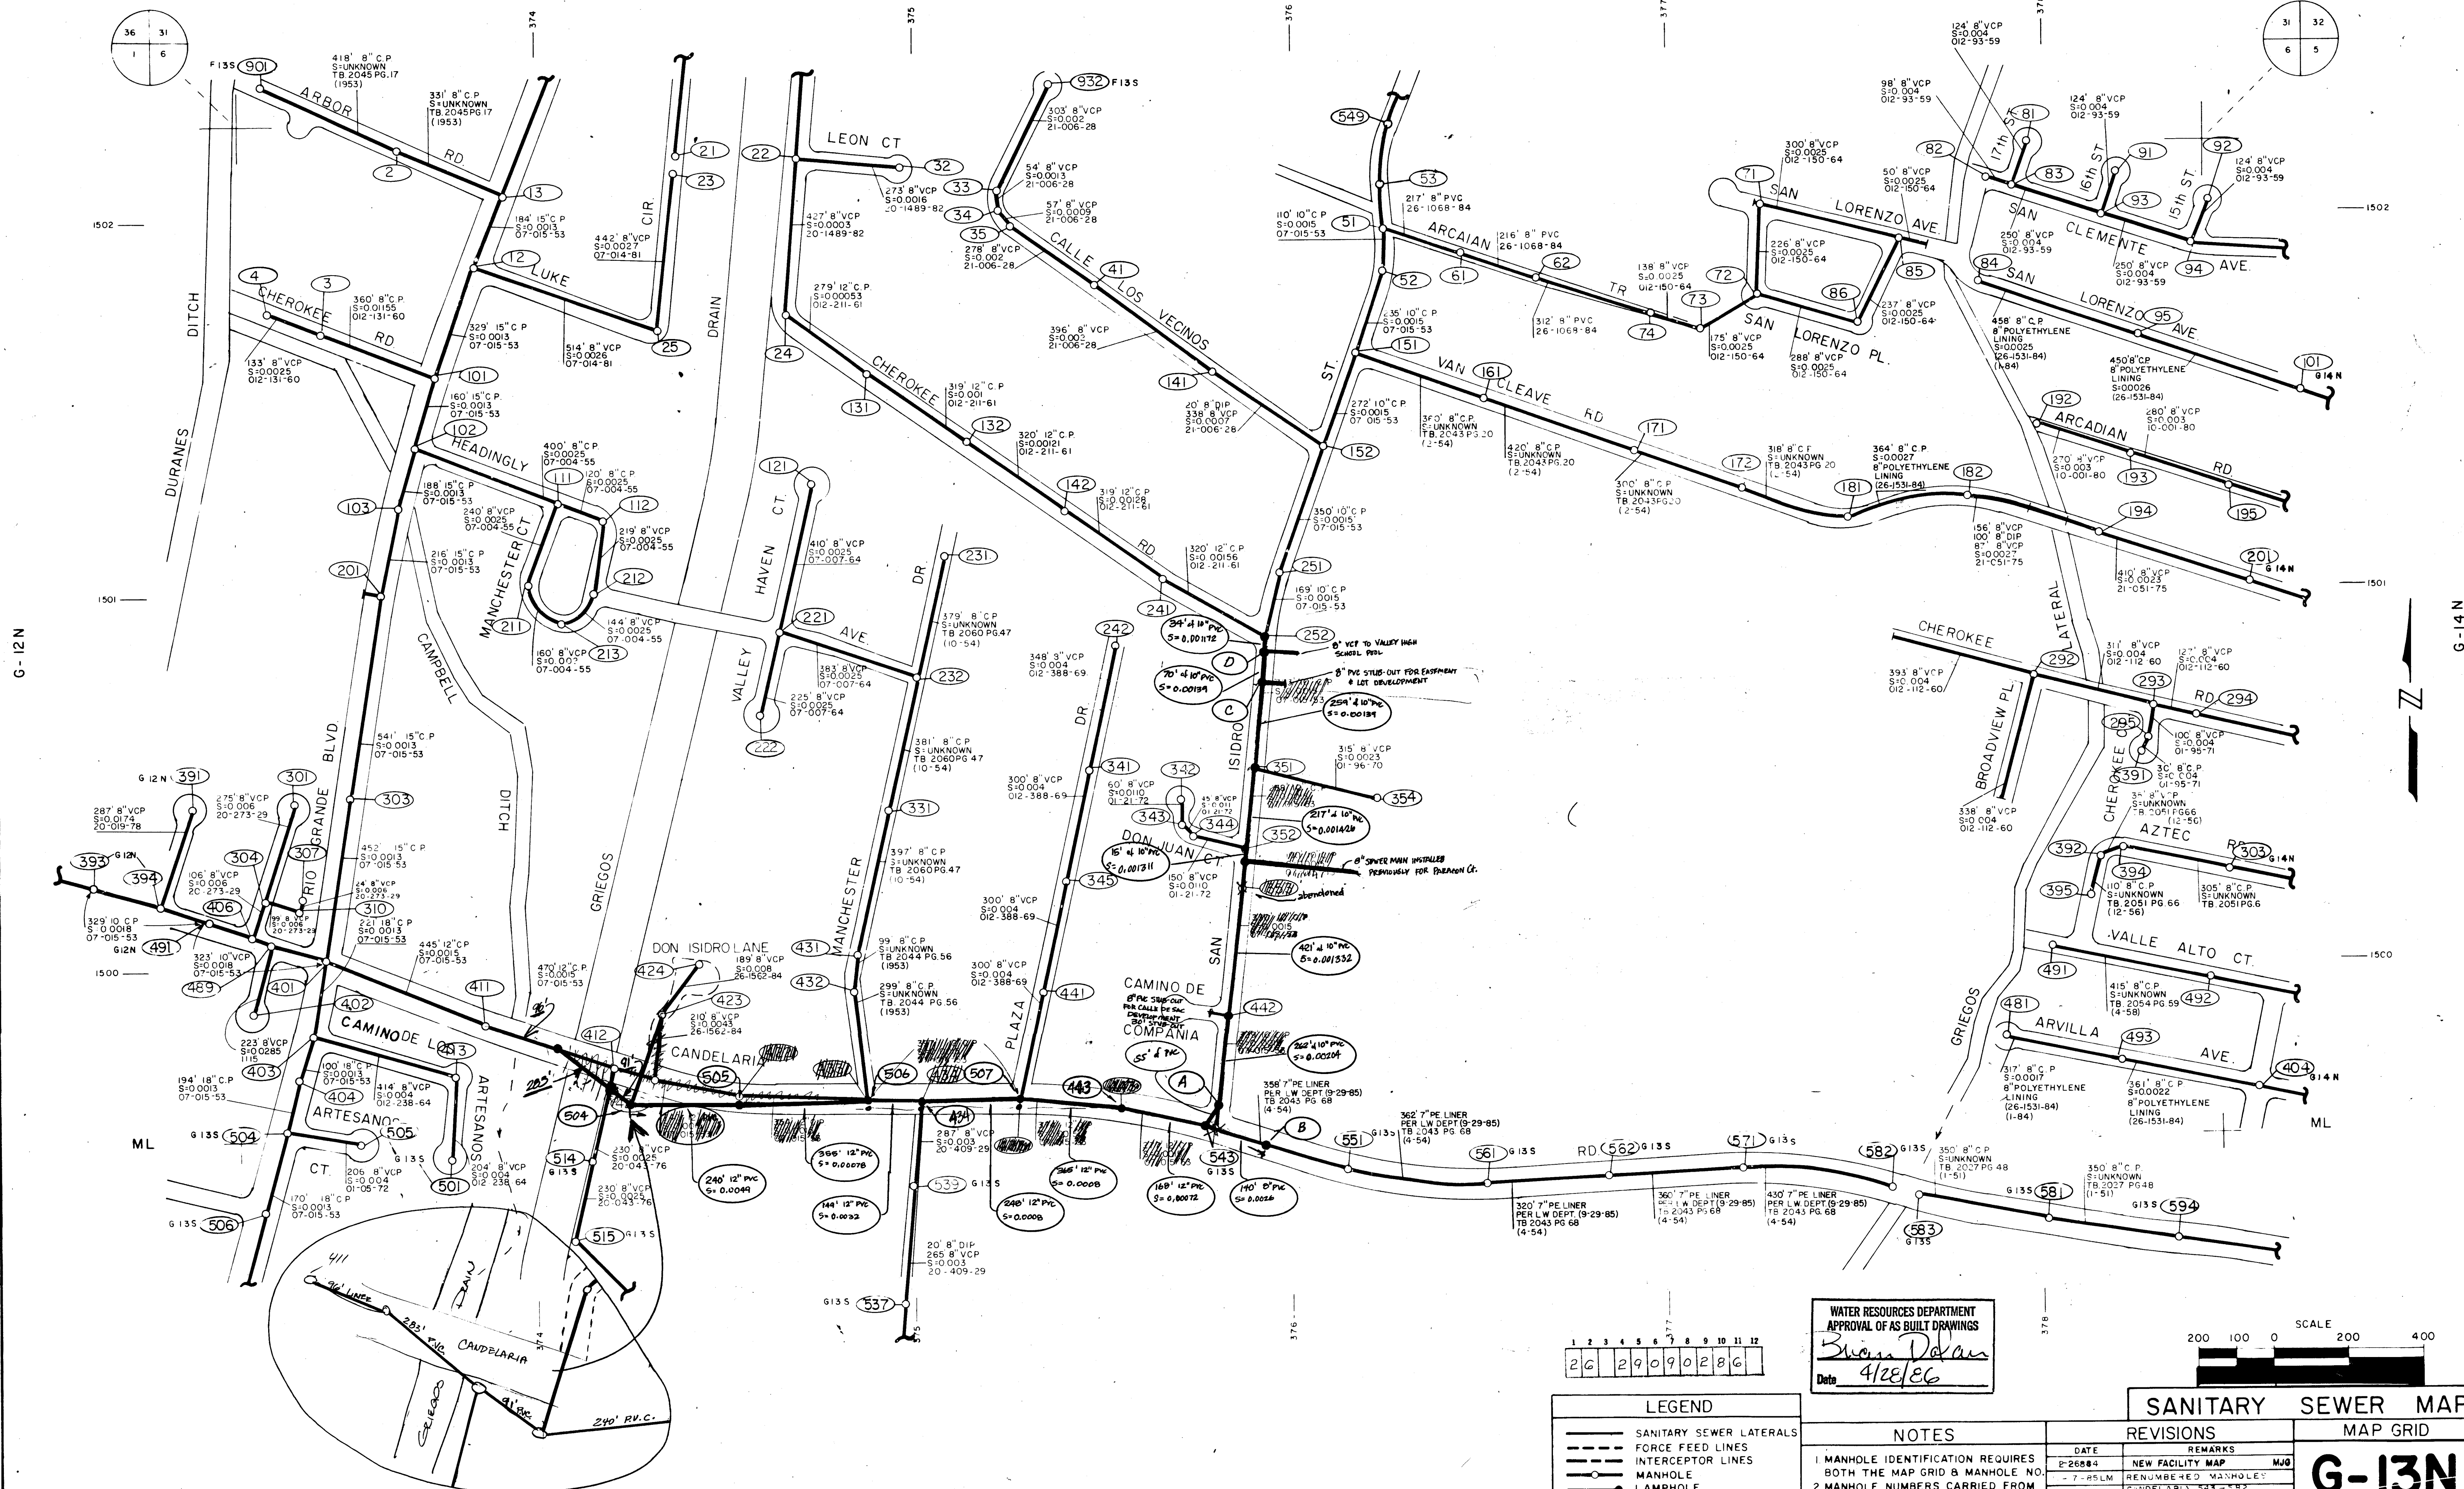

1	2	3	4	5	6	7	8	9	10	11	12
26	29	09	02	86							

LEGEND	
	SANITARY SEWER LATERALS
	FORCE FEED LINES
	INTERCEPTOR LINES
	MANHOLE
	LAMP HOLE
	DEAD END
	MANHOLE NUMBER

WATER RESOURCES DEPARTMENT
APPROVAL OF AS BUILT DRAWINGS
Brian D. Dean
Date 4/28/86

NOTES
1. MANHOLE IDENTIFICATION REQUIRES BOTH THE MAP GRID & MANHOLE NO.
2. MANHOLE NUMBERS CARRIED FROM ADJACENT MAPS HAVE THE MAP GRID SHOWN.

REVISIONS		DATE	REMARKS	BY
1	2-26-84	4-28-86	NEW FACILITY MAP	MJD
2	7-85 LM		RENUMBERED MANHOLES	
3	11-85 LM		RENUMBERED MANHOLES	
4	11-85 LM		RENUMBERED MANHOLES	
5	11-85 LM		RENUMBERED MANHOLES	
6	11-85 LM		RENUMBERED MANHOLES	
7	11-85 LM		RENUMBERED MANHOLES	
8	11-85 LM		RENUMBERED MANHOLES	
9	11-85 LM		RENUMBERED MANHOLES	
10	11-85 LM		RENUMBERED MANHOLES	
11	11-85 LM		RENUMBERED MANHOLES	
12	11-85 LM		RENUMBERED MANHOLES	

SANITARY SEWER MAP		MAP GRID	
G-13N		SHT 2 OF 2	

2909