


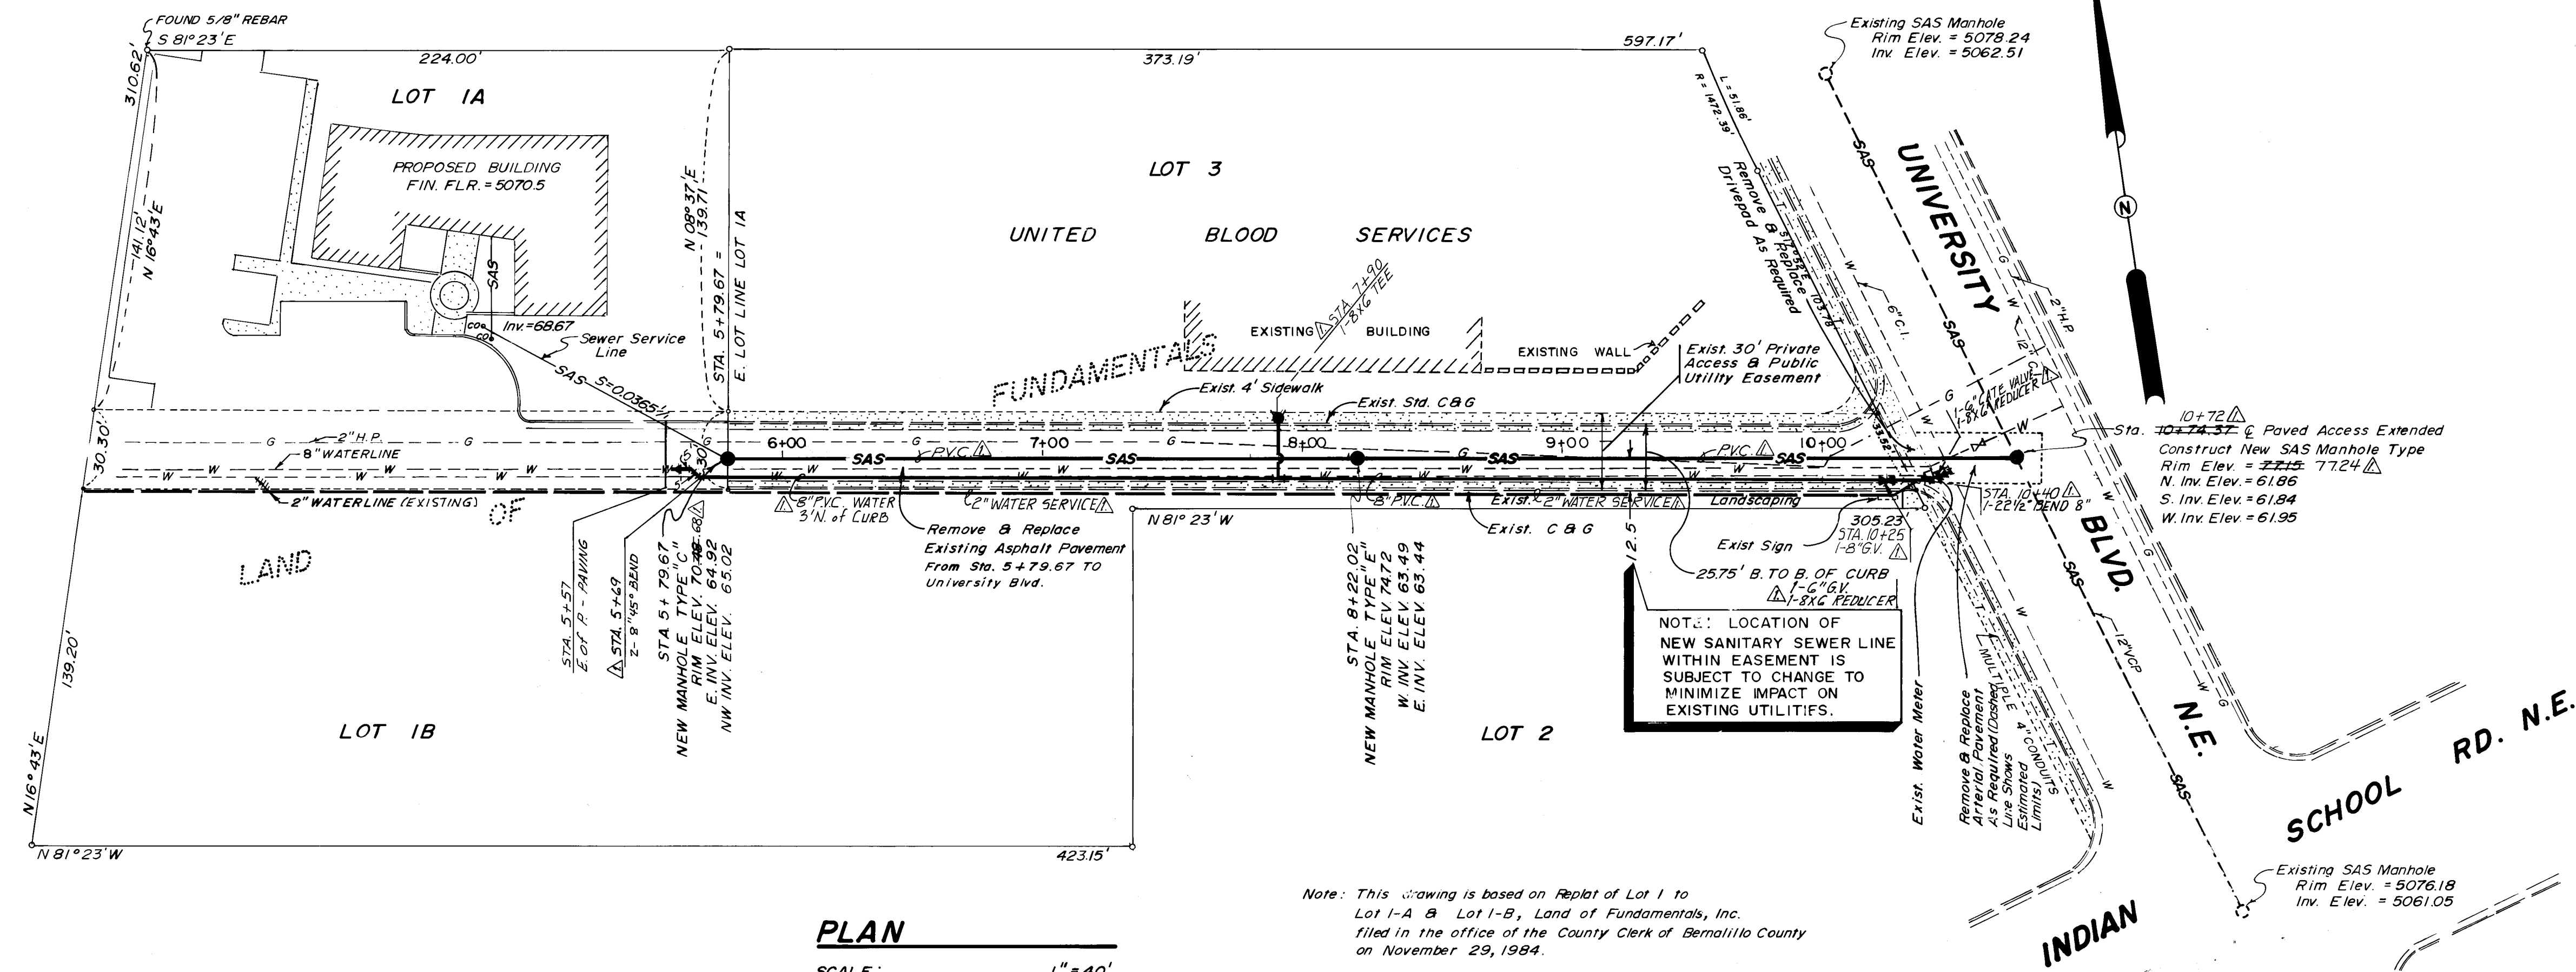



PLAN

SCALE: 1" = 40'

PROFILE

SCALE: HORIZ. 1" = 40'
VERT. 1" = 5'

Note: This drawing is based on Replat of Lot 1 to Lot 1-A & Lot 1-B, Land of Fundamentals, Inc. filed in the office of the County Clerk of Bernalillo County on November 29, 1984.

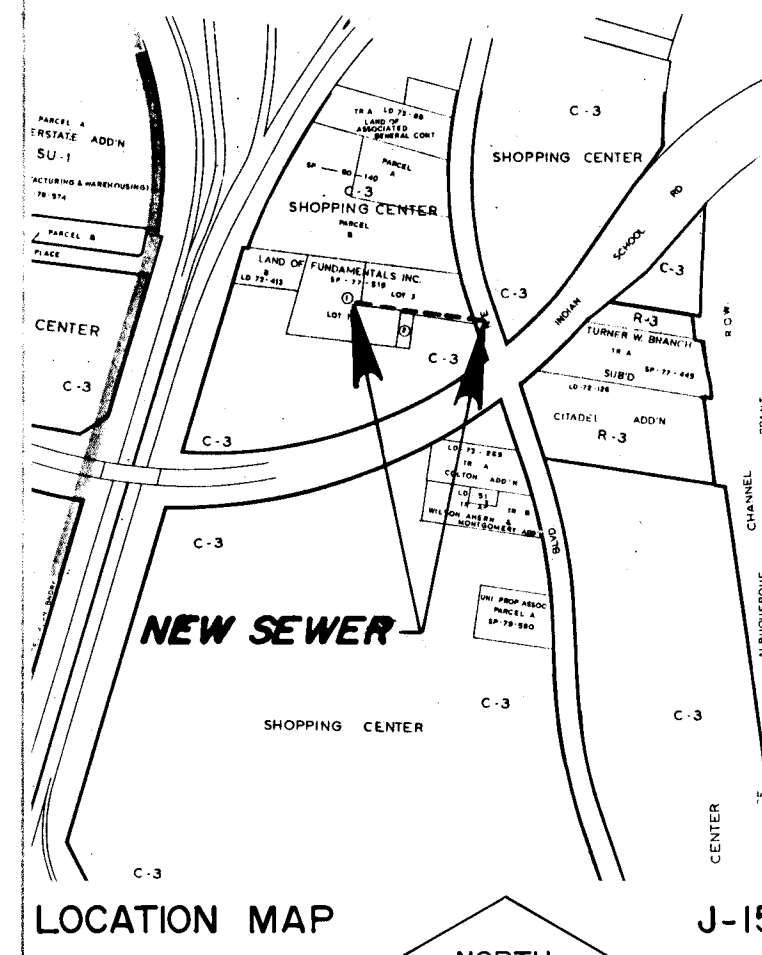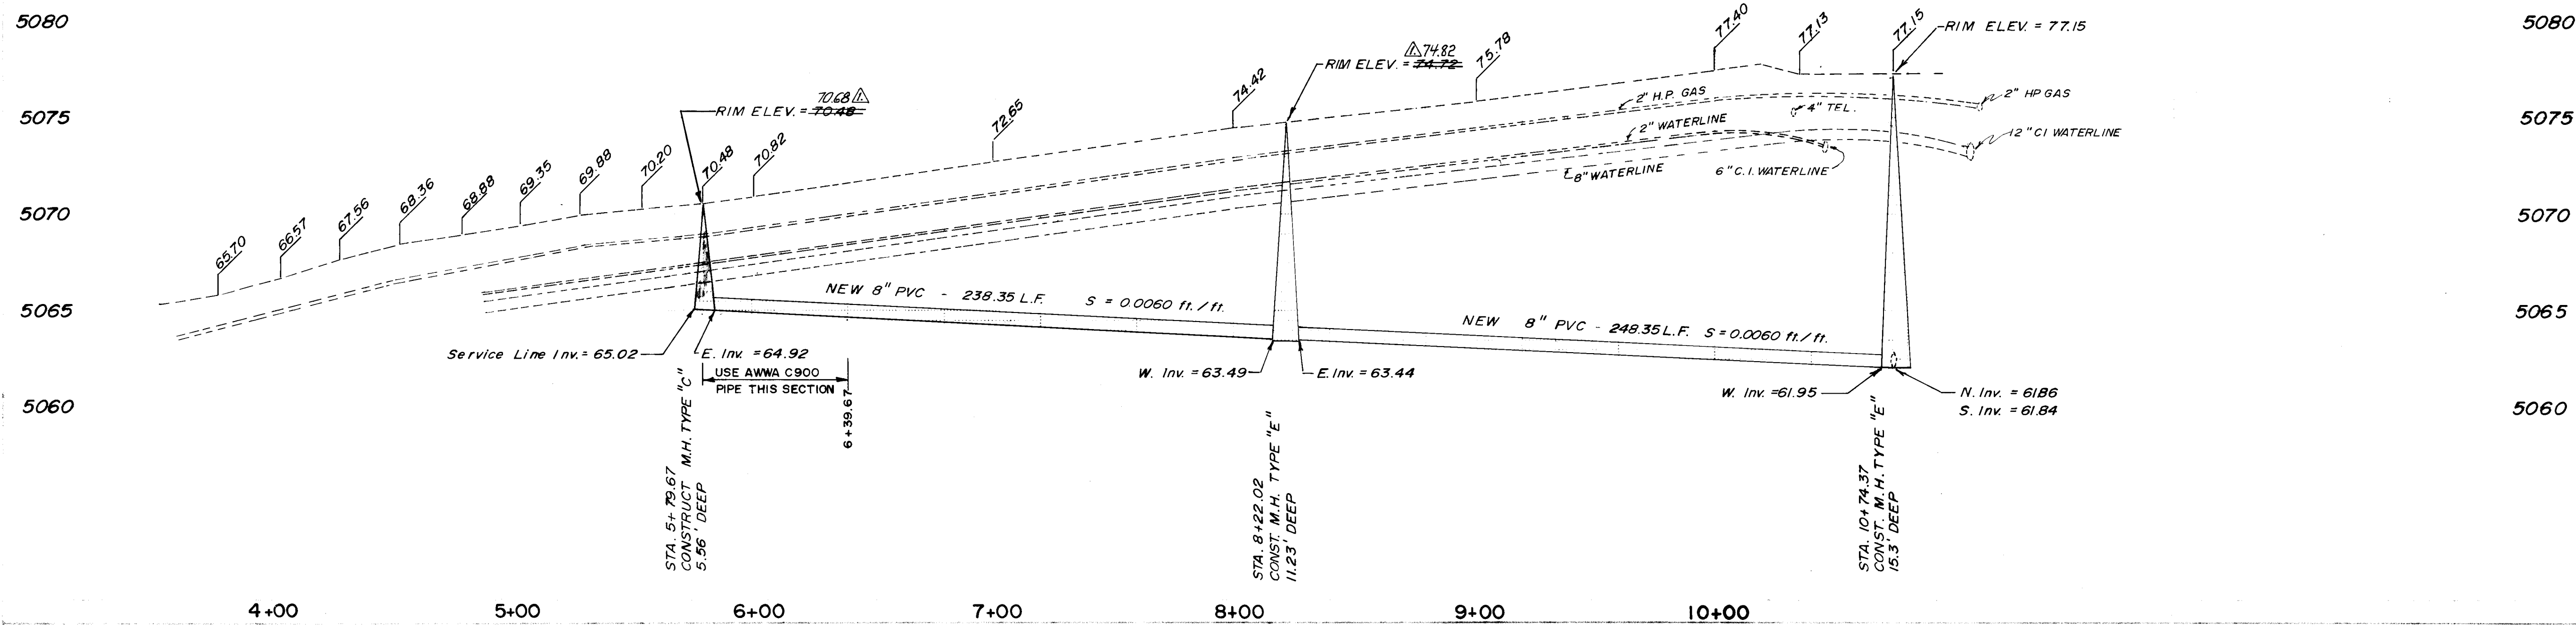

GENERAL NOTES:

1. ALL WORK DETAILED ON THESE PLANS TO BE PERFORMED UNDER CONTRACT SHALL, EXCEPT AS OTHERWISE STATED OR PROVIDED FOR HEREON, BE CONSTRUCTED IN ACCORDANCE WITH THE INTERIM SPECIFICATIONS FOR PUBLIC WORKS CONSTRUCTION, 1985, TOGETHER WITH THE STANDARD DRAWINGS CONTAINED THEREIN.
2. TWO WORKING DAYS PRIOR TO ANY EXCAVATION, CONTRACTOR MUST CONTACT LINE LOCATING SERVICE, 765-1234, FOR LOCATION OF EXISTING UTILITIES.
3. PRIOR TO CONSTRUCTION, THE CONTRACTOR SHALL EXCAVATE AND VERIFY THE HORIZONTAL AND VERTICAL LOCATIONS OF ALL OBSTRUCTIONS. SHOULD A CONFLICT EXIST, THE CONTRACTOR SHALL NOTIFY THE ENGINEER OR SURVEYOR SO THAT THE CONFLICT CAN BE RESOLVED WITH A MINIMUM AMOUNT OF DELAY.
4. BACKFILL COMPACTION SHALL BE ACCORDING TO ARTERIAL STREET USE WITHIN THE PAVEMENT LIMITS OF UNIVERSITY BLVD.
5. AT NO TIME SHALL MORE THAN ONE (1) LANE OF TRAFFIC BE BLOCKED ON UNIVERSITY BOULEVARD AT A GIVEN TIME WITH THE NOTED LANE BEING BLOCKED FOR A MAXIMUM OF TWO DAYS.
6. CONTRACTOR MUST OBTAIN BARRICADE PERMIT 24 HOURS IN ADVANCE OF ANY LANE CLOSURES.
7. CONTRACTOR SHALL TAKE NECESSARY PROTECTIVE MEASURES SUCH AS SHORING TO PROTECT EXISTING UTILITIES DURING EXCAVATION, PIPE PLACEMENT, AND BACKFILL OF THE SANITARY SEWER LINE.
8. LOCATION OF EXISTING UTILITIES WITHIN THE UTILITY EASEMENT ARE APPROXIMATE ONLY. CONTRACTOR SHALL DETERMINE THE EXACT LOCATIONS BY EXCAVATING AT TWO OR MORE LOCATIONS PRIOR TO COMMENCING ANY ACTUAL WORK ON THE SEWER LINE.

1	2	3	4	5	6	7	8	9	10	11	12
2	6	2	9	2	2	0	1	8	7		

APPROVAL OF AS BUILT DRAWINGS
CHIEF CONSTRUCTION ENGINEER
DATE 5-29-87

5/27/87 REVISION FROM AS BUILT INFORMATION
REVISIONS
DATE 5-27-86
F. LOVELADY
DATE 5-28-86
F. LOVELADY
DATE 5-29-86
F. LOVELADY

CITY OF ALBUQUERQUE MUNICIPAL DEVELOPMENT DEPARTMENT ENGINEERING DIVISION	
TITLE: SANITARY SEWER EXTENSION	
LOTS 1A & 1B, LAND OF FUNDAMENTALS	
APPROVALS	DATE
Engineer	1/19/87
Asst. Engineer	1/19/87
Hydrographer	1/19/87
Surveyor	1/19/87
Checker	1/19/87
Printer	1/19/87

DRAWING NO.	2922
MAP NO.	J-15
SHEET	1
OF	1